



INSIDE V-REG COMP.

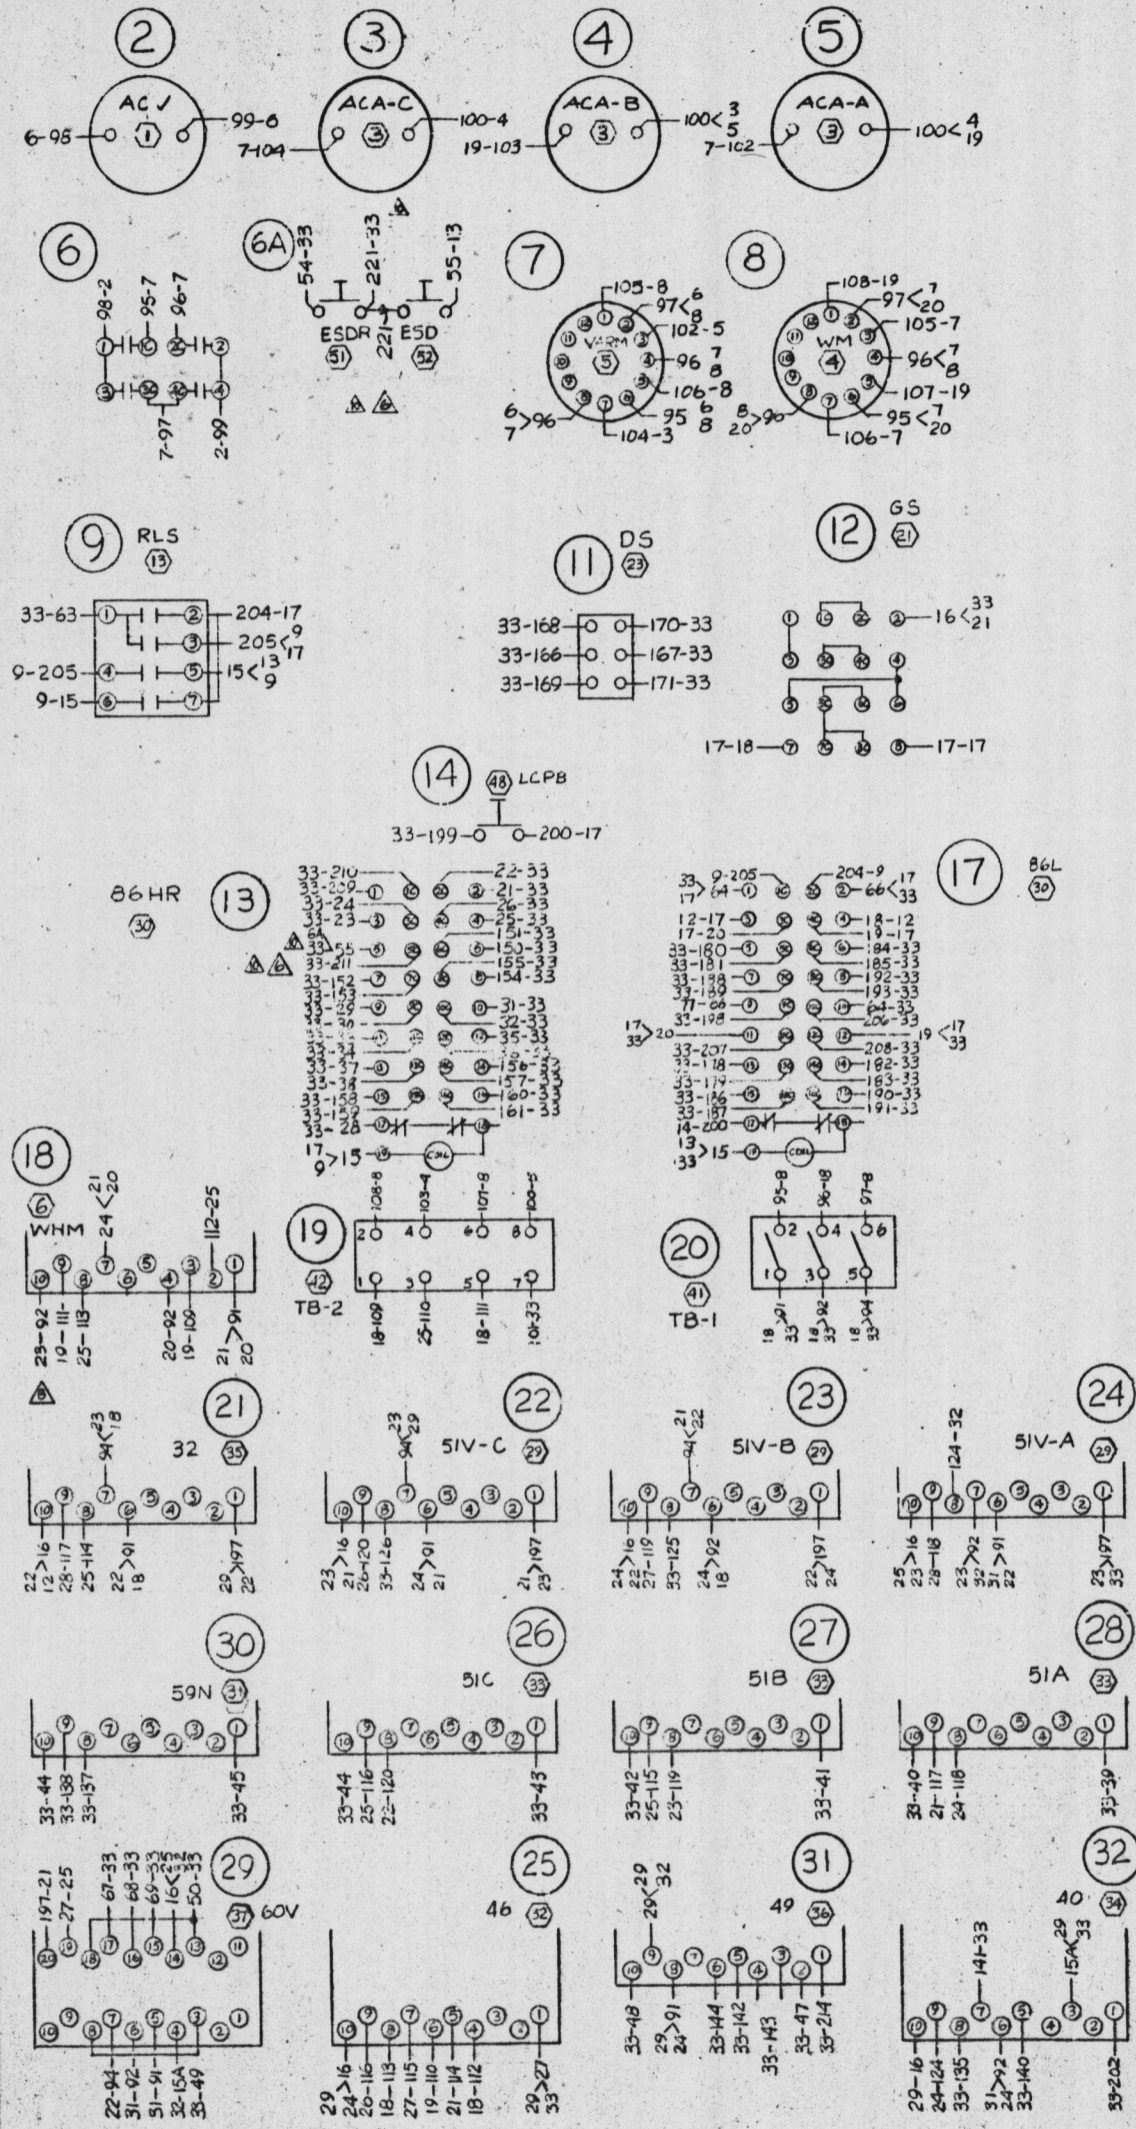

METERING DOOR R.V.

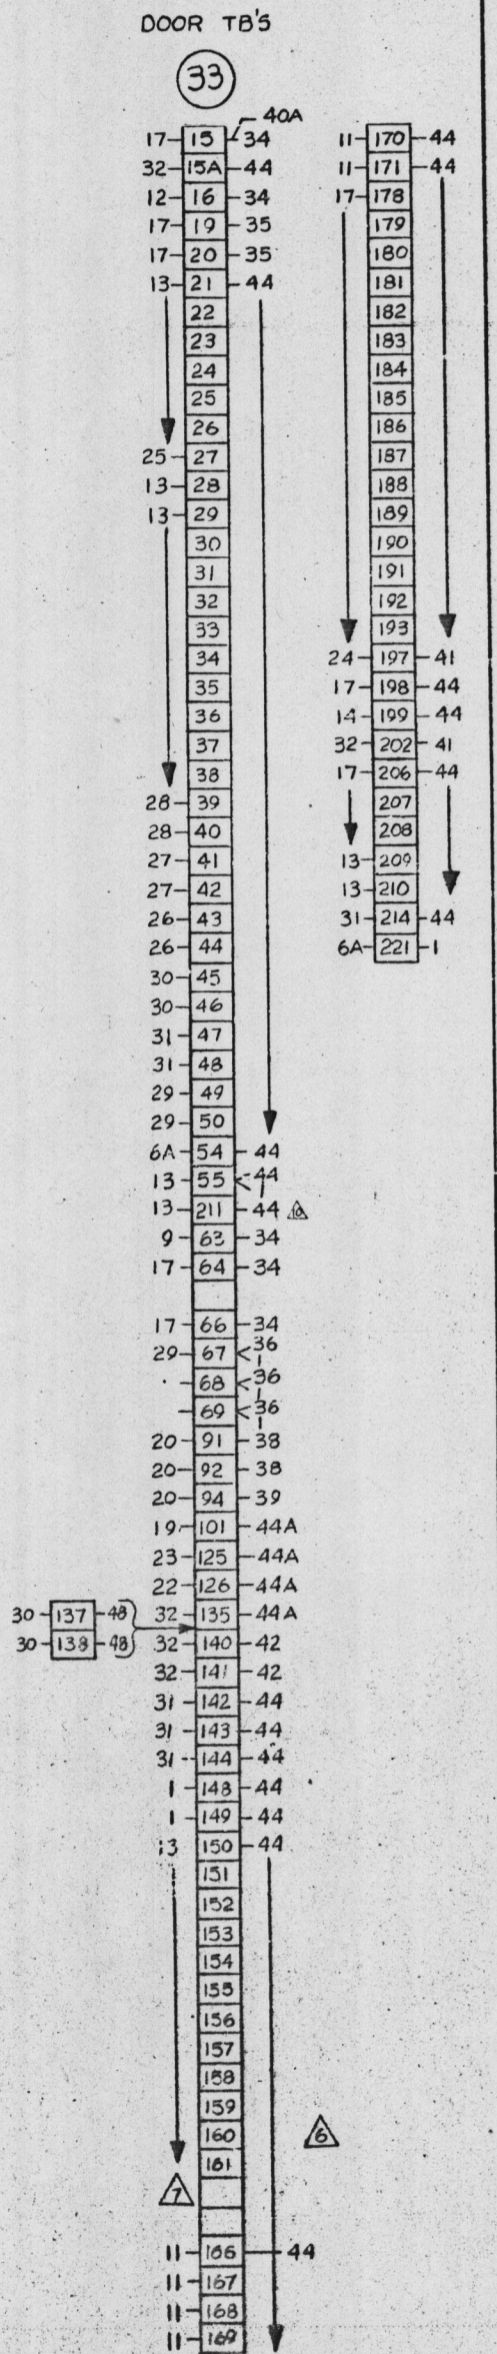

APERTURE CARD

MEM-20
TVA DIV 02 Bldg
PROJECT: BELLEFONTE 1 & 2
2000-10-10 6 8 1
CONTRACTOR: GENERAL TOR

APPROVED
This approval does not relieve
the contractor from any part of his
responsibility for the correctness
of design, construction and materials
TENNESSEE VALLEY AUTHORITY
DATE: OCT 23 1979
ASST. ENGR. C.A. DUFFLEY

TENNESSEE VALLEY AUTHORITY
CONTRACT NO. 76K51-86181
BELLEFONTE UNITS 1 & 2

NO.	REVISIONS	BY	DATE
10	PER CUST. REVISED PRINT 8-22-79	KP	8-10-79
	REDRAWN	AQ	10-30-78
	CORRECTION	J.E.	5-13-78
	AS BUILT	J.E.	3-2-78
	PER CUST. REVISED PRINT	M.E.	1-27-78
5	REVISED TO AGREE W/ OF LAVAL'S MARKED PRINT (17-21-77)	M.E.	12-22-77
4	PER CUST. LETTER DTD. 11-08-77	H.S.	11-15-77
3	PER CUST. REVISED PRINT	CTH	7-22-77
2	AS BUILT	CTH	5-27-77
1	PER CUST. PRINT	DAS	3-3-77

CONNECTION DIAGRAM DIESEL GENERATOR LOCAL PANEL

ENGINEER TVA
CUSTOMER DE LAVAL
P.O. NO. 62566



Post Office Box 1995
705 N. Carlton
Telephone 466-3621
Stockton, California 95201

DRAWN BY A.Q. DWG. NO. D54200-4 NONE
CHKD BY RBQ. SHEET 4 OF 4 DATE 10-30-78

THIS DRAWING IS CERTIFIED
TO BE TRUE AND CORRECT.
Signed: P. Heesman
Project Engineer
Date: 9-10-79

Docket # 50-438
Control # 8202080064
Date 820202 of Document
REGULATORY DOCKET FILE