


NOTES:
1. FOR GENERAL NOTES AND SYMBOLS SEE 56W1740-RT-01.

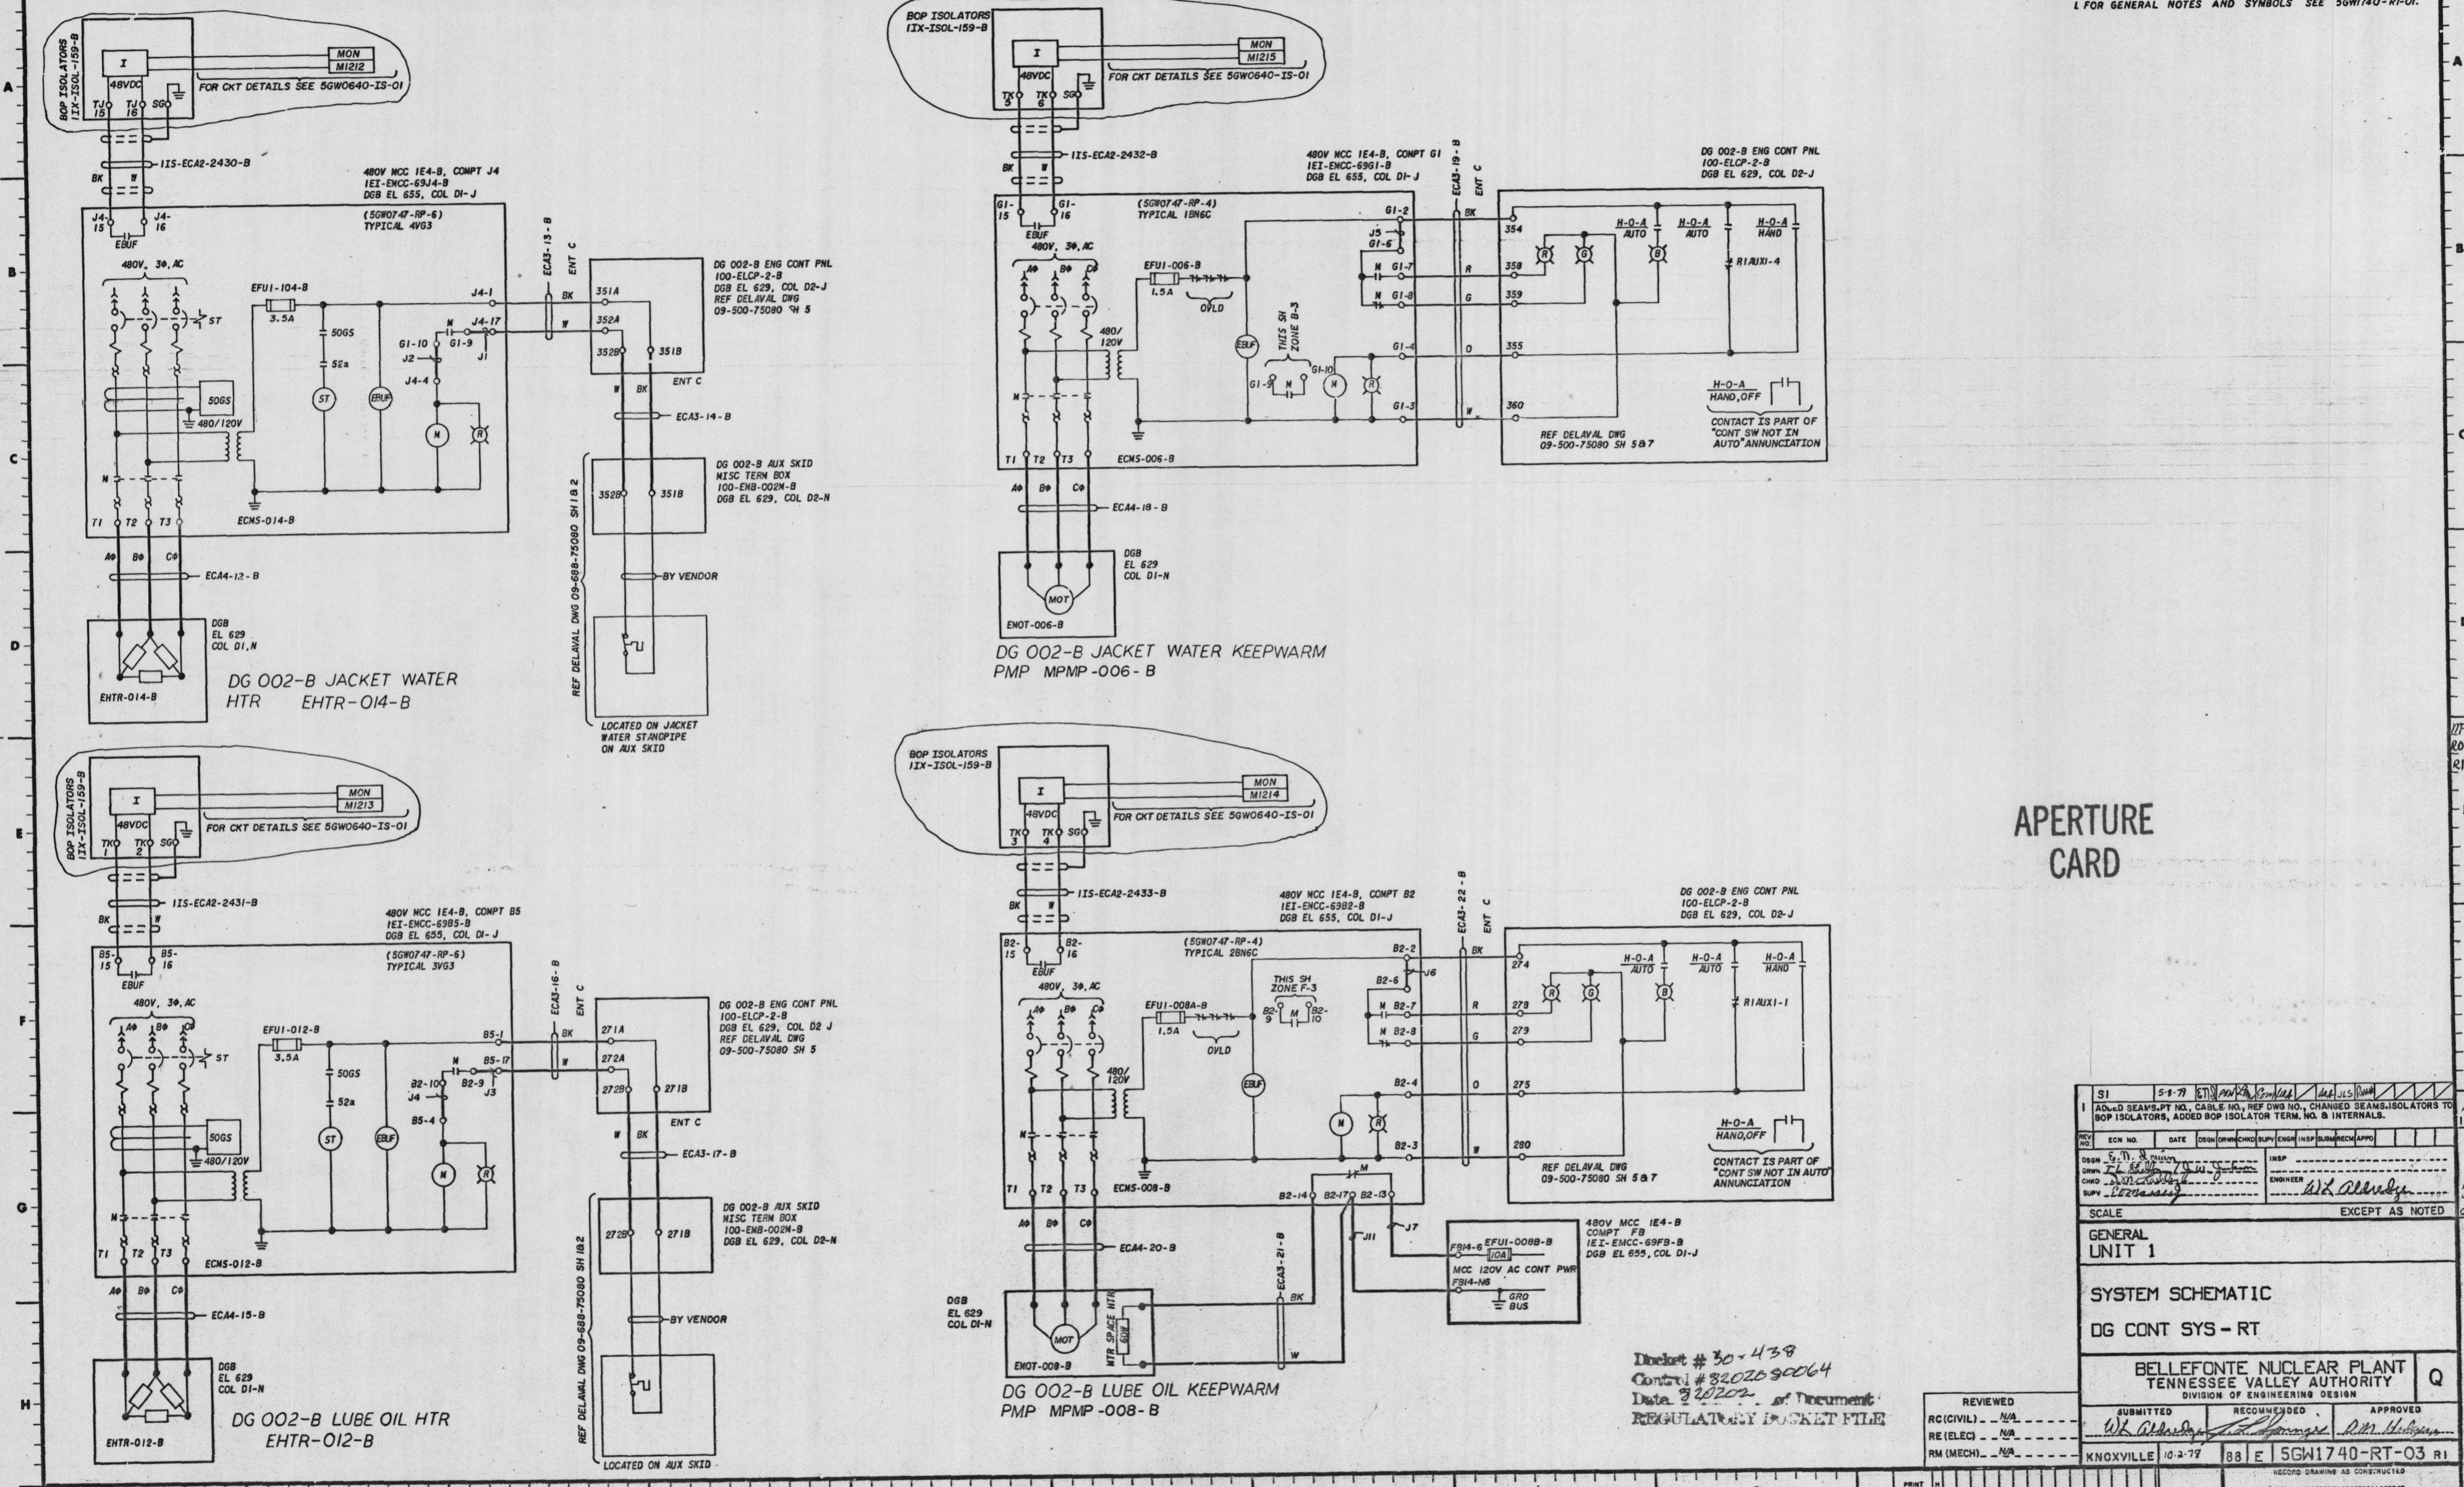

APERTURE CARD

SI	5-1-79	ENTR-012-B	ENTR-012-B	ENTR-012-B	ENTR-012-B
AD-D SEAM-PT NO., CABLE NO., REF Dwg NO., CHANGED SEAMS-ISOLATORS TO BOP ISOLATORS, ADDED BOP ISOLATOR TERM. NO. B INTERNALS.					
REV NO.	ECN NO.	DATE	DSGN	CHKD	SUPV
1			W.L. Alldredge	W.L. Alldredge	W.L. Alldredge
SCALE			EXCEPT AS NOTED		
GENERAL UNIT 1					
SYSTEM SCHEMATIC					
DG CONT SYS - RT					
BELLEFONTE NUCLEAR PLANT					
TENNESSEE VALLEY AUTHORITY					
DIVISION OF ENGINEERING DESIGN					
SUBMITTED	RECOMMENDED	APPROVED			
W.L. Alldredge	J.P. Morgan	R.M. Helgeson			
NO.	DATE	BY	NO.	DATE	BY
1	10-2-79	W.L. Alldredge			
KNOXVILLE 10-2-79 88 E SGM1740-RT-03 R1					
RECORD DRAWING AS CONSTRUCTED					

Docket # 30-438
Control # 8202090064
Date 3/20/22 of Document:
REGULATORY LOCKET FILE

PRINT	IN
SIZE	8 1/2 X 11
PRINTS RECD-#	