


NOTES:
1. FOR GENERAL NOTES AND REFERENCE DRAWINGS SEE 5GM1740-EG-01.
2. FOR MONITORING SYSTEMS DEVELOPMENT SEE 5GM1740-EG-03

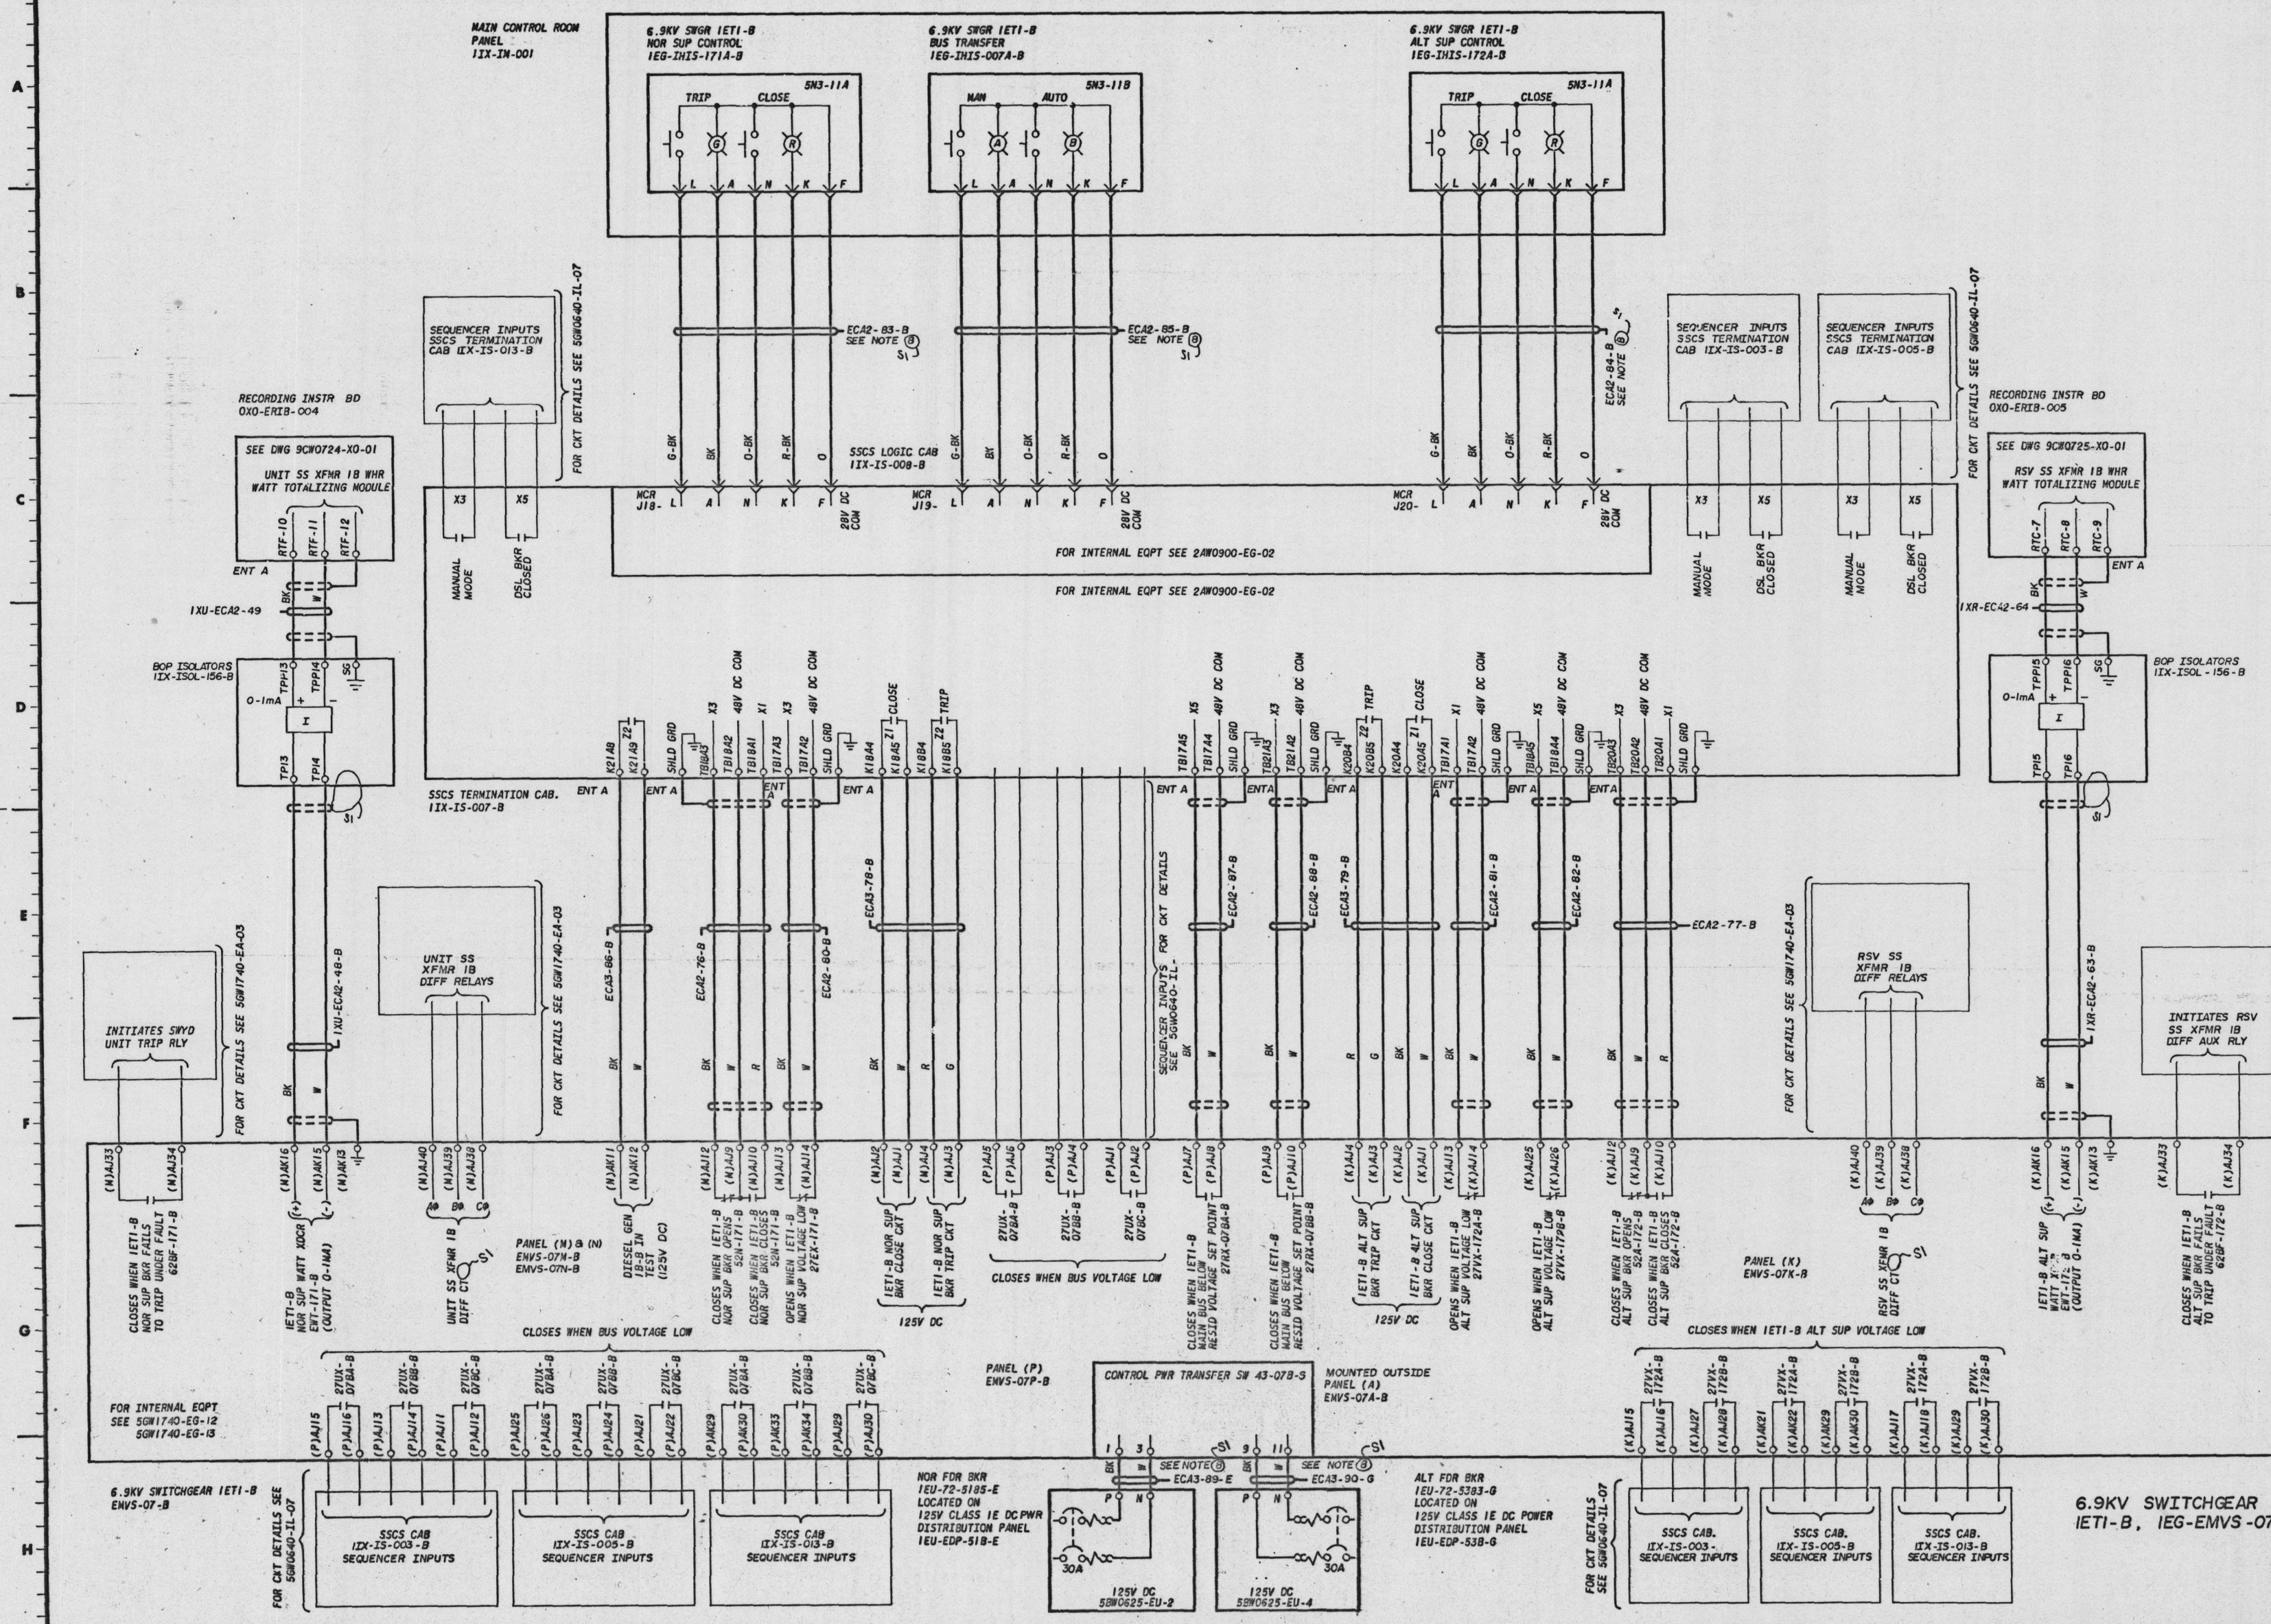

APERTURE CARD

Docket # 30439
Control # 8202030064
Date 8/20/02 of Document
REGULATORY DOCKET FILE

2	SI	1-31	7	Test (gnd) to Comp. - (MALS) (MWS)	17/4	1/10/02
ADDED BOP ISOLATOR TERMINAL POINTS & SIGNAL PATHS, REMOVED COL & FL. MINOR CHANGES.						
1	SI	17-19-77	1	APPROVALS	17/4	1/10/02
MINOR REVISIONS PER SI						
REV	ECN NO.	DATE	DESIGN	CHKD	ENGR	INSP
1	1	17-19-77	J.W. JACKSON	J.P. WOOLLEY		
DESIGN			J.W. JACKSON		INSPECTOR	
CHKD			J.P. WOOLLEY		ENGINEER	
SUPV			J.P. WOOLLEY		SUPERVISOR	
SCALE EXCEPT AS NOTED						
GENERAL UNIT 1						
SYSTEM SCHEMATIC						
6.9KV CLASS IE AC AUX POWER DISTRIBUTION SYSTEM						
BELLEFONTE NUCLEAR PLANT						
TENNESSEE VALLEY AUTHORITY						
DIVISION OF ENGINEERING DESIGN						
SUBMITTED			RECOMMENDED		APPROVED	
W.L.	
KNOXVILLE 11-29-77 88 E 5GM1740-EG-06 R2						
RECORD DRAWING AS CONSTRUCTED						

6.9KV SWITCHGEAR 1ET1-B, 1EG-EMVS-07-B