
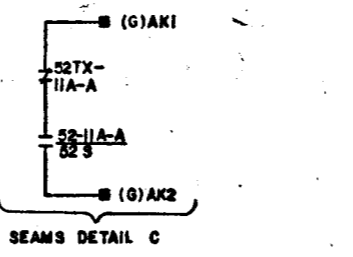
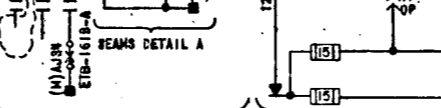
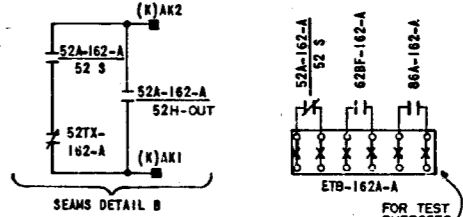
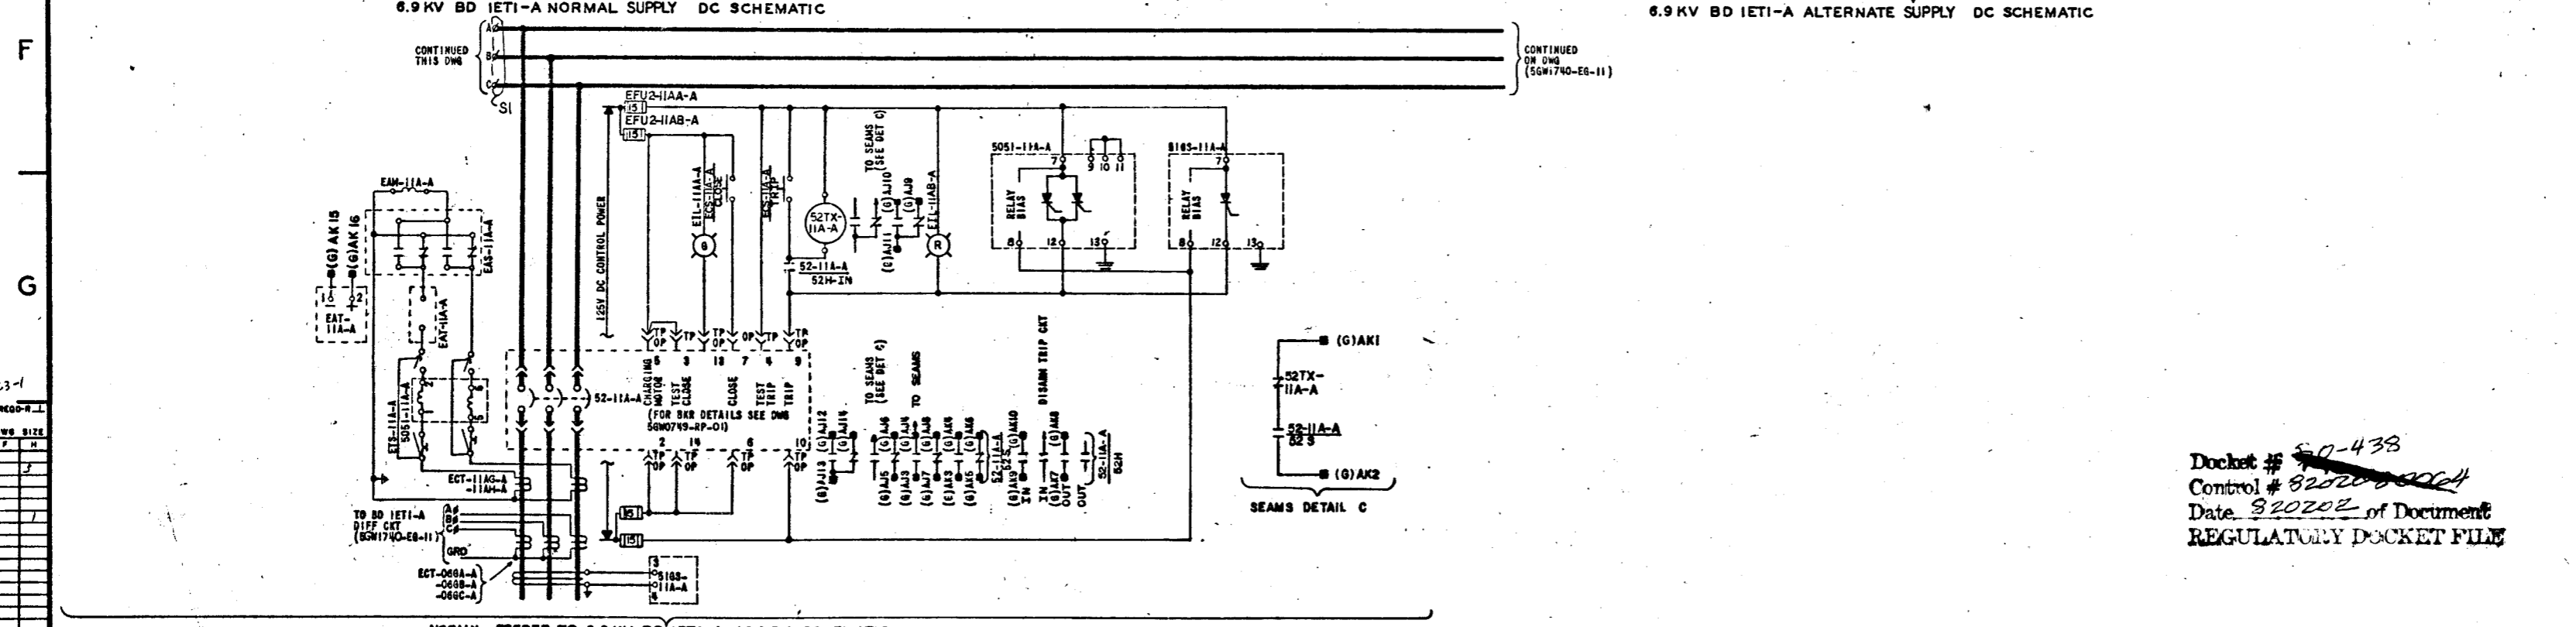


NOTES:
 1. FOR GENERAL NOTES AND REFERENCE DRAWINGS SEE 56W1740-EG-01.
 2. FOR EXTERNAL CABLING DIAGRAM SEE SYSTEM SCHEMATIC 56W1740-EG-02.
 3. A TRIP SIGNAL TO THE DSL GEN IS GENERATED ONLY WHEN THE DSL GEN BRK IS OPEN.

SYMBOLS:
 FOR GENERAL SYMBOLS SEE 56W1740-EG-01.
 ■ - SWGR INTERFACE

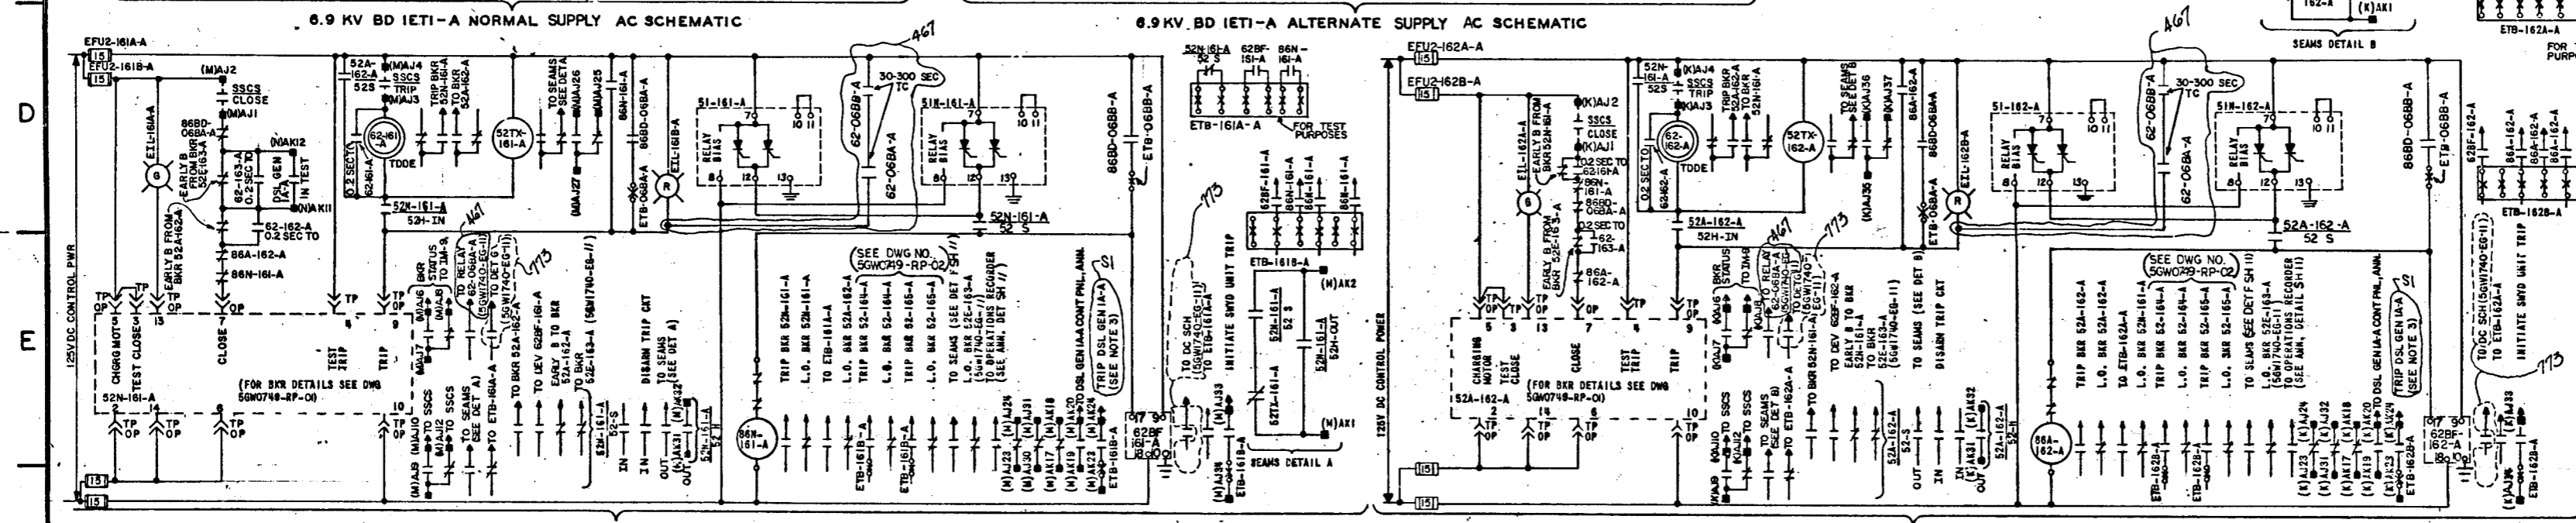

APERTURE CARD

R4, ECN 773

4	773	12-11-79	CHANGED 62BF CONTACT NOTATION, & ADDED S2S CONTACT NOTATION.
3	367, SI	5-18-79	INCORPORATED THE NEW & MODIFIED DESIGN REQUIREMENTS FOR BUS TRANSFERS & VOLTAGE ANN POIN 3, AND MINOR CHANGES.
2	SI	1-24-79	MINOR CHANGES.
1	SI, 341	7-19-78	IMPLEMENTED ANTICIPATORY RELAY SCHEME PER ECN 341, MINOR REVISIONS PER SI.
REV	ECN NO.	DATE	DESCRIPTION
DESIGN	D.M. LASHLEY, S.A. MCINTOSH		
APP'D	L.D. GRESLER		
SUPP	A.A. RUSSELL		

GENERAL
 UNIT 1
 SYSTEM SCHEMATIC
 6.9KV CLASS IE AC AUX POWER
 DISTRIBUTION SYSTEM

BELLEFONTE NUCLEAR PLANT
 TENNESSEE VALLEY AUTHORITY
 DIVISION OF ENGINEERING DESIGN

SUBMITTED: [Signature]
 RECOMMENDED: [Signature]
 APPROVED: [Signature]

KNOXVILLE 11-27-77 68 E 56W1740-EG-10 R4
 RECORD DRAWING AS CONSTRUCTED

Docket # 50-438
 Control # 82000-0004
 Date 3/20/02 of Document
 REGULATORY DOCKET FILE

PRINTS REQUIRED

NO.	DESCRIPTION	DATE
1	AS SHOWN	
2	AS SHOWN	
3	AS SHOWN	
