
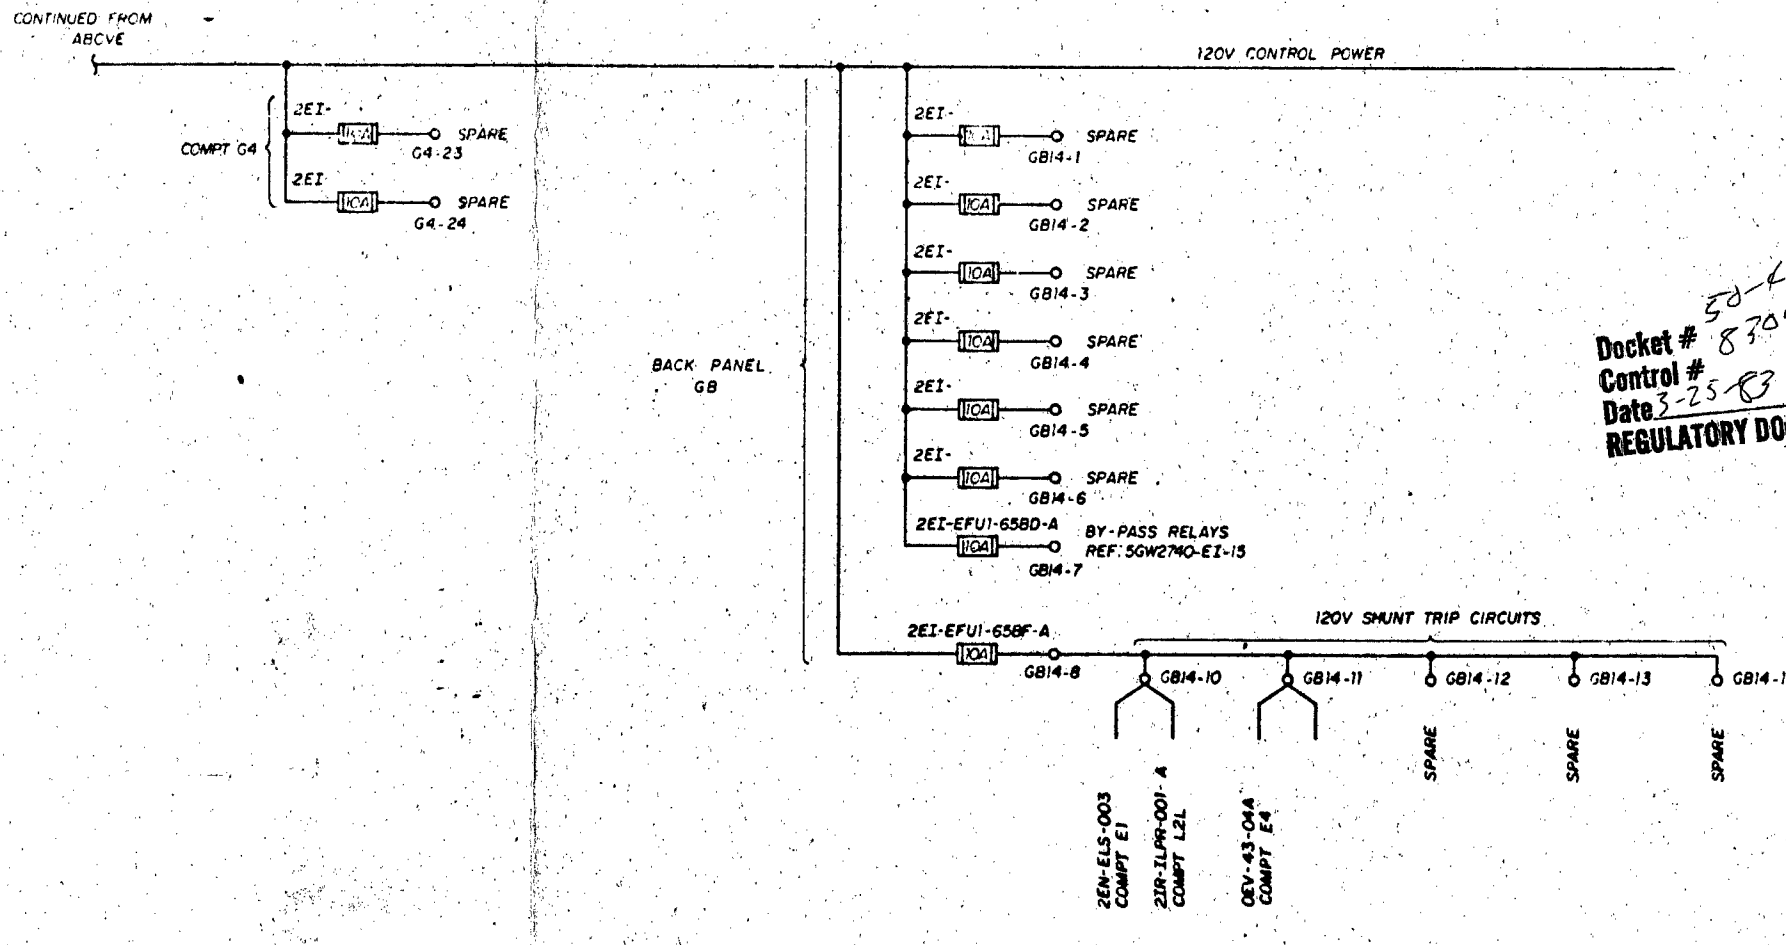
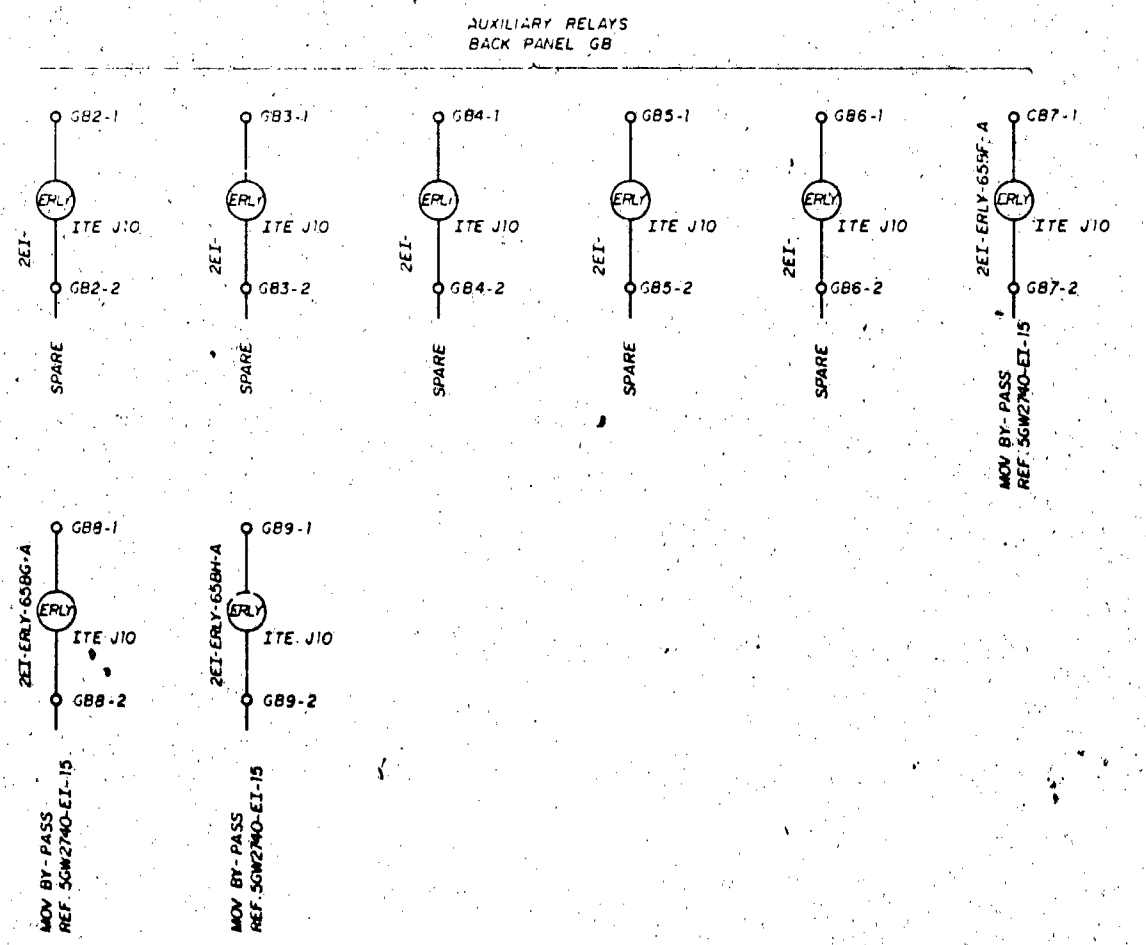


NOTES:
1. FOR GENERAL NOTES, REFERENCE DWGS AND SYMBOLS SEE DWG. 5AW2736-EI-1.

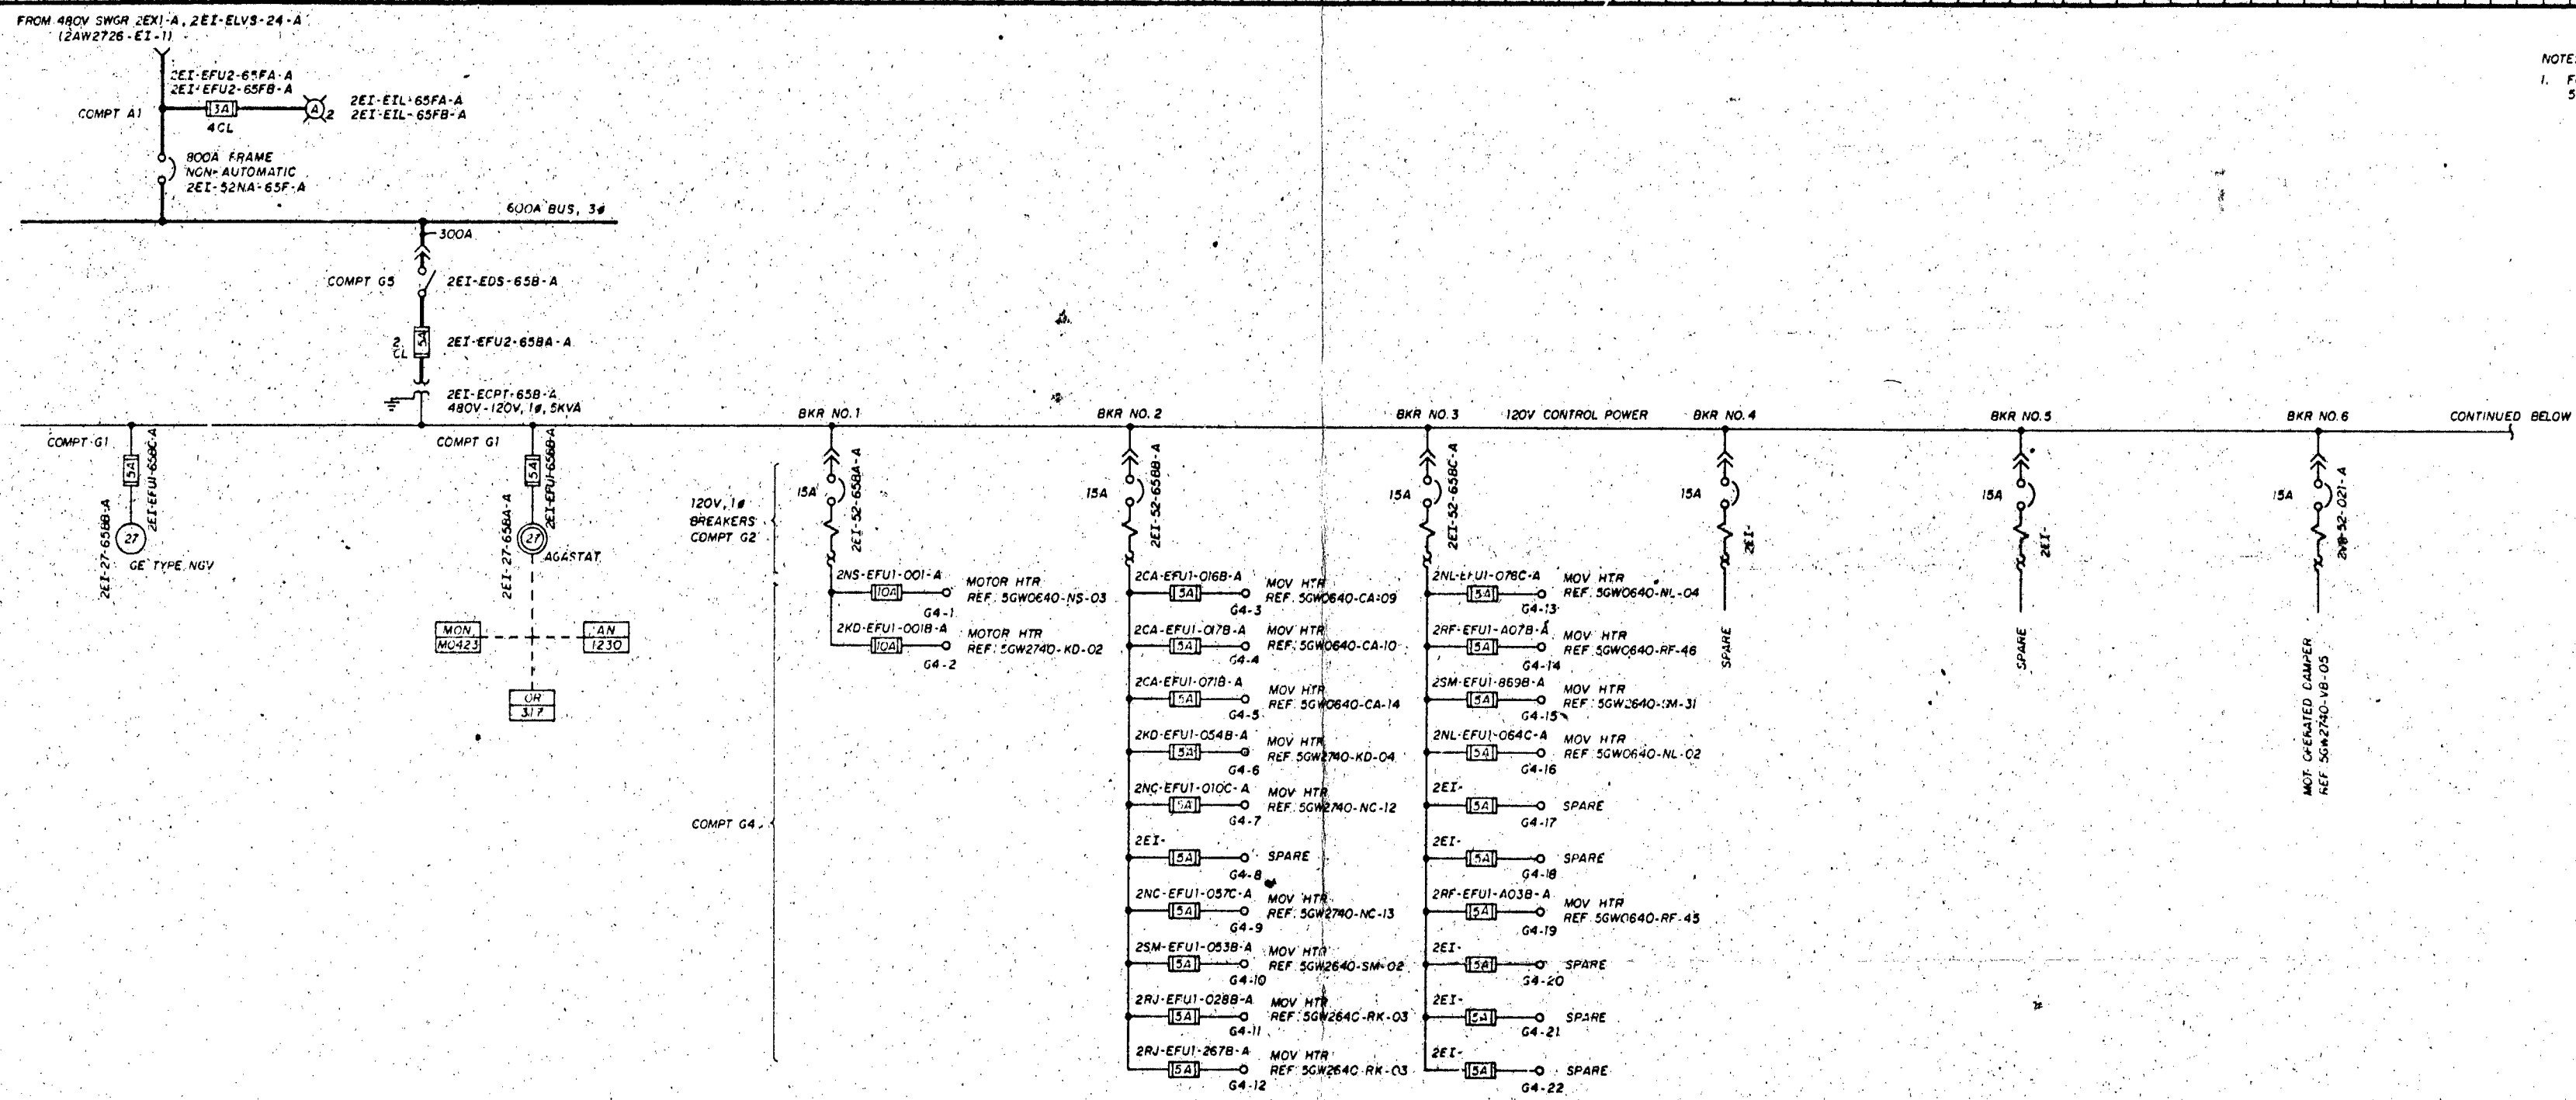

Docket # 50-478
Control # 8704050576
Date 3-25-83 of Document
REGULATORY DOCKET FILE

PRC
APERTURE
CARD

REV. NO.	ECW. NO.	DATE	ISSUED BY	CHKD BY	SUPV. ENGR.	INSP.	APPROVED
001							
SCALE: NTS EXCEPT AS NOTED							
AUXILIARY BUILDING UNIT 2							
SINGLE LINE 480V MCC 2E5-A 2EI-EMCC-65-A							
Bellefonte Nuclear Plant TENNESSEE VALLEY AUTHORITY DIVISION OF ENGINEERING DESIGN							
SUBMITTED		RECOMMENDED		APPROVED		Q	
INSPECTED AND APPROVED FOR ISSUE							
KNOXVILLE 9-3-82		BB E		5AW2736-EI-03 RD		RECORD DRAWING AS CONSTRUCTED	