


NOTES:
1. FOR GENERAL NOTES SEE SHEET 01.

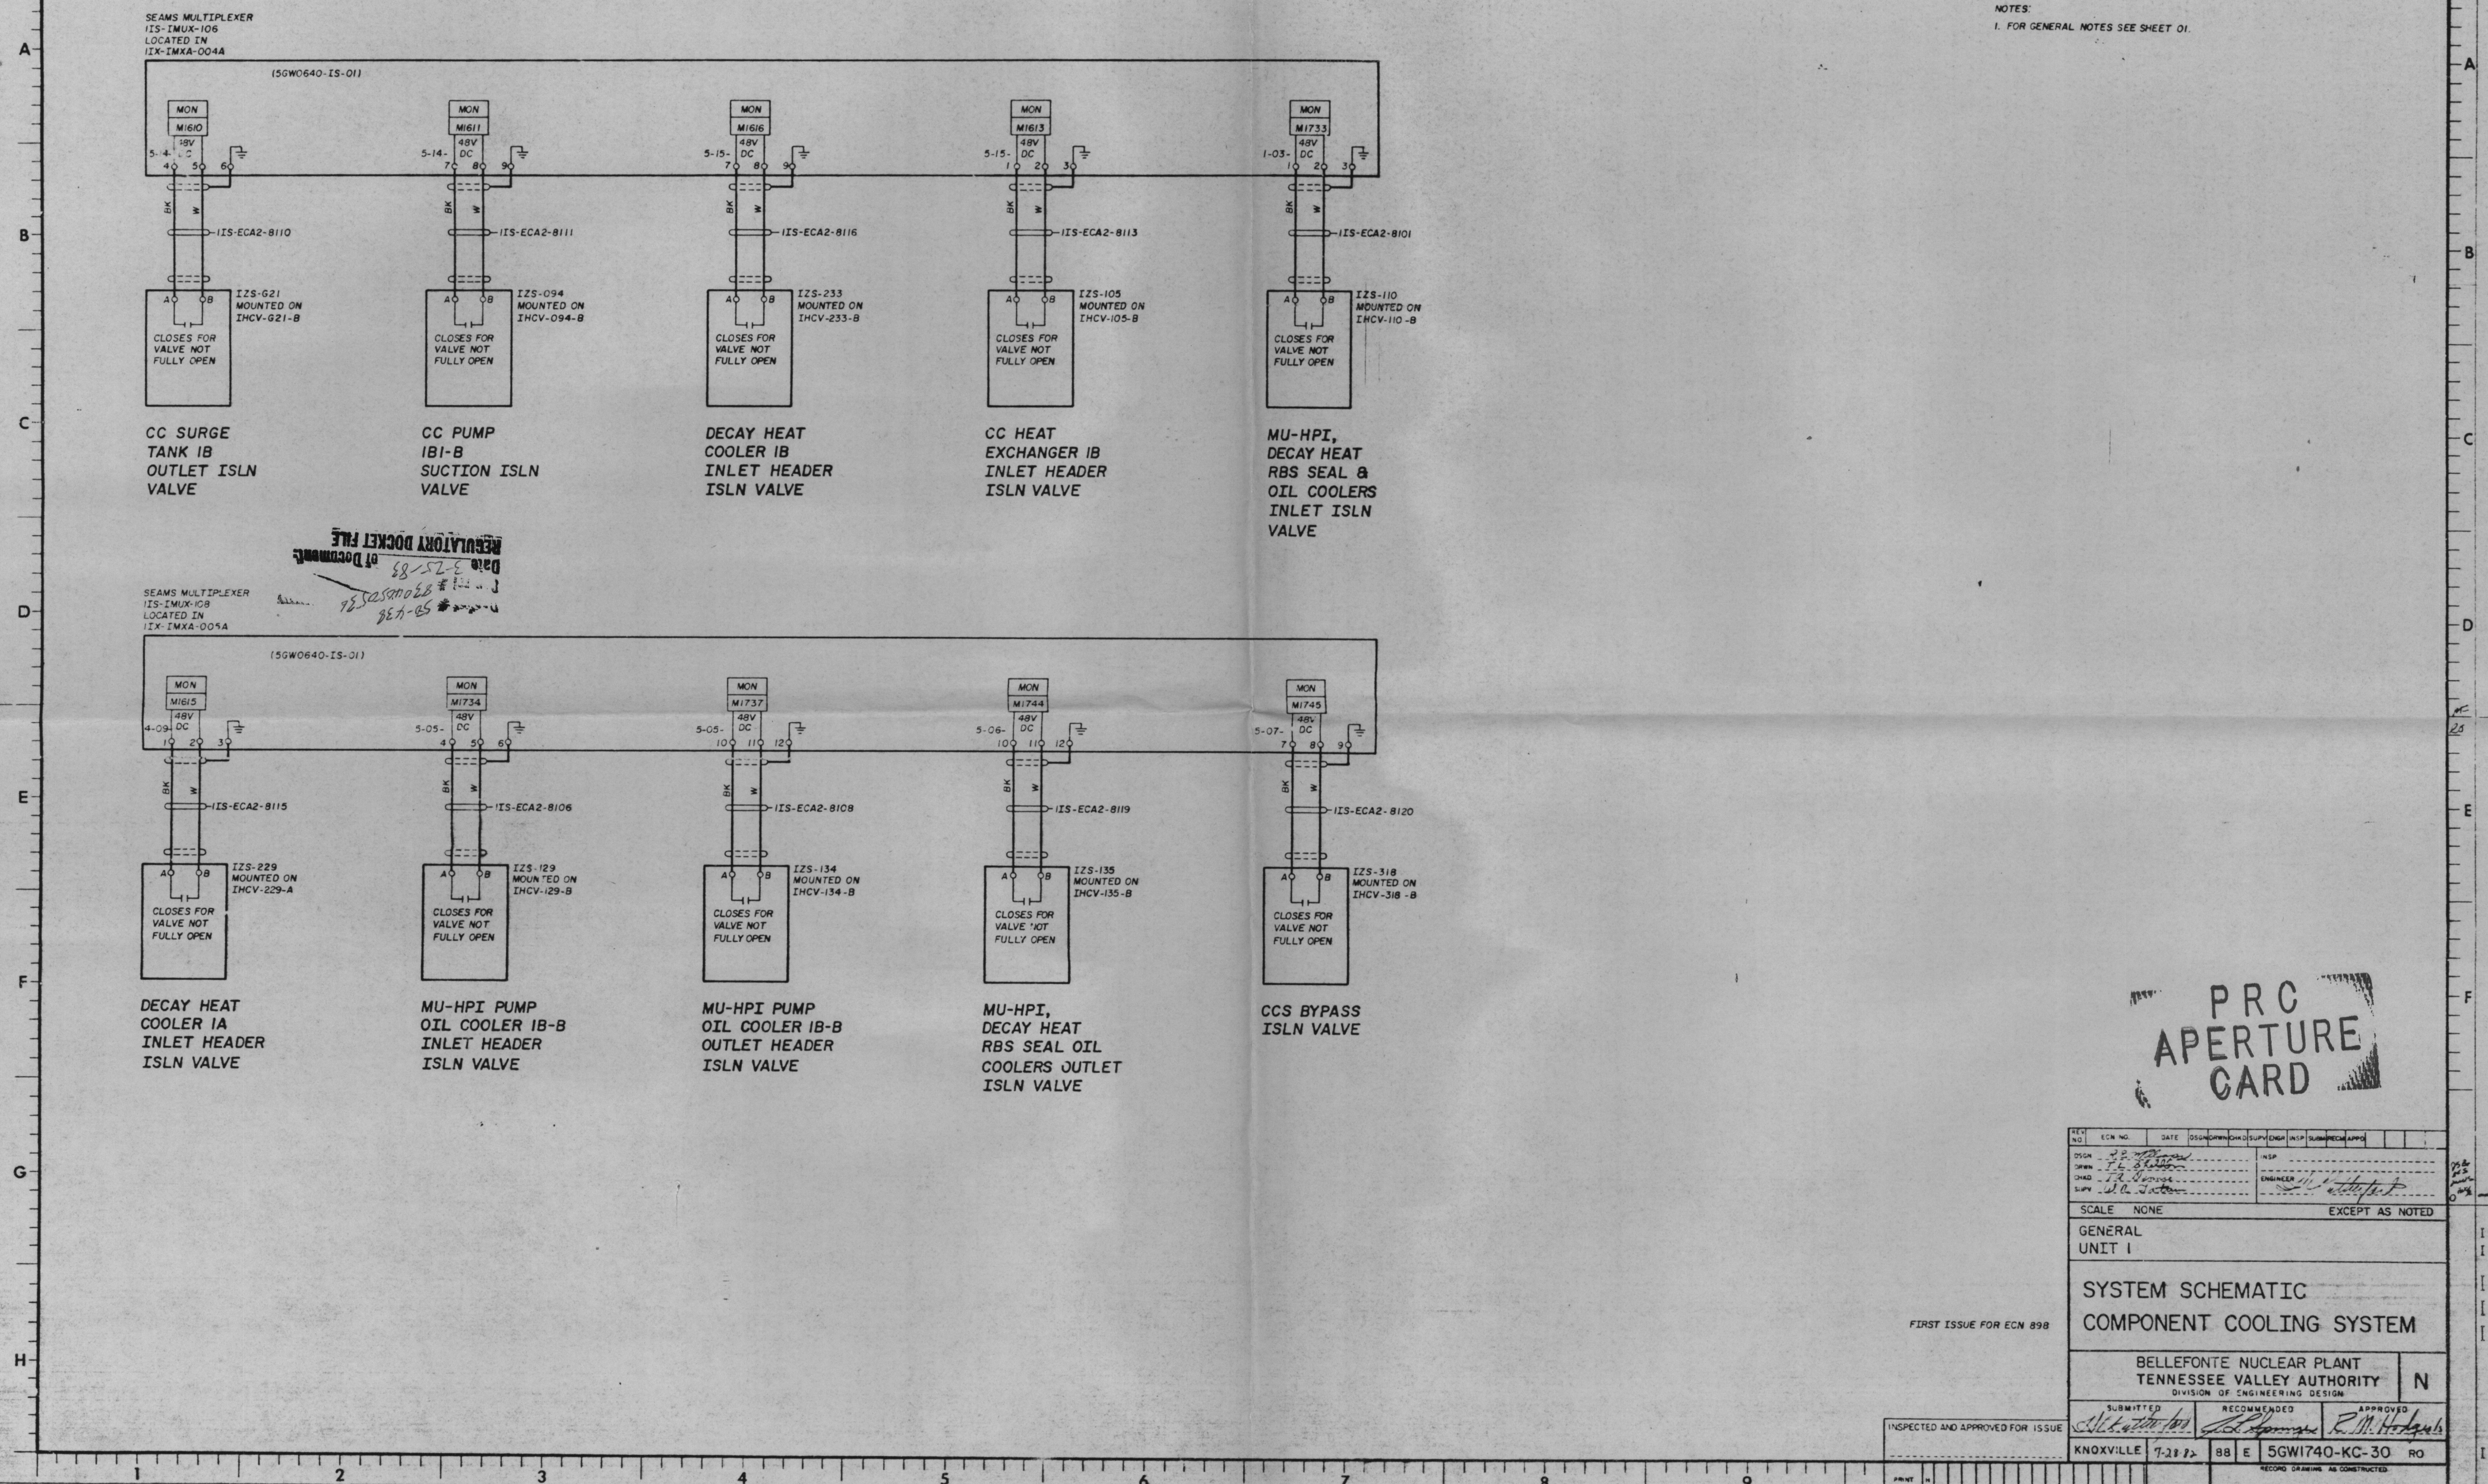

REGULATORY DOCKET FILE
Date 3-25-88
88-52-88
88-52-88
88-52-88

PRC
APERTURE
CARD

FIRST ISSUE FOR ECM 898

REV. NO.	ECN NO.	DATE	ISSUED BY	CHECKED BY	DESIGNED BY	DRAWN BY	APPROVED BY
SCALE: NONE			EXCEPT AS NOTED				
GENERAL UNIT I							
SYSTEM SCHEMATIC COMPONENT COOLING SYSTEM							
BELLEFONTE NUCLEAR PLANT TENNESSEE VALLEY AUTHORITY DIVISION OF ENGINEERING DESIGN							N
SUBMITTED		RECOMMENDED		APPROVED			
INSPECTED AND APPROVED FOR ISSUE							
KNOXVILLE			7-21-82		BB E		5GW1740-KC-30 RO
RECORD DRAWING AS CONSTRUCTED							

PRINT

SIZE

BA 04 PROJ ME EE CE AD CO E J MC SW RL PL
PRINTS 4800 - 8