



NOTES:
1 FOR GENERAL NOTES SEE SHEET 01.

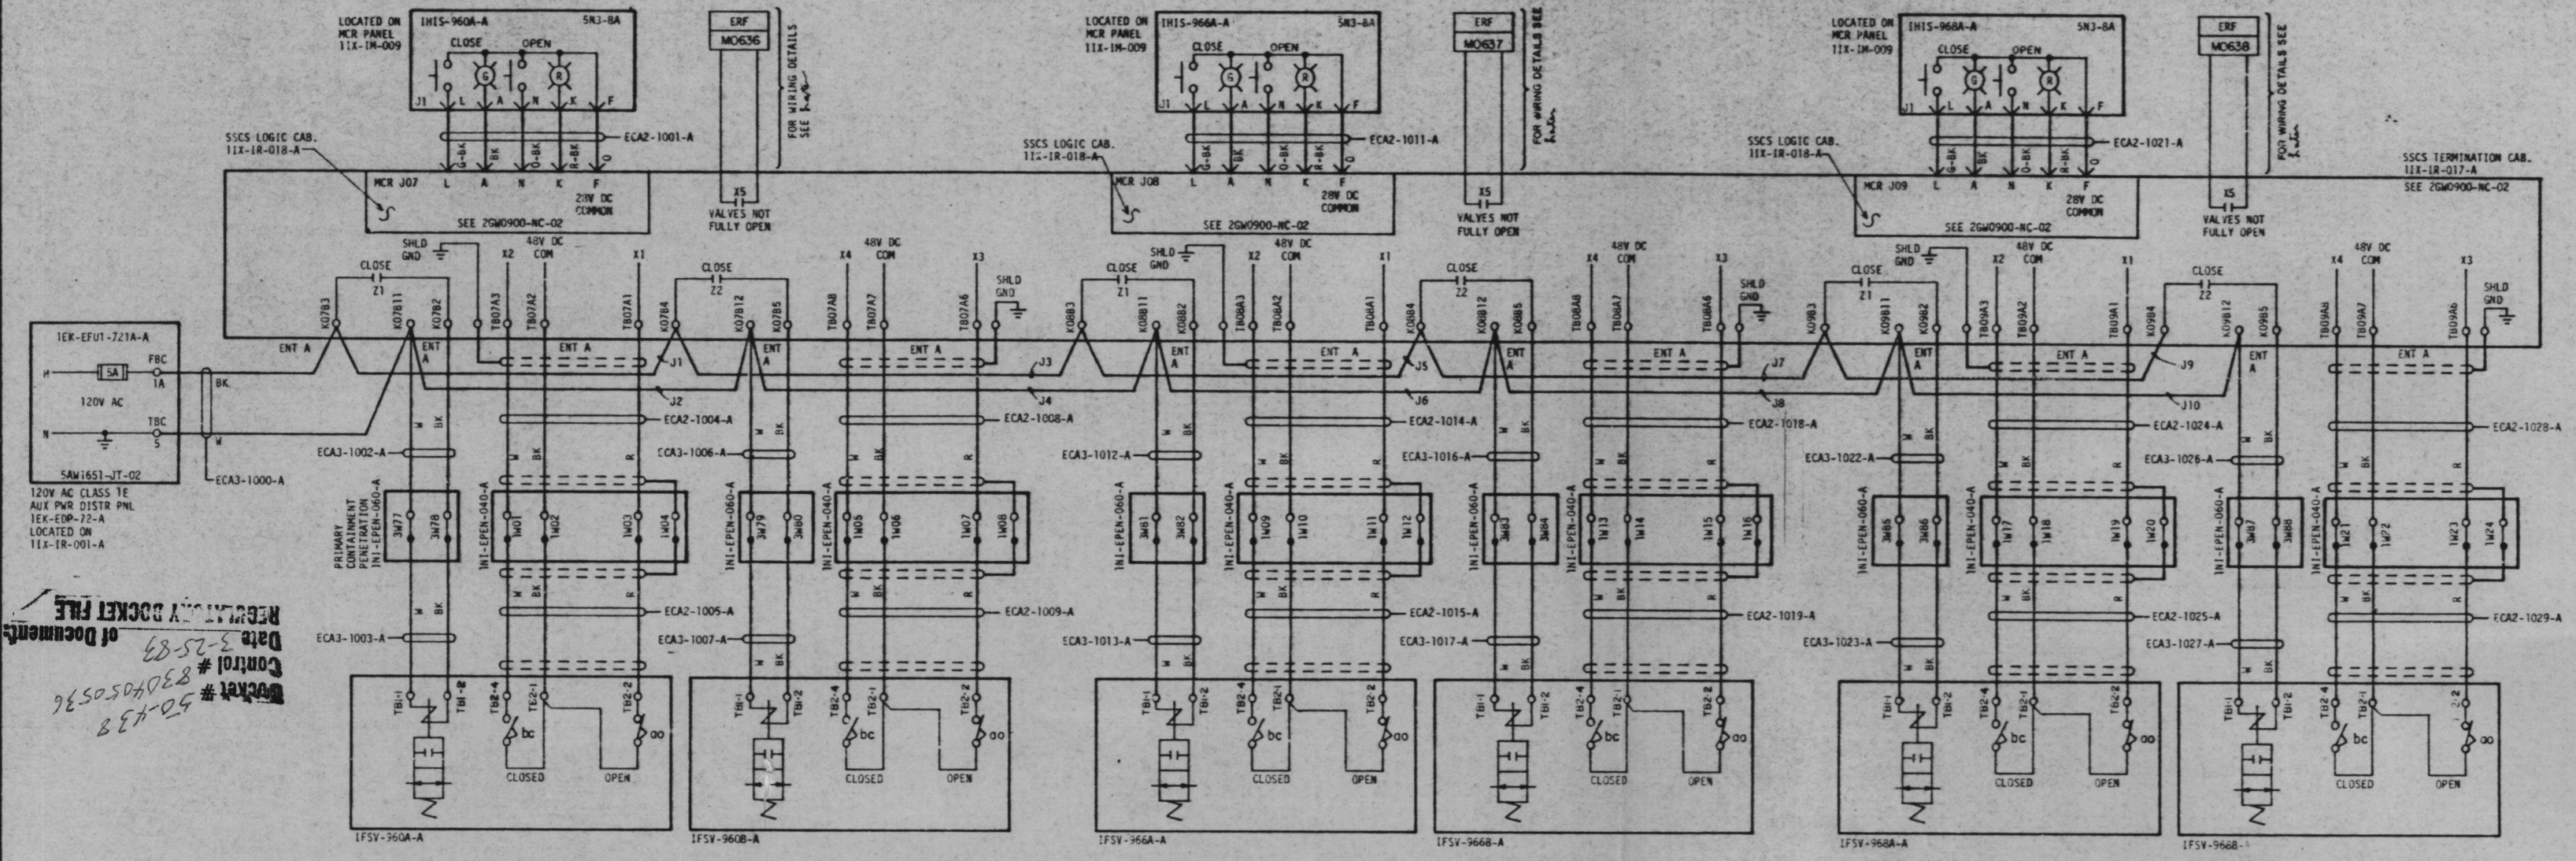

ILT-004A-D PRIMARY CONTAINMENT INSTRUMENTATION LINES ISOLATION VALVES

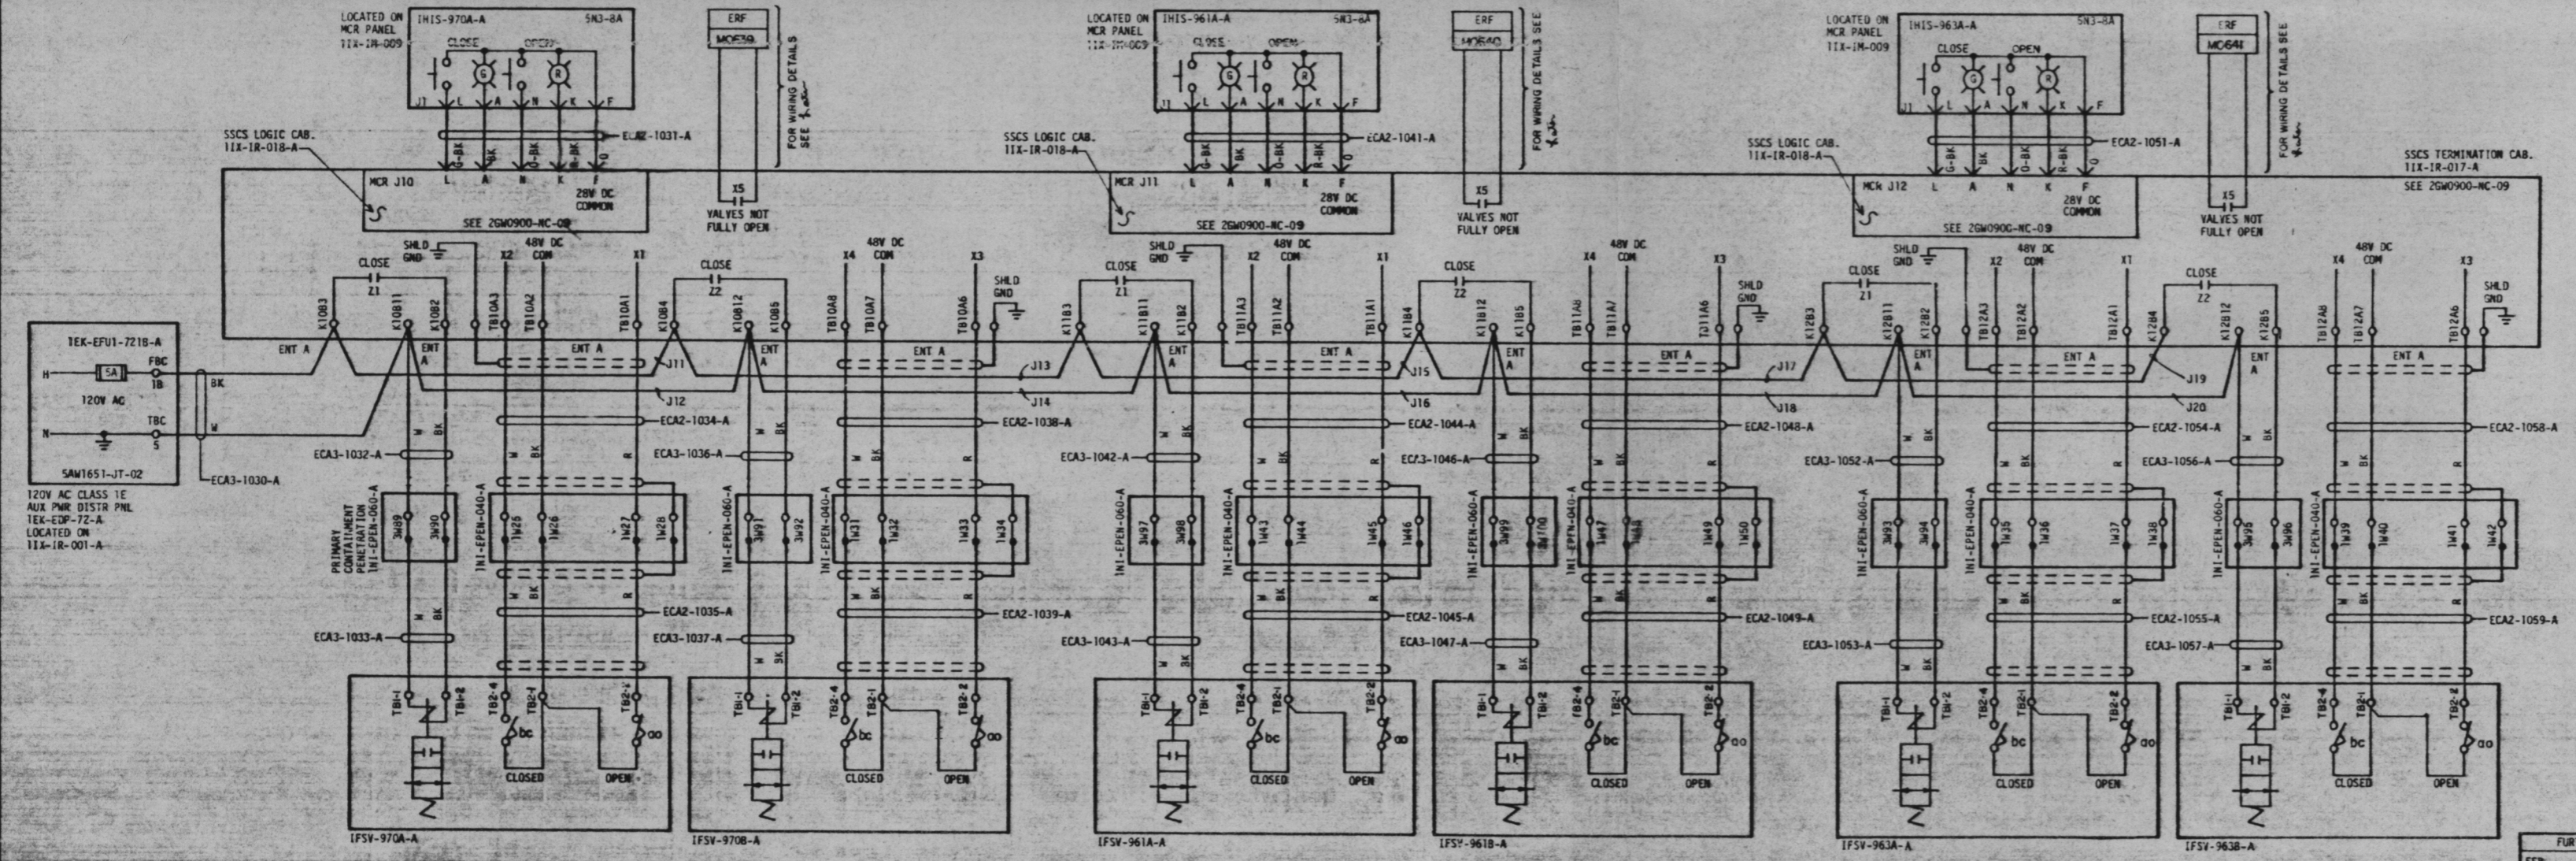

ILT-001A PRI CNTMT INSTR LINES ISOLATION VALVES

PRC APERTURE CARD

FIRST ISSUE FOR ECN 1027

REV. NO.	ECN NO.	DATE	DESIGNED	CHECKED	SUPV	ENGR	DRWG	APP'D
0001			<i>[Signature]</i>					
0002			<i>[Signature]</i>					
0003			<i>[Signature]</i>					

SCALE: NTS EXCEPT AS NOTED

GENERAL UNIT 1

SYSTEM SCHEMATIC REACTOR COOLANT SYS (NC)

BELLEFONTE NUCLEAR PLANT
TENNESSEE VALLEY AUTHORITY
DIVISION OF ENGINEERING DESIGN

SUBMITTED	RECOMMENDED	APPROVED
<i>[Signature]</i>	<i>[Signature]</i>	<i>[Signature]</i>

KNOXVILLE 9-23-82 88 E SGM1740-NC-32 RD

RECORD DRAWING AS CONSTRUCTED

120V AC CLASS 1E AUX PWR DISTR PNL
TEK-EDP-72-A
LOCATED ON 11X-IR-001-A

120V AC CLASS 1E AUX PWR DISTR PNL
TEK-EDP-72-A
LOCATED ON 11X-IR-001-A

120V AC CLASS 1E AUX PWR DISTR PNL
TEK-EDP-72-A
LOCATED ON 11X-IR-001-A

REVISION DOCKET FILE
of Documents
Date 3-25-89
Control # 50438
Docket # 3304050536