
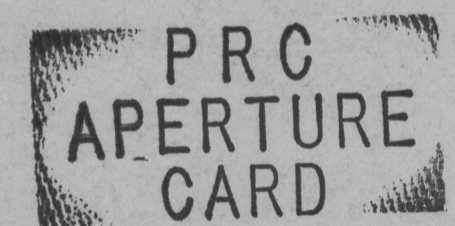


REGULATORY DOCKET FILE
Date of Document
Control # 88-52-3
Docket # 88-52-36

NOTES:
1. FOR GENERAL NOTES AND SYMBOLS SEE 56W1740-ND-01.
2. VALVE LIMIT SWITCHES SHOWN THIS SHEET WITH VALVES CLOSED.

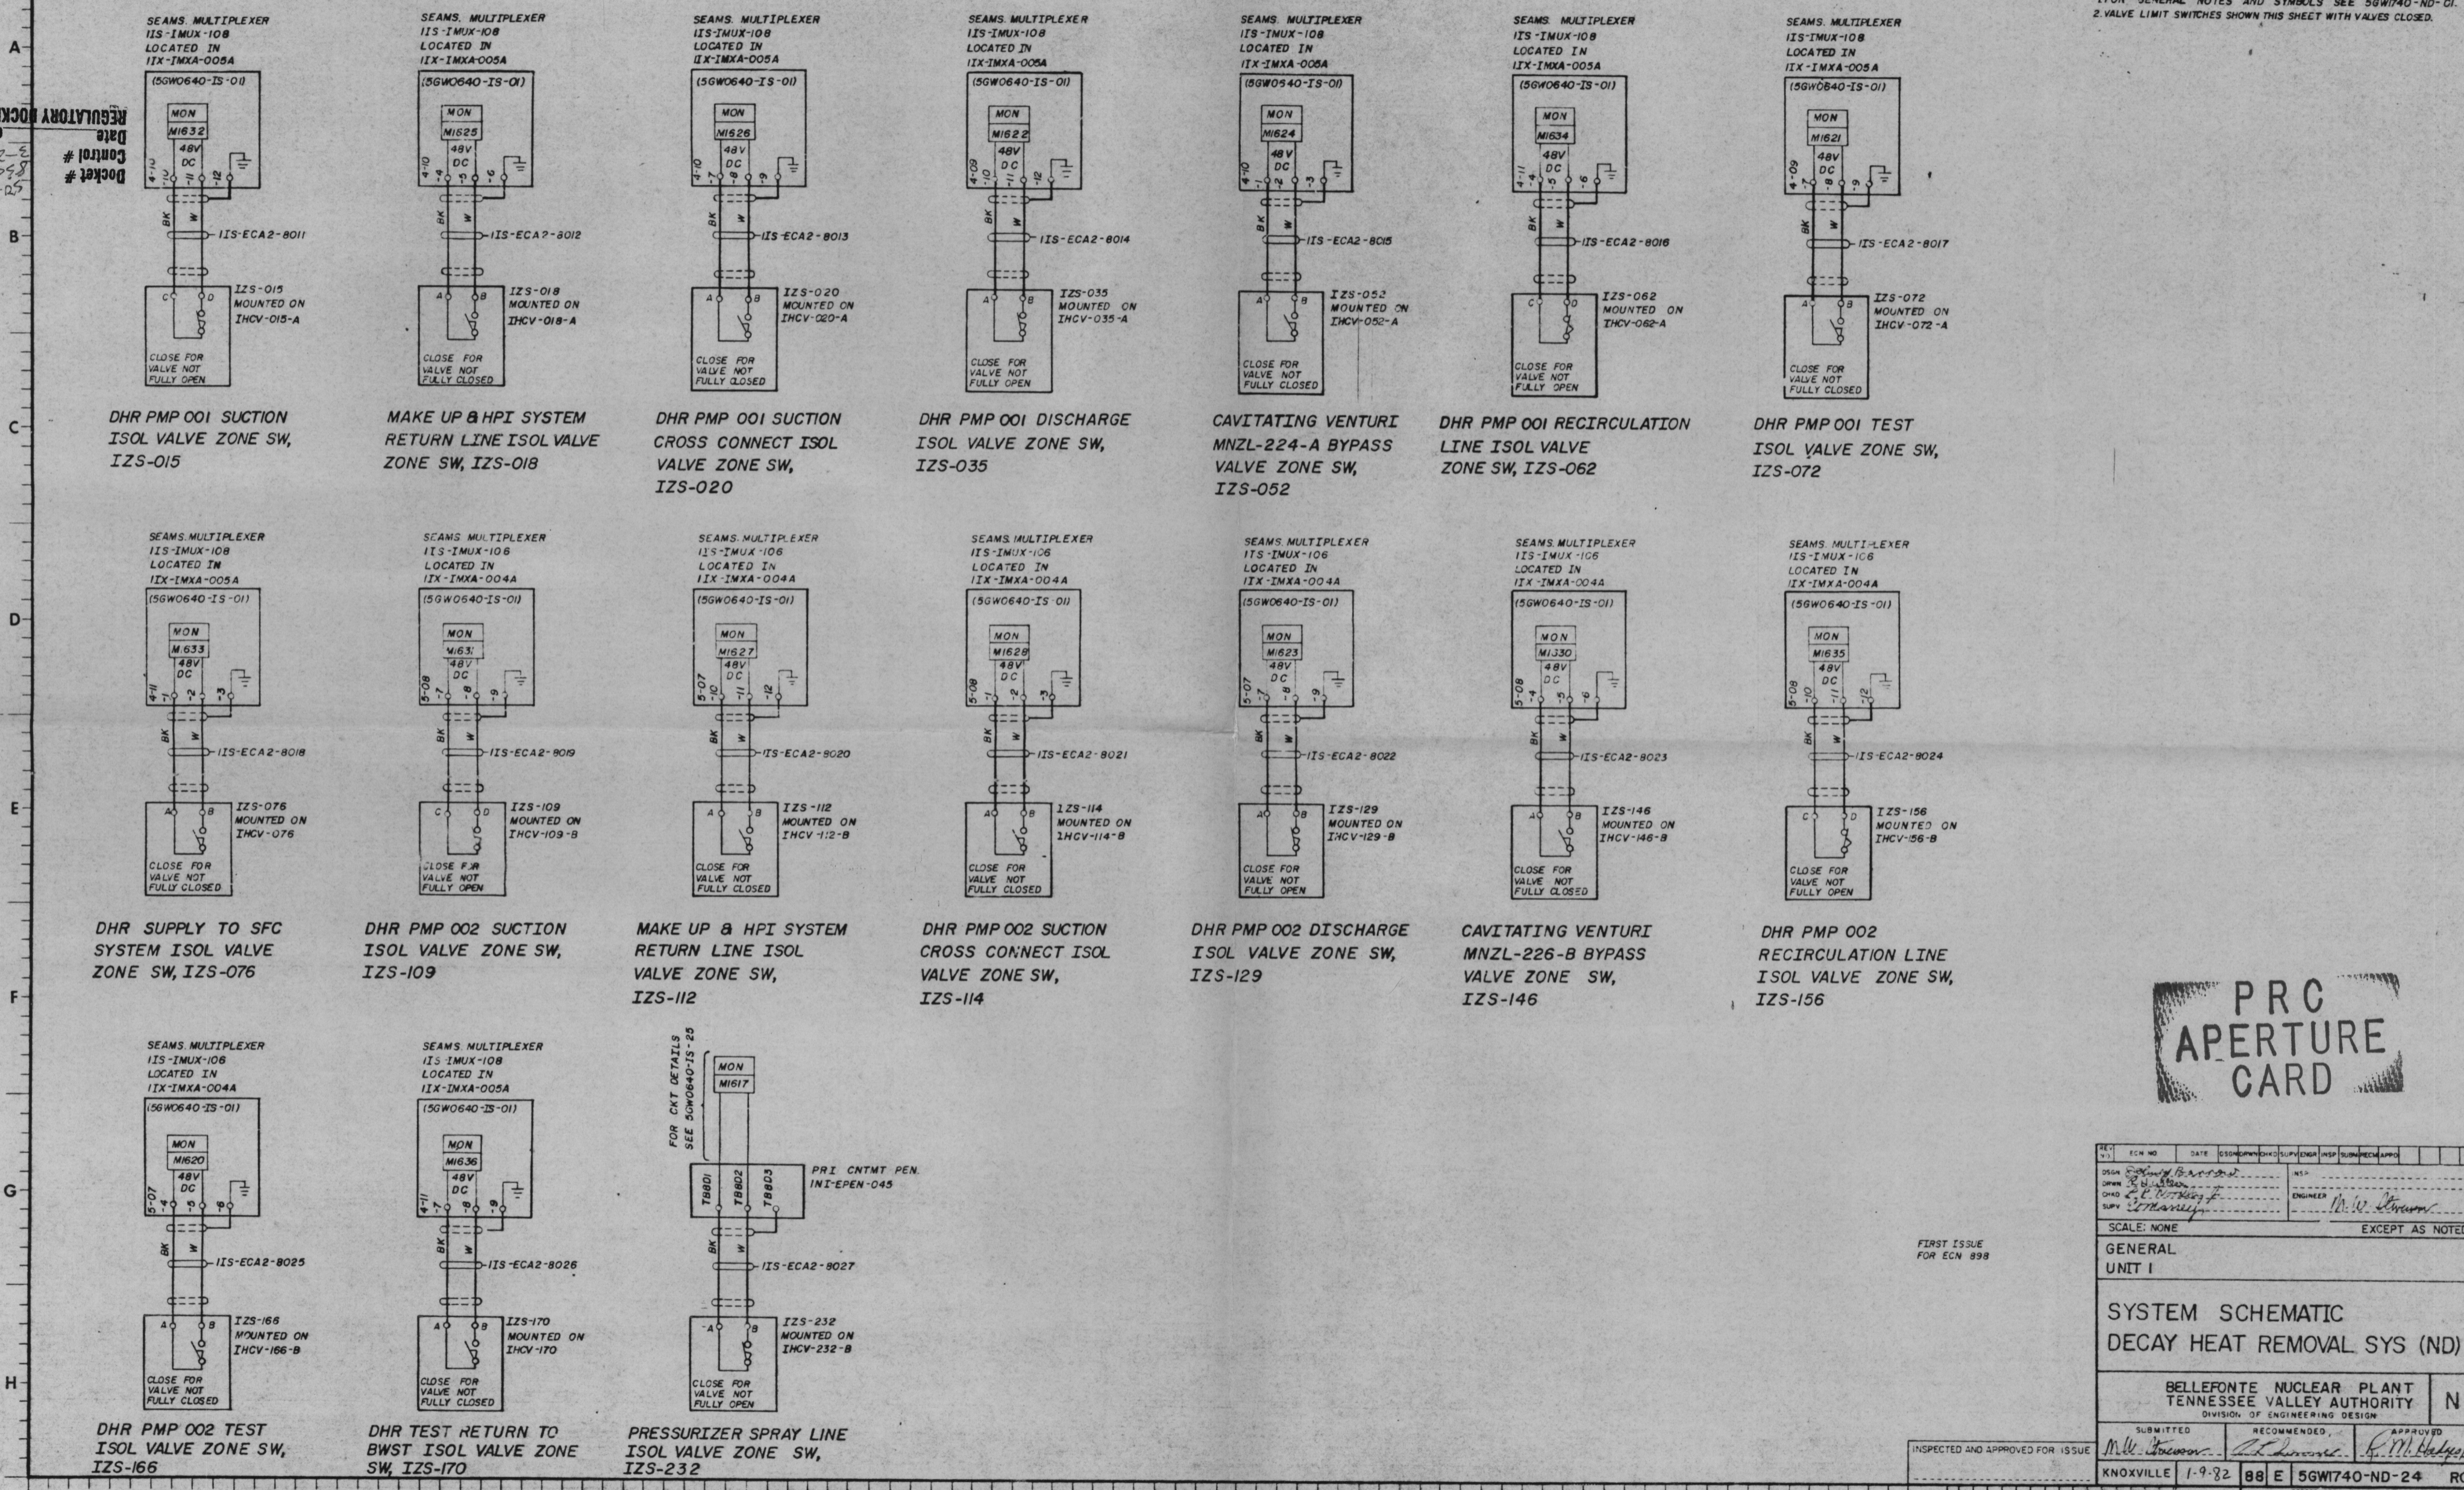

FIRST ISSUE FOR ECN 898

REV	ECN NO	DATE	DESIGNED	CHECKED	SUPV ENGR	INSP	SUBM REC'D	APPRO
DESIGN	E. J. Brown			NSP				
DRAWN	E. J. Brown			ENGINEER				
CHECKED	E. J. Brown			M. W. Brown				
SUPV	E. J. Brown			M. W. Brown				
SCALE: NONE								EXCEPT AS NOTED
GENERAL UNIT I								
SYSTEM SCHEMATIC DECAY HEAT REMOVAL SYS (ND)								
BELLEFONTE NUCLEAR PLANT TENNESSEE VALLEY AUTHORITY DIVISION OF ENGINEERING DESIGN								N
SUBMITTED			RECOMMENDED			APPROVED		
INSPECTED AND APPROVED FOR ISSUE								
KNOXVILLE 1-9-82 88 E 56W1740-ND-24 RO								
RECORD DRAWING AS CONSTRUCTED								

PRINT H
SIZE F

BA-4 PROJ INE EC AD :O ED MO TM BK PA
PRINTS 4800-4