


SFAMS MULTIPLEXER
115-1MX-108(215-1MX-208)
LOCATED IN
11X-1MXA-005A


SEAMS MULTIPLEXER
115-1MX-106(215-1MX-206)
LOCATED IN
11X-1MXA-004A

NOTES:
1. FOR GENERAL NOTES AND REFERENCES SEE 5GW0640-NS-01.
2. ALL LIMIT SWITCHES ARE SHOWN FOR VALVE IN FULLY OPEN POSITION. ALARM NOT-FULLY-OPEN.

-OLD DUE TO ECN 1277
ERC 1212/132

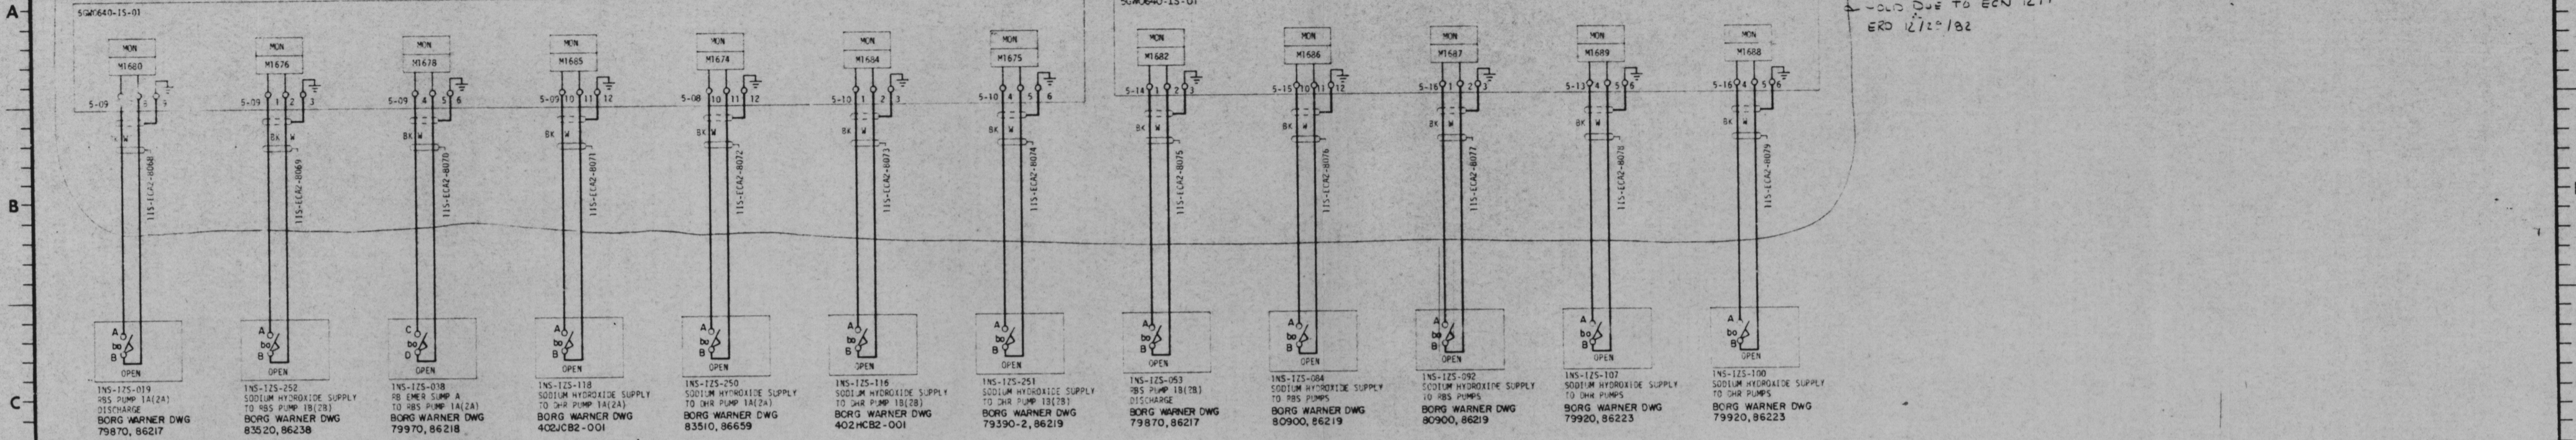

SEAMS MULTIPLEXER
115-1MX-106(215-1MX-206)
LOCATED IN
11X-1MXA-004A

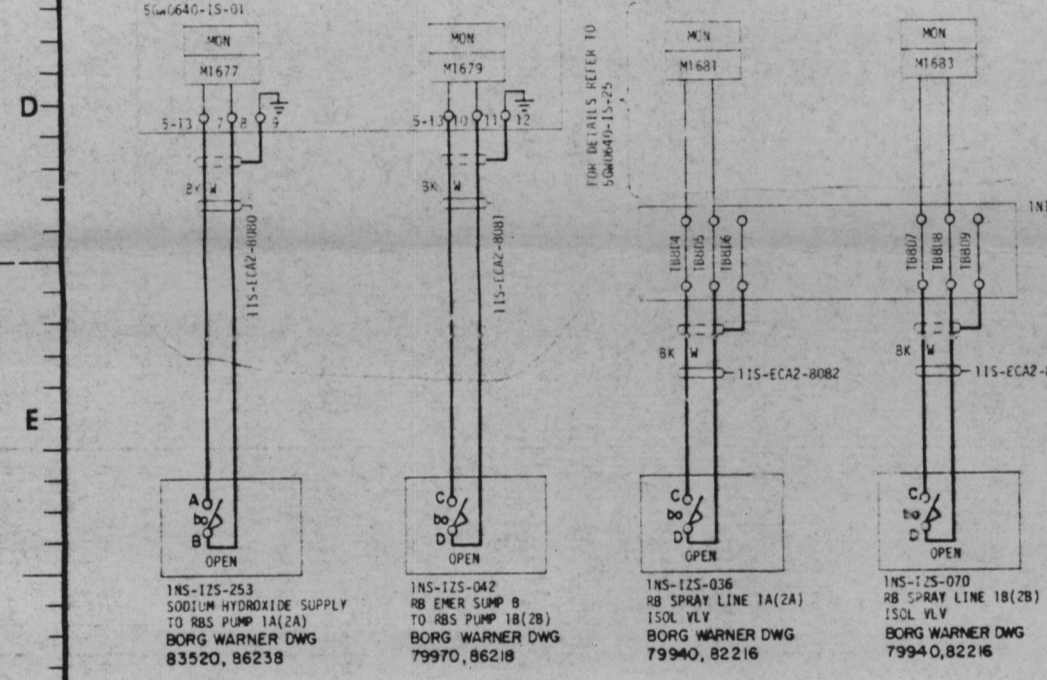

-OLD DUE TO ECN 1277
ERC 1212/132

REGULATORY DOCKET FILE
Data of Documents
Control # 8304402037
Docket # 83-228

PRC
APERTURE
CARD

ISSUED FOR ECN 898

REV. NO.	ECTN NO.	DATE	DESIGNED	CHECKED	SUPVISED	ENGR	INSP	SUBMITTER	APPROV
0001			W. J. Wilson						
DESIGN	W. J. Wilson								
DRAWN	D. A. Wilson								
CHECKED	D. A. Wilson								
SUPV	D. A. Wilson								
SCALE: NTS									
GENERAL UNITS 1 & 2									
SCHEMATIC DIAGRAM REACTOR BLDG SPRAY SYSTEM									
BELLEFONTE NUCLEAR PLANT TENNESSEE VALLEY AUTHORITY									
DIVISION OF ENGINEERING DESIGN									
SUBMITTED			RECOMMENDED			APPROVED			
M. W. Stewart			J. L. Stewart			R. M. Stewart			
INSPECTED AND APPROVED FOR ISSUE									
KNOXVILLE 1-20-92 88 E 5GW0640-NS-13 RD									
RECORD DRAWING AS CONSTRUCTED									