
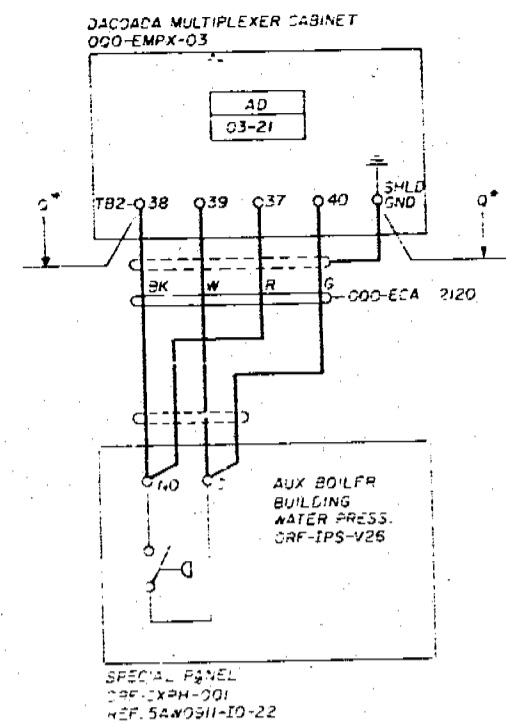
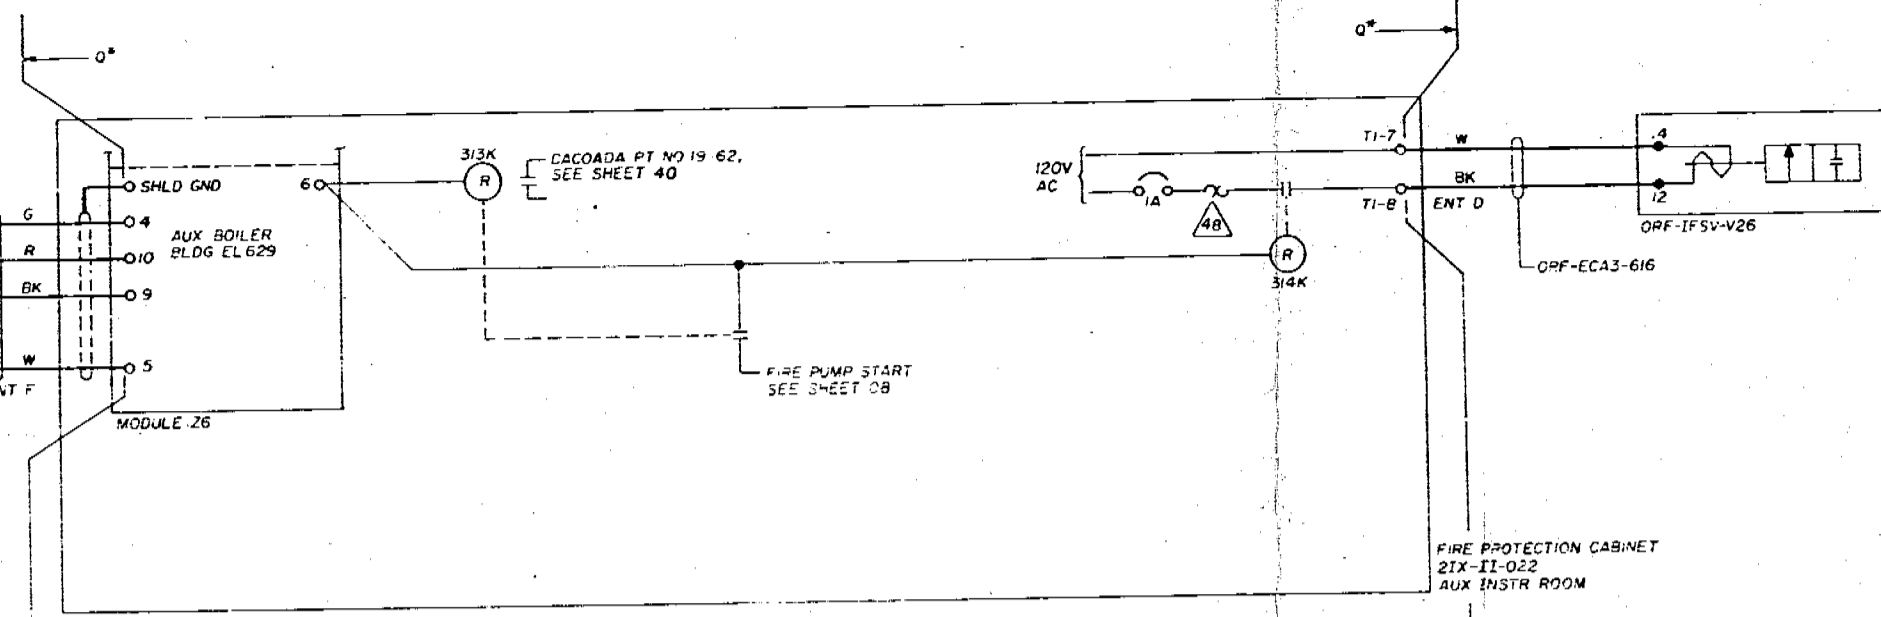


REF 5GW0640-RF-27

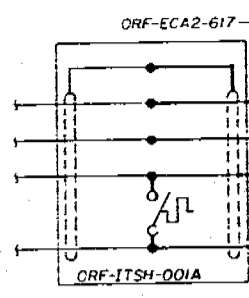

NOTES
1. FOR GENERAL NOTES AND REFERENCE DRAWING SEE 5GW0640-RF-01

PRC
APERTURE
CARD

Docket # 10438
Control # 20450536
Date 5-25-83
REGULATORY FILE

RO ISSUED FOR ECN 423

REV	ECN NO	DATE	ISSUED BY	SUPV ENGR	APP	DATE
1						
2						
3						
4						
5						
6						
7						
8						
9						
10						
11						
12						
SCALE: NTS EXCEPT AS NOTED						
POWERHOUSE UNITS 1 & 2						
SCHEMATIC DIAGRAM HP FIRE PROTECTION SYSTEM						
BELLEFONTE NUCLEAR PLANT TENNESSEE VALLEY AUTHORITY DIVISION OF ENGINEERING DESIGN						Q*
SUBMITTED		RECOMMENDED		APPROVED		
[Signature]		[Signature]		[Signature]		
INSPECTED AND APPROVED FOR ISSUE						
KNOXVILLE 7/1/82 88 E 5GW0640-RF-53 RO						
RECORD DRAWING AS CONSTRUCTED						

INSPECTED AND APPROVED FOR ISSUE

[Signatures]

KNOXVILLE 7/1/82 88 E 5GW0640-RF-53 RO

RECORD DRAWING AS CONSTRUCTED