


NOTES:
 1 FOR GENERAL NOTES AND SYMBOLS SEE 5GW1640-SM-01.
 2 LOSS OF HEATER CONTINUITY, LOW TEMPERATURE AND UNDER VOLTAGE IS MONITORED BY SEAMS AND IS SHOWN ON 5GW1740-MC-07.

TABLE A35
 HEAT TRACE
 (TO COMPLETE WIRING INFORMATION, SEE TYPICAL WIRING FIG. A35)

COL	1	2	3	4	5	6	7	8	9	10
VENDOR CKT NO.	79	101	9401	9601	1	10				
ENCL. EJECT.	80	102	9402	9602	2	11				
ECA3-										
TERM. NO.										
TERM. NO.										

REGULATORY DOCKET FILE
 Date 3-25-83
 Control # 830402536
 438

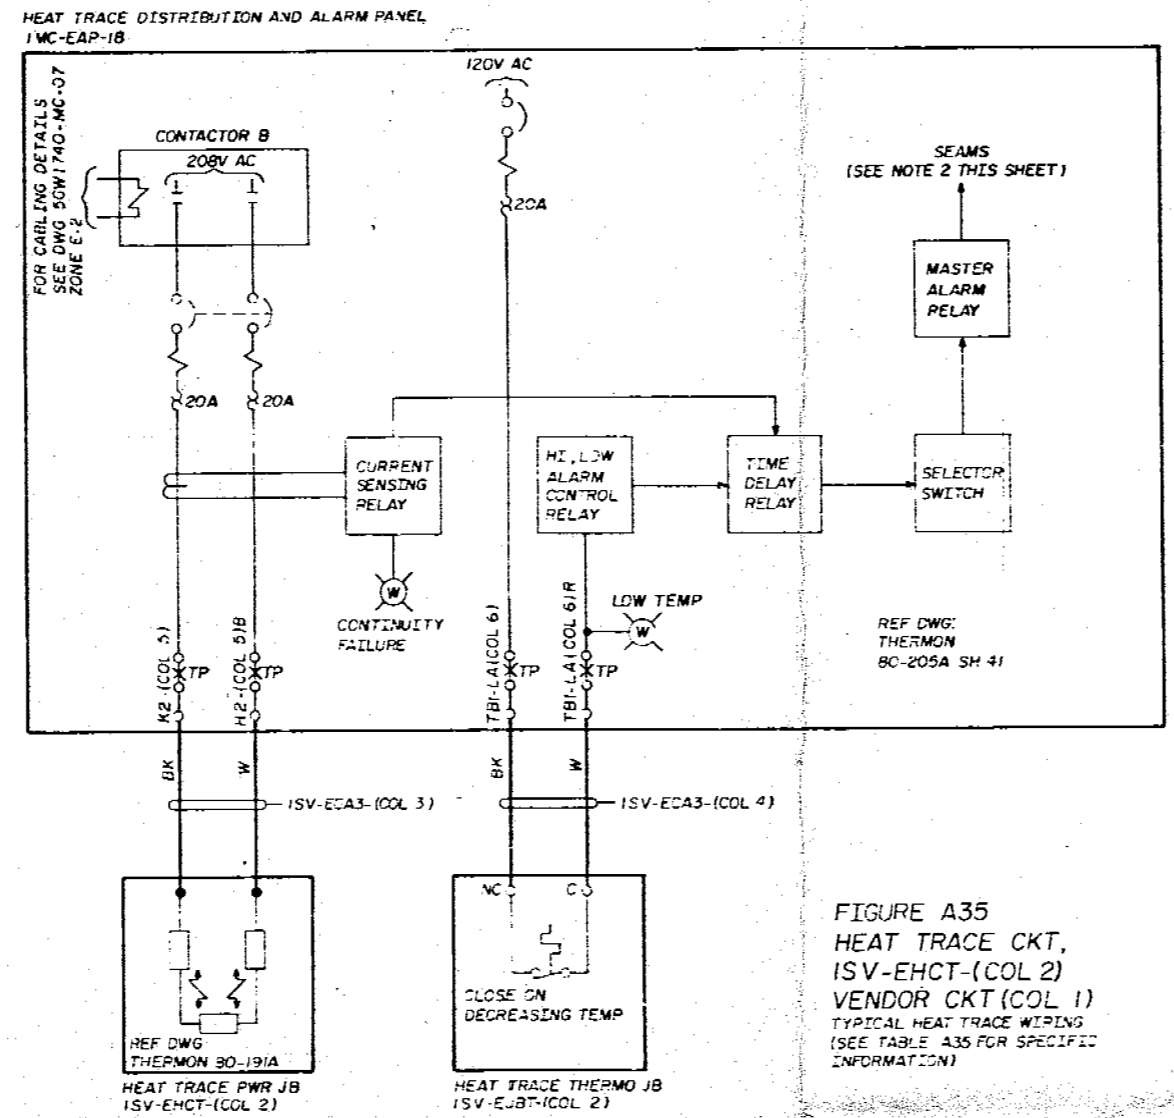

SYMBOLS:
 TP - TEST POINT (DISCONNECTING TERMINAL BLOCK)

PRC
APERTURE
CARD

REV. NO.	ECW NO.	DATE	ISSUED BY	DESIGNED BY	CHECKED BY	APP. BY	APP. DATE
DESIGN	R. D. Roberts		HELP				
DRAWN	T. J. B. B. B.		ENGINEER	N. C. Rutherford			
SUPV.	M. S. B. B.						
SCALE: NONE			EXCEPT AS NOTED				
GENERAL UNIT 1							
SCHEMATIC DIAGRAM MAIN & REHEAT STEAM SYSTEM							
BELLEFONTE NUCLEAR PLANT TENNESSEE VALLEY AUTHORITY							
DIVISION OF ENGINEERING DESIGN							
SUBMITTED		RECOMMENDED		APPROVED			
N. C. Rutherford		R. M. Roberts		R. M. Roberts			
KNOXVILLE		2-17-82		88 E		5GW1640-SM-35 RO	
RECORD DRAWING AS CONSTRUCTED							