


- NOTES:
- FOR GENERAL NOTES, REFERENCE DRAWINGS, AND SYMBOLS SEE SGW1640-SM-01.
 - THIS DRAWING REFERENCE IS FOR THE "AS BUILT" MANUFACTURER'S DRAWING BY YORK ELECTRO-PANEL CONTROL CO., INC. ON CONTRACT 7643-86243-1 (FILE NO. 44E-23-11).
 - AN ALARM SHALL BE GIVEN FOR HIGH LAY-BY STEAM PRESSURE.
 - REFER TO LIMITORNE CORPORATION DRAWINGS 03-602-0107-2 AND 15-477-587-3 ON CONTRACT 7643-86163-2 (FILE NO. 44M-17-2). ALSO, REFER TO DETAIL B37 ON SGW1640-SM-37. 15M-170V-587, 588, 589, 590 HAVE BEEN WIRED BY THE MANUFACTURER PER DRAWING 15-477-587-3 ON ABOVE REFERENCED CONTRACT. THESE CONNECTIONS ARE TO BE REWIRED BY CVA PER DETAIL B37 ON SGW1640-SM-37. REFERENCE SHOULD BE MADE TO DRAWING 15-477-7587-3 FOR LIMIT SWITCH CONTACT DEVELOPMENT.

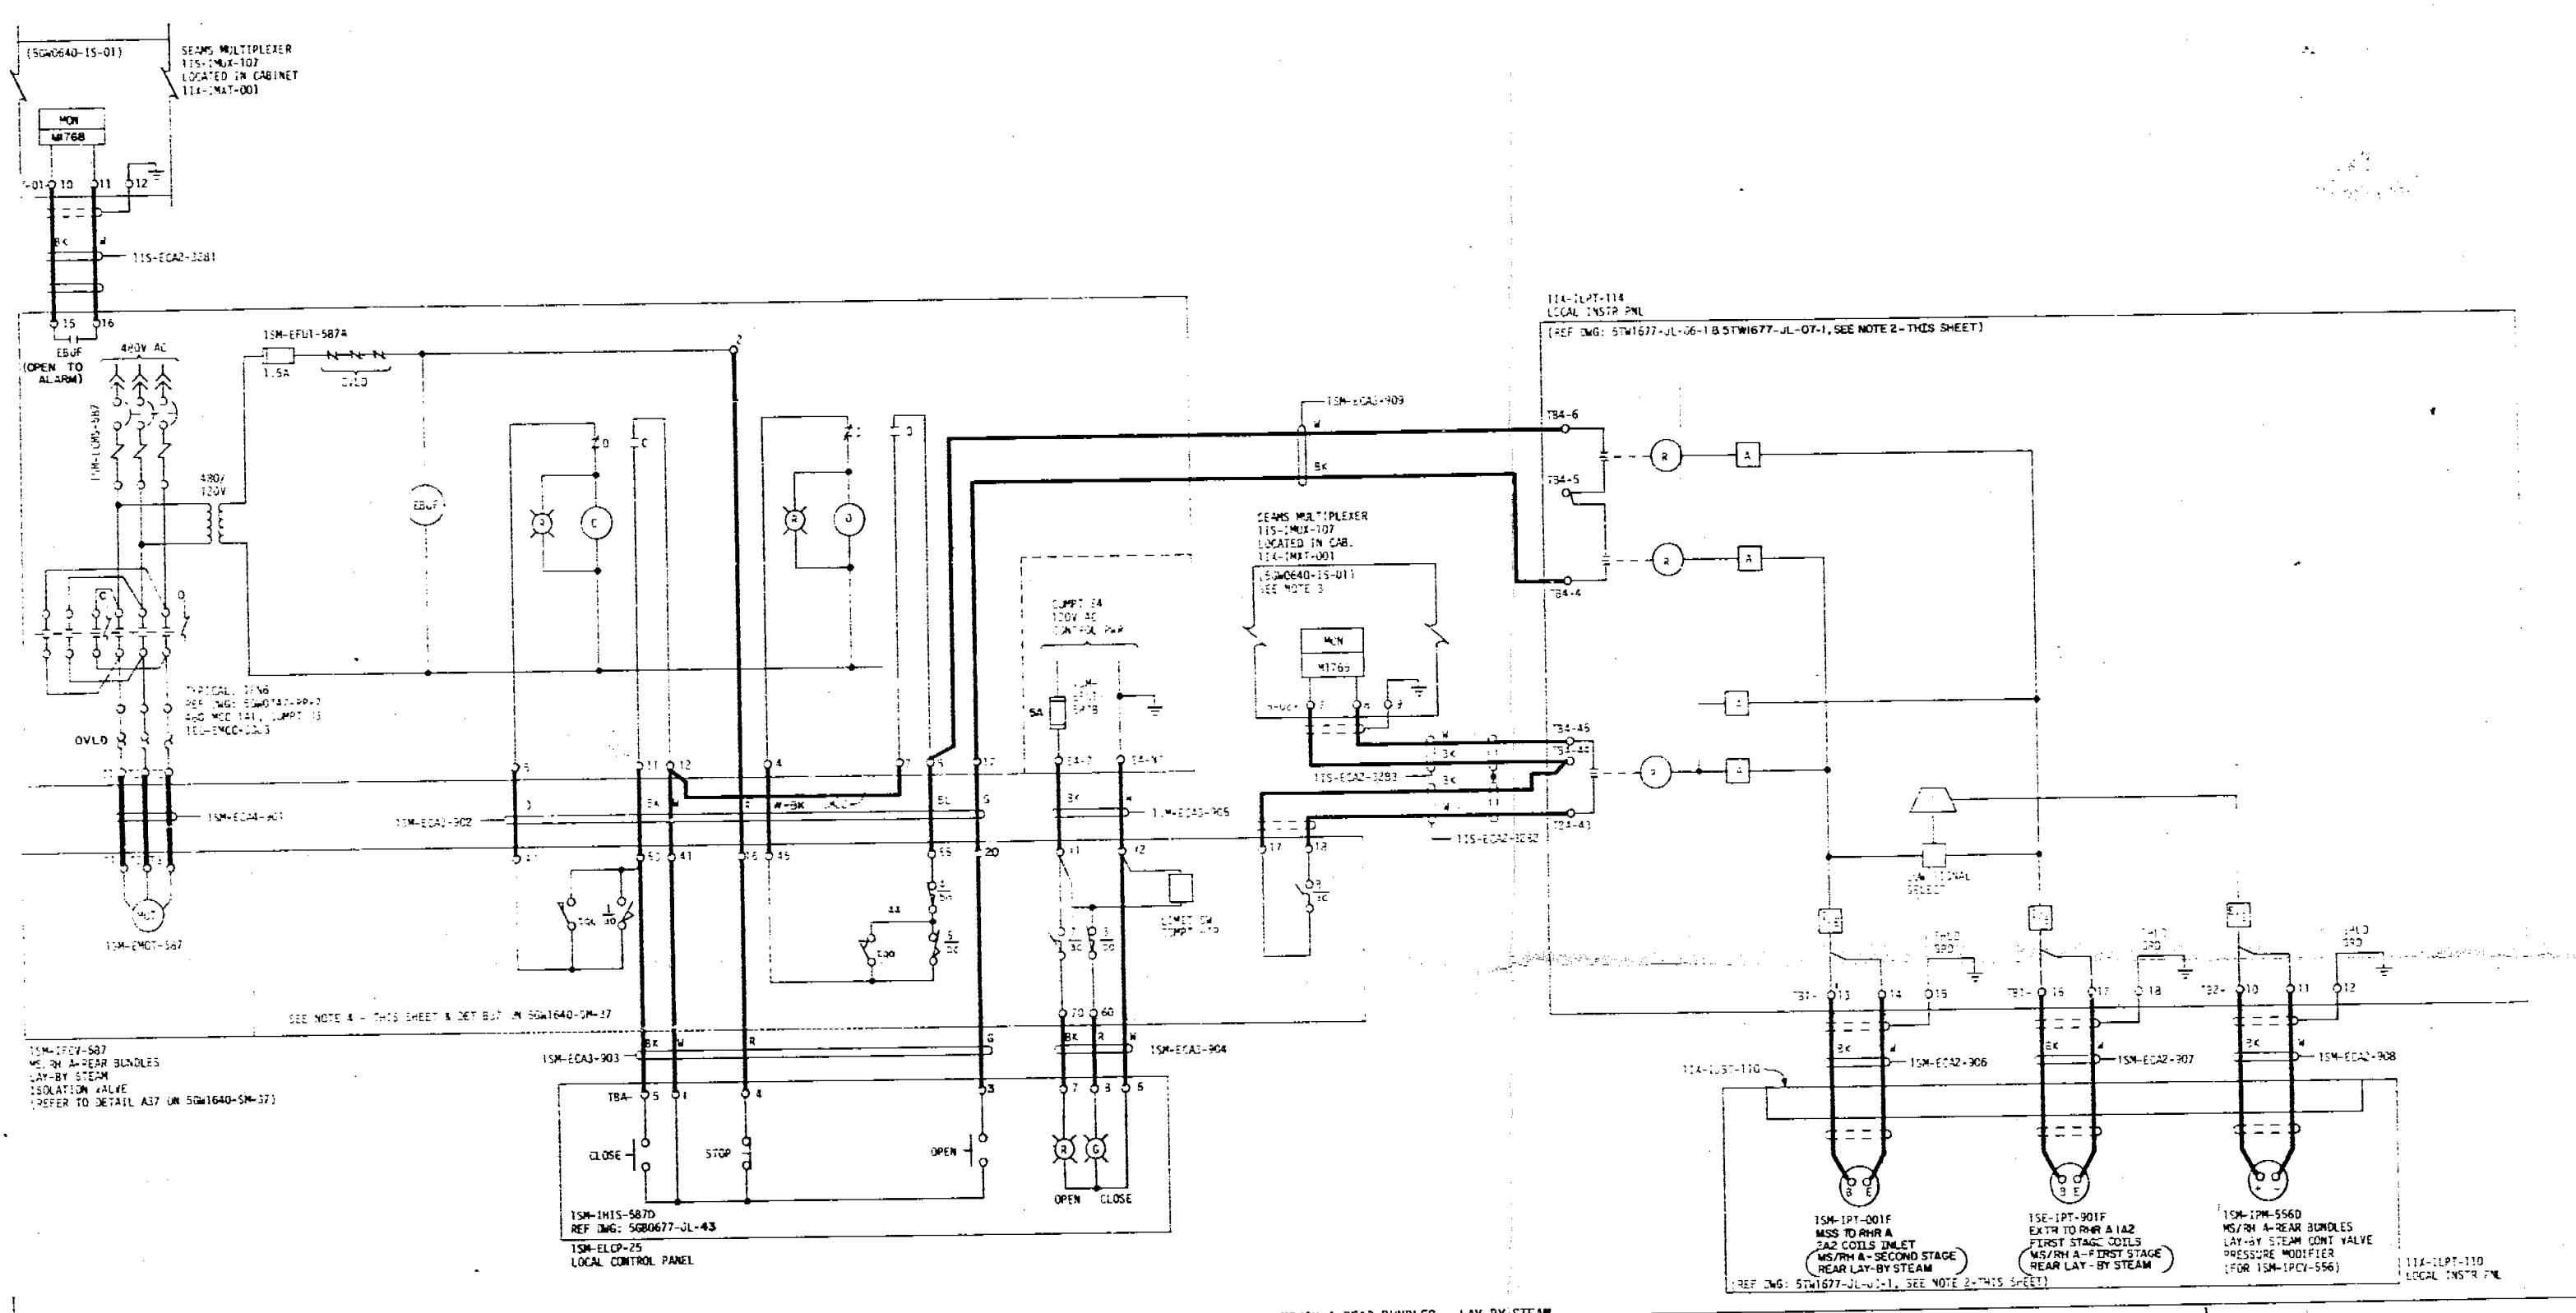

MS/RH A-REAR BUNDLES - LAY-BY STEAM

PRC APERTURE CARD

Docket # 80-438
 Control # 8304050536
 Date 3-25-83 of Document
 REGULATORY DOCKET FILE

REV	NO.	DATE	BY	CHKD	APP'D
DESIGN					
DRAWN					
CHECKED					
SUPV					
SCALE: NTS EXCEPT AS NOTED					
GENERAL UNIT 1					
SCHEMATIC DIAGRAM MAIN & REHEAT STEAM SYSTEM					
BELLEFONTE NUCLEAR PLANT TENNESSEE VALLEY AUTHORITY					
DIVISION OF ENGINEERING DESIGN					
SUBMITTED		RECOMMENDED		APPROVED	
<i>M. W. Stewart</i>		<i>R. M. Holcomb</i>		<i>R. M. Holcomb</i>	
INSPECTED AND APPROVED FOR ISSUE					
KNOXVILLE		7-31-81		88 E SGW1640-SM-38	
RECORD DRAWING AS CONSTRUCTED					

RD ISSUED FOR EEN 646									
PRINT	H								
SIZE	F								
OR DR PROJ	ME	CE	AS	CD	ED	MD	SW	SL	AL
PRINTS	REQD								