


- NOTES:
- FOR GENERAL NOTES, REFERENCE DRAWINGS, AND SYMBOLS SEE SGM1640-SM-01.
 - THIS DRAWING REFERENCE IS FOR THE "AS BUILT" MANUFACTURER'S DRAWING BY YORK ELECTRO-PANEL CONTROL CO., INC. IN CONTRACT 7643-86243-1 (FILE NO. ME-23-1).
 - AN ALARM SHALL BE GIVEN FOR HIGH LAY-BY STEAM PRESSURE.
 - REFER TO LIMITORIDE CORPORATION DRAWINGS 03-602-0107-2 AND 15-477-7687-3 IN CONTRACT 7643-86163-7 (FILE NO. MM-17-2). ALSO, REFER TO DETAIL 237 IN SGM1640-SM-37. 1SM-1CV-507, 578, 589, 590 HAVE BEEN WIRED BY THE MANUFACTURER PER DRAWING 15-477-7627-3 IN ABOVE REFERENCED CONTRACT. THESE ALLOCATIONS ARE TO BE RE-WIRED BY TVA PER DETAIL 837 IN SGM1640-SM-37. REFERENCE SHOULD BE MADE TO DRAWING 15-477-7687-3 FOR LIMIT SWITCH CONTACT DEVELOPMENT.

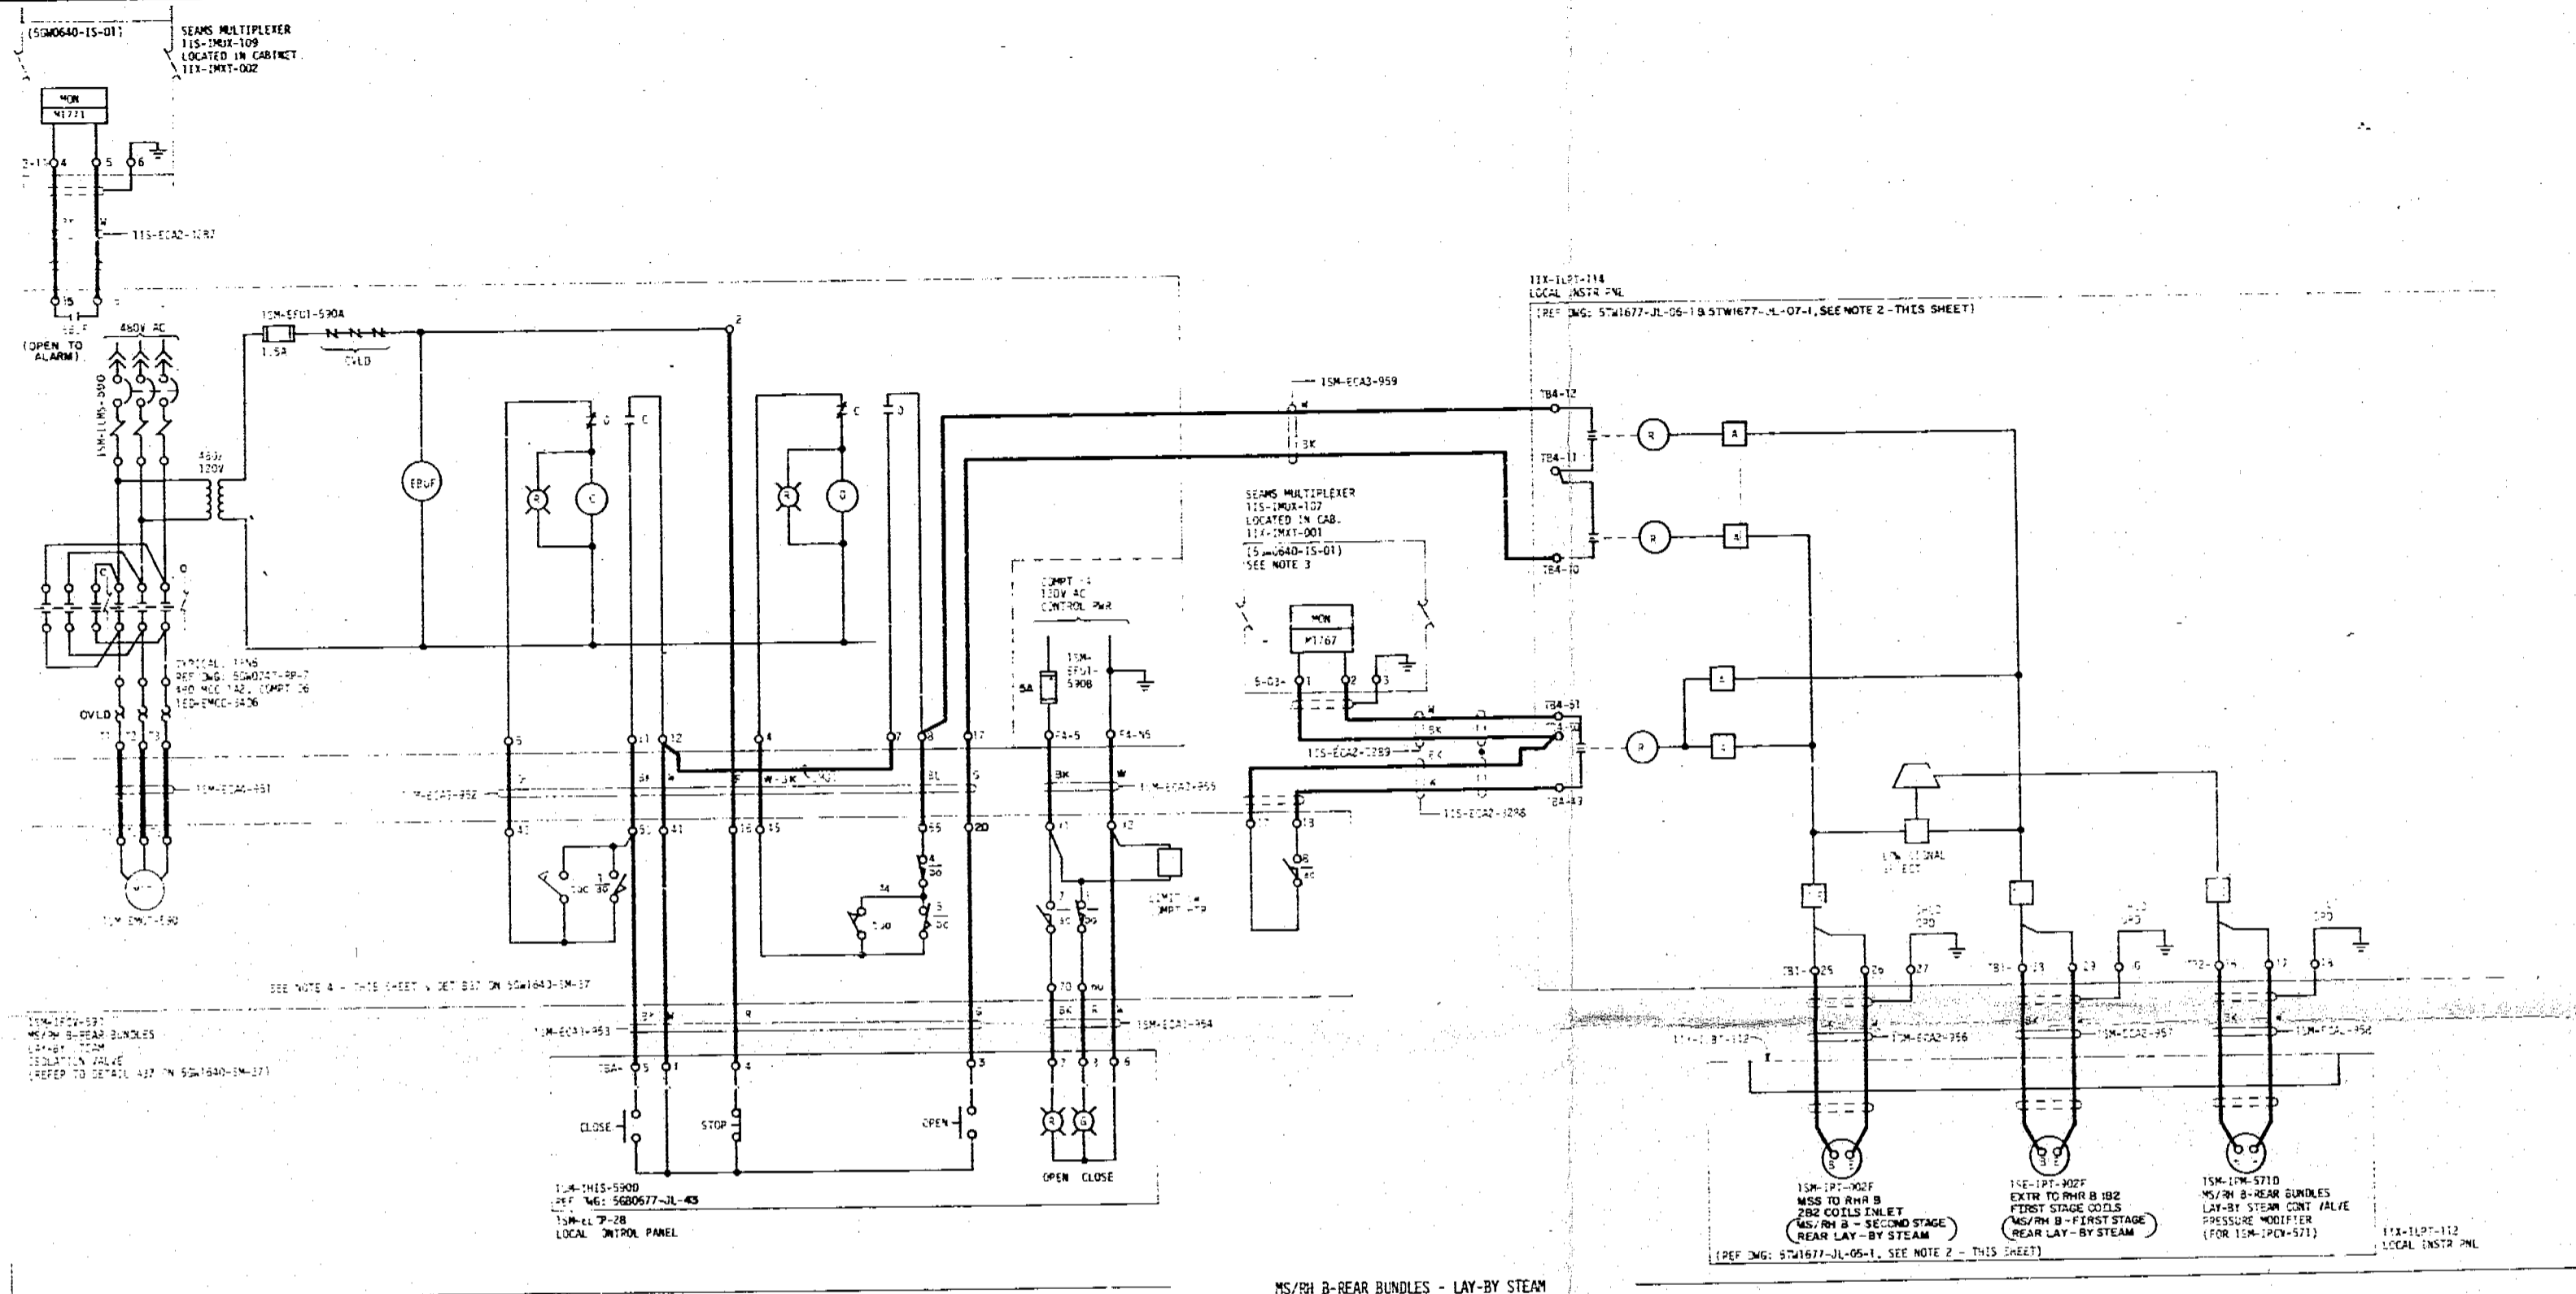

MS/RH B-REAR BUNDLES - LAY-BY STEAM

PRC APERTURE CARD

Doc # 58-498
 Cont # 8304053526
 Date 3-25-83 of Document
 REGULATORY DOCKET FILE

REV	ECN NO.	DATE	DESIGNED	CHECKED	SUPV	ENGR	WSP	APPROVED
1								
DESIGN	DATE		BY		CHECKED		BY	
ENGR	DATE		BY		CHECKED		BY	
SUPV	DATE		BY		CHECKED		BY	
SCALE: NTS								EXCEPT AS NOTED
GENERAL								
UNIT 1								
SCHEMATIC DIAGRAM								
MAIN & REHEAT STEAM SYSTEM								
BELLEFONTE NUCLEAR PLANT								
TENNESSEE VALLEY AUTHORITY								N
DIVISION OF ENGINEERING DESIGN								
SUBMITTED		RECOMMENDED		APPROVED				
M. J. Stewart		R. D. Hedges		M. J. Stewart				
KNOXVILLE		7-31-81		88 E		SGM1640-SM-40		
INSPECTED AND APPROVED FOR ISSUE								
NO. ISSUED FOR ECR 646								
RECORD DRAWING AS CONSTRUCTED								

NO. ISSUED FOR ECR 646
 INSPECTED AND APPROVED FOR ISSUE
 KNOXVILLE 7-31-81 88 E SGM1640-SM-40

PRINT	IN	1	2	3	4	5	6	7	8	9	10	11	12
SIZE	IN	1	2	3	4	5	6	7	8	9	10	11	12
OR ON PHOTO ME EE CE AD CD ED WD TM BL PA													
POINTS 4230-4													