


- NOTES:
- FOR GENERAL NOTES, REFERENCE DRAWINGS, AND SYMBOLS SEE SGM1640-SM-01.
 - THIS DRAWING REFERENCE IS FOR THE "AS BUILT" MANUFACTURER'S DRAWING BY YORK ELECTRO-PANEL CONTROL CO., INC. ON CONTRACT 7643-86243-1 (FILE NO. ME-23-1).
 - AN ALARM SHALL BE GIVEN FOR HIGH LAY-BY STEAM PRESSURE.
 - REFER TO LIMITORIDE CORPORATION DRAWINGS 03-602-0107-2 AND 15-477-7687-3 ON CONTRACT 7643-86163-7 (FILE NO. MM-17-2). ALSO, REFER TO DETAIL 237 ON SGM1640-SM-37. 1SM-1CV-507, -578, -589, -590 HAVE BEEN WIRED BY THE MANUFACTURER PER DRAWING 15-477-7627-3 ON ABOVE REFERENCED CONTRACT. THESE ALLOCATIONS ARE TO BE RE-WIRED BY TVA PER DETAIL 837 ON SGM1640-SM-37. REFERENCE SHOULD BE MADE TO DRAWING 15-477-7687-3 FOR LIMIT SWITCH CONTACT DEVELOPMENT.

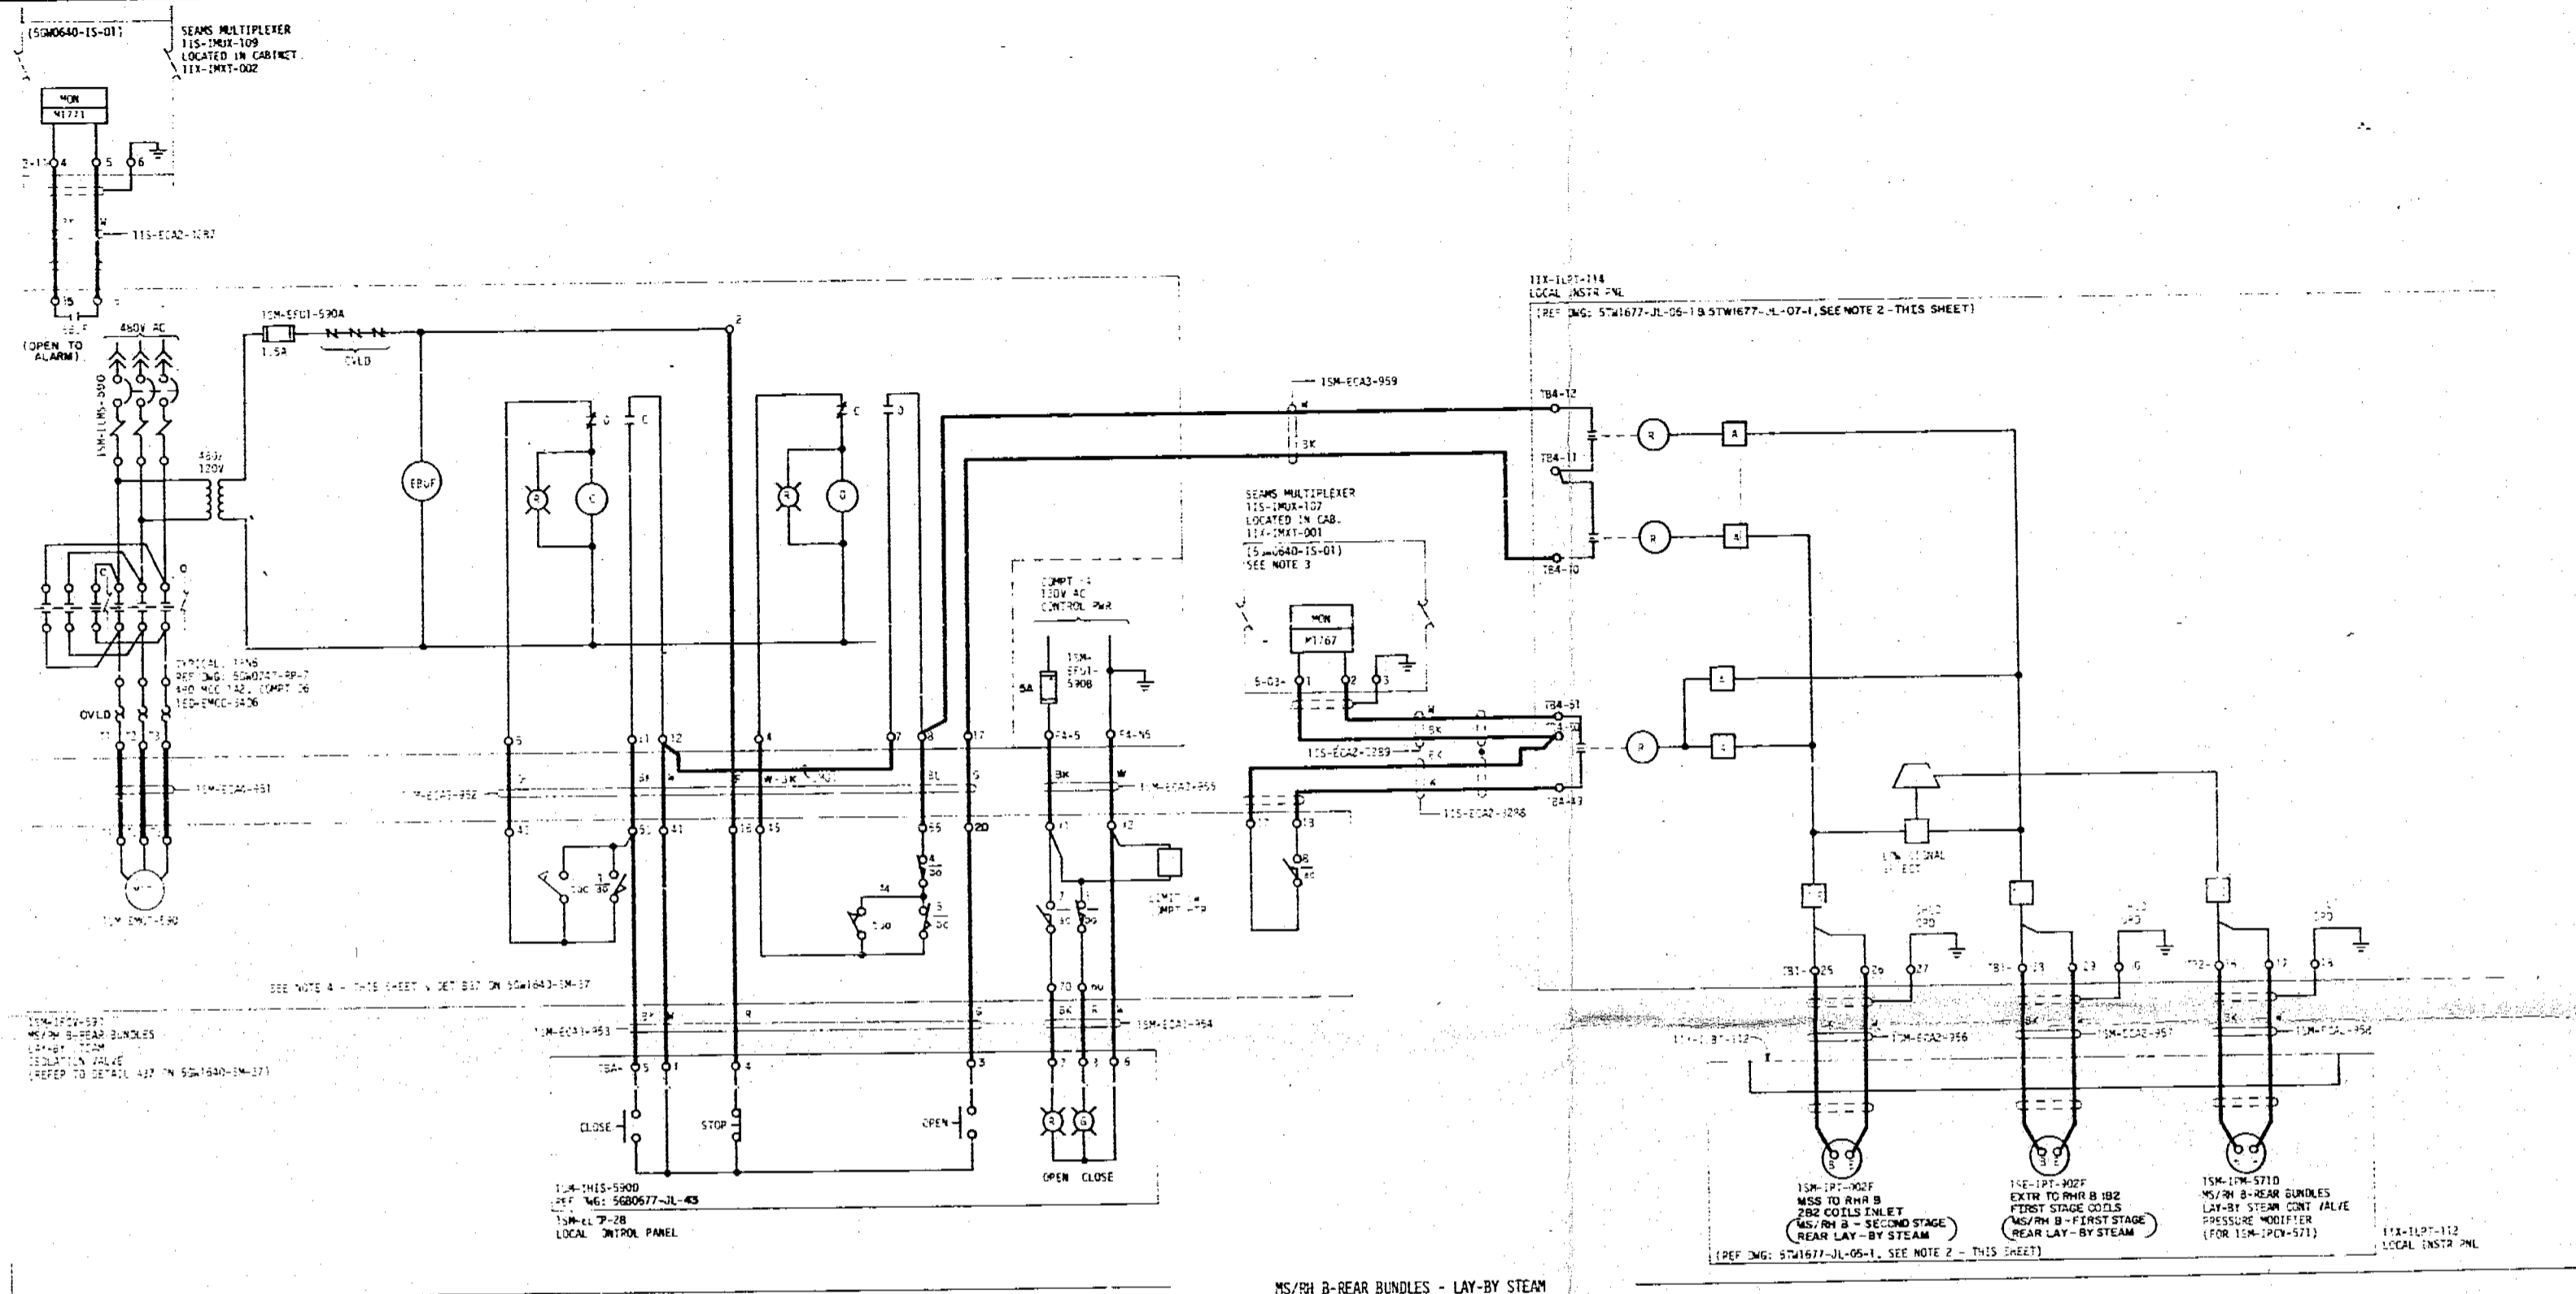

MS/RH B-REAR BUNDLES - LAY-BY STEAM

PRC APERTURE CARD

Doc # 58-498
 Cont # 8304053526
 Date 3-25-83
 REGULATORY DOCKET FILE

| | | | | | | | | |
|--|---------|------|---------------------|---------|------|----------------------|-----|-----------------|
| REV | ECN NO. | DATE | DESIGNED | CHECKED | SUPV | ENGR | WSP | APPROVED |
| 1 | | | | | | | | |
| 2 | | | | | | | | |
| 3 | | | | | | | | |
| 4 | | | | | | | | |
| 5 | | | | | | | | |
| 6 | | | | | | | | |
| 7 | | | | | | | | |
| 8 | | | | | | | | |
| 9 | | | | | | | | |
| 10 | | | | | | | | |
| 11 | | | | | | | | |
| 12 | | | | | | | | |
| SCALE: NTS | | | | | | | | EXCEPT AS NOTED |
| GENERAL UNIT 1 | | | | | | | | |
| SCHEMATIC DIAGRAM | | | | | | | | |
| MAIN & REHEAT STEAM SYSTEM | | | | | | | | |
| BELLEFONTE NUCLEAR PLANT TENNESSEE VALLEY AUTHORITY DIVISION OF ENGINEERING DESIGN | | | | | | | | N |
| SUBMITTED | | | RECOMMENDED | | | APPROVED | | |
| <i>M. H. Stewart</i> | | | <i>R. D. Hedges</i> | | | <i>M. H. Stewart</i> | | |
| KNOXVILLE | | | 7-31-81 | | | 88 E SGM1640-SM-40 | | |
| INSPECTED AND APPROVED FOR ISSUE | | | | | | | | |
| NO. ISSUED FOR ECR 646 | | | | | | | | |
| RECORD DRAWING AS CONSTRUCTED | | | | | | | | |

NO. ISSUED FOR ECR 646
 INSPECTED AND APPROVED FOR ISSUE
 KNOXVILLE 7-31-81 88 E SGM1640-SM-40

| | | | | | | | | | | | | | |
|---------------|----|---|---|---|---|---|---|---|---|---|----|----|----|
| PRINT | IN | 1 | 2 | 3 | 4 | 5 | 6 | 7 | 8 | 9 | 10 | 11 | 12 |
| SIZE | IN | 1 | 2 | 3 | 4 | 5 | 6 | 7 | 8 | 9 | 10 | 11 | 12 |
| PRINTS 4230-4 | | | | | | | | | | | | | |