


ROOF PLAN - TOP OF STEEL ELEV 167'-6"  
 UNLESS NOTED 4  
 REFLECTING FLOOR ELEV 162'-0"  
 STEEL (#8) UNLESS NOTED

FOR MODIFICATIONS  
 IN THIS AREA SEE  
 DWG. 522-041-010

EC  
 70139  
 RO

EC  
 70139  
 RO

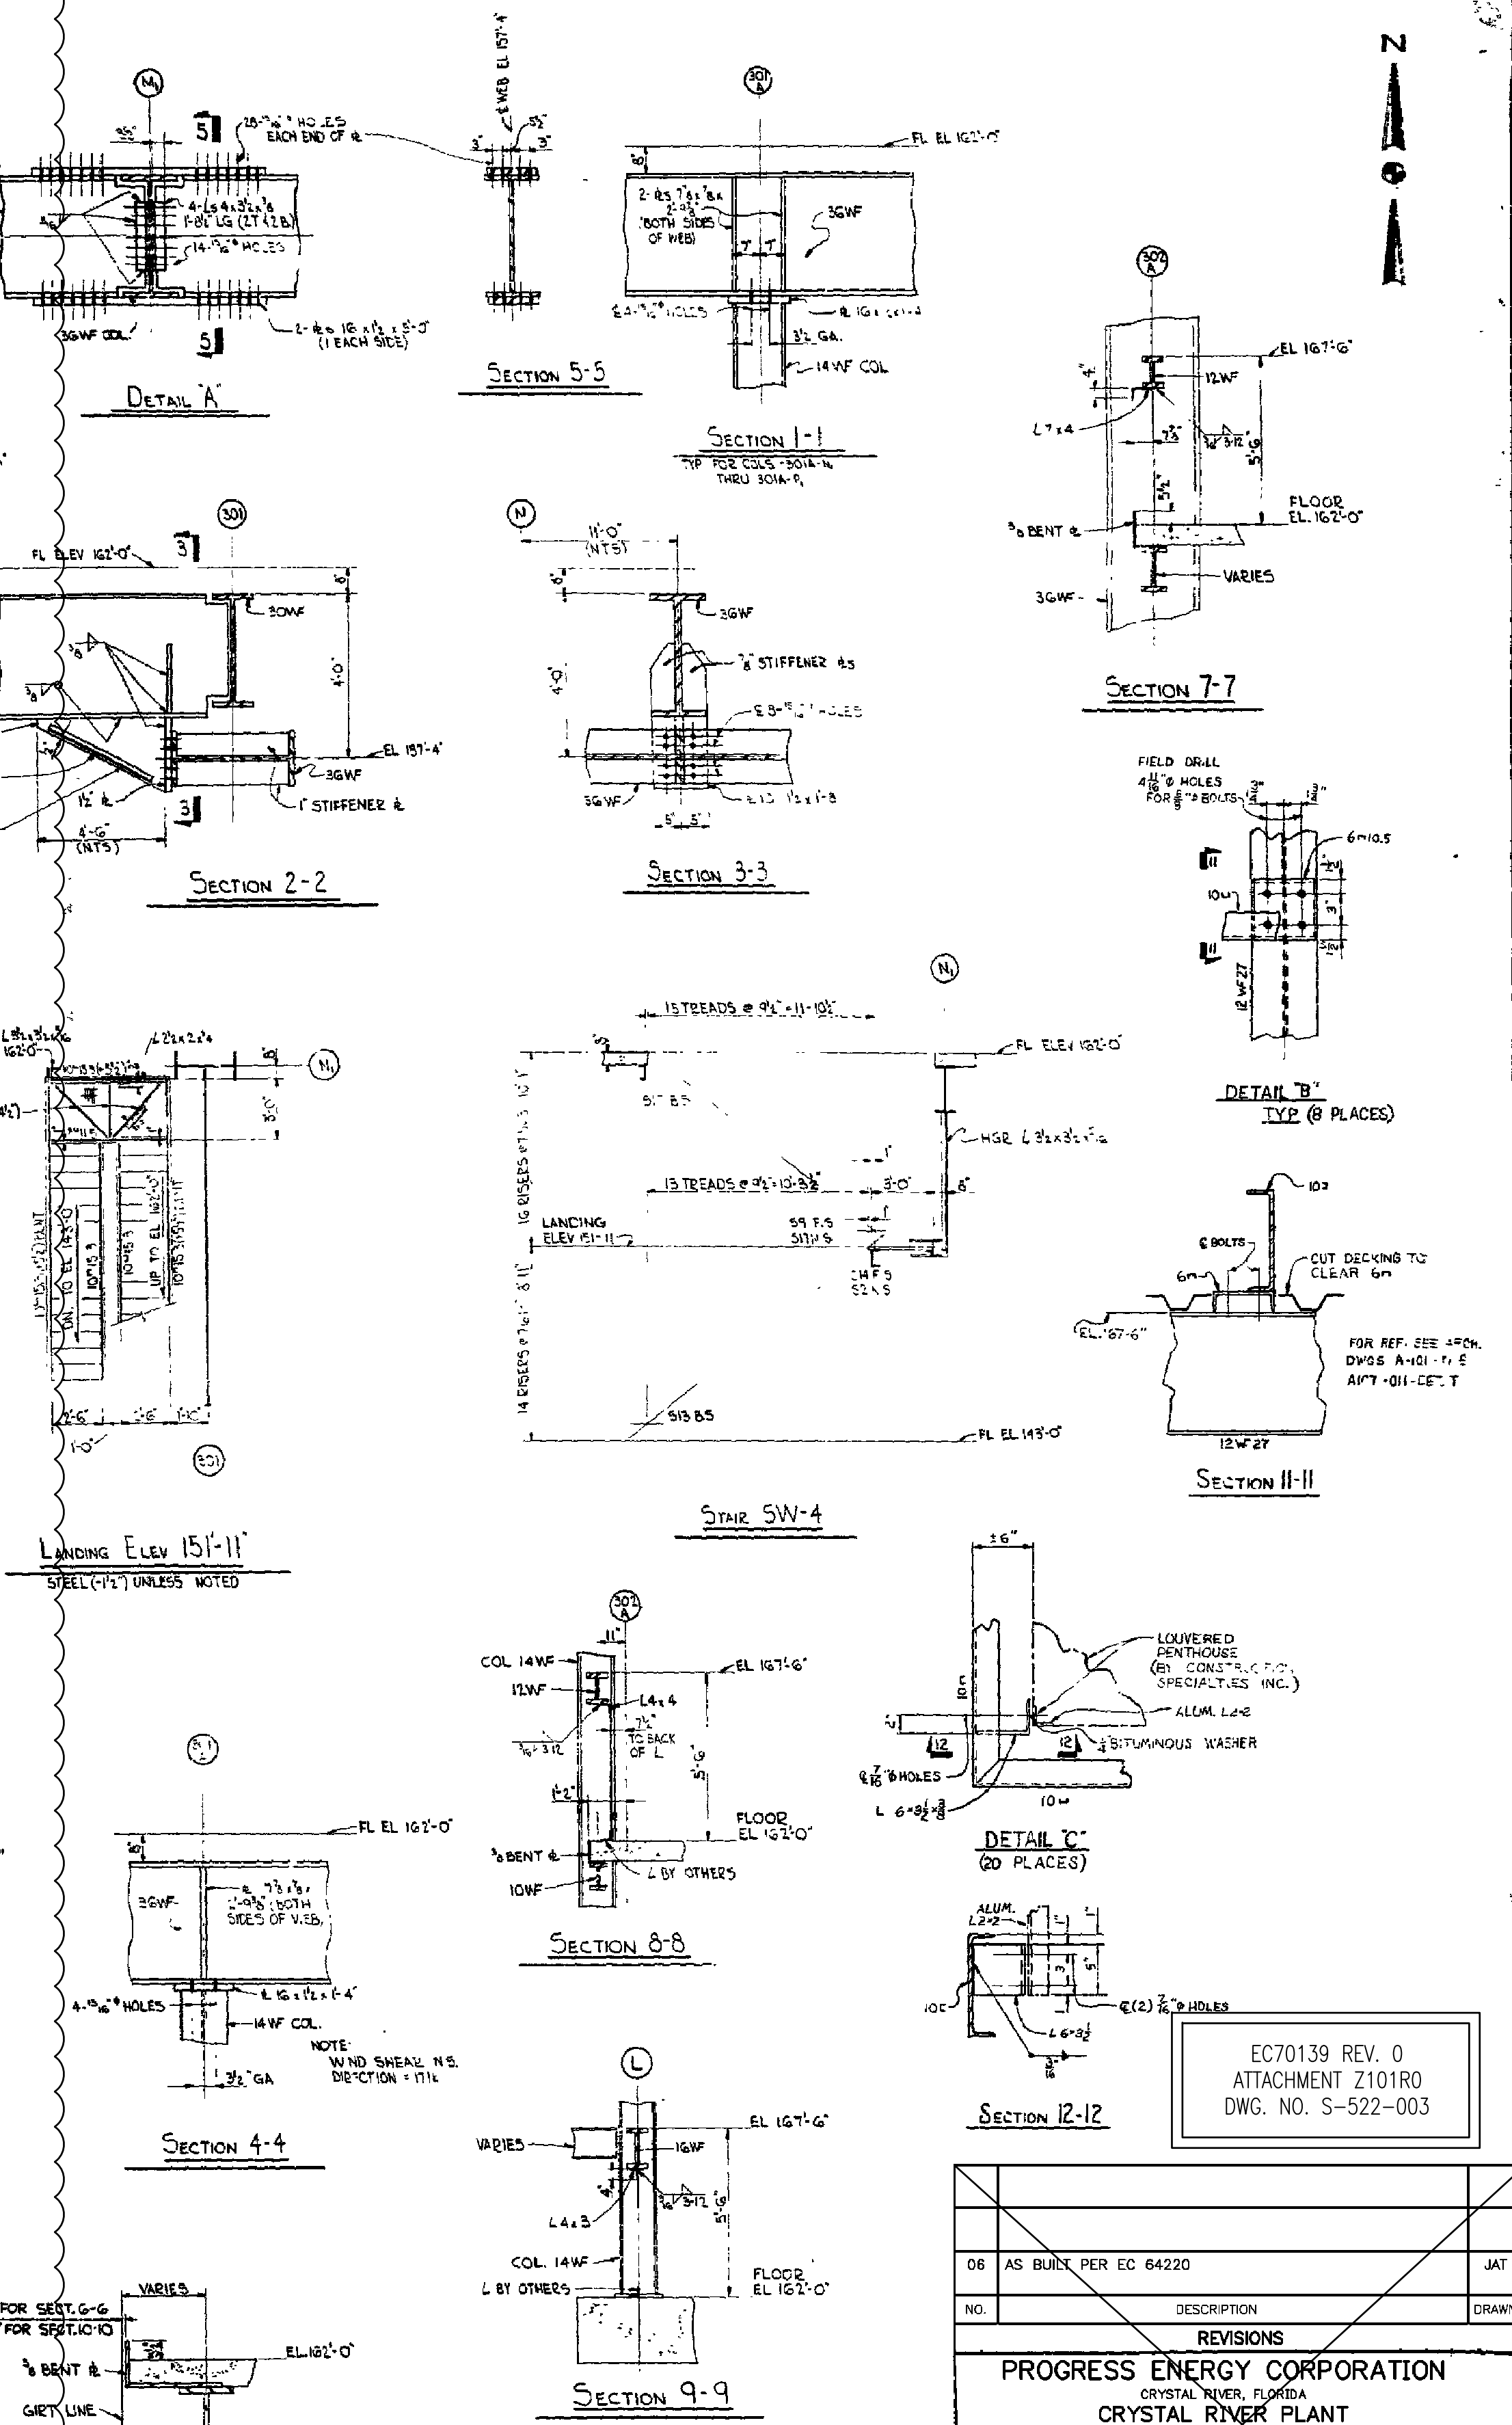

EC70139 REV. 0  
 ATTACHMENT Z101R0  
 DWG. NO. S-522-003

- NOTES:
- FOR GENERAL NOTES SEE DWG. S-522-411.
  - FOR AUXILIARY PULLING REFERENCES SEE DWG. S-522-301.
  - FOR DIMENSIONING REFERENCES SEE DWG. S-522-301.
  - FOR DIMENSIONING REFERENCES SEE DWG. S-522-301.
  - FOR DIMENSIONING REFERENCES SEE DWG. S-522-301.

NO.	DESCRIPTION	DRAWN
06	AS BUILT PER EC 64220	JAT

PROGRESS ENERGY CORPORATION  
 CRYSTAL RIVER, FLORIDA  
 CRYSTAL RIVER PLANT  
 855,000 KW UNIT NO. 3  
 AUXILIARY BUILDING SO. STEEL FRAMING  
 ROOF AT ELEV. 167'-6" & FLOOR  
 ELEV. 162'-0"

DESIGNED BY	REVISIONS	DATE	SCALE	WORK	CHECKED BY	DATE
RELEASING PURPOSES ONLY						
4203	E-522-003	6	S-522-003			

DWG# 522-003