



Nuclear Innovation
North America LLC
4000 Avenue F, Suite A
Bay City, Texas 77414

November 14, 2011
U7-C-NINA-NRC-110138

U. S. Nuclear Regulatory Commission
Attention: Document Control Desk
One White Flint North
11555 Rockville Pike
Rockville MD 20852-2738

South Texas Project
Units 3 and 4
Docket Nos. 52-012 and 52-013
Supplemental Response to Request for Additional Information

During audits of May 23-27, 2011, July 25-29, 2011, and September 27-30, 2011, the NRC Staff requested that Nuclear Innovation North America LLC (NINA) provide additional information to support the review of the Combined License Application (COLA). Attached is a supplemental response to NRC staff questions included in Request for Additional Information (RAI) 03.08.04-30 and 03.08.04-34 related to COLA Part 2, Tier 2, Section 3.8.

There are no commitments in this letter.

If you have any questions regarding these responses, please contact me at (361) 972-7136 or Bill Mookhoek at (361) 972-7274.

I declare under penalty of perjury that the foregoing is true and correct.

Executed on 11/14/11

Scott Head
Manager, Regulatory Affairs
South Texas Project Units 3 & 4

jep

Attachments:

RAI 03.08.04-30, Supplement 7
RAI 03.08.04-34, Supplement 2

DO91
NR20

STI 33047979

cc: w/o attachment except*
(paper copy)

(electronic copy)

Director, Office of New Reactors
U. S. Nuclear Regulatory Commission
One White Flint North
11555 Rockville Pike
Rockville, MD 20852-2738

*George F. Wunder
*Tom Tai
Charles Casto
U. S. Nuclear Regulatory Commission

Regional Administrator, Region IV
U. S. Nuclear Regulatory Commission
611 Ryan Plaza Drive, Suite 400
Arlington, Texas 76011-8064

Jamey Seely
Nuclear Innovation North America

Peter G. Nemeth
Crain, Caton and James, P.C.

Kathy C. Perkins, RN, MBA
Assistant Commissioner
Division for Regulatory Services
Texas Department of State Health Services
P. O. Box 149347
Austin, Texas 78714-9347

Richard Peña
Kevin Pollo
L. D. Blaylock
CPS Energy

Alice Hamilton Rogers, P.E.
Inspection Unit Manager
Texas Department of State Health Services
P. O. Box 149347
Austin, Texas 78714-9347

*Steven P. Frantz, Esquire
A. H. Gutterman, Esquire
Morgan, Lewis & Bockius LLP
1111 Pennsylvania Ave. NW
Washington D.C. 20004

*Tom Tai
Two White Flint North
11545 Rockville Pike
Rockville, MD 20852

RAI 03.08.04-30, Supplement 7**QUESTION:****Follow-up to Question 03.08.04-23**

In response to staff question requesting additional information (Letter U7-C-STP-NRC-100036, dated February 10, 2010) about how various steel and concrete elements of site-specific structures are designed, and the design results, the applicant provided some analysis and design information. The applicant also referred to the Supplement 2 response to Question 03.07.01-13 (Letter U7-C-STP-NRC-090230, dated 12/30/09) for pertinent design summary information. In order for the staff to conclude that the design of site-specific structures meet the requirements of GDC 2 by meeting the guidance provided in SRP 3.8.4 and 3.8.5, or otherwise, the applicant is requested to provide the following additional information:

1. The applicant states in the response that a three dimensional finite element analysis (FEA) is used for structural analysis and design of the UHS/RSW Pump House. FSAR Section 3H.6.6.1 states that analysis for the seismic loads was performed using equivalent static loads and the induced forces due to X, Y, and Z seismic excitations were combined using the SRSS method of combination. However, the applicant did not describe how the equivalent static loads due to seismic excitation were determined and applied to the static FEA model from the results of soil structure interaction (SSI) analysis used for determination of seismic response. Therefore, the applicant is requested to provide details of how seismic response analysis results from dynamic SSI analysis were transferred to the static FEA model, including how the effects of accidental torsion were included in the analysis and design of UHS/RSW Pump house. Please also update FSAR with the information, as appropriate.
2. The applicant stated in its response that the modulus of subgrade reaction for static loading was calculated as the average of the local values at nine locations under the foundation. The applicant is requested to provide these nine values, and explain why it is considered appropriate to use the average value. Please also explain how the foundation subgrade modulus was used for calculating nodal springs for the FEA model, and how the effect due to coupling of soil springs was considered in the analysis.
3. For seismic loading, the applicant has outlined a hand-calculated procedure that utilizes published formulas and charts to estimate the foundation spring constants. According to this procedure, the equivalent modulus and Poisson's ratio of a layered soil system are first estimated using the cumulative strain energy method. The resulting values are then used in the equations for computation of the spring constants for a rigid foundation of an arbitrary shape embedded in a uniform half-space. The shear moduli used for individual layers are strain compatible values, and include the mean, upper bound, and lower bound soil cases. The approximate procedure outlined above for developing the foundation spring constants does not take into account the pressure distribution under the base slab. Furthermore, this procedure does not account for the frequency dependence of these springs. As such, the applicant is requested to provide a justification for not considering the effects of pressure

distribution and system frequency in developing the foundation dynamic springs including describing the impact on the calculated results.

4. The applicant's response does not provide details as to how the soil springs calculated under static and seismic loadings are inputted to the 3-D static FEA model to calculate the design stresses. Therefore, the applicant is requested to describe in detail how the static and seismic soil springs are inputted into the FEA model, and how the results are obtained for stress evaluations. Specifically, the applicant is requested to explain if the two sets of springs were used in a single model, and how the two sets were combined to a single set of springs. Otherwise, if the two sets of springs were applied to separate FEA models, describe how the load combinations were performed. The applicant is also requested to provide sufficient detail to assist staff in understanding how static and seismic soil springs are used in the FEA model and results combined for stress evaluations.
5. In the FSAR mark-up of Sections 3H.6.6.3.1 and 3H.6.6.3.2 provided with the response, the applicant identifies the method used by the applicant for combining forces and moments. In this method, for each reinforcing zone, the maximum force or moment is coupled with the corresponding moment or force for design for the same load combination. It is not clear if this method of combining forces and moments for design will envelop the worst combination of forces and moments for all elements in a reinforcing zone. Therefore, the applicant is requested to describe the method of combining forces and moments used by the applicant with a typical example of a reinforcing zone, and demonstrate that this method of combination will yield the worst combination of forces and moments that should be considered for design.
6. The staff notes that in the FSAR mark-up of Section 3H.6.6.3.1 provided with the response, the reported values of soil springs for the RSW Pump House are significantly larger than those for the UHS basin. The applicant is requested to confirm these values, and explain the reason for the large difference.
7. The response did not include any information about the maximum static and dynamic bearing pressures under the foundations of UHS/RSW Pump House. The applicant is requested to provide the maximum static and dynamic bearing pressure under the foundations of UHS/RSW Pump House, compare these values with the maximum allowable static and dynamic bearing pressures, and include this information in the FSAR.
8. In its response to Question 03.07.01-19 (letter U7-C-STP-NRC-100129, dated June 7, 2010), the applicant provided analysis and design information for the seismic category I Diesel Generator Fuel Oil Storage Vault (DGFOV) which was not previously included in the FSAR. The information included in the response does not describe how structural analysis and design of the structure was performed. Also, reference is made to FSAR Section 3H.6.4 for design loads. FSAR Section 3H.6.4 has been updated several times in various responses, and it is not clear where this information can be found. Therefore, the applicant is requested to provide complete structural analysis and design information for the DGFOV to ensure it meets acceptance criteria 1 through 7 of SRP 3.8.4 and 3.8.5. The staff needs this information to conclude that the DGFOV is designed to withstand seismic loads and meet GDC 2. Include

in the response an updated version of Appendix 3H where structural analysis and design information for all seismic category I structures can be found.

9. While reviewing this response, and other responses referenced in this response, the staff noted that the applicant has used different values of coefficient of friction for sliding stability evaluation; e.g., the value 0.3 was used for the RSW Pump House, 0.4 was used for UHS basin, 0.58 was used DGFOV, and for the Reactor Building (RB) and the Control Building (CB), it was stated to be more than 0.47. It is not clear if these values are the required coefficient of friction, or the minimum coefficient of friction available. The applicant is requested to clearly specify the minimum coefficient of friction at various locations of the site, if they are different, and explain how these values were determined. Please also clarify this information in the FSAR.
10. The staff noted references to Diesel Generator Fuel Oil Tunnel (DGFOT) in several RAI responses. Please confirm that DGFOT is not a seismic category I structure, and if it is seismic category I, include the analysis and design information to show how the design of the DGFOT meets the acceptance criteria 1 through 7 in the SRP 3.8.4 and 3.8.5 in the FSAR.

SUPPLEMENTAL RESPONSE:

The Supplement 6 response to this RAI was submitted with Nuclear Innovation North America (NINA) letter U7-C-NINA-NRC-110116, dated September 12, 2011. This supplement provides the response to the following action items discussed in the NRC audit performed during the week of September 27, 2011.

Punch List Item 131

In RAI 03.08.04-30 S5, clarify why the wave propagation for DGFOT is based on site-specific SSE.

Action: Design parameters table (i.e. Table 3H.9-1) will be updated per Action Item 3.7-58.

Punch List Item 134

In COLA Rev. 6, Figures 3H.7-31 and 3H.7-32 are not legible and the table number in the table heading for Table 3H.9-1 is noted as Table 3H.8-1.

Action: COLA Rev 6 Figures 3H.7-31 and 32 will be replaced and design parameters table (i.e. Table 3H.9-1) will be updated per Action Item 3.7-58.

Action Item 3.7-58

Add a note to the design parameters table (i.e. Table 3H.9-1) to specify that the wave propagation parameters are site-specific and correct the table number in the table heading (Punch List Items 131 and 134) in RAI 03.08.04-30 S7.

Axial tensile strains, forces and moments at tunnel bends due to seismic wave propagation are layout dependent. Since the layout of Diesel Generator Fuel Oil Tunnels (DGFOT) is site-specific, the seismic wave propagation for DGFOT is based on the site-specific Safe Shutdown Earthquake.

COLA Figures 3H.7-31 and 3H.7-32 have been revised. The revised figures are provided in the RAI 03.07.01-29 Supplement 1 response which is being submitted concurrently with this response.

COLA Table 3H.9-1 has been revised per Action Item 3.7-58 (see Enclosure).

As a result of this response COLA Part 2, Tier 2, Appendix 3H will be revised as shown in the Enclosure.

Enclosure

Mark-ups to COLA Revision 6

Table 3H.9-1 Extreme Environmental Design Parameters for Seismic Analysis, Design, Stability Evaluation and Seismic Category II/I Design

Structure	Seismic Analysis						Design								Design for II/I			
	SSI			SSSI			Structure				Stability							
	Input Motion	Soil Type	Structural Damping for Generation of ISRS	Input Motion	Soil Type	Seismic	Tornado	Tornado Missiles	Flood	Seismic	Tornado	Tornado Missiles	Flotation	Coeff. Of Friction for Waterproofing Membrane	Seismic	Tornado	Tornado Missiles	Flood
Diesel Generator Fuel Oil Tunnels (DGOT)	Envelope of Amplified ⁽¹⁾ Site-Specific SSE & 0.3g R6 1.60	DCD & Site-Specific	4% for all SSI analysis cases	Site-Specific SSE	Site-Specific	Envelope of Amplified ⁽¹⁾ Site-Specific SSE & 0.3g R6 1.60 (See Note 4)	DCD Tornado Wind Parameters (As described in Table 5.0 of DCD/Tier 1)	DCD Missile Spectrum 1 as defined in Table 5.0 of DCD/Tier 1	Flood El. 40' MSL, Water Density 63.85 lb/ft ³ (above grade) + Drag Effect 44 psf (above grade) + Impact of Floating Debris per COLA Section 3.4.2 + Wind Generated Wave Action per COLA Figure 3.4-1 (only hydrodynamic portion)	Amplified ⁽¹⁾ Site-Specific SSE	Site-Specific Tornado Wind Parameters (Region II, R6 1.76 Rev. 1)	Site-Specific Tornado Missile Spectrum for Region II as shown in Table 2 of R6 1.76 Rev. 1 (Note 2)	Flood El. 40' MSL, Water Density 63.85 lb/ft ³ (above grade)	Site-Specific	NA	NA	NA	NA
UHS/RSW Pump House	Site-Specific SSE	Site-Specific	4% for all SSI analysis cases	Site-Specific SSE	Site-Specific	Site-Specific SSE	Site-Specific Tornado Wind Parameters (Region II, R6 1.76 Rev. 1)	Site-Specific Tornado Missile Spectrum for Region II as shown in Table 2 of R6 1.76 Rev. 1	Flood El. 40' MSL, Water Density 63.85 lb/ft ³ (above grade) + Drag Effect 44 psf (above grade) + Impact of Floating Debris per COLA Section 3.4.2 + Wind Generated Wave Action per COLA Figure 3.4-1 (only hydrodynamic portion)	Site-Specific SSE	Site-Specific Tornado Wind Parameters (Region II, R6 1.76 Rev. 1)	Site-Specific Tornado Missile Spectrum for Region II as shown in Table 2 of R6 1.76 Rev. 1	Flood El. 40' MSL, Water Density 63.85 lb/ft ³ (above grade)	Site-Specific	NA	NA	NA	NA
RSW Piping Tunnels	Amplified ⁽¹⁾ Site-Specific SSE	Site-Specific	4% for all SSI analysis cases Except 7% for Cracked Case	Site-Specific SSE	Site-Specific	Amplified ⁽¹⁾ Site-Specific SSE	Site-Specific Tornado Wind Parameters (Region II, R6 1.76 Rev. 1)	Site-Specific Tornado Missile Spectrum for Region II as shown in Table 2 of R6 1.76 Rev. 1	Flood El. 40' MSL, Water Density 63.85 lb/ft ³ (above grade) + Drag Effect 44 psf (above grade) + Impact of Floating Debris per COLA Section 3.4.2 + Wind Generated Wave Action per COLA Figure 3.4-1 (only hydrodynamic portion)	Amplified ⁽¹⁾ Site-Specific SSE	Site-Specific Tornado Wind Parameters (Region II, R6 1.76 Rev. 1)	Site-Specific Tornado Missile Spectrum for Region II as shown in Table 2 of R6 1.76 Rev. 1	Flood El. 40' MSL, Water Density 63.85 lb/ft ³ (above grade)	Site-Specific	NA	NA	NA	NA
Diesel Generator Fuel Oil Storage Vault (DGFOSV)	Envelope of Amplified ⁽¹⁾ Site-Specific SSE & 0.3g R6 1.60	Site-Specific	4% for all SSI analysis cases	Site-Specific SSE	Site-Specific	Envelope of Amplified ⁽¹⁾ Site-Specific SSE & 0.3g R6 1.60	Site-Specific Tornado Wind Parameters (Region II, R6 1.76 Rev. 1)	Site-Specific Tornado Missile Spectrum for Region II as shown in Table 2 of R6 1.76 Rev. 1	Flood El. 40' MSL, Water Density 63.85 lb/ft ³ (above grade) + Drag Effect 44 psf (above grade) + Impact of Floating Debris per COLA Section 3.4.2 + Wind Generated Wave Action per COLA Figure 3.4-1 (only hydrodynamic portion)	Amplified ⁽¹⁾ Site-Specific SSE	Site-Specific Tornado Wind Parameters (Region II, R6 1.76 Rev. 1)	Site-Specific Tornado Missile Spectrum for Region II as shown in Table 2 of R6 1.76 Rev. 1	Flood El. 40' MSL, Water Density 63.85 lb/ft ³ (above grade)	Site-Specific	NA	NA	NA	NA
Radwaste Building (RWB)	NA	NA	NA	Site-Specific SSE	Site-Specific	1/2 of 0.3g R6 1.60 SSE for RW-IIa Classification, 4% Damping	Per Table 2 of R6 1.143 Rev. 2 for RW-IIa Classification	Per Table 2 of R6 1.143 Rev. 2 for RW-IIa Classification	Flood El. 33' MSL RW-IIb Classification	Amplified ⁽¹⁾ Site-Specific SSE, 7% Damping	Site-Specific Tornado Wind Parameters (Region II, R6 1.76 Rev. 1)	Site-Specific Tornado Missile Spectrum for Region II as shown in Table 2 of R6 1.76 Rev. 1	Flood El. 40' MSL, Water Density 63.85 lb/ft ³ (above grade)	Site-Specific	Envelope of Amplified ⁽¹⁾ Site-Specific SSE & 0.3g R6 1.60, 7% Damping	DCD Tornado Wind Parameters (As described in Table 5.0 of DCD/Tier 1)	DCD Missile Spectrum 1 as defined in Table 5.0 of DCD/Tier 1	Flood El. 40' MSL, Water Density 63.85 lb/ft ³ (above grade) + Drag Effect 44 psf (above grade) + Impact of Floating Debris per COLA Section 3.4.2 + Wind Generated Wave Action per COLA Figure 3.4-1 (only hydrodynamic portion)
Control Bldg. Annex (CBA)	NA	NA	NA	NA	NA	IBC 2006	NA	NA	NA	Amplified ⁽¹⁾ Site-Specific SSE	Site-Specific Tornado Wind Parameters (Region II, R6 1.76 Rev. 1)	Site-Specific Tornado Missile Spectrum for Region II as shown in Table 2 of R6 1.76 Rev. 1	Flood El. 40' MSL, Water Density 63.85 lb/ft ³ (above grade)	Site-Specific	Envelope of Amplified ⁽¹⁾ Site-Specific SSE & 0.3g R6 1.60	DCD Tornado Wind Parameters (As described in Table 5.0 of DCD/Tier 1)	DCD Missile Spectrum 1 as defined in Table 5.0 of DCD/Tier 1	Flood El. 40' MSL, Water Density 63.85 lb/ft ³ (above grade) + Drag Effect 44 psf (above grade) + Impact of Floating Debris per COLA Section 3.4.2 + Wind Generated Wave Action per COLA Figure 3.4-1 (only hydrodynamic portion)
Turbine Building (TB)	NA	NA	NA	NA	NA	IBC 2006	NA	NA	NA	Site-Specific SSE	Site-Specific Tornado Wind Parameters (Region II, R6 1.76 Rev. 1)	Site-Specific Tornado Missile Spectrum for Region II as shown in Table 2 of R6 1.76 Rev. 1	Flood El. 40' MSL, Water Density 63.85 lb/ft ³ (above grade)	Site-Specific	0.3g R6 1.60 SSE	DCD Tornado Wind Parameters (As described in Table 5.0 of DCD/Tier 1)	DCD Missile Spectrum 1 as defined in Table 5.0 of DCD/Tier 1	Flood El. 40' MSL, Water Density 63.85 lb/ft ³ (above grade) + Drag Effect 44 psf (above grade) + Impact of Floating Debris per COLA Section 3.4.2 + Wind Generated Wave Action per COLA Figure 3.4-1 (only hydrodynamic portion)
Service Building (SB)	NA	NA	NA	NA	NA	IBC 2006	NA	NA	NA	Amplified ⁽¹⁾ Site-Specific SSE	Site-Specific Tornado Wind Parameters (Region II, R6 1.76 Rev. 1)	Site-Specific Tornado Missile Spectrum for Region II as shown in Table 2 of R6 1.76 Rev. 1	Flood El. 40' MSL, Water Density 63.85 lb/ft ³ (above grade)	Site-Specific	Envelope of Amplified ⁽¹⁾ Site-Specific SSE & 0.3g R6 1.60	DCD Tornado Wind Parameters (As described in Table 5.0 of DCD/Tier 1)	DCD Missile Spectrum 1 as defined in Table 5.0 of DCD/Tier 1	Flood El. 40' MSL, Water Density 63.85 lb/ft ³ (above grade) + Drag Effect 44 psf (above grade) + Impact of Floating Debris per COLA Section 3.4.2 + Wind Generated Wave Action per COLA Figure 3.4-1 (only hydrodynamic portion)

General Notes:

- 1) Amplified Site-Specific SSE accounts for the influence of nearby heavy Reactor Building, Control Building, and/or UHS/RSW Pump House.
- 2) For stability under tornado loading with tornado missile, restraints are required at top of DGOT access regions.
- 3) NA: Not Applicable
- 4) Seismic wave propagation for DGOT is based on site-specific SSE because its layout is site-specific.

Table 3H.9-1 Extreme Environmental Design Parameters for Seismic Analysis, Design, Stability Evaluation and Seismic Category II/I Design

RAI 03.08.04-34, Supplement 2**QUESTION:**

10 CFR 50, Appendix A, GDC 2, requires that structures important to safety shall be designed to withstand the effects of natural phenomena with appropriate combination of the effects of normal and accident conditions. To meet this requirement, all seismic category I structures must be designed for required strength at all locations in the structure. During the October 2010 Audit the applicant presented the procedures to verify the concrete sections of the UHS/PH structural members resulting from the code-required load combinations. The internal forces (i.e. shear, moment, axial force, torsion, etc.) used to determine the required strength of the structural members (i.e. walls, slabs, beam, columns, etc.) of the UHS/PH building are generated by the applicant with the help of SAP2000 models simulating the building's static and dynamic behavior. These element forces are subsequently processed by the applicant with a number of in-house developed programs for design of concrete sections. It was noted that concrete slabs and walls were designed for out-of-plane shear by averaging the element shear forces across cut lines that extended along the entire width of the walls and slabs. The staff considers that averaging of out of plane shear along the entire cut line of a slab or wall could lead to unconservative estimate of shear stress in slabs. The subject was discussed with the applicant during the audit. Although the applicant explained the procedure by referencing to ACI 349-97, Section 11.12, "Special provisions for slabs and footings," it did not provide the staff with a sufficient interpretation of the provision of the ACI code, which appears to be intended for shear strength of slabs and footings in the vicinity of columns, concentrated loads, or reactions, to close this issue. ACI 349- 97, Section 13.3.1, states that a slab system may be designed by any procedure satisfying conditions of equilibrium and geometric compatibility, if shown that the design strength at every section is at least equal to the required strength. Averaging of out-of-plane shear across the entire width of a slab may not show that the design strength at every section is at least equal to the required strength. Therefore, in order for the staff to conclude that the site-specific structures are adequately designed for out-of plane shear, the staff requests STP to demonstrate that use of average shear force across the entire width of slab, instead of the shear force demand at every section obtained from analysis may be considered acceptable by any or more of the following:

- Obtain clarification from the ACI regarding validity of use of Section 11.12 of ACI 349-87 for the situations where the provisions of the code were used,
- Provide examples of any precedence where similar methodology was accepted by the staff,
- Provide detailed justification using industry accepted standards, technical references, experimental results, etc., to justify redistribution of the shear forces obtained from finite element analysis.

The applicant is also requested to update the FSAR as necessary.

SUPPLEMENTAL RESPONSE:

The original response to this RAI was submitted with Nuclear Innovation North America (NINA) letter U7-C-NINA-NRC-110050, dated April 5, 2011. This supplement provides the response to the following action item discussed in the NRC audits performed during the weeks of May 23, 2011 and July 25, 2011.

Beam shear discussion (Punch List Item 119):

Calculations will be revised and FSAR tables will be updated as a Confirmatory Action (Follow-up to Punch List Item 56, Audit Action Item 3.8-21)

Finite element analysis was used for design of the following structures:

- Ultimate Heat Sink (UHS)/Reactor Service Water (RSW) Pump House
- Diesel Generator Fuel Oil Tunnels (DGFOT)
- Diesel Generator Fuel Oil Storage Vaults (DGFOVS)
- Radwaste Building (RWB)

As noted in the original response, unless noted otherwise, design of these structures for out-of-plane shear have been conservatively revised based on finite element analysis results for each element without averaging the shear over several elements. The Supplement 1 response to this RAI submitted with NINA letter U7-C-NINA-NRC-110116, dated September 12, 2011 provided the summary of results for UHS/RSW Pump House and DGFOT. This supplemental response provides the summary of results for RWB and DGFOVS.

RWB:

No averaging has been used for out-of-plane shear design. Tables 3H.3-3 and 3H.3-4 and Figures 3H.3-8 through 3H.3-49 (see Enclosure) have been revised to reflect the results of this analysis and replace the existing tables and figures in the COLA.

DGFOVS:

No averaging has been used for out-of-plane shear design. Table 3H.6-11 and Figures 3H.6-142 through 3H.6-208 (see Enclosure) have been revised to reflect the results of this analysis and replace the existing tables and figures in the COLA.

As a result of this response COLA Part 2, Tier 2, Appendix 3H will be revised as shown in the Enclosure.

Enclosure

Mark-ups to COLA Revision 6

3H.6.7.2.1 Wall and Slab Design

For each reinforcement zone, the following in-plane and transverse shears with the corresponding load combination are reported in Table 3H.6-11. The in-plane shear is the maximum average in-plane shear along a plane that crosses the longitudinal reinforcement zone.

The shell forces from every element for every load combination in the finite element model were evaluated to determine the required transverse reinforcement. The transverse shear and axial force reported in Tables 3H.6-11 correspond to the maximum required transverse reinforcement for an element within that transverse reinforcement zone.

- The in-plane shear is the maximum average in-plane shear along a plane that crosses the longitudinal reinforcement zone.

- The transverse shear is the maximum average transverse shear along a plane in that transverse reinforcement zone.

3H.6.7.3.1 Uplift Analysis

The SAP2000 finite element models were checked for uplift effects by reviewing the joint reaction at the basemat. It was determined that under seismic loading the DGFOV experiences uplift. Using the 100%, 40%, 40% rule for combination of three seismic excitations, non-linear analysis was run on each model with uniform Winkler soil springs and pseudo-coupled soil springs to determine an enveloping adjustment factor for forces and moments from the linear analysis for the foundation mat and the connecting walls. The non-linear analysis iterates multiple times removing soil springs that go into tension during each iteration until no soil springs are in tension. For the directional earthquake loading required for the nonlinear analysis, the DGFOV critical loading, a safe shutdown earthquake (SSE) from the southwest in combination with static active and passive loads for SSE, is considered.

Comparing resultant foundation mat and wall reactions from the linear analysis with mat and wall reactions from the nonlinear analysis, there is a maximum reaction increase of approximately 22167% for the foundation mat out-of-plane shear forces, 0.1% increase for the foundation mat in-plane shear and axial forces, 21247% increase for the foundation mat bending moments, 4% increase for the connecting walls shear forces and axial forces, and 106% increase for the connecting walls shear forces, axial forces, and bending moments (enveloping cases with Winkler and pseudo-coupled soil springs) in the nonlinear analysis. To account for this, the resulting forces and moments from the linear analyses were adjusted by applying an increase factor of 3.21467 to out-of-plane shear all forces in the foundation mat, an increase factor of 1.1 to in-plane shear and axial forces in the foundation mat, an increase factor of 3.12417 to all moments in the foundation mat, an increase factor 1.07 to all forces in the connecting walls, and an increase factor 1.1406 to all forces and moments in the connecting walls for the DGFOV design.

Table 3H.3-3: Results of Radwaste Building Concrete Wall Design (Continued)

Location	Face	Direction (Horizontal and Vertical)	Reinforcement Layout Designation (Section #)	Thickness (ft)	Reinforcement Zone Number ⁽¹⁾	Maximum Force ⁽²⁾	Element	Longitudinal Reinforcement Design Loads				Longitudinal Reinforcement Provided (in ² /ft)	Transverse Shear Design Loads ⁽³⁾				Transverse Shear ⁽⁴⁾ Reinforcement Provided (in ² /ft)	Remarks				
								Axial and Flexure Loads		In-Plane Shear Loads			Load Combination	Horizontal Section		Vertical Section						
								Load Combination	Axial ⁽⁵⁾ (kips / ft)	Moment ⁽⁶⁾ (k-ft / ft)	Load Combination			In-plane Shear (kips / ft)	Transverse Shear Force (kips / ft)	Corresponding Axial Force (kips / ft)			Transverse Shear Force (kips / ft)	Corresponding Axial Force (kips / ft)		
North Wall		Transverse	3H-3-12	5.5	8-T	-	-	-	-	-	-	D + L + H + E'	-121	45	3	-44	0.20 (#4@12)	-				
					9-T	-	-	-	-	-	-	-	-	-	-	-	-	-	-	-		
					10-T	-	-	-	-	-	-	-	-	-	-	-	-	-	-	-	-	
					11-T	-	-	-	-	-	-	-	-	-	-	-	-	-	-	-	-	
South Wall	Near Side	Horizontal	3H-3-13	3	1-4L	MTCM 34573	1.4D + 1.7L + 1.7F + 1.7Es	52	4	1.4D + 1.7L + 1.7F + 1.7Es	67	1.58										
						MCCM 34147	1.4D + 1.7L + 1.7F + 1.7Es	-109	-48													
						MMAAT 12252	1.4D + 1.7L + 1.7F + 1.7Es	10	-113													
						MMAAC 26252	1.4D + 1.7L + 1.7F + 1.7Es	-11	-113													
					2-4L	MTCM 31845	1.4D + 1.7L + 1.7F + 1.7Es	953	-83	1.4D + 1.7L + 1.7F + 1.7Es	124	3.12										
						MCCM 25431	1.4D + 1.7L + 1.7F + 1.7Es	-198	-82													
						MMAAT 31092	1.4D + 1.7L + 1.7F + 1.7Es	11	-243													
						MMAAC 31092	1.4D + 1.7L + 1.7F + 1.7Es	-9	-243													
					3-4L	MTCM 34156	1.4D + 1.7L + 1.7F + 1.7Es	122	-66	1.4D + 1.7L + 1.7F + 1.7Es	124	4.65										
						MCCM 34156	1.4D + 1.7L + 1.7F + 1.7Es	-253	-66													
						MMAAT 26246	1.4D + 1.7L + 1.7F + 1.7Es	11	-318													
						MMAAC 26246	1.4D + 1.7L + 1.7F + 1.7Es	-104	-322													
				4-4L	MTCM 26237	1.4D + 1.7L + 1.7F + 1.7Es	111	-210	1.4D + 1.7L + 1.7F + 1.7Es	112	6.24											
					MCCM 26237	1.4D + 1.7L + 1.7F + 1.7Es	-270	-200														
					MMAAT 26238	1.4D + 1.7L + 1.7F + 1.7Es	30	-295														
					MMAAC 26238	1.4D + 1.7L + 1.7F + 1.7Es	-229	-332														
				4	5-4L	MTCM 23291	1.4D + 1.7L + 1.7F + 1.7Es	70	-118	1.4D + 1.7L + 1.7F + 1.7Es	135	3.12										
						MCCM 14926	1.4D + 1.7L + 1.7F + 1.7Es	-194	-252													
						MMAAT 23316	1.4D + 1.7L + 1.7F + 1.7Es	33	-196													
						MMAAC 63367	0 + L + H + E'	-87	-382													
					6-4L	MTCM 11561	1.4D + 1.7L + 1.7F + 1.7Es	39	-49	1.4D + 1.7L + 1.7F + 1.7Es	135	4.65										
						MCCM 14323	1.4D + 1.7L + 1.7F + 1.7Es	-196	-262													
						MMAAT 11561	0 + L + H + E'	7	-382													
						MMAAC 11570	0 + L + H + E'	-82	-379													
					7-4L	MTCM 23297	1.4D + 1.7L + 1.7F + 1.7Es	113	-344	1.4D + 1.7L + 1.7F + 1.7Es	115	6.24										
						MCCM 23257	1.4D + 1.7L + 1.7F + 1.7Es	-296	-491													
						MMAAT 23305	1.4D + 1.7L + 1.7F + 1.7Es	2	-430													
						MMAAC 23305	1.4D + 1.7L + 1.7F + 1.7Es	-67	-477													
				5.5	8-4L	MTCM 4125	1.4D + 1.7L + 1.7F + 1.7Es	27	-58	1.4D + 1.7L + 1.7F + 1.7Es	135	3.12										
						MCCM 8521	1.4D + 1.7L + 1.7F + 1.7Es	-224	-215													
						MMAAT 7745	1.4D + 1.7L + 1.7F + 1.7Es	1	-148													
						MMAAC 6903	0 + L + H + E'	-73	-425													
					9-4L	MTCM 2345	1.4D + 1.7L + 1.7F + 1.7Es	47	-87	1.4D + 1.7L + 1.7F + 1.7Es	160	4.68										
						MCCM 2142	1.4D + 1.7L + 1.7F + 1.7Es	-168	-241													
						MMAAT 2288	1.4D + 1.7L + 1.7F + 1.7Es	4	-194													
						MMAAC 3285	0 + L + H + E'	-109	-303													
					10-4L	MTCM 2345	1.4D + 1.7L + 1.7F + 1.7Es	62	-82	1.4D + 1.7L + 1.7F + 1.7Es	160	6.24										
						MCCM 8531	0 + L + H + E'	-355	-1157													
						MMAAT 2297	0 + L + H + E'	8	-403													
						MMAAC 8531	0 + L + H + E'	-355	-1185													

Table 3H.3-3: Results of Radwaste Building Concrete Wall Design (Continued)

Location	Face	Direction	Reinforcement Layout Drawing Number (1)	Thickness (ft)	Reinforcement Zone Number ⁽²⁾	Maximum Force ⁽³⁾	Element	Longitudinal Reinforcement Design Loads				Longitudinal Reinforcement Provided (in ² /ft)	Transverse Shear Design Loads ⁽⁴⁾				Transverse Shear ⁽⁵⁾ Reinforcement Provided (in ² /ft)	Remarks		
								Axial and Flexure Loads		In-Plane Shear Loads			Horizontal Section		Vertical Section					
								Load Combination	Actual ⁽⁶⁾ (kips / ft)	Flexure ⁽⁷⁾ (ft-kips / ft)	Load Combination		In-plane Shear ⁽⁸⁾ (kips / ft)	Load Combination	Transverse Shear Force (kips / ft)	Corresponding Axial Force (kips / ft)			Transverse Shear Force (kips / ft)	Corresponding Axial Force (kips / ft)
South Wall	Near Side	Vertical	3H-14	3	1-V-L	MTCM 25214	1.4D + 1.7L + 1.7W + 1.7Eo	23	-51	1.4D + 1.7L + 1.7W + 1.7Eo	130	3.12								
						MCCM 25584	1.4D + 1.7L + 1.7W + 1.7Eo	-259	-29											
						MMAT 31135	1.4D + 1.7L + 1.7W + 1.7Eo	7	-231											
						MMAC 31135	1.4D + 1.7L + 1.7W + 1.7Eo	-43	-231											
						MTCM 34164	1.4D + 1.7L + 1.7W + 1.7Eo	79	-203											
						MCCM 34156	1.4D + 1.7L + 1.7W + 1.7Eo	-187	-190											
						MMAT 32162	1.4D + 1.7L + 1.7W + 1.7Eo	51	-287											
						MMAC 32162	1.4D + 1.7L + 1.7W + 1.7Eo	-41	-287											
						MTCM 26220	1.4D + 1.7L + 1.7W + 1.7Eo	42	-216											
						MCCM 27076	1.4D + 1.7L + 1.7W + 1.7Eo	-197	-91											
						MMAT 26238 / 26239	1.4D + 1.7L + 1.7W + 1.7Eo	19	-496											
						MMAC 26238 / 26239	1.4D + 1.7L + 1.7W + 1.7Eo	-156	-493											
					MTCM 25225	D + L + W + E	24	-423												
					MCCM 27377	1.4D + 1.7L + 1.7W + 1.7Eo	-190	-74												
					MMAT 26229	1.4D + 1.7L + 1.7W + 1.7Eo	4	-505												
					MMAC 26229	1.4D + 1.7L + 1.7W + 1.7Eo	-120	-511												
					MTCM 26237	1.4D + 1.7L + 1.7W + 1.7Eo	112	-652												
					MCCM 26237	1.4D + 1.7L + 1.7W + 1.7Eo	-351	-604												
					MMAT 26237	1.4D + 1.7L + 1.7W + 1.7Eo	31	-899												
					MMAC 26237	1.4D + 1.7L + 1.7W + 1.7Eo	-351	-904												
					MTCM 26237 / 26238	D + L + W + E	70	-680												
					MCCM 26548 / 26549	1.4D + 1.7L + 1.7W + 1.7Eo	-262	-681												
					MMAT 26237 / 26238	1.4D + 1.7L + 1.7W + 1.7Eo	17	-620												
					MMAC 26237 / 26238	1.4D + 1.7L + 1.7W + 1.7Eo	-251	-625												
					MTCM 26542	D + L + W + E	112	-485												
					MCCM 28431	1.4D + 1.7L + 1.7W + 1.7Eo	-353	-254												
					MMAT 26556 / 26557	1.4D + 1.7L + 1.7W + 1.7Eo	5	-567												
					MMAC 26556 / 26557	1.4D + 1.7L + 1.7W + 1.7Eo	-14	-568												
					MTCM 11512	1.4D + 1.7L + 1.7W + 1.7Eo	182	-62												
					MCCM 11513	1.4D + 1.7L + 1.7W + 1.7Eo	-329	-65												
					MMAT 11518	D + L + W + E	19	-218												
					MMAC 16496	D + L + W + E	-152	-280												
					MTCM 23273	1.4D + 1.7L + 1.7W + 1.7Eo	109	-72												
					MCCM 16526	1.4D + 1.7L + 1.7W + 1.7Eo	-357	-66												
					MMAT 22077	1.4D + 1.7L + 1.7W + 1.7Eo	8	-411												
					MMAC 23078	1.4D + 1.7L + 1.7W + 1.7Eo	-149	-471												
					MTCM 11569	1.4D + 1.7L + 1.7W + 1.7Eo	115	-97												
					MCCM 11570	1.4D + 1.7L + 1.7W + 1.7Eo	-425	-209												
					MMAT 23304	1.4D + 1.7L + 1.7W + 1.7Eo	7	-432												
					MMAC 23304	1.4D + 1.7L + 1.7W + 1.7Eo	-151	-499												
					MTCM 22631	1.4D + 1.7L + 1.7W + 1.7Eo	91	-365												
					MCCM 22631	1.4D + 1.7L + 1.7W + 1.7Eo	-304	-533												
MMAT 23297	D + L + W + E	6	-732																	
MMAC 23297	1.4D + 1.7L + 1.7W + 1.7Eo	-236	-823																	

Table 3H.3-3: Results of Radwaste Building Concrete Wall Design (Continued)

Location	Face	Direction	Reinforcement Layout Drawing Number (1)	Thickness (ft)	Reinforcement Zone Number (2)	Minimum Force ⁽³⁾	Element	Longitudinal Reinforcement Design Loads				Longitudinal Reinforcement Provided (in ² /ft)	Transverse Shear Design Loads ⁽⁴⁾				Transverse Shear ⁽⁵⁾ Reinforcement Provided (in ² /ft)	Remarks																	
								Axial and Flexure Loads		In-Plane Shear Loads			Load Combination	In-plane Shear (kips / ft)	Horizontal Section				Vertical Section																
								Load Combination	Axial ⁽⁶⁾ (kips / ft)	Flexure ⁽⁴⁾ (ft-kips / ft)	Transverse Shear Force (kip / ft)				Corresponding Axial Force (kip / ft)	Transverse Shear Force (kip / ft)			Corresponding Axial Force (kip / ft)																
South Wall	Near Side	Vertical	3H-3-14	5.5	12-V-L	MITCM 4873	1.4D + 1.7L + 1.7F + 1.7Es	108	-129	1.4D + 1.7L + 1.7F + 1.7Es	164	3.12																							
						MCCM 3100	1.4D + 1.7L + 1.7F + 1.7Es	-347	-111																										
						MMAAT 3123	D + L + F + E	6	-275																										
						MMAAC 3102	D + L + F + E	-237	-281																										
						MITCM 4069	1.4D + 1.7L + 1.7F + 1.7Es	219	-83									1.4D + 1.7L + 1.7F + 1.7Es	235	4.68															
						MCCM 4069	1.4D + 1.7L + 1.7F + 1.7Es	-450	-121																										
						MMAAT 3124	D + L + F + E	15	-292																										
						MMAAC 3124	D + L + F + E	-213	-292																										
						MITCM 2287	1.4D + 1.7L + 1.7F + 1.7Es	301	-291																		1.4D + 1.7L + 1.7F + 1.7Es	285	6.24						
						MCCM 2287	1.4D + 1.7L + 1.7F + 1.7Es	-747	-323																										
						MMAAT 2292	D + L + F + E	18	-874																										
						MMAAC 2292	D + L + F + E	-298	-874																										
	MITCM 2330	1.4D + 1.7L + 1.7F + 1.7Es	114	-249	1.4D + 1.7L + 1.7F + 1.7Es	224	7.8																												
	MCCM 2330	1.4D + 1.7L + 1.7F + 1.7Es	-346	-254																															
	MMAAT 2328	D + L + F + E	33	-551																															
	MMAAC 2328	D + L + F + E	-217	-551																															
	MITCM 2348	1.4D + 1.7L + 1.7F + 1.7Es	296	-224										1.4D + 1.7L + 1.7F + 1.7Es	285	9.36																			
	MCCM 2348	1.4D + 1.7L + 1.7F + 1.7Es	-497	-400																															
	MMAAT 2343	D + L + F + E	20	-418																															
	MMAAC 2343	D + L + F + E	-277	-418																															
	MITCM 34675	1.4D + 1.7L + 1.7F + 1.7Es	52	18																			1.4D + 1.7L + 1.7F + 1.7Es	67	1.56										
	MCCM 34447	1.4D + 1.7L + 1.7F + 1.7Es	-109	96																															
	MMAAT 26252	1.4D + 1.7L + 1.7F + 1.7Es	11	104																															
	MMAAC 26252	1.4D + 1.7L + 1.7F + 1.7Es	-11	104																															
MITCM 24423	1.4D + 1.7L + 1.7F + 1.7Es	94	100	1.4D + 1.7L + 1.7F + 1.7Es	124	3.12																													
MCCM 24431	1.4D + 1.7L + 1.7F + 1.7Es	-198	93																																
MMAAT 26664	1.4D + 1.7L + 1.7F + 1.7Es	31	207																																
MMAAC 26664	1.4D + 1.7L + 1.7F + 1.7Es	-36	207																																
MITCM 26237	1.4D + 1.7L + 1.7F + 1.7Es	111	172										1.4D + 1.7L + 1.7F + 1.7Es	124	4.68																				
MCCM 26237	1.4D + 1.7L + 1.7F + 1.7Es	-270	161																																
MMAAT 30673	1.4D + 1.7L + 1.7F + 1.7Es	25	250																																
MMAAC 32673	1.4D + 1.7L + 1.7F + 1.7Es	-141	251																																
MITCM 32170	1.4D + 1.7L + 1.7F + 1.7Es	120	77																			1.4D + 1.7L + 1.7F + 1.7Es	45	6.24											
MCCM 31209	1.4D + 1.7L + 1.7F + 1.7Es	-200	321																																
MMAAT 31900	1.4D + 1.7L + 1.7F + 1.7Es	93	361																																
MMAAC 31900	1.4D + 1.7L + 1.7F + 1.7Es	-187	361																																
MITCM 34156	1.4D + 1.7L + 1.7F + 1.7Es	122	63	1.4D + 1.7L + 1.7F + 1.7Es	67	7.8																													
MCCM 34156	1.4D + 1.7L + 1.7F + 1.7Es	-299	84																																
MMAAT 34162	1.4D + 1.7L + 1.7F + 1.7Es	54	196																																
MMAAC 34162	1.4D + 1.7L + 1.7F + 1.7Es	-71	196																																
MITCM 23291	1.4D + 1.7L + 1.7F + 1.7Es	70	108										1.4D + 1.7L + 1.7F + 1.7Es	135	3.12																				
MCCM 11257	1.4D + 1.7L + 1.7F + 1.7Es	-190	114																																
MMAAT 23279	D + L + F + E	0	166																																
MMAAC 11518	D + L + F + E	-162	292																																
MITCM 23297	1.4D + 1.7L + 1.7F + 1.7Es	113	306																			1.4D + 1.7L + 1.7F + 1.7Es	115	6.24											
MCCM 23297	1.4D + 1.7L + 1.7F + 1.7Es	-296	190																																
MMAAT 23305	1.4D + 1.7L + 1.7F + 1.7Es	34	485																																
MMAAC 23305	1.4D + 1.7L + 1.7F + 1.7Es	-35	485																																

7/17

Table 3H.3-3: Results of Radwaste Building Concrete Wall Design (Continued)

Location	Face	Direction	Reinforcement Layout Drawing Number (1)	Thickness (ft)	Reinforcement Zone Number (2)	Maximum Force (3)	Element	Longitudinal Reinforcement Design Loads				Longitudinal Reinforcement Provided (in ² /ft)	Transverse Shear Design Loads (4)				Transverse Shear Reinforcement Provided (in ² /ft)	Remarks		
								Axial and Flexure Loads			In-Plane Shear Loads		Load Combination	Horizontal Section		Vertical Section				
								Load Combination	Axial (kips / ft)	Flexure (ft-kips / ft)	Load Combination			In-plane Shear (kips / ft)	Transverse Shear Force (kip / ft)	Corresponding Axial Force (kip / ft)			Transverse Shear Force (kip / ft)	Corresponding Axial Force (kip / ft)
South Wall	Far Side	Horizontal	3H.3-15	5.5	8-HL	MTCM 8514	1.4D + 1.7L + 1.7F + 1.7Ea	32	23	1.4D + 1.7L + 1.7F + 1.7Ea	135	3.12								
						MCCM 8521	1.4D + 1.7L + 1.7F + 1.7Ea	-224	128											
						MMAT 8515	1.4D + 1.7L + 1.7F + 1.7F	8	190											
						MMAC 8529	D + L + F + E'	-125	545											
						MTCM 2345	1.4D + 1.7L + 1.7F + 1.7Ea	47	85											
						MCCM 3141	1.4D + 1.7L + 1.7F + 1.7Ea	-153	250											
					9-HL	MMAT 6475	1.4D + 1.7L + 1.7F + 1.7Ea	7	184	1.4D + 1.7L + 1.7F + 1.7Ea	180	4.68								
						MMAC 6477	D + L + F + E'	-55	827											
						MTCM 25214	1.4D + 1.7L + 1.7F + 1.7Ea	83	83											
						MCCM 25584	1.4D + 1.7L + 1.7F + 1.7Ea	-289	58											
						MMAT 25788	1.4D + 1.7L + 1.7F + 1.7Ea	6	233											
						MMAC 25788	1.4D + 1.7L + 1.7F + 1.7Ea	-48	252											
		1-VL	MTCM 34184	1.4D + 1.7L + 1.7F + 1.7Ea	79	224	1.4D + 1.7L + 1.7F + 1.7Ea	130	3.12											
			MCCM 27676	1.4D + 1.7L + 1.7F	-200	65														
			MMAT 29803	1.4D + 1.7L + 1.7F + 1.7Ea	6	359														
			MMAC 31629	1.4D + 1.7L + 1.7F + 1.7Ea	-45	379														
			MTCM 32181	1.4D + 1.7L + 1.7F + 1.7Ea	42	453														
			MCCM 25239	1.4D + 1.7L + 1.7F	-182	194														
		2-VL	MTCM 31834	1.4D + 1.7L + 1.7F + 1.7Ea	1	415	1.4D + 1.7L + 1.7F + 1.7Ea	97	6.24											
			MMAT 31634	1.4D + 1.7L + 1.7F + 1.7Ea	-60	485														
			MMAC 32182	1.4D + 1.7L + 1.7F + 1.7Ea	56	560														
			MTCM 25244	1.4D + 1.7L + 1.7F	-181	96														
			MMAT 32182	1.4D + 1.7L + 1.7F + 1.7Ea	58	560														
			MMAC 32182	1.4D + 1.7L + 1.7F + 1.7Ea	-38	560														
	3-VL	MTCM 26542	D + L + F + E'	112	375	1.4D + 1.7L + 1.7F + 1.7Ea	62	12.48												
		MCCM 29431	1.4D + 1.7L + 1.7F + 1.7Ea	-303	237															
		MMAT 26542	1.4D + 1.7L + 1.7F + 1.7Ea	10	437															
		MMAC 26542	1.4D + 1.7L + 1.7F + 1.7Ea	-195	437															
		MTCM 26237 / 26238	1.4D + 1.7L + 1.7F + 1.7Ea	21	583															
		MCCM 26542 / 26543	1.4D + 1.7L + 1.7F + 1.7Ea	-282	434															
	4-VL	MMAT 26237 / 26238	1.4D + 1.7L + 1.7F + 1.7Ea	62	644	1.4D + 1.7L + 1.7F + 1.7Ea	68	12.48												
		MMAC 26237 / 26238	1.4D + 1.7L + 1.7F + 1.7Ea	-181	644															
		MTCM 11512	1.4D + 1.7L + 1.7F + 1.7Ea	111	63															
		MCCM 11513	1.4D + 1.7L + 1.7F + 1.7Ea	-389	80															
		MMAT 22079	1.4D + 1.7L + 1.7F + 1.7Ea	11	247															
		MMAC 22079	1.4D + 1.7L + 1.7F + 1.7Ea	-114	247															
	5-VL	MTCM 16528	1.4D + 1.7L + 1.7F + 1.7Ea	90	7	1.4D + 1.7L + 1.7F + 1.7Ea	213	3.12												
		MCCM 16528	D + L + F + E'	-315	23															
		MMAT 23304	1.4D + 1.7L + 1.7F + 1.7Ea	3	509															
		MMAC 23304	1.4D + 1.7L + 1.7F + 1.7Ea	-110	509															
		MTCM 11969	1.4D + 1.7L + 1.7F + 1.7Ea	115	67															
		MCCM 11560	1.4D + 1.7L + 1.7F + 1.7Ea	-425	42															
	6-VL	MMAT 23297	1.4D + 1.7L + 1.7F + 1.7Ea	43	520	1.4D + 1.7L + 1.7F + 1.7Ea	213	6.24												
		MMAC 23297	1.4D + 1.7L + 1.7F + 1.7Ea	-154	520															

Table 3H.3-3: Results of Radwaste Building Concrete Wall Design (Continued)

Location	Face	Direction	Reinforcement Layout Drawing Number	Thickness (ft)	Reinforcement Zone Number ⁽¹⁾	Maximum Force ⁽²⁾	Element	Longitudinal Reinforcement Design Loads				Longitudinal Reinforcement Provided (in ² /ft)	Transverse Shear Design Loads ⁽³⁾				Transverse Shear ⁽⁴⁾ Reinforcement Provided (in ² /ft)	Remarks																										
								Axial and Flexure Loads		In-Plane Shear Loads			Load Combination	Transverse Shear (kip / ft)	Horizontal Section				Vertical Section																									
								Load Combination	Axial (kip / ft)	Moment (ft-kip / ft)	Load Combination				Transverse Shear Force (kip / ft)	Corresponding Axial Force (kip / ft)			Transverse Shear Force (kip / ft)	Corresponding Axial Force (kip / ft)																								
South Wall	Far Side	Vertical	3H-3-16	5.5	10-V-L	MTCM	3085	1.4D + 1.7L + 1.7W + 1.7E _s	194	60	1.4D + 1.7L + 1.7W + 1.7E _s	234	4.68																															
						MCCM	2238	1.4D + 1.7L + 1.7W + 1.7E _s	594	172																																		
						MSAT	4762	0 + L + W + E	16	682																																		
						MSAC	6019	0 + L + W + E	-233	718																																		
						MTCM	2287	1.4D + 1.7L + 1.7W + 1.7E _s	301	67									1.4D + 1.7L + 1.7W + 1.7E _s	203	6.24																							
						MCCM	2237	1.4D + 1.7L + 1.7W + 1.7E _s	-747	221																																		
						MSAT	4781	0 + L + W + E	19	711																																		
						MSAC	4781	0 + L + W + E	-253	739																																		
						MTCM	2340	1.4D + 1.7L + 1.7W + 1.7E _s	296	61																				1.4D + 1.7L + 1.7W + 1.7E _s	285	7.8												
						MCCM	3143	1.4D + 1.7L + 1.7W + 1.7E _s	-463	103																																		
						MSAT	7762	0 + L + W + E	25	671																																		
						MSAC	7762	0 + L + W + E	-257	671																																		
	Transverse Diagonal and Vertical			3H-3-17	3	1-T	-	-	-	-	-	1.4D + 1.7L + 1.7W + 1.7E _s	-54	48	-29	18	0.20 (#4@12)	-																										
						2-T	-	-	-	-	-	0 + L + W + E	-59	57	-20	-18	0.31 (#5@12)	-																										
						3-T	-	-	-	-	-	1.4D + 1.7L + 1.7W + 1.7E _s	-48	208	-13	125	0.44 (#6@12)	-																										
						4-T	-	-	-	-	-	1.4D + 1.7L + 1.7W + 1.7E _s	-149	3	-101	-64	1.26 (#6@6)	-																										
						5-T	-	-	-	-	-	1.4D + 1.7L + 1.7W + 1.7E _s	-178	14	-125	-63	2.43 (#7@6)	-																										
						6-T	-	-	-	-	-	1.4D + 1.7L + 1.7W + 1.7E _s	91	-40	5	-83	0.20 (#4@12)	-																										
						7-T	-	-	-	-	-	0 + L + W + E	103	52	-4	-40	0.31 (#5@12)	-																										
						8-T	-	-	-	-	-	1.4D + 1.7L + 1.7W + 1.7E _s	136	-58	8	-69	0.44 (#6@12)	-																										
						9-T	-	-	-	-	-	0 + L + W + E	116	-7	94	-17	0.50 (#7@12)	-																										
						10-T	-	-	-	-	-	1.4D + 1.7L + 1.7W + 1.7E _s	736	-43	90	-84	1.24 (#5@9)	-																										
						11-T	-	-	-	-	-	1.4D + 1.7L + 1.7W + 1.7E _s	196	-59	168	-65	1.78 (#6@6)	-																										
						12-T	-	-	-	-	-	0 + L + W + E	-132	-16	0	-17	0.20 (#4@12)	-																										
13-T	-	-	-	-	-	0 + L + W + E	145	-40	18	-29	0.31 (#5@12)	-																																
14-T	-	-	-	-	-	0 + L + W + E	-191	-22	0	-13	0.44 (#6@12)	-																																
15-T	-	-	-	-	-	0 + L + W + E	180	-30	132	-71	0.60 (#7@12)	-																																
East Wall	Near Side	Horizontal	3H-3-18	3	1-H-L	MTCM	3229	1.4D + 1.7L + 1.7W + 1.7E _s	81	-12	1.4D + 1.7L + 1.7W + 1.7E _s	67	1.55																															
						MCCM	2508	1.4D + 1.7L + 1.7W + 1.7E _s	-73	-13																																		
						MSAT	2933	1.4D + 1.7L + 1.7W + 1.7E _s	11	-114																																		
						MSAC	2701	0 + L + W + E	-24	-134																																		
					MTCM	3143	1.4D + 1.7L + 1.7W + 1.7E _s	124	-21	1.4D + 1.7L + 1.7W + 1.7E _s									121	3.12																								
					MCCM	2534	0 + L + W + E	-92	-17																																			
					MSAT	3407	1.4D + 1.7L + 1.7W + 1.7E _s	23	-210																																			
					MSAC	3407	1.4D + 1.7L + 1.7W + 1.7E _s	-13	-210																																			
					MTCM	3192	1.4D + 1.7L + 1.7W + 1.7E _s	68	-37																				1.4D + 1.7L + 1.7W + 1.7E _s	121	4.63													
					MCCM	3192	1.4D + 1.7L + 1.7W + 1.7E _s	-126	-63																																			
					MSAT	8231	1.4D + 1.7L + 1.7W + 1.7E _s	21	-353																																			
					MSAC	25404	0 + L + W + E	-91	-308																																			
				MTCM	2347	1.4D + 1.7L + 1.7W + 1.7E _s	33	-80	1.4D + 1.7L + 1.7W + 1.7E _s		160	3.12																																
				MCCM	11576	0 + L + W + E	-181	-287																																				
				MSAT	23407	1.4D + 1.7L + 1.7W + 1.7E _s	28	-65																																				
				MSAC	11576	0 + L + W + E	-175	-295																																				
				MTCM	23499	1.4D + 1.7L + 1.7W + 1.7E _s	47	-97		1.4D + 1.7L + 1.7W + 1.7E _s									178	4.58																								
				MCCM	11649	0 + L + W + E	-199	-289																																				
				MSAT	23411	1.4D + 1.7L + 1.7W + 1.7E _s	3	-177																																				
				MSAC	11649	0 + L + W + E	-199	-289																																				

Table 3H.3-3: Results of Radwaste Building Concrete Wall Design (Continued)

Location	Face	Direction	Reinforcement Layout Drawing Number (1)	Thickness (ft)	Reinforcement Zone Number (2)	Maximum Force (3)	Element	Longitudinal Reinforcement Design Loads				Longitudinal Reinforcement Provided (in ² /ft)	Transverse Shear Design Loads (4)				Transverse Shear Reinforcement Provided (in ² /ft)	Remarks			
								Axial and Flexure Loads		In-Plane Shear Loads			Load Combination	Horizontal Section		Vertical Section					
								Load Combination	Actual (kips / ft)	Moment (k-ft)	In-plane Shear (kips / ft)			Transverse Shear Force (kips / ft)	Corresponding Axial Force (kips / ft)	Transverse Shear Force (kips / ft)			Corresponding Axial Force (kips / ft)		
East Wall	Near Side	Horizontal	3H-3-18	4	6-HL	MTCM	22108	1.4D + 1.7L + 1.7F + 1.7Es	22	-40	1.4D + 1.7L + 1.7F + 1.7Es	170	6.24								
						MCCM	13553	D + L + H + E	-111	-391											
						MMAT	22108	1.4D + 1.7L + 1.7F + 1.7Es	3	-188											
						MMAC	14587	D + L + H + E	-154	-418											
					7-HL	MTCM	22750	1.4D + 1.7L + 1.7F + 1.7Es	21	-209	1.4D + 1.7L + 1.7F + 1.7Es	170	7.8								
						MCCM	11851	D + L + H + E	-225	-209											
						MMAT	23413	D + L + H + E	9	-988											
						MMAC	10653	D + L + H + E	-148	-722											
					8-HL	MTCM	8470	1.4D + 1.7L + 1.7F + 1.7Es	12	-87	1.4D + 1.7L + 1.7F + 1.7Es	148	3.12								
						MCCM	8125	D + L + H + E	-240	-484											
						MMAT	5473	1.4D + 1.7L + 1.7F + 1.7Es	10	-83											
						MMAC	8125	D + L + H + E	-235	-473											
	9-HL	MTCM	2352	1.4D + 1.7L + 1.7F + 1.7Es	48	-34	1.4D + 1.7L + 1.7F + 1.7Es	181	4.68												
		MCCM	8890	D + L + H + E	-248	-509															
		MMAT	2352	1.4D + 1.7L + 1.7F + 1.7Es	5	-86															
		MMAC	8890	D + L + H + E	-243	-510															
	10-HL	MTCM	2348	1.4D + 1.7L + 1.7F + 1.7Es	55	-67	1.4D + 1.7L + 1.7F + 1.7Es	181	6.24												
		MCCM	7708	D + L + H + E	-254	-1025															
		MMAT	2348	D + L + H + E	0	-393															
		MMAC	6815	D + L + H + E	-242	-1028															
	11-HL	MTCM	2715	1.4D + 1.7L + 1.7F + 1.7Es	55	-82	1.4D + 1.7L + 1.7F + 1.7Es	181	8.36												
		MCCM	8892	D + L + H + E	-236	-816															
		MMAT	2715	1.4D + 1.7L + 1.7F + 1.7Es	2	-377															
		MMAC	8135	D + L + H + E	-270	-823															
Far Side	Vertical	3H-3-19	1-VL	MTCM	25538	1.4D + 1.7L + 1.7F + 1.7Es	75	-27	1.4D + 1.7L + 1.7F + 1.7Es	74	1.58										
				MCCM	25546	1.4D + 1.7L + 1.7F + 1.7Es	-268	-19													
				MMAT	25234	1.4D + 1.7L + 1.7F + 1.7Es	8	-104													
				MMAC	25234	1.4D + 1.7L + 1.7F + 1.7Es	-150	-161													
			2-VL	MTCM	25344	D + L + H + E	85	-29	1.4D + 1.7L + 1.7F + 1.7Es	85	3.12										
				MCCM	28353	1.4D + 1.7L + 1.7F + 1.7Es	-330	-34													
				MMAT	25304	D + L + H + E	12	-216													
				MMAC	25308	1.4D + 1.7L + 1.7F + 1.7Es	-227	-291													
			3-VL	MTCM	32279	1.4D + 1.7L + 1.7F + 1.7Es	106	-53	1.4D + 1.7L + 1.7F + 1.7Es	85	4.68										
				MCCM	26310	1.4D + 1.7L + 1.7F + 1.7Es	-225	-303													
				MMAT	33710	D + L + H + E	5	-270													
				MMAC	33710	1.4D + 1.7L + 1.7F + 1.7Es	-115	-351													
4-VL	MTCM	11578	1.4D + 1.7L + 1.7F + 1.7Es	129	-28	1.4D + 1.7L + 1.7F + 1.7Es	189	3.12													
	MCCM	11576	1.4D + 1.7L + 1.7F + 1.7Es	-484	-128																
	MMAT	18173	D + L + H + E	23	-195																
	MMAC	22708	1.4D + 1.7L + 1.7F + 1.7Es	-241	-282																
5-VL	MTCM	11851	1.4D + 1.7L + 1.7F + 1.7Es	145	-29	1.4D + 1.7L + 1.7F + 1.7Es	189	4.68													
	MCCM	11851	1.4D + 1.7L + 1.7F + 1.7Es	-474	-151																
	MMAT	14258	D + L + H + E	31	-354																
	MMAC	14284	1.4D + 1.7L + 1.7F + 1.7Es	-320	-428																

Table 3H.3-3: Results of Radwaste Building Concrete Wall Design (Continued)

Location	Face	Direction	Reinforcement Drawing Number (1)	Thickness (ft)	Reinforcement Zone Number (2)	Maximum Force (3)	Element	Longitudinal Reinforcement Design Loads				Longitudinal Reinforcement Provided (psf/ft)	Transverse Shear Design Loads (4)				Transverse Shear Reinforcement Provided (in ² /ft)	Remarks							
								Axial and Flexure Loads		In-Plane Shear Loads			Load Combination	Horizontal Section		Vertical Section									
								Load Combination	Actual (kips / ft)	Moment (kips / ft)	In-Plane Shear (kips / ft)			Transverse Shear Force (kips / ft)	Corresponding Axial Force (kips / ft)	Transverse Shear Force (kips / ft)			Corresponding Axial Force (kips / ft)						
East Wall	Near Side	Vertical	3H-3-19	5	6-V-L	MTCM	8532	1.4D + 1.7L + 1.7F + 1.7E _s	33	-6	1.4D + 1.7L + 1.7F + 1.7E _s	187	3.12												
						MCCM	4255	1.4D + 1.7L + 1.7F + 1.7E _s	-385	-51															
						MBAT	4250	1.4D + 1.7L + 1.7F + 1.7E _s	21	-118															
						MBAC	4255	1.4D + 1.7L + 1.7F + 1.7E _s	-176	-118															
						MTCM	4474	1.4D + 1.7L + 1.7F + 1.7E _s	111	-85				1.4D + 1.7L + 1.7F + 1.7E _s	215	4.68									
						MCCM	4474	1.4D + 1.7L + 1.7F + 1.7E _s	-400	-116															
						MBAT	4451	0 + L + H + E	16	-106															
						MBAC	4451	0 + L + H + E	-228	-199															
						MTCM	4497	1.4D + 1.7L + 1.7F + 1.7E _s	223	-27							1.4D + 1.7L + 1.7F + 1.7E _s	225	8.24						
						MCCM	4130	1.4D + 1.7L + 1.7F + 1.7E _s	-418	-48															
						MBAT	4135	0 + L + H + E	24	-184															
						MBAC	4125	0 + L + H + E	-363	-325															
	MTCM	2715	1.4D + 1.7L + 1.7F + 1.7E _s	321	-45	1.4D + 1.7L + 1.7F + 1.7E _s	187	7.8																	
	MCCM	2715	1.4D + 1.7L + 1.7F + 1.7E _s	-491	-105																				
	MBAT	2521	0 + L + H + E	1	-1107																				
	MBAC	2531	0 + L + H + E	-196	-1108																				
	MTCM	2345	1.4D + 1.7L + 1.7F + 1.7E _s	291	-143				1.4D + 1.7L + 1.7F + 1.7E _s	235	9.36														
	MCCM	2340	1.4D + 1.7L + 1.7F + 1.7E _s	-471	-344																				
	MBAT	2533	0 + L + H + E	10	-1063																				
	MBAC	2533	0 + L + H + E	-199	-1072																				
	Far Side	Horizontal	3H-3-20	3	4-H-L							MTCM	32260	1.4D + 1.7L + 1.7F + 1.7E _s	74	13	1.4D + 1.7L + 1.7F + 1.7E _s	67	1.56						
												MCCM	32752	1.4D + 1.7L + 1.7F + 1.7E _s	-45	19									
												MBAT	2549	1.4D + 1.7L + 1.7F + 1.7E _s	0	121									
												MBAC	2549	1.4D + 1.7L + 1.7F + 1.7E _s	-23	121									
MTCM						31453	1.4D + 1.7L + 1.7F + 1.7E _s	124				40	1.4D + 1.7L + 1.7F + 1.7E _s	121	3.12										
MCCM						25384	0 + L + H + E	-62				39													
MBAT						34108	1.4D + 1.7L + 1.7F + 1.7E _s	8				237													
MBAC						34108	1.4D + 1.7L + 1.7F + 1.7E _s	-19				237													
MTCM						31192	1.4D + 1.7L + 1.7F + 1.7E _s	168	61	1.4D + 1.7L + 1.7F + 1.7E _s	63	4.68													
MCCM						31192	1.4D + 1.7L + 1.7F + 1.7E _s	-126	62																
MBAT						34107	1.4D + 1.7L + 1.7F + 1.7E _s	14	272																
MBAC						34107	1.4D + 1.7L + 1.7F + 1.7E _s	-22	272																
4	4-H-L	MTCM	23408	1.4D + 1.7L + 1.7F + 1.7E _s	47	62	1.4D + 1.7L + 1.7F + 1.7E _s	180	3.12																
		MCCM	11570	0 + L + H + E	-175	200																			
		MBAT	23408	1.4D + 1.7L + 1.7F + 1.7E _s	1	159																			
		MBAC	13561	0 + L + H + E	-102	314																			
	5-H-L	MTCM	14415	1.4D + 1.7L + 1.7F + 1.7W	10	17							1.4D + 1.7L + 1.7F + 1.7E _s	178	4.68										
		MCCM	14407	0 + L + H + E	-152	22																			
		MBAT	14380	1.4D + 1.7L + 1.7F + 1.7E _s	1	23																			
		MBAC	14345	0 + L + H + E	-91	162																			
	6-H-L	MTCM	14334	1.4D + 1.7L + 1.7F + 1.7W	17	23				1.4D + 1.7L + 1.7F + 1.7E _s	178	6.24													
		MCCM	14333	0 + L + H + E	-102	175																			
		MBAT	14801	1.4D + 1.7L + 1.7F + 1.7E _s	4	71																			
		MBAC	14805	0 + L + H + E	-86	382																			

Table 3H.3-3: Results of Radwaste Building Concrete Wall Design (Continued)

Location	Face	Direction	Reinforcement Drawing Number (1)	Thickness (ft)	Reinforcement Zone Number (2)	Maximum Force (3)	Element	Longitudinal Reinforcement Design Loads				Longitudinal Reinforcement Provided (in ² /ft)	Transverse Shear Design Loads (4)				Transverse Shear ⁽⁵⁾ Reinforcement Provided (in ² /ft)	Remarks			
								Axial and Flexure Loads			In-Plane Shear Loads		Horizontal Section		Vertical Section						
								Load Combination	Axial (kips / ft)	Flexure (ft-kips / ft)	Load Combination		In-Plane Shear (kips / ft)	Load Combination	Transverse Shear Force (kips / ft)	Corresponding Axial Force (kips / ft)			Load Combination	Transverse Shear Force (kips / ft)	Corresponding Axial Force (kips / ft)
West Wall	Near Side	Vertical	3H-3-24	4	4-V-L	MTCM	11573	1.4D + 1.7L + 1.7F + 1.7E _s	178	-83	1.4D + 1.7L + 1.7F + 1.7E _s	212	4.68								
						MCCM	11573	1.4D + 1.7L + 1.7F + 1.7E _s	-589	-314											
						MSAT	23345	D + L + F + E	3	-375											
						MSAC	23345	D + L + F + E	-128	-411											
					5-V-L	MTCM	22598	D + L + F + E	45	-55	1.4D + 1.7L + 1.7F + 1.7E _s	212	6.24								
						MCCM	22131	1.4D + 1.7L + 1.7F + 1.7E _s	-204	-129											
						MSAT	23381	D + L + F + E	0	-348											
						MSAC	23387	1.4D + 1.7L + 1.7F + 1.7E _s	-165	-377											
					6-V-L	MTCM	5196	1.4D + 1.7L + 1.7F + 1.7E _s	71	-29	1.4D + 1.7L + 1.7F + 1.7E _s	152	3.12								
						MCCM	4195	1.4D + 1.7L + 1.7F + 1.7E _s	-309	-25											
						MSAT	4195	D + L + F + E	12	-139											
						MSAC	4312	D + L + F + E	-168	-158											
	7-V-L	MTCM	4132	1.4D + 1.7L + 1.7F + 1.7E _s	183	-35	1.4D + 1.7L + 1.7F + 1.7E _s	205	4.68												
		MCCM	4132	1.4D + 1.7L + 1.7F + 1.7E _s	-558	-36															
		MSAT	8528	1.4D + 1.7L + 1.7F + 1.7E _s	18	-215															
		MSAC	8525	1.4D + 1.7L + 1.7F + 1.7E _s	-418	-270															
	8-V-L	MTCM	4129	1.4D + 1.7L + 1.7F + 1.7E _s	208	-19	1.4D + 1.7L + 1.7F + 1.7E _s	149	6.24												
		MCCM	4129	1.4D + 1.7L + 1.7F + 1.7E _s	-423	-103															
		MSAT	8534	1.4D + 1.7L + 1.7F + 1.7E _s	5	-211															
		MSAC	8534	D + L + F + E	-332	-251															
	9-V-L	MTCM	2347	1.4D + 1.7L + 1.7F + 1.7E _s	312	-83	1.4D + 1.7L + 1.7F + 1.7E _s	205	7.8												
		MCCM	2347	1.4D + 1.7L + 1.7F + 1.7E _s	-741	-178															
		MSAT	2443	D + L + F + E	55	-750															
		MSAC	2582	D + L + F + E	-184	-775															
Far Side	Horizontal	3H-3-25	3	1-H-L	MTCM	31715	1.4D + 1.7L + 1.7F + 1.7E _s	46	22	1.4D + 1.7L + 1.7F + 1.7E _s	75	1.56									
					MCCM	31715	1.4D + 1.7L + 1.7F + 1.7E _s	-65	16												
					MSAT	31559	1.4D + 1.7L + 1.7F + 1.7E _s	25	94												
					MSAC	31559	1.4D + 1.7L + 1.7F + 1.7E _s	-32	94												
				2-H-L	MTCM	32237	1.4D + 1.7L + 1.7F + 1.7E _s	83	53	1.4D + 1.7L + 1.7F + 1.7E _s	108	3.12									
					MCCM	32243	1.4D + 1.7L + 1.7F + 1.7E _s	-87	49												
					MSAT	31152	1.4D + 1.7L + 1.7F + 1.7E _s	29	171												
					MSAC	31152	1.4D + 1.7L + 1.7F + 1.7E _s	-38	171												
				3-H-L	MTCM	22898	1.4D + 1.7L + 1.7F + 1.7E _s	25	14	1.4D + 1.7L + 1.7F + 1.7E _s	143	3.12									
					MCCM	18550	D + L + F + E	-225	178												
					MSAT	11625	1.4D + 1.7L + 1.7F + 1.7E _s	2	142												
					MSAC	18825	D + L + F + E	-70	303												
4-H-L	MTCM	23343	1.4D + 1.7L + 1.7F + 1.7E _s	87	146	1.4D + 1.7L + 1.7F + 1.7E _s	143	6.24													
	MCCM	23343	D + L + F + E	-86	126																
	MSAT	23343	1.4D + 1.7L + 1.7F + 1.7E _s	39	221																
	MSAC	23343	1.4D + 1.7L + 1.7F + 1.7E _s	-68	221																
5-H-L	MTCM	4190	1.4D + 1.7L + 1.7F + 1.7E _s	28	34	1.4D + 1.7L + 1.7F + 1.7E _s	135	3.12													
	MCCM	8891	D + L + F + E	-239	178																
	MSAT	8720	1.4D + 1.7L + 1.7F + 1.7E _s	9	96																
	MSAC	8804	D + L + F + E	-174	500																
6-H-L	MTCM	2711	1.4D + 1.7L + 1.7F + 1.7E _s	53	14	1.4D + 1.7L + 1.7F + 1.7E _s	184	4.58													
	MCCM	3198	1.4D + 1.7L + 1.7F + 1.7E _s	-189	143																
	MSAT	3295	D + L + F + E	7	64																
	MSAC	3295	D + L + F + E	-129	258																

Table 3H.3-3: Results of Radwaste Building Concrete Wall Design (Continued)

Location	Face	Direction	Reinforcement Drawing Number (1)	Thickness (ft)	Reinforcement Zone Number (2)	Maximum Force (3)	Element	Longitudinal Reinforcement Design Loads				Longitudinal Reinforcement Provided (in ² /ft)	Transverse Shear Design Loads (4)				Transverse Shear Reinforcement Provided (in ² /ft)	Remarks							
								Axial and Flexure Loads		In-Plane Shear Loads			Load Combination	Horizontal Section		Vertical Section									
								Load Combination	Axial (kips / ft)	Flexure (ft-k)	Load Combination			In-Plane Shear (kips / ft)	Transverse Shear Force (kip / ft)	Corresponding Axial Force (kip / ft)			Transverse Shear Force (kip / ft)	Corresponding Axial Force (kip / ft)					
West Wall	Far Side	Vertical	3H-3-26	3	1-V-L	MTCM 29044	1.4D + 1.7L + 1.7F + 1.7E _s	62	46	1.4D + 1.7L + 1.7F + 1.7E _s	77	1.56													
						MCCM 29050	1.4D + 1.7L + 1.7F + 1.7E _s	-121	33																
						MMAT 32206	1.4D + 1.7L + 1.7F + 1.7E _s	3	101																
						MMAC 32206	1.4D + 1.7L + 1.7F + 1.7E _s	-11	101																
					2-V-L	MTCM 25402	1.4D + 1.7L + 1.7F + 1.7E _s	111	30	1.4D + 1.7L + 1.7F + 1.7E _s	90	3.12													
						MCCM 25402	1.4D + 1.7L + 1.7F + 1.7E _s	-363	33																
						MMAT 25690	D + L + H + E	4	196																
						MMAC 25690	1.4D + 1.7L + 1.7F + 1.7E _s	-55	220																
					3-V-L	MTCM 26300	1.4D + 1.7L + 1.7F + 1.7E _s	43	122	1.4D + 1.7L + 1.7F + 1.7E _s	90	4.68													
						MCCM 26377	1.4D + 1.7L + 1.7F + 1.7E _s	-143	164																
						MMAT 26344	1.4D + 1.7L + 1.7F + 1.7E _s	9	282																
						MMAC 26344	1.4D + 1.7L + 1.7F + 1.7E _s	-57	309																
				4-V-L	MTCM 13204	1.4D + 1.7L + 1.7F + 1.7E _s	123	39	1.4D + 1.7L + 1.7F + 1.7E _s	177	3.12														
					MCCM 13204	1.4D + 1.7L + 1.7F + 1.7E _s	-457	64																	
					MMAT 14385	D + L + H + E	8	253																	
					MMAC 14385	D + L + H + E	-180	254																	
				5-V-L	MTCM 11573	1.4D + 1.7L + 1.7F + 1.7E _s	178	97	1.4D + 1.7L + 1.7F + 1.7E _s	212	1.68														
					MCCM 11573	1.4D + 1.7L + 1.7F + 1.7E _s	-529	57																	
					MMAT 11623	D + L + H + E	2	238																	
					MMAC 11597	D + L + H + E	-232	234																	
				6-V-L	MTCM 2350	1.4D + 1.7L + 1.7F + 1.7E _s	214	74	1.4D + 1.7L + 1.7F + 1.7E _s	205	1.68														
					MCCM 2350	1.4D + 1.7L + 1.7F + 1.7E _s	-587	50																	
					MMAT 5186	D + L + H + E	8	340																	
					MMAC 6247	D + L + H + E	-158	369																	
				7-V-L	MTCM 2402	1.4D + 1.7L + 1.7F + 1.7E _s	112	27	1.4D + 1.7L + 1.7F + 1.7E _s	179	6.24														
					MCCM 3180	1.4D + 1.7L + 1.7F + 1.7E _s	-425	190																	
					MMAT 5191	D + L + H + E	12	307																	
					MMAC 4190	D + L + H + E	-291	309																	
				8-V-L	MTCM 2347	1.4D + 1.7L + 1.7F + 1.7E _s	312	90	1.4D + 1.7L + 1.7F + 1.7E _s	149	7.8														
					MCCM 2347	1.4D + 1.7L + 1.7F + 1.7E _s	-735	91																	
					MMAT 8534	1.4D + 1.7L + 1.7F + 1.7E _s	5	219																	
					MMAC 8534	1.4D + 1.7L + 1.7F + 1.7E _s	-211	219																	
				Transverse (Horizontal and Vertical)			3H-3-27	3	3-T	-	-	-	-	-	-	1.4D + 1.7L + 1.7F + 1.7E _s	18	20	21	118	0.20 (F5@12)	-			
									3-T	-	-	-	-	-	-	-	-	-	1.4D + 1.7L + 1.7F + 1.7E _s	47	10	44	28	0.31 (F5@12)	-
									4-T	-	-	-	-	-	-	-	-	-	D + L + H + E	6	-63	-61	-69	0.20 (F4@12)	-
									4-T	-	-	-	-	-	-	-	-	-	D + L + H + E	-1	-68	-115	-110	0.31 (F5@12)	-
5-T	-	-	-						-	-	-	-	-	-	D + L + H + E	-1	-66	125	-69	0.44 (F6@12)	-				
5-T	-	-	-						-	-	-	-	-	-	D + L + H + E	-135	-25	126	-364	0.79 (F6@12)	-				
4	4-T	-	-					-	-	-	-	-	-	-	D + L + H + E	-188	-66	-171	-259	1.78 (F6@9)	-				
	4-T	-	-					-	-	-	-	-	-	-	D + L + H + E	18	-40	84	-110	0.20 (F4@12)	-				
	5-T	-	-					-	-	-	-	-	-	-	D + L + H + E	-125	31	-12	-15	0.31 (F5@12)	-				
	5-T	-	-					-	-	-	-	-	-	-	D + L + H + E	-95	-6	-2	-17	0.44 (F6@12)	-				
	10-T	-	-					-	-	-	-	-	-	-	D + L + H + E	-42	-58	-122	185	0.20 (F7@12)	-				
	12-T	-	-					-	-	-	-	-	-	-	D + L + H + E	147	-22	-29	-251	1.24 (F6@9)	-				

Table 3H.3-3: Results of Radwaste Building Concrete Wall Design (Continued)

- Notes:
- (1) The reinforcement layout drawings show the various zones used to define the minimum reinforcement that will be provided based on finite element analysis results. Actual provided reinforcement based on final rebar layout and including development length may exceed the reported provided reinforcement and the zones with higher reinforcement may be extended beyond their reported boundaries. The dimensions in the reinforcement drawings are based on the dimensions of the SAP2000 shell elements, which are modeled at the centerline of the walls and slabs. Therefore, the reinforcement drawing dimensions do not match actual building dimensions.
 - (2) Each reinforcement layout drawing is divided into reinforcement zones. The reinforcement zone naming convention is as follows: "H" = horizontal, "V" = vertical, "L" = longitudinal reinforcement, "T" = transverse reinforcement. For slabs, vertical corresponds to North-South direction and horizontal corresponds to East-West direction.
 - (3) The maximum tension (MTCA) and compression (MCCA) axial forces are provided with the corresponding moment from the same load combination. The maximum moment that has a corresponding torsion (MMAT) in the same load combination and the maximum moment that has a corresponding compression (MMAC) in the same load combination are also provided. For the roof, the maximum tension and maximum moment (MTMA) are reported.
 - (4) Negative axial load is compression and positive axial load is tension. Negative moment applies tension to the top face of the shell element and positive moment applies tension to the bottom face of the shell element. For walls or slabs where the same reinforcement is provided on both faces, the moment is shown as absolute value. The axial and flexural loads reported in the table are the average of the 2 node pairs that form the 4 edges of the critical rectangular shell element. If the 2 node pairs on the shell element edges parallel to the reinforcement direction do not satisfy FEM interaction criteria, then only the 2 node pairs on the shell element edges perpendicular to the reinforcement direction are used for design (effective width considered). The element mesh is sufficiently refined for this design approach.
 - (5) The reported in-plane shear is the maximum average in-plane shear along a plane that crosses the longitudinal reinforcement zone.
 - (6) The transverse shear reinforcement loads are reported for the critical element requiring the largest area of steel for transverse reinforcement within the zone. The shear force and the corresponding axial force in the same load combination for each direction is reported for the critical element.
 - (7) The reported transverse shear reinforcement is the summation of the required shear reinforcement in the horizontal direction and the required shear reinforcement in the vertical direction.
 - (8) For certain areas of the structure, the standard element post-processing methods were too conservative. For such cases, detailed manual design was performed and the design forces determined by the detailed manual design are provided in the table.
 - (9) The longitudinal reinforcement shown is required to be tied.
 - (10) The reported forces are from the FEM analysis. The provided longitudinal reinforcement includes additional reinforcement required due to manual one-way design calculations.
 - (11) The reported axial and in-plane forces are from the FEM analysis. The reported flexural forces are from manual one-way design calculations.

Table 3H.3-4: Results of Radwaste Building Concrete Slab Design

Location	Face	Direction	Reinforcement Layout Drawing Number (1)	Thickness (ft)	Reinforcement Zone Number ²	Maximum Force ³	Element	Longitudinal Reinforcement Design Loads				Longitudinal Reinforcement Provided (m ² /ft)	Transverse Shear Design Loads ⁴				Transverse Shear ⁵ Reinforcement Provided (m ² /ft)	Remarks	
								Axial and Flexure Loads			Load Combination		In-Plane Shear (kips / ft)	Horizontal Section		Vertical Section			
								Load Combination	Axial ⁶ (kips / ft)	Moment ⁶ (ft-kips / ft)				Transverse Shear Force (kips / ft)	Corresponding Axial Force (kips / ft)	Transverse Shear Force (kips / ft)			Corresponding Axial Force (kips / ft)
Foundation Mat	Near Side	Horizontal	3H.3-28	12	1-1/L	MTOM	1209	0 - L + N + E	29	-218	1.4D + 1.7L + 1.7M + 1.7E _s	68	6.21						
						MCCM	1073	1.4D + 1.7L + 1.7M + 1.7E _s	-128	-54									
						MBAT	277	1.4D + 1.7L + 1.7M + 1.7E _s	1	-1162									
						MBAC	514	1.4D + 1.7L + 1.7M + 1.7E _s	-25	-1180									
						MTOM	29155	1.4D + 1.7L + 1.7M + 1.7E _s	66	-63									
						MCCM	25899	1.4D + 1.7L + 1.7M + 1.7E _s	-102	-273									
		MBAT	38850	1.4D + 1.7L + 1.7M + 1.7E _s	21	-1377													
		MBAC	28850	1.4D + 1.7L + 1.7M + 1.7E _s	-28	-1377													
		Vertical	3H.3-29	12	1-1/L	MTOM	944	1.4D + 1.7L + 1.7M + 1.7E _s	42	-176	1.4D + 1.7L + 1.7M + 1.7E _s	66	6.24						
						MCCM	820	0 - L + N + E	-189	-126									
						MBAT	850	1.4D + 1.7L + 1.7M + 1.7E _s	67	-1136									
						MBAC	28810	1.4D + 1.7L + 1.7M + 1.7E _s	-28	-1299									
	MTOM					27825	1.4D + 1.7L + 1.7M + 1.7E _s	125	-1815										
	MCCM					27825	1.4D + 1.7L + 1.7M + 1.7E _s	-108	-643										
	MBAT	27825	1.4D + 1.7L + 1.7M + 1.7E _s	125	-1815														
	MBAC	27825	1.4D + 1.7L + 1.7M + 1.7E _s	-43	-1815														
	Far Side	Horizontal	3H.3-30	12	1-1/L	MTOM	29556	1.4D + 1.7L + 1.7M + 1.7E _s	63	1405	1.4D + 1.7L + 1.7M + 1.7E _s	68	6.24						
						MCCM	933	1.4D + 1.7L + 1.7M + 1.7E _s	-72	1593									
						MBAT	415	1.4D + 1.7L + 1.7M + 1.7E _s	26	1578									
						MBAC	933	1.4D + 1.7L + 1.7M + 1.7E _s	-67	1823									
						MTOM	653	0 - L + N + E	63	1642									
						MCCM	645	1.4D + 1.7L + 1.7M + 1.7E _s	-18	480									
		MBAT	463	1.4D + 1.7L + 1.7M + 1.7E _s	1	2329													
		MBAC	654	1.4D + 1.7L + 1.7M + 1.7E _s	-87	2510													
Vertical		3H.3-31	12	1-1/L	MTOM	27264	0 - L + N + E	114	1049	1.4D + 1.7L + 1.7M + 1.7E _s	68	9.36							
					MCCM	27345	1.4D + 1.7L + 1.7M + 1.7E _s	-227	2252										
					MBAT	29849	1.4D + 1.7L + 1.7M + 1.7E _s	34	2642										
					MBAC	27347	1.4D + 1.7L + 1.7M + 1.7E _s	-207	3199										
	MTOM				29157	1.4D + 1.7L + 1.7M + 1.7E _s	91	834											
	MCCM				29159	1.4D + 1.7L + 1.7M + 1.7E _s	-108	1429											
MBAT	28155	1.4D + 1.7L + 1.7M + 1.7E _s	15	2252															
MBAC	28155	1.4D + 1.7L + 1.7M + 1.7E _s	-134	3259															
Transverse (Horizontal and Vertical)	Horizontal	3H.3-32	12	1-1	MTOM	890	1.4D + 1.7L + 1.7M + 1.7E _s	67	1062	1.4D + 1.7L + 1.7M + 1.7E _s	66	6.23							
					MCCM	293	1.4D + 1.7L + 1.7M + 1.7E _s	-190	2096										
					MBAT	890	1.4D + 1.7L + 1.7M + 1.7E _s	25	1886										
					MBAC	890	1.4D + 1.7L + 1.7M + 1.7E _s	-190	2096										
					MTOM	1291	0 - L + N + E	93	1051										
					MCCM	32363	1.4D + 1.7L + 1.7M + 1.7E _s	-171	1458										
	MBAT	32362	1.4D + 1.7L + 1.7M + 1.7E _s	7	2038														
	MBAC	32363	1.4D + 1.7L + 1.7M + 1.7E _s	-163	2104														
	Vertical	3H.3-32	12	2-1	MTOM	28433	0 - L + N + E	92	437	1.4D + 1.7L + 1.7M + 1.7E _s	66	9.36							
					MCCM	72	0 - L + N + E	-228	2034										
					MBAT	32371	1.4D + 1.7L + 1.7M + 1.7E _s	29	3045										
					MBAC	20	1.4D + 1.7L + 1.7M + 1.7E _s	-144	2912										
MTOM					27825	1.4D + 1.7L + 1.7M + 1.7E _s	125	1172											
MCCM					27825	1.4D + 1.7L + 1.7M + 1.7E _s	-224	3713											
MBAT	27825	1.4D + 1.7L + 1.7M + 1.7E _s	6	3675															
MBAC	27825	1.4D + 1.7L + 1.7M + 1.7E _s	-224	3713															
											1.4D + 1.7L + 1.7M + 1.7E _s	21	32	238	0	0.20 (#4@12)			
											1.4D + 1.7L + 1.7M + 1.7E _s	178	41	268	-31	0.31 (#5@12)			

Table 3H.3-4: Results of Radwaste Building Concrete Slab Design (Continued)

Location	Face	Direction	Reinforcement Layout Drawing Number (1)	Thickness (ft)	Reinforcement Zone Number (2)	Maximum Force (3)	Element	Longitudinal Reinforcement Design Loads				Longitudinal Reinforcement Provided (in ² /ft)	Transverse Shear Design Loads (4)				Transverse Shear ⁽⁵⁾ Reinforcement Provided (in ² /ft)	Remarks				
								Axial and Flexure Loads		In-Plane Shear Loads			Load Combination	In-plane Shear (kips/ft)	Horizontal Section				Vertical Section			
								Load Combination	Axial (kips/ft)	Flexure (ft-kips/ft)	Transverse Shear Force (kip/ft)				Corresponding Axial Force (kip/ft)	Transverse Shear Force (kip/ft)			Corresponding Axial Force (kip/ft)			
EL 36'±	Near Side	Horizontal	3H.3-33	5	1-HL	MTGM	37891	1.4D + 1.7L + 1.7W + 1.7Ea	88	-45	1.4D + 1.7L + 1.7W + 1.7Ea	122	3.12									
						MCCM	37891	1.4D + 1.7L + 1.7W + 1.7Ea	-291	-110												
						BMAT	38339	1.4D + 1.7L + 1.7W + 1.7Ea	1	-266												
						BMAC	38166	1.4D + 1.7L + 1.7W + 1.7Ea	-198	-354												
					2-HL	MTGM	38329	1.4D + 1.7L + 1.7W + 1.7Ea	64	-298	1.4D + 1.7L + 1.7W + 1.7Ea	197	4.68									
					MCCM	38144	1.4D + 1.7L + 1.7W + 1.7Ea	-324	-300													
					BMAT	38345	1.4D + 1.7L + 1.7W + 1.7Ea	19	-405													
					BMAC	38231	1.4D + 1.7L + 1.7W + 1.7Ea	-78	-386													
					3-HL	MTGM	37838	1.4D + 1.7L + 1.7W + 1.7Ea	67	-144	1.4D + 1.7L + 1.7W + 1.7Ea	73	6.24									
					MCCM	37838	1.4D + 1.7L + 1.7W + 1.7Ea	-302	-427													
					BMAT	37833	0 - L + W + E	13	-428													
					BMAC	37835	1.4D + 1.7L + 1.7W + 1.7Ea	-273	-434													
		4	4-HL	MTGM	38193	1.4D + 1.7L + 1.7W + 1.7Ea	61	4	1.4D + 1.7L + 1.7W + 1.7Ea	97	3.12											
		MCCM	37826	1.4D + 1.7L + 1.7W + 1.7Ea	-203	-188																
		BMAT	37773	1.4D + 1.7L + 1.7W + 1.7Ea	3	-308																
		BMAC	37788	1.4D + 1.7L + 1.7W + 1.7Ea	-49	-347																
		2	5-HL	MTGM	25335	1.4D + 1.7L + 1.7W + 1.7Ea	73	-19	1.4D + 1.7L + 1.7W + 1.7Ea	102	3.12											
		MCCM	25335	1.4D + 1.7L + 1.7W + 1.7Ea	-195	-30																
		BMAT	39026	1.4D + 1.7L + 1.7W + 1.7Ea	6	-115																
		BMAC	39028	1.4D + 1.7L + 1.7W + 1.7Ea	-41	-115																
		EL 36'±	Near Side	Vertical	3H.3-34	5	1-VL	MTGM	35834	1.4D + 1.7L + 1.7W + 1.7Ea	50	-48	1.4D + 1.7L + 1.7W + 1.7Ea	72	3.12							
								MCCM	35394	0 - L + W + E	-143	-143										
								BMAT	35395	1.4D + 1.7L + 1.7W + 1.7Ea	27	-190										
								BMAC	35395	1.4D + 1.7L + 1.7W + 1.7Ea	-114	-223										
2-VL	MTGM						36092	1.4D + 1.7L + 1.7W + 1.7Ea	145	-199	1.4D + 1.7L + 1.7W + 1.7Ea	52	4.68									
MCCM	37024						0 - L + W + E	-184	-164													
BMAT	34304						1.4D + 1.7L + 1.7W + 1.7Ea	2	-371													
BMAC	37023						1.4D + 1.7L + 1.7W + 1.7Ea	-177	-531													
3-VL	MTGM						35810	1.4D + 1.7L + 1.7W + 1.7Ea	180	-135	1.4D + 1.7L + 1.7W + 1.7Ea	72	6.24									
MCCM	35810						1.4D + 1.7L + 1.7W + 1.7Ea	-319	-37													
BMAT	35273						1.4D + 1.7L + 1.7W + 1.7Ea	34	-500													
BMAC	37824						1.4D + 1.7L + 1.7W + 1.7Ea	-187	-764													
4	4-VL			MTGM	38157	1.4D + 1.7L + 1.7W + 1.7Ea	62	-79	0 - L + W + E	66	3.12											
MCCM	38151			1.4D + 1.7L + 1.7W + 1.7Ea	-185	-258																
BMAT	38302			1.4D + 1.7L + 1.7W + 1.7Ea	7	-275																
BMAC	38258			1.4D + 1.7L + 1.7W + 1.7Ea	-38	-344																
5-VL	MTGM			38143	1.4D + 1.7L + 1.7W + 1.7Ea	44	-240	0 - L + W + E	66	4.68												
MCCM	38143			1.4D + 1.7L + 1.7W + 1.7Ea	-109	-412																
BMAT	38143			0 - L + W + E	9	-473																
BMAC	38143			1.4D + 1.7L + 1.7W + 1.7Ea	-67	-693																
6-VL	MTGM			38165	1.4D + 1.7L + 1.7W + 1.7Ea	66	-211	1.4D + 1.7L + 1.7W + 1.7Ea	52	6.24												
MCCM	38165			1.4D + 1.7L + 1.7W + 1.7Ea	-298	-747																
BMAT	38165			1.4D + 1.7L + 1.7W + 1.7Ea	1	-701																
BMAC	38165			1.4D + 1.7L + 1.7W + 1.7Ea	-211	-786																
2	7-VL	MTGM	25310	1.4D + 1.7L + 1.7W + 1.7Ea	33	-19	1.4D + 1.7L + 1.7W + 1.7Ea	41	1.56										(10)			
MCCM	25313	0 - L + W + E	-44	-27																		
BMAT	39027	1.4D + 1.7L + 1.7W + 1.7Ea	1	-50																		
BMAC	39027	1.4D + 1.7L + 1.7W + 1.7Ea	-21	-50																		
8-VL	MTGM	34573	1.4D + 1.7L + 1.7W + 1.7Ea	41	-25	1.4D + 1.7L + 1.7W + 1.7Ea	50	3.12											(10)			
MCCM	34574	0 - L + W + E	-40	-15																		
BMAT	34573	1.4D + 1.7L + 1.7W + 1.7Ea	20	-52																		
BMAC	34573	1.4D + 1.7L + 1.7W + 1.7Ea	-49	-62																		

Table 3H.3-4: Results of Radwaste Building Concrete Slab Design (Continued)

Location	Face	Direction	Reinforcement Layout Drawing Number (1)	Thickness (ft)	Reinforcement Zone Number ²	Maximum Force ³	Longitudinal Reinforcement Design Loads					Longitudinal Reinforcement Provided (in ² /ft)	Transverse Shear Design Loads ⁴				Transverse Shear ⁵ Reinforcement Provided (in ² /ft)	Remarks				
							Axial and Flexure Loads			In-Plane Shear Loads			Load Combination	In-Plane Shear (kips/ft)	Horizontal Section				Vertical Section			
							Load Combination	Axial ⁶ (kips/ft)	Moment ⁶ (ft-kips/ft)	Load Combination	Transverse Shear Force (kips/ft)				Corresponding Axial Force (kips/ft)	Transverse Shear Force (kips/ft)			Corresponding Axial Force (kips/ft)			
EL 38'-0"	Far Side	Horizontal	3H-35	5	1-H-L	MTCM 38350	1.4D + 1.7L + 1.7W + 1.7Ea	44	50	1.4D + 1.7L + 1.7W + 1.7Ea	122	3.12										
						MCCM 38398	1.4D + 1.7L + 1.7W + 1.7Ea	-194	78													
						MBAT 38138	1.4D + 1.7L + 1.7W + 1.7Ea	5	252													
						MBAC 38353	1.4D + 1.7L + 1.7W + 1.7Ea	-23	165													
					MTCM 38230	1.4D + 1.7L + 1.7W + 1.7Ea	98	68	1.4D + 1.7L + 1.7W + 1.7Ea	107	4.68											
					MCCM 37817	1.4D + 1.7L + 1.7W + 1.7Ea	-195	48														
					MBAT 38224	1.4D + 1.7L + 1.7W + 1.7Ea	6	374														
					MBAC 38224	1.4D + 1.7L + 1.7W + 1.7Ea	-99	416														
					MTCM 38193	1.4D + 1.7L + 1.7W + 1.7Ea	61	58	1.4D + 1.7L + 1.7W + 1.7Ea	97	3.12											
					MCCM 38193	1.4D + 1.7L + 1.7W + 1.7Ea	-239	173														
		MBAT 38195	1.4D + 1.7L + 1.7W + 1.7Ea	1	227																	
		MBAC 38509	1.4D + 1.7L + 1.7W + 1.7Ea	-139	227																	
		MTCM 25335	1.4D + 1.7L + 1.7W + 1.7Ea	98	15	1.4D + 1.7L + 1.7W + 1.7Ea	102	3.12														
		MCCM 25335	1.4D + 1.7L + 1.7W + 1.7Ea	-247	11																	
		MBAT 30021	1.4D + 1.7L + 1.7W + 1.7Ea	24	61																	
		MBAC 30021	1.4D + 1.7L + 1.7W + 1.7Ea	-11	61																	
		MTCM 38119	1.4D + 1.7L + 1.7W + 1.7Ea	54	73	1.4D + 1.7L + 1.7W + 1.7Ea	72	3.12														
		MCCM 37849	D + L + W + E	-230	129																	
		MBAT 30053	1.4D + 1.7L + 1.7W + 1.7Ea	34	208																	
		MBAC 37845	1.4D + 1.7L + 1.7W + 1.7Ea	-138	308																	
	MTCM 37131	1.4D + 1.7L + 1.7W + 1.7Ea	17	62	1.4D + 1.7L + 1.7W + 1.7Ea	72	4.68															
	MCCM 37074	D + L + W + E	-144	231																		
	MBAT 37553	1.4D + 1.7L + 1.7W + 1.7Ea	11	154																		
	MBAC 37809	1.4D + 1.7L + 1.7W + 1.7Ea	-149	557																		
	MTCM 35810	1.4D + 1.7L + 1.7W + 1.7Ea	163	173	1.4D + 1.7L + 1.7W + 1.7Ea	43	6.24															
	MCCM 35810	1.4D + 1.7L + 1.7W + 1.7Ea	-319	240																		
	MBAT 35282	1.4D + 1.7L + 1.7W + 1.7Ea	76	538																		
	MBAC 35282	1.4D + 1.7L + 1.7W + 1.7Ea	-103	538																		
	MTCM 38165	1.4D + 1.7L + 1.7W + 1.7Ea	66	69	D + L + W + E	66	3.12															
	MCCM 38165	D + L + W + E	-191	43																		
	MBAT 37764	1.4D + 1.7L + 1.7W + 1.7Ea	21	251																		
	MBAC 38553	1.4D + 1.7L + 1.7W + 1.7Ea	-135	408																		
	MTCM 38157	1.4D + 1.7L + 1.7W + 1.7Ea	26	85	1.4D + 1.7L + 1.7W + 1.7Ea	52	4.68															
	MCCM 38157	1.4D + 1.7L + 1.7W + 1.7Ea	-159	335																		
	MBAT 38155	1.4D + 1.7L + 1.7W + 1.7Ea	7	121																		
	MBAC 38153	1.4D + 1.7L + 1.7W + 1.7Ea	-147	443																		
	MTCM 25310	1.4D + 1.7L + 1.7W + 1.7Ea	33	6	1.4D + 1.7L + 1.7W + 1.7Ea	41	1.56															
	MCCM 25214	D + L + W + E	-64	6																		
	MBAT 30021	1.4D + 1.7L + 1.7W + 1.7Ea	3	31																		
	MBAC 39021	1.4D + 1.7L + 1.7W + 1.7Ea	-3	31																		
MTCM 34573	1.4D + 1.7L + 1.7W + 1.7Ea	41	21	1.4D + 1.7L + 1.7W + 1.7Ea	50	3.12																
MCCM 34821	1.4D + 1.7L + 1.7W + 1.7Ea	-79	10																			
MBAT 34525	1.4D + 1.7L + 1.7W + 1.7Ea	5	45																			
MBAC 34578	1.4D + 1.7L + 1.7W + 1.7Ea	-47	57																			
Roof	Near Side	Horizontal	3H-36	1	1-H-L	MTMM	1.4D + 1.7L + 1.7W + 1.7Ea	27	-	1.4D + 1.7L + 1.7W + 1.7Ea	-	0.79	-	-	-	-	-	-				
		Vertical	3H-33	1	1-V-L	MTMM	1.4D + 1.7L + 1.7W + 1.7Ea	22	16	1.4D + 1.7L + 1.7W + 1.7Ea	61	1.20	-	-	-	-	-	-				
	Far Side	Horizontal	3H-42	1	1-H-L	MTMM	1.4D + 1.7L + 1.7W + 1.7Ea	27	-	1.4D + 1.7L + 1.7W + 1.7Ea	-	0.79	-	-	-	-	-	-				
		Vertical	3H-41	1	1-V-L	MTMM	1.4D + 1.7L + 1.7W + 1.7Ea	22	16	1.4D + 1.7L + 1.7W + 1.7Ea	61	1.20	-	-	-	-	-	-				
EL 38'-0"	Far Side	Vertical	3H-37a	5	1-T	-	-	-	-	-	-	-	1.4D + 1.7L + 1.7W + 1.7Ea	94	-25	-3	-1	0.20 (#4@12)	-			
					2-T	-	-	-	-	-	-	-	-	-	1.4D + 1.7L + 1.7W + 1.7Ea	53	123	54	120	0.31 (#5@12)	-	
					3-T	-	-	-	-	-	-	-	-	-	-	1.4D + 1.7L + 1.7W + 1.7Ea	117	269	88	115	0.80 (#4@6)	-
					4-T	-	-	-	-	-	-	-	-	-	-	1.4D + 1.7L + 1.7W + 1.7Ea	26	28	62	48	0.85 (#4@6)	-

Table 3H.3-4: Results of Radwaste Building Concrete Slab Design (Continued)

- Notes:**
- (1) The reinforcement layout drawings show the various zones used to define the minimum reinforcement that will be provided based on finite element analysis results. Actual provided reinforcement based on final rebar layout and including development length may exceed the reported provided reinforcement and the zones with higher reinforcement may be extended beyond their reported boundaries. The dimensions in the reinforcement drawings are based on the dimensions of the SAP2000 shell elements, which are modeled at the centerline of the walls and slabs. Therefore, the reinforcement drawing dimensions do not match actual building dimensions.
 - (2) Each reinforcement layout drawing is divided into reinforcement zones. The reinforcement zone naming convention is as follows: "H" = horizontal, "V" = vertical, "L" = longitudinal reinforcement, "T" = transverse reinforcement. For slabs, vertical corresponds to North-South direction and horizontal corresponds to East-West direction.
 - (3) The maximum tension (MTCA) and compression (MCCA) axial forces are provided with the corresponding moment from the same load combination. The maximum moment that has a corresponding tension (MMAT) in the same load combination and the maximum moment that has a corresponding compression (MMAC) in the same load combination are also provided. For the roof, the maximum tension and maximum moment (MTMM) are reported.
 - (4) Negative axial load is compression and positive axial load is tension. Negative moment applies tension to the top face of the shell element and positive moment applies tension to the bottom face of the shell element. For walls or slabs where the same reinforcement is provided on both faces, the moment is shown as absolute value. The axial and flexural loads reported in the table are the average of the 2 node pairs that form the 4 edges of the critical rectangular shell element. If the 2 node pairs on the shell element edges parallel to the reinforcement direction do not satisfy P&M interaction criteria, then only the 2 node pairs on the shell element edges perpendicular to the reinforcement direction are used for design (effective width considered). The element mesh is sufficiently refined for this design approach.
 - (5) The reported in-plane shear is the maximum average in-plane shear along a plane that crosses the longitudinal reinforcement zone.
 - (6) The transverse shear reinforcement loads are reported for the critical element requiring the largest area of steel for transverse reinforcement within the zone. The shear force and the corresponding axial force in the same load combination for each direction is reported for the critical element.
 - (7) The reported transverse shear reinforcement is the summation of the required shear reinforcement in the horizontal direction and the required shear reinforcement in the vertical direction.
 - (8) For certain areas of the structure, the standard element post-processing methods were too conservative. For such cases, detailed manual design was performed and the design forces determined by the detailed manual design are provided in the table.
 - (9) The longitudinal reinforcement shown is required to be tied.
 - (10) The reported forces are from the FEM analysis. The provided longitudinal reinforcement includes additional reinforcement required due to manual one-way design calculations.
 - (11) The reported axial and in-plane forces are from the FEM analysis. The reported flexural forces are from manual one-way design calculations.

Table 3H.3-5 Summary of Structural Steel Design

Elevation 35'-0" Floor Steel Beams					
Location ⁶	Figure Number	Size ^{2,3,4}	Safety Margin = Capacity/Demand	Max. Moment (kip-ft)	Governing Load Combination ⁷
Elevation 35'-0" Formwork Steel Beams	3H.3-39	W10X54	2.0	81.7	D+L
		W14X193	1.5	565.8	D+L
		W14X283	1.8	700.4	D+L
Elevation 35'-0" Composite Steel Beams	3H.3-40	W14x82	1.5	629.5	D+L+E'
	3H.3-41	W36x210	1.3	577.4	Construction
	3H.3-42	W36x231	1.2	4540.4	D+L+E'
		W36x262	1.1	5511.0	D+L+E'

Roof Truss Members					
Location	Figure Number	Size ^{2,3,4}	Safety Margin = Capacity/Demand	Max. Axial Load ¹ (kip)	Governing Load Combination ⁷
North-South Spanning Truss Top Chord Member		W14X120	1.6	705.0	D+L+E'
			1.6	-962.0	D+L+E'
North-South Spanning Truss Bottom Chord Member		W14X311	1.4	2161.0	D+L+E'
			4.3	-908.0	D+E'
North-South Spanning Truss Outer Diagonal Members		W12X136	1.4	910.0	D+L+E'
			4.5	-329.0	D+E'
North-South Spanning Truss Outer Vertical Members	3H.3-43 3H.3-44	2L8X8X1	2.6	241.0	D+E'
			1.3	-667.0	D+L+E'
North-South Spanning Truss Inner Diagonal Members		2L8X6X3/4LLBB	1.4	284.0	D+L+E'
			3.7	-139.0	D+E'
North-South Spanning Truss Inner Vertical Members		2L5X5X1/2	2.0	91.0	D+E'
			1.3	-185.0	D+L+E'
North-South Spanning Truss Lateral Bracing Members		2L8X4X1LLBB	1.1	386.0	D+L+E'
			1.1	-316.0	D+L+E'
East-West Spanning Truss Top Chord Member		2L5X5X1/2	3.8	47.0	0.9D+E'
			1.9	-152.0	D+L+E'
East-West Spanning Truss Bottom Chord Member		2L8X4X1LLBB	1.4	316.0	D+L+E'
			7.1	-94.0	0.9D+E'
East-West Spanning Truss Outer Diagonal Members		L8X6X7/8	1.3	208.0	D+L+E'
			8.3	-51.0	0.9D+E'
East-West Spanning Truss Outer Vertical Members	3H.3-43 3H.3-45	L6X6X1/2	3.3	35.0	D+L+E'
			1.3	-143.0	D+L+E'
East-West Spanning Truss Inner Diagonal Members		L4X4X3/8	4.3	14.0	D+L+E'
			11.1	-7.0	0.9D+E'
East-West Spanning Truss Inner Vertical Members		L6X6X1/2	5.0	23.0	0.9D+E'
			2.9	-63.0	D+L+E'
East-West Spanning Truss Lateral Bracing Members		L5X5X3/8	3.8	18.0	D+L+E'
			2.6	-21.0	D+L+E'

Roof Purlins						
Location	Figure Number	Size ^{2,3,4}	Safety Margin = Capacity/Demand	Max. Axial Load ¹ (kip)	Max. Moment ⁷ (kip-ft)	Governing Load Combination ⁷
North-South Spanning Roof Purlins	3H.3-43	W12X210	1.3	-1299.3	-13.2	D+L+E'
East-West Spanning Roof Purlins						

Notes:

1. Positive axial load is tension and negative axial load is compression.
2. W-shapes : ASTM A572 Gr. 50 (Fy = 50ksi)
3. Angles and Double Angles : ASTM A36 Gr. 36 (Fy = 36ksi)
4. Member sizes reported are based on analysis results.
Actual member sizes used will have the same or greater capacity, but size and shape may vary based on connection design requirements.
5. E_s is the design basis earthquake load (1/2 SSE). E' is the 1/1 earthquake load (SSE).
6. The steel beams located between column lines W1-W7 and WA-WE are required for concrete formwork only. Once the concrete cures, the concrete alone is designed for all design basis loading. The formwork steel will remain in-place unless commodity routing required the formwork steel to be removed.
7. Maximum moment for governing load combination is based on bending about the minor-axis.

Table 3H.6-11: Results of DGFS Vault Concrete Design

Location	Thickness (ft)	Face	Direction	Reinforcement Layout Drawing Number (1)	Reinforcement Zone Number(2)	Maximum Force (3)	Element	Longitudinal Reinforcement Design Loads				Longitudinal Reinforcement Provided (in ² /ft)	Transverse Shear Design Loads(4)				Transverse Shear (7) Reinforcement Provided (in ² /ft)	Remarks															
								Axial and Flexure Loads		In-Plane Shear Loads			Horizontal Section		Vertical Section																		
								Load Combination	Axial (4) (kips / ft)	Flexure (4) (ft-kips / ft)	Load Combination		In-plane Shear (5) (kips / ft)	Transverse Shear Force (kip / ft)	Corresponding Axial Force (kip / ft)	Transverse Shear Force (kip / ft)			Corresponding Axial Force (kip / ft)														
Slab 1	6	Near Side	Horizontal	316-142	1-HL	MTCM	244	D+F+L+H+E	34	-71	D+F+L+H+E	24	3.12																				
						MCCM	2275	D+F+L+H+E	-73	-184																							
						MBAT	233	D+F+L+H+E	1	-574																							
						MBAC	243	D+F+L+H+E	-15	-412																							
					2-HL	MTCM	2280	D+F+L+H+E	55	-230	D+F+L+H+E	24	4.53																				
						MCCM	34	D+F+L+H+E	-52	50																							
						MBAT	99	D+F+L+H+E	5	-748																							
						MBAC	99	D+F+L+H+E	-1	-748																							
					3-HL	MTCM	344	D+F+L+H+E	36	-341	D+F+L+H+E	24	9.36																				
						MCCM	394	D+F+L+H+E	-86	-610																							
						MBAT	353	D+F+L+H+E	8	-1593																							
						MBAC	323	D+F+L+H+E	-11	-1593																							
				Vertical	1-VL	MTCM	2524	D+F+L+H+E	35	-55	D+F+L+H+E	27	3.12																				
						MCCM	174	D+F+L+H+E	-174	-61																							
						MBAT	2625	D+F+L+H+E	20	-322																							
						MBAC	115	D+F+L+H+E	-83	-516																							
						2-VL	MTCM	377	D+F+L+H+E	33												-52	D+F+L+H+E	27	4.53								
							MCCM	231	D+F+L+H+E	-147												9											
					MBAT		35	D+F+L+H+E	24	-419																							
					3-VL	MTCM	18	D+F+L+H+E	41	-123	D+F+L+H+E	27	6.24																				
						MCCM	117	1.4D+1.4F+1.7L+1.7H+1.7W	-123	-42																							
						MBAT	344	D+F+L+H+E	8	-608																							
					Horizontal	1-HL	MTCM	253	D+F+L+H+E	23	155	D+F+L+H+E	24	3.12																			
							MCCM	2299	D+F+L+H+E	-82	136																						
			MBAT	329			D+F+L+H+E	13	385																								
			MBAC	358			D+F+L+H+E	-22	445																								
			2-HL	MTCM		2299	D+F+L+H+E	52	512	D+F+L+H+E	24	4.53																					
				MCCM		354	D+F+L+H+E	-83	853																								
				MBAT		119	D+F+L+H+E	11	748																								
				MBAC		355	D+F+L+H+E	-74	940																								
			3-HL	MTCM		40	D+F+L+H+E	84	838	D+F+L+H+E	24	6.24																					
				MCCM		377	D+F+L+H+E	-86	321																								
				MBAT		40	D+F+L+H+E	86	913																								
				MBAC		378	D+F+L+H+E	-24	1215																								
			4-HL	MTCM	346	D+F+L+H+E	73	625	D+F+L+H+E	24	7.8																						
				MCCM	394	D+F+L+H+E	-85	495																									
				MBAT	99	D+F+L+H+E	9	1437																									
				MBAC	99	D+F+L+H+E	-5	1437																									
			1-VL	MTCM	349	D+F+L+H+E	51	650	D+F+L+H+E	27	6.24																						
				MCCM	294	D+F+L+H+E	-101	675																									
				MBAT	21	D+F+L+H+E	13	1001																									
				MBAC	295	D+F+L+H+E	-15	1102																									

(5)

Table 3H.6-11: Results of DGFS Vault Concrete Design (Continued)

Location	Thickness (ft)	Field	Direction	Reinforcement Layout Drawing Number (1)	Reinforcement Zone Number (2)	Maximum Force (k)	Element	Longitudinal Reinforcement Design Loads				Longitudinal Reinforcement Provided (in ² /ft)	Transverse Shear Design Loads (3)				Transverse Shear (7) Reinforcement Provided (in ² /ft)	Remarks					
								Axial and Flexure Loads		In-Plane Shear Loads			Horizontal Section		Vertical Section								
								Load Combination	Axial (4) (kips / ft)	Flexure (4) (ft-kips / ft)	Load Combination		In-plane Shear (5) (kips / ft)	Load Combination	Transverse Shear Force (kip / ft)	Corresponding Axial Force (kip / ft)			Transverse Shear Force (kip / ft)	Corresponding Axial Force (kip / ft)			
Slab 1	6	Far Side	Vertical	316-143	2-VL	MTCM	2521	D+F+L+H+E	50	575	D+F+L+H+E	19	0.30										
						MCCM	128	D+F+L+H+E	-300	1143													
						MBAT	333	D+F+L+H+E	67	973													
						MDAC	243	D+F+L+H+E	-135	1300													
					3-VL	MTCM	359	D+F+L+H+E	119	1130	D+F+L+H+E	27	13.92										
						MCCM	117	D+F+L+H+E	-235	1289													
						MBAT	71	D+F+L+H+E	21	1312													
						MDAC	221	D+F+L+H+E	-245	2135													
					4-VL	MTCM	267	D+F+L+H+E	4	177	D+F+L+H+E	17	14.04										
						MCCM	221	D+F+L+H+E	-303	1379													
						MBAT	-	-	-	-													
						MDAC	125	D+F+L+H+E	-249	2485													
					5-VL	MTCM	-	-	-	-	D+F+L+H+E	11	12.6										
						MCCM	215	D+F+L+H+E	-289	2309													
						MBAT	-	-	-	-													
						MDAC	197	D+F+L+H+E	-248	2453													
					2-T	-	-	-	-	-	-	-	-	-	D+F+L+H+E	172	-123	27	-21	0.31 (5#12)			
						-	-	-	-	-	-	-	-	-	D+F+L+H+E	125	12	112	5	0.30 (4#8)			
					Roof 2	2	Near Side	Horizontal	316-147	1-HL	MTCM	53	D+F+L+H+E	70	43	D+F+L+H+E	40	3.12					
											MCCM	53	D+F+L+H+E	-172	-14								
MBAT	53	D+F+L+H+E	21	-53																			
MDAC	539	D+F+L+H+E	-92	-70																			
1-VL	MTCM	471	D+F+L+H+E	41				-15	D+F+L+H+E	60	1.59												
	MCCM	58	D+F+L+H+E	-141				32															
	MBAT	471	D+F+L+H+E	24				-31															
	MDAC	511	D+F+L+H+E	-126				-118															
2-VL	MTCM	524	D+F+L+H+E	30				0	D+F+L+H+E	60	3.12												
	MCCM	524	D+F+L+H+E	-185				-68															
	MBAT	529	D+F+L+H+E	2			-68																
	MDAC	539	D+F+L+H+E	-85			-178																
3-VL	MTCM	529	D+F+L+H+E	6			-12	D+F+L+H+E	22	6.24													
	MCCM	529	D+F+L+H+E	-152			-152																
	MBAT	529	D+F+L+H+E	3			-14																
	MDAC	525	D+F+L+H+E	-104			-21																
Far Side	Horizontal	316-149	1-HL	MTCM			399	D+F+L+H+E	13	4	D+F+L+H+E	40	3.12										
				MCCM			523	D+F+L+H+E	-172	26													
				MBAT			529	D+F+L+H+E	3	67													
				MDAC			525	D+F+L+H+E	-21	81													
Vertical	316-150	1-VL	MTCM	524	D+F+L+H+E	31	24	D+F+L+H+E	60	1.59													
			MCCM	525	D+F+L+H+E	-114	11																
			MBAT	525	D+F+L+H+E	71	24																
			MDAC	529	D+F+L+H+E	-35	24																
Slab 3	2	Near Side	Horizontal	316-151	1-HL	MTCM	639	D+F+L+H+E	29	-13	D+F+L+H+E	24	1.59										
						MCCM	639	D+F+L+H+E	-65	-21													
						MBAT	643	D+F+L+H+E	2	-39													
						MDAC	638	D+F+L+H+E	-54	-57													

Table 3H.6-11: Results of DGFS Vault Concrete Design (Continued)

Location	Thickness (ft)	Face	Direction	Reinforcement Layout Drawing Number (1)	Reinforcement Zone Number (2)	Maximum Force (3)	Element	Longitudinal Reinforcement Design Loads				Longitudinal Reinforcement Provided (in ² /ft)	Transverse Shear Design Loads (4)				Transverse Shear (7) Reinforcement Provided (in ² /ft)	Remarks	
								Axial and Flexure Loads			In-Plane Shear Loads		Horizontal Section		Vertical Section				
								Load Combination	Axial (4) (kips / ft)	Flexure (4) (ft-kips / ft)	Load Combination		In-plane (5) Shear (kips / ft)	Transverse Shear Force (kip / ft)	Corresponding Axial Force (kip / ft)	Transverse Shear Force (kip / ft)			Corresponding Axial Force (kip / ft)
Roof 3	2	NAR 304	Horizontal	316-151	2-HL	MTCM	574	D+F+L+H+E	7	-12	D+F+L+H+W	24	3.12						
						MOCM	574	D+F+L+H+E	-8	4									
						MBAT	574	D+F+L+H+E	7	-10									
						MBAC	574	D+F+L+H+E	-3	-13									
			Vertical	316-152	1-VL	MTCM	575	D+F+L+H+W	21	-5	D+F+L+H+W	18	1.58						
						MOCM	575	D+F+L+H+E	-73	4									
						MBAT	538	D+F+L+H+E	15	55									
						MBAC	538	D+F+L+H+E	-6	55									
		2-VL	MTCM	574	D+F+L+H+E	38	-38	D+F+L+H+W	15	3.12									
			MOCM	574	D+F+L+H+E	-84	-11												
			MBAT	574	D+F+L+H+E	34	48												
			MBAC	574	D+F+L+H+E	-3	48												
		FAR 308	Horizontal	316-153	1-HL	MTCM	638	D+F+L+H+W	30	5	D+F+L+H+W	24	1.58						
						MOCM	621	D+F+L+H+E	-60	1									
						MBAT	643	D+F+L+H+E	3	28									
						MBAC	572	D+F+L+H+W	-2	21									
			2-HL	MTCM	574	D+F+L+H+E	5	6	D+F+L+H+W	24	3.12								
				MOCM	574	D+F+L+H+W	-15	14											
				MBAT	574	D+F+L+H+E	2	13											
				MBAC	573	D+F+L+H+W	-4	28											
Vertical	316-154A	1-VL	MTCM	575	D+F+L+H+W	35	6	D+F+L+H+W	18	1.58									
			MOCM	575	D+F+L+H+E	-75	8												
			MBAT	575	D+F+L+H+E	19	21												
			MBAC	538	D+F+L+H+W	-25	24												
2-VL	MTCM	574	D+F+L+H+E	38	21	D+F+L+H+W	15	3.12											
	MOCM	574	D+F+L+H+W	-114	41														
	MBAT	574	D+F+L+H+W	1	28														
	MBAC	574	D+F+L+H+W	-114	41														
TRANSVERSE (North-South & East-West)	316-154B	1-T											D+F+L+H+E	-15	51	-23	0	0.44 (30%)	
Roof 5	2	NAR 304	Horizontal	316-155	1-HL	MTCM	690	D+F+L+H+W	44	-12	D+F+L+H+W	37	1.58						
						MOCM	695	D+F+L+H+W	-47	-6									
						MBAT	771	D+F+L+H+E	0	52									
						MBAC	729	D+F+L+H+E	-6	41									
		Vertical	316-156	1-VL	MTCM	729	D+F+L+H+W	63	-5	D+F+L+H+E	18	1.58							
					MOCM	693	D+F+L+H+W	-63	-2										
					MBAT	721	D+F+L+H+E	0	-19										
					MBAC	725	D+F+L+H+W	-31	-19										
		FAR 308	Horizontal	316-157	1-HL	MTCM	724	D+F+L+H+W	32	8	D+F+L+H+W	27	1.58						
						MOCM	727	D+F+L+H+W	-145	16									
						MBAT	698	D+F+L+H+W	1	19									
						MBAC	732	D+F+L+H+W	-22	49									
		Vertical	316-158	1-VL	MTCM	711	D+F+L+H+W	27	0	D+F+L+H+E	18	1.58							
					MOCM	732	D+F+L+H+W	-170	15										
					MBAT	732	D+F+L+H+E	5	17										
					MBAC	697	D+F+L+H+W	-43	43										

Table 3H.6-11: Results of DGFS Vault Concrete Design (Continued)

Location	Thickness (ft)	Face	Direction	Reinforcement Layout Drawing Number (1)	Reinforcement Zone Number (2)	Maximum Force (k)	Element	Longitudinal Reinforcement Design Loads				Longitudinal Reinforcement Provided (in ² /ft)	Transverse Shear Design Loads (3)				Transverse Shear Reinforcement Provided (in ² /ft)	Remarks					
								Axial and Flexure Loads		In-Plane Shear Loads			Horizontal Section		Vertical Section								
								Load Combination	Axial (4) (kips / ft)	Flexure (4) (ft-kips / ft)	Load Combination		In-plane Shear (kips / ft)	Load Combination	Transverse Shear Force (kip / ft)	Corresponding Axial Force (kip / ft)			Transverse Shear Force (kip / ft)	Corresponding Axial Force (kip / ft)			
Roof 6	2	Near Side	Horizontal	316-159	1-HL	MTCM	534	D+F+L+H+W	43	-7	D+F+L+H+W	52	1.56										
						MCCM	630	D+F+L+H+W	-107	-20													
						MBAAT	637	D+F+L+H+W	2	-48													
						MBAC	639	D+F+L+H+W	-50	-74													
			Vertical	316-160	1-VL	MTCM	639	D+F+L+H+W	29	-5	D+F+L+H+W	87	1.56										
						MCCM	639	D+F+L+H+W	-68	-2													
		MBAAT				638	D+F+L+H+W	5	-24														
		MBAC				638	D+F+L+H+W	-33	65														
		Far Side	Horizontal	316-161	1-HL	MTCM	673	D+F+L+H+W	45	9	D+F+L+H+W	52	1.56										
						MCCM	657	D+F+L+H+W	-230	25													
						MBAAT	657	D+F+L+H+W	2	53													
						MBAC	658	D+F+L+H+W	-21	82													
Vertical	316-162		1-VL	MTCM	663	D+F+L+H+W	15	8	D+F+L+H+W	87	1.56												
				MCCM	660	D+F+L+H+W	-287	30															
		MBAAT		660	D+F+L+H+W	3	17																
		MBAC		658	D+F+L+H+W	-57	72																
Vault 7	4	Near Side	Horizontal	316-163	1-HL	MTCM	575	D+F+L+H+E	115	-55	D+F+L+H+E	61	3.12										
						MCCM	1044	D+F+L+H+E	-157	-40													
						MBAAT	911	D+F+L+H+E	5	-23													
						MBAC	1059	D+F+L+H+E	-163	-366													
					2-HL	MTCM	1045	D+F+L+H+E	21	-50	D+F+L+H+E	61	4.98										
						MCCM	1052	D+F+L+H+E	-184	-54													
						MBAAT	1015	D+F+L+H+E	2	-118													
						MBAC	1070	D+F+L+H+E	-185	-594													
					3-HL	MTCM	961	D+F+L+H+E	150	-234	D+F+L+H+E	61	6.24										
						MCCM	1042	D+F+L+H+E	-223	-25													
						MBAAT	1042	D+F+L+H+E	26	-268													
						MBAC	1041	D+F+L+H+E	-179	-765													
					4-HL	MTCM	-	-	-	-	D+F+L+H+E	44	7.8										
						MCCM	1053	D+F+L+H+E	-192	-888													
						MBAAT	-	-	-	-													
						MBAC	1085	D+F+L+H+E	-155	-230													
					1-VL	MTCM	798	D+F+L+H+E	76	-70	D+F+L+H+E	62	3.12										
						MCCM	1041	D+F+L+H+E	-188	-61													
		MBAAT	1059	D+F+L+H+E		1	-219																
		MBAC	1059	D+F+L+H+E		-54	-219																
		2-VL	MTCM	798	D+F+L+H+E	157	-173	D+F+L+H+E	62	4.98													
			MCCM	1029	D+F+L+H+E	-213	-61																
			MBAAT	591	D+F+L+H+E	1	-578																
			MBAC	604	D+F+L+H+E	-88	-457																
		3-VL	MTCM	912	D+F+L+H+E	51	-434	D+F+L+H+E	74	9.36													
			MCCM	1014	D+F+L+H+E	-131	-63																
			MBAAT	520	D+F+L+H+E	1	-688																
			MBAC	520	D+F+L+H+E	-49	-688																

Table 3H.6-11: Results of DGFOS Vault Concrete Design (Continued)

Location	Thickness (ft)	Face	Direction	Reinforcement Layout Drawing Number (1)	Reinforcement Zone Number ⁽²⁾	Maximum Percent (3)	Element	Longitudinal Reinforcement Design Loads				Longitudinal Reinforcement Provided (in ² /ft)	Transverse Shear Design Loads ⁽²⁾				Transverse Shear ⁽¹⁾ Reinforcement Provided (in ² /ft)	Remarks															
								Axial and Flexure Loads		In-Plane Shear Loads			Horizontal Section		Vertical Section																		
								Load Combination	Axial ⁽⁴⁾ (kips / ft)	Flexure ⁽⁴⁾ (ft-kips / ft)	Load Combination		In-plane Shear ⁽⁵⁾ (kips / ft)	Load Combination	Transverse Shear Force (kip / ft)	Corresponding Axial Force (kip / ft)			Transverse Shear Force (kip / ft)	Corresponding Axial Force (kip / ft)													
Wall 7	4	Near Side	Vertical	316-164	4-VL	MTCM	829	0+F+L+H+E	33	-429	D+F+L+H+E	63	10.92	-	-	-	-	-															
						MOCM	829	0+F+L+H+E	-118	-40																							
						MBAAT	830	0+F+L+H+E	1	-1217																							
						MBAAC	830	0+F+L+H+E	-54	-1224																							
					5-VL	MTCM	844	0+F+L+H+E	23	-717	D+F+L+H+E	58	12.45	-	-	-	-	-	-	-	(S)(12)												
						MOCM	844	0+F+L+H+E	-112	-38																							
						MBAAT	853	0+F+L+H+E	1	-1227																							
						MBAAC	852	0+F+L+H+E	-64	-1231																							
						1-HL	MTCM	859	0+F+L+H+E	108												19	D+F+L+H+E	61	3.12	-	-	-	-	-	-	-	-
							MOCM	861	0+F+L+H+E	-304												264											
				MBAAT	1047		0+F+L+H+E	9	124																								
				MBAAC	815		0+F+L+H+E	-123	380																								
				2-HL	MTCM	-	-	-	-	D+F+L+H+E	59	4.58	-	-	-	-	-	-	-	-	-												
					MOCM	1049	0+F+L+H+E	-155	143																								
					MBAAT	-	-	-	-																								
					MBAAC	514	0+F+L+H+E	-111	413																								
				Far Side	Vertical	316-165	1-VL	MTCM	1023	0+F+L+H+E	75	94	D+F+L+H+E	62	3.12	-	-	-	-	-	-	-											
								MOCM	1020	0+F+L+H+E	-203	19																					
								MBAAT	1056	0+F+L+H+E	5	159																					
							2-VL	MTCM	798	0+F+L+H+E	138	58	D+F+L+H+E	62	4.58	-	-	-	-	-	-	-	-										
		MOCM	1017					0+F+L+H+E	-256	120																							
		MBAAT	510					0+F+L+H+E	1	300																							
		3-VL	MTCM			1042	0+F+L+H+E	74	66	D+F+L+H+E	70	6.24	-	-	-	-	-	-	-	-													
			MOCM			1042	0+F+L+H+E	-211	39																								
			MBAAT			520	0+F+L+H+E	7	853																								
		4-VL	MTCM			539	0+F+L+H+E	19	255	D+F+L+H+E	58	7.8	-	-	-	-	-	-	-	-	-												
			MOCM			571	0+F+L+H+E	-75	354																								
			MBAAT			558	0+F+L+H+E	7	735																								
		5-VL	MTCM	-	-	-	-	D+F+L+H+E	58	12.48	-	-	-	-	-	-	-	-	-														
			MOCM	844	0+F+L+H+E	-112	44																										
			MBAAT	-	-	-	-																										
		316-166	Horizontal & Vertical	1-T	MTCM	-	-	-	-	-	-	-	-	-	-	-	-	-	-	-													
					2-T	-	-	-	-	-	-	-	-	-	-	-	-	-	-	-	-												
					3-T	-	-	-	-	-	-	-	-	-	-	-	-	-	-	-	-	-											
					4-T	-	-	-	-	-	-	-	-	-	-	-	-	-	-	-	-	-											
		Wall 8	4	Near Side	Horizontal	316-168	1-HL	MTCM	1124	0+F+L+H+E	115	-38	D+F+L+H+E	60	3.12	-	-	-	-	-	-												
								MOCM	1307	0+F+L+H+E	-173	-229																					
								MBAAT	1188	0+F+L+H+E	5	-188																					
								MBAAC	1301	0+F+L+H+E	-183	-368																					

Table 3H.6-11: Results of DGFOS Vault Concrete Design (Continued)

Location	Thickness (ft)	Face	Direction	Reinforcement Drawing Number (1)	Reinforcement Zone Number (2)	Maximum Force (k)	Element	Longitudinal Reinforcement Design Loads				Longitudinal Reinforcement Provided (in ² /ft)	Transverse Shear Design Loads (3)				Transverse Shear Reinforcement Provided (in ² /ft)	Remarks		
								Axial and Flexure Loads		In-Plane Shear Loads			Load Combination	In-plane Shear (kips/ft)	Horizontal Section				Vertical Section	
								Load Combination	Axial (k) (kips/ft)	Flexure (k) (ft-kips/ft)	Transverse Shear Force (kip/ft)				Corresponding Axial Force (kip/ft)	Transverse Shear Force (kip/ft)			Corresponding Axial Force (kip/ft)	
Wall 8	4	NAR Side	Horizontal	316-160	2-HL	MTCM 1278	D+F+L+H+E	20	-114	D=F+L+H+E	80	4.98								
						MCCM 1300	D+F+L+H+E	-153	-524											
						MMAT 1288	D+F+L+H+E	3	-123											
						MMAC 1300	D+F+L+H+E	-104	-211											
					3-HL	MTCM 1108	D+F+L+H+E	145	-274	D=F+L+H+E	60	6.04								
						MCCM 1230	D+F+L+H+E	-217	-242											
						MMAT 1280	D+F+L+H+E	50	-329											
						MMAC 1287	D+F+L+H+E	-137	-783											
					4-HL	MTCM -	-	-	-	D=F+L+H+E	44	7.8								
						MCCM 1305	D+F+L+H+E	-192	-903											
						MMAT -	-	-	-											
						MMAC 1314	D+F+L+H+E	-184	-248											
			Vertical	216-160	1-VL	MTCM 1121	D+F+L+H+E	73	-63	D=F+L+H+E	63	3.12								
						MCCM 1283	D+F+L+H+E	-194	-65											
						MMAT 1288	D+F+L+H+E	2	-105											
						MMAC 1287	D+F+L+H+E	-53	-245											
					2-VL	MTCM 1189	D+F+L+H+E	155	-130	D=F+L+H+E	63	4.98								
						MCCM 1281	D+F+L+H+E	-210	-43											
						MMAT 1108	D+F+L+H+E	3	-415											
						MMAC 1181	D+F+L+H+E	-86	-465											
					3-VL	MTCM 1173	D+F+L+H+E	53	-133	D=F+L+H+E	72	9.36								
						MCCM 1272	D+F+L+H+E	-129	-65											
						MMAT 1185	D+F+L+H+E	2	-263											
						MMAC 1185	D+F+L+H+E	-47	-263											
			4-VL	MTCM 1157	D+F+L+H+E	39	-212	D=F+L+H+E	61	13.92										
				MCCM 1157	D+F+L+H+E	-118	-44													
				MMAT 1149	D+F+L+H+E	6	-1222													
				MMAC 1149	D+F+L+H+E	-55	-1225													
			5-VL	MTCM 1141	D+F+L+H+E	21	-720	D=F+L+H+E	54	12.48					(5)(12)					
				MCCM 1141	D+F+L+H+E	-110	-36													
				MMAT 1117	D+F+L+H+E	0	-1229													
				MMAC 1133	D+F+L+H+E	-46	-1254													
			NAR Side	Horizontal	316-170	1-HL	MTCM 1143	D+F+L+H+E	106	12	D=F+L+H+E	60	3.12							
							MCCM 1109	D+F+L+H+E	-291	255										
							MMAT 1275	D+F+L+H+E	9	225										
							MMAC 1104	D+F+L+H+E	-134	375										
2-HL	MTCM -	-			-	-	D=F+L+H+E	50	4.58											
	MCCM 1184	D+F+L+H+E			-187	280														
	MMAT -	-			-	-														
	MMAC 1175	D+F+L+H+E			-111	429														
Vertical	316-171	1-VL	MTCM 1282	D+F+L+H+E	76	74	D=F+L+H+E	63	3.12											
			MCCM 1281	D+F+L+H+E	-201	19														
			MMAT 1288	D+F+L+H+E	5	201														
			MMAC 1272	D+F+L+H+E	-81	257														

Table 3H.6-11: Results of DGFS Vault Concrete Design (Continued)

Location	Thickness (ft)	Face	Direction	Reinforcement Layout Drawing Number (1)	Reinforcement Zone Number (2)	Maximum Force (3)	Element	Longitudinal Reinforcement Design Loads					Longitudinal Reinforcement Provided (in ² /ft)	Transverse Shear Design Loads (4)				Transverse Shear Reinforcement Provided (in ² /ft)	Remarks					
								Axial and Flexure Loads			In-Plane Shear Loads			Load Combination	In-plane Shear (kips/ft)	Load Combination	Horizontal Section			Vertical Section				
								Load Combination	Axial (4) (kips/ft)	Flexure (4) (ft-kips/ft)	Transverse Shear Force (kip/ft)	Corresponding Axial Force (kip/ft)					Transverse Shear Force (kip/ft)			Corresponding Axial Force (kip/ft)				
																					Longitudinal Reinforcement Provided (in ² /ft)			
Well #	4	F/R Side	Vertical	3H.6-171	2-VL	MTCM 1189	D+F+L+H+E	143	59	D+F+L+H+E	93	4.68	-	-	-	-	-	-						
						MCCM 1209	D+F+L+H+E	-250	179															
						MMAT 1207	D+F+L+H+E	2	477															
						MMAC 1207	D+F+L+H+E	-67	489															
					3-VL	MTCM 1280	D+F+L+H+E	72	148	D+F+L+H+E	65	6.24	-	-	-	-	-	-	-	-	-			
						MCCM 1280	D+F+L+H+E	-159	79															
						MMAT 1181	D+F+L+H+E	5	857															
						MMAC 1181	D+F+L+H+E	-24	857															
					4-VL	MTCM 1152	D+F+L+H+E	59	286	D+F+L+H+E	54	7.8	-	-	-	-	-	-	-	-	-			
						MCCM 1120	D+F+L+H+E	-72	351															
						MMAT 1145	D+F+L+H+E	7	754															
						MMAC 1145	D+F+L+H+E	-25	754															
					5-VL	MTCM -	-	-	-	D+F+L+H+E	54	12.45	-	-	-	-	-	-	-	-	-			
						MCCM 1141	D+F+L+H+E	-110	50															
						MMAT -	-	-	-															
						MMAC 1117	D+F+L+H+E	-67	114															
					-	-	-	Transverse (Horizontal & Vertical)	3H.6-172	1-T	-	-	-	-	-	-	D+F+L+H+E	6	0	-24	-159	0.20 (4@12)		
										2-T	-	-	-	-	-	-	D+F+L+H+E	-104	20	22	-75	0.31 (5@12)		
										3-T	-	-	-	-	-	-	-	D+F+L+H+E	-171	20	-8	-25		0.80 (4@8)
										4-T	-	-	-	-	-	-	-	D+F+L+H+E	-239	-10	-1	-12		1.24 (5@8)
Well #	2	Near Side	Horizontal	3H.6-173	1-HL	MTCM 959	D+F+L+H+W	43	4	D+F+L+H+W	58	1.56	-	-	-	-	-	-						
						MCCM 287	D+F+L+H+W	-45	-4															
						MMAT 998	D+F+L+H+E	1	35															
						MMAC 992	D+F+L+H+E	-12	35															
					2-HL	MTCM 1019	D+F+L+H+W	42	-4	D+F+L+H+W	58	3.12	-	-	-	-	-	-	-	-	-			
						MCCM 1019	D+F+L+H+W	-73	-7															
						MMAT 1018	D+F+L+H+E	20	-79															
						MMAC 1035	D+F+L+H+E	-26	-101															
					3-HL	MTCM 1030	D+F+L+H+W	53	-15	D+F+L+H+W	58	4.58	-	-	-	-	-	-	-	-	-			
						MCCM 1030	D+F+L+H+W	-106	-8															
			MMAT 1030	D+F+L+H+E		52	-65																	
			MMAC 1030	D+F+L+H+E		-15	-65																	
			Vertical	1-VL	MTCM 993	D+F+L+H+W	41	-4	D+F+L+H+W	47	1.56	-	-	-	-	-	-	-	-	-				
					MCCM 974	D+F+L+H+W	-81	-1																
					MMAT 1033	D+F+L+H+E	11	-61																
					MMAC 1033	D+F+L+H+E	-23	-61																
				2-VL	MTCM 1035	D+F+L+H+E	57	-9	D+F+L+H+W	47	3.12	-	-	-	-	-	-	-	-	-				
					MCCM 1019	D+F+L+H+E	-118	-14																
					MMAT 1031	D+F+L+H+E	9	-67																
					MMAC 1031	D+F+L+H+E	-40	-67																
3-VL	MTCM 1030	D+F+L+H+E	154	-102	D+F+L+H+W	45	6.24	-	-	-	-	-	-	-	-	-								
	MCCM 1030	D+F+L+H+E	-255	-50																				
	MMAT 1030	D+F+L+H+E	50	-179																				
	MMAC 1030	D+F+L+H+E	-101	-179																				

Table 3H.6-11: Results of DGFS Vault Concrete Design (Continued)

Location	Thickness (ft)	Face	Direction	Reinforcement Layout Drawing Number (1)	Reinforcement Zone Number (2)	Maximum Force (3)	Element	Longitudinal Reinforcement Design Loads				Longitudinal Reinforcement Provided (in ² /ft)	Transverse Shear Design Loads (4)				Transverse Shear (7) Reinforcement Provided (in ² /ft)	Remarks		
								Axial and Flexure Loads		In-Plane Shear Loads			Horizontal Section		Vertical Section					
								Load Combination	Axial (4) (kips / ft)	Flexure (4) (ft-kips / ft)	Load Combination		In-plane Shear (kips / ft)	Load Combination	Transverse Shear Force (kip / ft)	Corresponding Axial Force (kip / ft)			Transverse Shear Force (kip / ft)	Corresponding Axial Force (kip / ft)
Well 9	2	F/R Side	Horizontal	316-173	1-HL	MTCM	1032	D+F+L+H+E	31	17	D+F+L+H+W	58	1.58							
						MCCM	266	D+F+L+H+W	-131	16										
						MBAT	955	D+F+L+H+W	8	49										
						MSAC	233	D+F+L+H+W	-41	63										
			MTCM		1030	D+F+L+H+W	52	9	D+F+L+H+W	58	3.12									
			MCCM		1030	D+F+L+H+W	-108	29												
			MBAT		1011	D+F+L+H+W	2	37												
			MSAC		1000	D+F+L+H+W	-42	45												
		MTCM	992	D+F+L+H+E	43	4	D+F+L+H+W	47	1.58											
		MCCM	983	D+F+L+H+W	-120	7														
		MBAT	1026	D+F+L+H+W	1	12														
		MSAC	995	D+F+L+H+W	-50	65														
		MTCM	1035	D+F+L+H+E	52	4	D+F+L+H+W	45	3.12											
		MCCM	1030	D+F+L+H+W	-238	2														
MBAT	1023	D+F+L+H+W	62	5																
MSAC	1005	D+F+L+H+W	-187	27																
			Vertical	316-178A	1-VL															
			Vertical	316-178B	2-VL															
			Vertical	316-178C	1-T								D+F+L+H+E	-34	123	-34	4	0.44 (30%)		
			Vertical	316-178D	2-T								D+F+L+H+E	-43	114	-55	-2	1.24 (56%)		
Well 10	2	Rear Side	Horizontal	316-177	1-HL	MTCM	1233	D+F+L+H+E	35	34	D+F+L+H+W	59	1.58							
						MCCM	1215	D+F+L+H+W	-96	4										
						MBAT	1201	D+F+L+H+W	4	43										
						MSAC	1201	D+F+L+H+W	-15	79										
					MTCM	1245	D+F+L+H+E	40	43	D+F+L+H+W	59	3.12								
					MCCM	1245	D+F+L+H+W	-85	8											
					MBAT	1255	D+F+L+H+W	53	75											
					MSAC	1197	D+F+L+H+W	-36	68											
			MTCM		1257	D+F+L+H+E	74	60	D+F+L+H+W	59	4.58									
			MCCM		1257	D+F+L+H+W	-155	-10												
			MBAT		1257	D+F+L+H+W	34	66												
			MSAC		1257	D+F+L+H+W	-11	58												
			MTCM		1282	D+F+L+H+E	53	6	D+F+L+H+W	38	1.58									
			MCCM		1243	D+F+L+H+W	-82	-1												
			MBAT		1234	D+F+L+H+W	13	61												
			MSAC		1234	D+F+L+H+W	-15	61												
		MTCM	1259	D+F+L+H+E	123	65	D+F+L+H+W	38	3.12											
		MCCM	1259	D+F+L+H+W	-145	4														
		MBAT	1245	D+F+L+H+W	11	-103														
		MSAC	1245	D+F+L+H+W	-45	-103														
		MTCM	1257	D+F+L+H+E	144	-98	D+F+L+H+W	36	6.24											
		MCCM	1257	D+F+L+H+W	-217	-53														
		MBAT	1257	D+F+L+H+W	51	-138														
		MSAC	1257	D+F+L+H+W	-75	-138														
					Horizontal	316-179	1-HL	MTCM	1233	D+F+L+H+E	31	21	D+F+L+H+W	59	1.58					
					Horizontal	316-179	1-HL	MCCM	1285	D+F+L+H+W	-179	19								
					Horizontal	316-179	1-HL	MBAT	1284	D+F+L+H+W	0	49								
					Horizontal	316-179	1-HL	MSAC	1232	D+F+L+H+W	-41	66								

Table 3H.6-11: Results of DGFS Vault Concrete Design (Continued)

Location	Thickness (ft)	Face	Direction	Reinforcement Layout Drawing Number (1)	Reinforcement Zone Number ⁽²⁾	Maximum Force (k)	Element	Longitudinal Reinforcement Design Loads				Longitudinal Reinforcement Provided (in ² /ft)	Transverse Shear Design Loads ⁽³⁾				Transverse Shear ⁽¹⁾ Reinforcement Provided (in ² /ft)	Remarks			
								Axial and Flexure Loads		In-Plane Shear Loads			Horizontal Section		Vertical Section						
								Load Combination	Axial ⁽⁴⁾ (kips / ft)	Flexure ⁽⁴⁾ (ft-kips / ft)	Load Combination		In-plane Shear ⁽⁵⁾ (kips / ft)	Load Combination	Transverse Shear Force (kip / ft)	Corresponding Axial Force (kip / ft)			Transverse Shear Force (kip / ft)	Corresponding Axial Force (kip / ft)	
Well 10	2	Far Side	Horizontal	316-179	2-HL	MTCM	1257	D+F+L+H+WE	51	7	D+F+L+H+WE	59	3.12								
						MCCM	1257	D+F+L+H+WE	-155	25											
						MBAT	1199	D+F+L+H+WE	0	40											
						MMAC	1198	D+F+L+H+WE	-5	45											
			Vertical	316-180A	1-VL	MTCM	1281	D+F+L+H+WE	51	4	D+F+L+H+WE	38	1.56								
						MCCM	1344	D+F+L+H+WE	-120	5											
						MBAT	1235	D+F+L+H+WE	1	20											
						MMAC	1285	D+F+L+H+WE	-47	55											
		Vertical	316-180B	2-VL	MTCM	1195	D+F+L+H+WE	50	3	D+F+L+H+WE	38	3.12									
					MCCM	1257	D+F+L+H+WE	-191	4												
					MBAT	1199	D+F+L+H+WE	53	7												
					MMAC	1259	D+F+L+H+WE	-140	27												
		Thickened Horizontal (Vertical)	316-180C	1-T	-	-	-	-	-	-	-	D+F+L+H+WE	-31	120	10	3	0.44 (3#5)				
					2-T	-	-	-	-	-	-	-	-	D+F+L+H+WE	-32	102	27	-12	0.89 (4#5)		
Well 11	2	Near Side	Horizontal	316-181	1-HL	MTCM	921	D+F+L+H+WE	43	-7	D+F+L+H+WE	55	1.56								
						MCCM	939	D+F+L+H+WE	-85	-1											
						MBAT	921	D+F+L+H+WE	34	-44											
						MMAC	947	D+F+L+H+WE	-2	51											
			Vertical	316-182	1-VL	MTCM	944	D+F+L+H+WE	57	4	D+F+L+H+WE	43	1.56								
						MCCM	939	D+F+L+H+WE	-94	55											
						MBAT	935	D+F+L+H+WE	9	-35											
						MMAC	927	D+F+L+H+WE	-80	-35											
		Far Side	Horizontal	316-183	1-HL	MTCM	934	D+F+L+H+WE	31	5	D+F+L+H+WE	55	1.56								
						MCCM	927	D+F+L+H+WE	-210	52											
						MBAT	947	D+F+L+H+WE	5	45											
						MMAC	935	D+F+L+H+WE	-23	59											
		Vertical	316-184	1-VL	MTCM	944	D+F+L+H+WE	34	4	D+F+L+H+WE	43	1.56									
					MCCM	927	D+F+L+H+WE	-194	23												
					MBAT	925	D+F+L+H+WE	0	56												
					MMAC	927	D+F+L+H+WE	-73	59												
		Well 12	4	Near Side	Horizontal	316-185	1-HL	MTCM	1437	D+F+L+H+WE	24	-169	D+F+L+H+WE	102	3.12						
								MCCM	1345	D+F+L+H+WE	-129	-370									
								MBAT	1340	D+F+L+H+WE	14	-218									
								MMAC	1432	D+F+L+H+WE	-159	-474									
2-HL	MTCM						-	-	-	-	D+F+L+H+WE	85	4.29								
	MCCM						1433	D+F+L+H+WE	-129	-533											
3-HL	MTCM				1341	D+F+L+H+WE	-24	-175	D+F+L+H+WE	192	7.9										
	MCCM				1337	D+F+L+H+WE	-201	-531													
Vertical	316-186				1-VL	MTCM	1432	D+F+L+H+WE	51	-41	D+F+L+H+WE	100	3.12								
						MCCM	1440	D+F+L+H+WE	-150	-75											
						MBAT	1395	D+F+L+H+WE	4	-222											
						MMAC	1373	D+F+L+H+WE	-23	-230											

Table 3H.6-11: Results of DGFS Vault Concrete Design (Continued)

Location	Thickness (ft)	Face	Direction	Reinforcement Layout Drawing Number (1)	Reinforcement Zone Number (2)	Maximum Force (k)	Element	Longitudinal Reinforcement Design Loads				Longitudinal Reinforcement Provided (in ² /ft)	Transverse Shear Design Loads (3)				Transverse Shear (7) Reinforcement Provided (in ² /ft)	Remarks			
								Axial and Flexure Loads			In-Plane Shear Loads		Load Combination	In-plane Shear (kips/ft)	Horizontal Section				Vertical Section		
								Load Combination	Axial (4) (kips/ft)	Flexure (4) (ft-kips/ft)	Transverse Shear Force (kip/ft)				Corresponding Axial Force (kip/ft)	Transverse Shear Force (kip/ft)			Corresponding Axial Force (kip/ft)		
																				Transverse Shear Force (kip/ft)	Corresponding Axial Force (kip/ft)
Well 13	4	Half Side	Vertical	316-186	2-VL	MTCM 1430	D+F+L+H+E	125	-47	D+F+L+H+E	100	4.58	-	-	-	-	-				
						MCCM 1430	D+F+L+H+E	-210	-27												
						MBAT 1415	D+F+L+H+E	10	-200												
						MBAC 1415	D+F+L+H+E	-43	-200												
					3-VL	MTCM 1438	D+F+L+H+E	124	-118	D+F+L+H+E	100	6.24	-	-	-	-	-	-	-	-	
						MCCM 1435	D+F+L+H+E	-270	-22												
						MBAT 1408	D+F+L+H+E	41	-502												
						MBAC 1408	D+F+L+H+E	-12	-502												
					4-VL	MTCM 1382	D+F+L+H+E	22	-62	D+F+L+H+E	80	7.8	-	-	-	-	-	-	-	-	
						MCCM 1388	D+F+L+H+E	-88	-47												
						MBAT 1374	D+F+L+H+E	85	-714												
						MBAC 1388	D+F+L+H+E	-1	-577												
		1-HL	MTCM 1341	D+F+L+H+E	20	13	D+F+L+H+E	108	3.12	-	-	-	-	-	-	-	-				
			MCCM 1409	D+F+L+H+E	-194	54															
			MBAT 1349	D+F+L+H+E	1	80															
			MBAC 1383	D+F+L+H+E	-170	339															
		1-VL	MTCM 1343	D+F+L+H+E	98	57	D+F+L+H+E	100	3.12	-	-	-	-	-	-	-	-				
			MCCM 1335	D+F+L+H+E	-201	11															
			MBAT 1423	D+F+L+H+E	8	194															
			MBAC 1423	D+F+L+H+E	-109	212															
		2-VL	MTCM 1430	D+F+L+H+E	134	43	D+F+L+H+E	100	4.58	-	-	-	-	-	-	-	-				
			MCCM 1438	D+F+L+H+E	-270	42															
			MBAT 1385	D+F+L+H+E	50	339															
			MBAC 1400	D+F+L+H+E	-10	334															
		3-VL	MTCM 1383	D+F+L+H+E	73	275	D+F+L+H+E	90	6.24	-	-	-	-	-	-	-	-				
			MCCM 1391	D+F+L+H+E	-42	70															
			MBAT 1394	D+F+L+H+E	66	358															
			MBAC 1386	1.4D+1.4F+1.7L+1.7H+L7W	-1	235															
		1-T	-	-	-	-	-	-	-	D+F+L+H+E	13	23	-57	-130	0.20 (4#12)	-					
			2-T	-	-	-	-	-	-	D+F+L+H+E	7	1	-100	-62	0.31 (5#12)	-					
			3-T	-	-	-	-	-	-	D+F+L+H+E	8	57	174	-130	0.80 (4#8)	-					
		Well 13	4	Half Side	Horizontal	316-190	1-HL	MTCM 1874	D+F+L+H+WN	2	-17	D+F+L+H+E	102	3.12	-	-	-	-	-		
								MCCM 1953	D+F+L+H+E	-200	-62										
								MBAT 1873	D+F+L+H+E	0	42										
								MBAC 1953	D+F+L+H+E	-200	-62										
							2-HL	MTCM 1872	D+F+L+H+E	25	-10	D+F+L+H+E	102	4.58	-	-	-	-	-	-	-
MCCM 1942	D+F+L+H+E							-200	-57												
MBAT 1872	D+F+L+H+E							5	-199												
MBAC 1950	D+F+L+H+E							-199	-613												
3-HL	MTCM 1871						D+F+L+H+E	33	-48	D+F+L+H+E	102	6.24	-	-	-	-	-	-	-	-	
	MCCM 1925						D+F+L+H+E	-192	-77												
	MBAT 1884						D+F+L+H+E	11	-354												
	MBAC 1912						D+F+L+H+E	-120	-705												
4-HL	MTCM -						-	-	-	D+F+L+H+E	80	7.8	-	-	-	-	-	-	-	-	
	MCCM 1954						D+F+L+H+E	-202	-581												
	MBAT -						-	-	-												
	MBAC 1985						D+F+L+H+E	-100	-225												

Table 3H.6-11: Results of DGFS Vault Concrete Design (Continued)

Location	Thickness (ft)	Face	Direction	Reinforcement Layout Drawing Number (1)	Reinforcement Zone Number ⁽²⁾	Maximum Force (k)	Element	Longitudinal Reinforcement Design Loads				Longitudinal Reinforcement Provided (in ² /ft)	Transverse Shear Design Loads ⁽³⁾				Transverse Shear Reinforcement Provided (in ² /ft)	Remarks			
								Axial and Flexure Loads		In-Plane Shear Loads			Load Combination	In-plane Shear (kips / ft)	Horizontal Section				Vertical Section		
								Load Combination	Axial ⁽⁴⁾ (kips / ft)	Flexure ⁽⁴⁾ (ft-kips / ft)	Transverse Shear Force (kip / ft)				Corresponding Axial Force (kip / ft)	Transverse Shear Force (kip / ft)			Corresponding Axial Force (kip / ft)		
Wall 13	4	Near Side	Vertical	216/191	1-V/L	MTCM 1871	D+F+L+H+WN	72	-27	D-F+L+H+E	101	3.12									
						MCCM 1913	D+F+L+H+E	-155	-110												
						MMAT 1899	D+F+L+H+E	3	-174												
						MMAC 1906	D+F+L+H+E	-53	-174												
					2-V/L	MTCM 1857	D+F+L+H+E	155	-74	D-F+L+H+E	101	4.98									
						MCCM 1857	D+F+L+H+E	-280	-31												
						MMAT 1980	D+F+L+H+E	24	-422												
						MMAC 1980	D+F+L+H+E	-43	-422												
					3-V/L	MTCM 1904	D+F+L+H+E	86	-74	D-F+L+H+E	77	9.39									
						MCCM 1988	D+F+L+H+E	-119	-51												
						MMAT 1985	D+F+L+H+E	52	-258												
						MMAC 1987	D+F+L+H+E	-2	-258												
		Far Side	Vertical	216/192	1-H/L	MTCM 1871	D+F+L+H+E	37	152	D-F+L+H+E	105	3.12									
						MCCM 1945	D+F+L+H+E	-198	95												
						MMAT 1983	D+F+L+H+E	4	265												
					2-H/L	MTCM 1904	D+F+L+H+E	-180	414	D-F+L+H+E	53	4.98									
						MCCM 1904	D+F+L+H+E	-112	170												
						MMAT 1932	D+F+L+H+E	8	115												
				216/193	1-V/L	MTCM 1927	D+F+L+H+E	51	23	D-F+L+H+E	101	3.12									
						MCCM 1935	D+F+L+H+E	-201	3												
						MMAT 1937	D+F+L+H+E	5	179												
					2-V/L	MTCM 1957	D+F+L+H+E	141	17	D-F+L+H+E	101	4.98									
						MCCM 1957	D+F+L+H+E	-280	41												
						MMAT 1922	D+F+L+H+E	50	336												
216/194	1-T	-	-	-	-	-	-	D+F+L+H+E	-73	21	-6	-201	0.21 (4012)								
	2-T	-	-	-	-	-	-	D+F+L+H+E	5	2	107	-127	0.31 (5012)								
	3-T	-	-	-	-	-	-	D-F+L+H+E	1	46	-178	-138	0.59 (4007)								
Wall 14	2	Near Side	Vertical	216/195	1-H/L	MTCM 1579	D+F+L+H+WN	55	-13	D-F+L+H+WN	28	1.58									
						MCCM 1505	D+F+L+H+E	-118	-24												
						MMAT 1501	D+F+L+H+E	4	-56												
					2-H/L	MTCM 1853	D+F+L+H+E	31	-44	D-F+L+H+WN	28	3.12									
						MCCM 1426	D+F+L+H+E	-154	-34												
						MMAT 1853	D+F+L+H+E	7	-66												
			216/196	1-V/L	MTCM 1501	D+F+L+H+WN	42	4	D-F+L+H+WN	39	1.58										
					MCCM 1857	D+F+L+H+WN	-71	-1													
					MMAT 1589	D+F+L+H+WN	15	-42													
				2-V/L	MTCM 1496	D+F+L+H+E	21	-23	D-F+L+H+WN	39	3.12										
					MCCM 1496	D+F+L+H+E	-114	-11													
					MMAT 1544	D+F+L+H+E	22	-50													
MMAC 1496	D+F+L+H+E	-36	-58																		

Table 3H.6-11: Results of DGFS Vault Concrete Design (Continued)

Location	Thickness (ft)	Face	Direction	Reinforcement Layout Drawing Number (1)	Reinforcement Zone Number (2)	Maximum Force (3)	Element	Longitudinal Reinforcement Design Loads					Longitudinal Reinforcement Provided (in ² /ft)	Transverse Shear Design Loads ⁽⁴⁾				Transverse Shear ⁽⁷⁾ Reinforcement Provided (in ² /ft)	Remarks		
								Axial and Flexure Loads			In-Plane Shear Loads			Load Combination	In-plane Shear (kips / ft)	Horizontal Section				Vertical Section	
								Load Combination	Axial ⁽⁴⁾ (kips / ft)	Flexure ⁽⁴⁾ (ft-kips / ft)	Load Combination	Transverse Shear Force (kip / ft)				Corresponding Axial Force (kip / ft)	Transverse Shear Force (kip / ft)			Corresponding Axial Force (kip / ft)	
																					Transverse Shear Force (kip / ft)
Wall 14	2	NW Side	Vertical	316-106	3-VL	MTCM 1652	D+F+L+H+E	113	-34	D-F+L+H+E	35	4.93	-	-	-	-	-				
						MCCM 1654	D+F+L+H+E	-157	-10												
						MMAT 1652	D+F+L+H+E	57	-74												
						MMAC 1652	D+F+L+H+E	-42	-74												
					1-HL	MTCM 1625	D+F+L+H+E	50	20	D+F+L+H+W	28	1.56	-	-	-	-					
						MCCM 1503	D+F+L+H+W	-174	28												
						MMAT 1625	D+F+L+H+E	45	35												
						MMAC 1543	D+F+L+H+W	-75	68												
		2-HL	MTCM 1496	D+F+L+H+E	53	40	D+F+L+H+W	28	3.12	-	-	-	-								
			MCCM 1496	D+F+L+H+E	-150	15															
			MMAT 1652	D+F+L+H+E	50	52															
			MMAC 1652	D+F+L+H+E	-10	58															
		1-VL	MTCM 1557	D+F+L+H+W	31	3	D+F+L+H+W	30	1.56	-	-	-	-								
			MCCM 1567	D+F+L+H+W	-105	8															
			MMAT 1508	D+F+L+H+E	0	62															
			MMAC 1625	D+F+L+H+E	-51	30															
		2-VL	MTCM 1653	D+F+L+H+E	53	2	D+F+L+H+W	28	3.12	-	-	-	-								
			MCCM 1652	D+F+L+H+E	-221	60															
			MMAT 1652	D+F+L+H+E	1	68															
			MMAC 1652	D+F+L+H+E	-221	60															
1-T	-	-	-	-	-	-	-	D+F+L+H+E	-2	66	13	16	0.44 (23%)								
	2-T	-	-	-	-	-	-	D+F+L+H+E	-43	205	16	-222	0.38 (43%)								
Wall 15	2	NW Side	Vertical	316-200	1-HL	MTCM 1505	D+F+L+H+W	65	4	D-F+L+H+E	28	1.56	-	-	-	-	-				
						MCCM 1340	D+F+L+H+W	-40	-2												
						MMAT 1333	D+F+L+H+E	0	53												
						MMAC 1093	D+F+L+H+E	-14	63												
					2-HL	MTCM 1659	D+F+L+H+E	21	4	D+F+L+H+E	28	3.12	-	-	-	-					
						MCCM 1659	D+F+L+H+E	-33	-43												
						MMAT 1345	D+F+L+H+E	16	65												
						MMAC 1345	D+F+L+H+E	-27	-82												
		1-VL	MTCM 1703	D+F+L+H+E	53	-15	D+F+L+H+W	34	1.56	-	-	-	-								
			MCCM 1796	D+F+L+H+W	-107	-13															
			MMAT 1770	D+F+L+H+E	0	62															
			MMAC 1796	D+F+L+H+E	-11	-44															
		2-VL	MTCM 1689	D+F+L+H+W	75	-28	D+F+L+H+W	34	3.12	-	-	-	-								
			MCCM 1689	D+F+L+H+E	-65	-6															
			MMAT 1689	D+F+L+H+E	46	60															
			MMAC 1689	D+F+L+H+E	-1	-30															
		1-HL	MTCM 1643	D+F+L+H+W	24	1	D-F+L+H+E	28	1.56	-	-	-	-								
			MCCM 1696	D+F+L+H+W	-124	20															
			MMAT 1741	D+F+L+H+E	3	43															
			MMAC 1784	D+F+L+H+W	-86	57															
2-HL	MTCM 1652	D+F+L+H+E	22	26	D-F+L+H+E	28	3.12	-	-	-	-										
	MCCM 1713	D+F+L+H+E	-29	3																	
	MMAT 1645	D+F+L+H+E	13	38																	
	MMAC 1714	D+F+L+H+E	4	34																	


Table 3H.6-11: Results of DGFS Vault Concrete Design (Continued)

Location	Thickness (ft)	Face	Direction	Reinforcement Layout Drawing Number (1)	Reinforcement Zone Number (2)	Maximum Force (k)	Element	Longitudinal Reinforcement Design Loads				Longitudinal Reinforcement Provided (in ² /ft)	Transverse Shear Design Loads ⁽³⁾				Transverse Shear ⁽⁴⁾ Reinforcement Provided (in ² /ft)	Remarks			
								Axial and Flexure Loads		In-Plane Shear Loads			Load Combination	In-plane Shear (kips/ft)	Horizontal Section				Vertical Section		
								Load Combination	Axial ⁽⁵⁾ (kips/ft)	Flexure ⁽⁶⁾ (ft-kips/ft)	Transverse Shear Force (kip/ft)				Corresponding Axial Force (kip/ft)	Transverse Shear Force (kip/ft)			Corresponding Axial Force (kip/ft)		
Well 15	2	Far side	Vertical	316-204	1-VL	MTCM 1693	D+F+L+H+E	54	10	D+F+L+H+4W	34	1.58	-	-	-	-	-	-			
						MOCM 1706	D+F+L+H+4W	-106	6												
						MBAAT 1773	D+F+L+H+E	1	55												
						MBAAC 1856	D+F+L+H+4W	-23	72												
					2-VL	MTCM 1702	D+F+L+H+E	58	8	D+F+L+H+4W	34	3.12	-	-	-	-	-	-	-	-	-
						MOCM 1689	D+F+L+H+4W	-40	13												
						MBAAT 1714	D+F+L+H+E	1	13												
						MBAAC 1945	D+F+L+H+E	-70	22												
		Near side	Horizontal (Vertical)	316-030	1-H	-	-	-	-	-	-	D+F+L+H+E	22	26	36	33	0.44 (300)	-			
						-	-	-	-	-	-	-	-	-	-	-	-	-	-	-	
Well 16	2	Near Side	Horizontal	316-204	1-HL	MTCM 1434	D+F+L+H+4W	7	-4	D+F+L+H+4W	41	1.58	-	-	-	-	-	-			
						MOCM 1459	D+F+L+H+4W	-12	-4												
						MBAAT 1482	D+F+L+H+4W	5	-15												
						MBAAC 1432	D+F+L+H+4W	-4	-13												
					2-HL	MTCM 1485	D+F+L+H+E	13	-2	D+F+L+H+4W	51	3.12	-	-	-	-	-	-	-	-	-
						MOCM 1447	D+F+L+H+4W	-45	-6												
						MBAAT 1494	D+F+L+H+4W	0	-12												
						MBAAC 1470	D+F+L+H+4W	-41	0												
			Vertical	1-VL	MTCM 1430	D+F+L+H+4W	81	-4	D+F+L+H+4W	28	1.58	-	-	-	-	-	-	-	-	-	
					MOCM 1491	D+F+L+H+4W	-51	0													
					MBAAT 1449	D+F+L+H+E	5	-12													
					MBAAC 1491	D+F+L+H+4W	-51	0													
				2-VL	MTCM 1445	D+F+L+H+4W	37	-15	D+F+L+H+4W	28	3.12	-	-	-	-	-	-	-	-	-	
					MOCM 1447	D+F+L+H+4W	-40	0													
					MBAAT 1455	D+F+L+H+4W	6	0													
					MBAAC 1447	D+F+L+H+4W	-31	43													
		Far Side	Horizontal	316-206	1-HL	MTCM 1485	D+F+L+H+4W	13	8	D+F+L+H+4W	41	1.58	-	-	-	-	-	-	-		
						MOCM 1430	D+F+L+H+4W	-135	45												
						MBAAT 1490	D+F+L+H+4W	2	31												
						MBAAC 1430	D+F+L+H+4W	-134	45												
			2-HL	MTCM 1447	D+F+L+H+E	21	3	D+F+L+H+4W	51	3.12	-	-	-	-	-	-	-	-	-		
				MOCM 1475	D+F+L+H+4W	-54	10														
				MBAAT 1494	D+F+L+H+4W	3	11														
				MBAAC 1470	D+F+L+H+4W	-40	77														
		Vertical	1-VL	MTCM 1451	D+F+L+H+4W	32	11	D+F+L+H+4W	28	1.58	-	-	-	-	-	-	-	-	-		
				MOCM 1491	D+F+L+H+4W	-110	14														
				MBAAT 1492	D+F+L+H+4W	9	16														
				MBAAC 1491	D+F+L+H+4W	-60	70														
			2-VL	MTCM 1453	D+F+L+H+4W	47	15	D+F+L+H+4W	28	3.12	-	-	-	-	-	-	-	-	-		
				MOCM 1475	D+F+L+H+4W	-138	26														
				MBAAT 1482	D+F+L+H+4W	0	33														
				MBAAC 1475	D+F+L+H+4W	-6	41														


Table 3H.6-11: Results of DGFOS Vault Concrete Design (Continued)

Location	Thickness (ft)	Face	Direction	Reinforcement Layout Drawing Number (1)	Reinforcement Zone Number (2)	Maximum Force (3)	Element	Longitudinal Reinforcement Design Loads				Longitudinal Reinforcement Provided (in ² /ft)	Transverse Shear Design Loads (5)				Transverse Shear (7) Reinforcement Provided (in ² /ft)	Remarks	
								Axial and Flexure Loads		In-Plane Shear Loads			Load Combination	Horizontal Section		Vertical Section			
								Load Combination	Axial (4) (kips / ft)	Flexure (4) (ft-kips / ft)	Load Combination			In-plane (6) Shear (kips / ft)	Transverse Shear Force (kip / ft)	Corresponding Axial Force (kip / ft)			Transverse Shear Force (kip / ft)
Wall 16	2	-	Transverse (Horizontal / Vertical)	3116-203	1-T	-	-	-	-	-	-	-	-	-	-	-	1.24 (508)	Transverse shear reinforcement provided due to tomco missile impact evaluation.	


- Notes:
- (1) The reinforcement layout drawings show the various zones used to define the minimum reinforcement that will be provided based on finite element analysis results. Actual provided reinforcement based on final rebar layout and including development length may exceed the reported provided reinforcement and the zones with higher reinforcement may be extended beyond their reported boundaries. The dimensions in the reinforcement drawings are based on the dimensions of the SAP2000 shell elements, which are modeled at the centerline of the walls and slabs. Therefore, the reinforcement drawing dimensions do not match actual building dimensions.
 - (2) Each reinforcement layout drawing is divided into reinforcement zones. The reinforcement zone naming convention is as follows: "H" = horizontal, "V" = vertical, "L" = longitudinal reinforcement, "T" = transverse reinforcement. For slabs, vertical corresponds to Y-axis and horizontal corresponds to X-axis as shown on Figure 3H.6-140.
 - (3) The maximum tension (MTCA) and compression (MCOM) axial forces are provided with the corresponding moment from the same load combination. The maximum moment that has a corresponding tension (MBAT) in the same load combination and the maximum moment that has a corresponding compression (MBAC) in the same load combination are also provided.
 - (4) Negative axial load is compression and positive axial load is tension. Negative moment applies tension to the top face of the shell element and positive moment applies tension to the bottom face of the shell element. For walls or slabs where the same reinforcement is provided on both faces, the moment is shown as absolute value. The axial and flexural loads reported in the table are the average of the 2 node pairs that form the 4 edges of the critical rectangular shell element. If the 2 node pairs on the shell element edges parallel to the reinforcement direction do not satisfy P&M interaction criteria, then only the 2 node pairs on the shell element edges perpendicular to the reinforcement direction are used for design (effective width considered).
 - (5) The reported in-plane shear is the maximum average in-plane shear along a plane that crosses the longitudinal reinforcement zone.
 - (6) The transverse shear reinforcement loads are reported for the critical element requiring the largest area of steel for transverse reinforcement within the zone. The shear force and the corresponding axial force in the same load combination for each direction is reported for the critical element.
 - (7) The reported transverse shear reinforcement is the summation of the required shear reinforcement in the horizontal direction and the required shear reinforcement in the vertical direction.
 - (8) For certain areas of the structure, the standard element post-processing methods were too conservative. For such cases, detailed manual design was performed and the design forces determined by the detailed manual design are provided in the table.
 - (9) The reported forces are from the FEM analysis. The provided longitudinal reinforcement includes additional reinforcement required due to manual one-way design calculations.
 - (10) The longitudinal reinforcement shown is required to be tied.

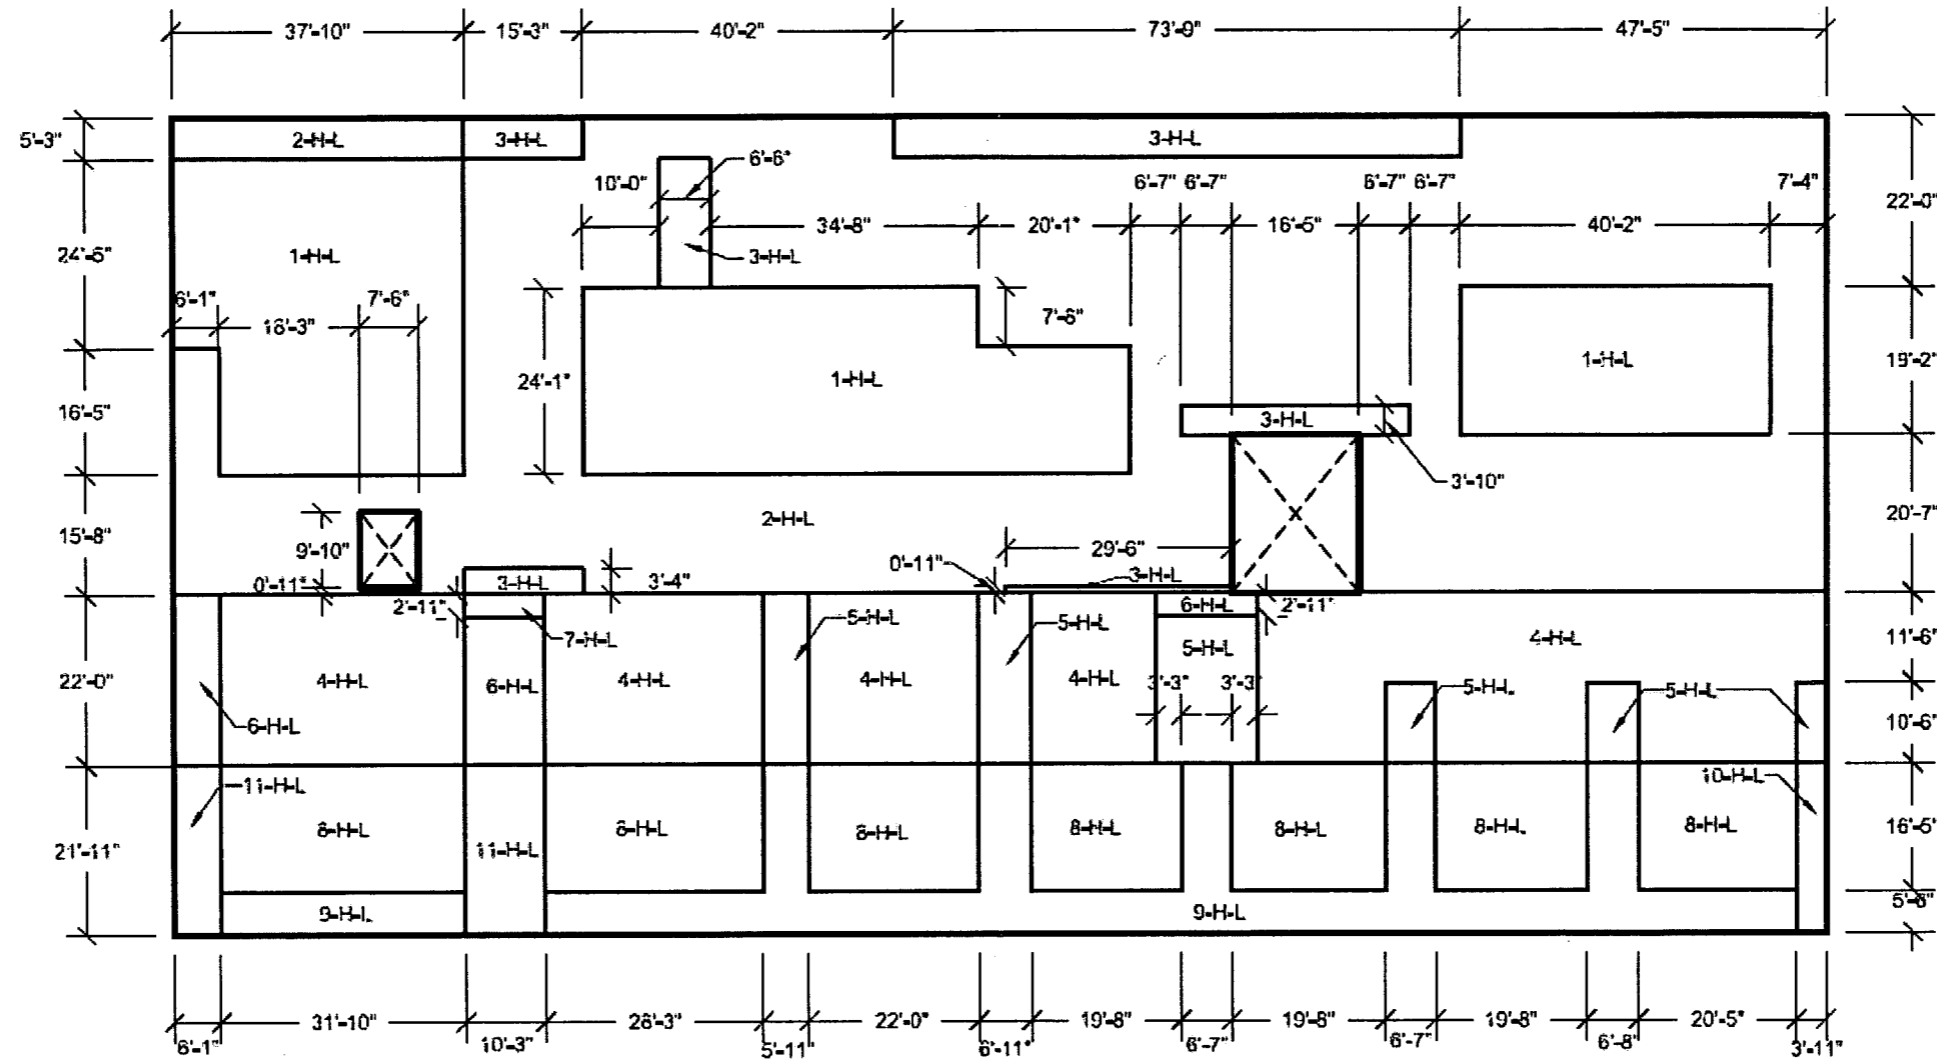


**FIGURE 3H.3-8: NORTH WALL LOOKING SOUTH
HORIZONTAL REINFORCEMENT ZONES
NEAR SIDE FACE**

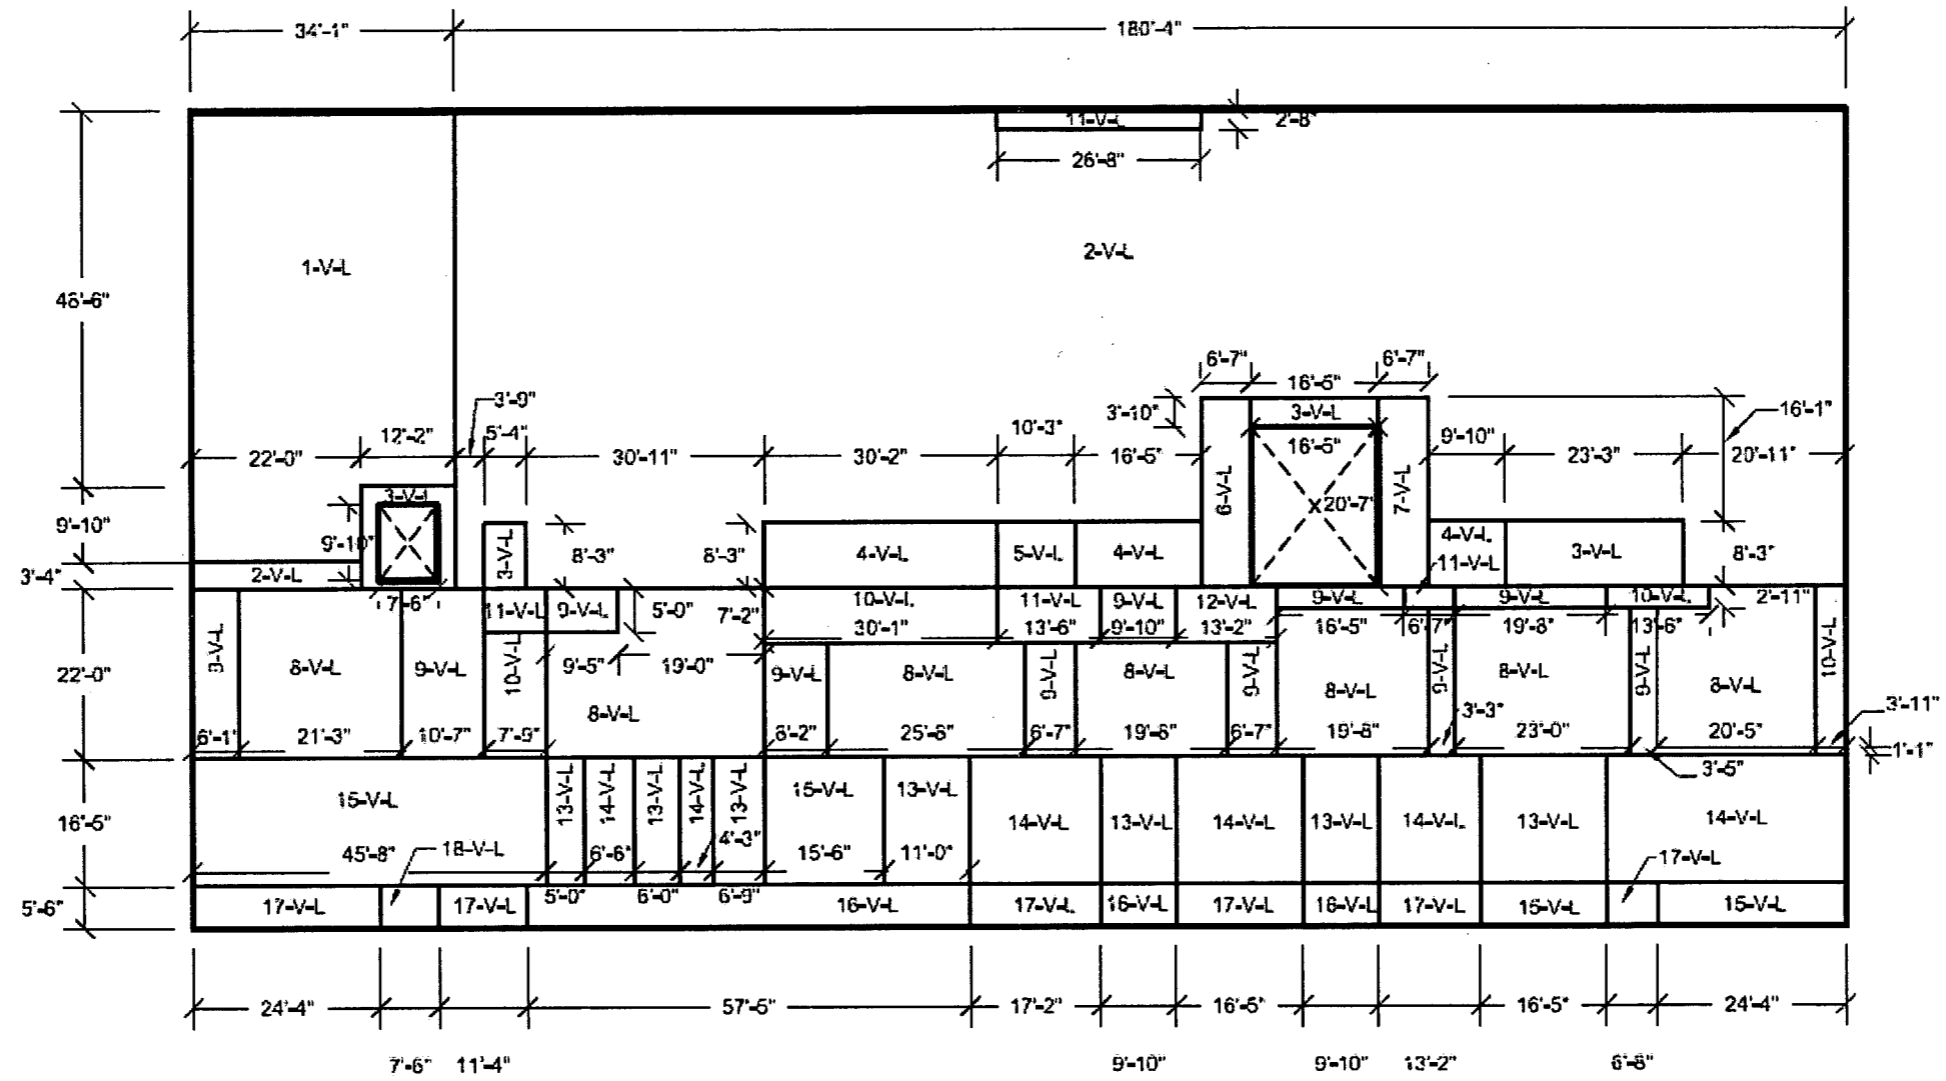


**FIGURE 3H.3-9: NORTH WALL LOOKING SOUTH
VERTICAL REINFORCEMENT ZONES
NEAR SIDE FACE**

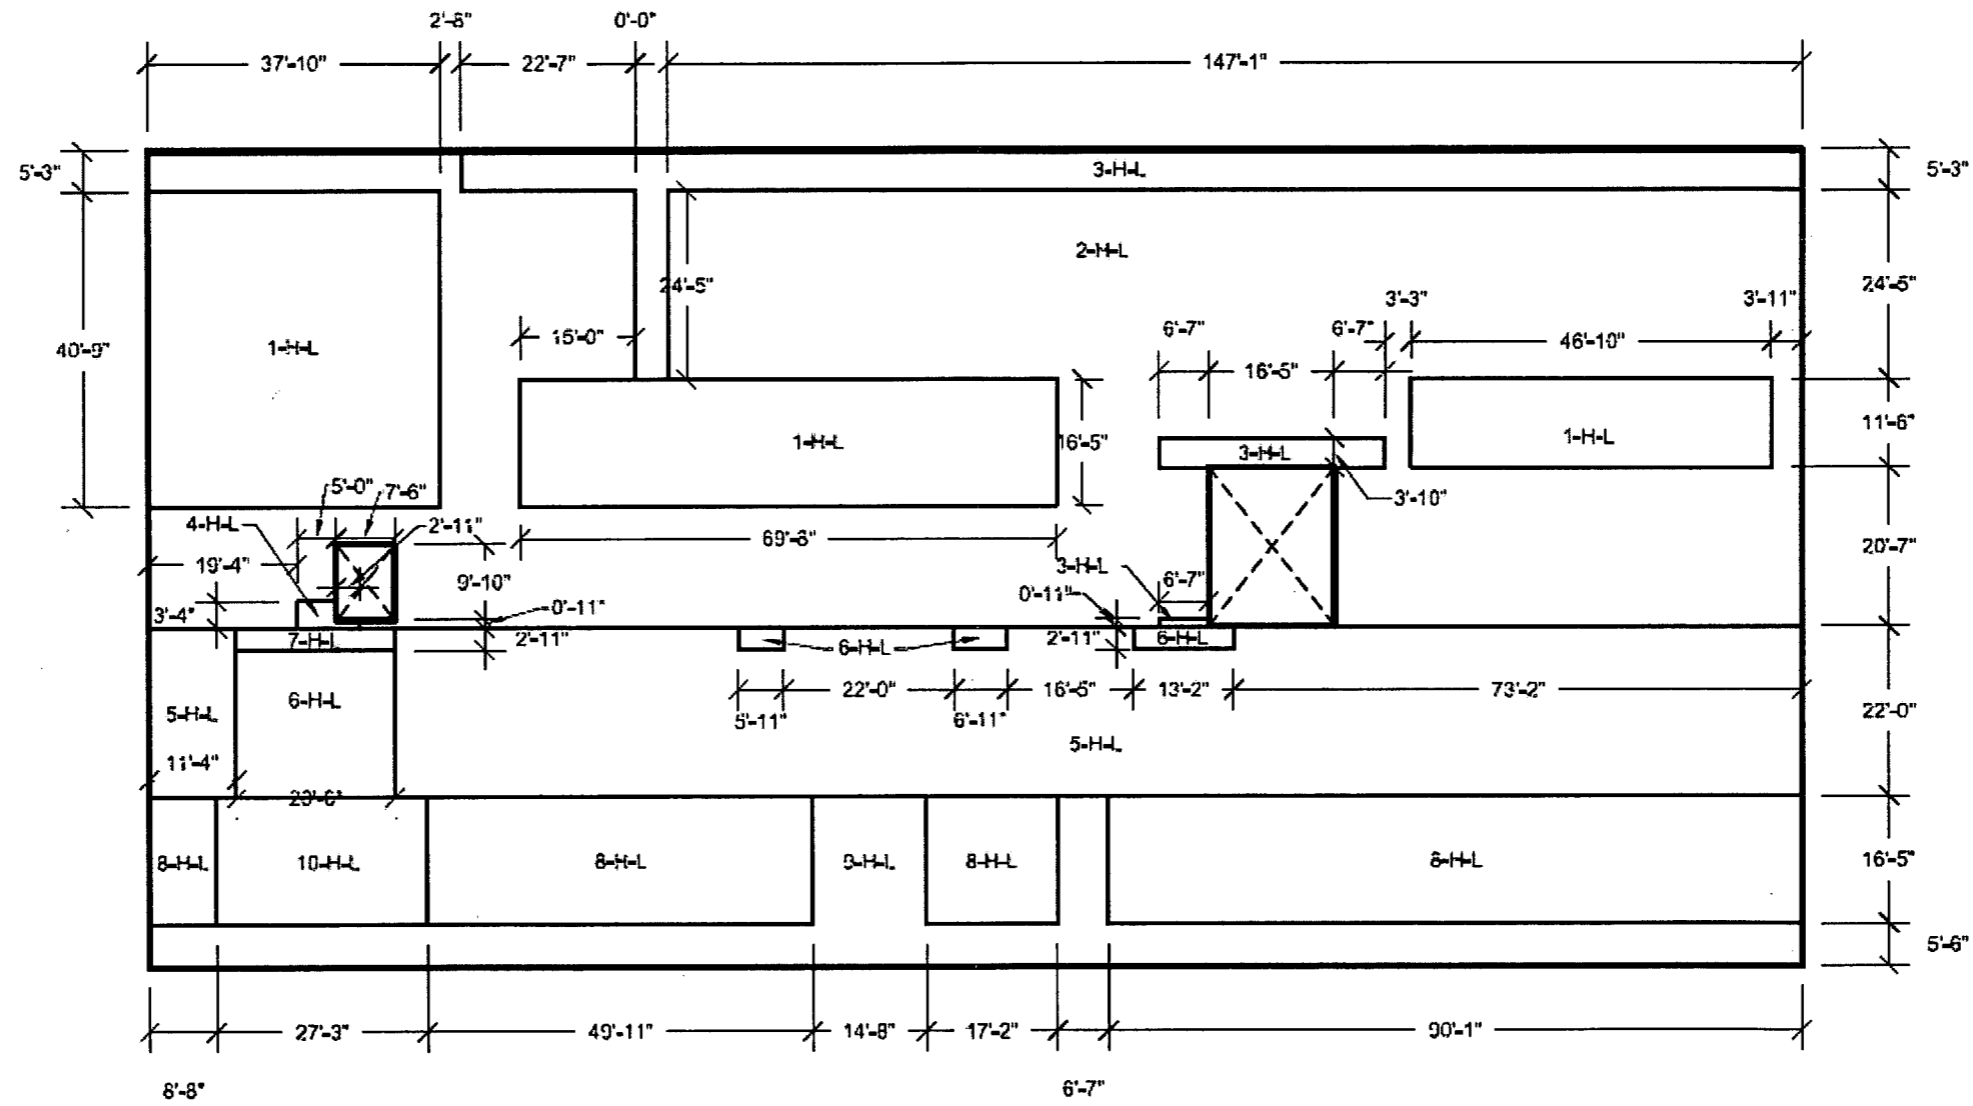


**FIGURE 3H.3-10: NORTH WALL LOOKING SOUTH
 HORIZONTAL REINFORCEMENT ZONES
 FAR SIDE FACE**

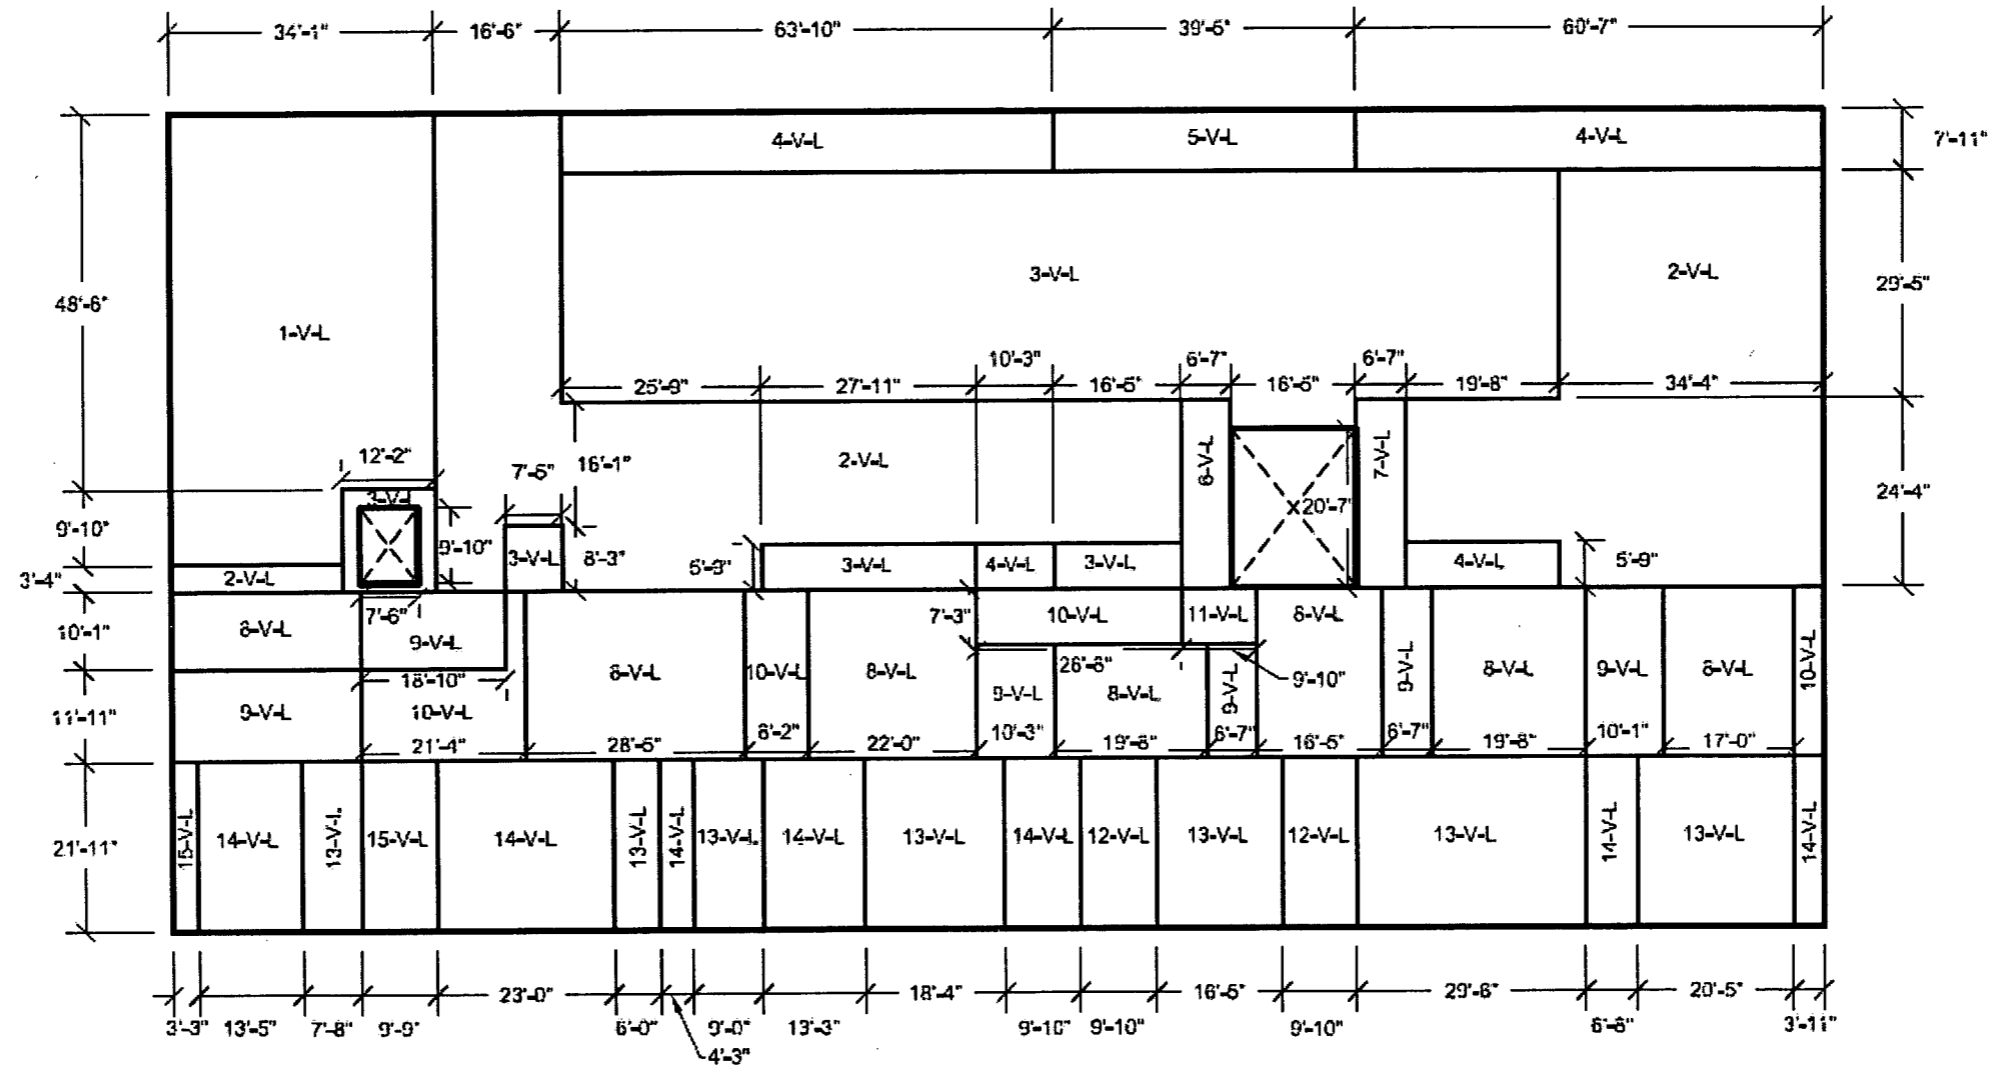


**FIGURE 3H.3-11: NORTH WALL LOOKING SOUTH
VERTICAL REINFORCEMENT ZONES
FAR SIDE FACE**

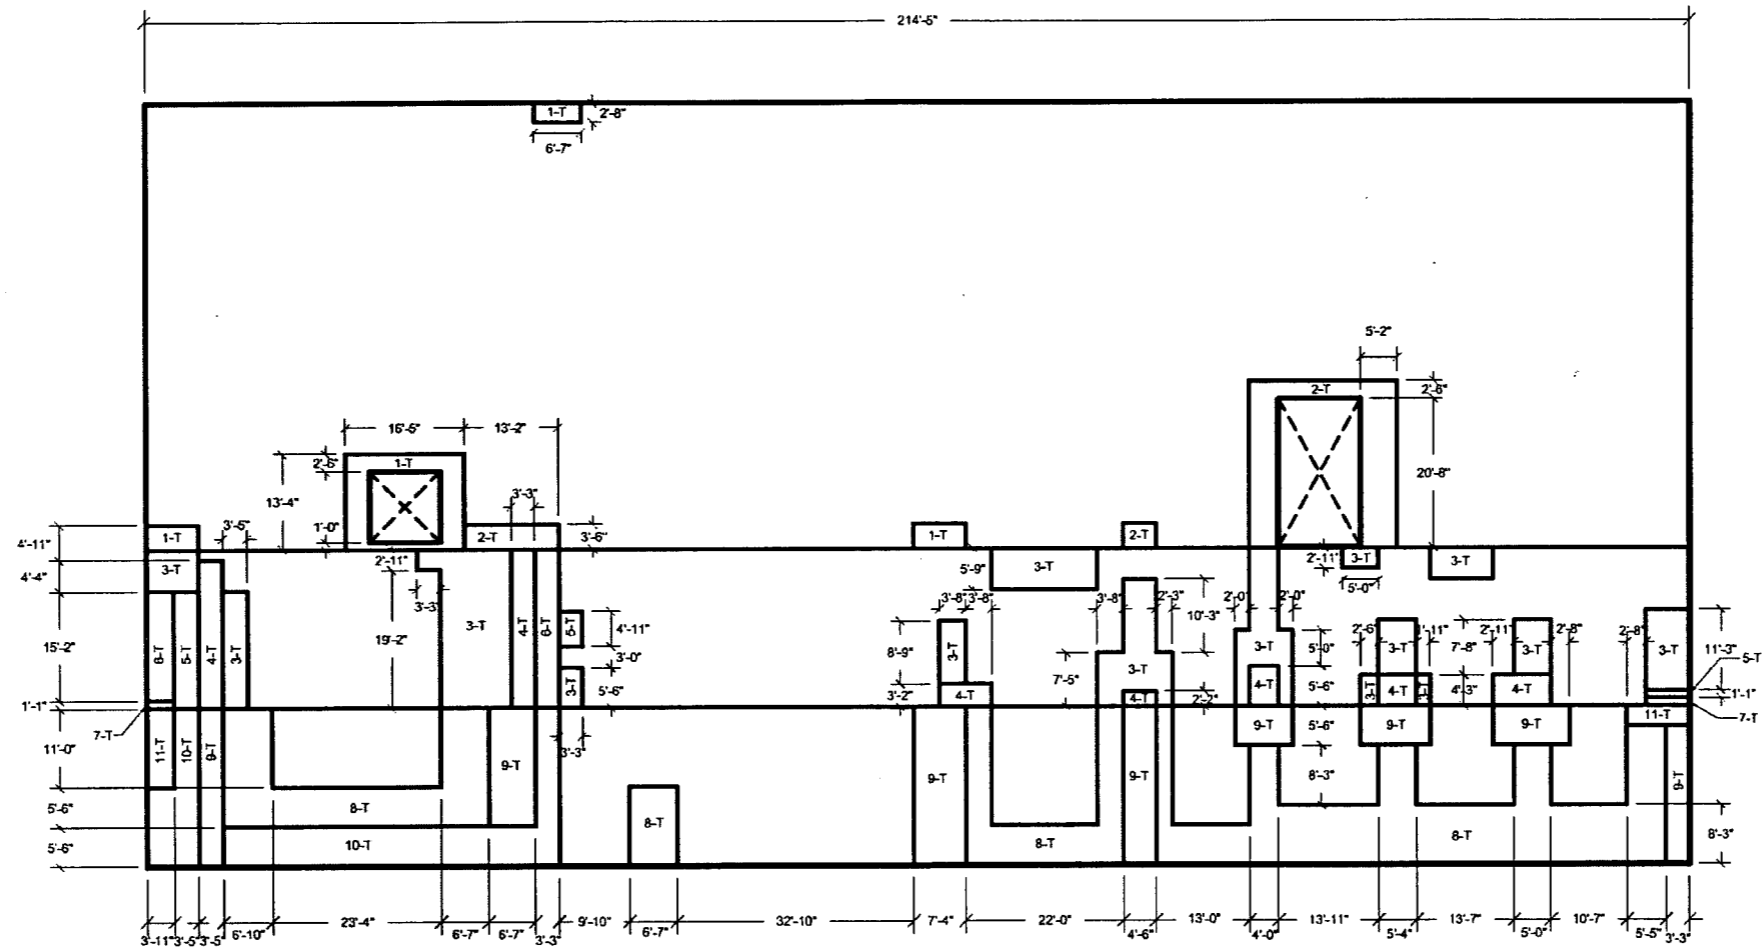


**FIGURE 3H.3-12: NORTH WALL LOOKING SOUTH
TRANSVERSE REINFORCEMENT ZONES**

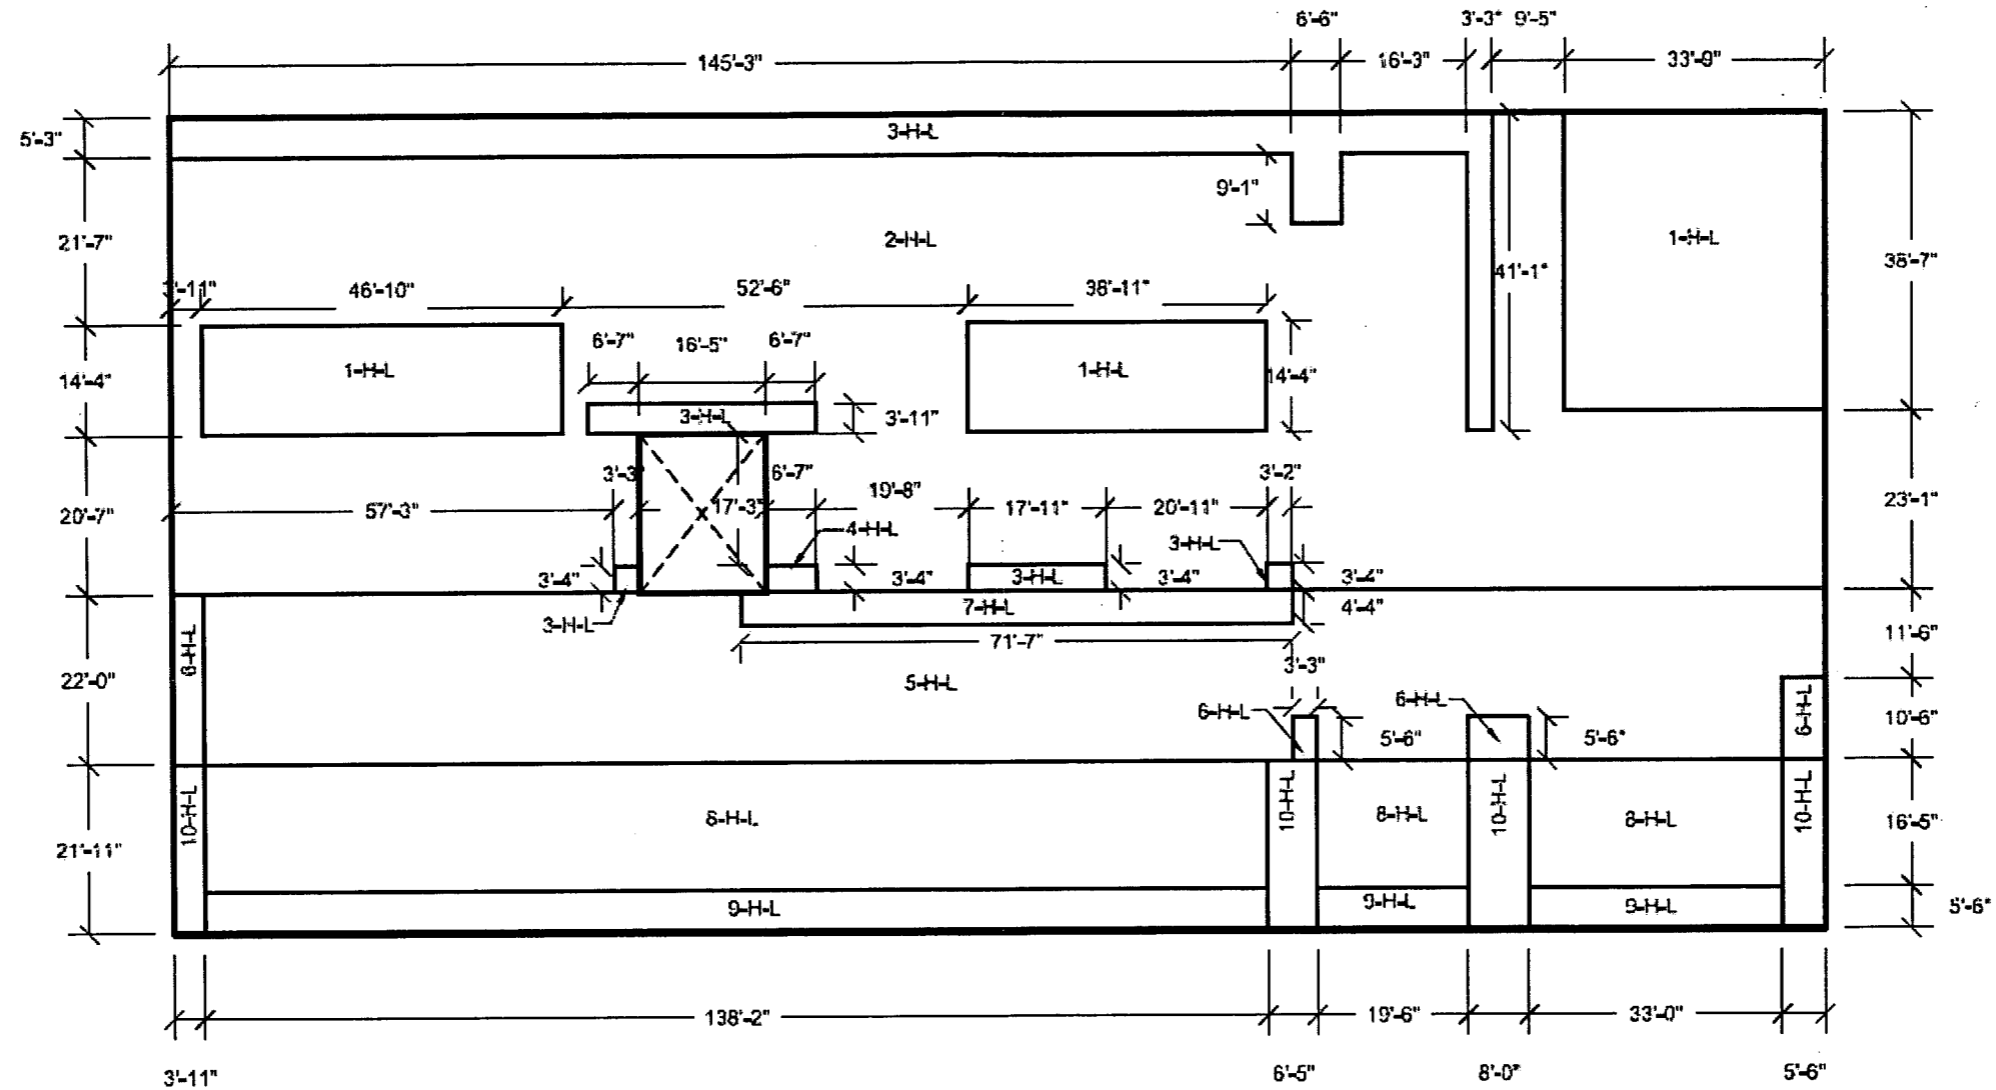


**FIGURE 3H.3-13: SOUTH WALL LOOKING NORTH
 HORIZONTAL REINFORCEMENT ZONES
 NEAR SIDE FACE**

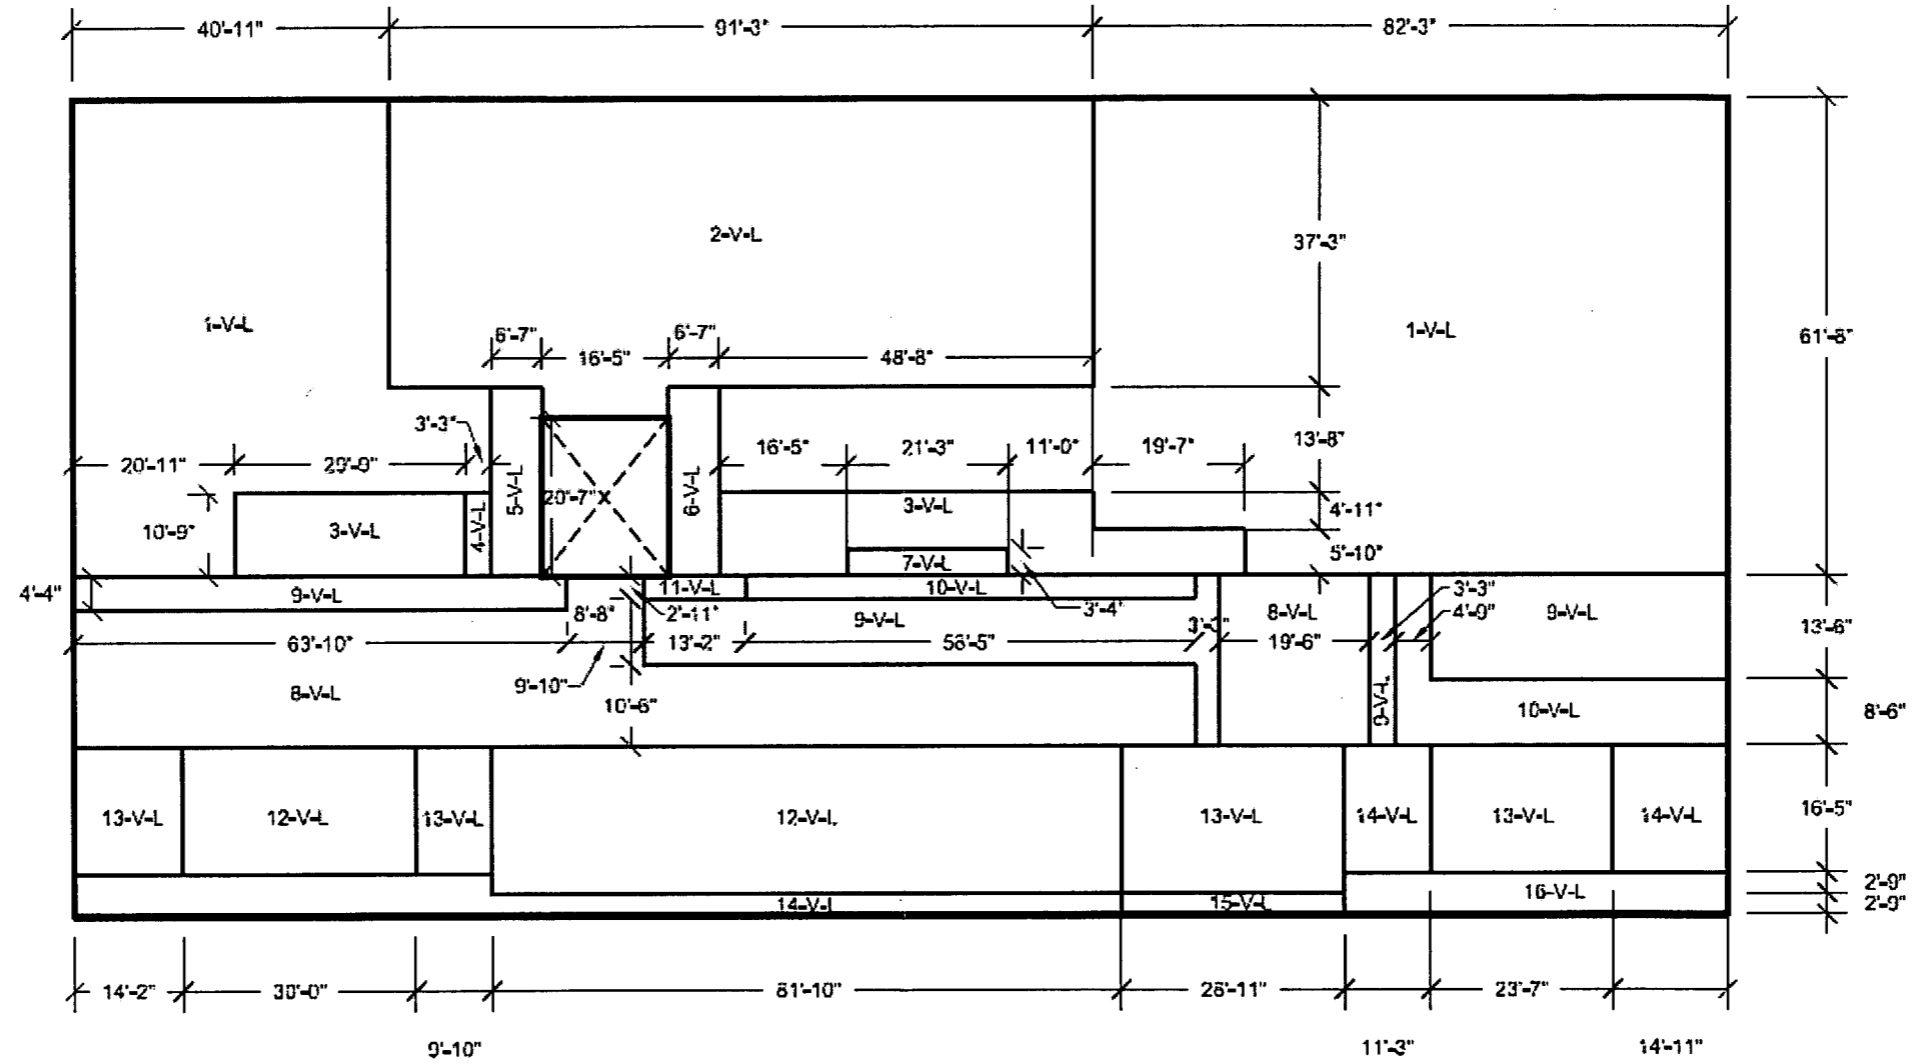


**FIGURE 3H.3-14; SOUTH WALL LOOKING NORTH
 VERTICAL REINFORCEMENT ZONES
 NEAR SIDE FACE**

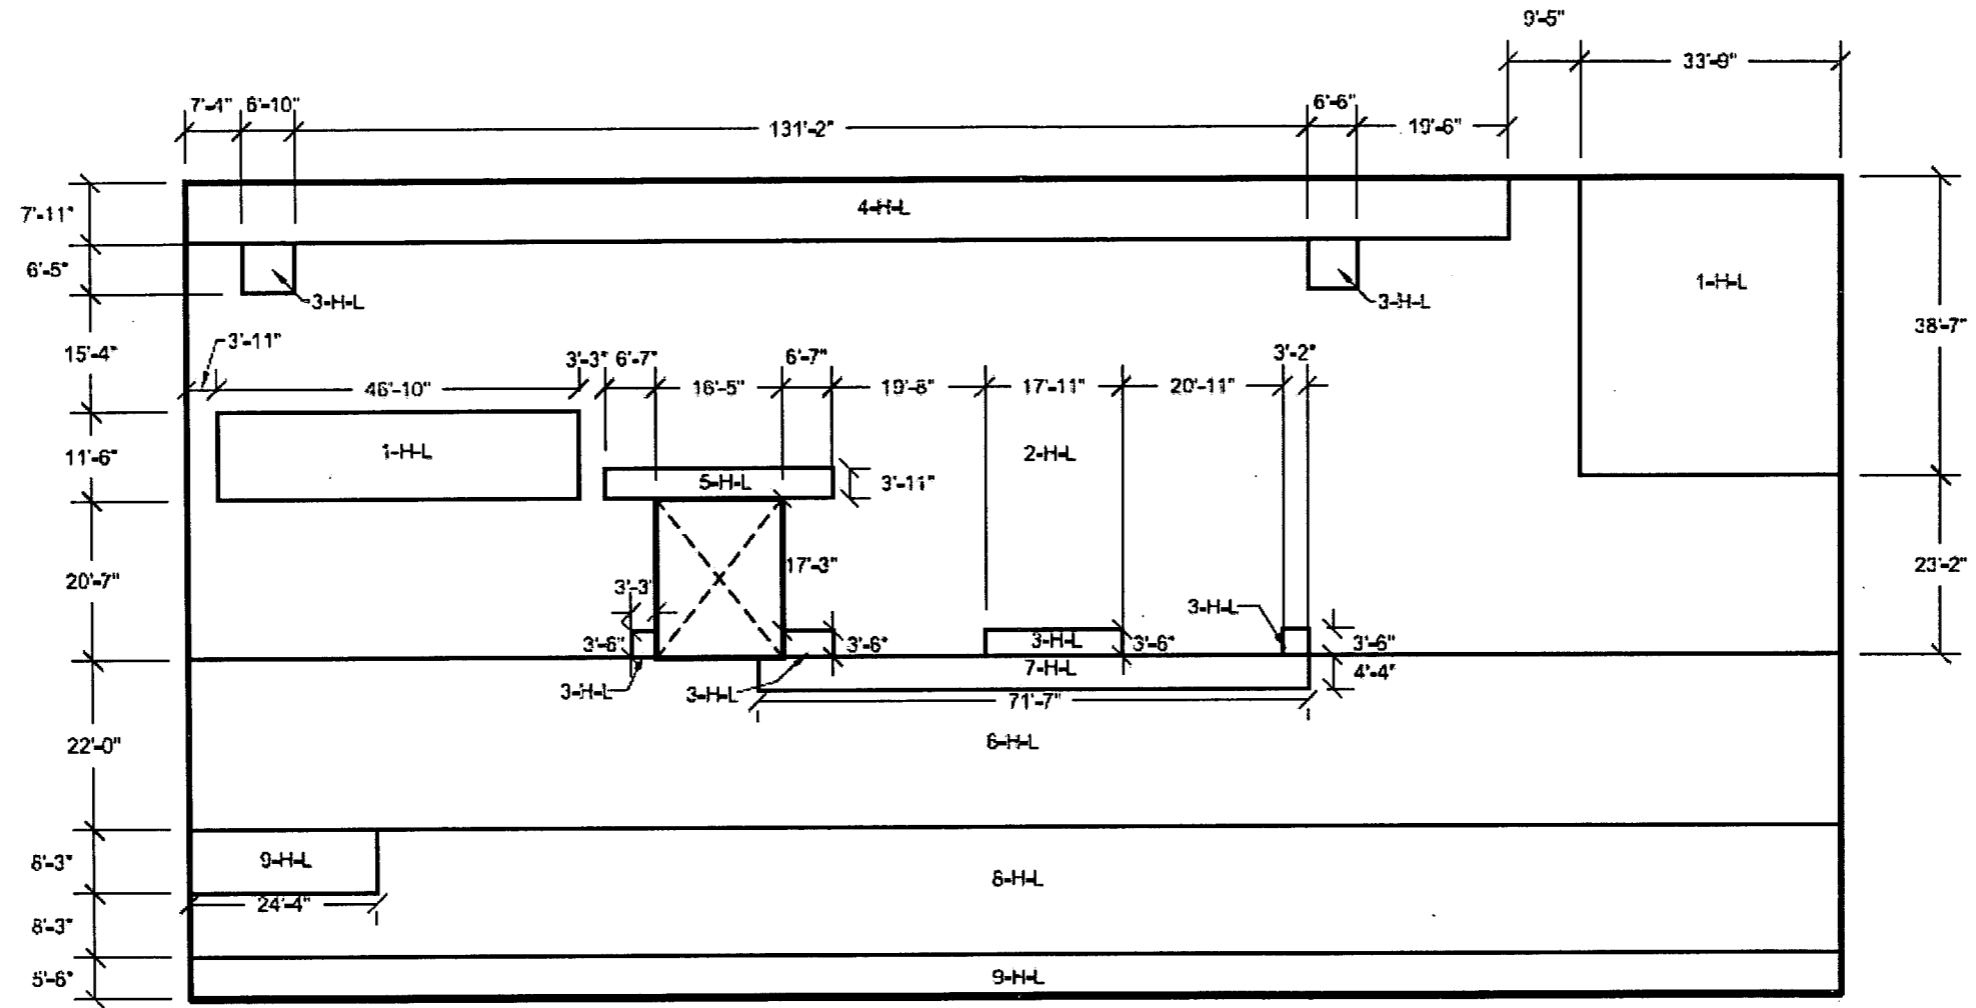


**FIGURE 3H.3-15: SOUTH WALL LOOKING NORTH
HORIZONTAL REINFORCEMENT ZONES
FAR SIDE FACE**

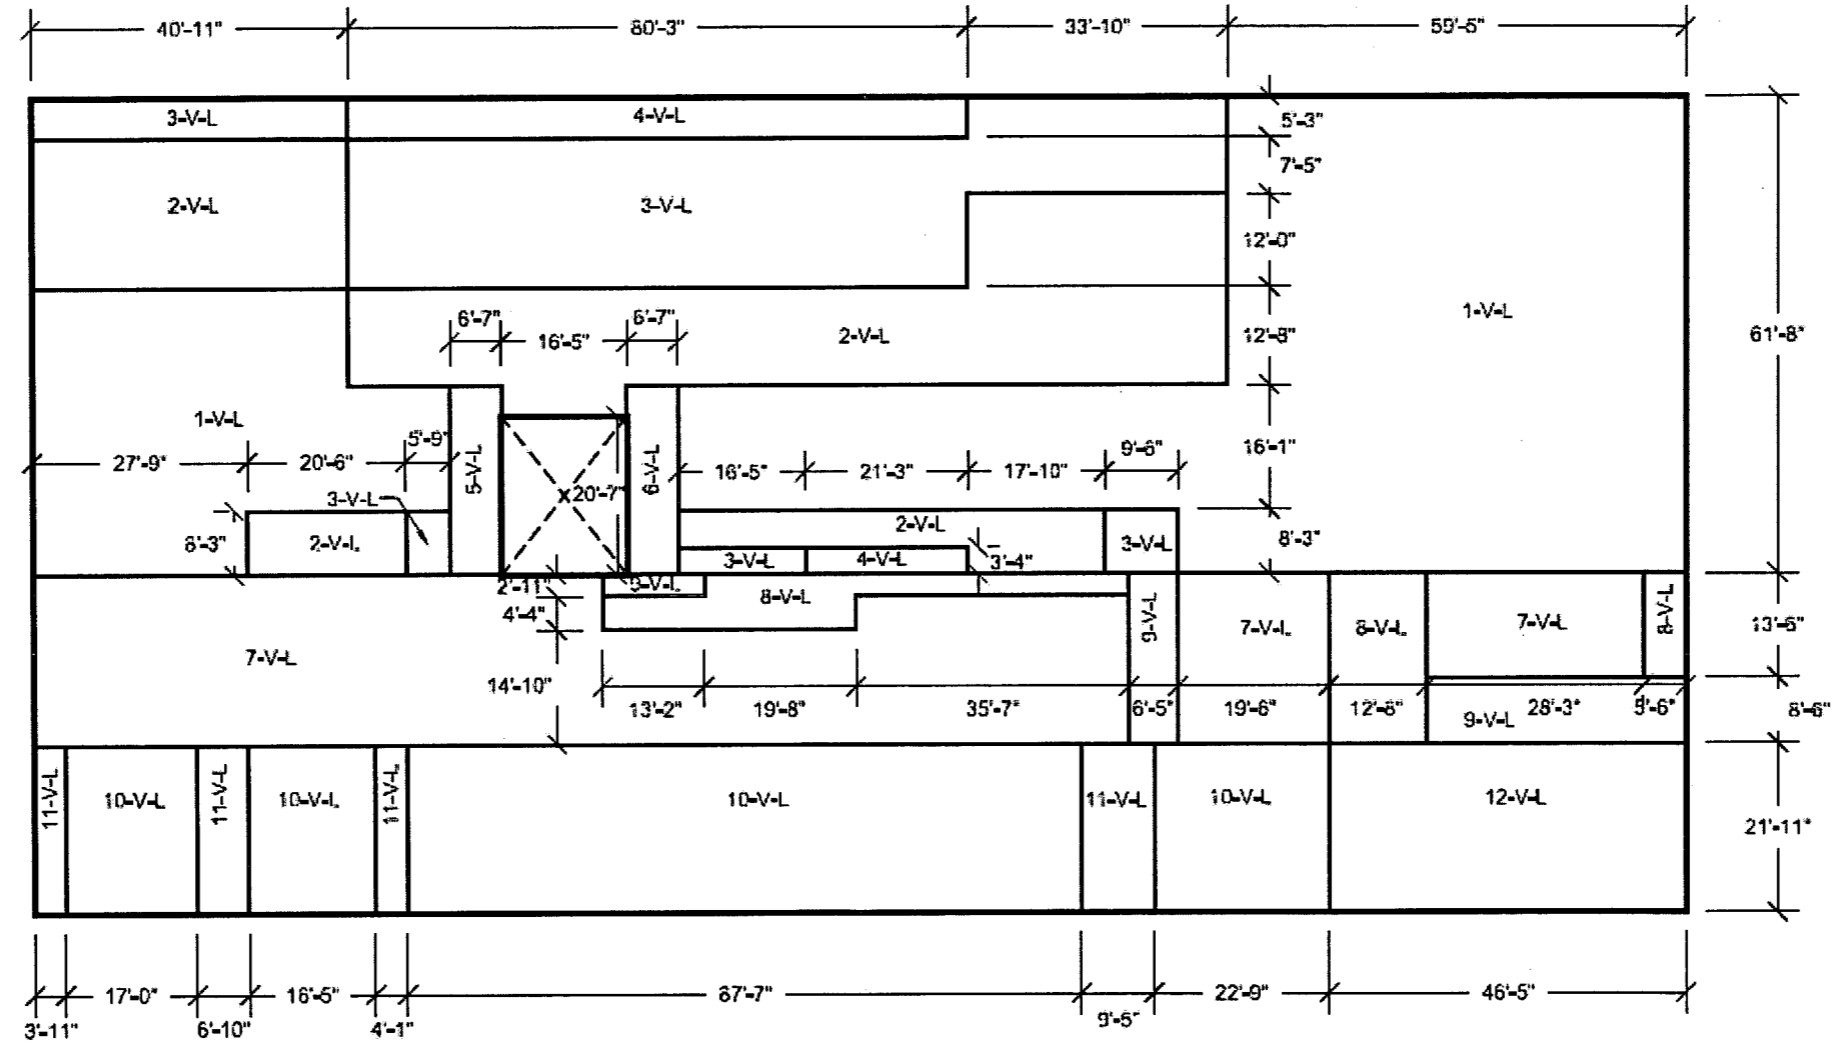


**FIGURE 3H.3-16; SOUTH WALL LOOKING NORTH
VERTICAL REINFORCEMENT ZONES
FAR SIDE FACE**

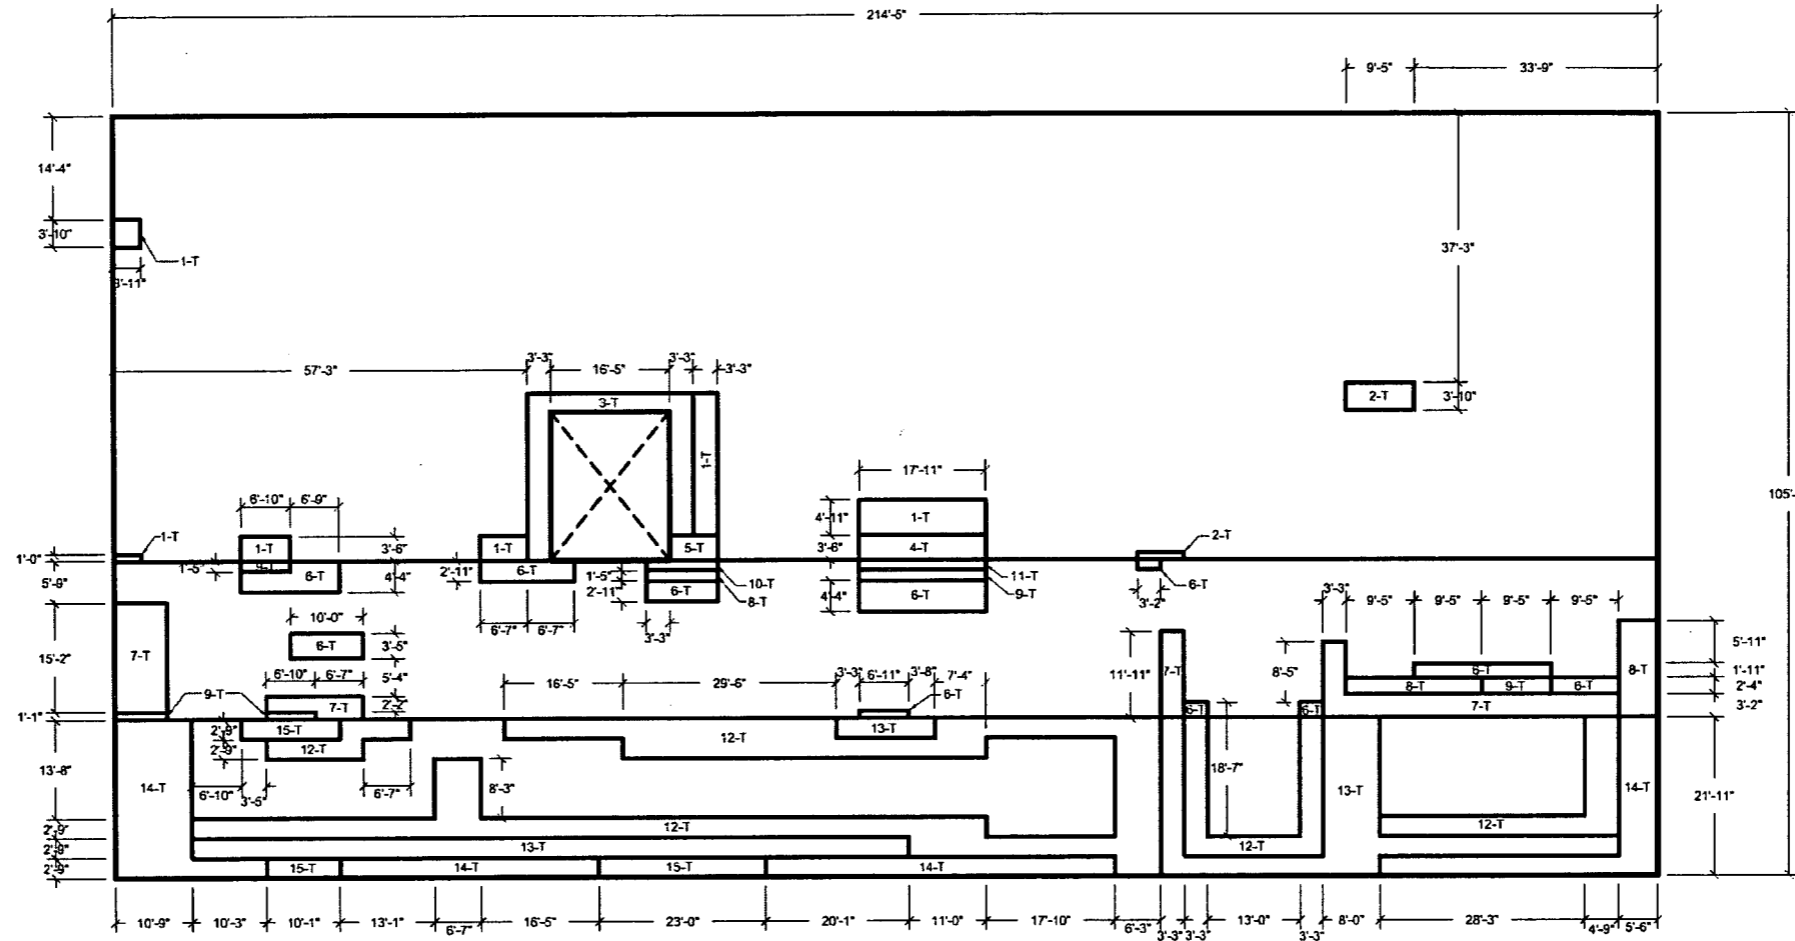


**FIGURE 3H.3-17: SOUTH WALL LOOKING NORTH
TRANSVERSE REINFORCEMENT ZONES**

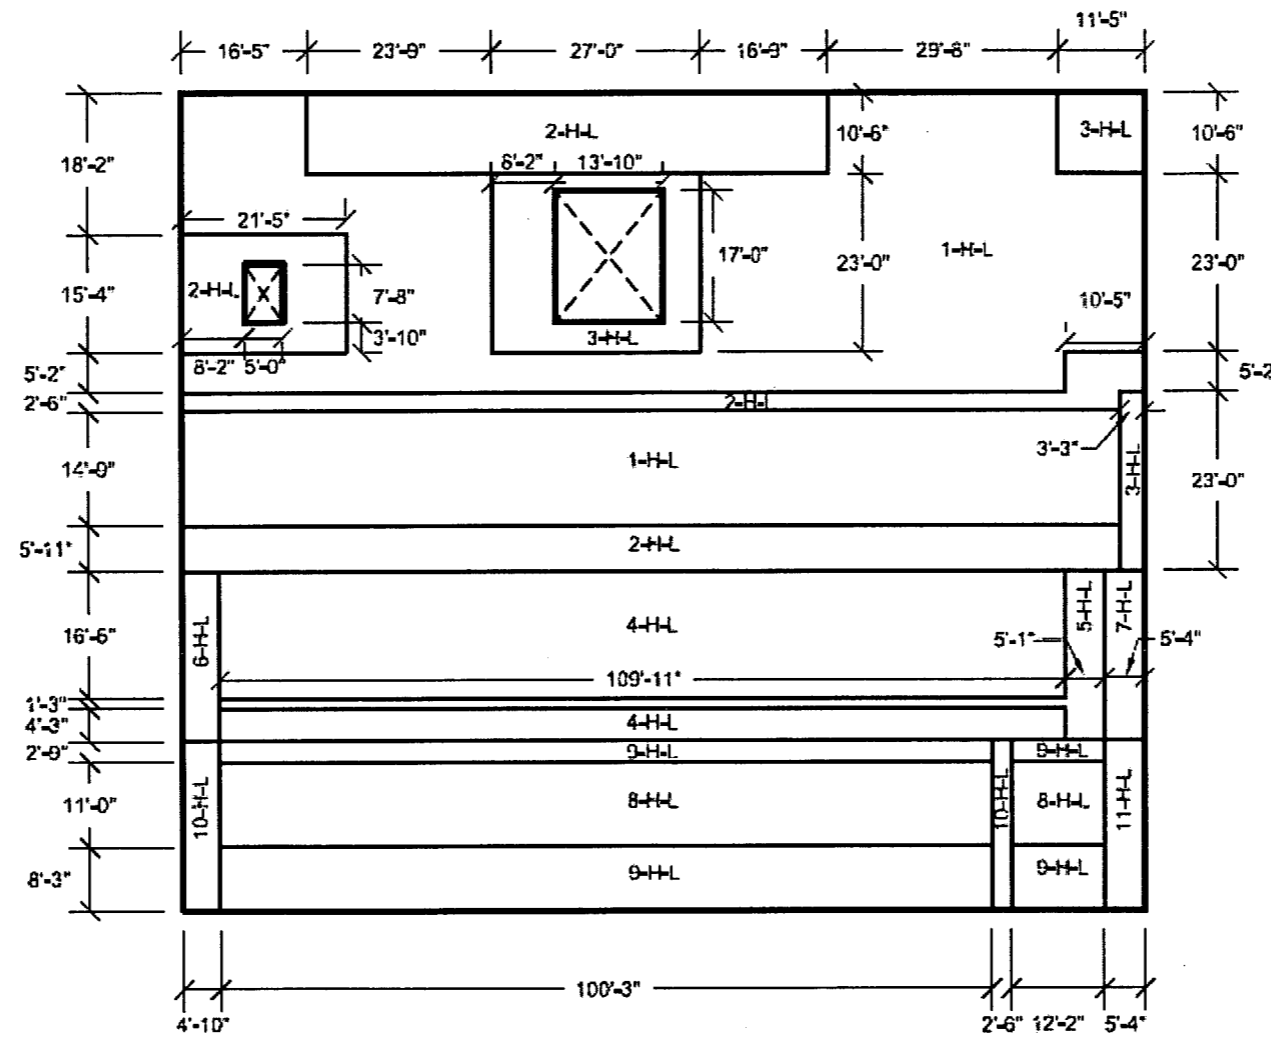

**FIGURE 3H.3-18: EAST WALL LOOKING WEST
 HORIZONTAL REINFORCEMENT ZONES
 NEAR SIDE FACE**

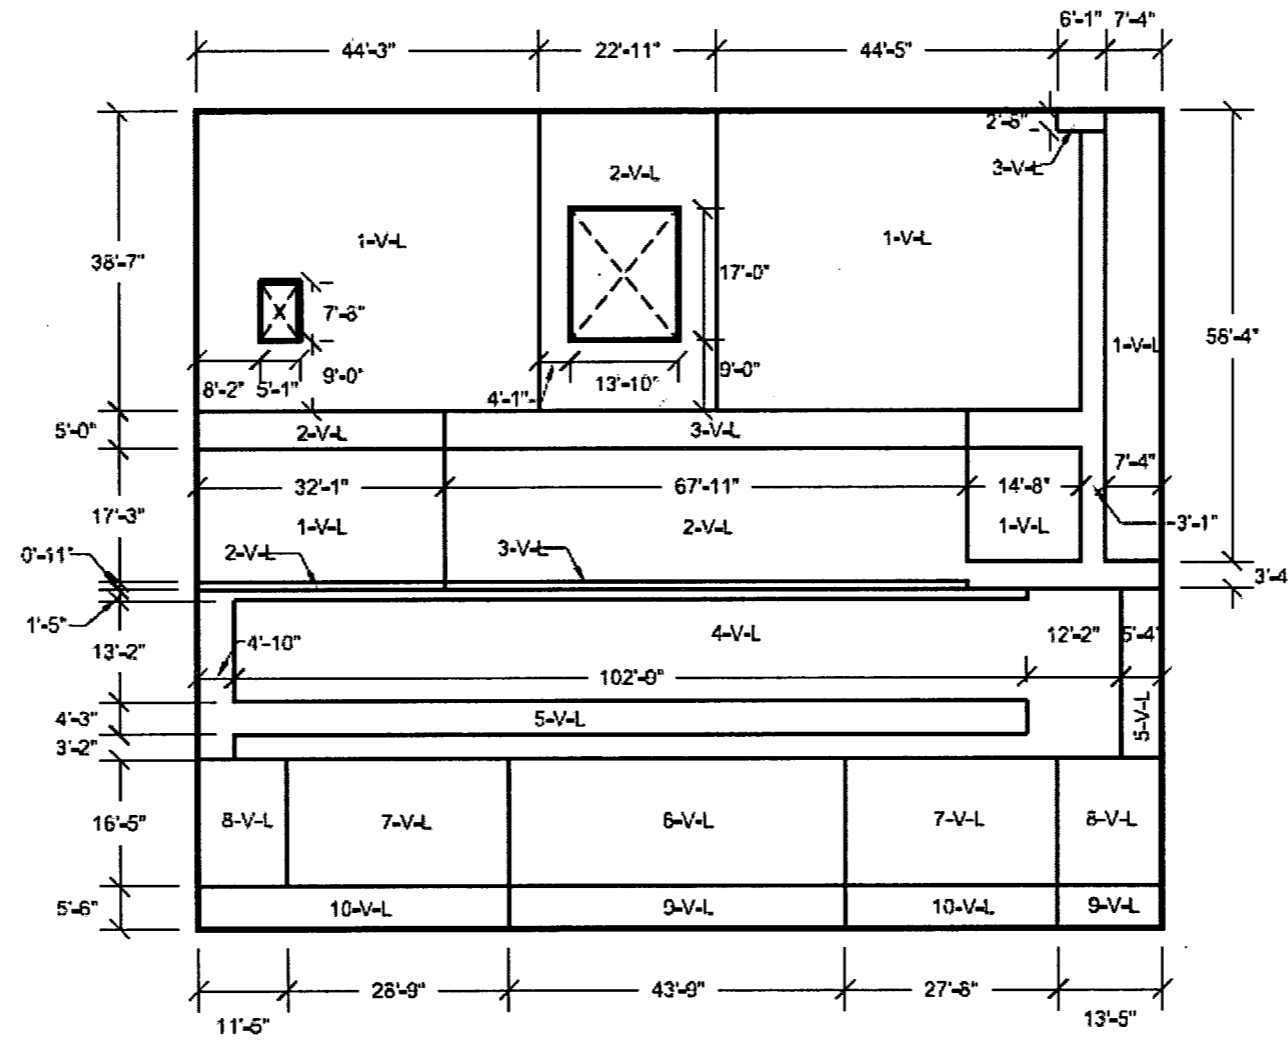

**FIGURE 3H.3-19: EAST WALL LOOKING WEST
VERTICAL REINFORCEMENT ZONES
NEAR SIDE FACE**

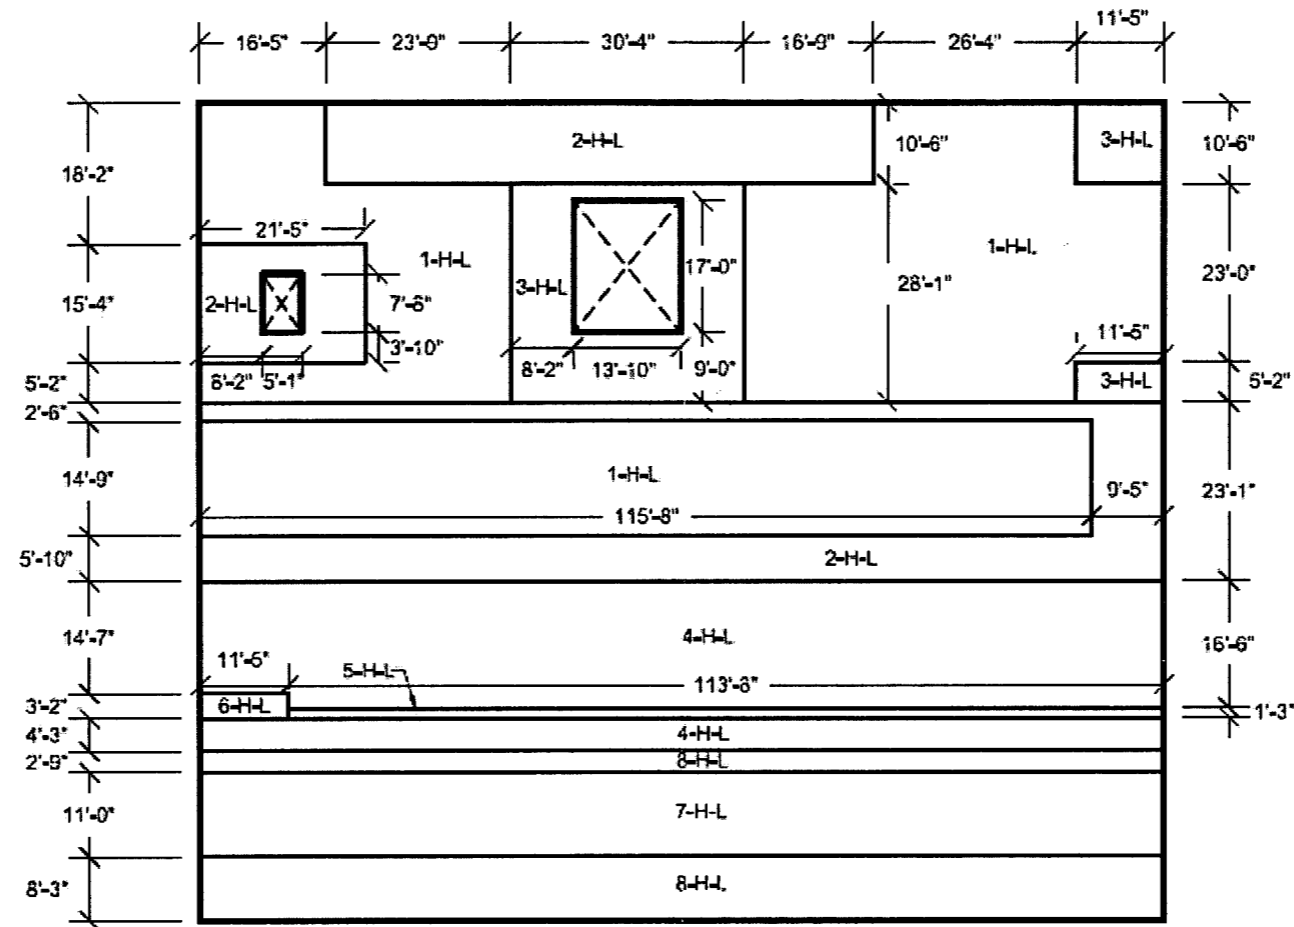

**FIGURE 3H.3-20: EAST WALL LOOKING WEST
HORIZONTAL REINFORCEMENT ZONES
FAR SIDE FACE**

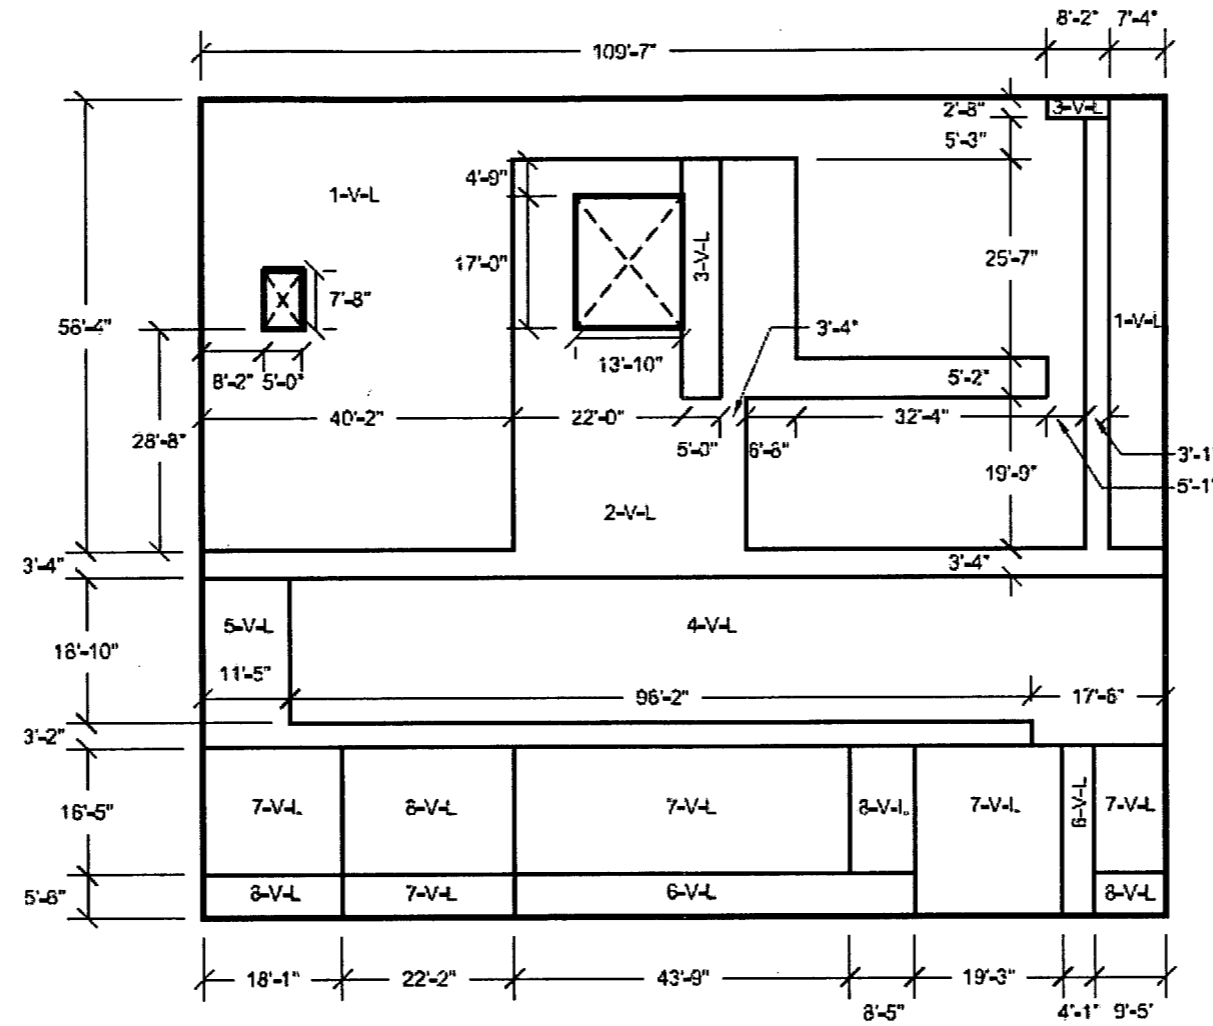


FIGURE 3H.3-21: EAST WALL LOOKING WEST
VERTICAL REINFORCEMENT ZONES
FAR SIDE FACE


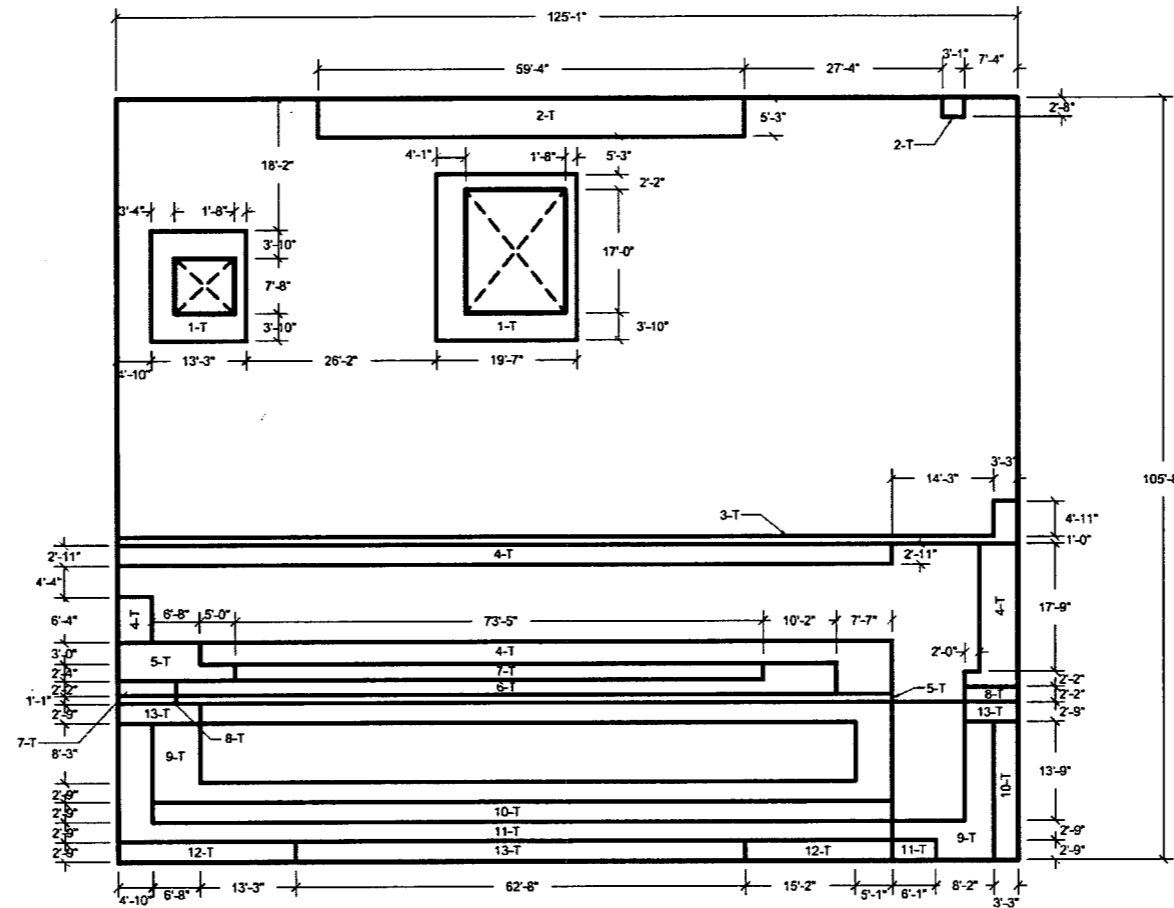


FIGURE 3H.3-22: EAST WALL LOOKING WEST
TRANSVERSE REINFORCEMENT ZONES

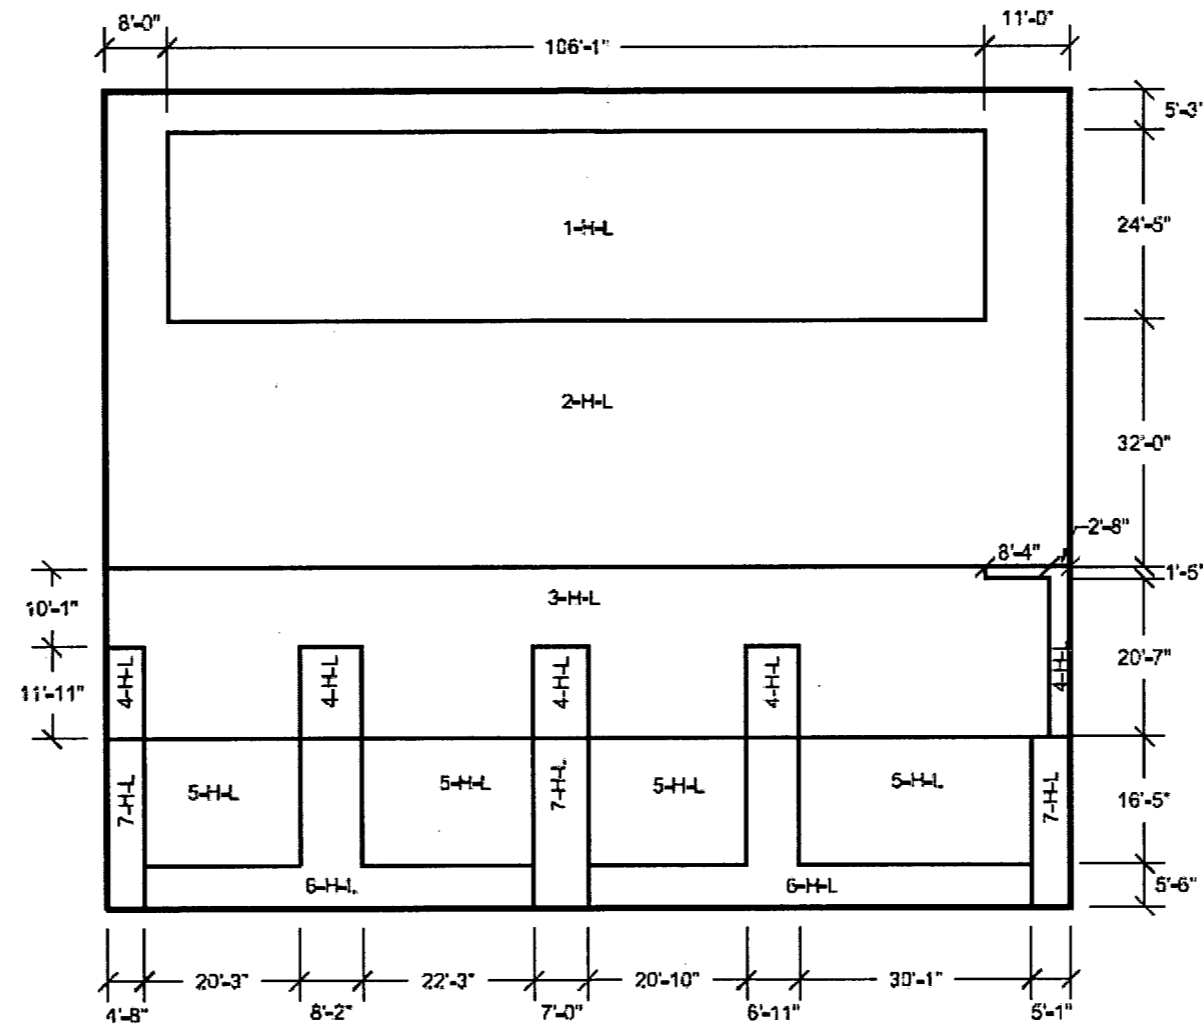

**FIGURE 3H.3-23: WEST WALL LOOKING EAST
 HORIZONTAL REINFORCEMENT ZONES,
 NEAR SIDE FACE**



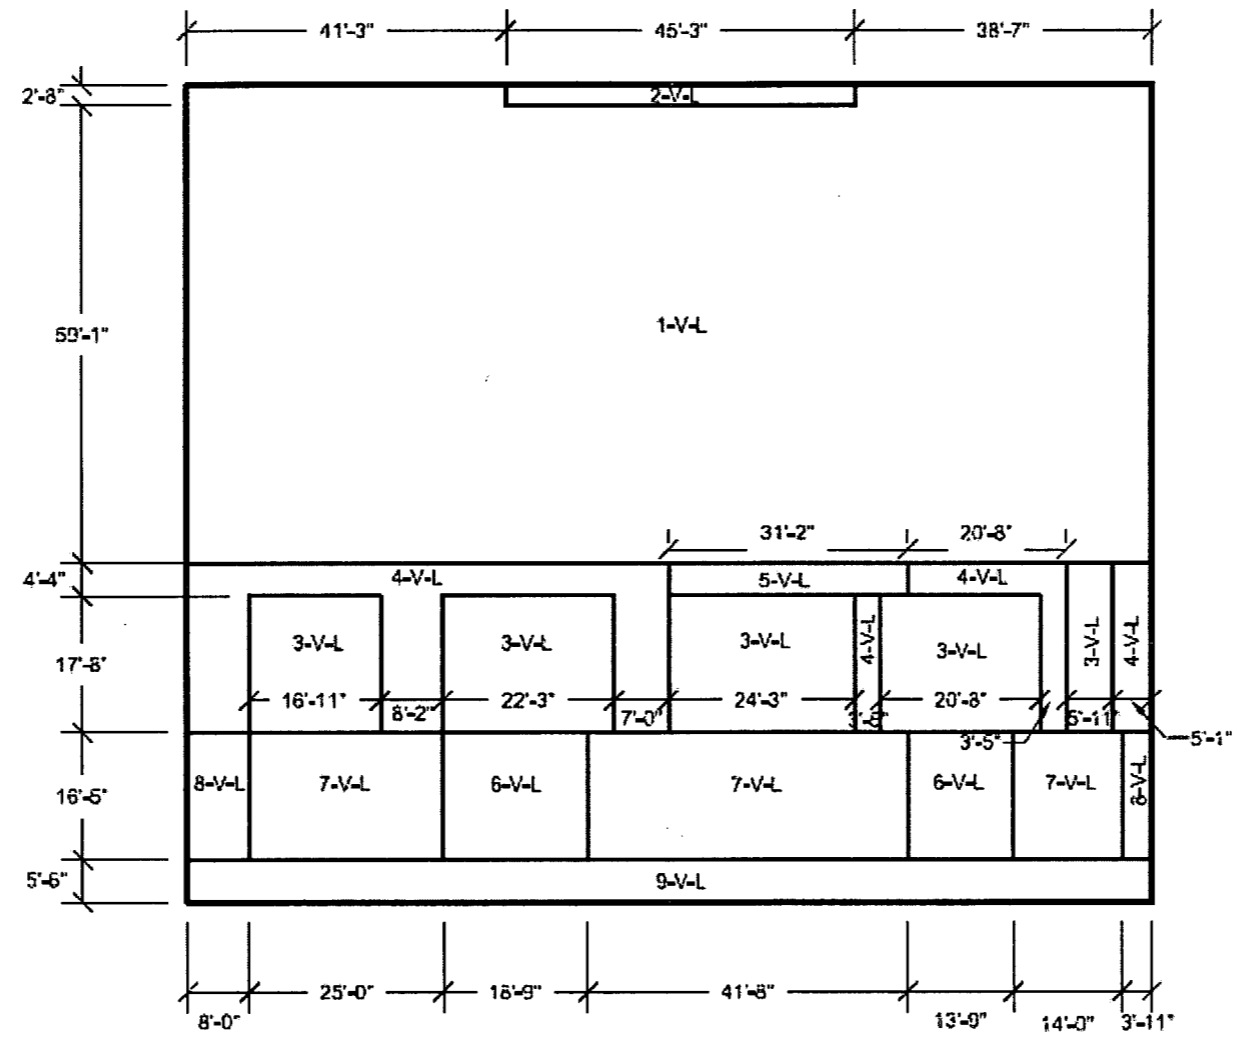


FIGURE 3H.3-24: WEST WALL LOOKING EAST
VERTICAL REINFORCEMENT ZONES
NEAR SIDE FACE

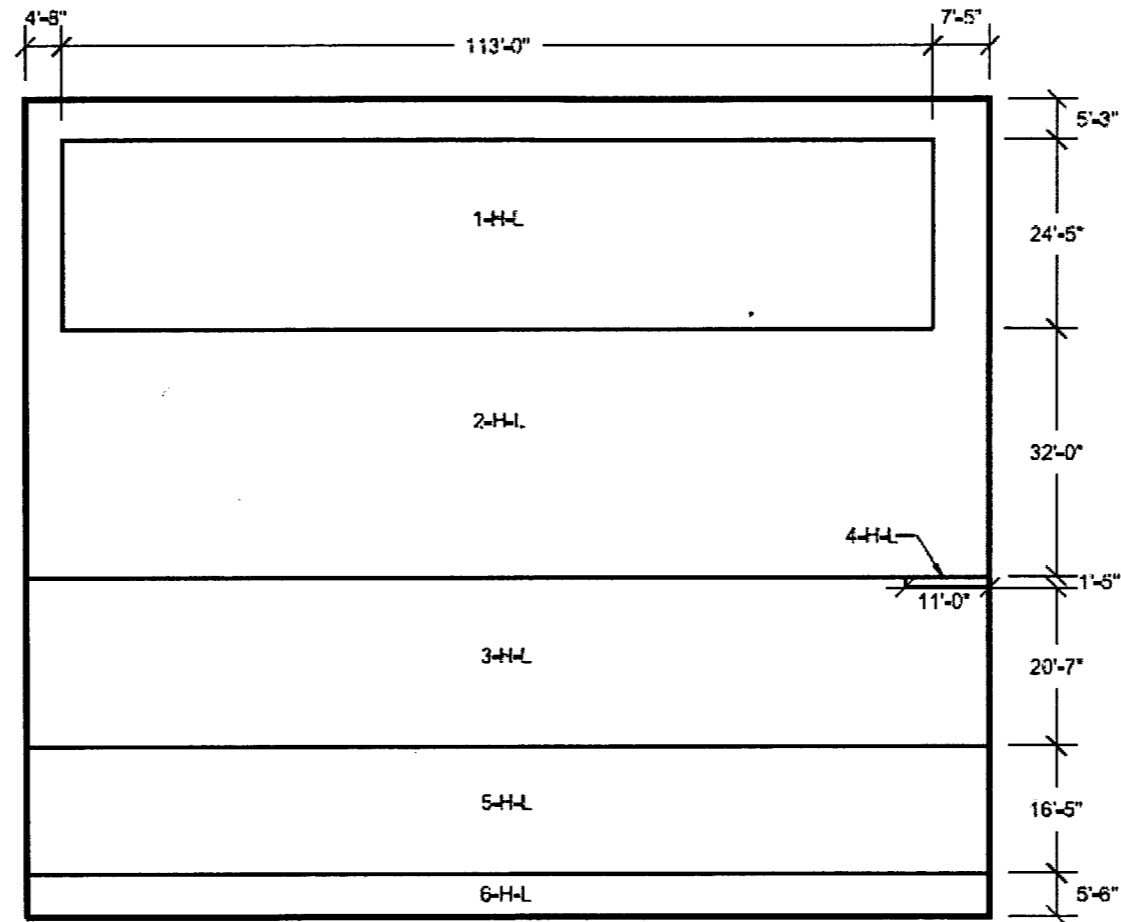

**FIGURE 3H.3-25: WEST WALL LOOKING EAST
HORIZONTAL REINFORCEMENT ZONES
FAR SIDE FACE**

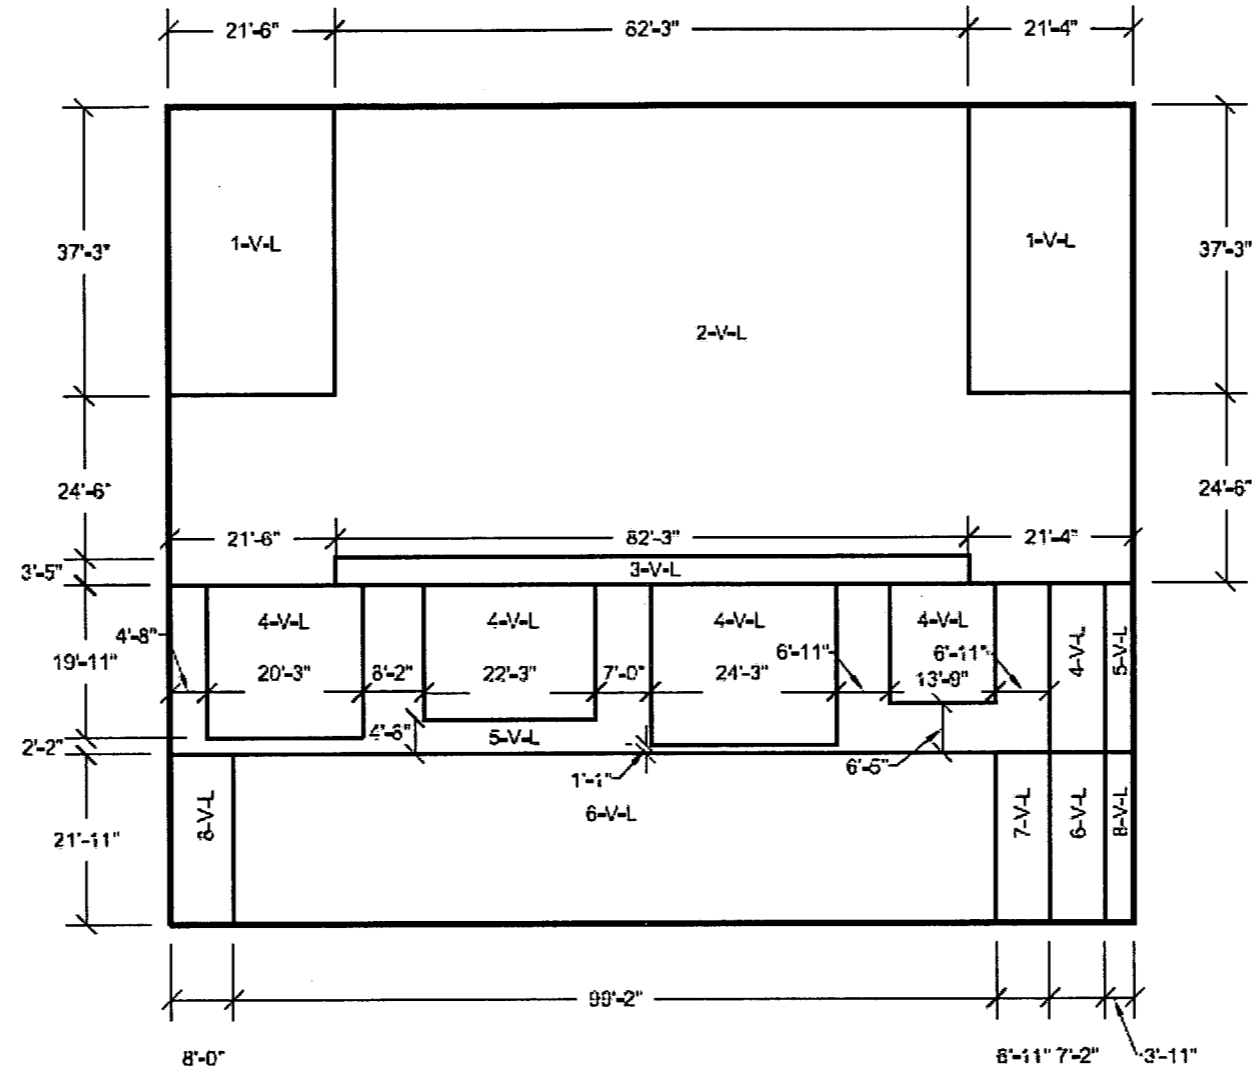

**FIGURE 3H.3-26: WEST WALL LOOKING EAST
 VERTICAL REINFORCEMENT ZONES
 FAR SIDE FACE**

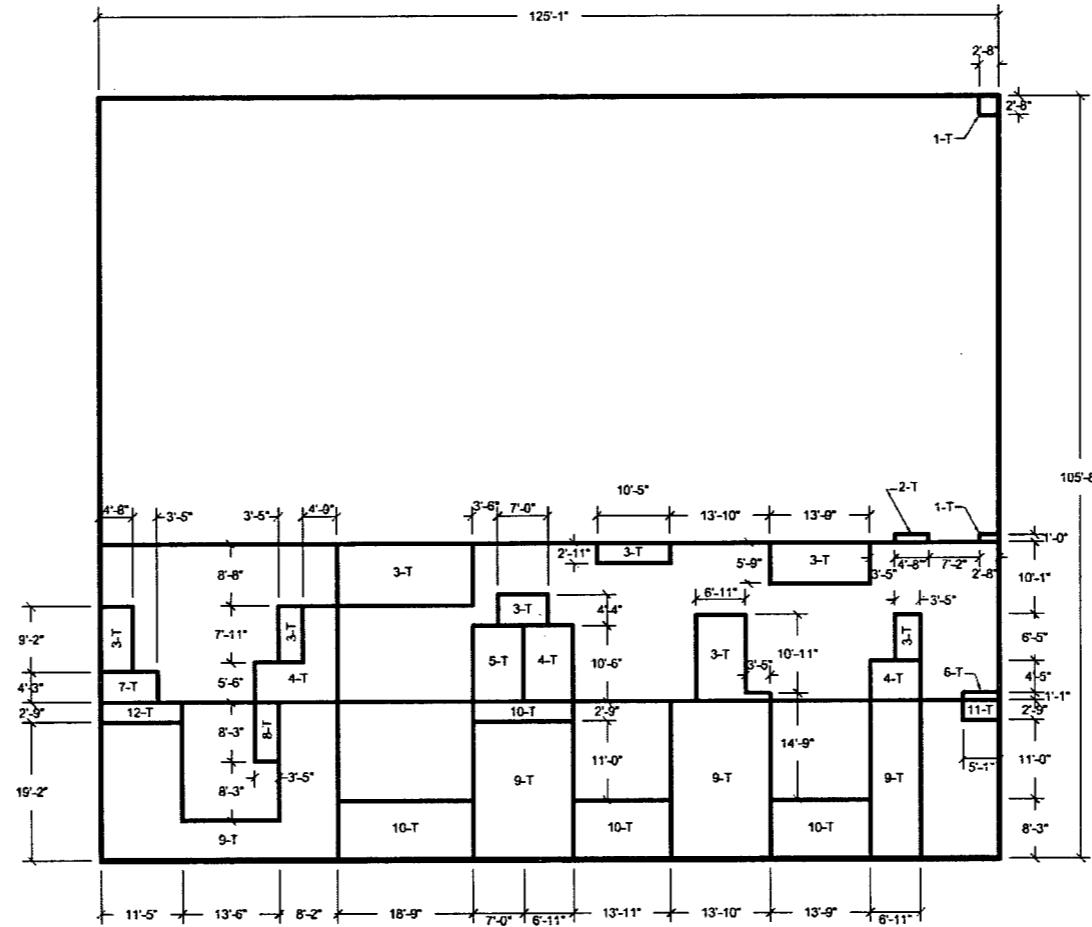


FIGURE 3H.3-27: WEST WALL LOOKING EAST
TRANSVERSE REINFORCEMENT ZONES

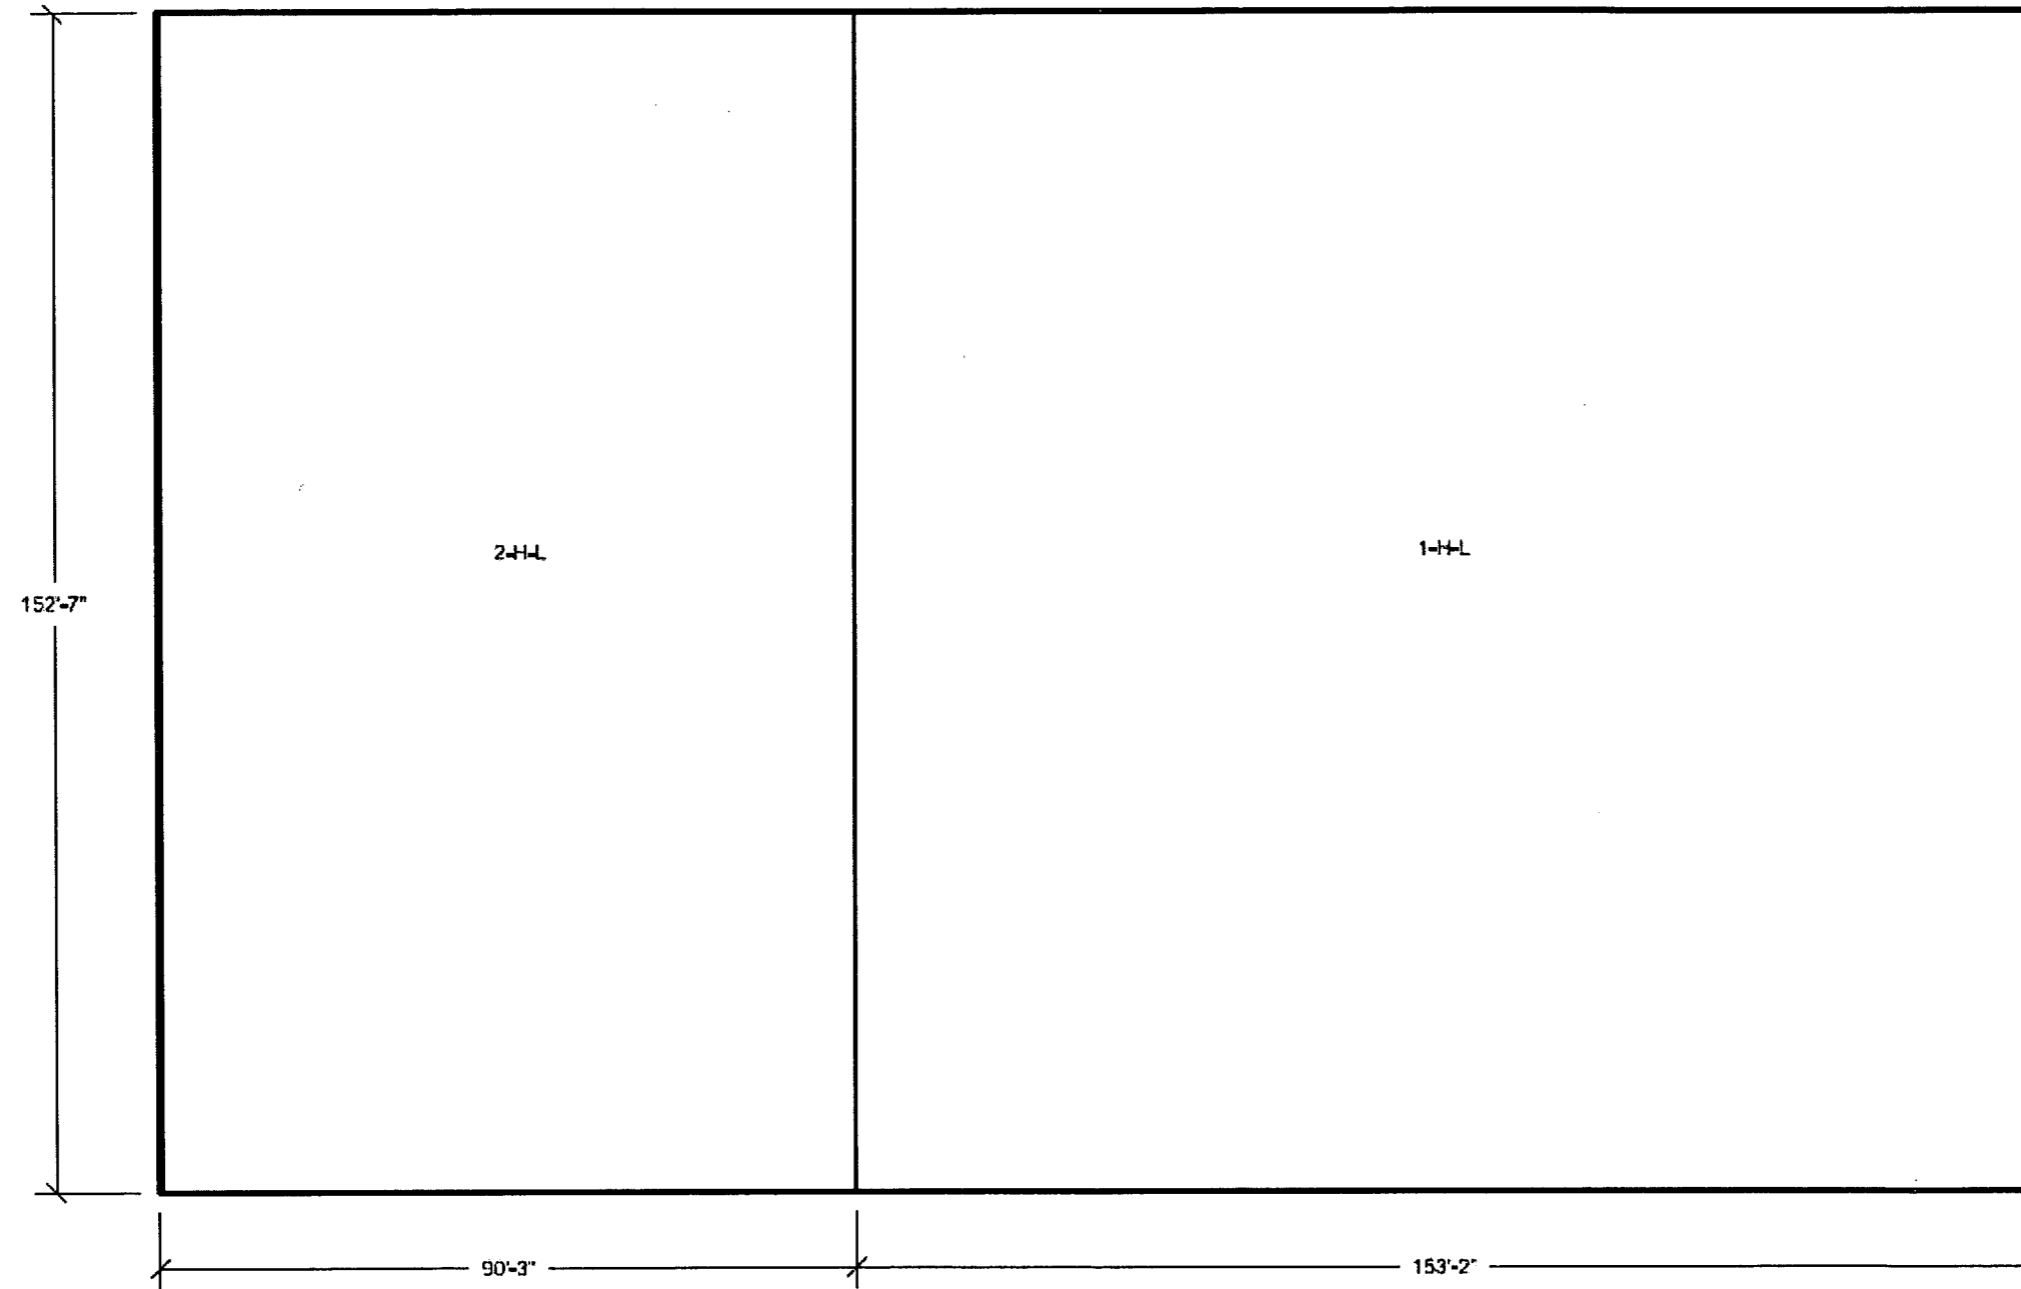


FIGURE 3H.3-28: BASEMAT LOOKING DOWN
EAST-WEST REINFORCEMENT ZONES
NEAR SIDE FACE



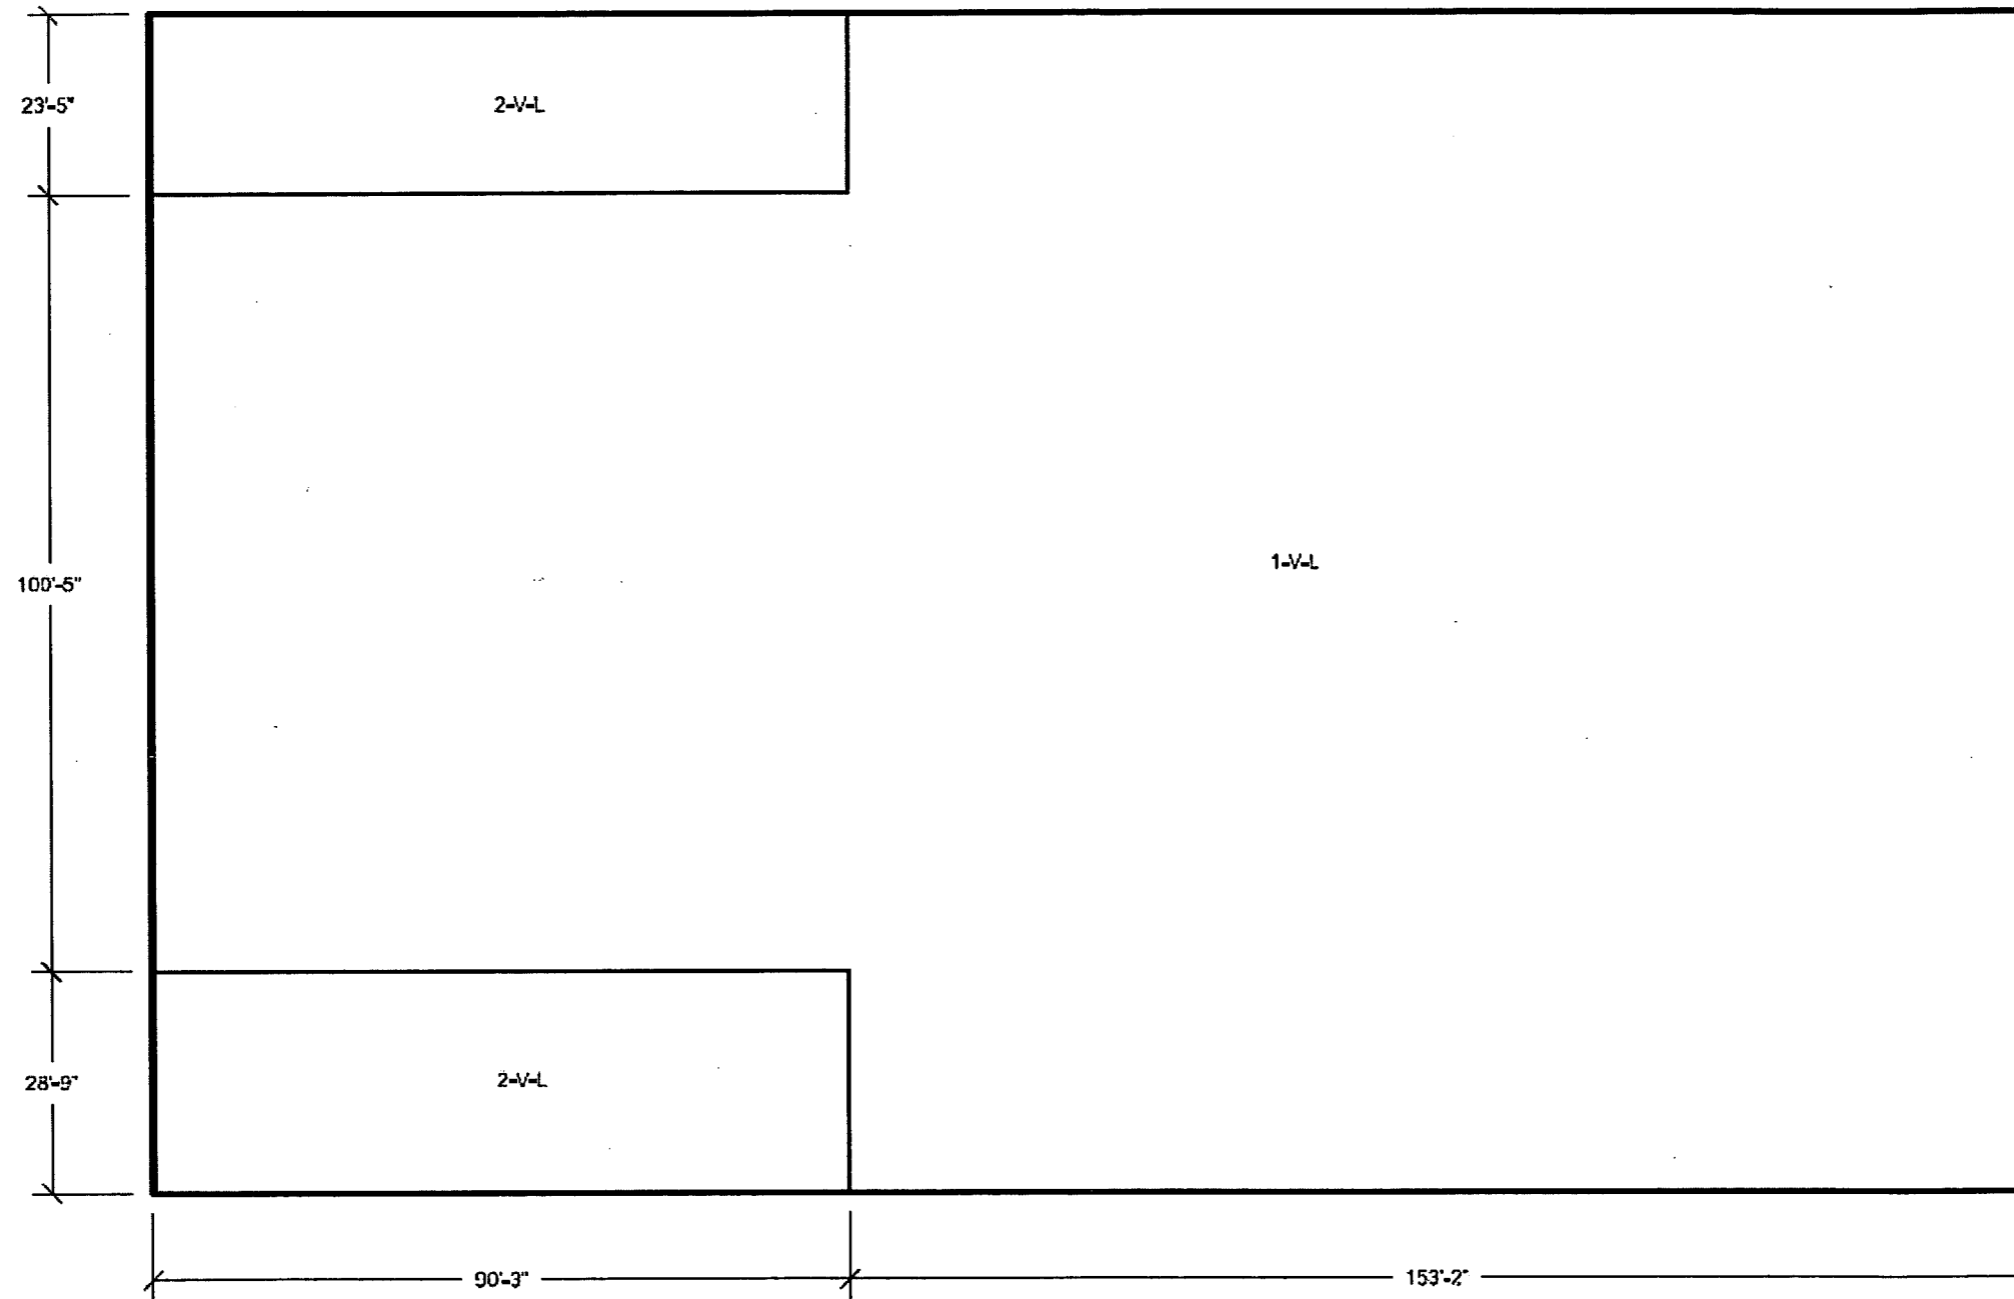


FIGURE 3H.3-29: BASEMAT LOOKING DOWN
NORTH-SOUTH REINFORCEMENT ZONES
NEAR SIDE FACE

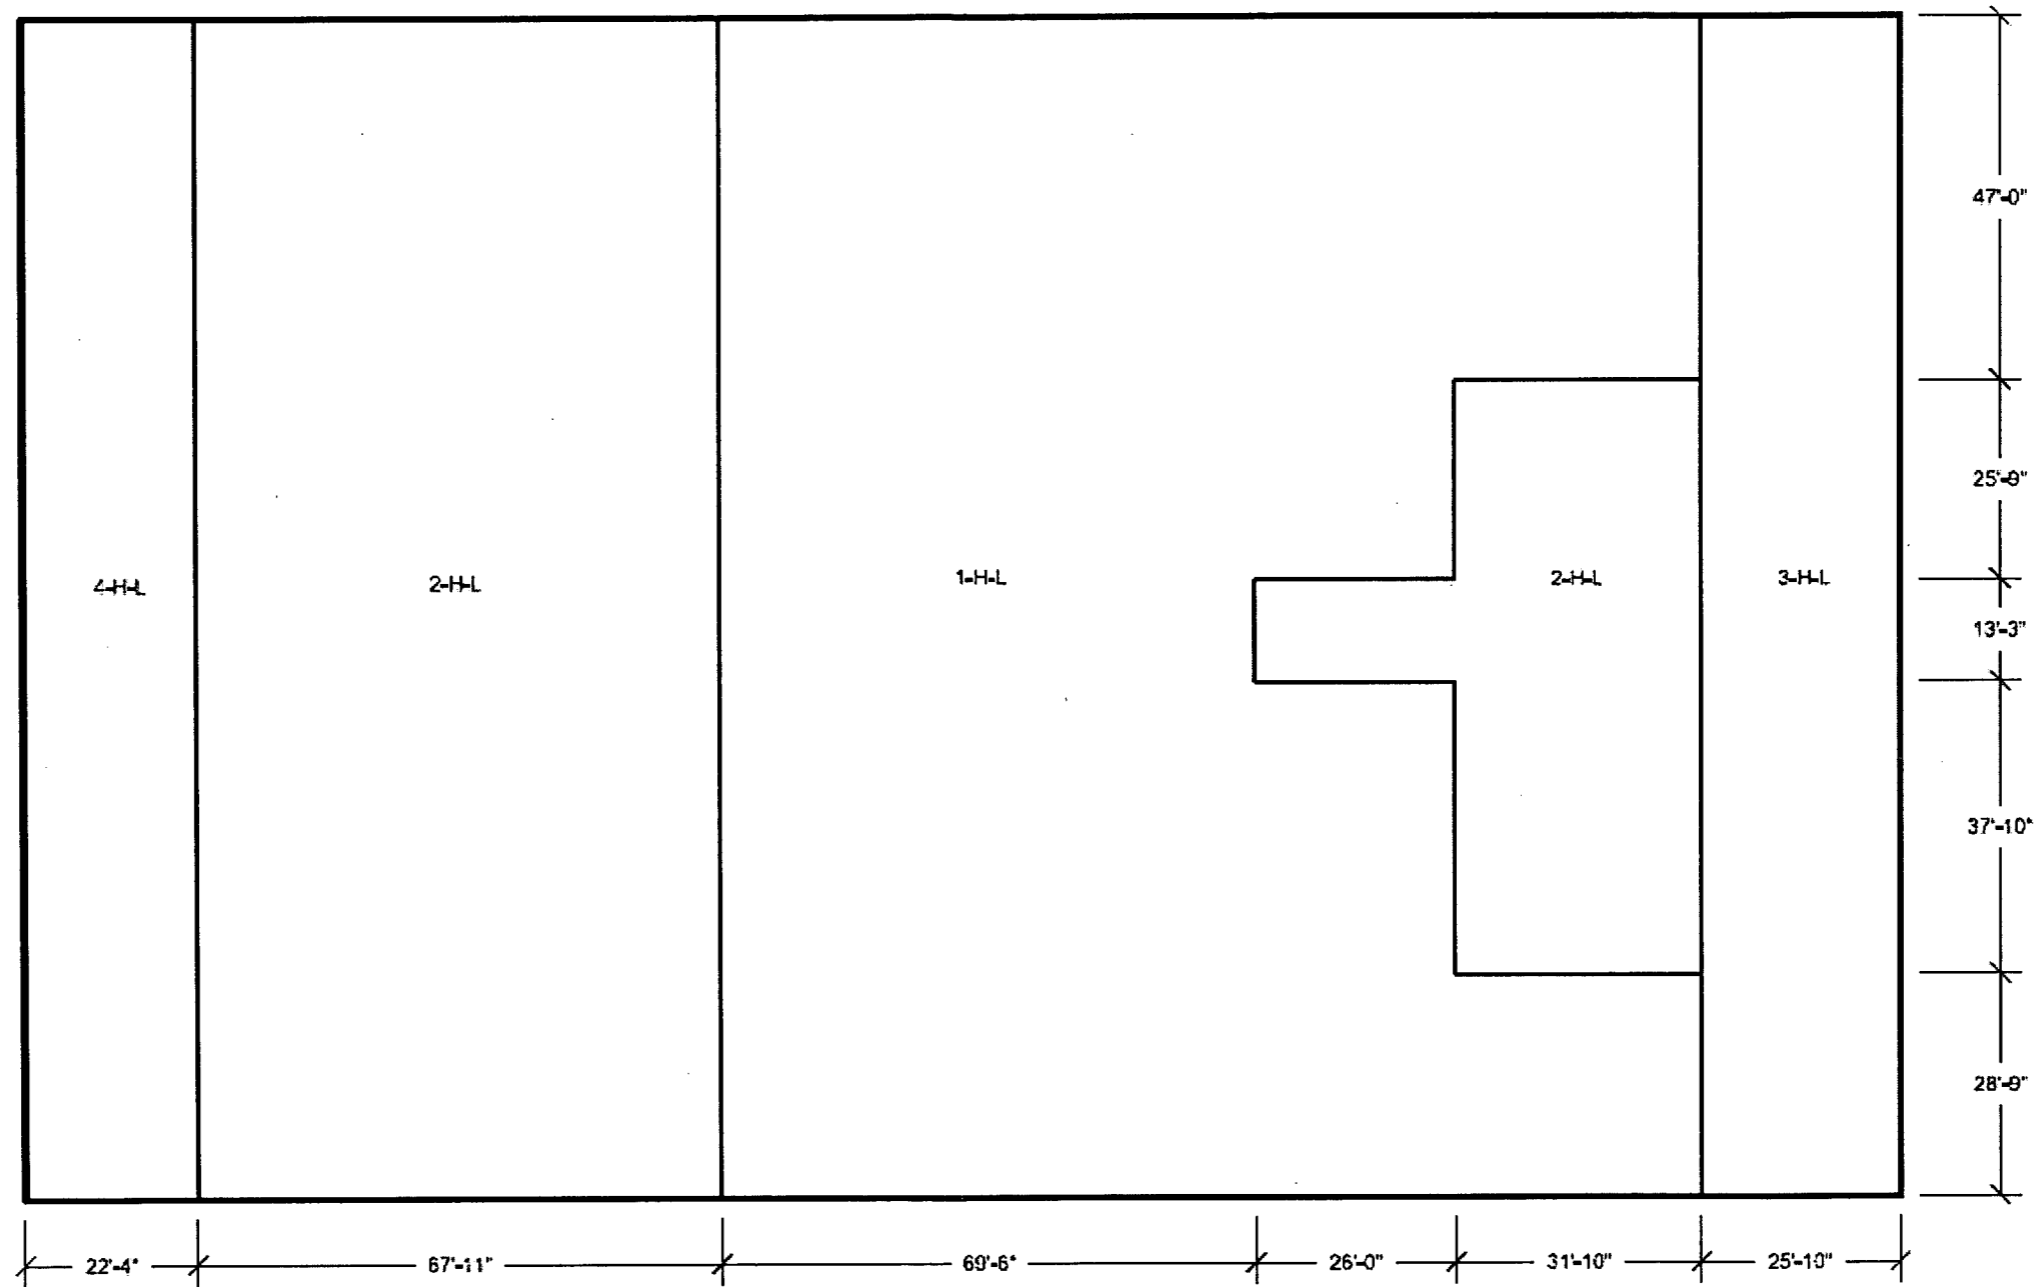

**FIGURE 3H.3-30: BASEMAT LOOKING DOWN
EAST-WEST REINFORCEMENT ZONES
FAR SIDE FACE**

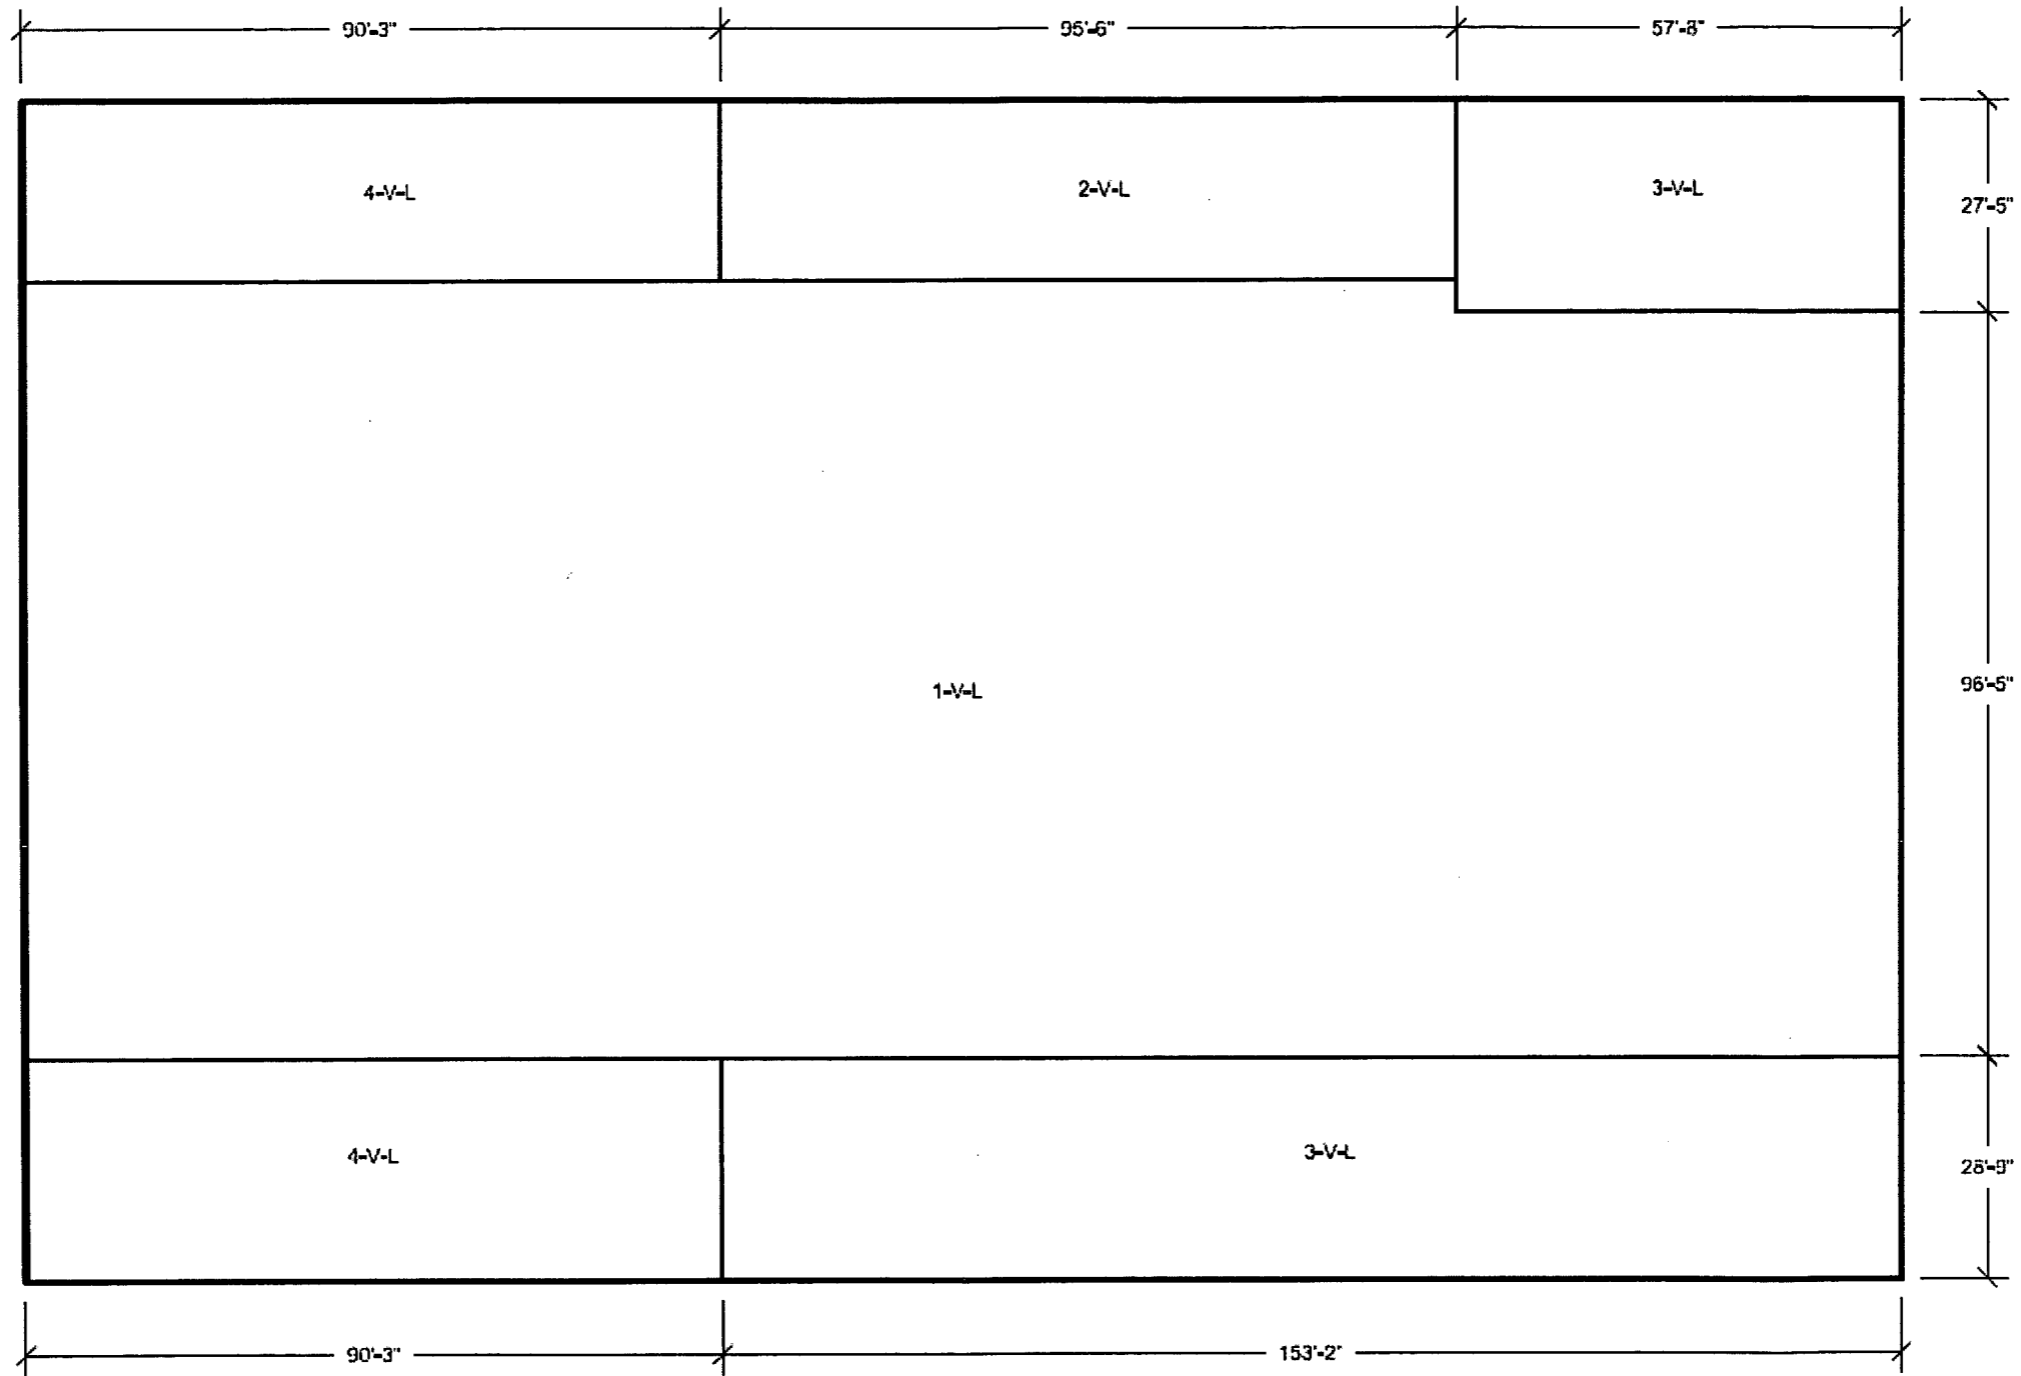

**FIGURE 3H.3-31: BASEMAT LOOKING DOWN
NORTH-SOUTH REINFORCEMENT ZONES
FAR SIDE FACE**



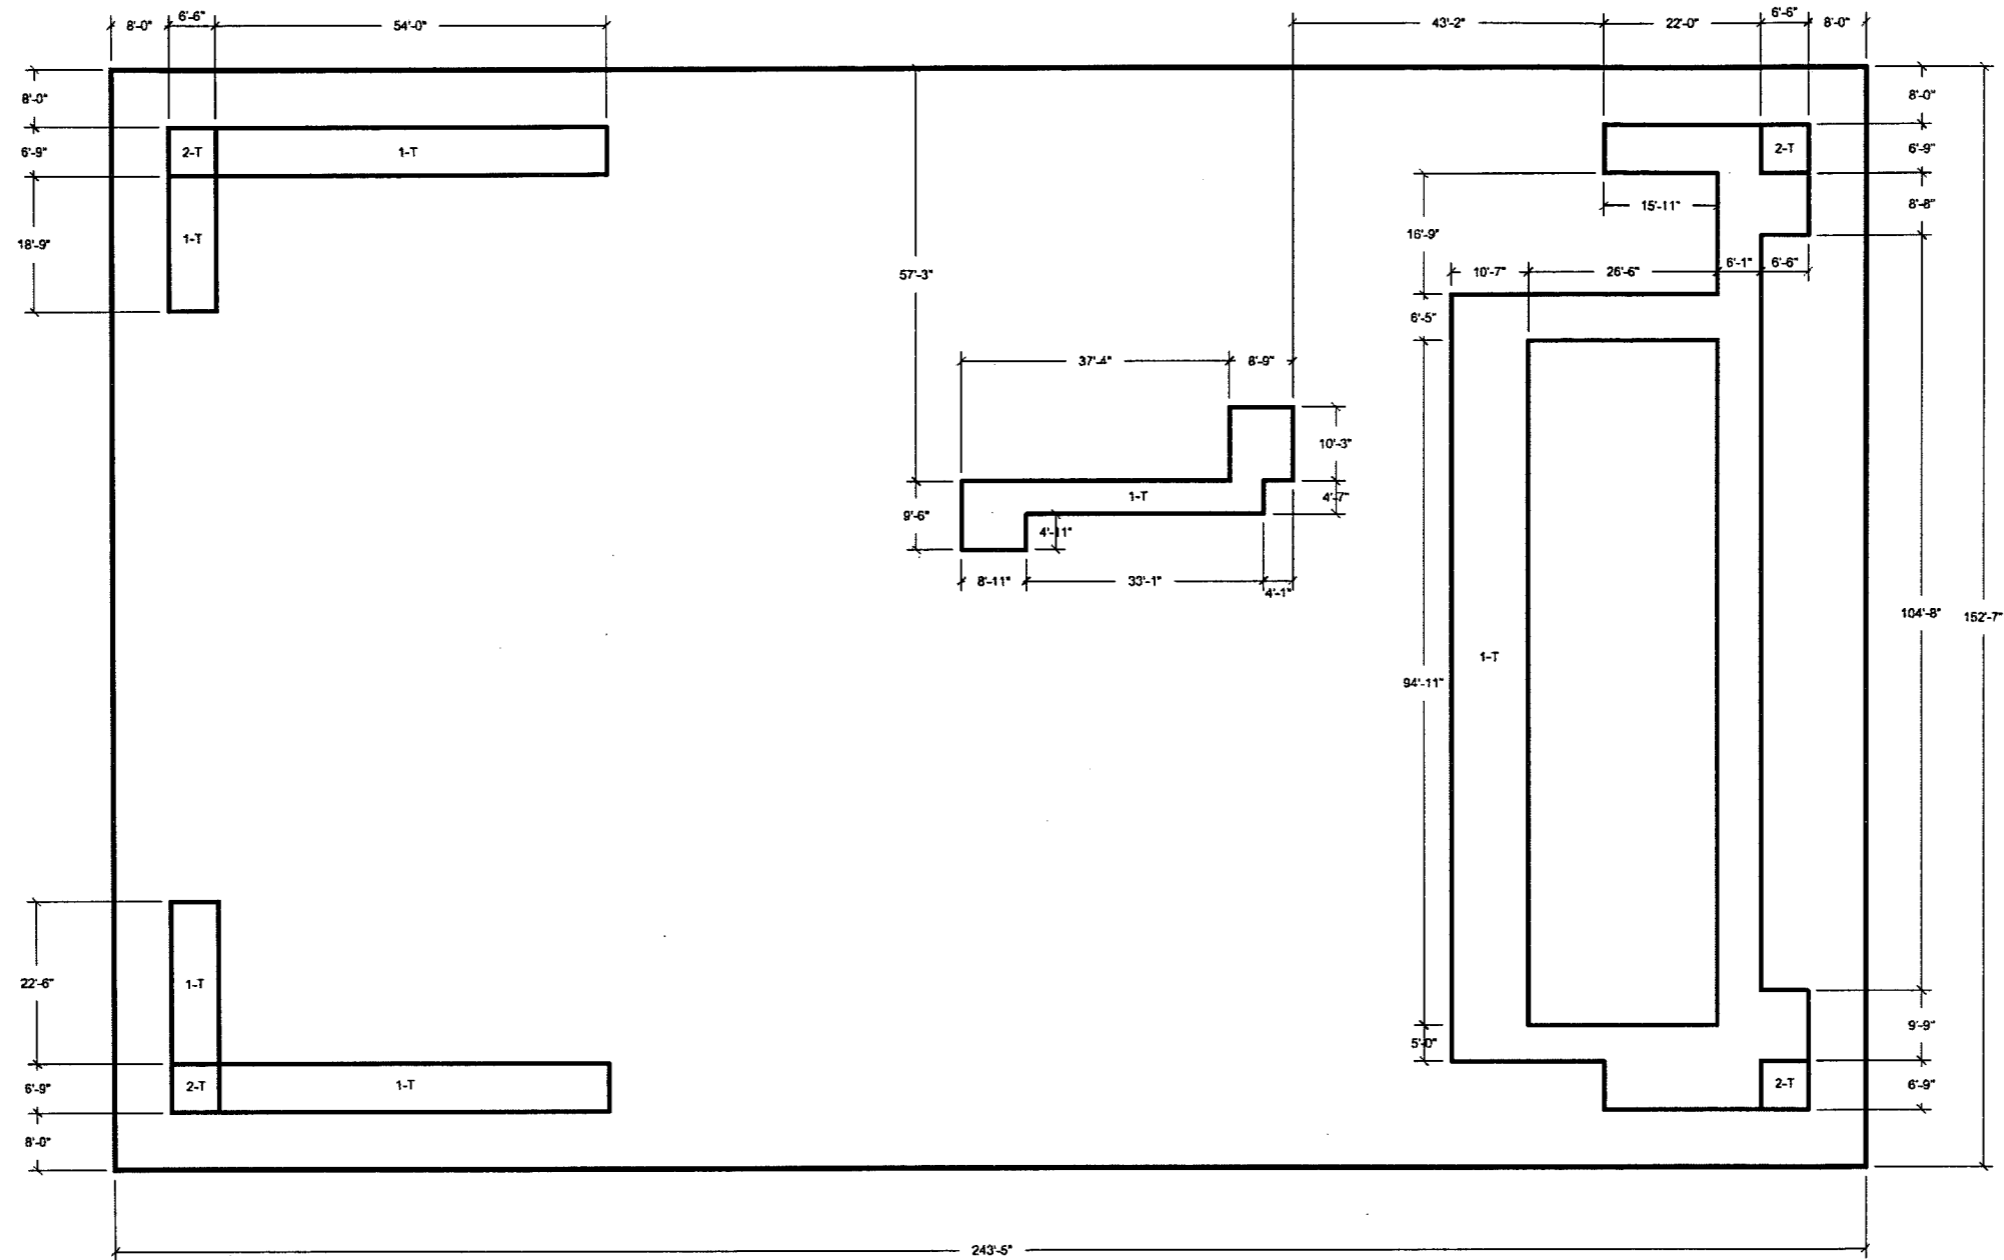



FIGURE 3H.3-32: BASEMAT LOOKING DOWN
TRANSVERSE REINFORCEMENT ZONES

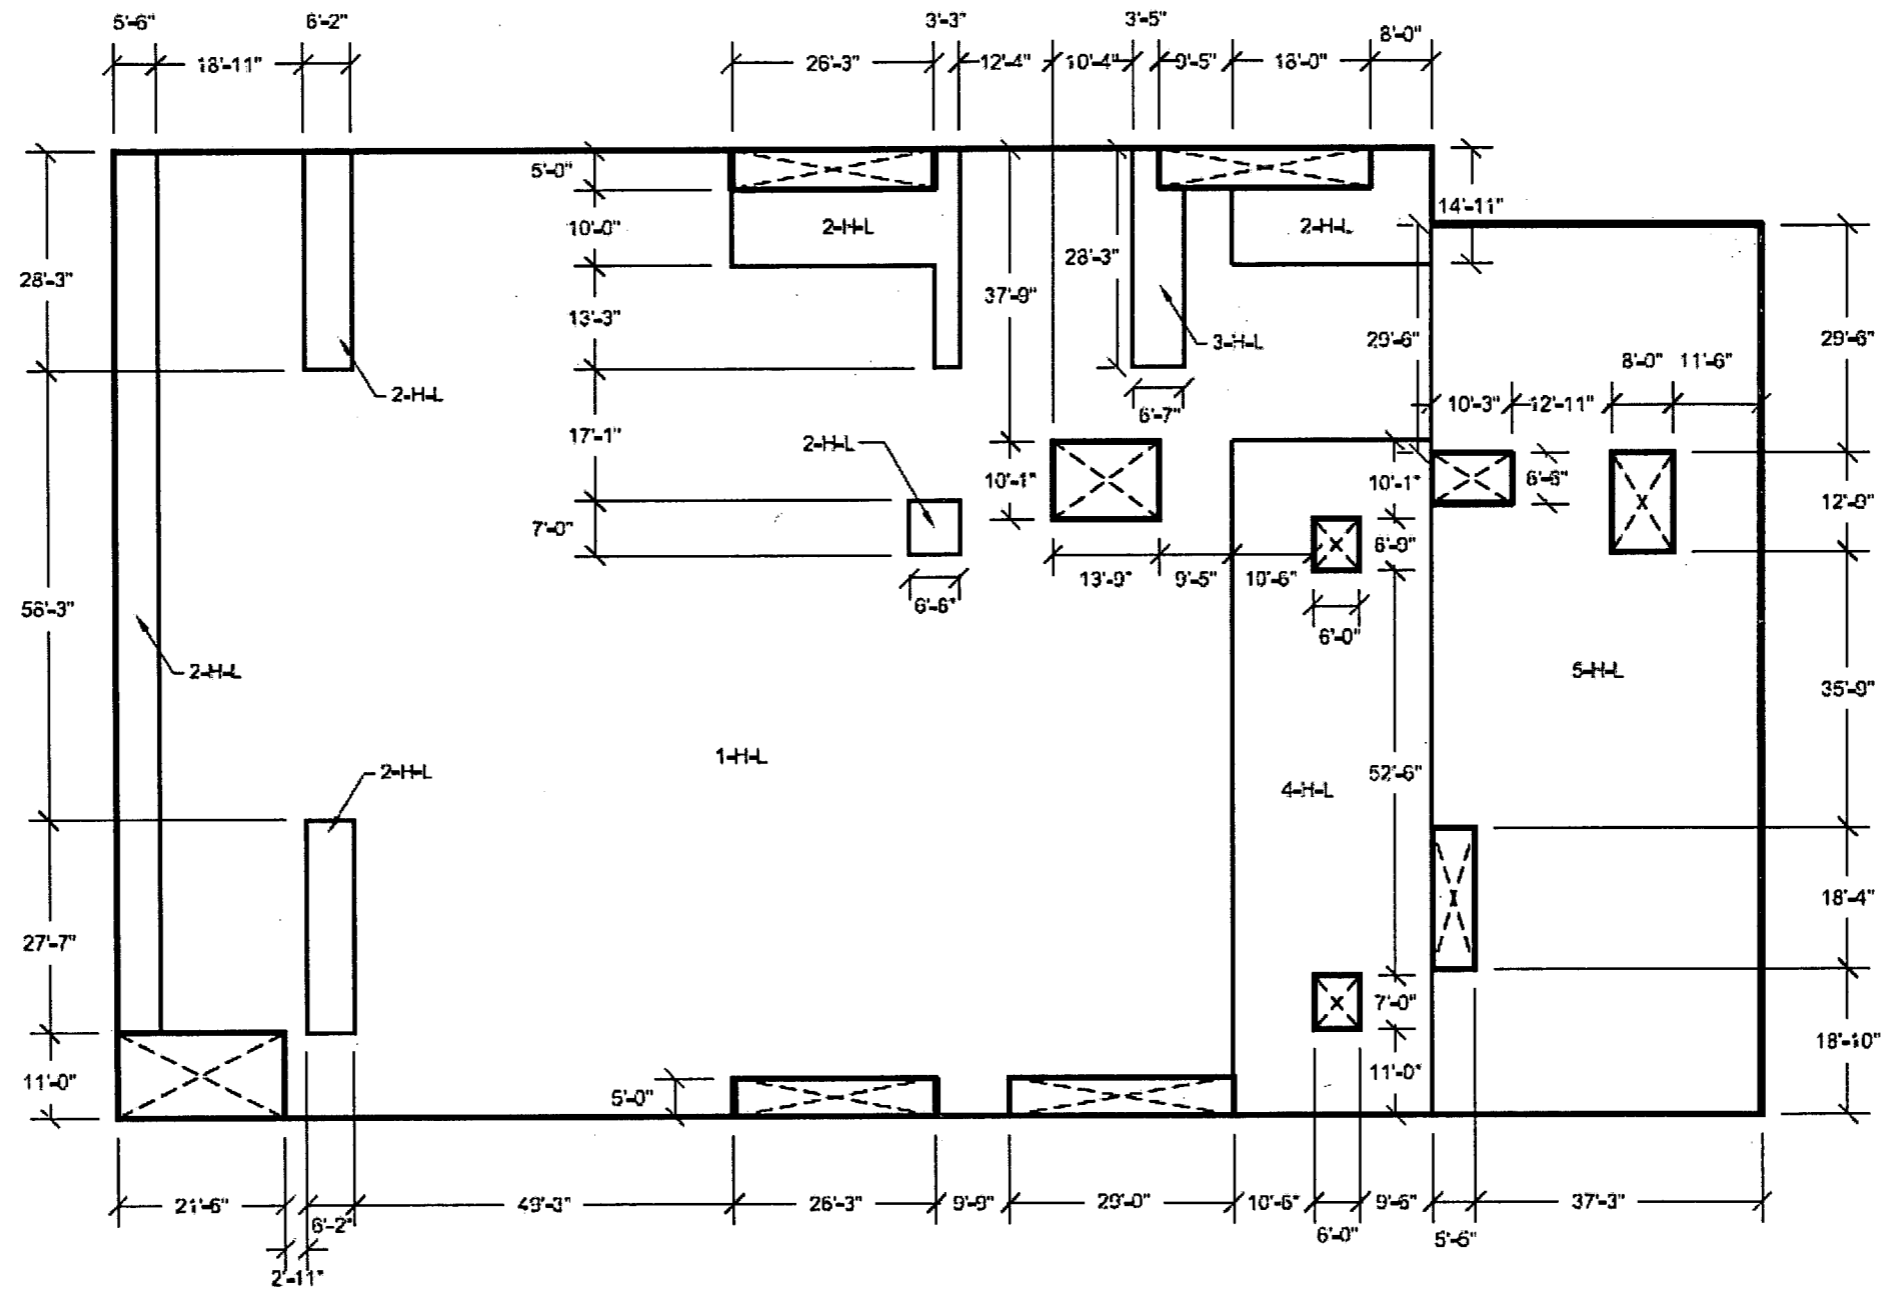


**FIGURE 3H.3-33: ELEVATION 35 LOOKING DOWN
EAST-WEST REINFORCEMENT ZONES
NEAR SIDE FACE**

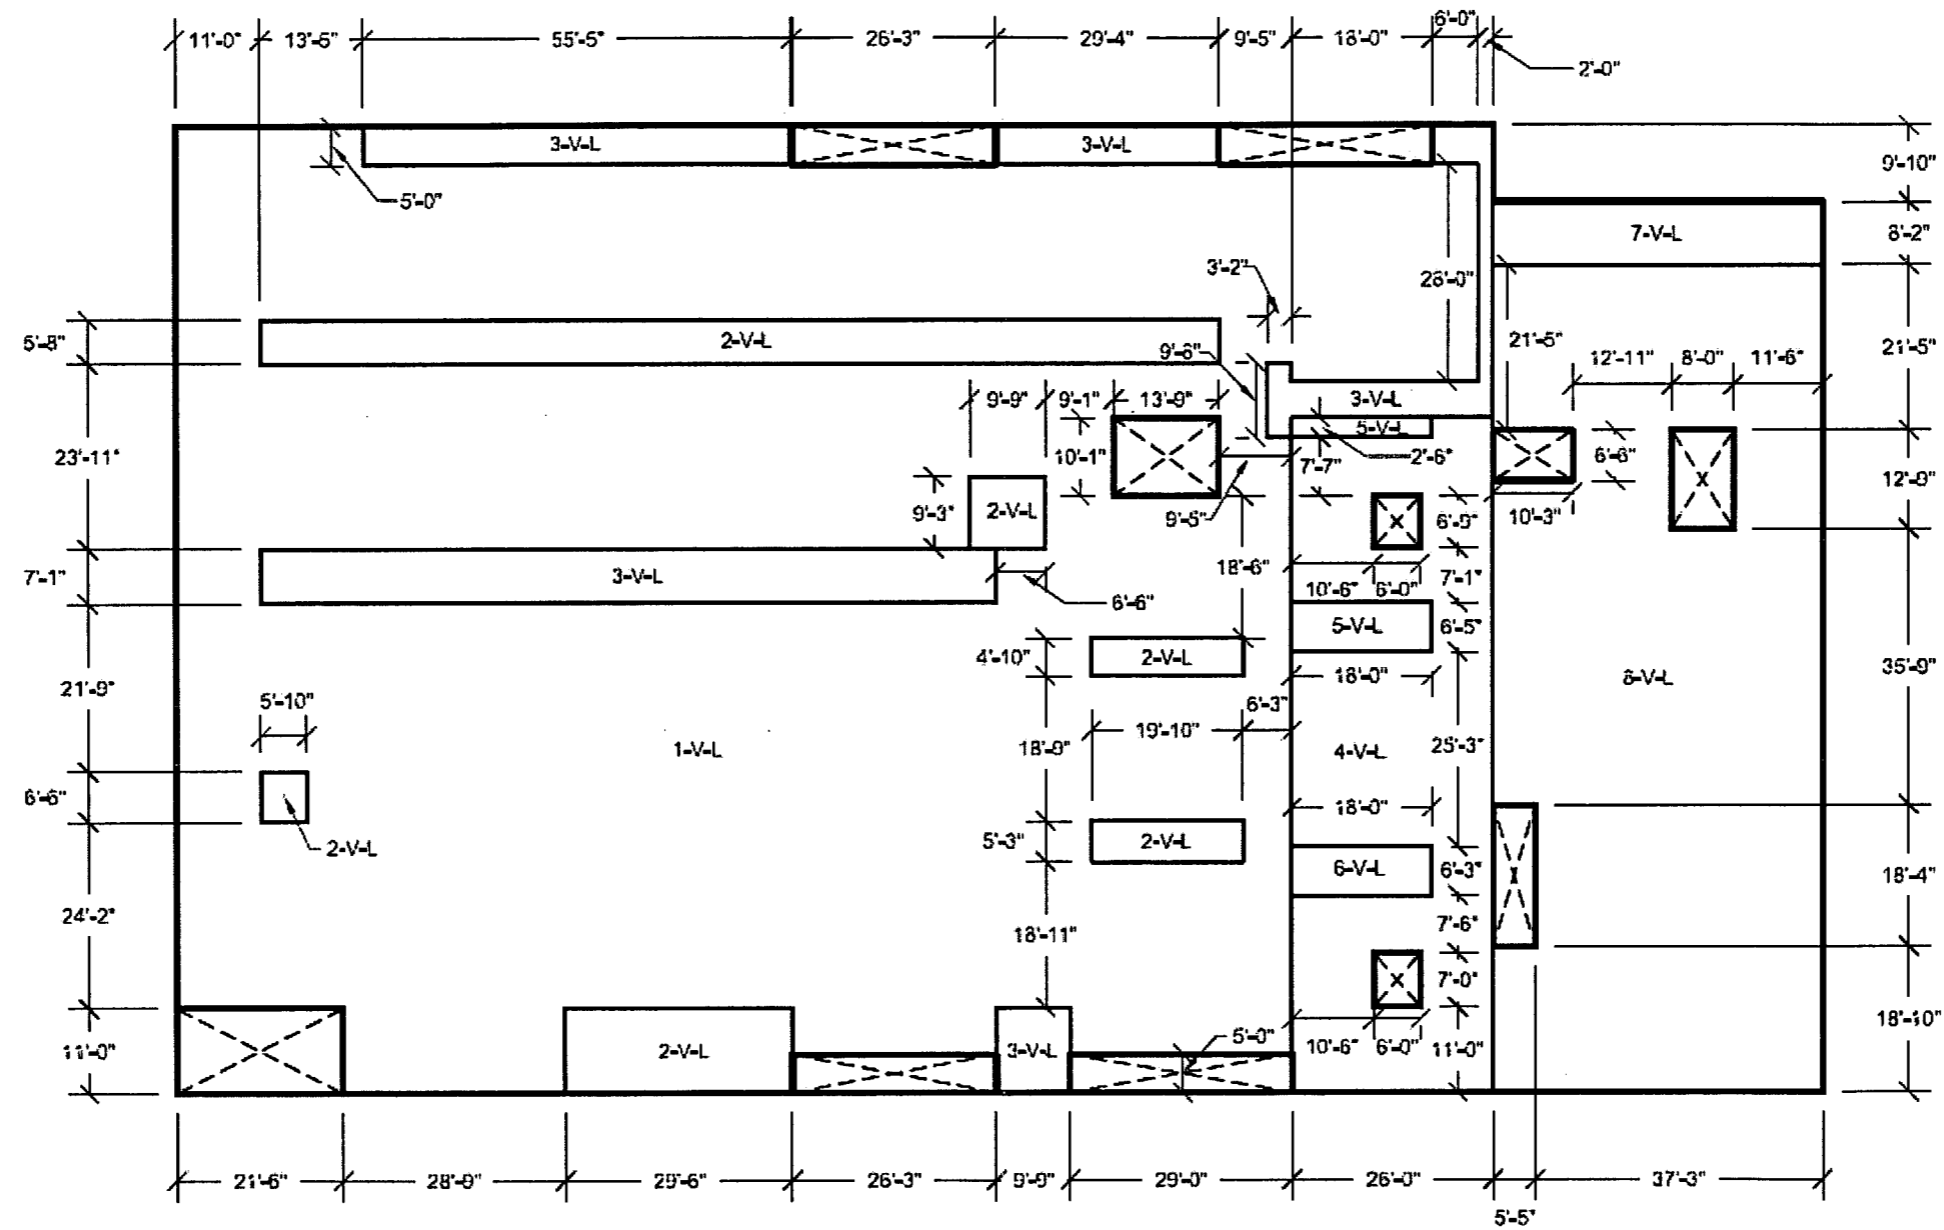


**FIGURE 3H, 3-34: ELEVATION 35 LOOKING DOWN
NORTH-SOUTH REINFORCEMENT ZONES
NEAR SIDE FACE**

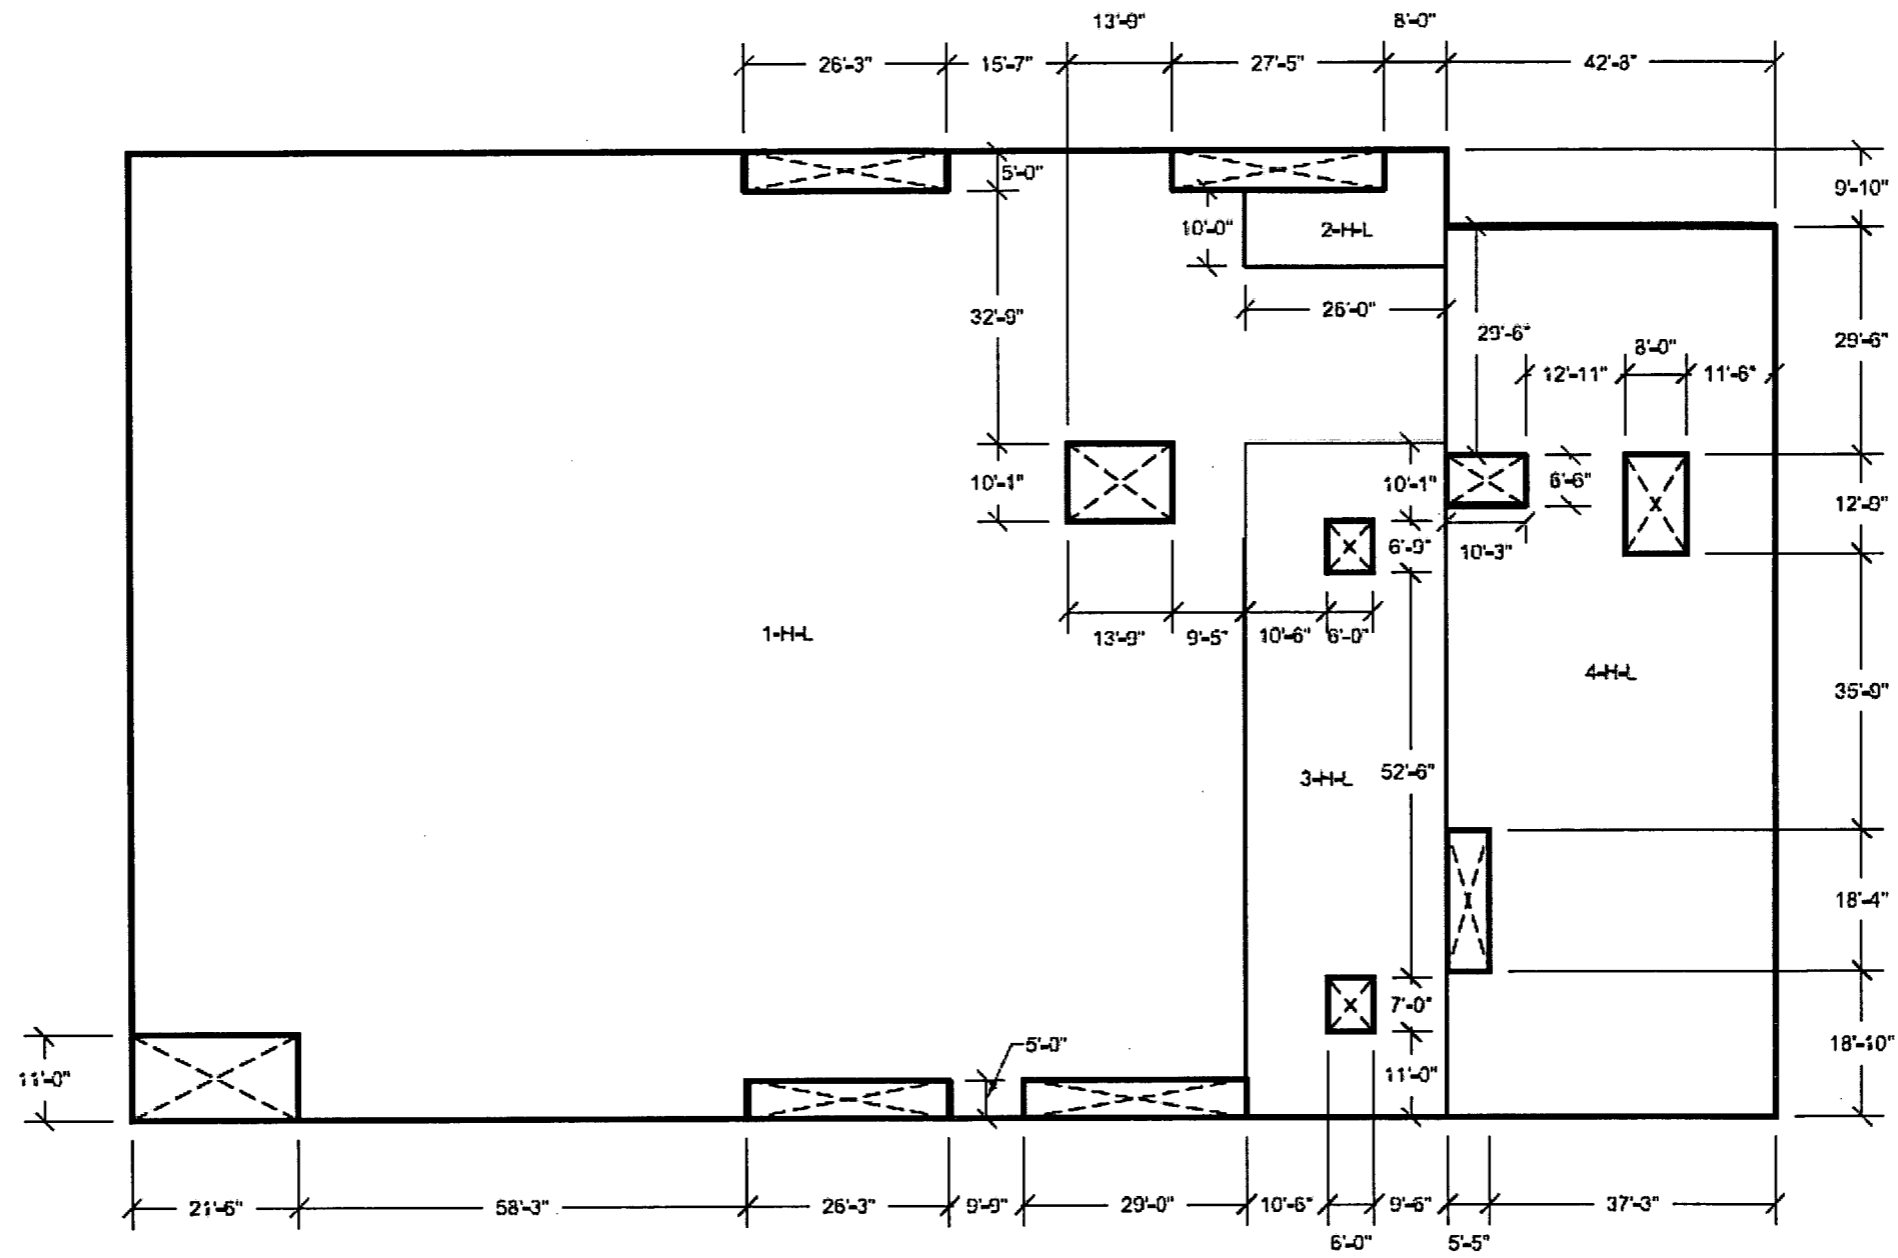

**FIGURE 3H.3-35: ELEVATION 35 LOOKING DOWN
 EAST-WEST REINFORCEMENT ZONES
 FAR SIDE FACE**

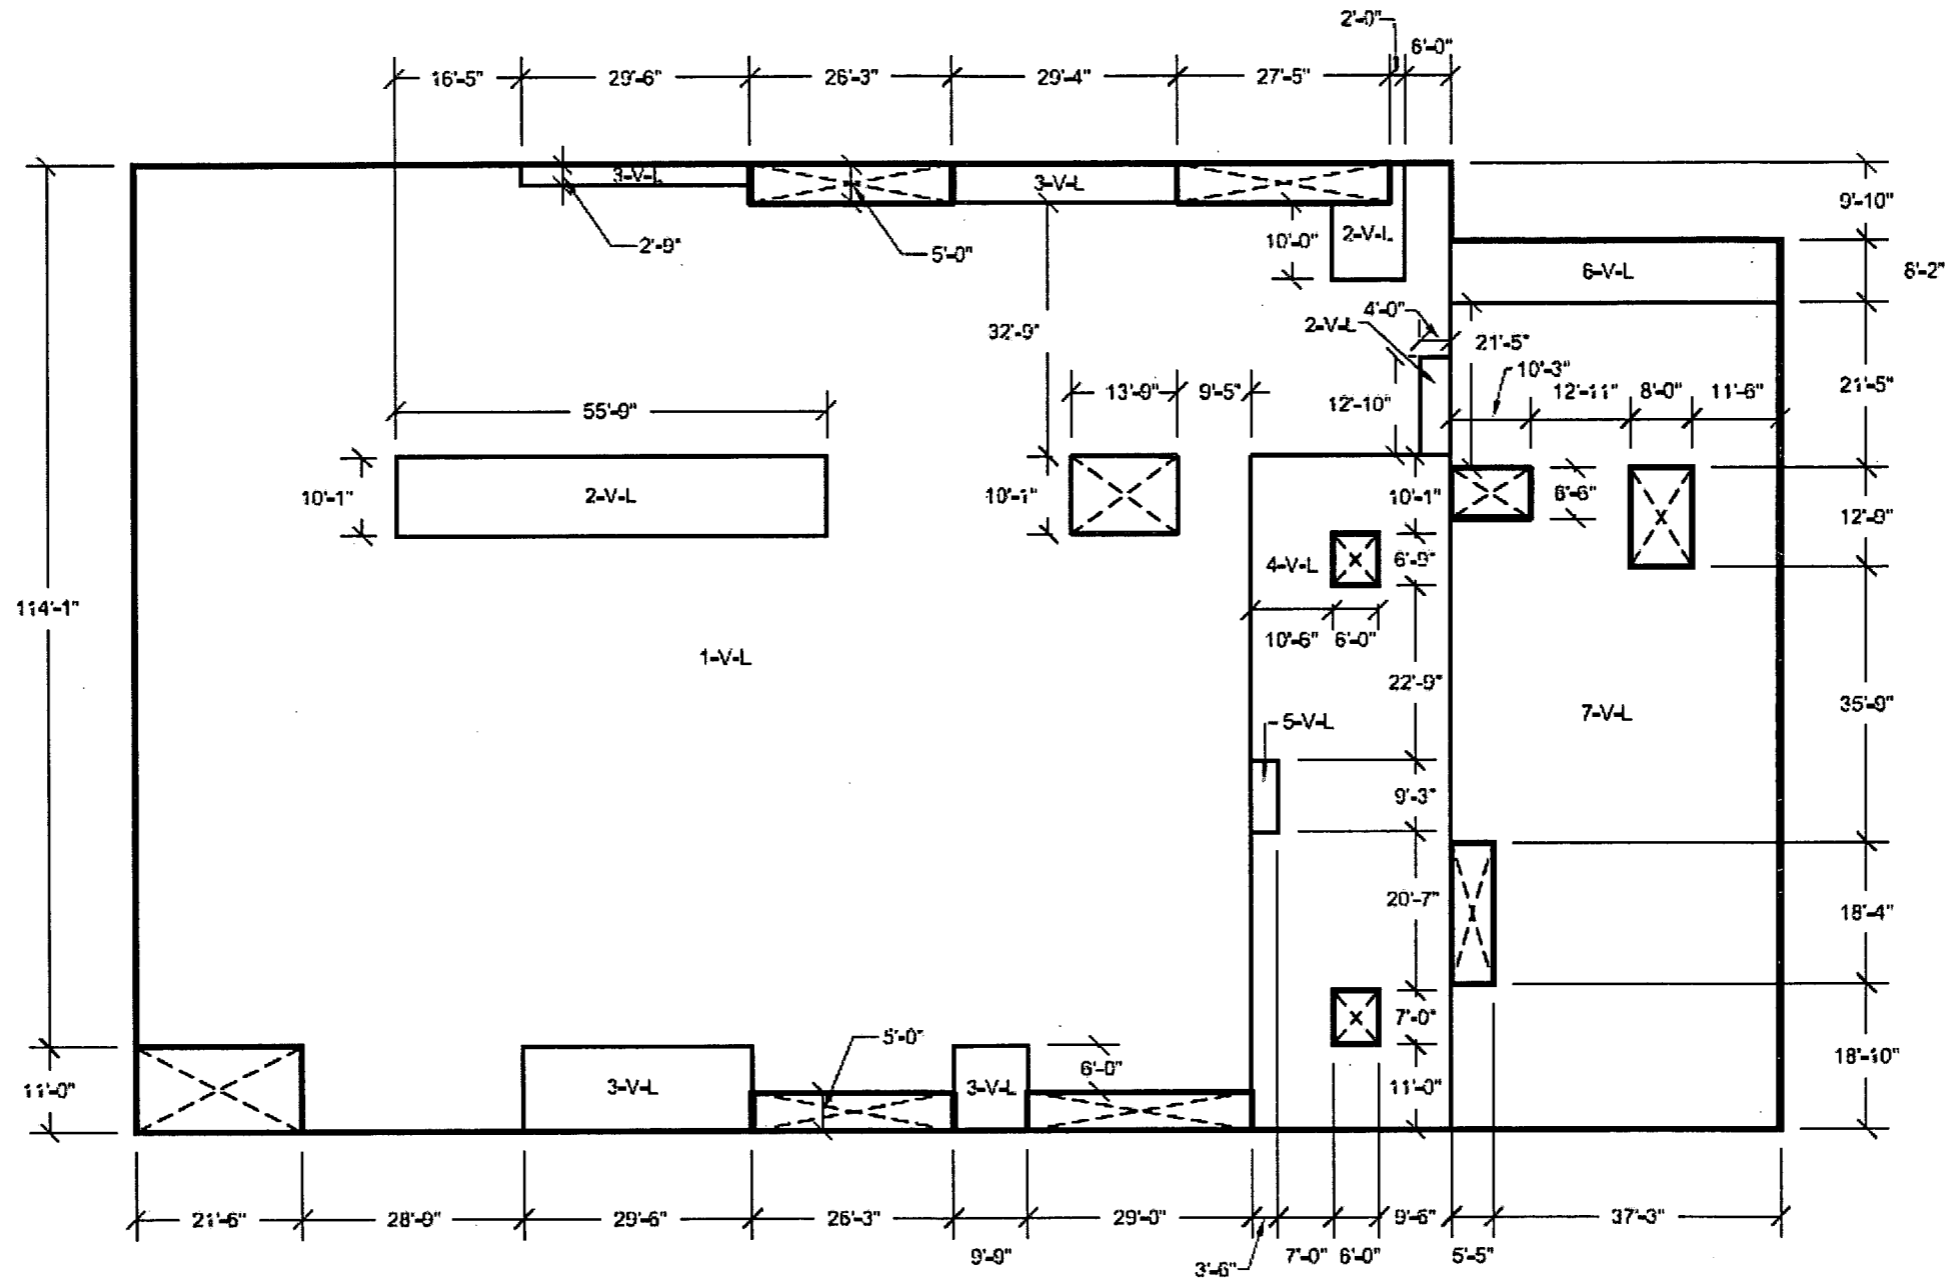

**FIGURE 3H,3-36: ELEVATION 35 LOOKING DOWN
NORTH-SOUTH REINFORCEMENT ZONES
FAR SIDE FACE**

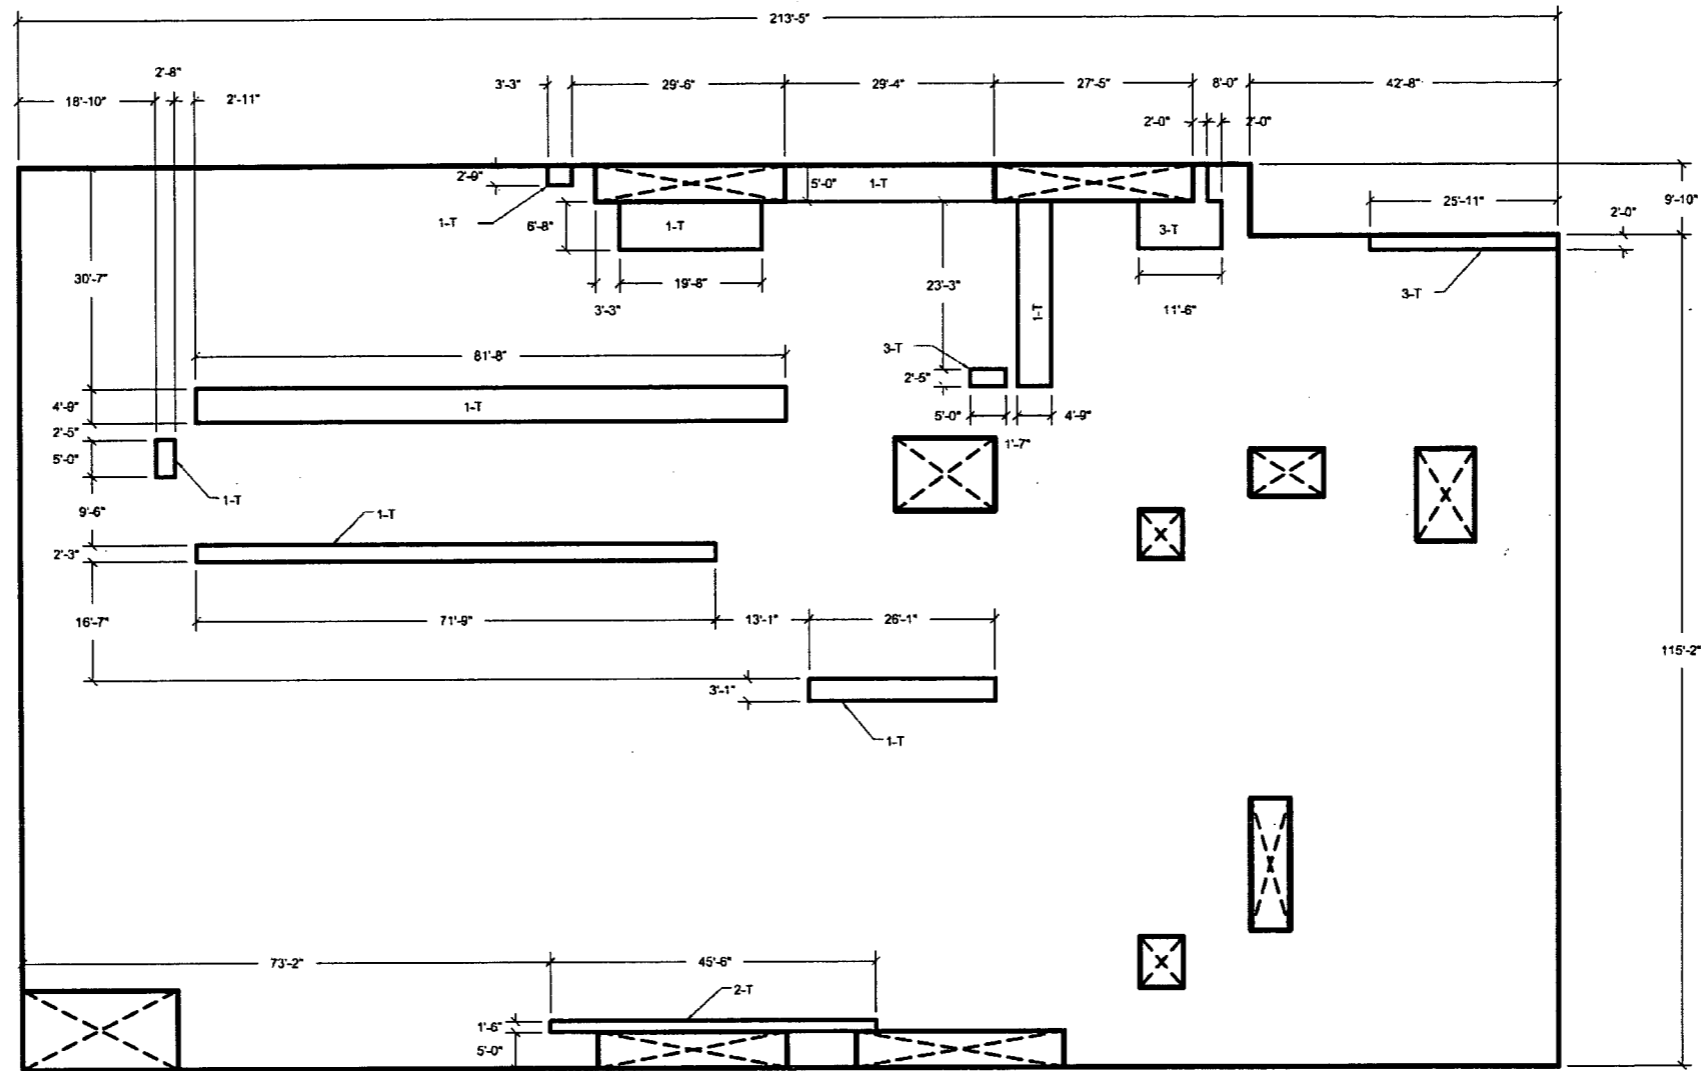

**FIGURE 3H.3-37a: ELEVATION 35 LOOKING DOWN
TRANSVERSE REINFORCEMENT ZONES**

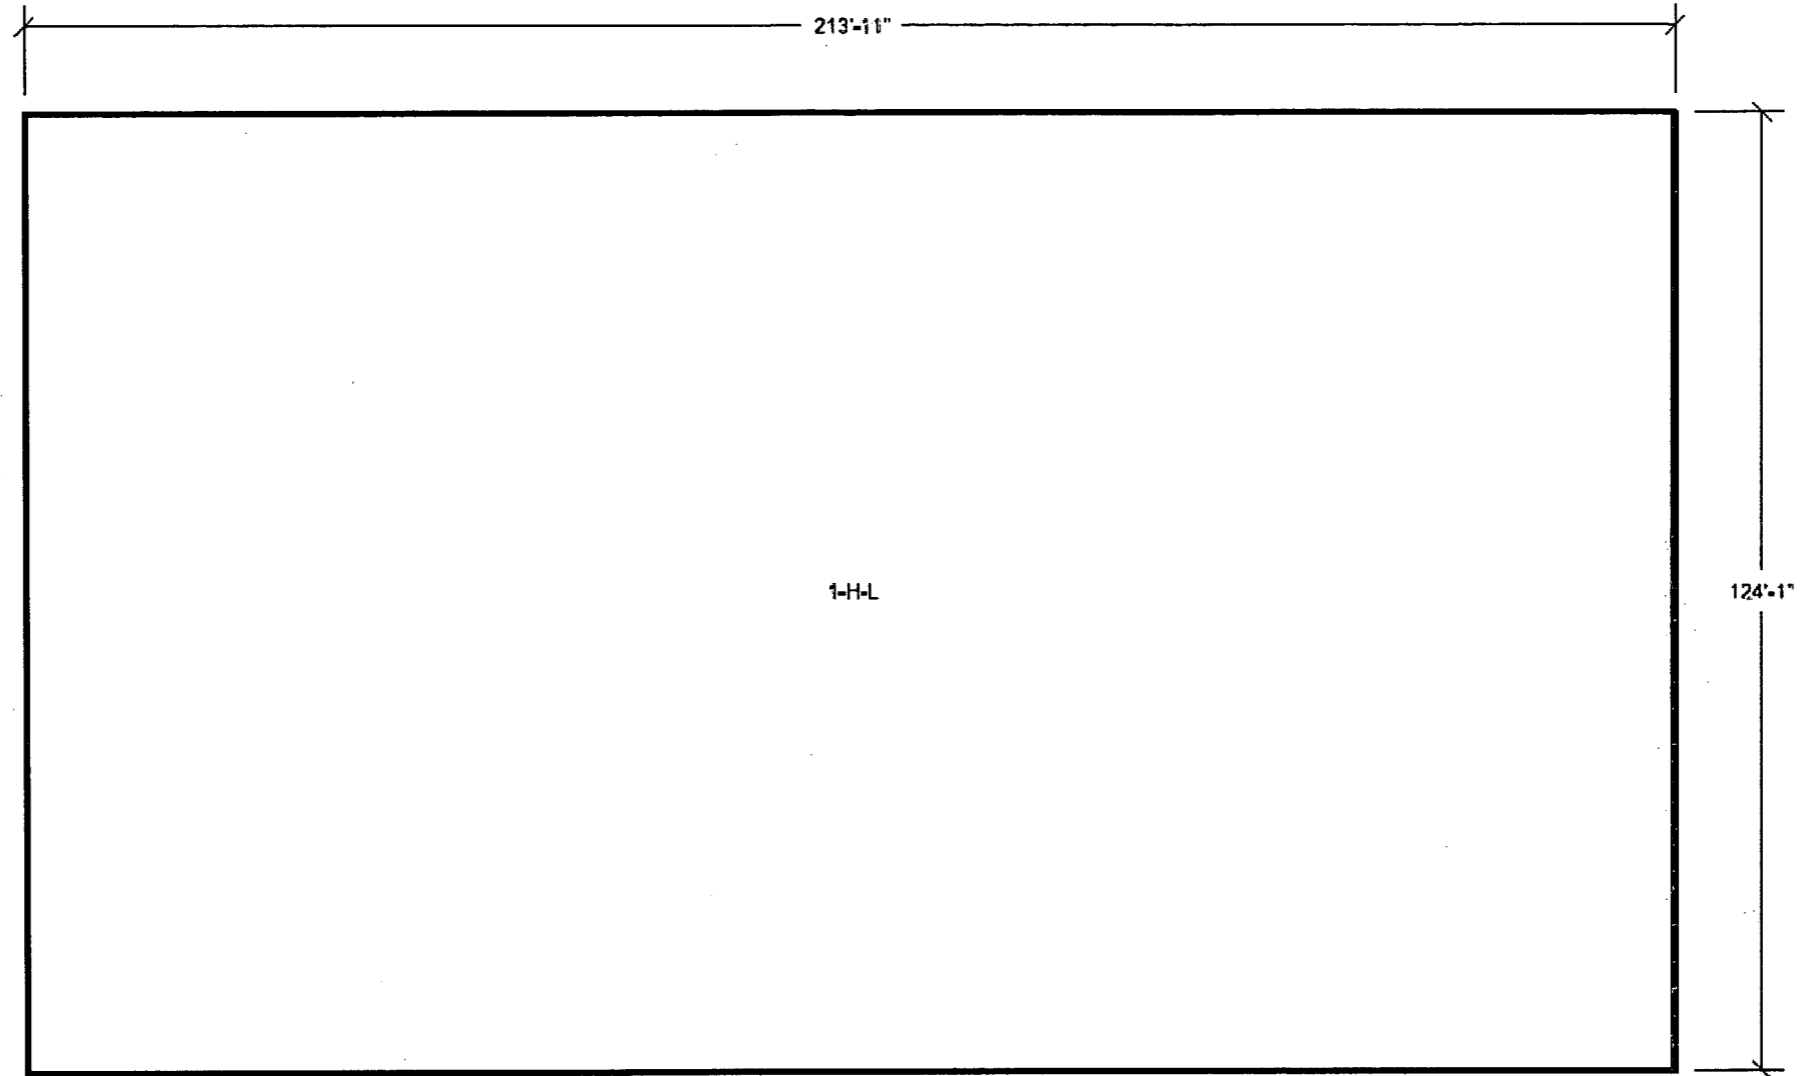


FIGURE 3H.3-36: ELEVATION 95 LOOKING DOWN
EAST-WEST REINFORCEMENT ZONES
NEAR SIDE FACE

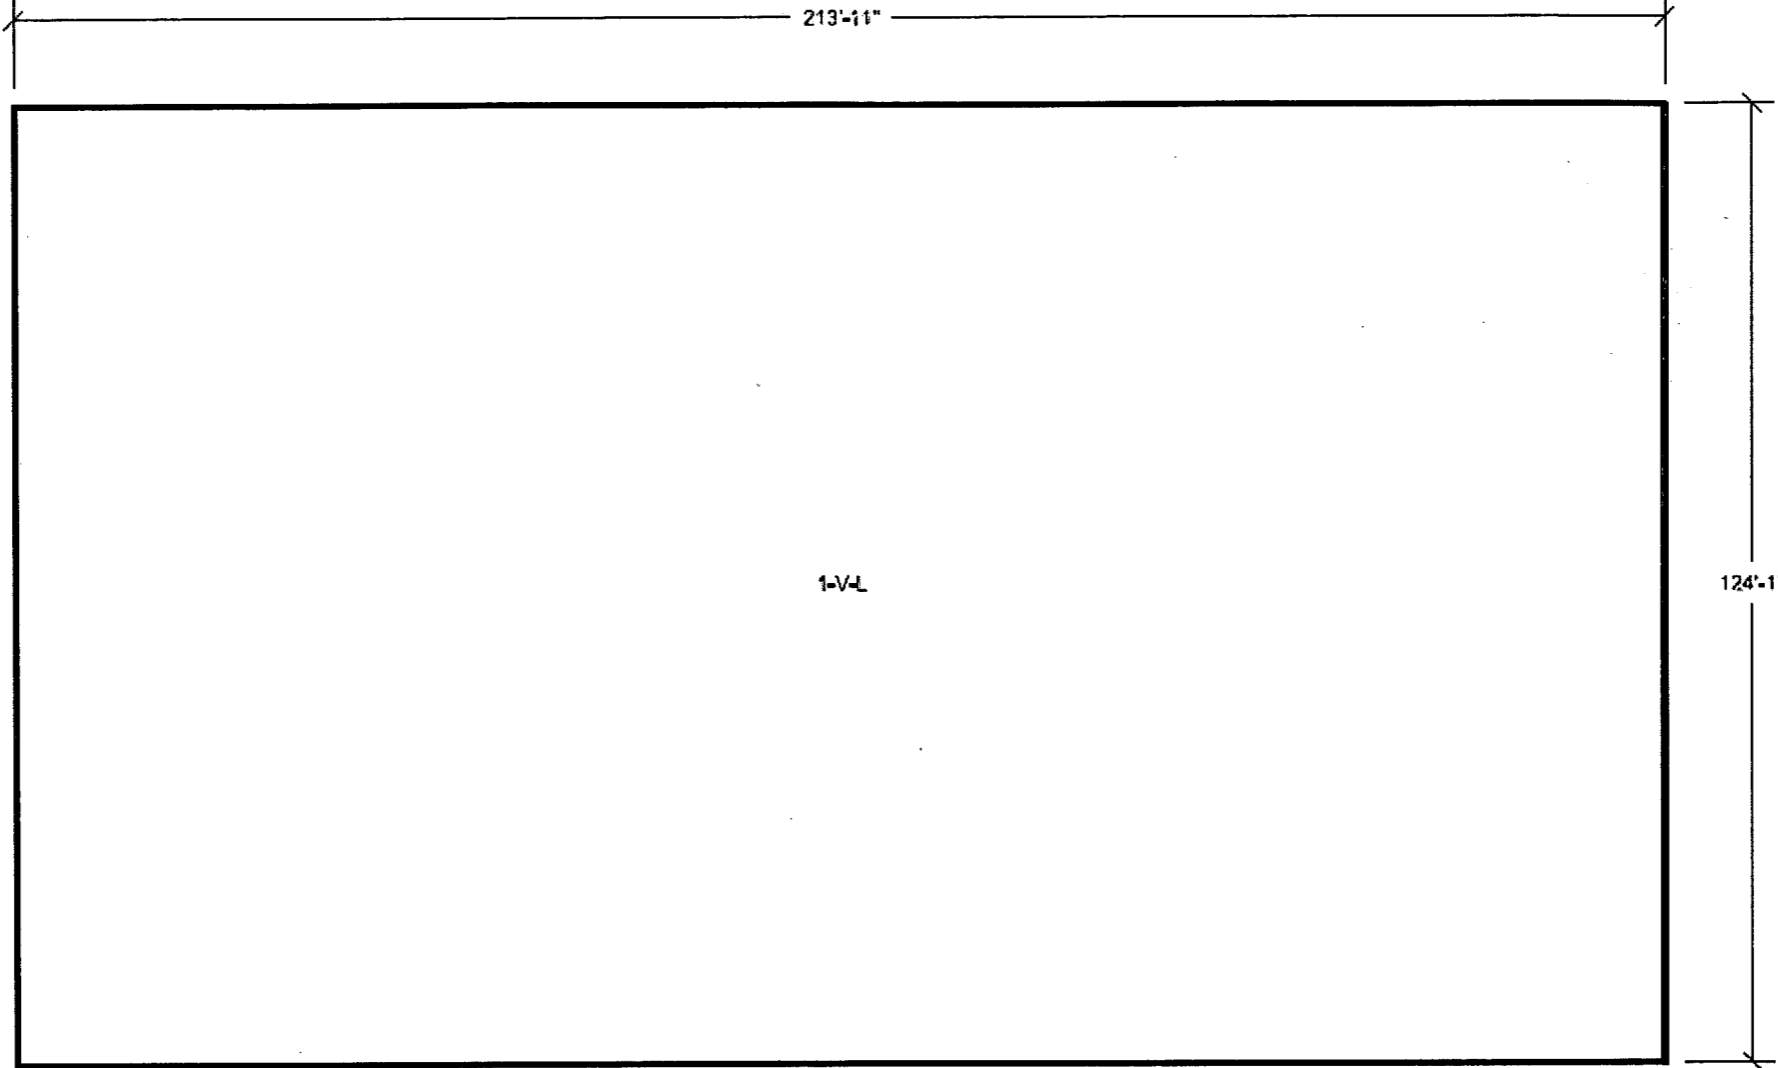


FIGURE 3H, 3-39: ELEVATION 95 LOOKING DOWN
NORTH-SOUTH REINFORCEMENT ZONES
NEAR SIDE FACE

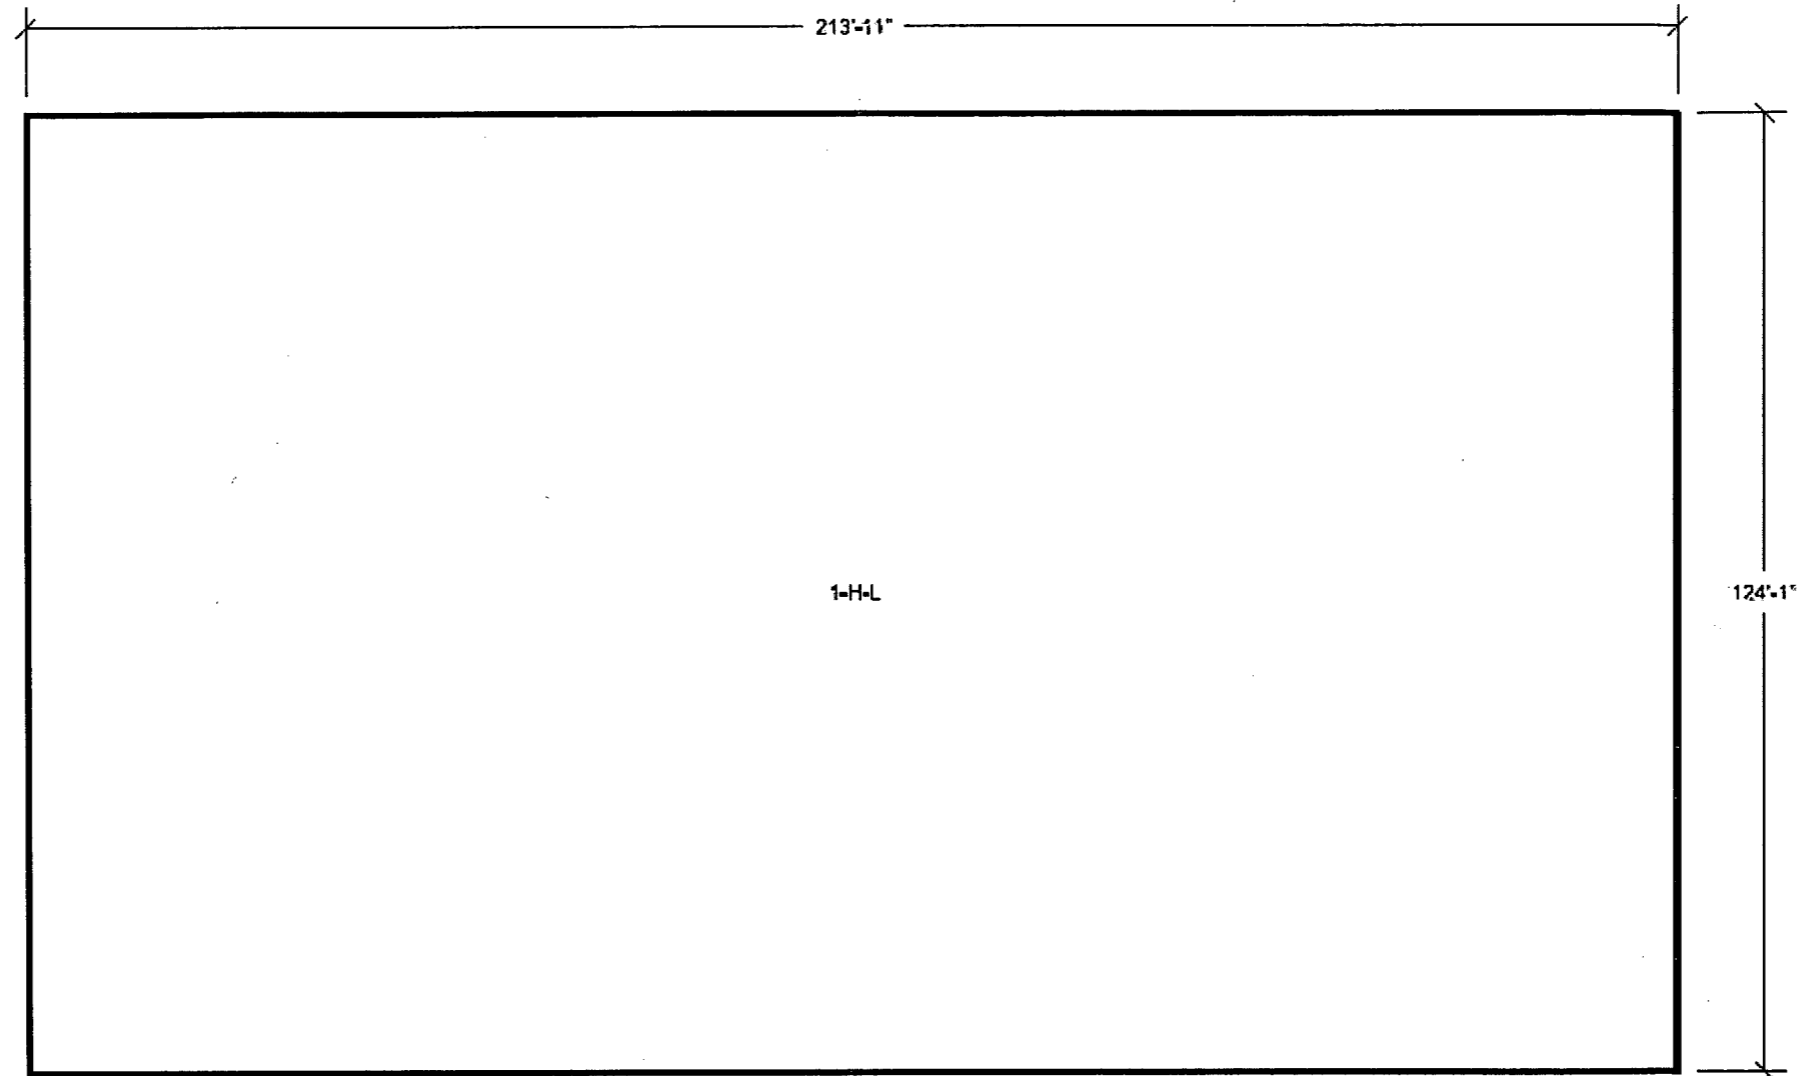


FIGURE 3H.3-40: ELEVATION 95 LOOKING DOWN
EAST-WEST REINFORCEMENT ZONES
FAR SIDE FACE

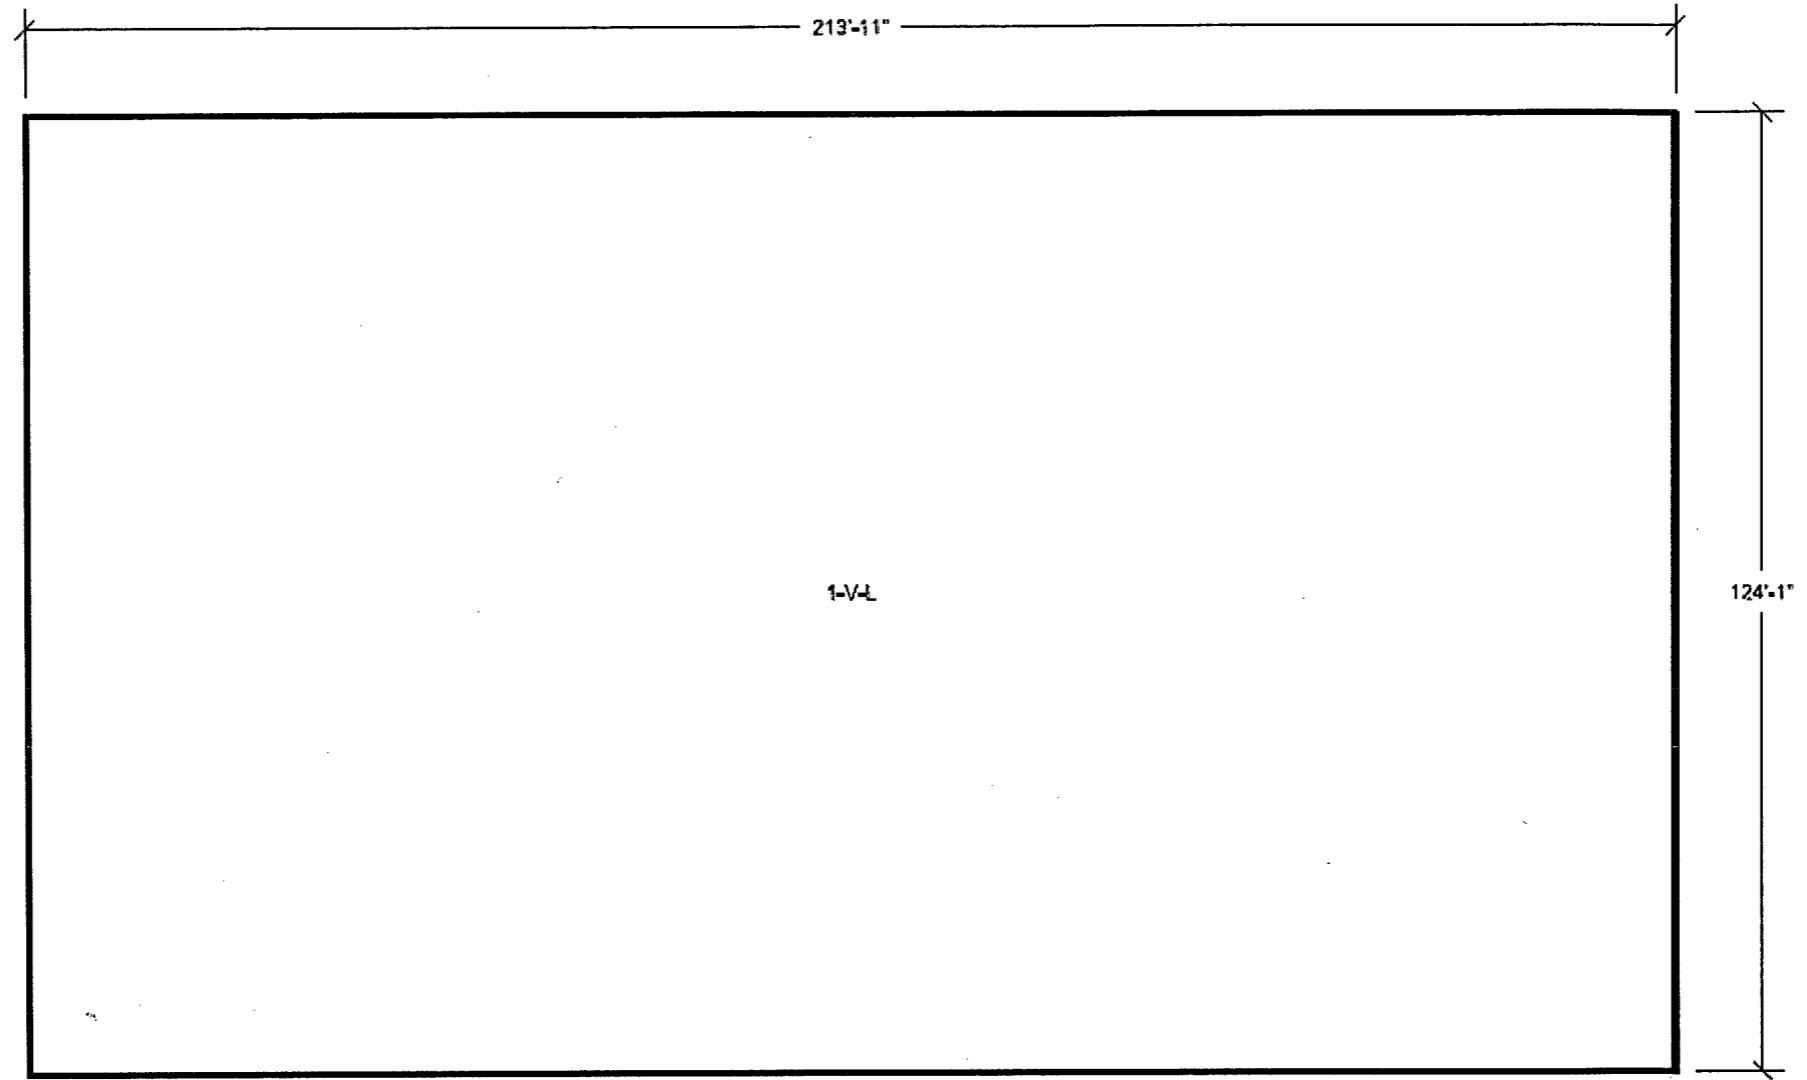


FIGURE 3H.3-4.1: ELEVATION 95 LOOKING DOWN
NORTH-SOUTH REINFORCEMENT ZONES
FAR SIDE FACE

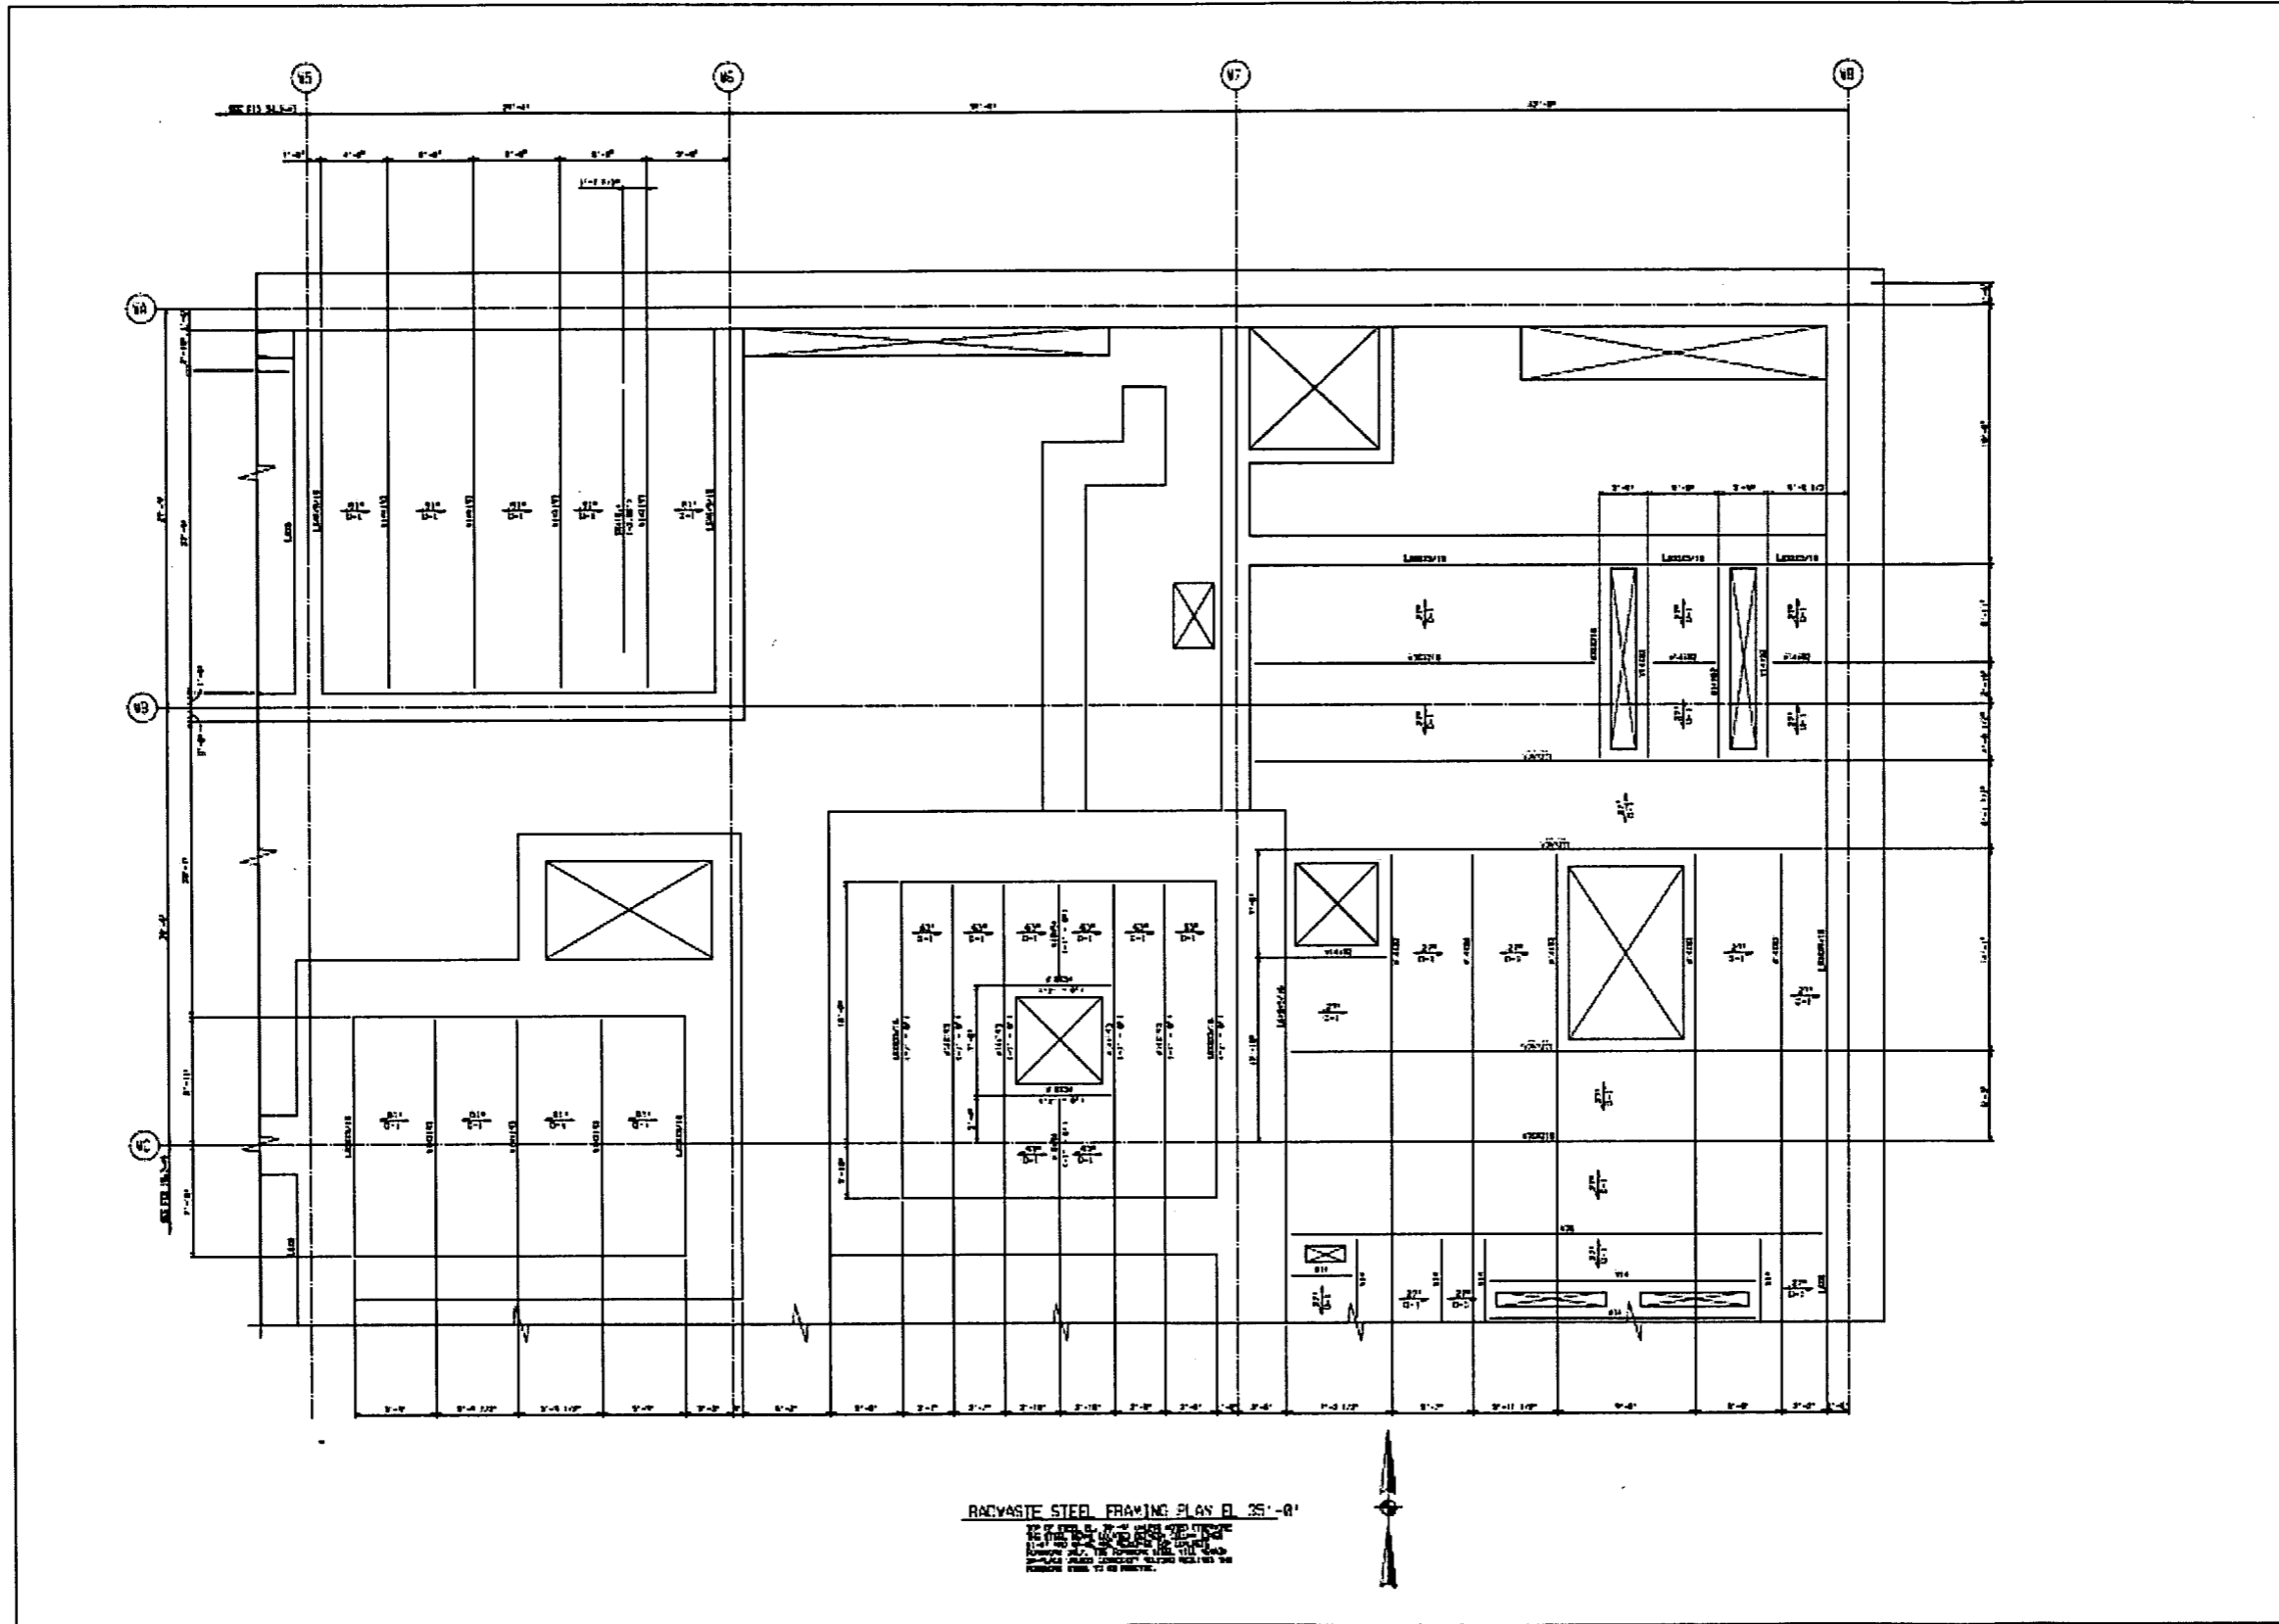


FIGURE 3H.3-44 EL 35'-0" STEEL LAYOUT BETWEEN COLUMN LINES W5-W8 AND WA-WC

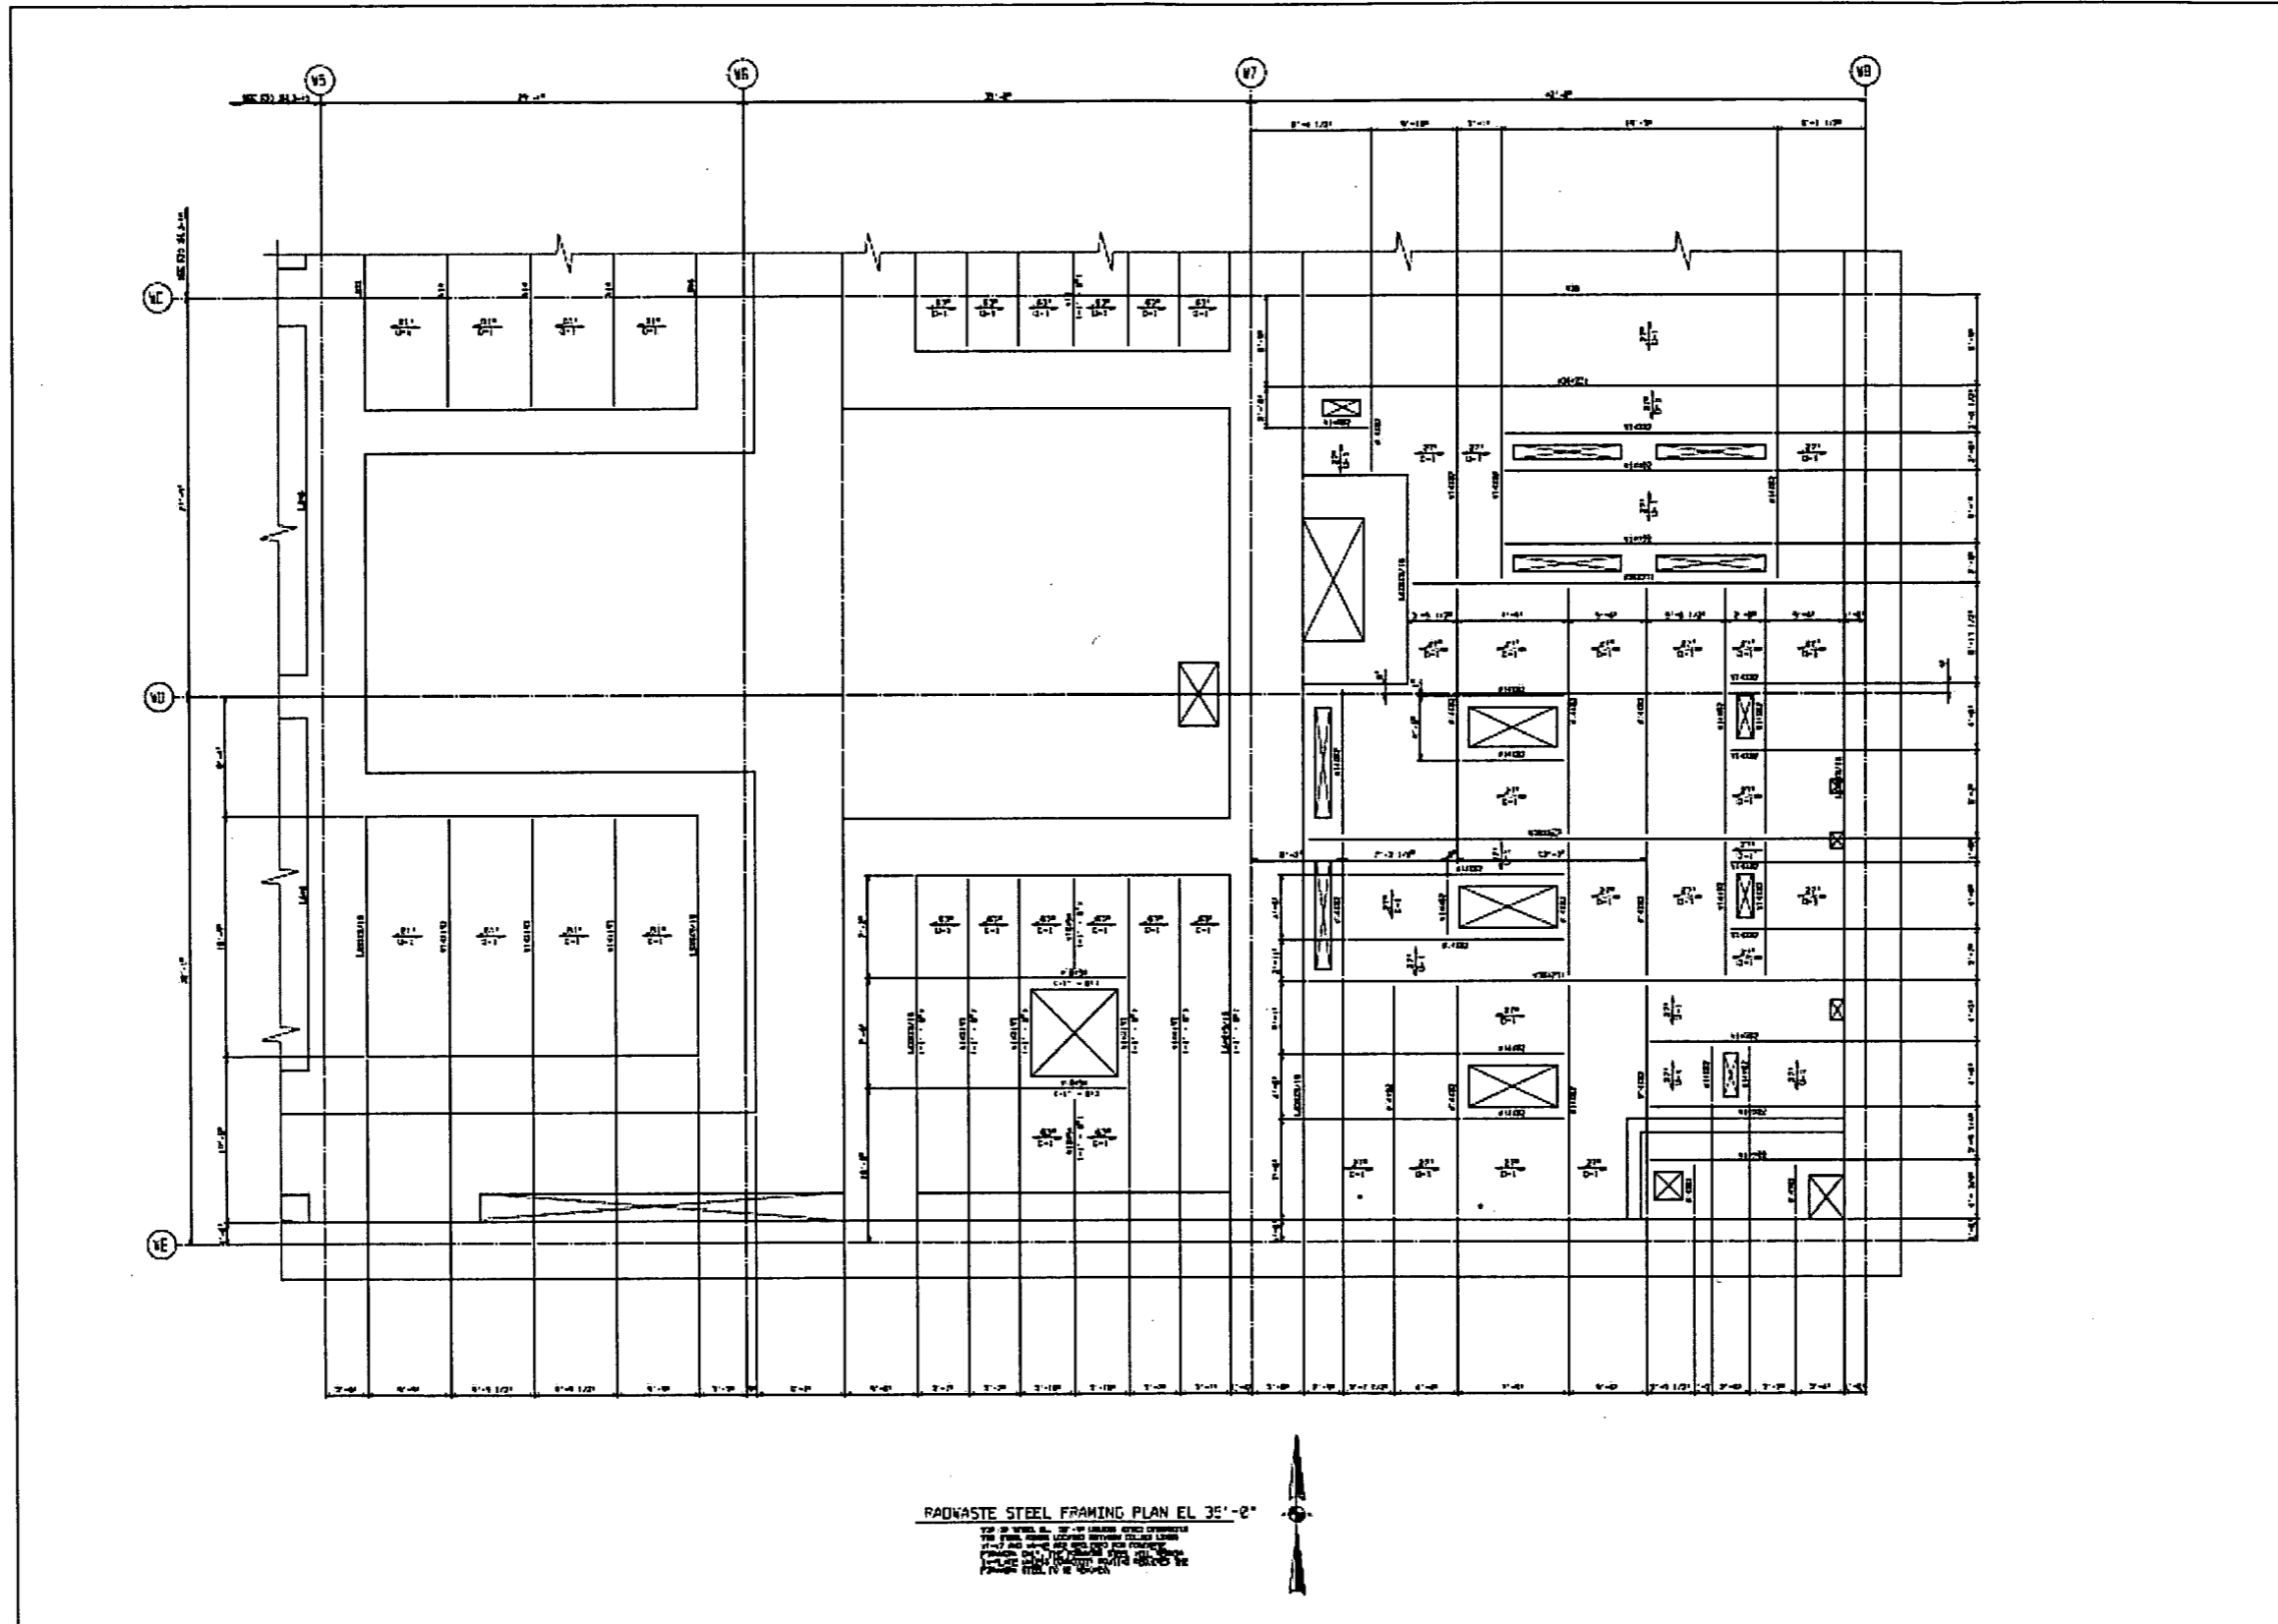


FIGURE 3H.3-46 EL 35'-0" STEEL LAYOUT BETWEEN COLUMN LINES W5-W8 AND WC-WE

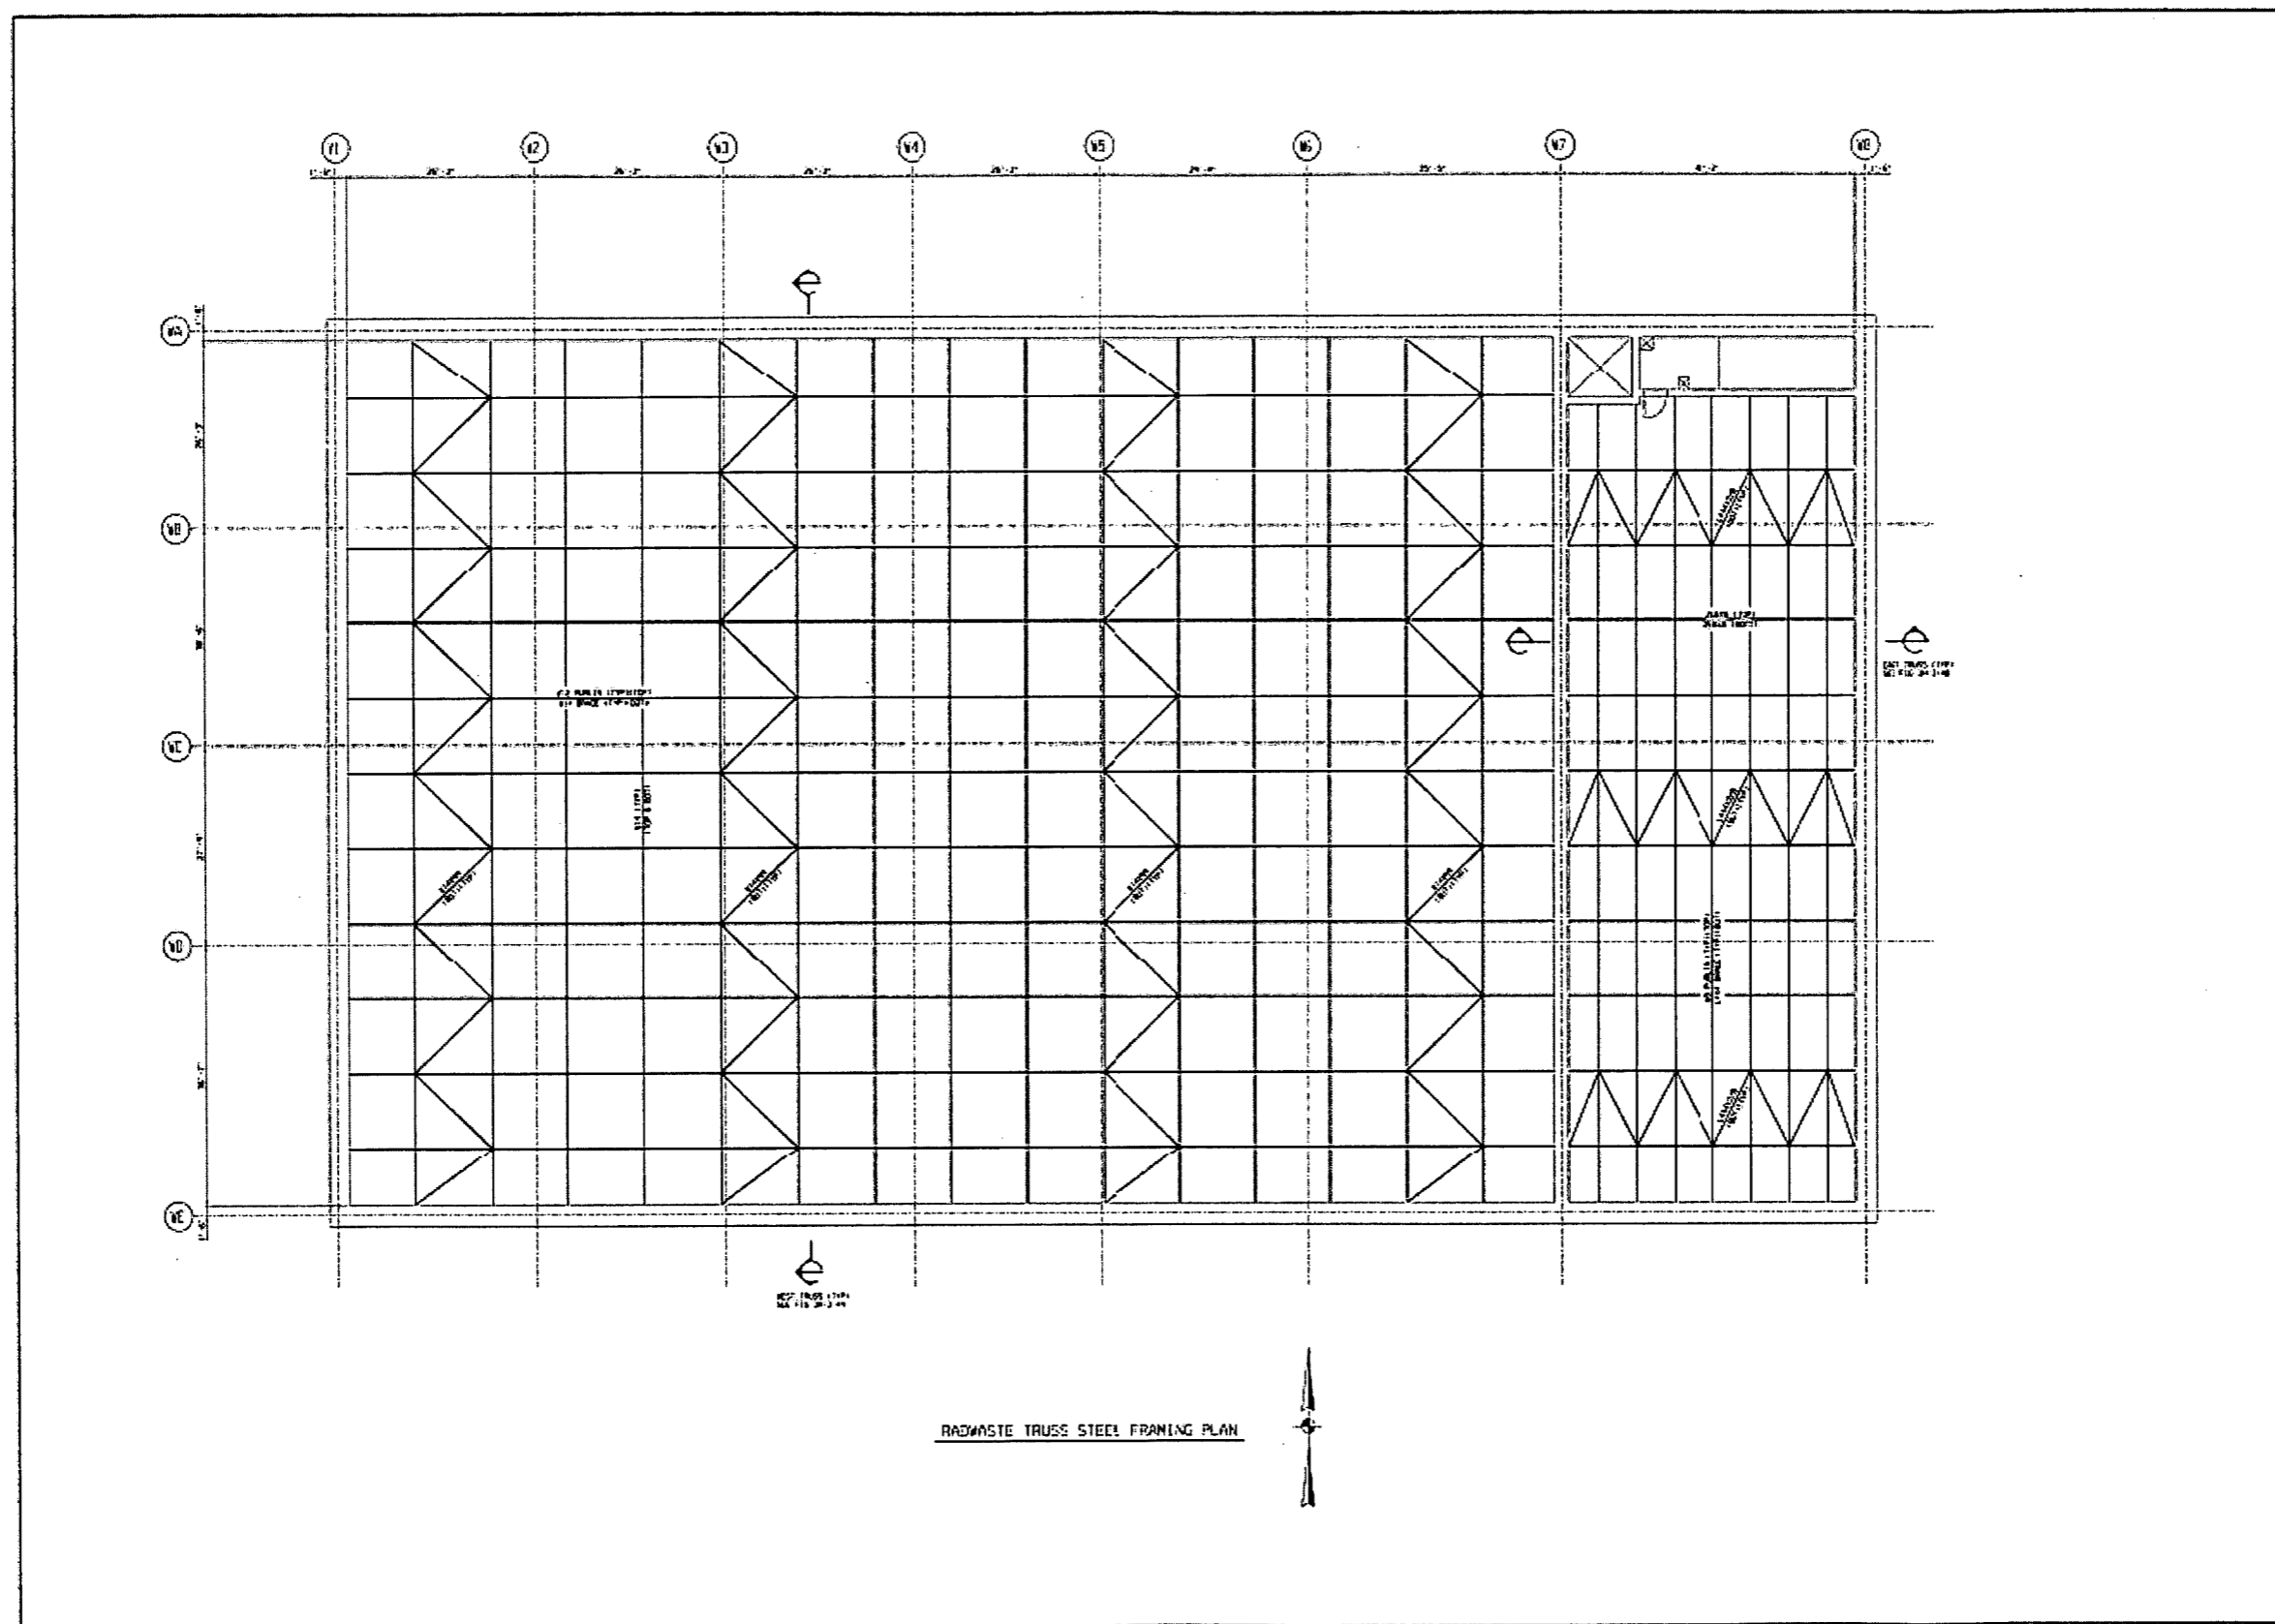


FIGURE 36.3-47 ROOF TRUSS, PURLIN AND HORIZONTAL BRACING LAYOUT (PLAN VIEW)


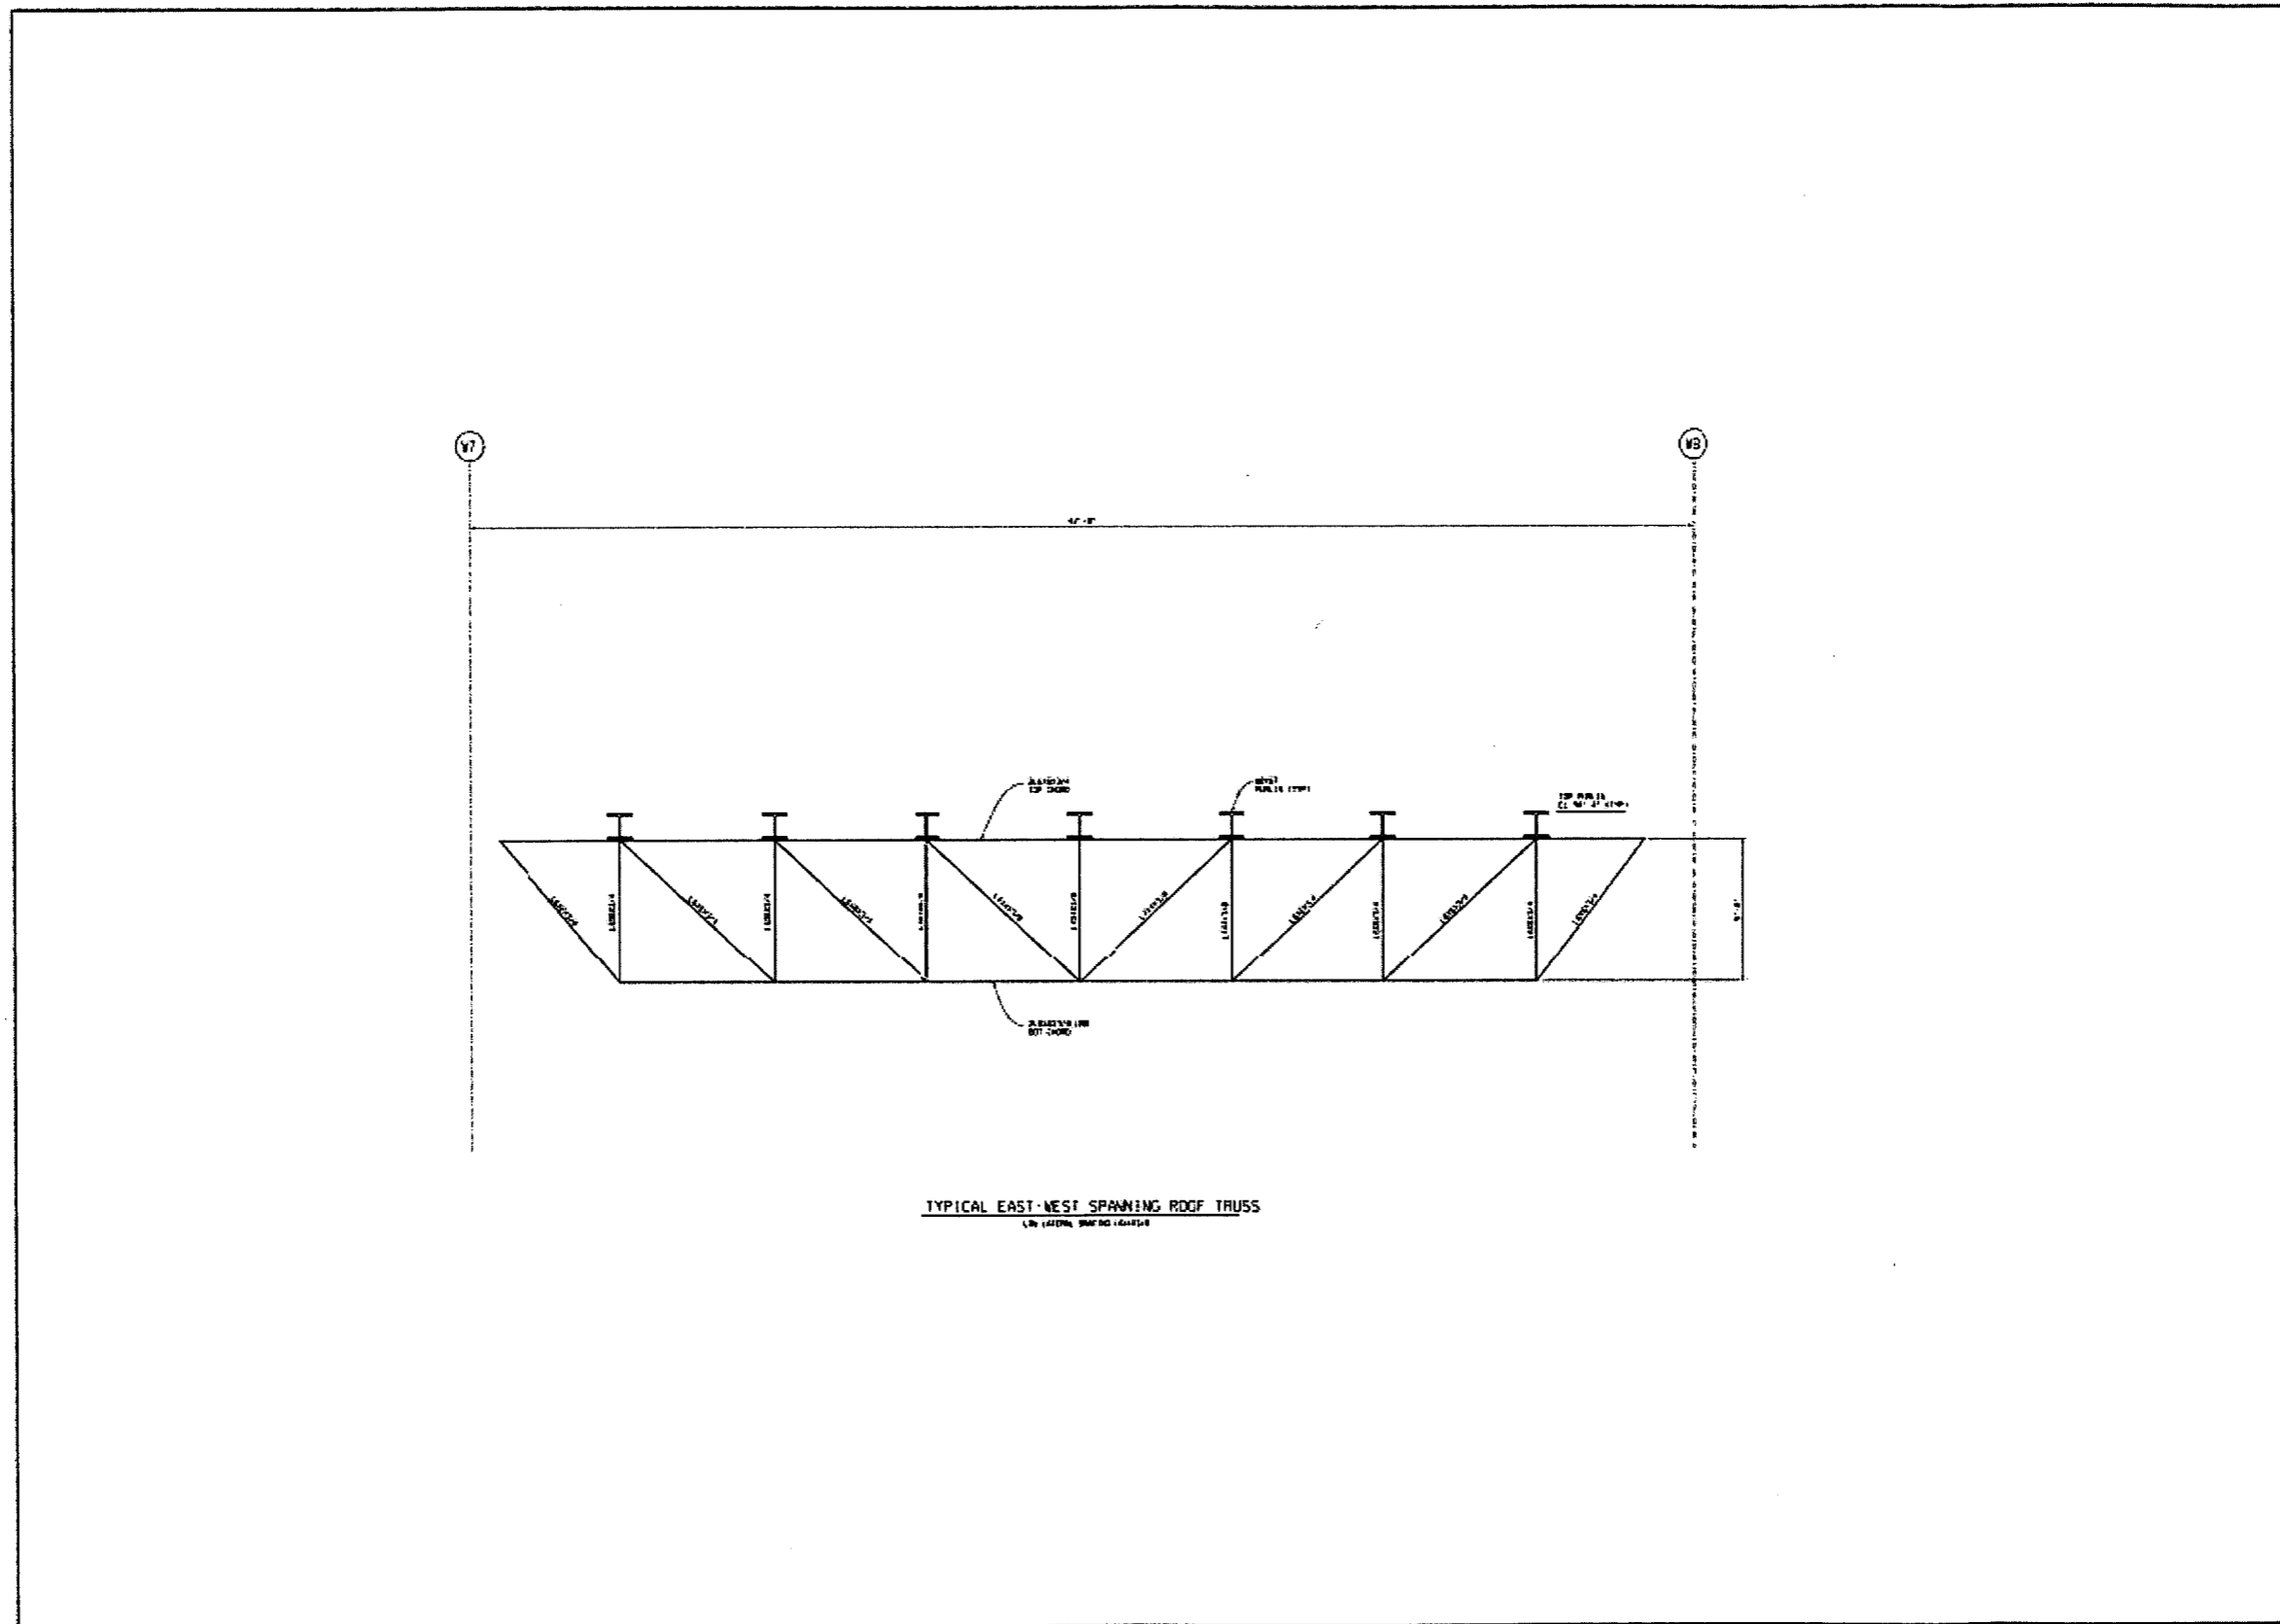


FIGURE (D11)-40 TYPICAL EAST-WEST SPANNING ROOF TRUSS BETWEEN COLUMN LINES W7-W8 (ELEVATION VIEW)

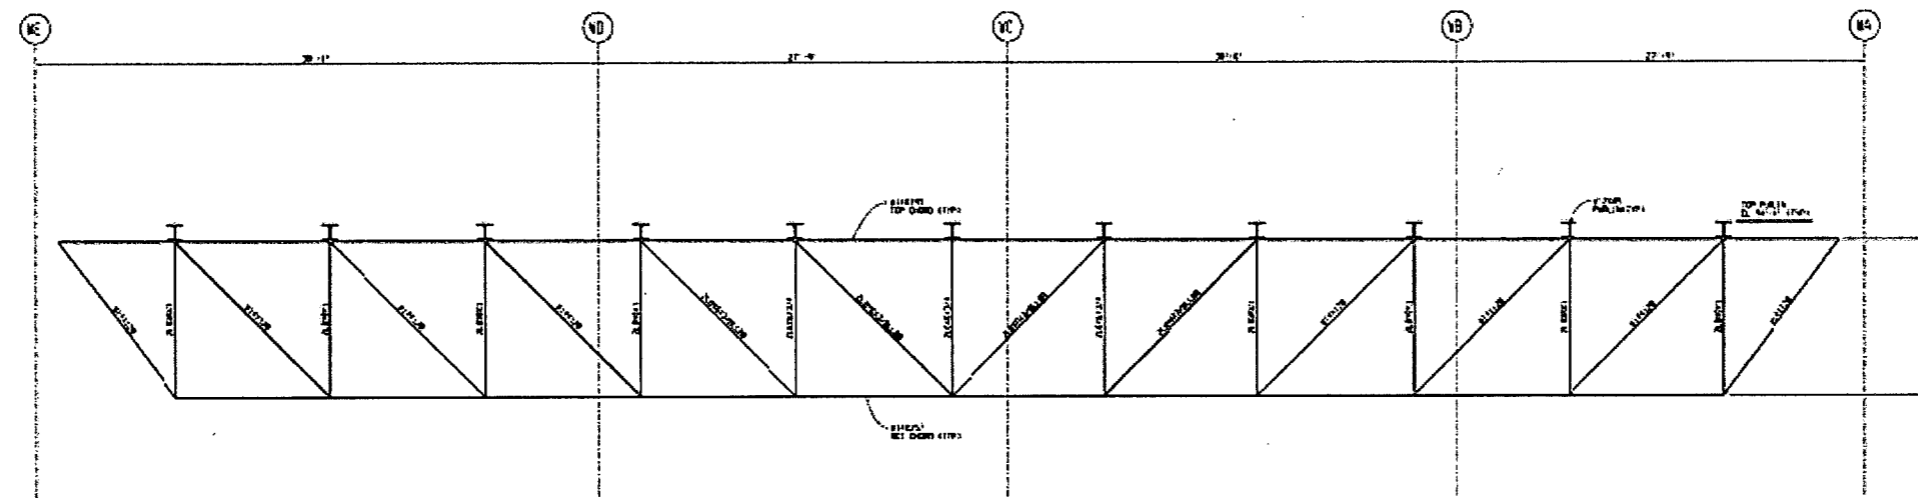

TYPICAL NORTH-SOUTH SPANNING ROOF TRUSS
1/2" = 1'-0" (VERTICAL)
1/4" = 1'-0" (HORIZONTAL)

FIGURE 34.3-49 TYPICAL NORTH-SOUTH SPANNING TRUSS BETWEEN COLUMN LINES MA-ME (ELEVATION VIEW)

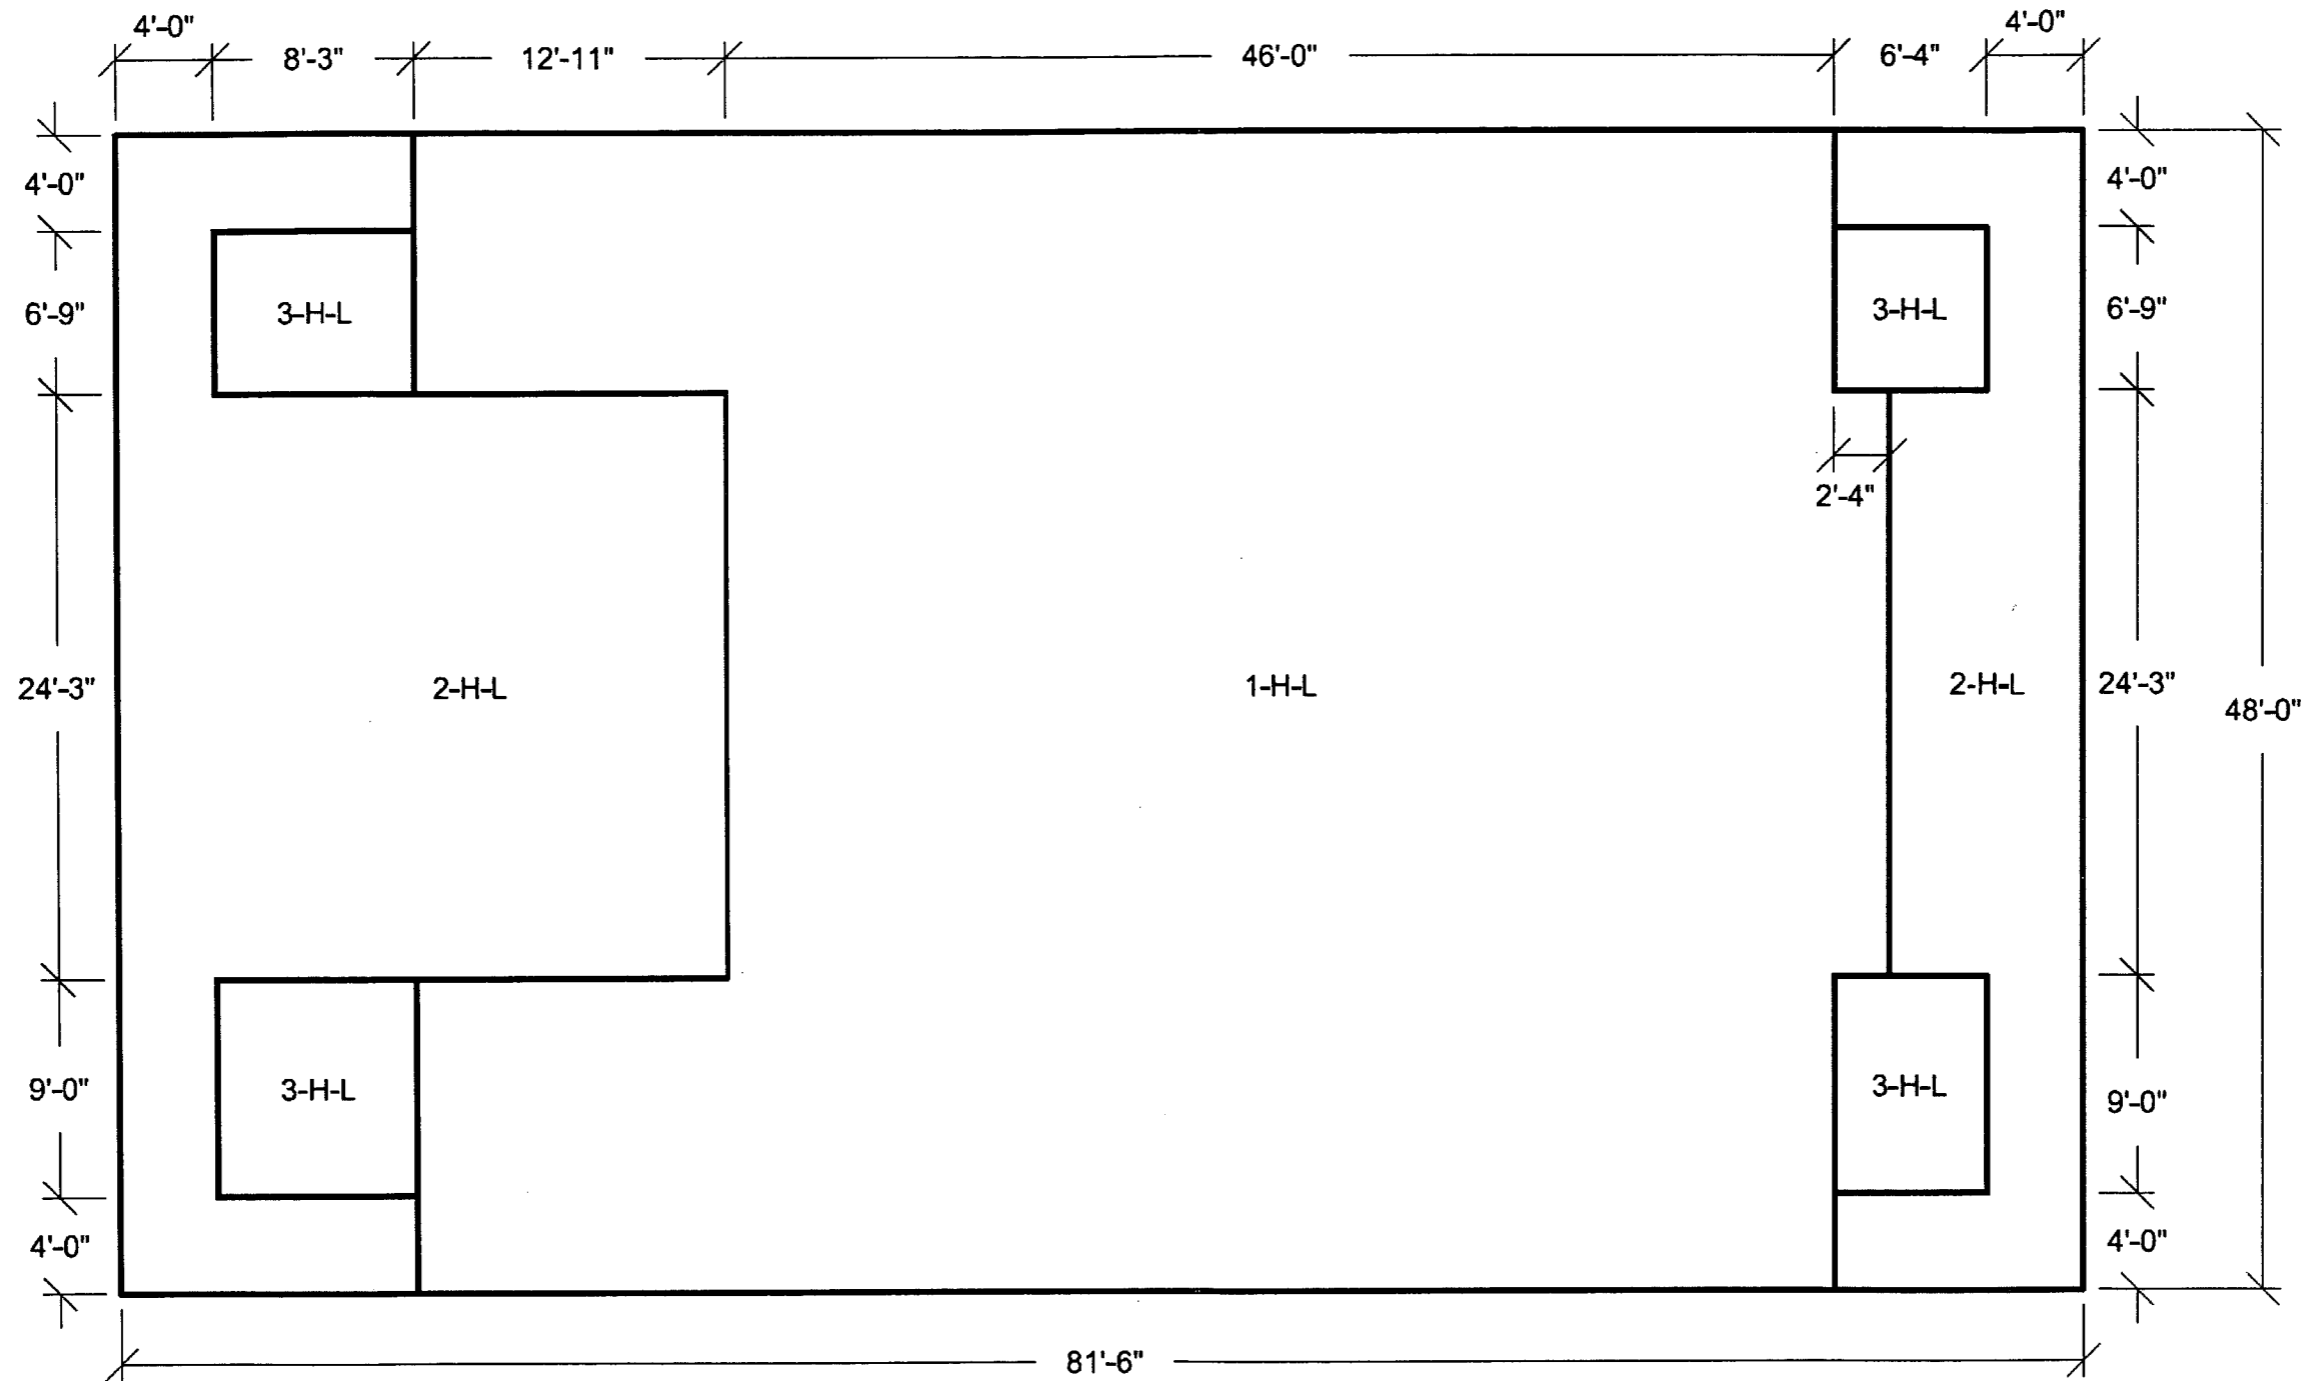


Figure 3H.6-142: Slab 1 Looking Down
Horizontal Reinforcement Zones
Near Side Face

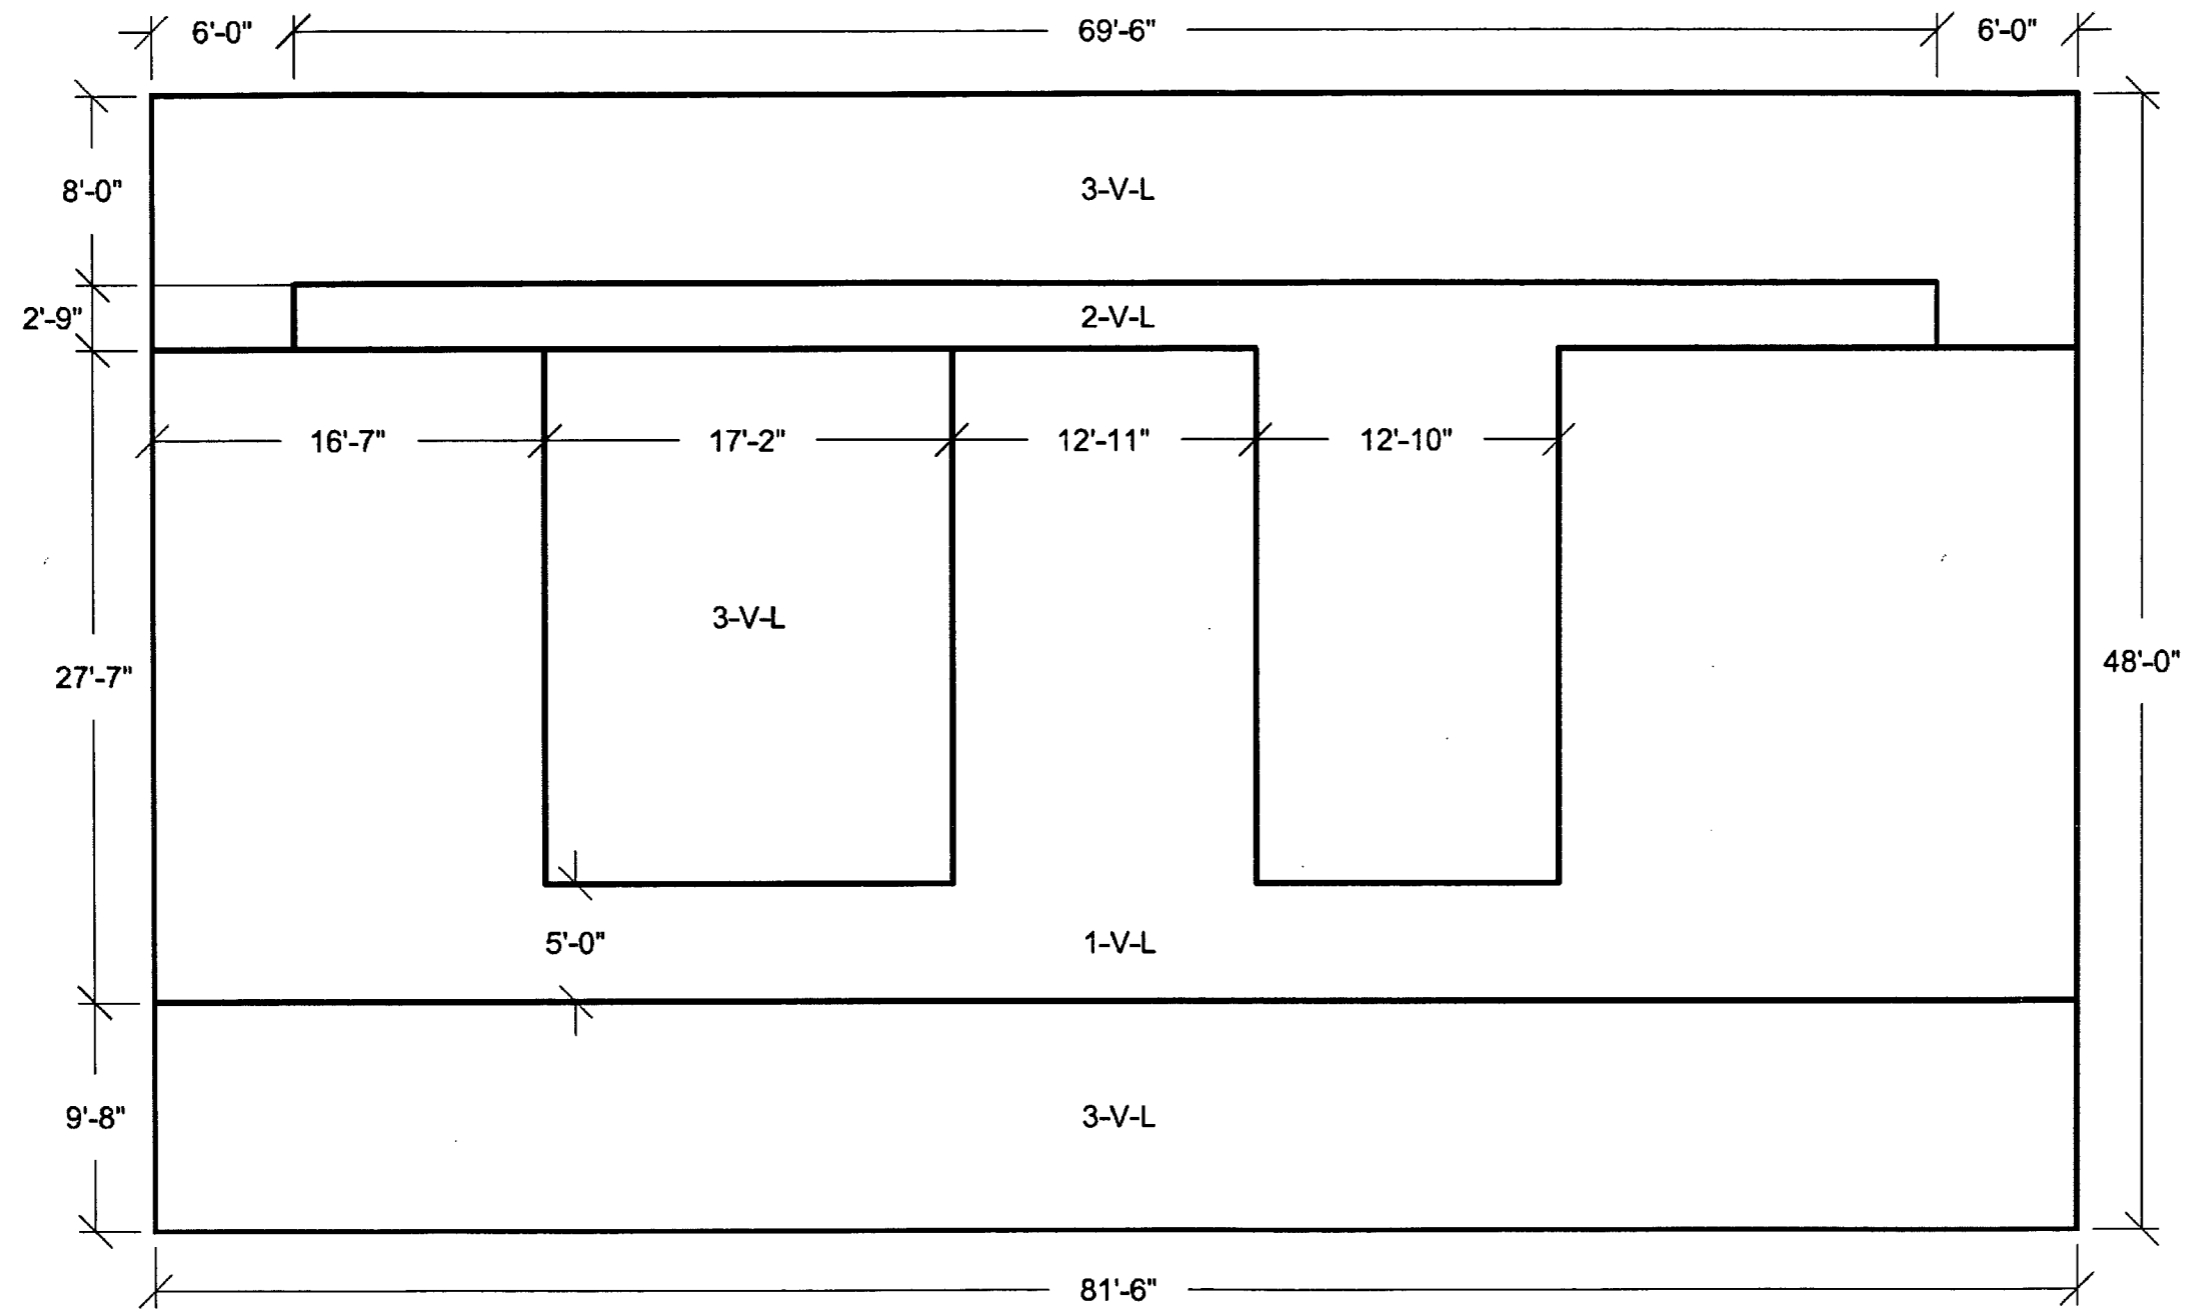


Figure 3H.6-143: Slab 1 Looking Down
Vertical Reinforcement Zones
Near Side Face

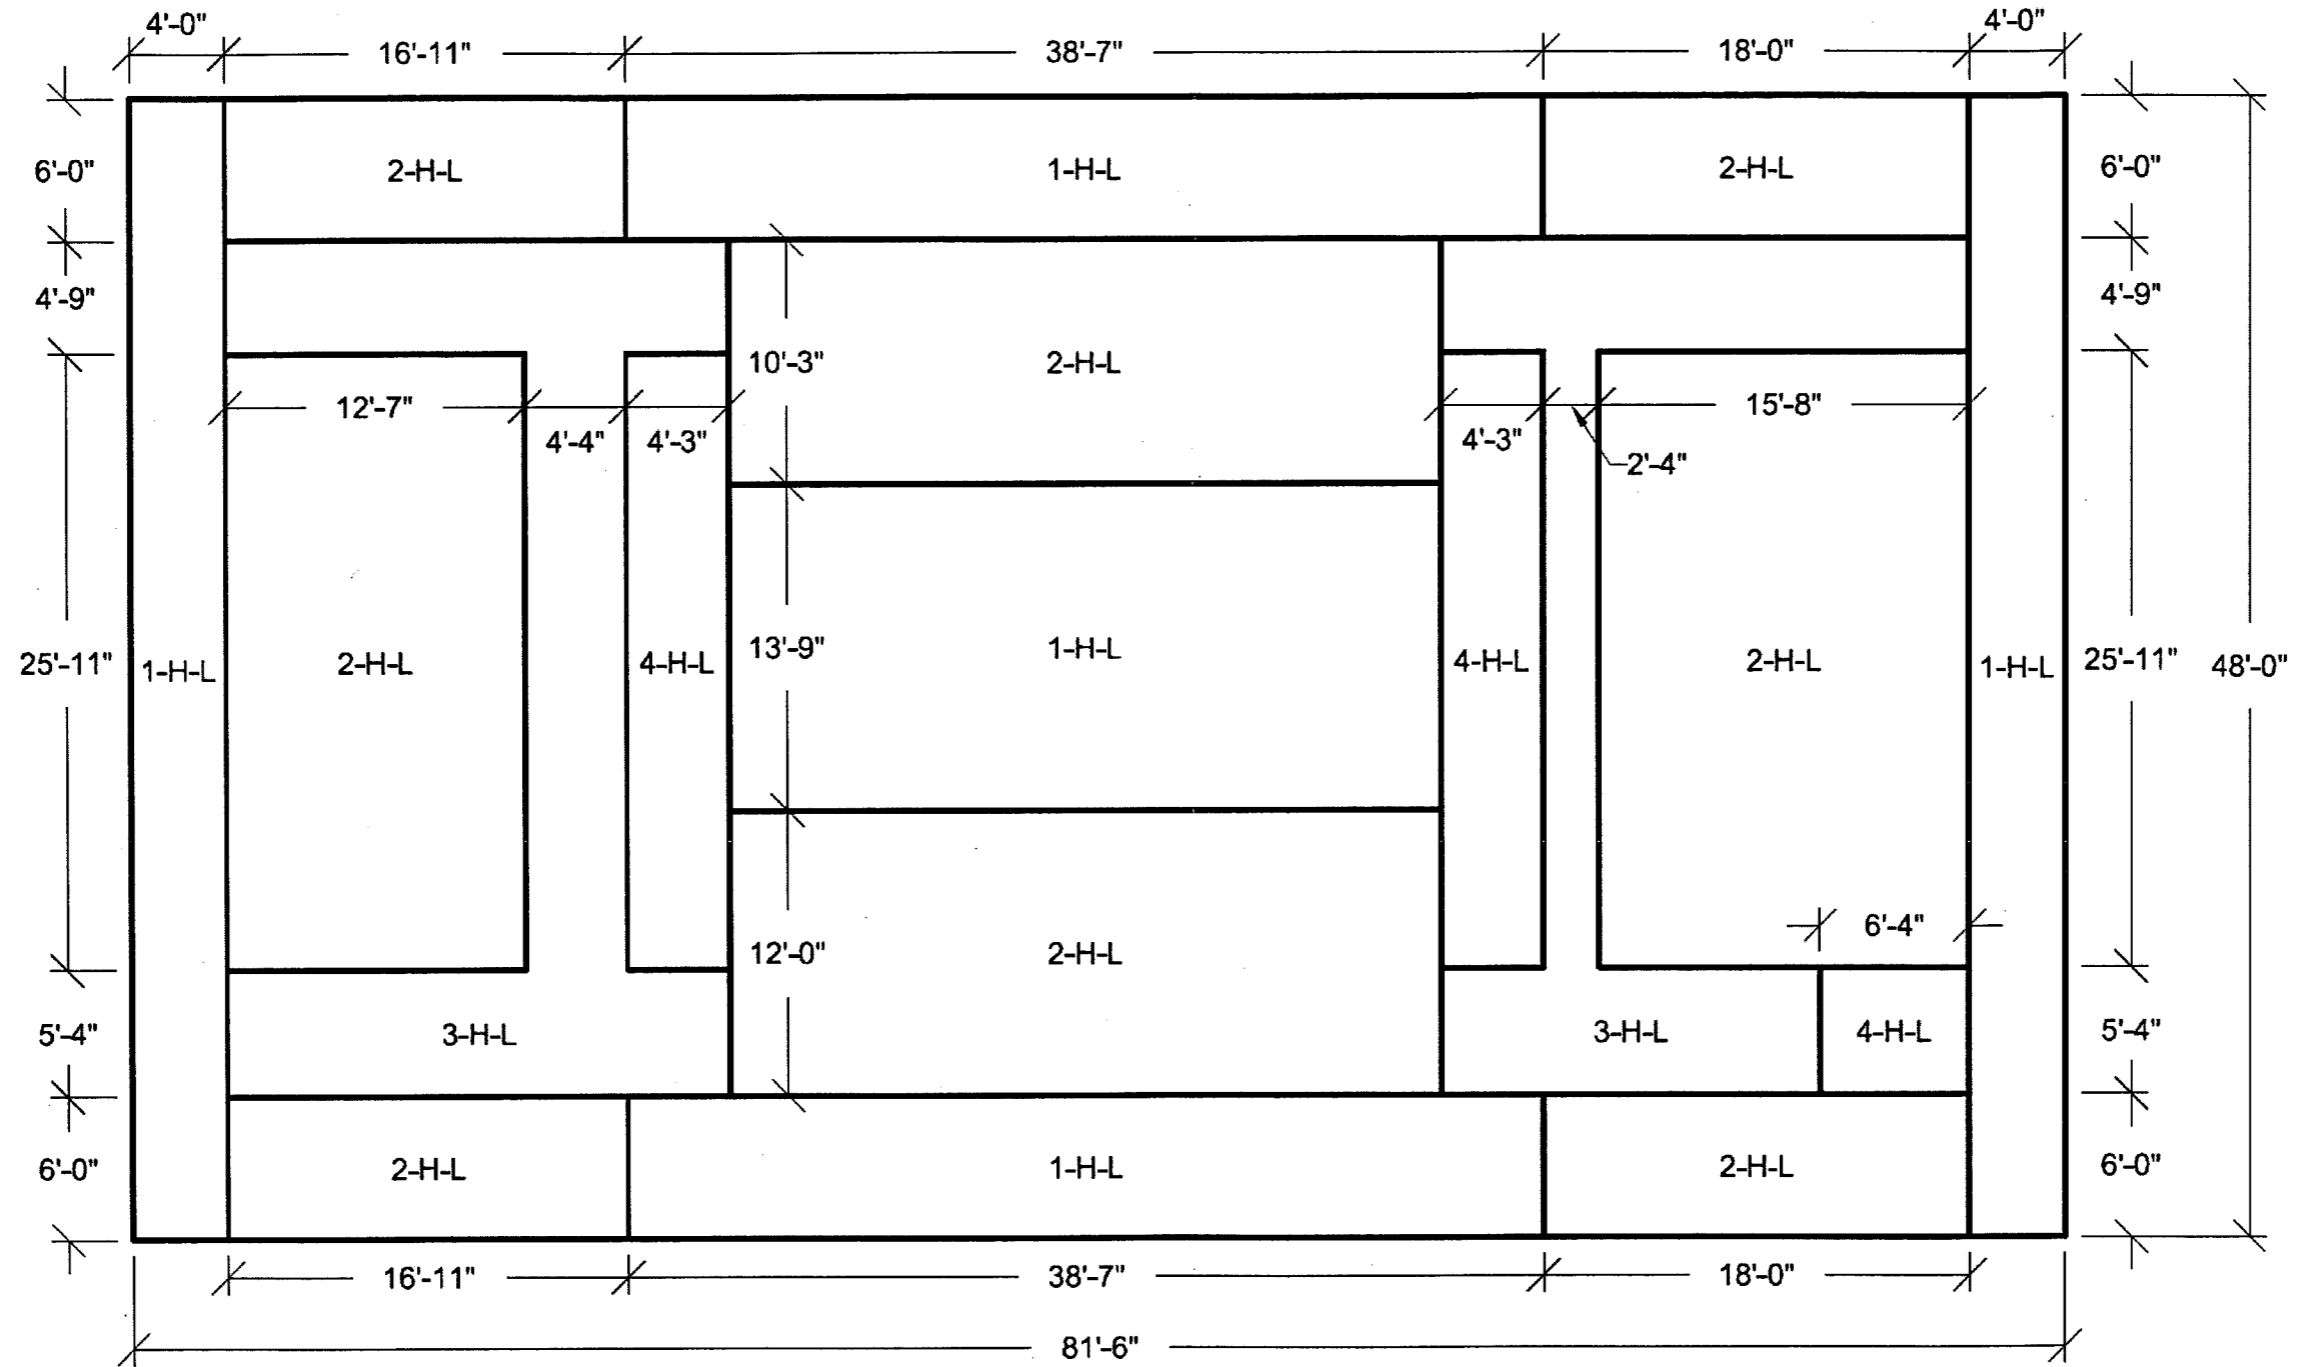


Figure 3H.6-144: Slab 1 Looking Down
 Horizontal Reinforcement Zones
 Far Side Face

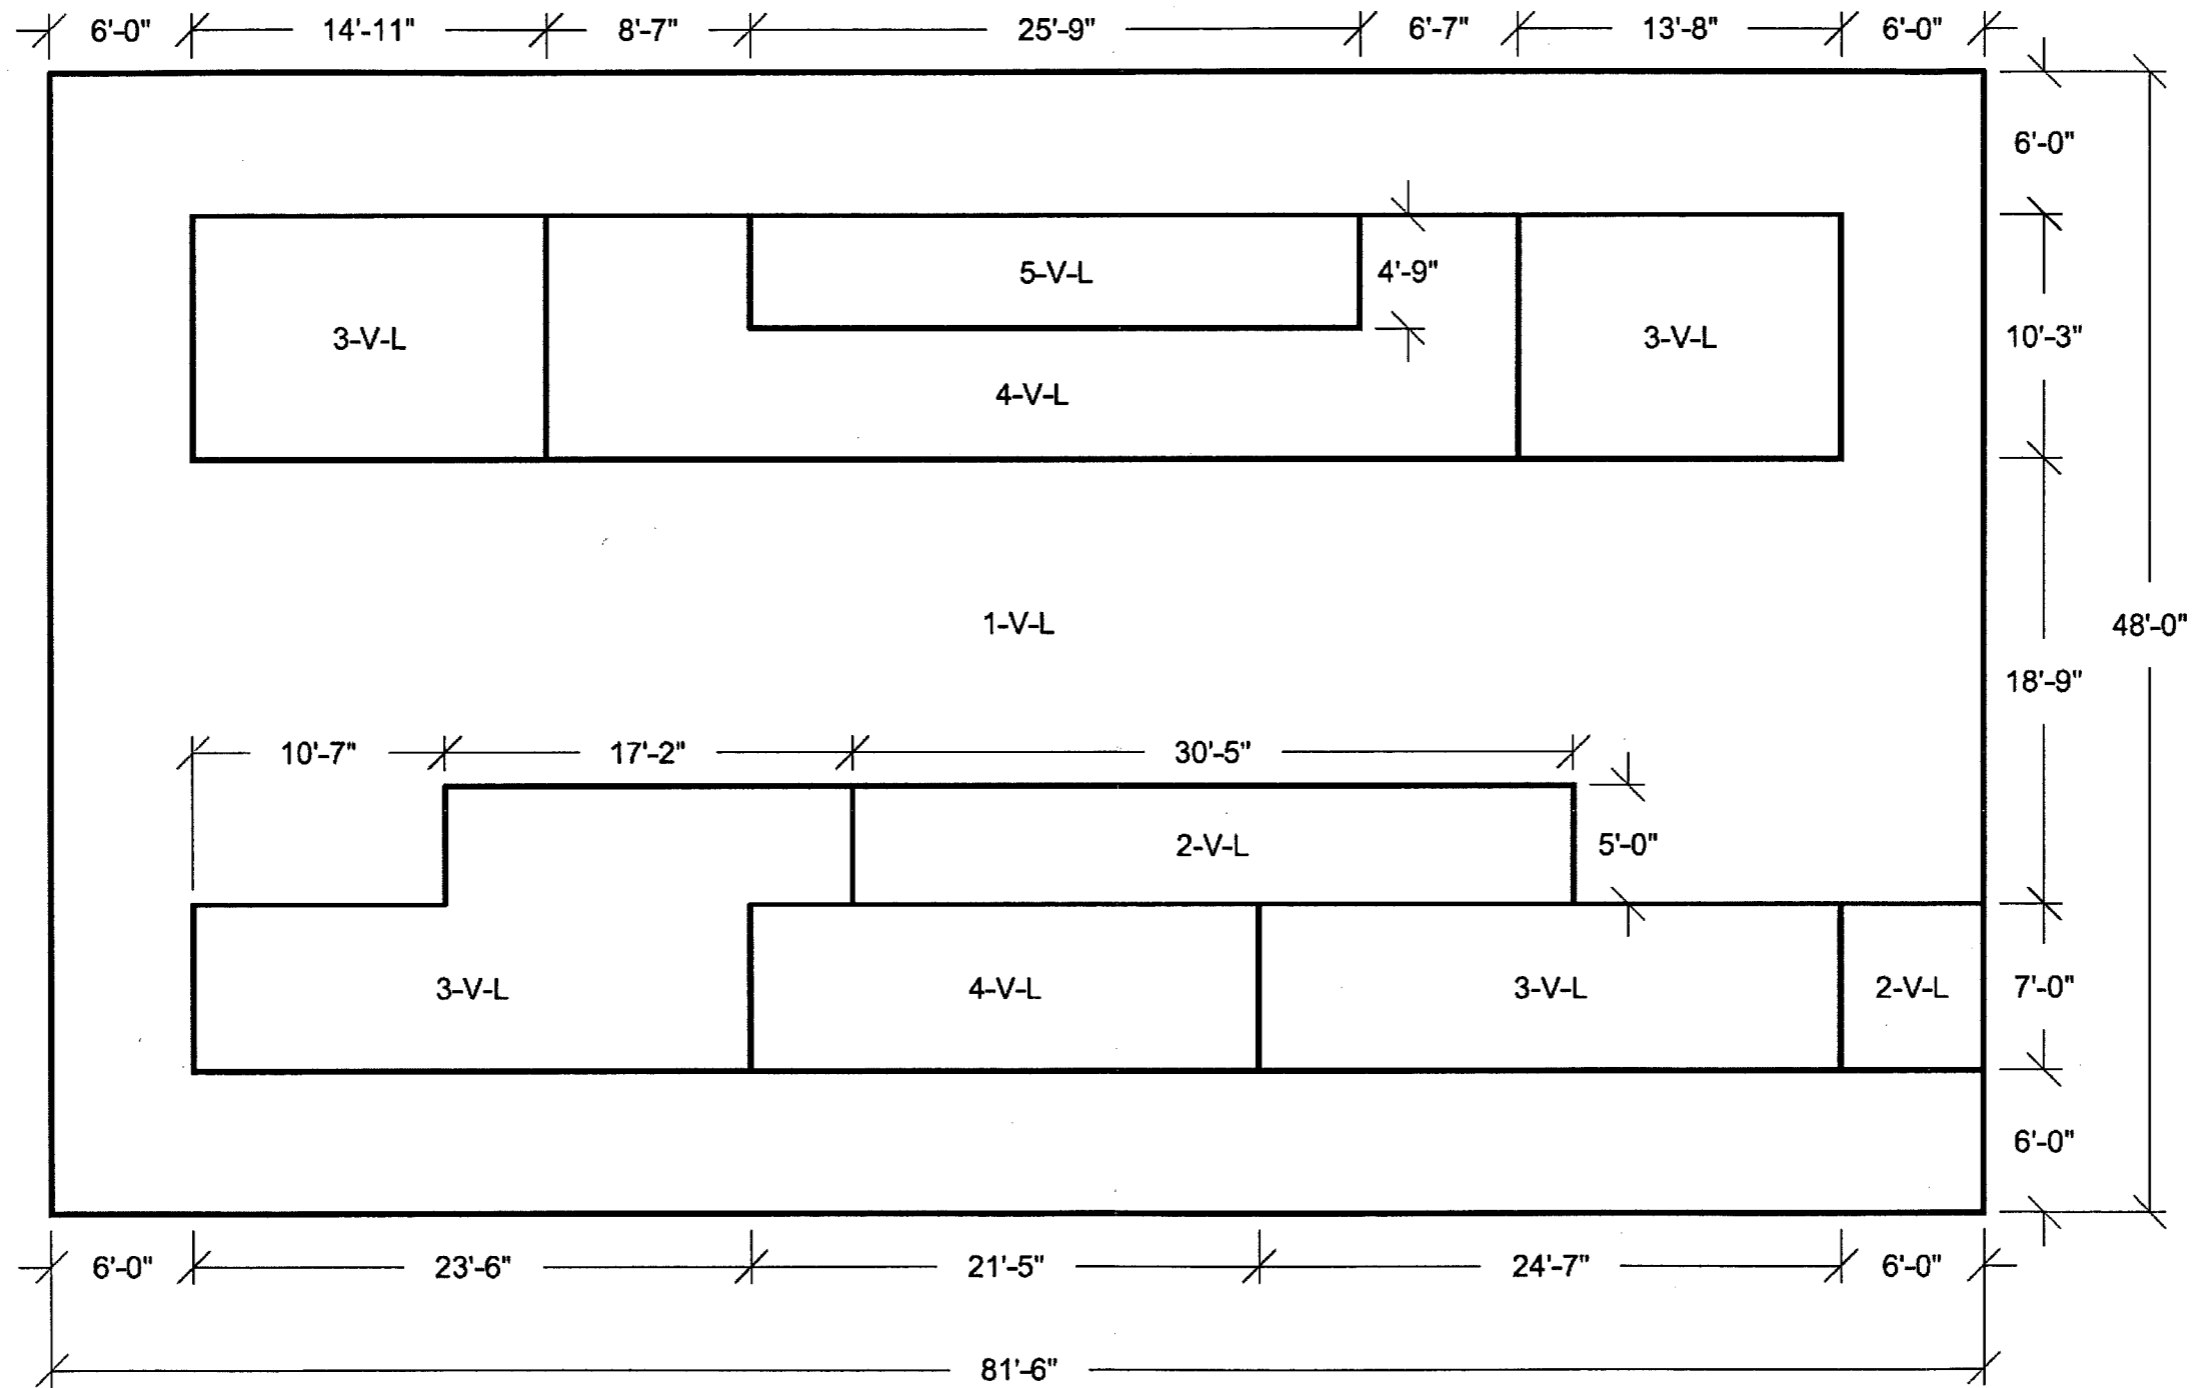


Figure 3H.6-145: Slab 1 Looking Down
Vertical Reinforcement Zones
Far Side Face

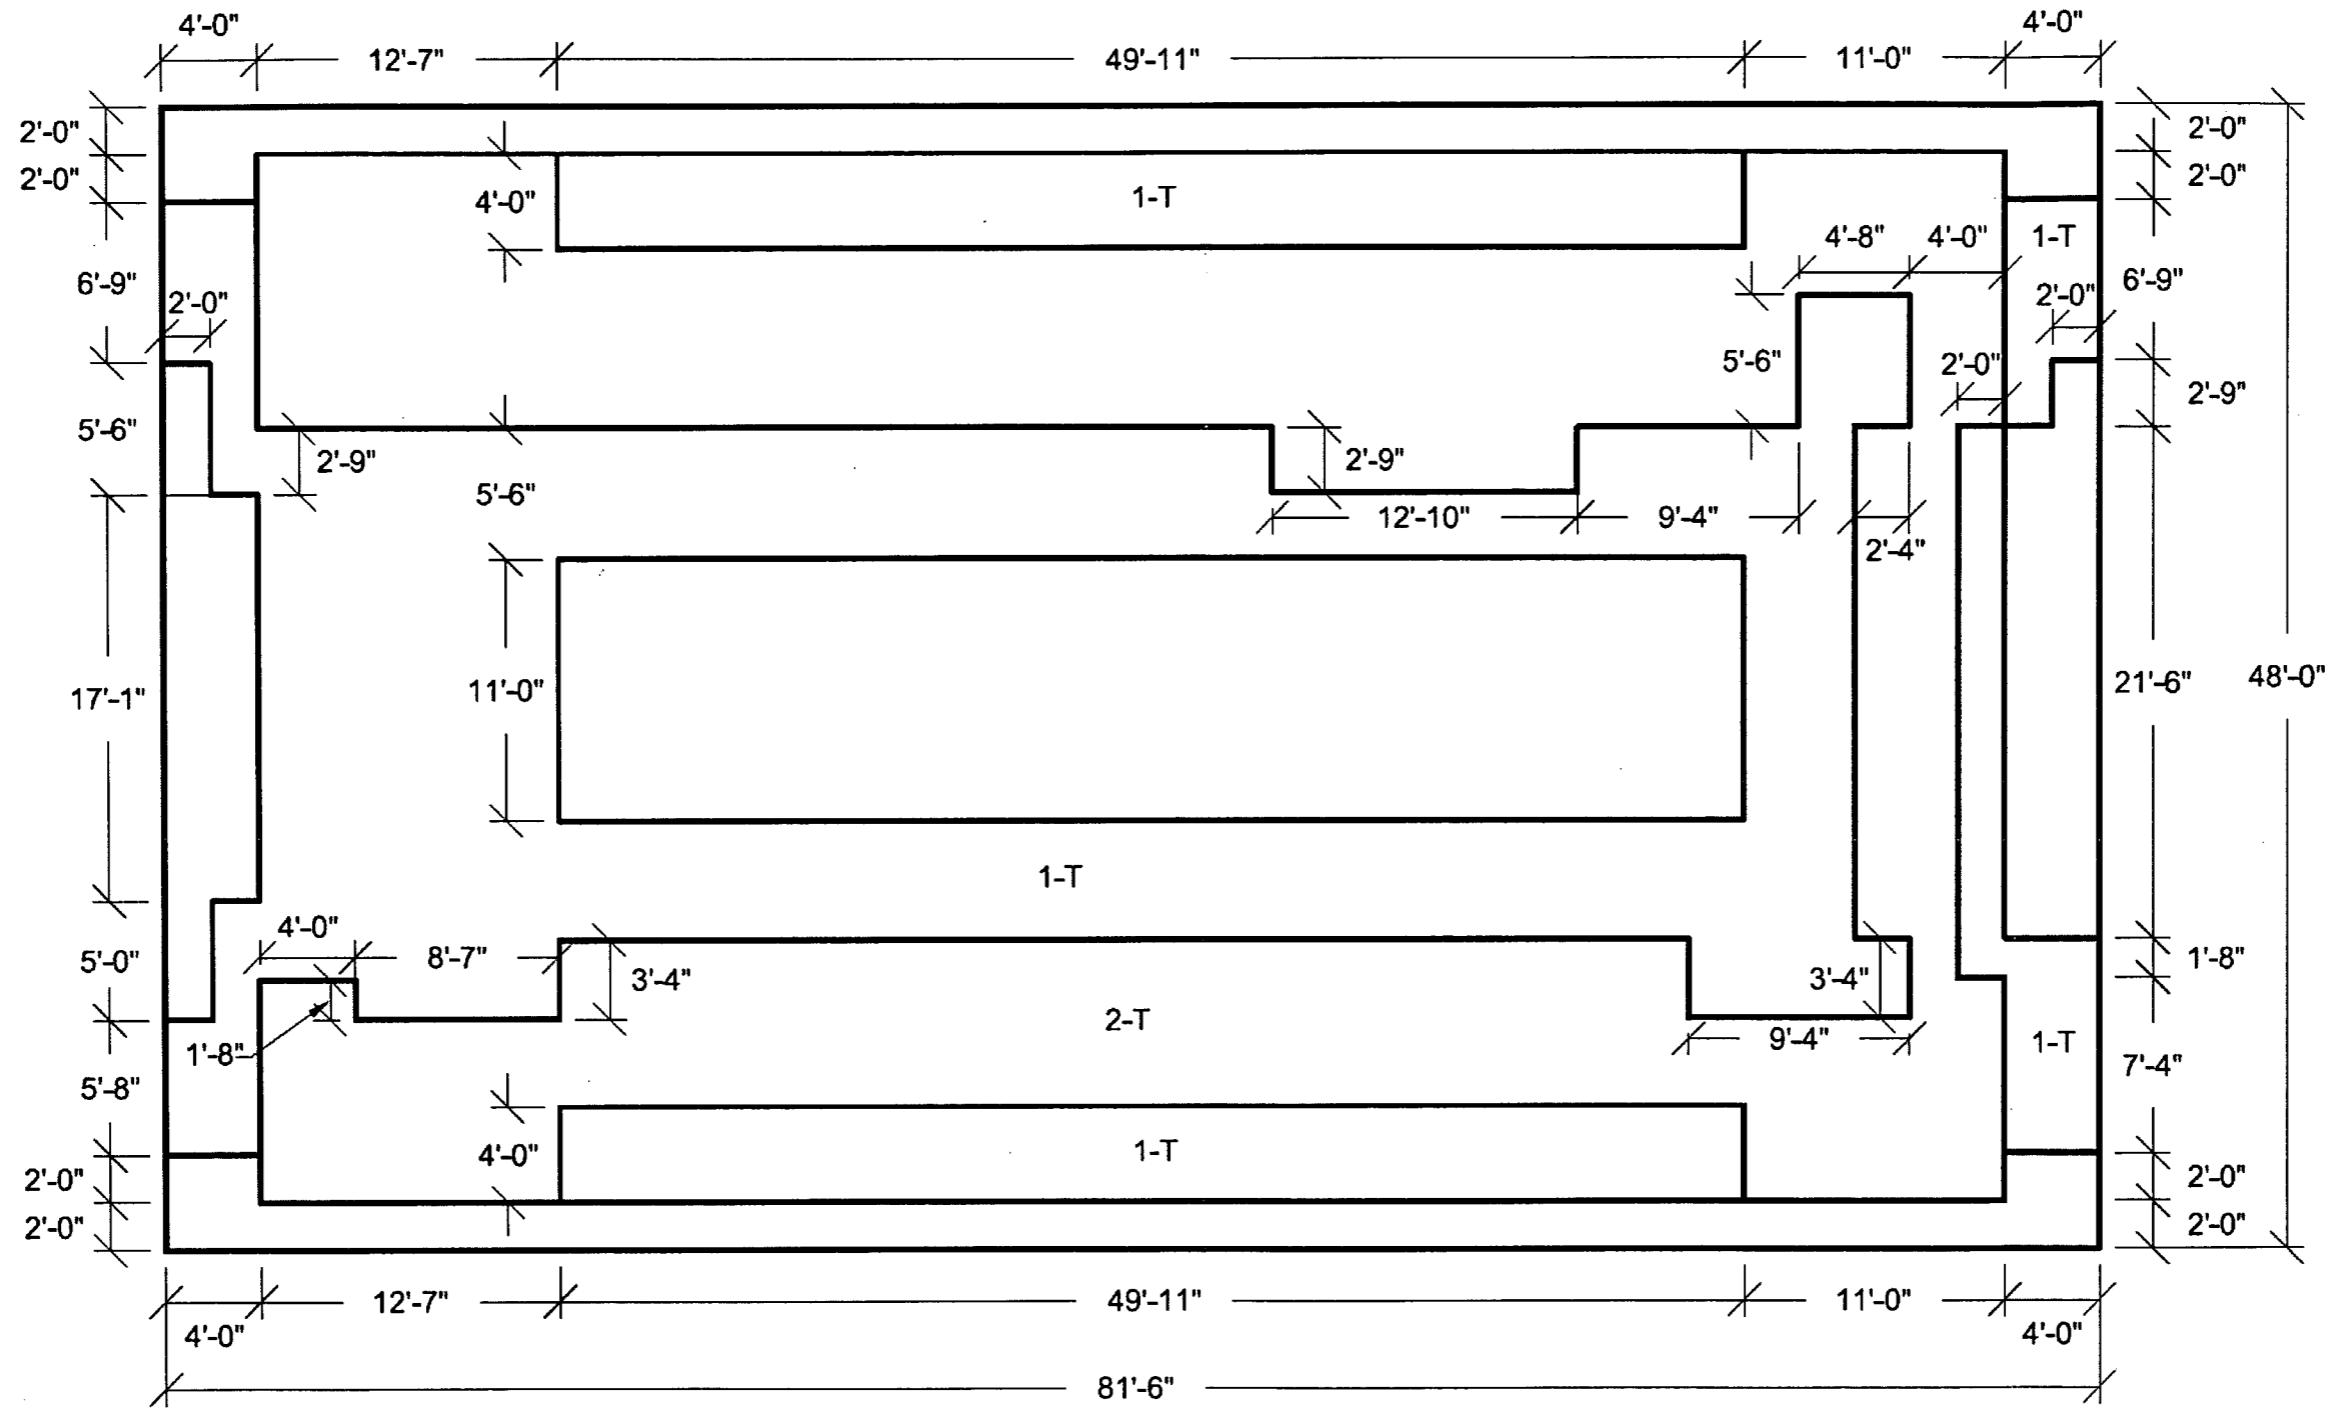


Figure 3H.6-146: Slab 1 Looking Down
Transverse Reinforcement Zones

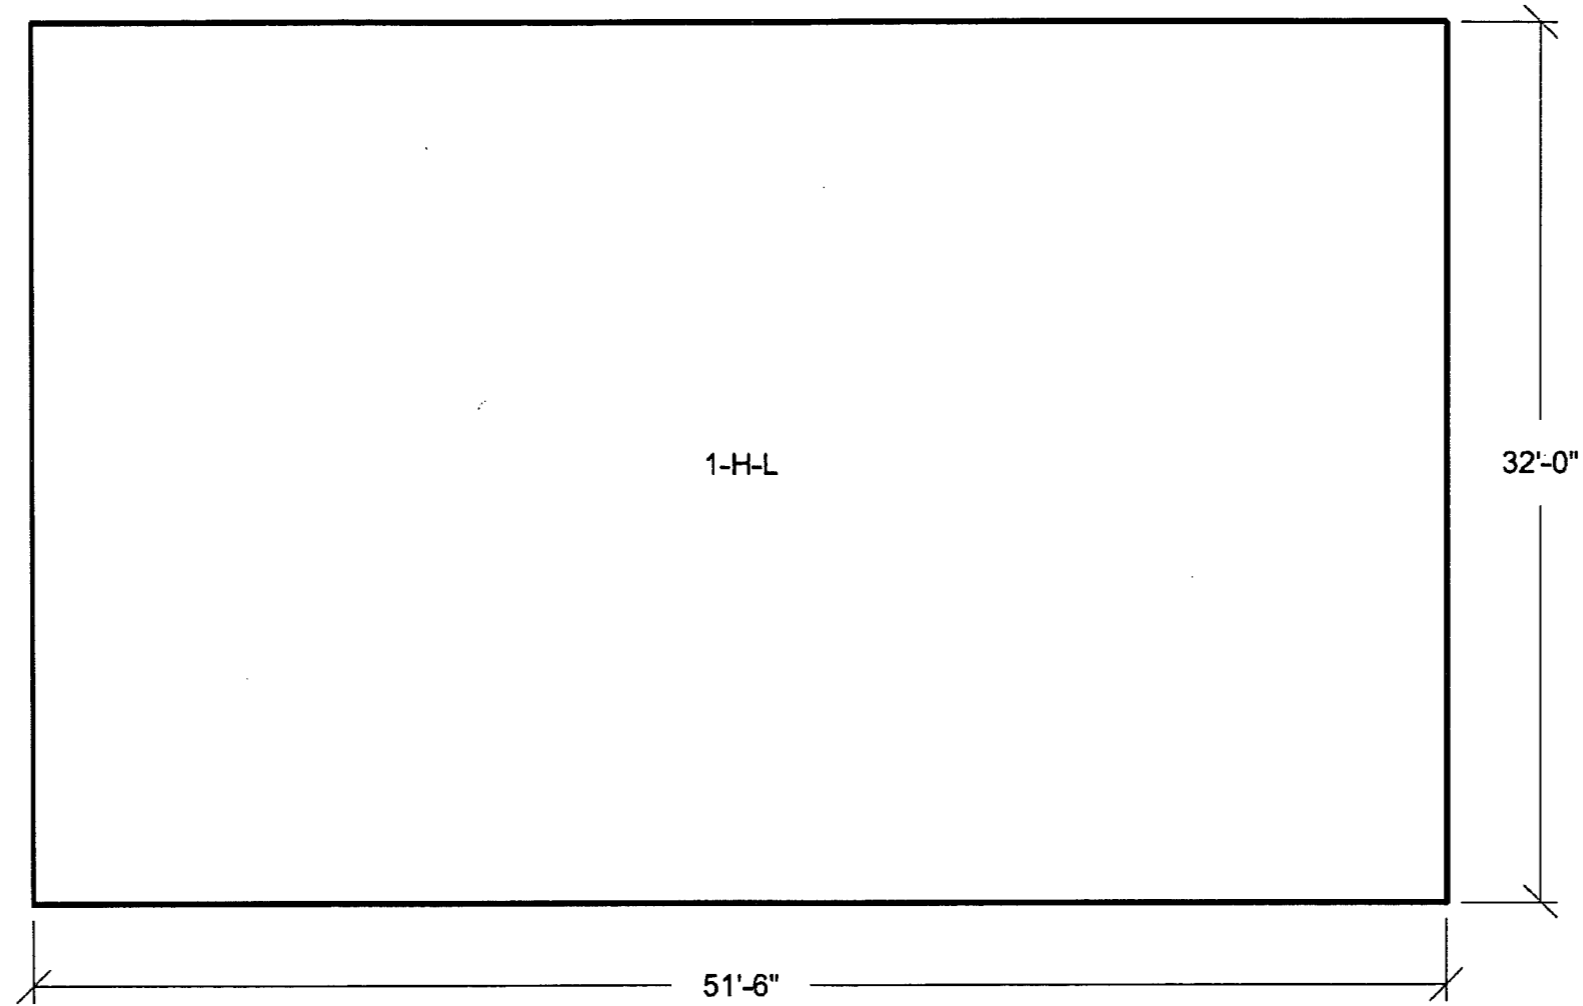


Figure 3H.6-147: Roof 2 Looking Down
Horizontal Reinforcement Zones
Near Side Face

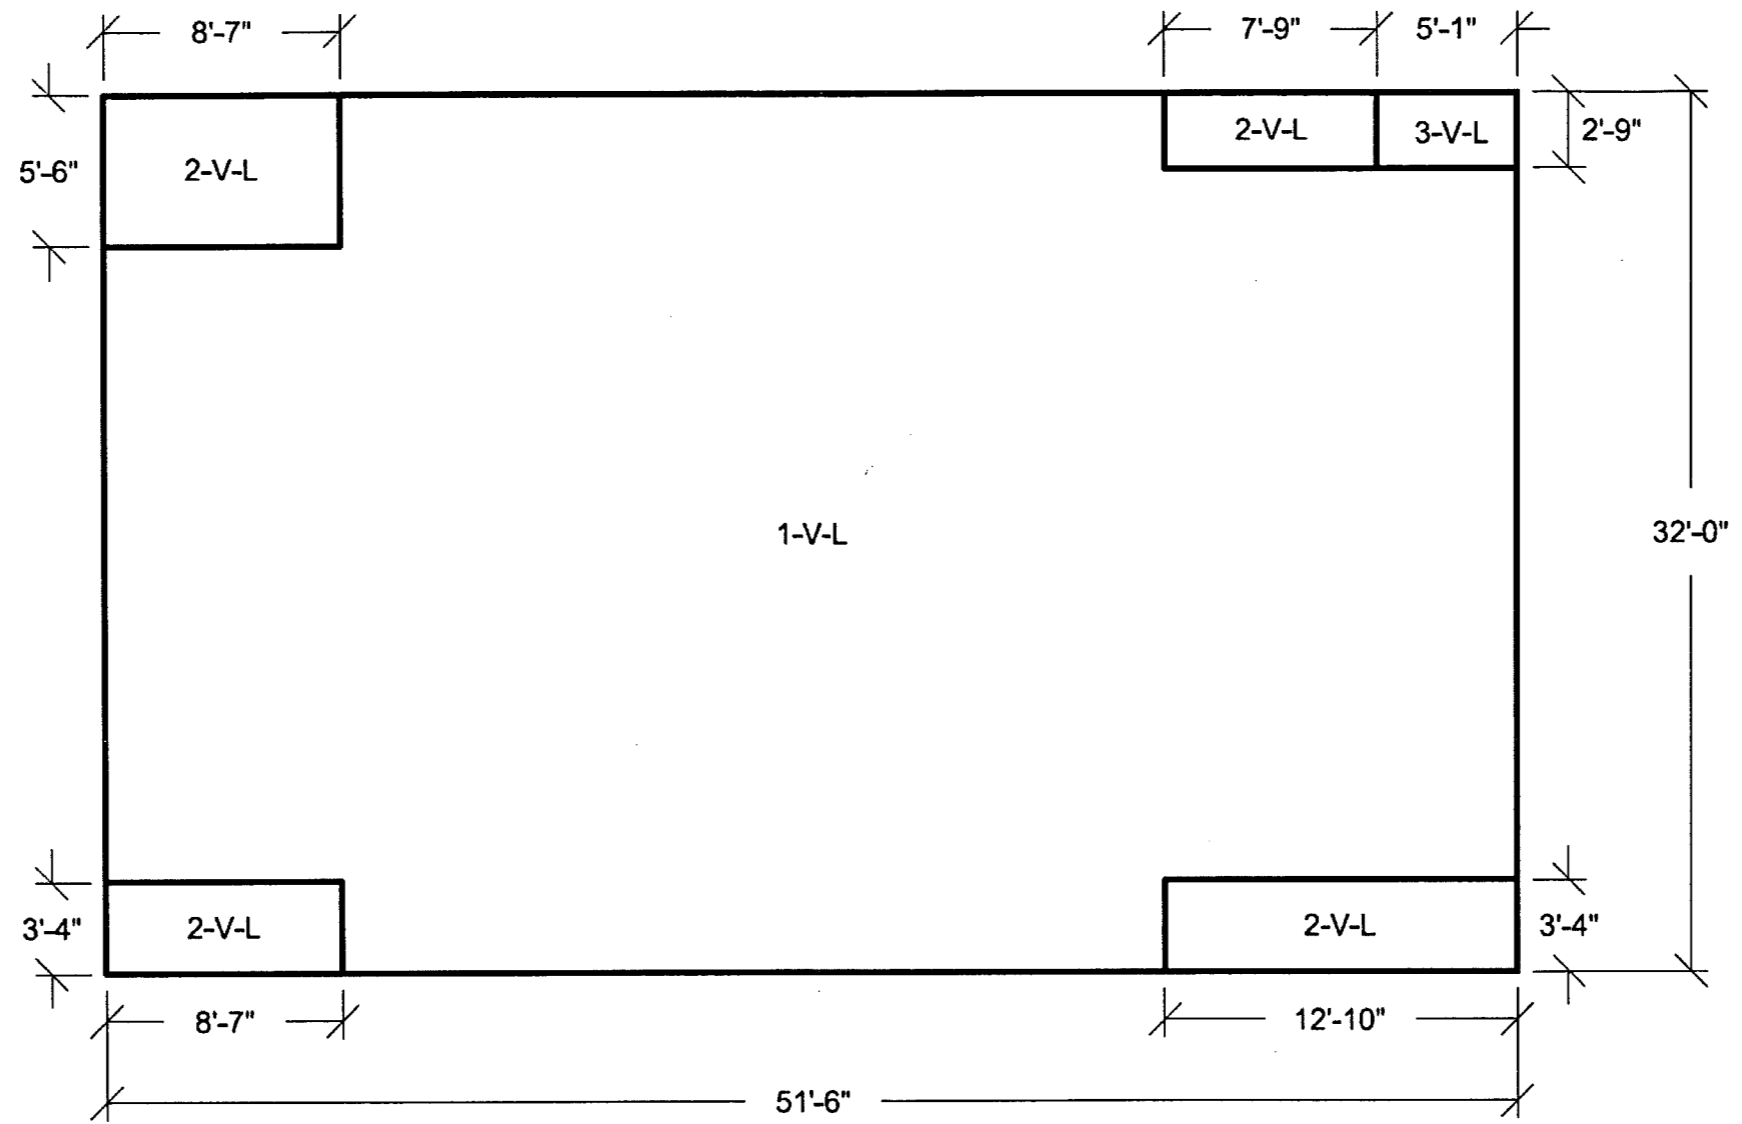


Figure 3H.6-148: Roof 2 Looking Down
Vertical Reinforcement Zones
Near Side Face

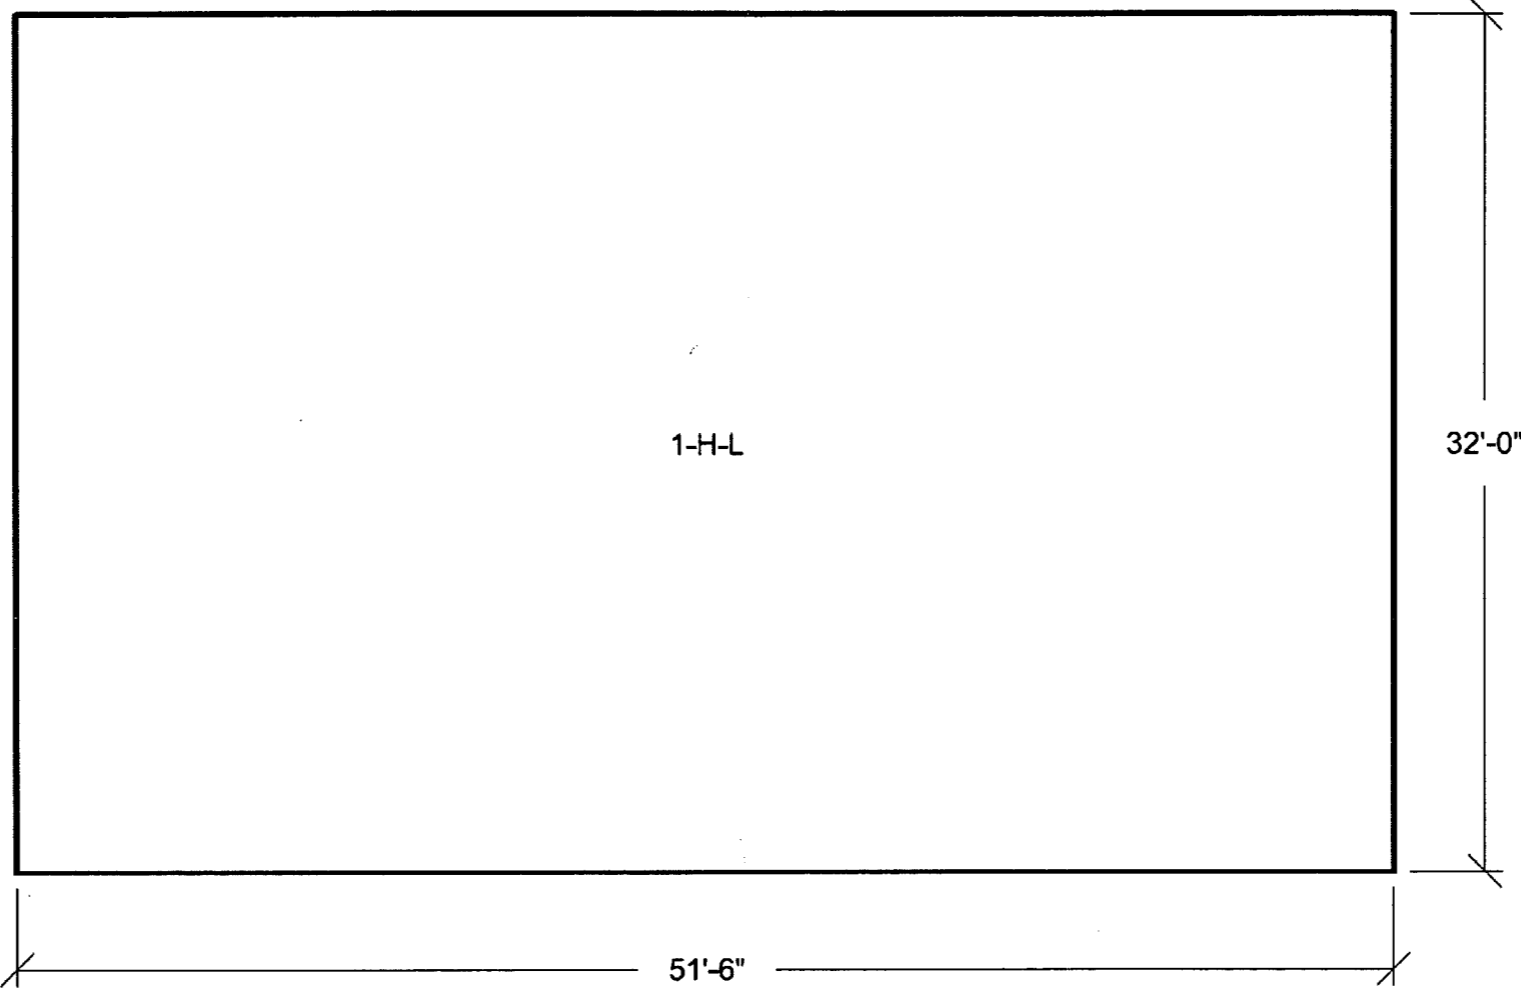


Figure 3H.6-149: Roof 2 Looking Down
Horizontal Reinforcement Zones
Far Side Face

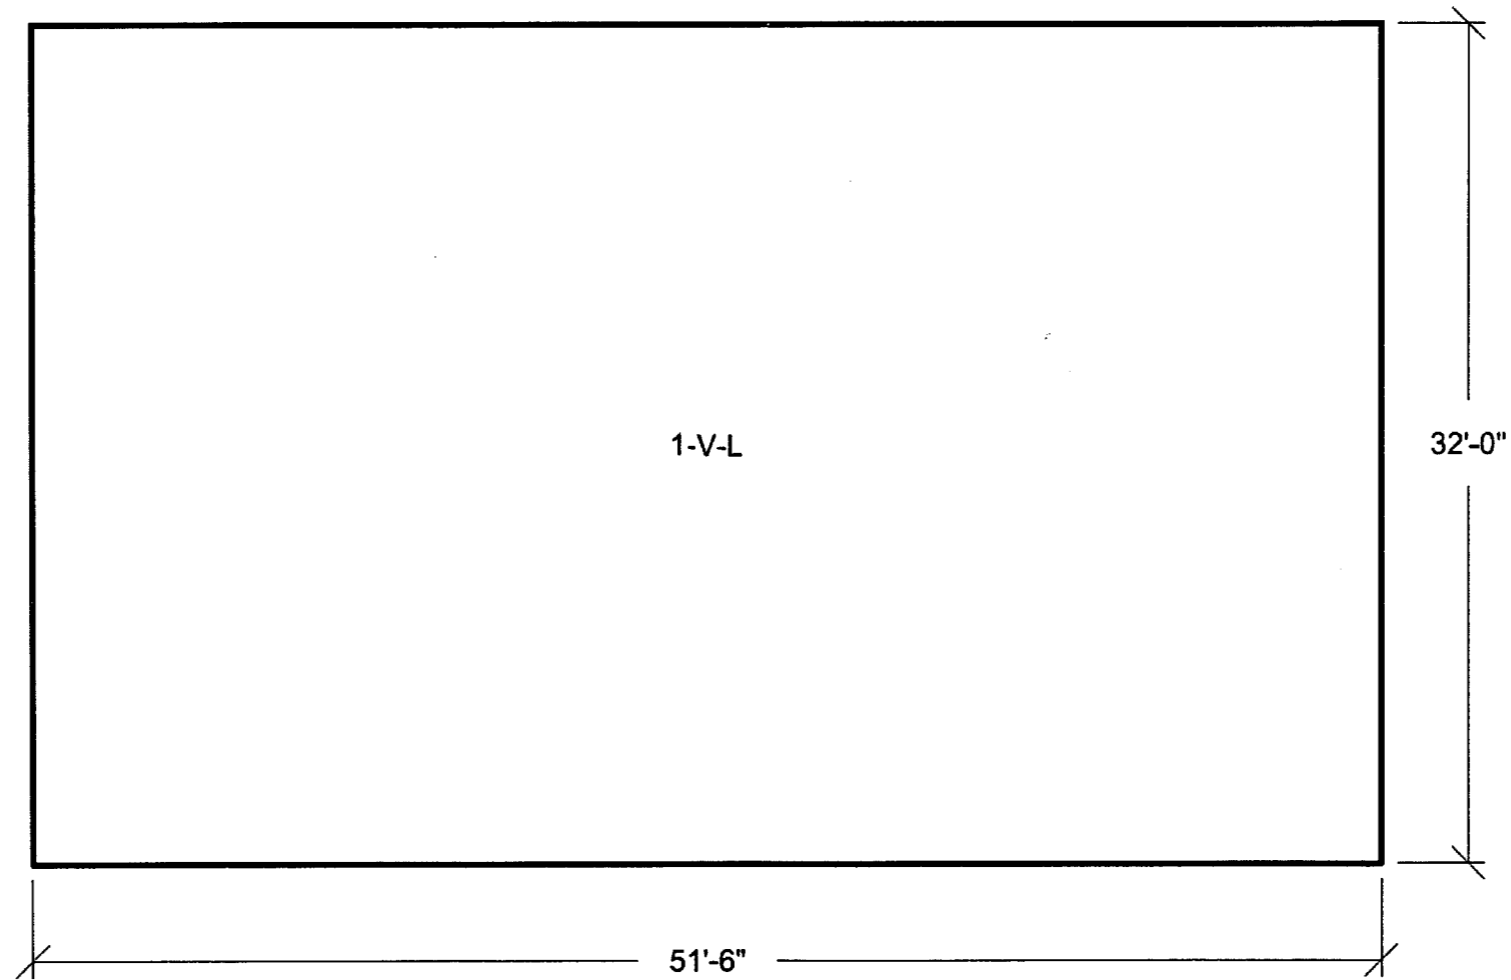


Figure 3H.6-150: Roof 2 Looking Down

Vertical Reinforcement Zones

Far Side Face

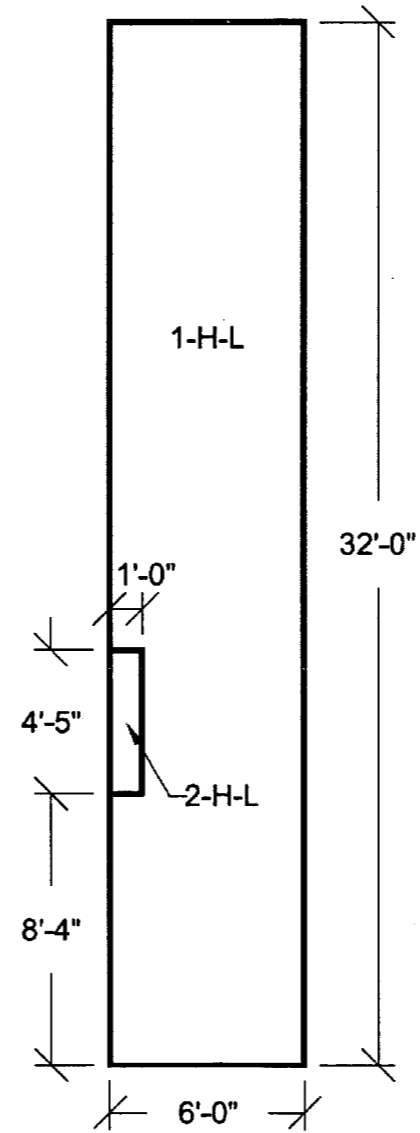


Figure 3H.6-151: Slab 3 Looking Down
Horizontal Reinforcement Zones
Near Side Face

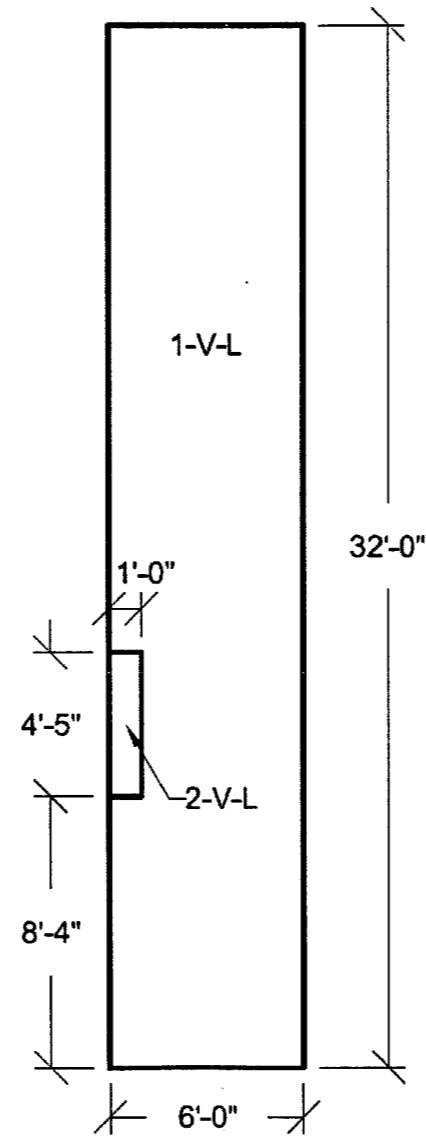


Figure 3H.6-152: Slab 3 Looking Down

Vertical Reinforcement Zones

Near Side Face

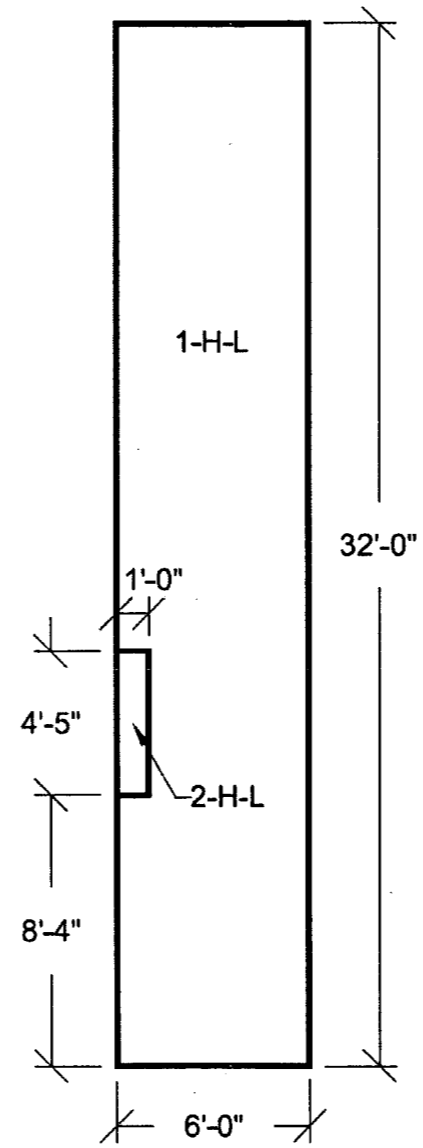


Figure 3H.6-153: Slab 3 Looking Down

Horizontal Reinforcement Zones

Far Side Face

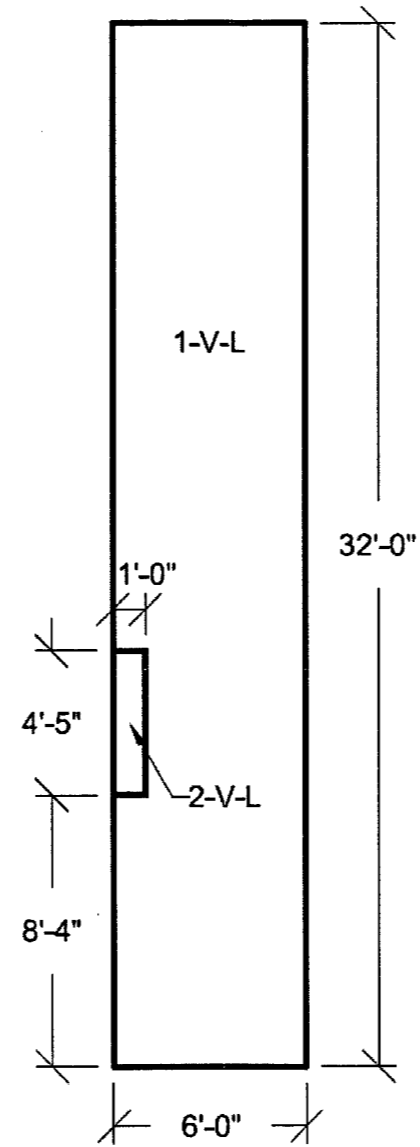


Figure 3H.6-154A: Slab 3 Looking Down

Vertical Reinforcement Zones

Far Side Face

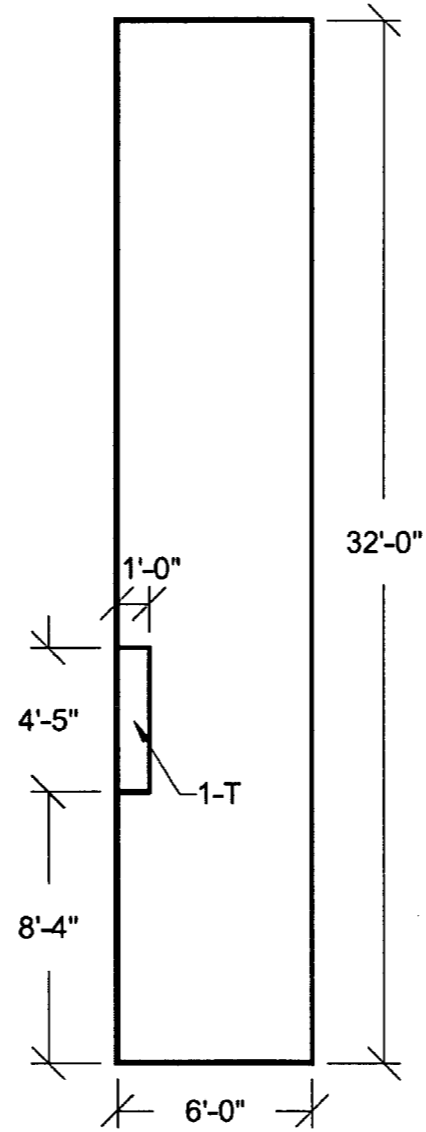


Figure 3H.6-154B: Slab 3 Looking Down
Transverse Reinforcement Zones

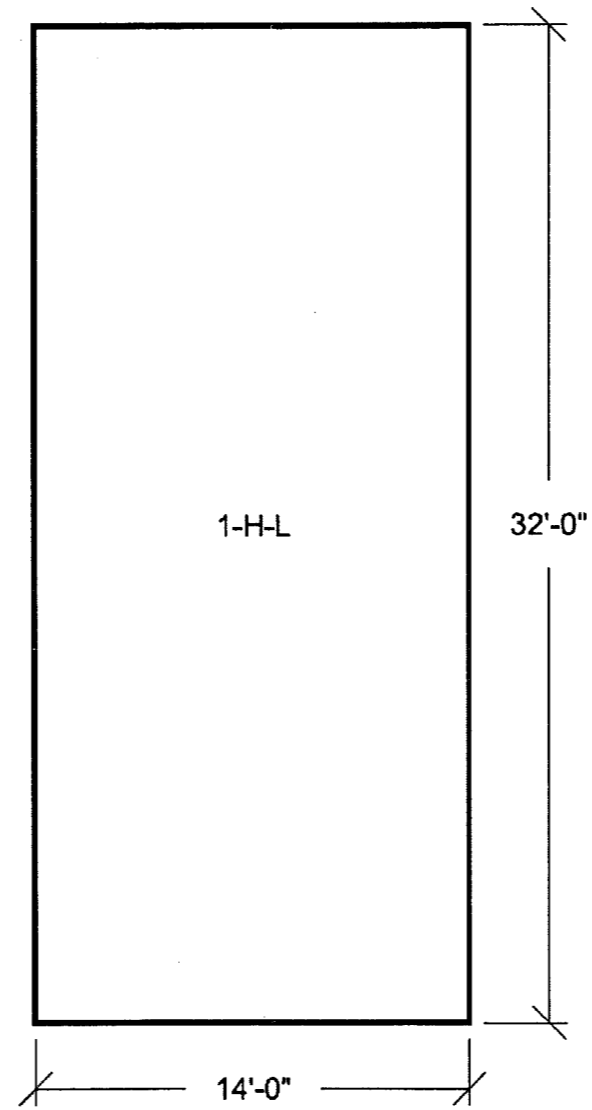


Figure 3H.6-155: Roof 5 Looking Down
Horizontal Reinforcement Zones
Near Side Face

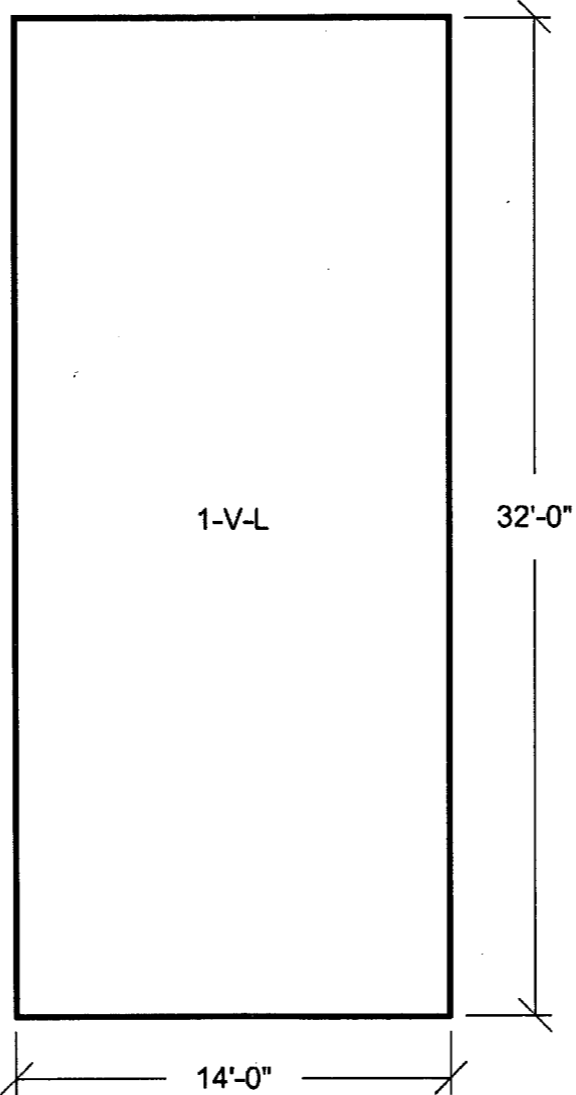


Figure 3H.6-156: Roof 5 Looking Down
Vertical Reinforcement Zones
Near Side Face

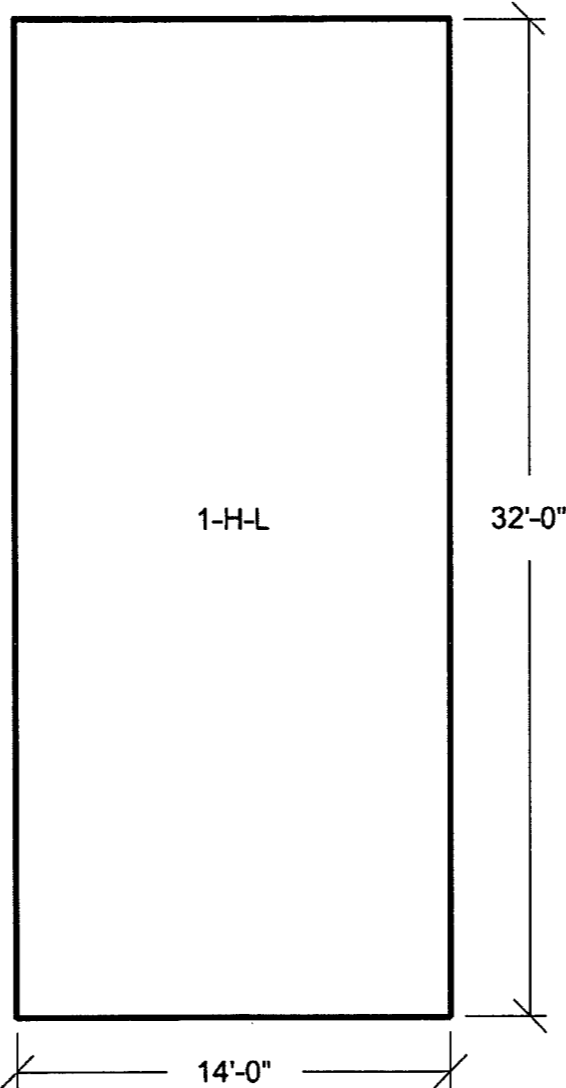


Figure 3H.6-157: Roof 5 Looking Down
Horizontal Reinforcement Zones
Far Side Face

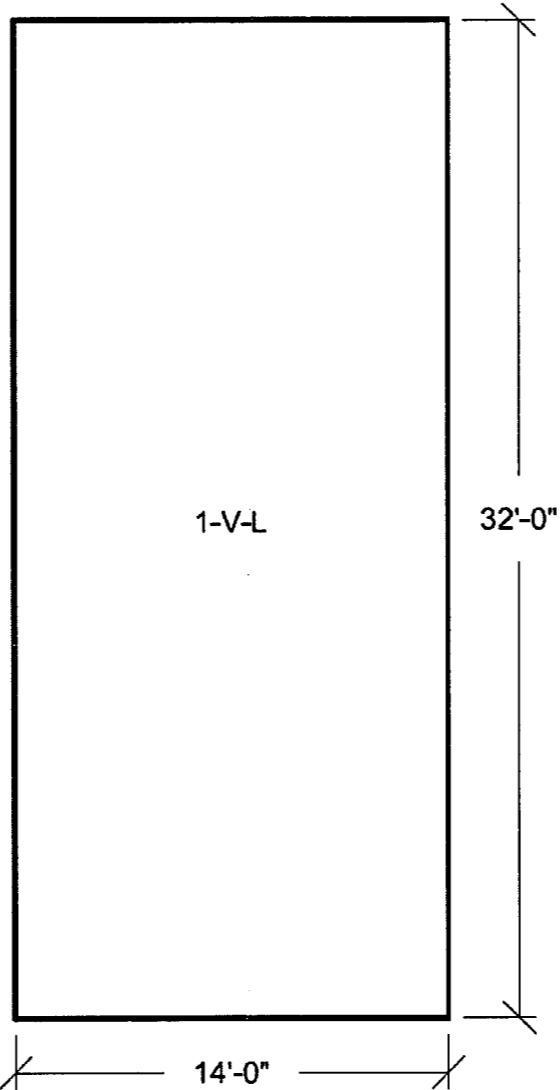


Figure 3H.6-158: Roof 5 Looking Down
Vertical Reinforcement Zones
Far Side Face

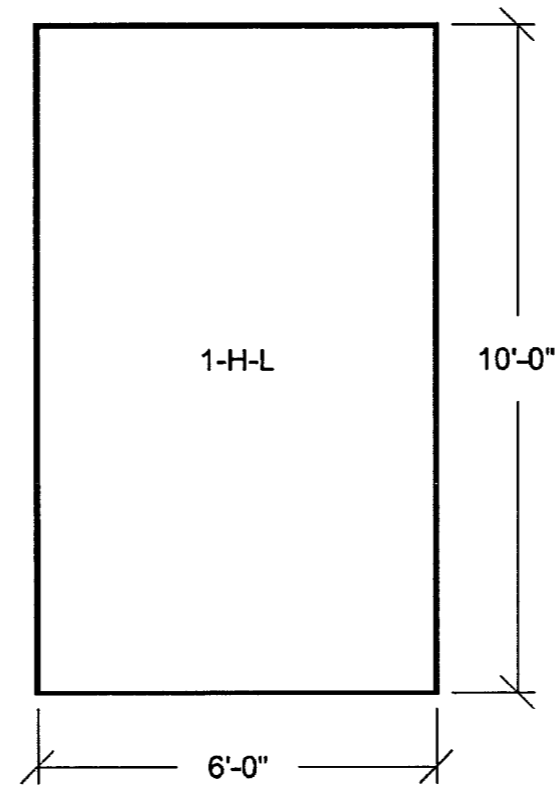


Figure 3H.6-159: Roof 6 Looking Down
Horizontal Reinforcement Zones
Near Side Face

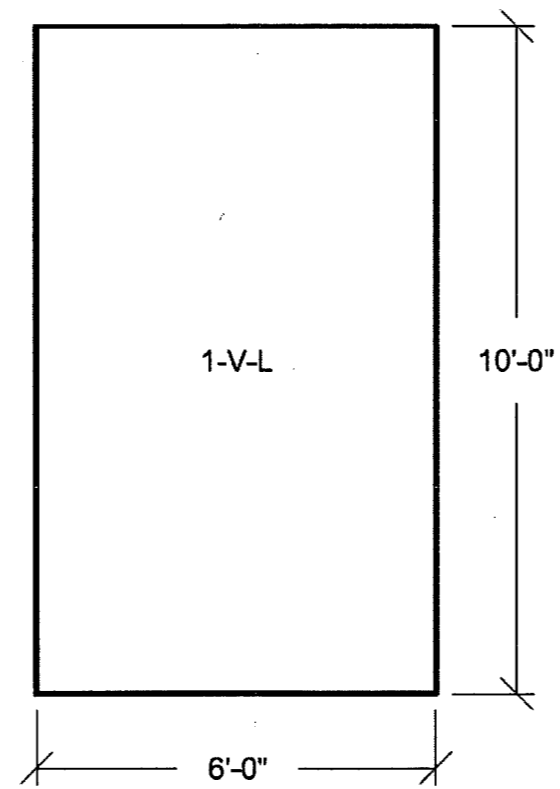


Figure 3H.6-160: Roof 6 Looking Down
Vertical Reinforcement Zones
Near Side Face

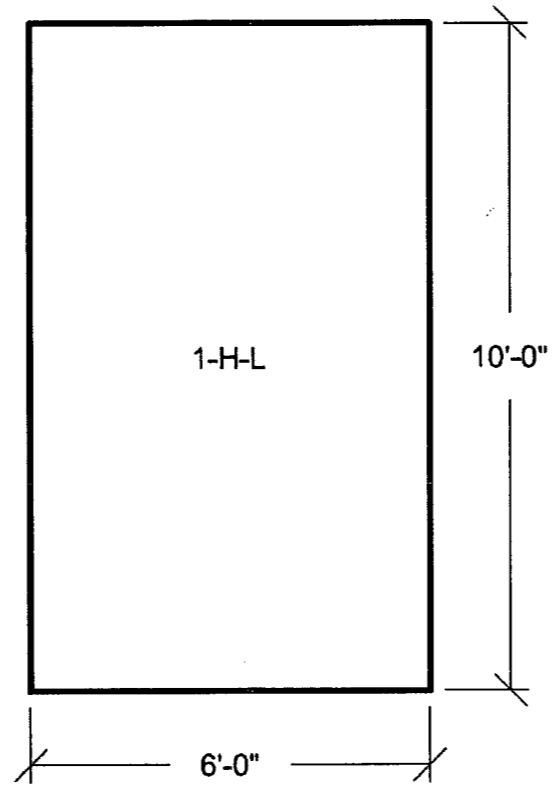


Figure 3H.6-161: Roof 6 Looking Down
Horizontal Reinforcement Zones
Far Side Face

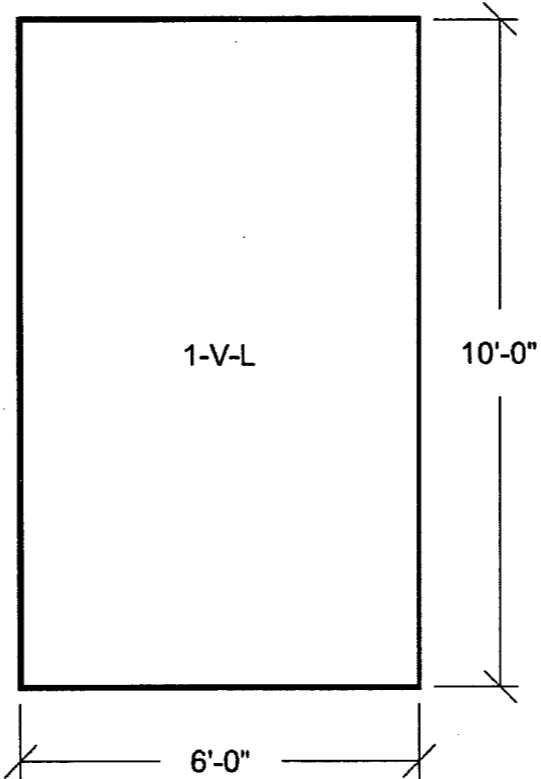


Figure 3H.6-162: Roof 6 Looking Down
Vertical Reinforcement Zones
Far Side Face

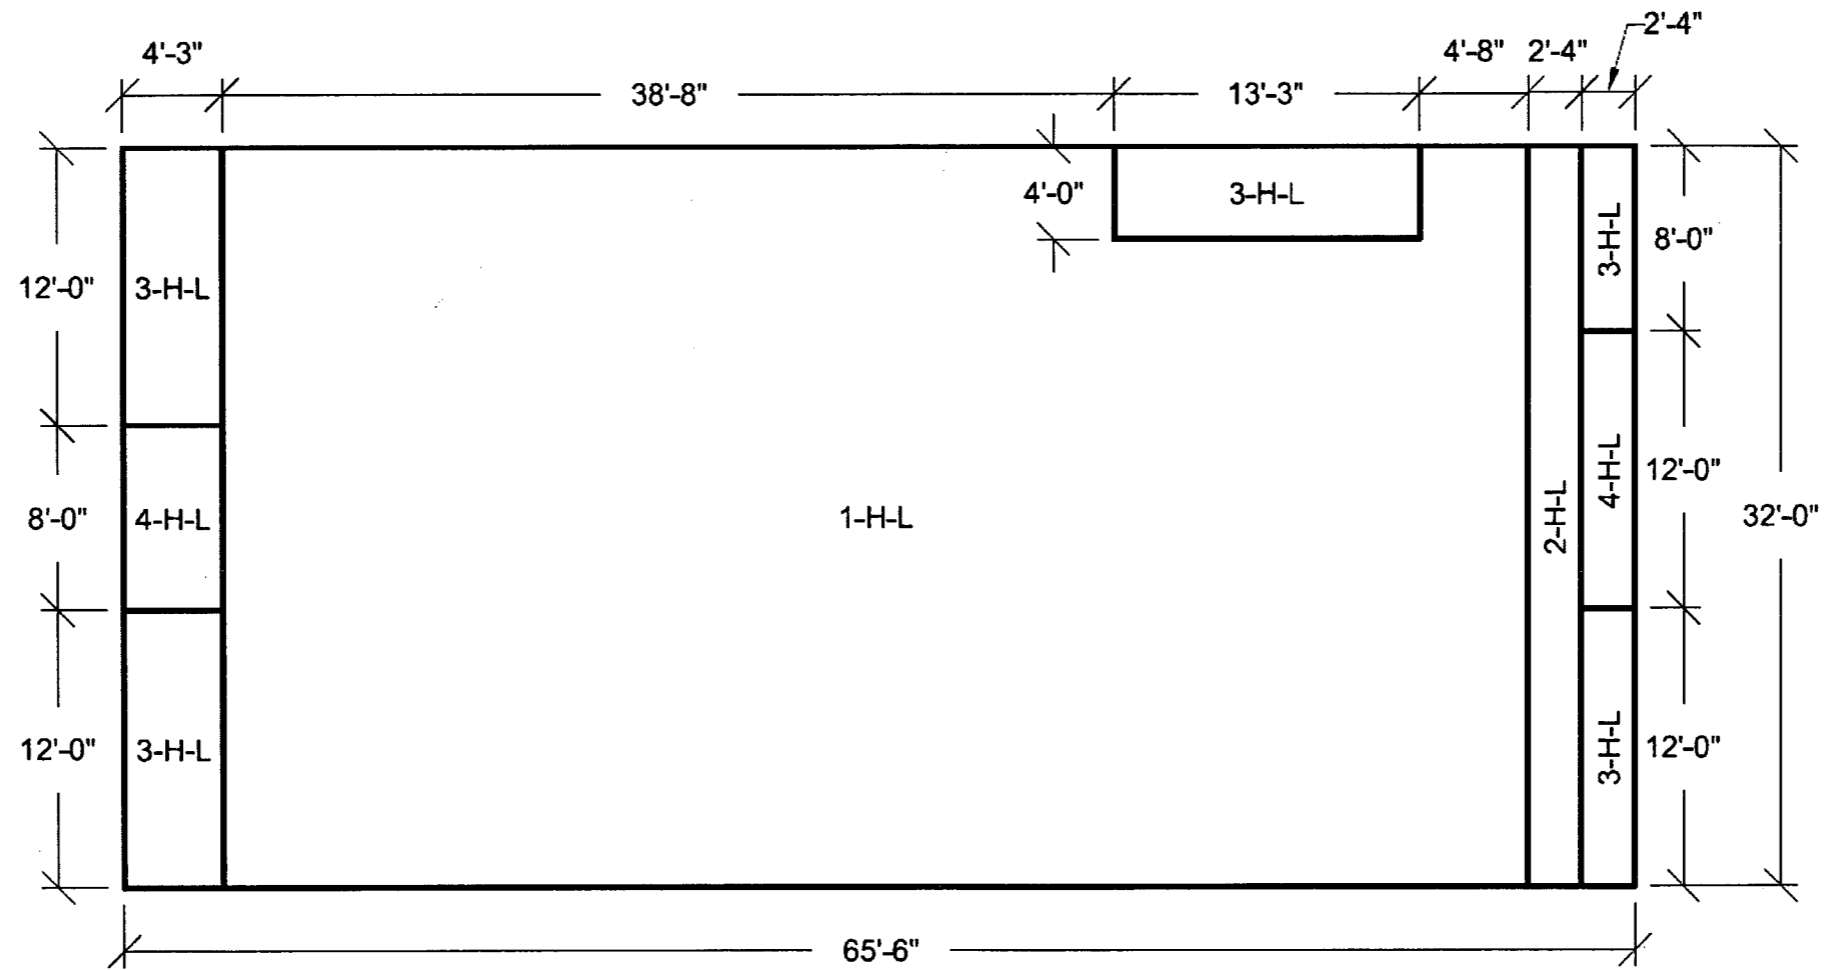


Figure 3H.6-163: Wall 7 Looking From Outside
Horizontal Reinforcement Zones
Near Side Face

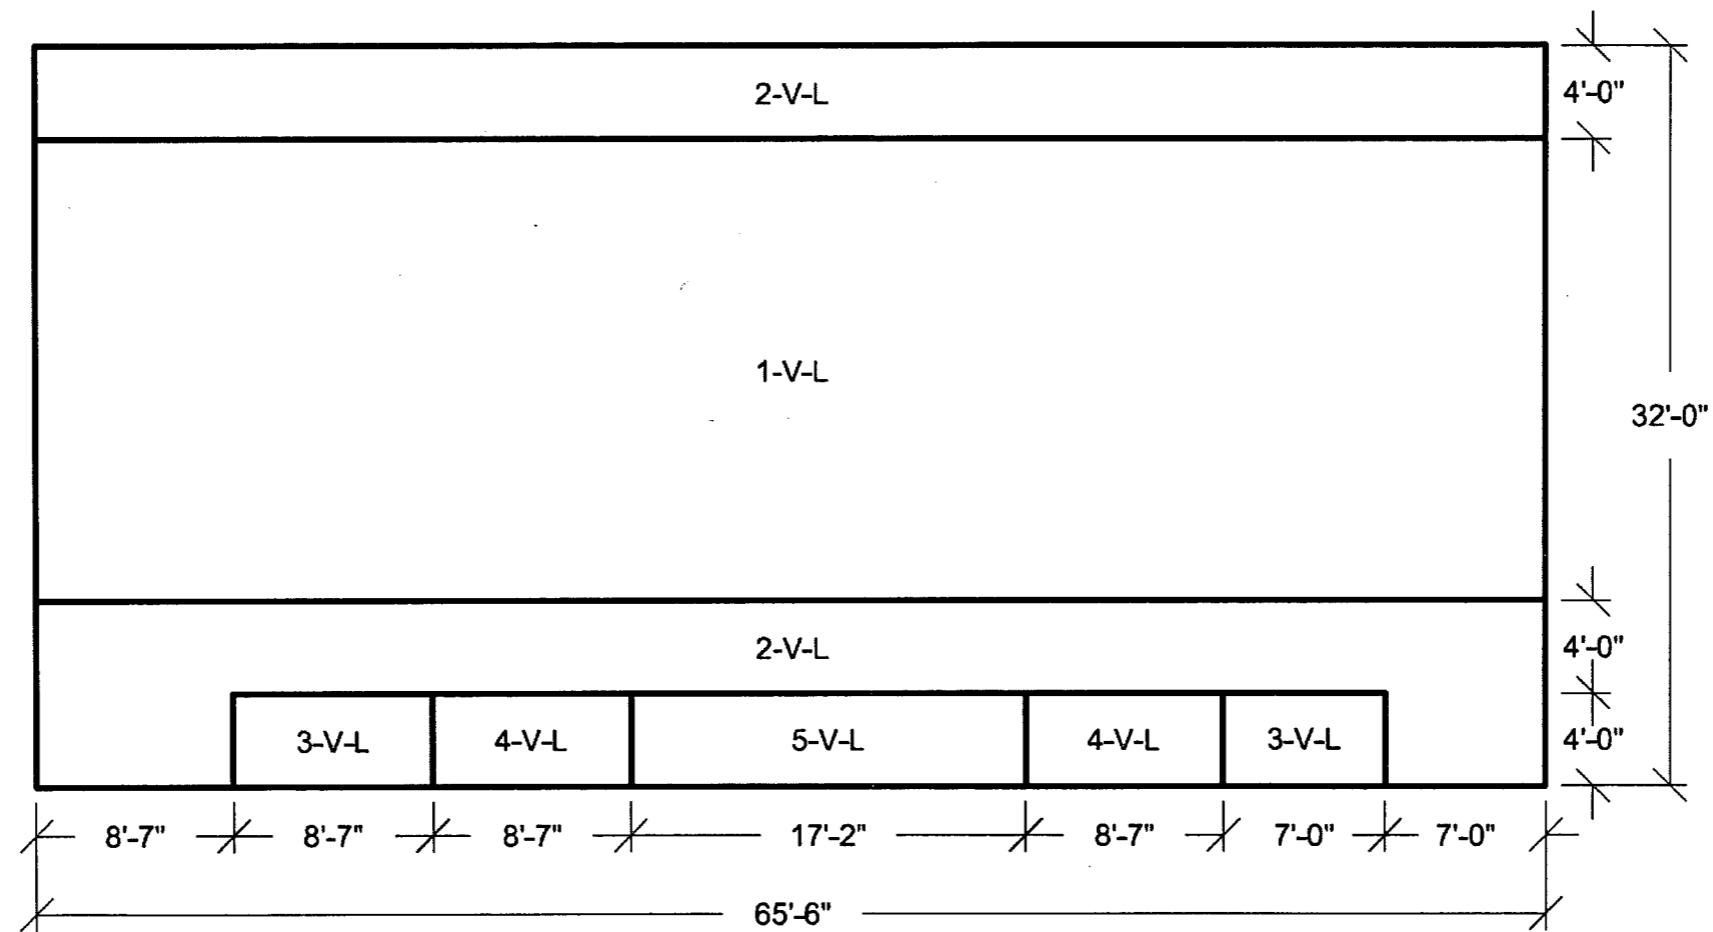


Figure 3H.6-164: Wall 7 Looking From Outside

Vertical Reinforcement Zones

Near Side Face

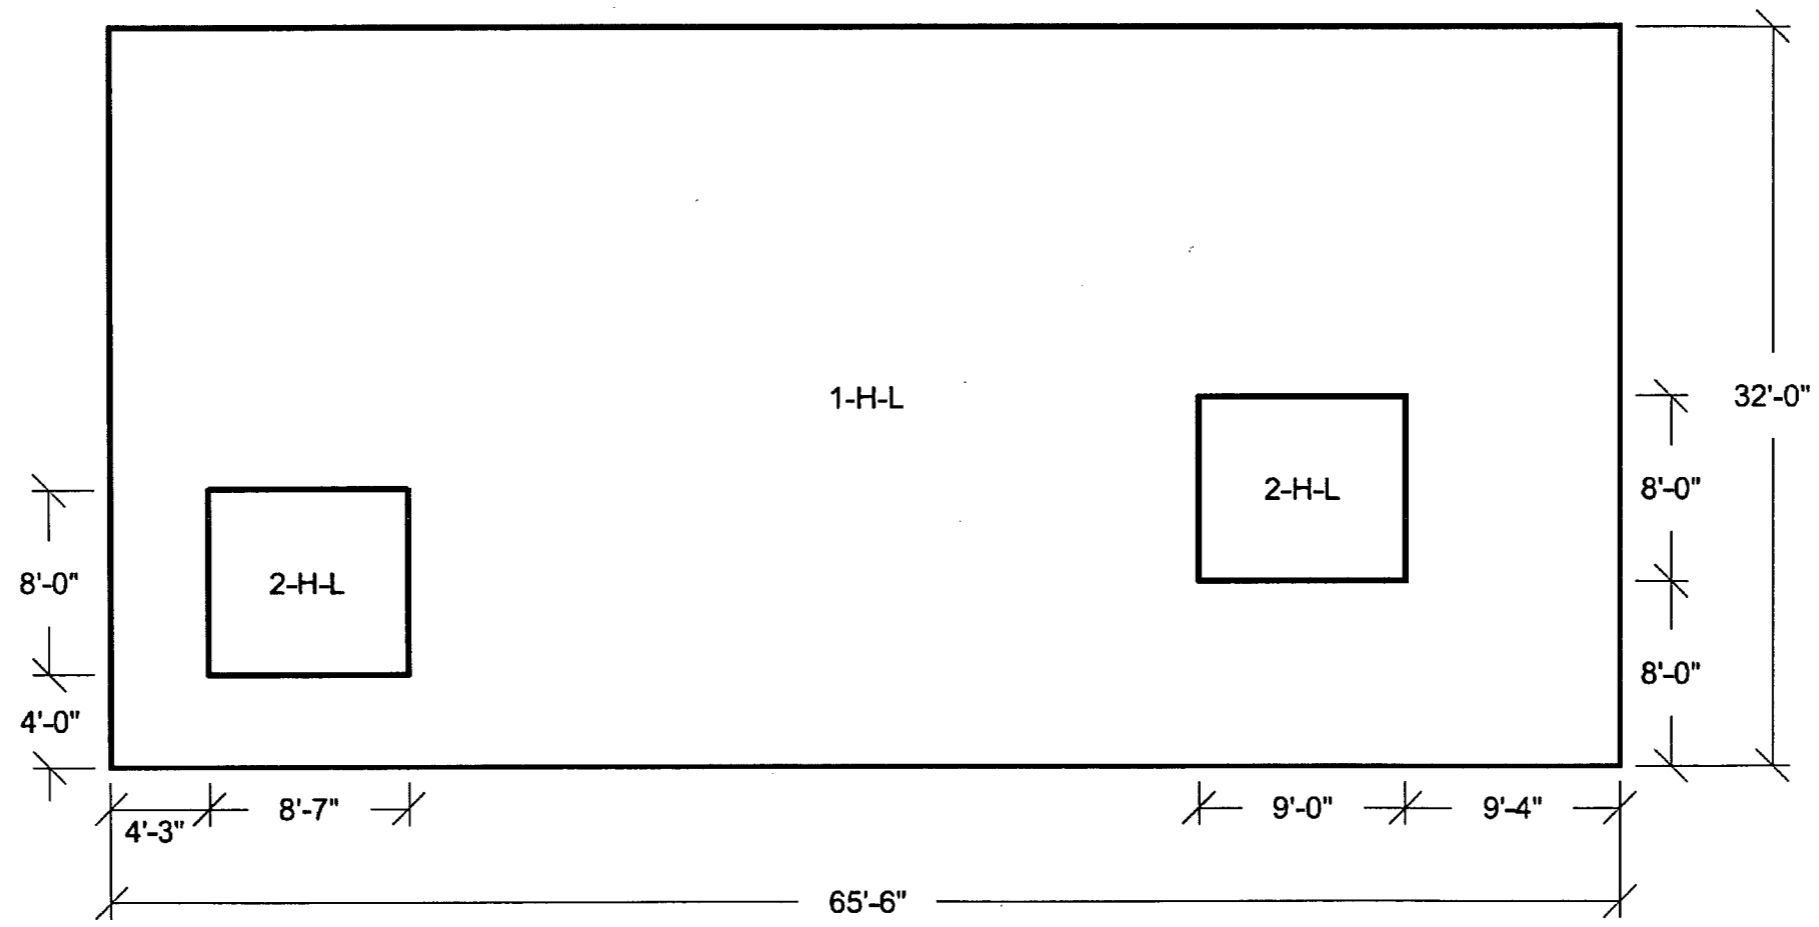


Figure 3H.6-165: Wall 7 Looking From Outside
Horizontal Reinforcement Zones
Far Side Face

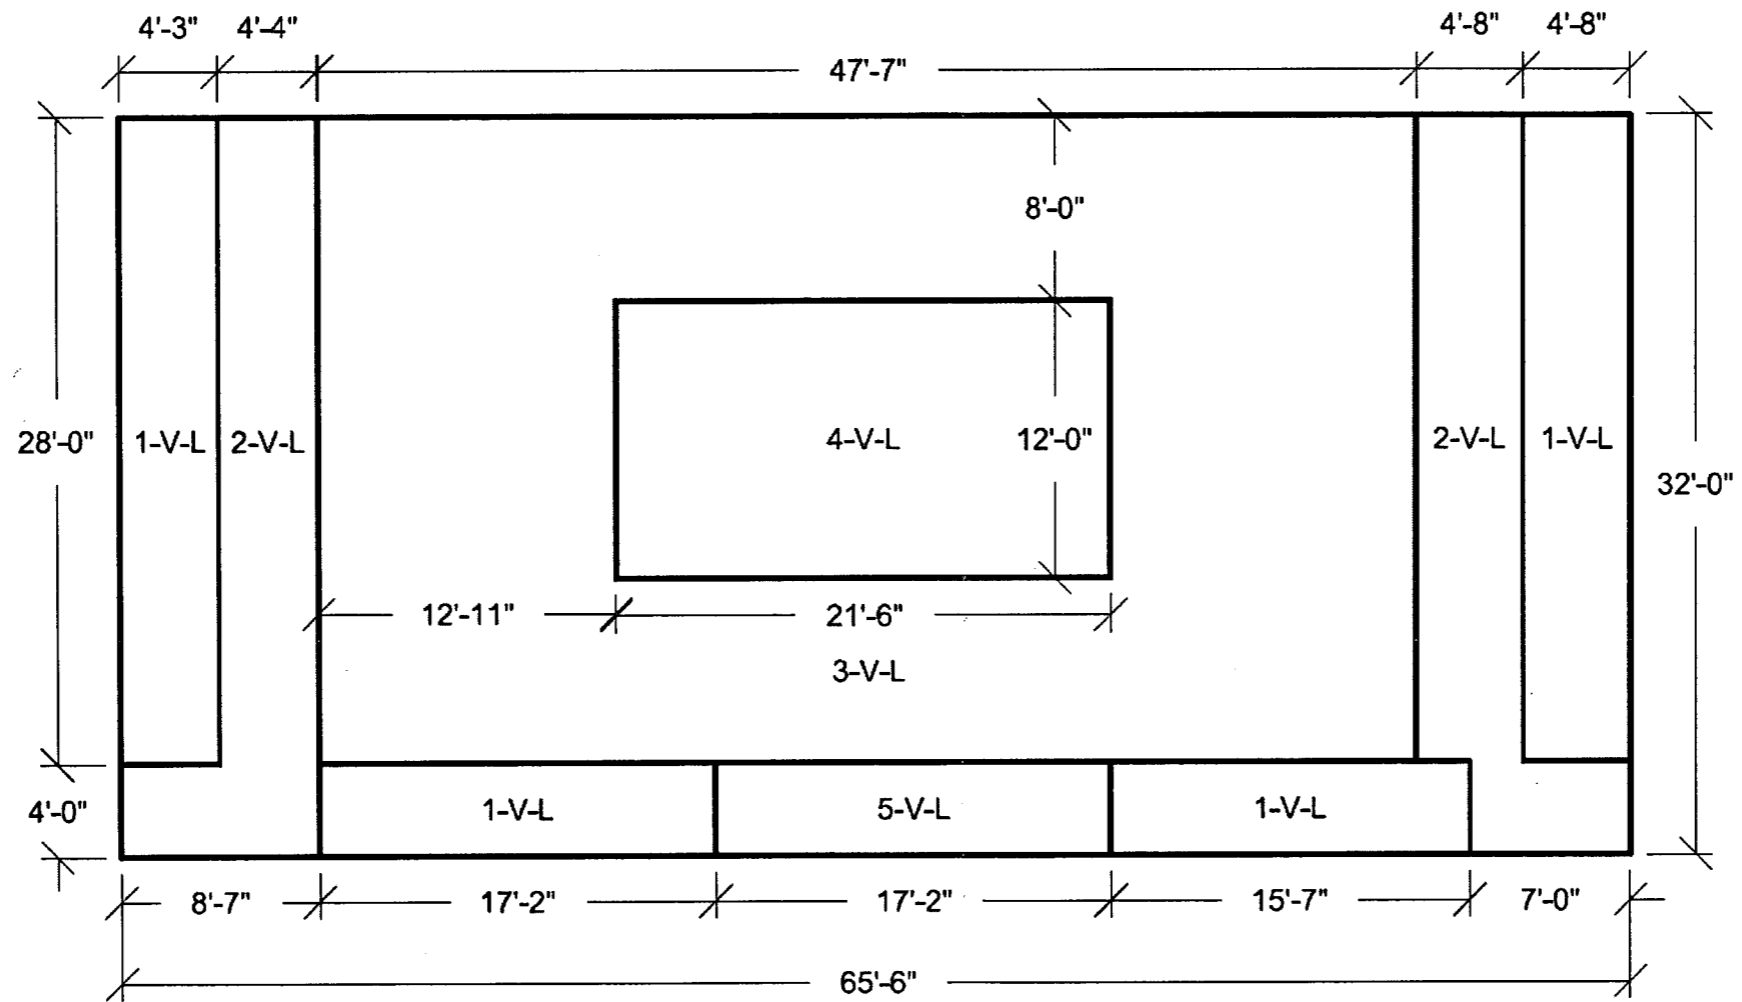


Figure 3H.6-166: Wall 7 Looking From Outside
Vertical Reinforcement Zones
Far Side Face

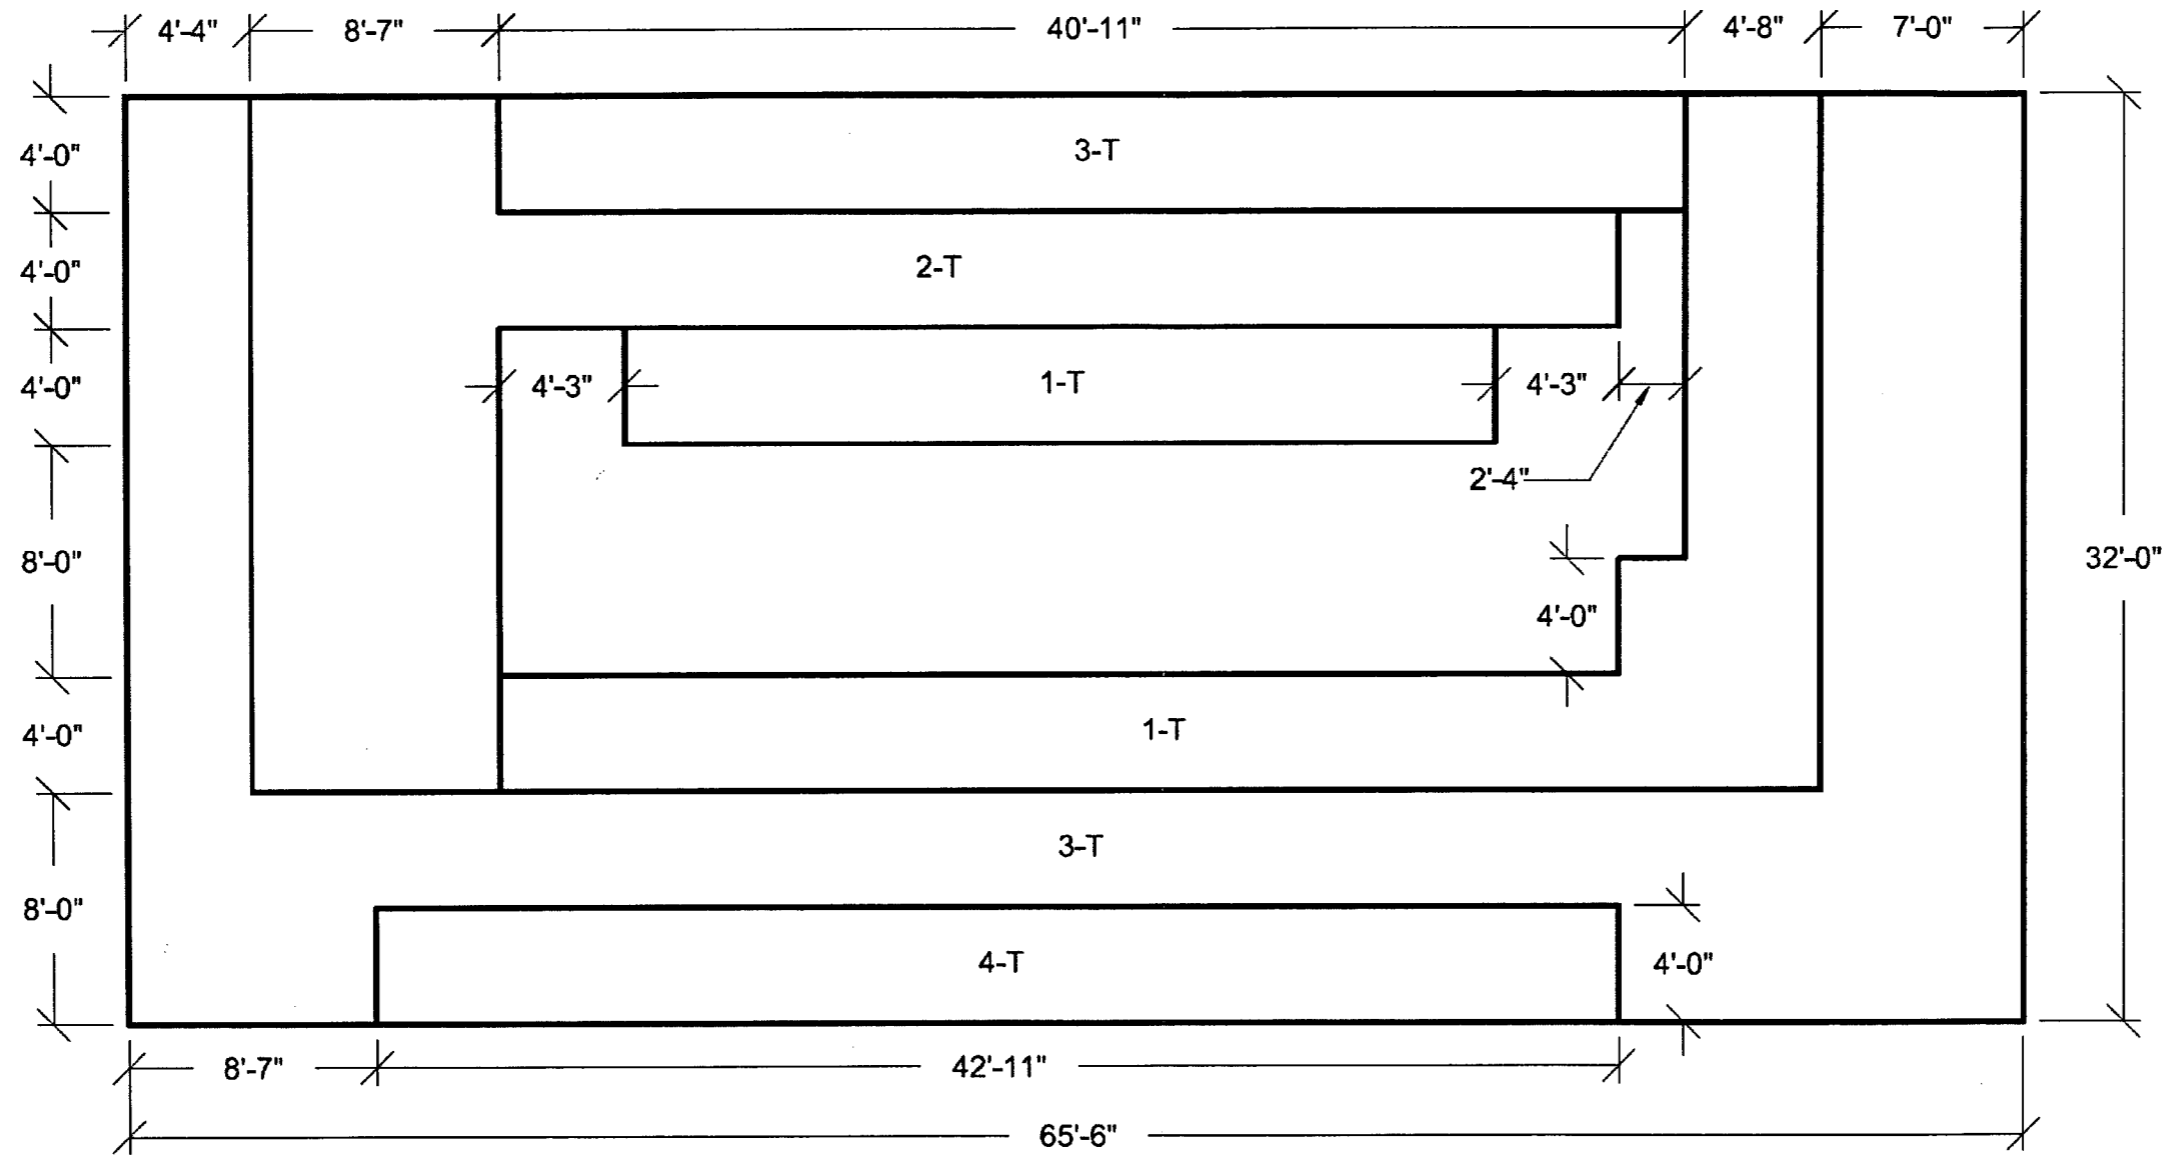


Figure 3H.6-167: Wall 7 Looking From Outside
Transverse Reinforcement Zones

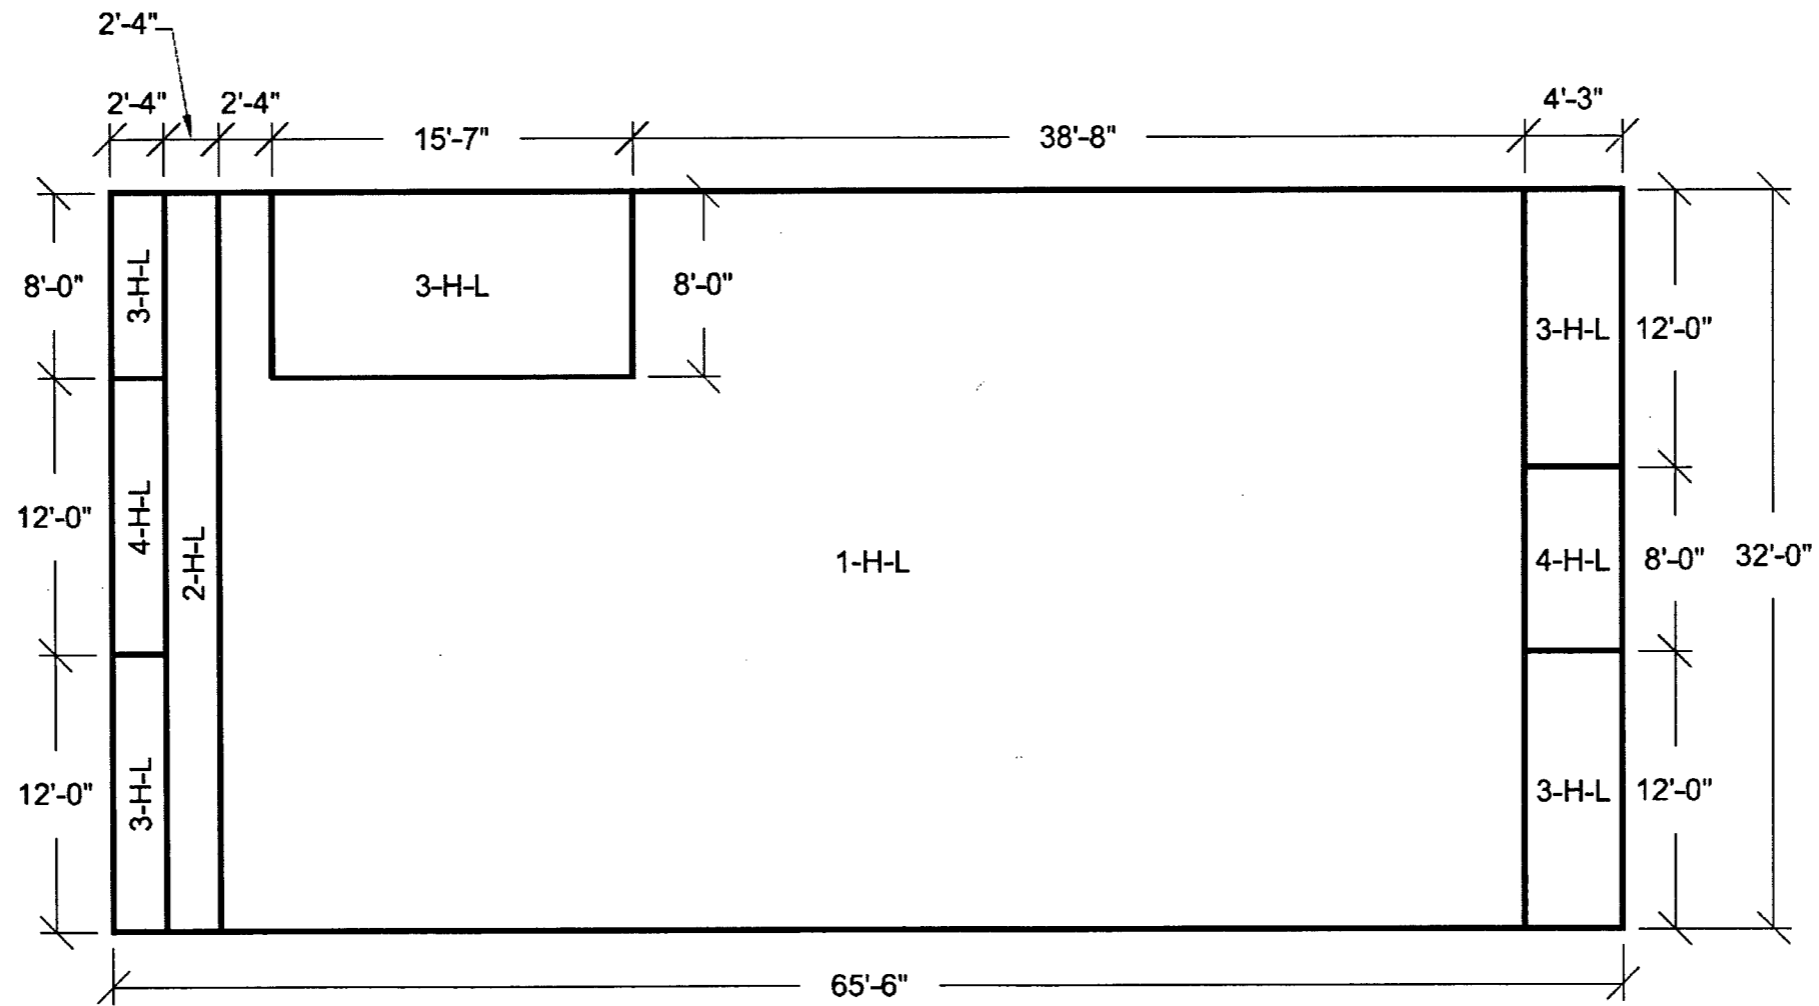


Figure 3H.6-168: Wall 8 Looking From Outside
Horizontal Reinforcement Zones
Near Side Face

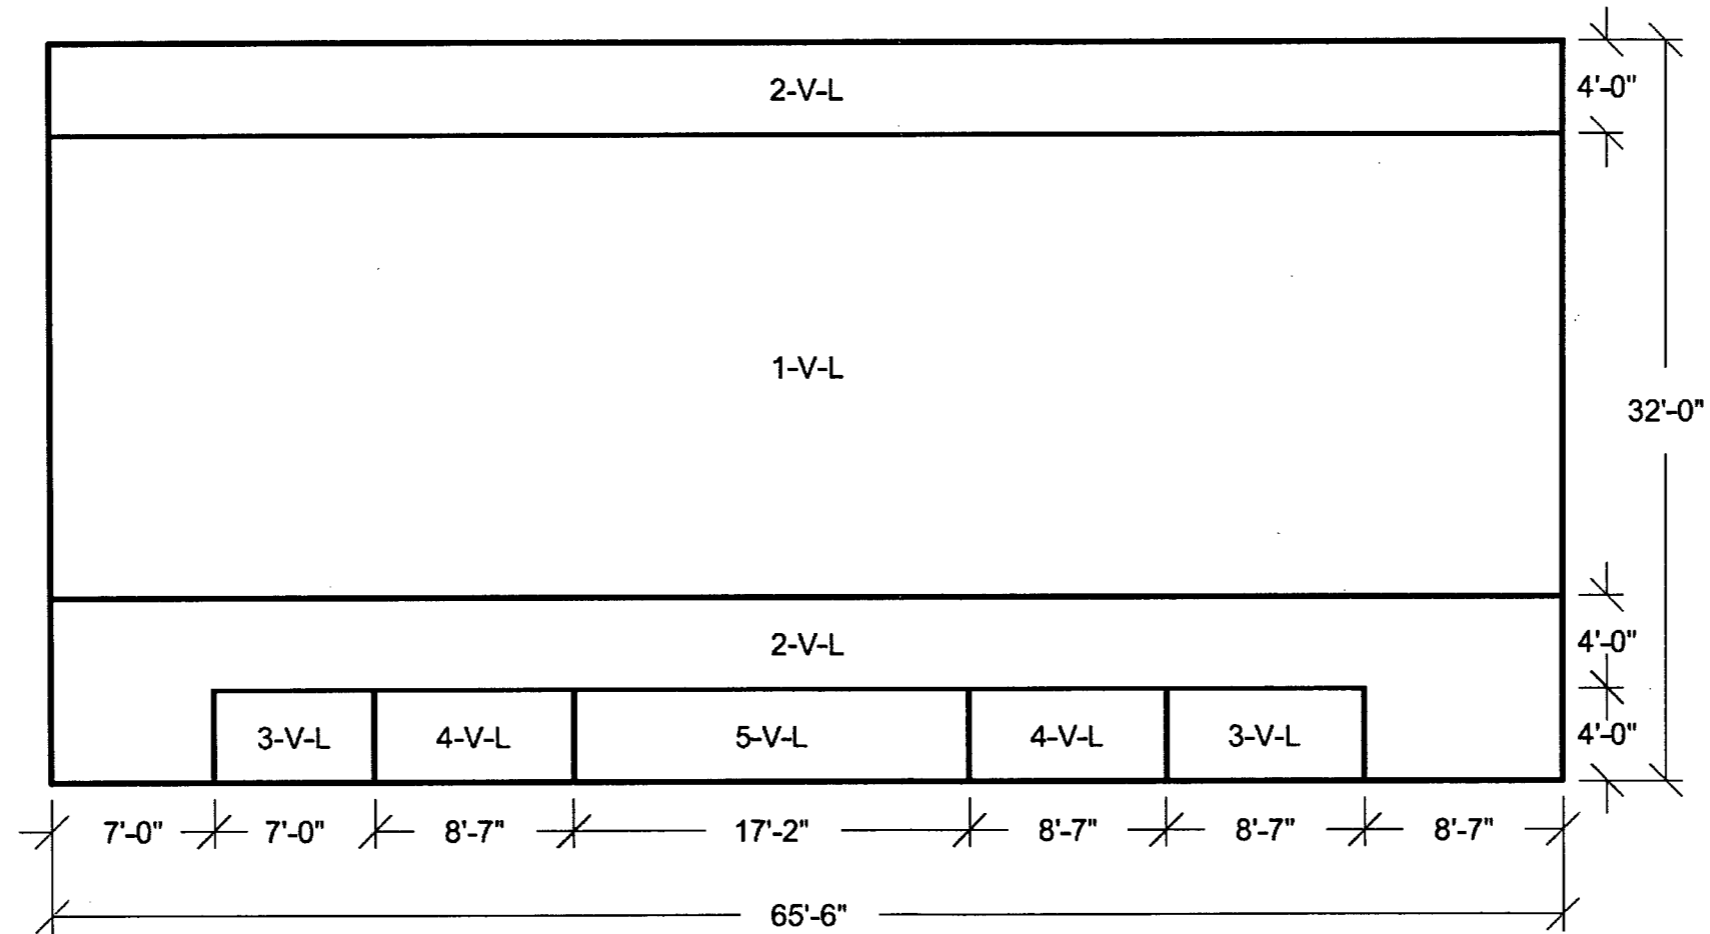


Figure 3H.6-169: Wall 8 Looking From Outside
Vertical Reinforcement Zones
Near Side Face

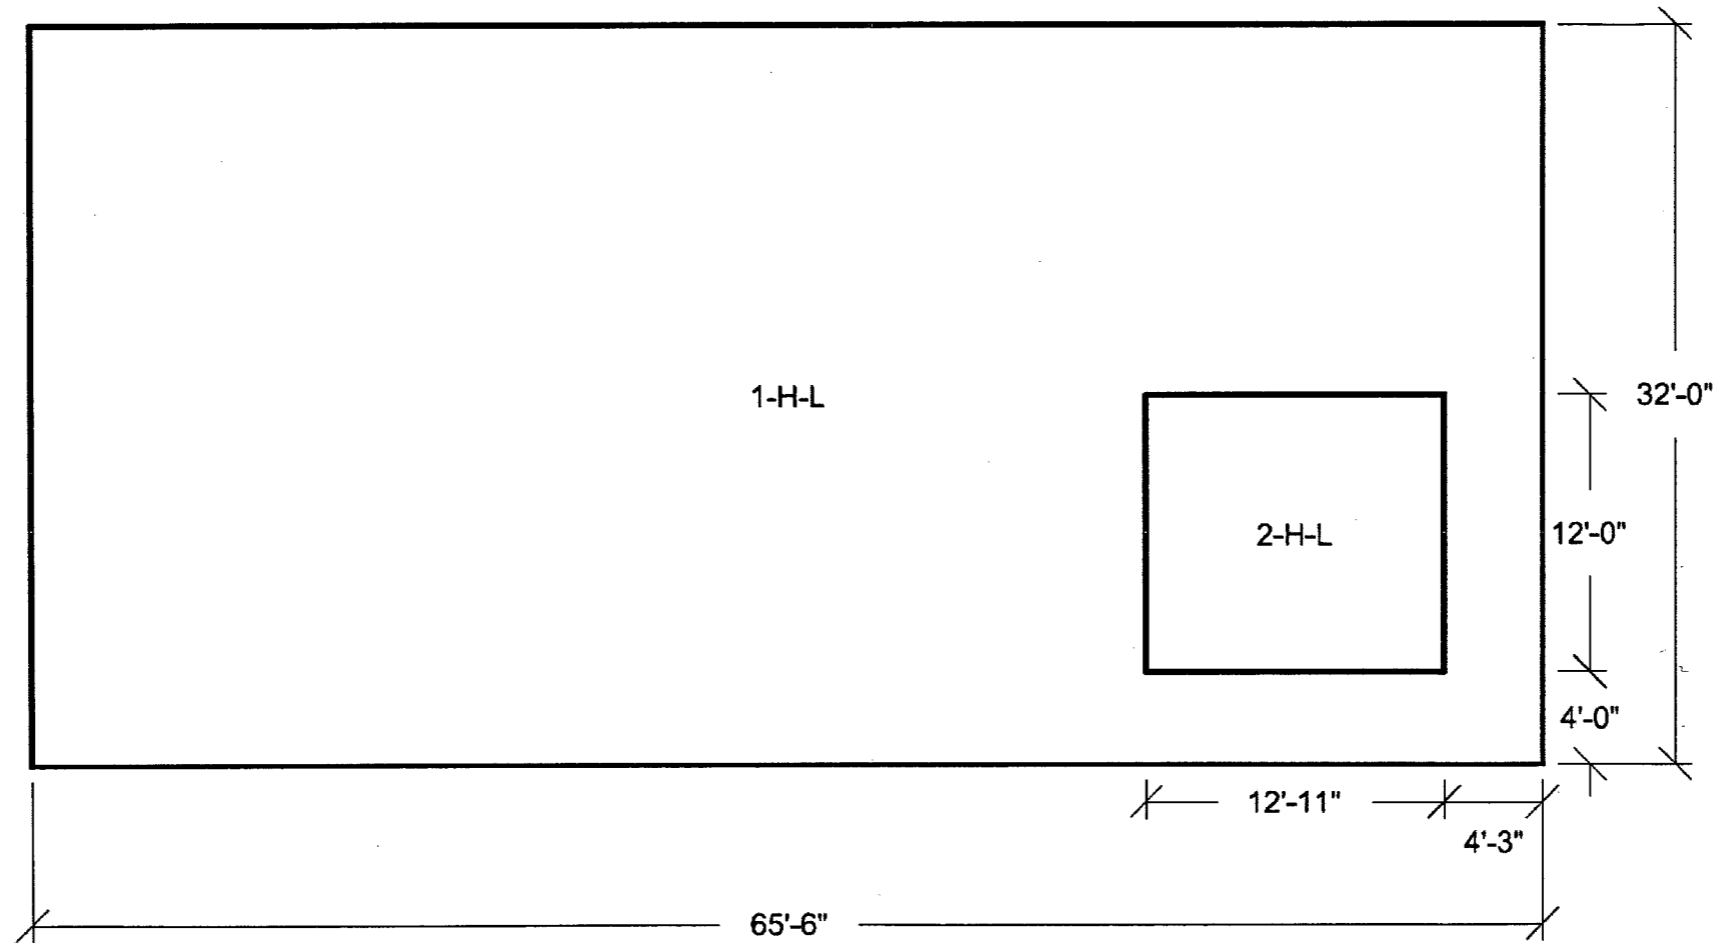


Figure 3H.6-170: Wall 8 Looking From Outside

Horizontal Reinforcement Zones

Far Side Face

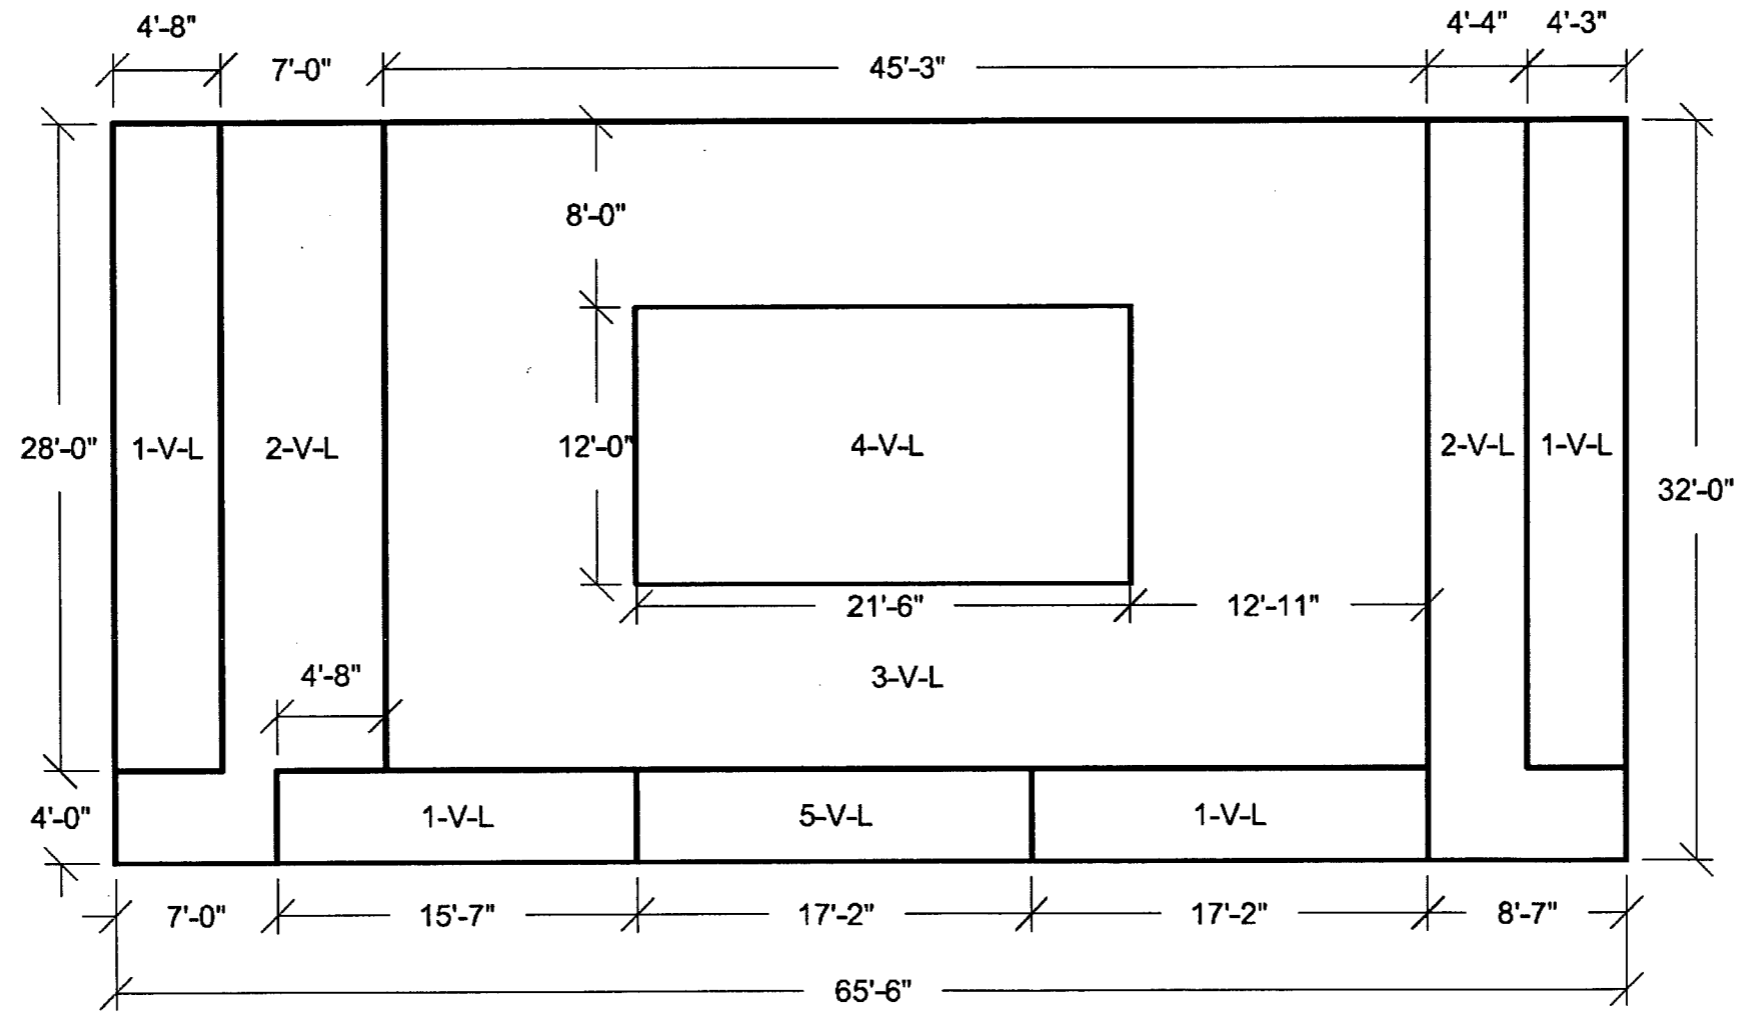


Figure 3H.6-171: Wall 8 Looking From Outside
Vertical Reinforcement Zones
Far Side Face

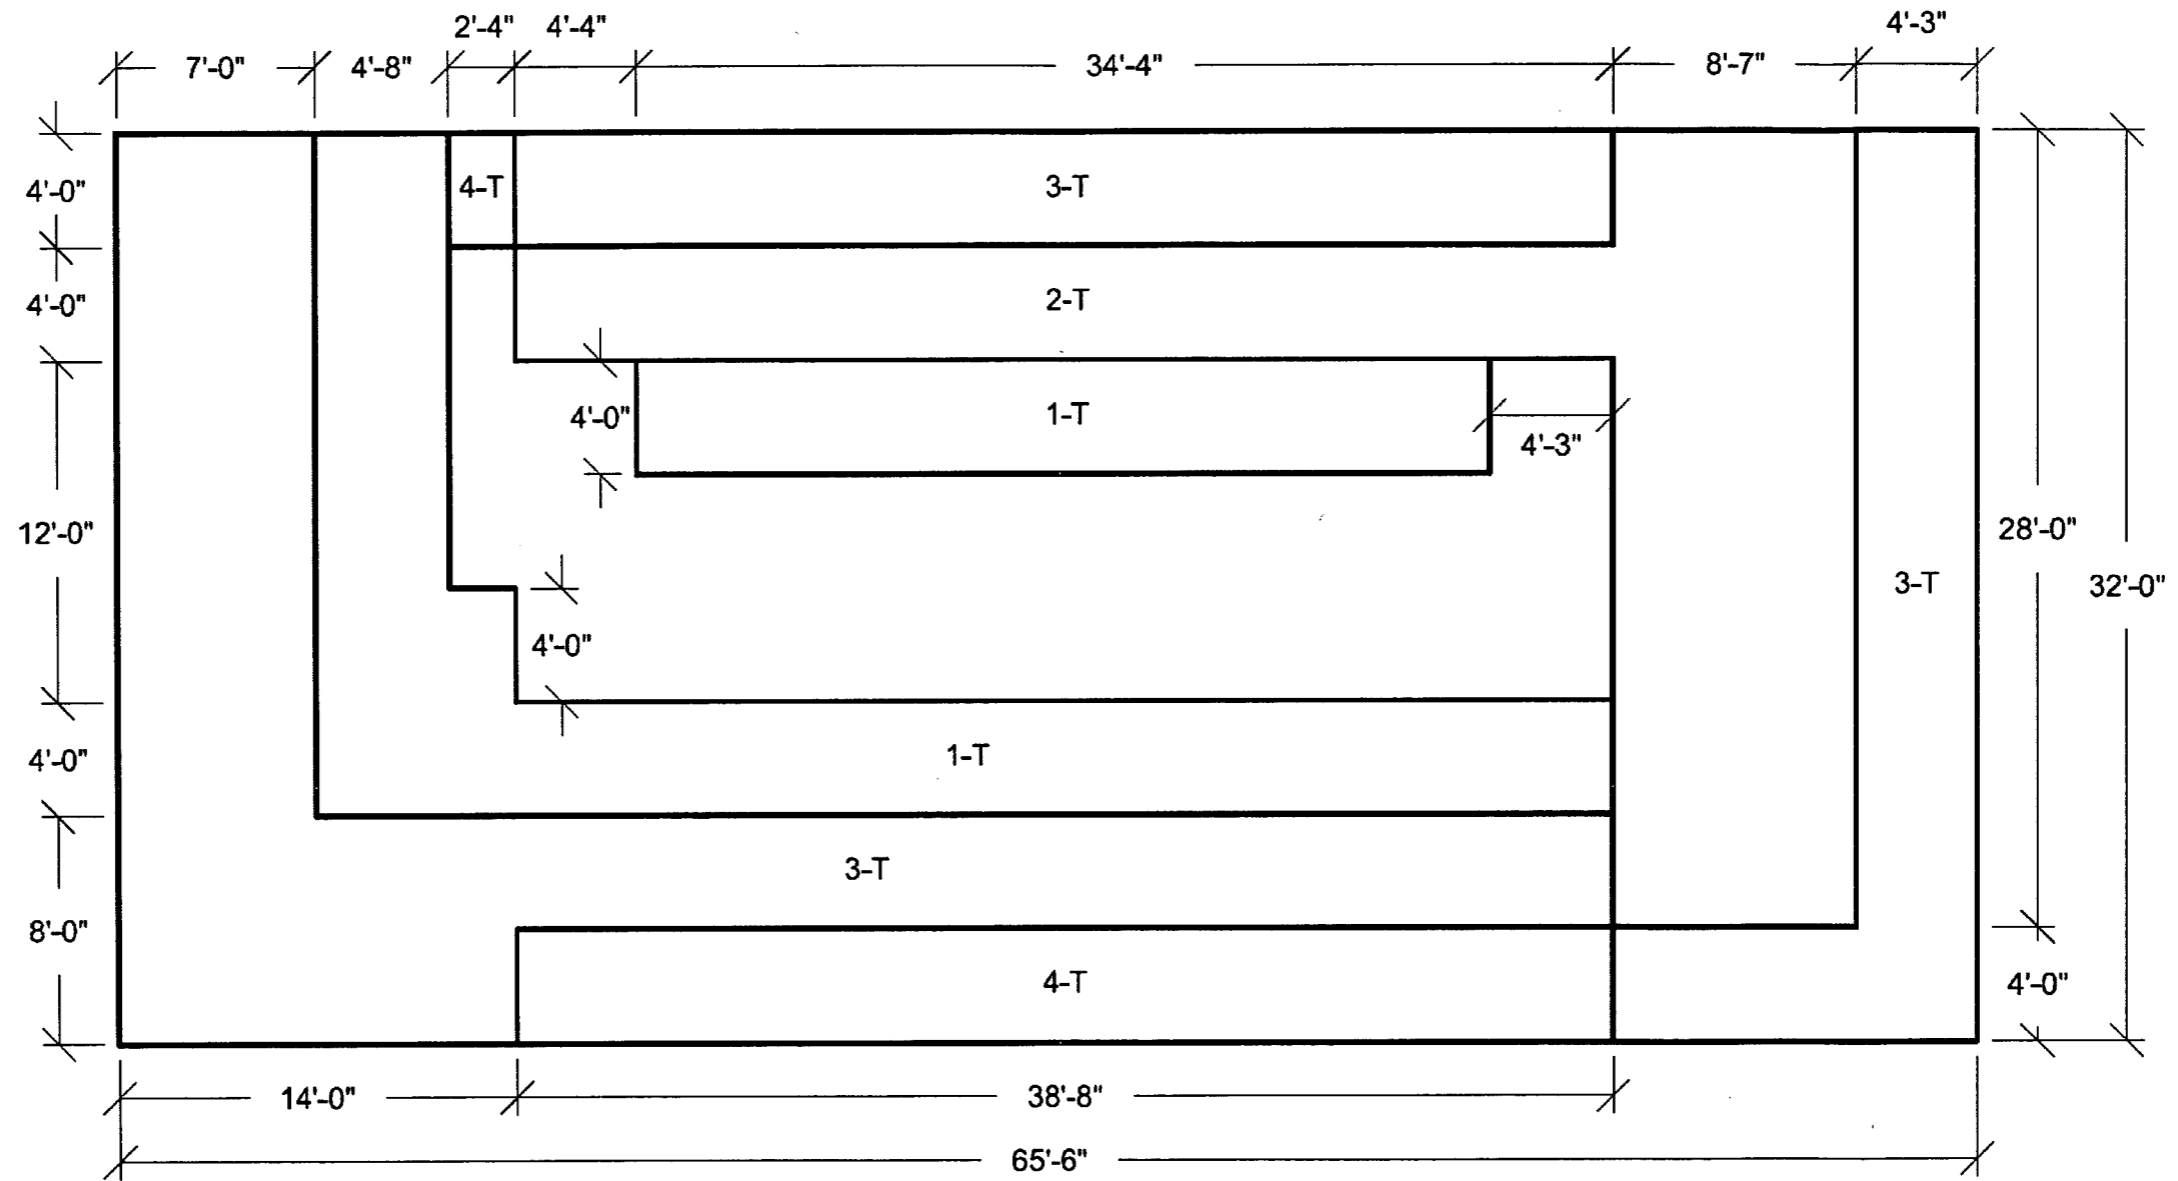


Figure 3H.6-172: Wall 8 Looking From Outside
Transverse Reinforcement Zones

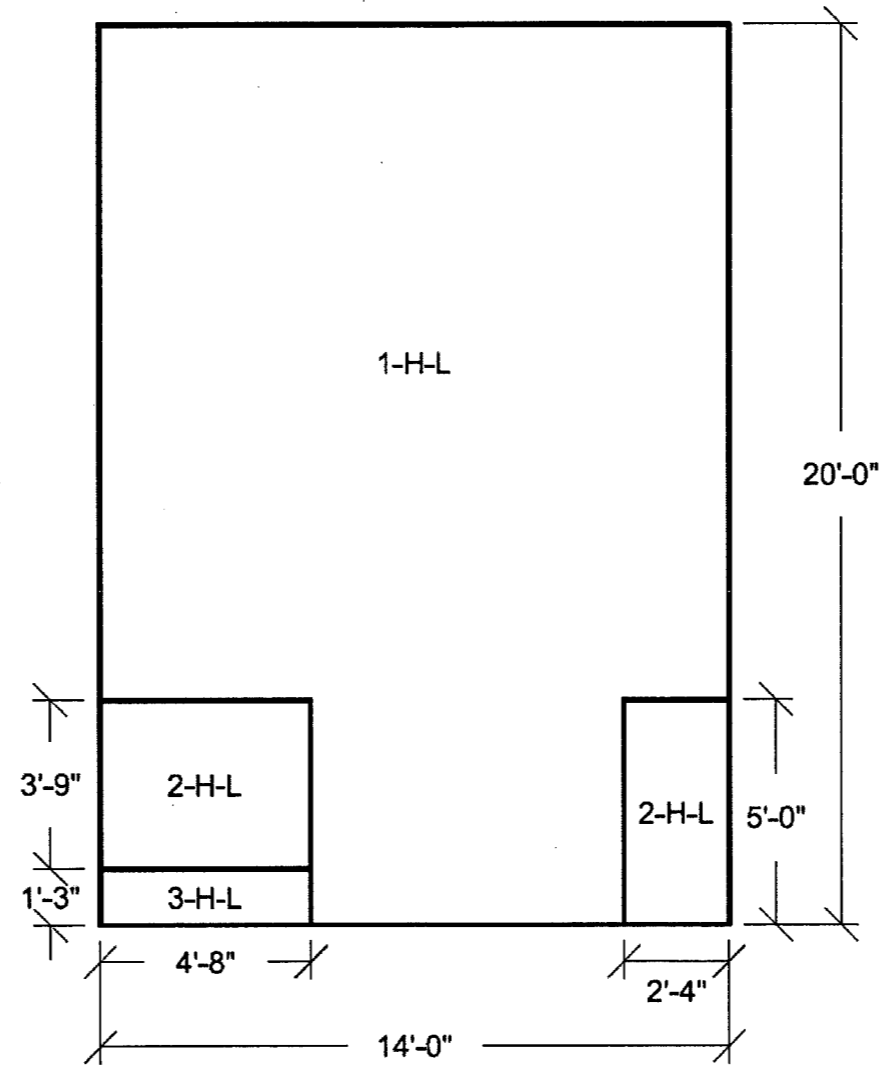


Figure 3H.6-173: Wall 9 Looking From Outside
Horizontal Reinforcement Zones
Near Side Face

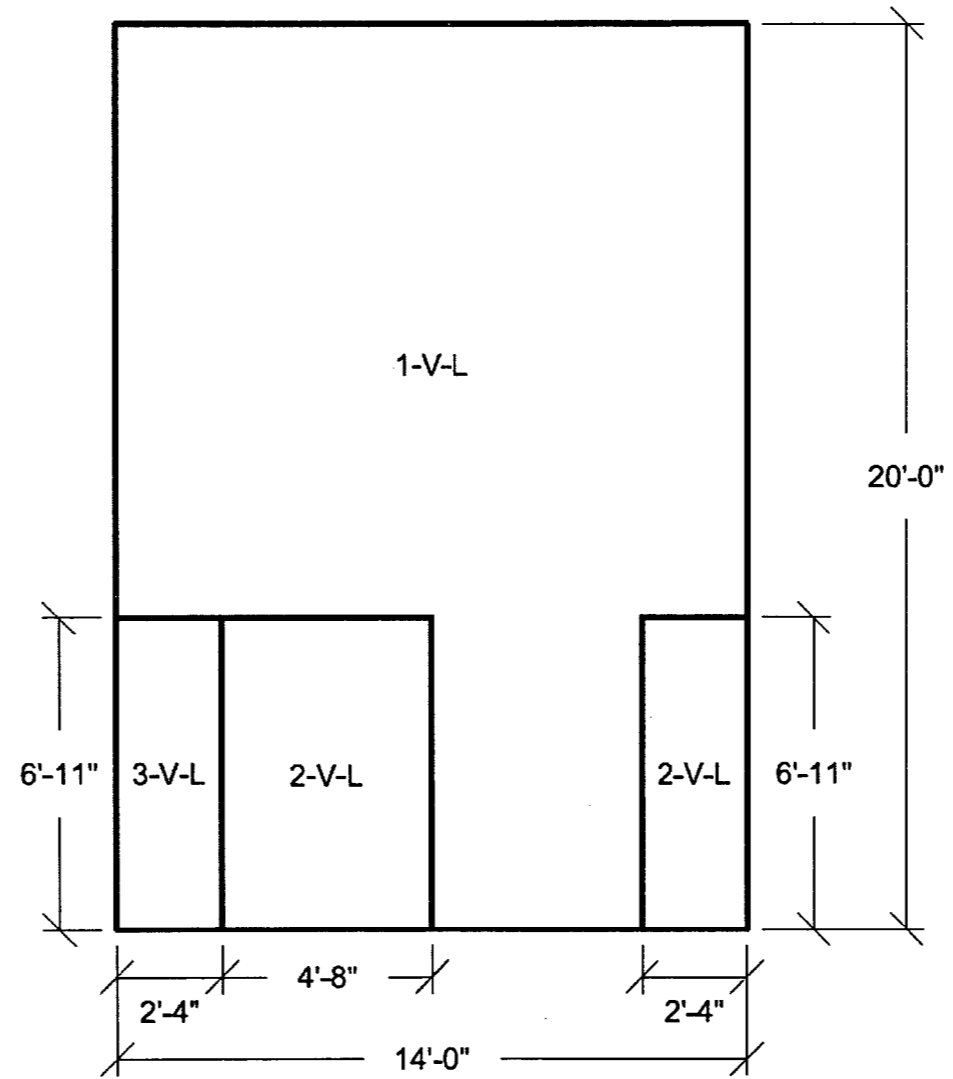


Figure 3H.6-174: Wall 9 Looking From Outside

Vertical Reinforcement Zones

Near Side Face

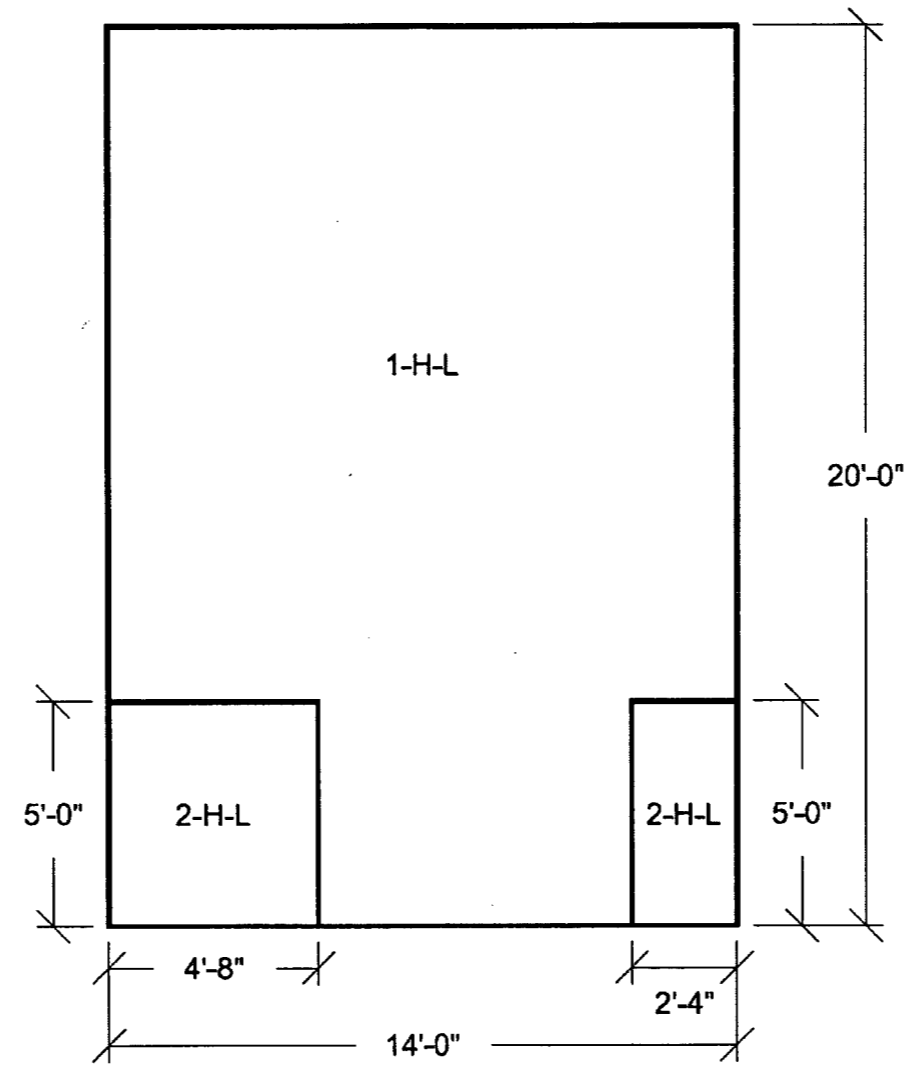


Figure 3H.6-175: Wall 9 Looking From Outside
Horizontal Reinforcement Zones
Far Side Face

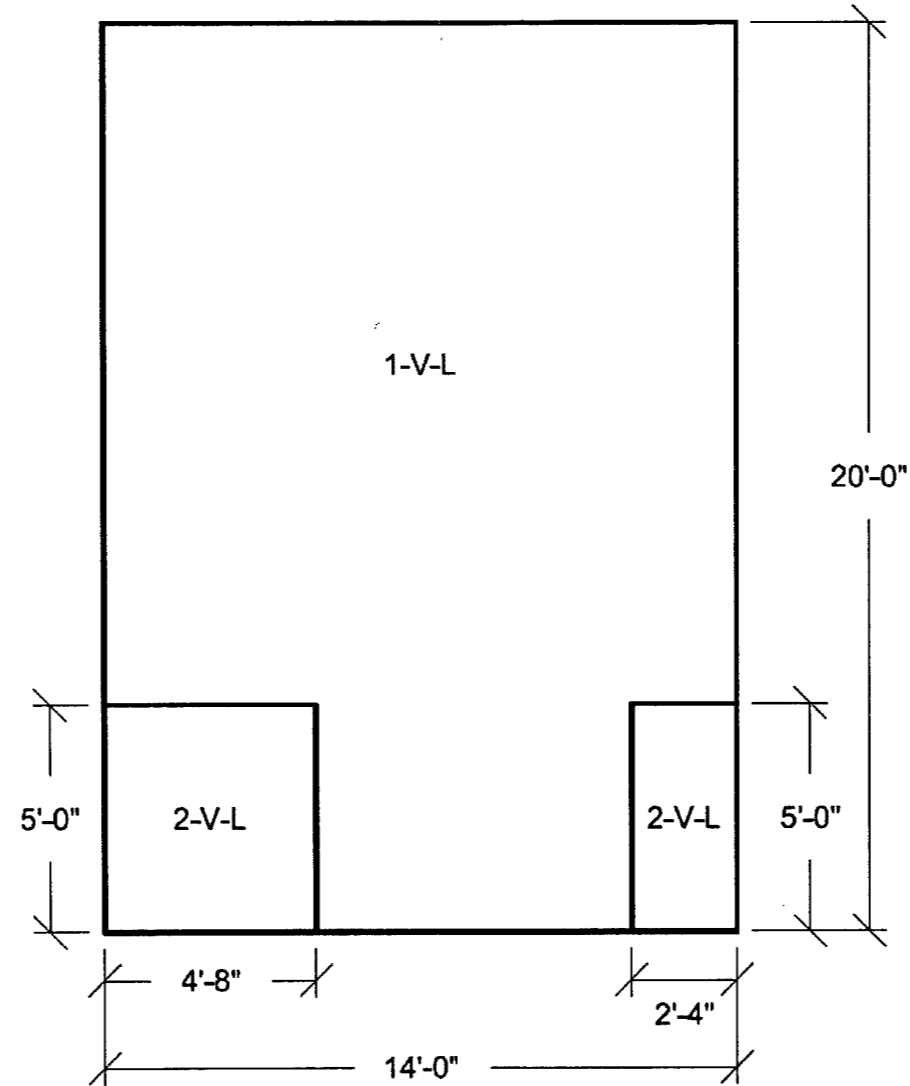


Figure 3H.6-176A: Wall 9 Looking From Outside
Vertical Reinforcement Zones
Far Side Face

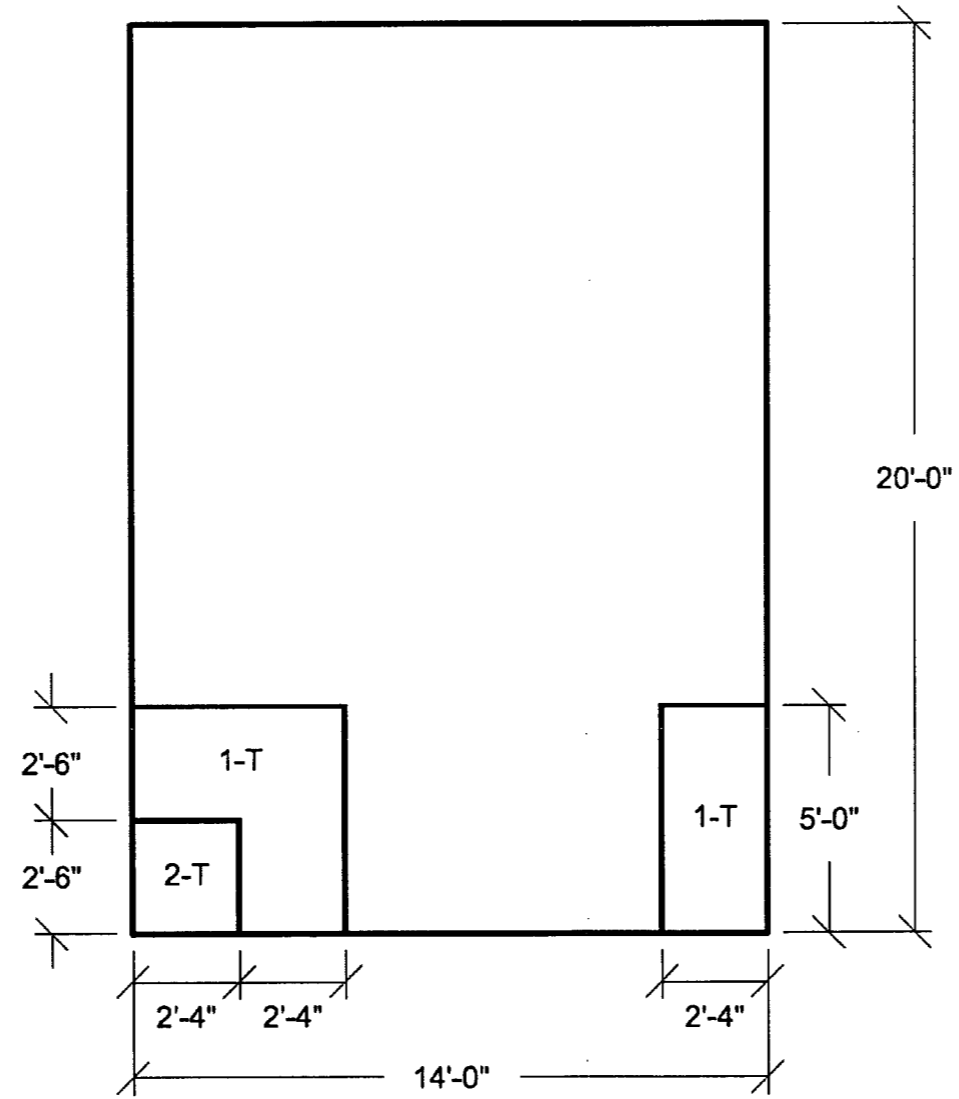


Figure 3H.6-176B: Wall 9 Looking From Outside
Transverse Reinforcement Zones

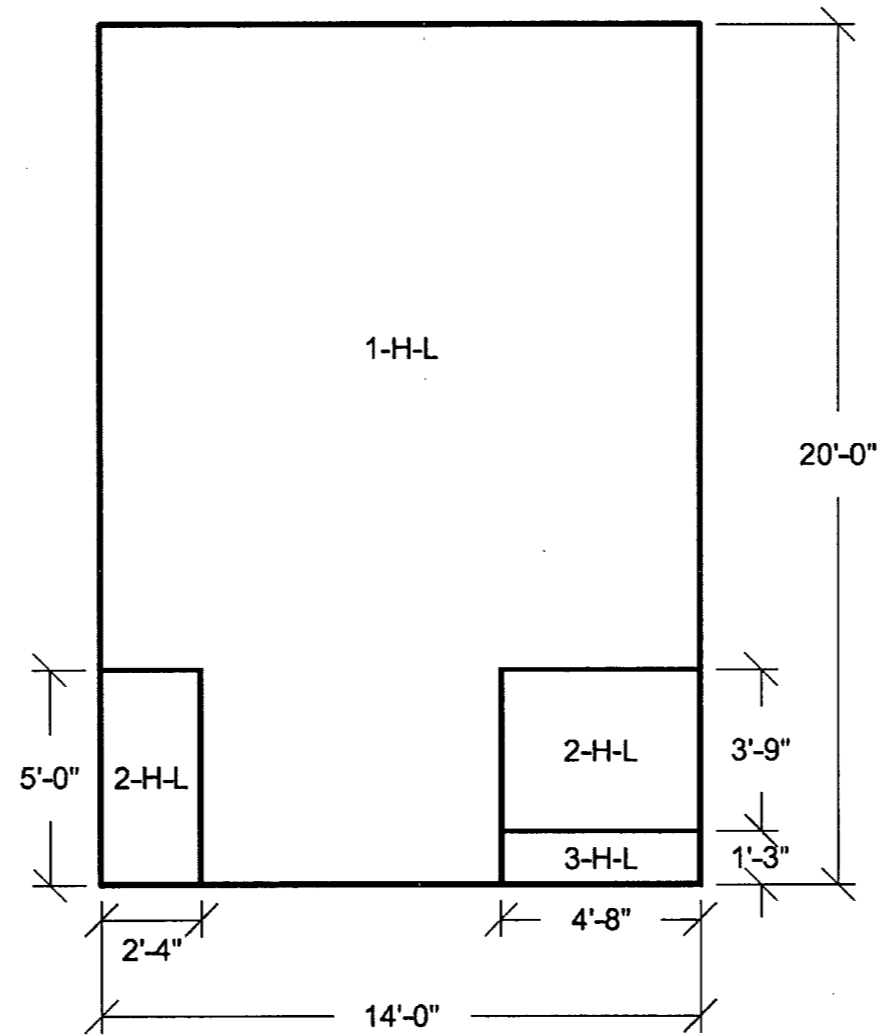


Figure 3H.6-177: Wall 10 Looking From Outside
Horizontal Reinforcement Zones
Near Side Face

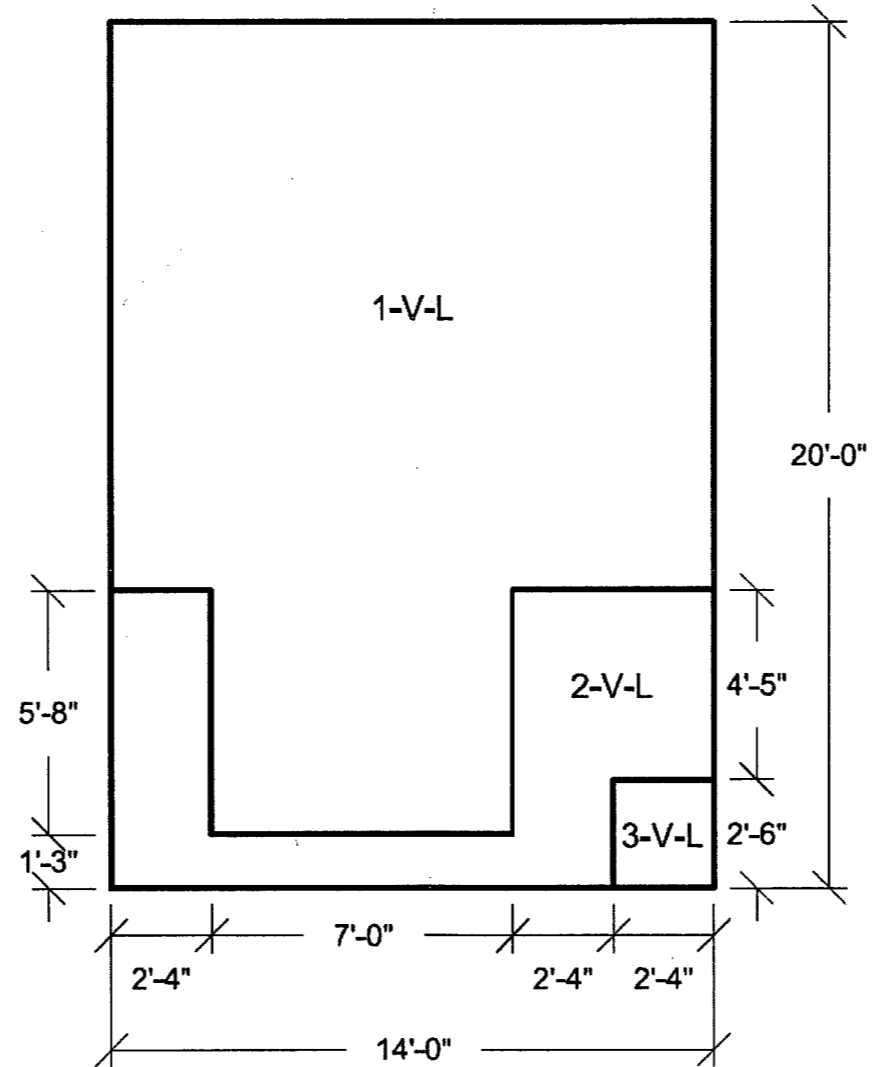


Figure 3H.6-178: Wall 10 Looking From Outside

Vertical Reinforcement Zones

Near Side Face

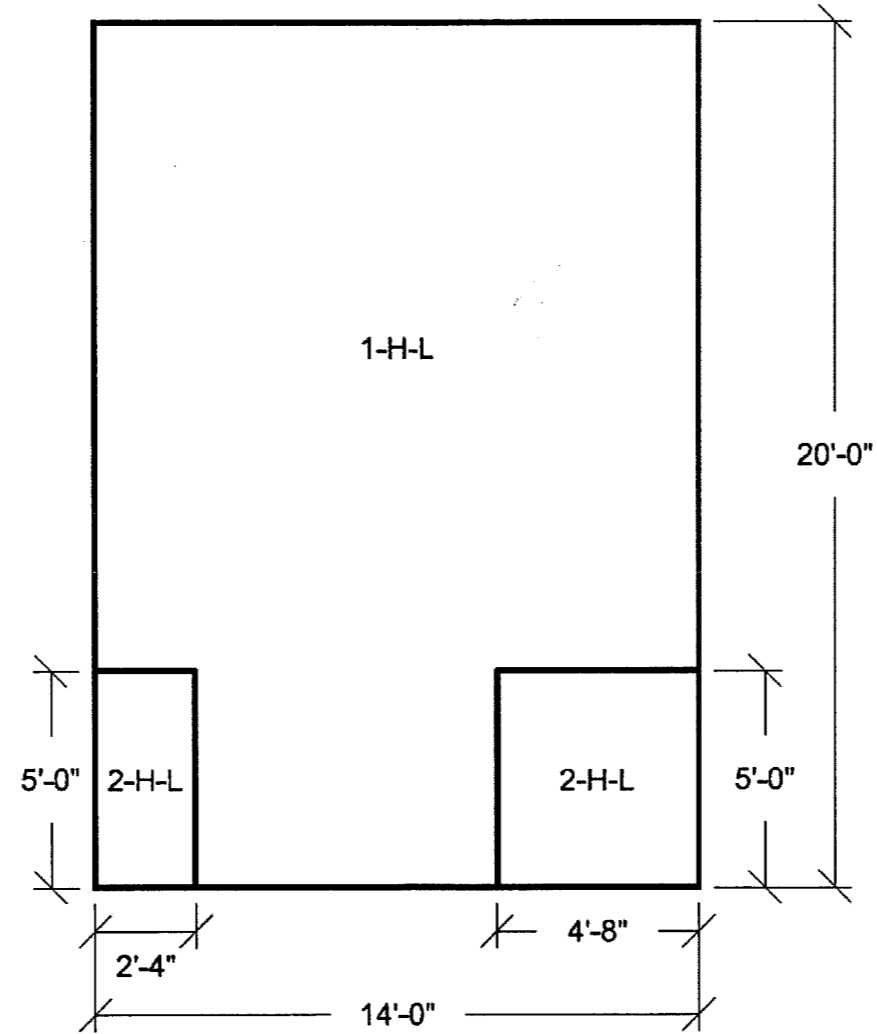


Figure 3H.6-179: Wall 10 Looking From Outside
Horizontal Reinforcement Zones
Far Side Face

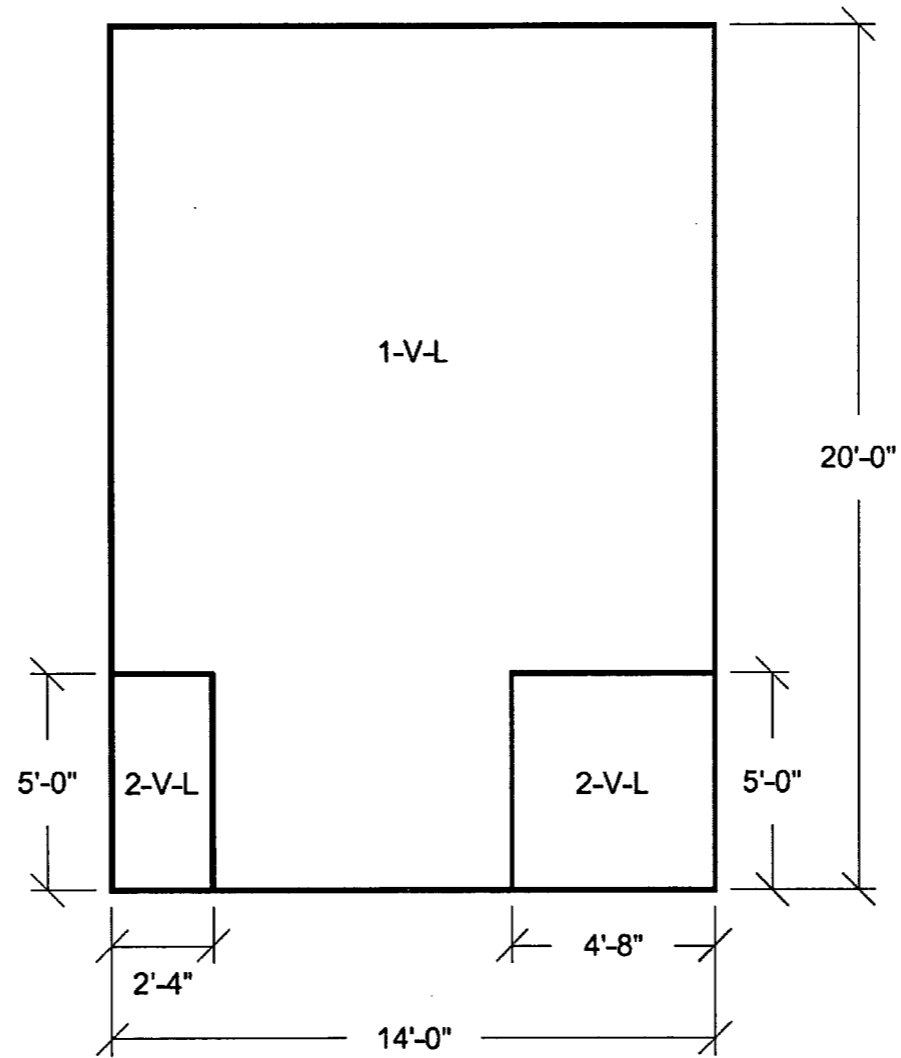


Figure 3H.6-180A: Wall 10 Looking From Outside

Vertical Reinforcement Zones

Far Side Face

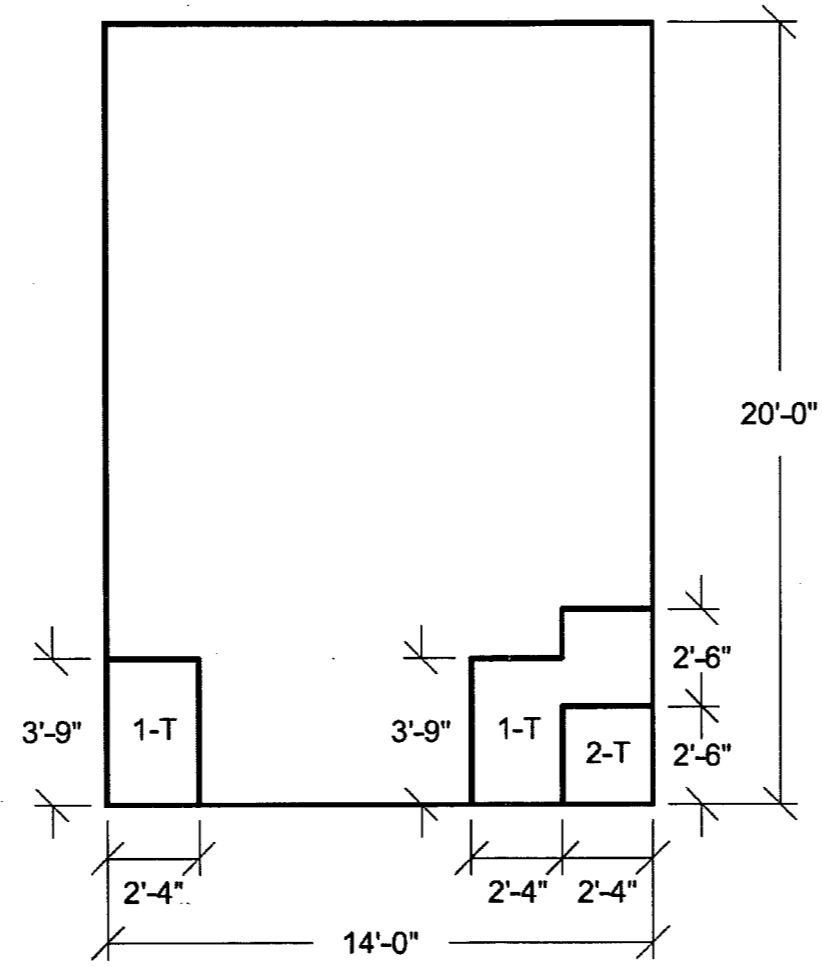


Figure 3H.6-180B: Wall 10 Looking From Outside
Transverse Reinforcement Zones

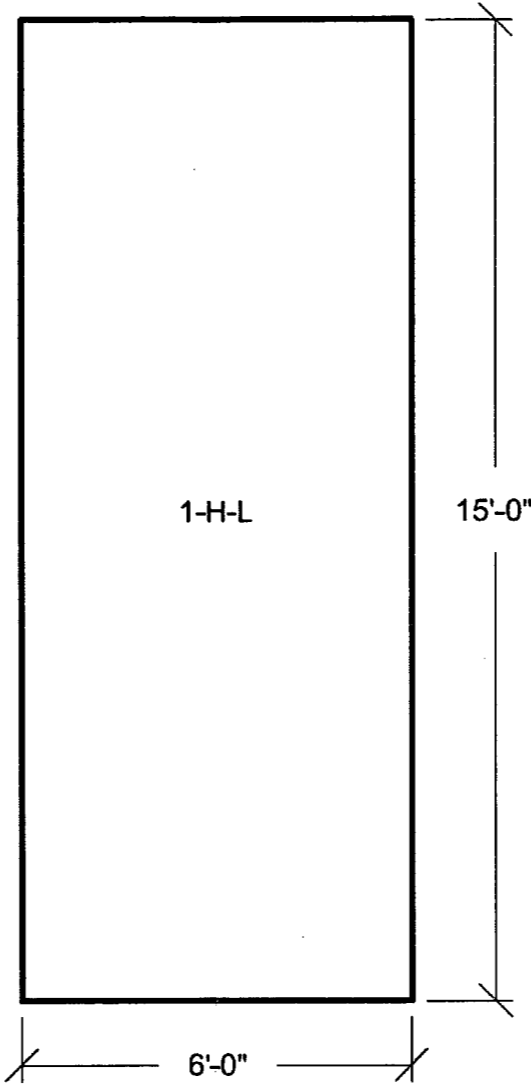


Figure 3H.6-181: Wall 11 Looking From Outside
Horizontal Reinforcement Zones
Near Side Face

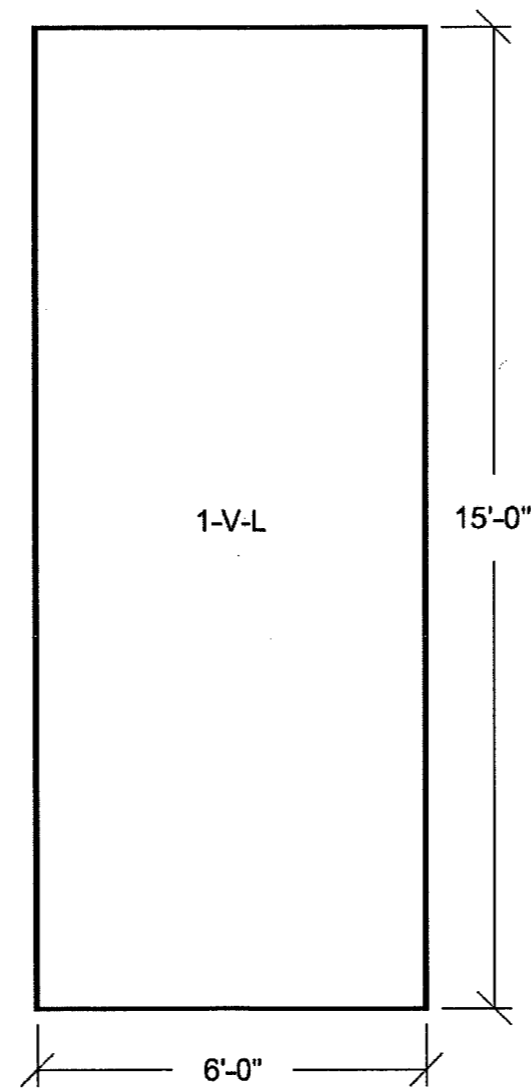


Figure 3H.6-182: Wall 11 Looking From Outside

Vertical Reinforcement Zones

Near Side Face

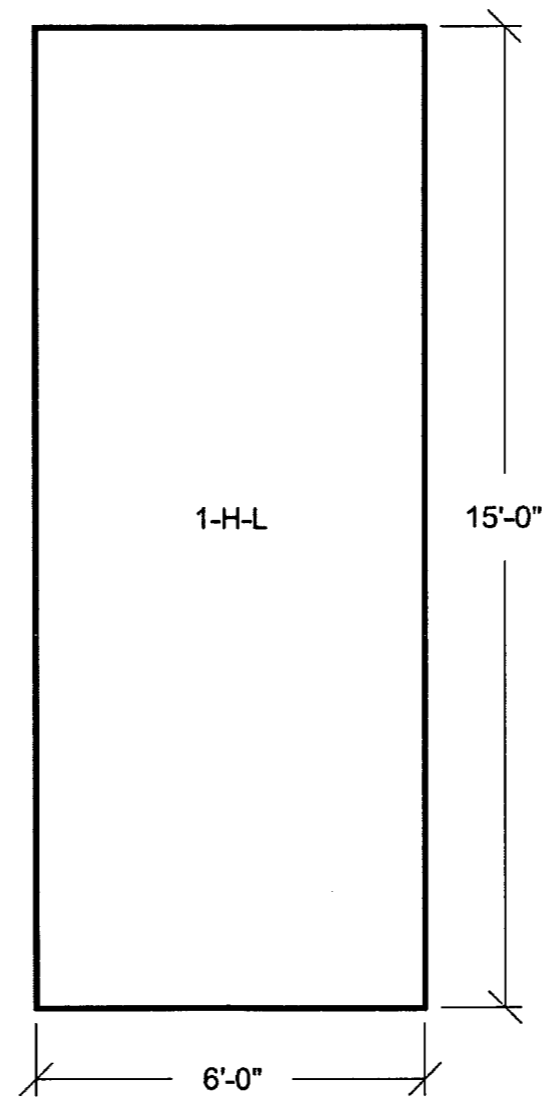


Figure 3H.6-183: Wall 11 Looking From Outside

Horizontal Reinforcement Zones

Far Side Face

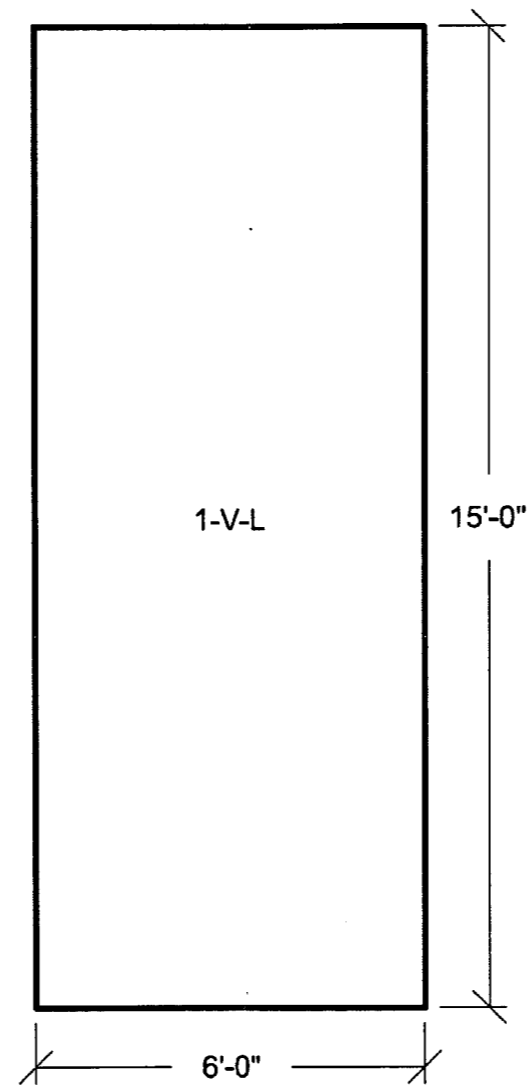


Figure 3H.6-184: Wall 11 Looking From Outside
Vertical Reinforcement Zones
Far Side Face

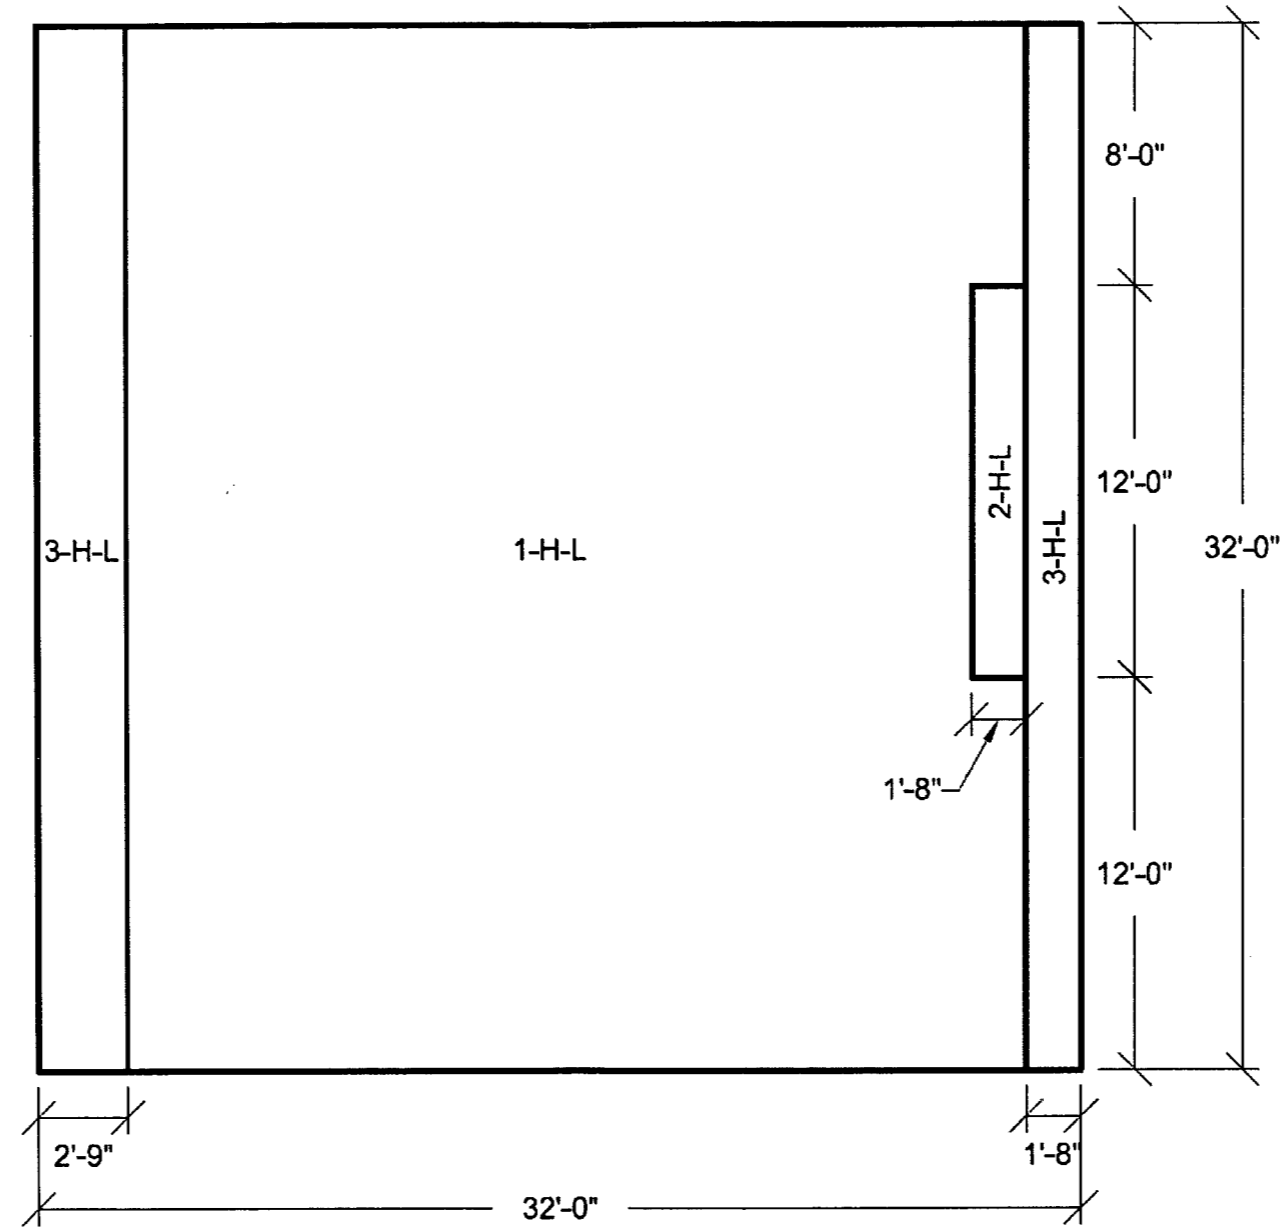


Figure 3H.6-185: Wall 12 Looking From Outside

Horizontal Reinforcement Zones

Near Side Face

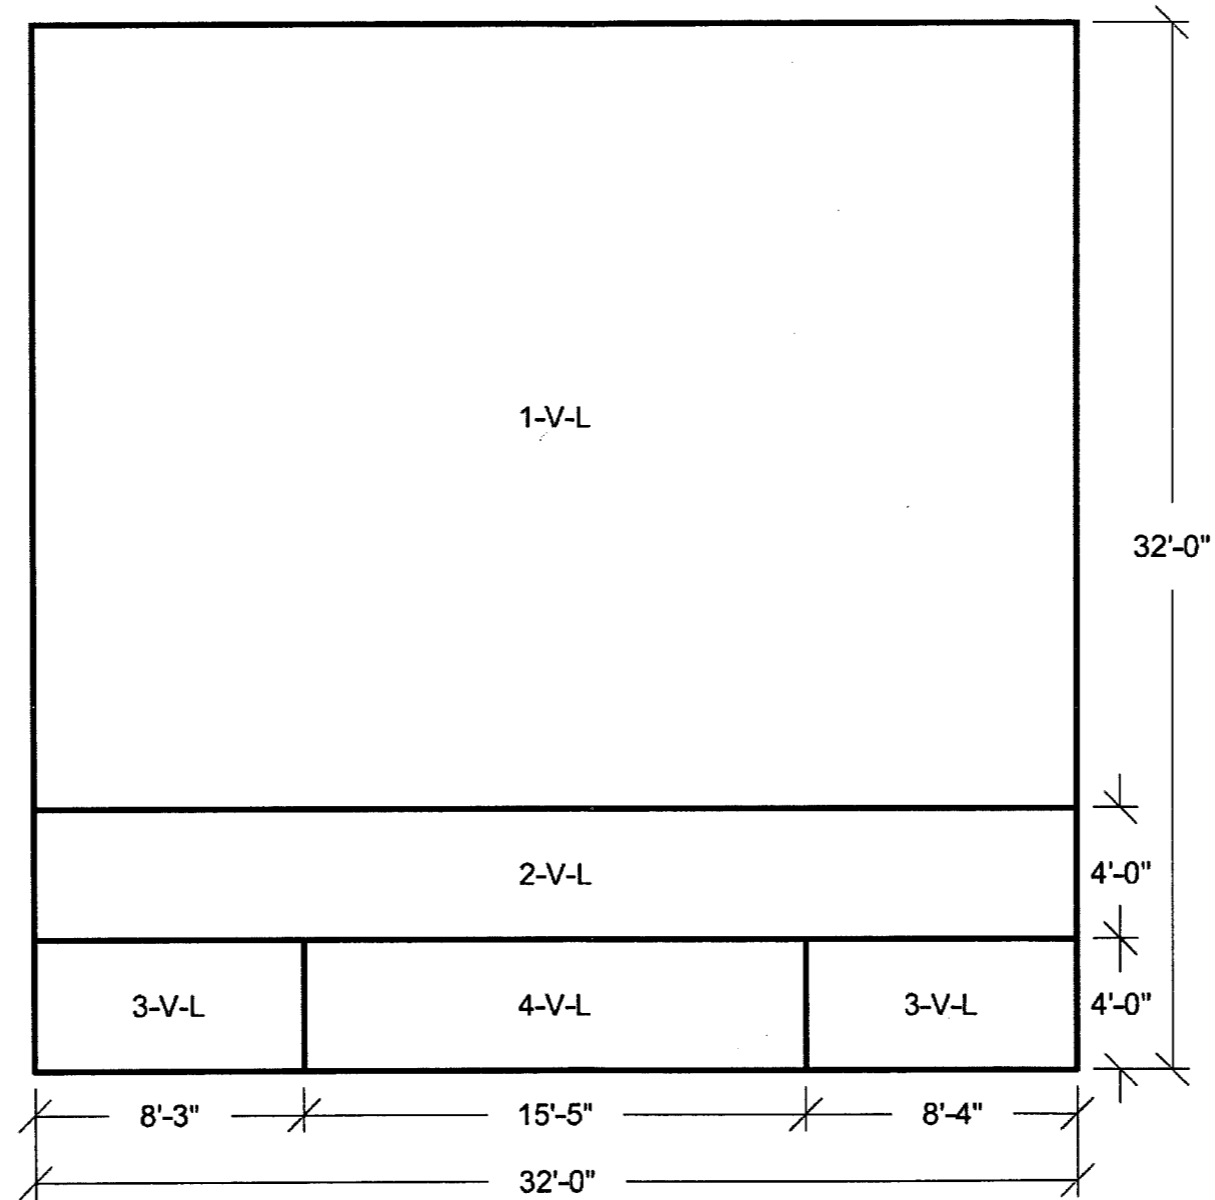


Figure 3H.6-186: Wall 12 Looking From Outside
Vertical Reinforcement Zones
Near Side Face

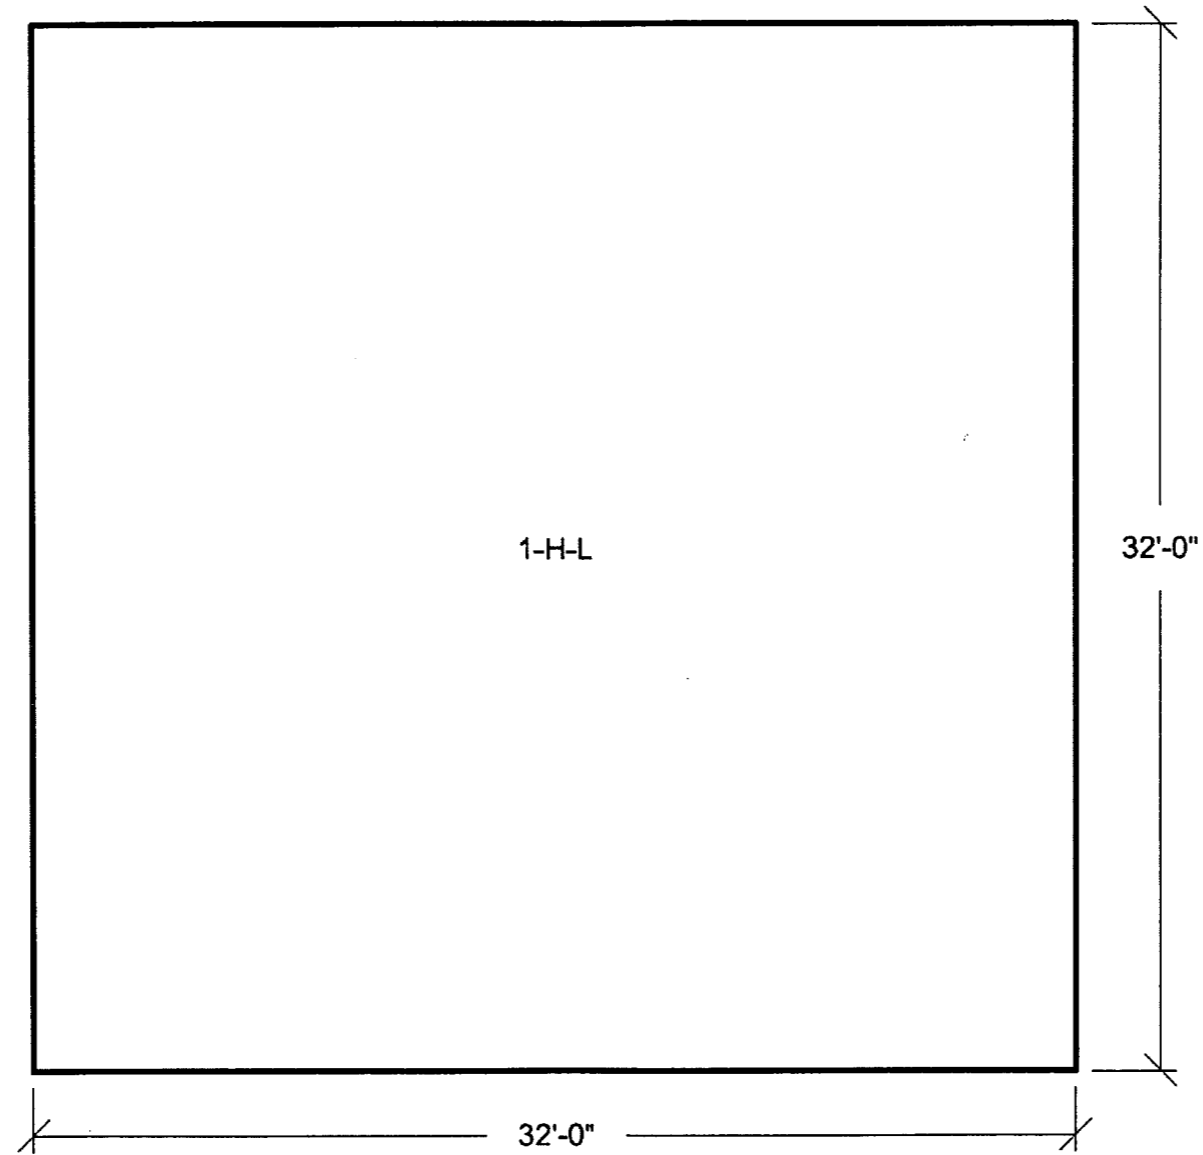


Figure 3H.6-187: Wall 12 Looking From Outside
Horizontal Reinforcement Zones
Far Side Face

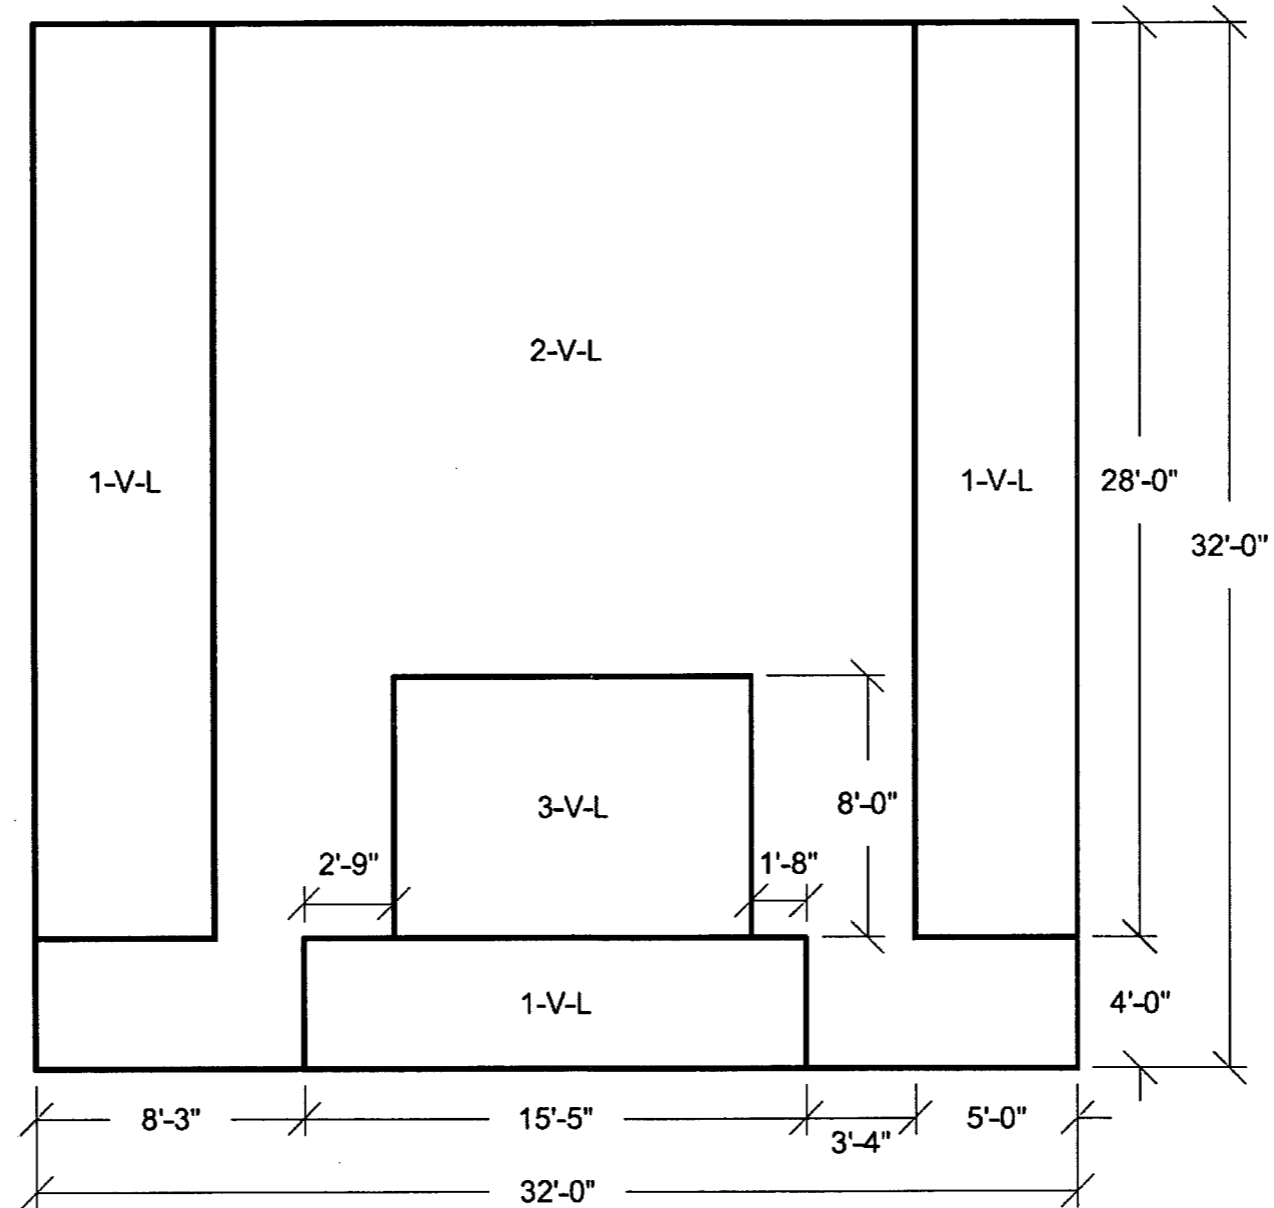


Figure 3H.6-188: Wall 12 Looking From Outside

Vertical Reinforcement Zones

Far Side Face

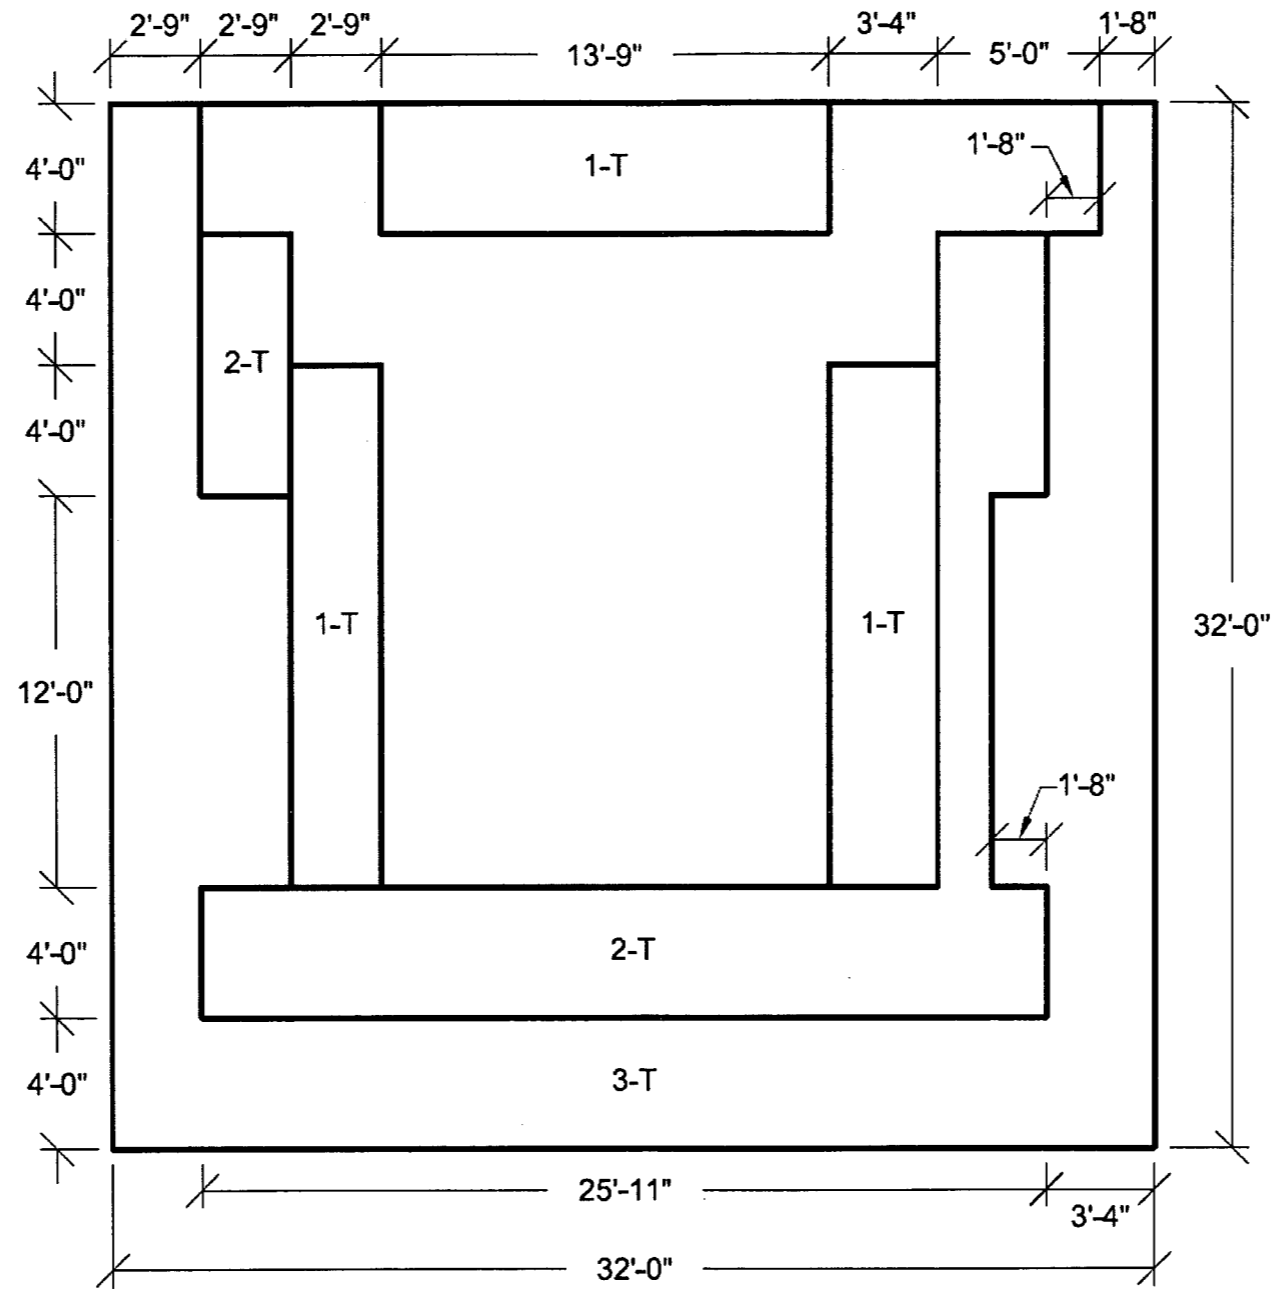


Figure 3H.6-189: Wall 12 Looking From Outside
Transverse Reinforcement Zones

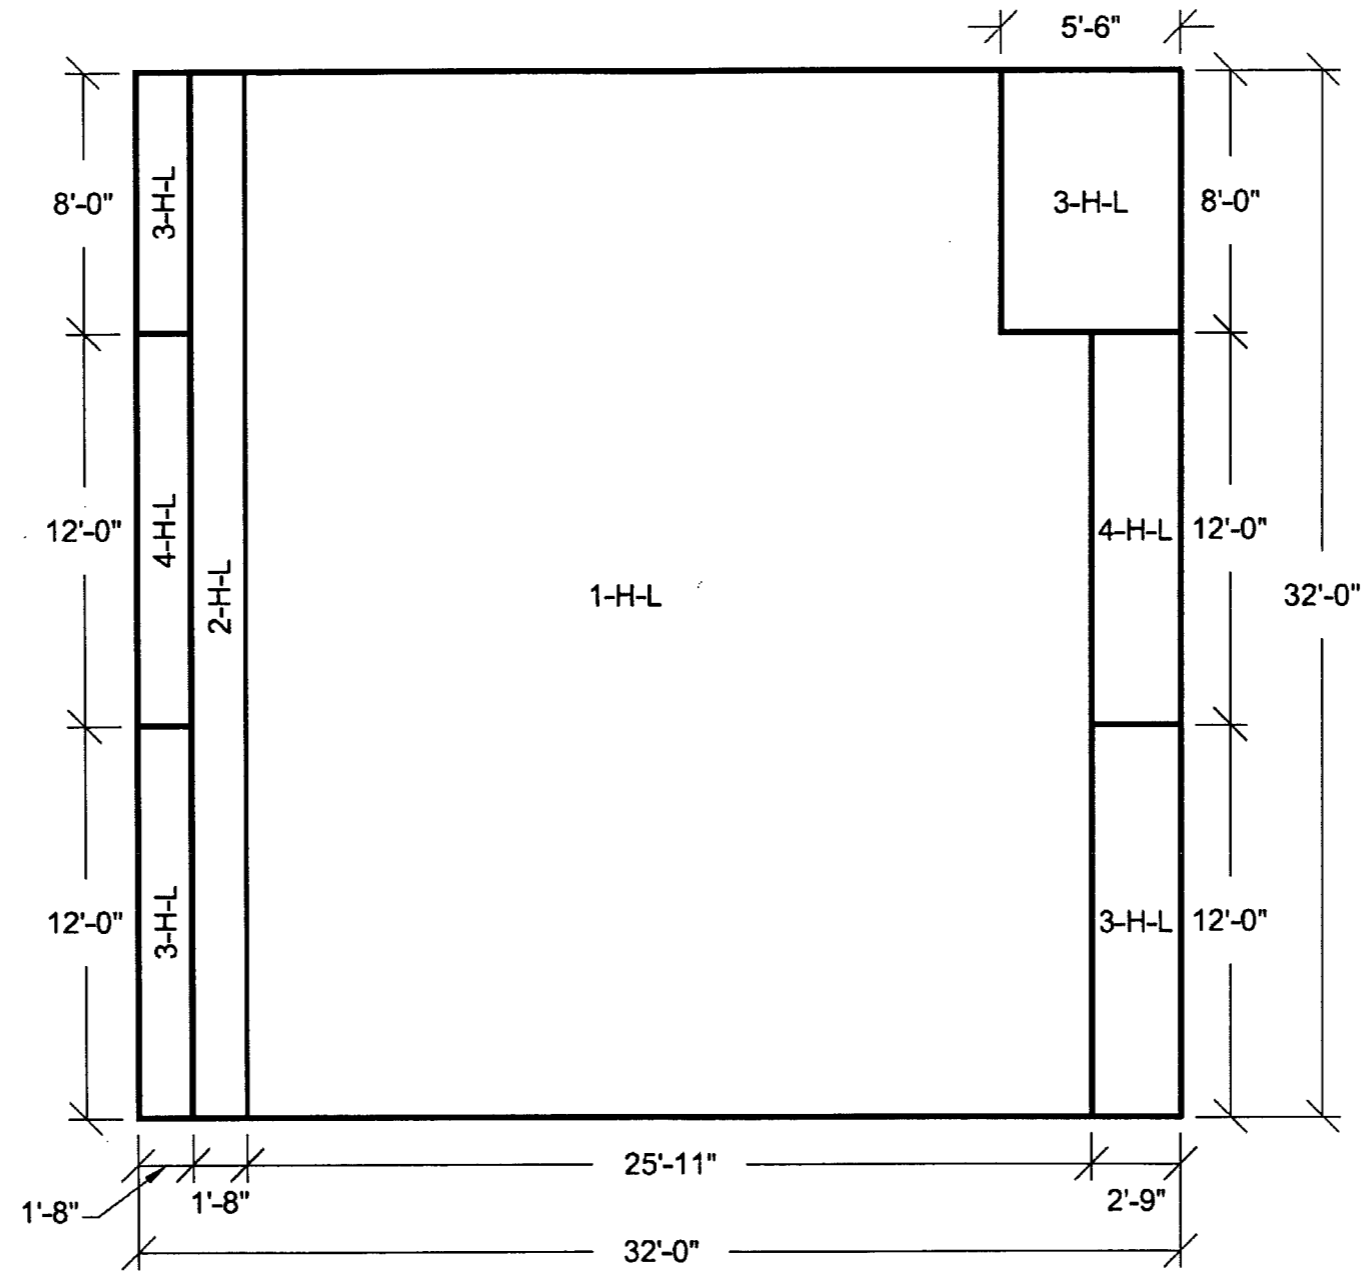


Figure 3H.6-190: Wall 13 Looking From Outside
Horizontal Reinforcement Zones
Near Side Face

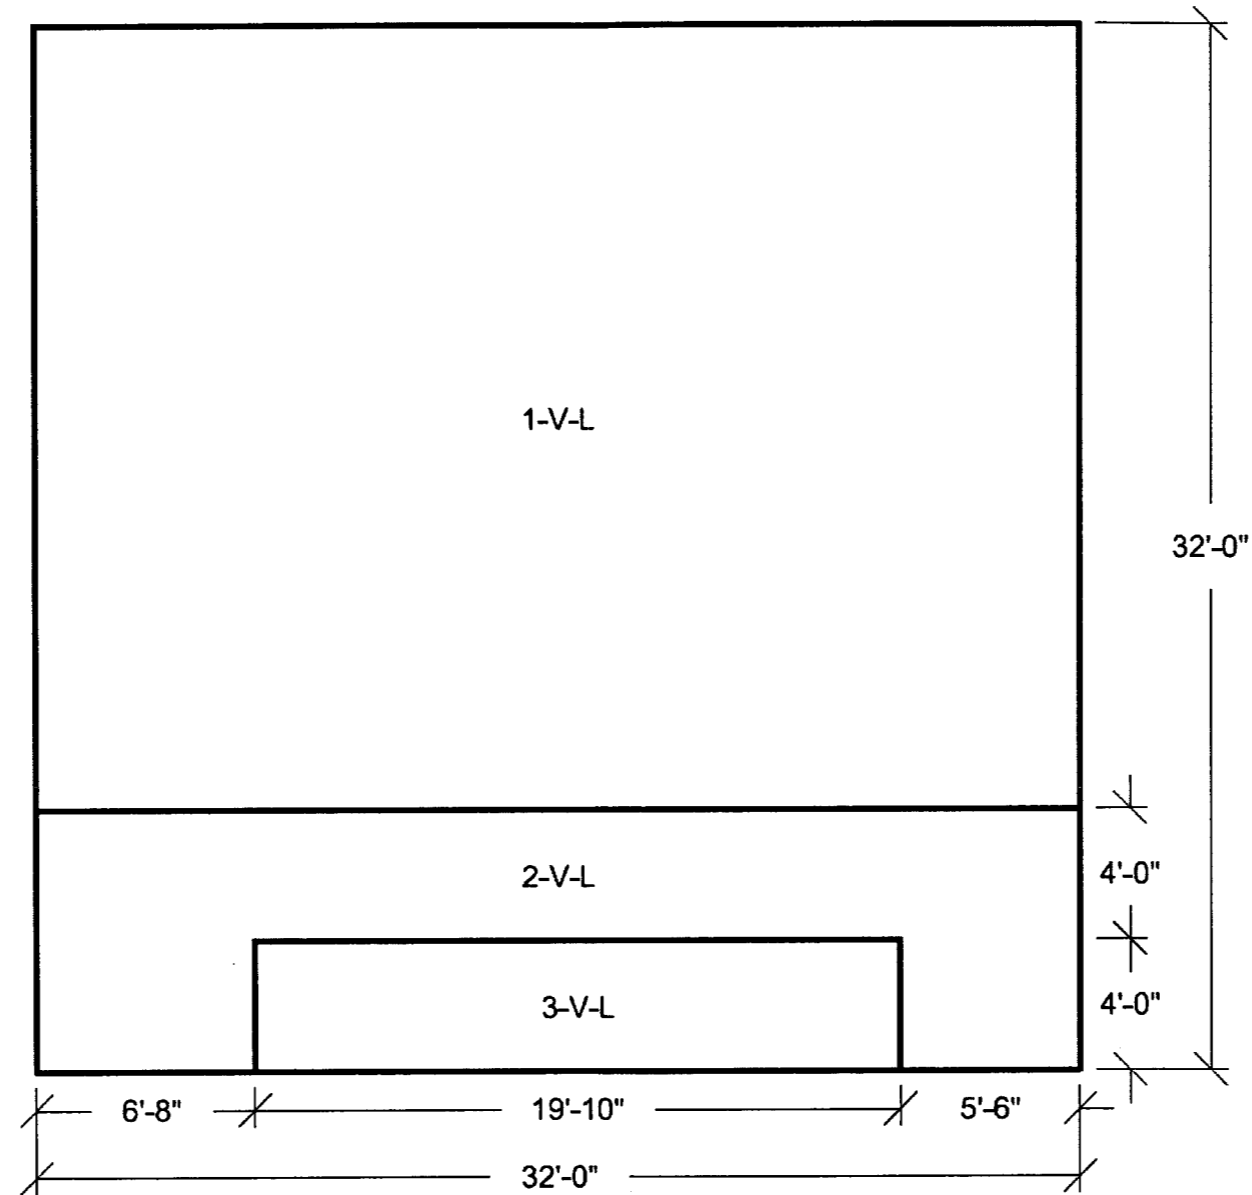


Figure 3H.6-191: Wall 13 Looking From Outside
Vertical Reinforcement Zones
Near Side Face

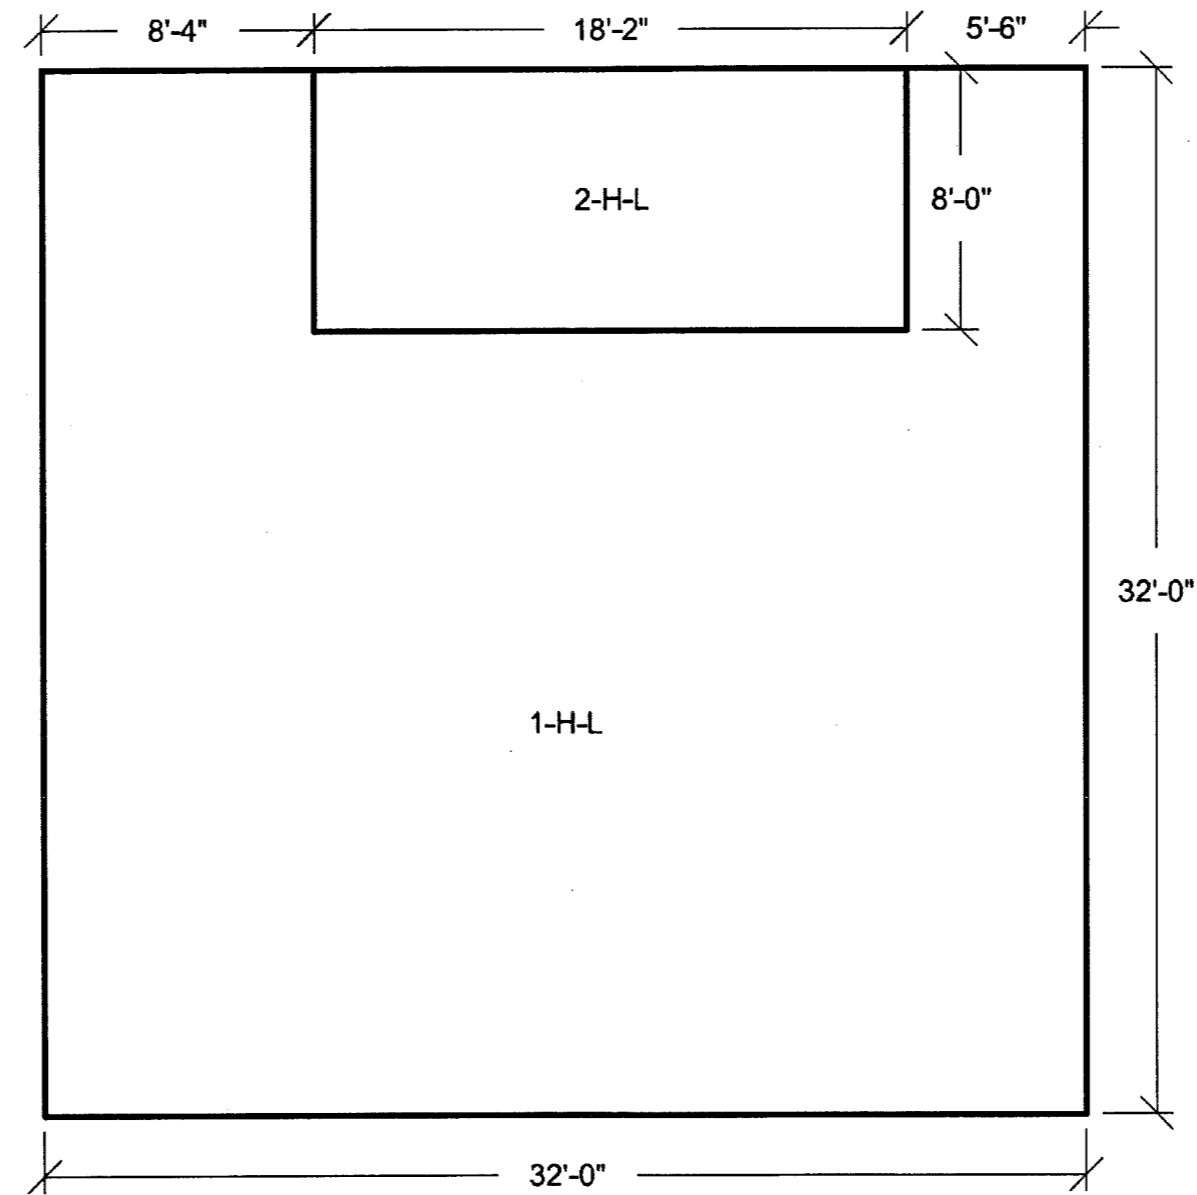


Figure 3H.6-192 Wall 13 Looking From Outside
Horizontal Reinforcement Zones
Far Side Face

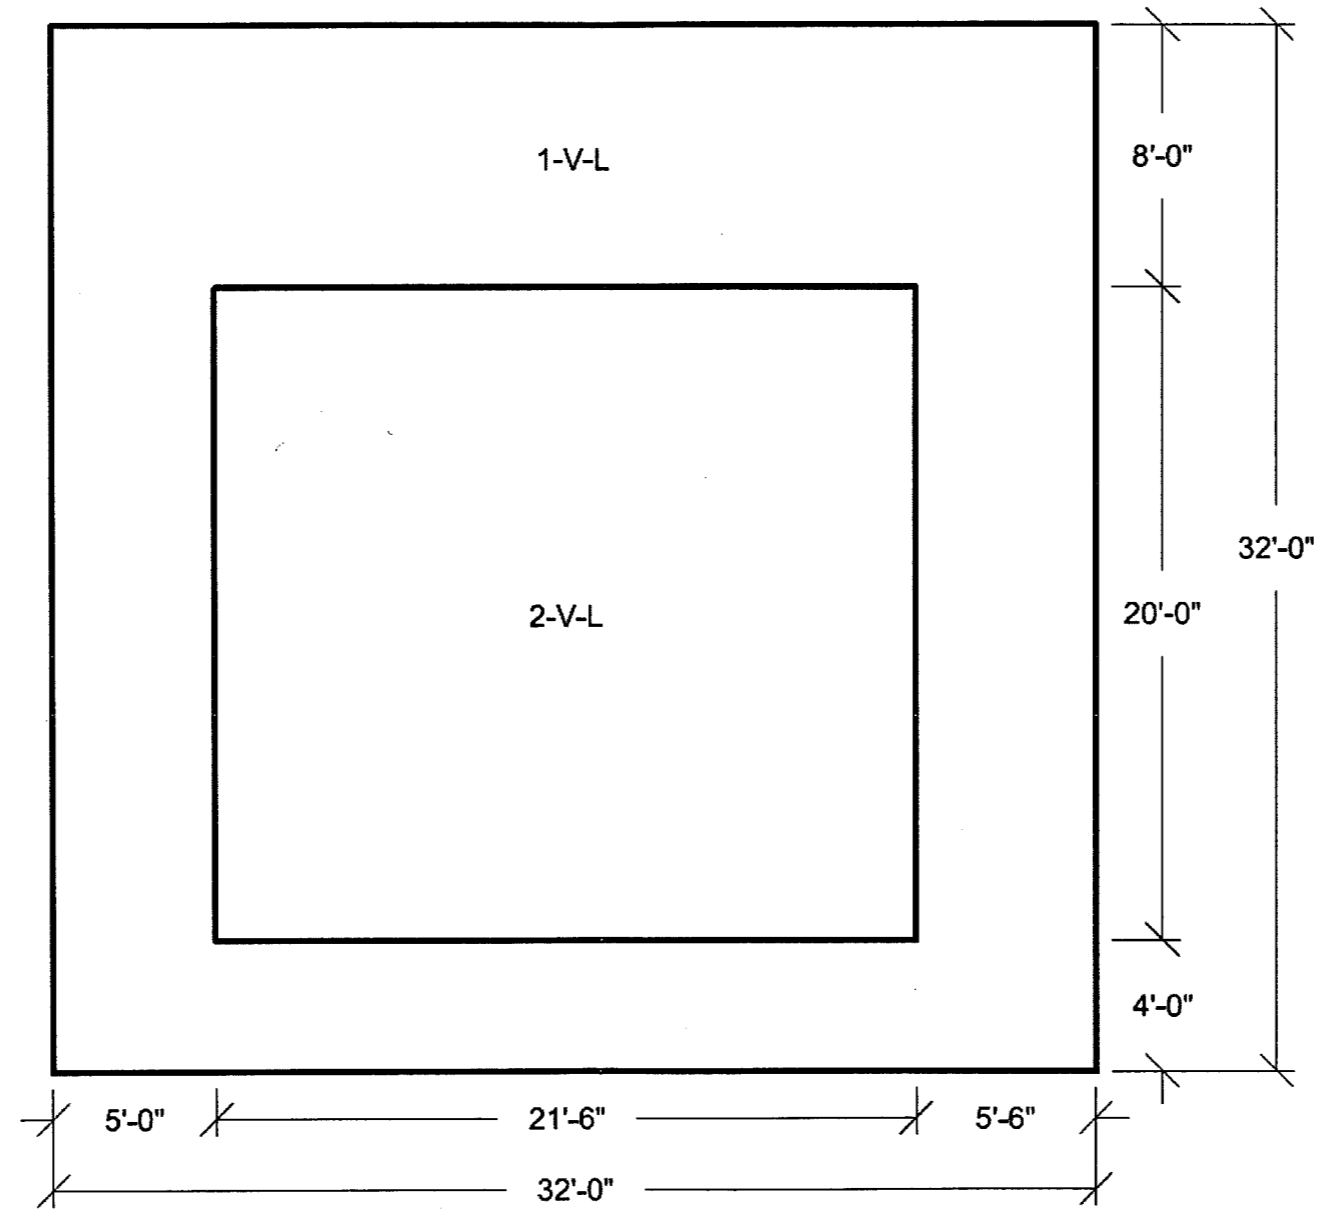


Figure 3H.6-193: Wall 13 Looking From Outside
Vertical Reinforcement Zones
Far Side Face

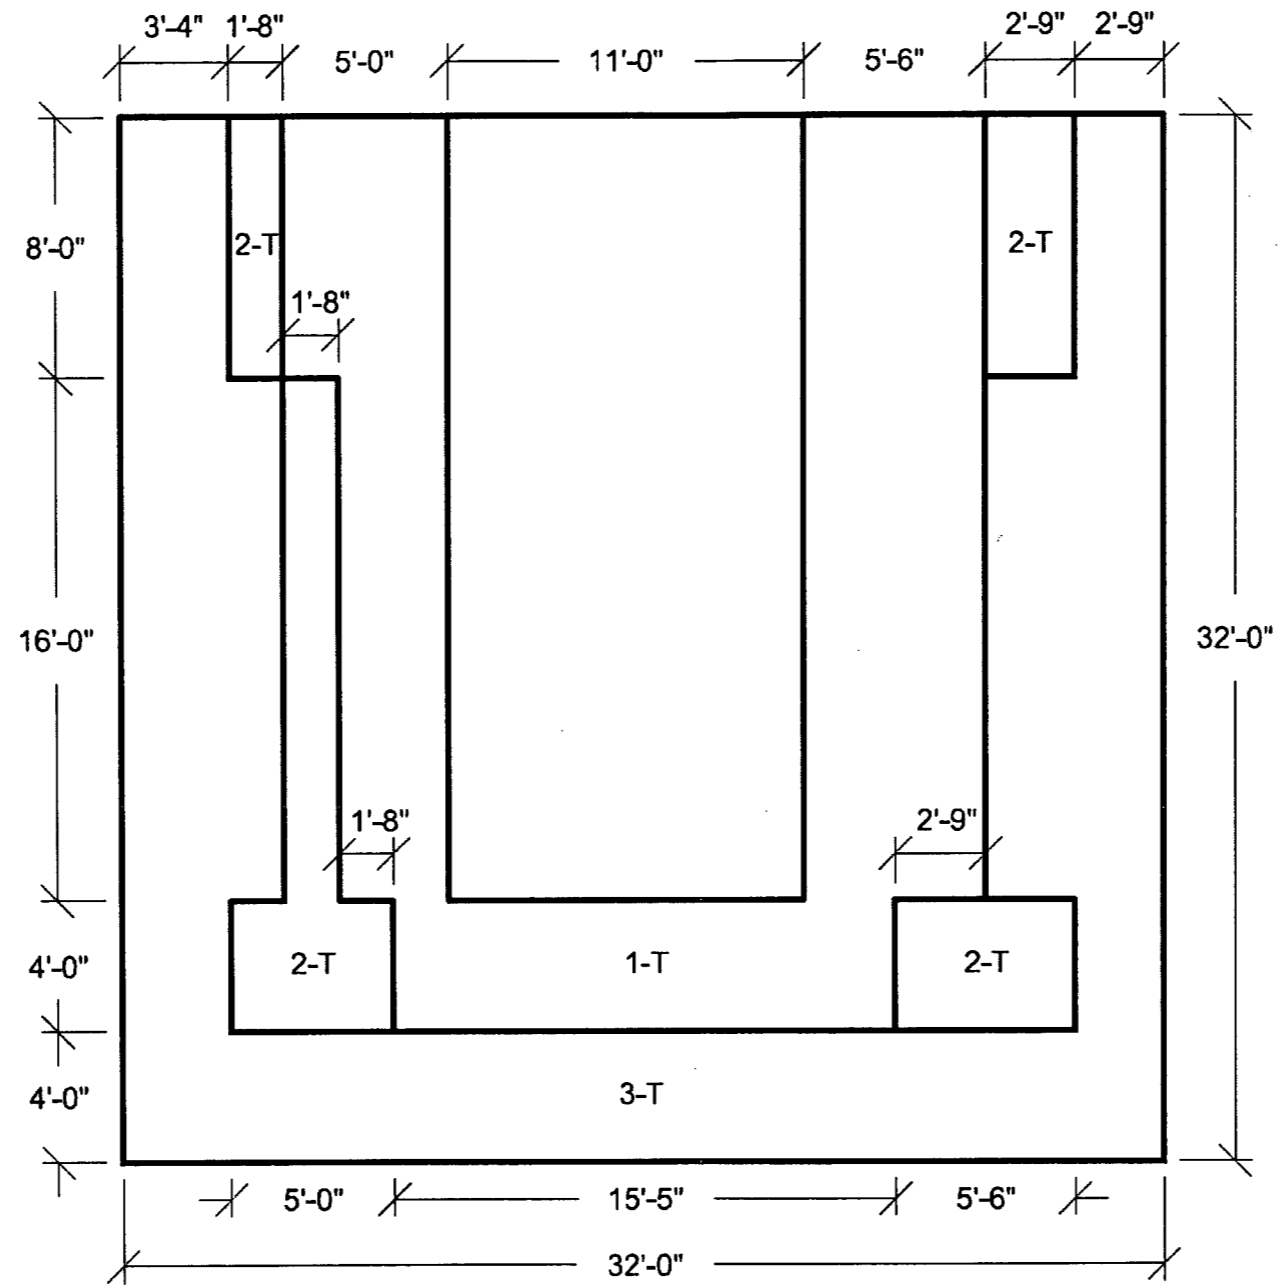


Figure 3H.6-194: Wall 13 Looking From Outside
Transverse Reinforcement Zones

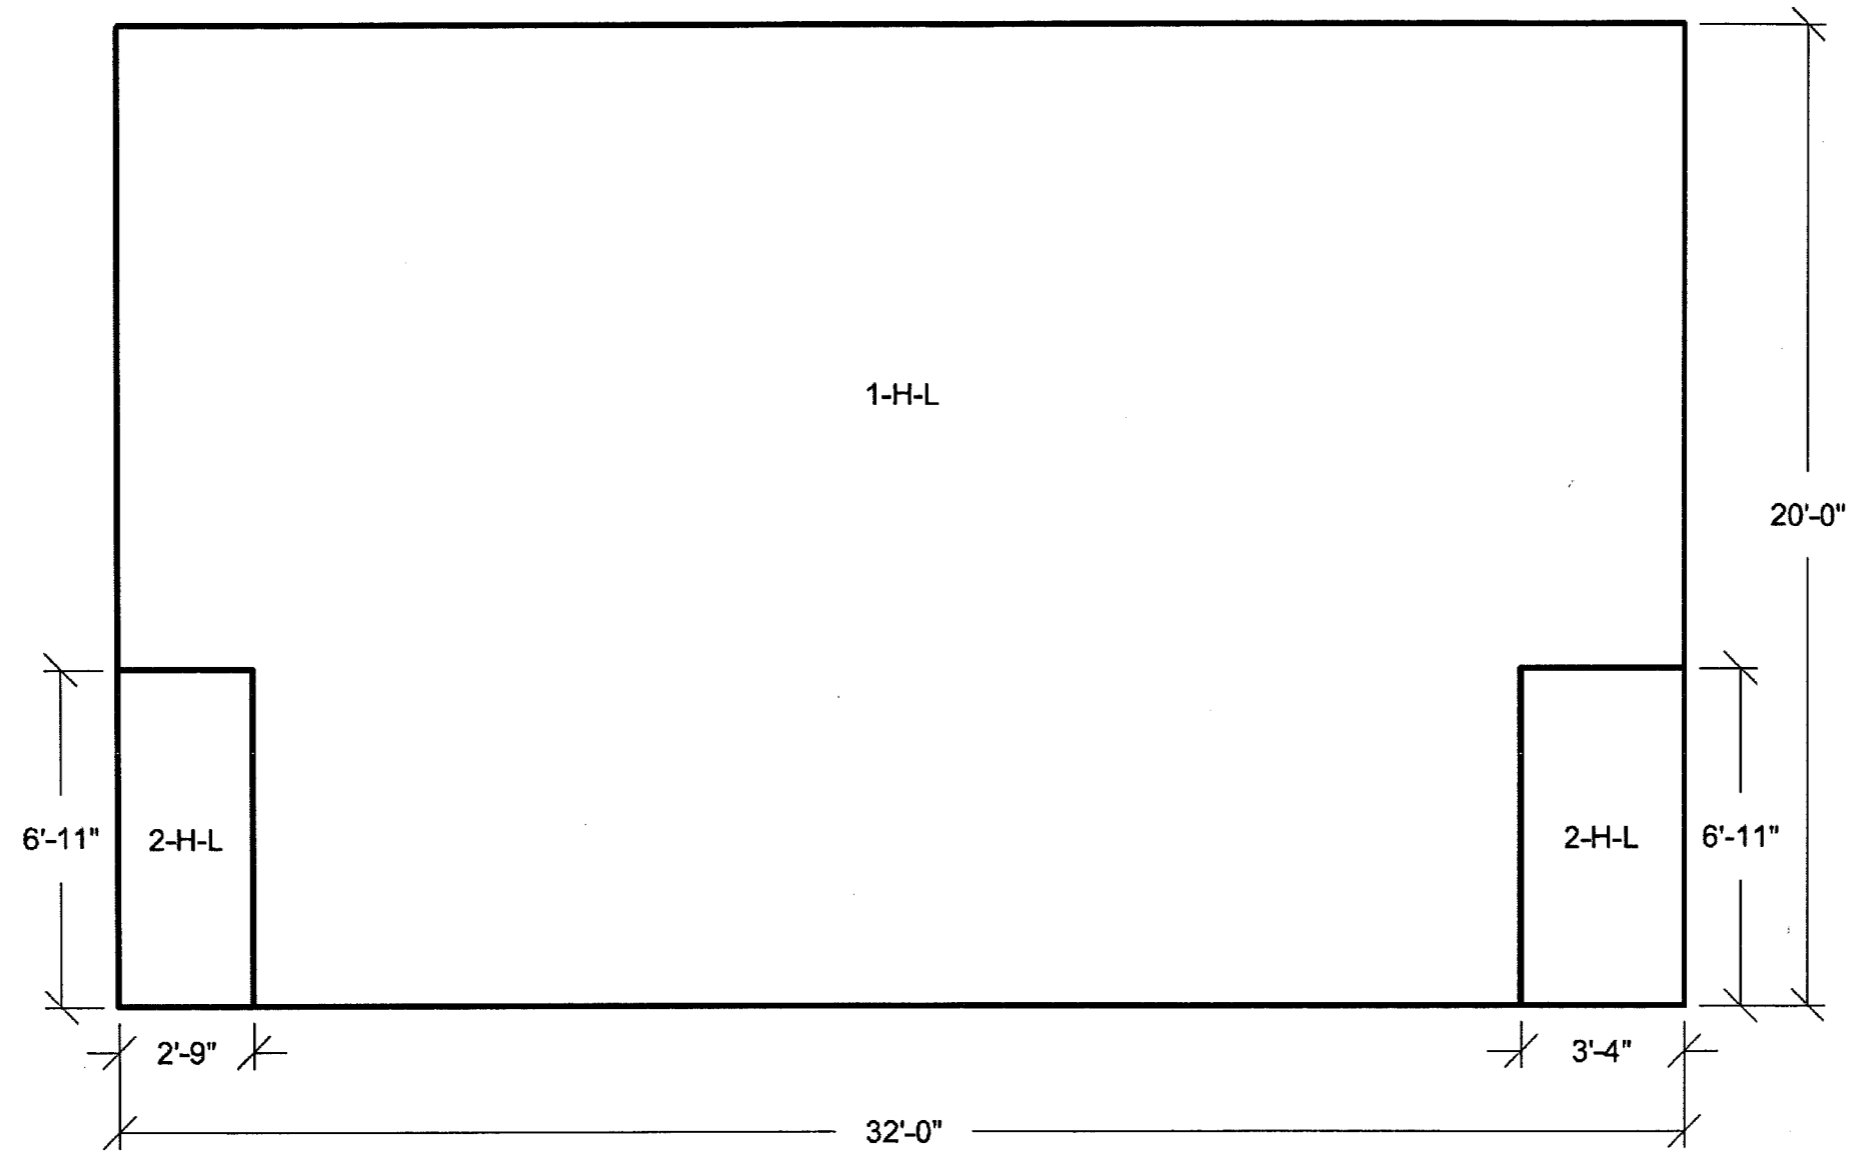


Figure 3H.6-195: Wall 14 Looking From Outside
Horizontal Reinforcement Zones
Near Side Face

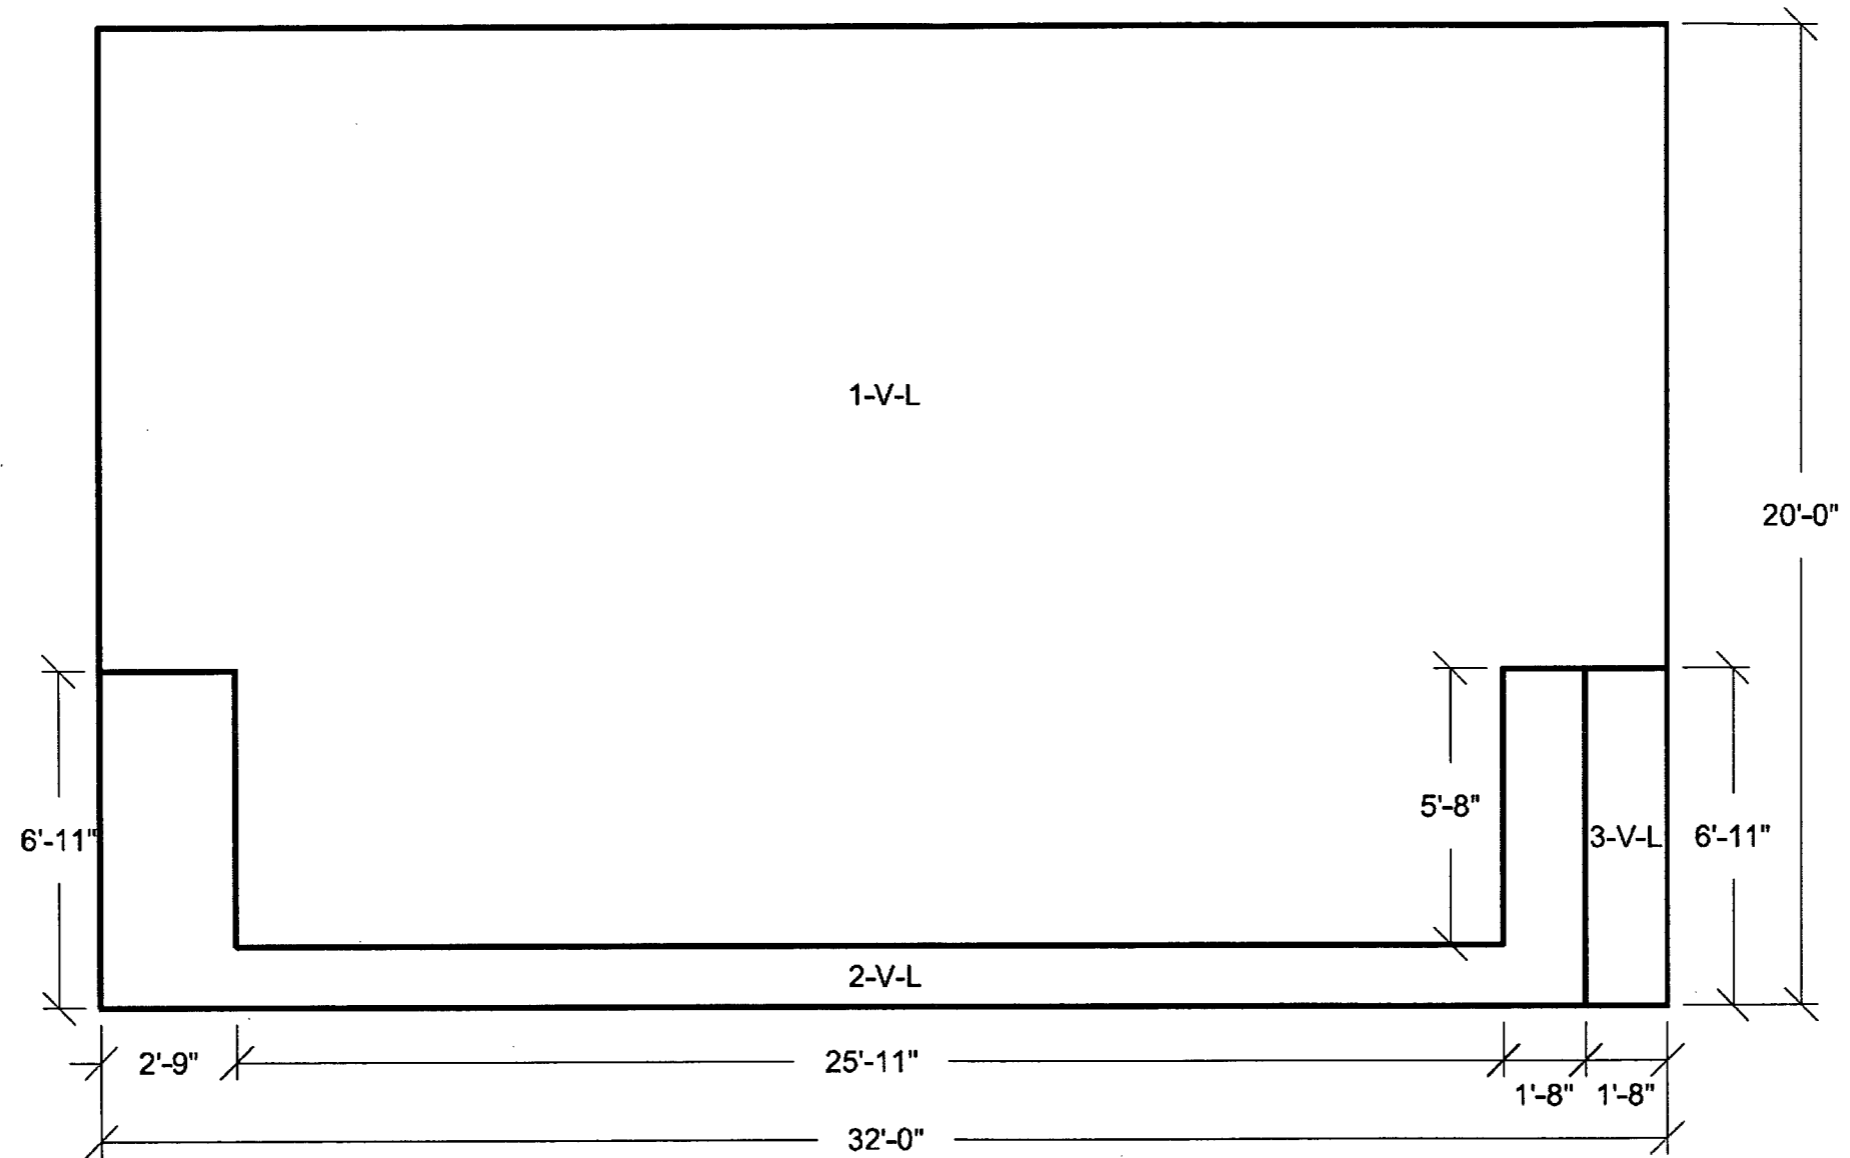


Figure 3H.6-196: Wall 14 Looking From Outside
Vertical Reinforcement Zones
Near Side Face

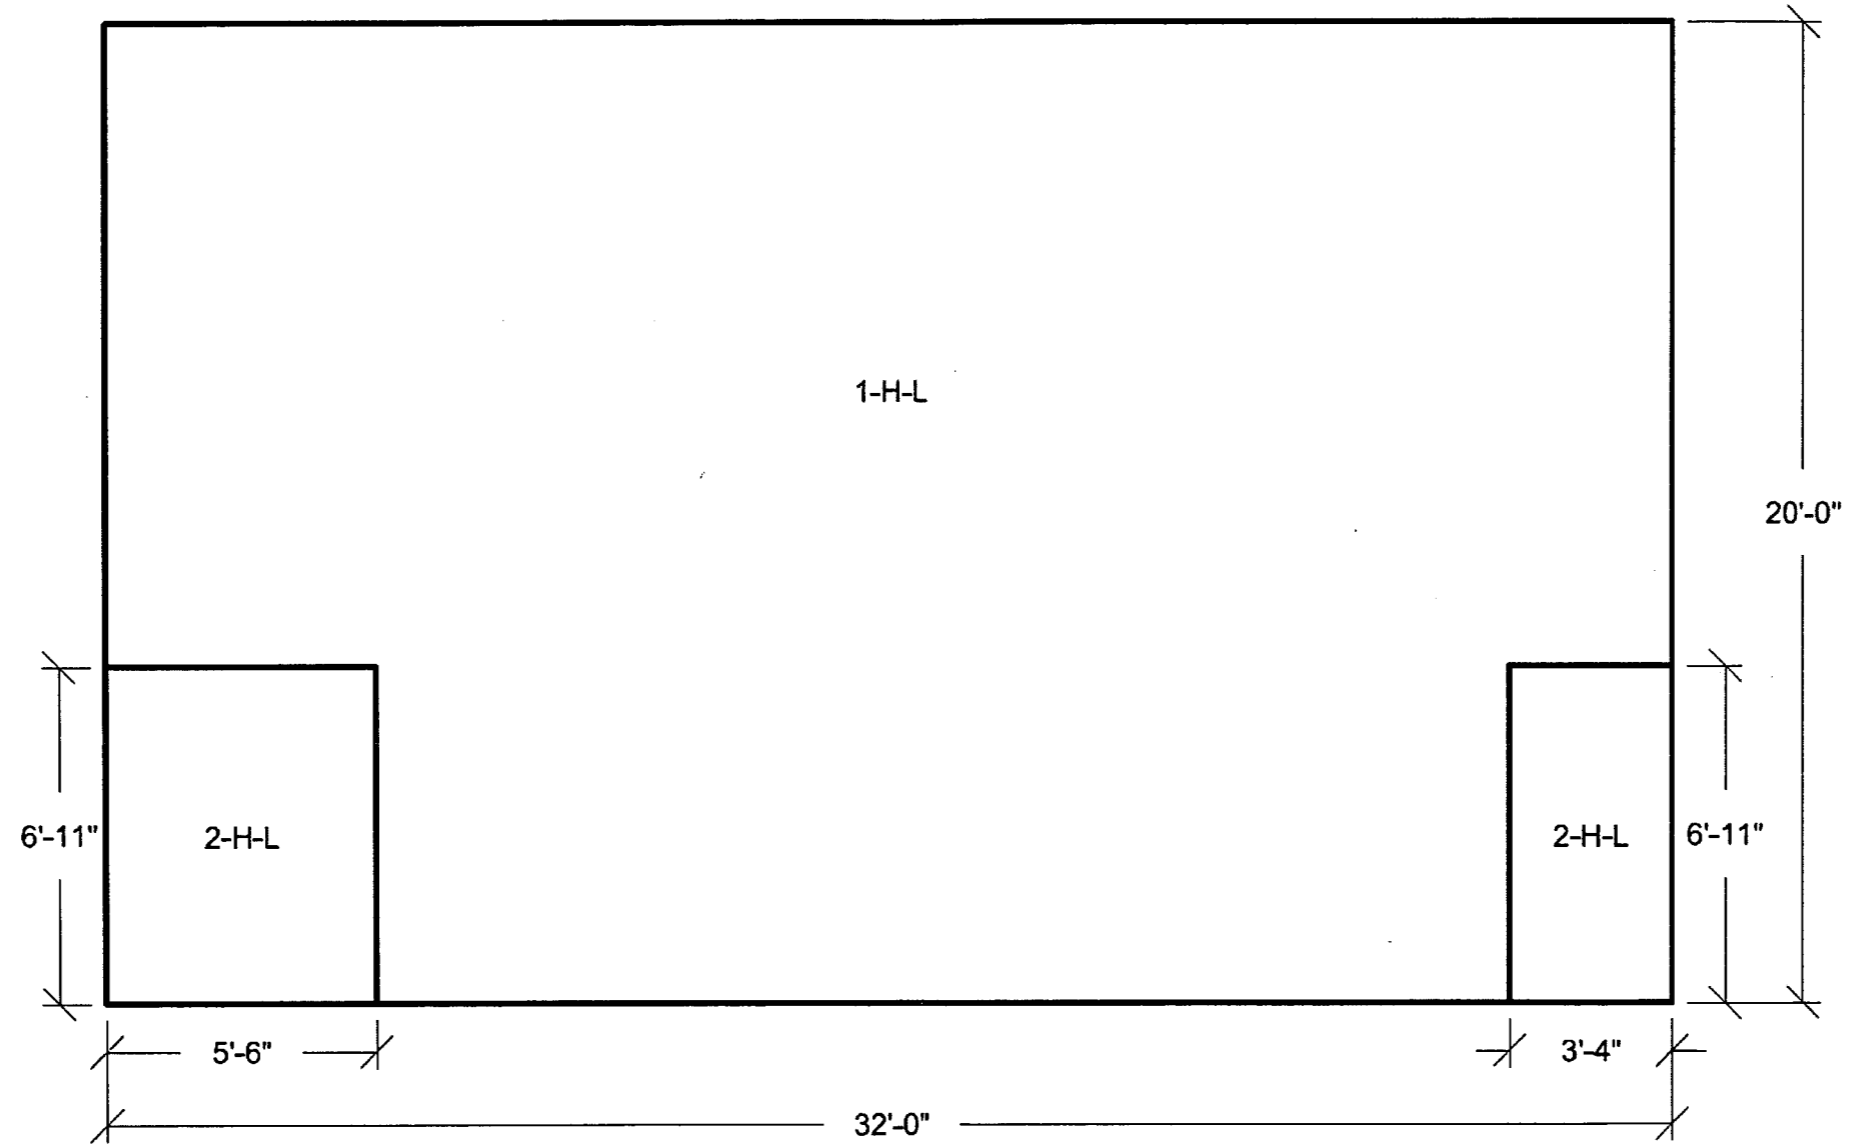


Figure 3H.6-197: Wall 14 Looking From Outside
Horizontal Reinforcement Zones
Far Side Face

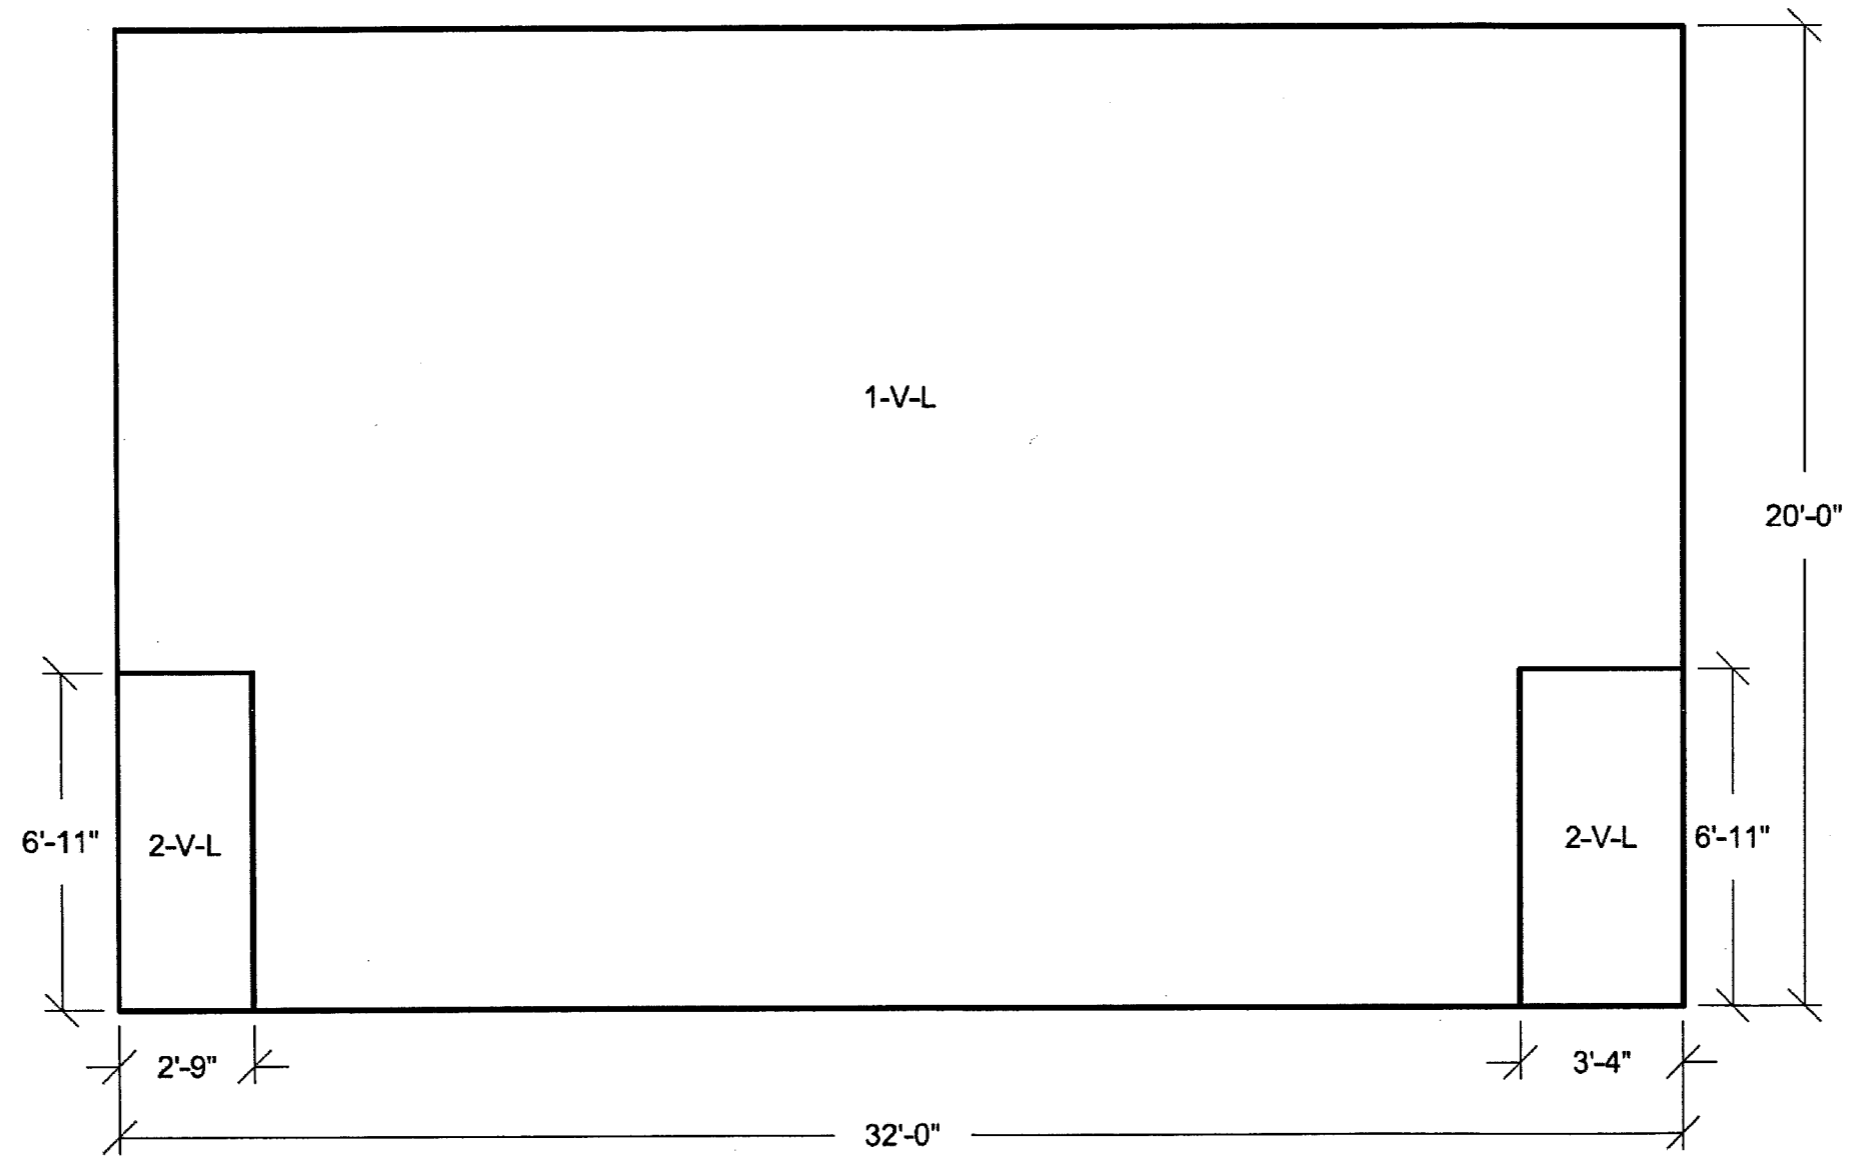


Figure 3H.6-198: Wall 14 Looking From Outside
Vertical Reinforcement Zones
Far Side Face

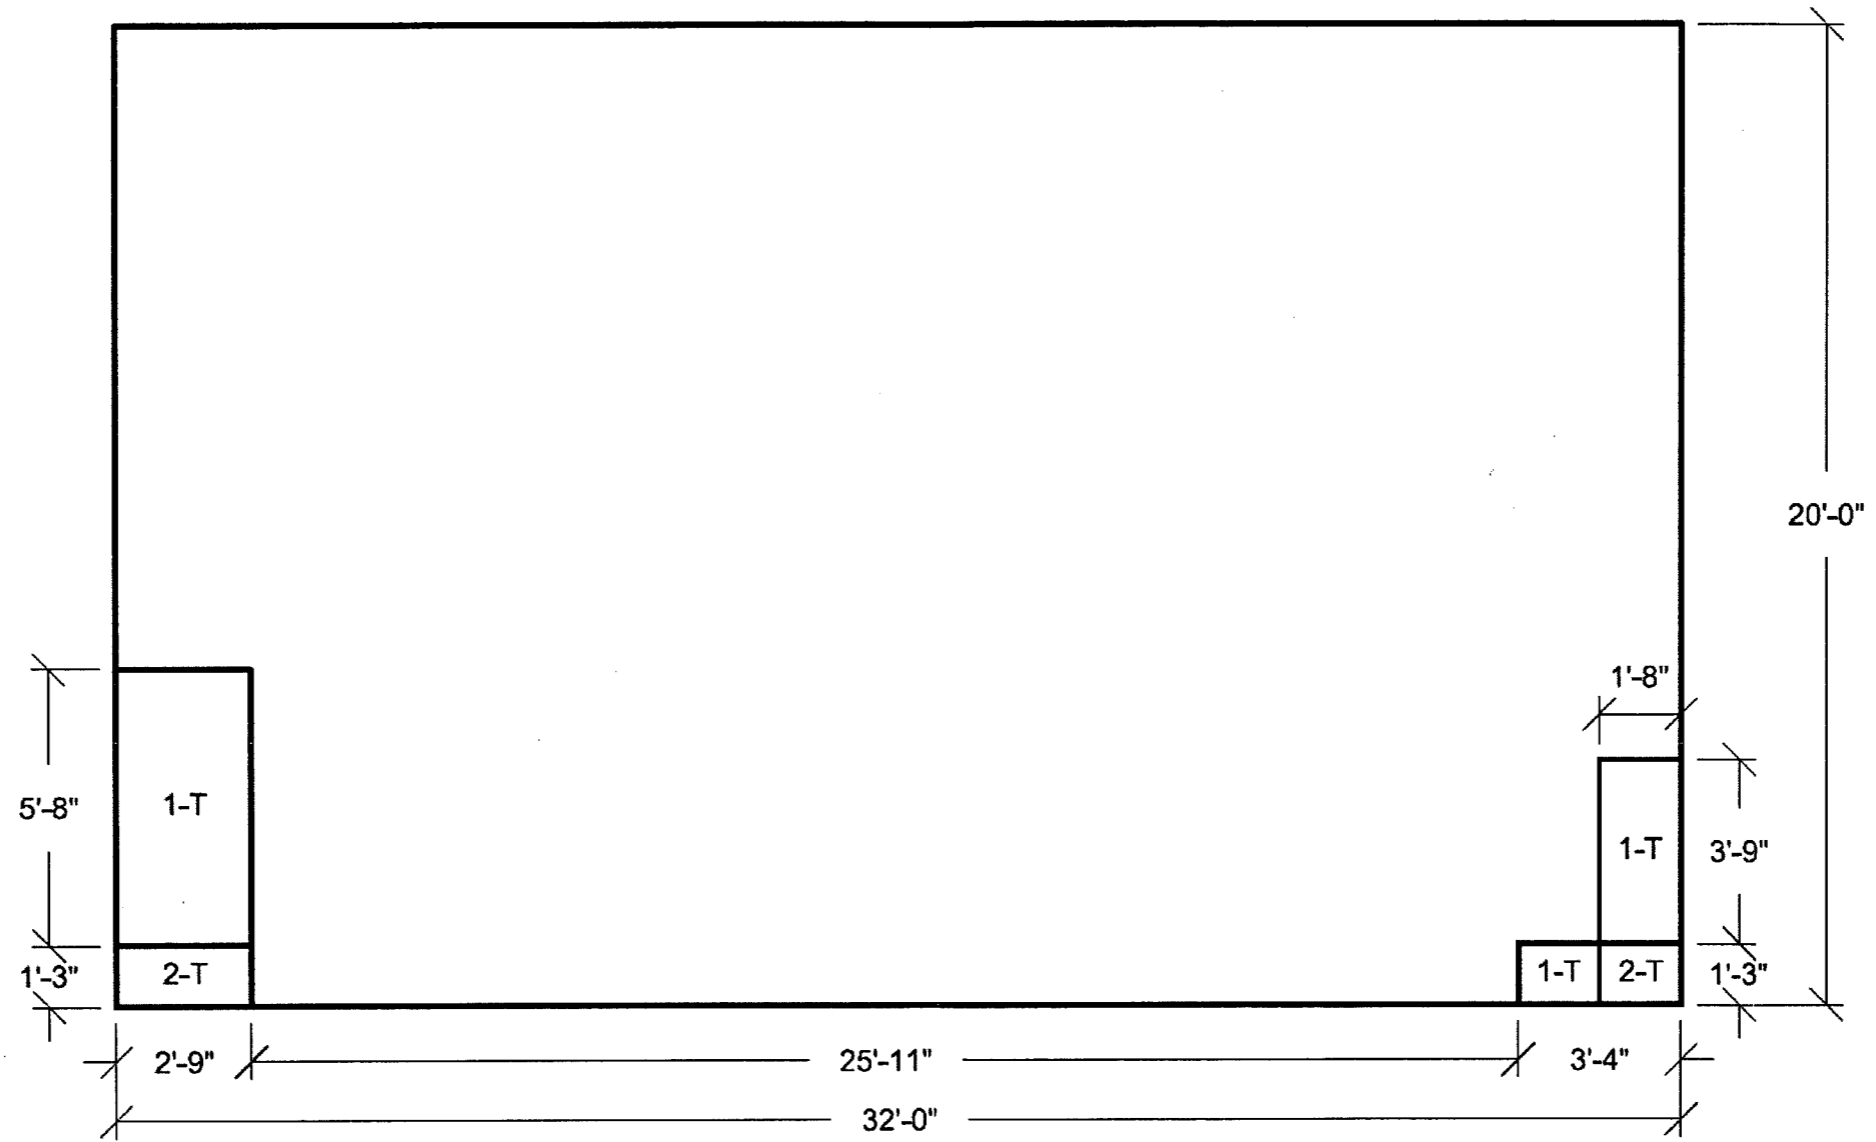


Figure 3H.6-199: Wall 14 Looking From Outside
Transverse Reinforcement Zones

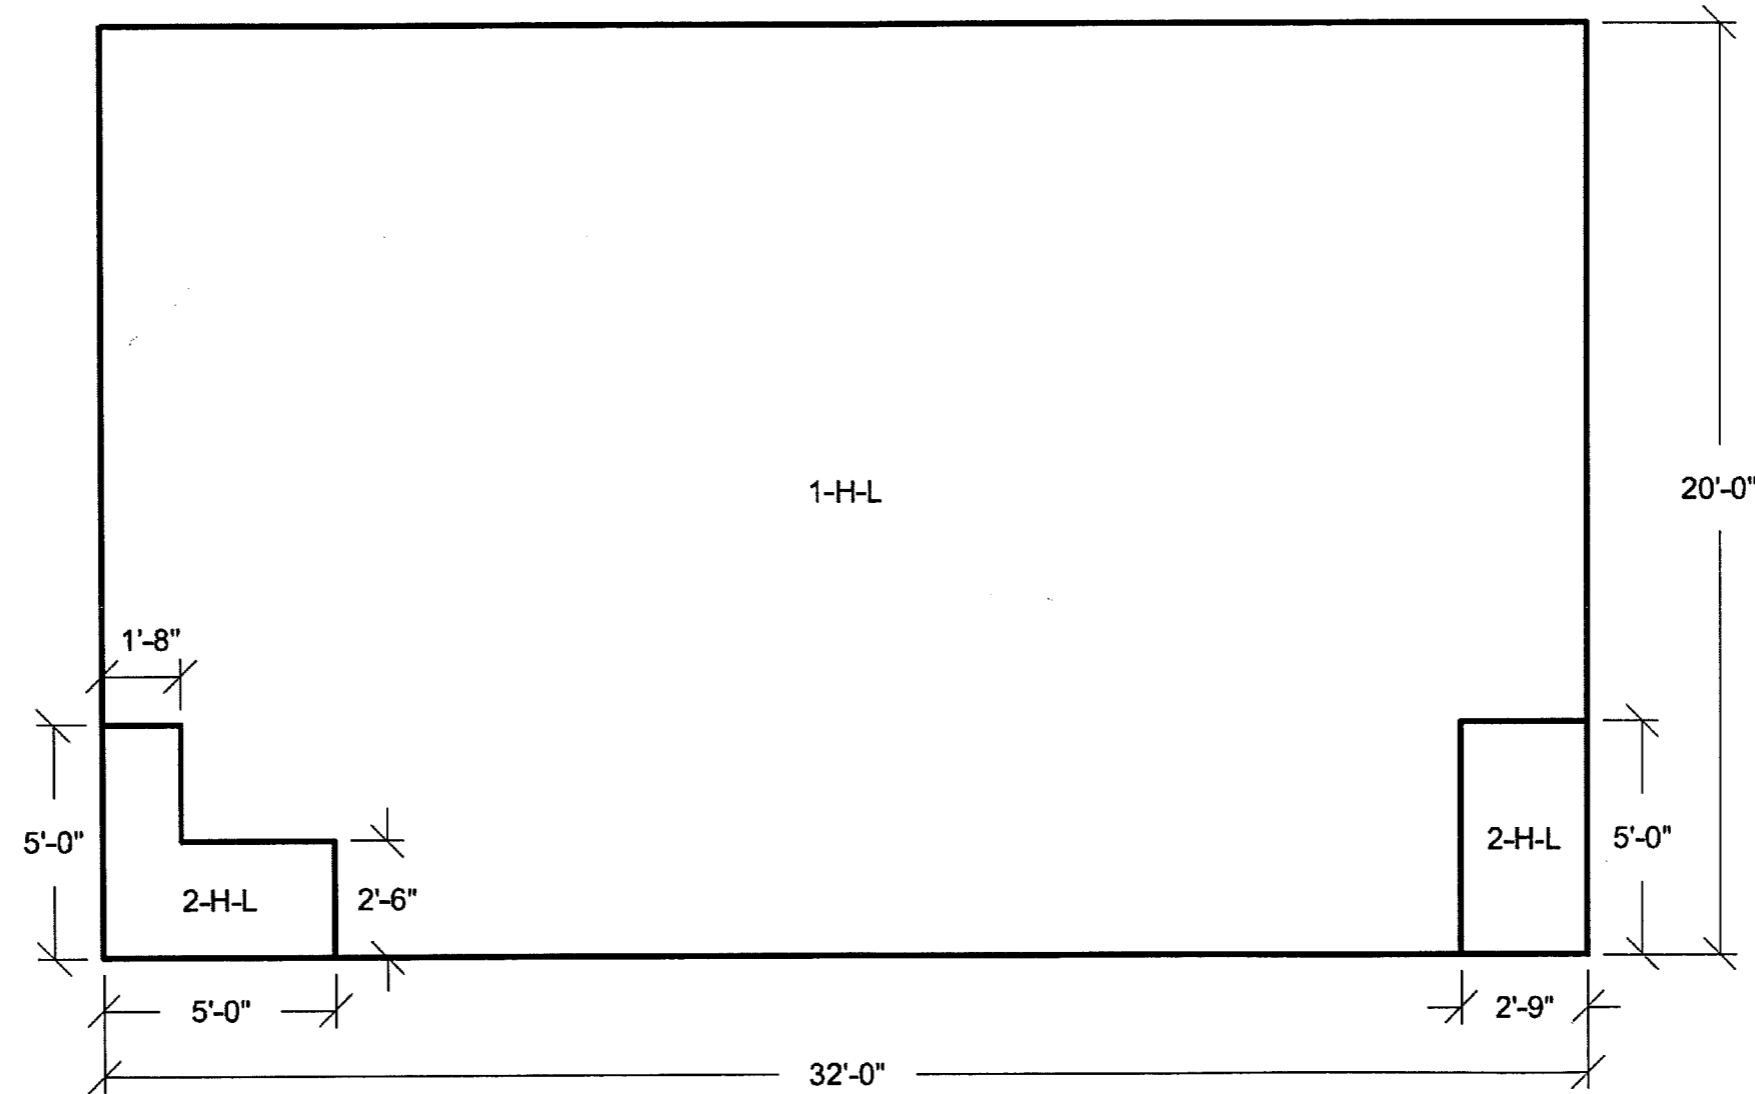


Figure 3H.6-200: Wall 15 Looking From Outside
Horizontal Reinforcement Zones
Near Side Face

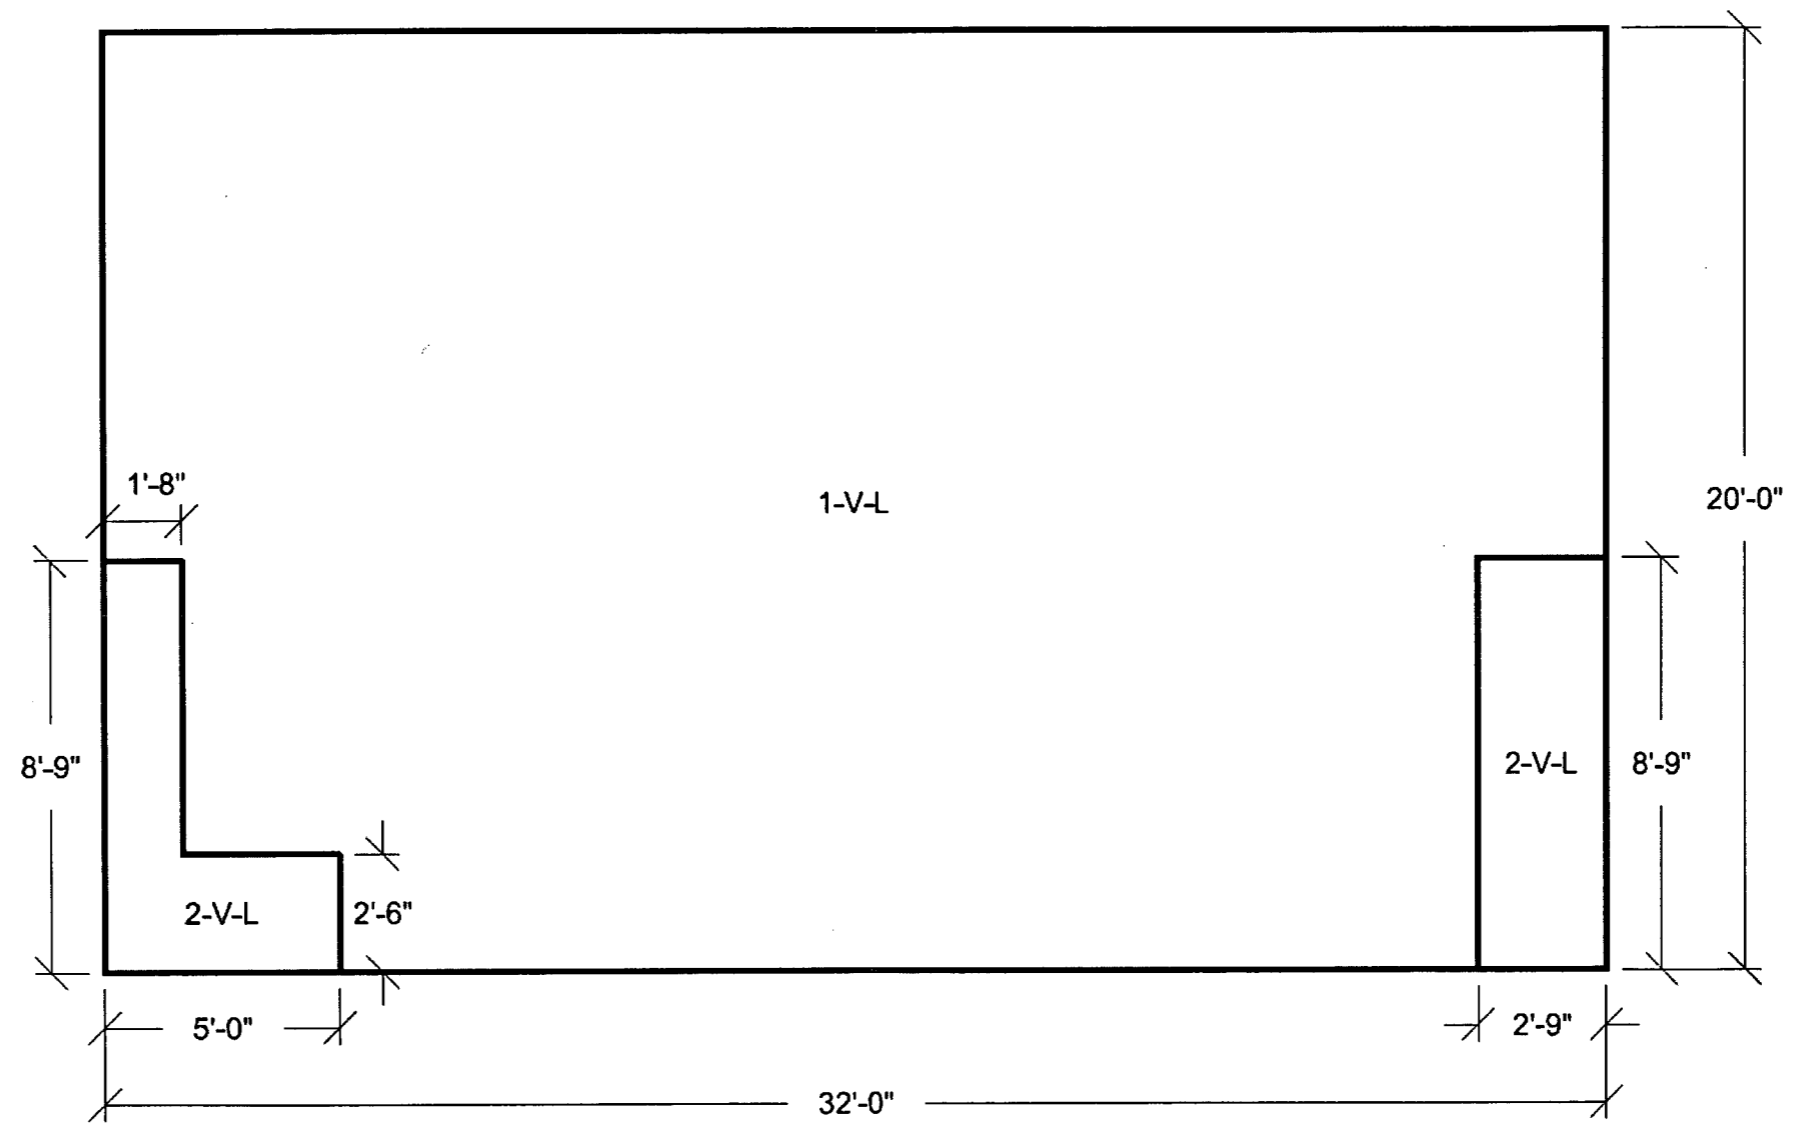


Figure 3H.6-201: Wall 15 Looking From Outside

Vertical Reinforcement Zones

Near Side Face

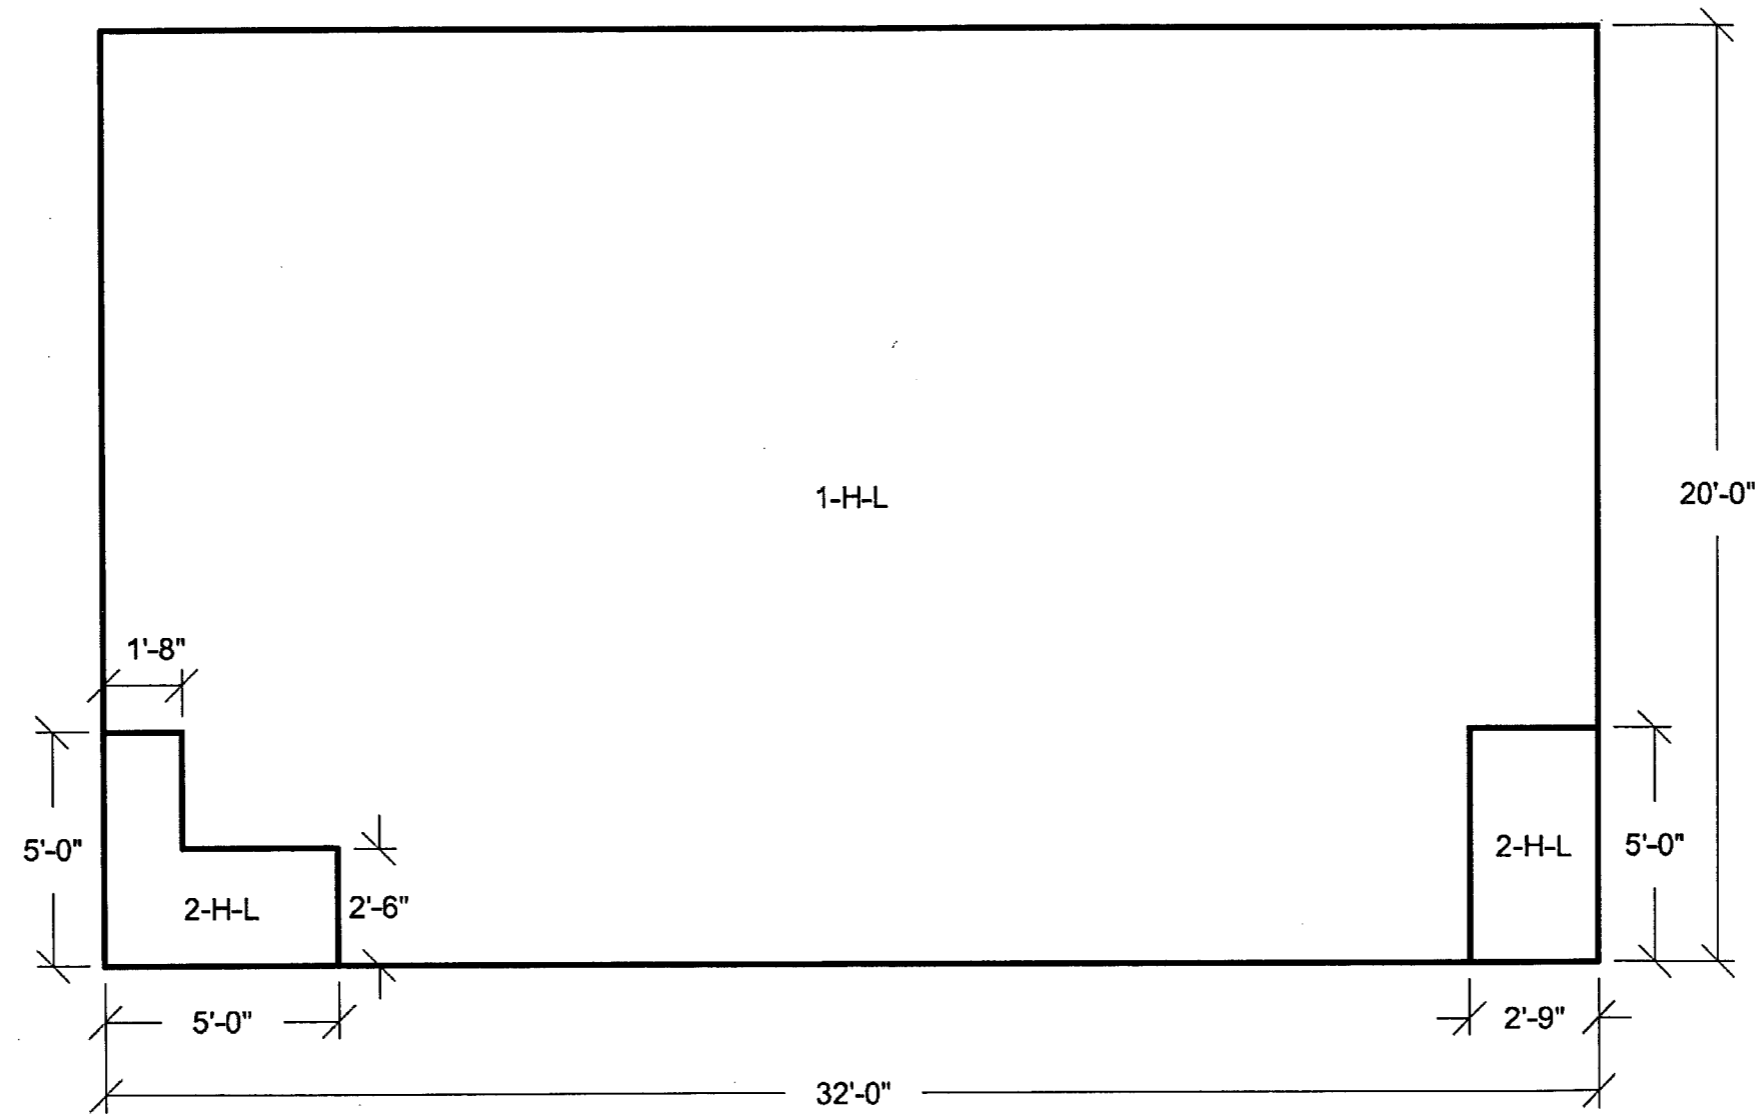


Figure 3H.6-202: Wall 15 Looking From Outside
Horizontal Reinforcement Zones
Far Side Face

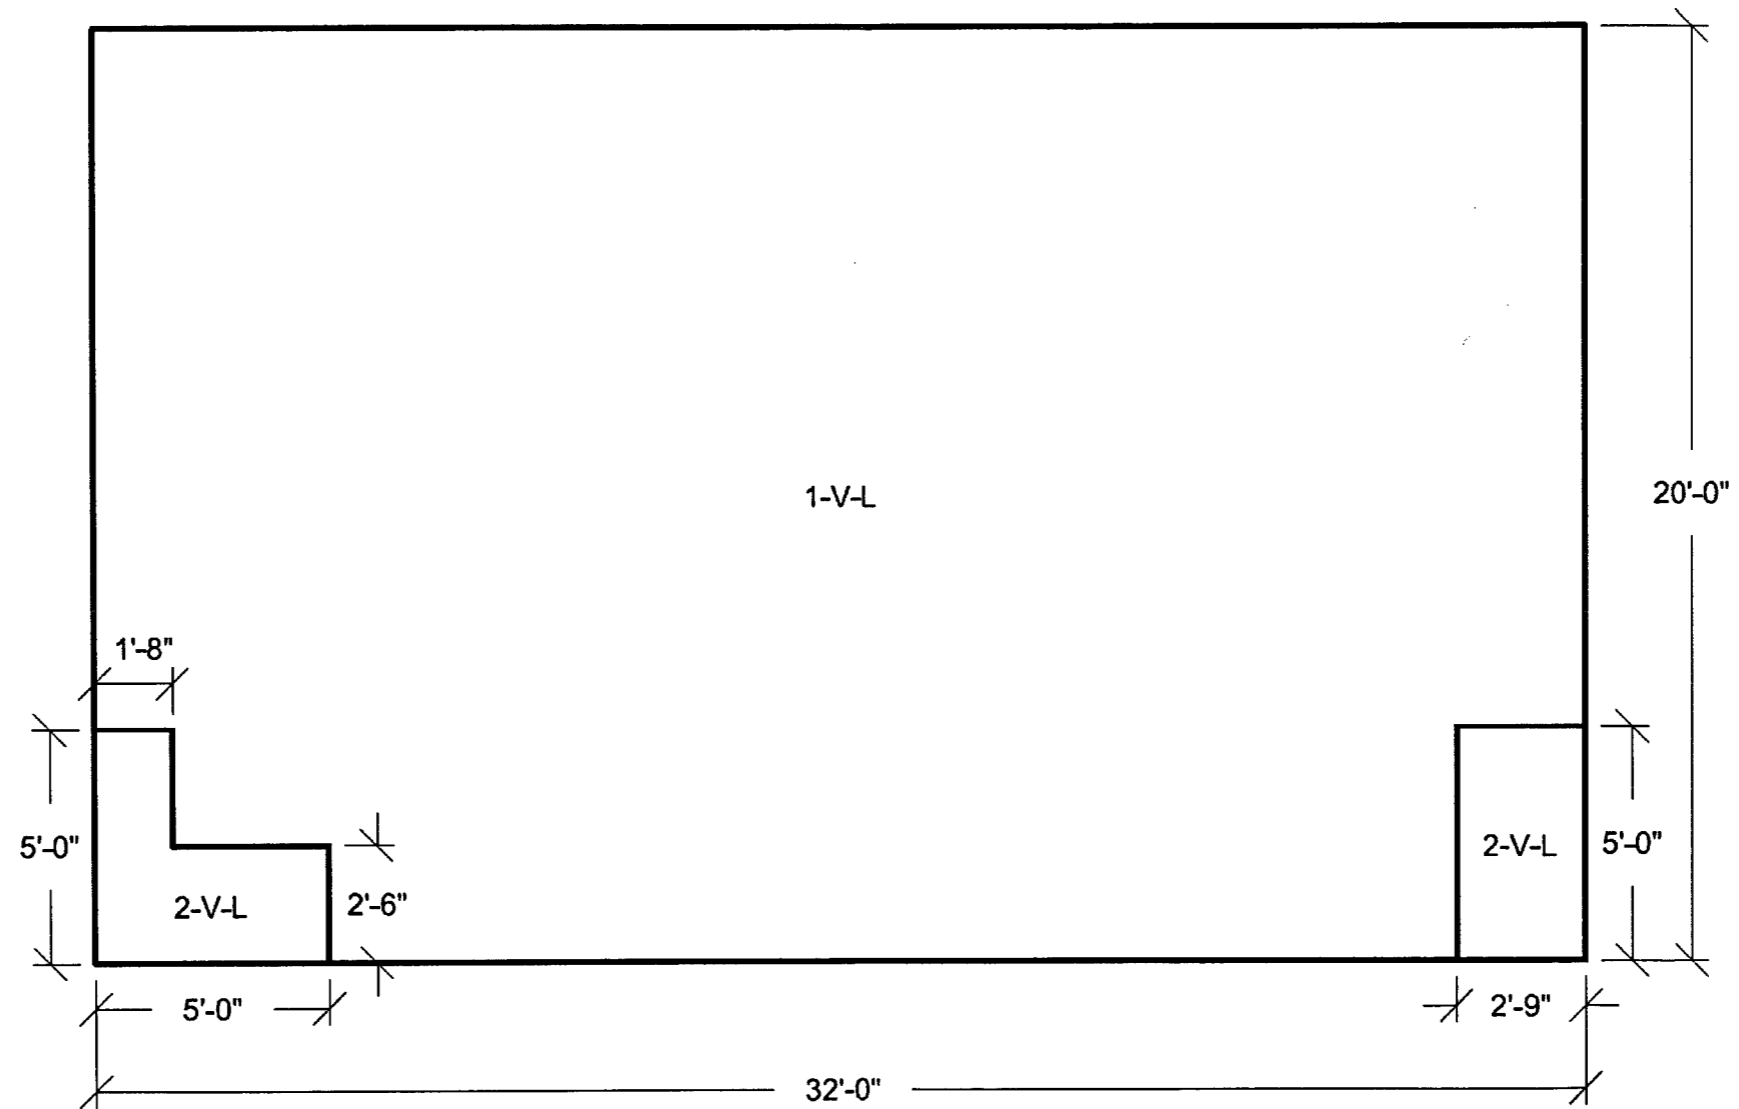


Figure 3H.6-203A: Wall 15 Looking From Outside
Vertical Reinforcement Zones
Far Side Face

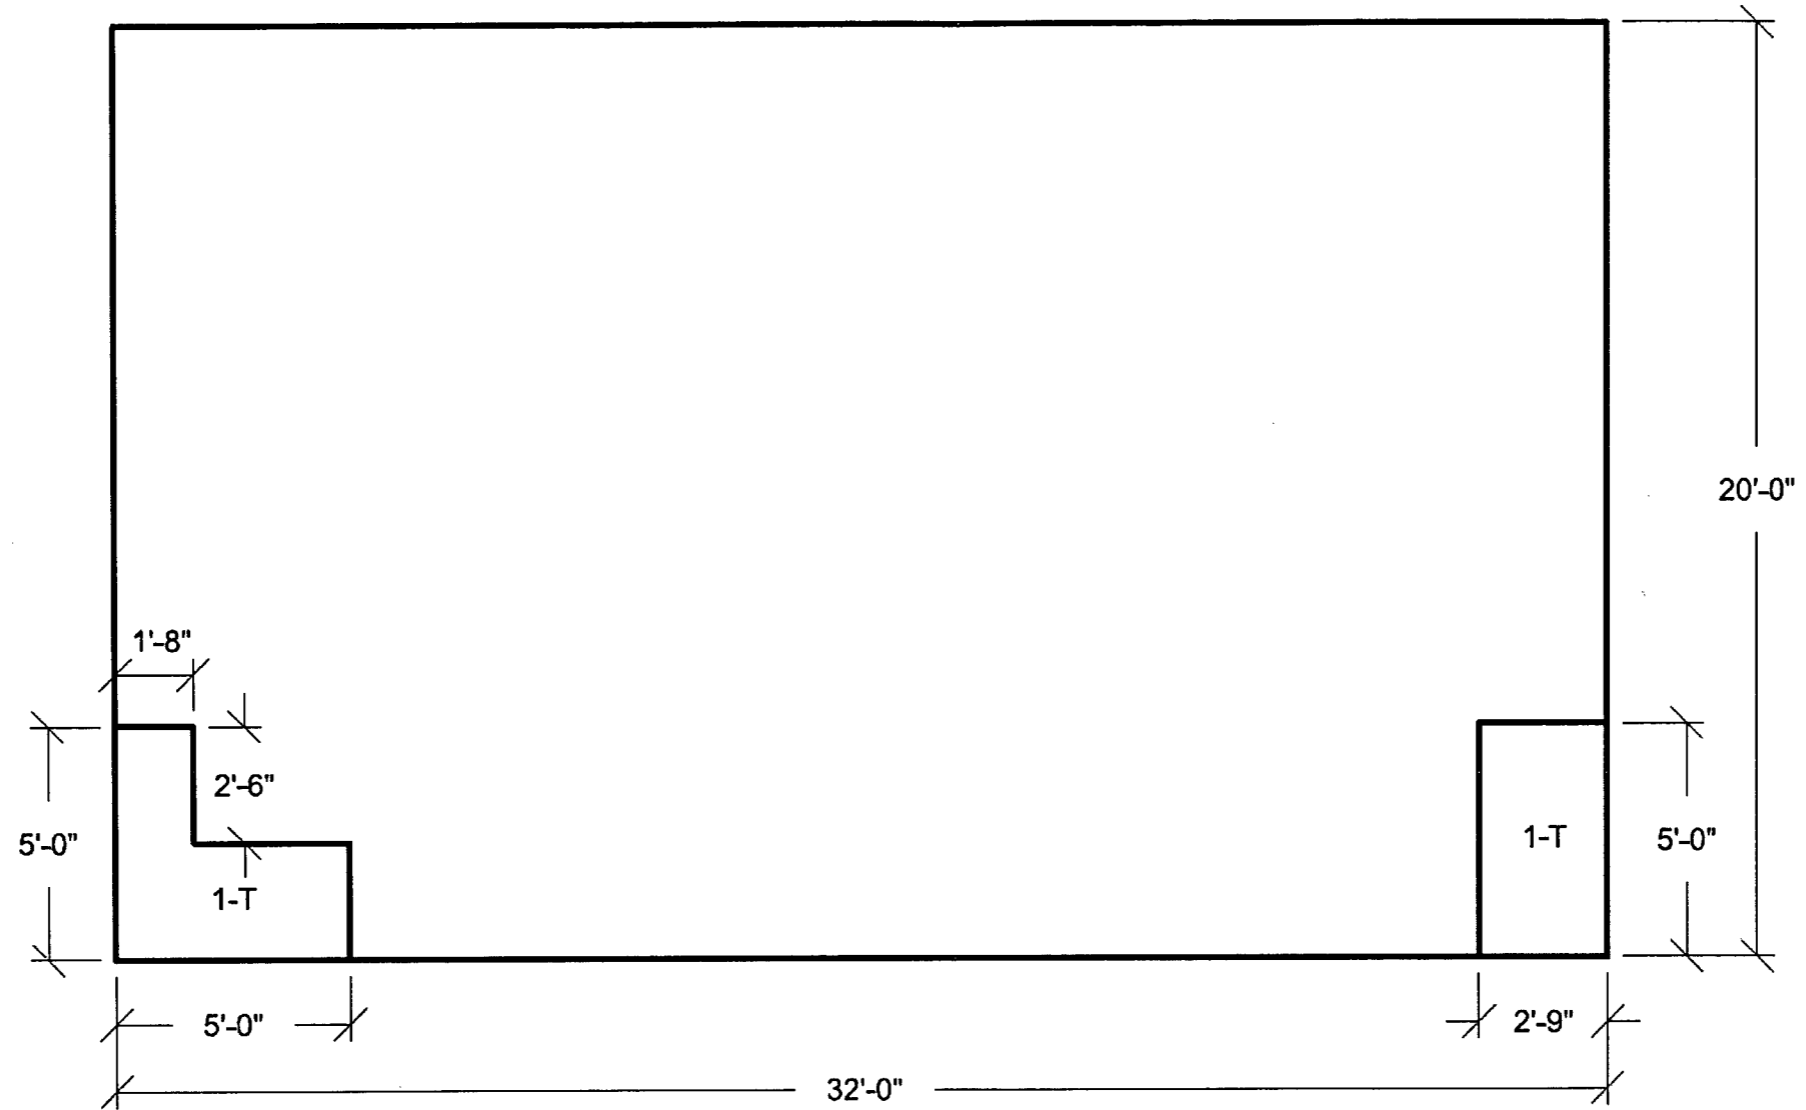


Figure 3H.6-203B: Wall 15 Looking From Outside
Transverse Reinforcement Zones

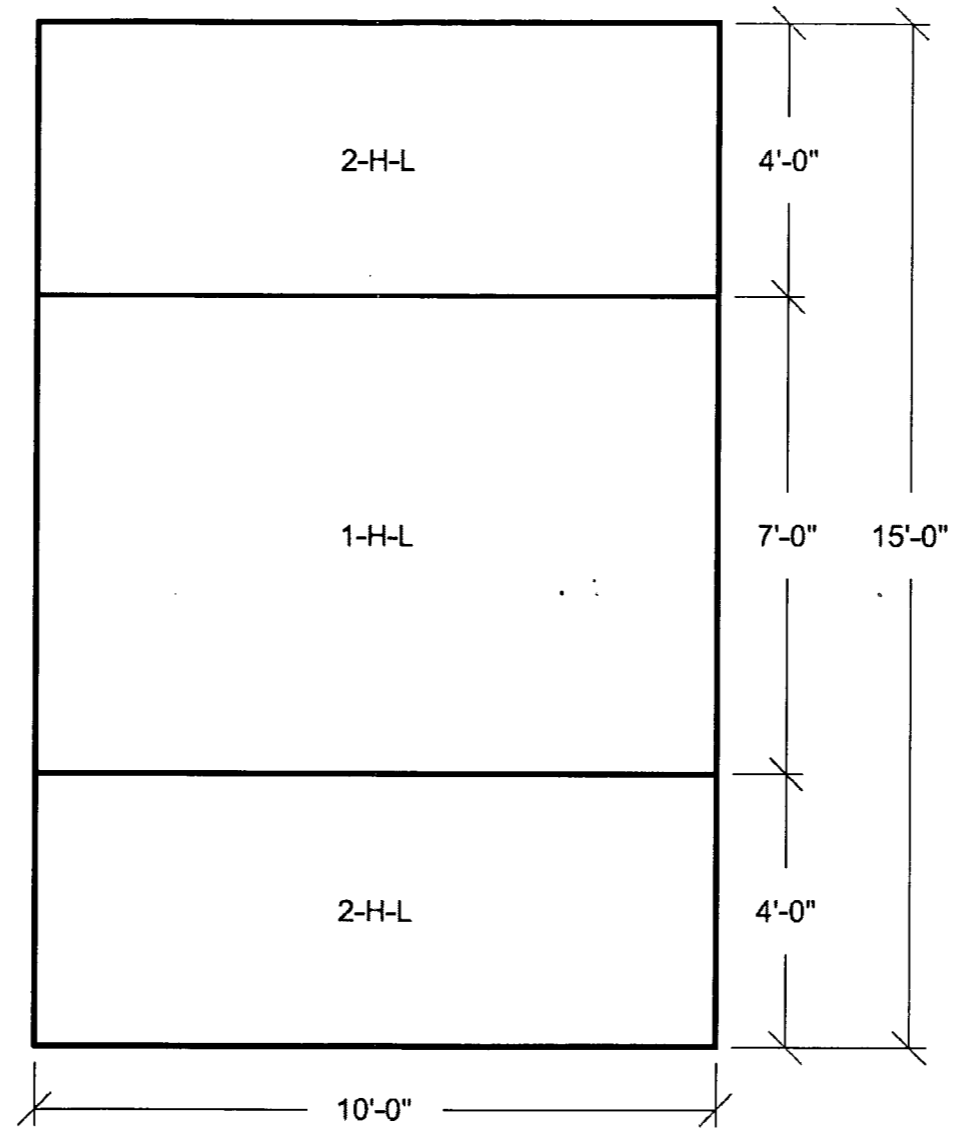


Figure 3H.6-204: Wall 16 Looking From Outside
Horizontal Reinforcement Zones
Near Side Face

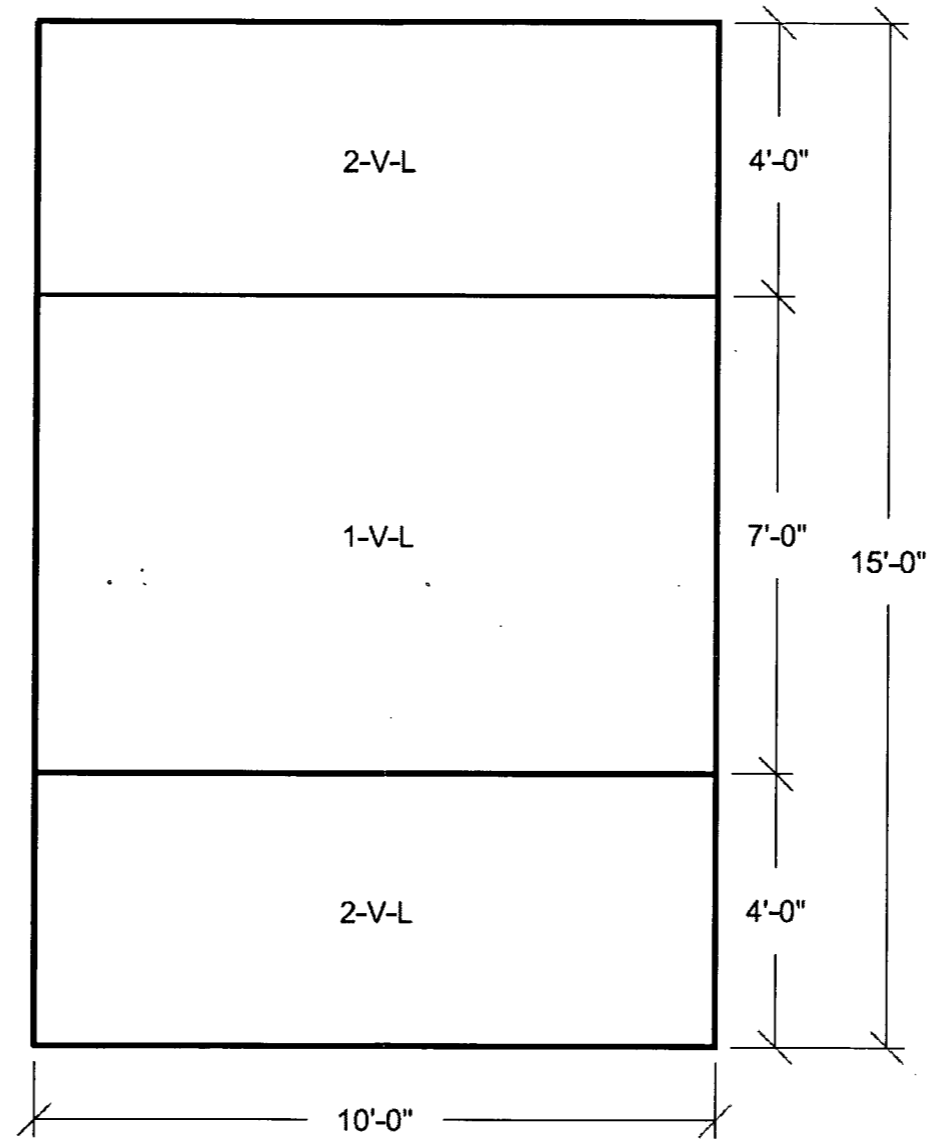


Figure 3H.6-205: Wall 16 Looking From Outside
Vertical Reinforcement Zones
Near Side Face

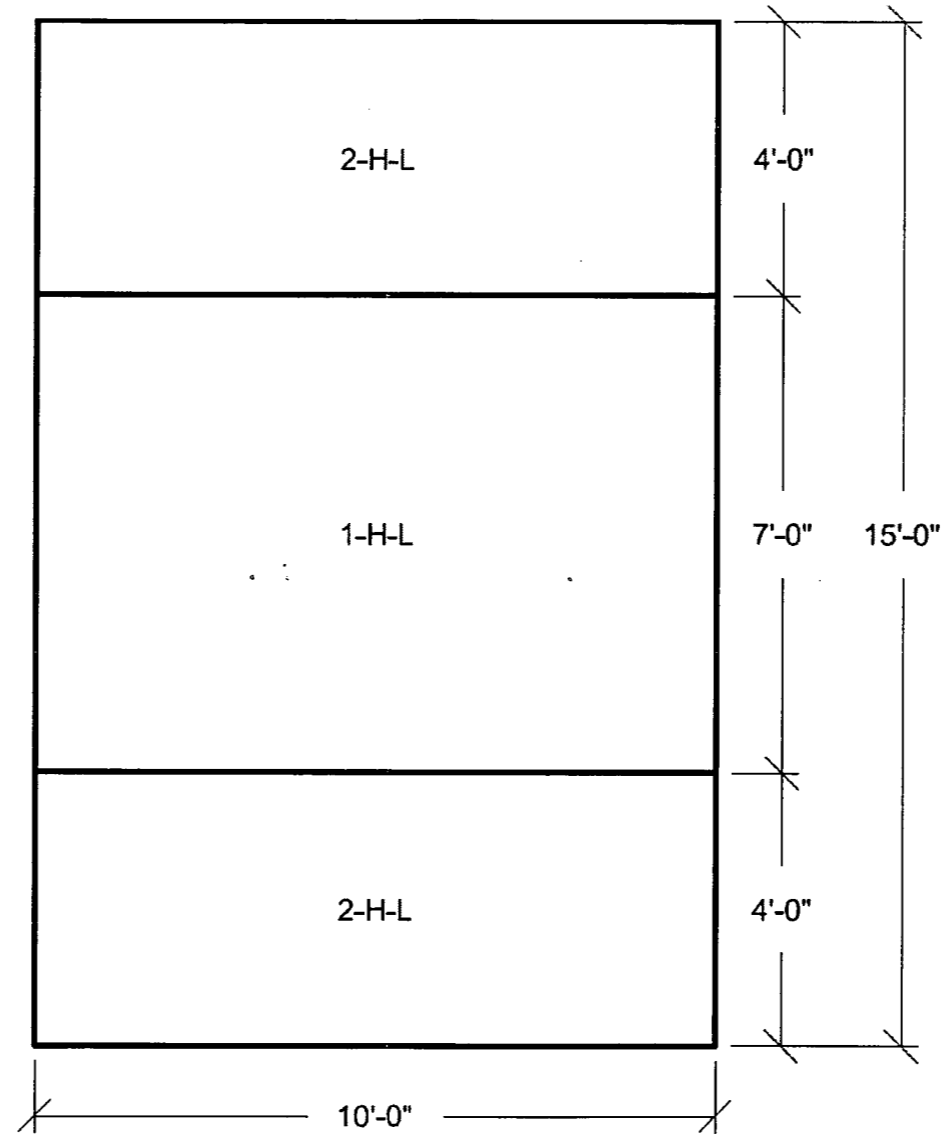


Figure 3H.6-206: Wall 16 Looking From Outside
Horizontal Reinforcement Zones
Far Side Face

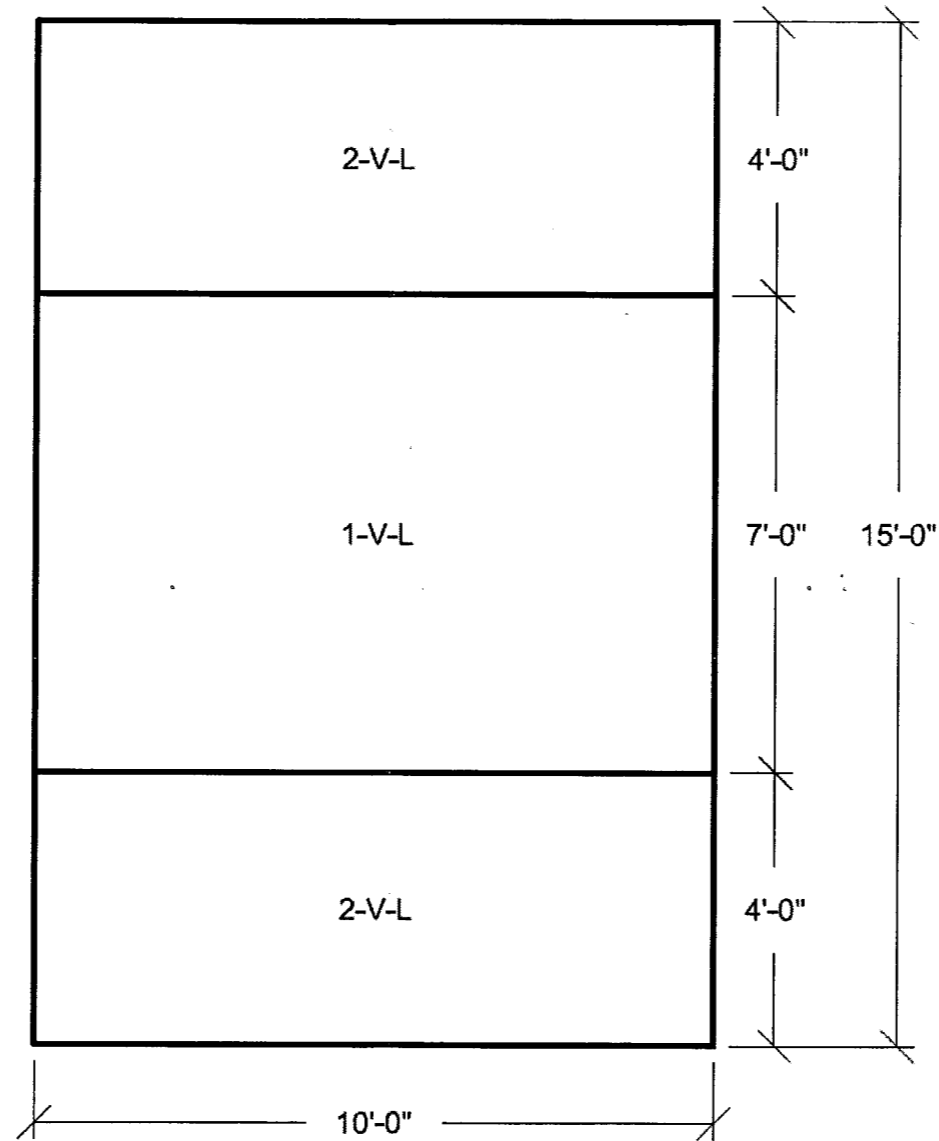


Figure 3H.6-207: Wall 16 Looking From Outside
Vertical Reinforcement Zones
Far Side Face

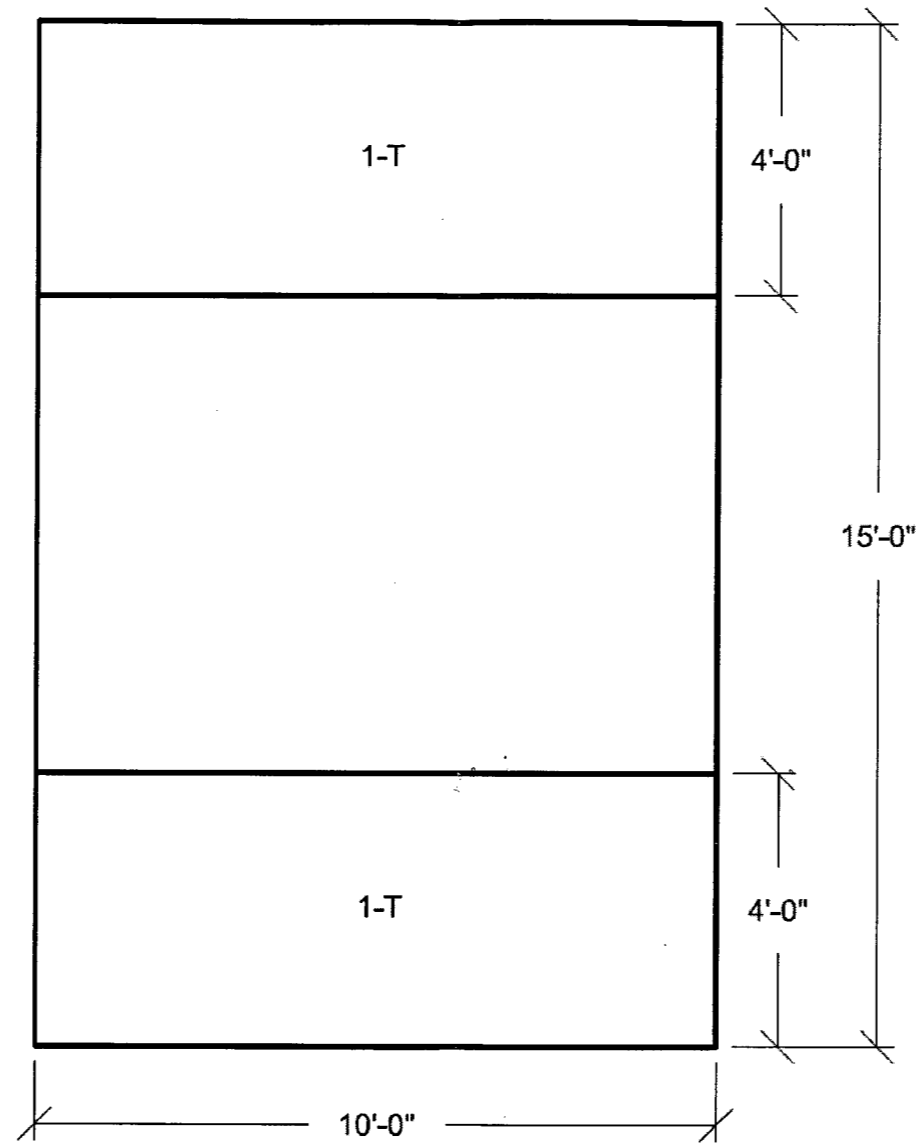


Figure 3H.6-208: Wall 16 Looking From Outside
Transverse Reinforcement Zones