


FOR REFERENCE SEE CIVIL DWGS.

- C-0036A SANITARY SEWER REV. 3
- C-0036B SANITARY SEWER REV. 3
- C-0036C SANITARY SEWER REV. 4
- C-0037D SEWAGE TREATMENT PLANT REV. 2

NOTES:

1. ALL EQUIPMENT NUMBERS ON THIS DRAWING ARE PREFIXED BY NSY70 UNLESS OTHERWISE NOTED.
2. ALL INSTRUMENT NUMBERS ON THIS DRAWING ARE PREFIXED BY SY70 UNLESS OTHERWISE NOTED.
3. CHECK VALVES TO HAVE OUTSIDE LEVER WITH EXTERIOR COUNTERWEIGHT.
4. ALL PIPING 2" AND SMALLER IS CLASSIFIED AS A III-"A" RADIATION LEVEL.
5. FOR EXPLANATION OF DRAINAGE PIPING NOTATION SEE DWG. M-0074.
6. FOR EXPLANATION OF SANITARY PIPING NOTATION SEE DWGS. C-0036A, C, & M-0720.

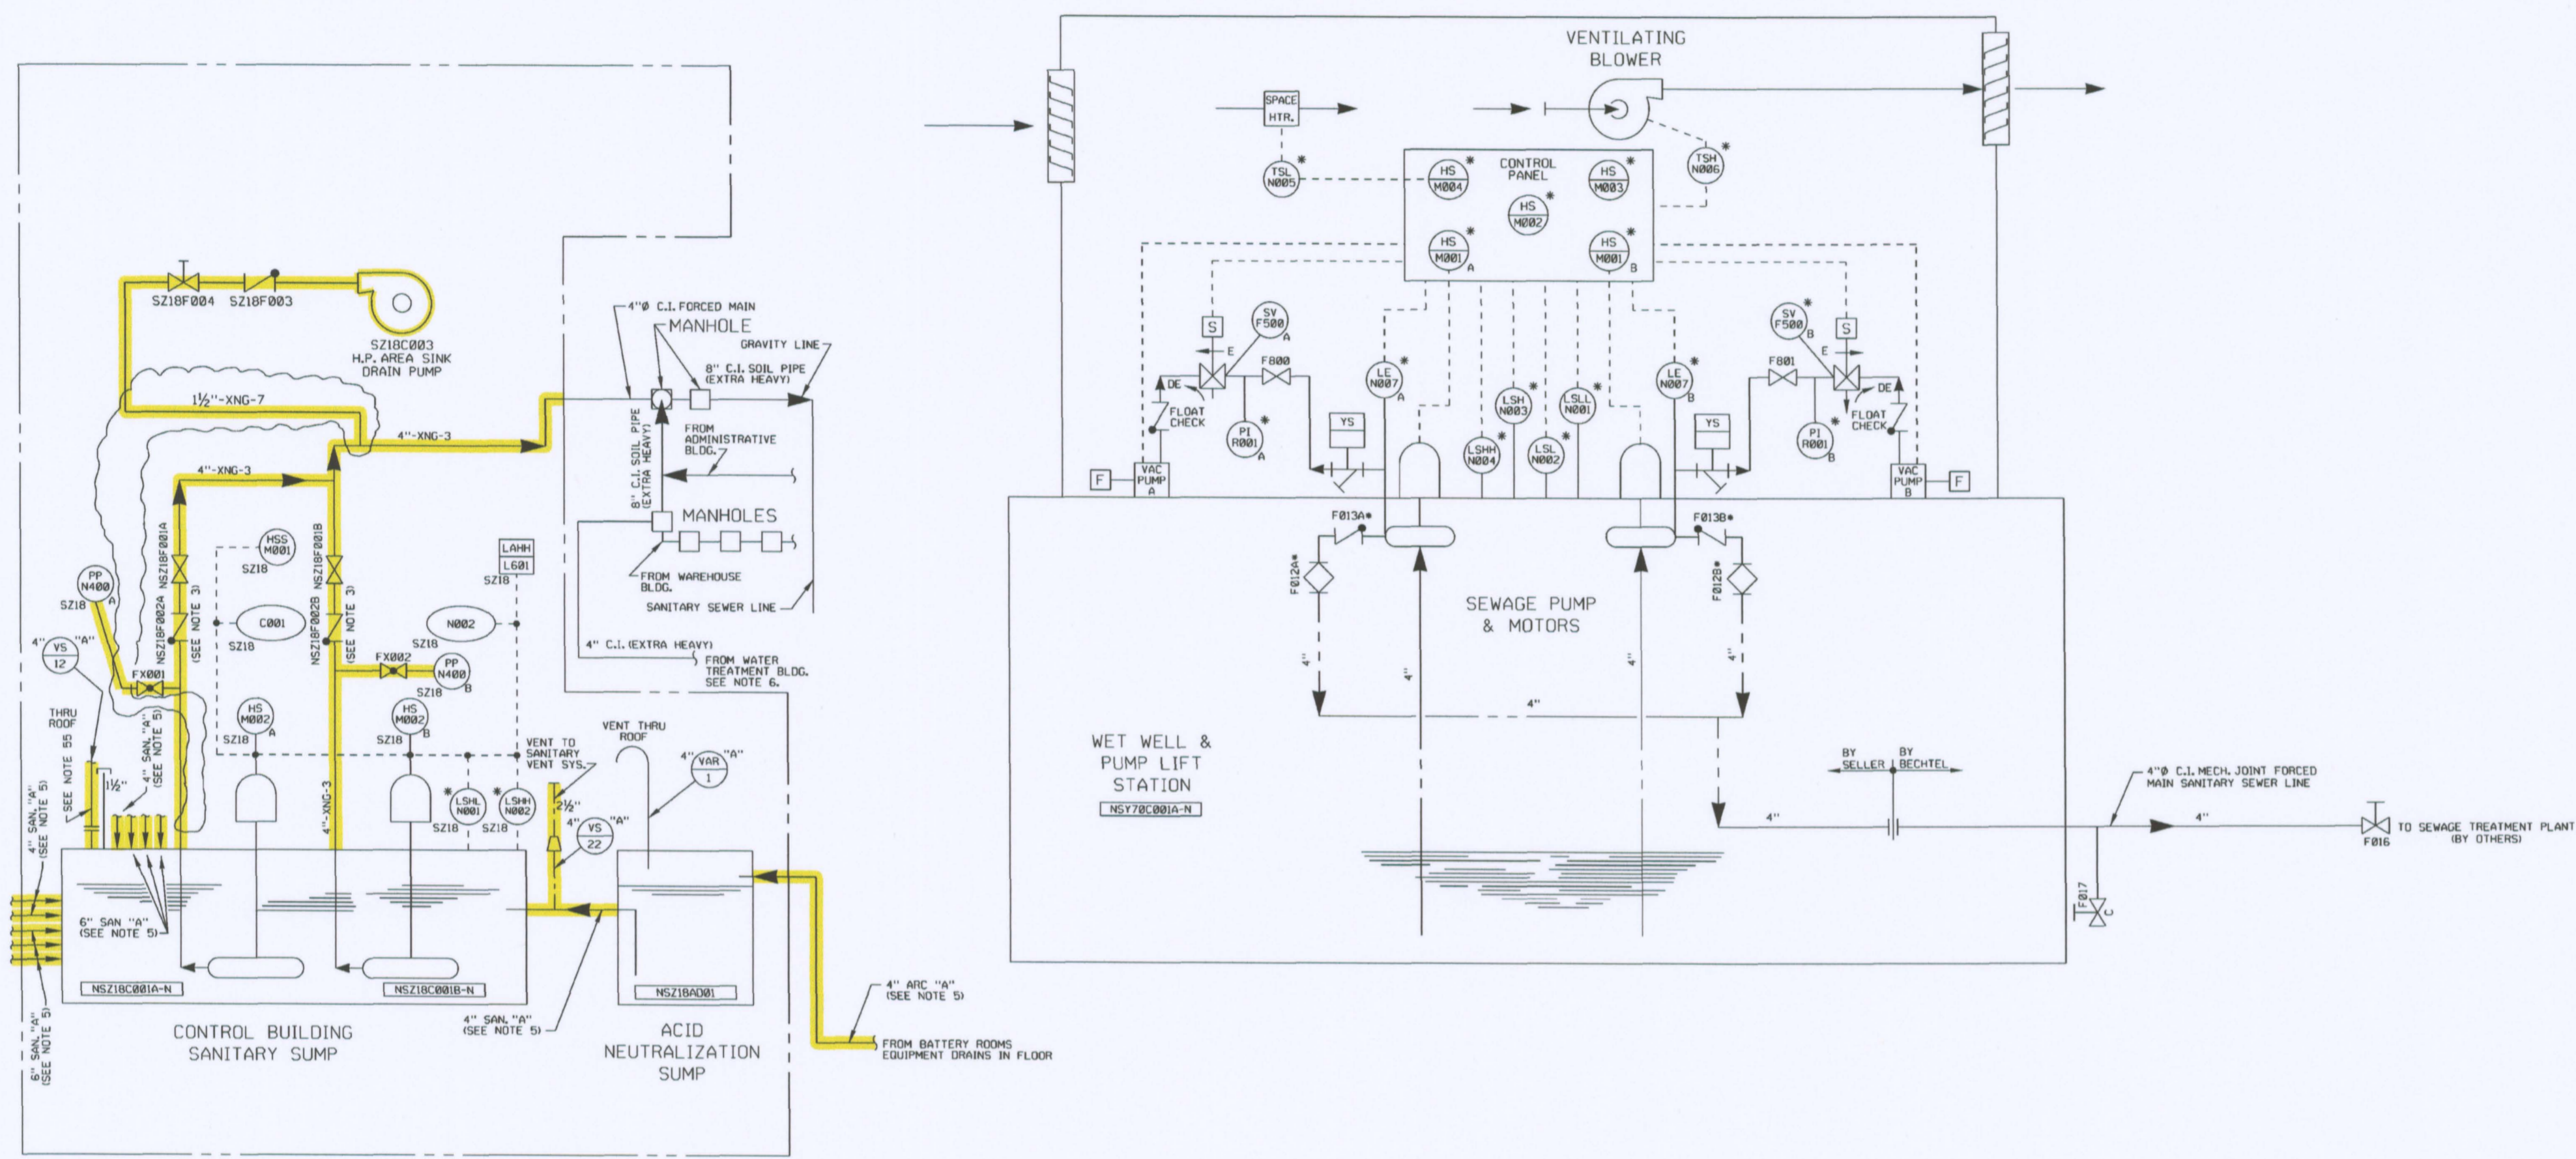

NO.	REVISIONS	DATE	BY	CHK	APP	DATE		
017	AS-BUILT PER EC 9348		WC	N/A	N/A	SP	MM	0-21-00
016	AS-BUILT PER EC-0317		SP	N/A	N/A	EMJ	MM	6-16-88
015	AS-BUILT PER DRN 05-500		SP	N/A	N/A	WC	MM	1-19-2006
014	AS-BUILT PER DRN 04-910							SIGN-OFF ON RECORD

GRAND GULF NUCLEAR STATION
 UNIT 1
 NUCLEAR PLANT ENGINEERING
UPDATED FINAL SAFETY ANALYSIS REPORT
 FIGURE NUMBER - 09.2-015
 P & I DIAGRAM
 CONTROL BLDG. SUMP AND SEWAGE LIFT STATION-UNIT 1

SCALE: NONE DRAWING No. M-0046 REV. 017

COMPONENTS SUBJECT TO AMR
 NON-SAFETY RELATED SYSTEMS & COMPONENTS AFFECTING SAFETY RELATED SYSTEMS AMM20

NO.	DATE	DESCRIPTION	BY	ENG	CHK	APP
REVISIONS						
LRA-M-0046						
CAD FILE: m0046.DGN						
MASTER FILE:						