
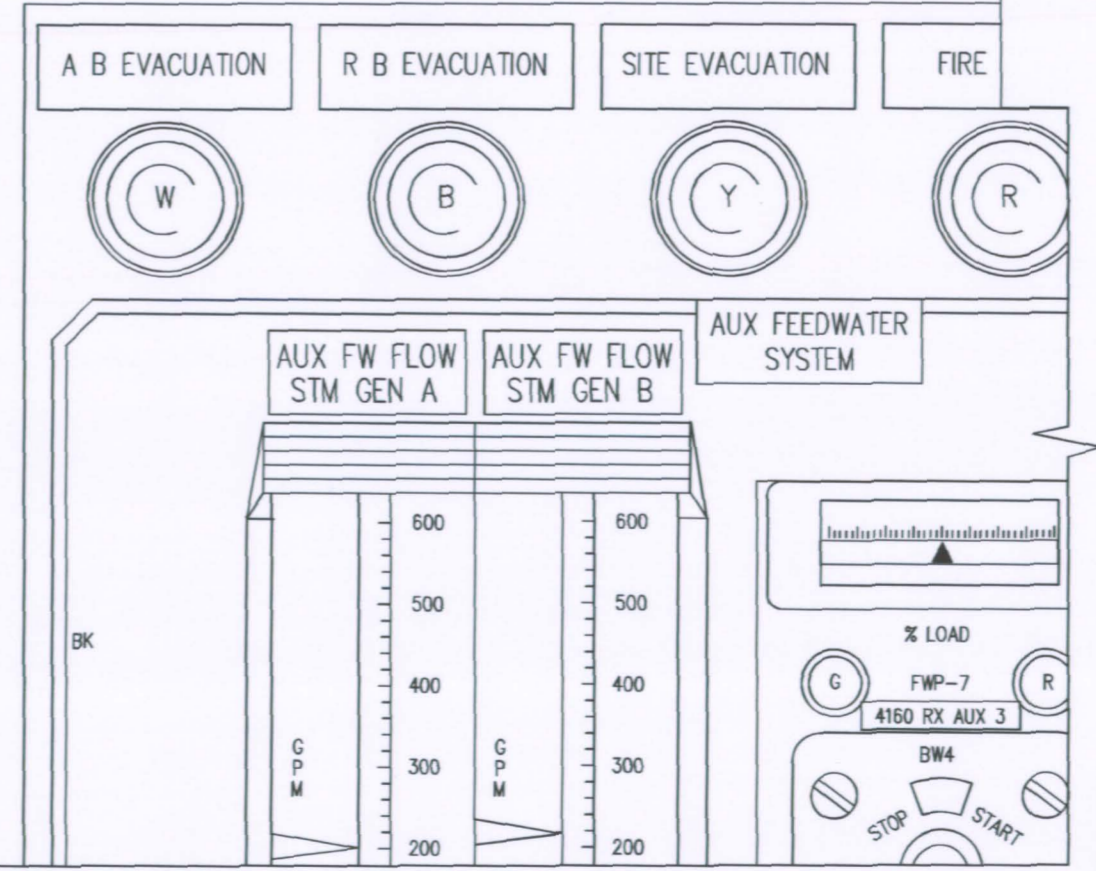
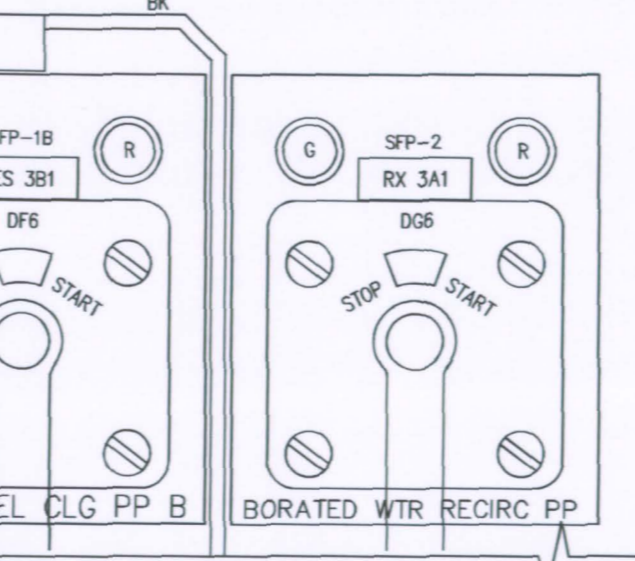
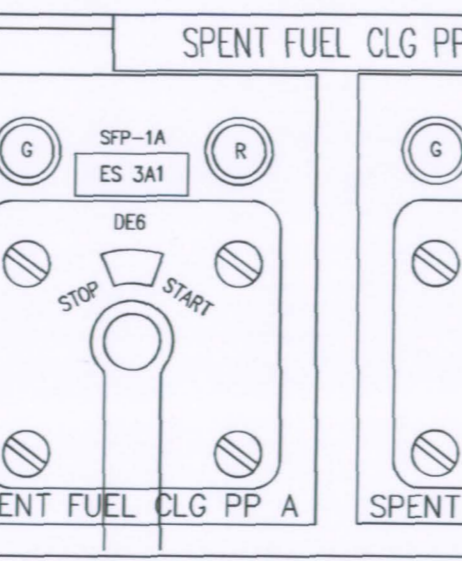
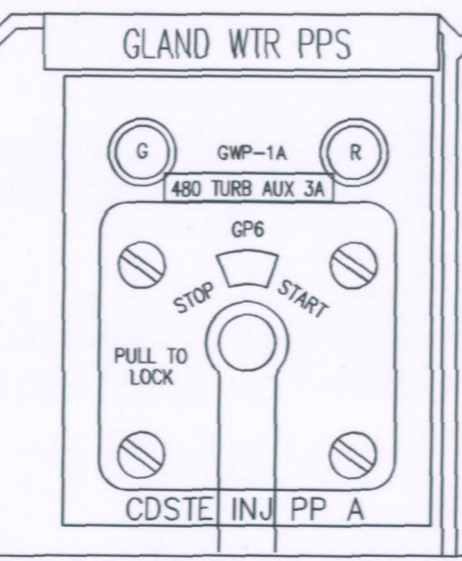
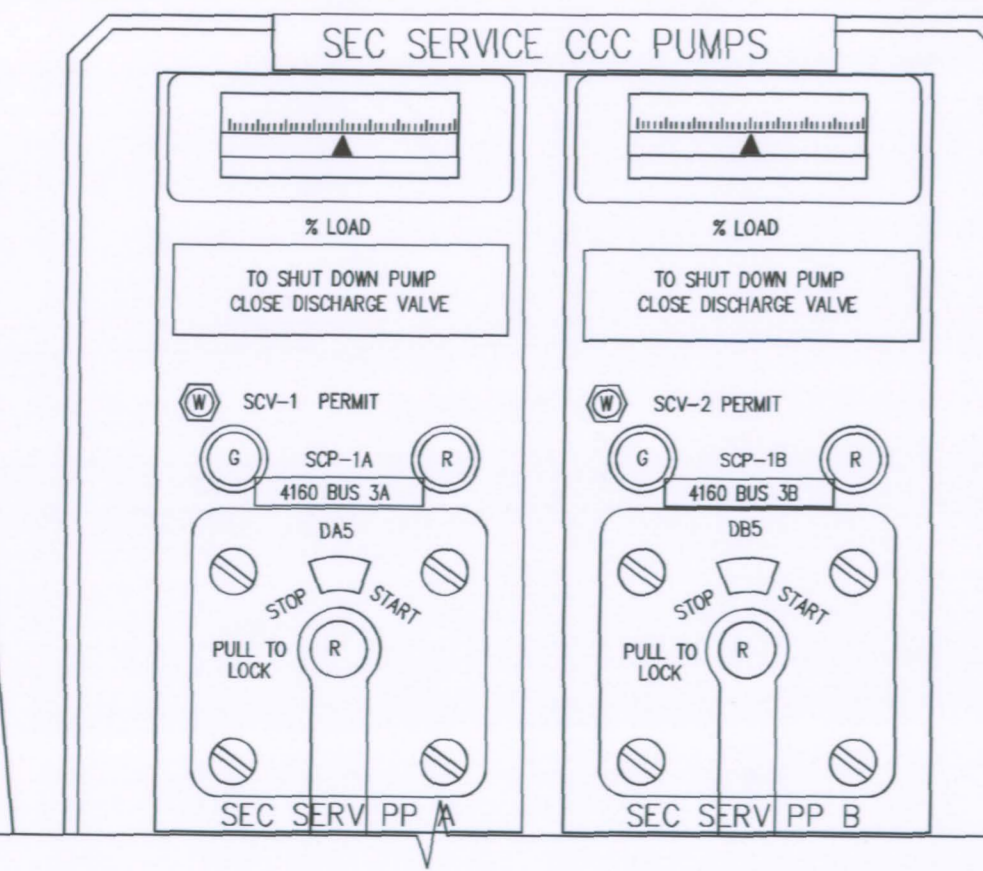
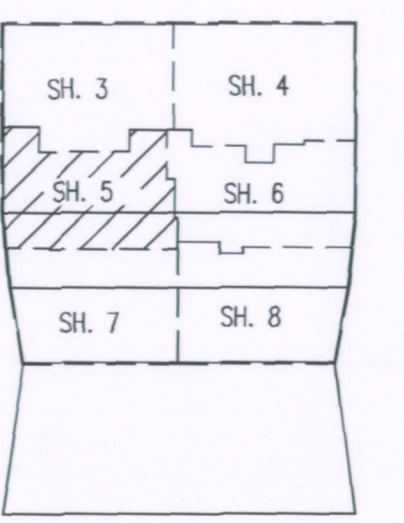
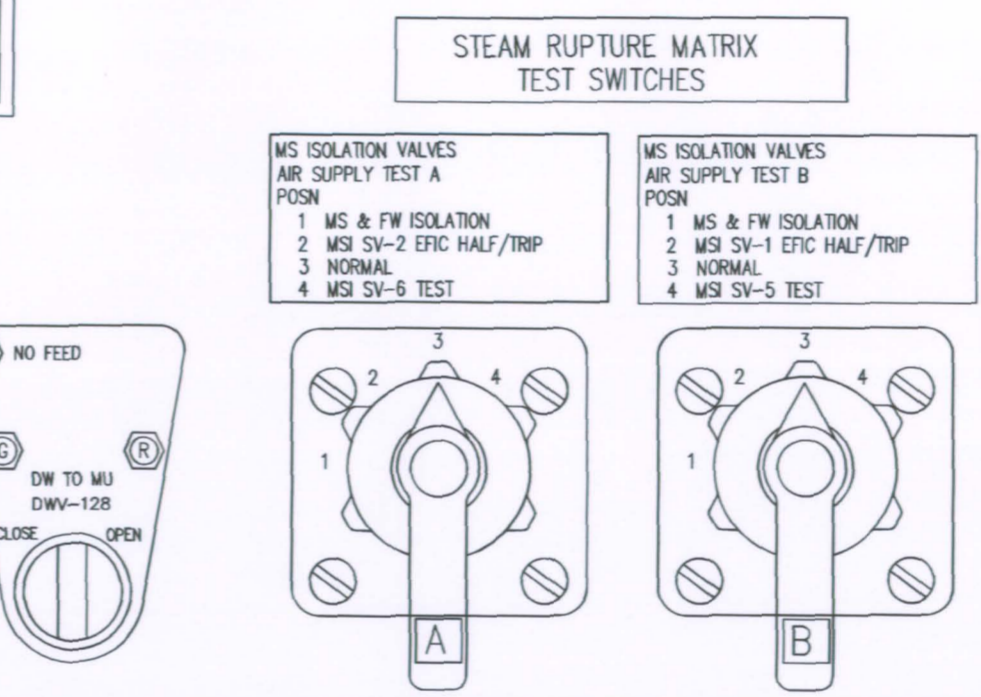
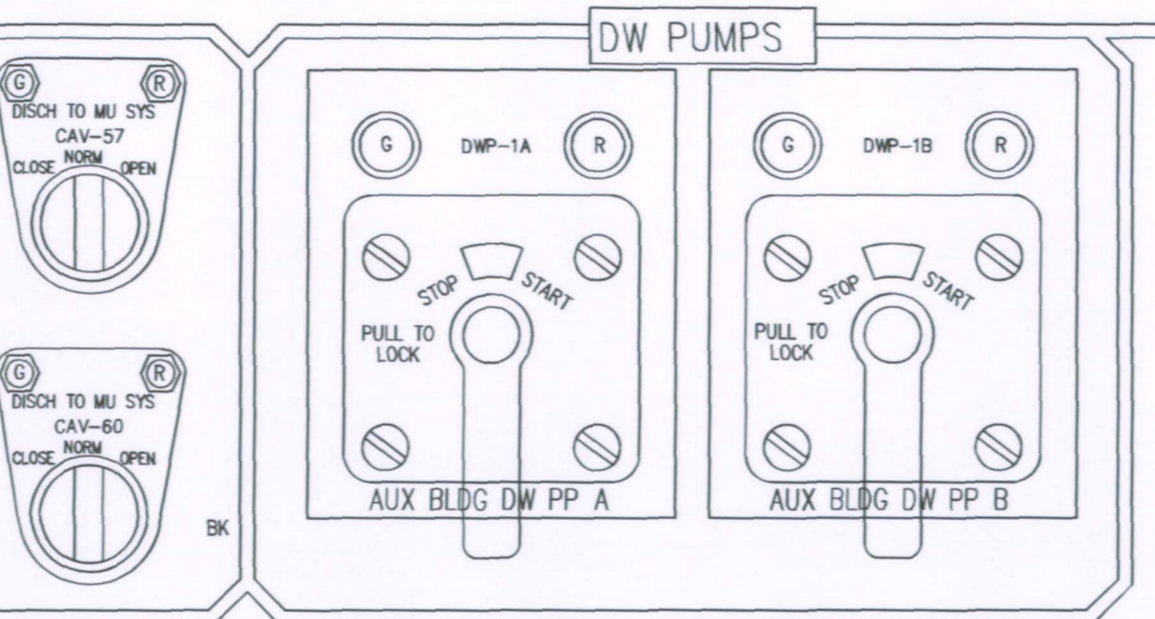
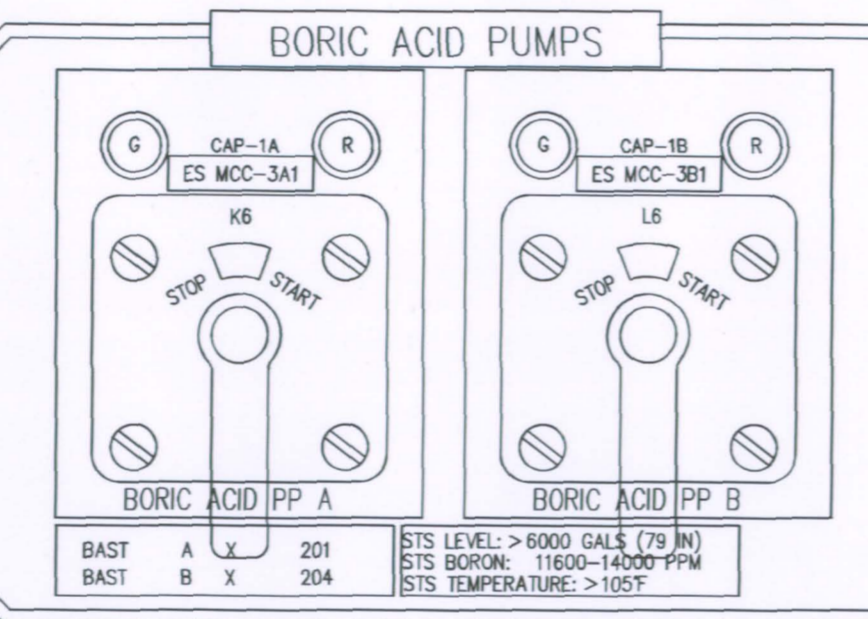
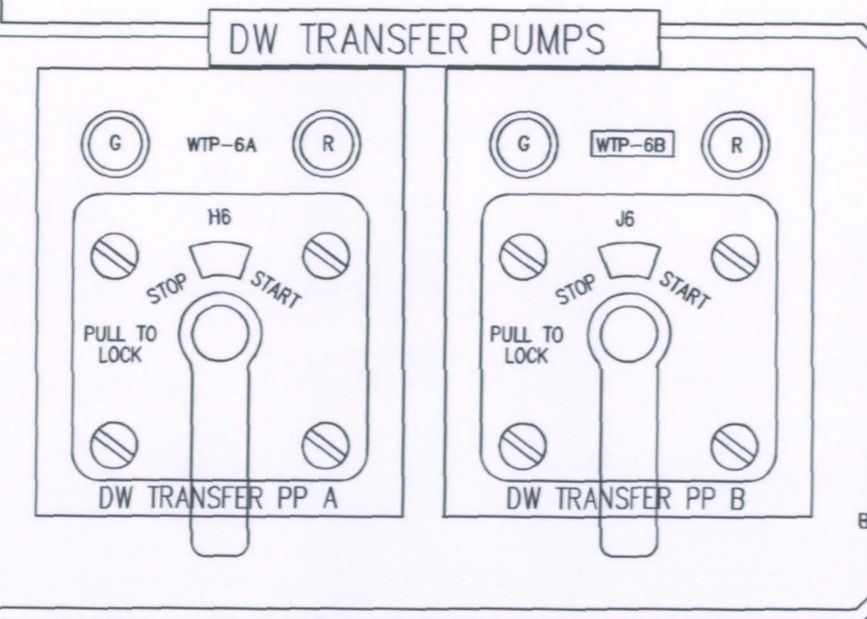
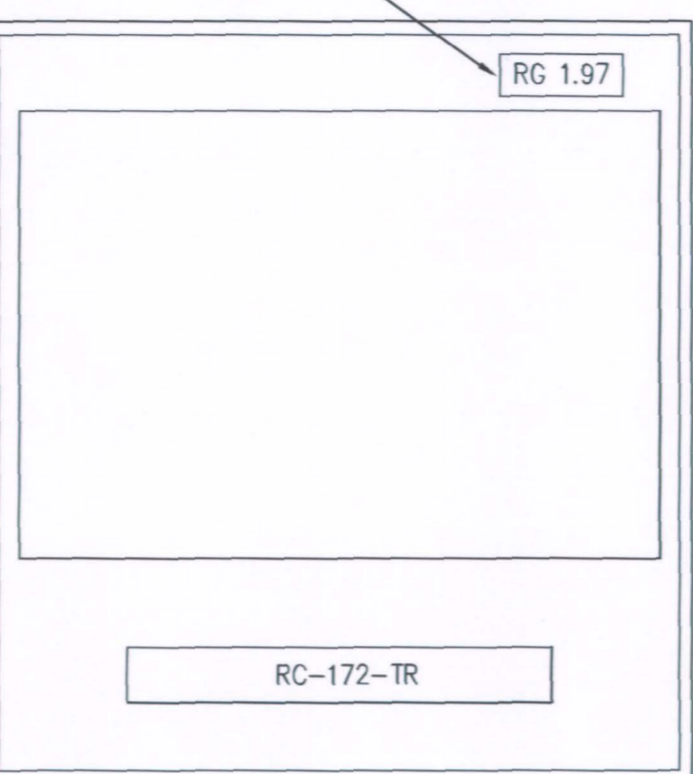
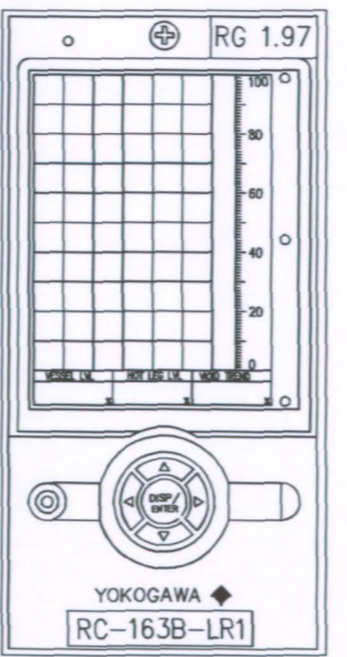
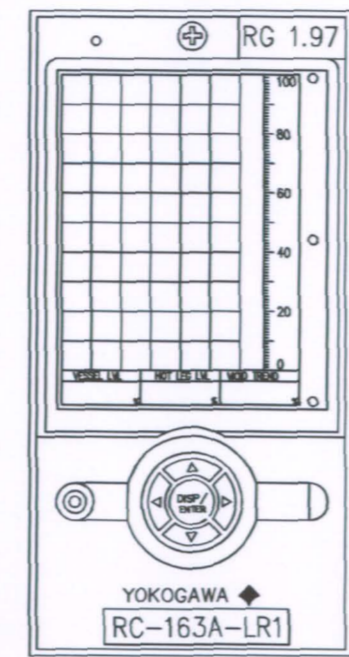
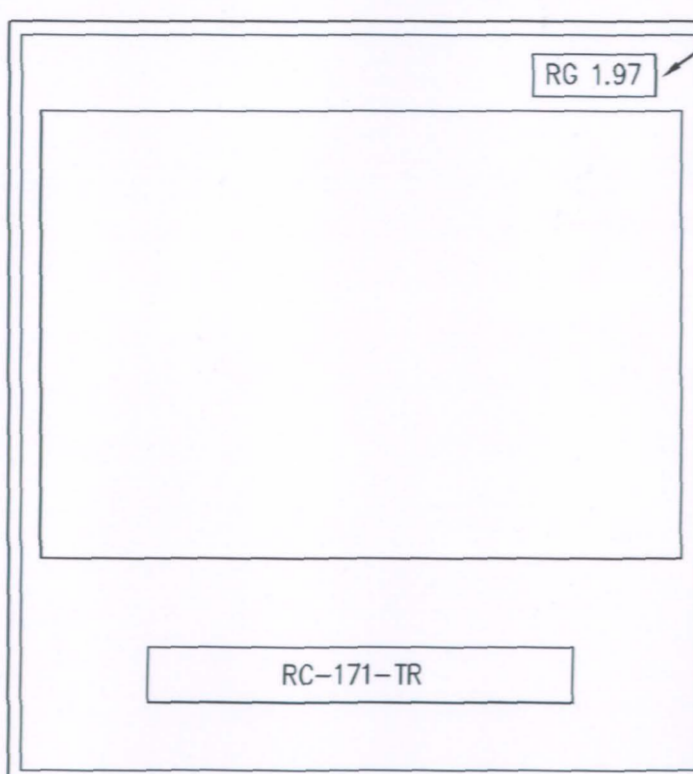
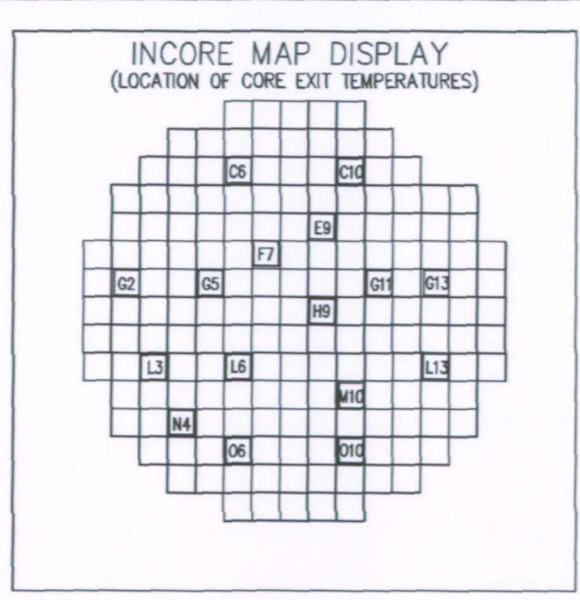


Relocation and consolidation of existing indicators.

SEE NOTE 1

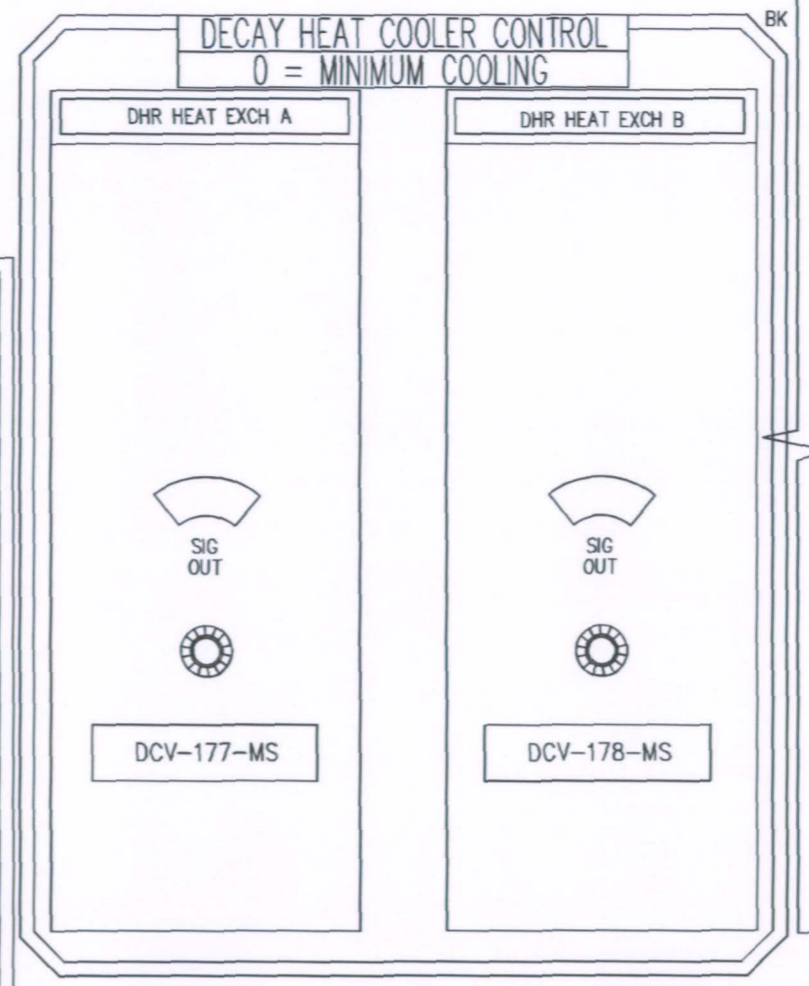

NOTES:
1. LABEL IS ORANGE WITH BLACK LETTERS SIGNIFYING RG 1.97 CATEGORY 1 INSTRUMENTS.

AS BUILT PER MAR 96-11-03-01	TDF	
REVISED PER DCN 97-113	TDF	KLM CSS 6-11-98
AS BUILT PER MAR 94-09-02-01, FCN 1	TDF	LSM CSS 6-13-97
NO. REVISIONS	BY	CHK APP DATE

FLORIDA POWER CORPORATION
ST. PETERSBURG, FLORIDA
CRYSTAL RIVER PLANT 855,000 KW
ELECTRICAL MAIN CONTROL BOARD
PRIMARY SECONDARY AUXILIARIES ASSEMBLY
APPROVED
FOR CONSTRUCTION BY
FLORIDA POWER CORPORATION
NUCLEAR PROJECT MANAGER

DATE	ENGR.	3/4	5500	D-201-151	11	E-201-151
RELEASED FOR	ENGR.	DATE	WORK ORDER	SIZE	DRAWING	REV