



MAY 24 2013

L-2013-113
10 CFR 50.55a

U.S. Nuclear Regulatory Commission
Attn: Document Control Desk
Washington, DC 20555-0001

RE: Turkey Point Units 3 and 4
Docket Nos. 50-250 and 50-251
Inservice Inspection Plan
Submittal of Relief Request No. 12

Pursuant to 10 CFR 50.55a(a)(3)(ii), Florida Power and Light (FPL) requests relief from ASME Section XI, section IWB-5200, subsection IWB-5222, paragraph (b), for the Class 1 pressure test boundaries subject to system pressurization identified in Table 1 and plant drawings of the attached Relief Request No 12. The relief is requested on the basis that hardship and unusual difficulty exists without compensating increase in the level of quality and safety. As discussed in the attached Relief Request, the use of the proposed alternative provides reasonable assurance of structural integrity or leak tightness of the subject components.

Due to the extended refueling outages for the extended power uprate (EPU) Turkey Point plant modifications, FPL is invoking the provision of ASME Code Section XI, IWA-2430(d)1 to extend the Fourth 10-Year ISI interval by 1-year for both Turkey Point Units 3 and 4 to complete the required inservice inspections during the refueling outages for Cycle 27 and Cycle 28 for Units 3 and Units 4 respectively, and to credit those inspections/examinations to the Fourth 10-Year ISI Interval. Accordingly, FPL requests the approval of the attached Relief Request No. 12 by February 1, 2014 to support the Unit 3 refueling outage for Cycle 27 currently scheduled in the Spring of 2014, and the Turkey Point Unit 4 refueling outage activities currently scheduled for Cycle 28 in the Fall of 2014.

If you have any questions or require additional information, please contact Robert Tomonto, Licensing Manager, at (305) 246-7327.

Very truly yours,

Michael Kiley
Site Vice President
Turkey Point Nuclear Plant

Attachment

cc: Regional Administrator, Region II, USNRC
Senior Resident Inspector, USNRC, Turkey Point Plant

A047
NRR

10 CFR 50.55a Relief Request Number 12

**Proposed Alternative
in Accordance with 10 CFR 50.55a (a)(3)(ii)**

**Hardship or Unusual Difficulty
Without Compensating Increase in Level of Quality or Safety**

1. ASME Code Component(s) Affected:

The affected components associated with this relief request are the Turkey Point Units 3 and 4 Class 1 pressure retaining components within the identified system boundary listed in Table 1 and the attached plant drawings.

2. Applicable Code Edition and Addenda:

The code of record for the Turkey Point Units 3 and Unit 4 for the Fourth 10-year Inservice Inspection (ISI) interval is the 1998 Edition with Addenda through 2000 of the American Society of Mechanical Engineers (ASME) Boiler and Pressure Vessel (B&PV), Section XI, "Rules for Inservice Inspection of Nuclear Power Plant Components."

3. Applicable Code Requirement:

The ASME B&PV Section XI 1998 Edition with Addenda through 2000, Table IWB-2500-1, Section IWB-5200 "System Test Requirements", subsection IWB-5222 "Boundaries", paragraph (b), requires that "The pressure retaining boundary during the system leakage test conducted at or near the end of each inspection interval shall extend to all Class 1 pressure retaining components within the system boundary."

4. Basis for Hardship or Unusual Difficulty without Compensating Increase In level of Quality or Safety

Turkey Point Units 3 and 4 request relief from IWB-5222(b) in accordance with 10 CFR 50.55a(a)(3)(ii) on the basis that hardship or unusual difficulty exists, without a compensating increase in the level of quality and safety. The attached Table 1 and plant drawings identify the Class 1 pressure retaining components that are associated with the requested relief.

The reason for the relief is discussed below.

Turkey Point Units 3 and 4 design of Class 1 vents and drains typically consist of a single isolation valve with a capped/blind flanged end that constitutes the Class 1 system boundary. Many of these valves are not readily accessible due to their physical locations and radiation/contamination levels in the area. Pressurization of these locations for testing would be performed in Mode 3 and would involve opening these single isolation valves to pressurize to the extended Class 1 pressure retaining components within the system

boundary. After performance of the required VT-2 visual examination, these single isolation valves would be closed, isolating a high temperature, pressurized volume of water between the isolation valve and the capped/blind flanged end. This results in an undesirable plant configuration that would be conducive to pressure lock or the initiation of system leakage from valve packing or capped/blind flanged ends.

In addition, the piping associated with the vents and drains will contain pressurized reactor coolant fluid between the valve and cap/blind flange. During the subsequent refueling outage, after depressurization of the reactor coolant system, the valve would need to be opened prior to cap/blind flange removal in order to release the pressurized slug of reactor coolant system fluid contained between the valve and cap/blind flange. This will need to be performed in order to eliminate a safety hazard.

Turkey Point Units No. 3 and 4 design also requires substantial effort to extend the Class 1 system boundary where check valves or non-redundant components serve as the first system isolation from the reactor coolant system. Such configurations may require check valve disassembly or other temporary configurations to achieve test pressures at upstream piping and valves. Since the Class 1 system pressure testing is performed in Mode 3, these temporary configurations could conflict with Technical Specification requirements and valve alignments. Establishing and restoring such temporary configurations could also result in an unwarranted increase in worker radiation exposures.

Relief is requested from fully pressurizing piping between the first and second isolation device on small bore size vent, drain, test, and fill lines in the Reactor Coolant System (RCS), which range in size from 0.5 inch to 2 inches. The configurations are either two small isolation valves in series, a valve and blind flange, or a valve and cap. In certain configurations, the piping between the two isolation boundaries will tee to a third valve that is also the second isolation boundary. The piping segments provide the design required double isolation barrier for the reactor coolant pressure boundary. The code required leakage test would be performed in Mode 3 at the normal operating temperature and pressure.

Leakage testing of these piping segments at nominal operating pressure in Mode 3 would require the opening of the inboard isolation valve at the normal operating RCS temperature and pressure conditions. In doing so, the design requirement for two primary coolant pressure boundary isolation devices would be violated. Additionally, opening of these valves introduces the potential risk for spills and personnel contamination. For configuration where blind flanges or caps are installed as the isolation device, opening of the inboard valve introduces the possibility of a personnel safety hazard if a flange or cap fails in the presence of inspection personnel.

A VT-2 visual examination is performed on these piping segments through the entire length as part of the Class 1 system inspection at the conclusion of each refueling outage. This leakage test does not specifically pressurize past the first isolation valve. Also, this leakage test is considered successful when no external or visible leakage is identified. Since this type of test assures that the combined first and second isolation devices are effective in

maintaining the reactor coolant pressure boundary at normal operating temperature and pressure, the increase in safety achieved from the code required leakage test (IWB-5222(b)) is not commensurate with the hardship of performing such code required leakage testing.

14-inch Residual Heat Removal (RHR) Motor Operated Valves (MOV)

Turkey Point Unit 3: This piping segment consists of approximately 26 feet of 14-inch piping between RHR inlet valves MOV-3-750 and MOV-3-751. Within this piping segment there is a 3/4 inch pipe branch with a 3/4 inch valve that branches off into a two 1/2 inch valves.

Turkey Point Unit 4: This piping segment consists of approximately 44 feet of 14 inch piping between RHR inlet valves MOV-4-750 and MOV-4-751. Within this piping segment there is a 1 inch pipe branch with a 1 inch valve that branches off into a 1 inch valve and a 1/2 inch valve. Also, within this 14-inch piping segment, there is a 3/4 inch vent valve.

MOV-3/4-750 and MOV-3/4-751 are interlocked to avoid over-pressurization of the RHR system. The interlock prevents manual opening of the valves with RCS pressure above the required pressure interlock setpoint.

A VT-2 visual examination is performed on these piping segments through the entire length as part of the Class 1 system inspection at the conclusion of each refueling outage. This proposed system pressure test does not specifically pressurize past the first isolation valve. It is possible that the piping becomes pressurized due to minor leakage past the first isolation valve. The leakage test is considered successful when no external or visible leakage is identified. This test will provide assurance that the combined first and second isolation devices are effective in maintaining the reactor coolant pressure boundary at normal operating temperature and pressure.

Based on the above, extension of the pressure retaining boundary during system leakage tests to Class 1 pressure retaining components within the system boundary represents a hardship and unusual difficulty that does not provide a compensating increase in the level of quality and safety.

Safety Injection Loops Low Head Check Valves 3-875A/B/C, 4-875A/B/C, and Upstream Piping

These six piping segments consist of 10-in. piping spans connected to an 8-in. and 2-in. piping span along with 3/4 inch and 1 inch connections with valves. Pressure testing in Mode 3 would require a pressure source be connected at each segment location. In so doing, the design requirement for two primary coolant pressure boundary isolation devices would be violated. For test locations located overhead and away from normal personnel access areas, ladders or scaffolding would have to be installed to provide access to the piping segment and to open the valve.

The piping segments are inspected using VT-2 visual examination as part of the Class 1 system inspection at the conclusion of each refueling outage. The proposed system

pressure test will not specifically pressurize past the first isolation valve for this inspection. It is possible that the piping becomes pressurized due to minor leakage past the first isolation valve. However, the pressure in the segment will be at least at the operating pressure of the emergency core cooling system accumulators, which are pressurized to between 600 psig and 660 psig.

The acceptance criteria will be that no external or visible leakage will be allowed for the test to be successful. Therefore, based on the above, the imposition of the ASME Code requirements on the plant would cause a significant burden that would not be compensated by an increase in the level of quality and safety. The proposed alternative provides reasonable assurance that the subject line segments' leakage integrity will be maintained.

Safety Injection Loops High Head Check Valves 3-874A/B, 4-874A/B, and Upstream Piping

These two piping segments consist of a 2-in. piping span between two check valves oriented toward the RCS. Pressure testing of these piping segments at nominal operating pressure in MODE 3 would require a modification to allow pressurizing to the normal operating RCS temperature and pressure conditions.

A VT-2 visual examination is performed on these piping segments through the entire length as part of the Class 1 system inspection at the conclusion of each refueling outage. The proposed system pressure test will not specifically pressurize past the first isolation valve for this inspection. It is possible that the piping becomes pressurized due to minor leakage past the first isolation valve. The acceptance criteria will be that no external or visible leakage will be allowed for the test to be successful.

Based on the above, it has been determined that compliance with the ASME Code requirement to perform the system pressure test on the subject line segments would result in a hardship that would not be compensated by an increase in quality and safety. The proposed alternative provides reasonable assurance that the subject line segments' leakage integrity will be maintained.

5. Proposed Alternative and Basis for Use:

Title 10 of the Code of Federal Regulations (10 CFR), Section 50.55a(g)(4), specifies that ASME Code Class 1, 2, and 3 components (including supports) must meet the requirements, except for the design and access provisions and the preservice examination requirements, set forth in the ASME Code, Section XI to the extent practical within the limitations of design geometry and materials of construction of the components.

Paragraph 50.55a(a)(3) of 10 CFR Part 50 states, in part, that alternatives to the requirements of 10 CFR 50.55a(g) may be used when authorized by the NRC if the licensee demonstrates (i) the proposed alternatives would provide an acceptable level of quality and safety, or if (ii) compliance with the specified requirements would result in hardship or unusual difficulty without a compensating increase in the level of quality and safety.

FPL is requesting authorization of an alternative to the requirements of the ASME Code Section XI, IWB-5222(b) pursuant to 10 CFR 50.55a(a)(3)(ii).

The proposed alternative for this request relief uses leakage testing. The Class 1 system boundary will be maintained in a normal, operational alignment during leakage tests for the items identified within Table 1 constituting exceptions to the Code-required boundary of IWB-5222(b). The VT-2 visual examination will extend to the Class 1 pressure retaining components within the system boundary during the performance of each system leakage test required by Table IWB-2500-1 examination category B-P. Items within Table 1 will be visually examined for evidence of leakage during system leakage testing without being pressurized.

Based on the discussion provided in Section 4, it is concluded that compliance with the specified requirements would result in hardship or unusual difficulty without compensating increase in the level of quality and safety, while the proposed alternative provides reasonable assurance of structural integrity or leak tightness of the subject components.

6. Duration of Proposed Alternative:

Relief Request No. 12 is requested for Turkey Point Units 3 and 4 for the Fourth 10-Year ISI Interval. The Unit 3 Fourth 10-Year ISI Interval began February 22, 2004 to February 21, 2014 and the Unit 4 Fourth 10-Year Interval began April 15, 2004 to April 14, 2014.

Due to the extended refueling outages for the extended power uprate (EPU) Turkey Point plant modifications, FPL is invoking the provision of ASME Code Section XI, IWA-2430(d)1 to extend the Fourth 10-Year ISI interval by 1-year for both Turkey Point Units 3 and 4 to complete the required inservice inspections during the refueling outages for Cycle 27 and Cycle 28 for Units 3 and Units 4 respectively, and to credit those inspections/examinations to the Fourth 10-Year ISI Interval.

7. Precedent

Similar relief has been granted for H.B Robinson Steam Electric Plant Unit No.2, Docket No. 50-261, TAC No. ME 8255, ML12181A26.

8. Attachments

Plant Drawings referenced in Table 1

Table 1
Relief Request No. 12
Turkey Point Unit 3 Affected Class 1 Pressure Retaining Components

| Affected Line or Component | Code Class | Pipe Diameter | Pipe Schedule | Approx Length | Exam Category | Drawing No. | Boundary Exception(s) |
|---|------------|---------------|--------------------------|---------------|---------------|-------------------|--|
| Drain line below PZR safety valve RV-3-551A (pipe piece between 3-545 and 3-545A) | 1 | 3/4 in. | A376 TP316 SMLS Sch. 160 | ≤ 1 ft. | B-P | 5613-M-3041 Sh. 2 | Valve 3-545 remains closed to avoid pressurizing downstream Class 1 pipe piece and valve 3-545A |
| Drain line below PZR safety valve RV-3-551B (pipe piece between 3-546 and 3-546A and 3-585) | 1 | 3/4 in. | A376 TP316 SMLS Sch. 160 | ≤ 2 ft. | B-P | 5613-M-3041 Sh. 2 | Valve 3-546 remains closed to avoid pressurizing downstream Class 1 pipe piece and valves 3-546A and 3-585 |
| Drain line below PRZ safety valve RV-3-551C (pipe piece between 3-547 and 3-547A) | 1 | 3/4 in. | A376 TP316 SMLS Sch. 160 | ≤ 1 ft. | B-P | 5613-M-3041 Sh. 2 | Valve 3-547 remains closed to avoid pressurizing downstream Class 1 pipe piece and valve 3-547A |
| RCS loop intermediate loop "A" drain valve, liquid waste disposal piping, and leak-off valve. | 1 | 2 in. | A376 TP316 SMLS Sch. 160 | ≤ 1 ft. | B-P | 5613-M-3041 Sh. 1 | Valve 3-508A remains closed to avoid pressurizing downstream Class 1 piping and valves 3-508B and 3-542 |
| | | 3/4 in. | A376 TP316 SMLS Sch. 160 | 28 ft. | | | |
| RCS loop intermediate loop "B" drain valve and liquid waste disposal piping | 1 | 2 in. | A376 TP316 SMLS Sch. 160 | ≤ 1 ft. | B-P | 5613-M-3041 Sh. 1 | Valve 3-515A remains closed to avoid pressurizing downstream Class 1 piping and valve 3-515B. |
| RCS loop intermediate loop "C" drain valve and liquid waste disposal piping | 1 | 2 in. | A376 TP316 SMLS Sch. 160 | ≤ 1 ft. | B-P | 5613-M-3041 Sh. 1 | Valve 3-505A remains closed to avoid pressurizing downstream Class 1 piping and valve 3-505B. |
| RCP "A" seal injection drain valve and blind flange | 1 | 3/4 in. | A376 TP316 SMLS Sch. 160 | ≤ 1 ft. | B-P | 5613-M-3047 Sh. 3 | Valve 3-300A remains closed to avoid pressurizing downstream pipe piece and flange |
| RCP "A" seal water bypass vent valve and blind flange | 1 | 3/4 in. | A376 TP316 SMLS Sch. 160 | ≤ 1 ft. | B-P | 5613-M-3047 Sh. 3 | Valve 3-300C remains closed to avoid pressurizing downstream pipe piece and flange |

Table 1
Relief Request No. 12
Turkey Point Unit 3 Affected Class 1 Pressure Retaining Components

| Affected Line or Component | Code Class | Pipe Diameter | Pipe Schedule | Approx Length | Exam Category | Drawing No. | Boundary Exception(s) |
|---|------------|-----------------|--------------------------|---------------|---------------|-------------------|---|
| RCP "B" seal injection drain valve and cap | 1 | 3/4 in. | A376 TP316 SMLS Sch. 160 | ≤ 1 ft. | B-P | 5613-M-3047 Sh. 3 | Valve 3-300D remains closed to avoid pressurizing downstream pipe piece and cap |
| RCP "B" seal water bypass Vent valve and blind flange. | 1 | 3/4 in. | A376 TP316 SMLS Sch. 160 | ≤ 1 ft. | B-P | 5613-M-3047 Sh. 3 | Valve 3-300F remains closed to avoid pressurizing downstream pipe piece and flange |
| RCP "C" seal injection drain valve and cap | 1 | 3/4 in. | A376 TP316 SMLS Sch. 160 | ≤ 1 ft. | B-P | 5613-M-3047 Sh. 3 | Valve 3-300G remains closed to avoid pressurizing downstream pipe piece and cap |
| RCP "C" seal water bypass Vent valve and blind flange. | 1 | 3/4 in. | A376 TP316 SMLS Sch. 160 | ≤ 1 ft. | B-P | 5613-M-3047 Sh. 3 | Valve 3-300J remains closed to avoid pressurizing downstream pipe piece and flange |
| Auxiliary spray line vent valve and upstream piping | 1 | 2 in. | A376 TP316 SMLS Sch. 160 | 139 ft. | B-P | 5613-M-3047 Sh. 2 | Valve CV-3-311 remains closed to avoid pressurizing downstream piping up to check valve 3-313 and vent pipe and vent valve 3-120J |
| | | 3/4 in | A376 TP316 SMLS Sch. 160 | ≤ 1 ft. | | | |
| Safety injection loop cold leg injection check valve 3-875A and upstream piping | 1 | 3/4 in. 1 in | A376 TP316 SMLS Sch. 160 | ≤ 3 ft. | B-P | 5613-M-3064 Sh. 1 | Check valve 3-875A to remain closed to avoid disassembly or other temporary configurations required to achieve test pressures at upstream piping and valves: 3-868A, 3-873D, 3-873A, 3-876A, 3-875D, 3-940A, 3-884B, and 3-941J |
| | | 2 in. | A376 TP316 SMLS Sch. 160 | 100 ft. | | | |
| | | 8 in. | A376 TP316 SMLS Sch. 120 | 3 ft. | | | |
| | | 10 in. | A376 TP316 SMLS Sch. 140 | 35 ft. | | | |

Table 1
Relief Request No. 12
Turkey Point Unit 3 Affected Class 1 Pressure Retaining Components

| Affected Line or Component | Code Class | Pipe Diameter | Pipe Schedule | Approx Length | Exam Category | Drawing No. | Boundary Exception(s) |
|---|------------|------------------|-----------------------------|---------------|---------------|----------------------|--|
| Safety injection loop cold leg injection check valve 3-875B and upstream piping | 1 | 3/4 in. 1 in. | A376 TP316 SMLS Sch. 160 | ≤ 5 ft. | B-P | 5613-M-3064 Sh. 1 | Check valve 3-875B to remain closed to avoid disassembly or other temporary configurations required to achieve test pressures at upstream piping and valves 3-868B, 3-873E, 3-873B 3-875E, 3-940B, 3-884D, 3-941K, 3-941R, 3-941V, 3-876B and 3-876D |
| | | 2 in. | A376 TP316 SMLS Sch. 160 | 70 ft. | | | |
| | | 8 in. | A376 TP316 SMLS Sch. 120 | 10 ft. | | | |
| | | 10 in. | A376 TP316 SMLS Sch. 140 | 58 ft. | | | |
| Safety injection loop cold leg injection check valve 3-875C and upstream piping | 1 | 3/4 in. 1 in. | A376 TP316 SMLS Sch. 160 | ≤ 3 ft. | B-P | 5613-M-3064 Sh. 1 | Check valve 3-875C to remain closed to avoid disassembly or other temporary configurations required to achieve test pressures at upstream piping and valves 3-868C, 3-873F, 3-873C, 3-940C, 3-884F, 3-875F, 3-876E, 3-942A, and 3-876C. |
| | | 2 in. | A376 TP316 SMLS Sch. 160 | 69 ft. | | | |
| | | 8 in. | A376 TP316 SMLS Sch. 120 | 18 ft. | | | |
| | | 10 in. | A376 TP316 SMLS Sch. 140 | 41 ft. | | | |
| Residual heat removal motor-operated valve MOV-3-750 and common suction piping | 1 | 14 in. | A376 TP316 SMLS Sch. 140 | 26 ft. | B-P | 5613-M-3050 Sh. 1 | Valve MOV-3-750 to remain closed to avoid pressuring downstream piping and valves, MOV-3-751, 3-750B, 3-750C and 3-750D. |
| | | 3/4 in. 1/2 in. | A376 TP316 SMLS Sch. 160 | 3 ft. | | | |
| Downstream piping of CV-3-310B | 1 | 3 in. | A376 TP316 SMLS Sch. 160 | 45 ft. | B-P | 5613-M-3047 Sh. 2 | Valve CV-3-310B to remain closed to avoid pressurizing downstream piping up to check valve 3-312B |

Table 1
Relief Request No. 12
Turkey Point Unit 3 Affected Class 1 Pressure Retaining Components

| Affected Line or Component | Code Class | Pipe Diameter | Pipe Schedule | Approx Length | Exam Category | Drawing No. | Boundary Exception(s) |
|--|------------|---------------|--------------------------|---------------|---------------|-------------------|---|
| Safety Injection check valves 3-874A, 3-874B and upstream piping | 1 | 2 in. | A376 TP316 SMLS Sch. 160 | 222 ft. | B-P | 5613-M-3062 Sh. 1 | Check valves 3-874A and 3-874B to remain closed to avoid disassembly or other temporary configurations required to achieve test pressures at upstream piping and valves MOV-3-866A and B, 3-941C and D, and 3-957 |
| | | 3/4 in. | A376 TP316 SMLS Sch. 160 | ≤1 ft. | | | |
| Pressurizer Spray line drain valve and cap | 1 | 3/4 in. | A376 TP316 SMLS Sch. 160 | ≤1 ft. | B-P | 5613-M-3041 Sh. 2 | Valve 3-568 remains closed to avoid pressurizing downstream pipe piece and cap |
| Pressurizer Spray line drain valve and cap | 1 | 3/4 in. | A376 TP316 SMLS Sch. 160 | ≤1 ft. | B-P | 5613-M-3041 Sh. 2 | Valve 3-569 remains closed to avoid pressurizing downstream pipe piece and cap |
| Regenerative Heat Exchanger outlet drain line and cap | 1 | 3/4 in. | A376 TP316 SMLS Sch. 160 | ≤ 1 ft. | B-P | 5613-M-3047 Sh. 1 | Valve 3-201A remains closed to avoid pressurizing downstream pipe piece and cap |

Table 1
Relief Request No.12
Turkey Point Unit 4 Affected Class 1 Pressure Retaining Components


| Affected Line or Component | Code Class | Pipe Diameter | Pipe Schedule | Approx Length | Exam Category | Drawing No. | Boundary Exception(s) |
|--|------------|---------------|--------------------------|---------------|---------------|-------------------|--|
| Drain line below PZR safety valve RV-4-551A (pipe piece between 4-545 and 4-545A) | 1 | 3/4 in. | A376 TP316 SMLS Sch. 160 | ≤ 1 ft. | B-P | 5614-M-3041 Sh. 2 | Valve 4-545 remains closed to avoid pressurizing downstream Class 1 pipe piece and valve 4-545A |
| Drain line below PZR safety valve RV-4-551B (pipe piece between 4-546, 4-546A, and 4-585) | 1 | 3/4 in. | A376 TP316 SMLS Sch. 160 | ≤ 2 ft. | B-P | 5614-M-3041 Sh. 2 | Valve 4-546 remains closed to avoid pressurizing downstream Class 1 pipe piece and valves 4-546A and 4-585 |
| Drain line below PRZ safety valve RV-4-551C (pipe piece between 4-547 and 4-547A) | 1 | 3/4 in. | A376 TP316 SMLS Sch. 160 | ≤ 1 ft. | B-P | 5614-M-3041 Sh. 2 | Valve 4-547 remains closed to avoid pressurizing downstream Class 1 pipe piece and valve 4-547A |
| RCS loop intermediate loop "A" drain valve, liquid waste disposal piping, and leak-off valve | 1 | 2 in. | A376 TP316 SMLS Sch. 160 | ≤ 1 ft. | B-P | 5614-M-3041 Sh. 1 | Valve 4-508A remains closed to avoid pressurizing downstream Class 1 piping and valves 4-508B and 4-542 |
| | | 3/4 in. | A376 TP316 SMLS Sch. 160 | 28 ft. | | | |
| RCS loop intermediate loop "B" drain valve and liquid waste disposal piping | 1 | 2 in. | A376 TP316 SMLS Sch. 160 | ≤ 1 ft. | B-P | 5614-M-3041 Sh. 1 | Valve 4-515A remains closed to avoid pressurizing downstream Class 1 piping and valve 4-515B. |
| RCS loop intermediate loop "C" drain valve and liquid waste disposal piping | 1 | 2 in. | A376 TP316 SMLS Sch. 160 | ≤ 1 ft. | B-P | 5614-M-3041 Sh. 1 | Valve 4-505A remains closed to avoid pressurizing downstream Class 1 piping and valve 4-505B. |
| RCP "A" seal injection drain valve and blind flange | 1 | 3/4 in. | A376 TP316 SMLS Sch. 160 | ≤ 1 ft. | B-P | 5614-M-3047 Sh. 3 | Valve 4-300A remains closed to avoid pressurizing downstream pipe piece and flange |

| <p align="center">Table 1 Relief Request No.12 Turkey Point Unit 4 Affected Class 1 Pressure Retaining Components</p> | | | | | | | |
|--|------------|------------------|--------------------------|---------------|---------------|-------------------|---|
| Affected Line or Component | Code Class | Pipe Diameter | Pipe Schedule | Approx Length | Exam Category | Drawing No. | Boundary Exception(s) |
| RCP "A" seal water bypass vent valve and blind flange | 1 | 3/4 in. | A376 TP316 SMLS Sch. 160 | ≤ 1 ft. | B-P | 5614-M-3047 Sh. 3 | Valve 4-300C remains closed to avoid pressurizing downstream pipe piece and flange |
| RCP "B" seal injection drain valve and cap | 1 | 3/4 in. | A376 TP316 SMLS Sch. 160 | ≤ 1 ft. | B-P | 5614-M-3047 Sh. 3 | Valve 4-300D remains closed to avoid pressurizing downstream pipe piece and cap |
| RCP "B" seal water bypass Vent valve and blind flange. | 1 | 3/4 in. | A376 TP316 SMLS Sch. 160 | ≤ 1 ft. | B-P | 5614-M-3047 Sh. 3 | Valve 4-300F remains closed to avoid pressurizing downstream pipe piece and flange |
| RCP "C" seal injection drain valve and cap | 1 | 3/4 in. | A376 TP316 SMLS Sch. 160 | ≤ 1 ft. | B-P | 5614-M-3047 Sh. 3 | Valve 4-300G remains closed to avoid pressurizing downstream pipe piece and cap |
| RCP "C" seal water bypass Vent valve and blind flange. | 1 | 3/4 in. | A376 TP316 SMLS Sch. 160 | ≤ 1 ft. | B-P | 5614-M-3047 Sh. 3 | Valve 4-300J remains closed to avoid pressurizing downstream pipe piece and flange |
| Piping downstream of CV-4-311 | 1 | 2 in. | A376 TP316 SMLS Sch. 160 | 142 ft. | B-P | 5614-M-3047 Sh. 2 | Valve CV-4-311 remains closed to avoid pressurizing downstream piping up to check valve 4-313. |
| Safety injection loop cold leg injection check valve 4-875A and upstream piping | 1 | 3/4 in. 1 in. | A376 TP316 SMLS Sch. 160 | ≤ 3 ft. | B-P | 5614-M-3064 Sh. 1 | Check valve 4-875A to remain closed to avoid disassembly or other temporary configurations required to achieve test pressures at upstream piping and valves 4-868A, 4-868D, 4-873D, 4-873A, 4-876A, 4-875D, 4-876E 4-940A, 4-884B, and 4-941J |
| | | 2 in. | A376 TP316 SMLS Sch. 160 | 89 ft. | | | |
| | | 8 in. | A376 TP316 SMLS Sch. 120 | 15 ft. | | | |

| <p align="center">Table 1 Relief Request No.12 Turkey Point Unit 4 Affected Class 1 Pressure Retaining Components</p> | | | | | | | |
|--|------------|-----------------------------|-----------------------------|---------------|---------------|----------------------|---|
| Affected Line or Component | Code Class | Pipe Diameter | Pipe Schedule | Approx Length | Exam Category | Drawing No. | Boundary Exception(s) |
| | | 10 in. | A376 TP316 SMLS Sch. 140 | 46 ft. | | | |
| Safety injection loop cold leg injection check valve 4-875B and upstream piping | 1 | 3/4 in. 1 in. | A376 TP316 SMLS Sch. 160 | ≤ 4 ft. | B-P | 5614-M-3064 Sh. 1 | Check valve 4-875B to remain closed to avoid disassembly or other temporary configurations required to achieve test pressures at upstream piping and valves 4-868B, 4-868E, 4-873E, 4-873B, 4-875E, 4-940B, 4-884D, 4-941K, 4-941R, 4-941V, 4-876B and 4-876D |
| | | 2 in. | A376 TP316 SMLS Sch. 160 | 110 ft. | | | |
| | | 8 in. | A376 TP316 SMLS Sch. 120 | 21 ft. | | | |
| | | 10 in. | A376 TP316 SMLS Sch. 140 | 59 ft. | | | |
| Safety injection loop cold leg injection check valve 4-875C and upstream piping | 1 | 3/4 in. 1 in. | A376 TP316 SMLS Sch. 160 | ≤ 4 ft. | B-P | 5614-M-3064 Sh. 1 | Check valve 4-875C to remain closed to avoid disassembly or other temporary configurations required to achieve test pressures at upstream piping and valves 4-868F, 4-868C, 4-873F, 4-873C, 4-940C, 4-941L, 4-884F, 4-875F, 4-876C |
| | | 2 in. | A376 TP316 SMLS Sch. 160 | 87 ft. | | | |
| | | 8 in. | A376 TP316 SMLS Sch. 120 | 5 ft. | | | |
| | | 10 in. | A376 TP316 SMLS Sch. 140 | 49 ft. | | | |
| Residual heat removal motor-operated valve MOV-4-750 and common suction piping | 1 | 14 in. | A376 TP316 SMLS Sch. 140 | 44 ft. | B-P | 5614-M-3050 Sh. 1 | Valve MOV-4-750 to remain closed to avoid pressuring downstream piping and valves, MOV-4-751, 4-750A, 4-750B, 4-750C and 4-750D. |
| | | 3/4 in. 1/2 in. 1 in. | A376 TP316 SMLS Sch. 160 | 10 ft. | | | |

Table 1
Relief Request No.12
Turkey Point Unit 4 Affected Class 1 Pressure Retaining Components

| Affected Line or Component | Code Class | Pipe Diameter | Pipe Schedule | Approx Length | Exam Category | Drawing No. | Boundary Exception(s) |
|--|------------|------------------|-----------------------------|---------------|---------------|----------------------|---|
| Piping downstream of CV-4-310B | 1 | 3 in. | A376 TP316 SMLS Sch. 160 | 48 ft. | B-P | 5614-M-3047 Sh. 2 | Valve CV-4-310B to remain closed to avoid pressurizing downstream piping up to check valve 4-312B |
| Safety Injection check valves 4-874A, 4-874B and upstream piping | 1 | 2 in. | A376 TP316 SMLS Sch. 160 | 140 ft. | B-P | 5614-M-3062 Sh. 1 | Check valves 4-874A and 4-874B to remain closed to avoid disassembly or other temporary configurations required to achieve test pressures at upstream piping and valves MOV-4-866A and B, 4-941C and D, and 4-957 |
| | | 3/4 in. 1 in. | A376 TP316 SMLS Sch. 160 | ≤ 3 ft. | | | |
| Pressurizer Spray line drain valve and cap | 1 | 3/4 in. | A376 TP316 SMLS Sch. 160 | ≤ 1 ft. | B-P | 5614-M-3041 Sh. 2 | Valve 4-568 remains closed to avoid pressurizing downstream pipe piece and cap |
| Pressurizer Spray line drain valve and cap | 1 | 3/4 in. | A376 TP316 SMLS Sch. 160 | ≤ 1 ft. | B-P | 5614-M-3041 Sh. 2 | Valve 4-569 remains closed to avoid pressurizing downstream pipe piece and cap |
| Regenerative Heat Exchanger outlet drain line and flange | 1 | 3/4 in. | A376 TP316 SMLS Sch. 160 | ≤ 1 ft. | B-P | 5614-M-3047 Sh. 1 | Valve 4-201A remains closed to avoid pressurizing downstream pipe piece and flange |

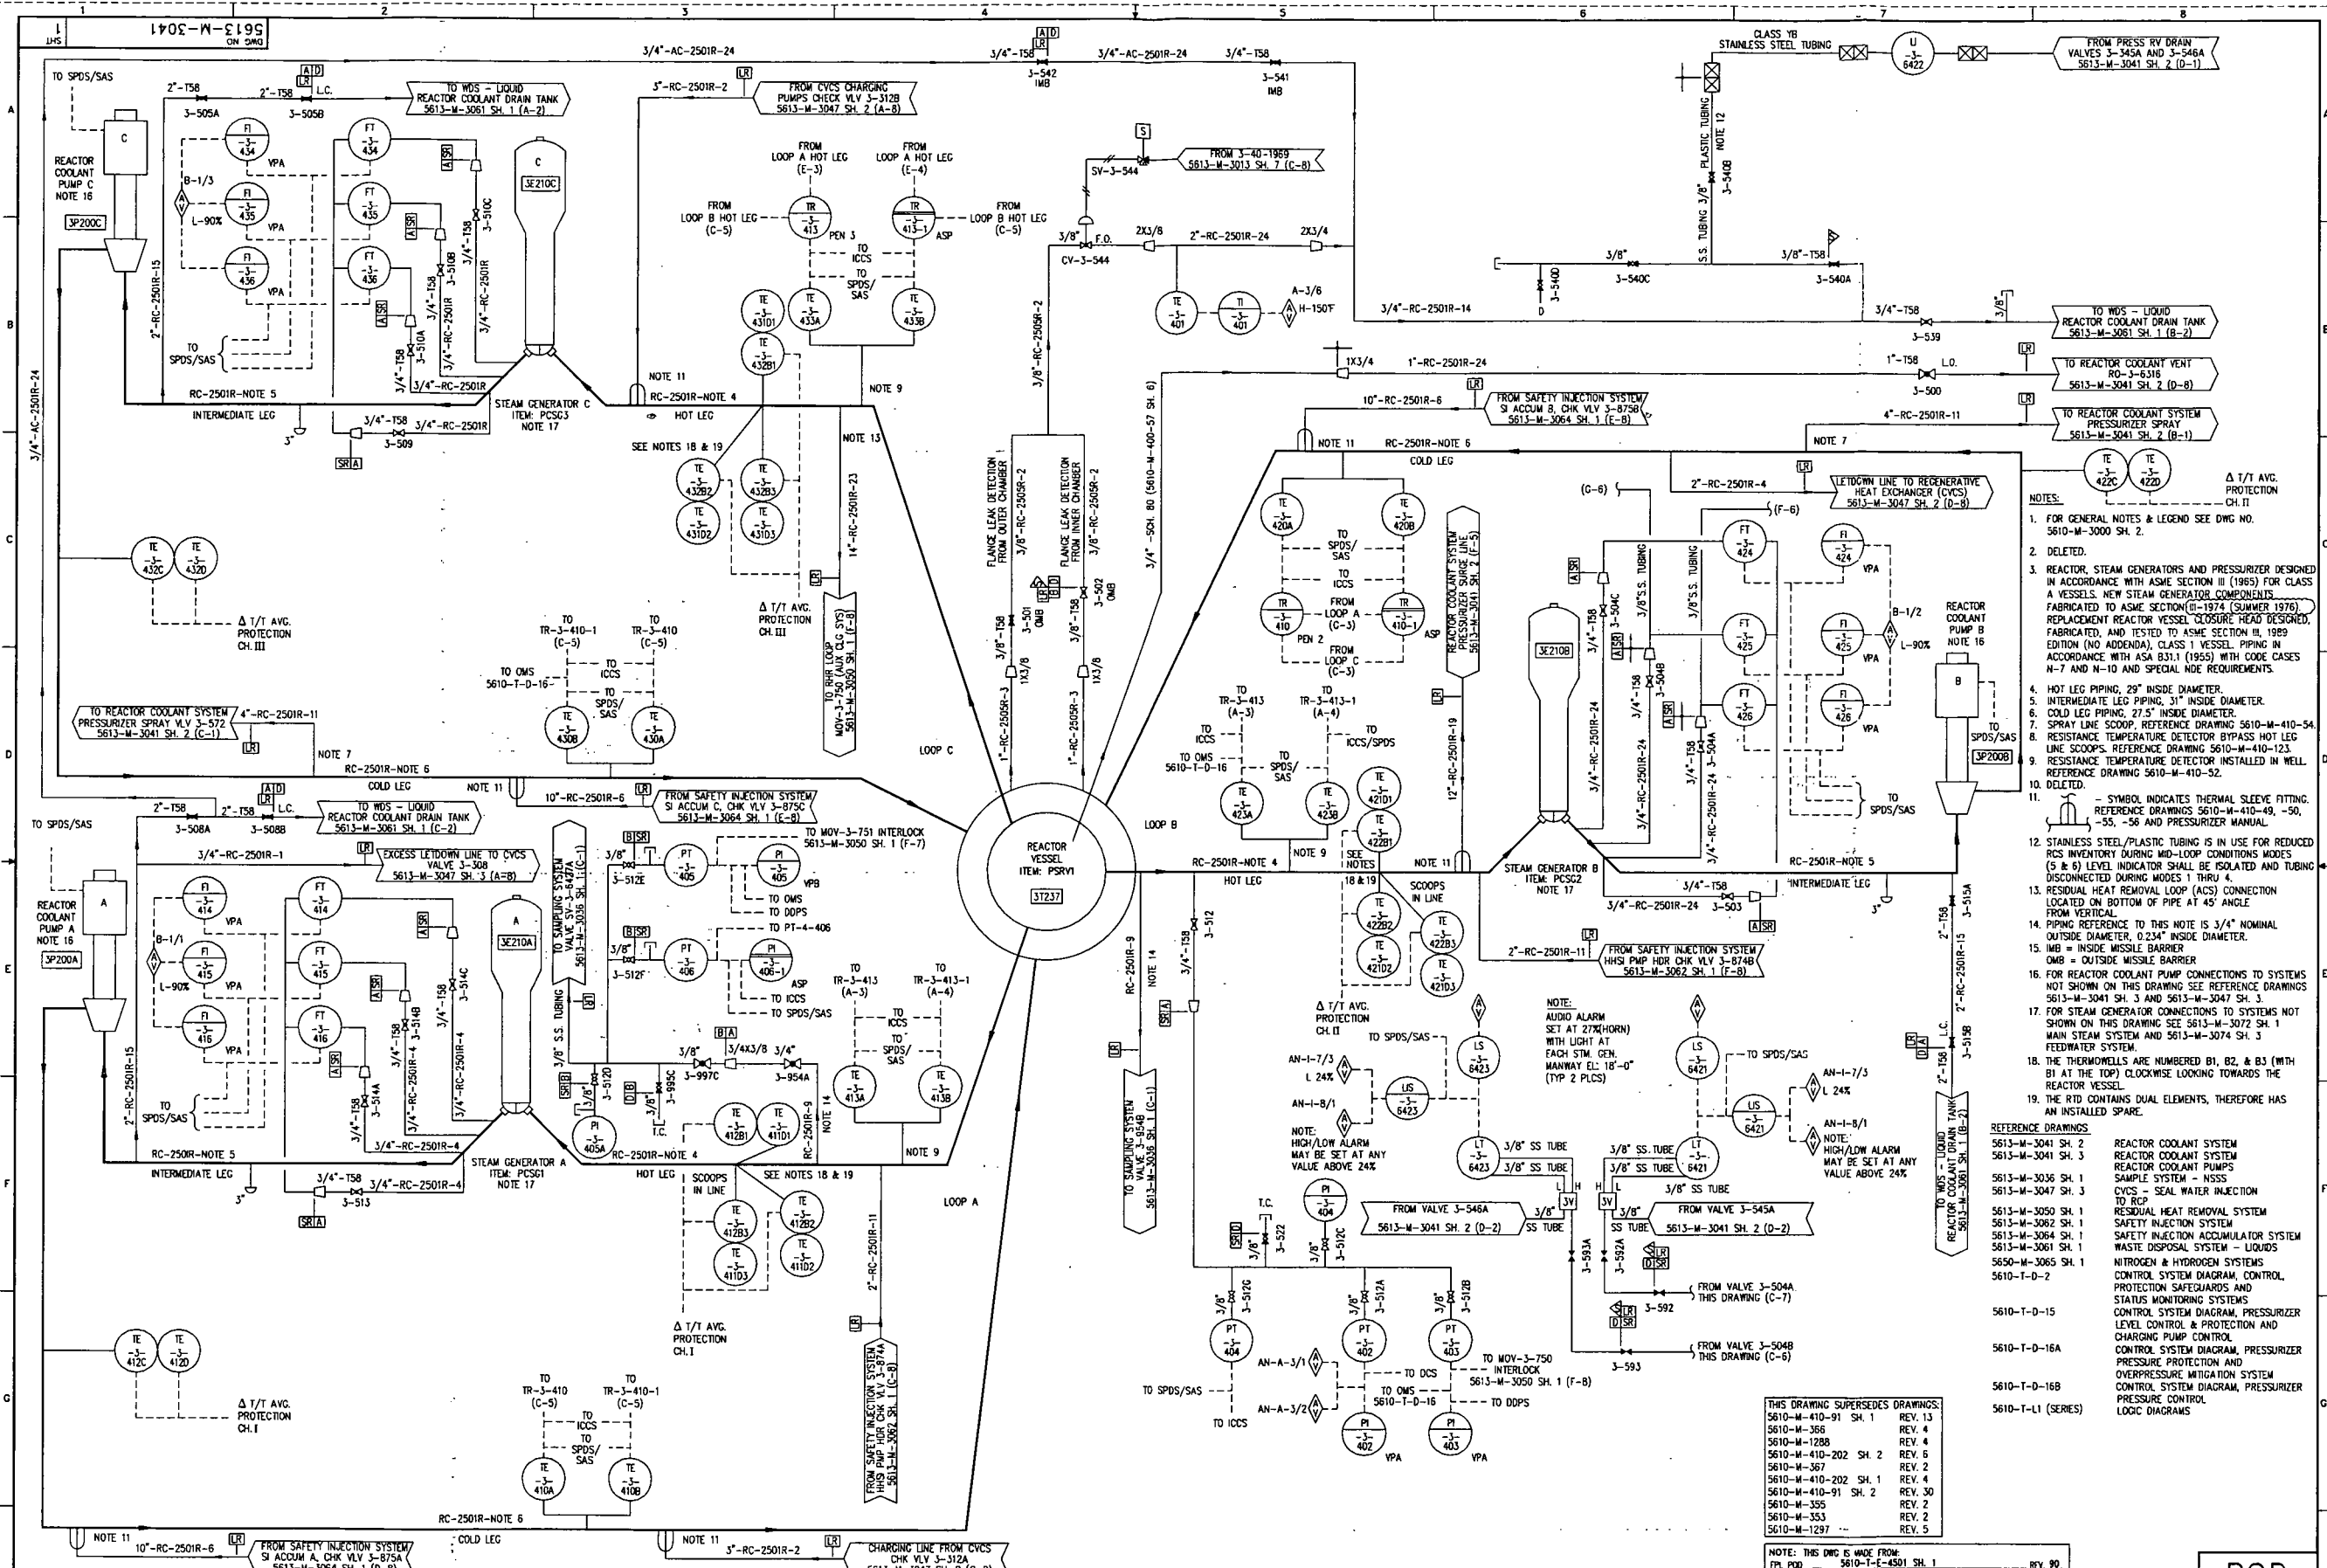

| REV | DATE | REVISION | BY | CH | APP | APP | REV | DATE | REVISION | BY | CH | APP | APP |
|-----|----------|--|-----|----|-----|-----|-----|----------|--|----|----|-----|-----|
| 23 | 11-17-04 | ISSUED AS-BUILT PER PC/M 03-057 AND INCORP. CRN-M-11190. | RV | SB | CMZ | JTL | 29 | 6-12-09 | ISSUED AS-BUILT PER CRN-M-12566 (PC/M 09-005). | RH | RV | BRG | PRB |
| 22 | 11-09-04 | ISSUED AS-BUILT PER PC/M 04-012 AND INCORP. CRN-M-11143. | RV | RH | ASD | JMM | 28 | 3-20-08 | ISSUED AS-BUILT PER CRN-M-12280 (PC/M 07-095). | RH | RV | PJV | PRB |
| 21 | 05-19-03 | ISSUED AS-BUILT PER CRN-M-10612 (PC/M 02-065). | RH | RV | AAP | CMZ | 27 | 10-23-07 | ISSUED AS-BUILT PER CRN-M-12029 (PC/M 07-021). | RH | RV | PJV | MCT |
| 20 | 10-12-01 | ISSUED AS-BUILT PER CRN-M-10420 (PC/M 98-008). | RH | RH | BP | TS | 26 | 7-10-06 | ISSUED AS-BUILT PER CRN-M-12747 (PC/M 03-106). | RH | BB | - | TS |
| 19 | 09-28-01 | ISSUED AS-BUILT PER PC/M 99-051. | RH | RV | ASD | JM | 25 | 6/22/06 | ISSUED AS-BUILT PER CRN-M-11658 (PC/M 03-106). | RH | RV | RSV | JTL |
| 18 | 04-08-00 | ISSUED AS-BUILT PER CRN-M-9993 (PC/M 99-061). | JPC | JZ | - | JRH | 24 | 3-26-06 | ISSUED AS-BUILT PER PC/M 04-012 & INCORP. CRN-M-11529. | RH | SB | BSC | JTL |

THIS DRAWING SUPERSEDES DRAWINGS:

| | |
|----------------------|---------|
| 5610-M-410-91 SH. 1 | REV. 13 |
| 5610-M-366 | REV. 4 |
| 5610-M-1288 | REV. 4 |
| 5610-M-410-202 SH. 2 | REV. 5 |
| 5610-M-367 | REV. 2 |
| 5610-M-410-202 SH. 1 | REV. 4 |
| 5610-M-410-91 SH. 2 | REV. 30 |
| 5610-M-355 | REV. 2 |
| 5610-M-353 | REV. 2 |
| 5610-M-1297 | REV. 5 |

NOTE: THIS Dwg IS MADE FROM:
FPL POD 5610-T-E-4501 SH. 1 REV. 90
FPL POD 5610-T-E-4061 SH. 1 REV. 55

POD

5613-M-3041


REACTOR COOLANT SYSTEM

STONE & WEBSTER ENGINEERING CORP.
FT. LAUDERDALE, FLORIDA

DRAWING NUMBER
5613-M-3041

SHEET 1

041
REV
29

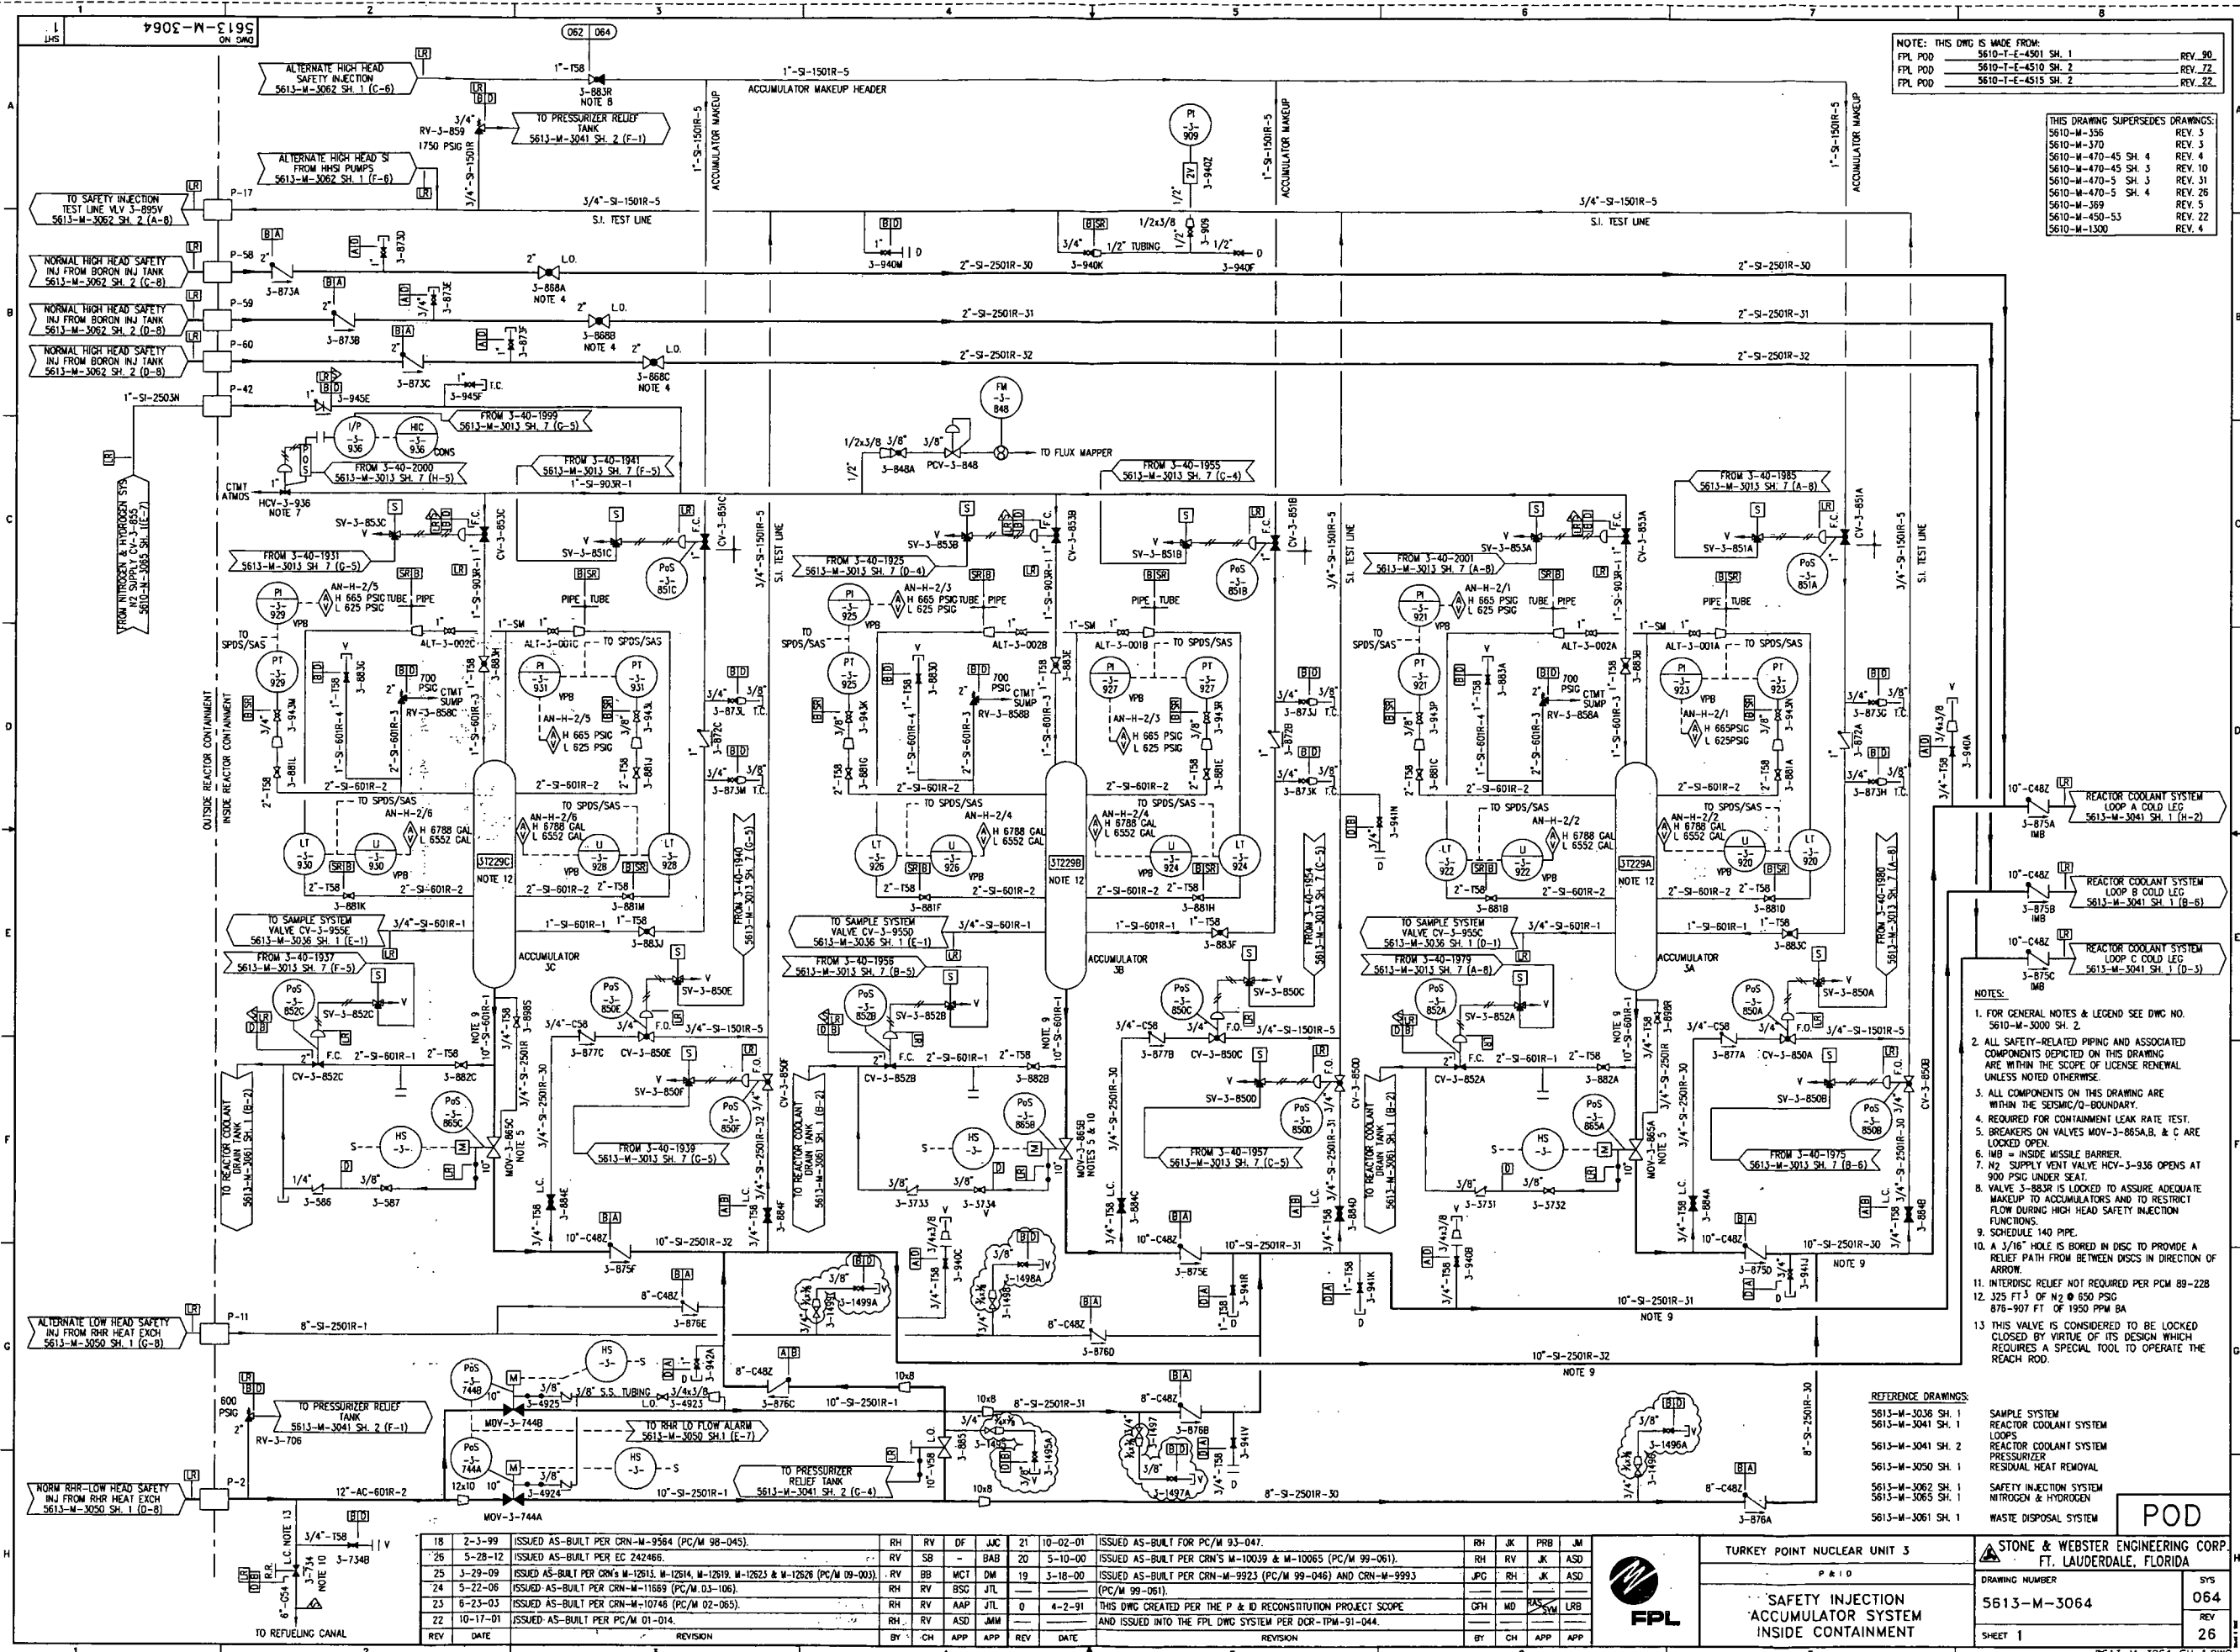

NOTE: THIS DWG IS MADE FROM:
FPL POD 5610-T-E-4501 SH. 1 REV. 30
FPL POD 5610-T-E-4510 SH. 2 REV. 22
FPL POD 5610-T-E-4515 SH. 2 REV. 22

THIS DRAWING SUPERSEDES DRAWINGS:
5610-M-356 REV. 3
5610-M-370 REV. 3
5610-M-470-45 SH. 4 REV. 10
5610-M-470-45 SH. 3 REV. 10
5610-M-470-5 SH. 4 REV. 26
5610-M-369 REV. 5
5610-M-450-53 REV. 22
5610-M-1300 REV. 4

- NOTES:
1. FOR GENERAL NOTES & LEGEND SEE DWG NO. 5610-M-3000 SH. 2.
 2. ALL SAFETY-RELATED PIPING AND ASSOCIATED COMPONENTS DEPICTED ON THIS DRAWING ARE WITHIN THE SCOPE OF LICENSE RENEWAL UNLESS NOTED OTHERWISE.
 3. ALL COMPONENTS ON THIS DRAWING ARE WITHIN THE SEISMIC/0-BOUNDARY.
 4. REQUIRED FOR CONTAINMENT LEAK RATE TEST.
 5. BREAKERS ON VALVES MOV-3-855A,B & C ARE LOCKED OPEN.
 6. INB = INSIDE MISSILE BARRIER.
 7. N2 SUPPLY VENT VALVE HCV-3-936 OPENS AT 900 PSIG UNDER SEAT.
 8. VALVE 3-883R IS LOCKED TO ASSURE ADEQUATE MAKEUP TO ACCUMULATORS AND TO RESTRICT FLOW DURING HIGH HEAD SAFETY INJECTION FUNCTIONS.
 9. SCHEDULE 140 PIPE.
 10. A 3/16" HOLE IS BORED IN DISC TO PROVIDE A RELIEF PATH FROM BETWEEN DISCS IN DIRECTION OF ARROW.
 11. INTERDISC RELIEF NOT REQUIRED PER PCM 89-228.
 12. 325 FT³ OF N2 @ 650 PSIG 876-907 FT OF 1950 PPM BA.
 13. THIS VALVE IS CONSIDERED TO BE LOCKED CLOSED BY VIRTUE OF ITS DESIGN WHICH REQUIRES A SPECIAL TOOL TO OPERATE THE REACH ROD.

REFERENCE DRAWINGS:
5613-M-3036 SH. 1
5613-M-3041 SH. 1
5613-M-3041 SH. 2
5613-M-3050 SH. 1
5613-M-3062 SH. 1
5613-M-3065 SH. 1
5613-M-3061 SH. 1

SAMPLE SYSTEM
REACTOR COOLANT SYSTEM
LOOPS
REACTOR COOLANT SYSTEM
PRESSURIZER
RESIDUAL HEAT REMOVAL
SAFETY INJECTION SYSTEM
NITROGEN & HYDROGEN
WASTE DISPOSAL SYSTEM

| REV | DATE | REVISION | BY | CH | APP | APP | REV | DATE | REVISION | BY | CH | APP | APP |
|-----|----------|---|----|----|-----|-----|-----|----------|---|-----|----|-----|-----|
| 18 | 2-3-99 | ISSUED AS-BUILT PER CRN-M-9584 (PC/M 98-045). | RH | RV | DF | JJC | 21 | 10-02-01 | ISSUED AS-BUILT FOR PC/M 93-047. | RH | JK | PRB | JM |
| 26 | 5-28-12 | ISSUED AS-BUILT PER EC 242466. | RV | SB | - | BAB | 20 | 5-10-00 | ISSUED AS-BUILT PER CRN'S M-10039 & M-10065 (PC/M 99-061). | RH | RV | JK | ASD |
| 25 | 3-29-09 | ISSUED AS-BUILT PER CRN'S M-12615, M-12614, M-12619, M-12623 & M-12626 (PC/M 09-003). | RV | DM | MCT | DM | 19 | 3-18-00 | ISSUED AS-BUILT PER CRN-M-9923 (PC/M 99-046) AND CRN-M-9993 (PC/M 99-061). | JPC | RH | JK | ASD |
| 24 | 5-22-06 | ISSUED AS-BUILT PER CRN-M-11669 (PC/M 03-106). | RH | RV | BSC | JTL | - | - | - | GFH | MD | PRB | LRB |
| 23 | 6-23-03 | ISSUED AS-BUILT PER CRN-M-10746 (PC/M 02-065). | RH | RV | AAP | JTL | 0 | 4-2-91 | THIS DWG CREATED PER THE P & ID RECONSTITUTION PROJECT SCOPE AND ISSUED INTO THE FPL DWG SYSTEM PER DCR-TPM-91-044. | GFH | MD | PRB | LRB |
| 22 | 10-17-01 | ISSUED AS-BUILT PER PC/M 01-014. | RH | RV | ASD | JMM | - | - | - | BY | CH | APP | APP |

TURKEY POINT NUCLEAR UNIT 3

SAFETY INJECTION
ACCUMULATOR SYSTEM
INSIDE CONTAINMENT

STONE & WEBSTER ENGINEERING CORP.
FT. LAUDERDALE, FLORIDA

DRAWING NUMBER
5613-M-3064


SHEET 1

POD

064

REV
26

5613-M-3064 SH. 1.DWG

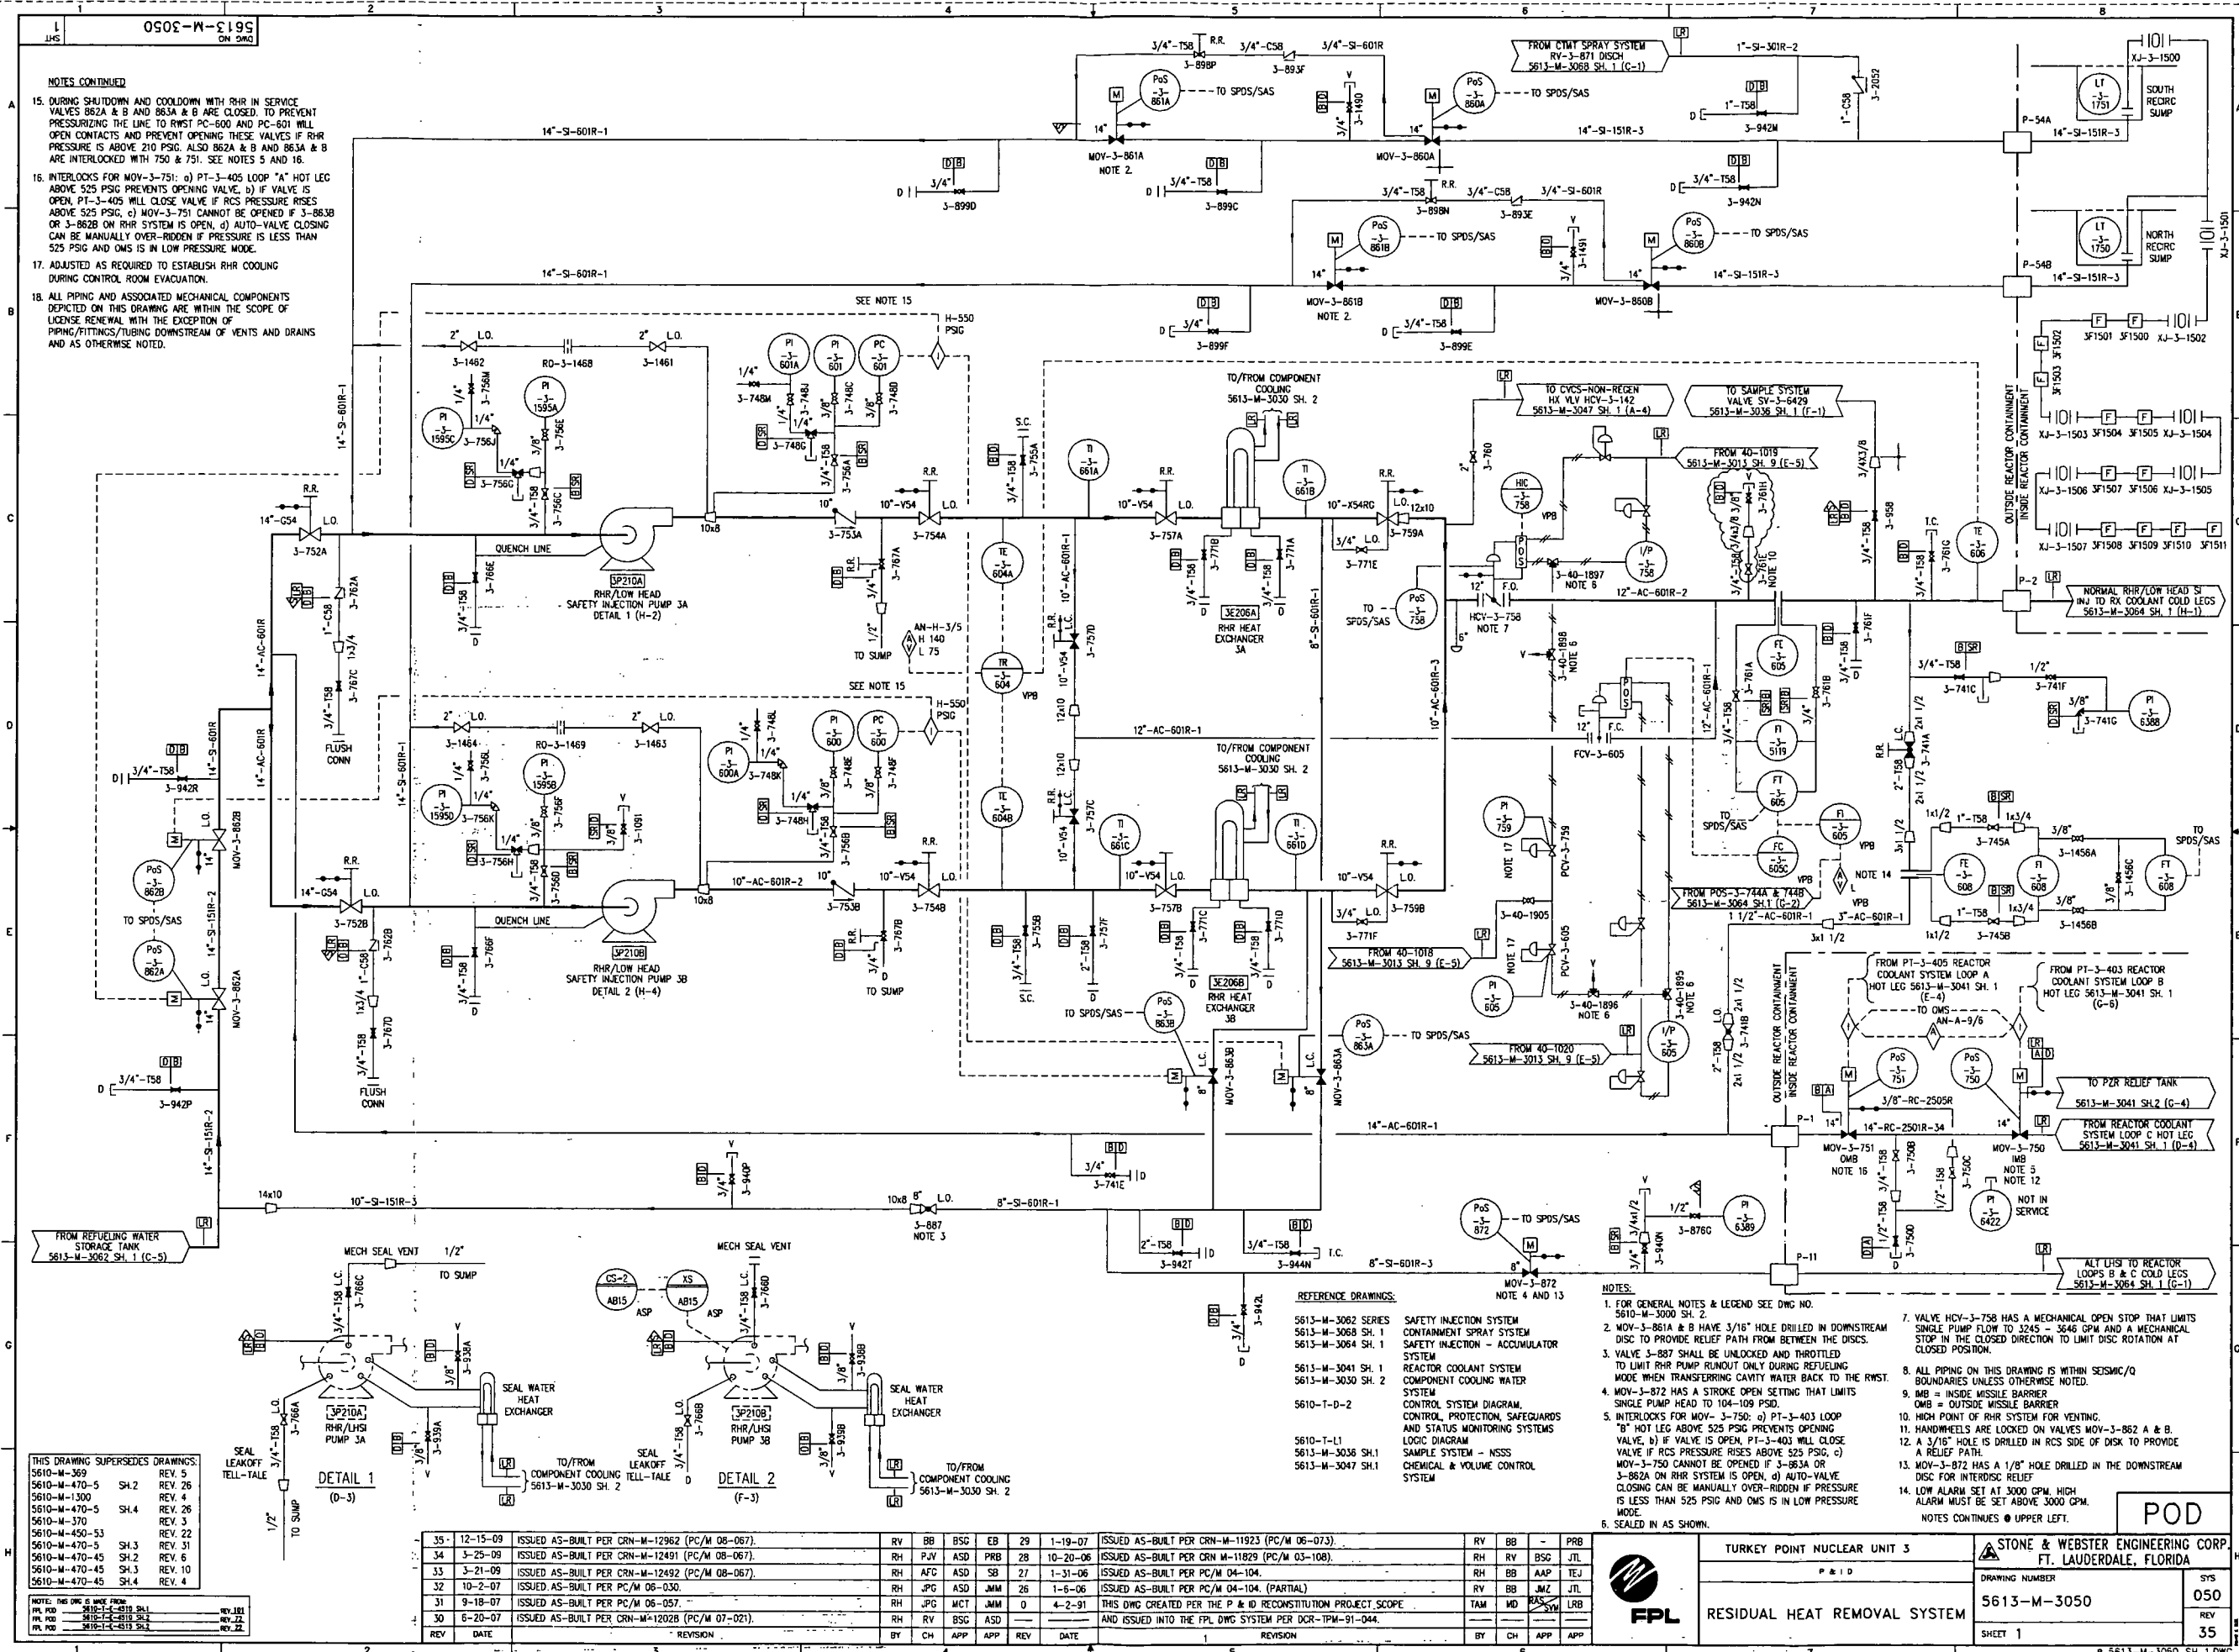

NOTES CONTINUED

15. DURING SHUTDOWN AND COOLDOWN WITH RHR IN SERVICE VALVES 862A & B AND 863A & B ARE CLOSED. TO PREVENT PRESSURIZING THE LINE TO RWST PC-600 AND PC-601 WILL OPEN CONTACTS AND PREVENT OPENING THESE VALVES IF RHR PRESSURE IS ABOVE 210 PSIG. ALSO 862A & B AND 863A & B ARE INTERLOCKED WITH 750 & 751. SEE NOTES 5 AND 16.

16. INTERLOCKS FOR MOV-3-751: a) PT-3-405 LOOP "A" HOT LEG ABOVE 525 PSIG PREVENTS OPENING VALVE. b) IF VALVE IS OPEN, PT-3-405 WILL CLOSE VALVE IF RCS PRESSURE RISES ABOVE 525 PSIG. c) MOV-3-751 CANNOT BE OPENED IF 3-863B OR 3-862B ON RHR SYSTEM IS OPEN. d) AUTO-VALVE CLOSING CAN BE MANUALLY OVER-RIDDEN IF PRESSURE IS LESS THAN 525 PSIG AND OMS IS IN LOW PRESSURE MODE.

17. ADJUSTED AS REQUIRED TO ESTABLISH RHR COOLING DURING CONTROL ROOM EVACUATION.

18. ALL PIPING AND ASSOCIATED MECHANICAL COMPONENTS DEPICTED ON THIS DRAWING ARE WITHIN THE SCOPE OF LICENSE RENEWAL WITH THE EXCEPTION OF PIPING/FITTINGS/TUBING DOWNSTREAM OF VENTS AND DRAINS AND AS OTHERWISE NOTED.

THIS DRAWING SUPERSEDES DRAWINGS:

| DWG NO. | REV. | DATE |
|---------------|---------|----------|
| 5610-M-369 | REV. 5 | 12-15-09 |
| 5610-M-470-5 | SH.2 | REV. 26 |
| 5610-M-1300 | REV. 4 | REV. 26 |
| 5610-M-470-5 | SH.4 | REV. 26 |
| 5610-M-370 | REV. 3 | REV. 26 |
| 5610-M-450-53 | REV. 22 | REV. 26 |
| 5610-M-470-5 | SH.3 | REV. 31 |
| 5610-M-470-45 | SH.2 | REV. 6 |
| 5610-M-470-45 | SH.3 | REV. 10 |
| 5610-M-470-45 | SH.4 | REV. 4 |

NOTES: THIS Dwg IS MADE FROM:
REV. 101
REV. 22
REV. 22

| | | | | | | | | | | | | | |
|-----|----------|--|----|-----|-----|-----|-----|----------|--|-----|----|-----|-----|
| 35 | 12-15-09 | ISSUED AS-BUILT PER CRN-M-12962 (PC/M 08-067). | RV | BB | BSG | EB | 29 | 1-19-07 | ISSUED AS-BUILT PER CRN-M-11923 (PC/M 06-073). | RV | BB | - | PRB |
| 34 | 3-25-09 | ISSUED AS-BUILT PER CRN-M-12491 (PC/M 08-067). | RH | PJV | ASD | PRB | 28 | 10-20-06 | ISSUED AS-BUILT PER CRN-M-11829 (PC/M 03-108). | RH | RV | BSG | JTL |
| 33 | 3-21-09 | ISSUED AS-BUILT PER CRN-M-12492 (PC/M 08-067). | RH | AFC | ASD | SB | 27 | 1-31-06 | ISSUED AS-BUILT PER PC/M 04-104. | RH | BB | AAP | TEJ |
| 32 | 10-2-07 | ISSUED AS-BUILT PER PC/M 06-030. | RH | JPG | ASD | JMM | 26 | 1-6-06 | ISSUED AS-BUILT PER PC/M 04-104. (PARTIAL) | RV | BB | JAZ | JTL |
| 31 | 9-18-07 | ISSUED AS-BUILT PER PC/M 06-057. | RH | JPG | MCT | JMM | 0 | 4-2-91 | THIS DWG CREATED PER THE P & ID RECONSTITUTION PROJECT SCOPE | TAM | MD | BSG | LRB |
| 30 | 6-20-07 | ISSUED AS-BUILT PER CRN-M-12028 (PC/M 07-021). | RH | RV | BSG | ASD | - | - | AND ISSUED INTO THE FPL DWG SYSTEM PER DCR-TPM-91-044. | - | - | - | - |
| REV | DATE | REVISION | BY | CH | APP | APP | REV | DATE | REVISION | BY | CH | APP | APP |

REFERENCE DRAWINGS:

- 5613-M-3062 SERIES SAFETY INJECTION SYSTEM
- 5613-M-3068 SH. 1 CONTAINMENT SPRAY SYSTEM
- 5613-M-3064 SH. 1 SAFETY INJECTION - ACCUMULATOR
- 5613-M-3041 SH. 1 REACTOR COOLANT SYSTEM
- 5613-M-3030 SH. 2 COMPONENT COOLING WATER SYSTEM
- 5610-T-D-2 CONTROL SYSTEM DIAGRAM, CONTROL, PROTECTION, SAFEGUARDS AND STATUS MONITORING SYSTEMS
- 5610-T-L1 LOGIC DIAGRAM
- 5613-M-3036 SH.1 SAMPLE SYSTEM - NSSS
- 5613-M-3047 SH.1 CHEMICAL & VOLUME CONTROL SYSTEM

NOTES:

- FOR GENERAL NOTES & LEGEND SEE Dwg NO. 5610-M-3000 SH. 2.
- MOV-3-861A & B HAVE 3/16" HOLE DRILLED IN DOWNSTREAM DISC TO PROVIDE RELIEF PATH FROM BETWEEN THE DISCS.
- VALVE 3-887 SHALL BE UNLOCKED AND THROTTLED TO LIMIT RHR PUMP RUNOUT ONLY DURING REFUELING MODE WHEN TRANSFERRING CAVITY WATER BACK TO THE RWST.
- MOV-3-872 HAS A STROKE OPEN SETTING THAT LIMITS SINGLE PUMP HEAD TO 104-109 PSID.
- INTERLOCKS FOR MOV-3-750: a) PT-3-403 LOOP "B" HOT LEG ABOVE 525 PSIG PREVENTS OPENING VALVE. b) IF VALVE IS OPEN, PT-3-403 WILL CLOSE VALVE IF RCS PRESSURE RISES ABOVE 525 PSIG. c) MOV-3-750 CANNOT BE OPENED IF 3-863A OR 3-862A ON RHR SYSTEM IS OPEN. d) AUTO-VALVE CLOSING CAN BE MANUALLY OVER-RIDDEN IF PRESSURE IS LESS THAN 525 PSIG AND OMS IS IN LOW PRESSURE MODE.
- SEALED IN AS SHOWN.
- VALVE HCV-3-758 HAS A MECHANICAL OPEN STOP THAT LIMITS SINGLE PUMP FLOW TO 1245 - 3546 GPM AND A MECHANICAL STOP IN THE CLOSED DIRECTION TO LIMIT DISC ROTATION AT CLOSED POSITION.
- ALL PIPING ON THIS DRAWING IS WITHIN SEISMIC/O BOUNDARIES UNLESS OTHERWISE NOTED.
- IMB = INSIDE MISSILE BARRIER
- OMB = OUTSIDE MISSILE BARRIER
- HIGH POINT OF RHR SYSTEM FOR VENTING.
- HANDWHEELS ARE LOCKED ON VALVES MOV-3-862 A & B.
- A 3/16" HOLE IS DRILLED IN RCS SIDE OF DISK TO PROVIDE A RELIEF PATH.
- MOV-3-872 HAS A 1/8" HOLE DRILLED IN THE DOWNSTREAM DISC FOR INTERDISC RELIEF.
- LOW ALARM SET AT 3000 GPM. HIGH ALARM MUST BE SET ABOVE 3000 GPM.

POD

NOTES CONTINUES UPPER LEFT.

TURKEY POINT NUCLEAR UNIT 3

P & ID

STONE & WEBSTER ENGINEERING CORP.
FT. LAUDERDALE, FLORIDA


DRAWING NUMBER

5613-M-3050


SHEET 1

REV 050

REV 35

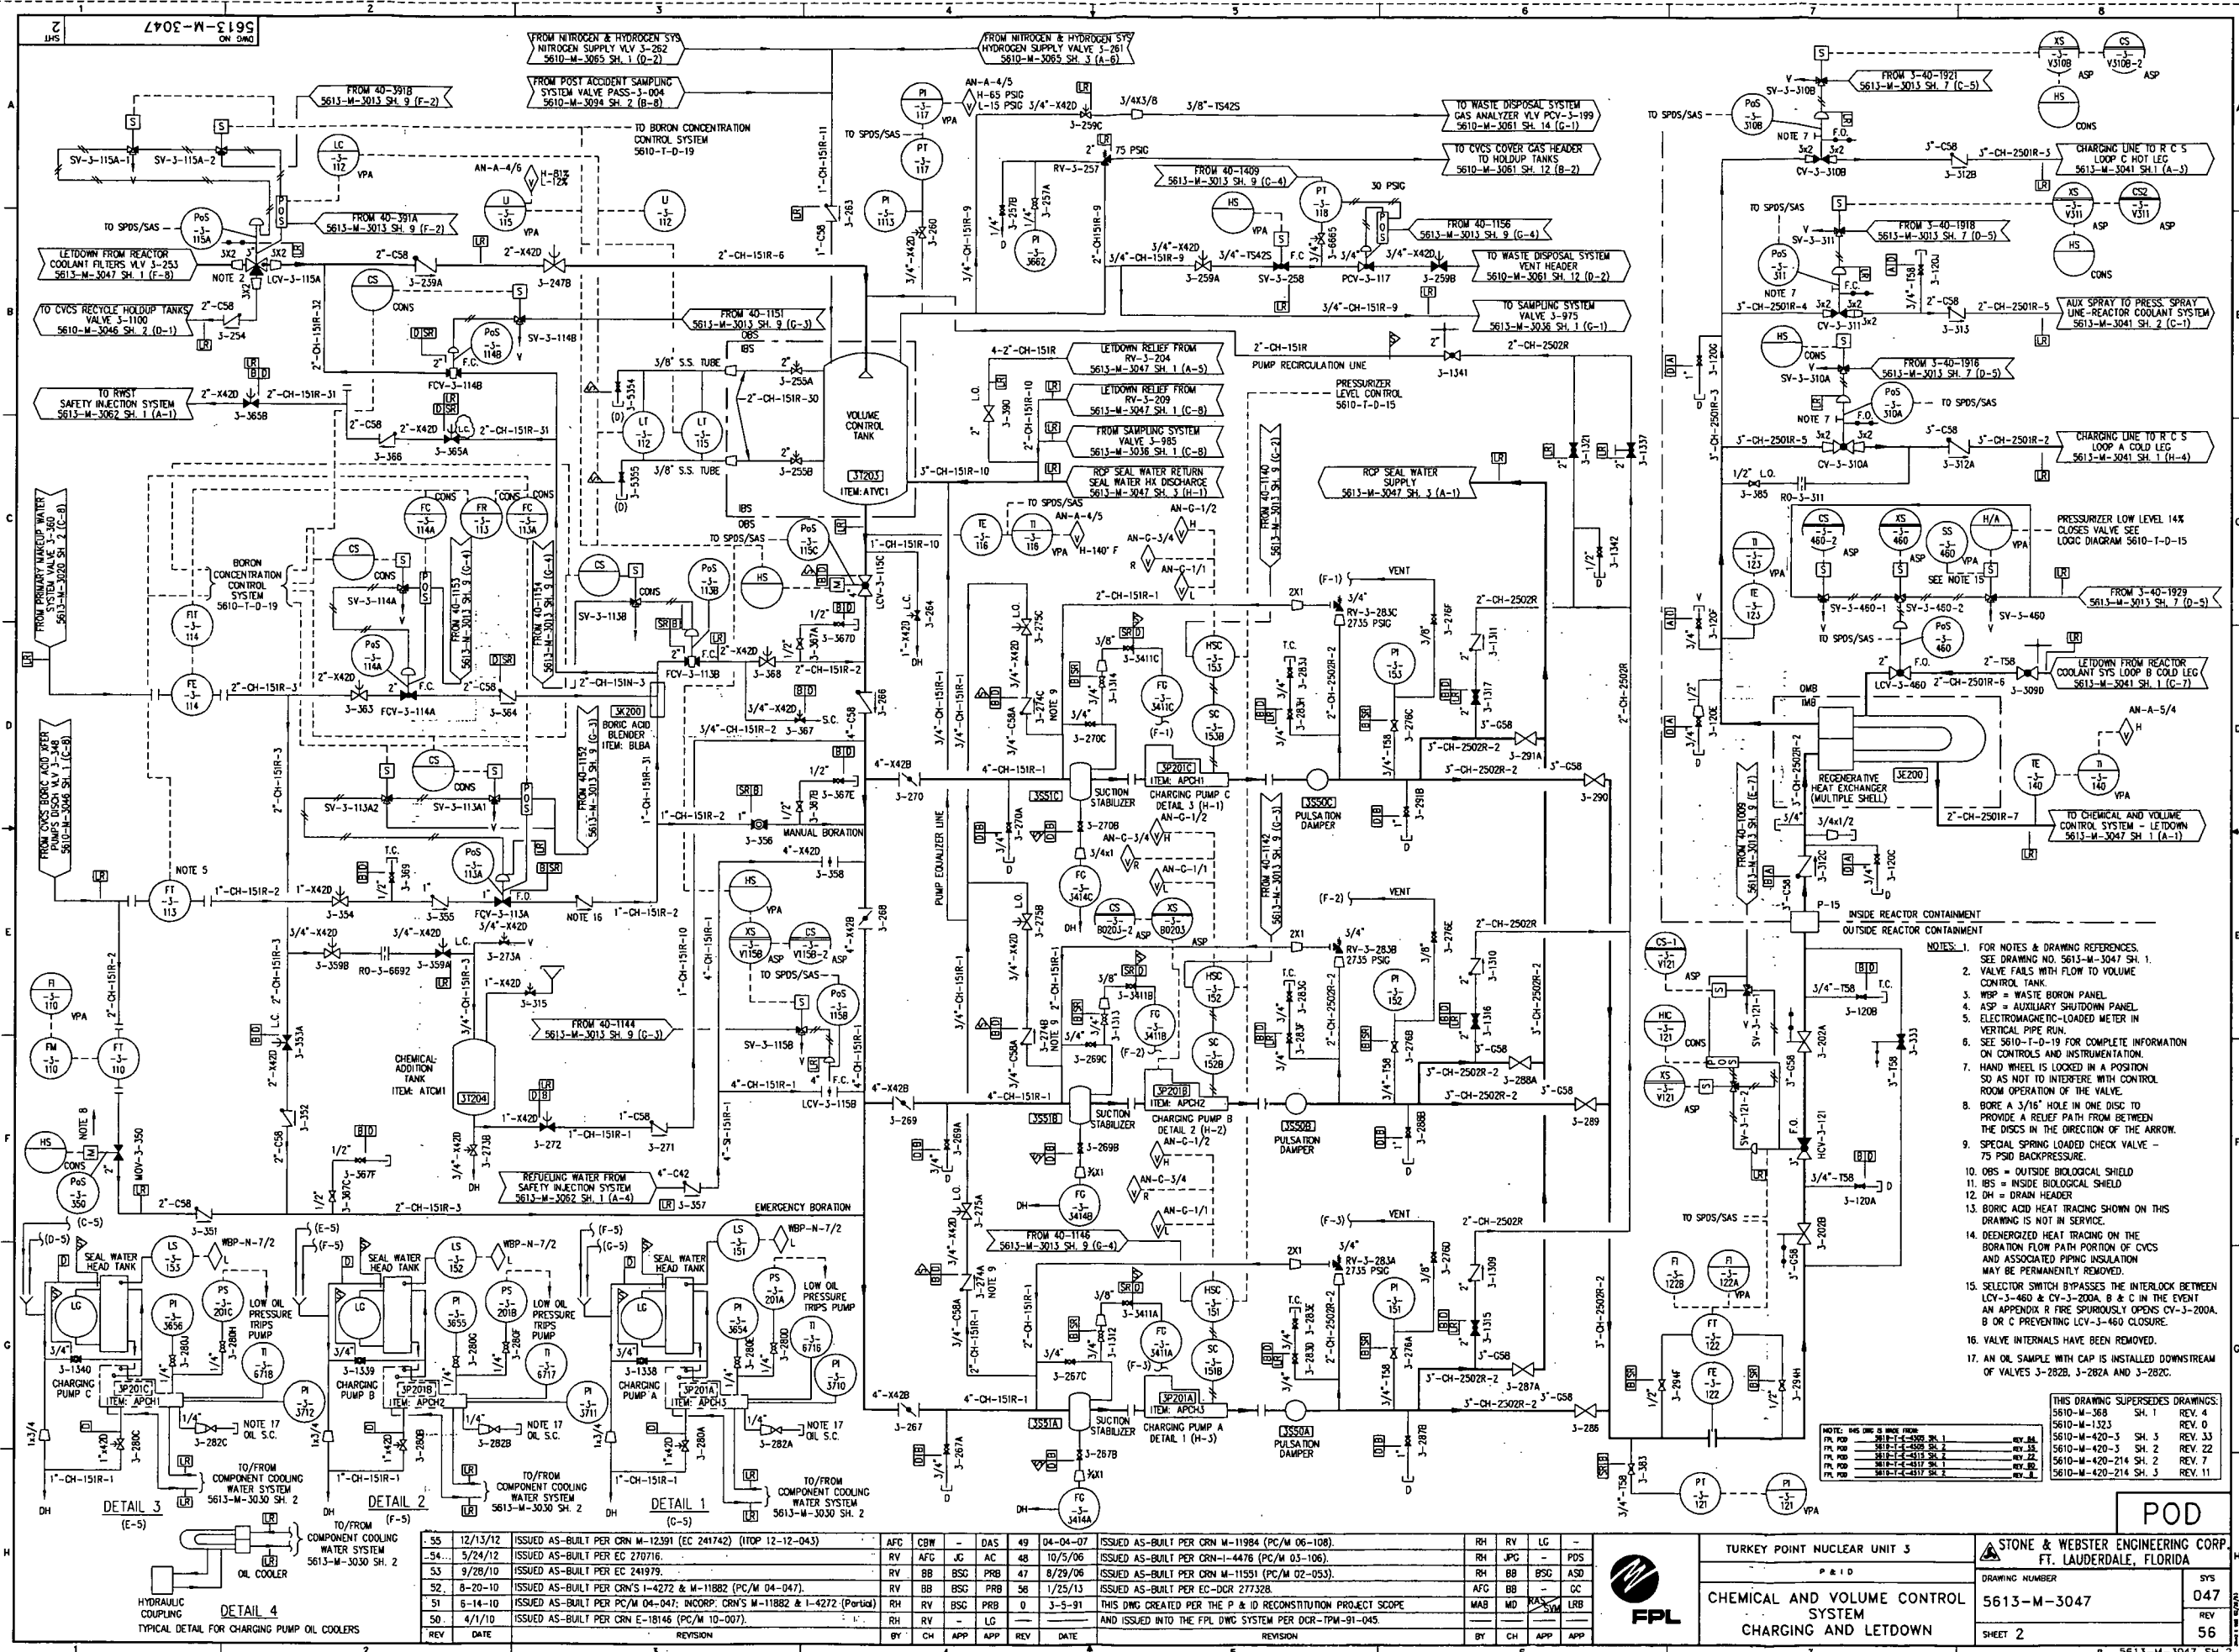

| REV | DATE | REVISION | BY | CH | APP | REV | DATE | REVISION | BY | CH | APP |
|-----|----------|---|-----|-----|-----|-----|----------|--|-----|-----|-----|
| 35 | 12/13/12 | ISSUED AS-BUILT PER CRN M-12391 (EC 241742) (TDP 12-12-043) | AFG | CBW | - | 49 | 04-04-07 | ISSUED AS-BUILT PER CRN M-11984 (PC/M 06-108) | RH | RV | LG |
| 34 | 5/24/12 | ISSUED AS-BUILT PER EC 270716 | RV | AFG | JC | 48 | 10/5/06 | ISSUED AS-BUILT PER CRN-14476 (PC/M 03-106) | RH | JPC | - |
| 33 | 9/26/10 | ISSUED AS-BUILT PER EC 241978 | RV | BB | BSC | 47 | 8/29/06 | ISSUED AS-BUILT PER CRN-11551 (PC/M 02-053) | RH | BB | BSC |
| 32 | 8-20-10 | ISSUED AS-BUILT PER CRN'S 1-4272 & M-11882 (PC/M 04-047) | RV | BB | BSC | 56 | 1/25/13 | ISSUED AS-BUILT PER EC-DCR 277328 | AFG | BB | - |
| 31 | 6-14-10 | ISSUED AS-BUILT PER PC/M 04-047; INCORP. CRN'S M-11882 & 1-4272 (Portals) | RH | RV | BSC | 0 | 3-5-91 | THIS DWG CREATED PER THE P & ID RECONSTITUTION PROJECT SCOPE | MAB | MD | RAS |
| 30 | 4/1/10 | ISSUED AS-BUILT PER CRN E-18146 (PC/M 10-007) | RH | RV | - | - | - | AND ISSUED INTO THE FPL DMC SYSTEM PER DCR-TPM-91-045 | MAB | CH | APP |



TURKEY POINT NUCLEAR UNIT 3

CHARGE AND VOLUME CONTROL SYSTEM

SHEET 2

POD

5613-M-3047

047

56

STONE & WEBSTER ENGINEERING CORP.

FT. LAUDERDALE, FLORIDA

DRAWING NUMBER

REV. 4

REV. 0


REV. 33

REV. 22


REV. 7

REV. 11

- NOTES:
- FOR NOTES AND DRAWING REFERENCES, SEE DRAWING NO. 5613-M-3047 SH. 1.
 - VALVE FAILS WITH FLOW TO VOLUME CONTROL TANK.
 - WBP = WASTE BORON PANEL.
 - ASP = AUXILIARY SHUTDOWN PANEL.
 - ELECTROMAGNETIC-LOADED METER IN VERTICAL PIPE RUN.
 - SEE 5610-T-0-19 FOR COMPLETE INFORMATION ON CONTROLS AND INSTRUMENTATION.
 - HAND WHEEL IS LOCKED IN A POSITION SO AS NOT TO INTERFERE WITH CONTROL ROOM OPERATION OF THE VALVE.
 - BORE A 3/16" HOLE IN ONE DISC TO PROVIDE A RELIEF PATH FROM BETWEEN THE DISCS IN THE DIRECTION OF THE ARROW.
 - SPECIAL SPRING LOADED CHECK VALVE - 75 PSID BACKPRESSURE.
 - OBS = OUTSIDE BIOLOGICAL SHIELD.
 - IBS = INSIDE BIOLOGICAL SHIELD.
 - DH = DRAIN HEADER.
 - BORIC ACID HEAT TRACING SHOWN ON THIS DRAWING IS NOT IN SERVICE.
 - DEENERGIZED HEAT TRACING ON THE BORATION FLOW PATH PORTION OF CVCS AND ASSOCIATED PIPING INSULATION MAY BE PERMANENTLY REMOVED.
 - SELECTOR SWITCH BYPASSES THE INTERLOCK BETWEEN LCV-3-460 & CV-3-200A, B & C IN THE EVENT AN APPENDIX R FIRE SPURIOUSLY OPENS CV-3-200A, B OR C PREVENTING LCV-3-460 CLOSURE.
 - VALVE INTERNALS HAVE BEEN REMOVED.
 - AN OIL SAMPLE WITH CAP IS INSTALLED DOWNSTREAM OF VALVES 3-282B, 3-282A AND 3-282C.

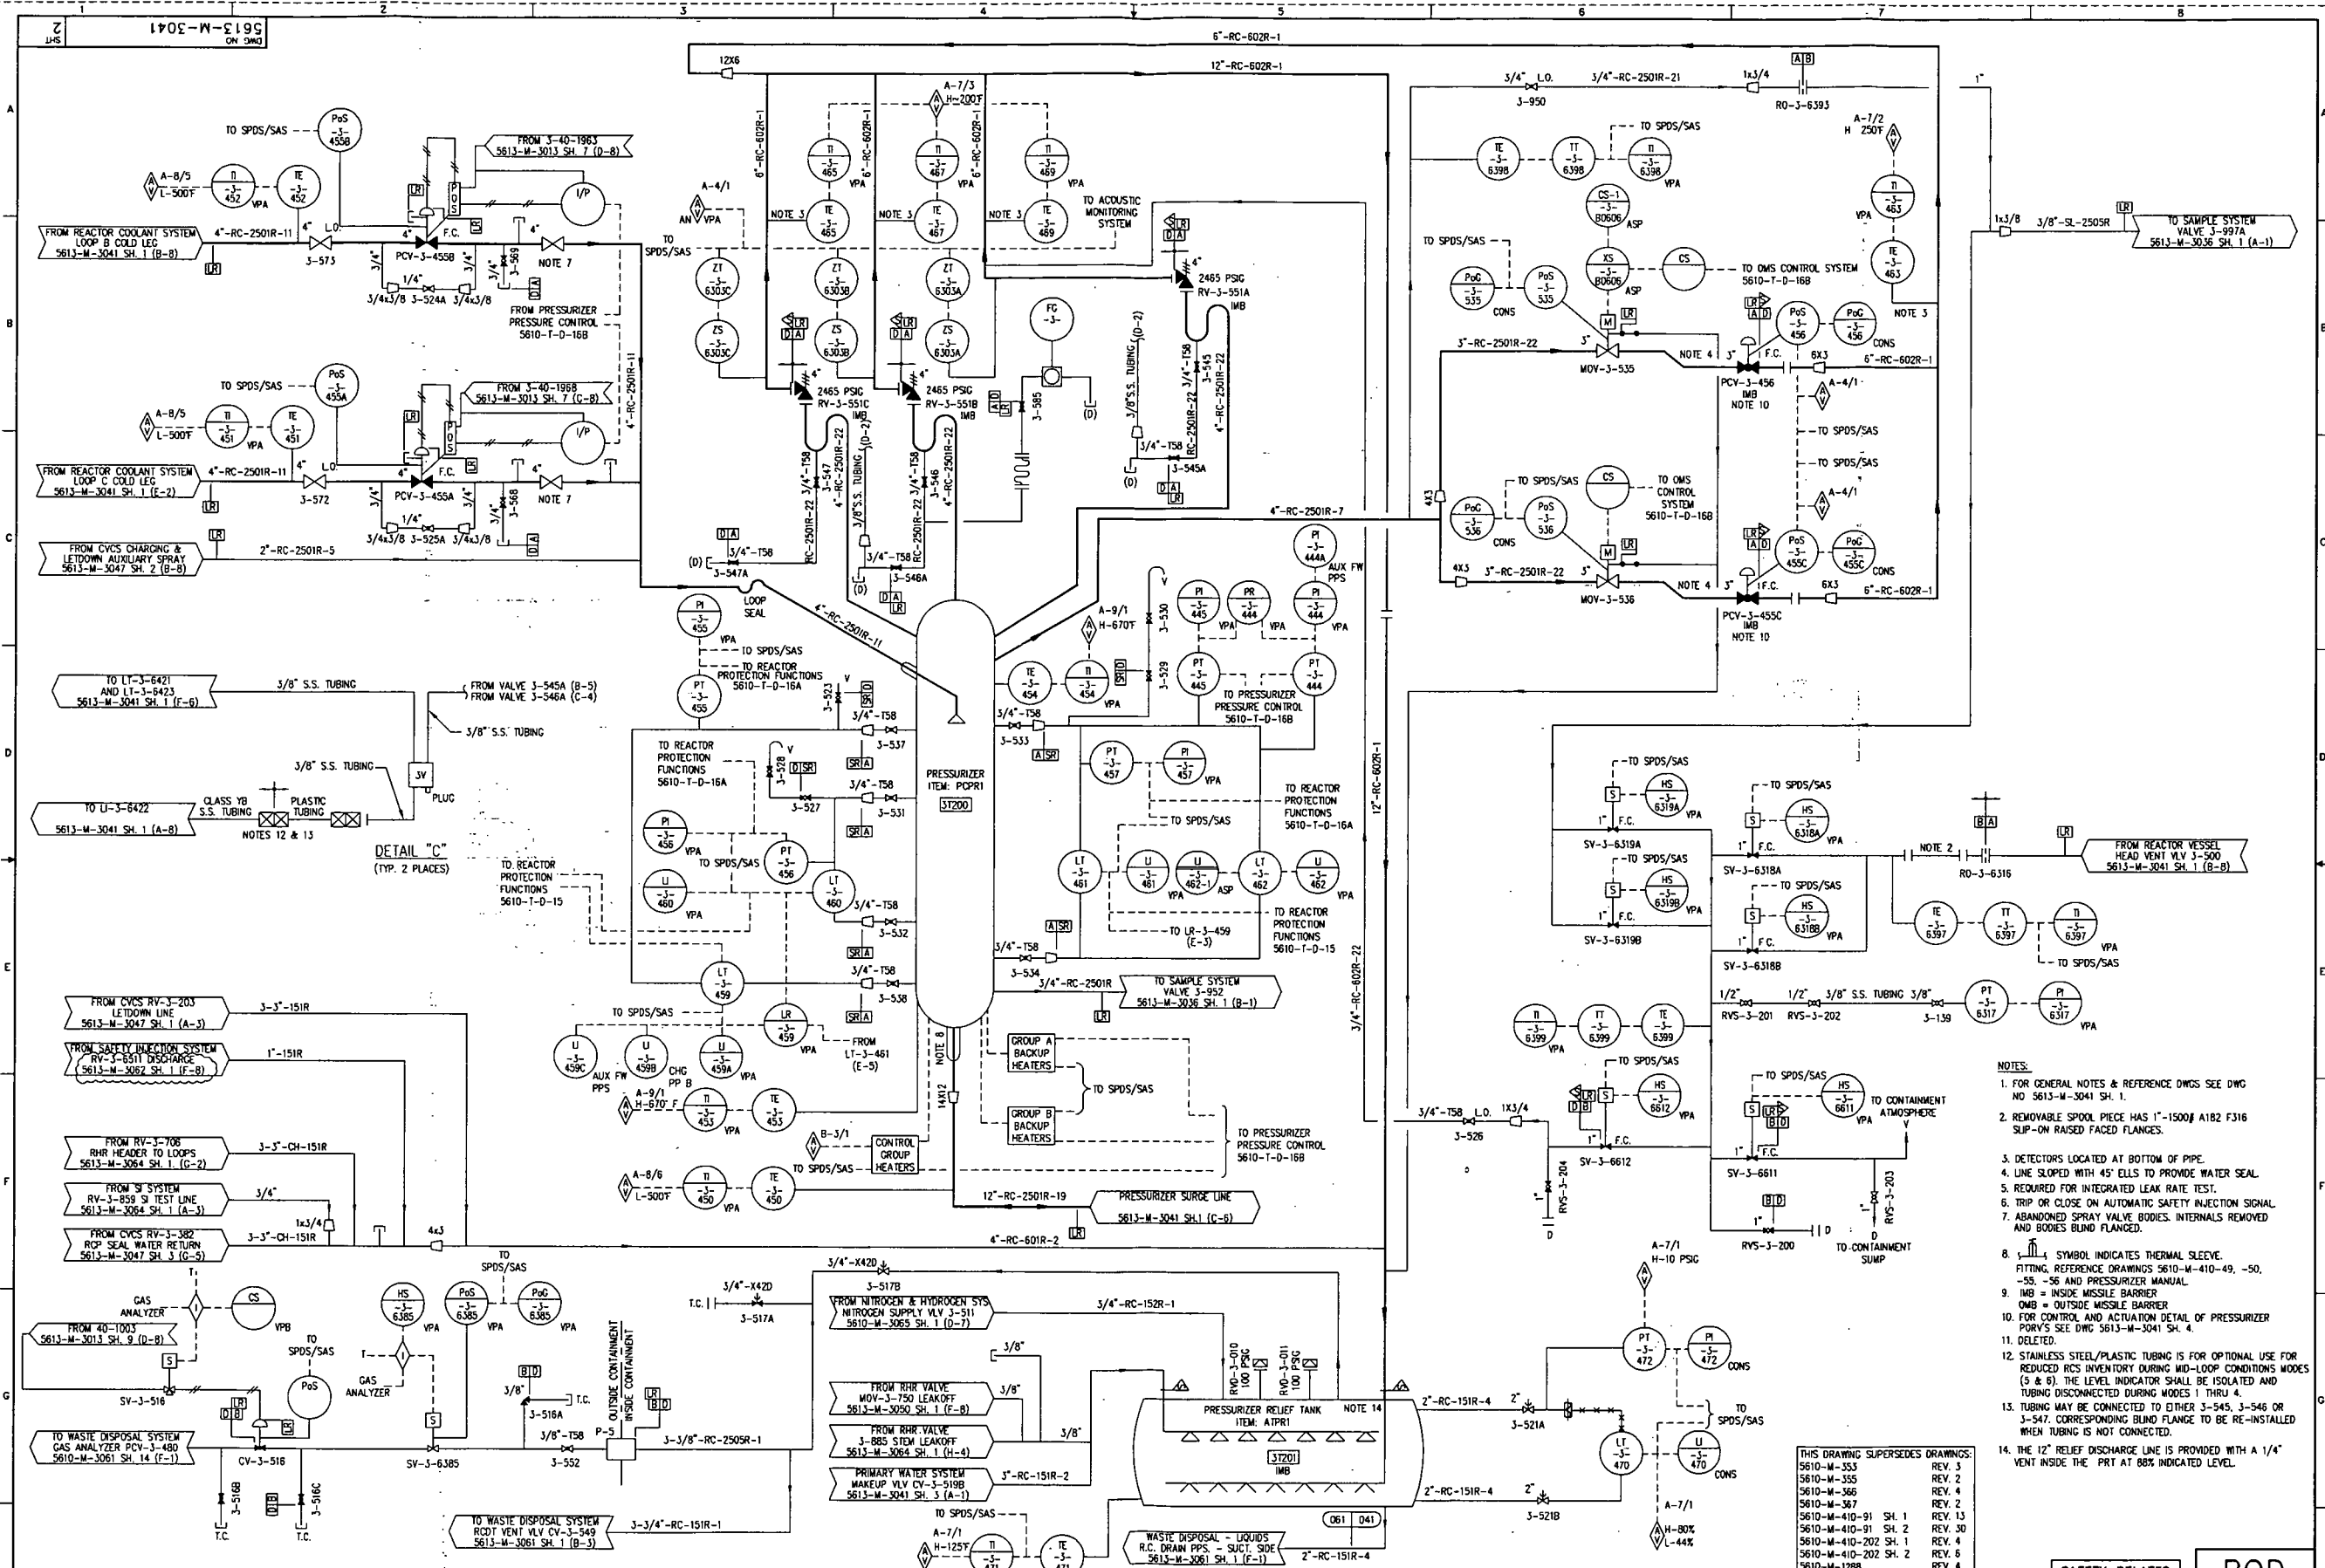

| | | | |
|---|---------|--|-------------------------|
| NOTE: THIS DWG IS MADE FROM: FPL P00 5610-T-E-4501 SH. 1 FPL P00 5610-T-E-4517 SH. 2 | | REV. 90 REV. 8 | |
| 43 | 7/13/12 | ISSUED AS-BUILT PER EC 246977 (PC/M 09-083). | RV BB AN JD 37 3-26-06 |
| 42 | 7/12/12 | ISSUED AS-BUILT PER EC 246924. | RH RV PSB JD 36 7-11-05 |
| 41 | 7/1/12 | ISSUED AS-BUILT PER EC 246924 (PARTIAL). | AFB SB BP 35 12-2-04 |
| 40 | 5/24/12 | ISSUED AS-BUILT PER EC 242470. | AFB BB AC 44 8-02-12 |
| 39 | 9/28/09 | ISSUED AS-BUILT PER CRN-I-5092 (PC/M 09-070). | RV RH LG 0 2-15-91 |
| 38 | 9/25/06 | ISSUED AS-BUILT PER CRN-M-11759 (PC/M 03-106) | RH RV BSG JTL |
| REV. DATE | | REVISION | |
| BY | CH | APP | APP |
| DATE | DATE | DATE | DATE |
| THIS DRAWING SUPERSEDES DRAWINGS: 5610-M-353 REV. 3 5610-M-355 REV. 2 5610-M-366 REV. 4 5610-M-367 REV. 2 5610-M-410-91 SH. 1 5610-M-410-91 SH. 2 5610-M-410-202 SH. 1 5610-M-410-202 SH. 2 5610-M-1288 REV. 4 5610-M-1310 REV. 2 | | ISSUED AS-BUILT PER PC/M 04-012 AND INCORP. CRN M-11529. ISSUED AS-BUILT PER CRN-M-11395 (PC/M 03-106). ISSUED AS-BUILT PER PC/M 04-157. ISSUED AS-BUILT PER EC-00R 277023. THIS DRAWING CREATED PER THE P & ID RECONSTRUCTION PROJECT SCOPE AND ISSUED INTO THE FPL SYSTEM PER DCR-TPM-91-043. | |
| RH | SB | BSG | JTL |
| RH | RHV | AAP | PRB |
| RH | RV | AAP | JMM |
| RH | RV | AC | JG |
| TAM | HLG | AN | LRB |
| BY | CH | APP | APP |
| TURKEY POINT NUCLEAR UNIT 3 | | P & ID | |
| REACTOR COOLANT SYSTEM | | SHEET 2 | |
| SAFETY RELATED | | POD | |
| STONE & WEBSTER ENGINEERING CORP. FT. LAUDERDALE, FLORIDA | | DRAWING NUMBER 5613-M-3041 | |
| | | SYS 041 | |
| | | REV 44 | |

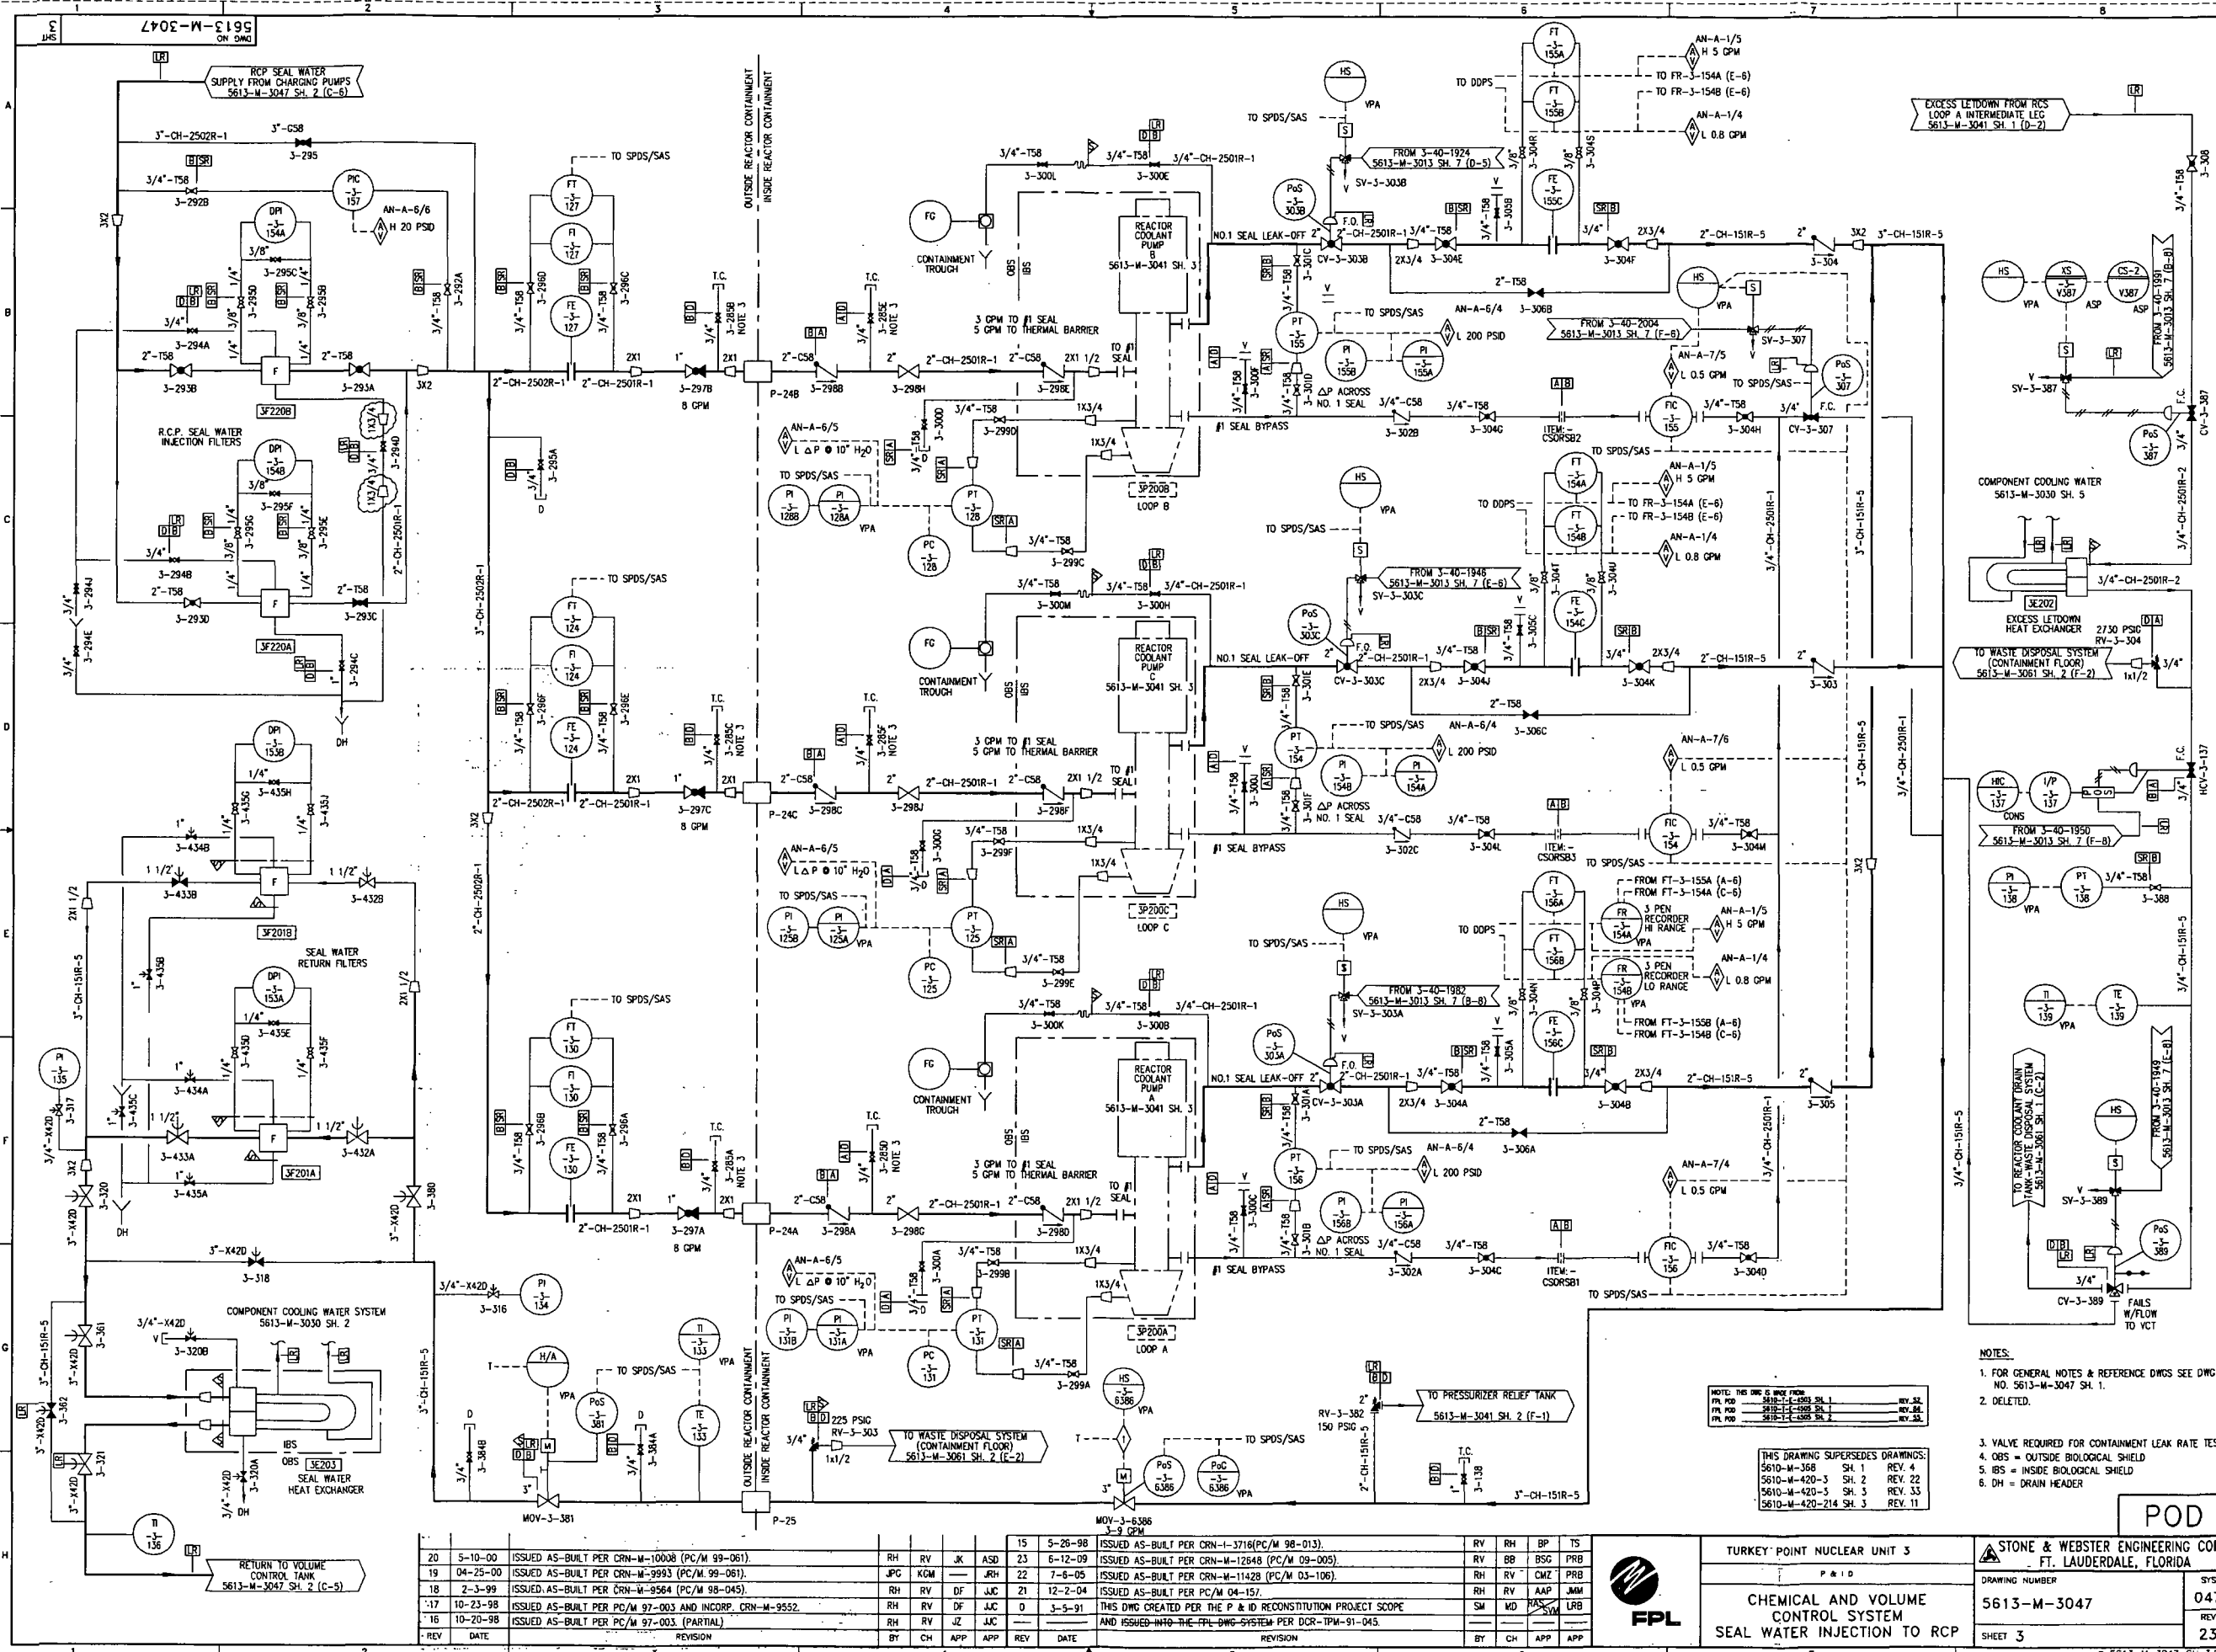

THIS DRAWING SUPERSEDES DRAWINGS:
5613-M-3047 SH. 1 REV. 4
5613-M-3047 SH. 2 REV. 22
5613-M-3047 SH. 3 REV. 33
5613-M-3047 SH. 4 REV. 11

- NOTES:
- FOR GENERAL NOTES & REFERENCE DWGS SEE DWG NO. 5613-M-3047 SH. 1.
 - DELETED.
 - VALVE REQUIRED FOR CONTAINMENT LEAK RATE TEST.
 - OBS = OUTSIDE BIOLOGICAL SHIELD
 - IBS = INSIDE BIOLOGICAL SHIELD
 - DH = DRAIN HEADER


| C-9 TQM | | | | | | | | | | | | | |
|---------|----------|---|-----|-----|-----|-----|------|----------|---|-----|-----|-----|-----|
| 20 | 5-10-00 | ISSUED AS-BUILT PER CRN-M-10008 (PC/M 99-061). | RH | RV | JK | ASD | 23 | 5-26-98 | ISSUED AS-BUILT PER CRN-M-13716 (PC/M 98-013). | RV | RH | BP | TS |
| 19 | 04-25-00 | ISSUED AS-BUILT PER CRN-M-9993 (PC/M 99-061). | JPC | KCM | JK | JRH | 22 | 6-12-09 | ISSUED AS-BUILT PER CRN-M-12648 (PC/M 09-005). | RV | BB | BSC | PRB |
| 18 | 2-3-99 | ISSUED AS-BUILT PER CRN-M-9564 (PC/M 98-045). | RH | RV | DF | JJC | 21 | 7-8-05 | ISSUED AS-BUILT PER CRN-M-11428 (PC/M 03-106). | RH | RV | CMZ | PRB |
| 17 | 10-23-98 | ISSUED AS-BUILT PER PC/M 97-003 AND INCORP. CRN-M-9552. | RH | RV | DF | JJC | 21 | 12-2-04 | ISSUED AS-BUILT PER PC/M 04-157. | RH | RV | AAP | JMM |
| 16 | 10-20-98 | ISSUED AS-BUILT PER PC/M 97-003 (PARTIAL). | RH | RV | JZ | JJC | 20 | 3-5-91 | THIS DWG CREATED PER THE P & ID RECONSTITUTION PROJECT SCOPE AND ISSUED INTO THE FPL DWG SYSTEM PER DCR-TPW-91-043. | SM | MD | RAS | LBB |
| REV | DATE | REVISION | BY | CHK | APP | REV | DATE | REVISION | BY | CHK | APP | APP | |



TURKEY POINT NUCLEAR UNIT 3
P & ID
CHEMICAL AND VOLUME
CONTROL SYSTEM
SEAL WATER INJECTION TO RCP

STONE & WEBSTER ENGINEERING CORP.
FT. LAUDERDALE, FLORIDA
DRAWING NUMBER
5613-M-3047
SHEET 3
SYS
047
REV
23

POD

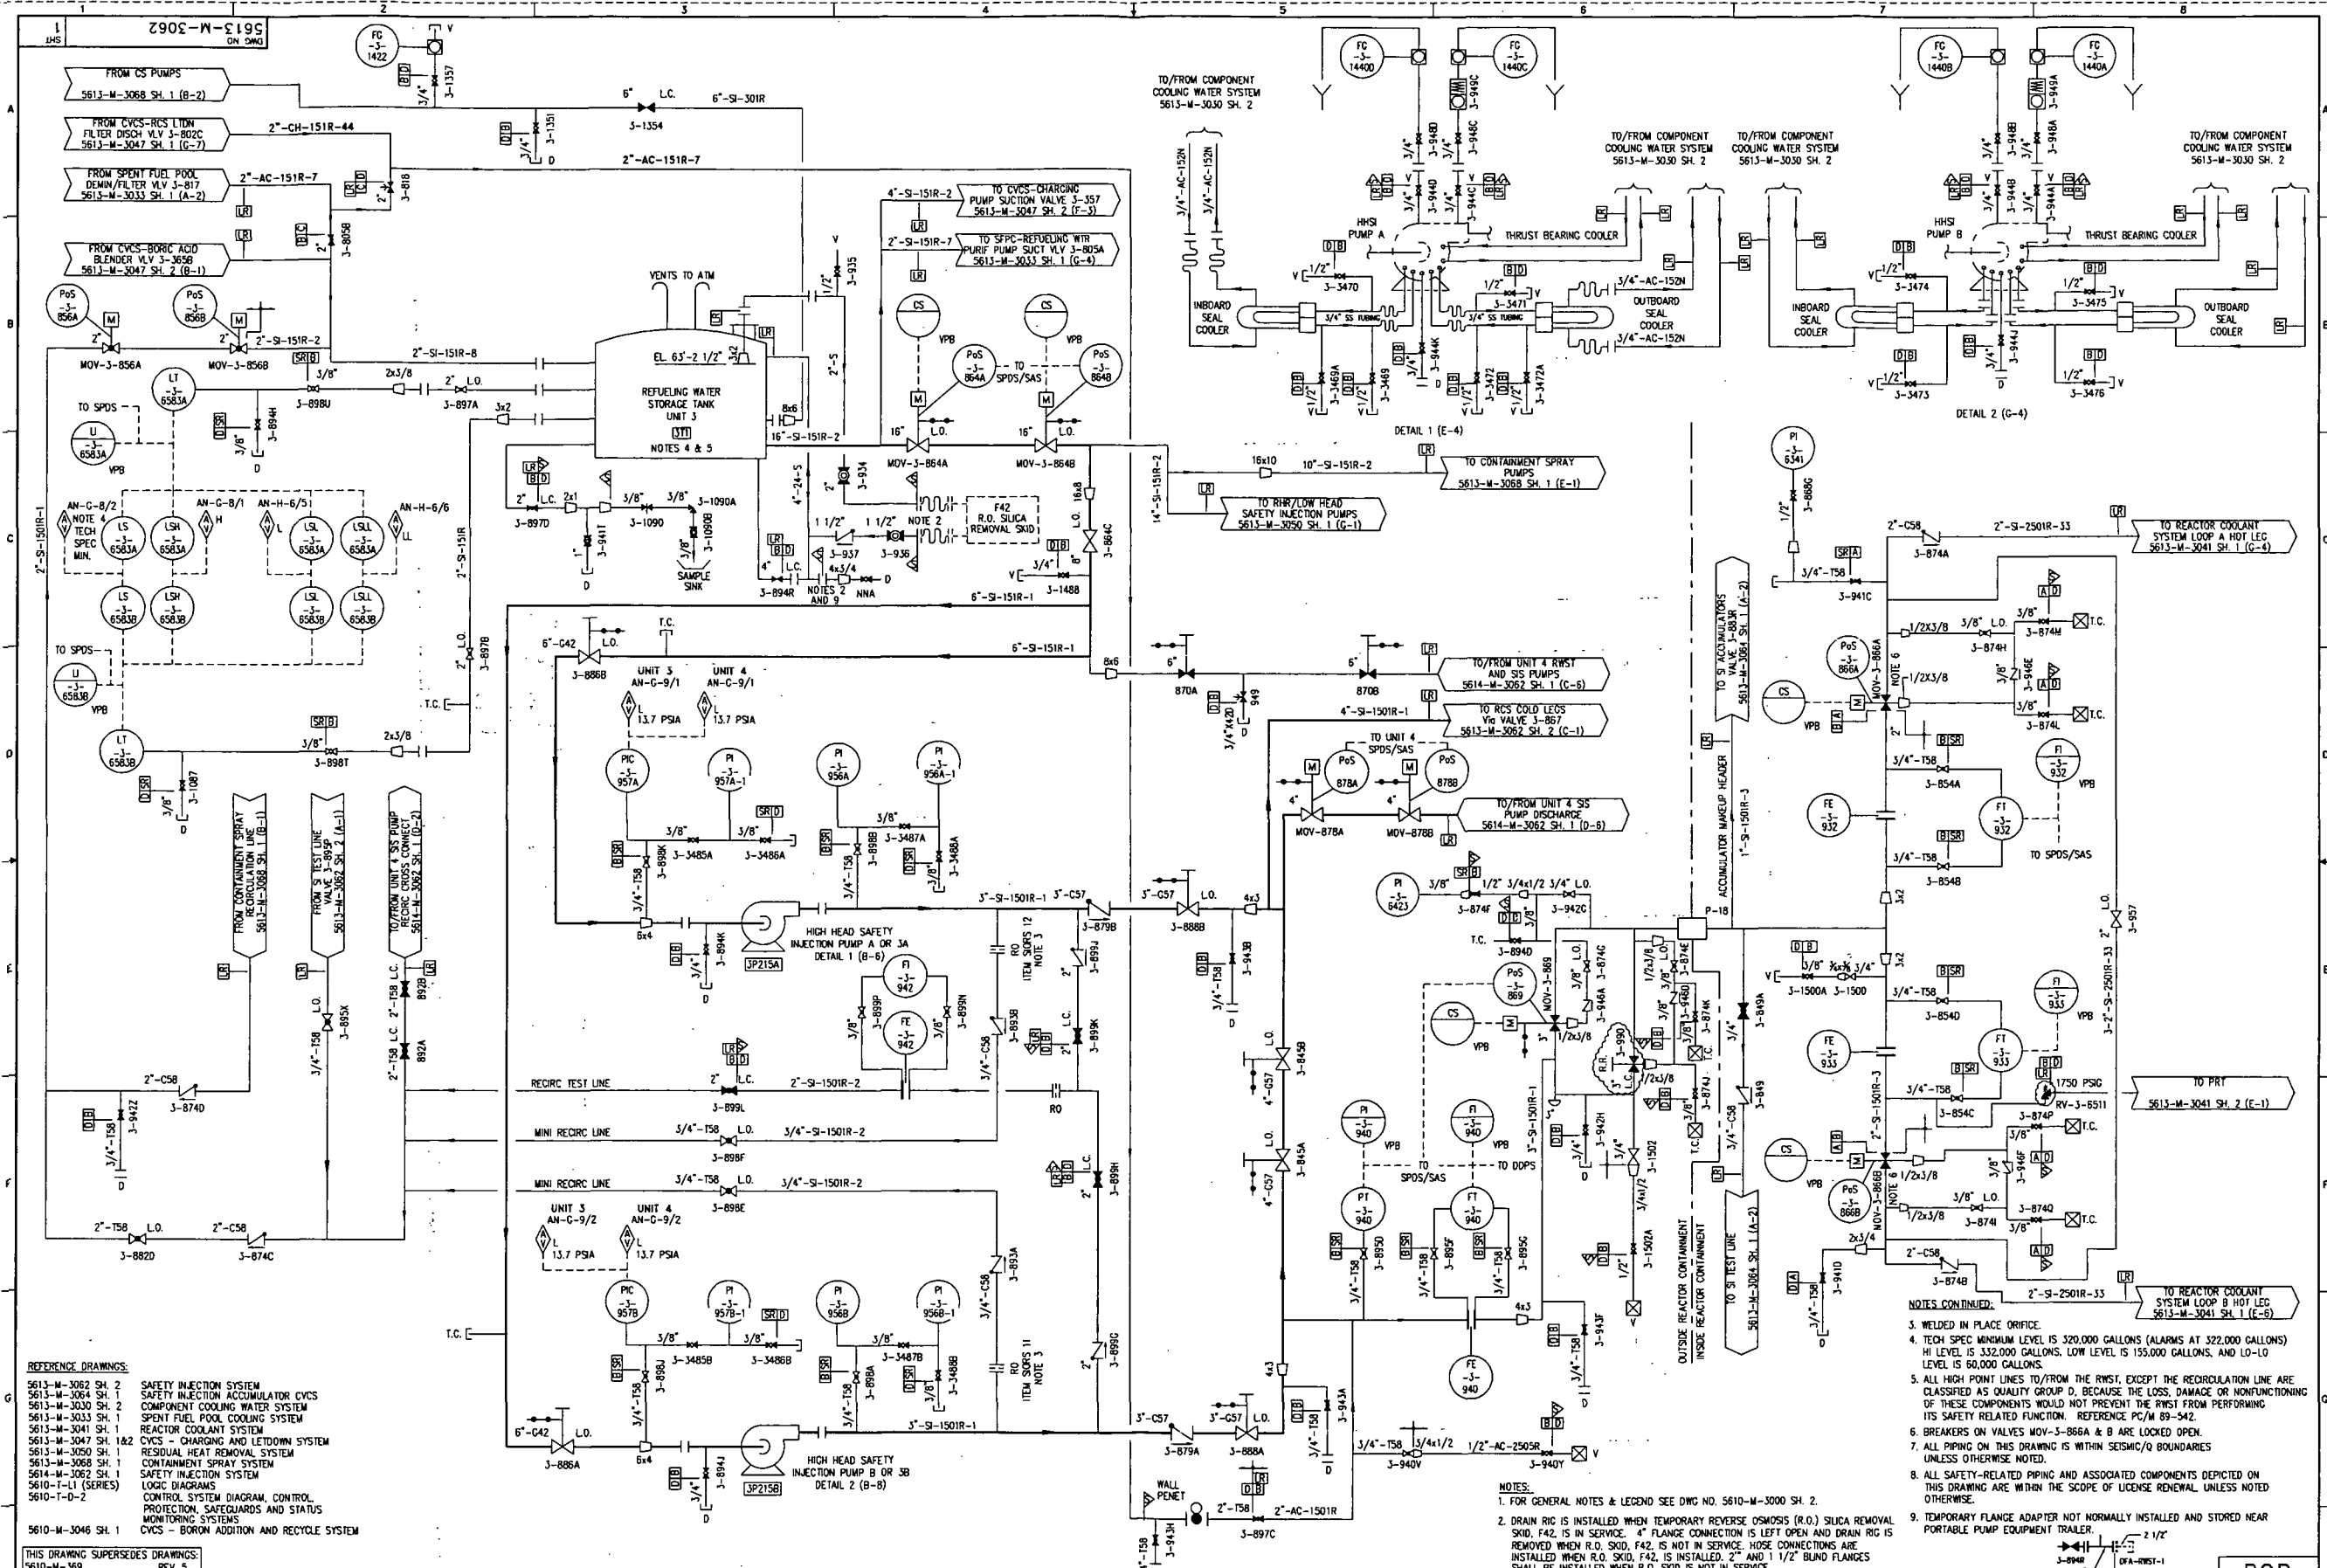

REFERENCE DRAWINGS:
5613-M-3062 SH. 2 SAFETY INJECTION SYSTEM
5613-M-3064 SH. 1 SAFETY INJECTION ACCUMULATOR CYCLES
5613-M-3030 SH. 2 COMPONENT COOLING WATER SYSTEM
5613-M-3033 SH. 1 SPENT FUEL POOL COOLING SYSTEM
5613-M-3041 SH. 1 REACTOR COOLANT SYSTEM
5613-M-3047 SH. 1&2 CYCLES - CHARGING AND LETDOWN SYSTEM
5613-M-3050 SH. 1 RESIDUAL HEAT REMOVAL SYSTEM
5613-M-3068 SH. 1 CONTAINMENT SPRAY SYSTEM
5614-M-3062 SH. 1 SAFETY INJECTION SYSTEM
5610-T-10-2 LOGIC DIAGRAMS
5610-T-10-2 CONTROL SYSTEM DIAGRAM, STATUS
5610-T-10-2 PROTECTION, SAFEGUARDS AND STATUS
5610-T-10-2 MONITORING SYSTEMS
5610-M-3046 SH. 1 CYCLES - BORON ADDITION AND RECYCLE SYSTEM

THIS DRAWING SUPERSEDES DRAWINGS:
5610-M-369 REV. 5
5610-M-370 REV. 3
5610-M-380 REV. 5
5610-M-470-5 SH. 1 REV. 21
5610-M-470-5 SH. 2 REV. 26
5610-M-470-5 SH. 4 REV. 26
5610-M-470-5 SH. 1 REV. 5
5610-M-470-5 SH. 2 REV. 6
5610-M-470-5 SH. 4 REV. 4
5610-M-1300 REV. 4
5610-M-1387 REV. 2

| REV | DATE | REVISION |
|-----|----------|---|
| 40 | 5-28-12 | ISSUED AS-BUILT PER EC 242466-- |
| 39 | 5-24-12 | ISSUED AS-BUILT PER EC 247012 (PARTIAL). |
| 38 | 5-18-12 | ISSUED AS-BUILT PER CRN-004 (EC 242267); CRN-002 (EC 247012). |
| 37 | 4-18-12 | ISSUED AS-BUILT PER EC 247012 (PC/M 09-143) AND INCORP CRN-005. (PARTIAL) |
| 36 | 12/14/10 | ISSUED AS-BUILT PER EC 270396. |
| 35 | 10-12-10 | ISSUED AS-BUILT PER EC 242393 & INCORP. CRN 004. |

| REV | DATE | REVISION |
|-----|------|--------------------|
| RV | SB | - BAB 34 10-4-10 |
| AFG | BB | - MUF 33 6-30-09 |
| RH | CW | - PRB 42 7-13-12 |
| RV | BB | - RV 41 6-20-12 |
| RH | RV | - BSC VMC 0 4-2-91 |
| RH | SB | - KKD RSV |


| REV | DATE | REVISION |
|-----|------|-----------|
| RH | RV | - LC RSV |
| RV | BB | - JKP PRB |
| RH | CR | - JLF |
| RH | RV | - MCF |
| MAB | MD | - PAX |
| BY | CH | - APP APP |



TURKEY POINT NUCLEAR UNIT 3
P & ID
SAFETY INJECTION SYSTEM

STONE & WEBSTER ENGINEERING CORP.
FT. LAUDERDALE, FLORIDA
DRAWING NUMBER
5613-M-3062
SHEET 1
SYS
062
REV
42

POD

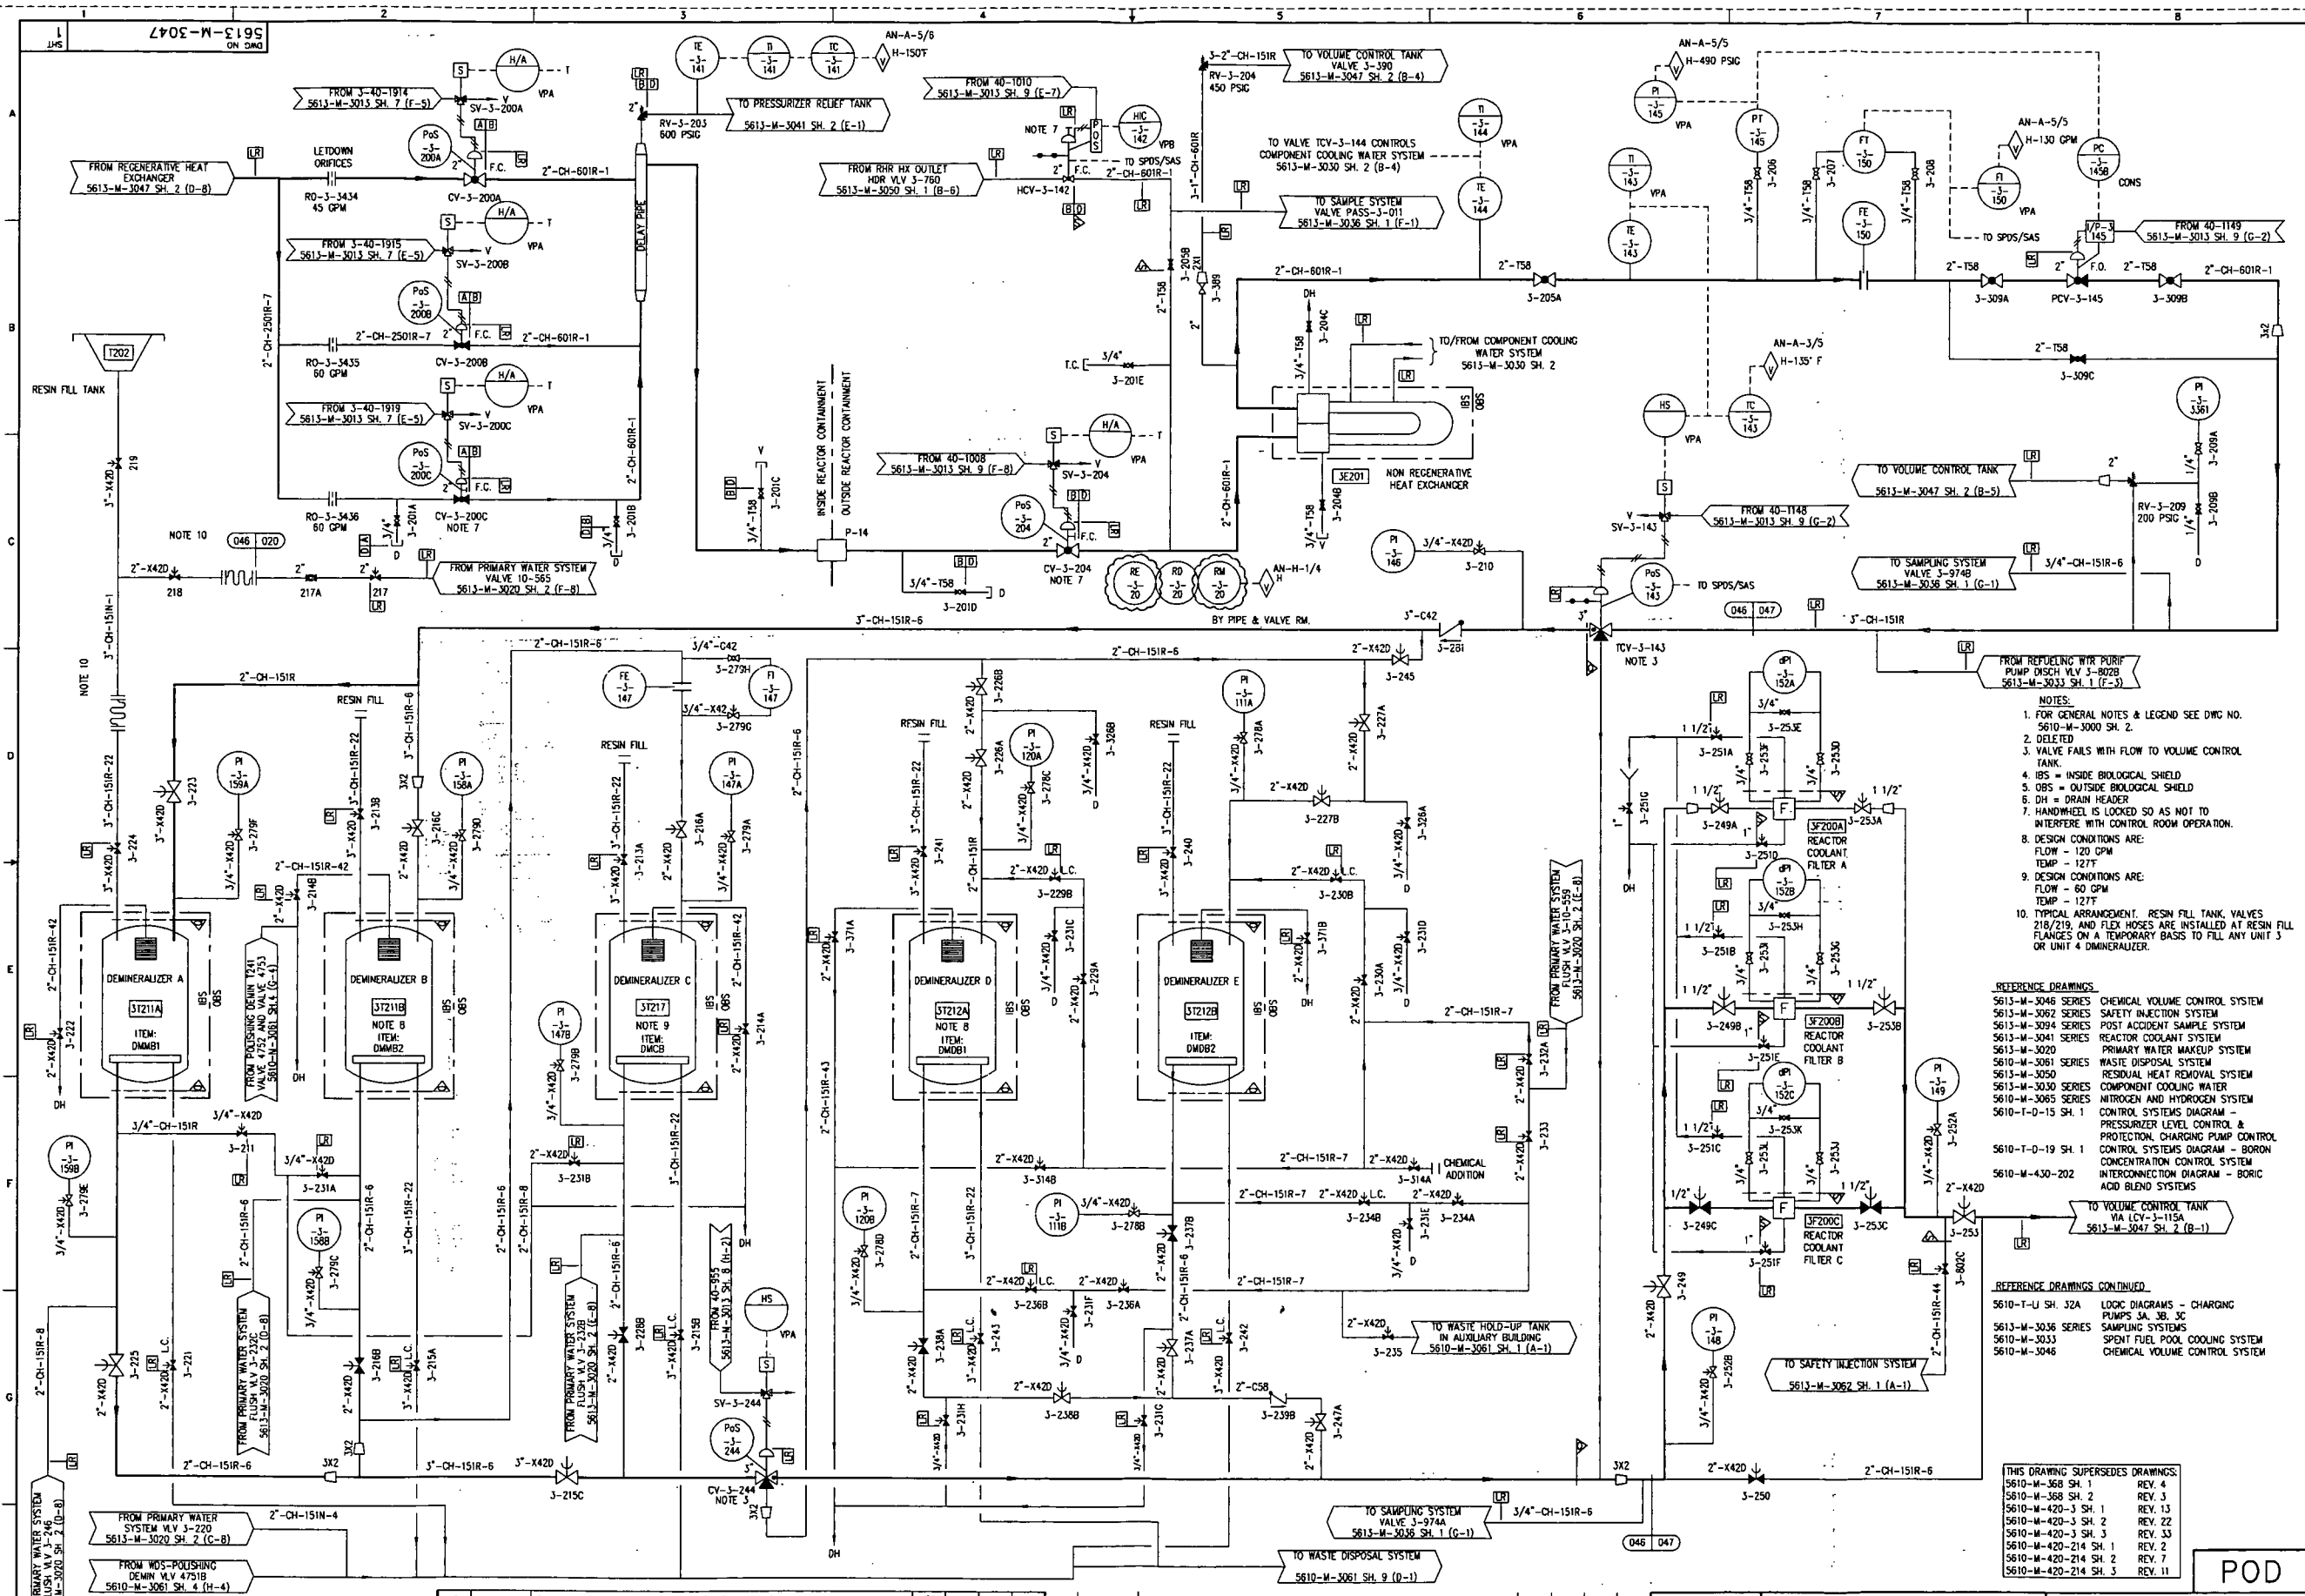

| | | | | | | | | | | | | | |
|--|---------|--|-----|----|-----|-----|---------|--|---|--|-----|-----|-----|
| NOTE: THIS DWG IS MADE FROM: FPL P00 5610-T-E-4505 SH. 1 FPL P00 5610-T-E-4505 SH. 2 FPL P00 5610-T-E-4505 SH. 3 FPL P00 5610-T-E-4515 SH. 2 | | | | | | | | | | REV. 84 REV. 85 REV. 87 REV. 88 REV. 89 REV. 90 REV. 91 REV. 92 | | | |
| 16 | 3-6-00 | ISSUED AS-BUILT PER CRN-M-9848 (PC/M 99-046), CRN-M-9991 (PC/M 99-061) AND CRN-M-9993 (PC/M 99-061). | JPC | RH | BSG | JML | 19 | 3/8/05 | ISSUED AS-BUILT PER CRN-M-11262 (PC/M 03-106). | RH | RRW | BSG | JTL |
| 15 | 11-9-99 | ISSUED AS-BUILT PER CRN-M-9790, M-9794 (PC/M 99-033). | RH | RV | CMZ | JTL | 18 | 10/15/04 | ISSUED AS-BUILT PER PC/M 03-132. | RH | SB | PRB | JTL |
| 22 | 5/23/12 | ISSUED AS-BUILT PER EC 244766. | RV | RH | MA | 17 | 6-17-02 | ISSUED AS-BUILT PER CRN-M-10465 (PC/M 00-016). | RH | RV | ACM | JTL | |
| 21 | 9/21/09 | ISSUED AS-BUILT PER PC/M 06-103. | RV | RH | BB | SB | 0 | 3-5-91 | THIS DWG CREATED PER THE P & ID RECONSTITUTION PROJECT SCOPE AND ISSUED INTO THE FPL DWG SYSTEM PER DCR-TPM-91-045. | MAB | MD | PAC | LIB |
| 20 | 6/1/07 | ISSUED AS-BUILT PER CRN-M-11762 (PC/M 03-106). | RH | RV | PJV | RSV | | | | BY | CH | APP | APP |
| REV | DATE | REVISION | BY | CH | APP | APP | REV | DATE | REVISION | BY | CH | APP | APP |

TURKEY POINT NUCLEAR UNIT 3
P & ID
CHEMICAL AND VOLUME CONTROL SYSTEM
CHARGING AND LETDOWN

STONE & WEBSTER ENGINEERING CORP.
FT. LAUDERDALE, FLORIDA

DRAWING NUMBER
5613-M-3047


SHEET 1

THIS DRAWING SUPERSEDES DRAWINGS:
5610-M-368 SH. 1 REV. 8
5610-M-368 SH. 2 REV. 9
5610-M-420-3 SH. 1 REV. 13
5610-M-420-3 SH. 2 REV. 22
5610-M-420-3 SH. 3 REV. 33
5610-M-420-214 SH. 1 REV. 2
5610-M-420-214 SH. 2 REV. 7
5610-M-420-214 SH. 3 REV. 11

POD
047
REV
22

- NOTES:
- FOR GENERAL NOTES & LEGEND SEE DWG NO. 5610-M-3000 SH. 2.
 - DELETED
 - VALVE FAILS WITH FLOW TO VOLUME CONTROL TANK.
 - IBS = INSIDE BIOLOGICAL SHIELD
 - OBS = OUTSIDE BIOLOGICAL SHIELD
 - DH = DRAIN HEADER
 - HANDWHEEL IS LOCKED SO AS NOT TO INTERFERE WITH CONTROL ROOM OPERATION.
 - DESIGN CONDITIONS ARE:
FLOW - 120 GPM
TEMP - 127°F
 - DESIGN CONDITIONS ARE:
FLOW - 60 GPM
TEMP - 127°F
 - TYPICAL ARRANGEMENT. RESIN FILL TANK VALVES 218/219, AND FLEX HOSES ARE INSTALLED AT RESIN FILL FLANGES ON A TEMPORARY BASIS TO FILL ANY UNIT 3 OR UNIT 4 DEMINERALIZER.


- REFERENCE DRAWINGS:
- 5613-M-3046 SERIES CHEMICAL VOLUME CONTROL SYSTEM
 - 5613-M-3062 SERIES SAFETY INJECTION SYSTEM
 - 5613-M-3094 SERIES POST ACCIDENT SAMPLE SYSTEM
 - 5613-M-3041 SERIES REACTOR COOLANT SYSTEM
 - 5613-M-3020 PRIMARY WATER MAKEUP SYSTEM
 - 5610-M-3081 SERIES WASTE DISPOSAL SYSTEM
 - 5613-M-3050 RESIDUAL HEAT REMOVAL SYSTEM
 - 5613-M-3030 SERIES COMPONENT COOLING WATER
 - 5610-M-3065 SERIES NITROGEN AND HYDROGEN SYSTEM
 - 5610-T-0-15 SH. 1 CONTROL SYSTEMS DIAGRAM - PRESSURIZER LEVEL CONTROL & PROTECTION, CHARGING PUMP CONTROL
 - 5610-T-0-19 SH. 1 CONTROL SYSTEMS DIAGRAM - BORON CONCENTRATION CONTROL SYSTEM
 - 5610-M-430-202 INTERCONNECTION DIAGRAM - BORIC ACID BLEND SYSTEMS
- REFERENCE DRAWINGS CONTINUED:
- 5610-T-U SH. 32A LOGIC DIAGRAMS - CHARGING PUMPS SA, SB, SC
 - 5613-M-3036 SERIES SAMPLING SYSTEMS
 - 5610-M-3033 SPENT FUEL POOL COOLING SYSTEM
 - 5610-M-3046 CHEMICAL VOLUME CONTROL SYSTEM

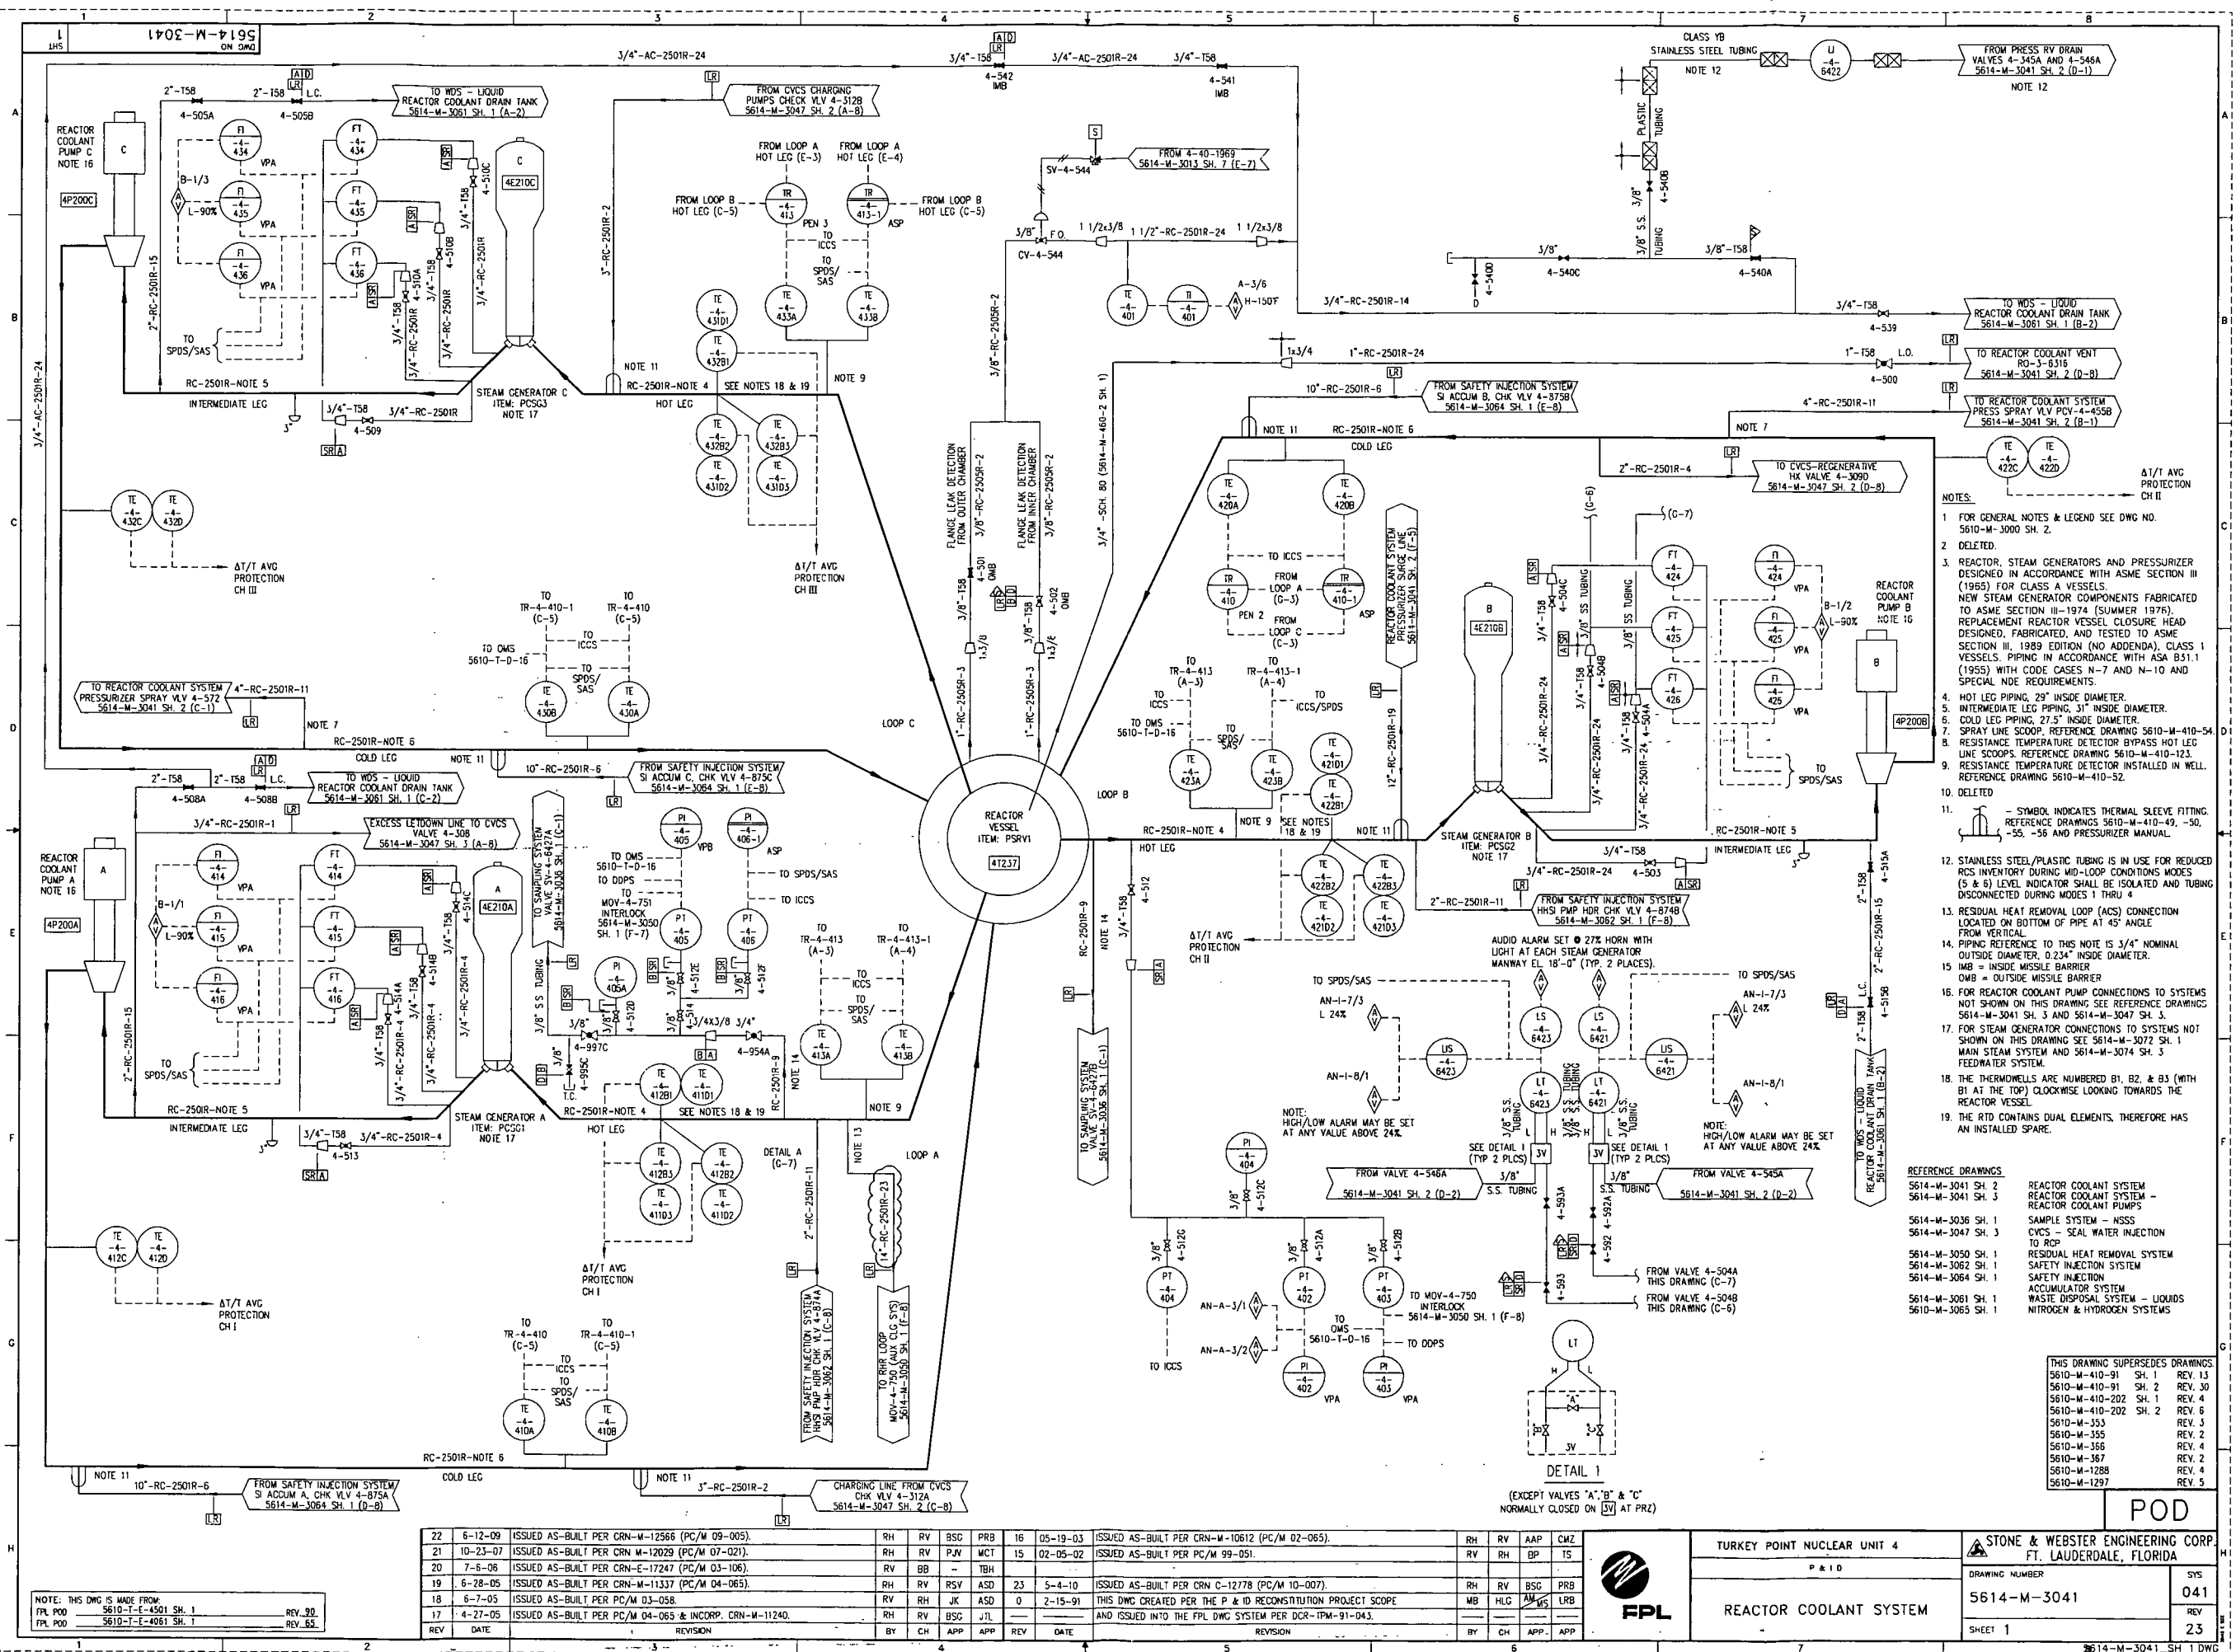

| | | |
|-----|----------|--|
| 22 | 6-12-09 | ISSUED AS-BUILT PER CRN-W-12566 (PC/M 09-005). |
| 21 | 10-23-07 | ISSUED AS-BUILT PER CRN M-12029 (PC/M 07-021). |
| 20 | 7-6-06 | ISSUED AS-BUILT PER CRN-E-17247 (PC/M 03-106). |
| 19 | 6-28-05 | ISSUED AS-BUILT PER CRN-W-11337 (PC/M 04-065). |
| 18 | 6-27-05 | ISSUED AS-BUILT PER PC/M 03-058. |
| 17 | 4-27-05 | ISSUED AS-BUILT PER PC/M 04-065 & INCORP. CRN- |
| REV | DATE | REVISION |

| | | | | | | |
|----|----|-----|-----|-----|----------|--|
| RH | RV | BSC | PRB | 16 | 05-19-03 | ISSUED AS-BUILT PER CRN-M-10612 (PC/M 02-085) |
| RH | RV | PJV | MCT | 15 | 02-05-02 | ISSUED AS-BUILT PER PC/M 99-051. |
| RV | BB | | TBH | | | |
| RH | RV | RSV | ASD | 23 | 5-4-10 | ISSUED AS-BUILT PER CRN C-12778 (PC/M 10-007). |
| RV | RH | JK | ASD | 0 | 2-15-91 | THIS DMC CREATED PER THE P & R RECONSTRUCTION |
| RH | RV | BSC | JPL | | | AND ISSUED INTO THE FPL DMC SYSTEM PER DCR-TPR |
| BY | CH | APP | APP | REV | DATE | REVISION |


| | | | |
|----|-----|-----|-----|
| RH | RV | AAP | CMZ |
| RV | RH | BP | TS |
| RH | RV | BSG | PRB |
| MB | HLG | AL | LRB |
| BY | CH | APP | APP |




TURKEY POINT NUCLEAR UNIT 4


P R I D

REACTOR COOLANT SYSTEM

| | | |
|--|--|--|
|  STONE & WEBSTER ENGINEERING CORP. FT. LAUDERDALE, FLORIDA | | H 1 2 3 2234 22 |
|--|--|--|

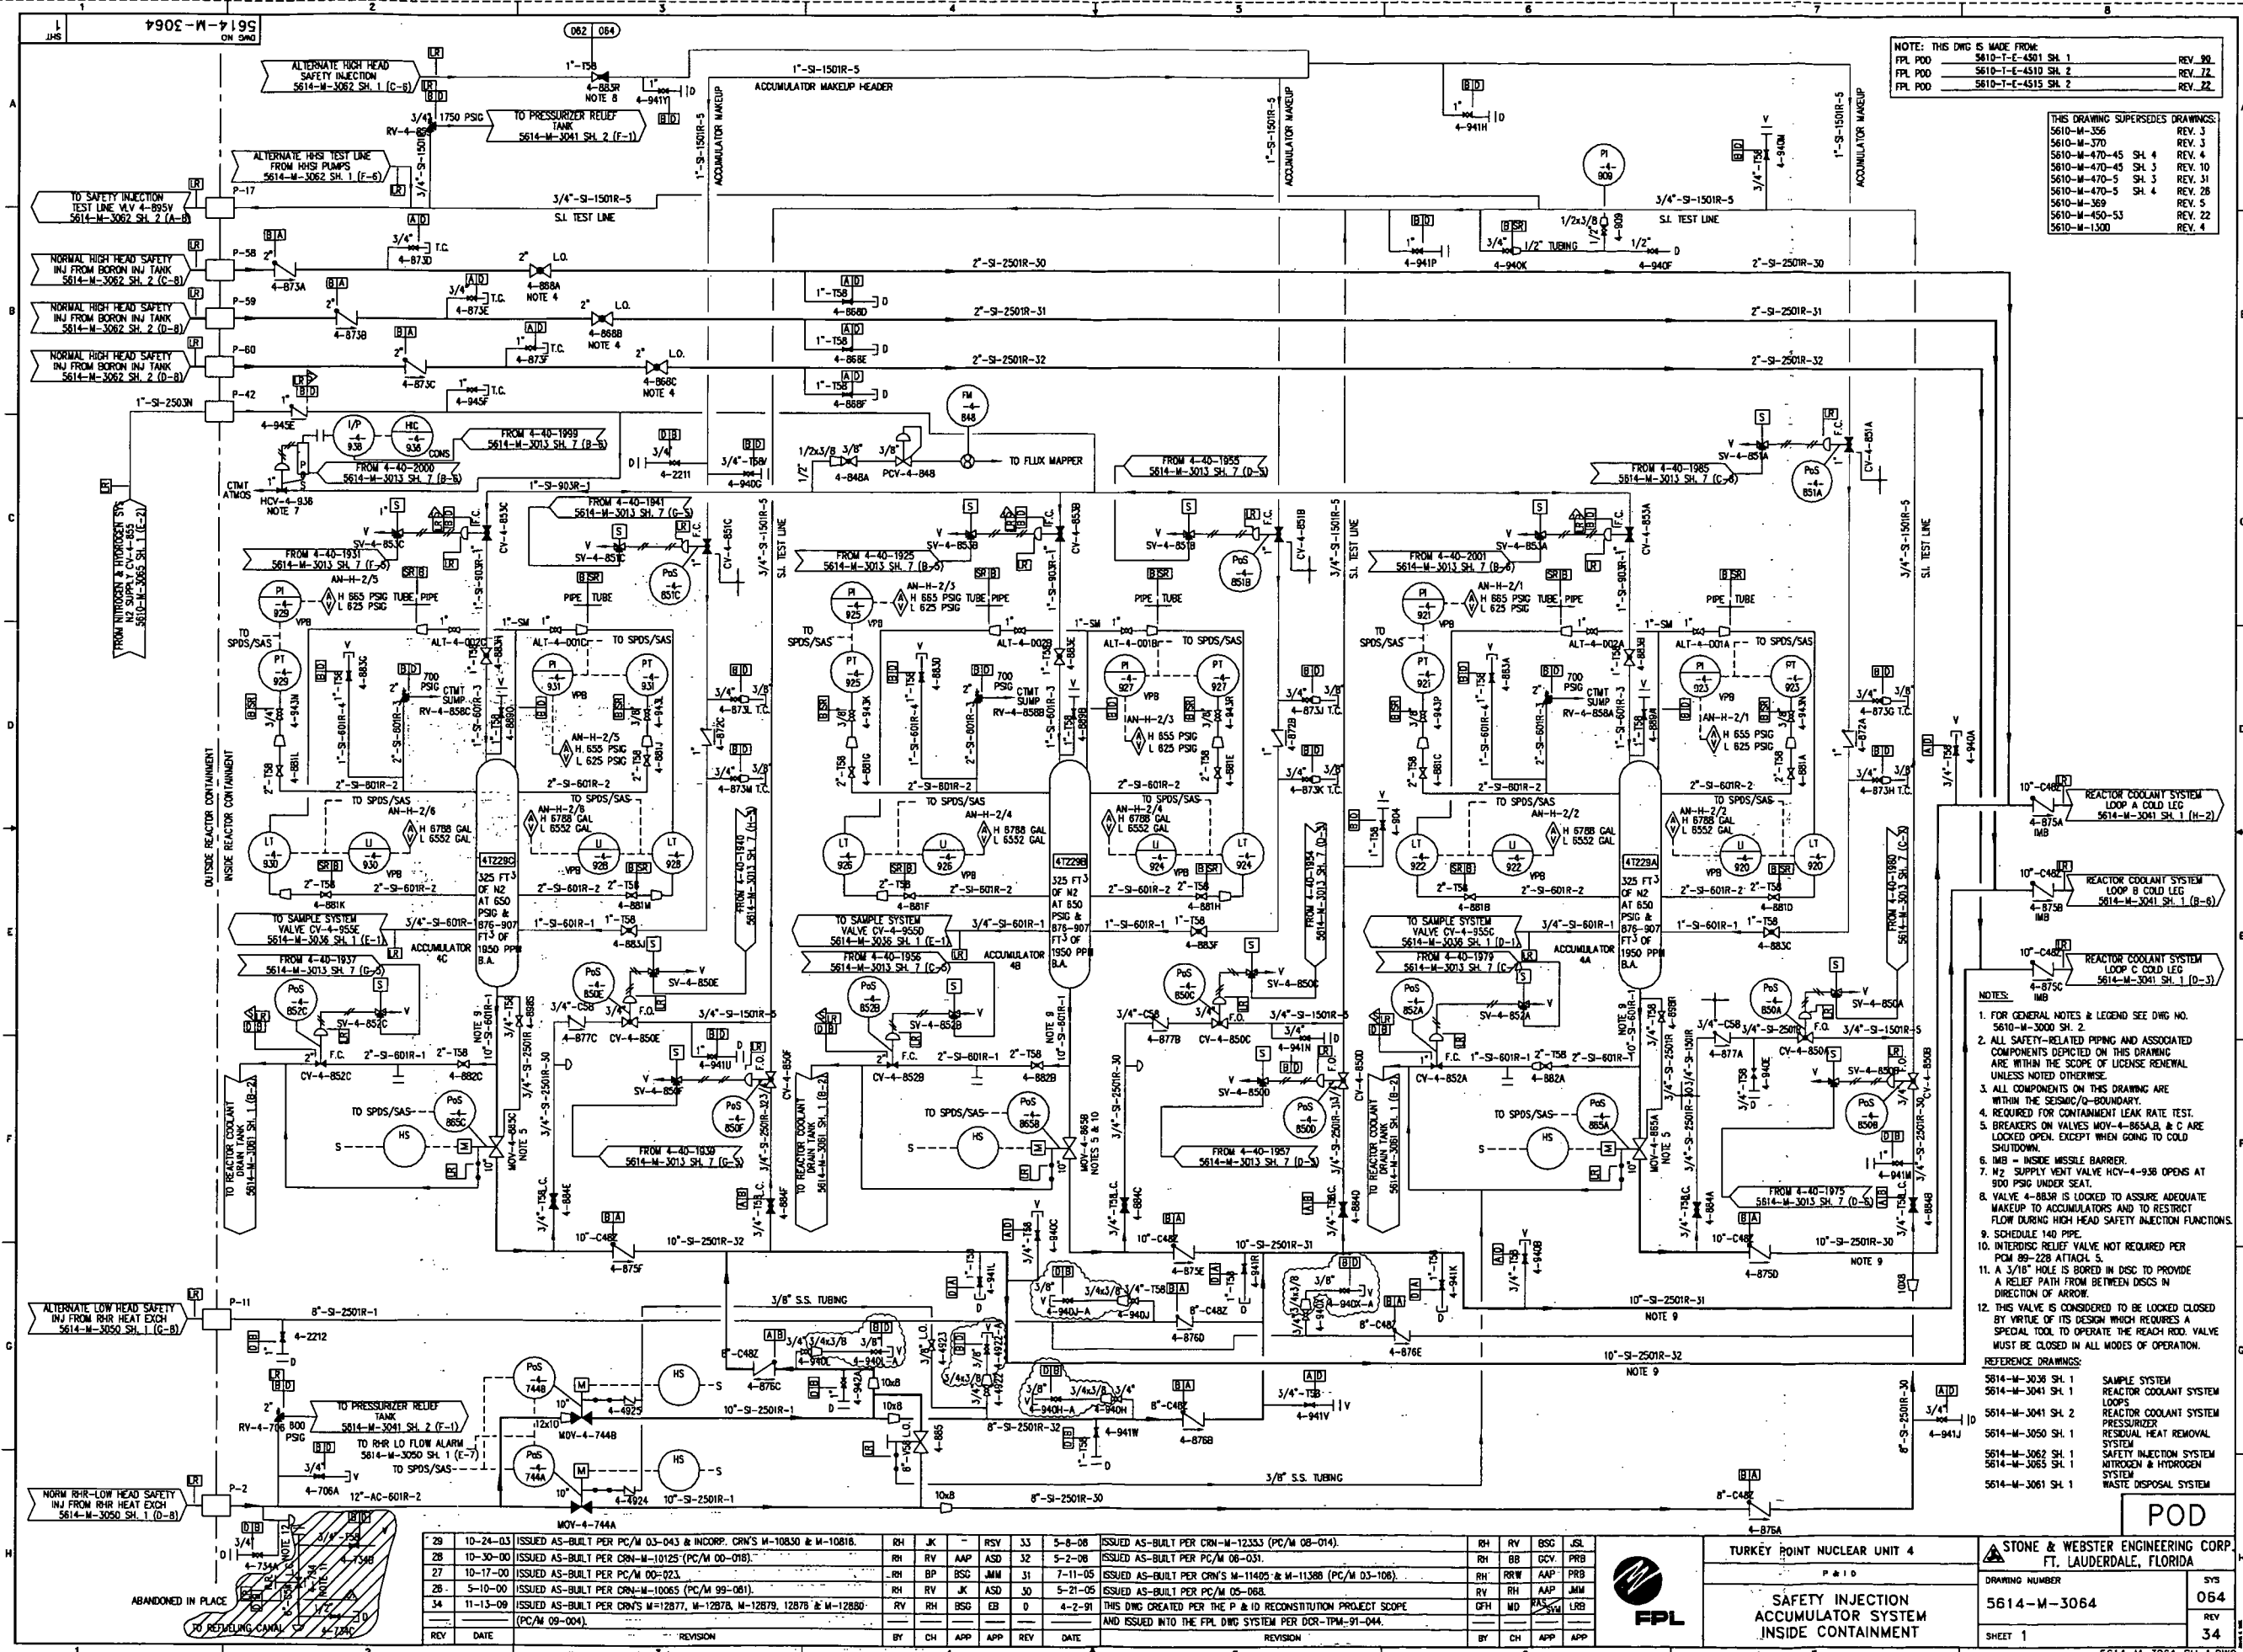

| | | | | | | | | | | | | |
|-----|----------|---|----|----|-----|-----|--------|--|---|-----|-----|-----|
| 29 | 10-24-03 | ISSUED AS-BUILT PER PC/M 03-043 & INCORP. CRN'S M-10830 & M-10816. | RH | JK | RSY | 33 | 5-8-08 | ISSUED AS-BUILT PER CRN-M-12333 (PC/M 08-014). | RH | RV | BSC | JSL |
| 28 | 10-30-00 | ISSUED AS-BUILT PER CRN-M-10125 (PC/M 00-018). | RH | RV | AAP | ASD | 32 | 5-2-08 | ISSUED AS-BUILT PER PC/M 06-031. | RH | BB | GCY |
| 27 | 10-17-00 | ISSUED AS-BUILT PER PC/M 00-023. | RH | BP | BSC | JMM | 31 | 7-11-05 | ISSUED AS-BUILT PER CRN'S M-11405 & M-11388 (PC/M 03-108). | RH | PRR | AAP |
| 26 | 5-10-00 | ISSUED AS-BUILT PER CRN-M-10065 (PC/M 99-081). | RH | RV | JK | ASD | 30 | 5-21-05 | ISSUED AS-BUILT PER PC/M 05-068. | RV | RH | AAP |
| 34 | 11-13-09 | ISSUED AS-BUILT PER CRN'S M-12877, M-12878, M-12879, 12876 & M-12880 (PC/M 09-004). | RH | RV | BSC | EB | 0 | 4-2-91 | THIS DWG CREATED PER THE P & ID RECONSTITUTION PROJECT SCOPE AND ISSUED INTO THE FPL DWG SYSTEM PER DCR-TPM-91-044. | GFI | MD | RAS |
| REV | DATE | REVISION | BY | CH | APP | APP | REV | DATE | REVISION | BY | CH | APP |

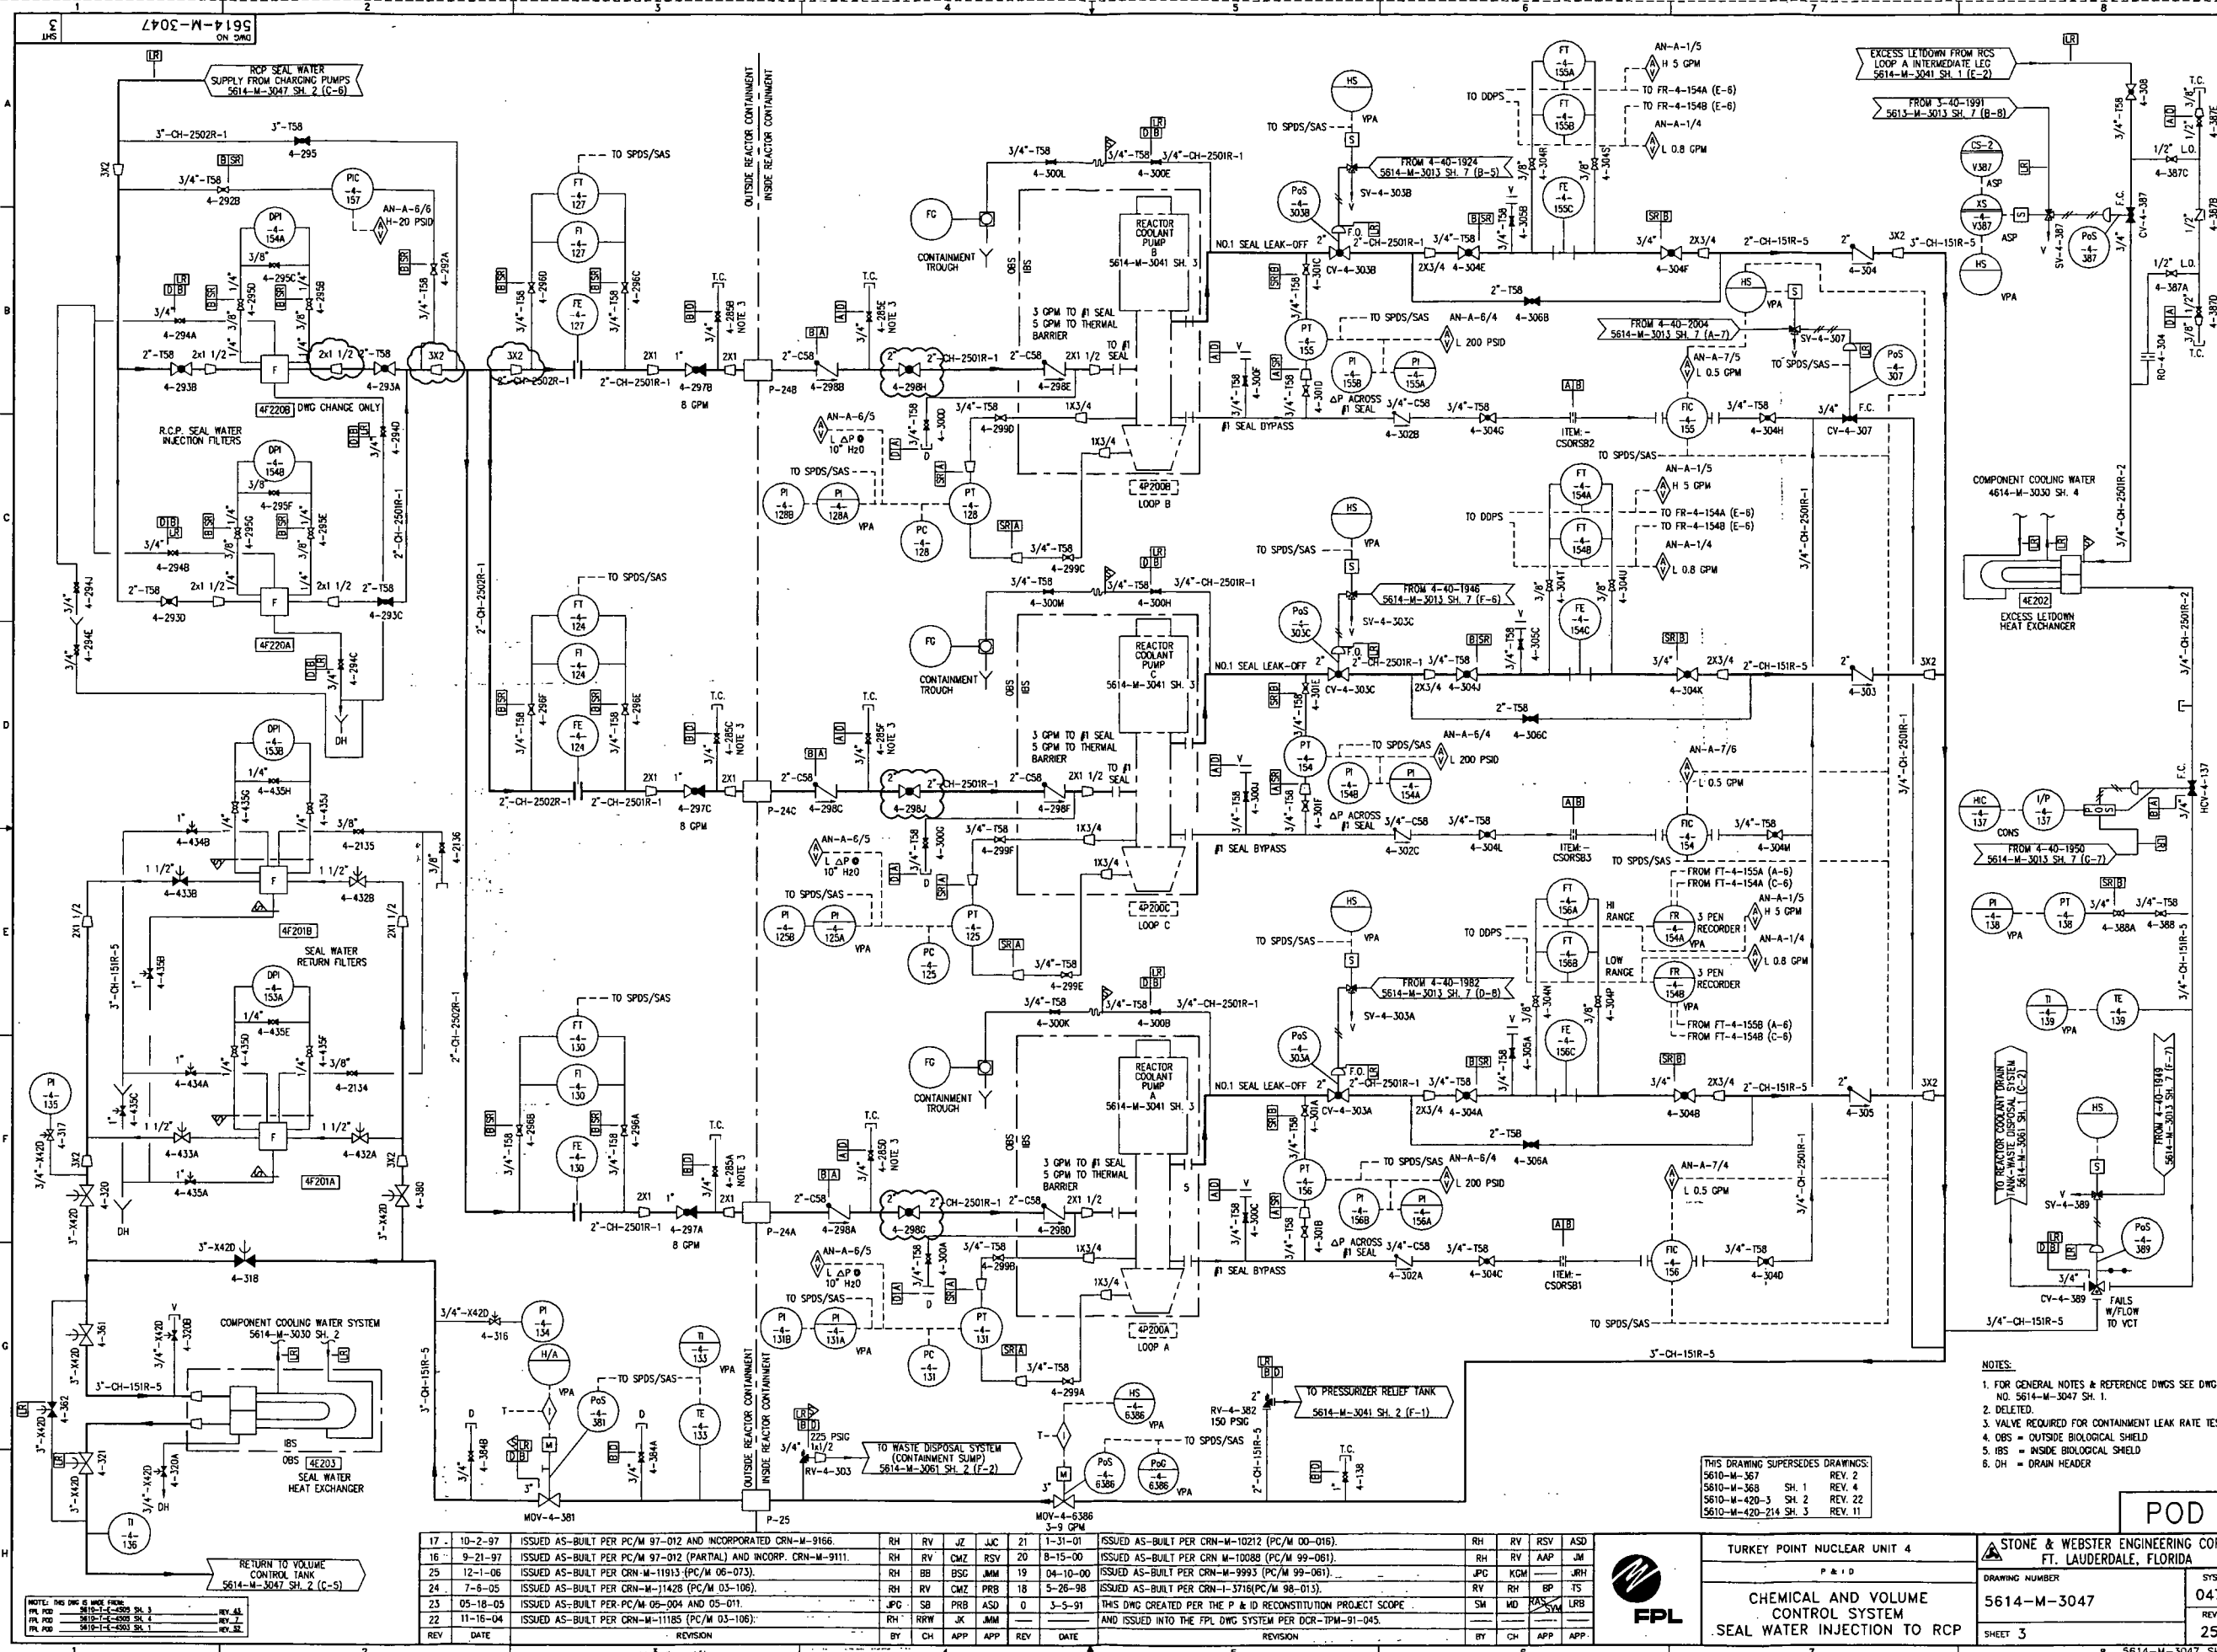

- NOTES:
1. FOR GENERAL NOTES & REFERENCE DWGS SEE DWG NO. 5614-M-3047 SH. 1.
 2. DELETED.
 3. VALVE REQUIRED FOR CONTAINMENT LEAK RATE TEST.
 4. OBS = OUTSIDE BIOLOGICAL SHIELD
 5. IBS = INSIDE BIOLOGICAL SHIELD
 6. DH = DRAIN HEADER


THIS DRAWING SUPERSEDES DRAWINGS:
5610-M-367 REV. 2
5610-M-368 SH. 1 REV. 4
5610-M-420-3 SH. 2 REV. 22
5610-M-420-214 SH. 3 REV. 11

| REV | DATE | REVISION | BY | CH | APP | APP | REV | DATE | REVISION | BY | CH | APP | APP |
|-----|----------|---|-----|-----|-----|-----|-----|----------|---|-----|-----|-----|-----|
| 17 | 10-2-97 | ISSUED AS-BUILT PER PC/M 97-012 AND INCORPORATED CRN-M-9166. | RH | RV | JZ | JUC | 21 | 1-31-01 | ISSUED AS-BUILT PER CRN-M-10212 (PC/M 00-016). | RH | RV | RSV | ASD |
| 16 | 9-21-97 | ISSUED AS-BUILT PER PC/M 97-012 (PARTIAL) AND INCORP. CRN-M-9111. | RH | RV | CMZ | RSV | 20 | 8-15-00 | ISSUED AS-BUILT PER CRN-M-10088 (PC/M 99-061). | RH | RV | AAP | JM |
| 25 | 12-1-06 | ISSUED AS-BUILT PER CRN-M-11913 (PC/M 06-073). | RH | BB | BSC | JMM | 19 | 04-10-00 | ISSUED AS-BUILT PER CRN-M-9993 (PC/M 99-061). | JPC | KOM | JRH | |
| 24 | 7-6-05 | ISSUED AS-BUILT PER CRN-M-11426 (PC/M 03-106). | RH | RV | CMZ | PRB | 18 | 5-26-98 | ISSUED AS-BUILT PER CRN-M-9716 (PC/M 98-013). | RV | RH | BP | TS |
| 23 | 05-18-05 | ISSUED AS-BUILT PER PC/M 05-004 AND 05-011. | JPC | SB | PRB | ASD | 0 | 3-5-91 | THIS DWG CREATED PER THE P & ID RECONSTRUCTION PROJECT SCOPE AND ISSUED INTO THE FPL DWG SYSTEM PER DCR-TPM-91-045. | SM | MD | PAN | LSM |
| 22 | 11-16-04 | ISSUED AS-BUILT PER CRN-M-11185 (PC/M 03-106). | RH | RRW | JK | JMM | | | | | | | |



TURKEY POINT NUCLEAR UNIT 4
P & ID
CHEMICAL AND VOLUME
CONTROL SYSTEM
SEAL WATER INJECTION TO RCP

| | |
|--|------------|
| STONE & WEBSTER ENGINEERING CORP. FT. LAUDERDALE, FLORIDA | SYS 047 |
| DRAWING NUMBER 5614-M-3047 | REV 25 |
| SHEET 3 | |

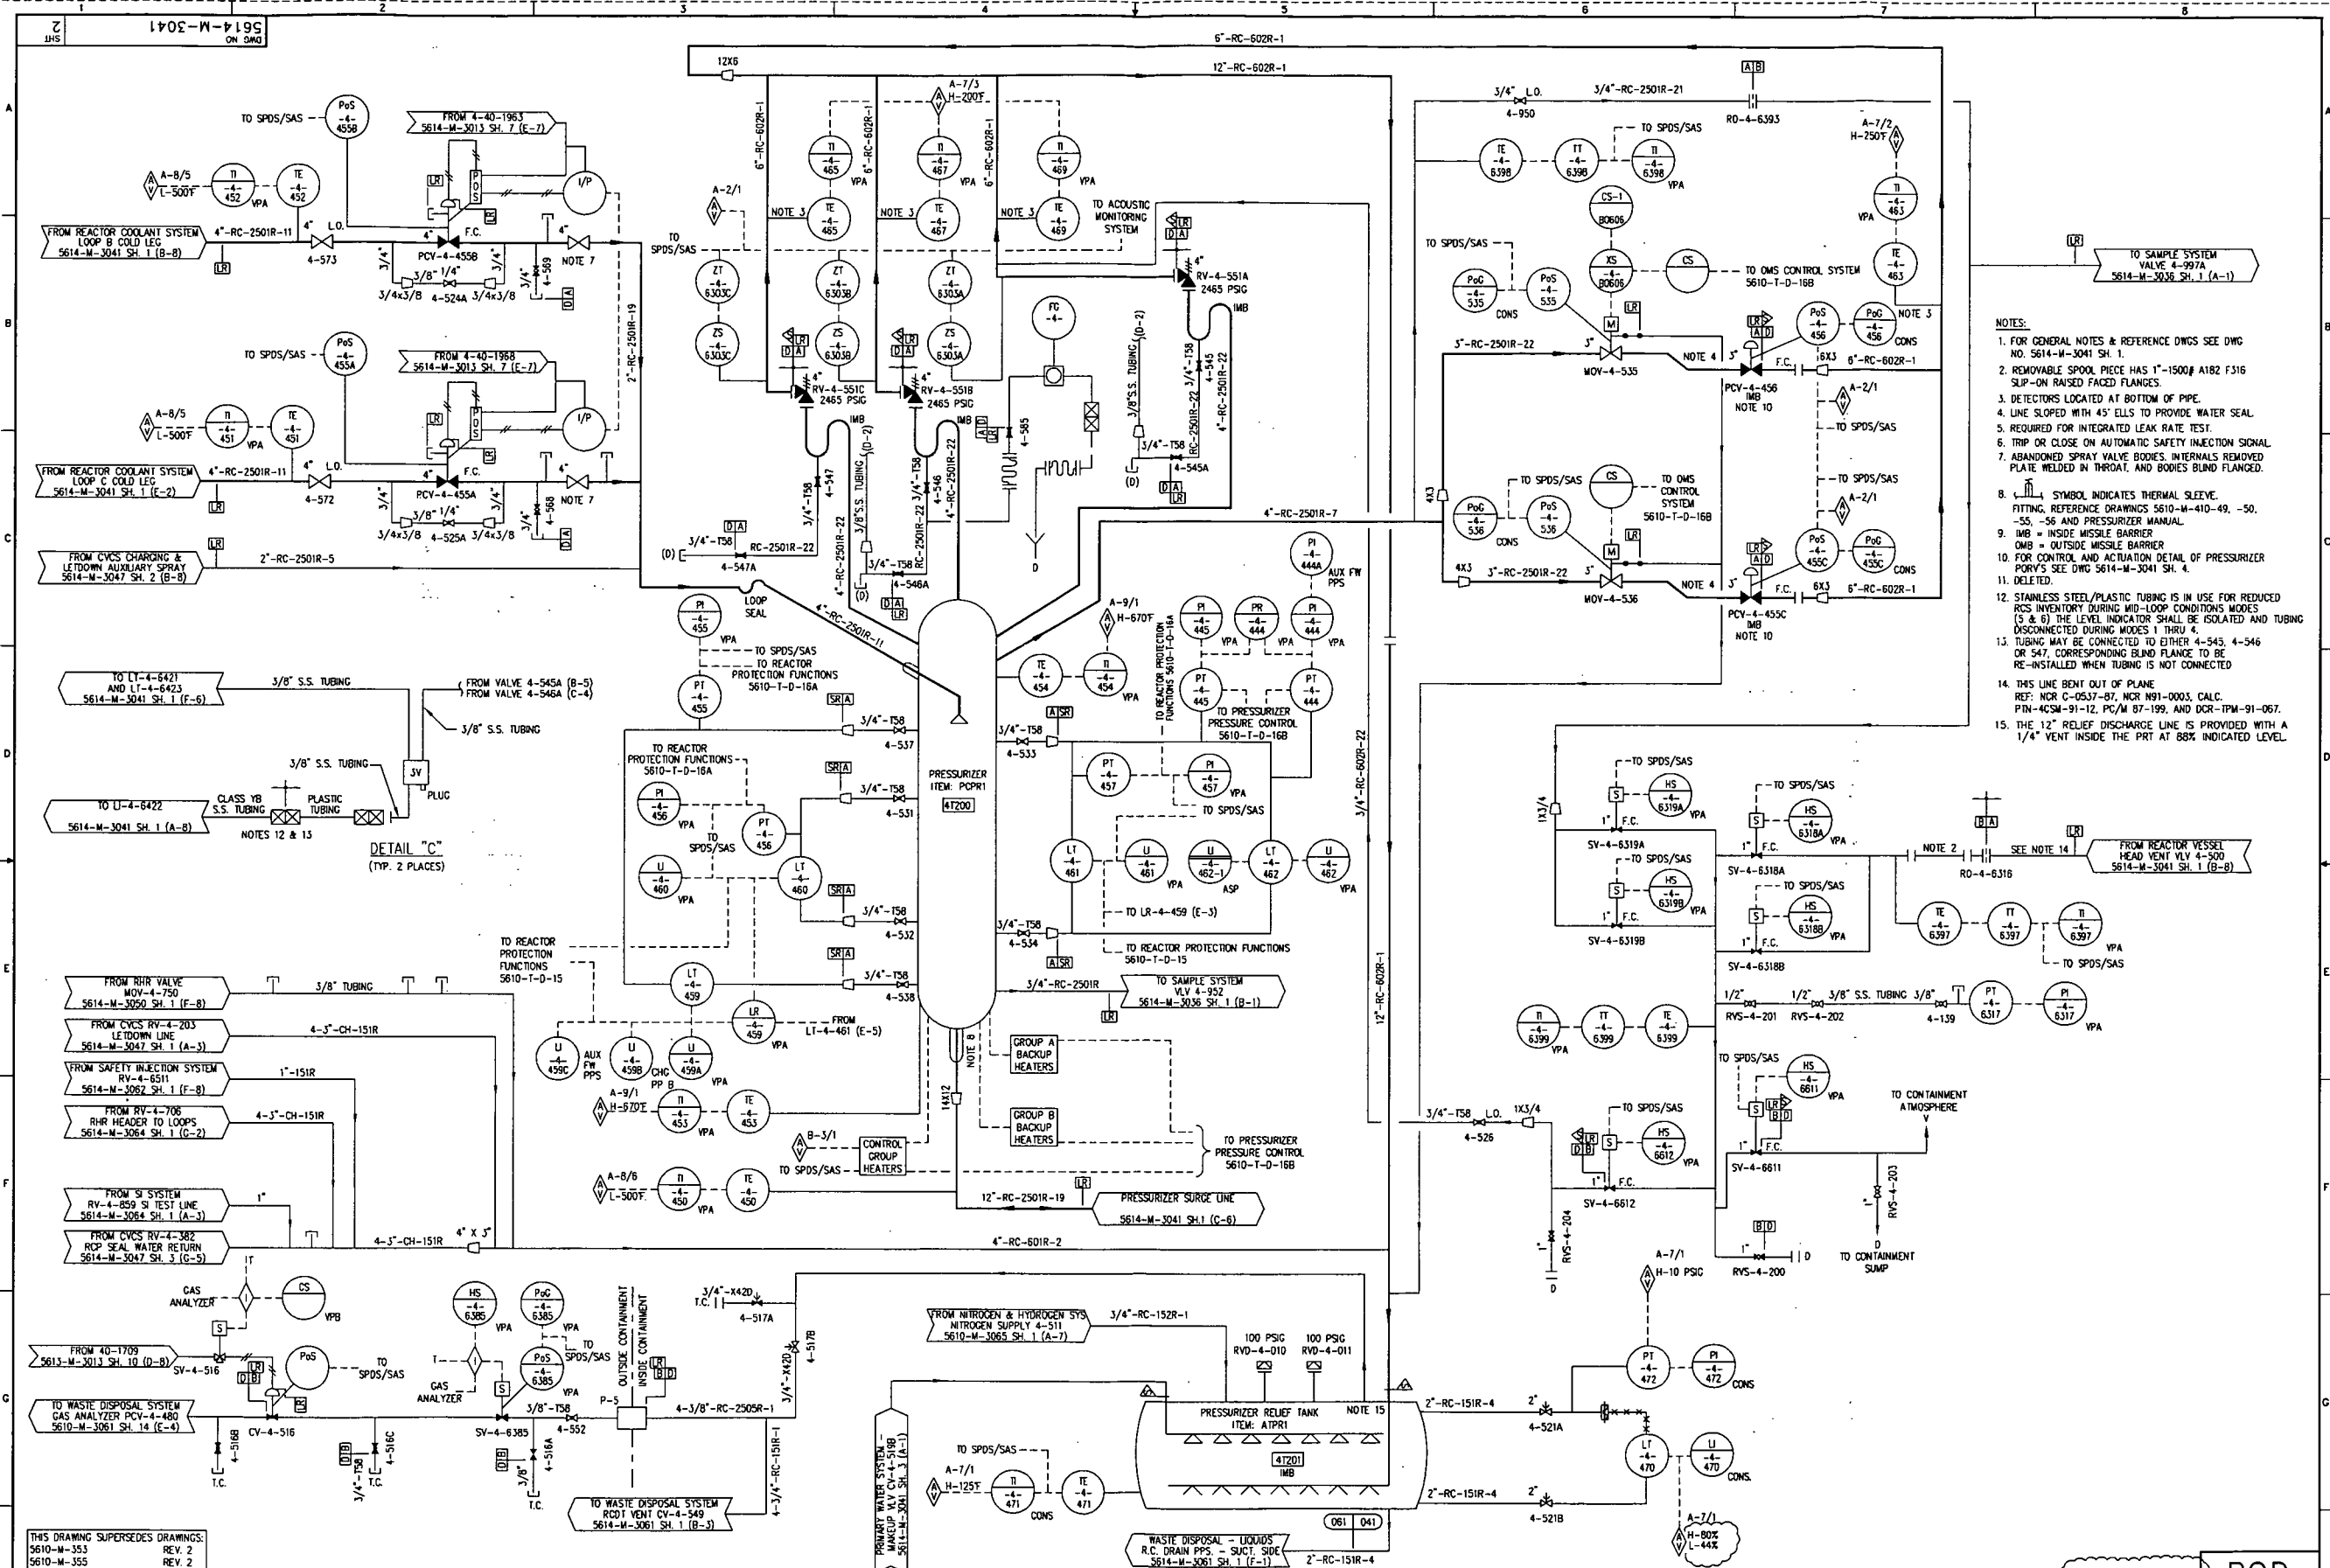


- NOTES:
- FOR GENERAL NOTES & REFERENCE DWGS SEE DWG NO. 5614-M-3041 SH. 1.
 - REMOVABLE SPOOL PIECE HAS 1"-1500# A182 F316 SLIP-ON RAISED FACED FLANGES.
 - DETECTORS LOCATED AT BOTTOM OF PIPE.
 - LINE SLOPED WITH 45° ELLS TO PROVIDE WATER SEAL.
 - REQUIRED FOR INTEGRATED LEAK RATE TEST.
 - TRIP OR CLOSE ON AUTOMATIC SAFETY INJECTION SIGNAL.
 - ABANDONED SPRAY VALVE BODIES, INTERIORS REMOVED PLATE WELDED IN THROAT, AND BODIES BLIND FLANGED.
 - SYMBOL INDICATES THERMAL SLEEVE. FITTING, REFERENCE DRAWINGS 5610-M-410-49, -50, -55, -56 AND PRESSURIZER MANUAL.
 - IMB = INSIDE MISSILE BARRIER. OMB = OUTSIDE MISSILE BARRIER.
 - FOR CONTROL AND ACTUATION DETAIL OF PRESSURIZER PORV'S SEE DWG 5614-M-3041 SH. 4.
 - DELETED.
 - STAINLESS STEEL/PLASTIC TUBING IS IN USE FOR REDUCED RCS INVENTORY DURING MID-LOOP CONDITIONS MODES (5 & 6) THE LEVEL INDICATOR SHALL BE ISOLATED AND TUBING DISCONNECTED DURING MODES 1 THRU 4.
 - TUBING MAY BE CONNECTED TO EITHER 4-543, 4-546 OR 547, CORRESPONDING BLIND FLANGE TO BE RE-INSTALLED WHEN TUBING IS NOT CONNECTED.
 - THIS LINE BENT OUT OF PLANE. REF: NCR C-0537-87, NCR N91-0003, CALC. PIN-4C5M-91-12, PC/M 07-199, AND DCR-IPM-91-067.
 - THE 12" RELIEF DISCHARGE LINE IS PROVIDED WITH A 1/4" VENT INSIDE THE PRT AT 80% INDICATED LEVEL.

THIS DRAWING SUPERSEDES DRAWINGS:
5610-M-353 REV. 2
5610-M-355 REV. 2
5610-M-366 REV. 4
5610-M-367 REV. 2
5610-M-410-91 SH. 1 REV. 13
5610-M-410-91 SH. 2 REV. 30
5610-M-410-202 SH. 1 REV. 4
5610-M-410-202 SH. 2 REV. 6
5610-M-1288 REV. 4
5610-M-1310 REV. 2

NOTE: THIS DWG IS MADE FROM:
5612-T-1-551 SH. 1 REV. 01

| REV | DATE | REVISION | BY | CH | APP | APP | REV | DATE | REVISION | BY | CH | APP | APP |
|-----|---------|---|----|-----|-----|-----|-----|---------|---|----|-----|-----|-----|
| 32 | 4-27-05 | ISSUED AS-BUILT PER PC/M 04-065 & INCORP. CRN-M-11240. | RH | RV | BSC | JTL | 38 | 2/6/13 | ISSUED AS-BUILT PER EC 242470 (ITOP 13-02-027). | RH | AFG | - | DL |
| 31 | 4-21-05 | ISSUED AS-BUILT PER PC/M 04-056. | RH | JPC | AAP | CMZ | 37 | 9/28/09 | ISSUED AS-BUILT PER CRN-M-13092 (PC/M 09-070). | RV | RH | - | LG |
| 30 | 2-12-04 | ISSUED AS-BUILT PER CRN-M-10859 (PC/M 03-050). | RH | RV | ASD | JTL | 36 | 9-22-09 | ISSUED AS-BUILT PER CRN-M-12837 (PC/M 09-070). | RH | RV | - | LC |
| 41 | 4-24-13 | ISSUED AS-BUILT PER EC 246978 (ITOP 13-04-164). | RH | RV | - | JM | 35 | 9/25/06 | ISSUED AS-BUILT PER CRN-M-11759 (PC/M 03-106). | RH | RV | BSC | JTL |
| 40 | 3-4-13 | ISSUED AS-BUILT PER EC 246924 (ITOP 13-03-010). | RV | RH | - | JD | 34 | 7-11-05 | ISSUED AS-BUILT PER CRN-M-11395 (PC/M 03-106). | RH | RRW | AAP | PRB |
| 39 | 2-10-13 | ISSUED AS-BUILT PER EC 246924 (ITOP'S 13-02-043 & 047). (PARTIAL) | RV | BB | PSB | CW | 33 | 6-28-05 | ISSUED AS-BUILT PER CRN-M-11337 (PC/M 04-065). | RH | RV | RSV | ASD |



SAFETY RELATED **POD**

TURKEY POINT NUCLEAR UNIT 4

P & I D

REACTOR COOLANT SYSTEM


DRAWING NUMBER
5614-M-3041


SHEET 2

SYS
041

REV
41

8 5614-M-3041 SH. 2.DWG

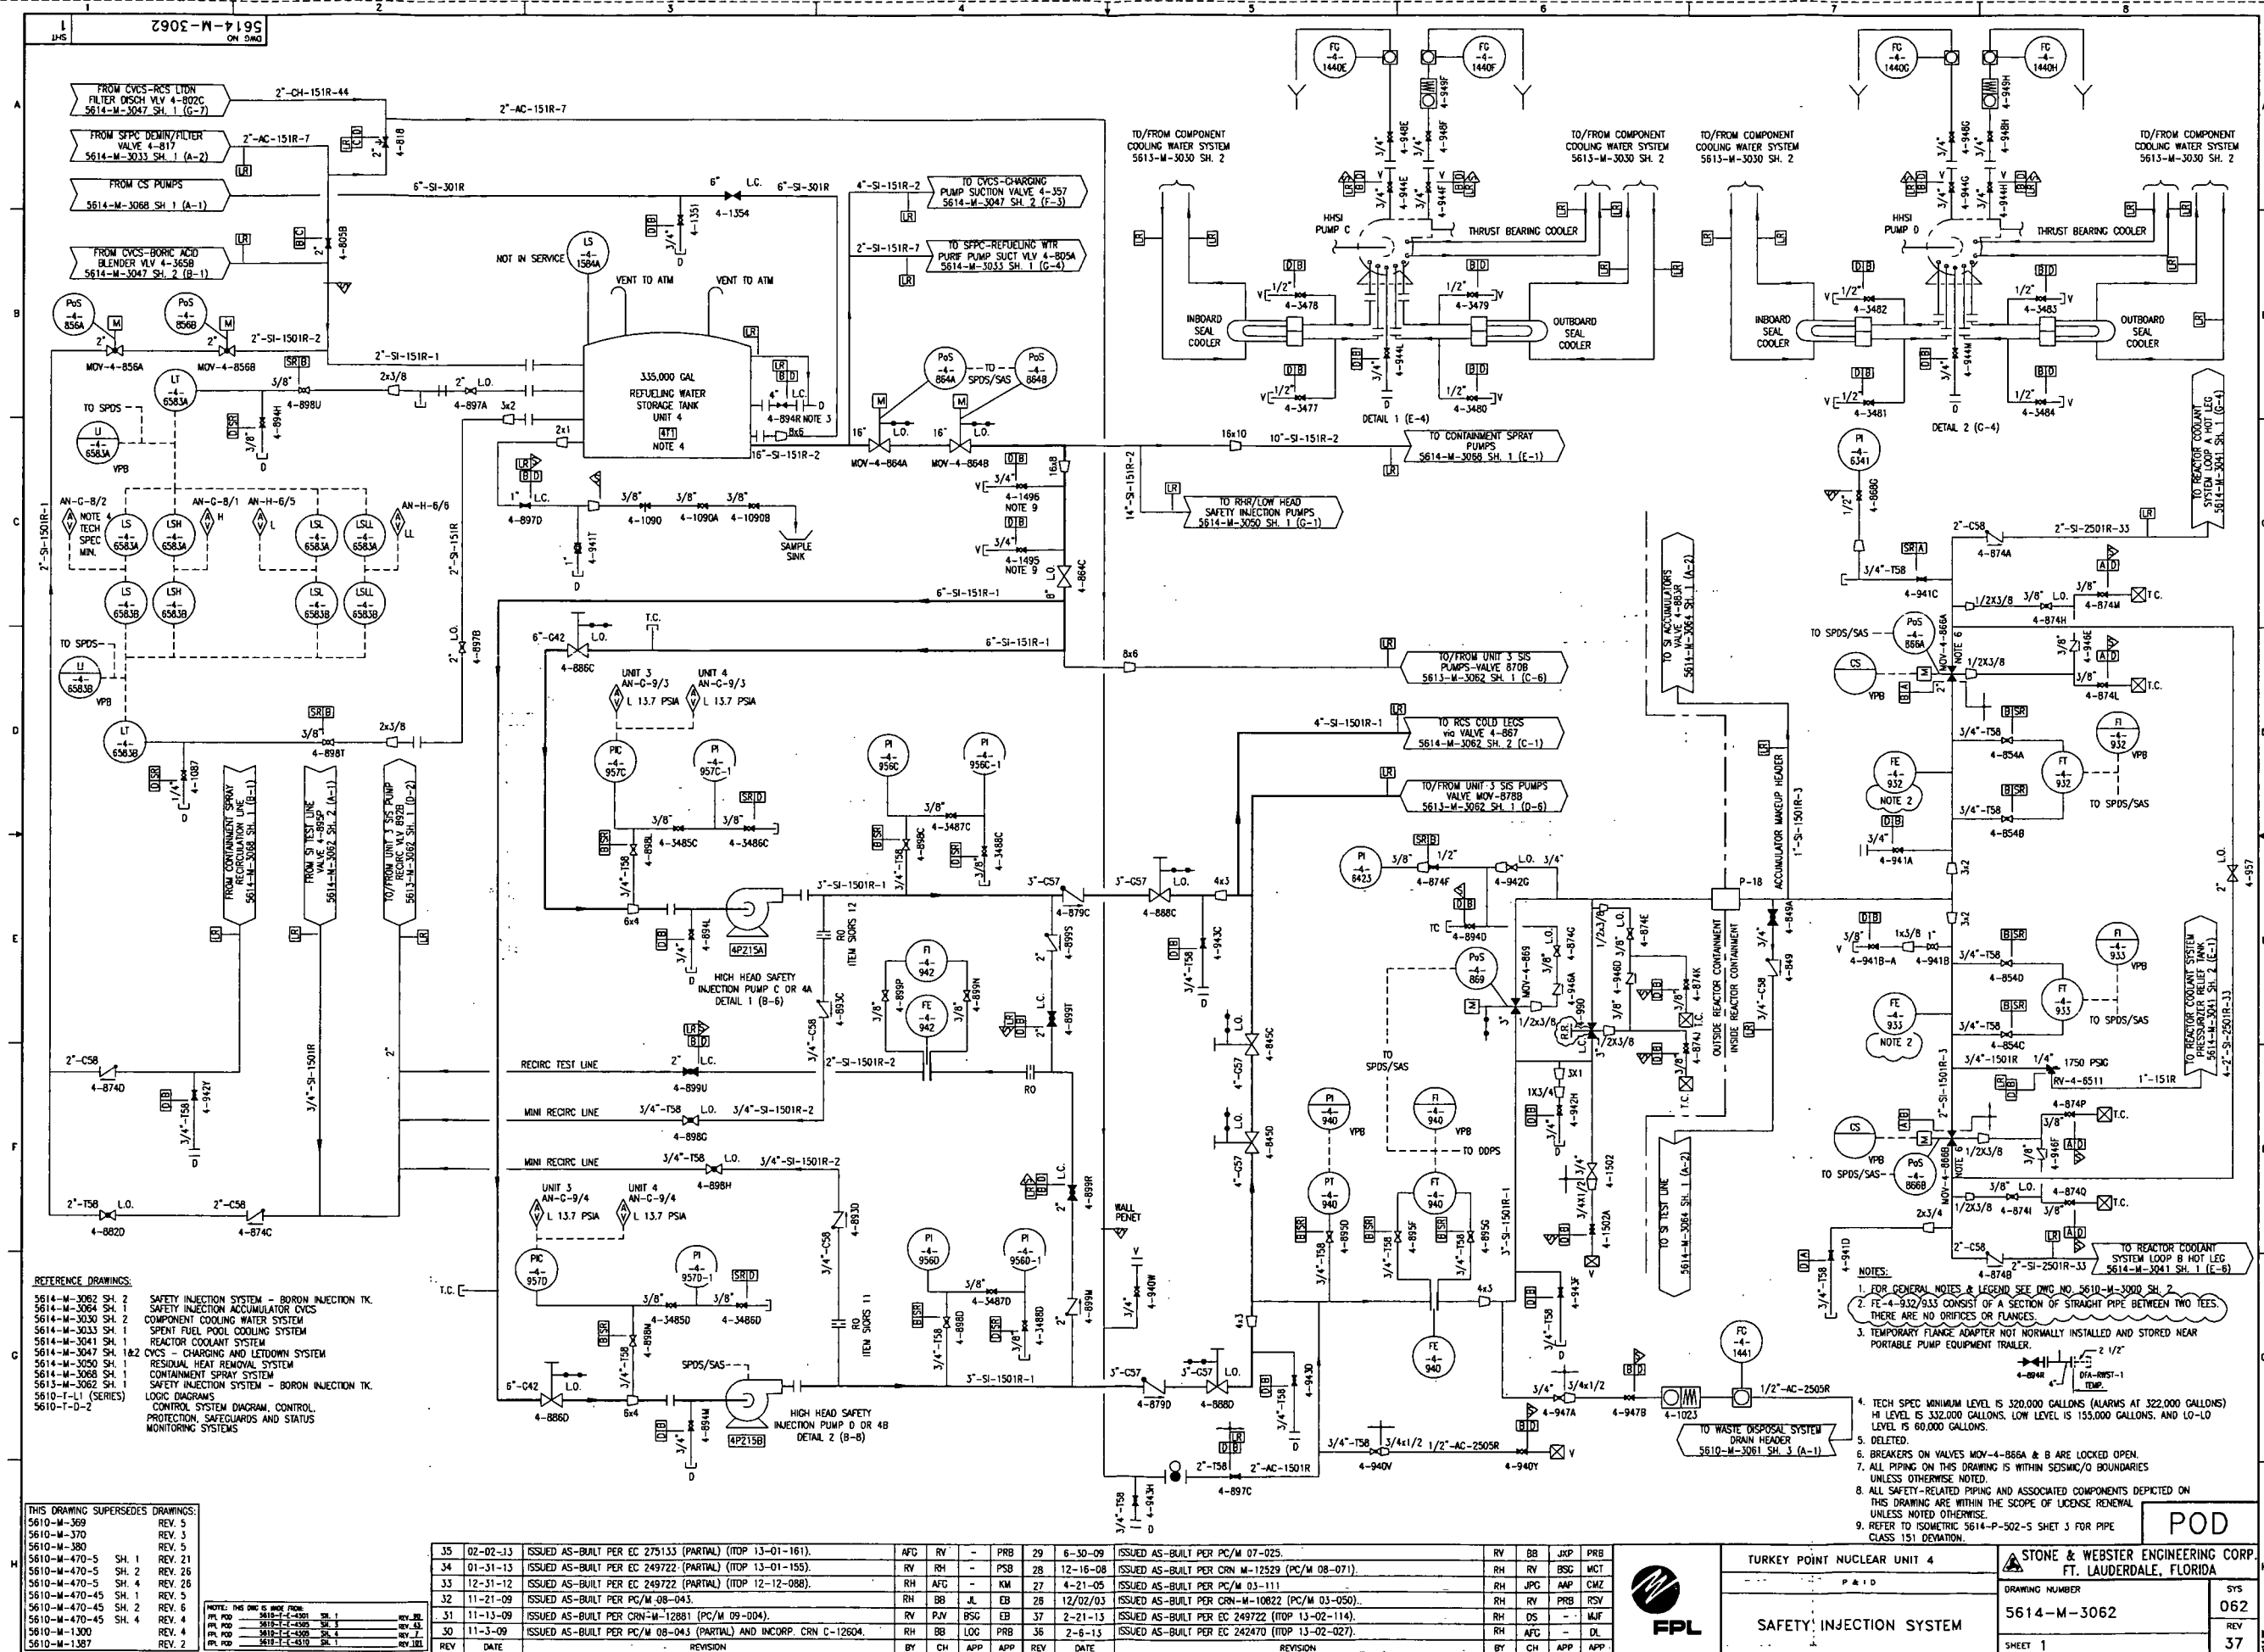

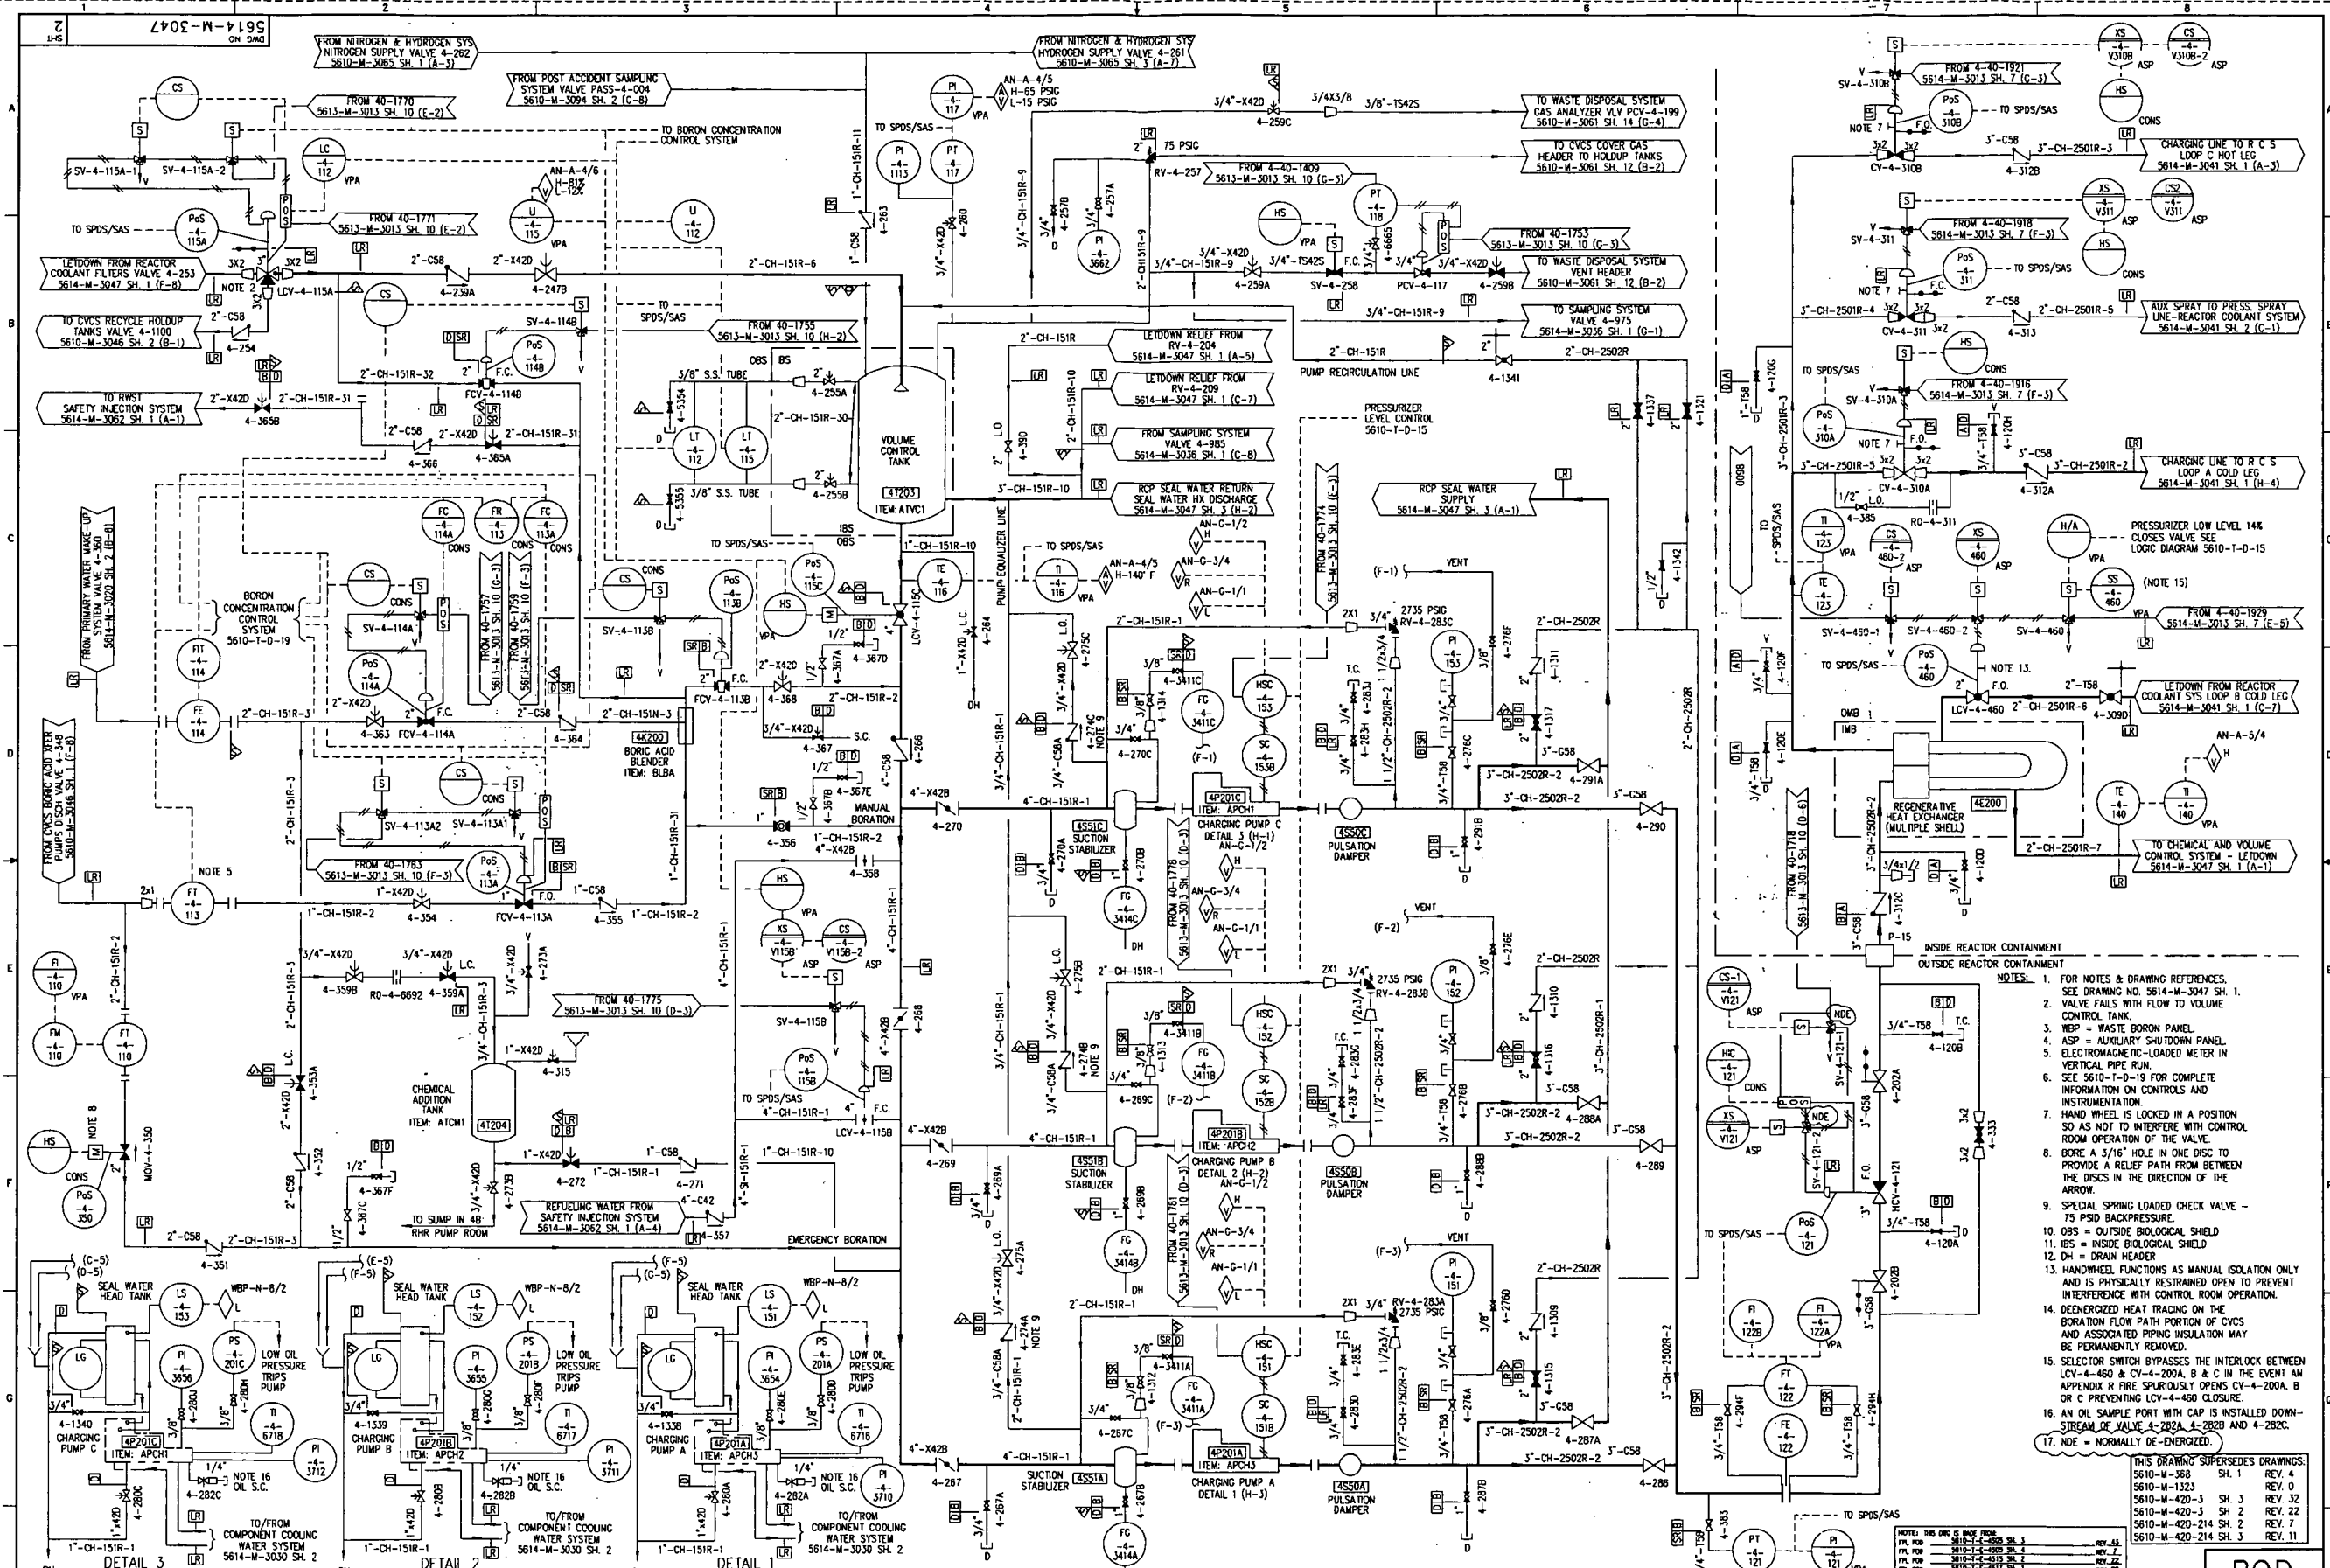


- NOTES:
1. FOR NOTES & DRAWING REFERENCES, SEE DRAWING NO. 5614-M-3047 SH. 1.
 2. VALVE FAILS WITH FLOW TO VOLUME CONTROL TANK.
 3. WBP = WASTE BORON PANEL.
 4. ASP = AUXILIARY SHUTDOWN PANEL.
 5. ELECTROMAGNETIC-LOADED METER IN VERTICAL PIPE RUN.
 6. SEE 5610-T-0-19 FOR COMPLETE INFORMATION ON CONTROLS AND INSTRUMENTATION.
 7. HAND WHEEL IS LOCKED IN A POSITION SO AS NOT TO INTERFERE WITH CONTROL ROOM OPERATION OF THE VALVE.
 8. BORE A 3/16" HOLE IN ONE DISC TO PROVIDE A RELIEF PATH FROM BETWEEN THE DISCS IN THE DIRECTION OF THE ARROW.
 9. SPECIAL SPRING LOADED CHECK VALVE - 75 PSID BACKPRESSURE.
 10. OBS = OUTSIDE BIOLOGICAL SHIELD.
 11. IBS = INSIDE BIOLOGICAL SHIELD.
 12. DH = DRAIN HEADER.
 13. HANDWHEEL FUNCTIONS AS MANUAL ISOLATION ONLY AND IS PHYSICALLY RESTRAINED OPEN TO PREVENT INTERFERENCE WITH CONTROL ROOM OPERATION.
 14. DEENERGIZED HEAT TRACING ON THE BORATION FLOW PATH PORTION OF CVCS AND ASSOCIATED PIPING INSULATION MAY BE PERMANENTLY REMOVED.
 15. SELECTOR SWITCH BYPASSES THE INTERLOCK BETWEEN LCV-4-460 & CY-4-200A, B & C IN THE EVENT AN APPENDIX R FIRE SPURIOUSLY OPENS CY-4-200A, B OR C PREVENTING LCV-4-460 CLOSURE.
 16. AN OIL SAMPLE PORT WITH CAP IS INSTALLED DOWNSTREAM OF VALVE 4-282A, 4-282B AND 4-282C.
 17. NDE = NORMALLY DE-ENERGIZED.

THIS DRAWING SUPERSEDES DRAWINGS:

| | | |
|----------------|-------|---------|
| 5610-M-368 | SH. 1 | REV. 4 |
| 5610-M-1323 | SH. 1 | REV. 0 |
| 5610-M-420-3 | SH. 3 | REV. 32 |
| 5610-M-420-3 | SH. 2 | REV. 22 |
| 5610-M-420-214 | SH. 2 | REV. 7 |
| 5610-M-420-214 | SH. 3 | REV. 11 |

| (F-5) | | | DH | | (G-5) | | | | DH | | | | |
|-------|---------|--|----|-----|-------|-----|---------|--|--|-----|-----|-----|-----|
| 61 | 4-3-11 | ISSUED AS-BUILT PER EC 249137. (PARTIAL) | RY | SB | BSG | JE | 55 | 07-31-07 | ISSUED AS-BUILT PER CRN-M-11939 (PC/M 02-053 AND CRN-1-4271 (PC/M 04-066). | RY | JPG | BSG | PRB |
| 60 | 4-2-11 | ISSUED AS-BUILT PER EC 249137. (PARTIAL) | RY | CW | ABR | PRB | 64 | 10-6-12 | ISSUED AS-BUILT PER CRN-001 (EC 242341). (TOP # 12-09-062) | RH | RV | CAF | PRB |
| 59 | 6-18-10 | ISSUED AS-BUILT PER PC/M 08-010. | RH | BB | PRB | 63 | 5-13-11 | ISSUED AS-BUILT PER EC-DCR 272278. | RH | BB | CAF | PRB | |
| 58 | 4/1/10 | ISSUED AS-BUILT PER CRN E-18146 (PC/M 10-007). | RH | RV | LC | 62 | 4-14-11 | ISSUED AS-BUILT PER EC 249137. | RH | BB | JC | PRB | |
| 57 | 3/25/10 | ISSUED AS-BUILT PER PC/M 08-010 (PARTIAL). | RH | RV | BSG | PRB | 0 | 3-5-91 | THIS DWG CREATED PER THE P & ID RECONSTITUTION PROJECT SCOPE | MAB | MD | PRB | PRB |
| 56 | 9/2/09 | ISSUED AS-BUILT PER CRN I-5071 (PC/M 02-066). | RH | BSG | LC | | | AND ISSUED INTO THE FPL DMC SYSTEM PER DCR-TPM-91-045. | | | | | |
| REV | DATE | REVISION | BY | CH | APP | APP | REV | DATE | REVISION | BY | CH | APP | APP |

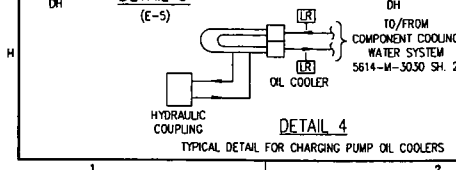

TURKEY POINT NUCLEAR UNIT 4

STONE & WEBSTER ENGINEERING CORP.
FT. LAUDERDALE, FLORIDA


DRAWING NO. 5614-M-3047

SHEET 2

POD

047

64

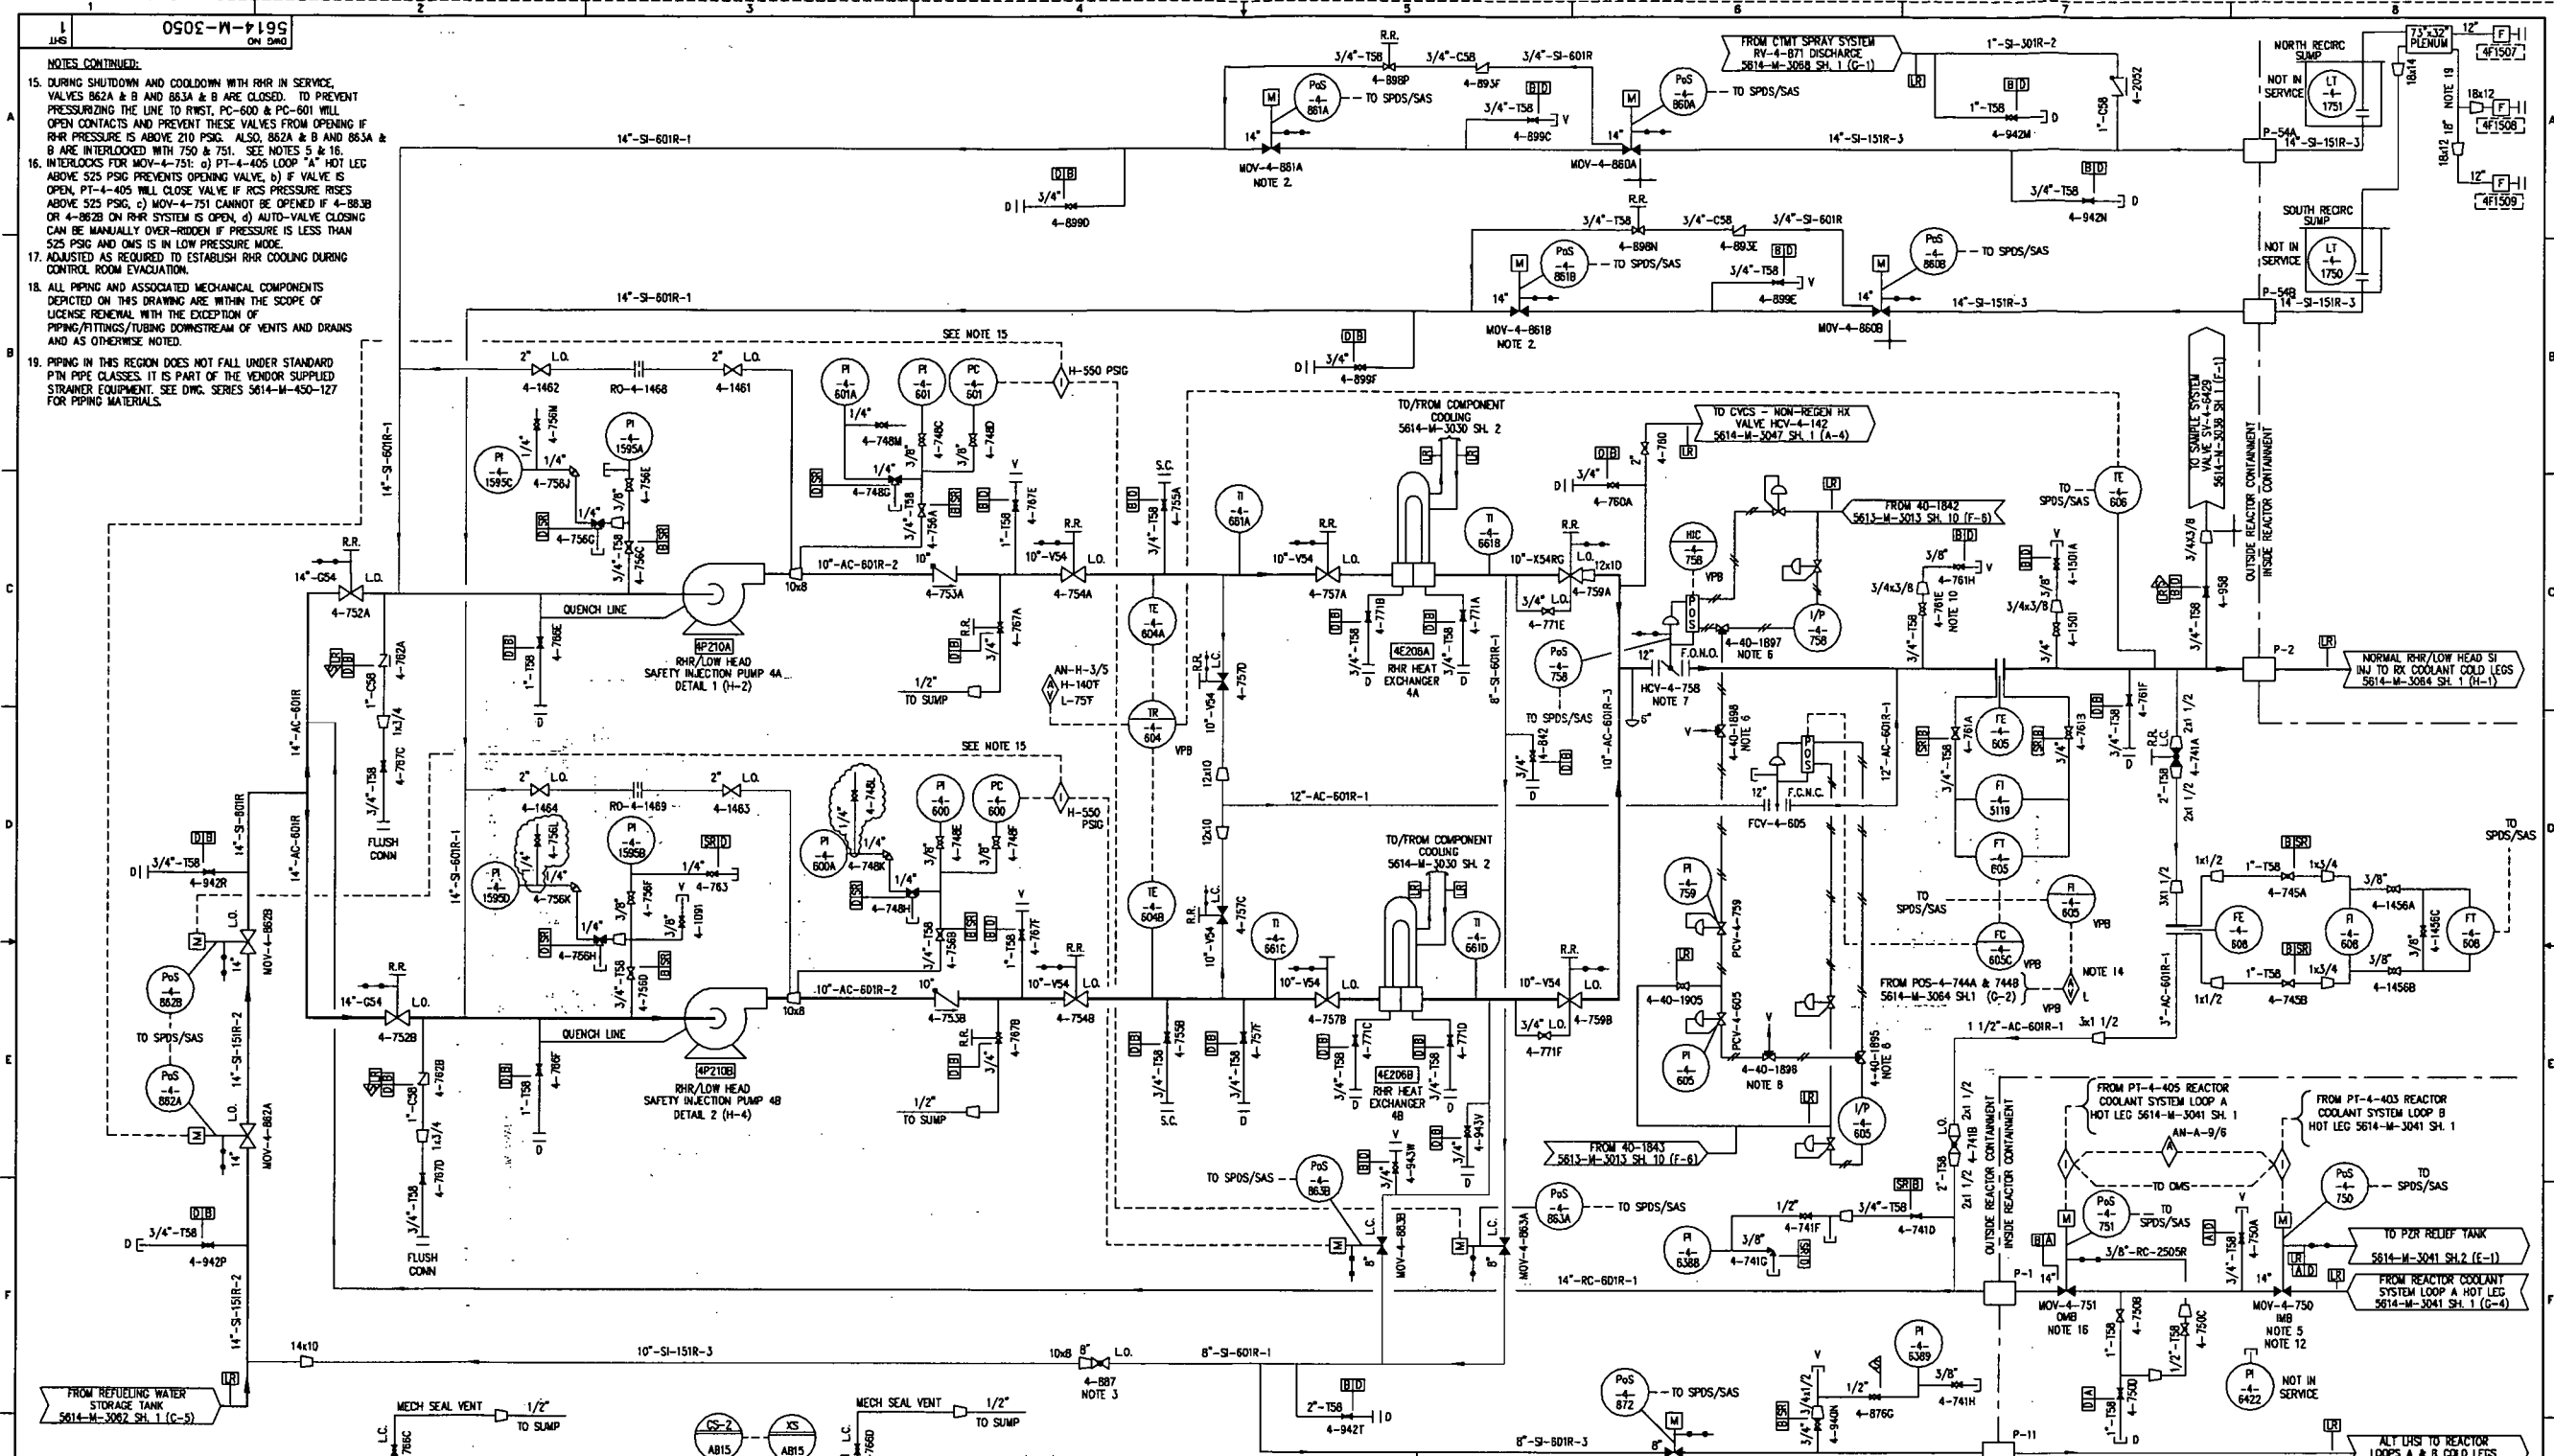

THIS DRAWING SUPERSEDES DRAWINGS:

| | |
|---------------|--------------|
| 5610-M-389 | REV. 5 |
| 5610-M-470-5 | SH.2 REV. 26 |
| 5610-M-1300 | REV. 4 |
| 5610-M-470-5 | SH.4 REV. 26 |
| 5610-M-370 | REV. 3 |
| 5610-M-450-53 | REV. 22 |
| 5610-M-470-5 | SH.3 REV. 31 |
| 5610-M-470-45 | SH.2 REV. 6 |
| 5610-M-470-45 | SH.3 REV. 10 |
| 5610-M-470-45 | SH.4 REV. 4 |

NOTES: THIS DRAWING IS A REVISION OF 5610-M-389. REV. 10. 5610-M-389 IS A REVISION OF 5610-M-389. REV. 10. 5610-M-389 IS A REVISION OF 5610-M-389. REV. 10.

REV. DATE

| | | |
|----|----------|--|
| 37 | 11-25-08 | ISSUED AS-BUILT PER CRN M-12954 (PC/M 08-067). |
| 38 | 11/23/09 | ISSUED AS-BUILT PER CRN M-12949 (PC/M 08-067). |
| 39 | 11/11/09 | ISSUED AS-BUILT PER CRN M-12826 (PC/M 08-067). |
| 40 | 8/12/09 | ISSUED AS-BUILT PER CRN M-12754 (PC/M 08-034). |
| 41 | 1/17/09 | ISSUED AS-BUILT PER PC/M 04-104 (PARTIAL). |
| 42 | 5-2-08 | ISSUED AS-BUILT PER PC/M 06-031 AND INCORP. CRN M-12309. |

REFERENCE DRAWINGS:

| | | |
|-------------|--------|---|
| 5610-M-3062 | SERIES | SAFETY INJECTION SYSTEM |
| 5610-M-3063 | SH.1 | CONTAINMENT SPRAY SYSTEM |
| 5610-M-3064 | SH.1 | SAFETY INJECTION - ACCUMULATOR SYSTEM |
| 5610-M-3041 | SH.1 | REACTOR COOLANT SYSTEM COMPONENT COOLING WATER |
| 5610-M-3030 | SH.2 | SYSTEM CONTROL SYSTEM DIAGRAM |
| 5610-T-0-2 | | CONTROL, PROTECTION, SAFEGUARDS AND STATUS MONITORING SYSTEMS LOGIC DIAGRAM |
| 5610-T-1-1 | | |
| 5610-M-3036 | SH.1 | SAMPLE SYSTEM - NSSS |
| 5610-M-3047 | SH.1 | CHEMICAL & VOLUME CONTROL SYSTEM |

NOTES:


- FOR GENERAL NOTES & LEGEND SEE DWG. NO. 5610-M-3000 SH. 2.
- MOV-4-861A & B HAVE 3/16" HOLE DRILLED IN DOWNSTREAM DISC TO PROVIDE RELIEF PATH FROM BETWEEN THE DISCS.
- VALVE 4-887 SHALL BE UNLOCKED AND THROTTLED TO LIMIT RHR PUMP RUNOUT ONLY DURING REFUELING MODE WHEN TRANSFERRING CAVITY WATER BACK TO THE REACTOR.
- MOV-4-872 TO OPEN ONLY 2 1/2" TO AVOID RHR PUMP RUNOUT DURING ALTERNATE RHR COOLING.
- INTERLOCKS FOR MOV-4-750: a) PT-4-403 LOOP "B" HOT LEG ABOVE 525 PSIG PREVENTS OPENING VALVE. b) IF VALVE IS OPEN, PT-4-403 WILL CLOSE VALVE IF RCS PRESSURE RISES ABOVE 525 PSIG. c) MOV-4-750 CANNOT BE OPENED IF 4-883A OR 4-882A ON RHR SYSTEM IS OPEN. d) AUTO-VALVE CLOSING CAN BE MANUALLY OVER-RIDDEN IF PRESSURE IS LESS THAN 525 PSIG AND OMS IS IN LOW PRESSURE MODE.

NOTE CONTINUED @ UPPER LEFT CORNER.



POD

5610-M-3050

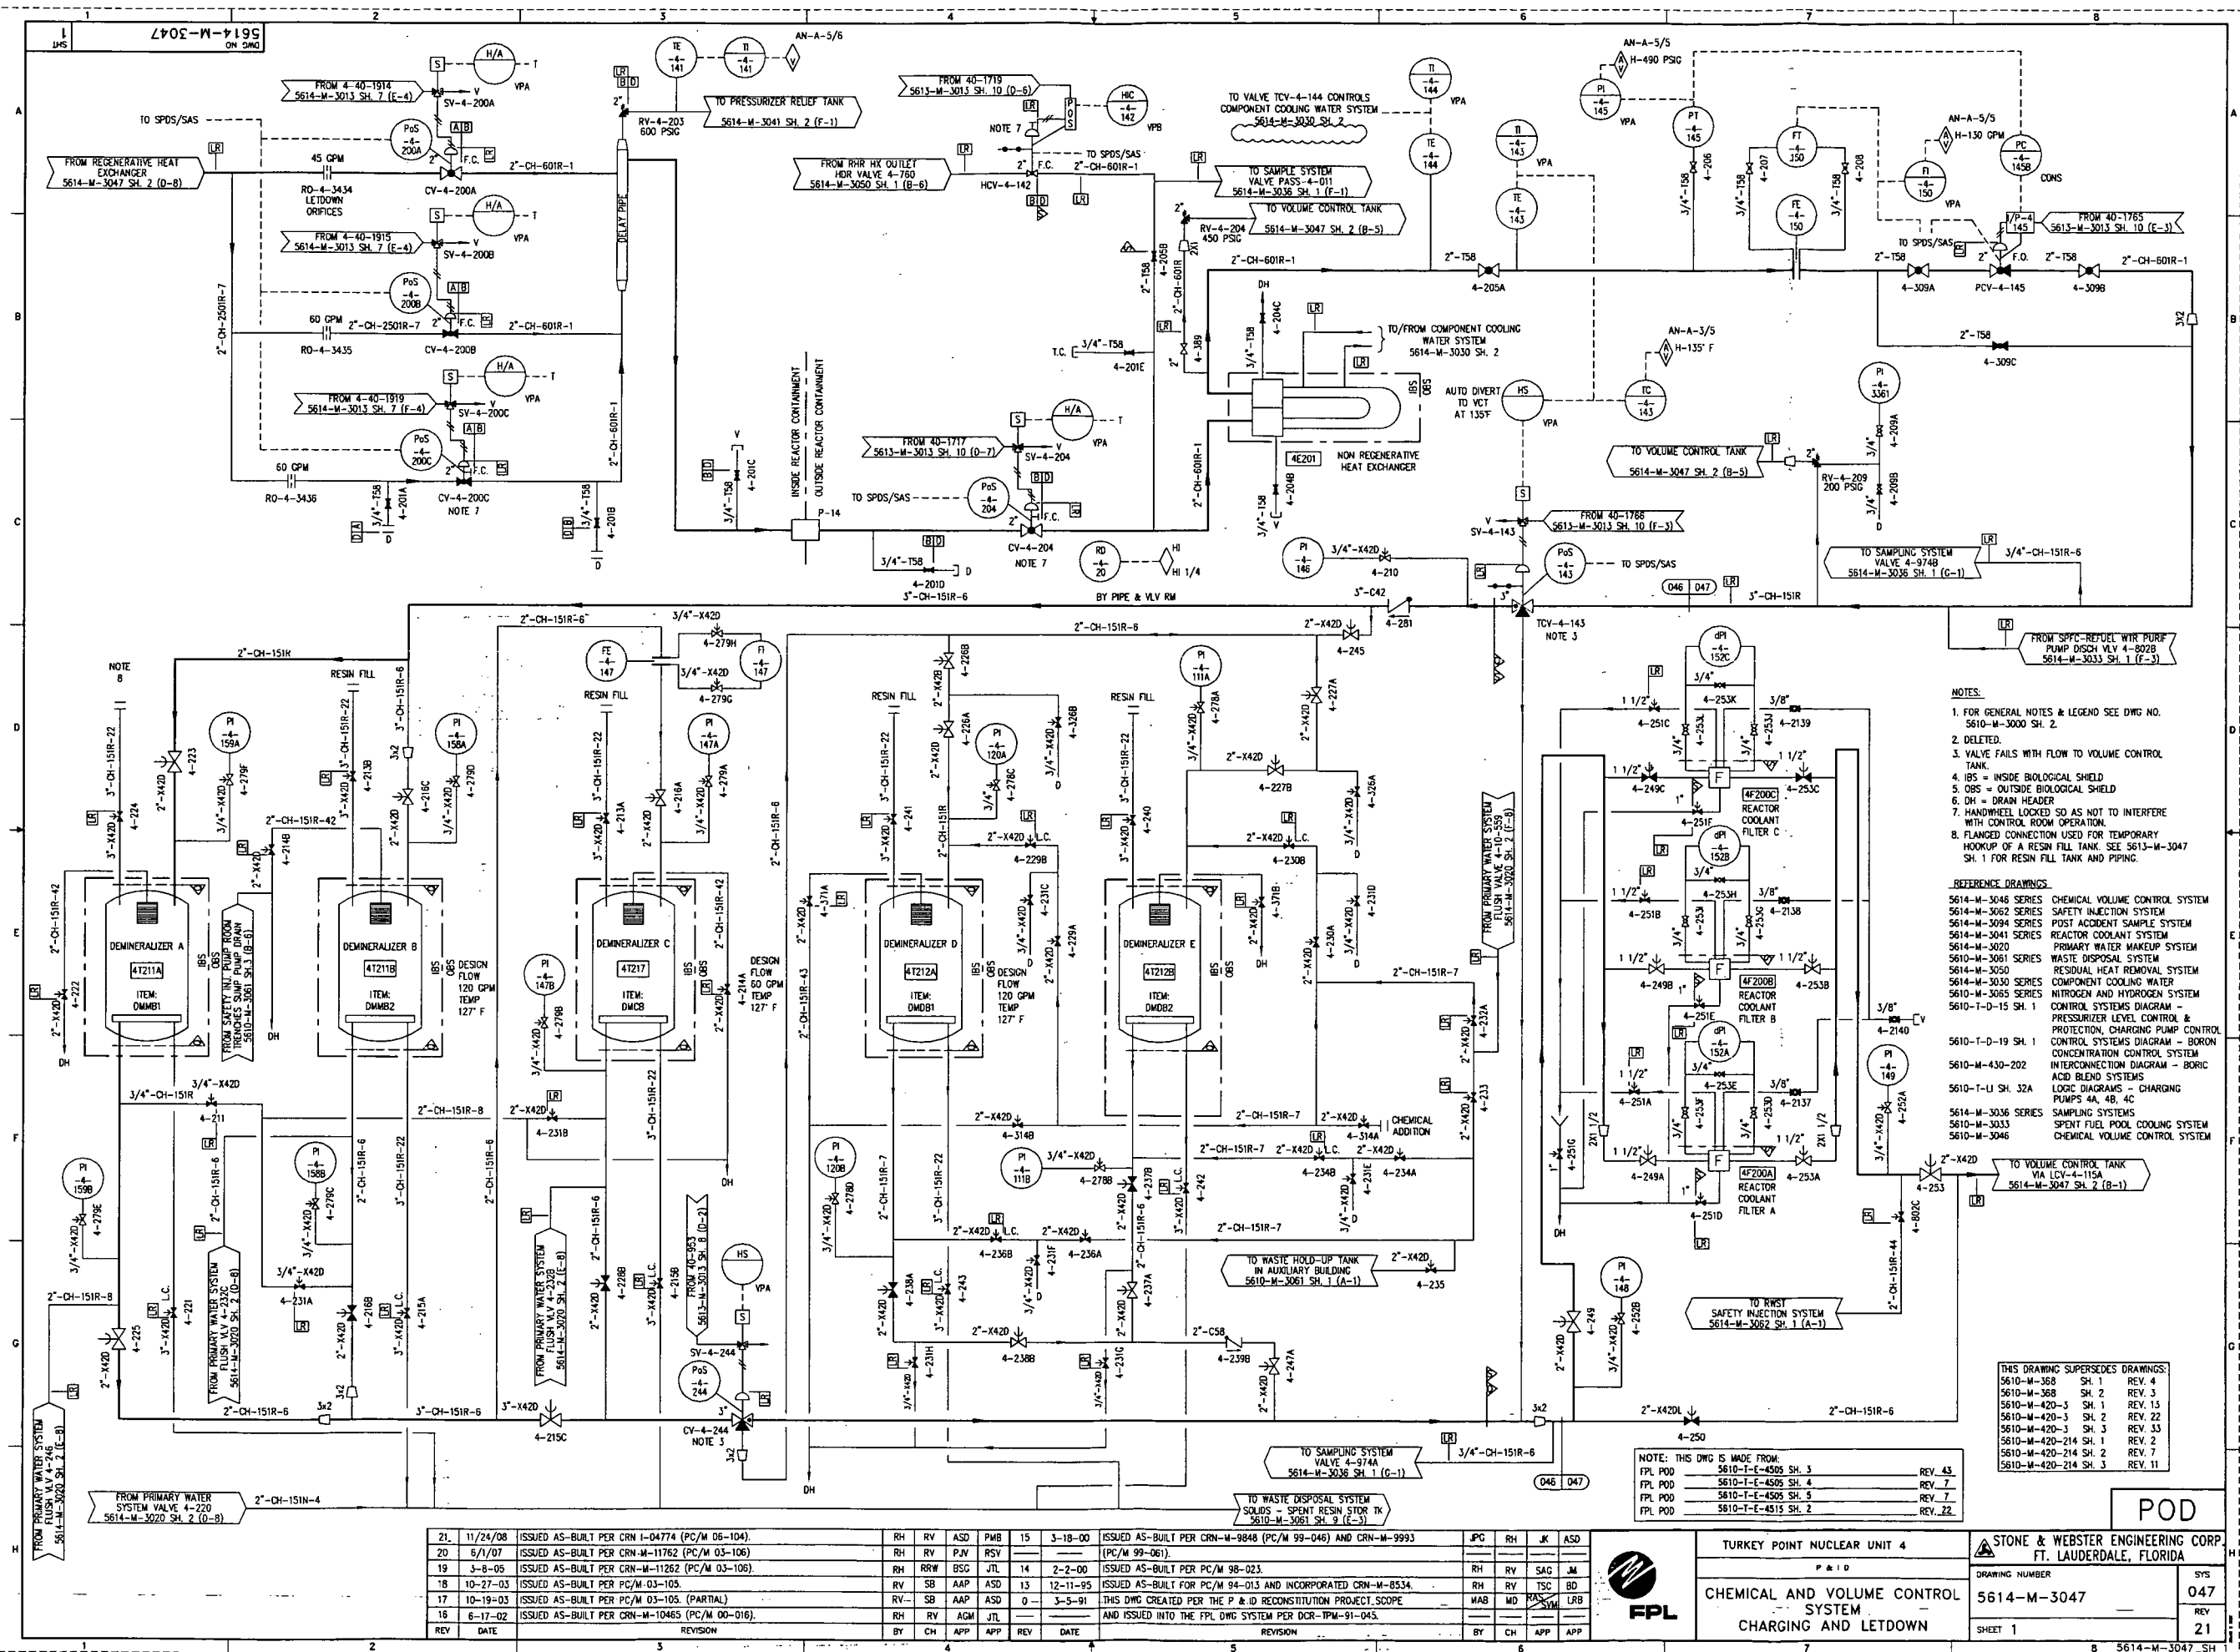REV. 38



| | | | | | | | | | | | | | |
|-----|----------|--|----|-----|-----|-----|-----|----------|--|-----|----|-----|-----|
| 21 | 11/24/08 | ISSUED AS-BUILT PER CRN I-04774 (PC/M 08-104). | RH | RV | ASD | PWB | 15 | 3-18-00 | ISSUED AS-BUILT PER CRN-M-9848 (PC/M 99-046) AND CRN-M-9993 (PC/M 99-061). | JPC | RH | JK | ASD |
| 20 | 5/1/07 | ISSUED AS-BUILT PER CRN-M-11762 (PC/M 03-106). | RH | RV | P.N | RSV | | | | | | | |
| 19 | 3-8-05 | ISSUED AS-BUILT PER CRN-M-11262 (PC/M 03-106). | RH | RRW | BSC | JTL | 14 | 2-2-00 | ISSUED AS-BUILT PER PC/M 98-023. | | | | |
| 18 | 10-27-03 | ISSUED AS-BUILT PER PC/M 03-105. | RV | SB | AAP | ASD | 13 | 12-11-95 | ISSUED AS-BUILT FOR PC/M 94-013 AND INCORPORATED CRN-M-8534. | RH | RV | SAG | JM |
| 17 | 10-19-03 | ISSUED AS-BUILT PER PC/M 03-105. (PARTIAL) | RV | SB | AAP | ASD | 0 | 3-5-91 | THIS DWG CREATED PER THE P & ID RECONSTITUTION PROJECT SCOPE | RH | RV | TSC | BD |
| 16 | 6-17-02 | ISSUED AS-BUILT PER CRN-M-10465 (PC/M 00-016). | RH | RV | AGM | JTL | | | AND ISSUED INTO THE FPL DWG SYSTEM PER DCR-1PM-91-045. | MAB | MD | RAY | APP |
| REV | DATE | REVISION | BY | CH | APP | APP | REV | DATE | REVISION | BY | CH | APP | APP |

| | | | | |
|---|---|--|--|-----|
|  FPL | TURKEY POINT NUCLEAR UNIT 4 | |  STONE & WEBSTER ENGINEERING CORP. FT. LAUDERDALE, FLORIDA | |
| | P & I D | | DRAWING NUMBER | SYS |
| | CHEMICAL AND VOLUME CONTROL SYSTEM CHARGING AND LETDOWN | | 5614-M-3047 | 047 |
| | | | SHEET 1 | 21 |