

Southern California Edison Company



P. O. BOX 800  
2244 WALNUT GROVE AVENUE  
ROSEMEAD, CALIFORNIA 91770

K. P. BASKIN  
MANAGER OF NUCLEAR ENGINEERING,  
SAFETY, AND LICENSING

November 15, 1982

TELEPHONE  
(213) 572-1401

Director, Office of Nuclear Reactor Regulation  
Attention: D. M. Crutchfield, Chief  
Operating Reactors Branch No. 5  
Division of Licensing  
U. S. Nuclear Regulatory Commission  
Washington, D.C. 20555

Gentlemen:

Subject: Docket No. 50-206  
Piping Data for Review of SEP Topic III-6  
Seismic Design Considerations  
San Onofre Nuclear Generating Station  
Unit 1

By letter dated October 29, 1982 we provided design information regarding various piping and equipment to permit independent seismic analyses of these items. Provided as an attachment to this letter is similar information for lines 2081-2-2501R, 2080-2-2501R, 5011-3-2501R, 5011-4-2501R and 5023-3-2501R. These lines are associated with the charging and pressurizer spray systems.

If you have any questions on this information, please let me know.

Very truly yours,

*Mr. D. Medford for KPB*

Enclosure

cc: T. Bridges (EG&G)

*A028*

8211190207 821115  
PDR ADDCK 05000206  
PDR

ATTACHMENT 1

PIPING SYSTEM ENGINEERING DATA

FOR

PIPING SYSTEMS:

- Pressurizer Spray  
Line Numbers: 5011-3-2501R, 5011-4-2501R, 5025-3-2501R
  
- Pressurizer Auxiliary Spray  
Line Number: 2080-2-2501R
  
- Charging Line  
Line Number: 2081-2-2501R

## TABLE OF CONTENTS

- Introduction
- Piping System Engineering Data
- Data List - Attachment "A"
- Pipe Data - Attachment "B"
- Piping Isometrics - Attachment "C"
- Valve Data - Attachment "D"
- Anchor Movements - Attachment "E"  
(Includes Equipment Drawings)

## INTRODUCTION

This report will describe the information required for a Dynamic Seismic Analysis, as well as other types of analyses such as Deadweight and Thermal for the Charging Line (Calc No. 101), Pressurizer Auxiliary Spray (Calc No. 100), and Pressurizer Spray (Calc No. 102). The order in which the data are presented is the same as that outlined in the "Piping System Engineering Data" sheet, Attachment "A".

1. Design and operating temperature-pressure are listed in Attachment "B".
2. The system is analyzed for pressure, deadweight, thermal and dynamic seismic loading conditions for a faulted condition using service level D stress allowable as guidelines, and stress allowables per the established criteria.
3. The detailed piping isometrics with all necessary dimensions and support locations are shown in Attachment "C".
4. Information on nominal pipe sizes, schedules weights and insulation are provided in Attachment "B".
5. The support type (showing support direction) and location is shown on the isometric drawings in Attachment C. The stiffness values are minimum rigid, per the established criteria.
6. Attachment "D" contains the valve data used for this analysis, including copies of the valve drawings used to prepare the valve data. This attachment contains information for all valves shown in Attachment "C".
7. Anchor thermal movements at equipment pertaining to this analysis can be obtained from equipment drawings provided in Attachment "E". The translation and rotational stiffness of anchors used in this analysis are  $(10^6)$  lb/in and  $(10^8)$  in-lb/rad. Thermal displacements at attachments of the identified piping system to the loop piping are provided in Attachment "E".
8. The drawings for the pressurizer C-2, and the regenerative heat exchanger are provided in Attachment "E".
9. N/A
10. The response spectra to perform dynamic analysis is per seismic response spectra established for the plant and defined in the established criteria.
11. N/A
12. N/A

ATTACHMENT "A"

DATA LIST

# PIPING SYSTEM ENGINEERING DATA

For Class 1 piping analyses and reviews, the following engineering data are required.

- ✓ 1. List of design and operating temperatures and pressures.
- ✓ 2. List of load cases, their associated operating conditions, and appropriate Service Level (example: the ECC system will be analyzed for a plant faulted condition using Service Level B stress allowances). The list should also include significant transients and their associated cycles necessary for the fatigue analyses.
- ✓ 3. Detailed piping drawings and/or isometrics <sup>indicating the geometry of the piping system</sup> along with all necessary dimensions and <sup>and</sup> ~~and~~ locations.
- ✓ 4. List of nominal pipe sizes, schedules, weights, <sup>and materials</sup> ~~etc.~~
- ✓ 5. List of pipe support types, locations, stiffnesses, and preloads or the applicable support drawings.
- ✓ 6. List of valve locations, weights, lengths, and eccentricities (center of gravity locations).
7. List of any anchor movements (thermal, seismic, etc.), motions, and applicable stiffness values.
8. Applicable data (length, weight, center of <sup>gravity</sup>, <sup>insulation thickness</sup>, etc.) <sup>for any attached</sup> ~~for any attached~~ equipment (eg. pumps, heat tanks, etc.).
9. Greater <sup>thermal</sup> gradient information.
10. <sup>Response spectra</sup> ~~Response spectra~~, static acceleration levels, or <sup>varying accel-</sup> ~~varying accel-~~ <sup>nation</sup> ~~nation~~ for dynamic analyses.
11. Description of any special fittings or <sup>components present on the piping system</sup> ~~components present on the piping system~~.
12. If applicable, any imposed forces and <sup>moments due to relief valve</sup> ~~moments due to relief valve~~ discharge, connected lines and components, etc.
13. The design specification. It is recognized that the <sup>design</sup> ~~design~~ specification would include some of the above data.

Unless otherwise directed, the following assumptions will be used:

1. All components are butt welded (<sup>fusion</sup> ~~fusion~~ and <sup>butt</sup> ~~butt~~ welds). Weld specifications would be needed if verification of this assumption is required.
2. All components meet applicable ANSI standards or <sup>listed in table</sup> ~~listed in table~~ NB-3132-1 of the ASME Code.
3. The requirements of ASME Code, Section III, <sup>Subpart 3100</sup> ~~Subpart 3100~~ are satisfied.

This list is not necessarily all inclusive; thus, verification is required due to special requirements made to certain projects or programs.

ATTACHMENT "B"

PIPE DATA



WESTINGHOUSE NUCLEAR TECHNOLOGY DIVISION

|   |                       |                |               |                |          |
|---|-----------------------|----------------|---------------|----------------|----------|
| TITLE <i>PIPING SYSTEM ENGINEERING DATA</i>   |                       |                |               |                | PAGE     |
| <i>LINE NOS. 2080, 2081, 5011, &amp; 5025</i> |                       |                |               |                | OF       |
| PROJECT                                       | AUTHOR                | DATE           | CHK'D. BY     | DATE           | DATE     |
| <i>S.C.E</i>                                  | <i>Richard J. ...</i> | <i>11/1/82</i> | <i>R. ...</i> | <i>11/1/82</i> | <i>~</i> |
| S.O.  | CALC. NO.             | FILE NO.       | GROUP         |                |          |
|   | <i>2</i>              |                | <i>PSA-1</i>  |                |          |

PIPE DATA

| SYSTEM                  | RC                   | RC                   | RC                   | RC                   | RC                   |
|-------------------------|----------------------|----------------------|----------------------|----------------------|----------------------|
| LINE NO.                | 2080-2"<br>2501R     | 2081-2"<br>2501R     | 5011-3"<br>2501R     | 5011-4"<br>2501R     | 5025-3"<br>2501R     |
| DESIGN TEMP °F          | 500                  | 500                  | 570                  | 570                  | 570                  |
| OPER. TEMP °F (MAX)     | 500                  | 500                  | 570                  | 570                  | 570                  |
| DESIGN PRESS PSIG       | 2500                 | 2500                 | 2500                 | 2500                 | 2500                 |
| OPER. PRESS. PSIG (MAX) | 2500                 | 2500                 | 2500                 | 2500                 | 2500                 |
| MATERIAL CLASS          | 2501R                | 2501R                | 2501R                | 2501R                | 2501R                |
| MATERIAL                | A 312<br>TP 316      | A 312<br>TP 316      | A 312<br>TP 316      | A 312<br>TP 316      | A 312<br>TP 316      |
| SCHEDULE                | 160                  | 160                  | 160                  | 160                  | 160                  |
| O. D. INCH.             | 2.375                | 2.375                | 3.5                  | 4.5                  | 3.5                  |
| t. INCH.                | .343                 | .343                 | .437                 | .531                 | .437                 |
| INSUL. THK (IN)         | 1 1/2                | 1 1/2                | 1 1/2                | 2                    | 1 1/2                |
| LBS/FT PIPE             | 7.444                | 7.444                | 14.32                | 22.51                | 14.32                |
| LBS/FT WATER            | .971                 | .971                 | 2.348                | 4.02                 | 2.348                |
| LBS/FT INSUL.           | 2.352                | 2.352                | 3.32                 | 4.8                  | 3.32                 |
| TOTAL LBS/FT            | 10.767               | 10.767               | 19.988               | 31.33                | 19.988               |
| COEFF. THERM. X 10/FT   | .0591                | .0591                | .0587                | .0587                | .0587                |
| E <sub>c</sub> PSI      | 28.3x10 <sup>6</sup> | 28.3x10 <sup>6</sup> | 28.3x10 <sup>6</sup> | 28.3x10 <sup>6</sup> | 28.3x10 <sup>6</sup> |
| SC                      | 18800                | 18800                | 18800                | 18800                | 18800                |
| SH                      | 18000                | 18000                | 17300                | 17300                | 17300                |

|          |           |        |      |           |      |           |      |
|----------|-----------|--------|------|-----------|------|-----------|------|
| REV. NO. | REV. DATE | AUTHOR | DATE | CHK'D. BY | DATE | CHK'D. BY | DATE |
|----------|-----------|--------|------|-----------|------|-----------|------|

**2D. PIPING SPECIFICATION**  
**CLASS 2501**

**Design Conditions**

Pressure 2500 psig  
Maximum Temperature 650° F

**Material:** Stainless Steel, The ASTM Specification is listed below for each item.

**Pipe**

|              |                 |
|--------------|-----------------|
| Size         | 1/2" to 12"     |
| Construction | Seamless        |
| ASTM Spec*   | *A 312 Type 316 |
| Schedule     | 160             |

**Fittings**

|           |                |               |
|-----------|----------------|---------------|
| Size      | 2" and smaller | 2-1/2" to 12" |
| Type      | Forged         | Seamless      |
| Joint     | Socket welded  | Butt welded   |
| ASTM Spec | A 182 F 316    | A 403 WP 316  |
| Rating    | 4000#          | Schedule 160  |

**Flanges**

|           |                |               |
|-----------|----------------|---------------|
| Size      | 2" and smaller | 2-1/2" to 12" |
| Type      | Forged         | Forged        |
| Joint     | Socket welded  | Welding neck  |
| ASTM Spec | A 182 F 316    | A 182 F 316   |
| Rating    | 1500# RTJ      | 1500# RTJ     |
| Bored to  | Schedule 160   | Schedule 160  |

\*Require supplementary requirement S7 in accordance with A 376 in sizes 3" and larger.

|  |     |           |     |      |     |                              |         |  |            |
|--|-----|-----------|-----|------|-----|------------------------------|---------|--|------------|
| FORM NO. ENG. 87 KE MECHANICAL SECTION |     | REVISIONS |     | DATE |     | Location SAN ONOFRE - UNIT 1 | M-18668 | PIPING DESIGN AND MATERIAL SPECIFICATION | Class 2501 |
| Approved                               | OK. | OK.       | OK. | OK.  | OK. |                              |         |  |            |
| Checked                                | OK. | OK.       | OK. | OK.  | OK. |                              |         |  |            |
| Design                                 | OK. | OK.       | OK. | OK.  | OK. |                              |         |  |            |
| Material                               | OK. | OK.       | OK. | OK.  | OK. |                              |         |  |            |
| Welding                                | OK. | OK.       | OK. | OK.  | OK. |                              |         |  |            |
| Final                                  | OK. | OK.       | OK. | OK.  | OK. |                              |         |  |            |
| Southern California Edison             |     | SCE       |     |      |     |                              |         |  |            |


ATTACHMENT "C"

PIPING ISOMETRICS

| <u>Line No.</u> | <u>Isometric Drawing Number</u> |
|-----------------|---------------------------------|
| 2081-2"-2501R   | 334480-3                        |
| 2080-2"-2501R   | 334481-2<br>334482-3            |
| 5011-3"-2501R   | 334595-2                        |
| 5011-4"-2501R   |                                 |
| 5025-3"-2501R   | 334597-2                        |

Calc. N° 100

Denote Node N°

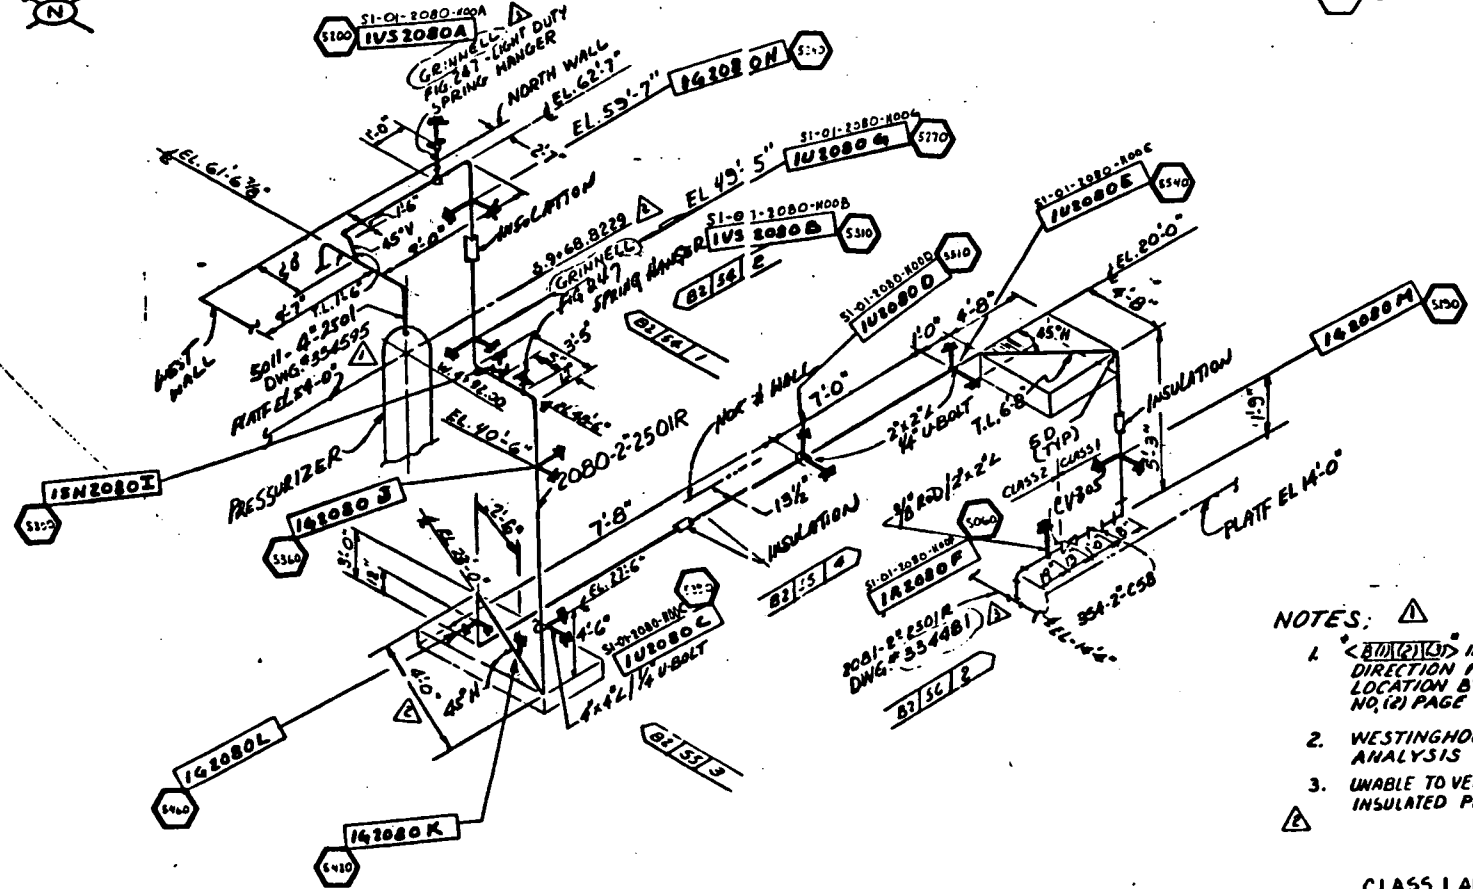

NOTES:

1. INDICATES VIEWING DIRECTION & PHOTOGRAPH LOCATION BY (1) PHOTO BOOK NO, (2) PAGE NO, (3) PHOTO NO
2. WESTINGHOUSE SCOPE OF ANALYSIS
3. UNABLE TO VERIFY FITTINGS ON INSULATED PIPING.

CLASS 1 AND 2 PIPING  
SAFETY RELATED

BOP-SEISMIC REEVALUATION  
ANALYSIS BOUNDARY-ISOMETRIC

UNIT 1

CERTIFIED AS BUILT

334480-3

|    |          |          |
|----|----------|----------|
| 3  | ✓        | 12/21/78 |
| 2  | ✓        | 9/6/78   |
| 1  | ✓        | 4/13/78  |
| 0  | AS BUILT | 9/1/77   |
| NO | REPT     | DATE     |

|  |      |          |
|--|------|----------|
| BECHTEL CORPORATION<br>ENGINEERS & CONSTRUCTORS<br>LOS ANGELES, CALIF. |      |          |
| JOB NO.  | DATE | APPROVED |
| 1216-001   |      |          |

| NO. | REVISIONS                           | DATE     | DR.    | CHK. | EQS. | CHK.E. | P.E. | QAE. |
|-----|-------------------------------------|----------|--------|------|------|--------|------|------|
| 3   | INCORPORATED CCN # 2                | 12-29-78 | J.C.E. | DSH  | MAN  | N/A    | MAN  | MAN  |
| 2   | INCORPORATED CCN # 1 (NEW DWG. NO.) | 9-6-78   | J.C.E. | B.D. | MAN  | N/A    | MAN  | MAN  |
| 1   | INCORP DCN # 2, 63 (22 & 45 & 41)   | 3-10-77  | 9-6-77 | E.S. | MAN  | N/A    | MAN  | MAN  |
| 0   | AS BUILT                            | 9-9-77   | SKY    | JWL  | MAN  | N/A    | MAN  | MAN  |

|          |   |
|----------|---|
| A.O. NO. | SAN ONOFRE NUCLEAR GENERATING STATION                                   |
| FILE     | ISOMETRIC - LN N° 2080 2" 250IR FROM LN N° 2081-2" TO PR. AUX SPRAY     |
|          | SOUTHERN CALIFORNIA EDISON COMPANY<br>SCALE NONE<br>LOS ANGELES, CALIF. |

334480-3


1216-001-3

CALL N° 101

⬡ DENOTES NODE N°.



\* PER (N) WALKDOWN INFO  
LINE N° 2081-2"-2501R

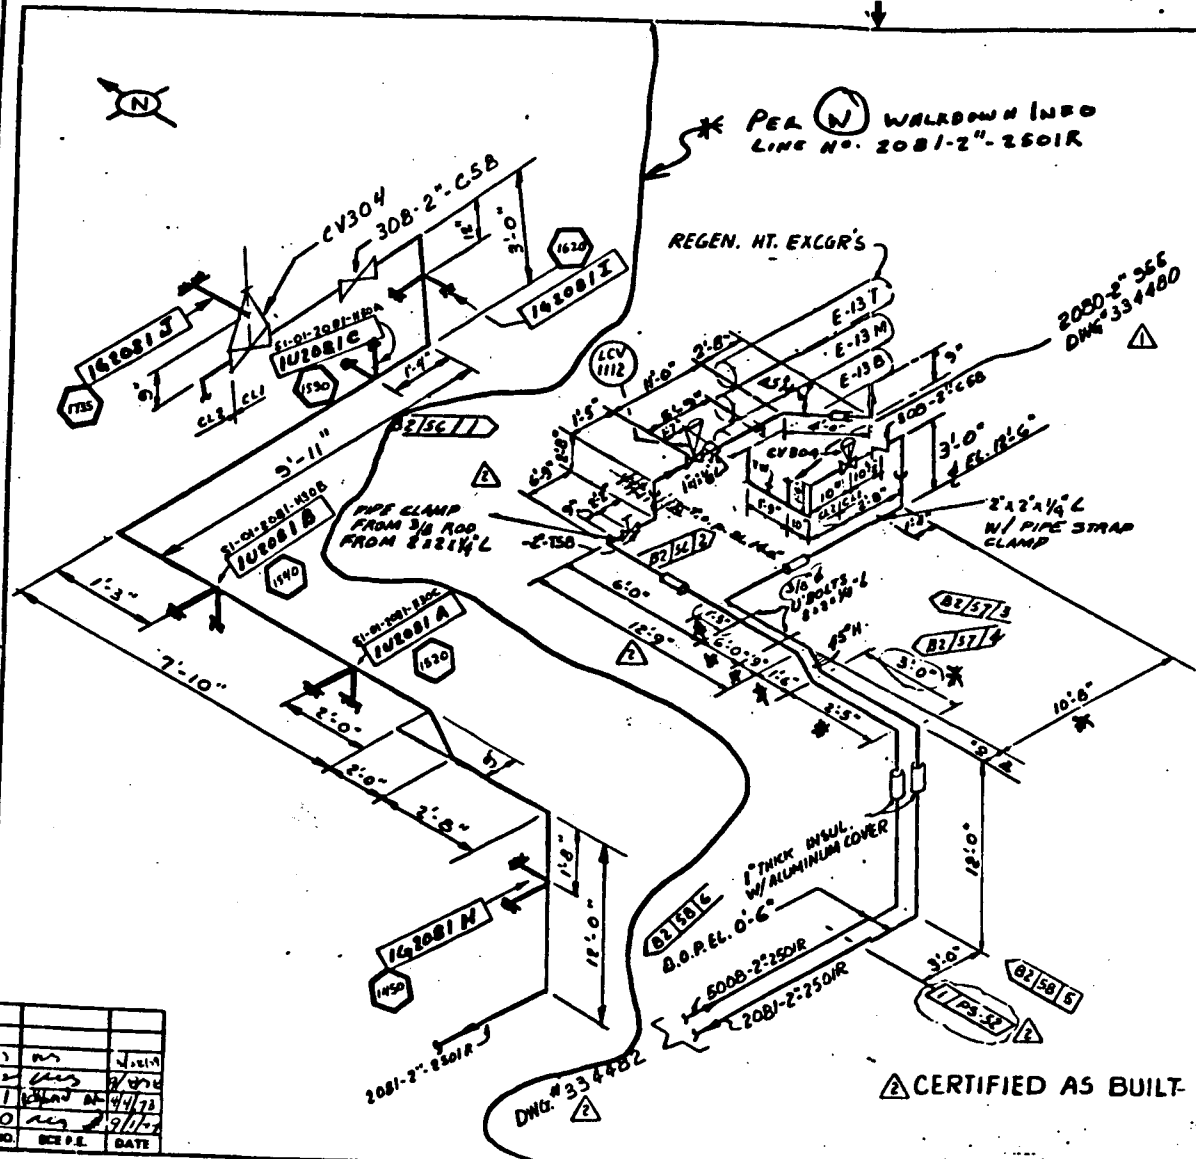

NOTES

1. <B11(2)13> INDICATES VIEWING DIRECTION & PHOTOGRAPH LOCATION BY (1) PHOTO BOOK NO, (2) PAGE NO, (3) PHOTO NO
2. WESTINGHOUSE SCOPE OF ANALYSIS
3. FOR PIPE SUPPORT AND HANGER DETAIL SEE M-31736
4. UNABLE TO VERIFY FITTINGS ON INSULATED PIPING.

CLASS 1 AND 2 PIPING  
SAFETY RELATED

⬡ CERTIFIED AS BUILT

BOP-SEISMIC REEVALUATION  
ANALYSIS BOUNDARY-ISOMETRIC  
UNIT 1

334481-2

334481-2

|     |          |        |
|-----|----------|--------|
| NO. | REV.     | DATE   |
| 1   | AS BUILT | 4/4/78 |
| 2   | REVISED  | 9/1/78 |
| 3   | REVISED  | 9/1/78 |

**BECHTEL CORPORATION**  
ENGINEERS & CONSTRUCTORS  
LOS ANGELES, CALIF.


|          |      |          |
|----------|------|----------|
| JOB NO.  | DATE | APPROVED |
| 1286-001 |      |          |

| NO. | REVISIONS                                 | DATE    | BY     | CHECKED | DATE    | BY  | APPROVED |
|-----|---|---------|--------|---------|---------|-----|----------|
| 3   | INCORPORATED CCN#2                        | 3-30-77 | J.L.C. | J.L.C.  | 3-30-77 | NEW | N/A      |
| 2   | INCORPORATED CCN#1 (NEW DMG. NO.)         | 9-6-78  | J.L.C. | J.L.C.  | 9-6-78  | NEW | N/A      |
| 1   | INCORPORATED DCN#1, 2, 3 (C/O 456122 SH1) | 4-6-79  | J.L.C. | J.L.C.  | 4-6-79  | NEW | N/A      |
| 0   | AS BUILT                                  | 3-4-77  | R.W.W. | J.L.C.  | 3-4-77  | NEW | N/A      |

A.D. NO. SAN ONOFRE NUCLEAR GENERATING STATION  
FILE 15OMETRIC-LINE 5008-2-2501R;  
2081-2-2501R; REG. HT EXCHANGER TO LOOP 1A"  
SOUTHERN CALIFORNIA EDISON COMPANY

Calc N° 102

Hexagon symbol denotes Note N°

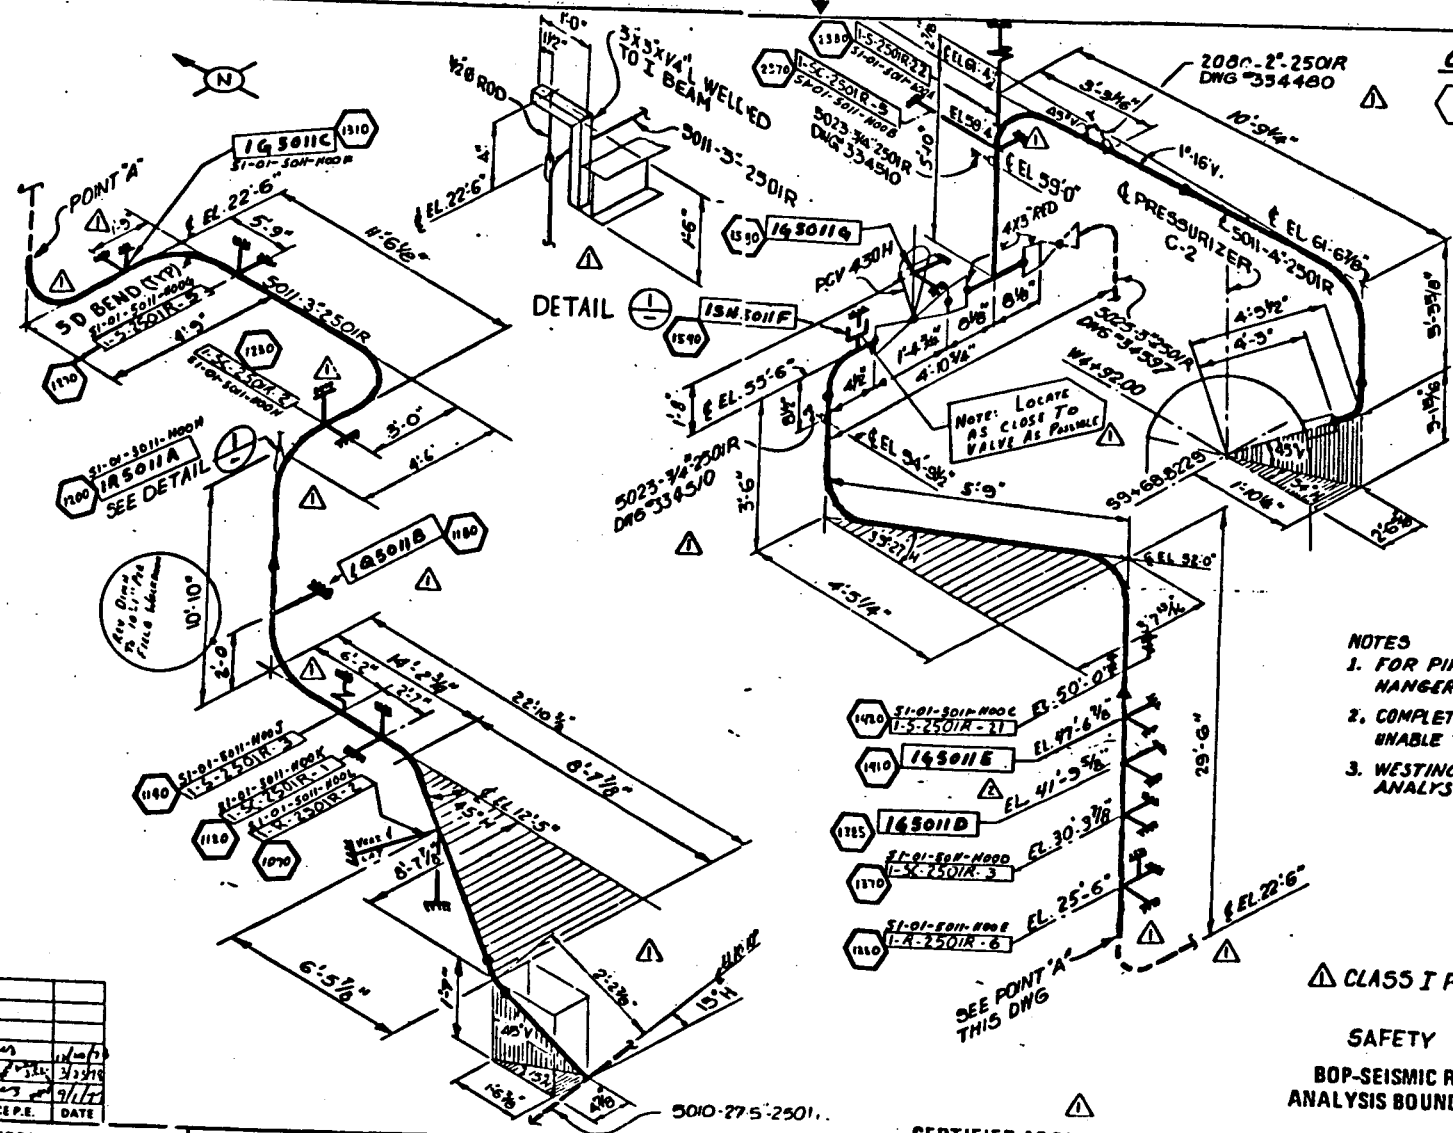

- NOTES
1. FOR PIPE SUPPORT AND HANGER DETAILS, SEE M-3123
  2. COMPLETE LINE INSULATED UNABLE TO VERIFY FITTINGS
  3. WESTINGHOUSE SCOPE OF ANALYSIS

CLASS I PIPING

SAFETY RELATED  
BOP-SEISMIC REEVALUATION  
ANALYSIS BOUNDARY-ISOMETRIC

CERTIFIED AS BUILT

UNIT 1

|     |          |          |
|-----|----------|----------|
| NO. | DATE     | APPROVED |
| 1   | 12/27/78 | J.C.L.   |
| 2   | 1/10/79  | J.C.L.   |

BECHTEL CORPORATION  
ENGINEERS & CONSTRUCTORS  
LOS ANGELES, CALIF.

|   |                         |          |        |    |     |     |     |     |
|---|-------------------------|----------|--------|----|-----|-----|-----|-----|
| 2 | INCORPORATED CCN#1      | 12/27/78 | J.C.L. | 03 | MDW | N/A | N/A | N/A |
| 1 | INCORPORATED DCN #3 & 2 |          |        |    |     |     |     |     |


|          |      |   |
|----------|------|---|
| I.O. NO. | FILE | SAN ONOFRE NUCLEAR GENERATING STATION                                     |
|          |      | ISOMETRIC-LINE#S 5011-3-2501R & 5011-4-2501R FROM LOOP 'A' TO PRESSURIZER |
|          |      | SOUTHERN CALIFORNIA EDISON COMPANY<br>SCALE NONE<br>LOS ANGELES, CALIF.   |

334595-2

334595-2

SCALE N° 101

⬡ DENOTES NODE N°

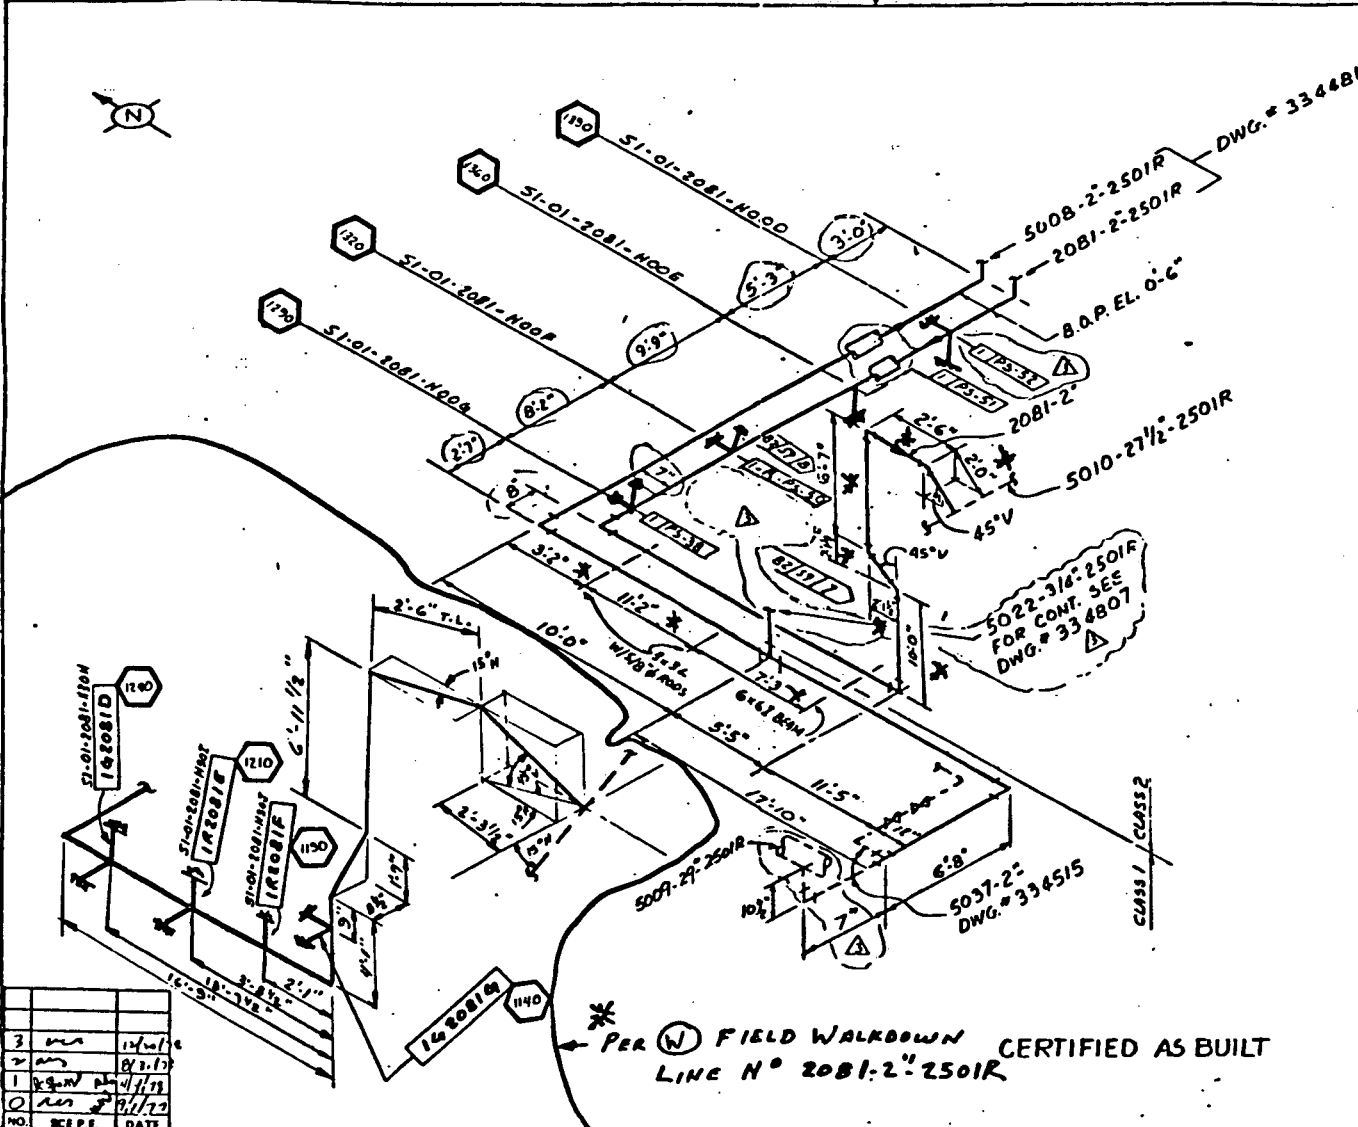

NOTES

1. <PHOTO> INDICATES VIEWING DIRECTION & PHOTOGRAPH LOCATION BY (1) PHOTO BOOK NO, (2) PAGE NO, (3) PHOTO NO
2. WESTINGHOUSE SCOPE OF ANALYSIS
3. FOR PIPE SUPPORT AND HANGER DETAILS SEE M-31736
4. BOTH LINES INSULATED - UNABLE TO VERIFY FITTINGS.

CLASS 1 & 2 PIPING  
SAFETY RELATED

BOP-SEISMIC REEVALUATION  
ANALYSIS BOUNDARY-ISOMETRIC

UNIT 1

\* PER (W) FIELD WALKDOWN CERTIFIED AS BUILT  
LINE N° 2081-2'-2501R

| NO. | DATE    | DATE |
|-----|---------|------|
| 3   | 12/1/74 |      |
| 2   | 07/2/73 |      |
| 1   | 04/1/73 |      |
| 0   | 01/1/73 |      |


|  |      |          |
|--|------|----------|
| BECHTEL CORPORATION<br>ENGINEERS & CONSTRUCTORS<br>LOS ANGELES, CALIF. |      |          |
| JOB NO.<br>12186 001   | DATE | APPROVED |

| NO. | REVISIONS                               | DATE     | DR.    | CHK.   | EGS. | CH.F. | RE. | DATE    |
|-----|---|----------|--------|--------|------|-------|-----|---------|
| 3   | INCORPORATED CCN #2                     | 03/27/78 | J.C.E. | B.D.E. | N/A  | N/A   | N/A | 01/1/78 |
| 2   | INCORPORATED CCN #1 (NEW DWG. NO.)      | 04-5-78  | J.C.E. | B.D.E. | N/A  | N/A   | N/A | 01/1/78 |
| 1   | INCORP DCN #1, 2, 3 (0-14 #45422, SA 2) | 04-6-78  | J.C.E. | B.D.E. | N/A  | N/A   | N/A | 01/1/78 |
| 0   | AS BUILT                                | 04-7-77  | R.W.M. | J.L.   | N/A  | N/A   | N/A | 01/1/77 |

|          |  |
|----------|--|
| I.G. NO. | SAN ONOFRE NUCLEAR GENERATING STATION  |
| FILE     | ISOMETRIC-LUN#S 5008-2'-2501R;<br>2081-2'-2501R; REGEN HEAT<br>EXCHANGER TO LOOP "A" |
|          | SOUTHERN CALIFORNIA EDISON COMPANY<br>SCALE NONE LOS ANGELES, CALIF.                 |

334402-3

△ DENOTES NODE N°

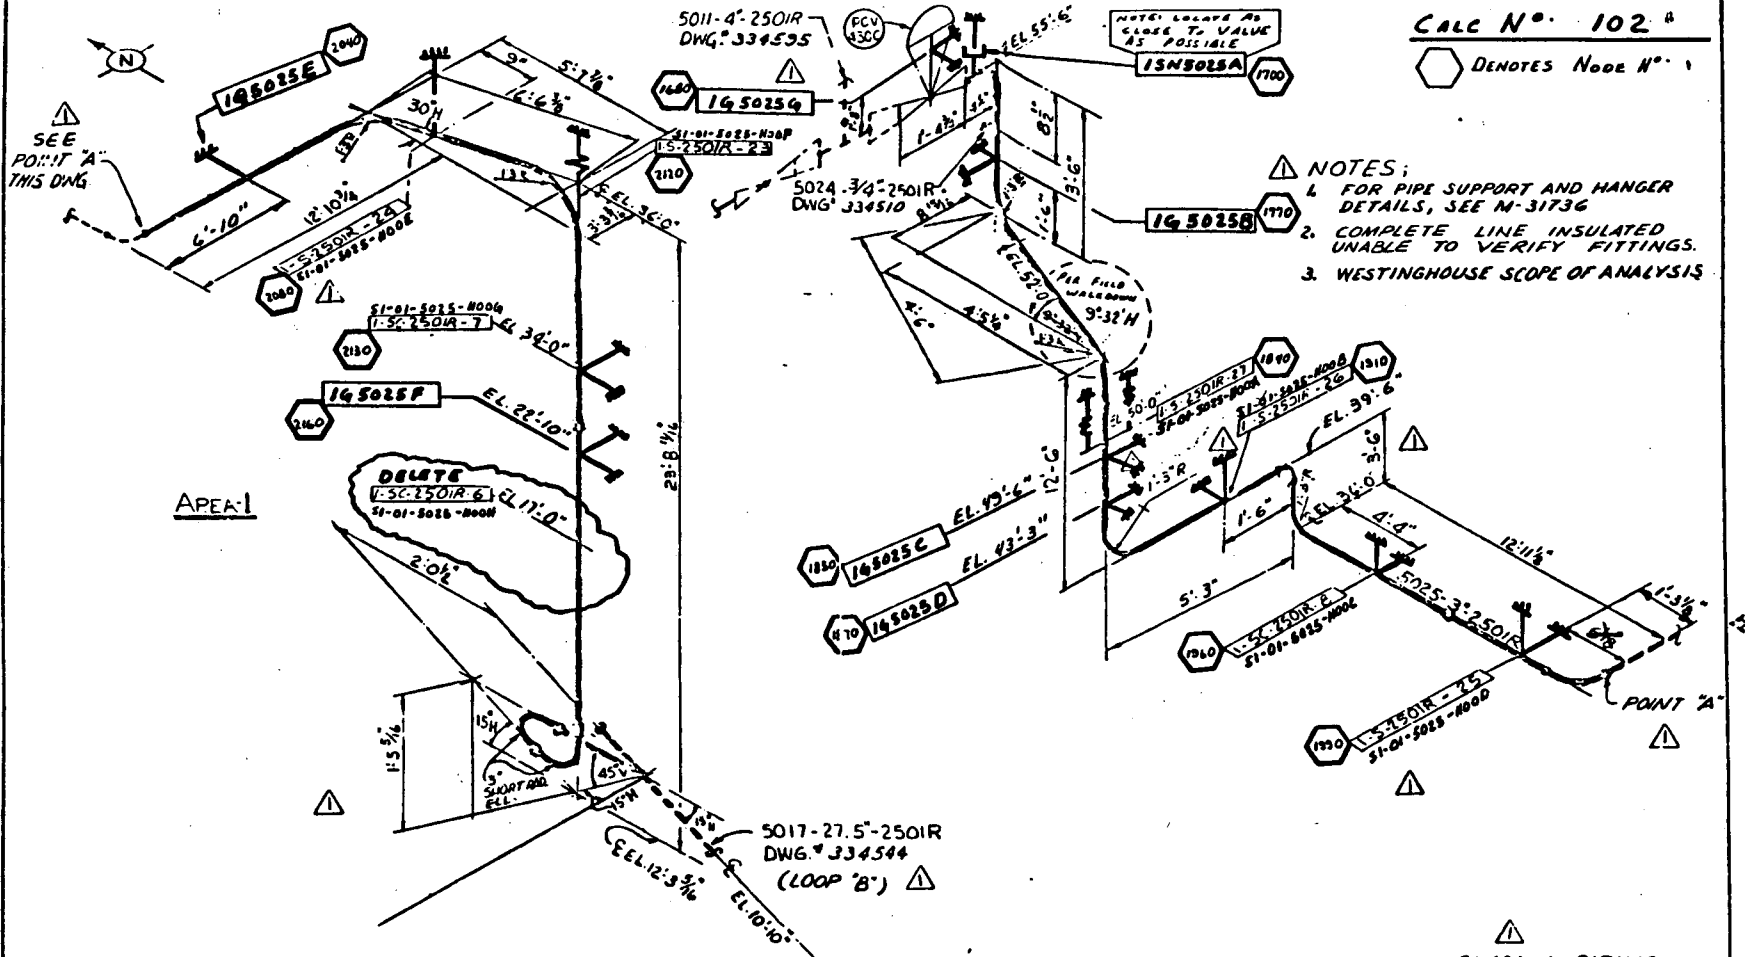

- △ NOTES:
1. FOR PIPE SUPPORT AND HANGER DETAILS, SEE M-3173G
  2. COMPLETE LINE INSULATED UNABLE TO VERIFY FITTINGS.
  3. WESTINGHOUSE SCOPE OF ANALYSIS

AREA I

△  
 CLASS 1 PIPING.  
 SAFETY RELATED  
 BOP-SEISMIC REEVALUATION  
 CERTIFIED AS BUILT ANALYSIS BOUNDARY-ISOMETRIC  
 UNIT 1

|    |         |      |
|----|---------|------|
|    |         |      |
| ✓  | 1/24/13 |      |
| ✓  | 1/27/13 |      |
| 0  | 1/27/13 |      |
| NO | SCPE.   | DATE |

|  |      |          |                          |  |          |    |     |     |     |      |      |          |   |  |
|--|------|----------|--------------------------|--|----------|----|-----|-----|-----|------|------|----------|---|--|
| BECHTEL CORPORATION<br>ENGINEERS & CONSTRUCTORS<br>LOS ANGELES, CALIF. |      |          |                          |  |          |    |     |     |     |      |      | J.O. NO. | SAN ONOFRE NUCLEAR GENERATING STATION                       |  |
| JOB NO.  | DATE | APPROVED | 2 INCORPORATED CCN#1     |  | 12/29/12 | ES | JCC | MAN | N/A | ✓    | WAL  | FILE     | ISOMETRIC-LINE N° 5025-3'-2501R<br>FROM LOOP 'B' TO 5011-4" |  |
| 12186-001  |      |          | 1 INCORPORATED DCN#1 & 2 |  | 1-19     | SA | ZB  | HL  | N/A | ✓    | FRAN |          |   |  |
|  |      |          | 0 AS BUILT               |  | 4-9-13   | SA | ZB  |     | N/A | ✓    | FRAN |          |   |  |
|  |      |          | NO REVISIONS             |  | DATE     | DR | CHK | EGS | CHK | P.E. | DATE |          |   |  |

334597-2

334597-2



ATTACHMENT "D"

VALVE DATA

VALVE DATA

1) Line No. 2080-2"-2501R

- a) Valve - 354-2"-C58  
Weight = 29#  
Length (Body) = 8 1/2"  
C. G. = x = 1 1/16", y = 1 1/4" \*  
ID = 2C58  
Vendor = Rockwell  
Drawing C-61462 (Not available)
- Valve data estimated from Rockwell Drawing ACD-31605533

- b) Valve - CV-305  
Weight = 475#  
Length (Body) = 10"  
C. G. = 22 5/8"  
ID = 2IA58R  
Vendor = BSB Safety  
Drawing 95216-20 (Not Available)
- Valve data estimated from Copes Vulcan Drawing D-189777

2) Line No. 2081-2"-2501R

- a) Valve 308-2"-C58  
Weight = 29#  
Length (Body) = 8 1/2"  
C. G. = x = 1 1/16", y = 1 1/4" \*  
ID = 2C58  
Vendor = Rockwell  
Drawing C-61462 (Not Available)
- Valve data estimated from Rockwell Drawing ACD-31605533

- b) Valve CV-304  
Weight = 475#  
Length (Body) = 10"  
C.G. = 22 5/8"  
ID = 2IA58R  
Vendor = BSB Safety  
Drawing 95215-20 (Not Available)
- Valve data estimated from Copes Vulcan Drawing D-189777

3) Line No. 5011-3"-2501R

- a) Valve - PCV-430H  
Weight = 500#  
Length (Body) = 16 3/4"  
C. G. = 20"  
ID = 3RA58RGA  
Vendor = BSB Safety  
Drawing (Not Available)
- Valve data estimated from the following two Copes-Vulcan Drawings D-166035 and D-166833.

4) Line No. 5025-3" - 2501R

- a) Valve - PCV-430C  
Weight = 500#  
Length (Body) - 16 3/4"  
C.G. = 20"  
ID = 3RA58RGA  
Vendor = BSB Safety  
Drawing (Not Available)
- Valve data estimated from the following two Copes-Vulcan Drawings D-166035 and D-166833.

\*x = Distance from center of valve body to CG location, measured along the axis of the valve body in the direction of flow.

y = Distance from the centerline of the valve body to CG location, measured perpendicular to the axis of the valve body.

ACD-3405533

**CLASS 1500**  
FORGED CHROMIUM-NICKEL, AUSTENITIC STEEL, P. 308  
2500 P.S.I. AT 1000°F  
2240 P.S.I. AT 800°F

**CLASS 1500**  
FORGED CHROMIUM-NICKEL, AUSTENITIC STEEL, P. 312  
2500 P.S.I. AT 1000°F  
2240 P.S.I. AT 800°F

| FIG. | SIZES | ENDS    | ENGLISH DIMENSIONS     | METRIC DIMENSIONS |
|------|-------|---------|------------------------|-------------------|
| 3676 | 2"    | SOCKET  | A - END TO END         | 8.50              |
|      |       |         | AA - END HUB DIAMETER  | 3.50              |
| 3676 | 2"    | WELDING | AB - CENTER OF SOCKET  | 8.22              |
|      |       |         | AC - CENTER TO END     | 5.44              |
| 3676 | 2"    | WELDING | A - END TO END         | 2.00              |
|      |       |         | A - SOCKET DIAMETER    | 1.12              |
| 3676 | 2"    | WELDING | A - SOCKET DIAMETER    | 2.75              |
|      |       |         | CF - FLOW CORRECTIVE B | 3.12              |
| 3676 | 2"    | WELDING | E - REPAIR CLEARANCE   | 3.50              |
|      |       |         | E - FLOW CORRECTIVE B  | 5.00              |

WEIGHT, KILOGRAMS (10<sup>3</sup>)

| FIG. | SIZES | ENDS    | ENGLISH DIMENSIONS    | METRIC DIMENSIONS |
|------|-------|---------|-----------------------|-------------------|
| 3676 | 2"    | SOCKET  | A - END TO END        | 210               |
|      |       |         | AA - END HUB DIAMETER | 89                |
| 3676 | 2"    | WELDING | AB - CENTER OF SOCKET | 138               |
|      |       |         | AC - CENTER TO END    | 10                |
| 3676 | 2"    | WELDING | A - END TO END        | 210               |
|      |       |         | A - SOCKET DIAMETER   | 138               |
| 3676 | 2"    | WELDING | E - REPAIR CLEARANCE  | 76                |
|      |       |         | E - FLOW CORRECTIVE B | 84                |


**CLASS 1500**  
FORGED CHROMIUM-NICKEL, AUSTENITIC STEEL, P. 312  
2500 P.S.I. AT 1000°F  
2240 P.S.I. AT 800°F

**CLASS 1500**  
FORGED CHROMIUM-NICKEL, AUSTENITIC STEEL, P. 312  
2500 P.S.I. AT 1000°F  
2240 P.S.I. AT 800°F

**CLASS 1500**  
FORGED CHROMIUM-NICKEL, AUSTENITIC STEEL, P. 312  
2500 P.S.I. AT 1000°F  
2240 P.S.I. AT 800°F

**CLASS 1500**  
FORGED CHROMIUM-NICKEL, AUSTENITIC STEEL, P. 312  
2500 P.S.I. AT 1000°F  
2240 P.S.I. AT 800°F

2408 P.S.I. AT 800°F  
SERIAL NO. 2408  
LOT NO. 2408  
2 YEAR WARRANTY

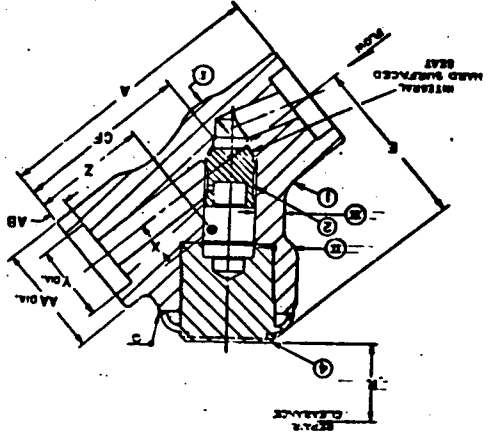

FORGED STEEL CHECK UNITS  
ROCKWELL EDWARD  
Flow Control Division  
ROCKWELL INTERNATIONAL








20278A

**LIST OF MATERIALS**  
QUANTITIES ARE FOR ONE VALVE  
WHEN A RM OR LAVE SPEC ARE INDICATED THE LATEST REVISION APPLIES  
RMC NO. MATERIAL SPECIFICATIONS  
REQD. NO. SPECIFICATIONS

**NOTE:**  
DIMENSIONS SHOWN ARE NOMINAL  
PROVIDED FOR GENERAL INFORMATION  
AND AS SUCH ARE SHOWN WITHOUT  
TOLERANCE.  
DIMENSIONS IN INCHES & MM  
(VALUES) MEETS ALL APPLICABLE  
REQUIREMENTS OF A.S.M.E.  
CLASS B.  
8-BVAL CODE, SECTION II.

MINIMUM CODE REQUIREMENTS  
FOR WELDING TEMPLATES

FC 11  
724

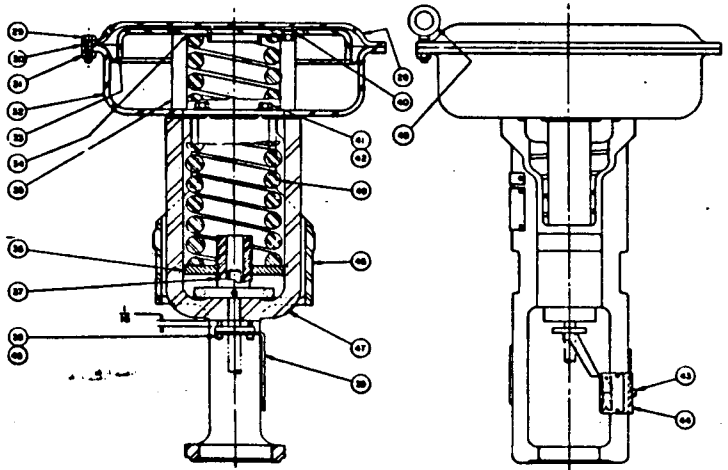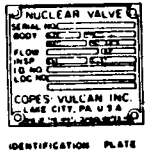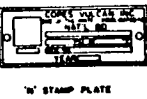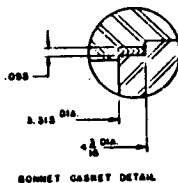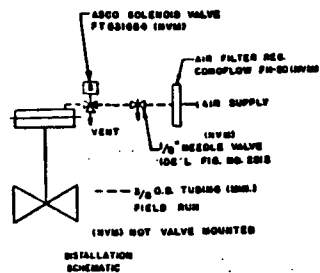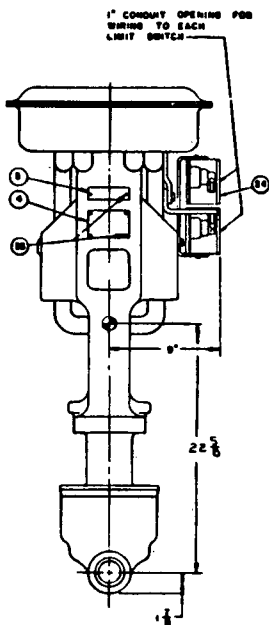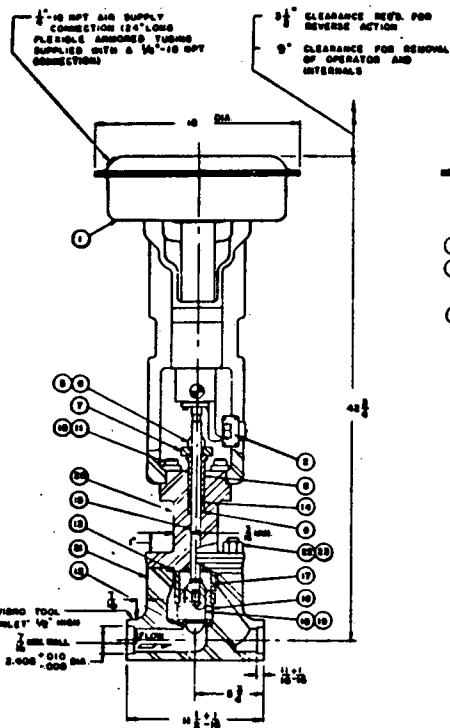

LIST OF MATERIALS

| ITEM NO. | QTY | PART NO. | DESCRIPTION      | MAT'L | REF. DESIG.    | REMARKS |
|----------|-----|----------|------------------|-------|----------------|---------|
| 1        | 1   | 131600   | OPERATOR CONTROL | STEEL | ASME B31.1     |         |
| 2        | 1   | 131601   | INDICATOR ARM    | STEEL | COMPL. 1/2\"/> |         |

- NOTES:
- FOR MINIMUM Q. OF 50 - SET VALUE AT 1" INCHES.
  - MAXIMUM TEMPERATURE 500 °F.
  - AIR PRESSURE IN THE CHAMBER MUST NOT EXCEED 100 PSIG TO PREVENT COMPONENT DAMAGE.
  - STUB WASL. CRES. ASME SA-420, OR 300.
  - WET WASL. CRES. ASME SA-192/SA-308, B-C.
  - RECOMMENDED SPARE PARTS ARE MARKED WITH AN ASTERISK ON THE BILL OF MATERIALS.
  - REQUIRED AIR PRESSURE INPUT TO SHUT OFF BACKSEAT = 90 PSIG.
  - REQUIRED AIR PRESSURE INPUT TO SHUT OFF BACKSEAT = 90 PSIG.
  - MAXIMUM AIR TO OPERATE = 80 PSIG.
  - MINIMUM WALL THK (ANSI B7.1-1963)
  - ALL DIMENSIONS ARE IN INCHES AND ARE REFERENCE UNLESS OTHERWISE SPECIFIED BY TOLERANCE.
  - BONNET MATERIAL - CRES. ASME SA-192/SA-308, B-C.
  - BACKSEAT WASL. - STEELITE NO. 9.
  - ON REVERSE ACTING UNITS, DIAPHRAGM PLATE (ITEM 20) MUST BE ATTACHED TO FRAME (ITEM 40) WITH SCREWS (ITEM 41) AND SPACERS (ITEM 39). ON DIRECT ACTING UNITS, DIAPHRAGM PLATE IS ATTACHED TO YOKE (ITEM 42) BY THE SAME METHOD.
  - WHEN ASSEMBLING ITEMS 39 AND 37 USE GRAM COMPOLD WEA. CH PART NO. 3045, OR THREADED.
  - TIGHTEN SCREWS, ITEM 40 TO 20 LB. FT. OF TORQUE.
  - SEE BOLTS TO BE 100" APART.

| NO. | DATE    | REVISIONS          | BY  | CHK | NO. | DATE | REVISIONS | BY | CHK | NO. | DATE | REVISIONS | BY | CHK |
|-----|---------|--------------------|-----|-----|-----|------|-----------|----|-----|-----|------|-----------|----|-----|
| 1   | 10-2-64 | DESIGN             | ... | ... |     |      |           |    |     |     |      |           |    |     |
| 2   | 10-2-64 | REVISED TO 1/2\"/> |     |     |     |      |           |    |     |     |      |           |    |     |

MICROFILMED FROM COMPANIES ORIGINAL

VALVE IDENT 2-157886  
 DWT BY 342 LBB 2-10-78  
 OPER. MODE REVERSE ACTING  
 COPE'S VULCAN, INC.  
 MODEL D-100-160 OPER.  
 2"-1500 LB ASME STD.  
 VALVE ASSEMBLY  
 ASME CODE CLASS-2  
 COPE'S VULCAN, INC.  
 LAWRENCE, MISSOURI  
 10-2-64





ATTACHMENT "E"

THERMAL DISPLACEMENTS AT LOOP CONNECTIONS

1 SHEET

EQUIPMENT DRAWINGS

1300 Cu. Ft. Pressurizer  
Drawing No. 790D654

Regenerative Heat Exchanger  
Drawing No. B-1-12240-6

THERMAL DISPLACEMENTS AT LOOP CONNECTIONS

1) Line No. 2081 - 2" - 2501R Attachment to Loop A Line 5010-27 1/2"-2501R.

Reference: Isometric 334482-3

Displacement considered (inches and radians)

|              |              |               |
|--------------|--------------|---------------|
| x = .0177    | y = -.0615   | z = 1.0154    |
| Rx = .001029 | Ry = .000175 | Rz = -.001076 |

2) Line No. 5011-3" - 2501R Attachment to Loop A Line 5010-27 1/2"-2501R.

Reference: Isometric 334595-2

Displacement considered (inches and radians)

|              |              |               |
|--------------|--------------|---------------|
| x = .0345    | y = -.0696   | z = 1.0863    |
| Rx = .001029 | Ry = .000175 | Rz = -.001076 |

3) Line No. 5025-3"-2501R Attachment to Loop B Line 5017-27.5"-2501R

Reference: Isometric 334597-2


Displacement considered (inches and radians)

|              |              |              |
|--------------|--------------|--------------|
| x = -.860    | y = -.0582   | z = -.484    |
| Rx = .000417 | Ry = .000175 | Rz = .001429 |





DIMENSIONS & DATA  
**CERTIFIED FOR**  
 CUST. ORDER 54-P-41432-B  
 OUR ORDER 400-64-1570  
 BY Rm DATE 6-17-65  
**BASCO, INC.**

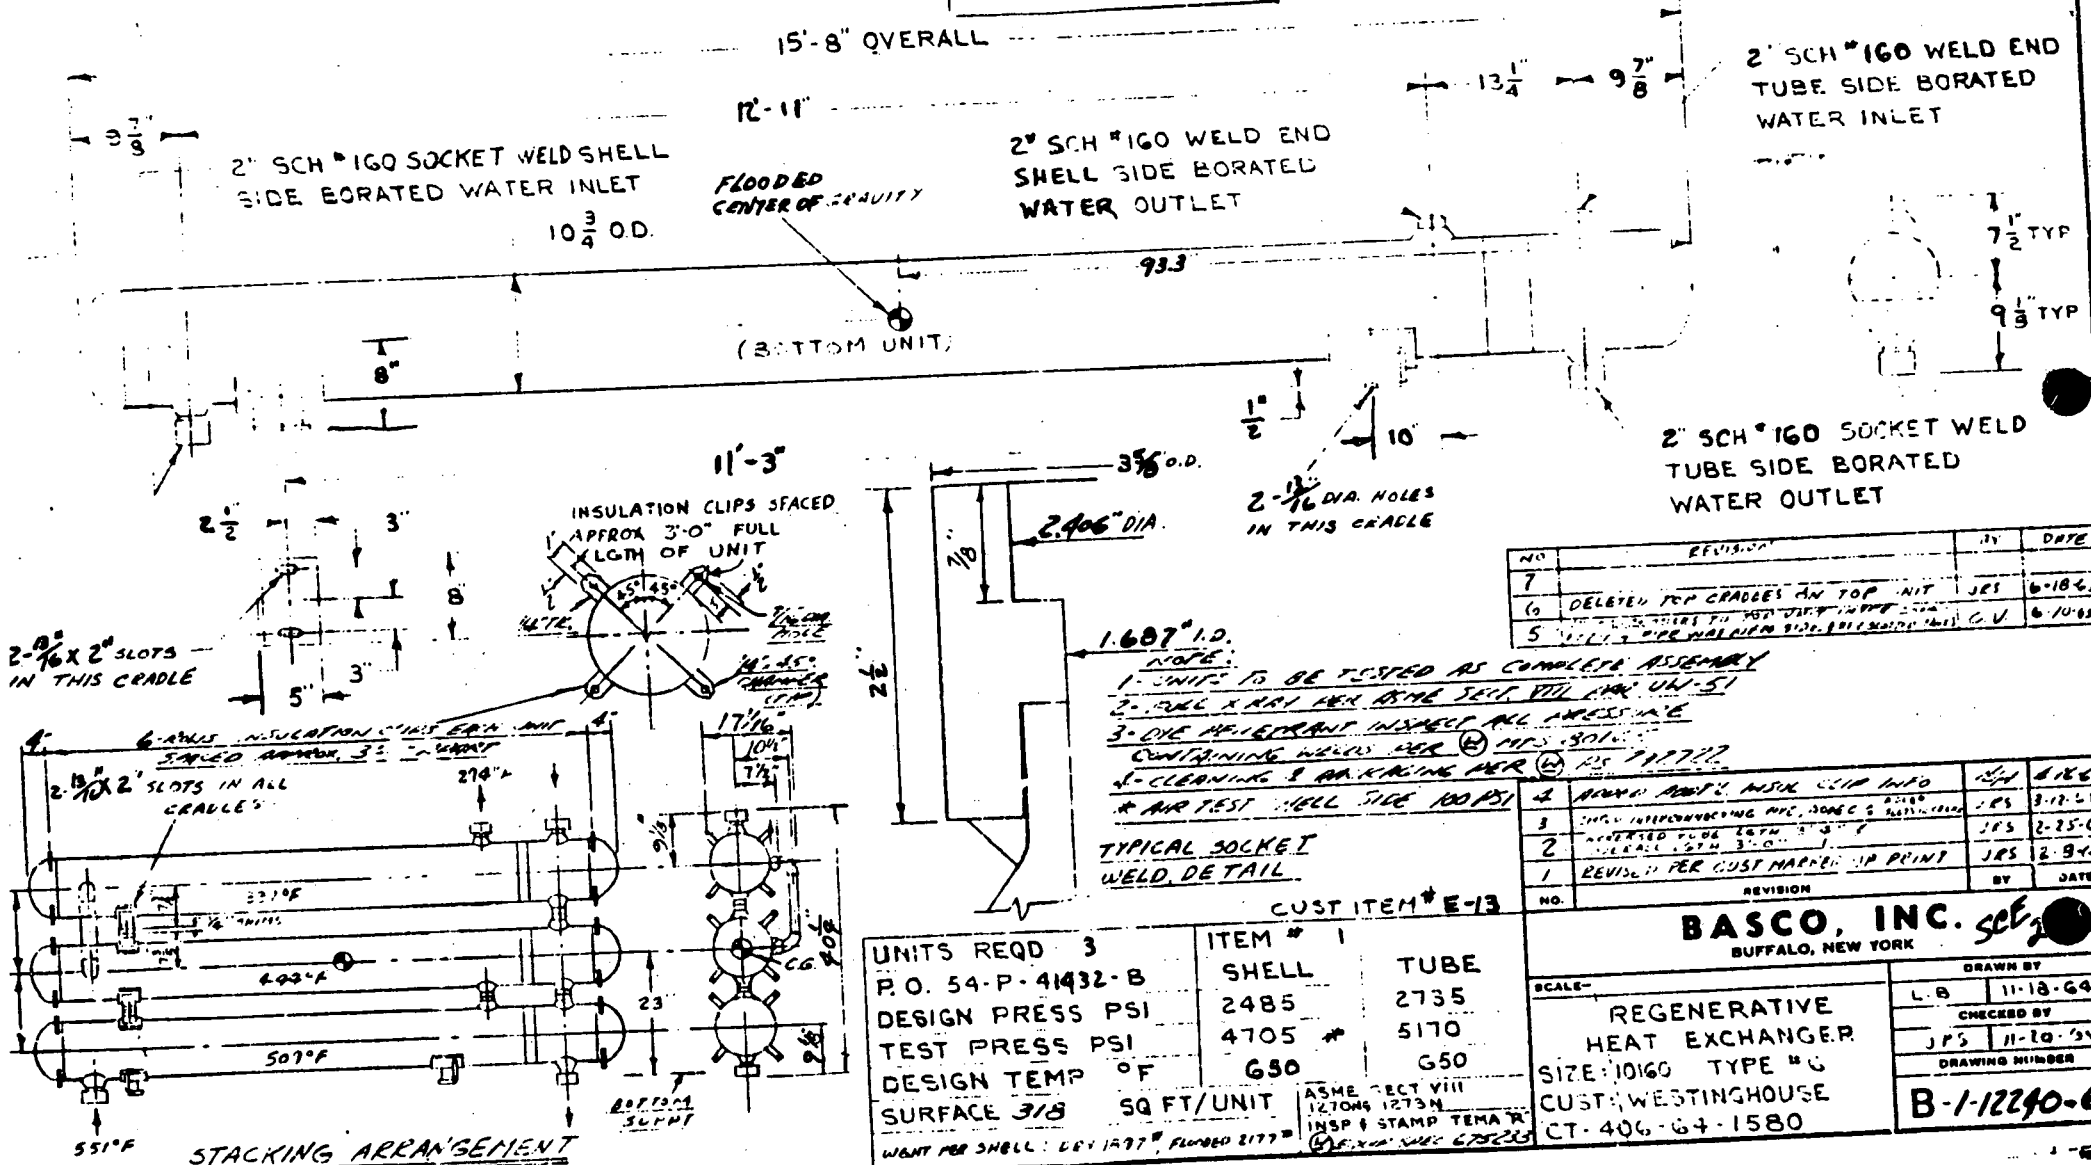

| NO. | REVISION                                   | BY  | DATE    |
|-----|--|-----|---------|
| 7   |  |     |         |
| 6   | DELETED TOP CRADLES ON TOP UNIT            | JRS | 6-18-64 |
| 5   | ADDED HOLES TO 2-1/16 DIA. HOLES IN CRADLE | JRS | 6-10-65 |

- NOTE:**
- UNITS TO BE TESTED AS COMPLETE ASSEMBLY
  - FULL X-RAY PER ASME SECT VIII AND UN-51
  - DYE PENETRANT INSPECT ALL WELDS
  - CLEANING & MARKING PER ASME SECT VIII
  - AIR TEST SHELL SIDE 100 PSI

TYPICAL SOCKET WELD DETAIL

| NO. | REVISION                                   | BY  | DATE    |
|-----|--|-----|---------|
| 3   | ADDED HOLES TO 2-1/16 DIA. HOLES IN CRADLE | JRS | 8-17-64 |
| 2   | ADDED HOLES TO 2-1/16 DIA. HOLES IN CRADLE | JRS | 2-25-64 |
| 1   | REVISED PER CUSTOMER PRINT                 | JRS | 2-9-65  |

**BASCO, INC.**  
 BUFFALO, NEW YORK

|               |                        |                   |              |
|---------------|------------------------|-------------------|--------------|
| UNITS REQD    | 3                      | ITEM #            | 1            |
| P.O.          | 54-P-41432-B           | SHELL             | 2485         |
| DESIGN PRESS  | PSI                    | TUBE              | 2735         |
| TEST PRESS    | PSI                    |                   | 5170         |
| DESIGN TEMP   | °F                     |                   | G50          |
| SURFACE       | 3/8 SQ FT/UNIT         | ASME SECT VIII    | 12TONG 1273N |
| WGT PER SHELL | LET 1277, FLOODED 2177 | INSP & STAMP TEMA | 675223       |

|                             |                |             |          |
|-----------------------------|----------------|-------------|----------|
| SCALE                       | DRAWN BY       | L.B         | 11-18-64 |
| REGENERATIVE HEAT EXCHANGER | CHECKED BY     | JRS         | 11-10-64 |
| SIZE 10160 TYPE #G          | DRAWING NUMBER | B-1-12240-6 |          |
| CUSTOMER WESTINGHOUSE       |                |             |          |
| CT-400-64-1580              |                |             |          |