


1 2 3 4 5 6 7 8 9 10 11 12

A
B
C
D
E
F
G
H

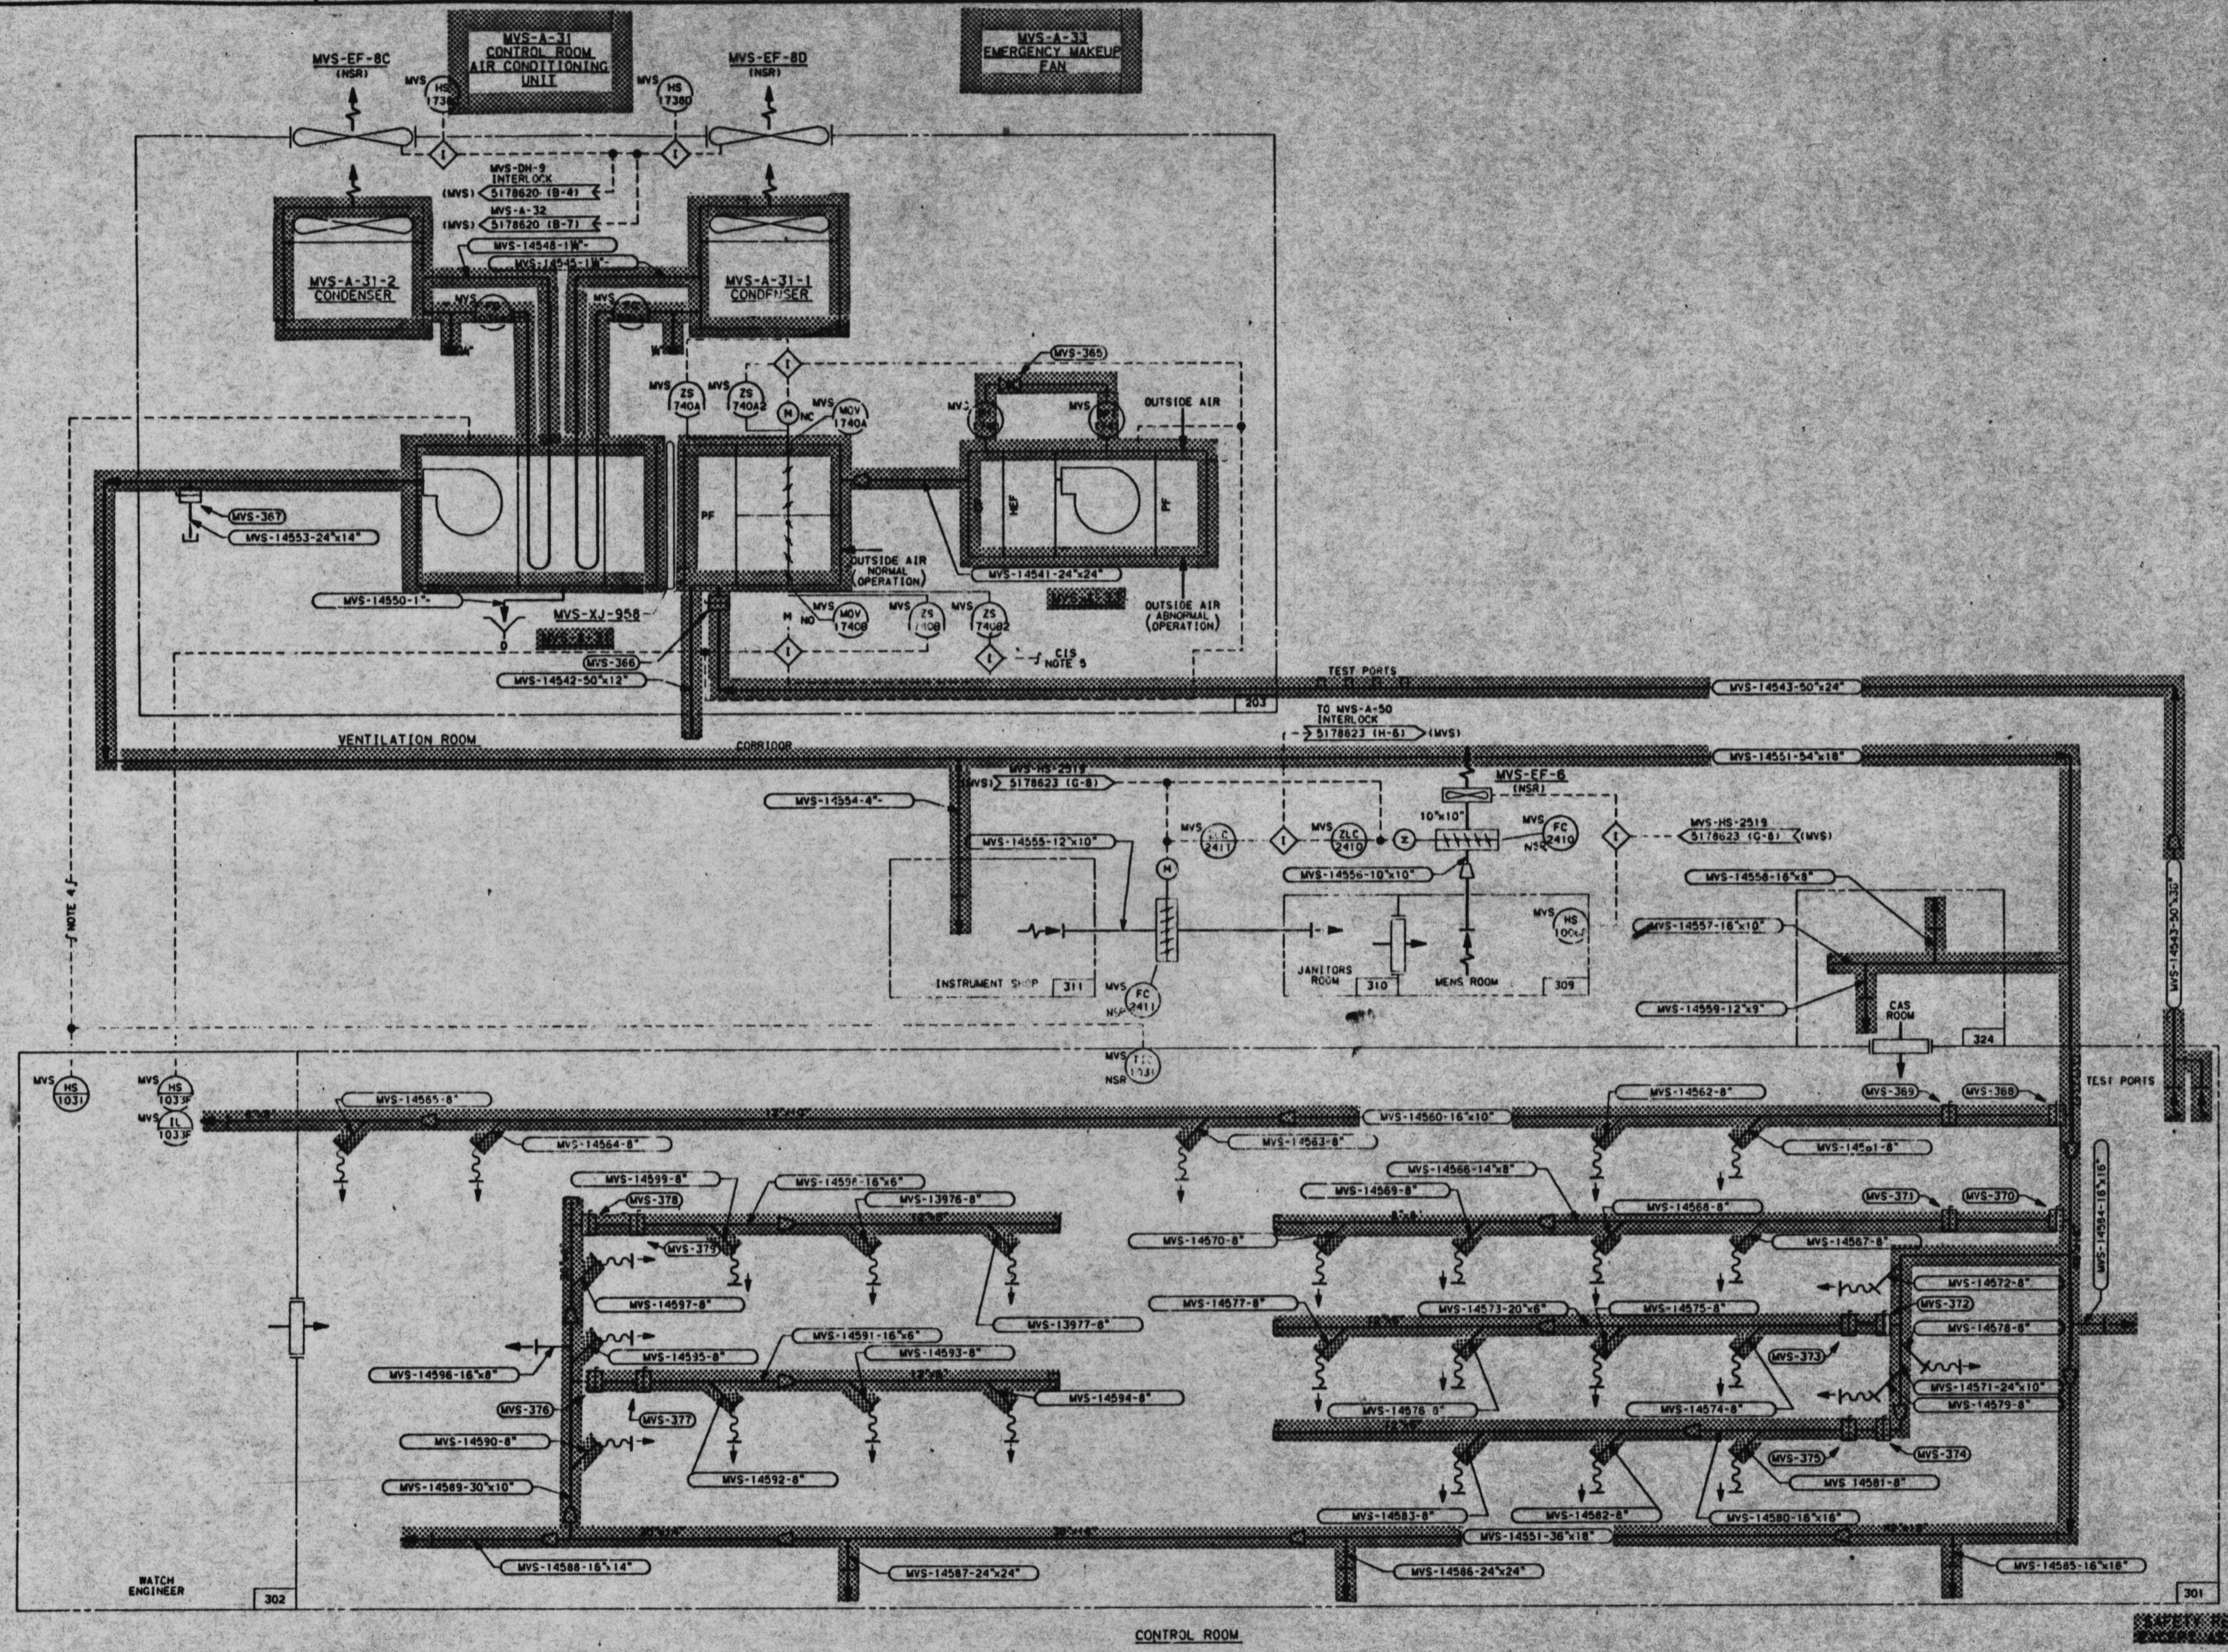

TI
APERTURE
CARD

CHECK GLH 8-21-85
ECM 5-12-86

- NOTES:
1. SEE DWG 5178620 FOR SH 1
 2. SEE DWG 5178621 FOR SH 2
 3. SEE DWG 5178623 FOR SH 4
 4. SEE DWG 5148927 FOR CONTROL DETAILS
 5. SEE DWG N1544 SH 15 FOR CONTROL DETAILS
 6. THIS DRAWING SUPERSEDES DRAWINGS 568782 & 5159856 AND ALL CCN'S WHICH PERTAIN TO THEM

NO.	REVISIONS	M.	DATE	P.E.	GAE	SUPY	APPROVED	ENGR	CK'D	MADE	J.O.	NO.	REVISIONS	N.	DATE	P.E.	GAE	SUPY	APPROVED	ENGR	CK'D	MADE	J.O.	
5178000	P & I DIAGRAM LEGEND SH 1																							
5178001	P & I DIAGRAM LEGEND SH 2																							
5178002	P & I DIAGRAM LEGEND SH 3																							
N1544	ELEM DIAGRAM-FAN A-33 SH 15												2	AS BUILT-INCORP CC#1 & #2										
455378	ELEM DIAGRAM-FAN EF-8C & EF-8D												1	AS BUILT-INCORP DCN #3										
													0	ISSUED AS BUILT										

WP 32-297 MVS

LOCATION: SAN ONO RE NUCLEAR GEN. STA. UNIT 1

SHEET NO. M

P & I DIAGRAM
MISCELLANEOUS
VENTILATION SYS SH 3

SCALE: NONE

OF SHTS.

EDISON
Rosemead Calif. 91768

8/84-982-CADW 10-83

5178622-2

MICROFILMED FROM
BEST AVAILABLE COPY

26X

36