

CONFIGURATION CHANGE

SHEET 1 of 2	EDM USE ONLY
	CC No. 4
	DATE 12-8-80

REQUESTED BY WESLEY TAM	<input type="checkbox"/> SPECIFICATION <input checked="" type="checkbox"/> DRAWING <input type="checkbox"/> PROCEDURE <input type="checkbox"/> INSTRUCTION	REVISION 3	CLASS SR
TITLE ELEM. DIAGRAM	NUMBER 64353	SUPPLIER	
CV MTR FEED CV-516 CV-526, CV-528 & CV-737B		<input type="checkbox"/> BECHTEL <input checked="" type="checkbox"/> EDISON	
DESCRIPTION OF CHANGE		I.O. NO. 7764	W.O. NO.

- CHANGE RELAY CONTACTS AND TERMINAL NUMBERS:
FROM TO

216VR1 (7-8)	A-38 (M3-T3) & A-38 (M4-T4)
216VR3 (5-6)	A-40 (M3-T3) & A-40 (M4-T4)
216VR2 (5-6)	A-39 (M3-T3) & A-39 (M4-T4)
216VR1 (5-6)	A-38 (M3-R3)
- ADD WORK PACKAGE NUMBER AND REMOVE THE TERM "NUCLEAR" FROM SAFETY RELATED CLASSIFICATION.

JUSTIFICATION
 REPLACE HFA RELAYS WITH QUALIFIED IE AGASTAT RELAYS FOR CONTAINMENT ISOLATION VALVES CV-516, CV-526 & CV-528.
 TMI-II W.P. #2.1.4

EVALUATION

OTHER AFFECTED DOCUMENTS / DRAWINGS:
 DOCUMENT CHANGE REQUIRED FOR:
 CONSTRUCTION AS BUILT OTHER

FIELD APPROVALS				DESIGN APPROVALS			
ENGR./DISCIPLINE	DATE	CONSTR. SUPER.	DATE	RESPONSIBLE ENGR.	DATE	INDEPENDENT REVIEW ENGR.	DATE
ENGR./DISCIPLINE	DATE	G.A. PER.	DATE	ARCHITECTURAL	DATE	MECHANICAL	DATE
ENGR./DISCIPLINE	DATE	STATION SUPT. POWER SUPPLY (RECORD REV.)	DATE	CIVIL-STRUCTURAL	DATE	NUCLEAR	DATE
				CONTROLS	DATE	QUALITY ASSURANCE	DATE
				ELECTRICAL	DATE	PROJECT ENGINEER	DATE
				CONSTRUCTION	DATE	CHECKER (AS APPROPRIATE)	DATE

Docket # 50-206
 Control # 8108200403
 Date 8-18-81 of Document
 REGULATORY DOCKET FILE


TERA
 APERTURE
 CARD

REGULATORY DOCKET FILE COPY

8108200426

16X

MICROFILMED FROM
 BEST AVAILABLE COPY

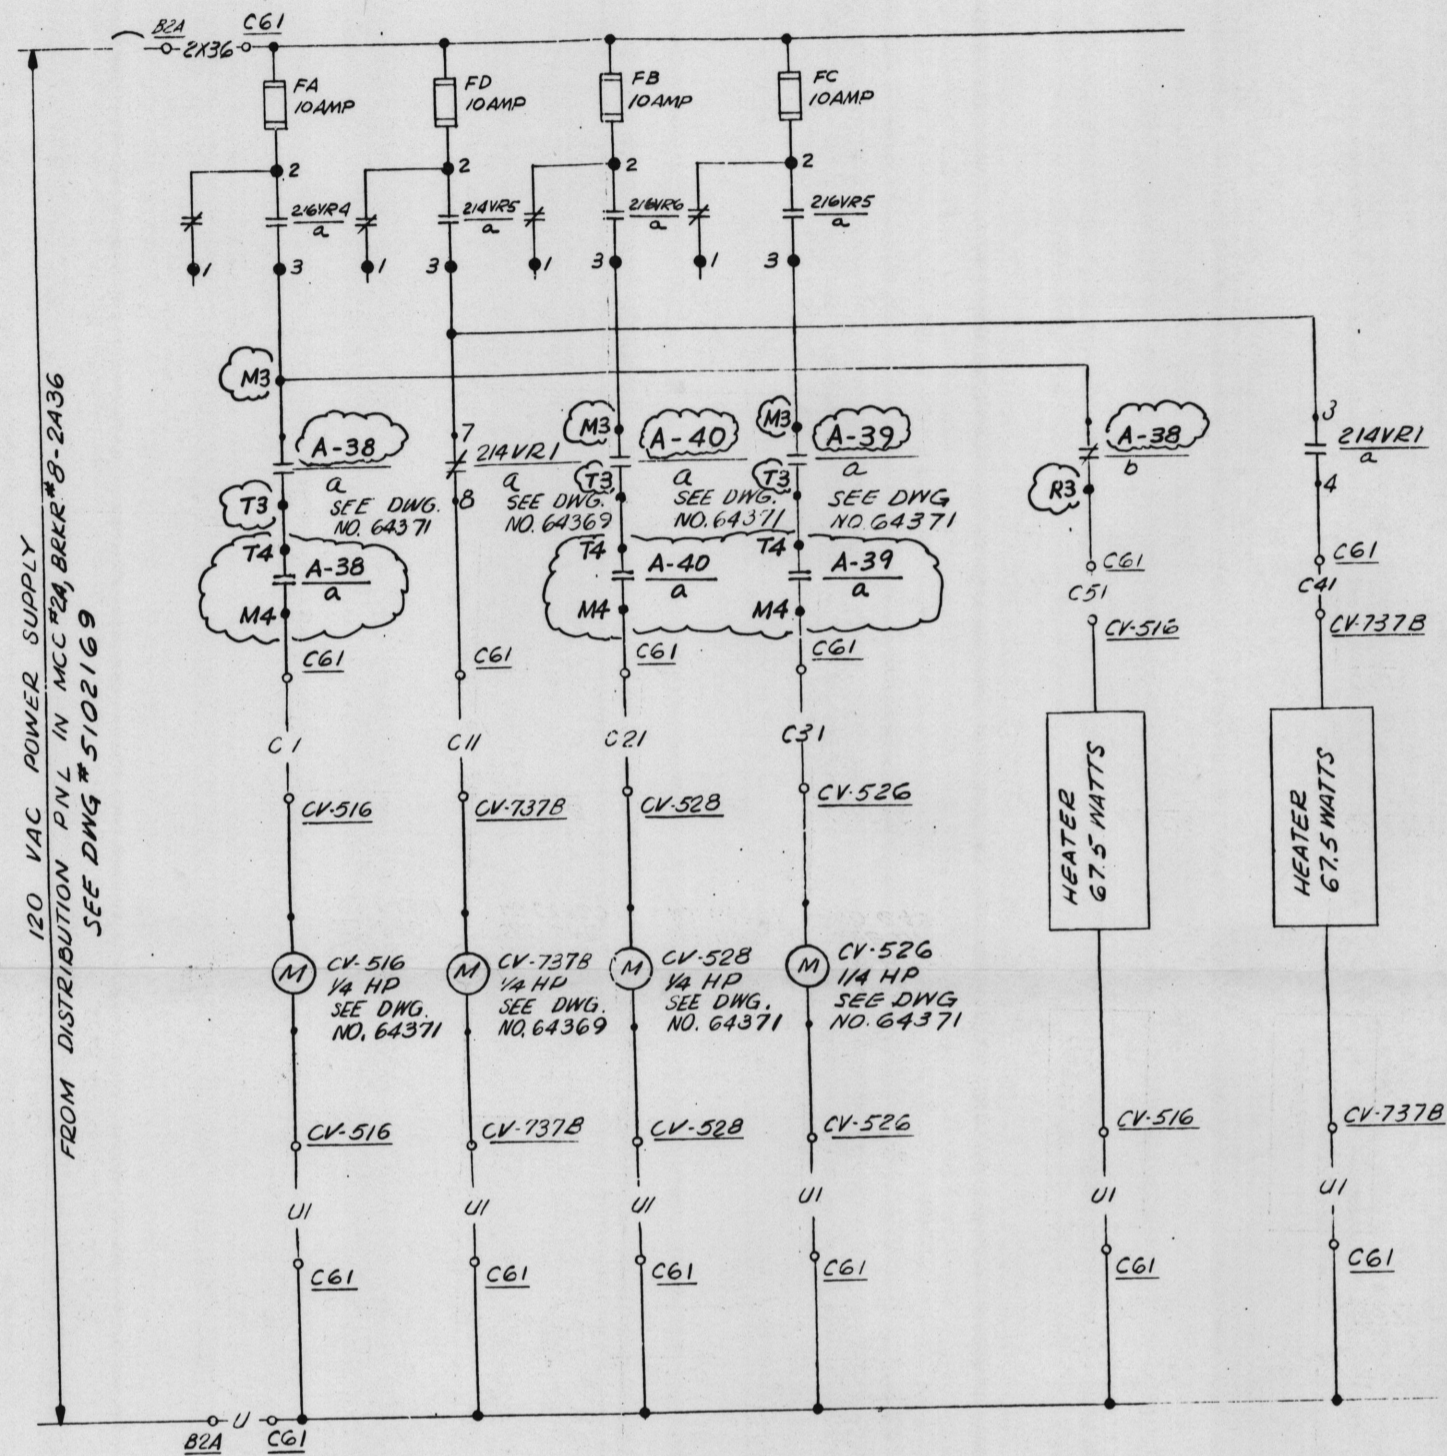

120 VAC POWER SUPPLY FROM DISTRIBUTION PNL IN MCC RM BRER # B-2A36 SEE DWG # 5102169

SCHEME NO. 16Y2A36

AFTER
 Drwg. # 64353-3
 CC # 4
 Sheet # 2 of 2

NOTE:
 1. FOR SCHEMATIC DIAGRAM ON CONTROL VALVES (CV) SEE DWG. 64351 FOR REFERENCE.

TMI - II PROJECT
 W. P. # 2.1.4

SAFETY RELATED


REACTOR AUXILIARIES
 N1542 SH. 95A
 UNIT 1

BECHTEL CORPORATION ENGINEERS & CONSTRUCTORS LOS ANGELES, CALIF.													I.O. NO. 7255 FILE	SAN ONOFRE NUCLEAR GENERATING STATION CV MTR SEED CV 516 CV 528, CV 526, CV 520
JOB NO. 11793-001	DATE	APPROVED											SOUTHERN CALIFORNIA EDISON COMPANY SCALE NONE LOS ANGELES, CALIF.	
NO.	SCE P.E.	DATE	DWG. NO.	REFERENCE	NO.	REVISIONS	DATE	DR.	CHK.	E.G.S.	CH.F.E.	P.E.	Q.A.E.	

24X
 MICROFILMED FROM
 BEST AVAILABLE COPY

Docket # 50-206
 Control # 8108200403
 Date 8-18-81 of Document
 REGULATORY DOCKET FILE
 REGULATORY DOCKET FILE COPY

Reject

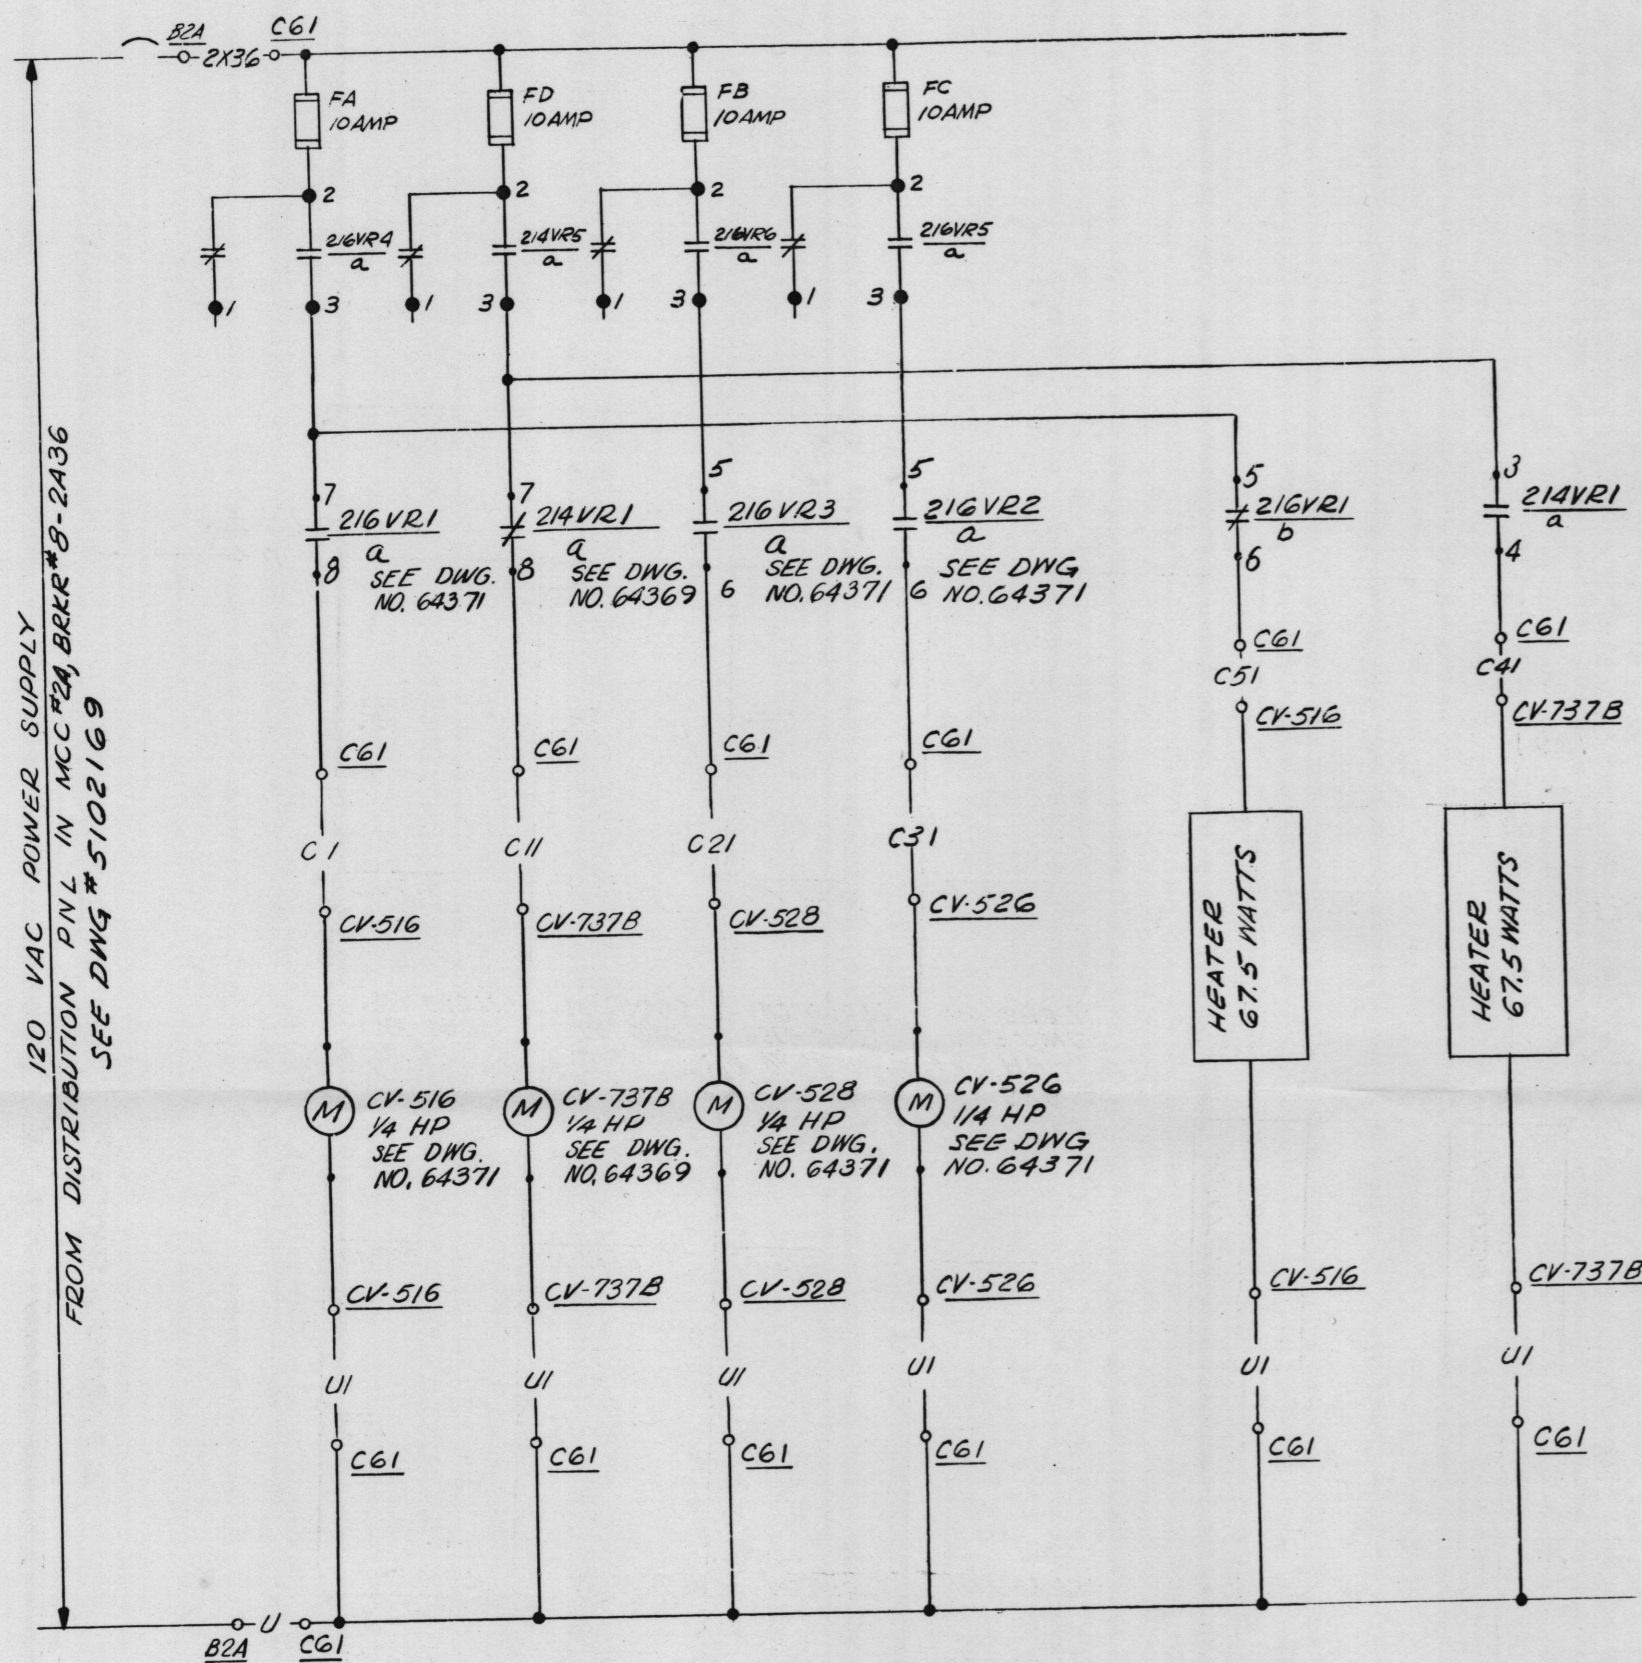

120 VAC POWER SUPPLY
FROM DISTRIBUTION PNL IN MCC #24, BRK#8-2436
SEE DWG #5102169

SCHEME NO. 16Y2A36

NOTE:
1. FOR SCHEMATIC DIAGRAM ON CONTROL VALVES (CV) SEE DWG. 64351 FOR REFERENCE.

NUCLEAR SAFETY RELATED

REGULATORY DOCKET FILE COPY

Docket # 50-206
Control # 8106200403
Date 8-18-81 of Document
REGULATORY DOCKET FILE

REACTOR AUXILIARIES
N1542 SH.95A
UNIT 1

BECHTEL CORPORATION
ENGINEERS & CONSTRUCTORS
LOS ANGELES, CALIF.

JOB NO. 11793
-001

NO.	DATE	APPROVED
1	10/13/76	[Signature]
2	10/13/76	[Signature]

NO. SCE P.E. DATE



DWG. NO. REFERENCE

NO.	REVISIONS	DATE	DR.	CHK.	E.G.S.	CH.F.E.	P.E.	Q.A.E.
3	REC. REV.-ADDED STA. FILE NO.	12-23-77	MK	DK		RZ	RT	
2	INCRP. DCN. 2 EFF. IMMEDIATELY	3-11-77	GR	SM				
1	INCORPORATED DCN SUB NO. 1	10-28-76	RG	HL	CFA			
0	ISSUED FOR CONSTRUCTION	7-13-76	ENR	JL	CFA			

10-NO. 7255 SAN ONOFRE NUCLEAR GENERATING STATION

ELEMENTARY DIAGRAM
CV MTR FEED - CV-516,
CV-526, CV-528 & CV-737B

SOUTHERN CALIFORNIA EDISON COMPANY
SCALE NONE LOS ANGELES, CALIF.

64353-3

MICROFILMED FROM
BEST AVAILABLE COPY

dupe
810 2270814

21X

