


D  
C  
B  
A

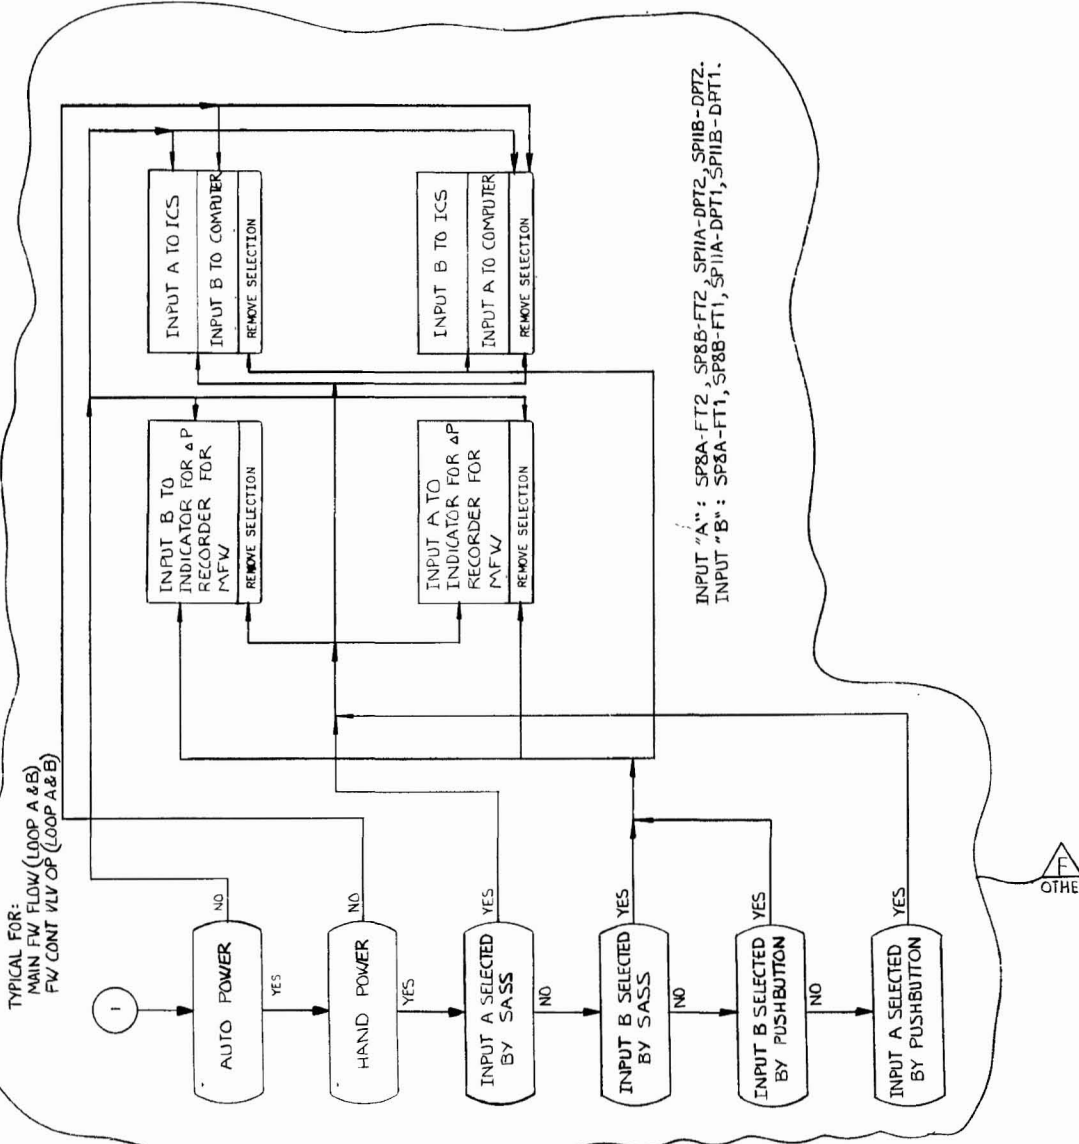

OTHER

THIS DRAWING IS FOR  
GENERAL INFORMATION  
AND REFERENCE ONLY  
and has not been returned to the manufacturer with  
GAI APPROVAL or COMMENTS  
SIGNED: P. K. G. ENGINEER  
DATE: 1/27/75 RK-12

REFERENCE Dwg.:  
D554567 ANV LOG LOGIC

RECEIVED  
U. E. & C. INC.  
JUN 20 1974  
ENGINEERING  
DEPARTMENT

44-92-33-485-0

|  |  |  |  |  |  |
|--|--|--|--|--|--|
| Gilbert/Cominwash, Inc.<br>REVISED TO INDICATE AS<br>BUILT CONDITIONS PER<br>GPU DCN-CO73818 &<br>G/C, Inc. EGN-1495.<br>INTERFACE: N/I  |  | G/C INC.<br>ADDED SAFETY CLASS &<br>REV TO IND AS BUILT<br>CONDOS PER GPU DCN-<br>CO32314 & GAT EGN-0723<br>INTERFACE: REPAIR<br>B.G. BY: <u>AK</u> M/85<br>REV: <u>AK</u> DATE: |  | NOT IMPORTANT TO SAFETY<br><b>AS-BUILT DRAWING</b>   |  |
| GPU Nuclear<br>ADMINISTRATIVE REV<br>REVISIONS<br>DATE:  |  | BABCOCK & WILCOX<br>DRAWING NUMBER<br>620-0005   |  | AUXILIARY SYSTEM<br>DIGITAL LOGIC<br>SECONDARY PLANT<br>CUSTOMER: METROPOLITAN EDISON CO.<br>PLANT: THREE MILE ISLAND NUCLEAR STATION<br>CONTRACTING ENG.: GILBERT ASSOCIATES, INC.<br>B.M.CO. JOB NO.: 150L CUST. ORDER NO.: A-56-22,024-0605 |  |
| THIS DRAWING IS THE PROPERTY OF BAILEY METER COMPANY.<br>NEITHER THE DRAWING, NOR REPRODUCTIONS OF IT, NOR<br>INFORMATION DERIVED FROM IT IS TO BE GIVEN TO OTHERS.<br>NO USE IS TO BE MADE OF IT WHICH IS OR MAY BE INJURIOUS<br>TO BAILEY METER COMPANY. |  | 22 02 302 00   |  | DATE: <u>6-25</u><br>DRAWING NO.:<br>REV: <u>F</u> DWN: FB<br>CHKD: <u>AK</u><br>APVD: <u>AK</u><br>ENGR:  |  |
| BAILEY METER COMPANY<br>WICKLIFFE, OHIO  |  | D556189  |  | DATE: <u>6-25</u><br>DRAWING NO.:<br>REV: <u>F</u> DWN: FB<br>CHKD: <u>AK</u><br>APVD: <u>AK</u><br>ENGR:  |  |