
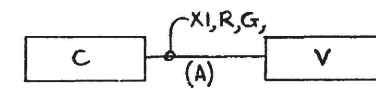


| | | | | | | | | | |
|---------|---|--|----------|-----|-------|------|-------|-------|-------|
| G-231-0 | 3 | "AS BUILT" FOR DER 89-0095, INC. DEN E-44B-314 | DATE | DP | CHK | SUPV | CHIEF | PROJ. | OWNER |
| | 1 | REVISED AS NOTED | 2/16/88 | LHS | MDEAL | CAL | | | |
| | 0 | ISSUED FOR CONSTRUCTION | 6-24-81 | PS | MCKES | CHS | | | |
| | | | 12/20/75 | SJH | MC | KS | CHC | | |

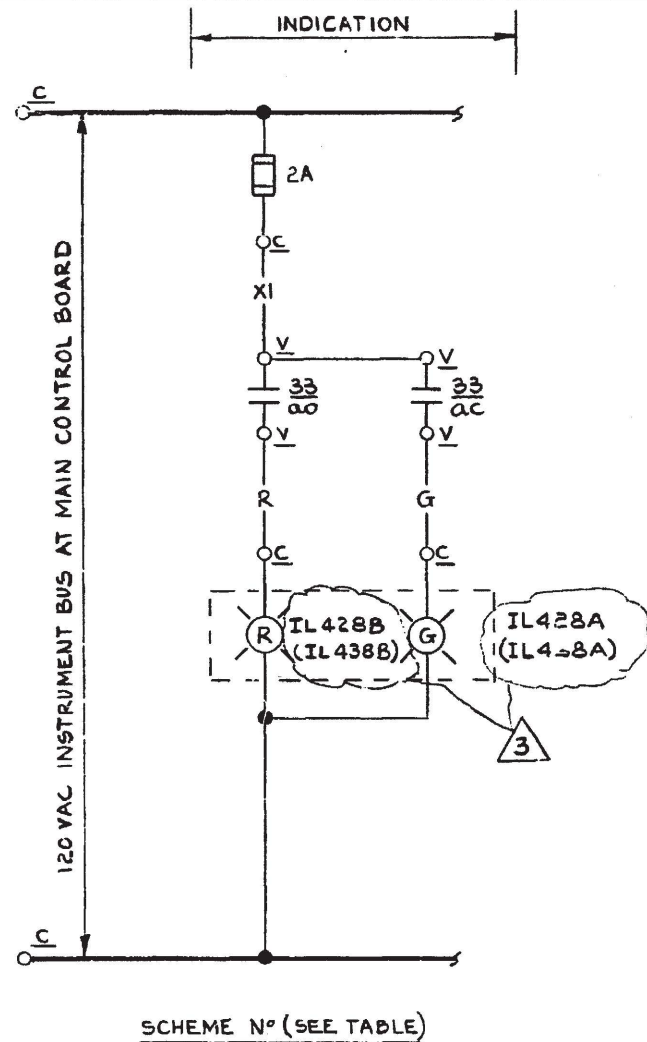

BLOCK DIAGRAM

NOTES

1. FOR GENERAL NOTES SEE DRAWING INDEX E:44B
2. FOR LIMIT SWITCH DESIGNATIONS SEE DRAWING E-30B, SH-2.

| SCHEME | SU N° | CHANNEL | WIRE PREFIX | EQUIPMENT | | DESCRIPTION |
|--------|-------|---------|-------------|-----------|-------|-----------------------------|
| | | | | C | V | |
| V42B | 045 | A | FRA | C5711 | V 428 | MFP I-1 RECIRCULATING VALVE |
| V43B | 045 | B | FRB | C5711 | V 438 | MFP I-2 RECIRCULATING VALVE |
| | | | | | | |

DAVIS-BESSE NUCLEAR POWER STATION
 THE TOLEDO EDISON COMPANY
 THE CLEVELAND ELECTRIC ILLUMINATING COMPANY

ELEMENTARY WIRING DIAGRAMS
 FEEDWATER SYSTEM
 MFP RECIRCULATING VALVES

| | | | |
|-----------------|---------|-------------|------|
| BECHTEL COMPANY | JOB NO. | DRAWING NO. | REV. |
| | 7749 | E-44B SH-7 | 3 |

I CERTIFY THAT THE IMAGE CONTAINED ON THIS FRAME WAS MADE IN THE NORMAL AND REGULAR COURSE OF BUSINESS, ON THE DATE STATED BELOW AND THAT IT IS AN ACCURATE REPRODUCTION OF THE RECORD(S) SUBMITTED TO NUCLEAR RECORDS MANAGEMENT.

223-90 OPERATOR Sharon Sutton 16X