
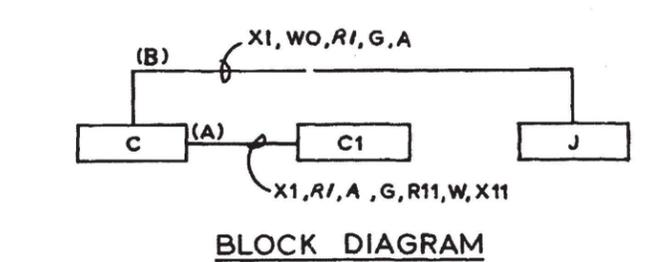


0-231-0	REV.	DESCRIPTION	DATE	DR	CHK	SUPV	CHIEF	PROJ	OWNER
		AS BUILT FOR FOR 81-075 SUPP 5 INC. DGN E-45B-75	1-26-87	JAD	JAD	JAD	JAD	JAD	JAD
		AS BUILT FOR 81-075 INC. FCN 36374 DGN E-45B-47	12-2-85	JAD	JAD	JAD	JAD	JAD	JAD

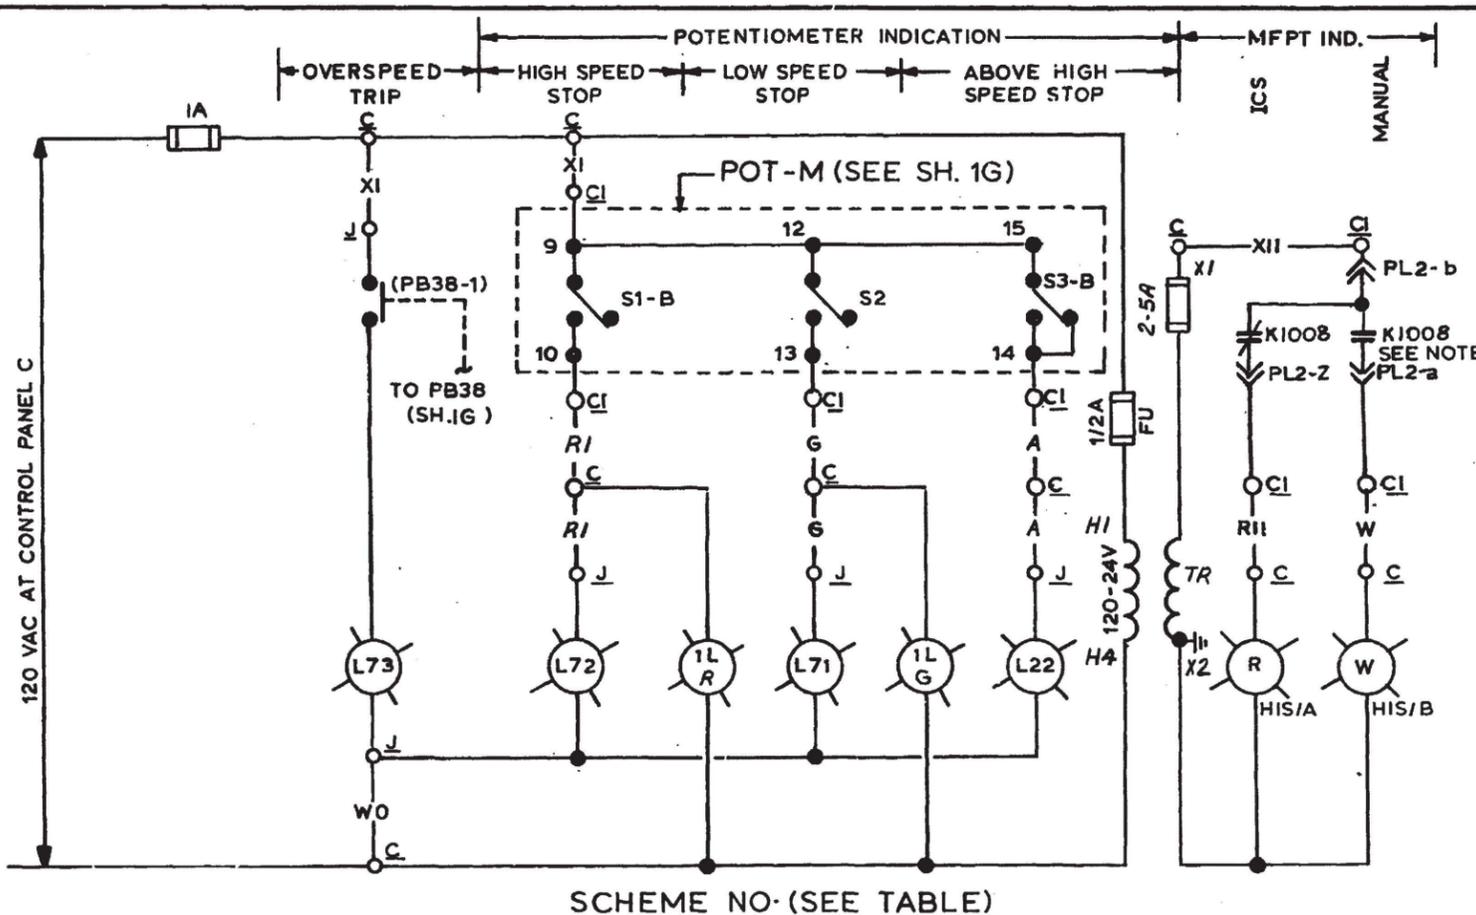

NOTES:
 1. FOR GENERAL NOTES SEE DWG. INDEX E-45B.
 2. FOR REFERENCE VENDOR DRAWINGS SEE GE WIRING DIAGRAM 134B541BE SH. 28 (BECHTEL DRAWING 7749-M-38-134) AND GE SCHEMATIC DIAGRAM 509E481EX SH. 1 (BECHTEL DRAWING 7749-M-38-178).
 3. RELAY (K1008) ENERGIZES IN MANUAL MODE.

SCHEME NO.	START UP NO.	CH. NO.	WIRE PREFIX AT MCB	EQUIPMENT			DESCRIPTION
				C	C1	J	
MFPT11	036	A	POTA	C5711	C5757D	JT2401	MFPT-1 CONTROL
MFPT21	036	B	POTB	C5711	C5757D	JT2301	MFPT-2 CONTROL

CONTROL TRANS.
TR
X-805
X-806

INDICATING LIGHTS					
GE NO.	INSTR. NO.	GE NO.	INSTR. NO.	HIS/A	HIS/B
ILR	IL805B	IL G	IL805A	HIS-805C1	HIS-805C2
ILR	IL806B	IL G	IL806A	HIS-806C1	HIS-806C2

DAVIS-BESSE NUCLEAR POWER STATION
 THE TOLEDO EDISON COMPANY
 THE CLEVELAND ELECTRIC ILLUMINATING COMPANY

ELEMENTARY WIRING DIAGRAM
 AFPT & MFPT CONTROL AUXILIARIES
 MFPT CONTROL

BECHTEL COMPANY	JOB NO.	DRAWING NO.	REV.
	7749	E-45B SH-1F	1

I CERTIFY THAT THE IMAGE CONTAINED ON THIS FRAME WAS MADE IN THE NORMAL AND REGULAR COURSE OF BUSINESS, ON THE DATE STATED BELOW AND THAT IT IS AN ACCURATE REPRODUCTION OF THE RECORD(S) SUBMITTED TO NUCLEAR RECORDS MANAGEMENT.
 DATE 1-26-87 OPERATOR Don M. McCloskey BX