


0-231-0	REV.	DESCRIPTION	DATE	DR	CHK	SUPV	CHIEF	PROJ	OWNER
4		AS-BUILT FOR MOD B7-1105, INC. DCN E-45B-125.	3/1/74	RAB	W/RE	W/RE	W/RE	W/RE	W/RE
5		INC. DCN E-45E-124 PER MOD 94-0014 SUPP'D	10/1/74	JOR	SBW	SBW	SBW	SBW	SBW
0		ISSUED FOR CONSTRUCTION	3/5/73	RS	LEW	LEW	LEW	LEW	LEW

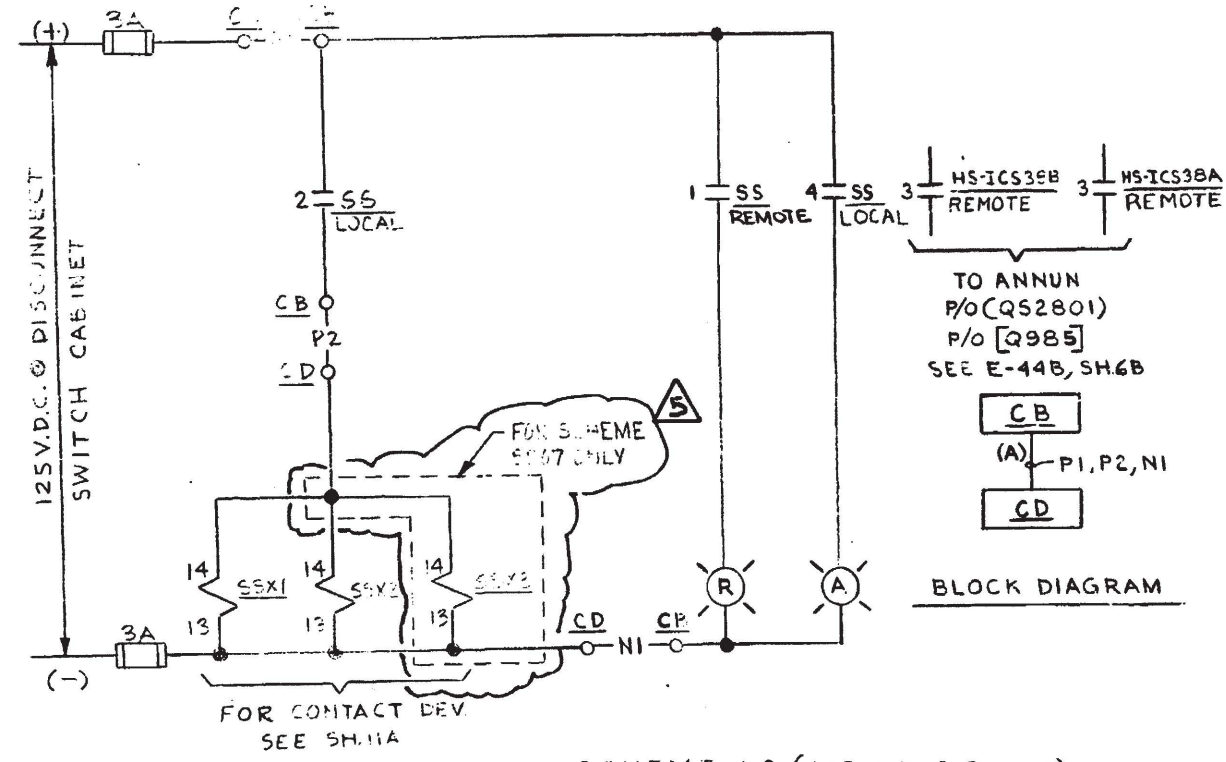

SCHEME NO. (SEE TABLE BELOW)

SCHEME NO.	START UP NO.	CHANNEL	SS	EQUIPMENT		DESCRIPTION
				CD	CB	
SD07	50	1	HS-1CS38B	CDE12A-1	C3630	AFPT 1 GOV. CTRL. SEL. CRKT.
SD08	50	2	HS-1CS38A	CDI2A-1	C3630	AFPT 2 GOV. CTRL. SEL. CRKT.

- NOTES:**
- FOR GEN. NOTES, SEE DWG INDEX E-45B
  - DELETED
  - FOR SS SWITCH DEVELOPMENT SEE E-30B SH.11, FIG. 4A

**DAVIS-BESSE NUCLEAR POWER STATION**  
 THE TOLEDO EDISON COMPANY  
 THE CLEVELAND ELECTRIC ILLUMINATING COMPANY

ELEMENTARY WIRING DIAGRAM  
 AFPT & MFPT CONTROL & AUXILIARIES  
 AFPT CONTROL

BECHTEL COMPANY	JOB NO.	DRAWING NO.	REV.
	7749	E-45B SH-11C	5

I CERTIFY THAT THE IMAGE CONTAINED ON THIS FRAME WAS MADE IN THE NORMAL AND REGULAR COURSE OF BUSINESS ON THE DATE STATED BELOW AND THAT IT IS AN ACCURATE REPRODUCTION OF THE RECORD(S) SUBMITTED TO NUCLEAR RECORDS MANAGEMENT.

DATE: 12-1-94 OPERATOR: *[Signature]* 16X