


G-231-0	2	REVISED AS NOTED					
	3	"AS BUILT" FOR FCR 85-0112, SUPP. 1, INC. DCN E-52B-265					
	0	ISSUED FOR CONSTRUCTION					
		DESCRIPTION					
	DATE	DR	CHK	SUPV	CHIEF	PROJ	OWNER
	1-21-70	RMS	CD	U	SM		
	12/23/67	GFB	MS	AS	TR	5	MS
	12/26/70	DMC	MS	ES	MS		

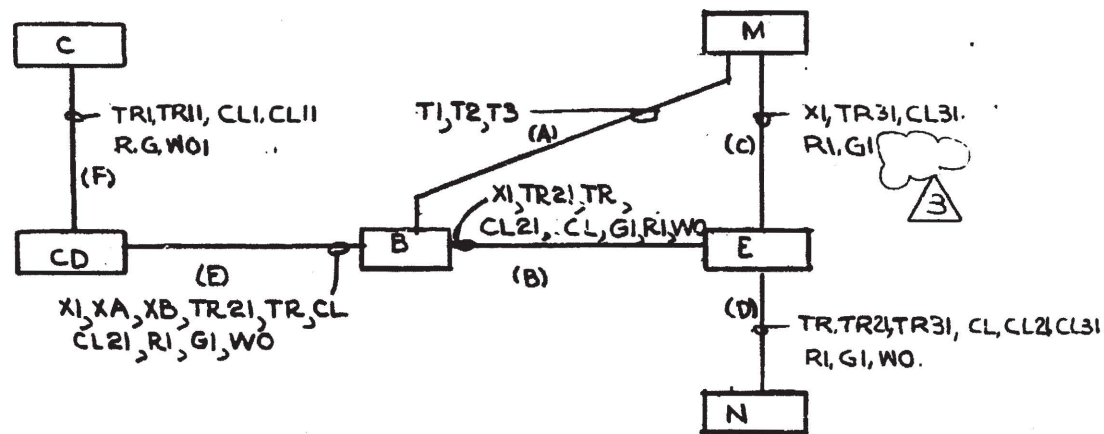

SCHEME NO	MCC	SU NO	CHANNEL	WIRE PREFIX	CS	EQUIPMENT NUMBERS						DESCRIPTION
						C	CD	B	M	E	N	
BF1125	F11A	49	2	S1B	H152736	C5705	CDF11A-2	BF1125	MV27360	EV27360	NV27360	PRZR SPRAY LINE ISO VLV

**DAVIS-BESSE NUCLEAR POWER STATION**  
 THE TOLEDO EDISON COMPANY  
 THE CLEVELAND ELECTRIC ILLUMINATING COMPANY

ELEMENTARY WIRING DIAGRAMS  
 REACTOR COOLING SYSTEM  
 PRZR SPRAY LINE ISO VLV

BECHTEL COMPANY	JOB NO.	DRAWING NO.	REV.
	<b>7749</b>	<b>E52B-SH-2B</b>	<b>3</b>