


G-231-0	2	REVISED AS NOTED					
	3	"AS BUILT" FOR FCR 85-0112, SUPP. 1, INC. DCN E-52B-265					
	0	ISSUED FOR CONSTRUCTION					
		DESCRIPTION					
	DATE	DR	CHK	SUPV	CHIEF	PROJ	OWNER
	1-21-76	RMS	CD	U	SM		
	12/13/82	GFB	MP	JIS	TR	5	ML
	12/16/74	D MC	ENS	ES	ML		

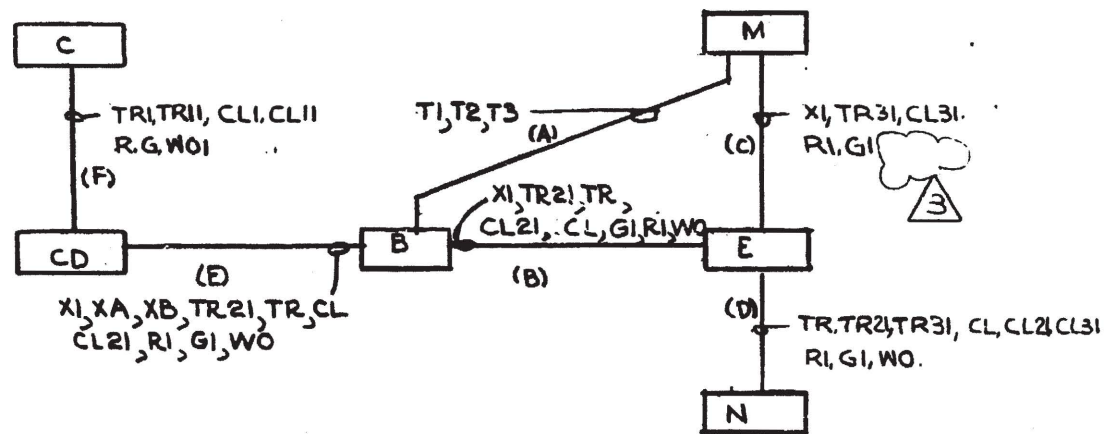

SCHEME NO	MCC	SU NO	CHANNEL	WIRE PREFIX	CS	EQUIPMENT NUMBERS						DESCRIPTION
						C	CD	B	M	E	N	
BF1125	F11A	49	2	S1B	H152736	C5705	CDF11A-2	BF1125	MV27360	EV27360	NV27360	PRZR SPRAY LINE ISO VLV

DAVIS-BESSE NUCLEAR POWER STATION
 THE TOLEDO EDISON COMPANY
 THE CLEVELAND ELECTRIC ILLUMINATING COMPANY

ELEMENTARY WIRING DIAGRAMS
 REACTOR COOLING SYSTEM
 PRZR SPRAY LINE ISO VLV

BECHTEL COMPANY	JOB NO.	DRAWING NO.	REV.
	7749	E52B-SH-2B	3