
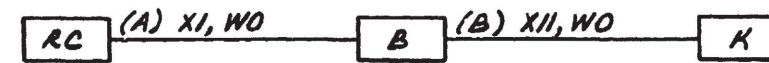


OWNER	-
OWNER	-
PROJ	11-17-80
CHIEF	DR
SUPV	DR
CHK	DR
DATE	11-17-80
DESCRIPTION	0 "AS BUILT" FOR FCR 77-22B, SUPPL. 1
REV.	

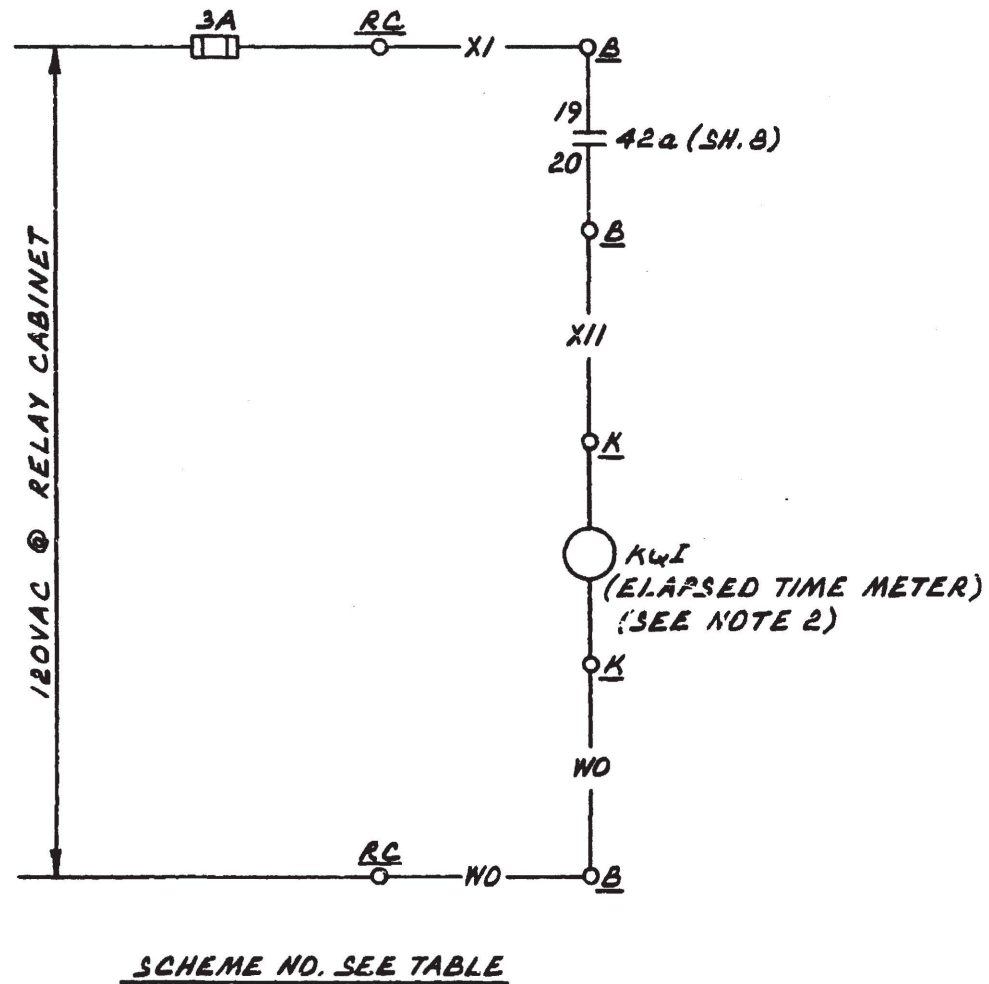

BLOCK DIAGRAM

NOTES

1. FOR GENERAL NOTES SEE DWG. INDEX E-58B.
2. ELAPSED TIME METER EAQLE SIGNAL BULLETIN 705 CAT #HK510A6 MOUNTED IN A SIZE ONE BOX.

SCHEME NO.	S.U. NO.	CHANNEL	EQUIPMENT			DESCRIPTION
			B	RC	K	
ETMO3	34	A	BE1219	RC4601	KQ10301	EMER. VENT. SYS. FAN 1-1 E.T. METER
ETMO4	34	B	BF1203	RC4602	KQ10302	EMER. VENT. SYS. FAN 1-2 E.T. METER

**DAVIS-BESSE NUCLEAR POWER STATION**

THE TOLEDO EDISON COMPANY  
THE CLEVELAND ELECTRIC ILLUMINATING COMPANY

ELEMENTARY WIRING DIAGRAM  
**CTMT VENTILATION SYSTEM**  
EVS FAN 1 & 2 ELAPSED TIME METER

BECHTEL COMPANY	JOB NO.	DRAWING NO.	REV.
	7749	E-58B SH.8A	0