
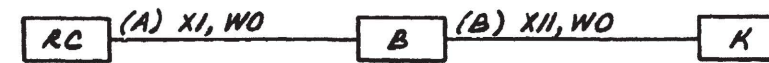


| | |
|-------------|---------------------------------------|
| OWNER | - |
| OWNER | - |
| PROJ | 11-17-66 |
| CHIEF | DR |
| SUPV | DR |
| CHK | DR |
| DATE | 11-17-66 |
| DESCRIPTION | 0 "AS BUILT" FOR FCR 77-22B, SUPPL. 1 |
| REV. | |

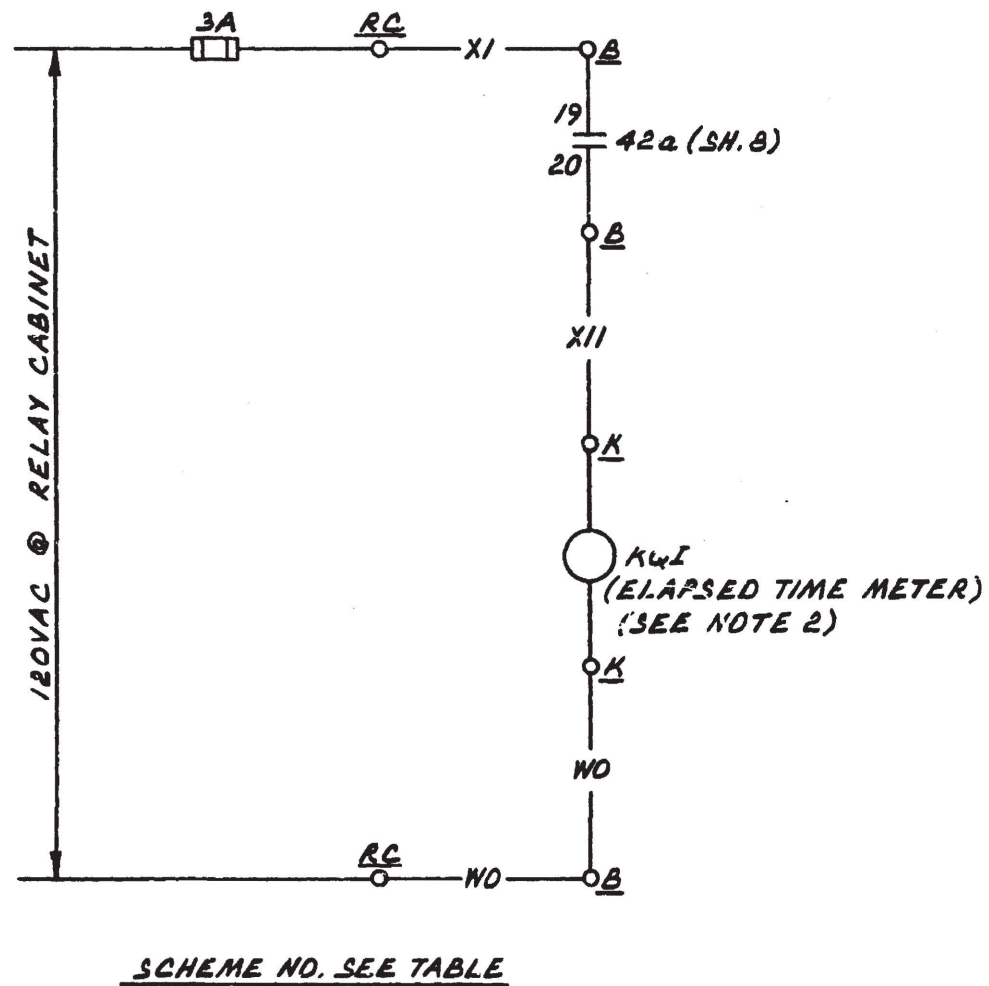

BLOCK DIAGRAM

NOTES

1. FOR GENERAL NOTES SEE DWG. INDEX E-58B.
2. ELAPSED TIME METER EAQLE SIGNAL BULLETIN 705 CAT #HK510A6 MOUNTED IN A SIZE ONE BOX.

| SCHEME NO. | S.U. NO. | CHANNEL | EQUIPMENT | | | DESCRIPTION |
|------------|----------|---------|-----------|--------|---------|-------------------------------------|
| | | | B | RC | K | |
| ETMO3 | 34 | A | BE1219 | RC4601 | KQ10301 | EMER. VENT. SYS. FAN 1-1 E.T. METER |
| ETMO4 | 34 | B | BF1203 | RC4602 | KQ10302 | EMER. VENT. SYS. FAN 1-2 E.T. METER |

DAVIS-BESSE NUCLEAR POWER STATION

THE TOLEDO EDISON COMPANY
THE CLEVELAND ELECTRIC ILLUMINATING COMPANY

ELEMENTARY WIRING DIAGRAM
CTMT VENTILATION SYSTEM
EVS FAN 1 & 2 ELAPSED TIME METER

| | | | |
|-----------------|---------|-------------|------|
| BECHTEL COMPANY | JOB NO. | DRAWING NO. | REV. |
| | 7749 | E-58B SH.8A | 0 |