
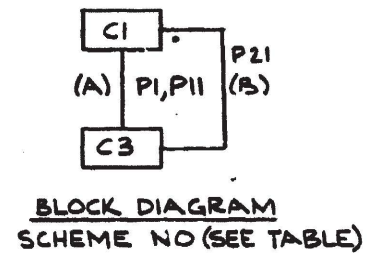


G-231-D	2	SRN 143E INCORPORATED IN REVI	7-28-74	CW	GA	SM/AM	STNS						
	3	AS-BUILT FOR 81-067, INC. DON 774 9-E-64B-49 PER AP4-3565K	11/15/74	CO	FP	DM							
	0	ISSUED FOR CONSTRUCTION	5/1/77	CW	DM	SM/AM							
	REV.	DESCRIPTION	DATE	DR	CHK	SUPV	CHIEF	PROJ	OWNER				

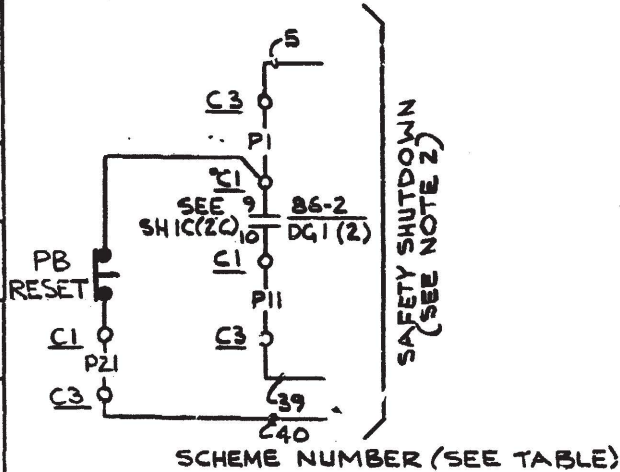

NOTES  
 1) FOR GENERAL NOTES & LOCATION DESIGNATIONS SEE DRWG INDEX E 64B.  
 2) FOR CONTINUATION OF <sup>86-2</sup> CRKT SEE BRUCE GM DWG NO B157FO2501 SH3 (BECHTEL FP 12501-M-180Q-14)

3

SCHEME NO.	START-UP NO	CHAN	EQUIPMENT		DESCRIPTION
			C1	C3	
GD110	024	1	C3615	C3621	EMER DG1-1 ENGINE SAFETY SHUTDOWN
GD210	024	2	C3616	C3622	EMER DG 1-2 ENGINE SAFETY SHUTDOWN

**DAVIS-BESSE NUCLEAR POWER STATION**  
 THE TOLEDO EDISON COMPANY  
 THE CLEVELAND ELECTRIC ILLUMINATING COMPANY  
 ELEMENTARY WIRING DIAGRAM  
 EMER DSL GENS  
 ENGINE SAFETY SHUTDOWN

BECHTEL COMPANY	JOB NO.	DRAWING NO.	REV.
	7749	E-64B SH.15	3

N15128

I certify that the image contained on this frame was made in the normal

