

REV.	DATE	DRWN	CHKD	APPD
24	030801	MAL	JHC	N/A
25	110202	MAL	JHC	N/A
26	042001	RLW	JHC	N/A
27	042001	RLW	JHC	N/A
28	090601	MAL	JHC	N/A
29	110402	MAL	JHC	N/A
30	111102	MAL	JHC	N/A
31	041905	MAL	JHC	N/A
32	010305	MAM	JHC	N/A
33	060707	MAM	JHC	N/A
34	111308	MAM	JHC	N/A
35	020909	MAM	JHC	N/A
36	060110	MAM	JHC	N/A
37	080311	MAM	JHC	N/A
38	110414	MAM	JHC	N/A
39	050110	MAM	JHC	N/A
40	020110	MAM	JHC	N/A

- NOTES:**
1. DELETED.
 2. DRILLED RESTRICTION $\frac{1}{8}$ " IN DIAMETER. POINT AT WHICH QUALITY GROUP CLASSIFICATION IS CHANGED FROM "A" TO "B". INSERVICE INSPECTION WILL BE PERFORMED ON CLASS "A" PIPE UP TO THIS ORFICE.
 3. SEE WESTINGHOUSE DRAWINGS 1145E04 SHT. 1, 2 & 3.
 4. DELETED.
 5. DELETED.
 6. PIPING CONTAINING 12 PER CENT BORIC ACID WILL HAVE TEES WITH A CLEANOUT TO PERMIT CLEANING OF SYSTEM AS REQUIRED.
 7. FOR P & ID LEGEND AND SYMBOLS SEE DRAWINGS M-220101 THRU M-220104.
 8. MINI FLOW ORFICE SUPPLIED BY SI PUMP VENDOR.
 9. HEAT TRACING NON-CLASS 1E.
 10. ISOLATION SWITCH PROVIDED IN THE CONTROL ROOM FOR POWER LOCKOUT OF VALVES 8802A, B AND 8835.
 11. SG-AP-6. PEAK RECORDING ACCELEROMETER, TO BE MOUNTED ON SURFACE OF HORIZONTAL PIPE SECTION.
 12. DELETED.
 13. DELETED.
 14. VALVE HANDWHEEL AND BREAKER LOCKED IN OPEN POSITION DURING NORMAL OPERATION.
 15. DELETED.
 16. EMV025 SENSES UPSTREAM PRESSURE AND PROVIDES BACKPRESSURE ON THE SI TEST HEADER AS DESIGNATED BY ENGINEERING.
 17. CAPPED SWAGELOK ADAPTER.

REV.	DATE	DRWN	CHKD	APPD
34	111308	MAM	JHC	N/A
35	020909	MAM	JHC	N/A
36	060110	MAM	JHC	N/A
37	080311	MAM	JHC	N/A
38	110414	MAM	JHC	N/A
39	050110	MAM	JHC	N/A
40	020110	MAM	JHC	N/A


AS-BUILT CLASS 1

**PIPING AND INSTRUMENTATION DIAGRAM
HIGH PRESSURE COOLANT
INJECTION SYSTEM**

FSAR FIGURE 6.3-1 SHEET 2

CALLAWAY ENERGY CENTER


UNION ELECTRIC COMPANY	REV. 38
------------------------	---------

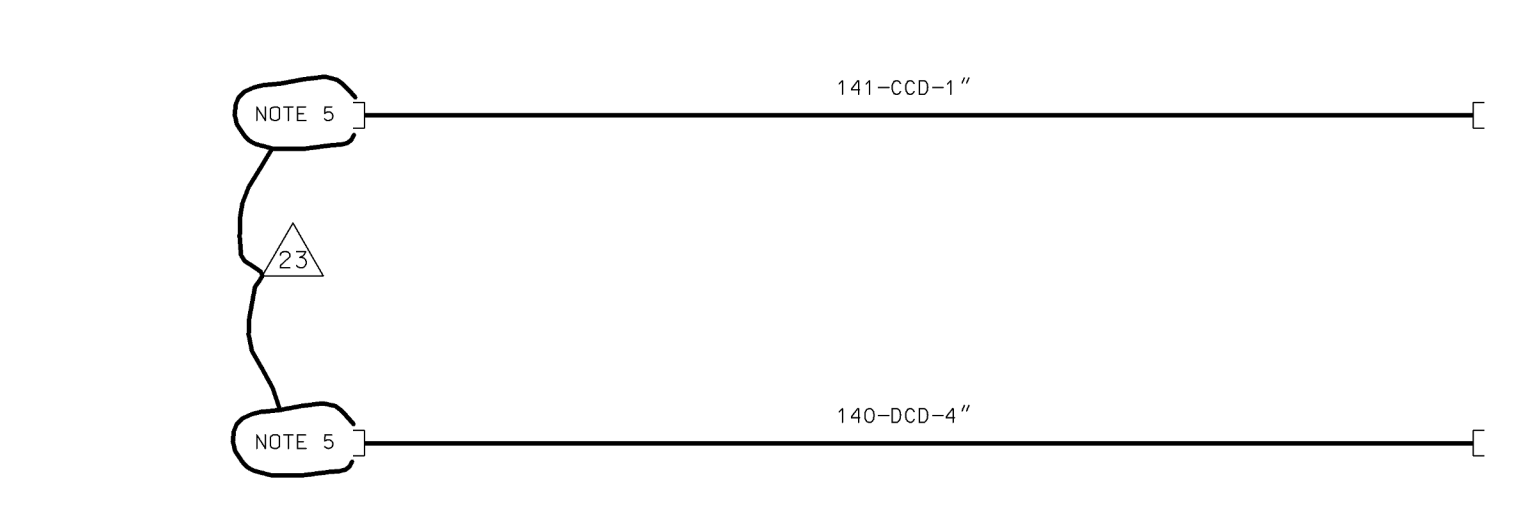


NOTES:

- FOR GENERAL NOTES & REFERENCES SEE DWG. M-22EM01.
- DELETED
- SEE DWGS. M-23EM02, M-23EV08, M-23EM09 & M-23EM10 FOR EQUIPMENT NOT SHOWN ON THIS DWG. THAT HAS BEEN PERMANENTLY REMOVED FROM SERVICE.
- DRILLED RESTRICTION 3/4" IN DIAMETER. POINT AT WHICH QUALITY GROUP CLASSIFICATION IS CHANGED FROM "A" TO "B". INSERVICE INSPECTION WILL BE PERFORMED ON CLASS "A" PIPE UP TO THIS ORFICE.
- THIS CONNECTION IS TO BE USED ONLY FOR BEYOND-DESIGN-BASIS (FLEX) EMERGENCY CORE COOLING.
- DELETED
- DELETED
REV.	DATE	DRAWN	CHKD.	SUPV.	APPD.	LOCATION	CLASS
1	11/89	MAL					
2							
3							
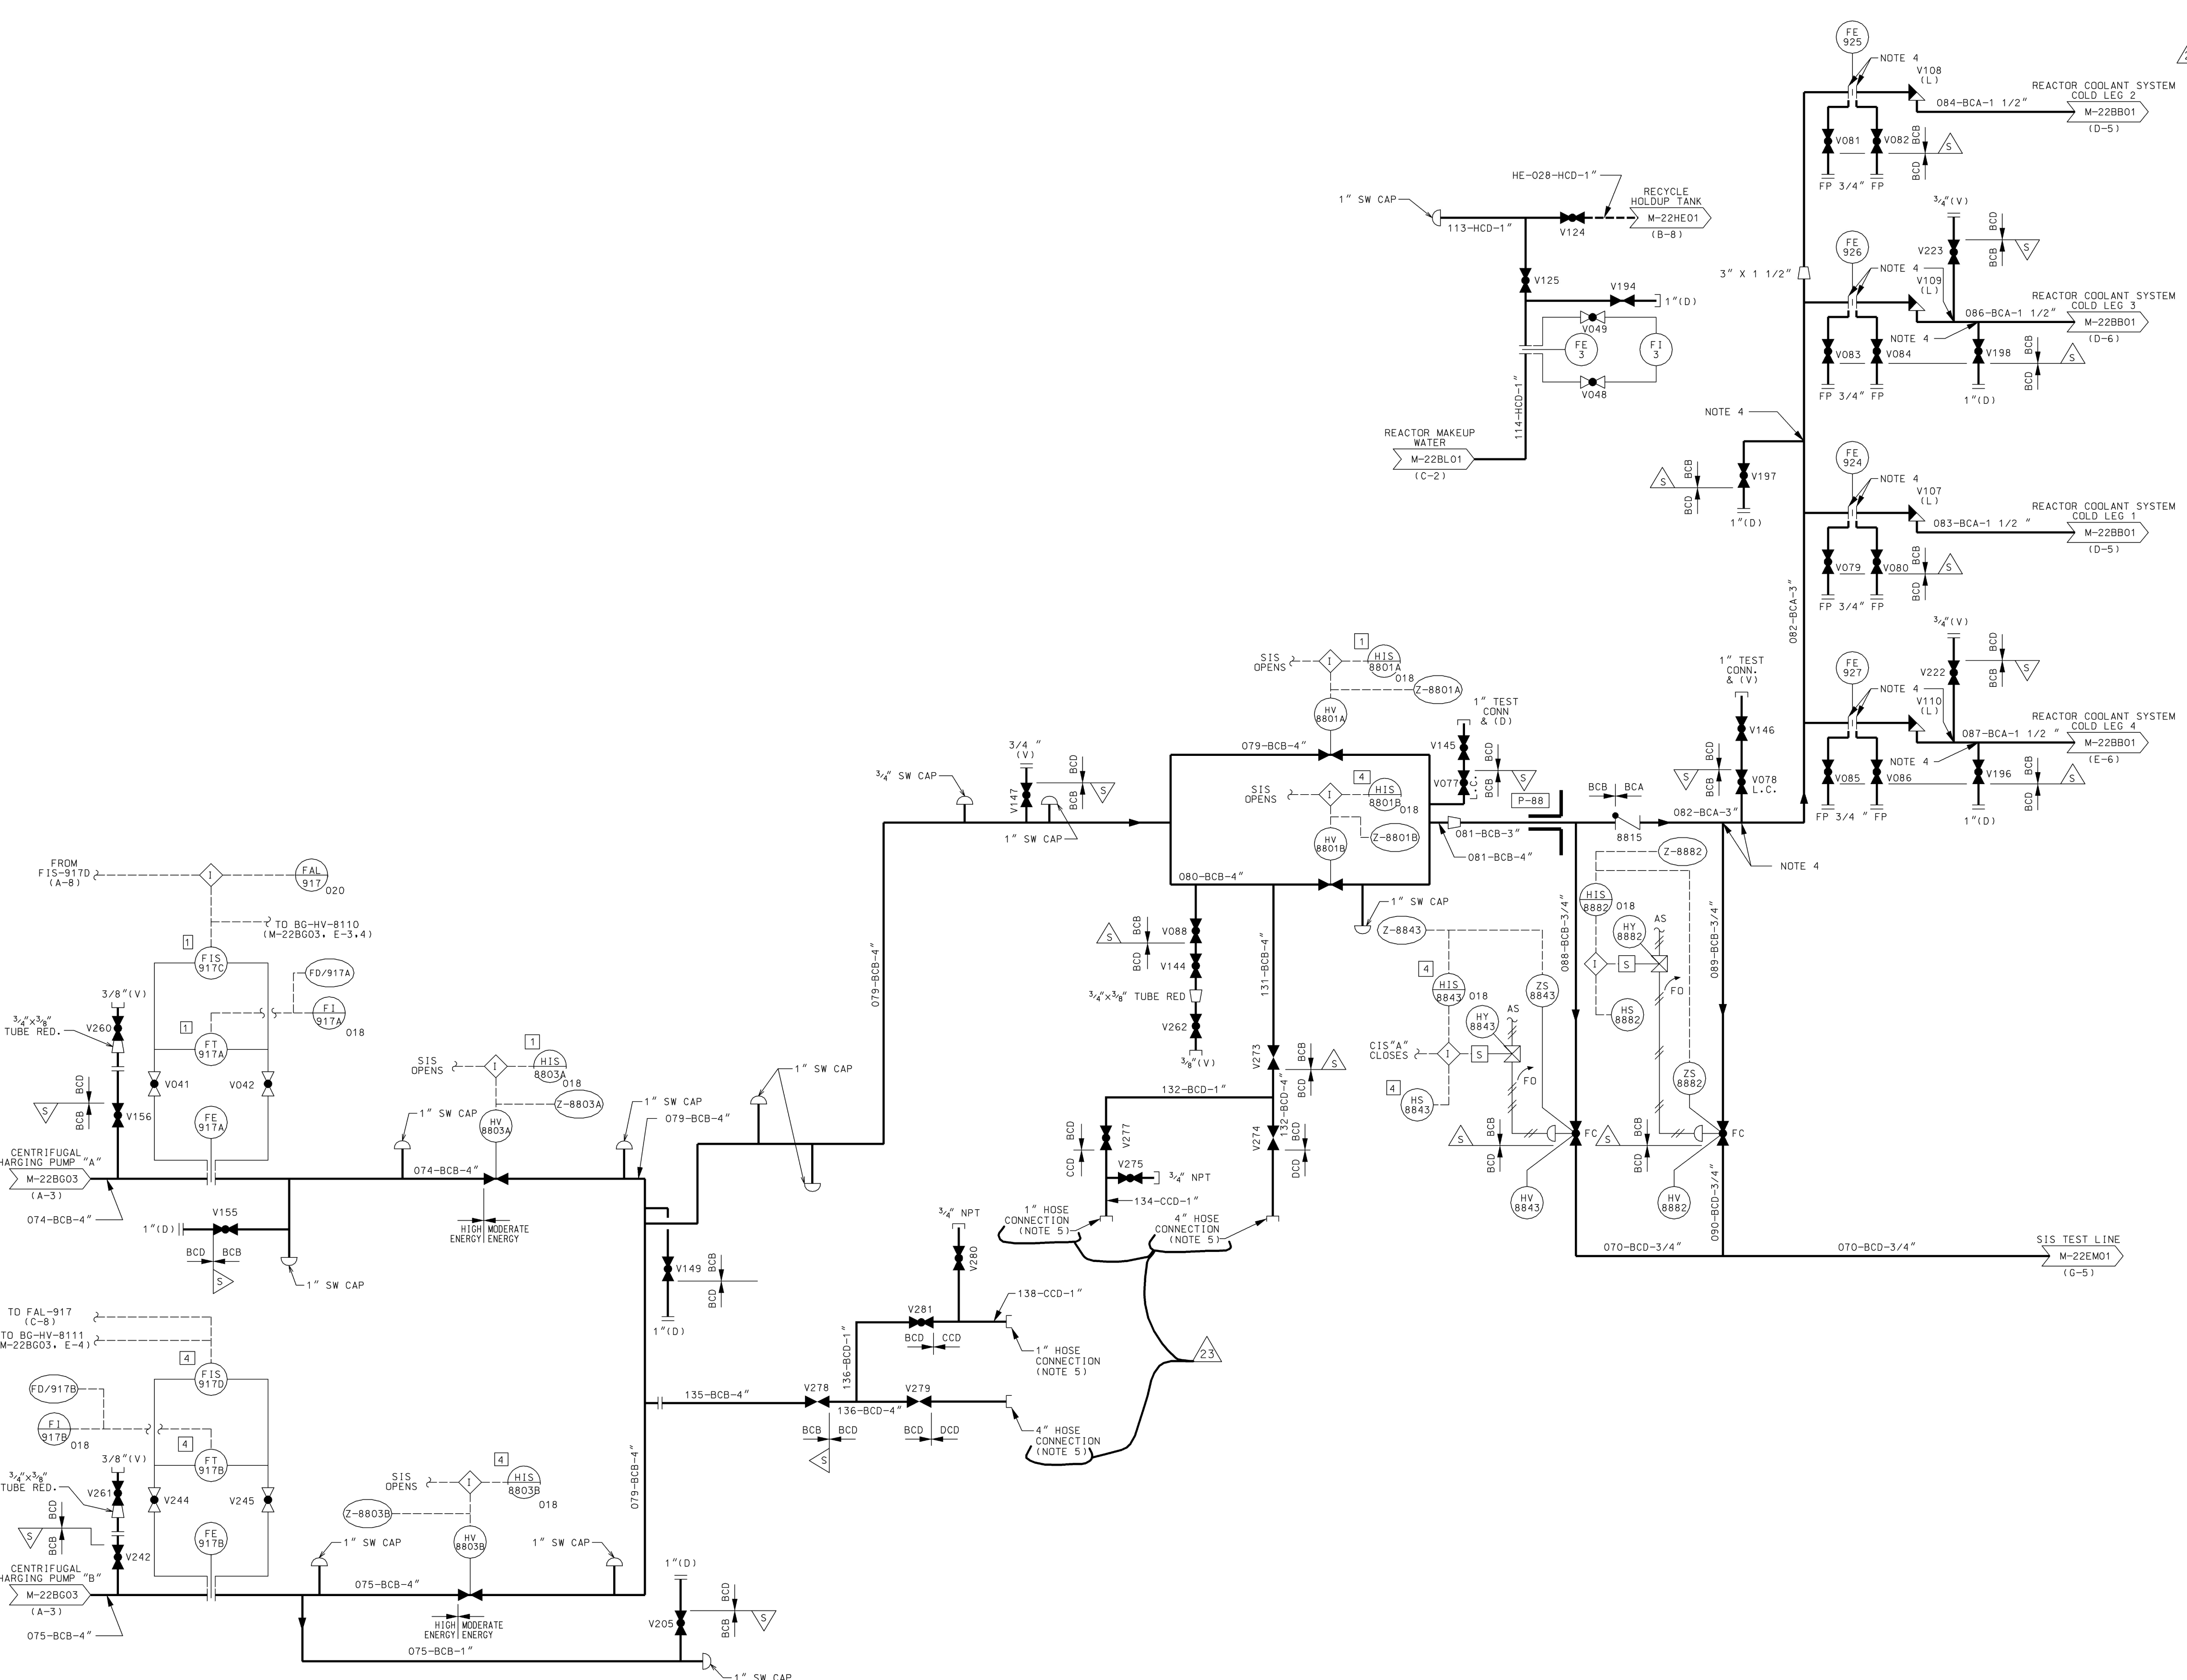


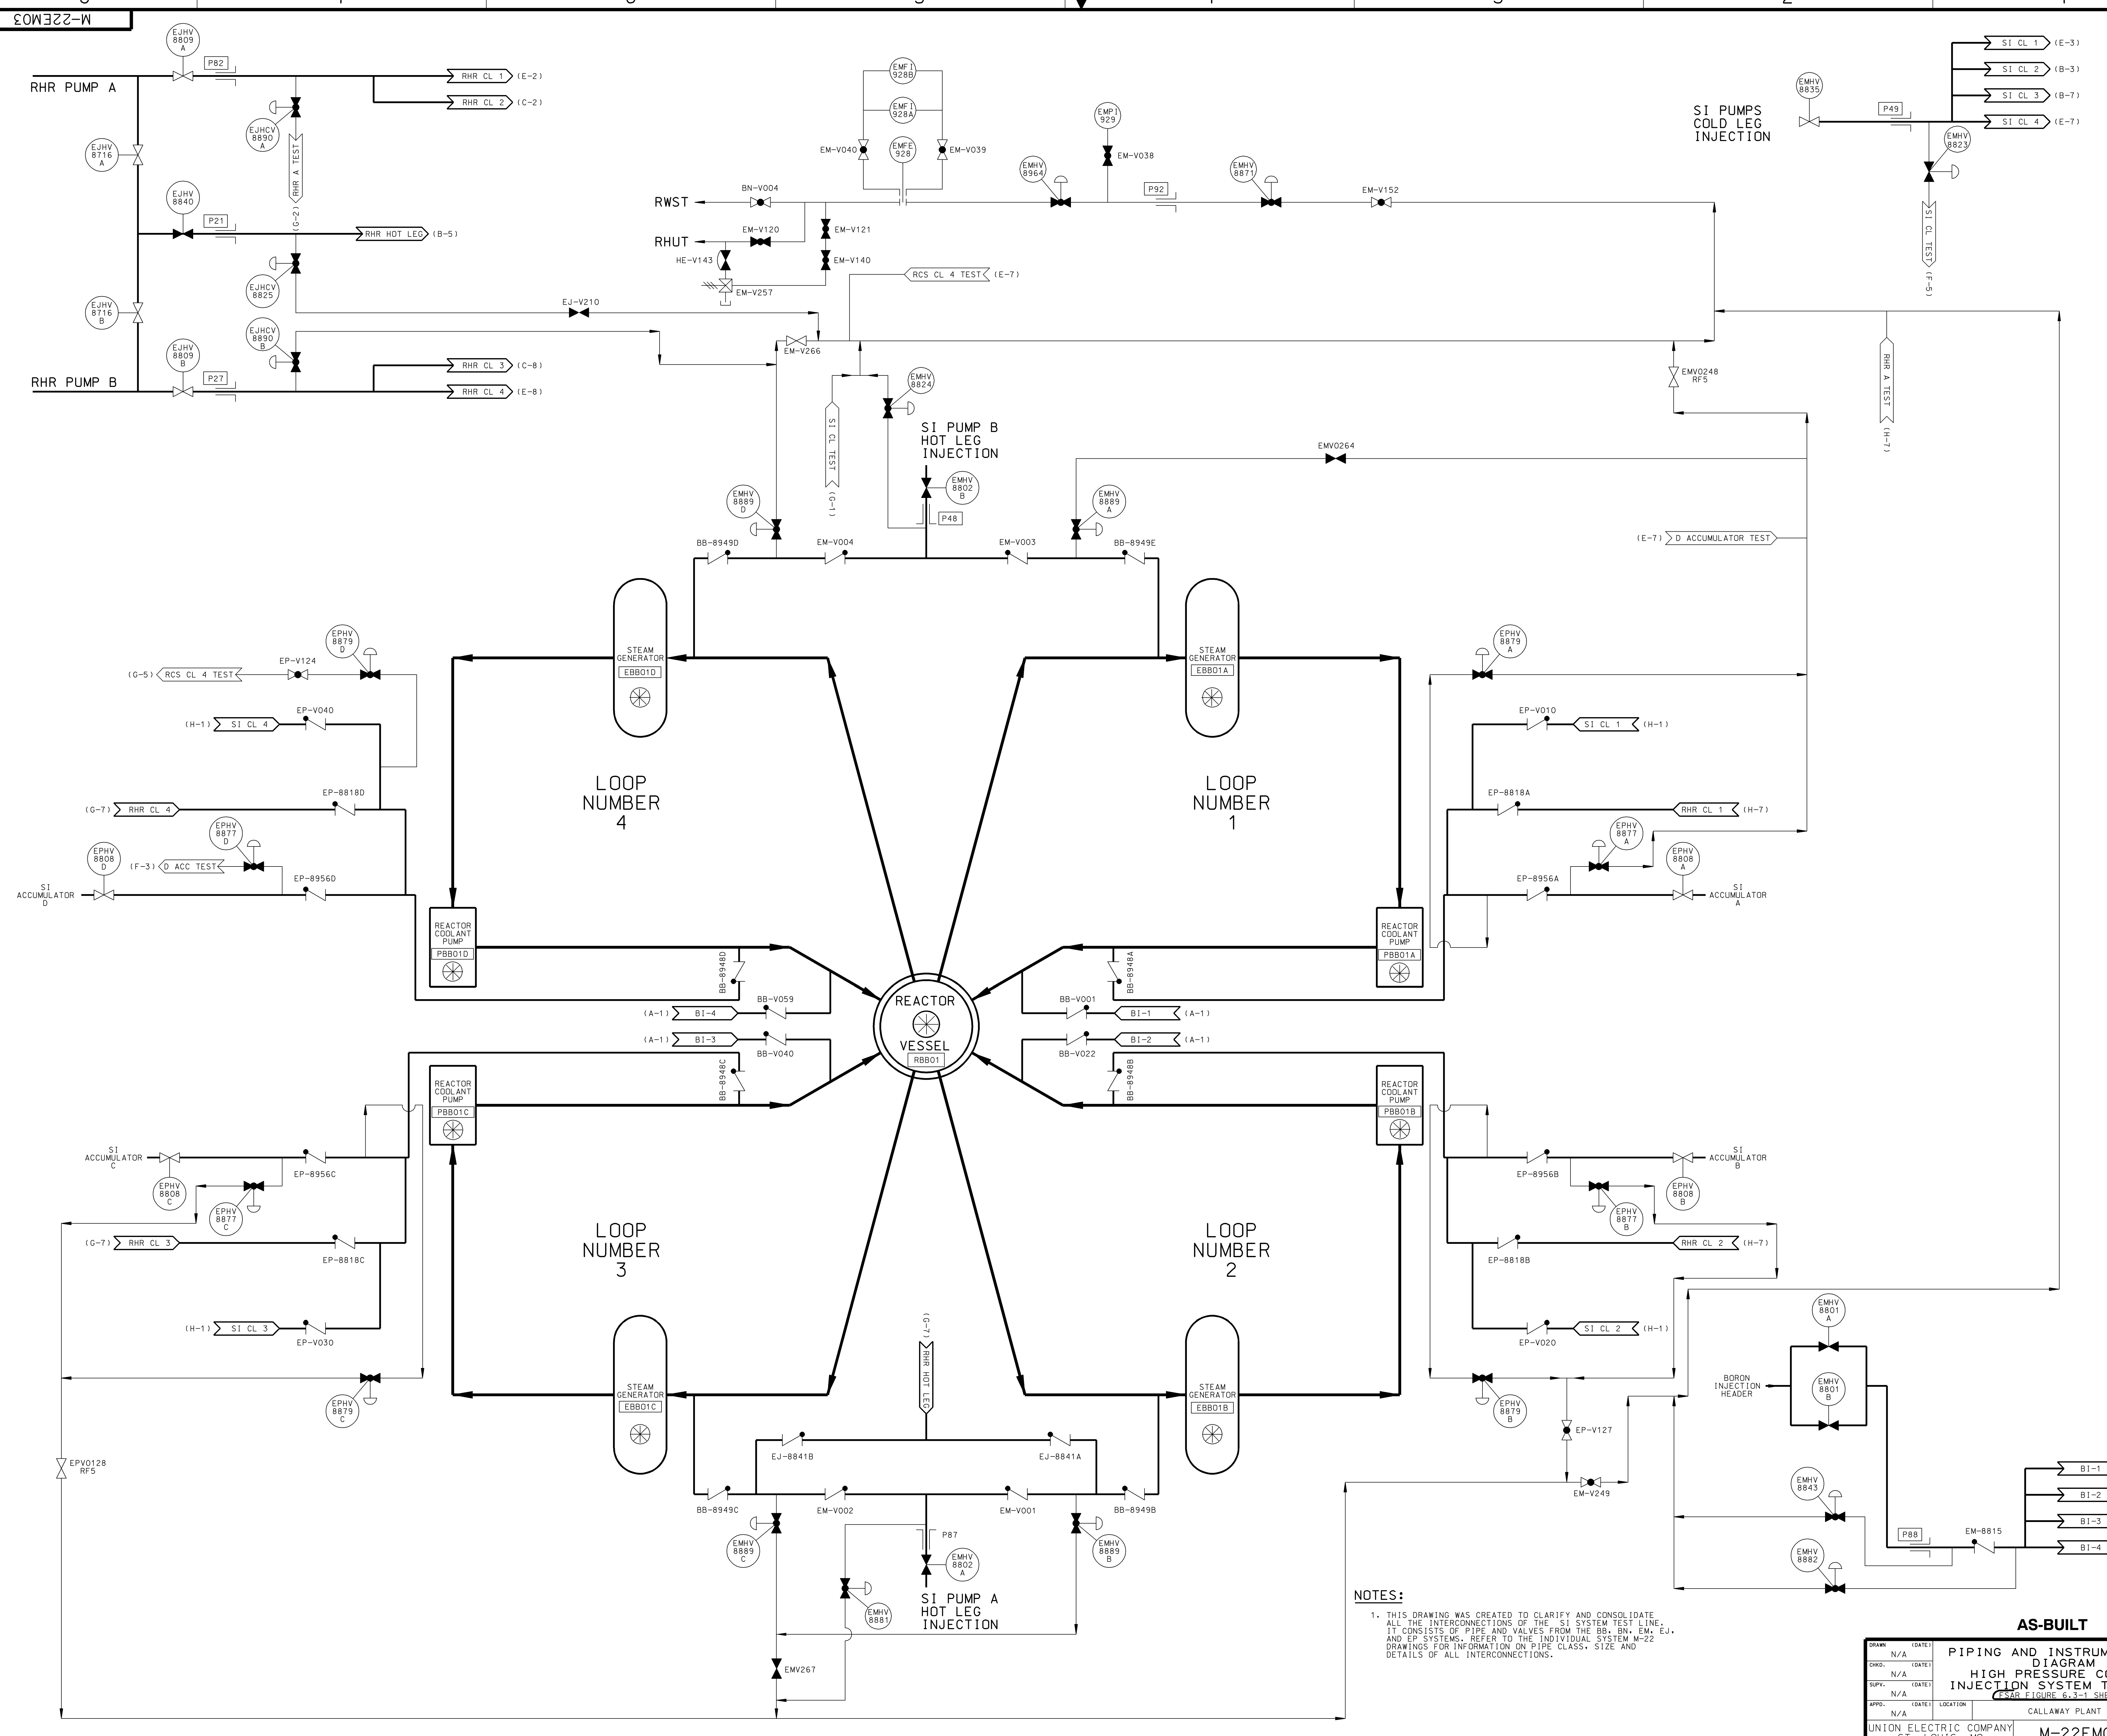

NOTES:
 1. THIS DRAWING WAS CREATED TO CLARIFY AND CONSOLIDATE ALL THE INTERCONNECTIONS OF THE SI SYSTEM TEST LINE. IT CONSISTS OF PIPE AND VALVES FROM THE BB, BN, EM, EJ, AND EP SYSTEMS. REFER TO THE INDIVIDUAL SYSTEM M-22 DRAWINGS FOR INFORMATION ON PIPE CLASS, SIZE AND DETAILS OF ALL INTERCONNECTIONS.

REV. DATE DRAWN 050791 SBR
 CHKD: SUPV: APPD: DLB: TJM N/A
 INITIAL ISSUE PER RFR-8869A
 REV. DATE DRAWN 072991 JHK
 CHKD: SUPV: APPD: DLB: TJM N/A
 INCORP: EMP 90-1007.
 REV. DATE DRAWN 2 11391 MAL
 CHKD: SUPV: APPD: DLB: TJM N/A
 INCORP: DEC-0710.
 REV. DATE DRAWN 3 071892 GDC
 CHKD: SUPV: APPD: DLB: TJM N/A
 INCORP: DEC-0883.
 REV. DATE DRAWN 4 011830 LEP
 CHKD: SUPV: APPD: DLB: TJM N/A
 INCORP: DEC-0927.
 REV. DATE DRAWN 5 080990 LEP
 CHKD: SUPV: APPD: DLB: TJM N/A
 INCORP: DEC-1267.
 REV. DATE DRAWN 6 043096 DLB
 CHKD: SUPV: APPD: DLB: TJM N/A
 INCORP: DEC-1331.
 REV. DATE DRAWN 7 041097 HLP
 CHKD: SUPV: APPD: DLB: TJM N/A
 INCORP: RFR-17539A.
 REV. DATE DRAWN 8 041200 MAL
 CHKD: SUPV: APPD: DLB: TJM N/A
 INCORP: MP 00-1003A.
 REV. DATE DRAWN 9 030801 MAL
 CHKD: SUPV: APPD: DLB: TJM N/A
 INCORP: RFR 21102A.
 REV. DATE DRAWN 10 042001 RLW
 CHKD: SUPV: APPD: DLB: TJM N/A
 INCORP: MP 00-1015 (PARTIAL).
 REV. DATE DRAWN 11 042101 RLW
 CHKD: SUPV: APPD: DLB: TJM N/A
 INCORP: MP 00-1015A.
 REV. DATE 12 110402
 DRAWN(CHKD): SUPV: RLW MAL DLB
 INCORPORATE MP 01-1015A
 REV. DATE 13 041905
 DRAWN(CHKD): SUPV: MAL RLW TWS
 INCORP: RFR 22941A

AS-BUILT CLASS 1			
DRAWN	N/A	DATE	
CHKD:	N/A	DATE	
SUPV:	N/A	DATE	
APPD:	N/A	DATE	
UNION ELECTRIC COMPANY		CALLAWAY PLANT	REV. 13
ST. LOUIS, MO		M-22EM03	

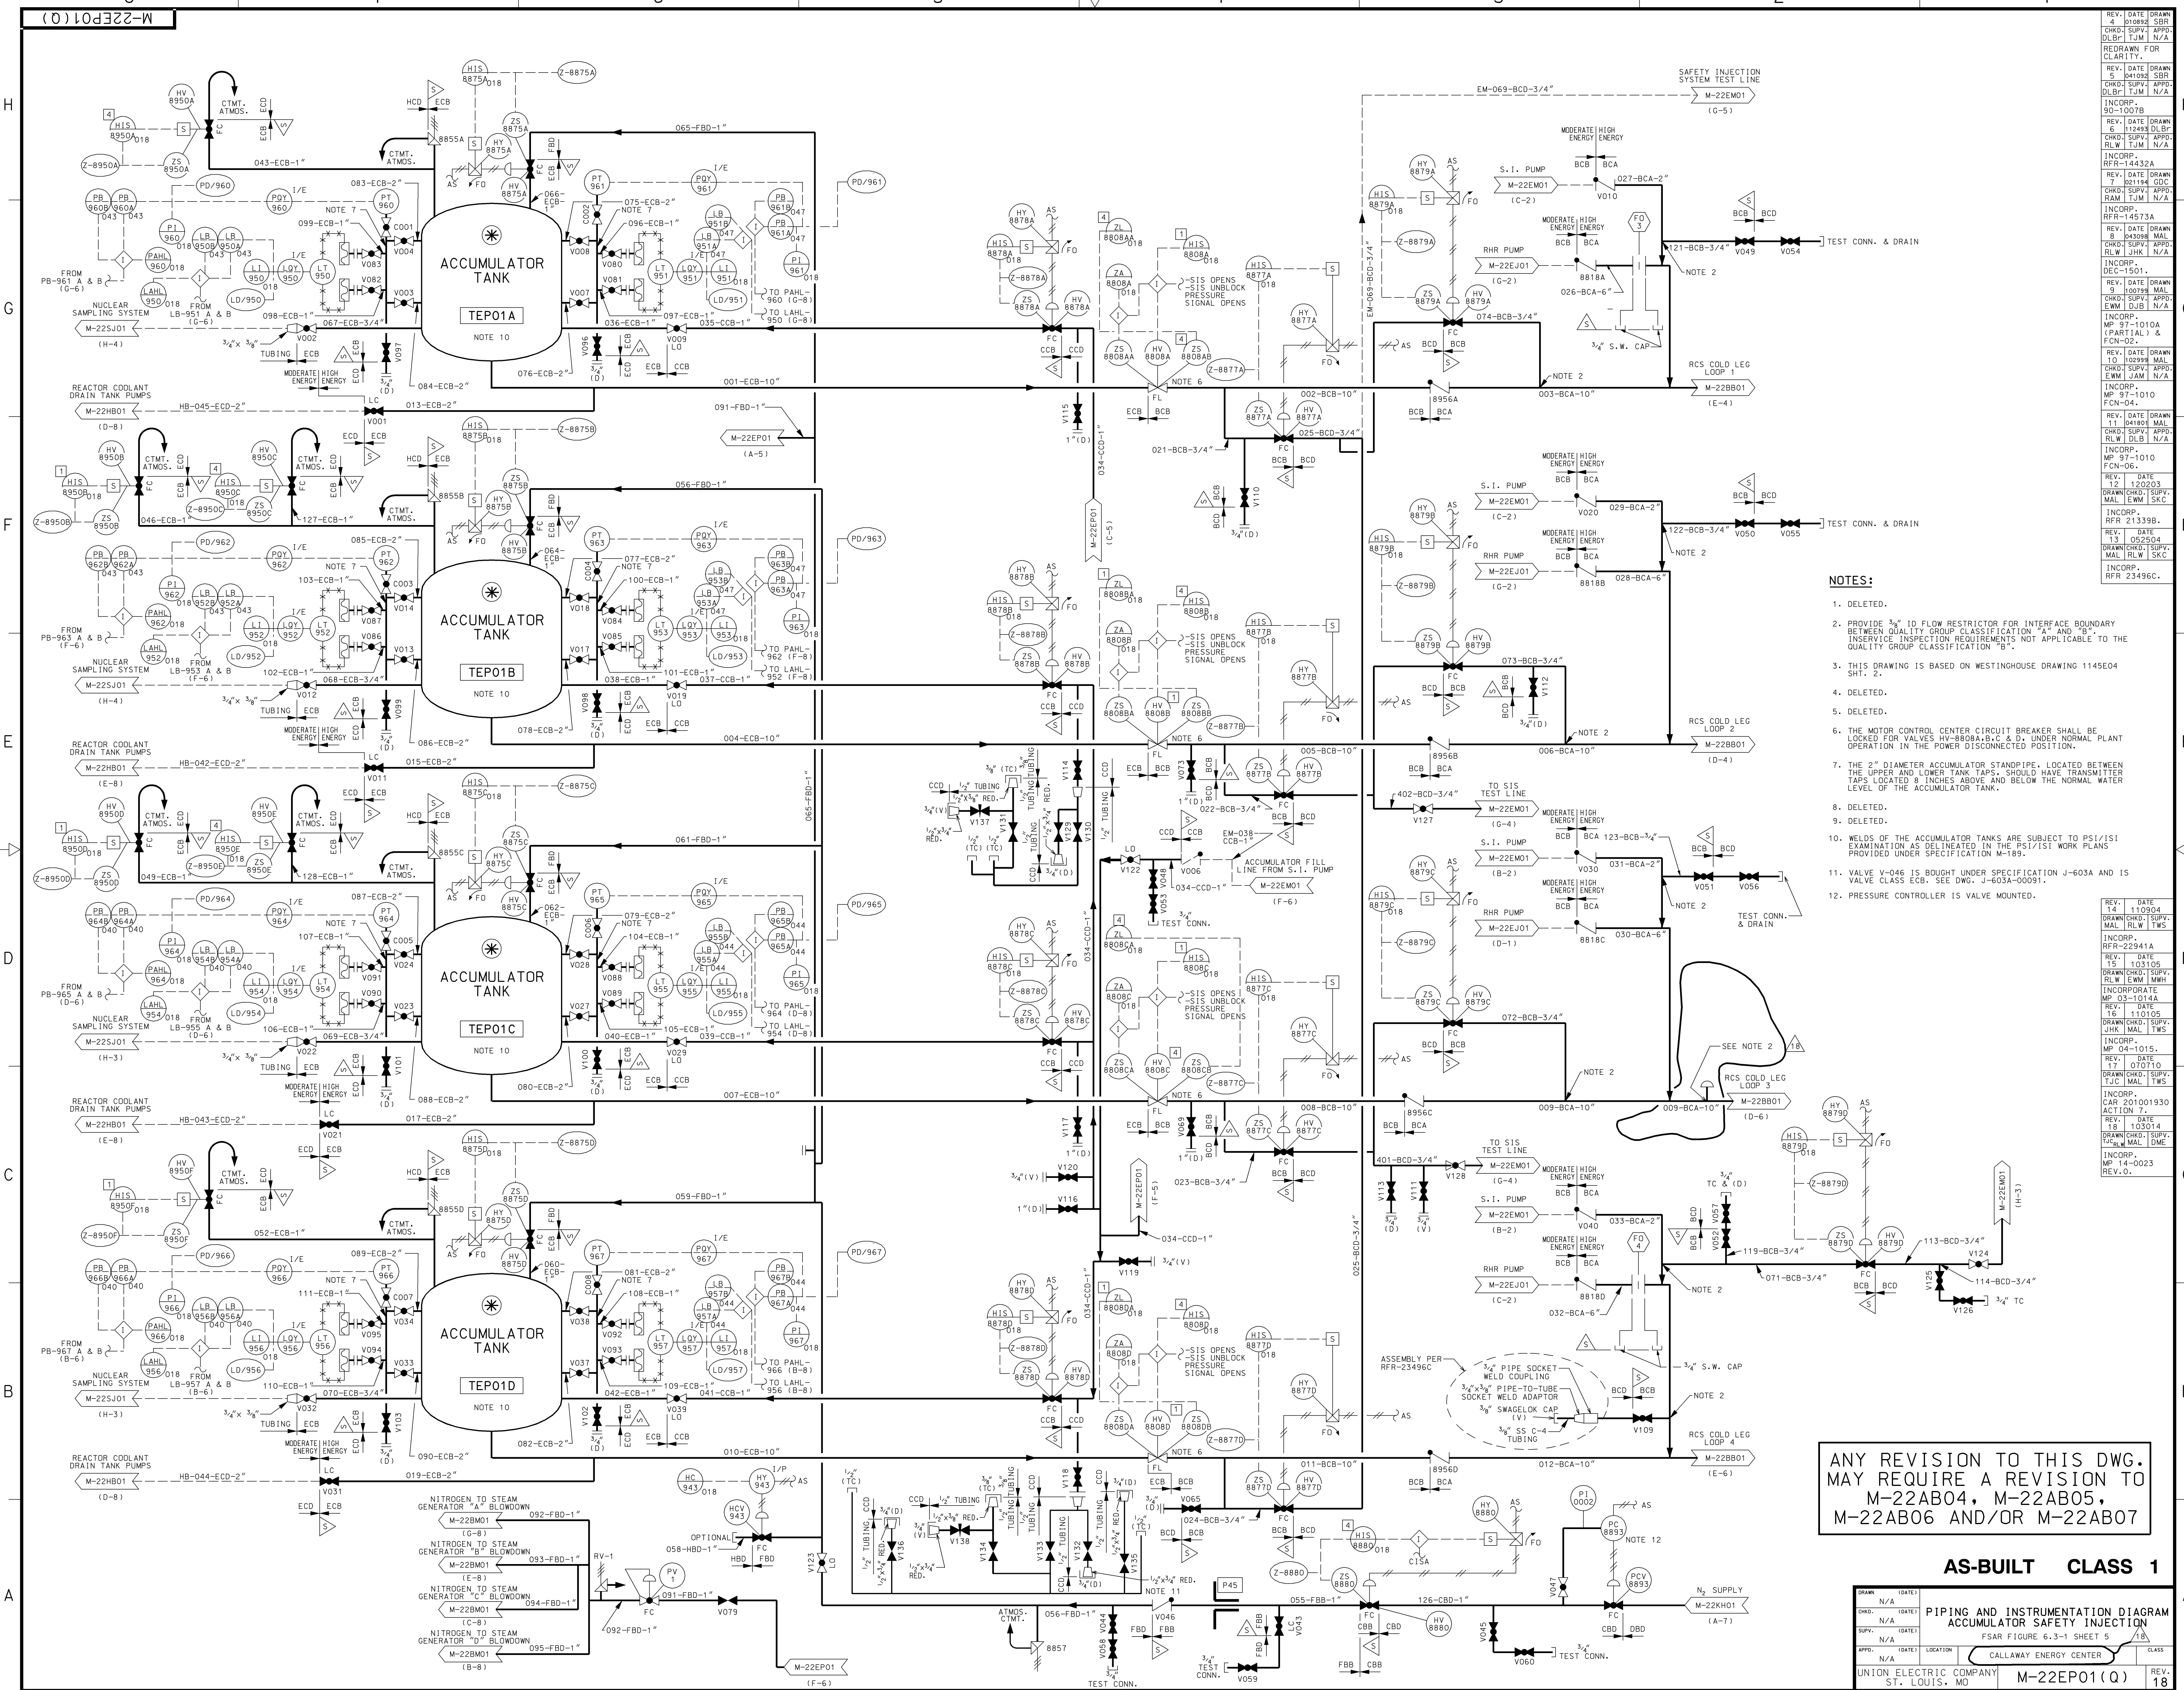


- NOTES:**
- DELETED.
 - PROVIDE 3/4" IO FLOW RESTRICTOR FOR INTERFACE BOUNDARY BETWEEN QUALITY CLASSIFICATION "A" AND "B". INSERVICE INSPECTION REQUIREMENTS NOT APPLICABLE TO THE QUALITY GROUP CLASSIFICATION "B".
 - THIS DRAWING IS BASED ON WESTINGHOUSE DRAWING 1145E04 SHI. 2.
 - DELETED.
 - DELETED.
 - THE MOTOR CONTROL CENTER CIRCUIT BREAKER SHALL BE LOCKED FOR VALVES HV-888A3, C & D, UNDER NORMAL PLANT OPERATION IN THE POWER DISCONNECTED POSITION.
 - THE 2" DIAMETER ACCUMULATOR STANDPIPE, LOCATED BETWEEN THE UPPER AND LOWER TANK TAPS, SHOULD HAVE TRANSMITTER TAPS LOCATED 8 INCHES ABOVE AND BELOW THE NORMAL WATER LEVEL OF THE ACCUMULATOR TANK.
 - DELETED.
 - DELETED.
 - WELDS OF THE ACCUMULATOR TANKS ARE SUBJECT TO PS1/IS1 EXAMINATION AS DETAILED IN THE PS1/IS1 WORK PLAN PROVIDED UNDER SPECIFICATION M-189.
 - VALVE V-046 IS BOUGHT UNDER SPECIFICATION J-603A AND IS VALVE CLASS ECB. SEE DWG. J-603A-00091.
 - PRESSURE CONTROLLER IS VALVE MOUNTED.

ANY REVISION TO THIS DWG. MAY REQUIRE A REVISION TO M-22AB04, M-22AB05, M-22AB06 AND/OR M-22AB07

AS-BUILT CLASS 1


DRWN	DATE	N/A	
CHKD	DATE	N/A	
SUPV	DATE	N/A	
APPD	DATE	N/A	
LOC	LOCATION	CALLAWAY ENERGY CENTER	CLAS
UNION ELECTRIC COMPANY			M-22EP01 (Q)
ST. LOUIS, MO			REV. 18

REV.	DATE	DRWN	BY	APPD.	DATE	DRWN	BY	APPD.	DATE
1	11/09/04	110904	ML	TWS					
2	11/09/04	110904	ML	TWS					
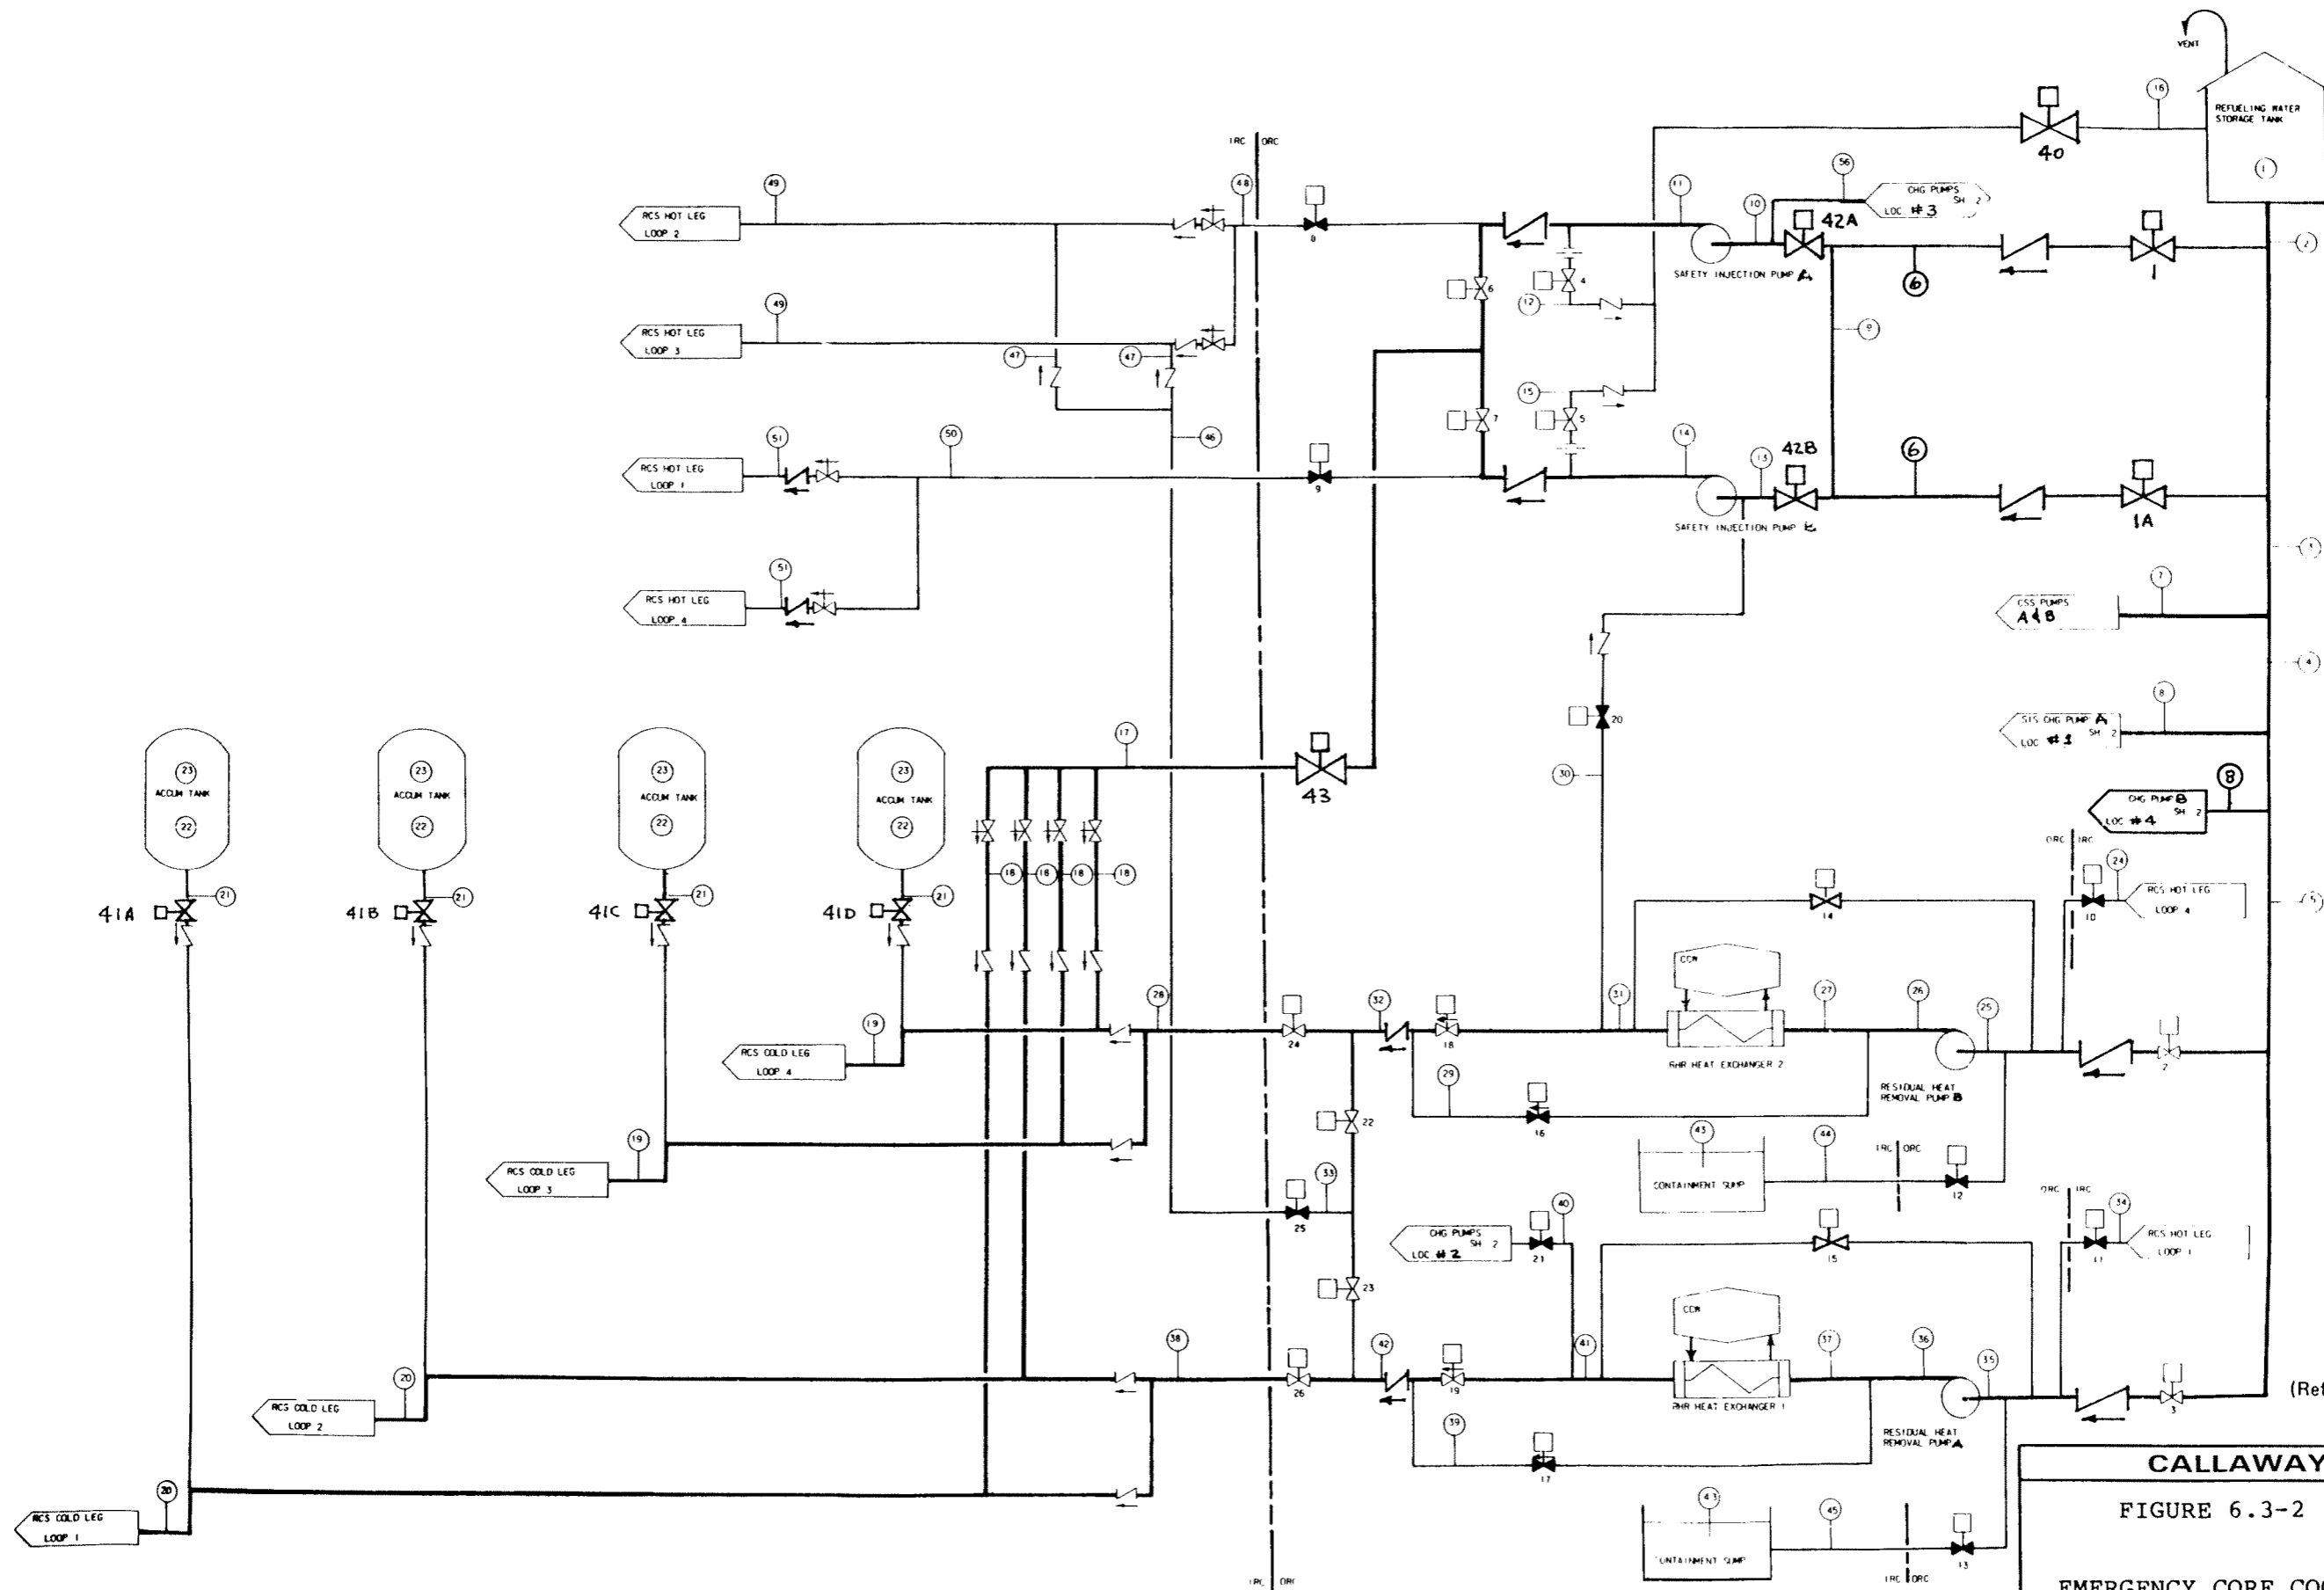

(Refer to following notes)
 REV. OL-5
 6/91

CALLAWAY PLANT
 FIGURE 6.3-2 (SHEET 1)
 EMERGENCY CORE COOLING SYSTEM
 PROCESS FLOW DIAGRAM

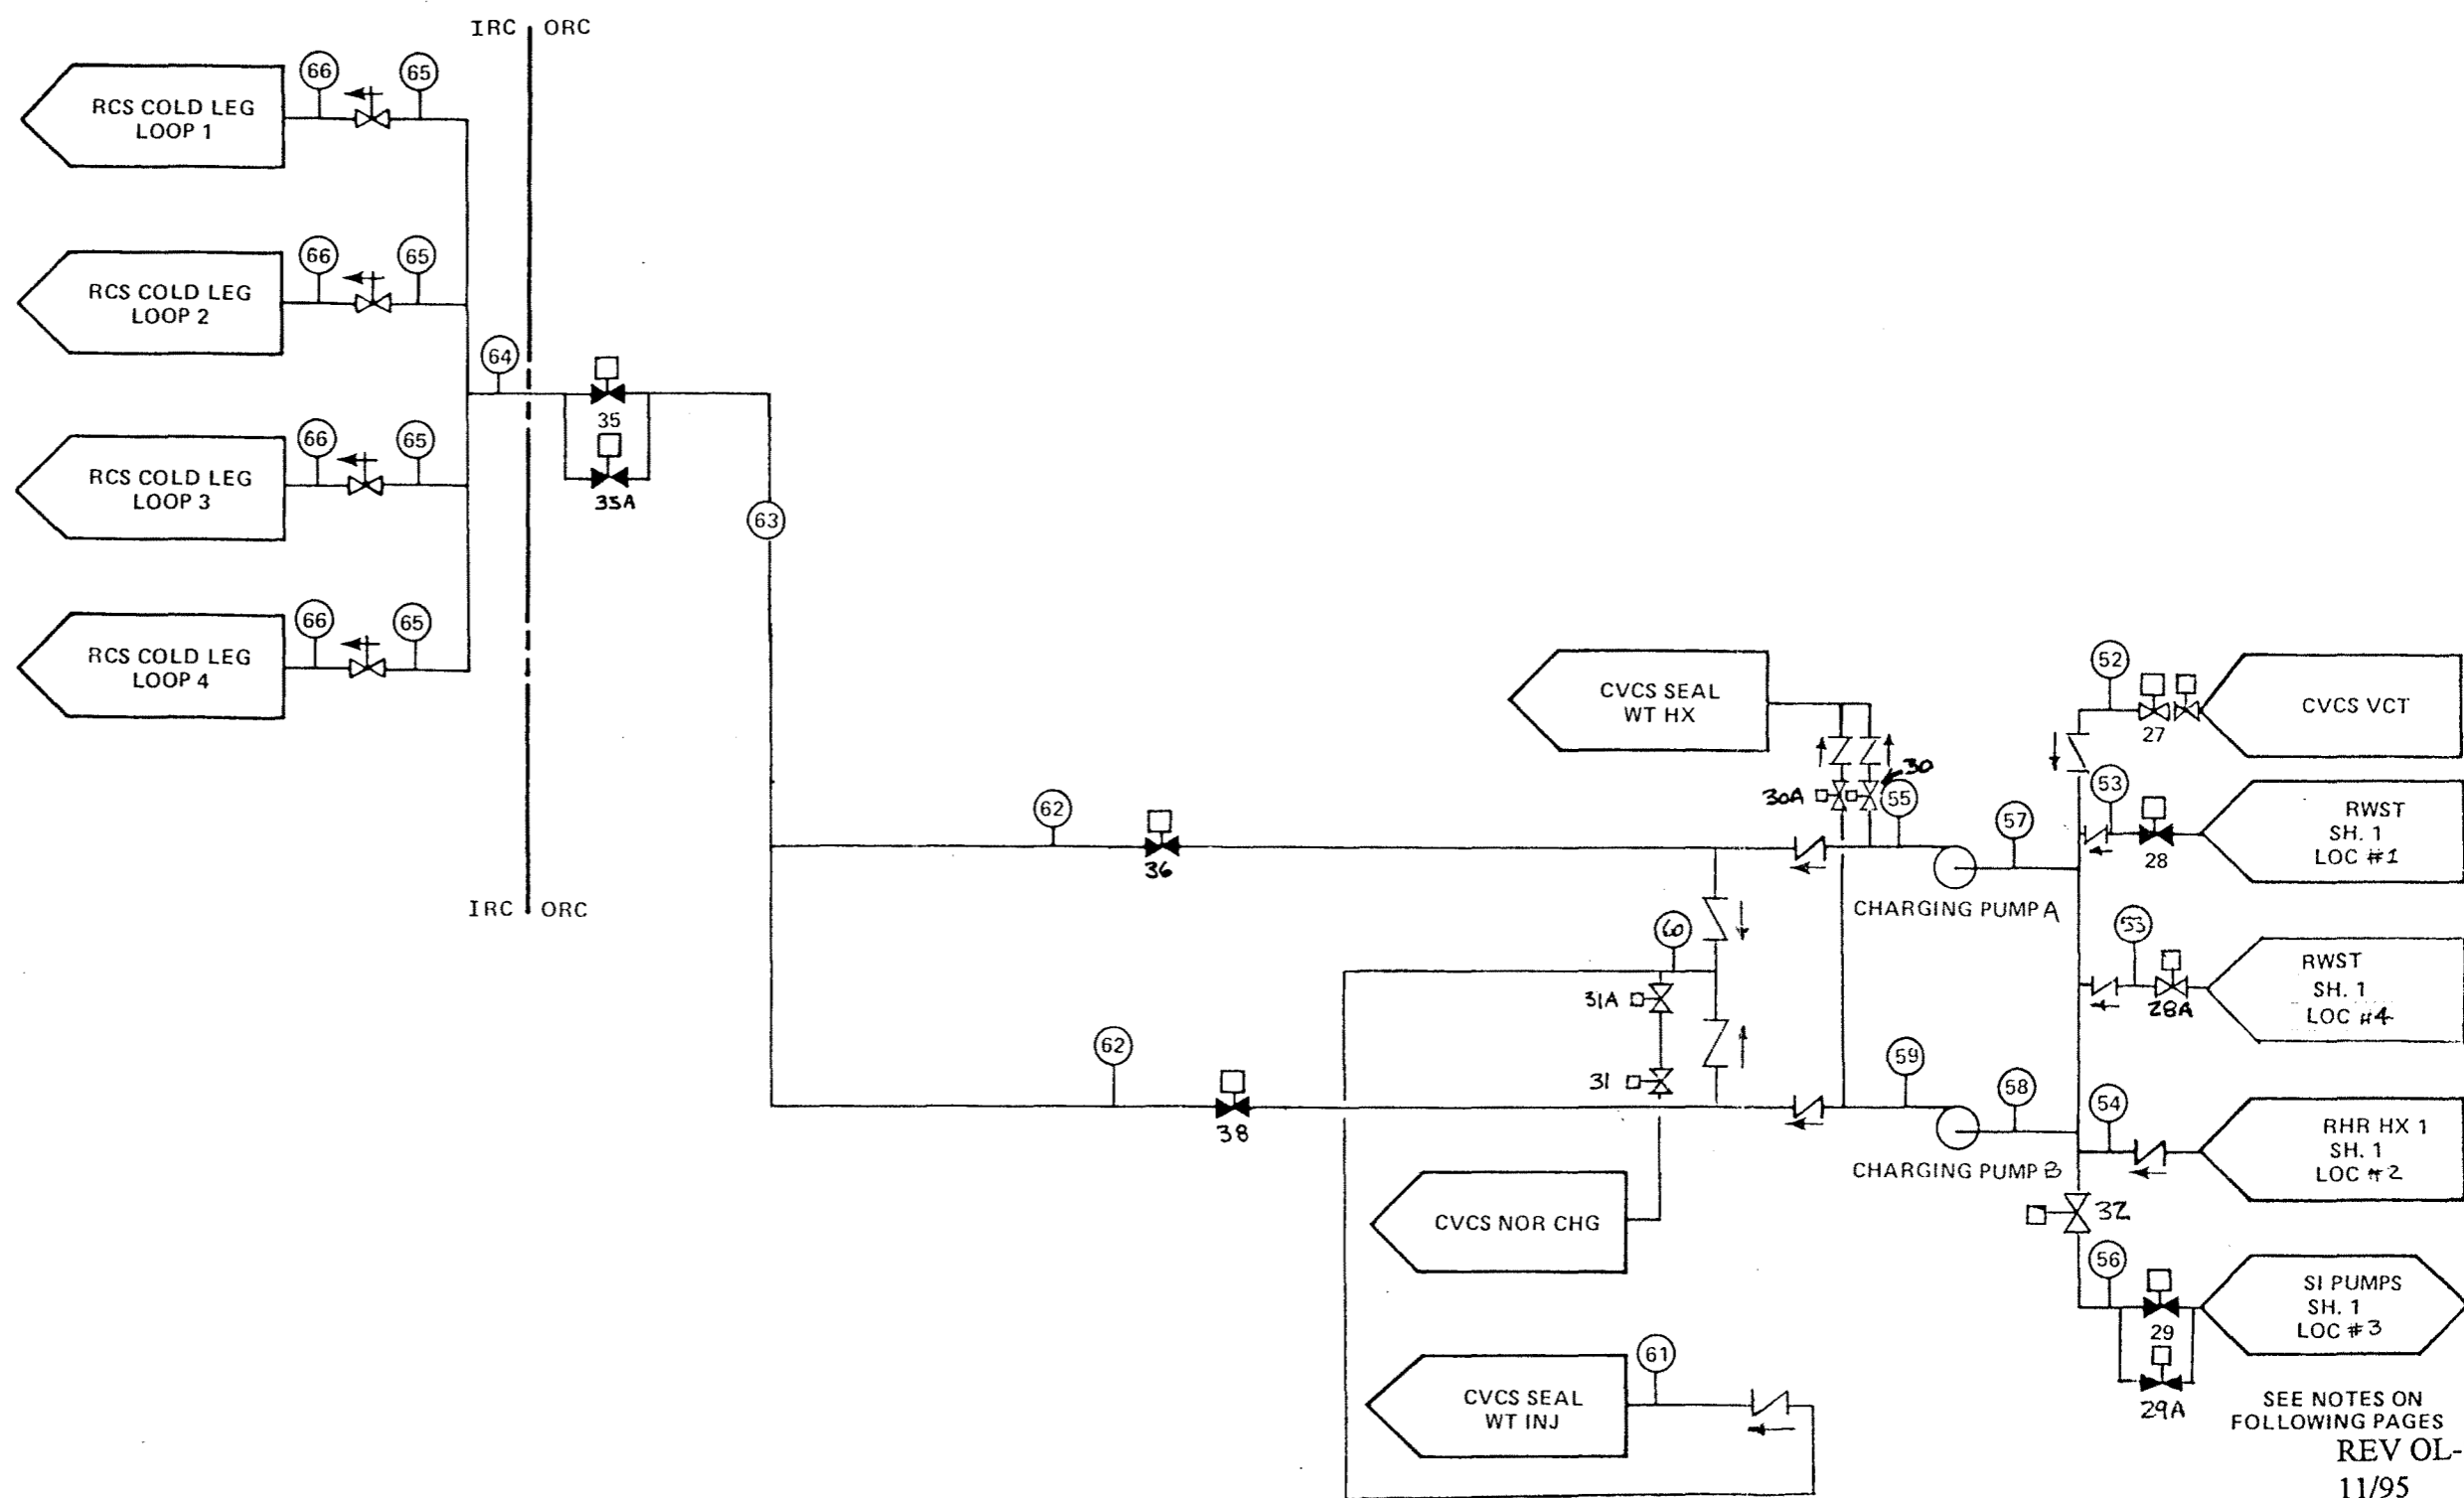

CALLAWAY PLANT
 FIGURE 6.3-2 (SHEET 2)
 EMERGENCY CORE COOLING SYSTEM
 PROCESS FLOW DIAGRAM

NOTES TO FIGURE 6.3-2

MODES OF OPERATION

Mode A - Injection

This mode presents the process conditions for the case of maximum safeguards, i.e., all pumps operating, following accumulator delivery. Two residual heat removal (RHR) pumps, two safety injection (SI) pumps, and two centrifugal charging (CC) pumps operate, taking suction from the RWST and delivering to the reactor through the cold leg connections. EJ-HV-8716A and B and EJ-HV-8809A and B are maintained open during operating modes 1-3 in order that either RHR pump is able to inject to all four RCS cold legs. Note that the flow from each pump is less than its maximum runout since the pump discharge piping is shared by the two pumps of each subsystem. Note also that the SI pump branch connections to the RHR lines are assumed very close to their discharge into the accumulator lines, thereby eliminating any increase in RHR branch line head loss due to the combined flows of the RHR and SI pumps. The RHR line resistance was assumed to be the minimum of the allowable bank presented in the limiting pressure drop and elevation head design requirements, allowing maximum RHR injection flow.

Mode B - Cold Leg Recirculation

This mode presents the process conditions for the case of cold leg recirculation, assuming RHR pump A out of service and RHR pump B operating, SI pumps A and B operating, and CC pumps A and B operating.

In this mode, the ECCS pumps operate in series, with only the RHR pump capable of taking suction from the containment sump. The recirculation coolant is then delivered by the RHR pump to both of the SI pumps, which deliver to the reactor through their cold leg connections, and to both of the CC pumps. The CC pumps deliver to the reactor through their cold leg connections. The RHR pump also delivers flow directly to the reactor through two cold legs since the RHR discharge cross-connect valves are closed when making the transfer from injection to recirculation.

Mode C - Hot Leg Recirculation

This mode presents the process conditions for the case of hot leg recirculation, assuming RHR pump B out of service and RHR pump A operating, CC pumps A and B operating, and SI pumps A and B operating.

In this mode, the ECCS pumps again operate in series with only the RHR pump taking suction from the containment sump. The recirculated coolant is then delivered by the RHR pump to both of the SI and to both of the CC pumps. The CC pumps continue to deliver to the reactor through their cold leg connections and the SI pumps deliver to the reactor through their hot leg connections. The RHR pump also delivers directly to the reactor through two hot leg connections.

NOTES TO FIGURE 6.3-2 (Sheet 2)

VALVE ALIGNMENT CHART

Valve NO.	<u>Operational Modes</u>		
	<u>A</u>	<u>B</u>	<u>C</u>
1 (BN-HV-8806A)	O	C	C
1A (BN-HV-8806B)	O	C	C
2 (BN-HV-8812B)	O	C	C
3 (BN-HV-8812A)	O	C	C
4 (EM-HV-8814A)	O	C	C
5 (EM-HV-8814B)	O	C	C
6 (EM-HV-8821A)	O	O	C
7 (EM-HV-8821B)	O	O	C
8 (EM-HV-8802A)	C	C	O
9 (EM-HV-8802B)	C	C	O
10 (EJ-HV-8701B)	C	C	C
11 (EJ-HV-8701A)	C	C	C
12 (EJ-HV-8811B)	C	O	O
13 (EJ-HV-8811A)	C	O	O
14 (EJ-FCV-0611)	C	C	O
15 (EJ-FCV-0610)	C	O	C
16 (EJ-FCV-0619)	C	C	C
17 (EJ-FCV-0618)	C	C	C
18 (EJ-HCV-0607)	O	O	O
19 (EJ-HCV-0606)	O	O	O
20 (EJ-HV-8804B)	C	O	O
21 (EJ-HV-8804A)	C	O	O
22 (EJ-HV-8716B)	O*	C	C**
23 (EJ-HV-8716A)	O*	C	C
24 (EJ-HV-8809B)	O*	O	C
25 (EJ-HV-8840)	C	C	O
26 (EJ-HV-8809A)	O*	O	C
27 (BG-LCV-0112B)	C	C	C
27A (BG-LCV-0112C)	C	C	C
28 (BN-LCV-0112D)	O	C	C
28A (BN-LCV-0112E)	O	C	C
29 (EM-HV-8807A)	C	O	O
29A (EM-HV-8807B)	C	O	O
30 (BG-HV-8110)	C	C	C
30A (BG-HV-8111)	C	C	C
31 (BG-HV-8105)	C	C	C
31A (BG-HV-8106)	C	C	C
32 (EM-HV-8924)	O	O	O
35 (EM-HV-8801A)	O	O	O
35A (EM-HV-8801B)	O	O	O
36 (EM-HV-8803A)	O	O	O
38 (EM-HV-8803B)	O	O	O
40 (BN-HV-8813)	O	C	C
41A (EP-HV-8808A)	O	O	O
41B (EP-HV-8808B)	O	O	O
41C (EP-HV-8808C)	O	O	O
41D (EP-HV-8808D)	O	O	O
42A (EM-HV-8923A)	O	O	O
42B (EM-HV-8923B)	O	O	O
43 (EM-HV-8835)	O	O	C

O = open

C = closed

* EJ-HV-8716A and B and EJ-HV-8809A and B are maintained open during operating modes 1-3 in order that either RHR pump is able to inject to all four RCS cold legs.

** Assuming that only RHR pump A is operating.

CALLAWAY - SP

NOTES TO FIGURE 6.3-2 (Sheet 3)

MODE A - INJECTION PHASE(CONDITIONS FOLLOWING ACCUMULATOR DELIVERY)

<u>Location</u>	<u>Fluid</u>	<u>Pressure (psig)</u>	<u>Temperature (F)</u>	<u>(gpm)</u>	<u>Flow (lb/sec)</u>	<u>Volume (gal)</u>
1	Refueling water	Atm tank	100	-	-	394,000
2	"	(a)	100	16,905	2,333	-
3	"	13 psia	100	16,025	12,211	-
4	"	-	100	9,695	1,338	-
5	"	-	100	8,856	1,222	-
6	"	11 psia	100	440	61.5	-
7	"	-	100	3,165	437	-
8	"	>10 psia	100	419	58	-
9	"	>10 psia	100	440	61.5	-
10	"	10 psia	100	440	61.5	-
11	"	1165	100	440	61.5	-
12	"	<25	100	39	5	-
13	"	10 psia	100	440	61.5	-
14	"	1165	100	440	61.5	-
15	"	<25	100	39	5	-
16	"	-	100	78	11	-
17	"	1050	100	802	111	-
18	"	73	100	200.5	28	-
19	"	Low pressure	100	2,414.5	333	-
20	"	Low pressure	100	2,414.5	333	-
21	Borated Water	0	100	0	0	-
22	Borated Water	0	100	0	0	6358 ^(b)

CALLAWAY - SP

NOTES TO FIGURE 6.3-2 (Sheet 4)

<u>Location</u>	<u>Fluid</u>	<u>Pressure (psig)</u>	<u>Temperature (F)</u>	<u>(gpm)</u>	<u>Flow (lb/sec)</u>	<u>Volume (gal)</u>
23	Nitrogen	0	100	0	0	500(ft ³)
24	Reactor coolant	-	100	0	0	-
25	Refueling water	0	100	4,428	611	-
26	"	138	100	4,428	611	-
27	"	-	100	4,428	611	-
28	"	47	100	4,428	611	-
29	"	86	100	0	0	-
30	"	-	100	0	0	-
31	"	-	100	4,428	611	-
32	"	86	100	4,428	611	-
33	"	86	100	0	0	-
34	Reactor coolant	-	100	0	0	-
35	Refueling water	0	100	4,428	611	-
36	"	138	100	4,428	611	-
37	"	-	100	4,428	611	-
38	"	47	100	4,428	611	-
39	"	86	100	0	0	-
40	"	-	100	0	0	-
41	"	-	100	4,428	611	-
42	"	86	100	4,428	611	-
43	Recirc. coolant	Containment pressure	120	0	0	-
44	"	"	120	0	0	-
45	"	"	120	0	0	-

CALLAWAY - SP

NOTES TO FIGURE 6.3-2 (Sheet 5)

<u>Location</u>	<u>Fluid</u>	<u>Pressure (psig)</u>	<u>Temperature (F)</u>	<u>(gpm)</u>	<u>Flow (lb/sec)</u>	<u>Volume (gal)</u>
46	Refueling water	Low pressure	100	0	0	-
47	"	"	100	0	0	-
48	"	"	100	0	0	-
49	"	"	100	0	0	-
50	"	"	100	0	0	-
51	Refueling water	Low pressure	100	0	0	-
52	"	"	100	0	0	-
53	"	>10 psia	100	419	58	-
54	"	-	100	0	0	-
55	"	1,519	100	419	58	-
56	"	-	100	0	0	-
57	"	10 psia	100	419	58	-
58	"	10 psia	100	419	58	-
59	"	1,519	100	419	58	-
60	"	1,516	100	124	17	-
61	"	~0	100	124	17	-
62	"	1,456	100	357	49.3	-
63	"	-	100	714	99	-
64	"	1,396	100	714	99	-
65	"	1,008	100	178.5		24.6
66	"	388	100	178.5		24.6

NOTES:

- (a) At reference conditions, 100°F and 0 psig
- (b) Minimum allowable volume at normal operating conditions

CALLAWAY - SP

NOTES TO FIGURE 6.3-2 (Sheet 6)

MODE B - COLD LEG RECIRCULATION (PUMP B OPERATING)

<u>Location</u>	<u>Fluid</u>	<u>Pressure (psig)</u>	<u>Temperature (F)</u>	<u>(gpm)</u>	<u>Flow (lb/sec)</u>	<u>Volume (gal)</u>
1	Refueling water	Atm tank	100	-	-	<5000
2	"	-	100	0	0	-
3	"	-	100	0	0	-
4	"	-	100	0	0	-
5	"	-	100	0	0	-
6	Recirc. coolant	-	186	0	0	-
7	Refueling water	-	100	0	0	-
8	"	-	100	0	0	-
9	Recirc. coolant	~35	186	1,278	170	-
10	"	~35	186	440	59	-
11	"	~1,165	186	~440	59	-
12	Refueling water	-	100	0	0	-
13	Recirc. coolant	~35	186	440	59	-
14	"	~1,165	186	~440	59	-
15	Refueling water	-	100	0	0	-
16	"	-	100	0	0	-
17	Recirc. coolant	1,050	186	880	117	-
18	"	73	186	220	29	-
19	"	Low pressure	186	1,761	235	-
20	"	Low pressure	186	220	29	-

CALLAWAY - SP

NOTES TO FIGURE 6.3-2 (Sheet 7)

<u>Location</u>	<u>Fluid</u>	<u>Pressure (psig)</u>	<u>Temperature (F)</u>	<u>(gpm)</u>	<u>Flow (lb/sec)</u>	<u>Volume (gal)</u>
21	Nitrogen	0	Ambient	0	0	-
22	Nitrogen	0	Ambient	0	0	6358 ^(b)
23	"	0	Ambient	0	0	500 (ft ³)
24	Recirc. coolant	-	212	0	0	-
25	"	~12	212	4,800	640	-
26	"	113	212	4,800	640	-
27	"	-	212	4,800	640	-
28	"	29	186	3,082	411	-
29	"	56	186	0	0	-
30	"	60	186	1,718	229	-
31	"	65	186	4,800	640	-
32	"	55	186	3,082	411	-
33	"	0	186	0	0	-
34	"	-	212	0	0	-
35	Refueling water	-	100	0	0	-
36	"	-	100	0	0	-
37	"	-	100	0	0	-
38	"	-	100	0	0	-
39	"	-	100	0	0	-
40	"	-	100	0	0	-
41	"	-	100	0	0	-
42	"	-	100	0	0	-
43	Recirc. coolant	Containment pressure	212	-	-	~350,000
44	"	"	212	4,800	640	-
45	"	"	212	0	0	-

CALLAWAY - SP

NOTES TO FIGURE 6.3-2 (Sheet 8)

<u>Location</u>	<u>Fluid</u>	<u>Pressure (psig)</u>	<u>Temperature (F)</u>	<u>(gpm)</u>	<u>Flow (lb/sec)</u>	<u>Volume (gal)</u>
46	Refueling water	Low pressure	100	0	0	-
47	"	"	100	0	0	-
48	"	"	100	0	0	-
49	"	"	100	0	0	-
50	"	"	100	0	0	-
51	Refueling water	Low pressure	100	0	0	-
52	Recirc. coolant	-	186	0	0	-
53	"	-	186	0	0	-
54	"	-	186	0	0	-
55	"	~1519	186	419	56	-
56	"	~30	186	838	111	-
57	"	~30	186	419	56	-
58	"	~30	186	419	56	-
59	"	~1,519	186	419	56	-
60	"	1,516	186	124	16	-
61	"	0	186	124	16	-
62	"	1,456	186	357	47.6	-
63	"	-	186	714	95	-
64	Recirc. coolant	1,396	186	714	95	-
65	"	1,008	186	178.5	24	-
66	"	388	186	178.5	24	-

NOTES:

- (a) At reference conditions, 212°F and 0 psig
- (b) Minimum water volume at operating conditions.

CALLAWAY - SP

NOTES TO FIGURE 6.3-2 (Sheet 9)

MODE C - HOT LEG RECIRCULATION (PUMP A OPERATING)

<u>Location</u>	<u>Fluid</u>	<u>Pressure (psig)</u>	<u>Temperature (F)</u>	<u>(gpm)</u>	<u>Flow (lb/sec)</u>	<u>Volume (gal)</u>
1	Refueling water	Atm tank	100	-	-	<5000
2	"	-	100	0	0	-
3	"	-	100	0	0	-
4	"	-	100	0	0	-
5	"	-	100	0	0	-
6	Recirc. coolant	-	182	0	0	-
7	Refueling water	-	100	0	0	-
8	"	-	100	0	0	-
9	Recirc. coolant	~25	<186	660	88	-
10	"	~25	<186	660	88	-
11	"	~715	100	0	0	-
12	Refueling water	-	<186	660	88	-
13	Recirc. coolant	~25	<186	660	88	-
14	"	~715	100	0	0	-
15	Refueling water	-	100	0	0	-
16	"	-	<186	0	0	-
17	Recirc. coolant	0	<186	0	0	-
18	"	-	186	0	0	-
19	"	Low pressure	186	0	0	-
20	"	Low pressure	<186	660	88	-

CALLAWAY - SP

NOTES TO FIGURE 6.3-2 (Sheet 10)

<u>Location</u>	<u>Fluid</u>	<u>Pressure (psig)</u>	<u>Temperature (F)</u>	<u>(gpm)</u>	<u>Flow (lb/sec)</u>	<u>Volume (gal)</u>
21	Nitrogen	-	Ambient	0	0	-
22	Nitrogen	0	Ambient	0	0	6358 ^(b)
23	"	0	Ambient	0	0	500(ft ³)
24	Recirc. coolant	-	212	0	0	-
25	"	-	<212	0	0	-
26	"	-	<212	0	0	-
27	"	-	<212	0	0	-
28	"	-	<186	0	0	-
29	"	-	<186	0	0	-
30	"	-	<186	0	0	-
31	"	-	<186	0	0	-
32	"	-	<186	0	0	-
33	"	50	<186	2,642	352	-
34	"	-	212	0	0	-
35	"	12	212	4,800	640	-
36	"	113	212	4,800	640	-
37	"	-	212	4,800	640	-
38	"	-	<186	0	0	-
39	"	55	<186	0	0	-
40	"	60	<186	2,158	288	-
41	"	65	<186	4,800	640	-
42	"	55	<186	2,642	352	-
43	Recirc. coolant	Containment pressure	212	-	-	-
44	"	"	212	0	0	-
45	"	"	212	4,800	640	-
46	"	7	<186	2,642	352	-
47	"	5	<186	1,321	176	-


CALLAWAY - SP

NOTES TO FIGURE 6.3-2 (Sheet 11)

<u>Location</u>	<u>Fluid</u>	<u>Pressure (psig)</u>	<u>Temperature (F)</u>	<u>(gpm)</u>	<u>Flow (lb/sec)</u>	<u>Volume (gal)</u>
48	"	645	<186	660	88	-
49	"	-	<186	1,651	220	-
50	"	645	<186	660	88	-
51	"	-	<186	330	44	-
52	"	-	<186	0	0	-
53	"	-	<186	0	0	-
54	"	-	<186	2,158	288	-
55	"	~1,519	<186	419	56	-
56	"	<35	<186	1,320	180	-
57	"	~35	<186	419	56	-
58	"	~35	<186	419	56	-
59	"	~1,519	<186	419	56	-
60	"	1,516	<186	124	16	-
61	"	~0	<186	124	16	-
62	"	1,456	<186	357	47.6	-
63	-	-	<186	714	95	-
64	Recirc. coolant	1,396	<186	714	95	-
65	"	1,008	<186	178.5	24	-
66	"	388	<186	178.5	24	-

NOTES:

- (a) At reference conditions, 212°F and 0 psig.
- (b) Minimum water volume at operating conditions

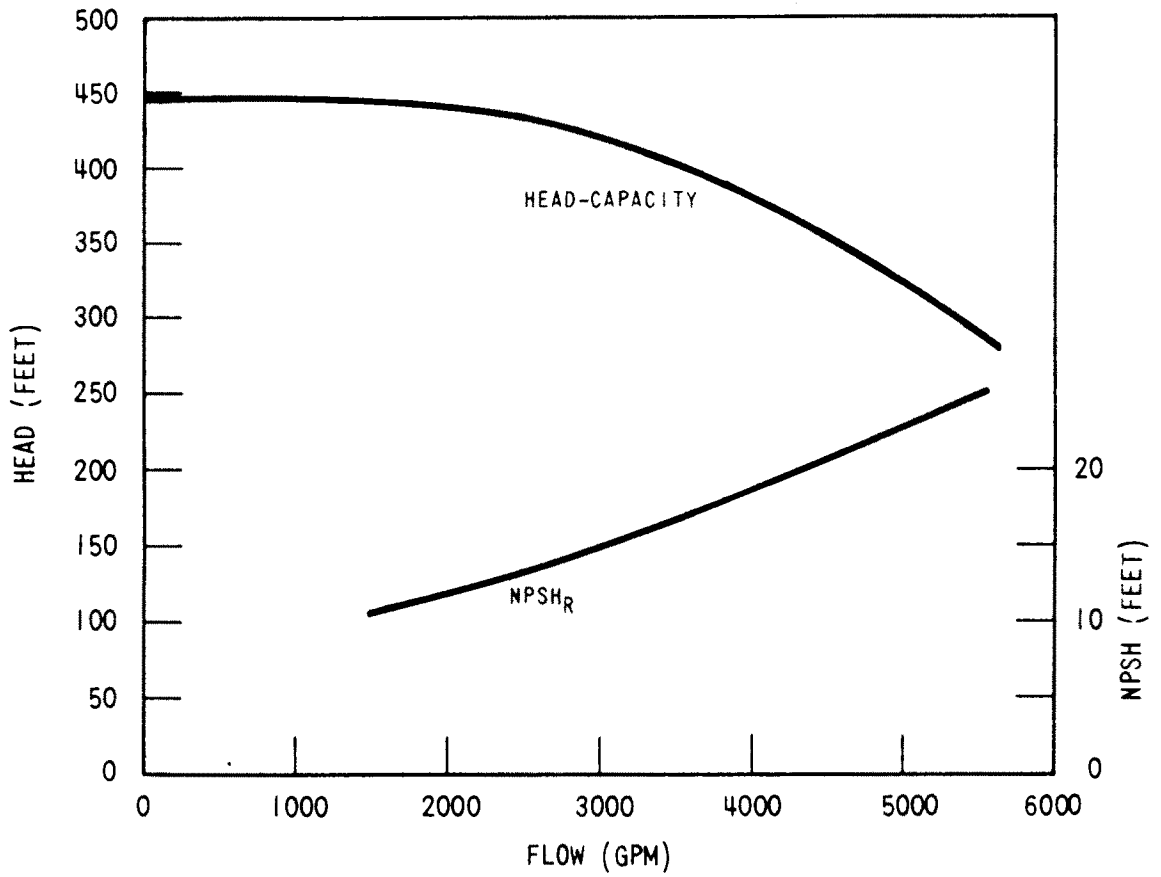

Rev. OL-0
6/86

CALLAWAY PLANT

FIGURE 6.3-3


**TYPICAL RESIDUAL HEAT REMOVAL PUMP
PERFORMANCE CURVE**

CALLAWAY PLANT

FIGURE 6.3-4

CENTRIFUGAL CHARGING PUMP
PERFORMANCE CURVE
INJECTION PHASE

REV. OL-6
6/92

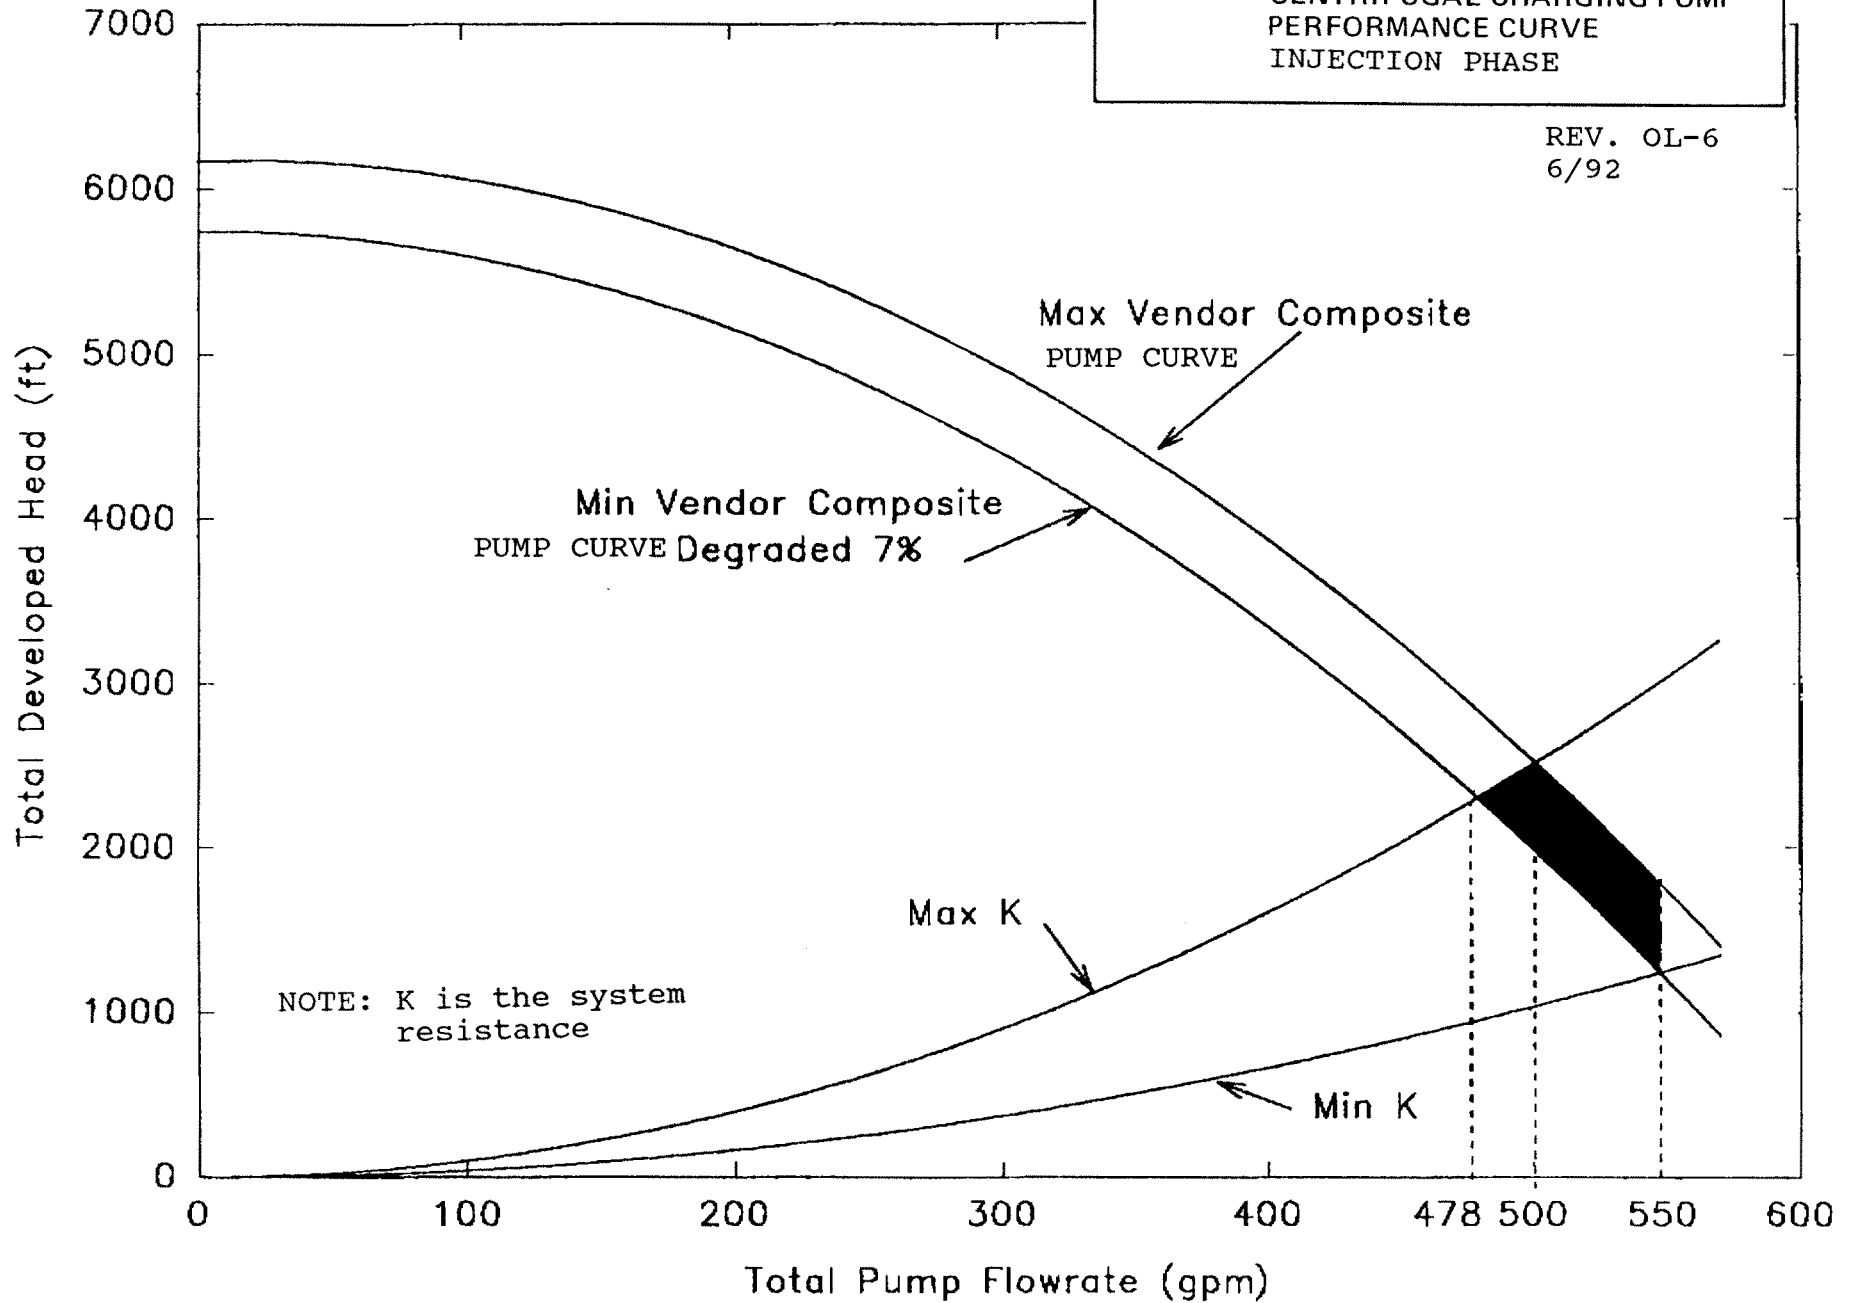



CALLAWAY PLANT

FIGURE 6.3-5

SAFETY INJECTION PUMP
PERFORMANCE CURVE
INJECTION PHASE

REV. OL-6
6/92

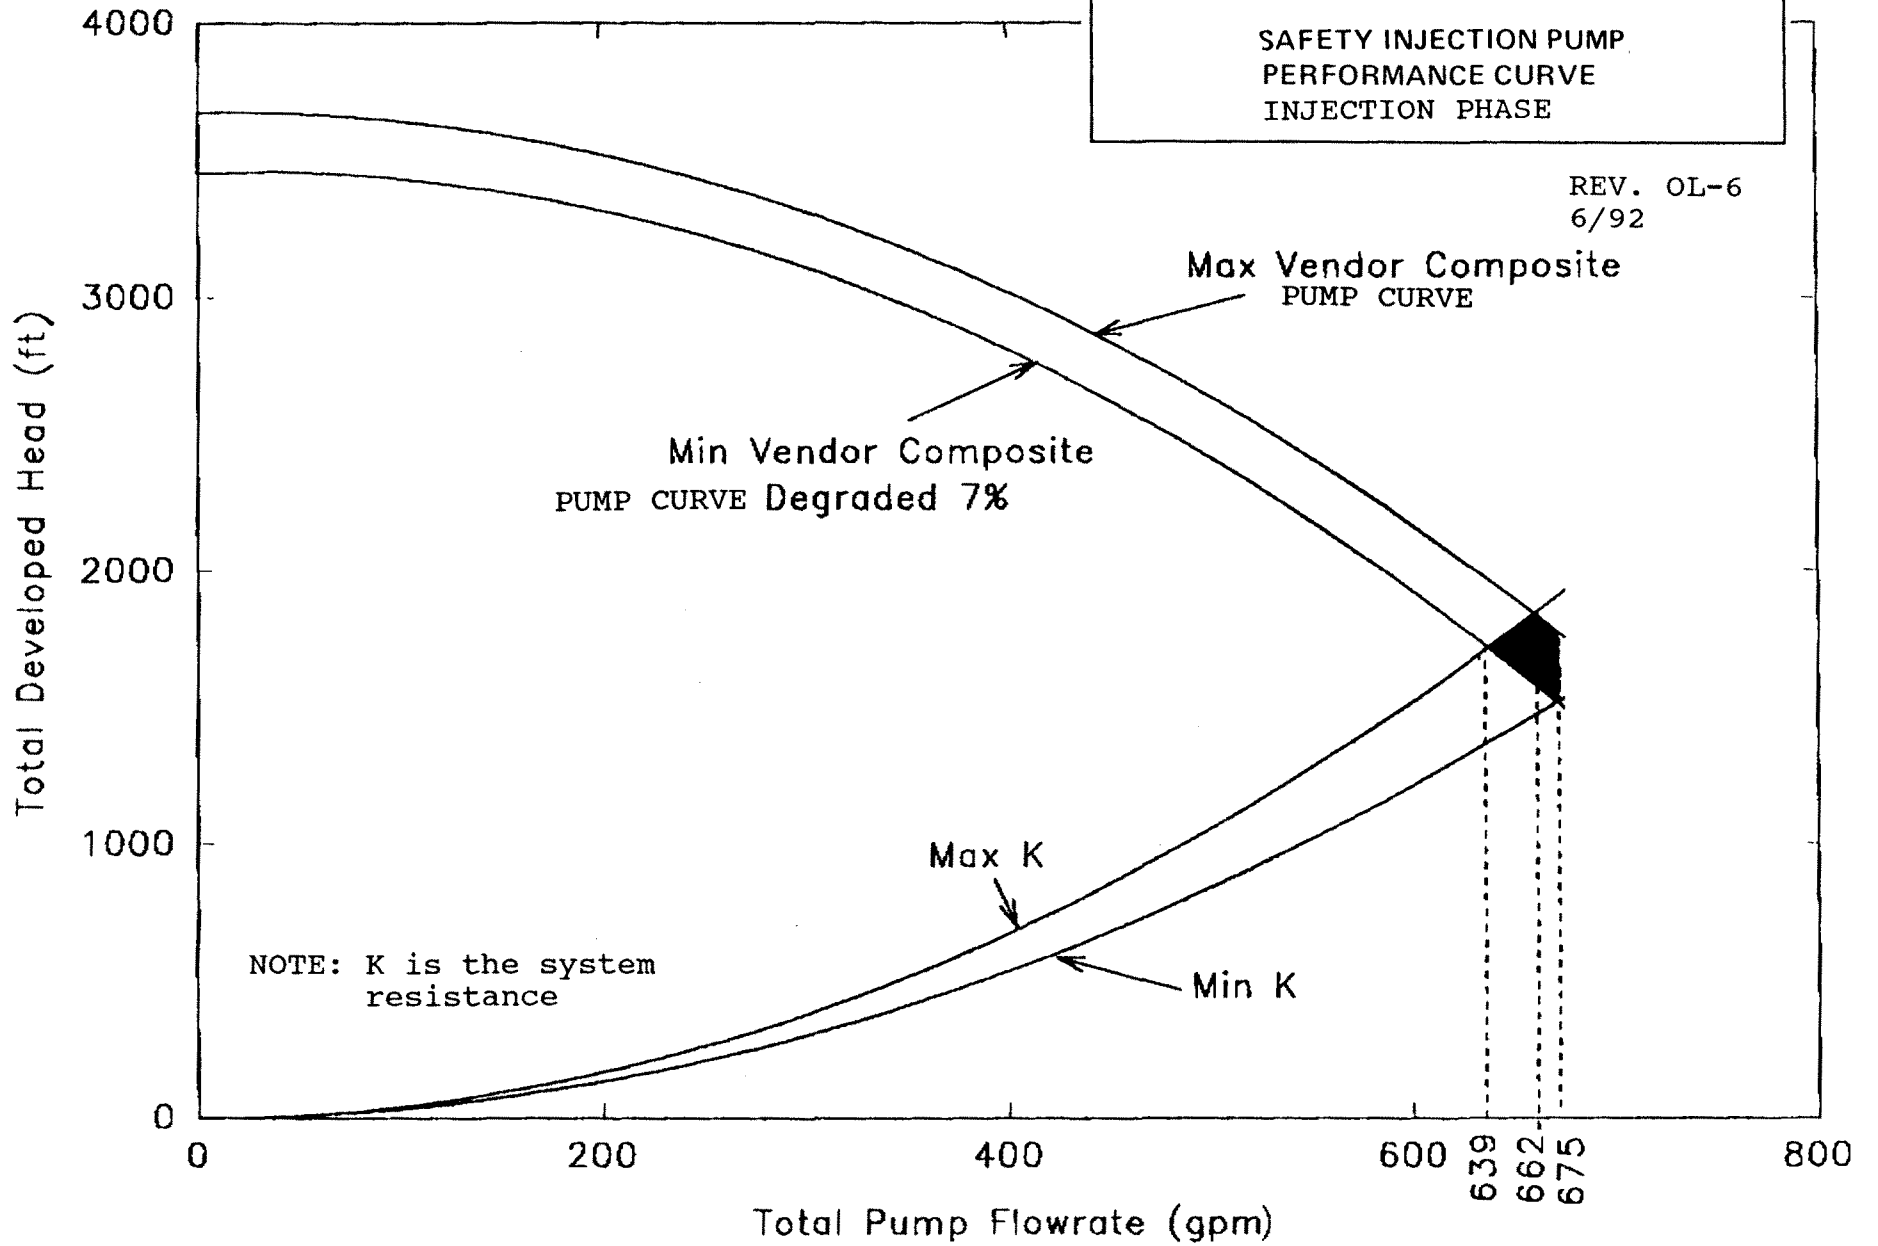


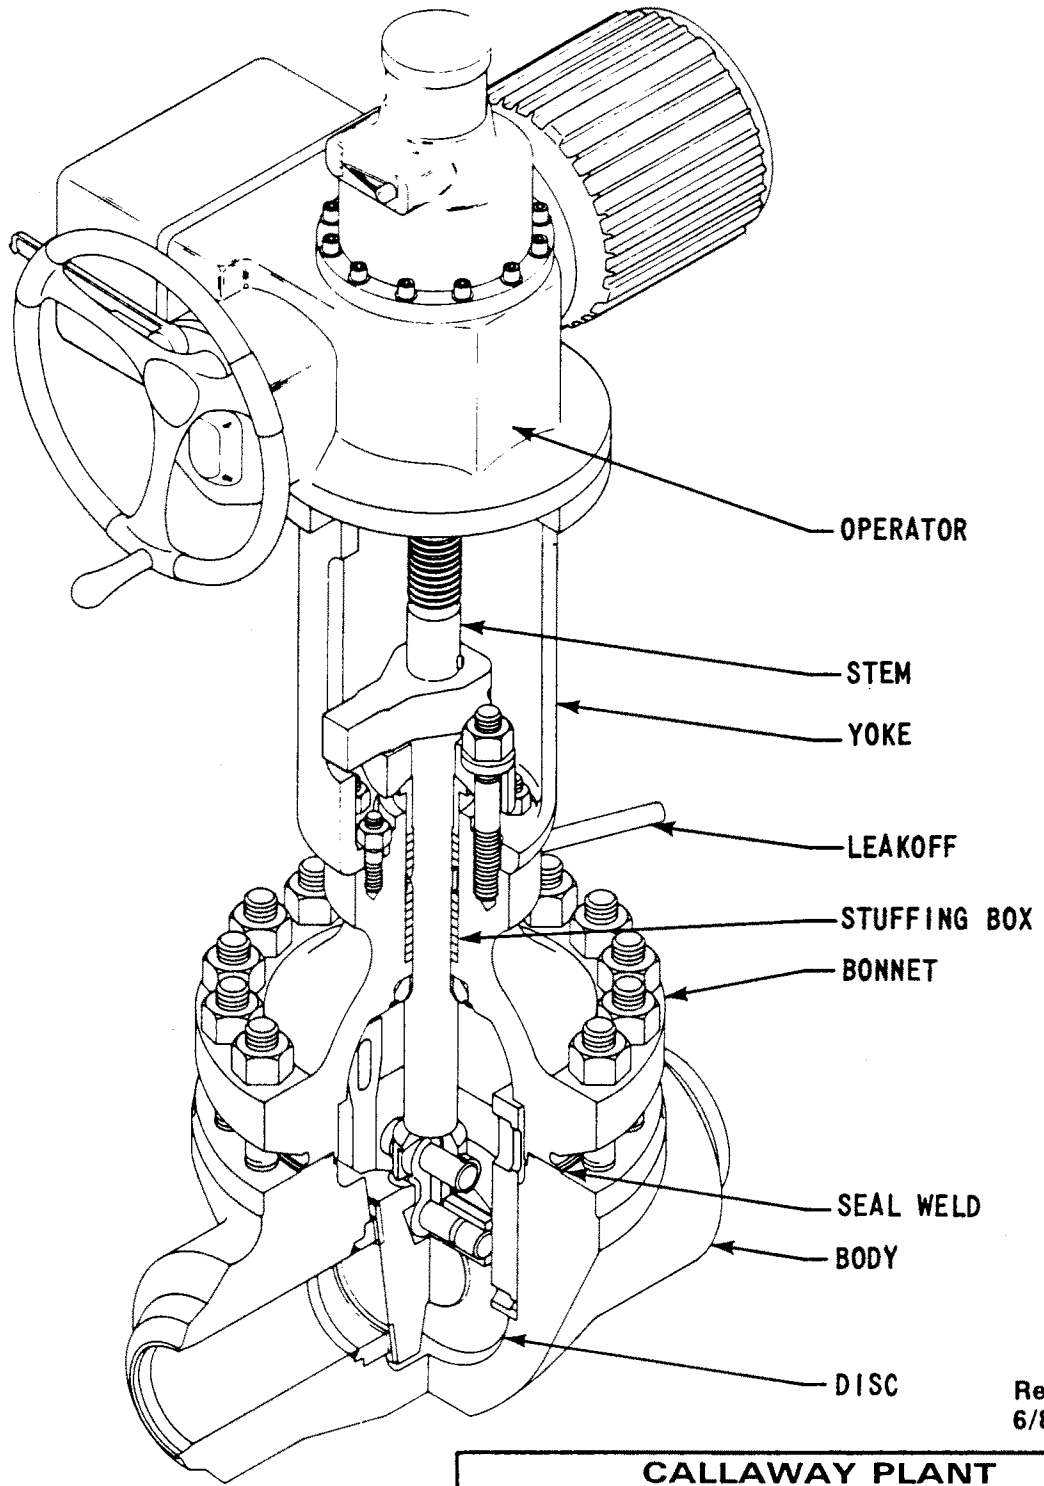

Rev. OL-0
6/86

CALLAWAY PLANT
FIGURE 6.3-6 GATE VALVE ASSEMBLY

RWST VOLUMES AND SET POINTS INFORMATION

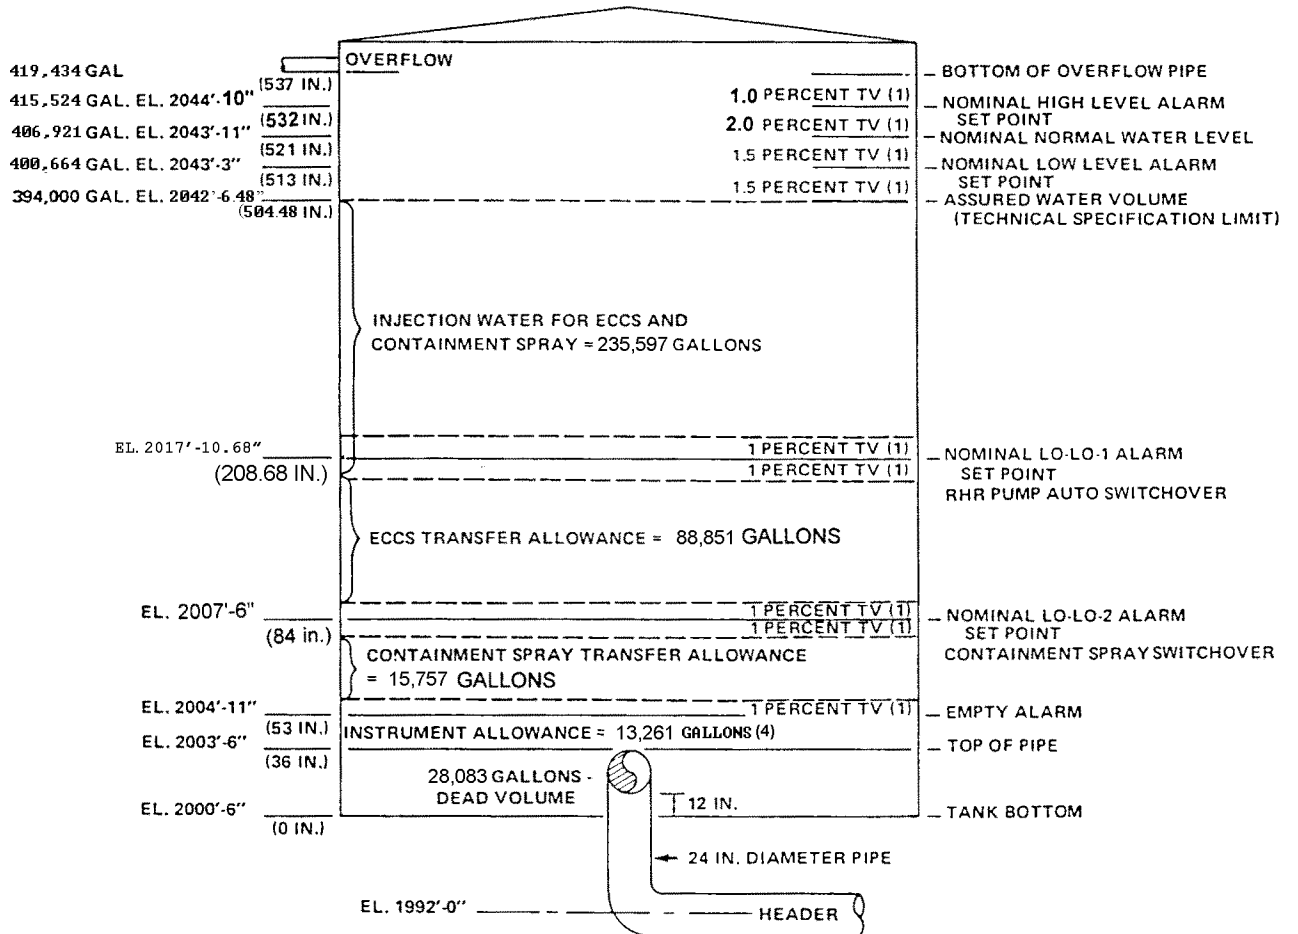

NOTES:


- 1) TANK VOLUME (TV) PERCENTS ARE BASED ON TOTAL STORED VOLUME TO OVERFLOW (0 IN. TO 537 IN.).
- 2) INSTRUMENT SPAN AND ACCURACY ARE BASED ON THE AVAILABLE VOLUME FROM THE LOWER INSTRUMENT TAP ZERO REFERENCE TO THE OVERFLOW (24 IN. TO 537 IN.).
- 3) TANK VOLUME (GAL./FT.) can be found in calculation M-FL-18.
- 4) Instrument allowance includes level required to preclude air ingestion due to vortexing. See Calculation BN-24.

CALLAWAY PLANT

FIGURE 6.3-7

RWST LEVELS AND VOLUMES

REV. 13 9/07

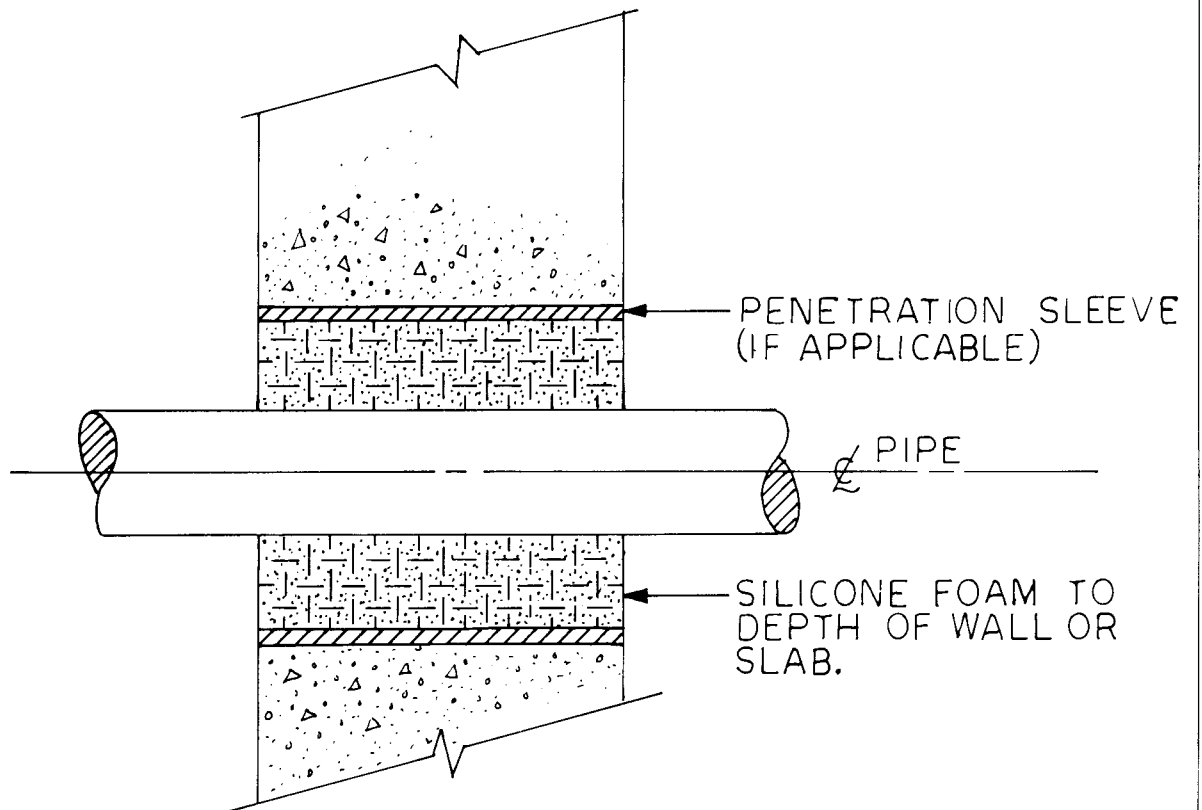


Rev. OL-0
6/86

CALLAWAY PLANT

FIGURE 6.4-1
SHEET 1


TYPICAL DETAIL
SEALING OF PIPING PENETRATION
THROUGH CONT. RM. FL. OR WALL

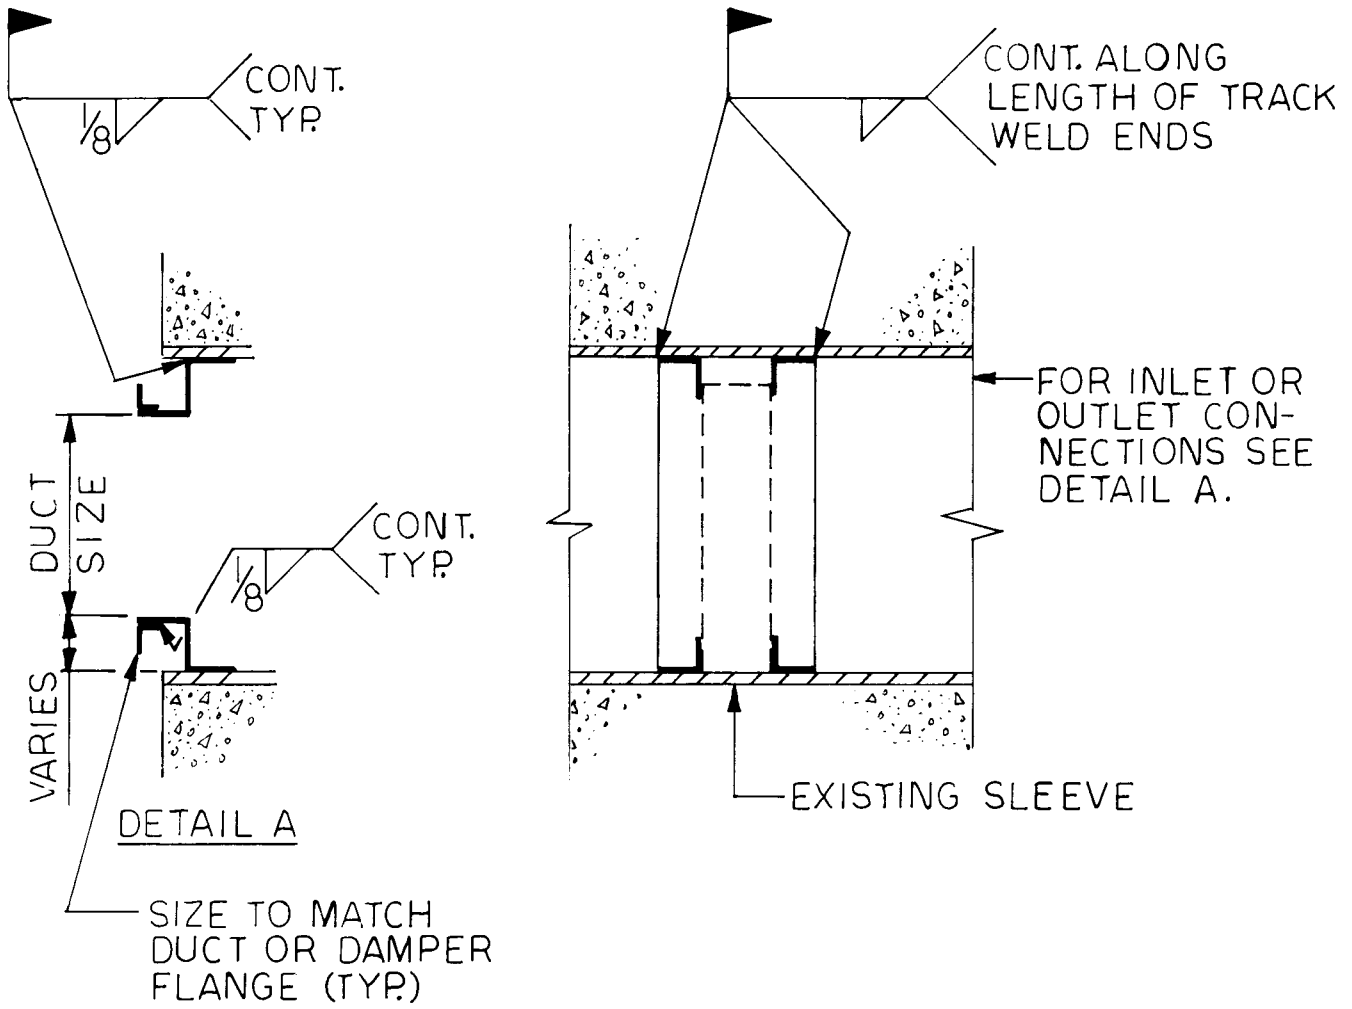

Rev. OL-0
6/86

CALLAWAY PLANT

FIGURE 6.4-1
SHEET 2
TYPICAL DETAIL
SEALING OF DUCTWORK PENET.
THROUGH CONT. RM. FL. OR WALL

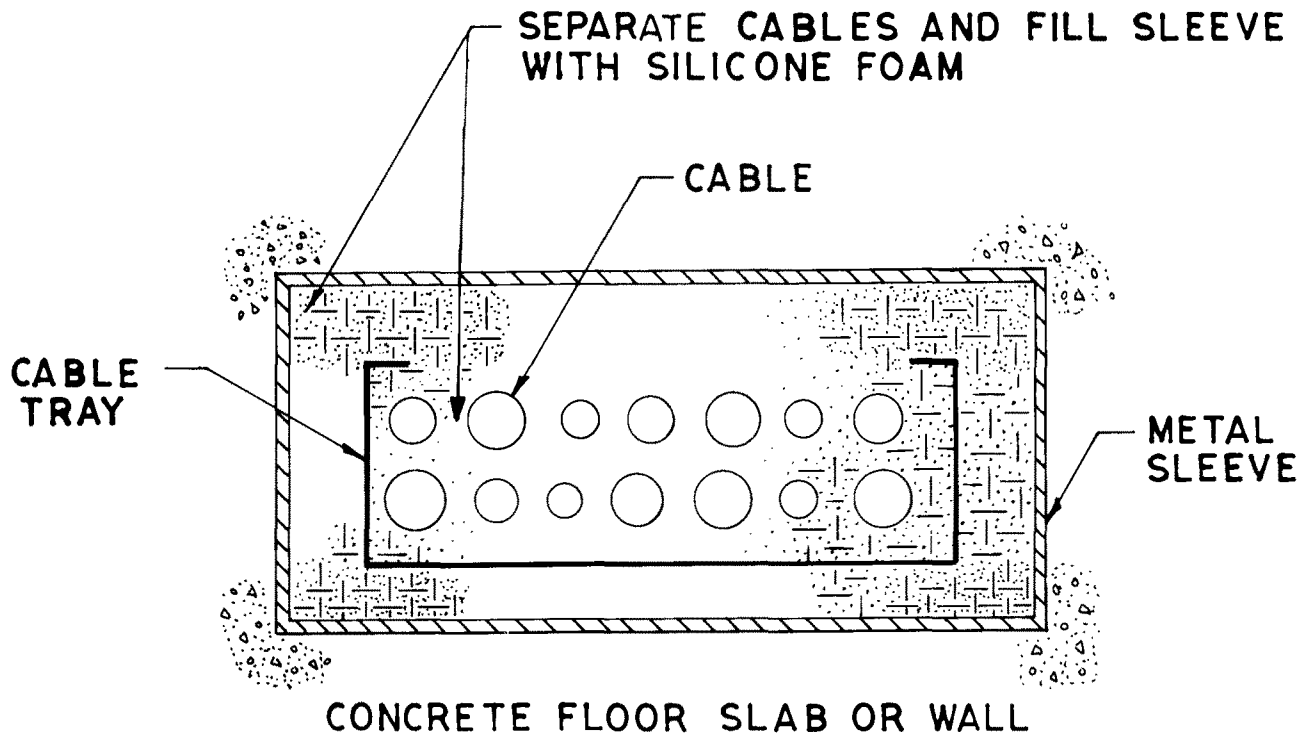


Rev. OL-0
6/86

CALLAWAY PLANT

FIGURE 6.4-1
SHEET 3


TYPICAL DETAIL
SEALING OF CABLE TRAY PENET.
THROUGH CONT. RM. FL. OR WALL

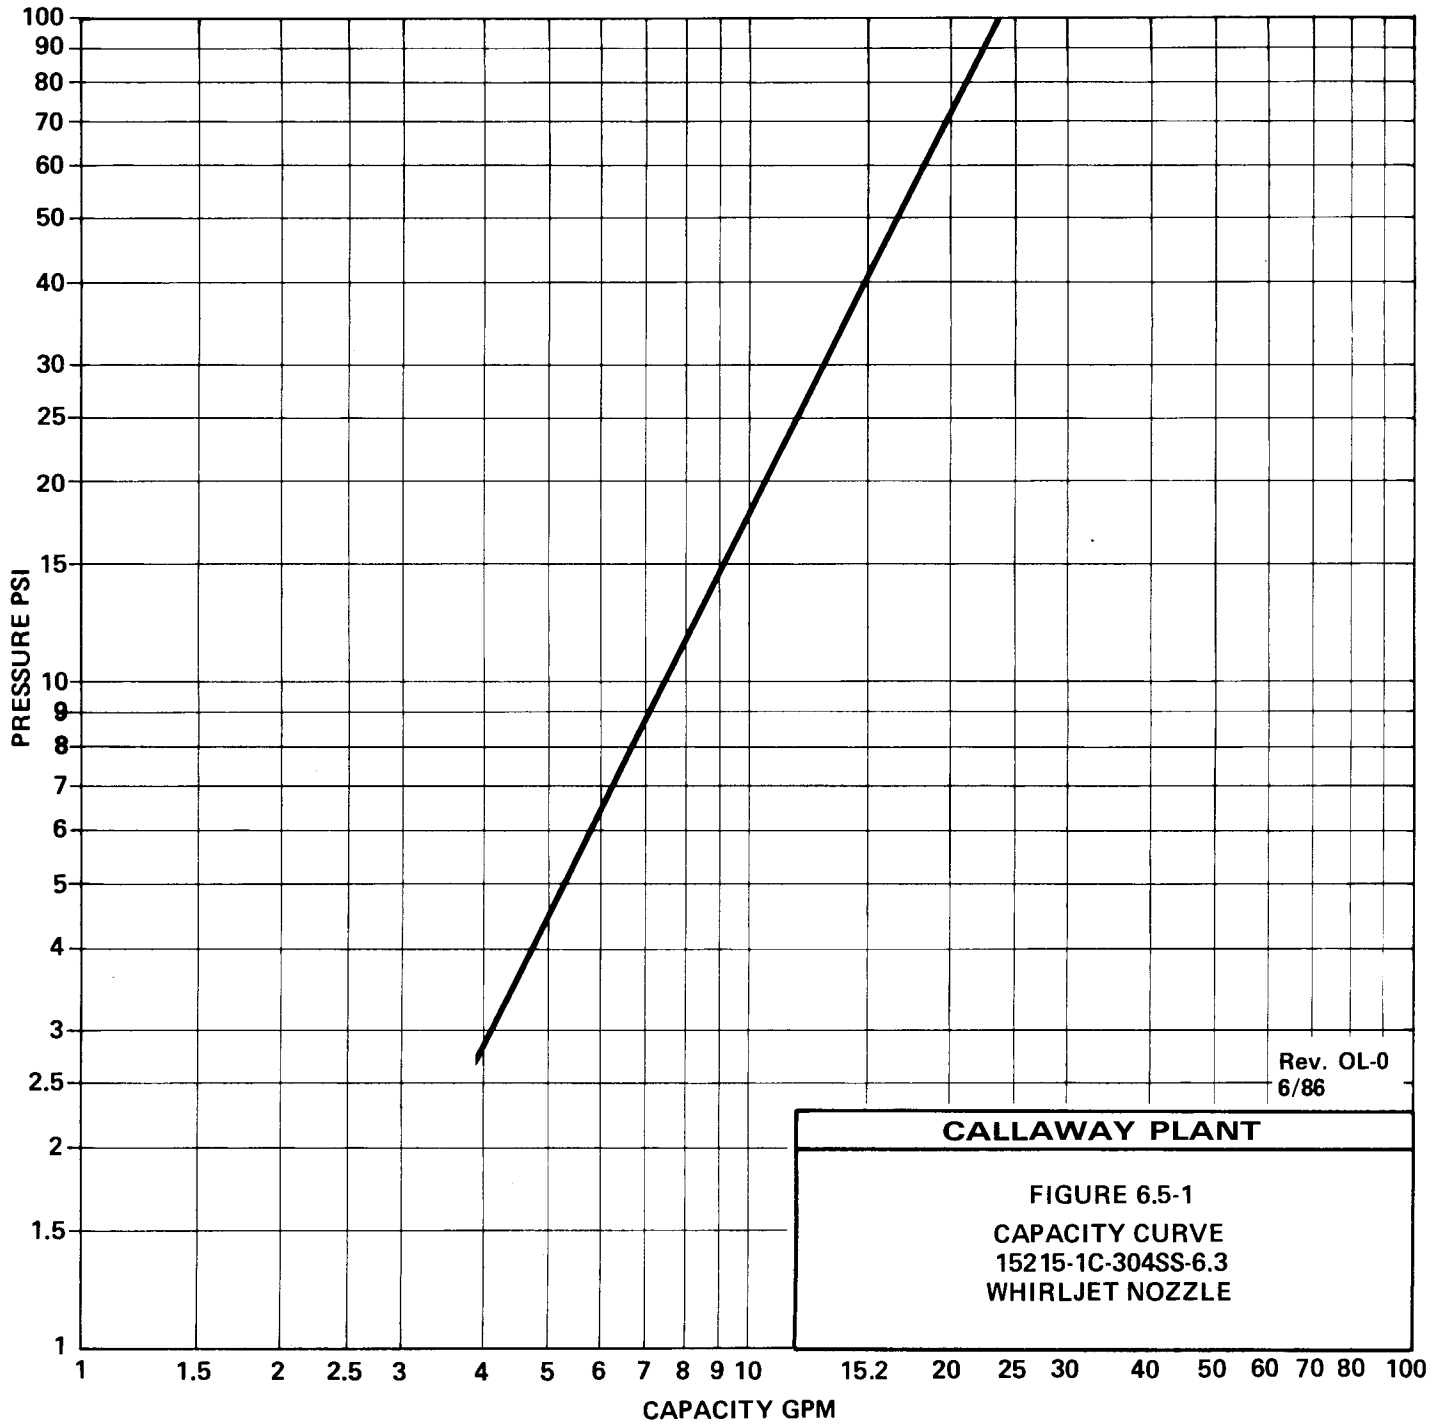


Rev. OL-0
6/86

CALLAWAY PLANT

**FIGURE 6.5-1
CAPACITY CURVE
15215-1C-304SS-6.3
WHIRLJET NOZZLE**

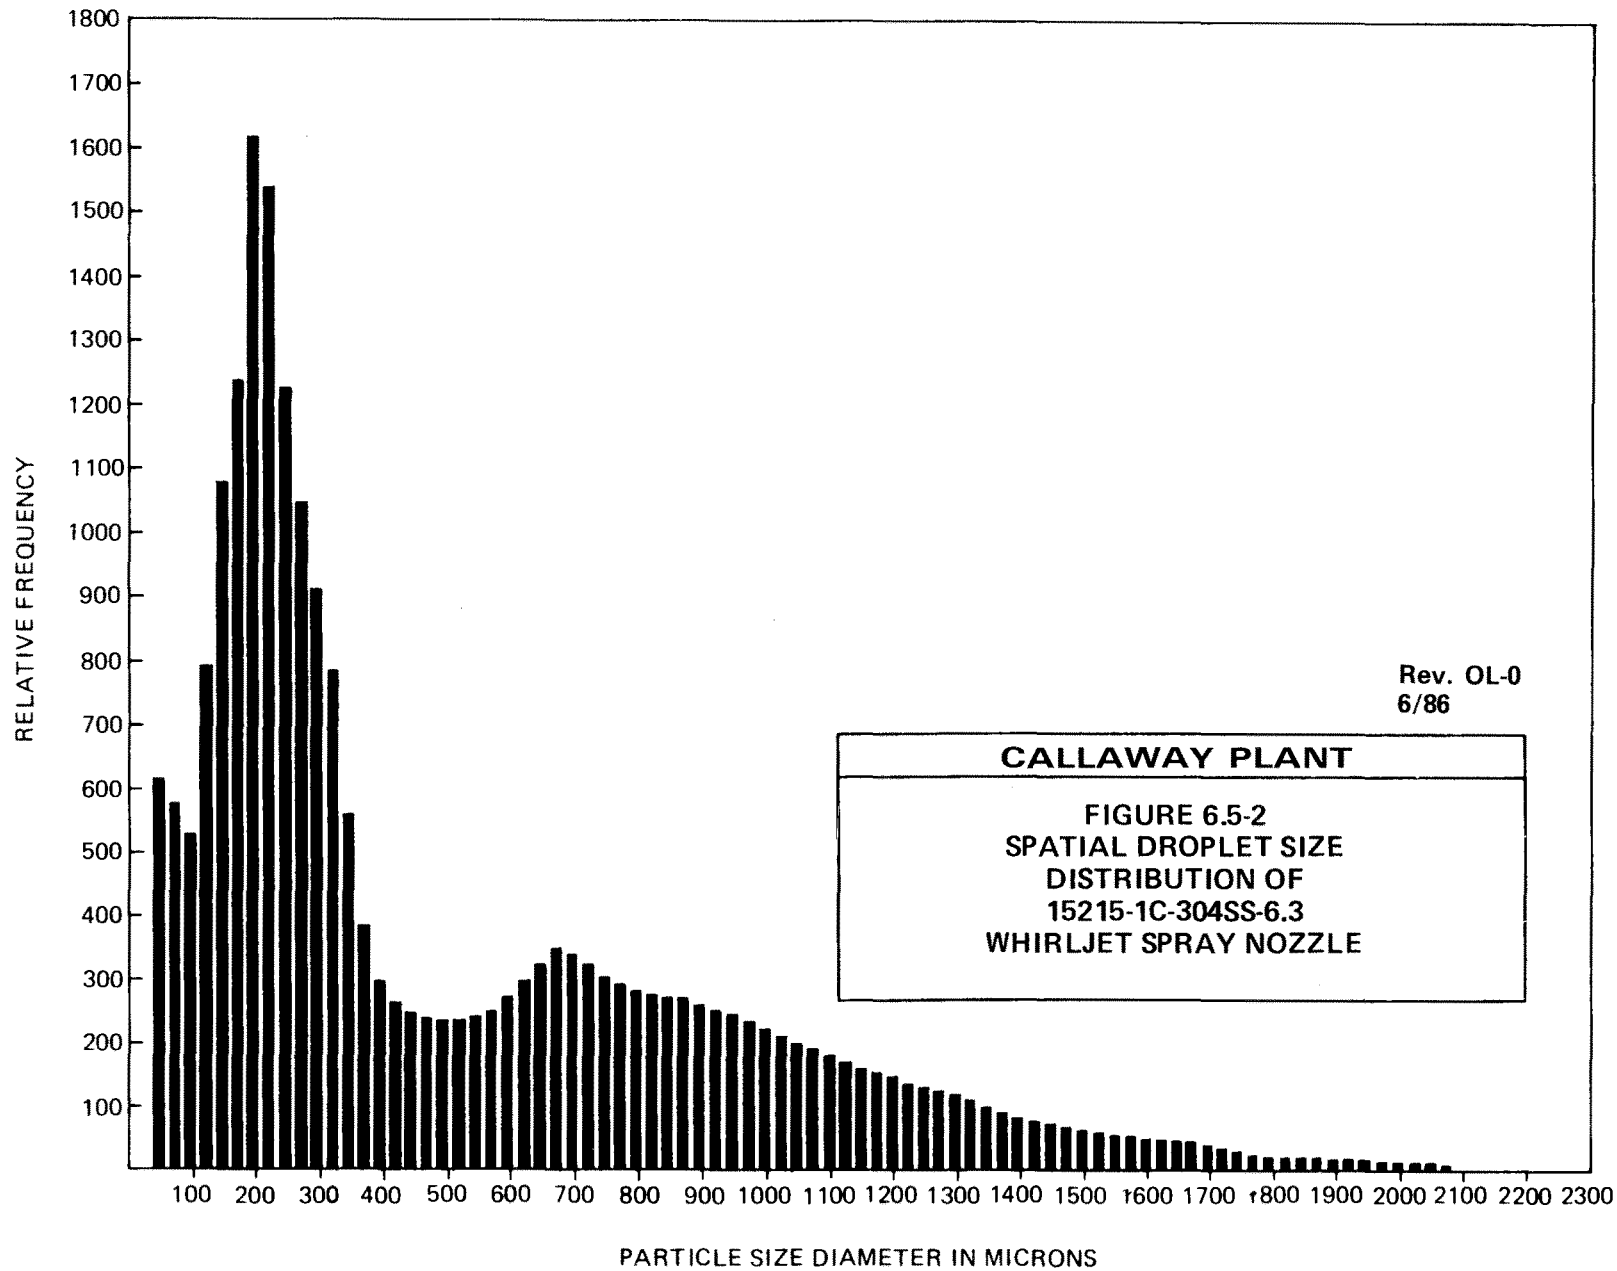


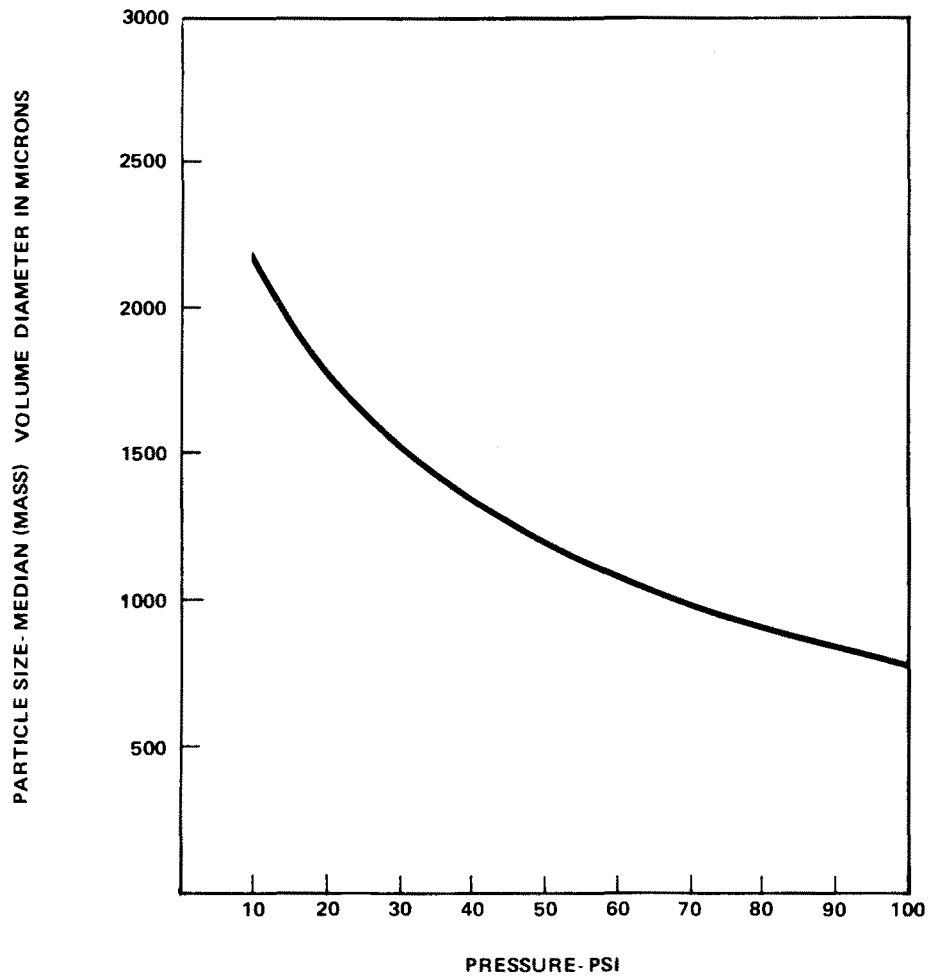

Rev. OL-0
6/86

CALLAWAY PLANT

**FIGURE 6.5-3
PARTICLE SIZE
VS.
PRESSURE
15215-1C-304-SS-6.3
WHIRLJET SPRAY NOZZLE**

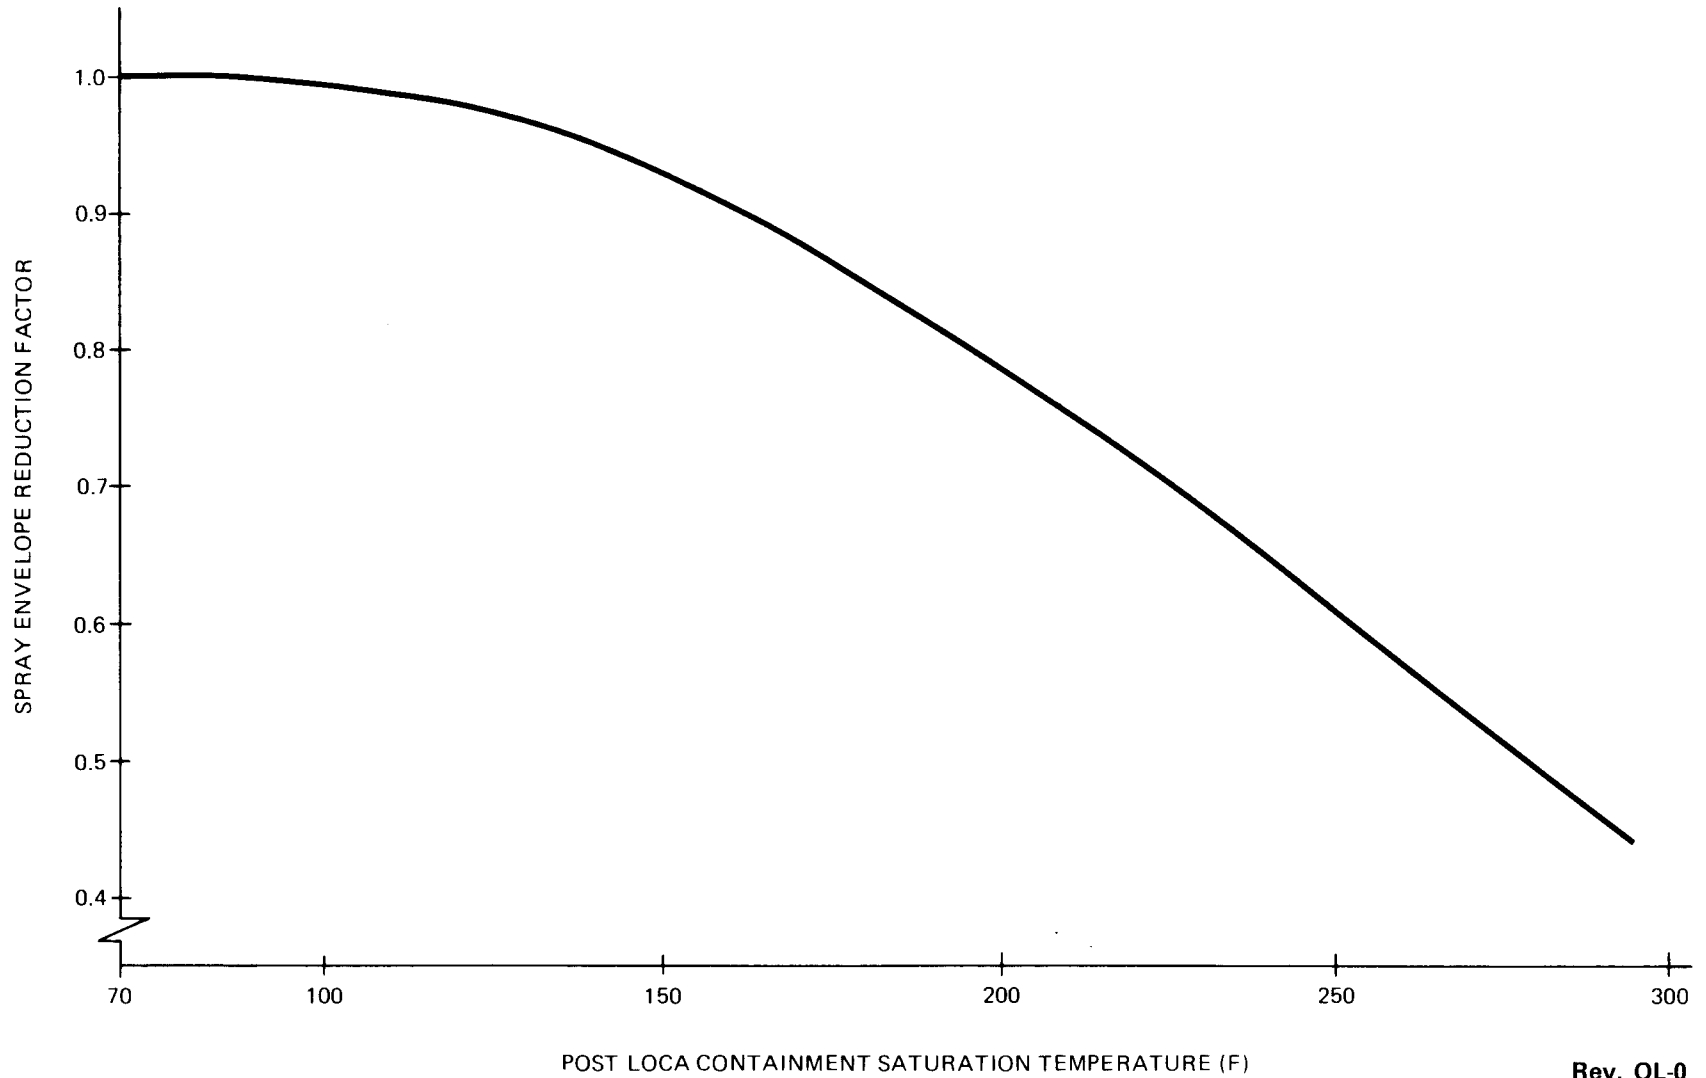

Rev. OL-0
6/86


CALLAWAY PLANT

**FIGURE 6.5-4
SPRAY ENVELOPE
REDUCTION FACTOR**


CALLAWAY - SP

FIGURE 6.5-5 HAS BEEN DELETED


Rev. OL-8
11/95

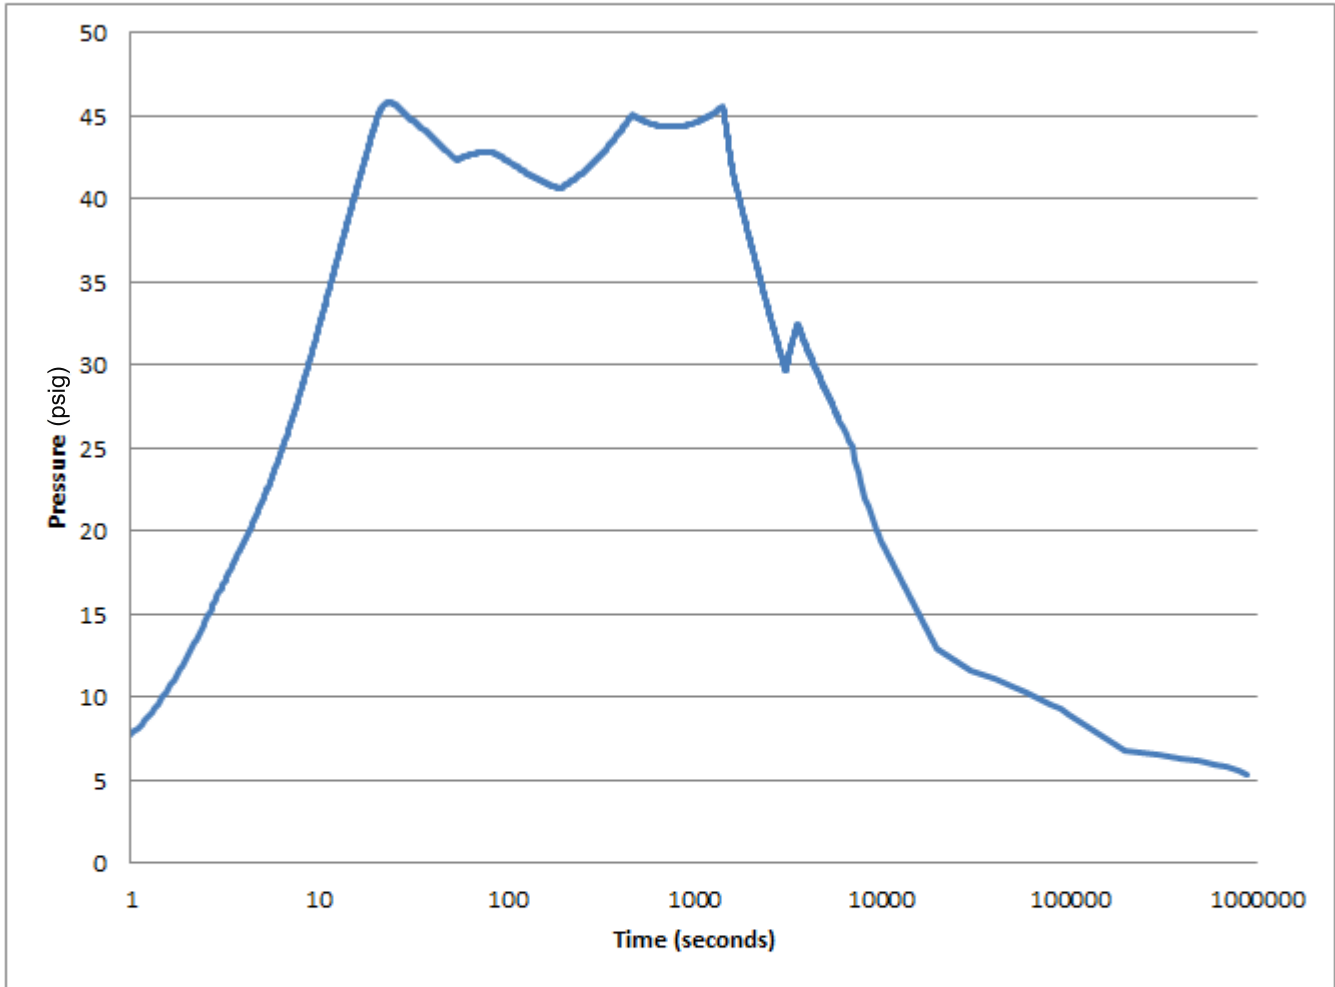

CALLAWAY PLANT
FIGURE 6.2.1-1
DOUBLE-ENDED PUMP SUCTION GUILLOTINE BREAK
MINIMUM SAFEGUARDS
CONTAINMENT PRESSURE VS. TIME
REV. 17 10/13

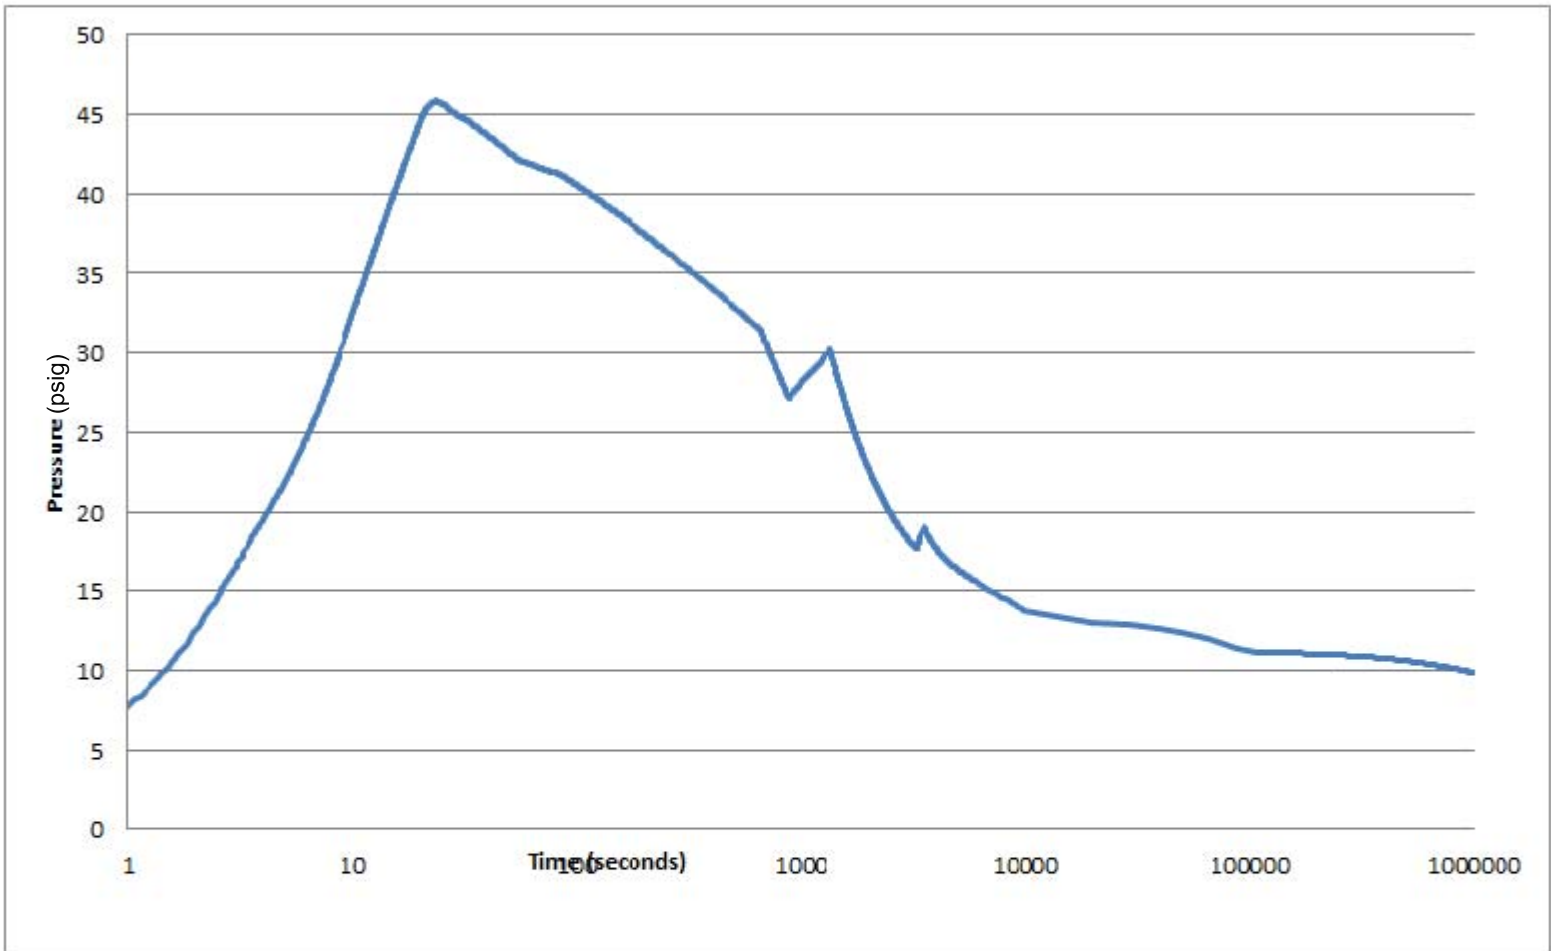

CALLAWAY PLANT
FIGURE 6.2.1-2
DOUBLE-ENDED PUMP SUCTION GUILLOTINE BREAK
MAXIMUM SAFEGUARDS
CONTAINMENT PRESSURE VS. TIME
 REV. 17 10/13

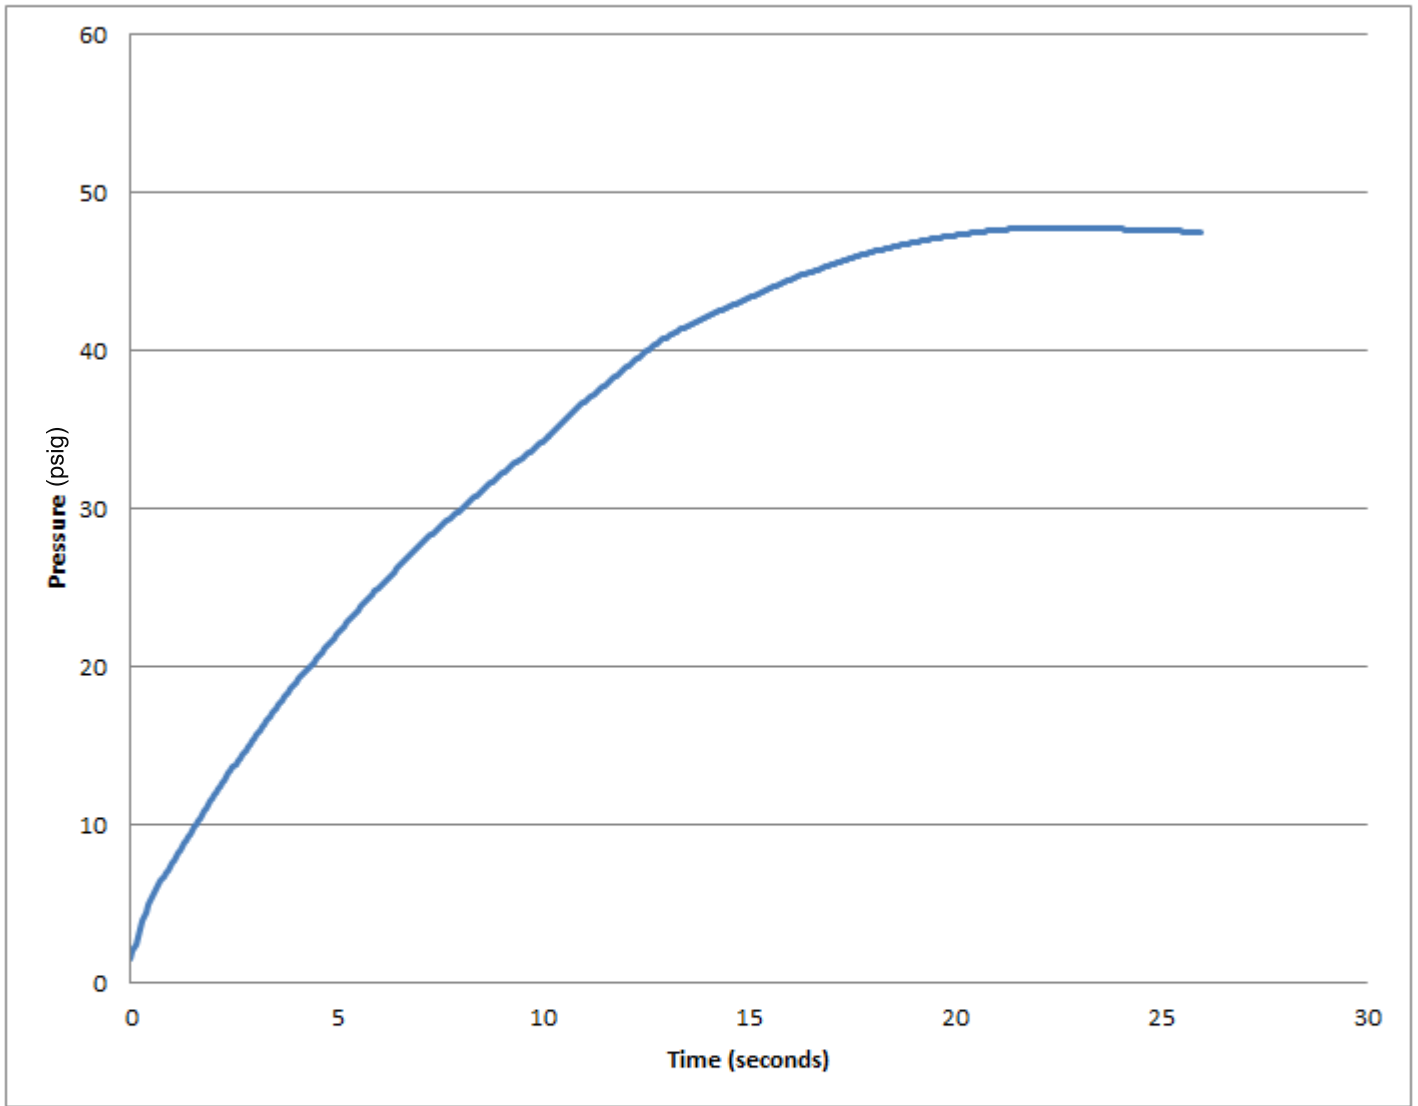


CALLAWAY PLANT


FIGURE 6.2.1-3

**DOUBLE-ENDED HOT LEG GUILLOTINE BREAK
CONTAINMENT PRESSURE VS. TIME**

REV. 17 10/13

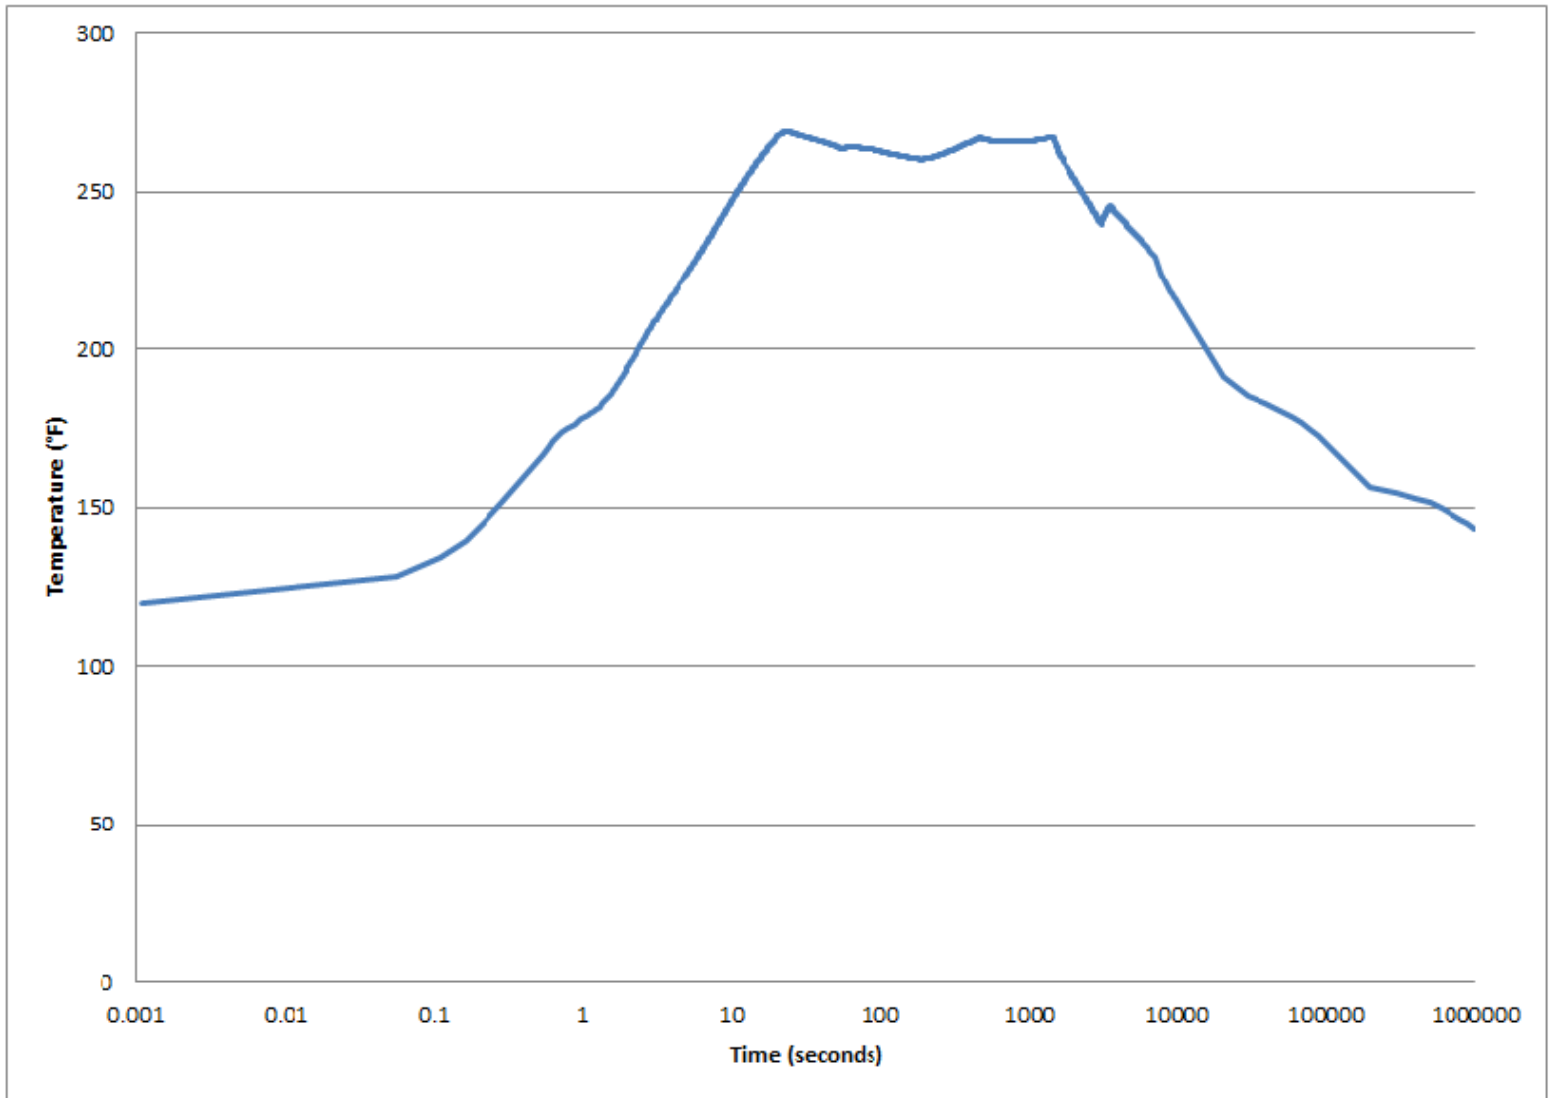

CALLAWAY PLANT
FIGURE 6.2.1-4
DOUBLE-ENDED PUMP SUCTION GUILLOTINE BREAK
MINIMUM SAFEGUARDS
CONTAINMENT TEMPERATURE VS. TIME
REV. 17 10/13

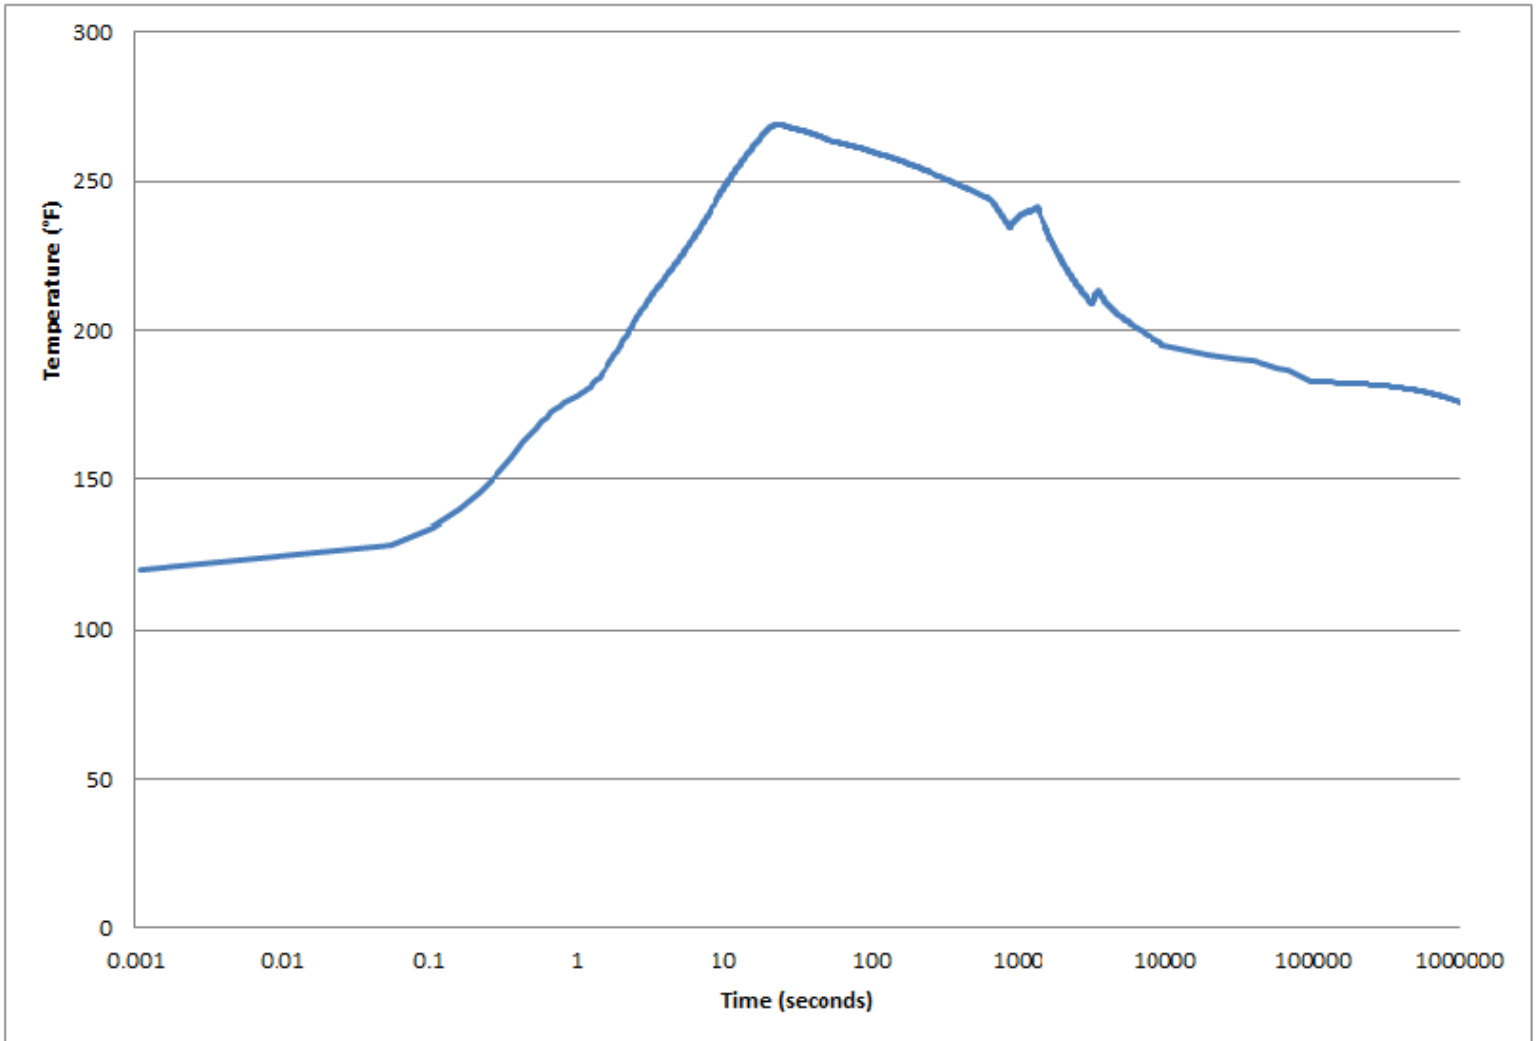


CALLAWAY PLANT


FIGURE 6.2.1-5

**DOUBLE-ENDED PUMP SUCTION GUILLOTINE BREAK
MAXIMUM SAFEGUARDS
CONTAINMENT TEMPERATURE VS. TIME**


REV. 17 10/13

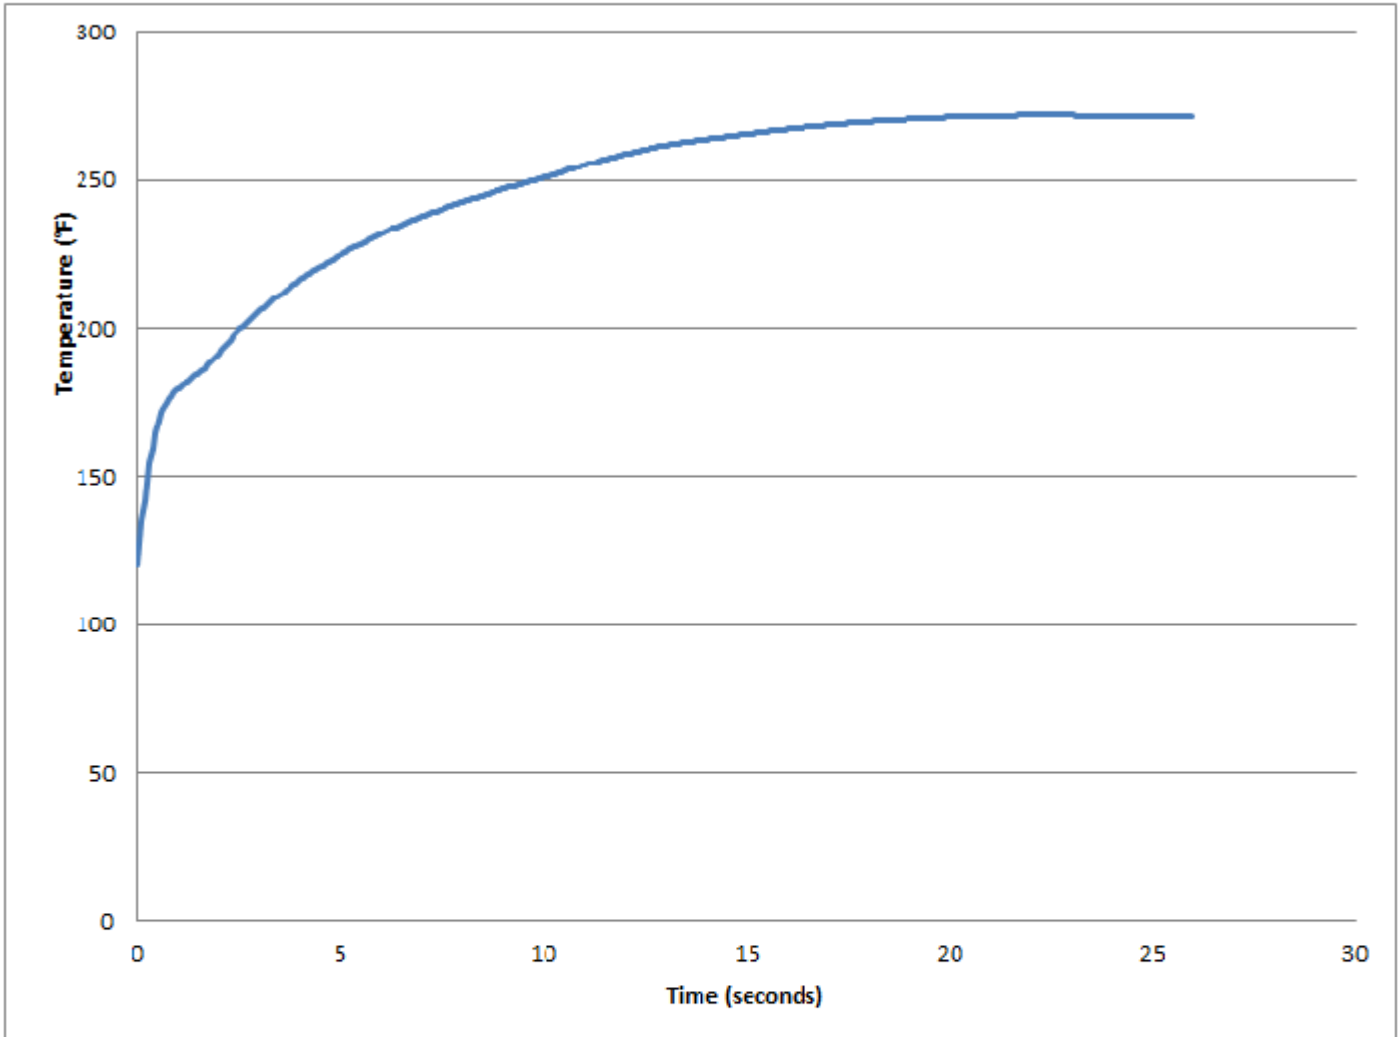

CALLAWAY PLANT
FIGURE 6.2.1-6
DOUBLE-ENDED HOT LEG GUILLOTINE BREAK
CONTAINMENT TEMPERATURE VS. TIME
REV. 17 10/13

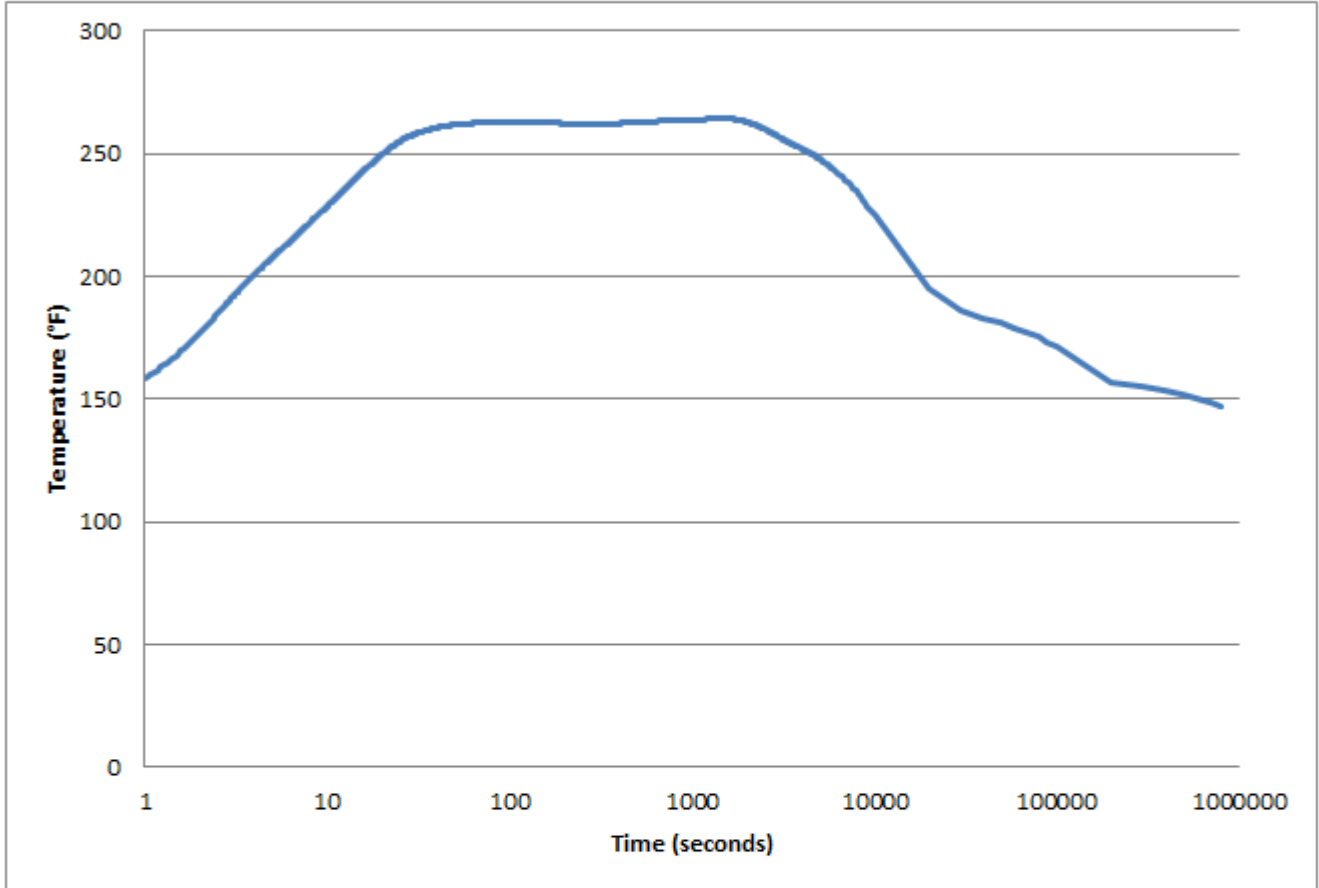

CALLAWAY PLANT
FIGURE 6.2.1-7
DOUBLE-ENDED PUMP SUCTION GUILLOTINE BREAK
MINIMUM SAFEGUARDS
CONTAINMENT SUMP TEMPERATURE VS. TIME
REV. 17 10/13

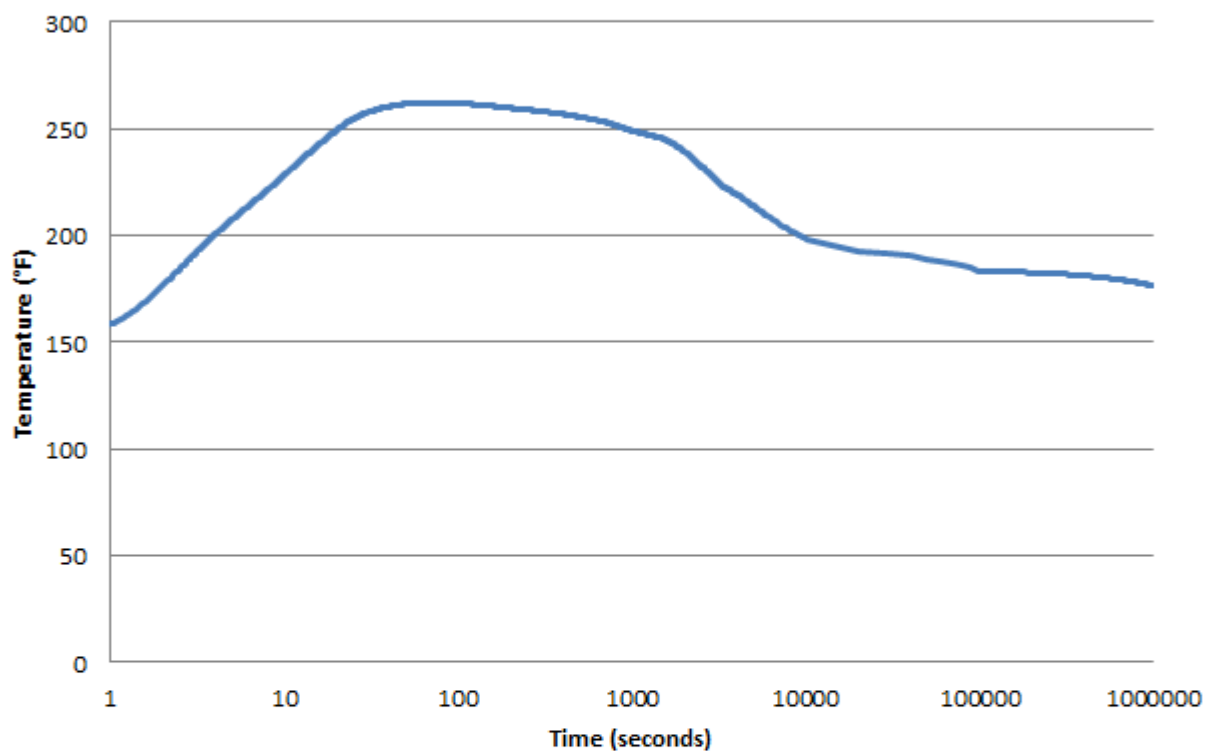

CALLAWAY PLANT

FIGURE 6.2.1-8

DOUBLE-ENDED PUMP SUCTION GUILLOTINE BREAK
MAXIMUM SAFEGUARDS
CONTAINMENT SUMP TEMPERATURE VS. TIME


REV. 17 10/13

Figure 6.2.1-9 Deleted

Figure 6.2.1-10 Deleted

Figure 6.2.1-11 Deleted


Figure 6.2.1-12 Deleted

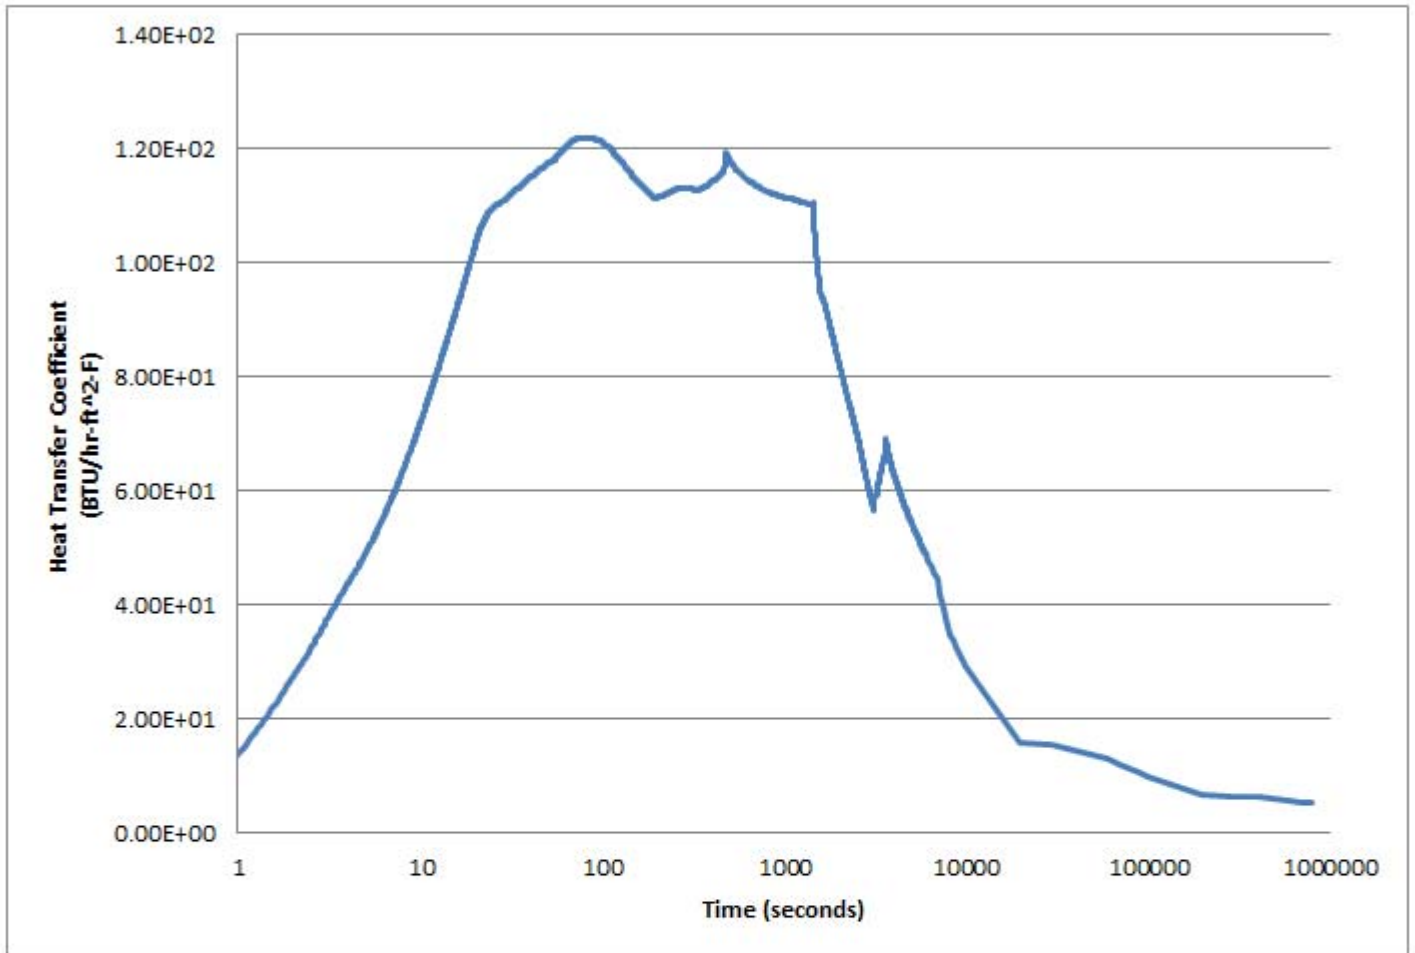

CALLAWAY PLANT

FIGURE 6.2.1-13

Double-Ended Pump Suction Guillotine Break
 Minimum Safeguards
 Condensing Heat Transfer Coefficient vs. Time
 REV. 16 10/13

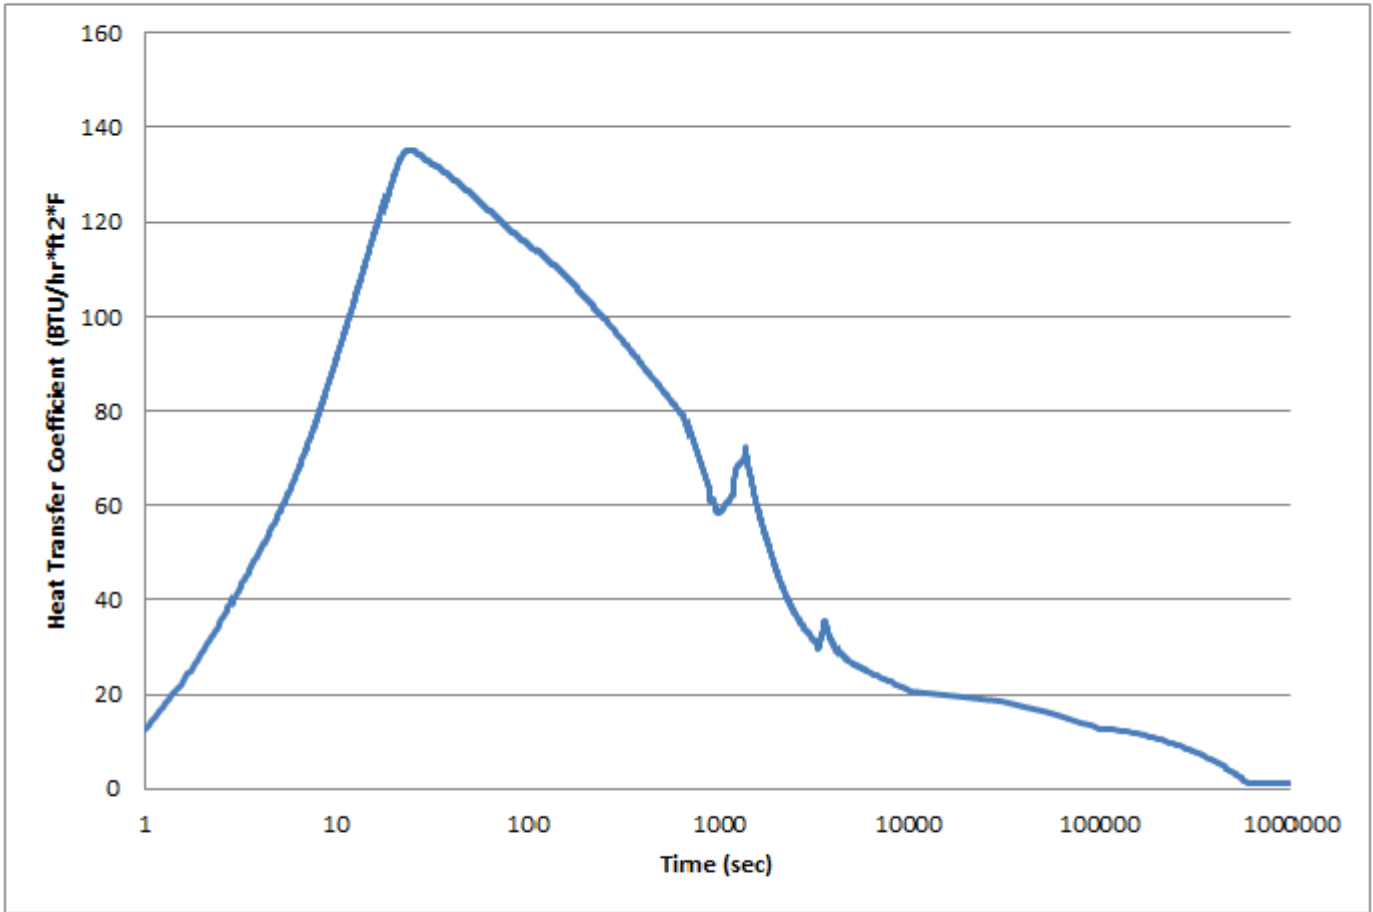


CALLAWAY PLANT


FIGURE 6.2.1-14

Double-Ended Pump Suction Guillotine Break
 Maximum Safeguards
 Condensing Heat Transfer Coefficient vs. Time

REV. 16 10/13

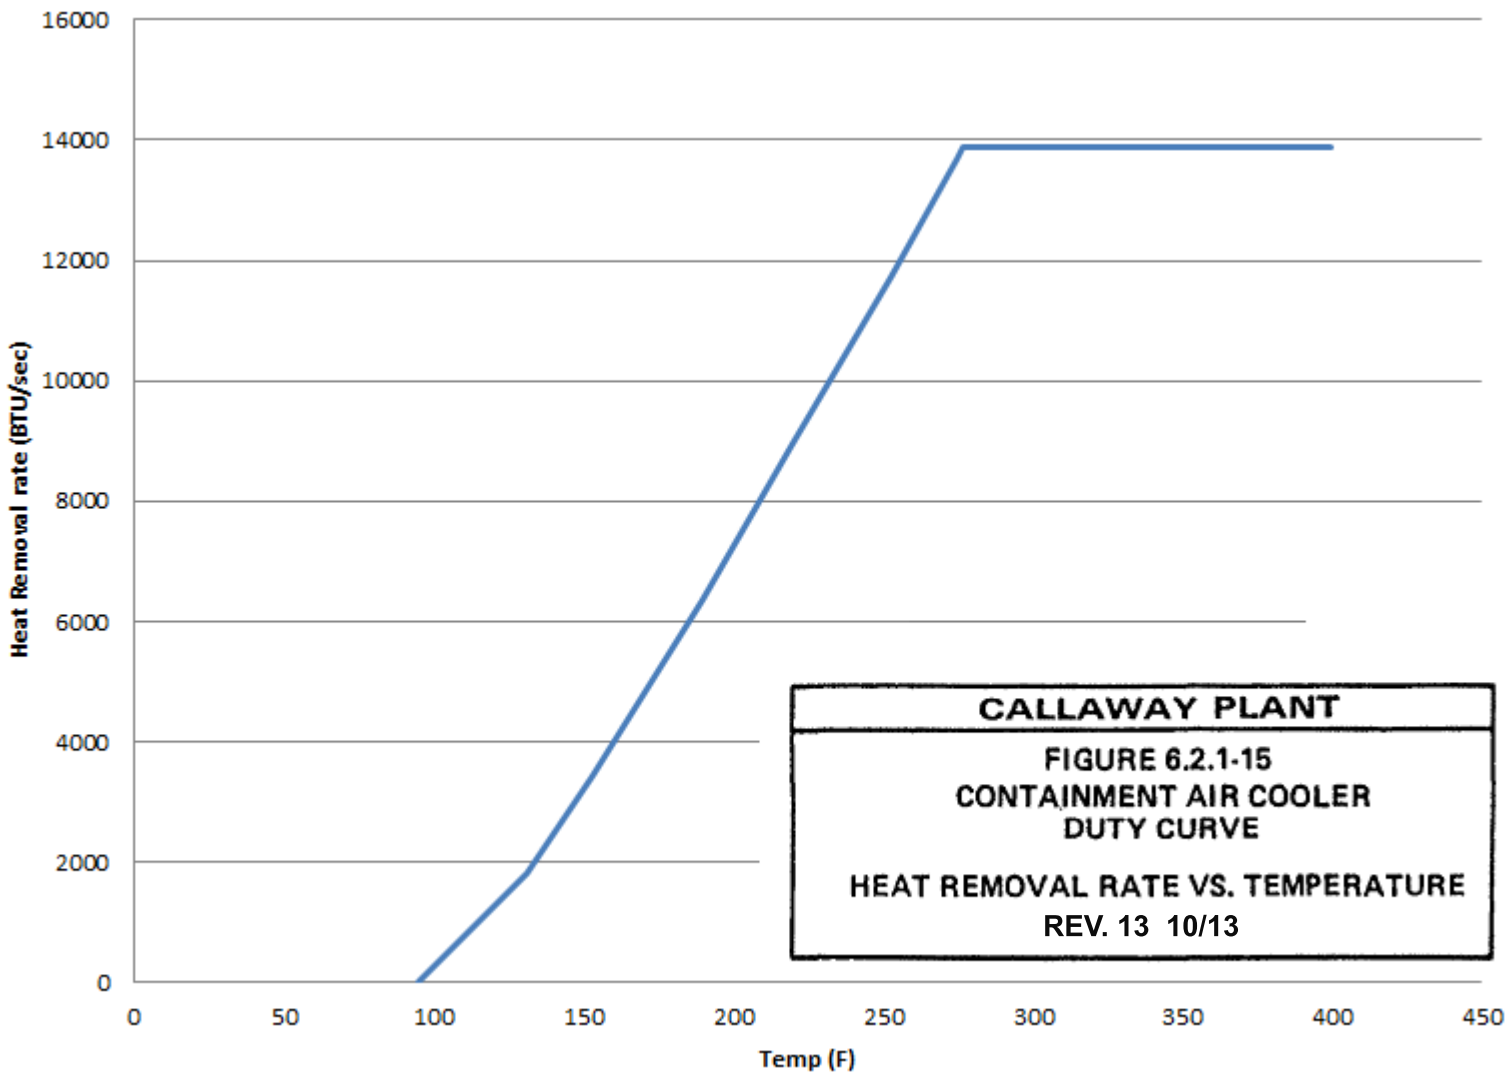

CALLAWAY PLANT
FIGURE 6.2.1-15
CONTAINMENT AIR COOLER
DUTY CURVE
HEAT REMOVAL RATE VS. TEMPERATURE
REV. 13 10/13

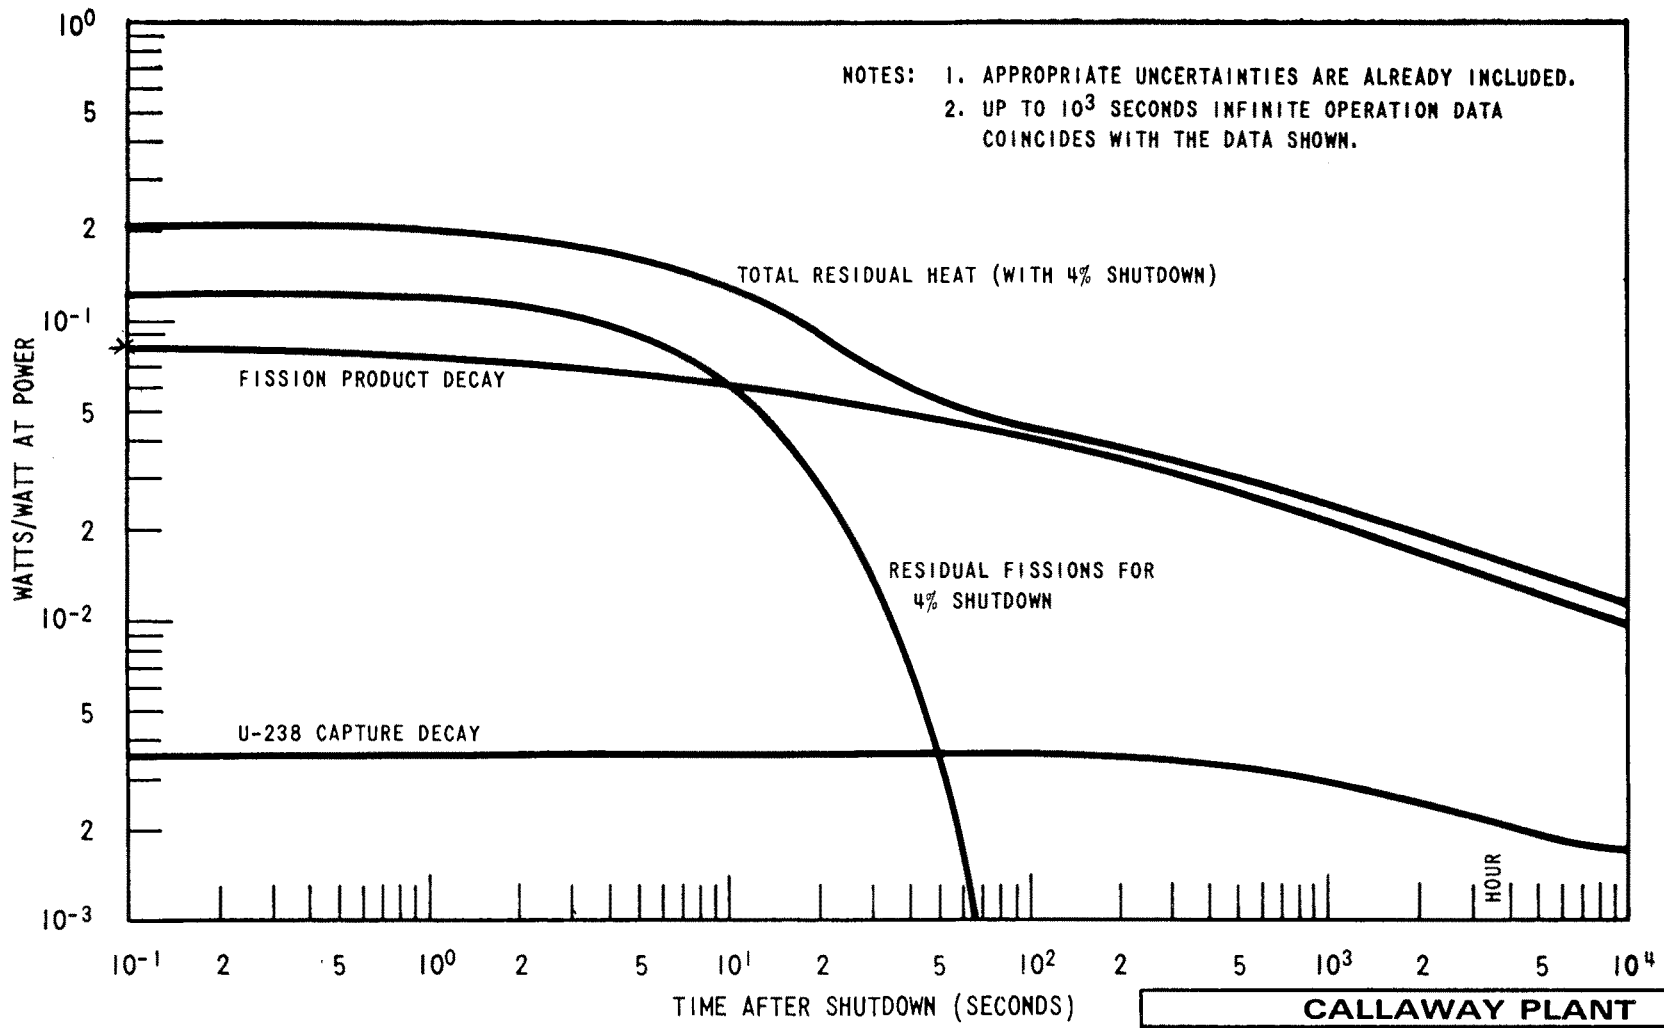


Rev. OL-0
6/86

CALLAWAY PLANT

FIGURE 6.2.1-16

REACTOR DECAY POWER

SHEET 1

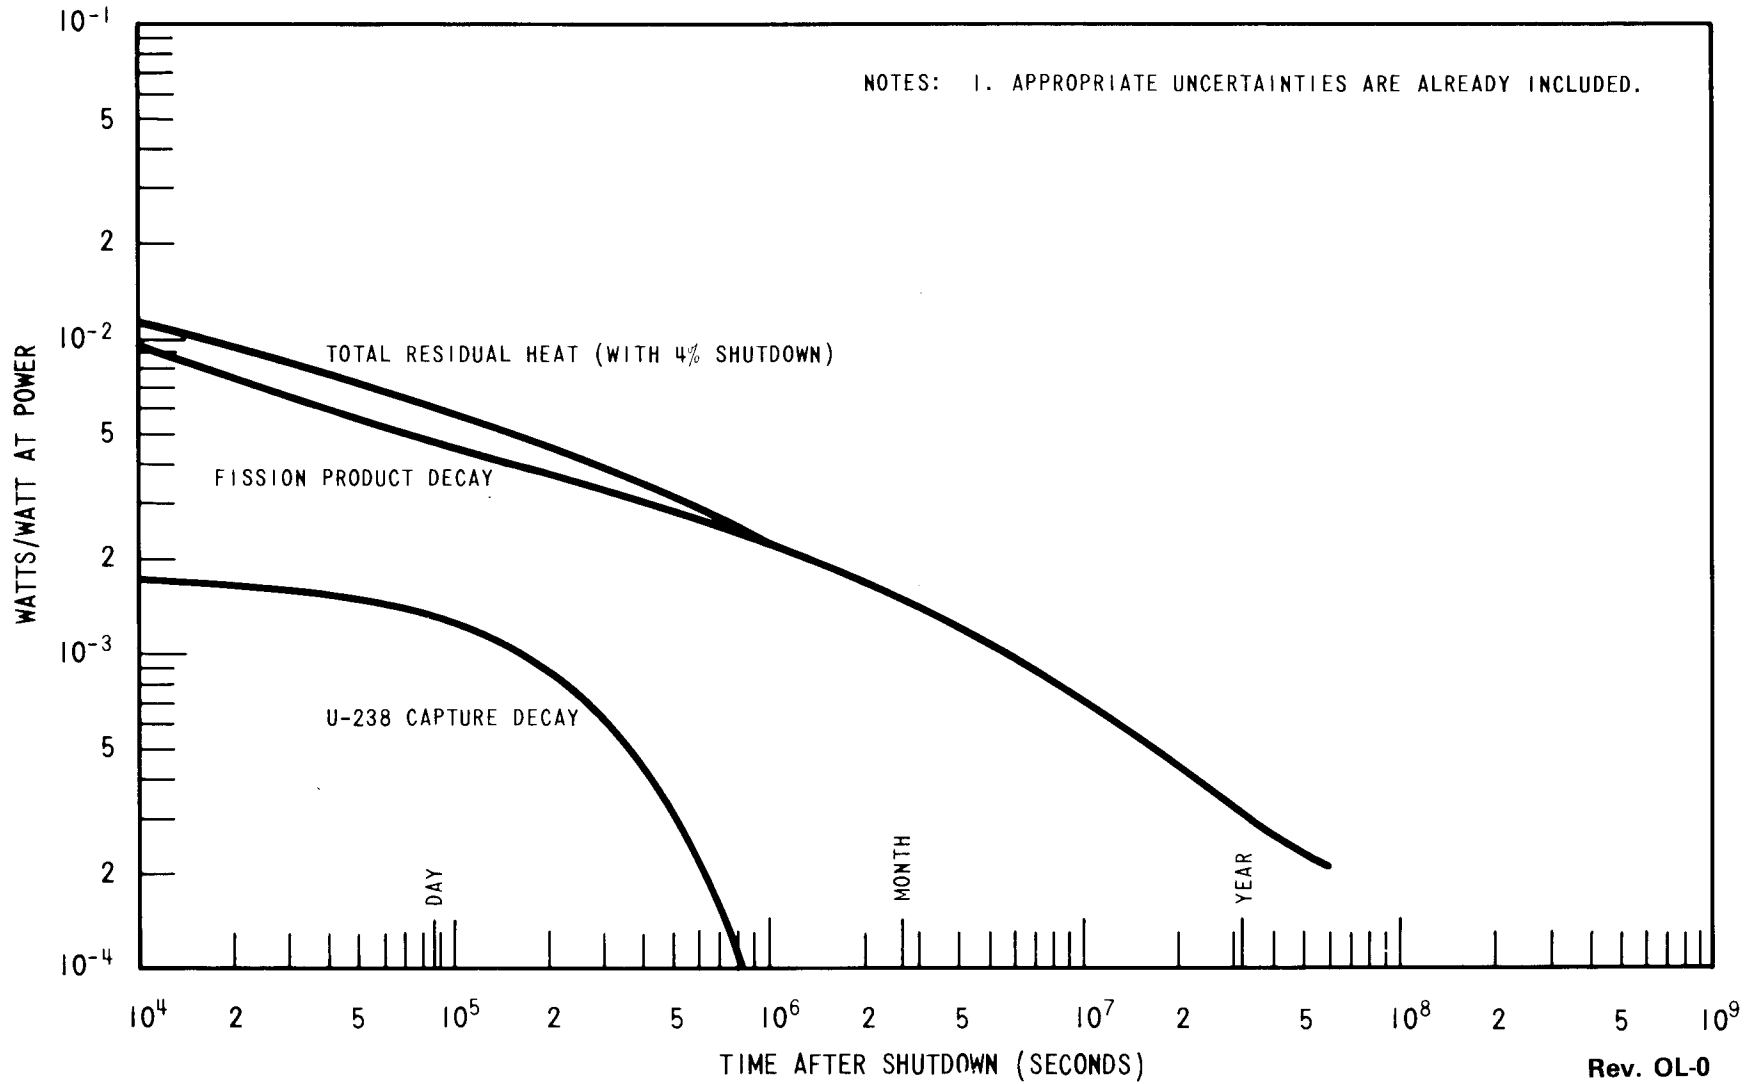

Rev. OL-0
6/86

CALLAWAY PLANT

FIGURE 6.2.1-16

REACTOR DECAY POWER

SHEET 2

Figure 6.2.1-17 Deleted

Figure 6.2.1-18 Deleted

Figure 6.2.1-19 Deleted

Figure 6.2.1-20 Deleted

Figure 6.2.1-21 Deleted

Figure 6.2.1-22 Deleted

Figure 6.2.1-23 Deleted

Figure 6.2.1-24 Deleted

Figure 6.2.1-25 Deleted

Figure 6.2.1-26 Deleted

Figures 6.2.1-27 thru 6.2.1-42
have been deleted.

Figures 6.2.1-27 thru 6.2.1-42
have been deleted.

Figures 6.2.1-27 thru 6.2.1-42
have been deleted.

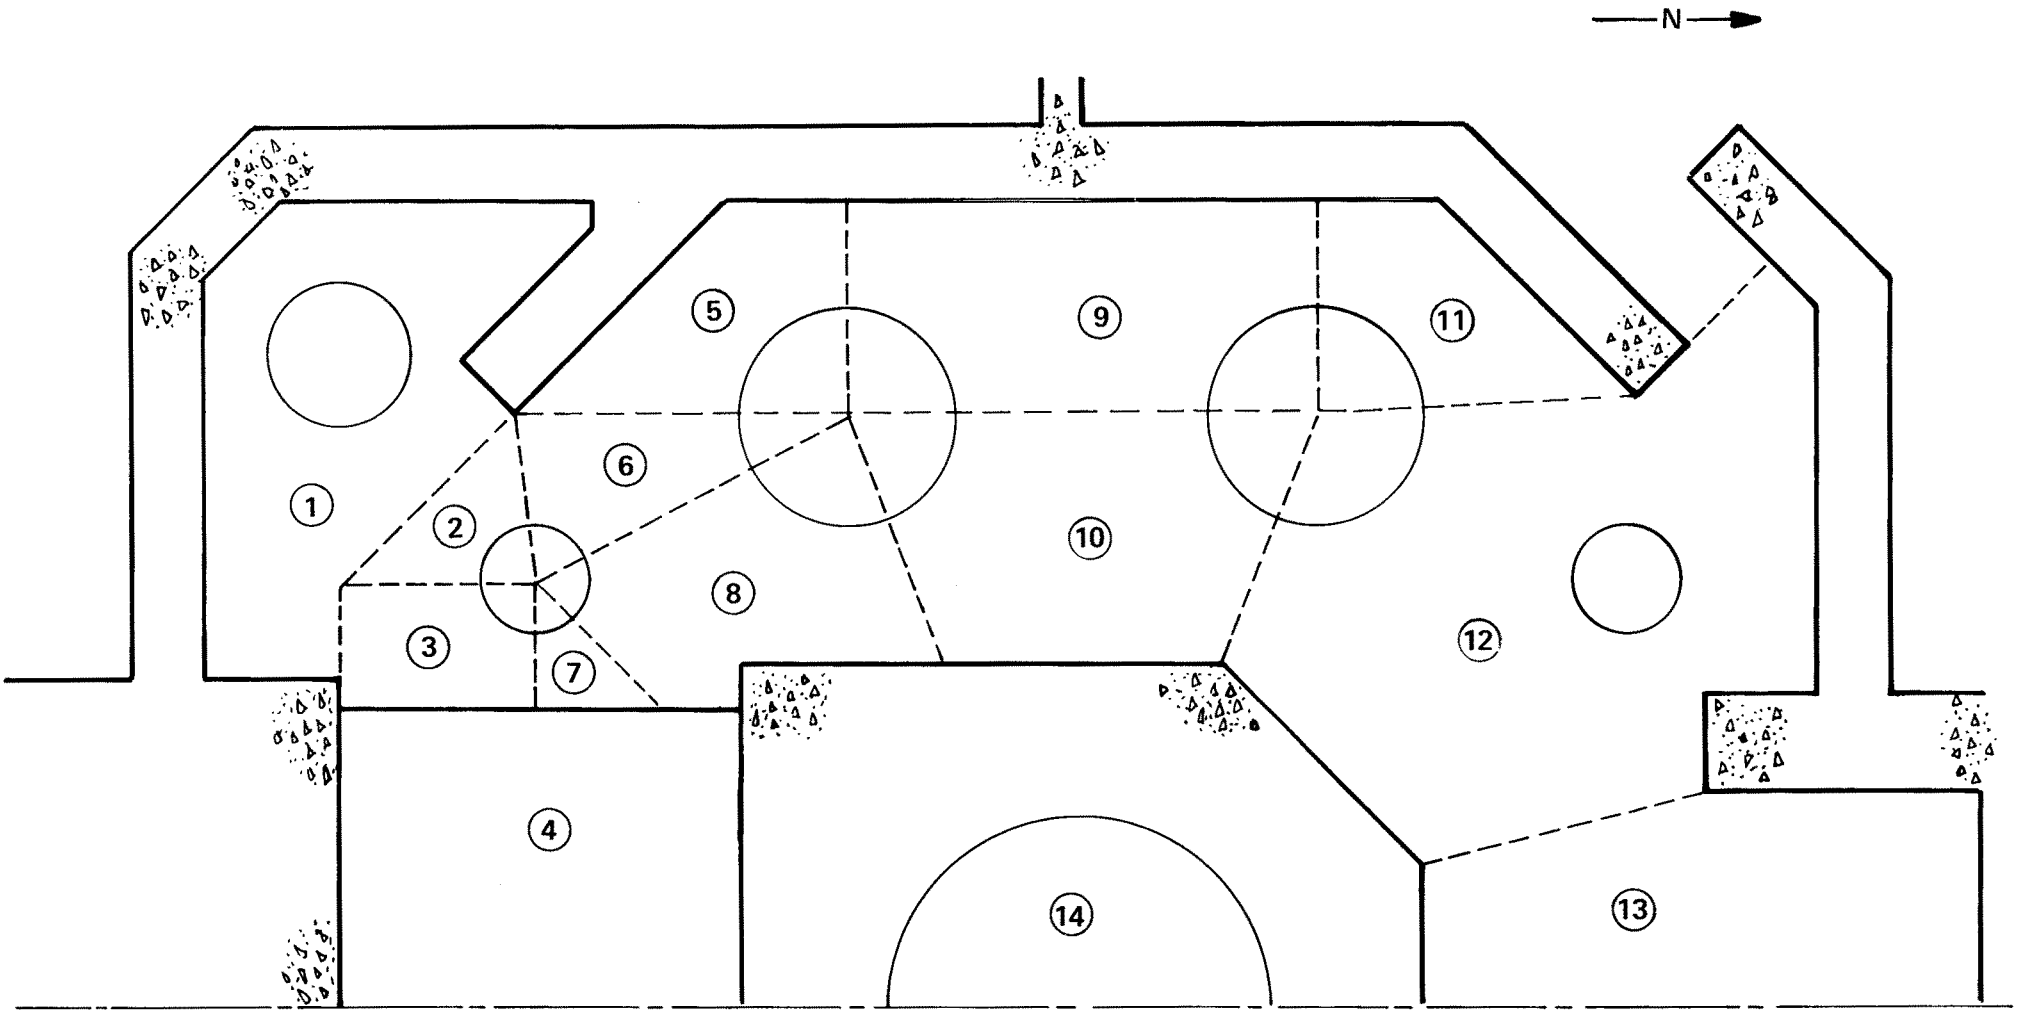


LEVEL 1
 EL. 2001'-4" TO 2018'-4"

○ - NODE NUMBER
 - - - - - NODE BOUNDARY

Rev. OL-0
 6/86

CALLAWAY PLANT
FIGURE 6.2.1-43
STEAM GENERATOR LOOP COMPARTMENT ANALYSIS
NODALIZATION SCHEME - LEVEL 1

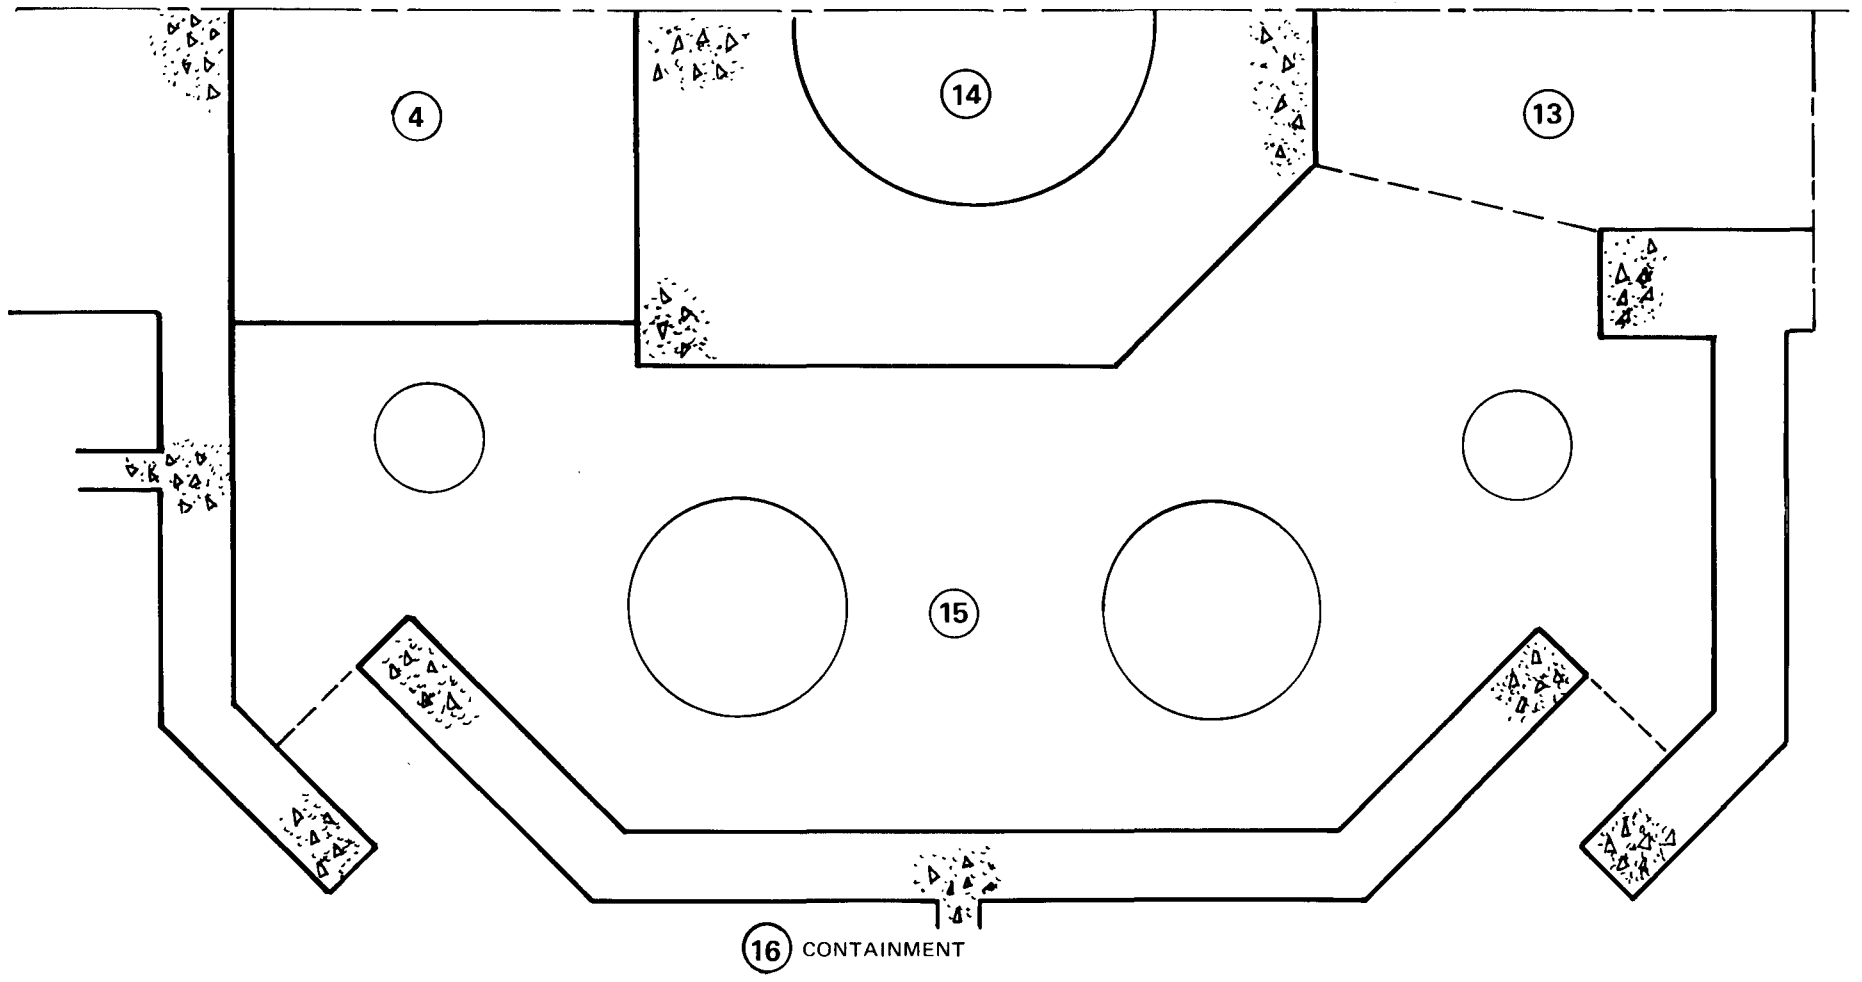

○ NODE NUMBER
 - - - - - NODE BOUNDARY


16 CONTAINMENT

LEVEL 1

EL. 2001'-4" TO 2018'-4"

Rev. OL-0
 6/86


CALLAWAY PLANT
FIGURE 6.2.1-44
STEAM GENERATOR LOOP COMPARTMENT ANALYSIS
NODALIZATION SCHEME - LEVEL 1

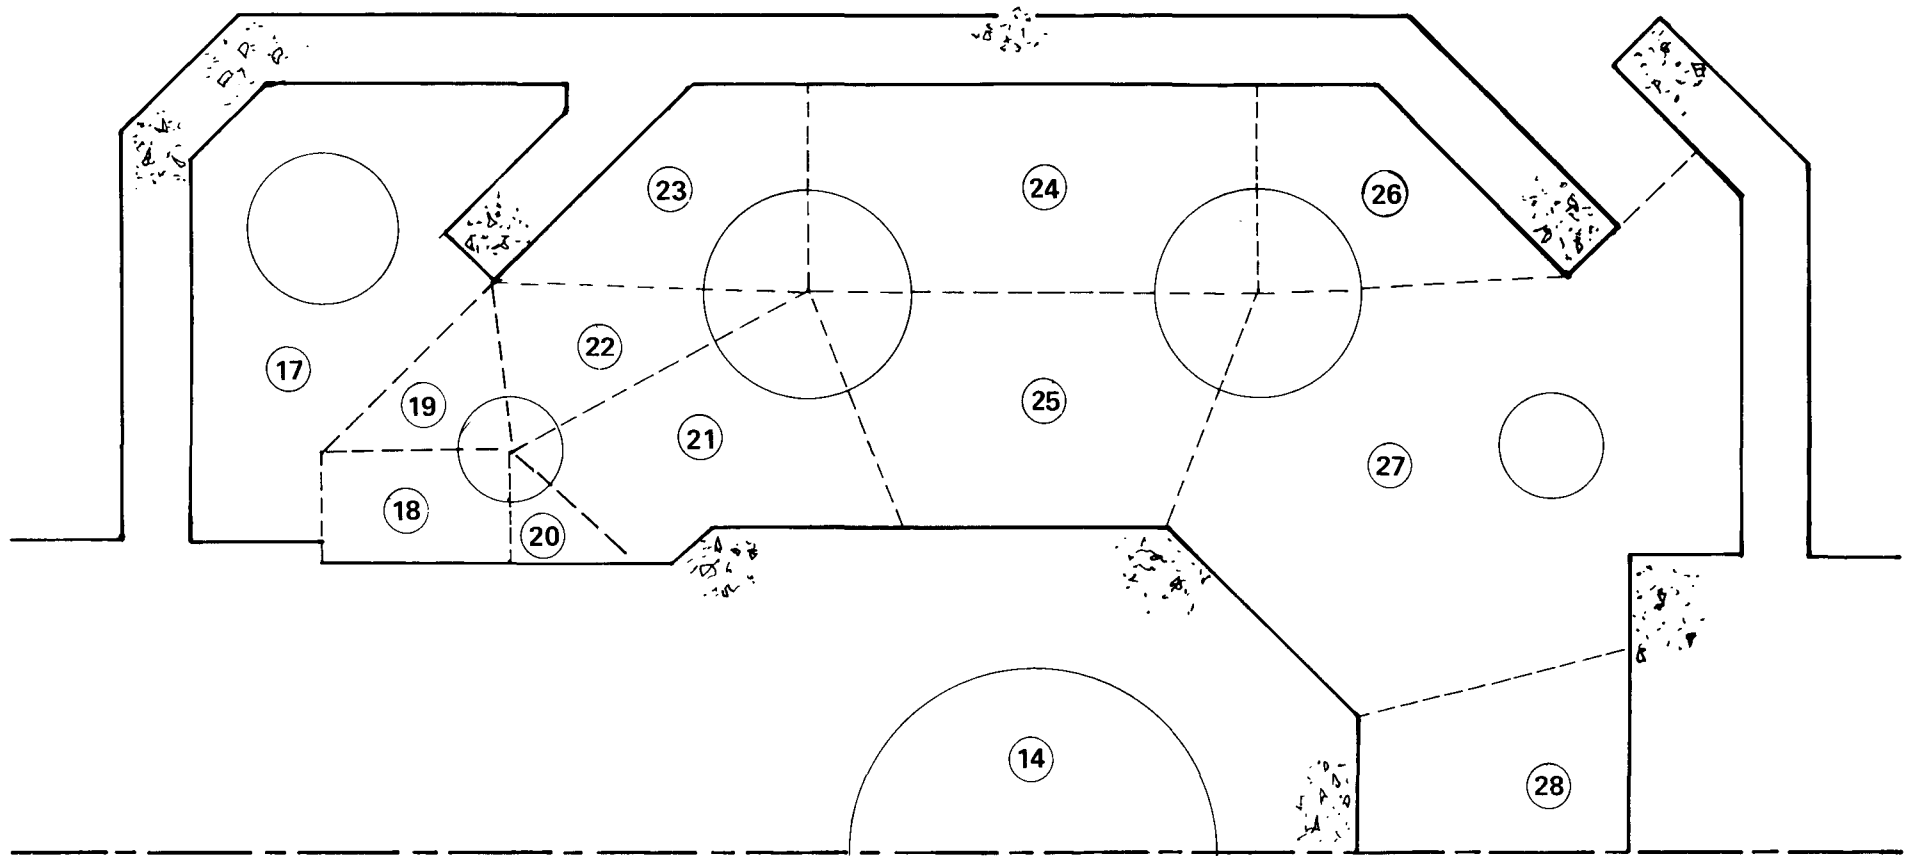

LEVEL 2
 EL. 2018'-4" TO 2025'-0"

Rev. OL-0
 6/86

CALLAWAY PLANT
FIGURE 6.2.1-45
STEAM GENERATOR LOOP COMPARTMENT ANALYSIS
NODALIZATION SCHEME - LEVEL 2

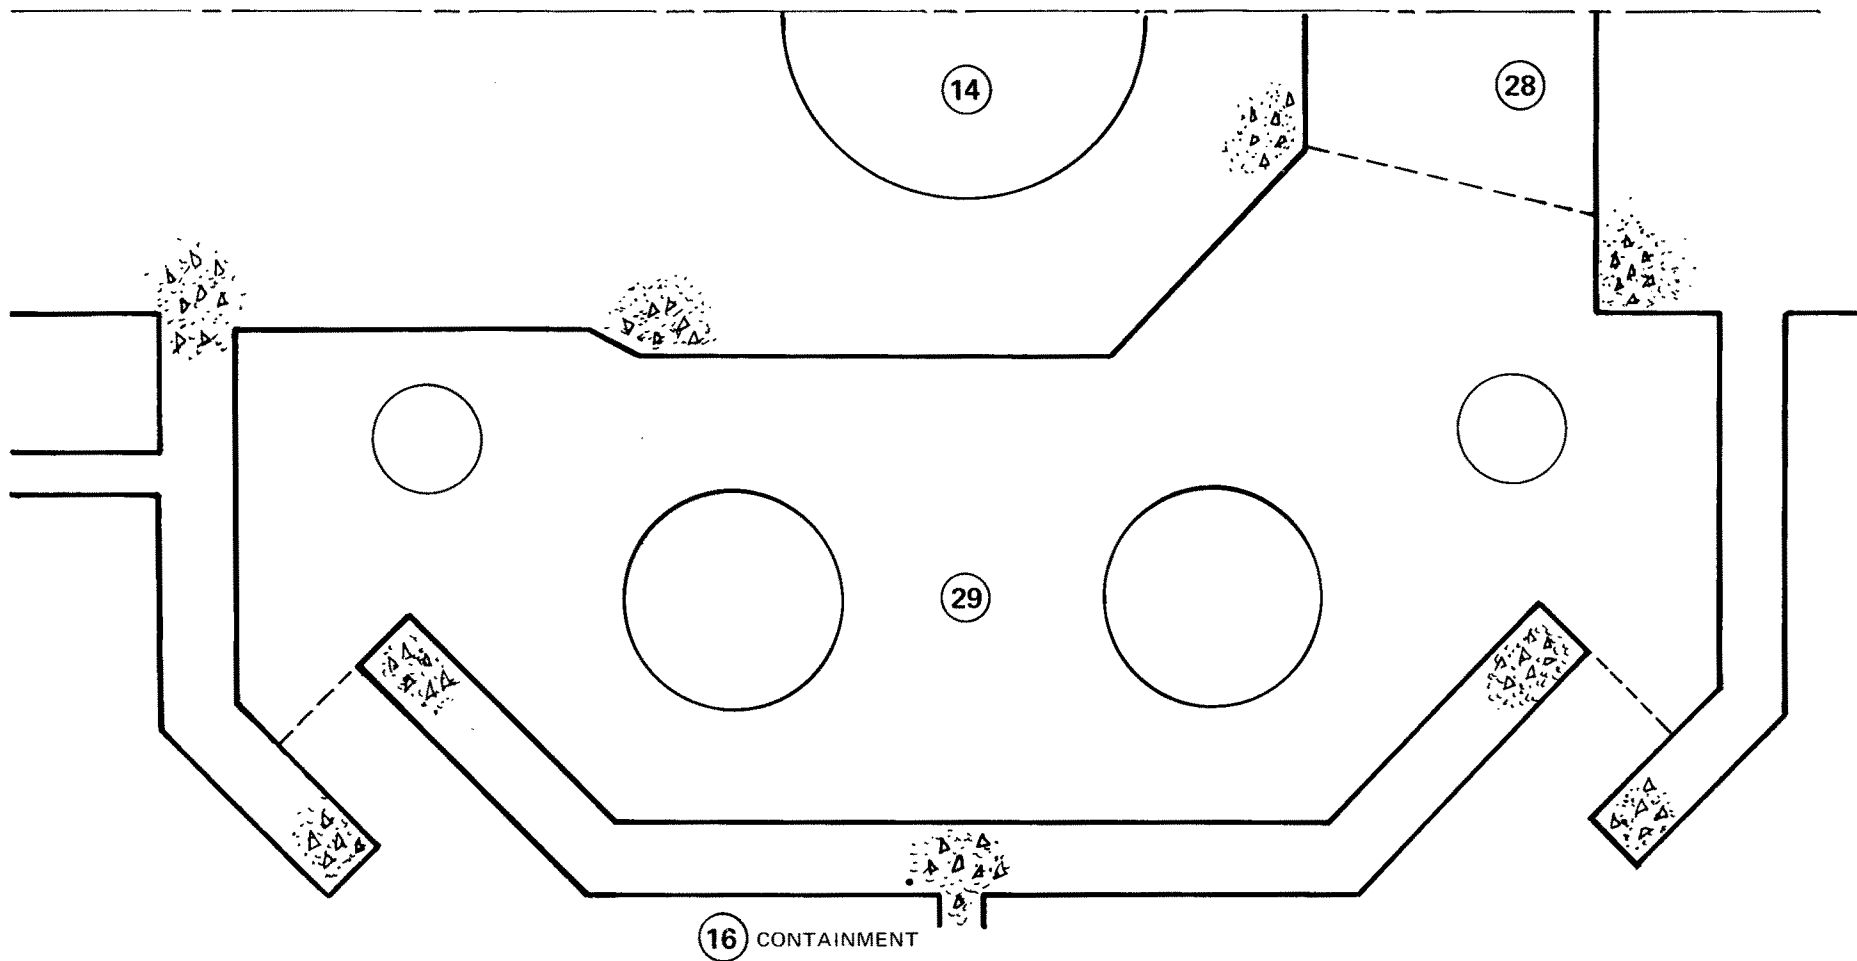

LEVEL 2

EL. 2018'-4" TO 2025'-0"

Rev. OL-0
6/86


CALLAWAY PLANT
FIGURE 6.2.1-46
STEAM GENERATOR LOOP COMPARTMENT ANALYSIS
NODALIZATION SCHEME - LEVEL 2

Figure 6.2.1-47 Deleted

Figure 6.2.1-48 Deleted

Figure 6.2.1-49 Deleted

Figure 6.2.1-50 Deleted

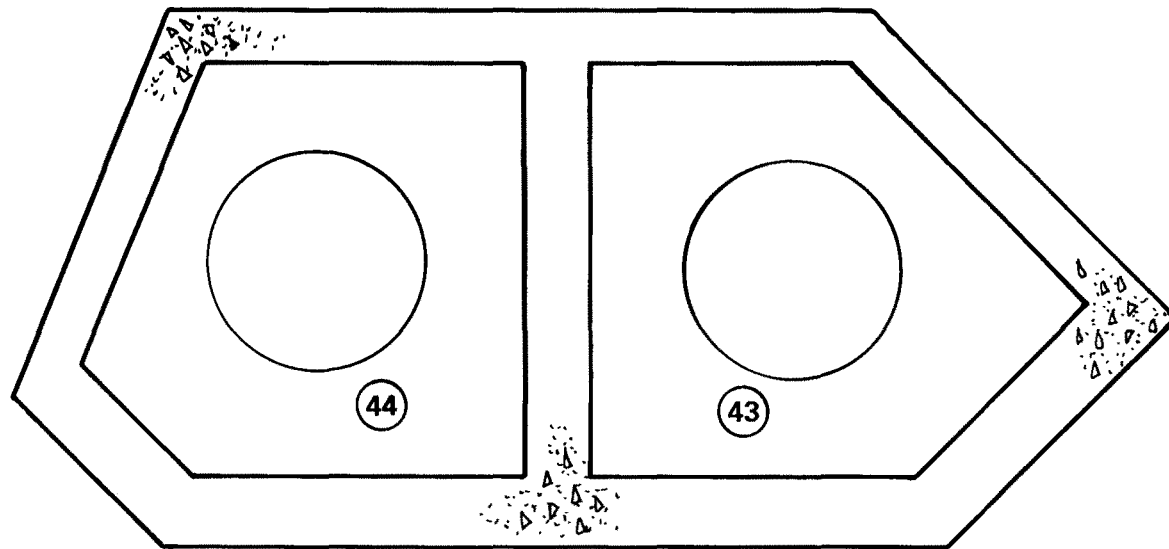

LEVEL 4

EL. 2045'-6" TO 2060'-0"


Rev. OL-0
6/86

CALLAWAY PLANT

FIGURE 6.2.1-51

**STEAM GENERATOR LOOP
COMPARTMENT ANALYSIS**

NODALIZATION SCHEME - LEVEL 4

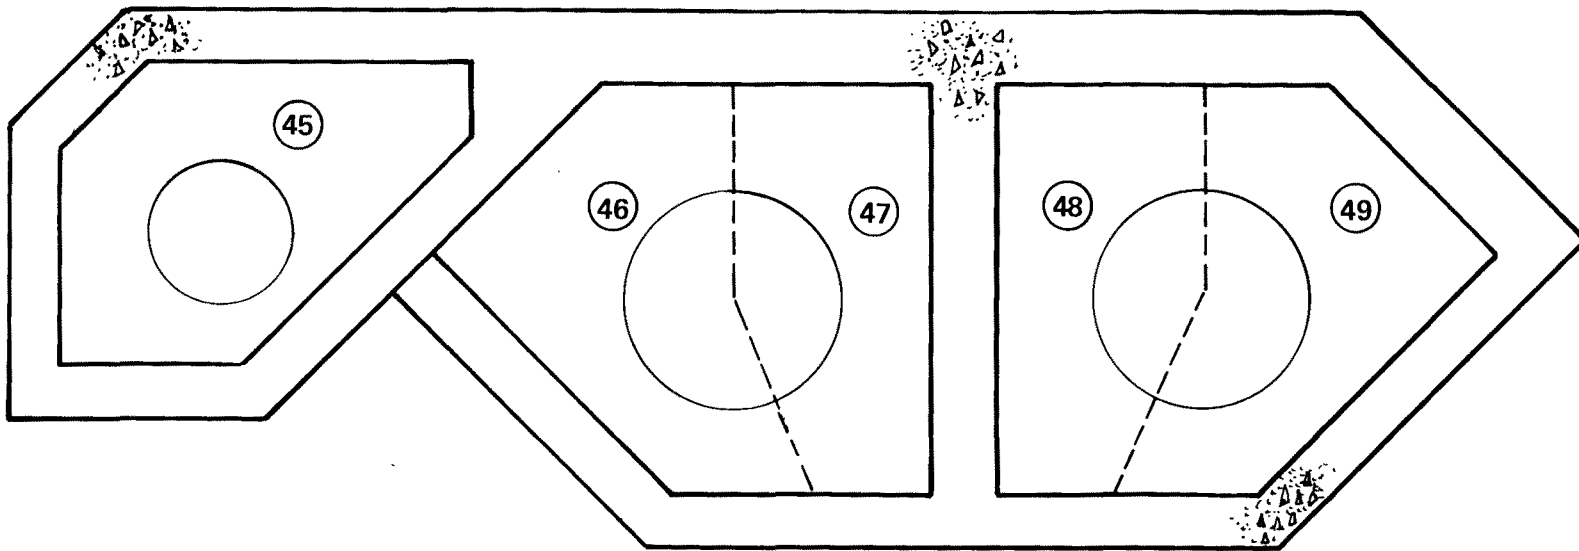


LEVEL 5

EL. 2060'-0" TO 2068'-8"

Rev. OL-0
6/86


CALLAWAY PLANT
FIGURE 6.2.1-52
STEAM GENERATOR LOOP COMPARTMENT ANALYSIS
NODALIZATION SCHEME - LEVEL 5

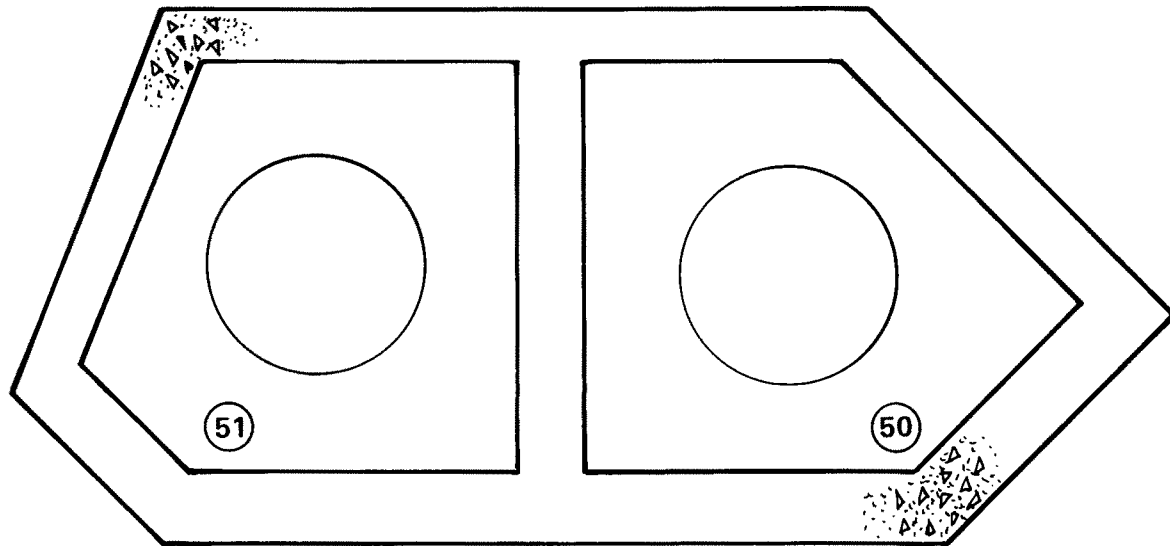

LEVEL 5
EL. 2060'-0" TO 2068'-8"

Rev. OL-0
6/86

CALLAWAY PLANT
FIGURE 6.2.1-53
STEAM GENERATOR LOOP COMPARTMENT ANALYSIS
NODALIZATION SCHEME - LEVEL 5

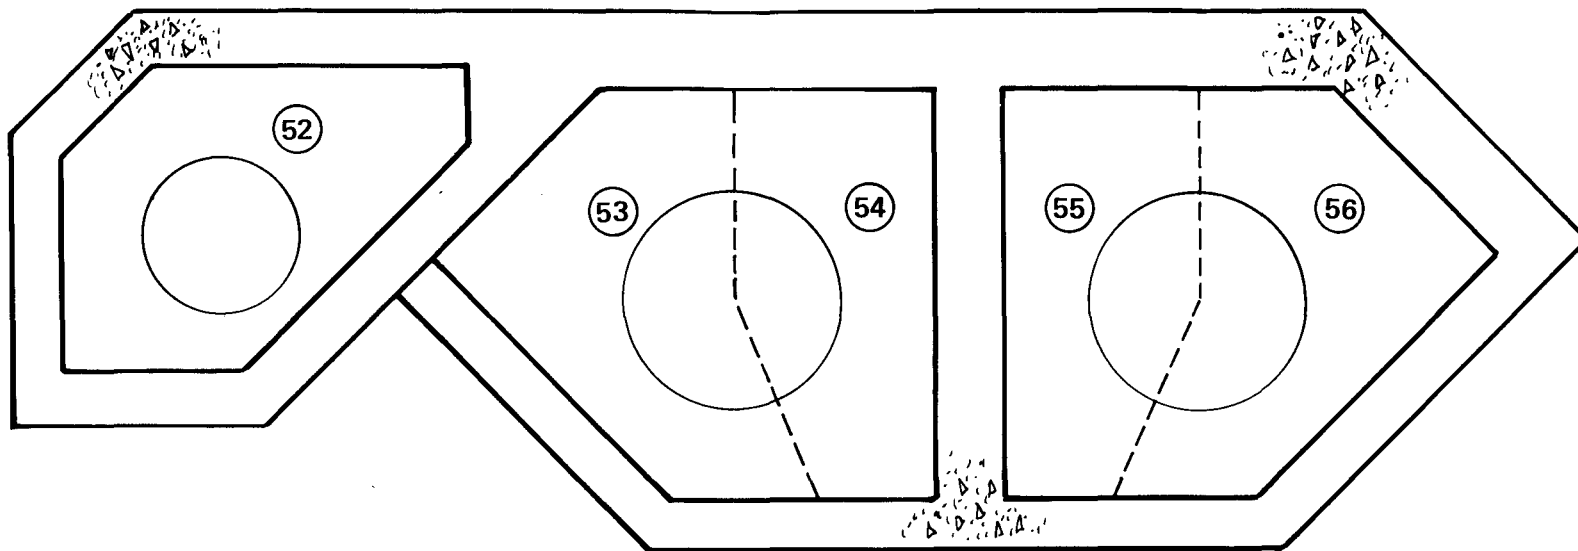

LEVEL 6

EL. 2068'-8" TO 2086'-0 3/4"

(EL. 2068'-8" TO 2090'-4" IN PRESSURIZER COMPT.)


Rev. OL-0
6/86

CALLAWAY PLANT

FIGURE 6.2.1-54

**STEAM GENERATOR LOOP
COMPARTMENT ANALYSIS**

NODALIZATION SCHEME - LEVEL 6

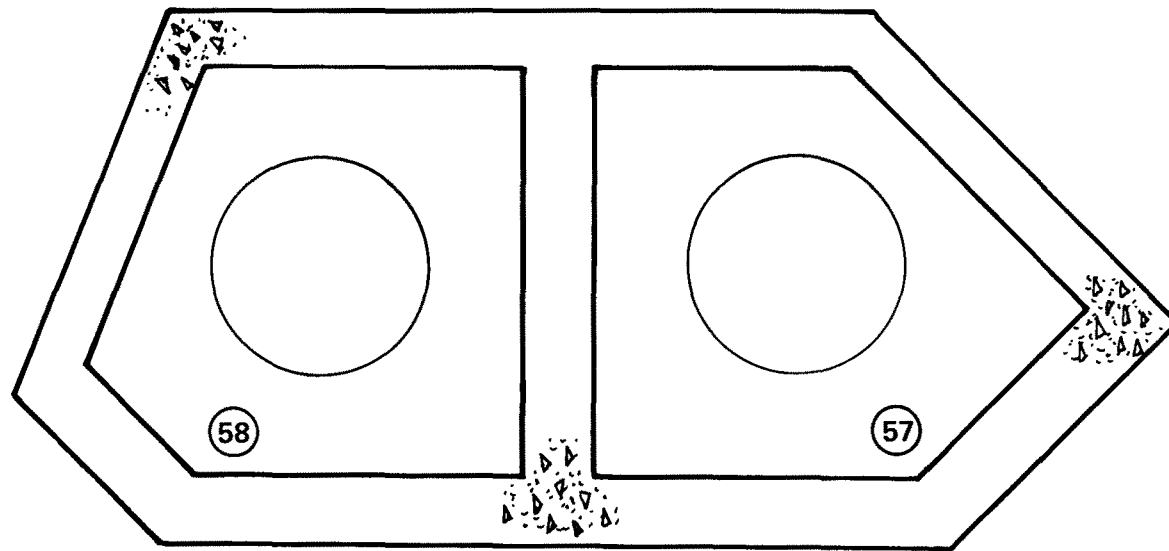



LEVEL 6


EL. 2068'-8" TO 2086'-0 3/4"


Rev. OL-0
6/86

CALLAWAY PLANT
FIGURE 6.2.1-55
STEAM GENERATOR LOOP COMPARTMENT ANALYSIS
NODALIZATION SCHEME - LEVEL 6

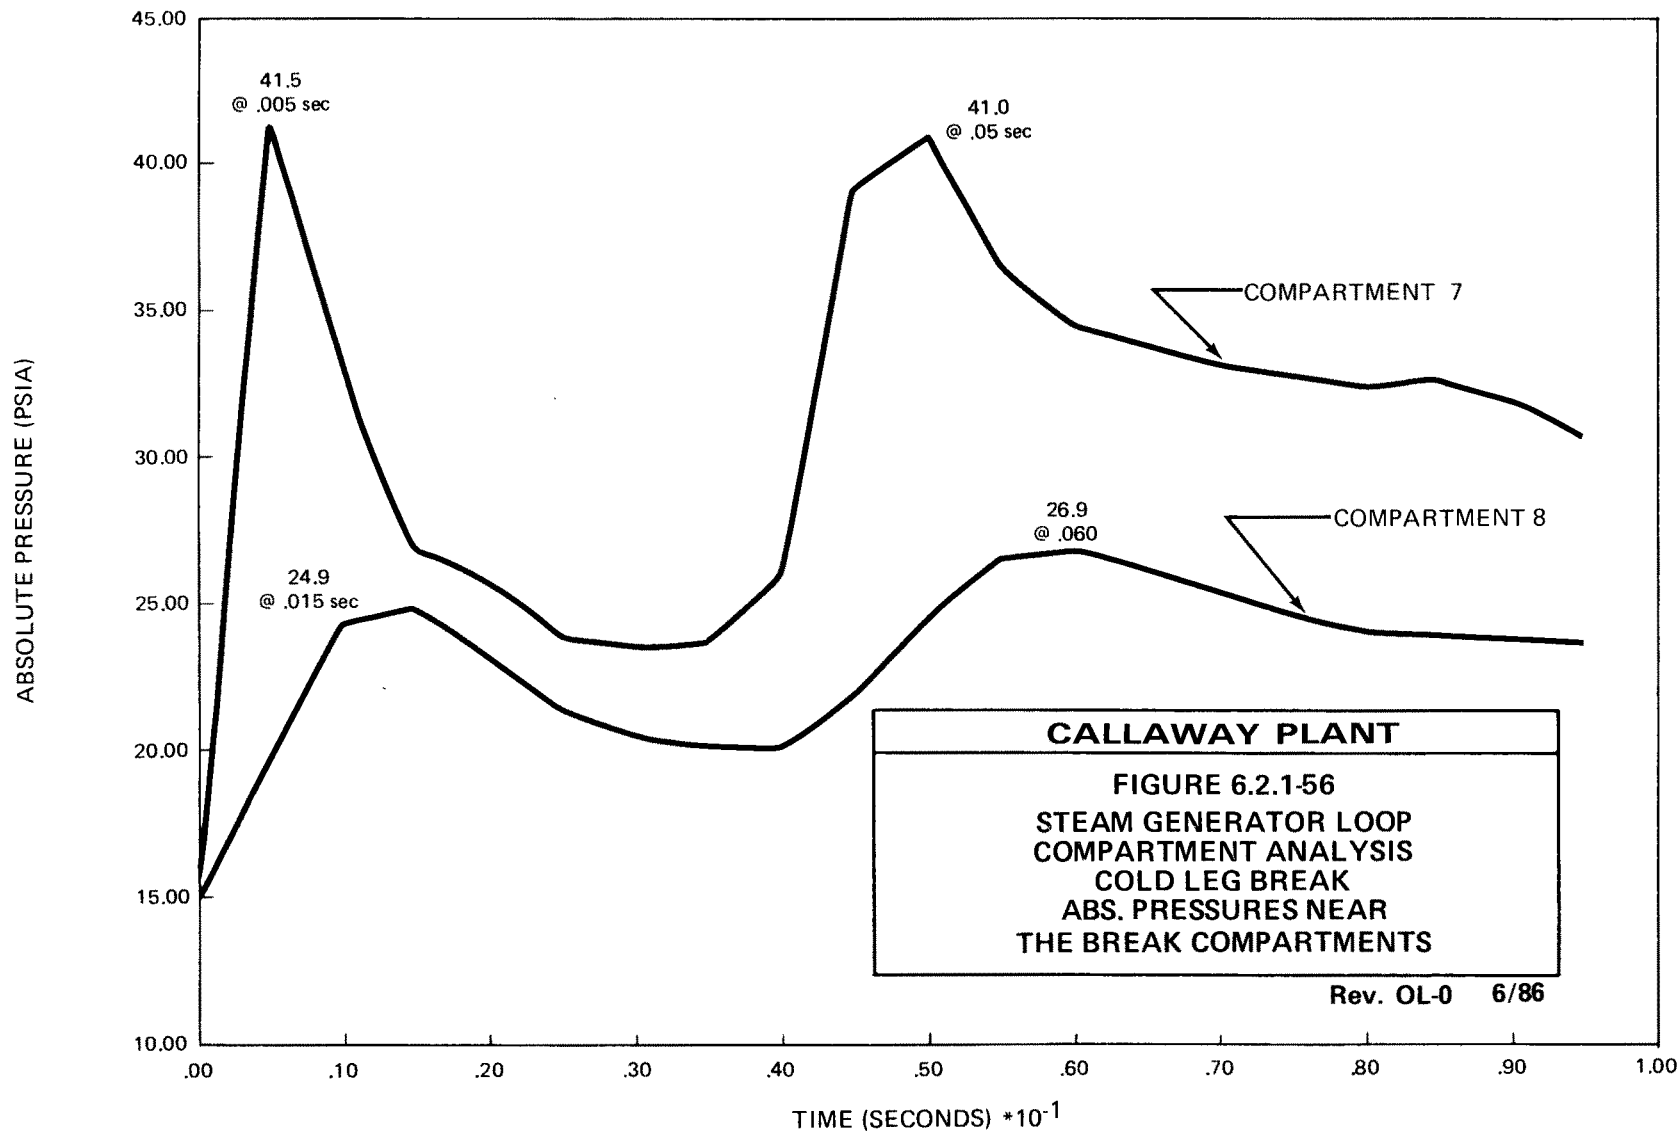

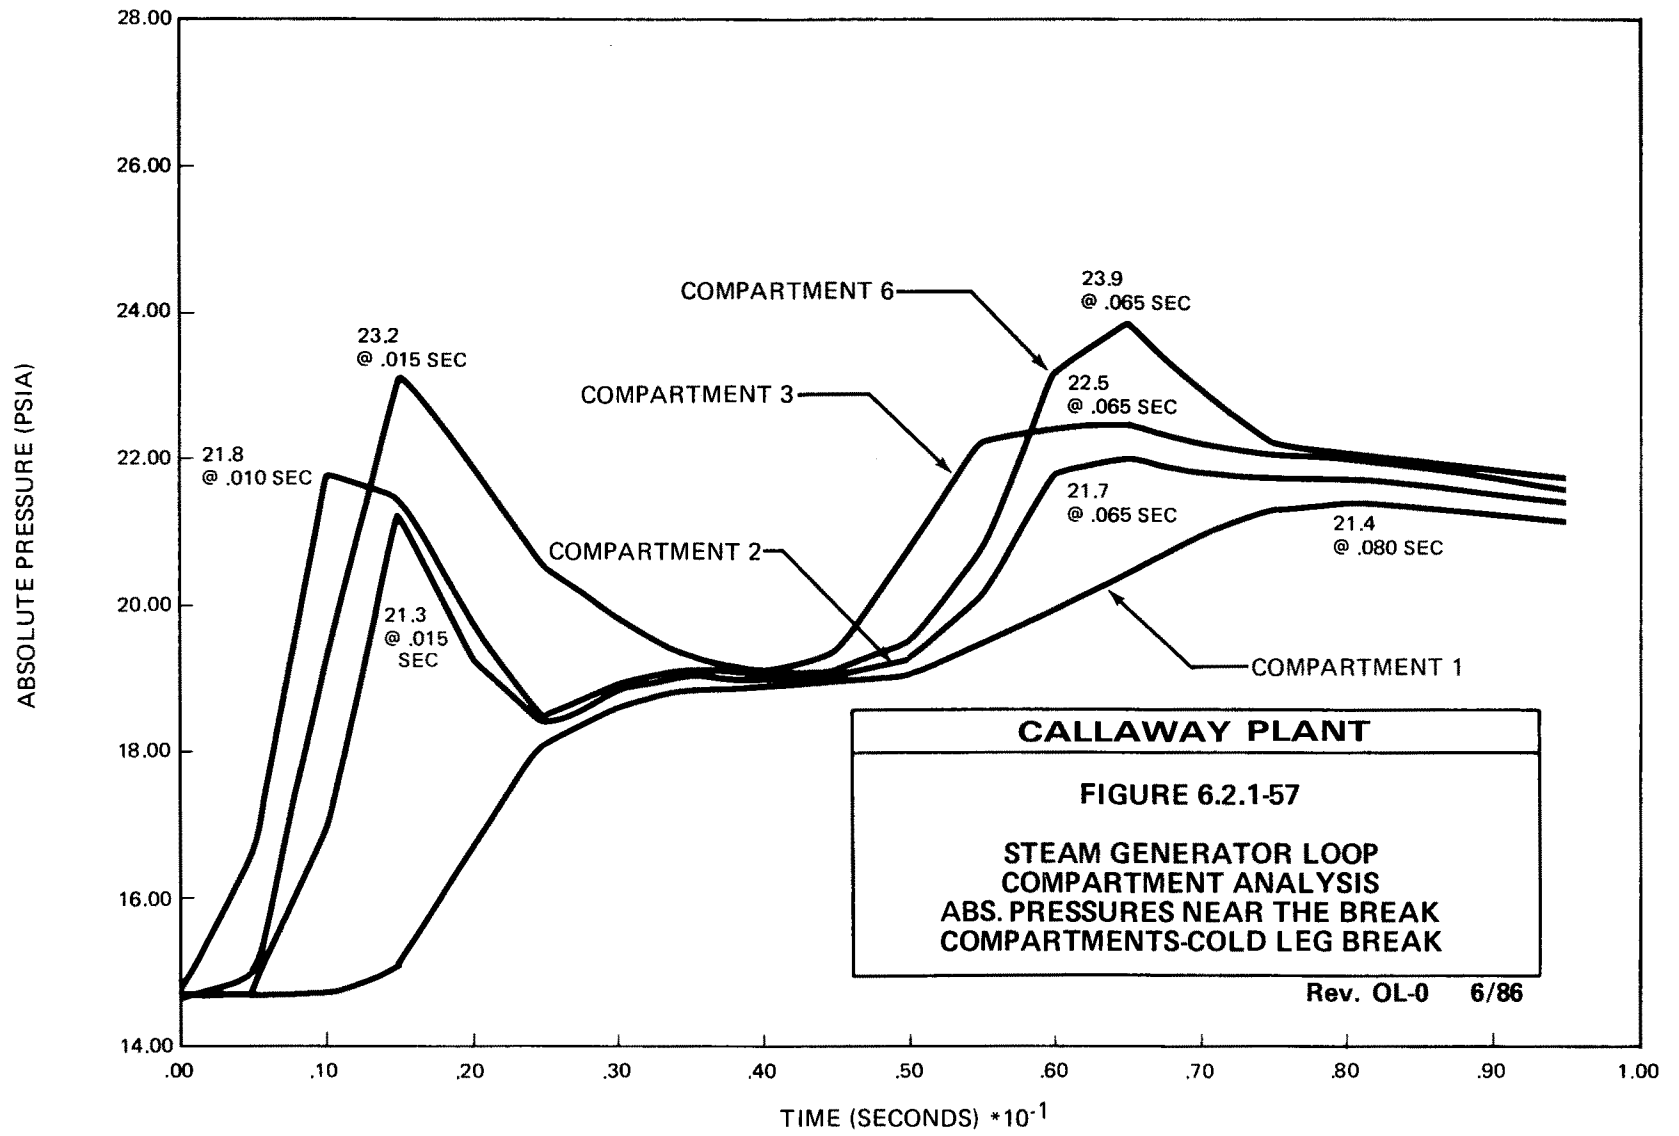


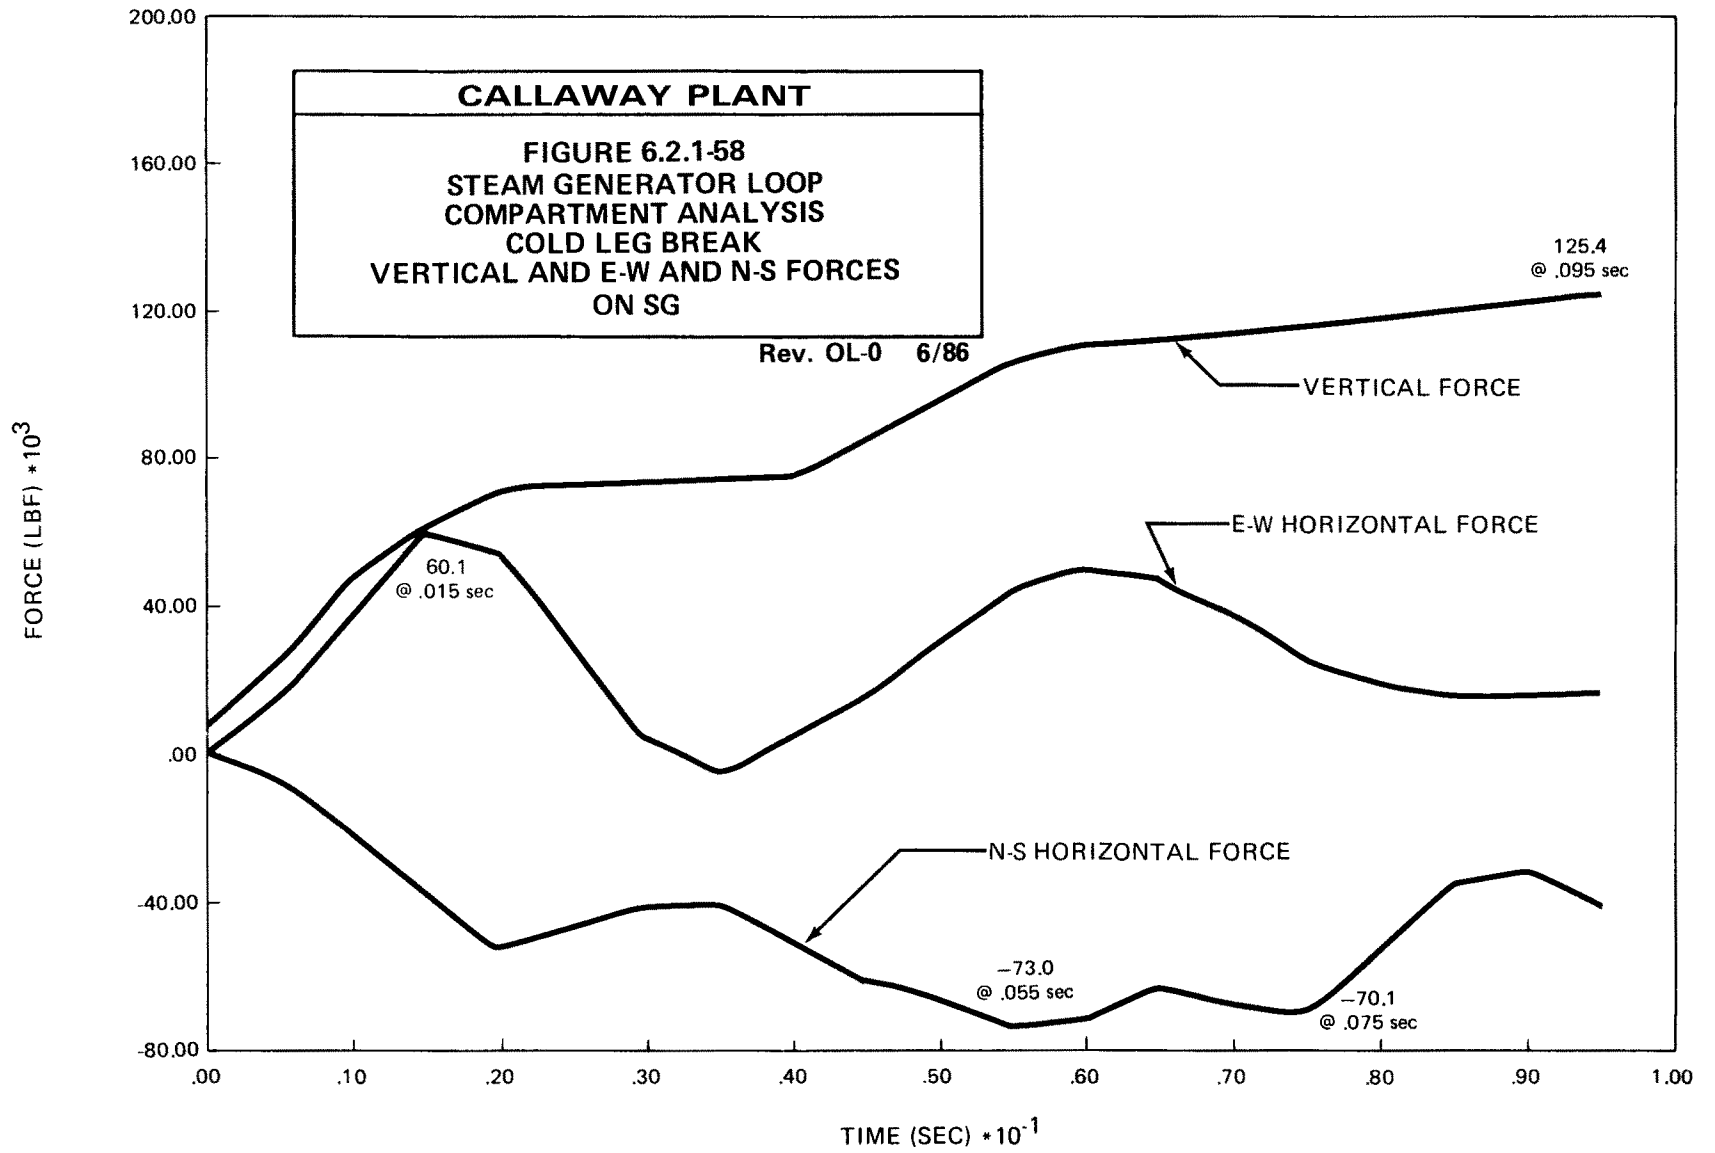


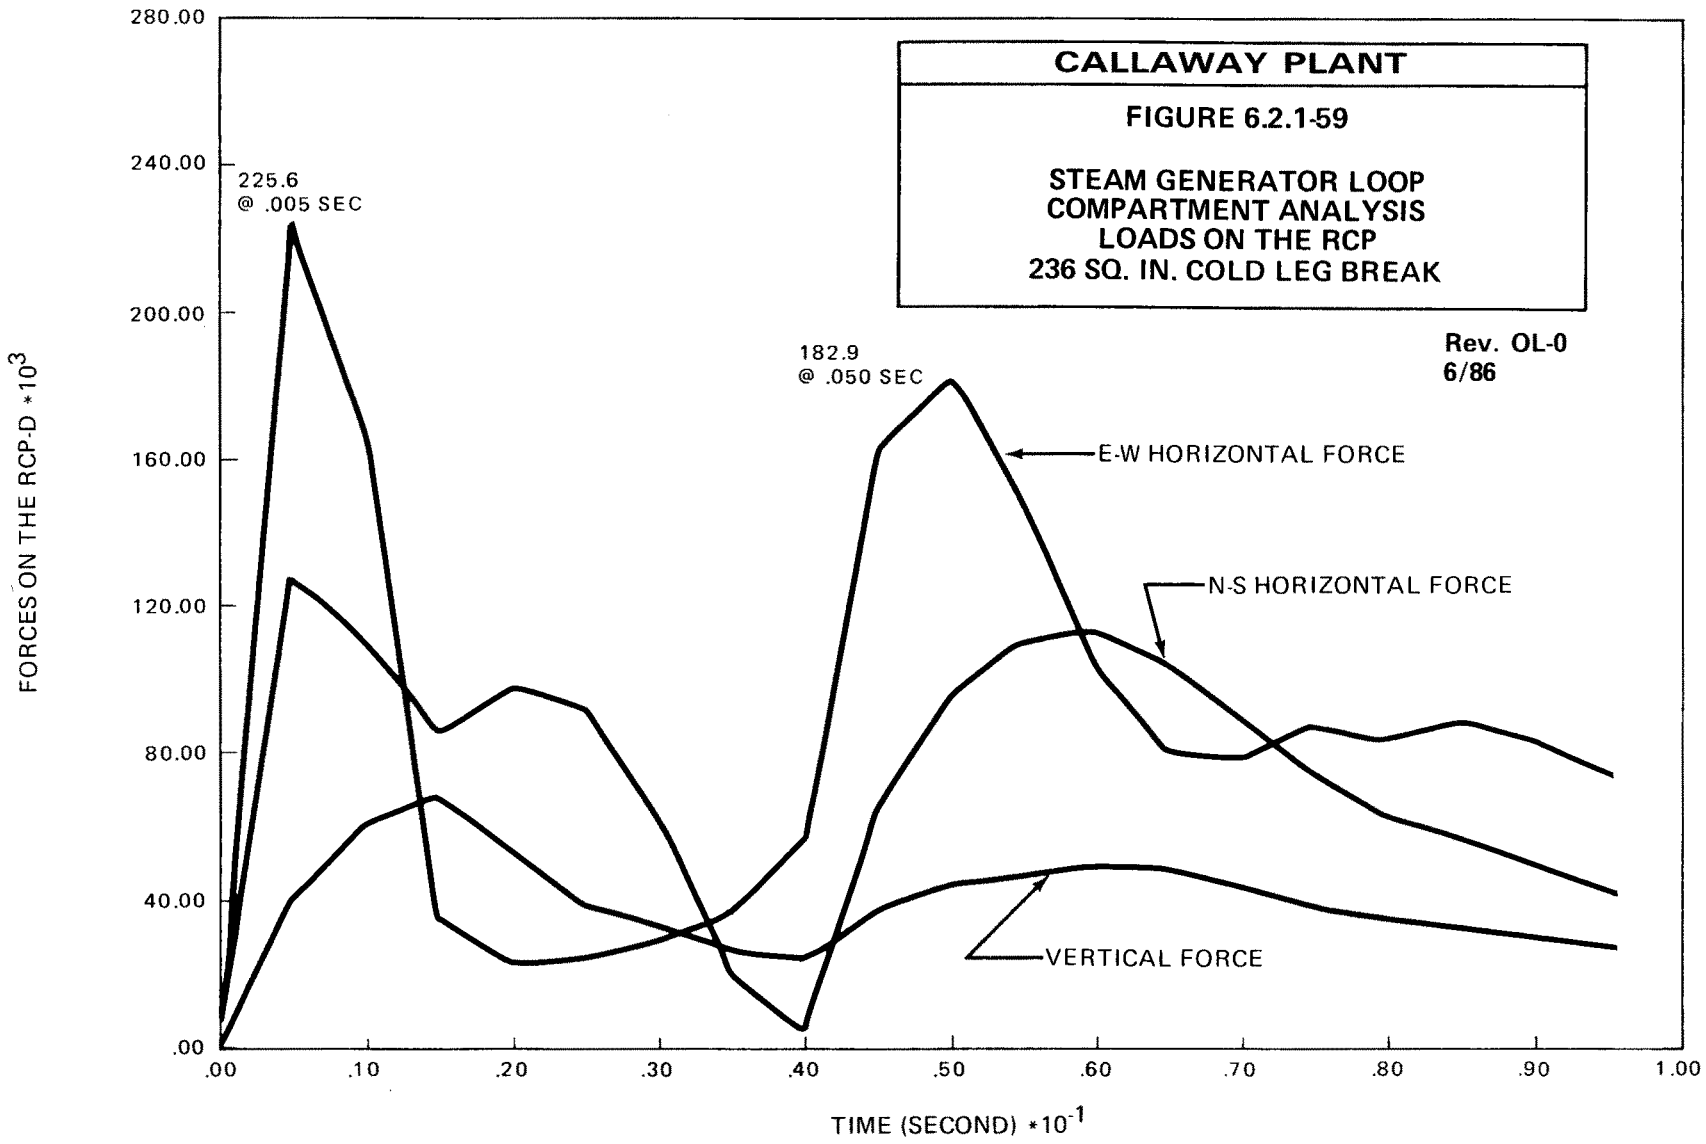

CALLAWAY PLANT
FIGURE 6.2.1-60
STEAM GENERATOR LOOP
COMPARTMENT ANALYSIS
236 IN² COLD LEG BREAK
DIRECTION OF PEAK HORIZONTAL
FORCES ON REACTOR COOLANT
PUMP AND STEAM GENERATOR

Rev. OL-0
6/86

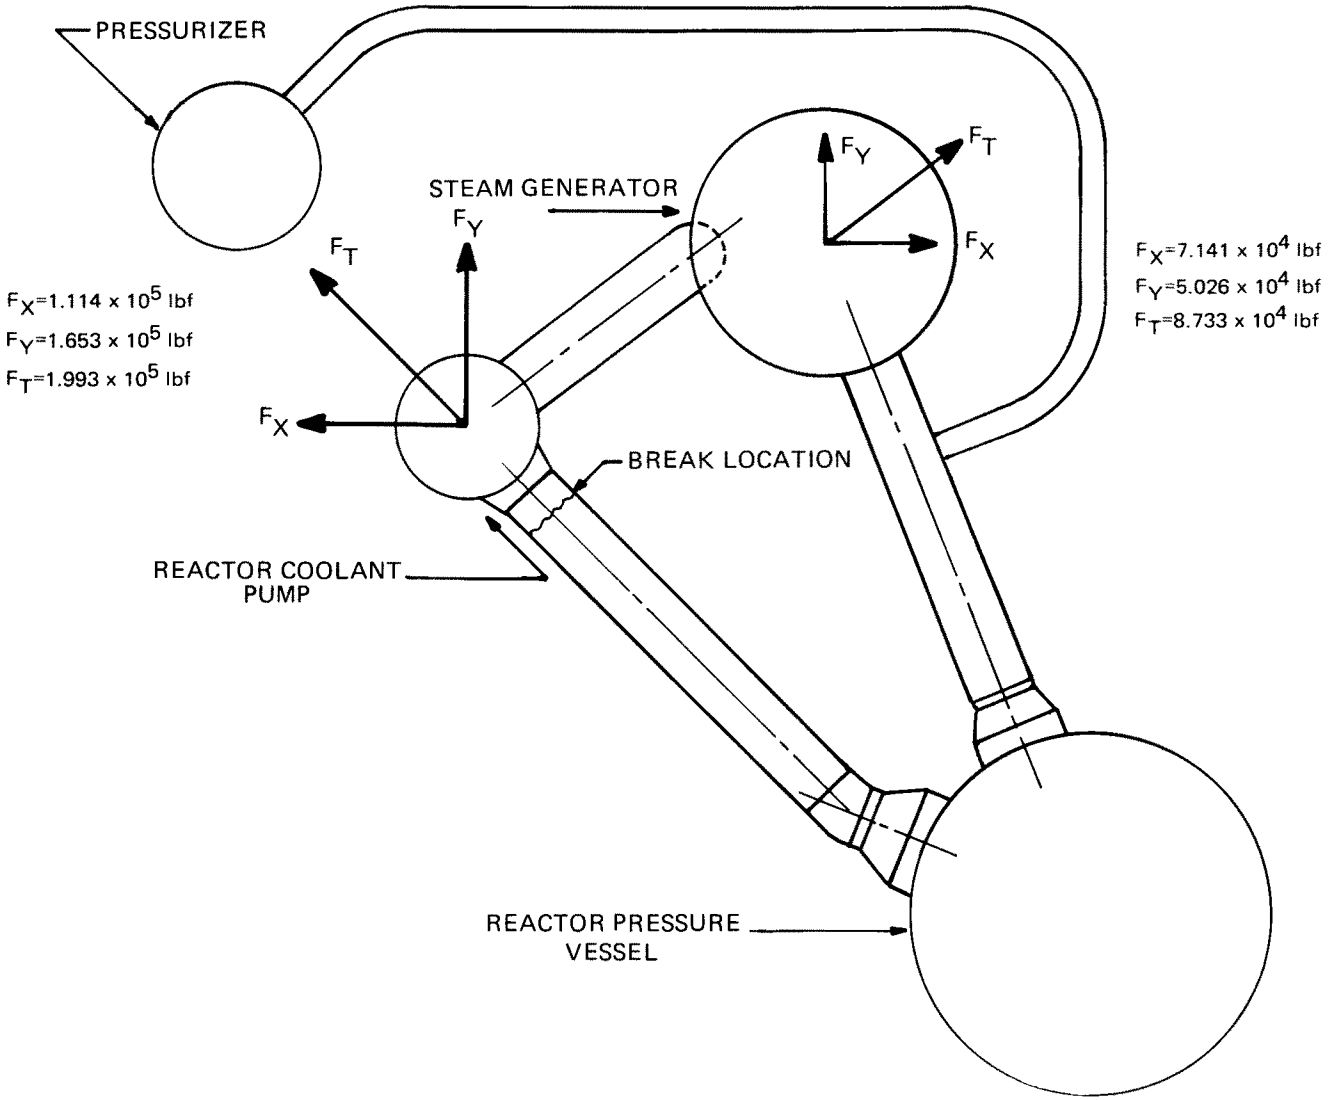


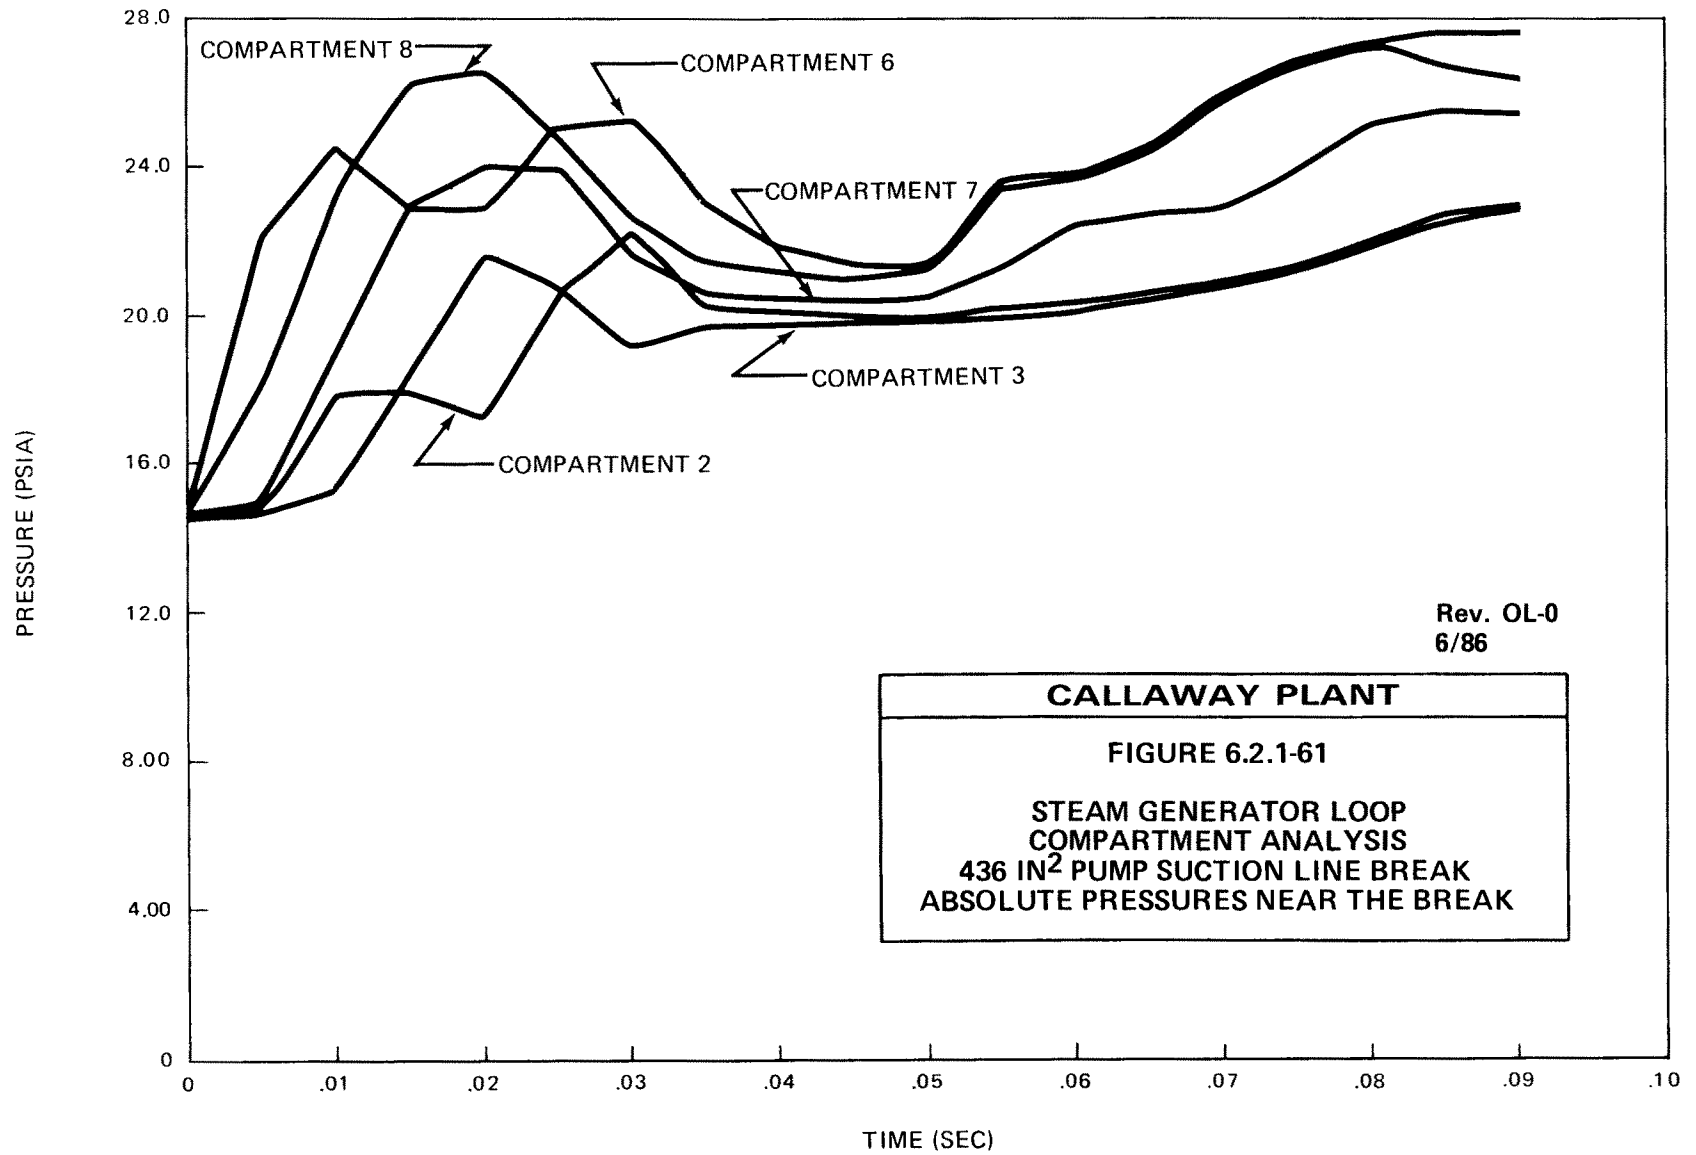



CALLAWAY PLANT

FIGURE 6.2.1-62
STEAM GENERATOR LOOP
COMPARTMENT ANALYSIS
436 IN² PUMP SUCTION LINE BREAK
N-S COMPONENT OF
HORIZONTAL FORCE ON SG

Rev. OL-0
6/86

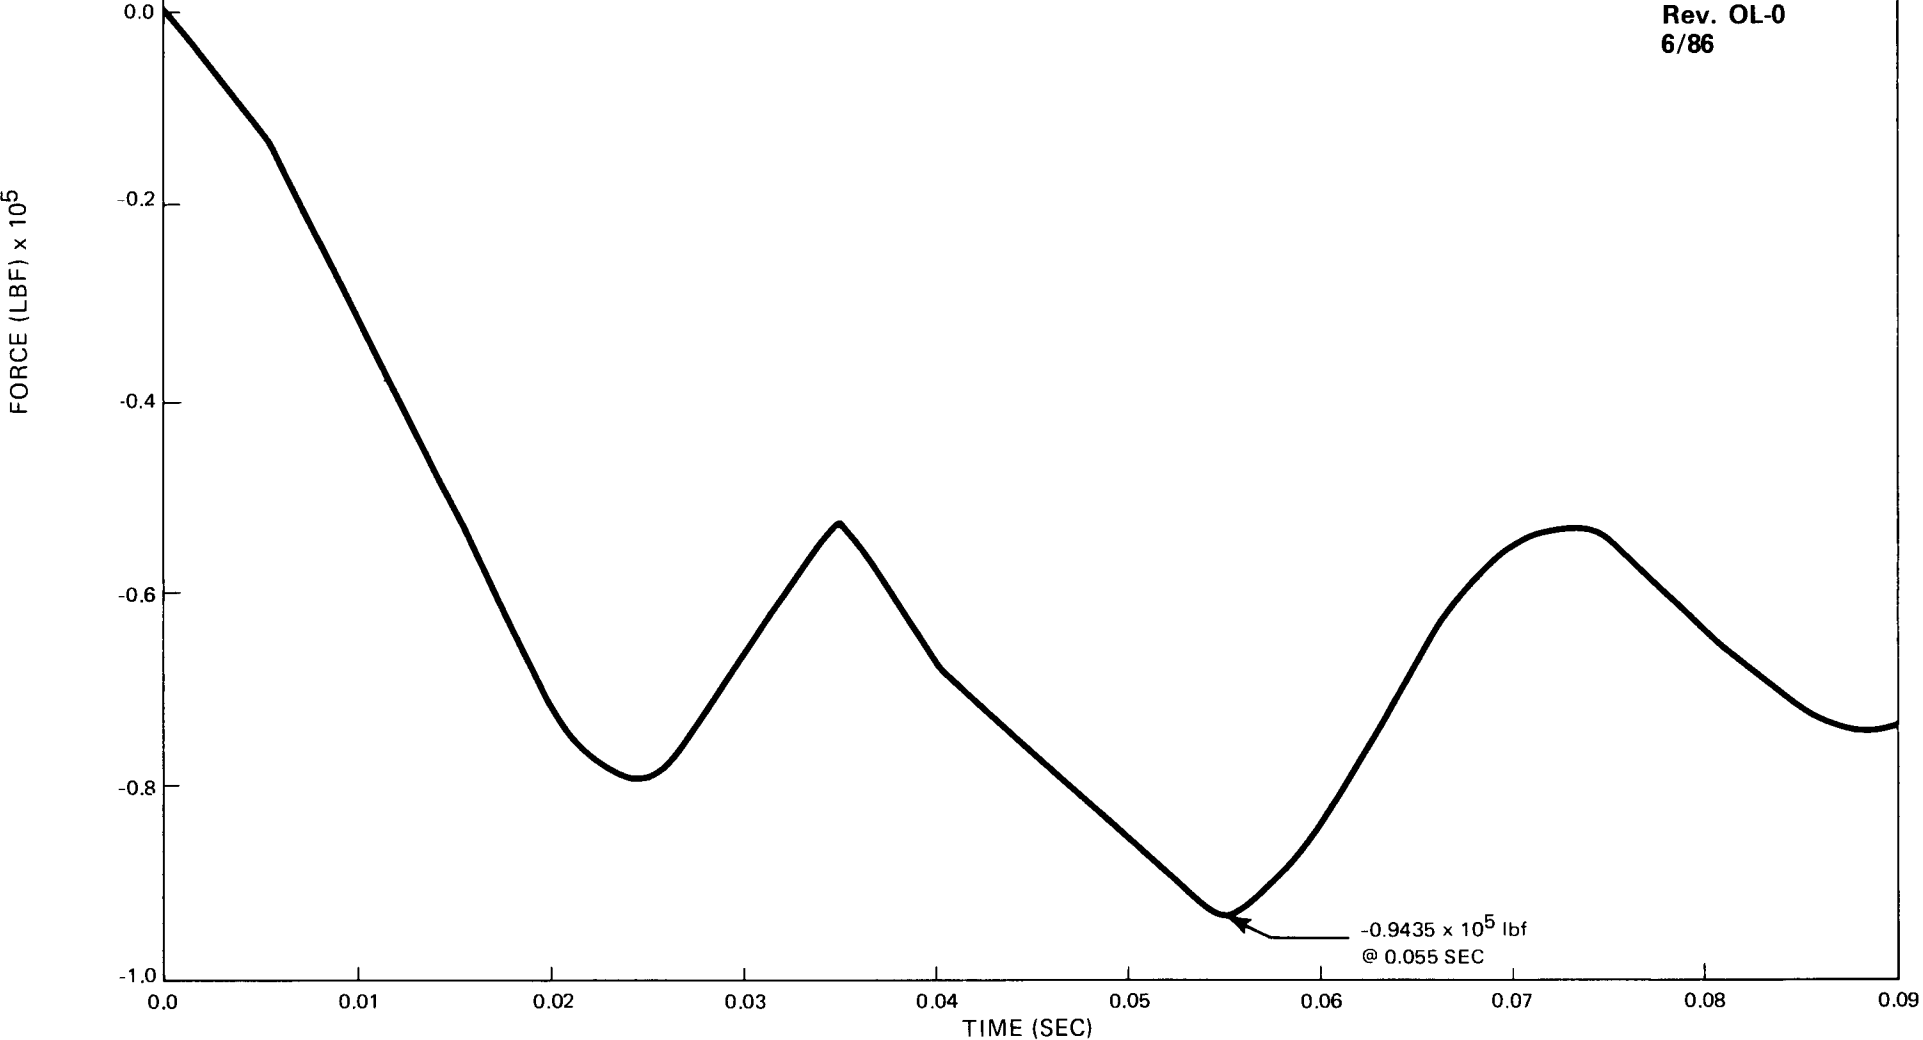

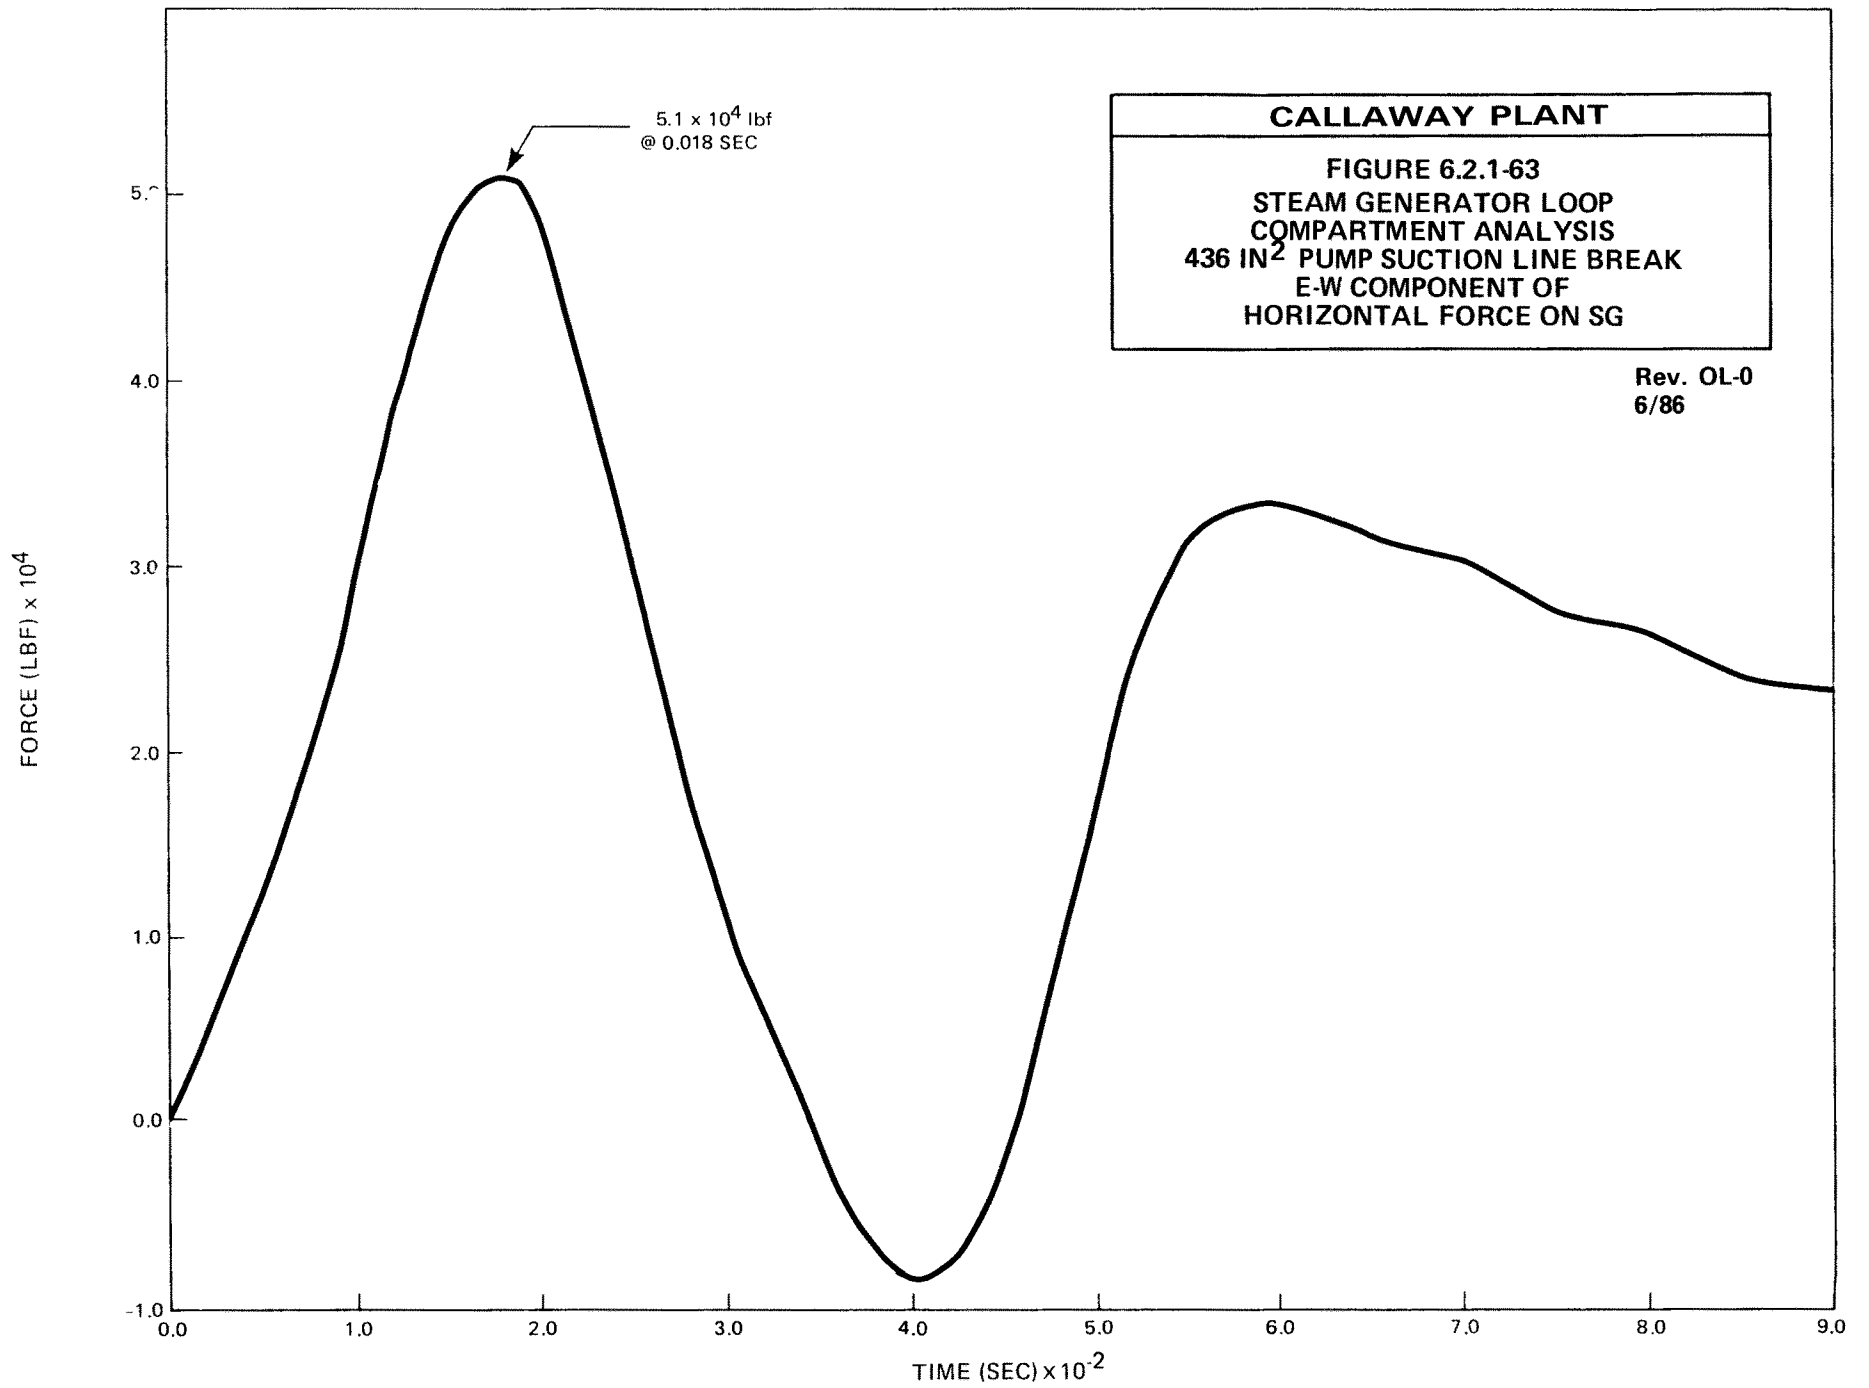


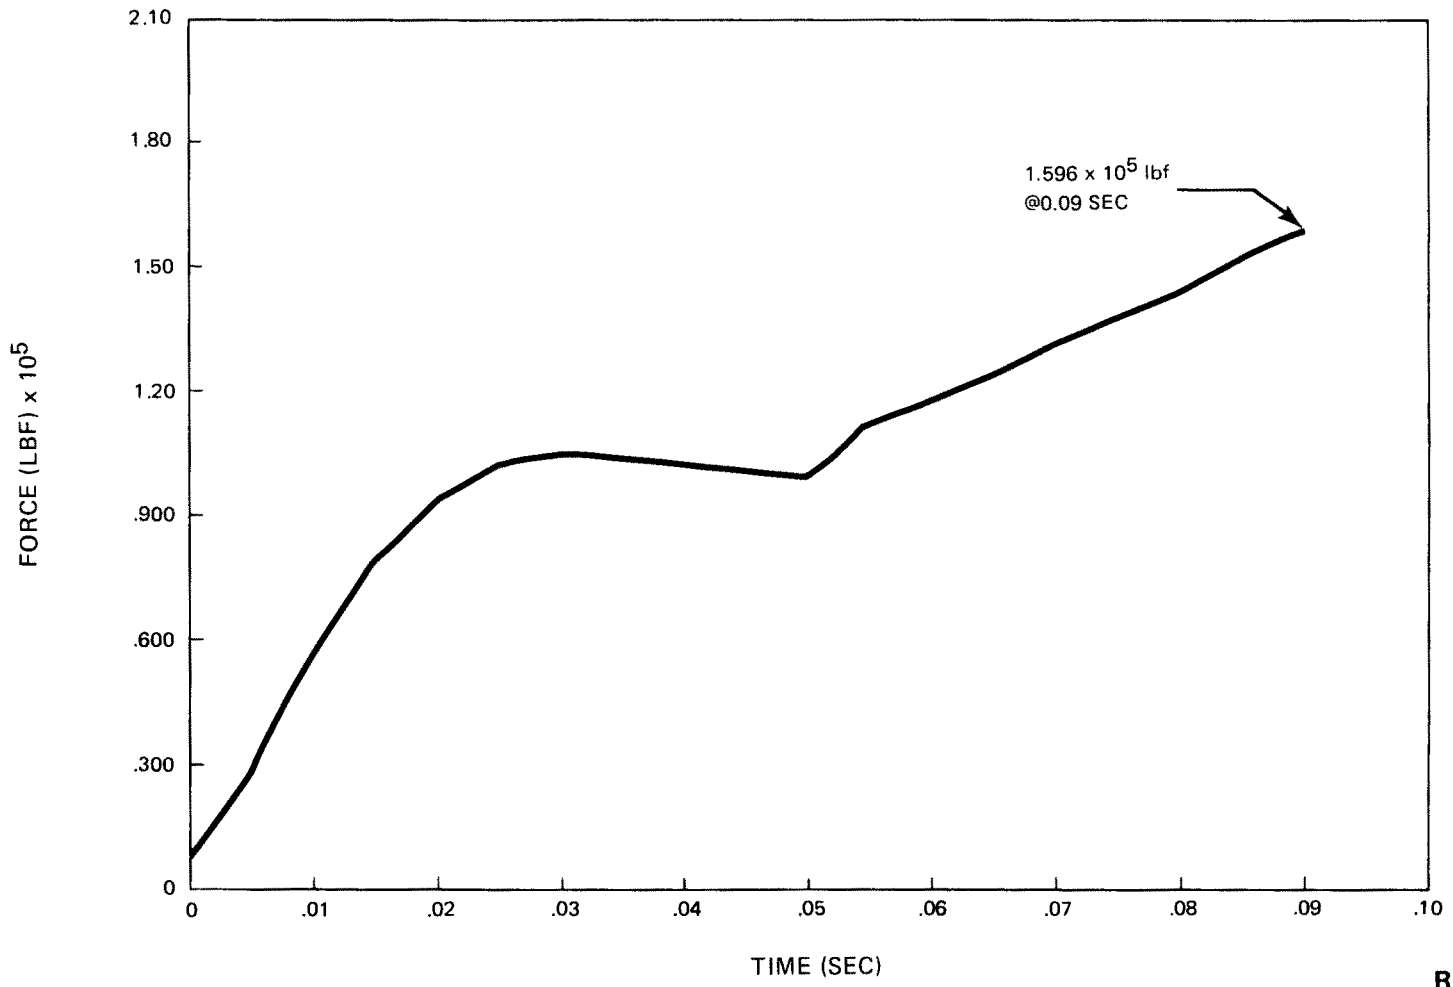

Rev. OL-0
6/86

CALLAWAY PLANT


FIGURE 6.2.1-64
STEAM GENERATOR LOOP
COMPARTMENT ANALYSIS
436 IN² PUMP SUCTION LINE BREAK
VERTICAL FORCE ON SG

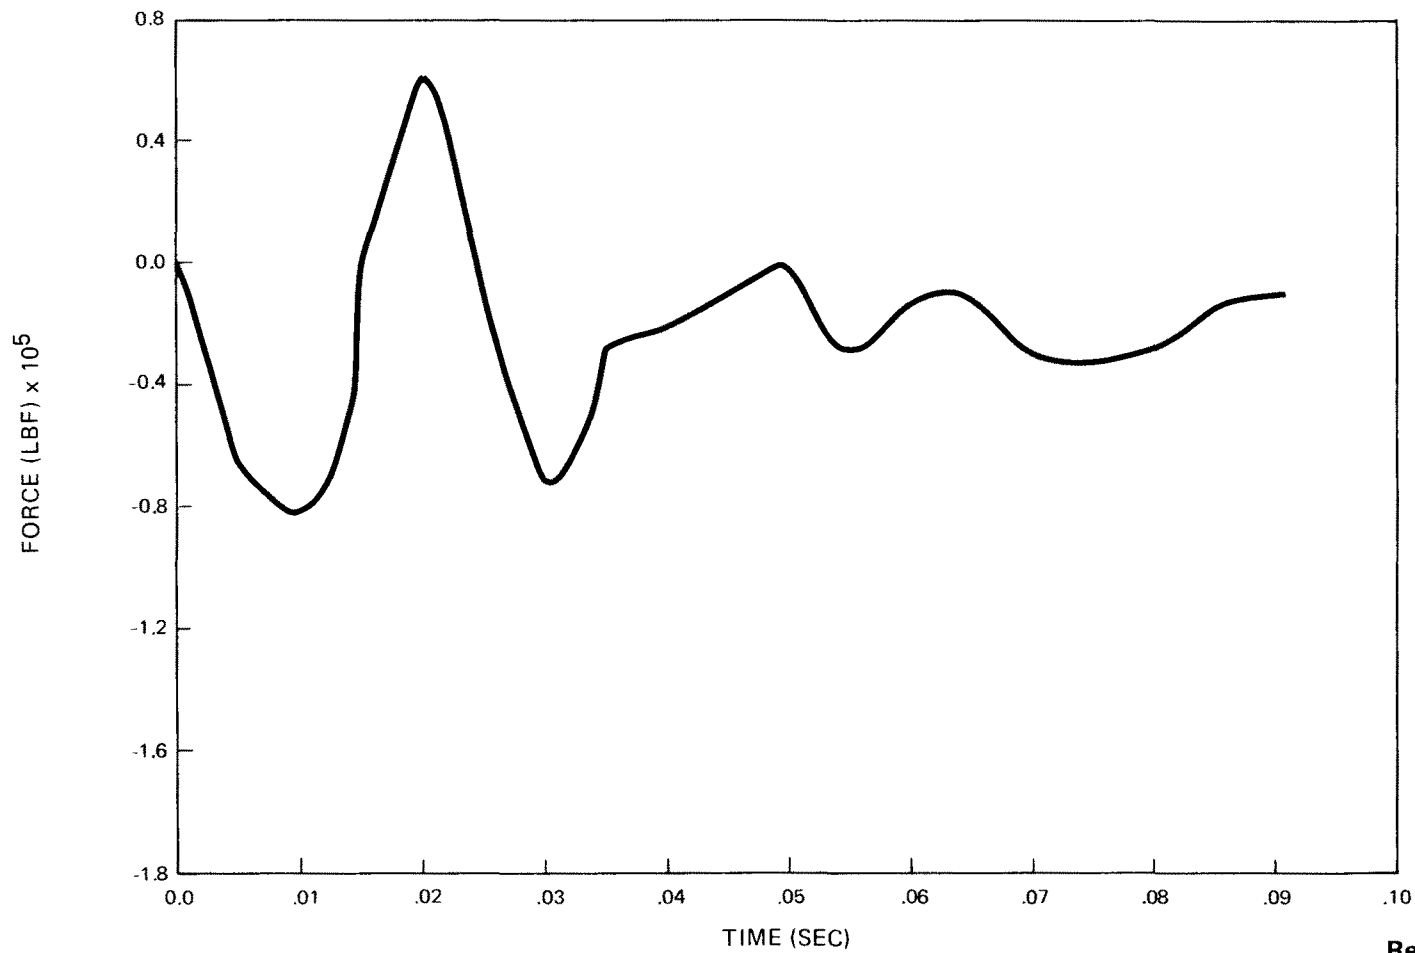

Rev. OL-0
6/86


CALLAWAY PLANT

**FIGURE 6.2.1-65
STEAM GENERATOR LOOP
COMPARTMENT ANALYSIS
436 IN² PUMP SUCTION LINE BREAK
N-S COMPONENT OF HORIZONTAL FORCE
ON RCP**

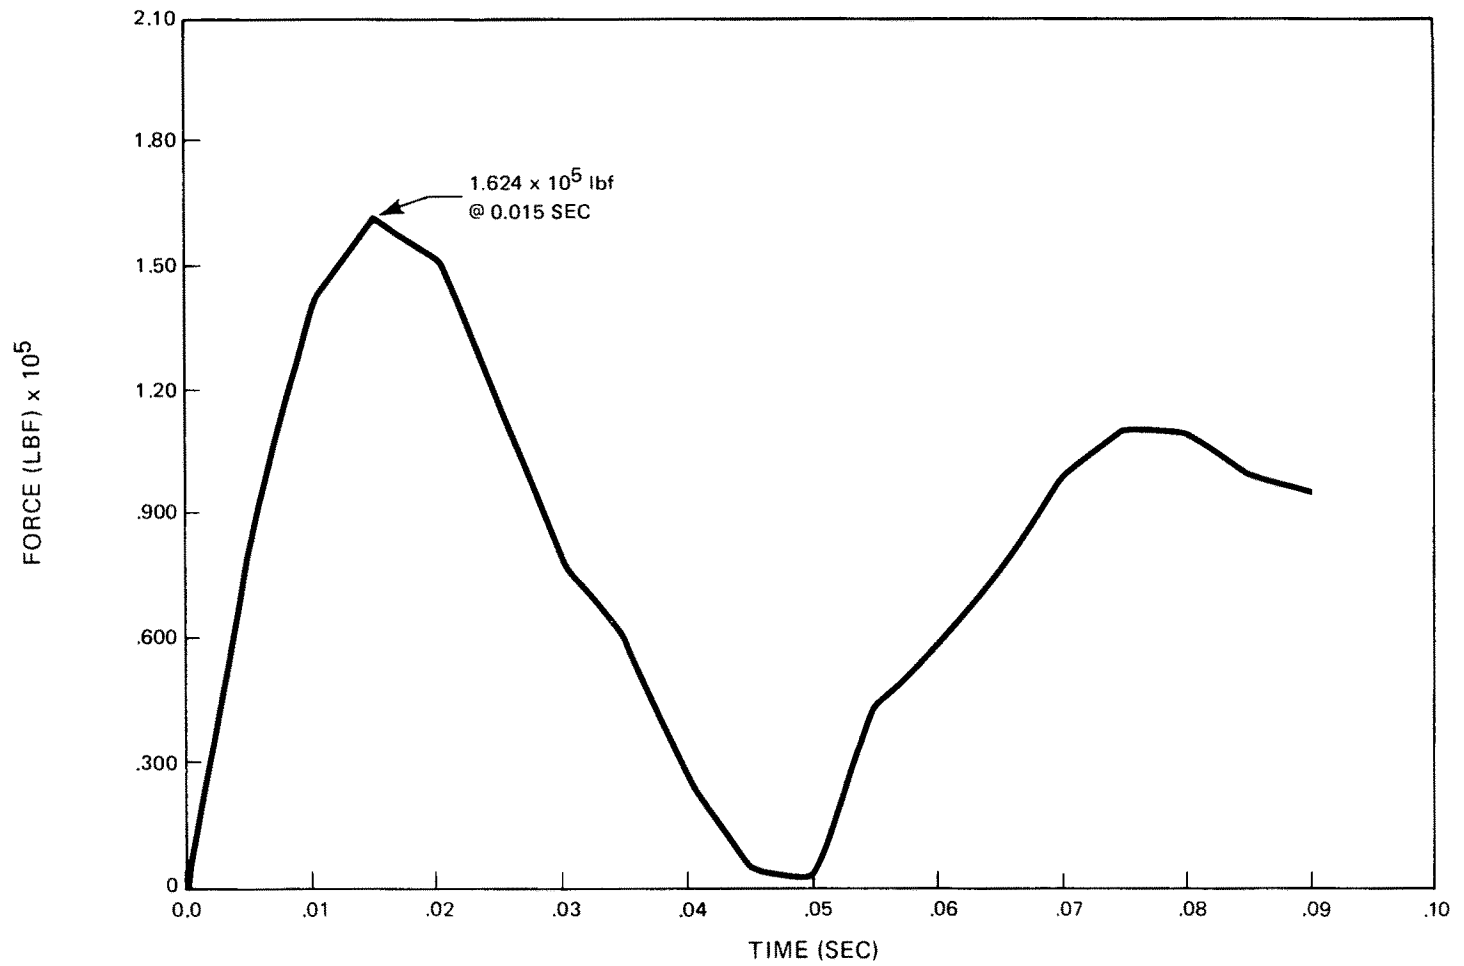

CALLAWAY PLANT

FIGURE 6.2.1-66
STEAM GENERATOR LOOP
COMPARTMENT ANALYSIS
436 IN² PUMP SUCTION LINE BREAK
E-W COMPONENT OF HORIZONTAL FORCE
ON RCP

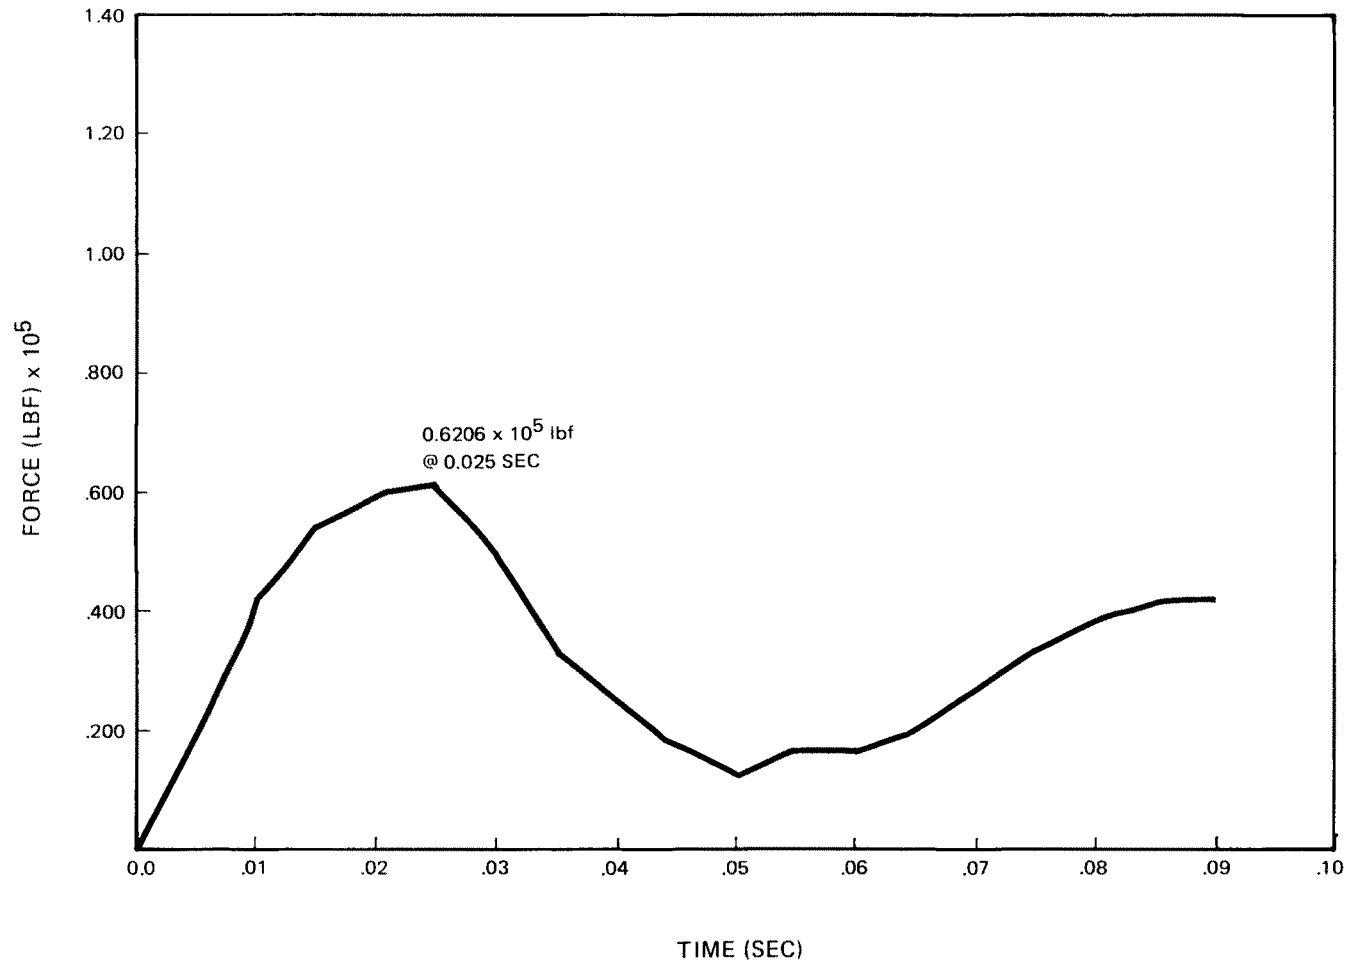


TIME (SEC)


Rev. OL-0
6/86

CALLAWAY PLANT
FIGURE 6.2.1-67
STEAM GENERATOR LOOP
COMPARTMENT ANALYSIS
436 IN² PUMP SUCTION LINE BREAK
VERTICAL FORCE
ON RCP

CALLAWAY PLANT


FIGURE 6.2.1-68
STEAM GENERATOR LOOP
COMPARTMENT ANALYSIS
436 IN² PUMP SUCTION LINE BREAK
DIRECTION OF PEAK HORIZONTAL FORCES
ON REACTOR COOLANT PUMP AND
STEAM GENERATOR

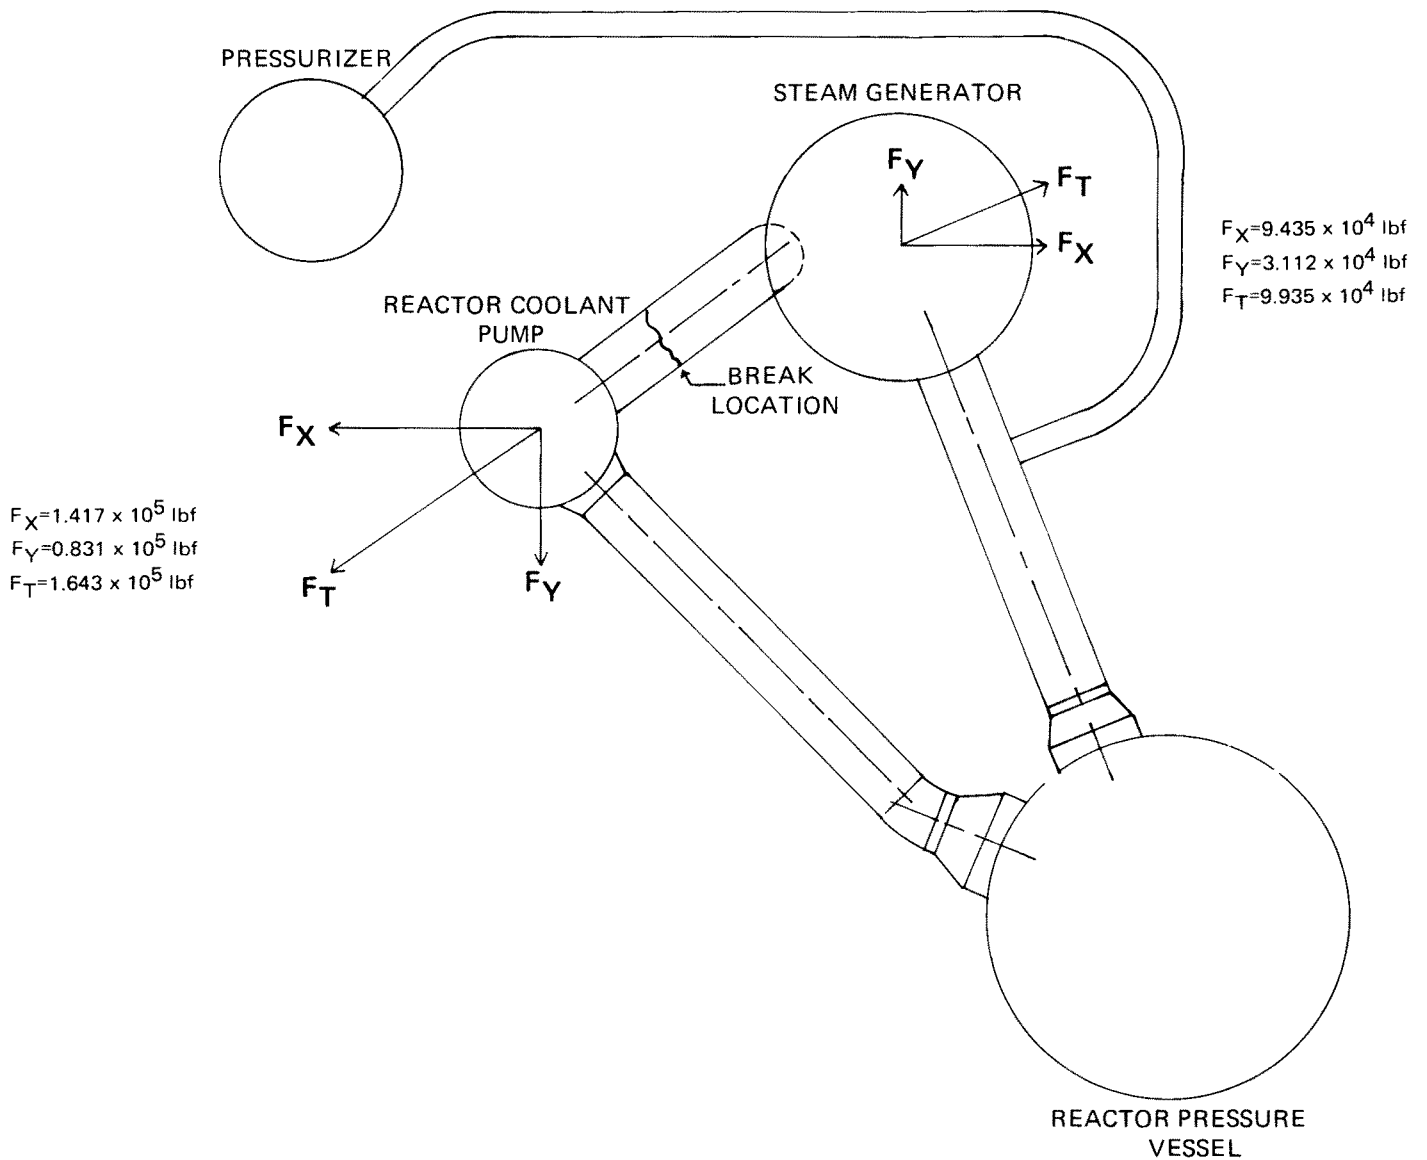

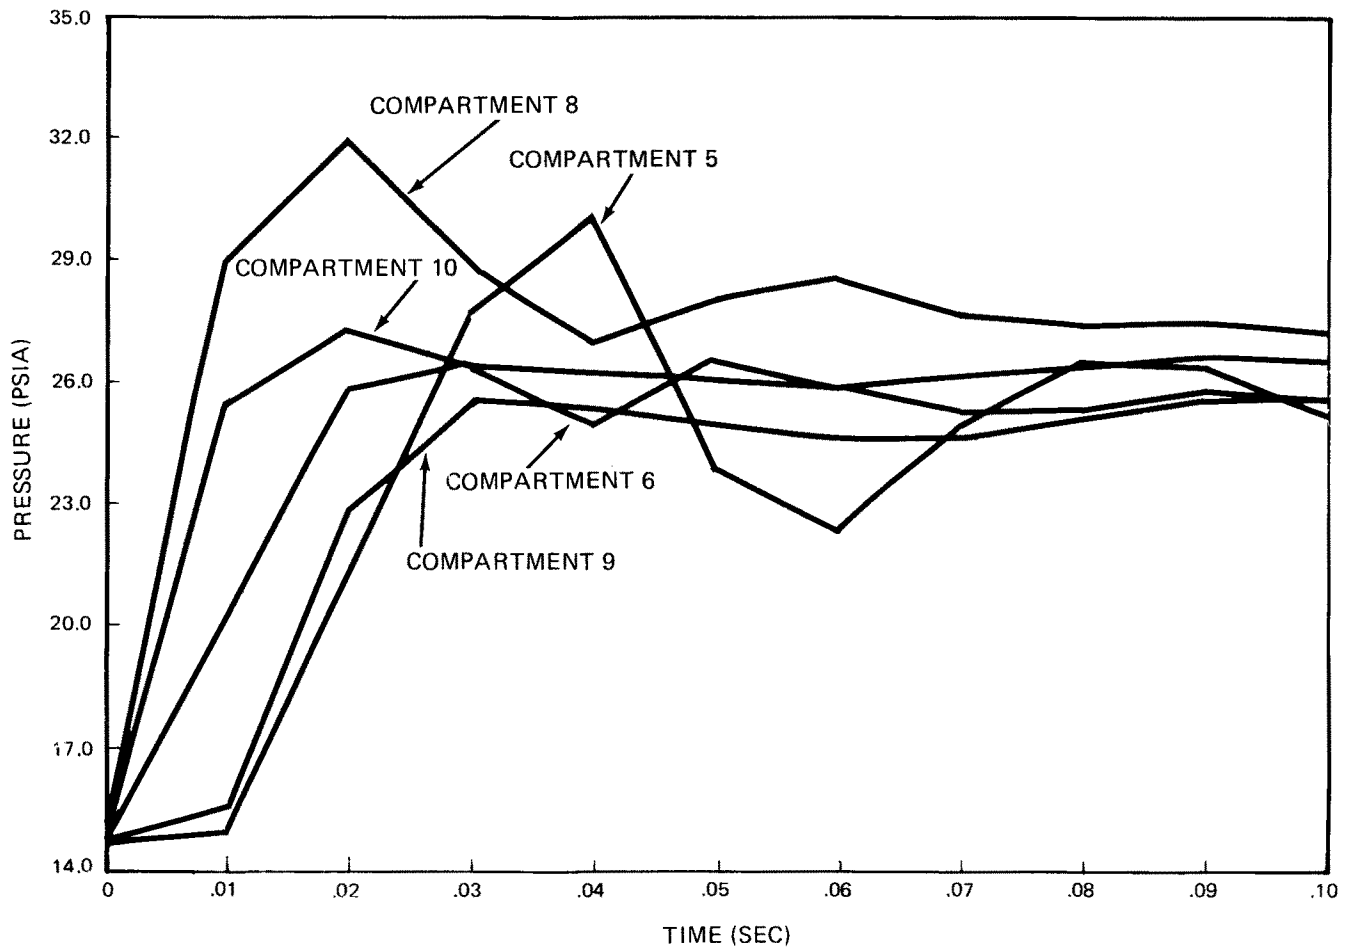


Rev. OL-0
6/86

CALLAWAY PLANT
<p>FIGURE 6.2.1-69 STEAM GENERATOR LOOP COMPARTMENT ANALYSIS 763 IN² HOT LEG BREAK ABSOLUTE PRESSURE NEAR THE BREAK</p>

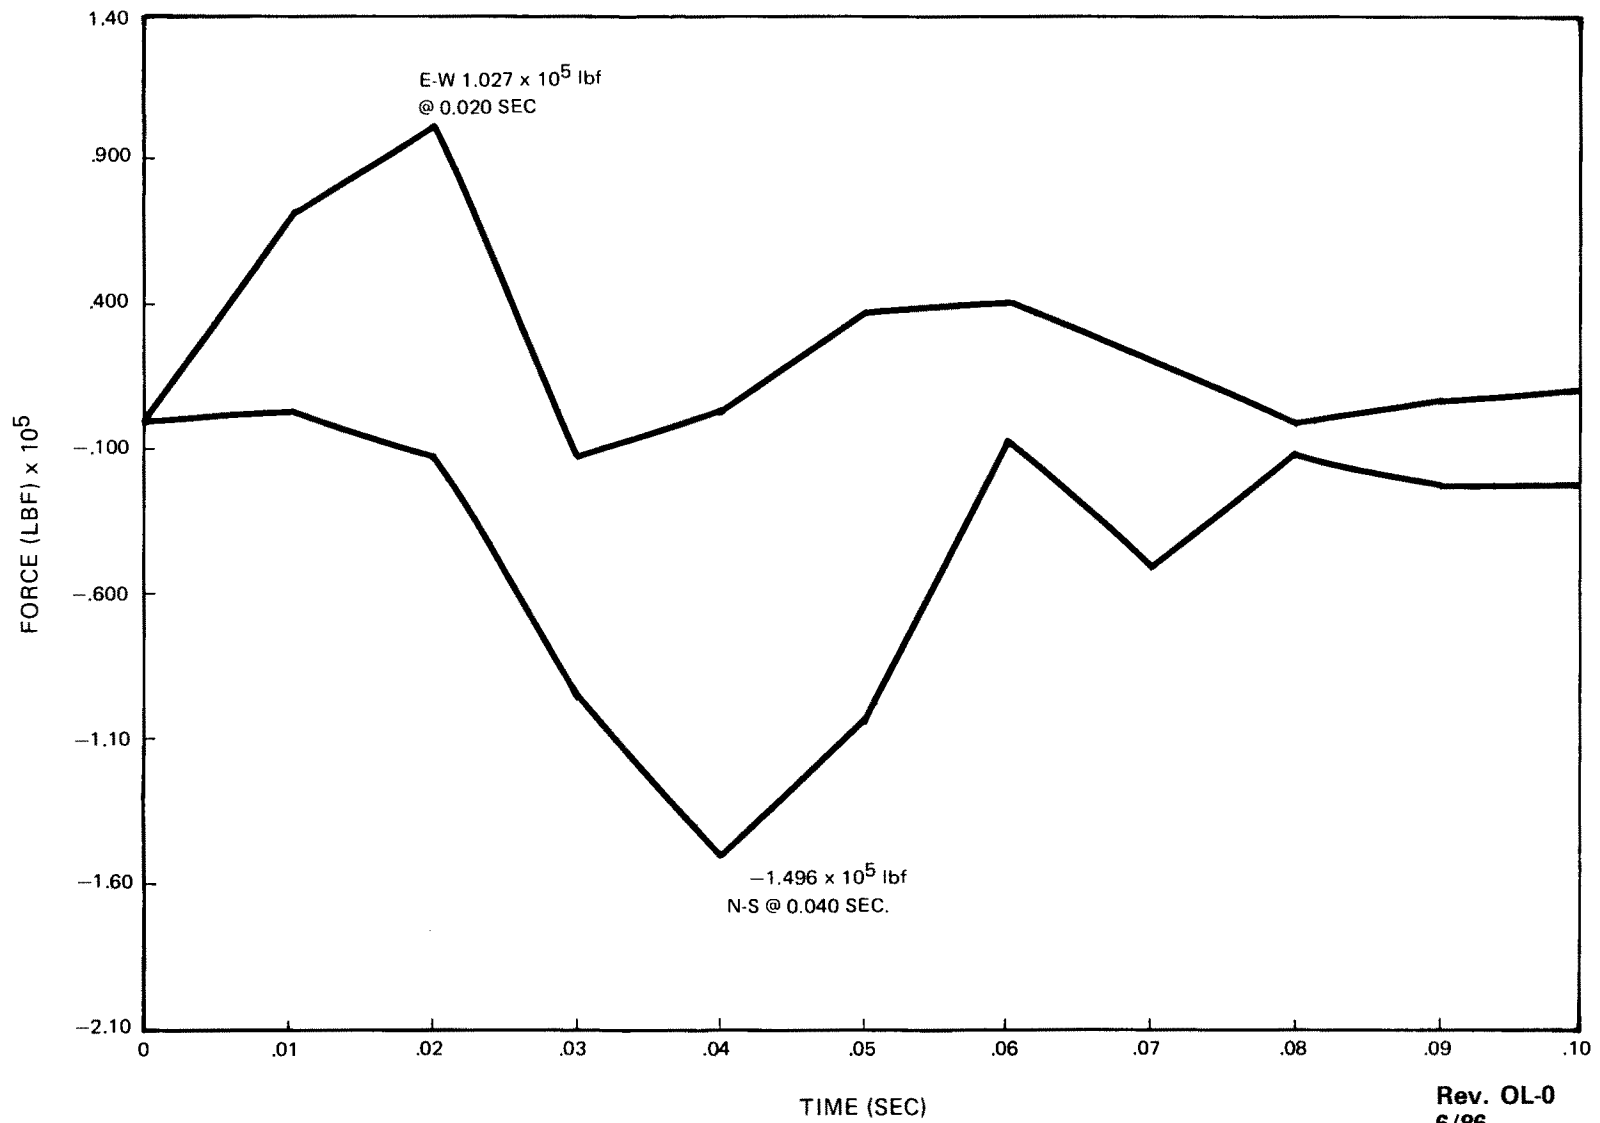

Rev. OL-0
6/86

CALLAWAY PLANT
FIGURE 6.2.1-70
STEAM GENERATOR LOOP
COMPARTMENT ANALYSIS
763 IN² HOT LEG BREAK
HORIZONTAL FORCES ON SG

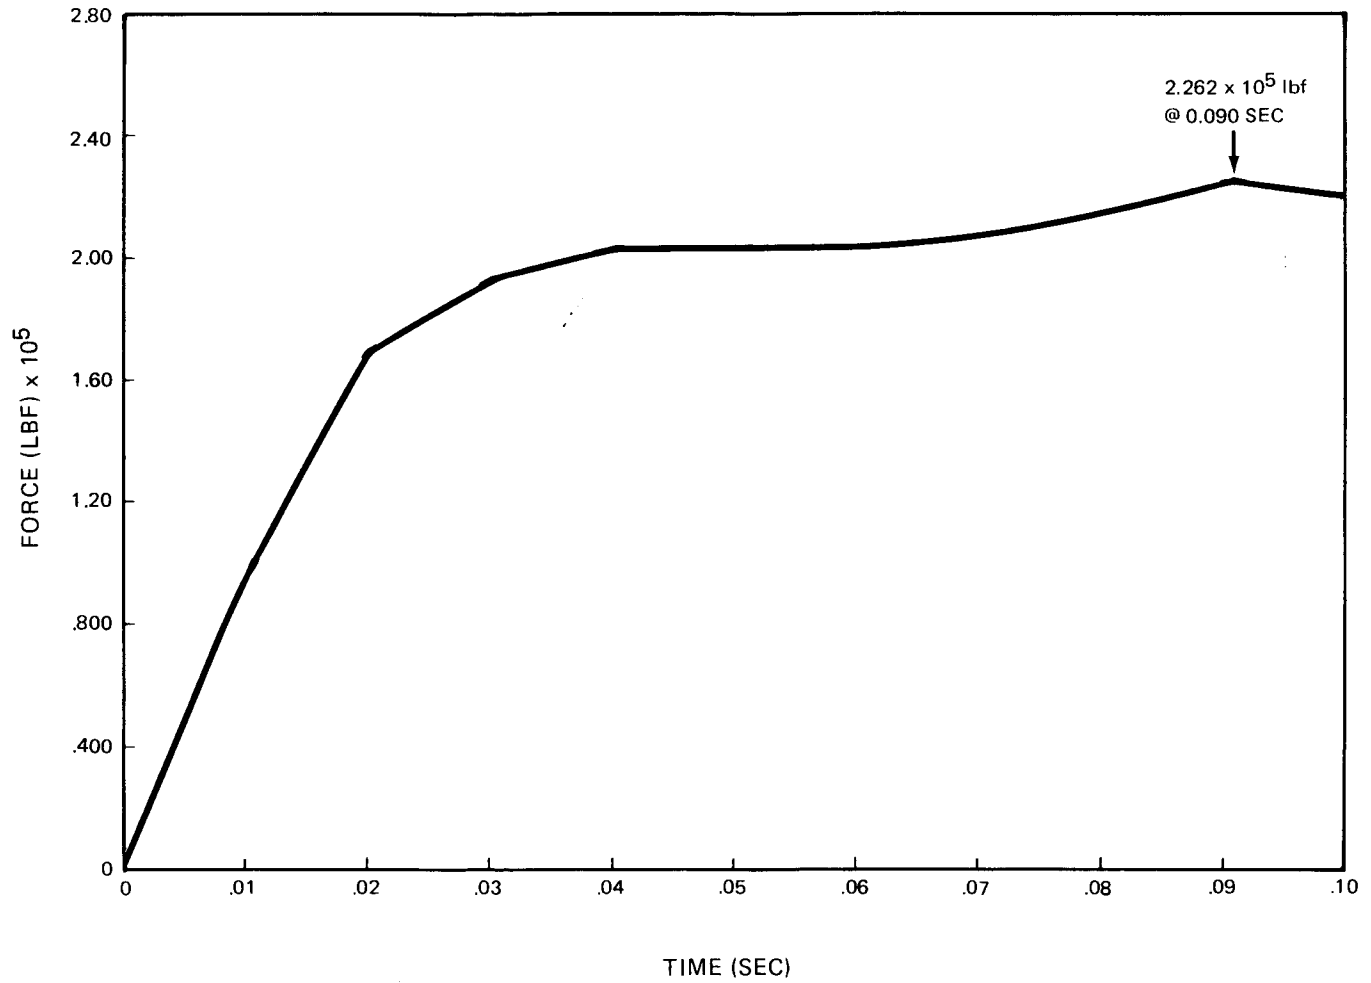


TIME (SEC)

Rev. OL-0
6/86

CALLAWAY PLANT


**FIGURE 6.2.1-71
STEAM GENERATOR LOOP
COMPARTMENT ANALYSIS
763 IN² HOT LEG BREAK
VERTICAL FORCE ON SG**

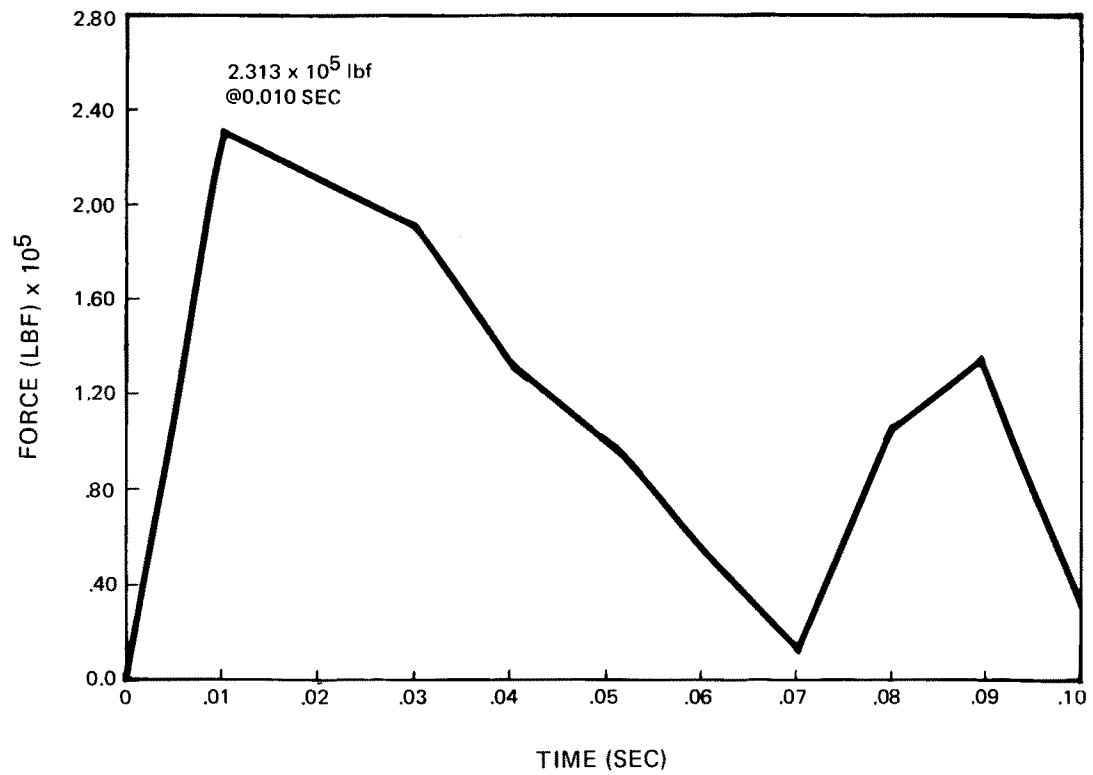

Rev. OL-0
6/86

CALLAWAY PLANT


**FIGURE 6.2.1-72
STEAM GENERATOR LOOP
COMPARTMENT ANALYSIS
763 IN² HOT LEG BREAK
N-S COMPONENT OF
HORIZONTAL FORCE ON RCP**

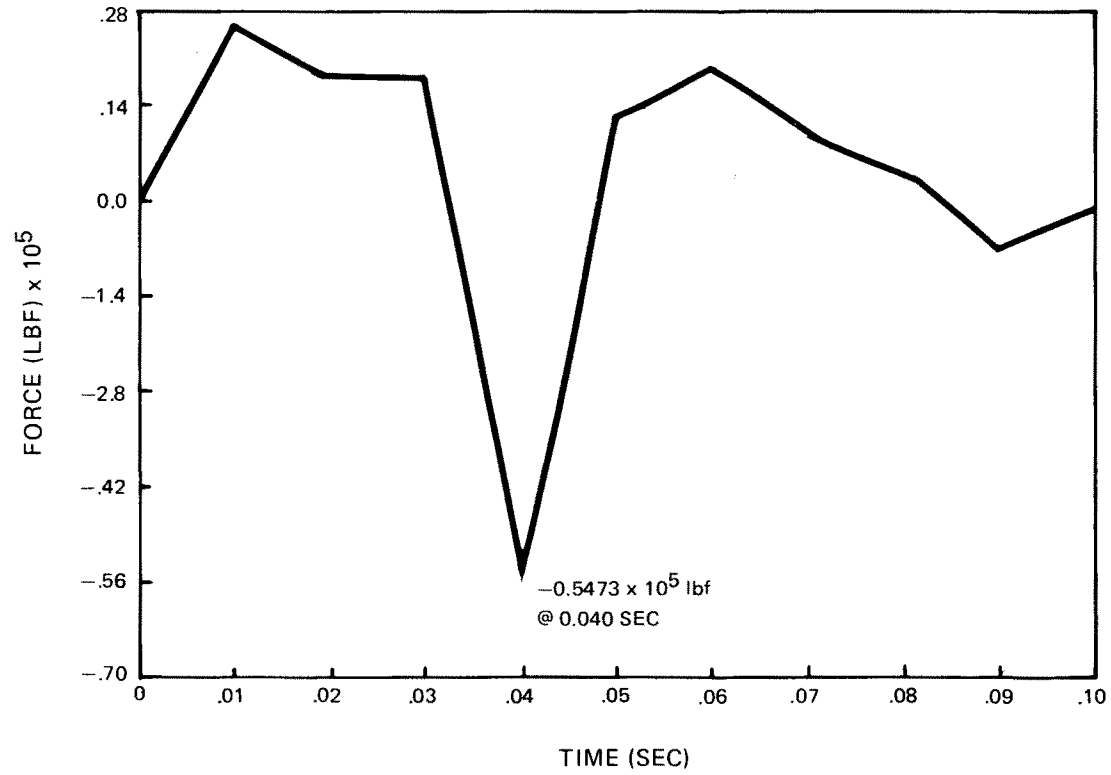

Rev. OL-0
6/86

CALLAWAY PLANT

**FIGURE 6.2.1-73
STEAM GENERATOR LOOP
COMPARTMENT ANALYSIS
763 IN² HOT LEG BREAK
E-W COMPONENT OF
HORIZONTAL FORCE ON RCP**

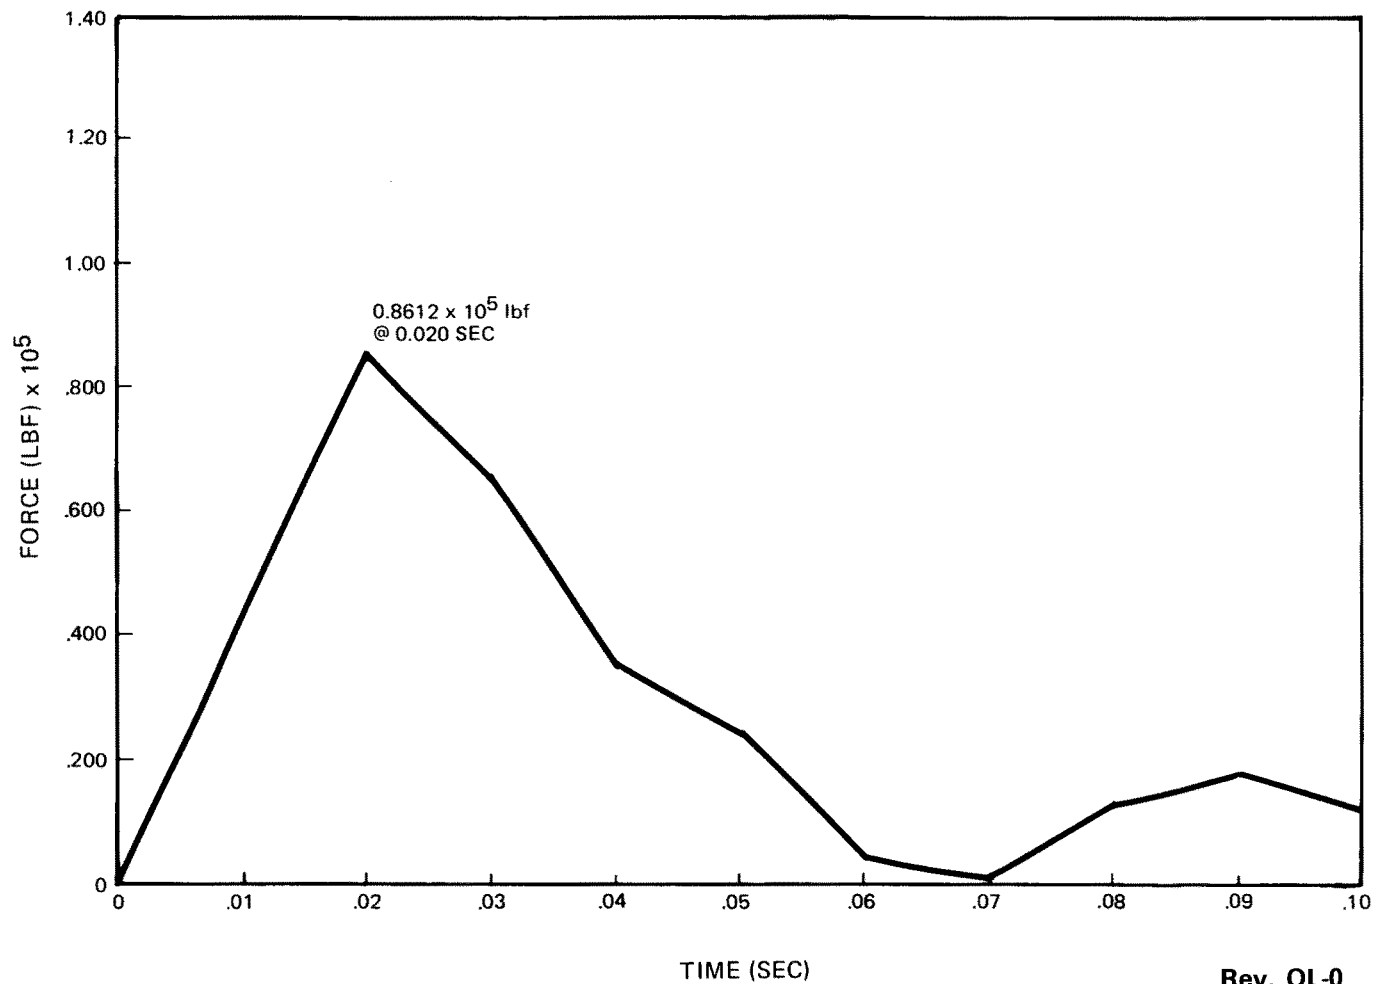



Rev. OL-0
6/86

CALLAWAY PLANT

**FIGURE 6.2.1-74
STEAM GENERATOR LOOP
COMPARTMENT ANALYSIS
763 IN² HOT LEG BREAK
VERTICAL FORCE ON RCP**

CALLAWAY PLANT
FIGURE 6.2.1-75
STEAM GENERATOR LOOP
COMPARTMENT ANALYSIS
763 IN² HOT LEG BREAK
DIRECTION OF PEAK HORIZONTAL FORCES
ON REACTOR COOLANT PUMP
AND STEAM GENERATOR

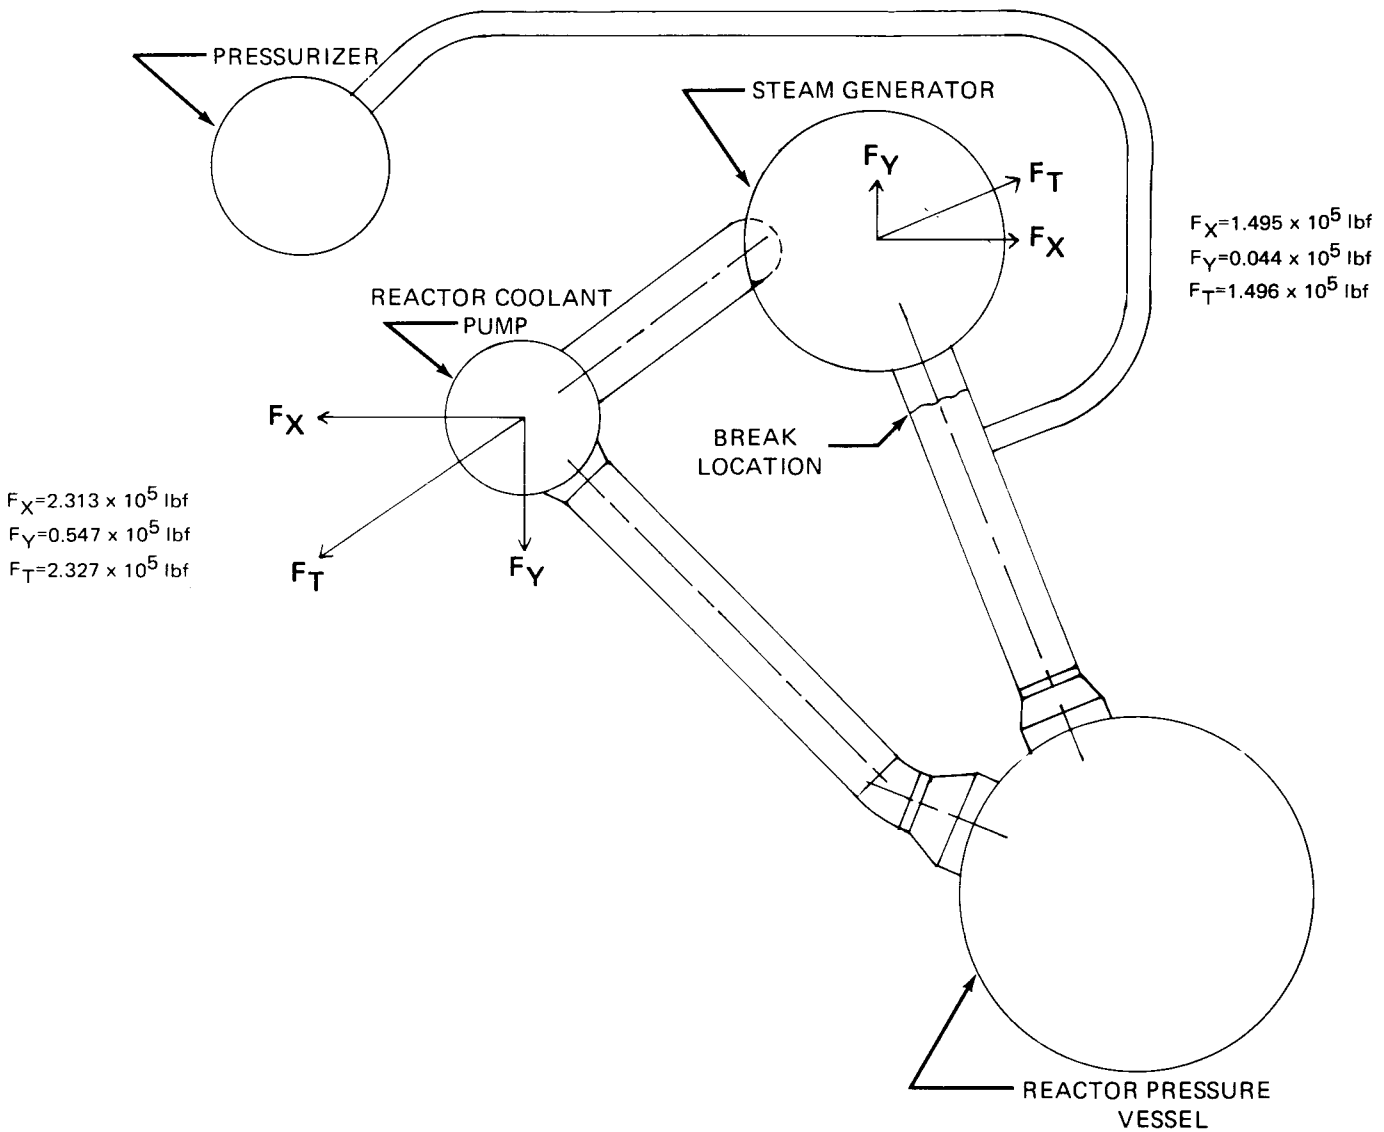


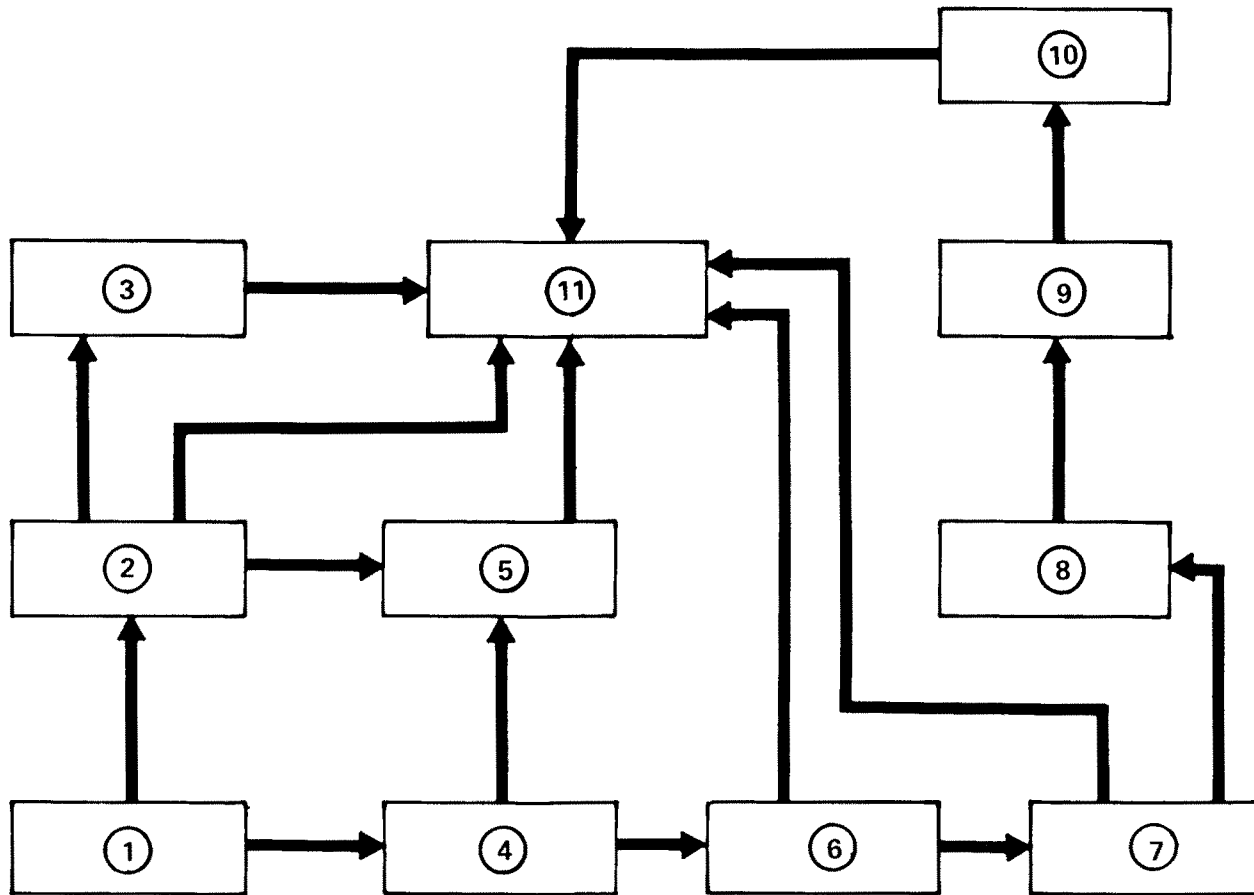


FOR NODE VOLUMES AND VENT PATH AREAS, FLOW COEFFICIENTS AND I/a's, REFER TO TABLES 6.2.1-26 AND 6.2.1-27


Rev. OL-0
6/86

CALLAWAY PLANT
FIGURE 6.2.1-77
FLOW DIAGRAM PRESSURIZER COMPARTMENT ANALYSIS

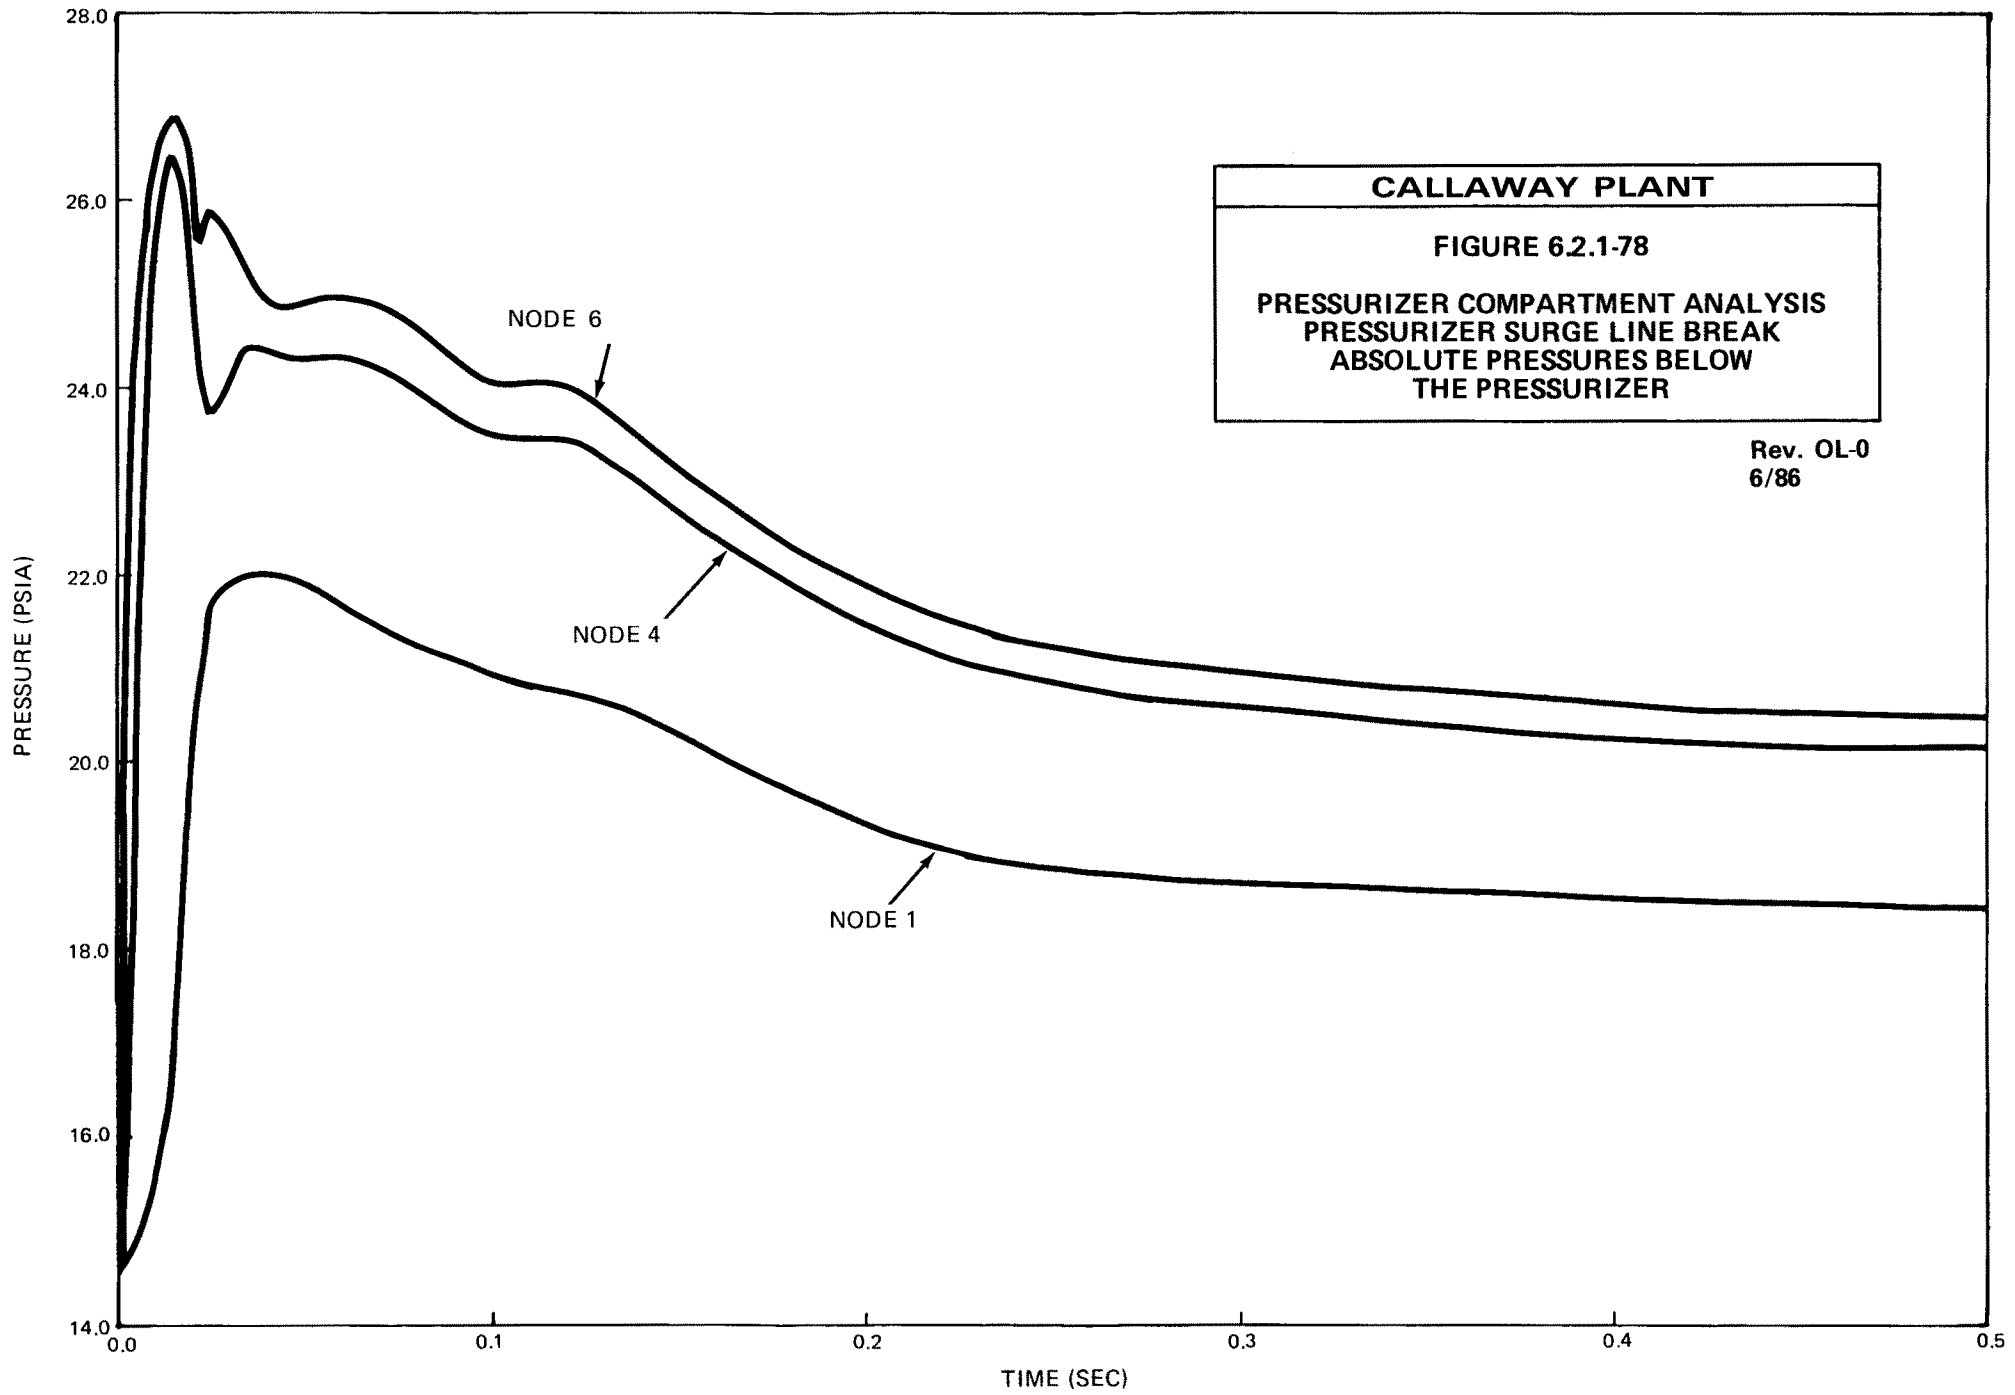


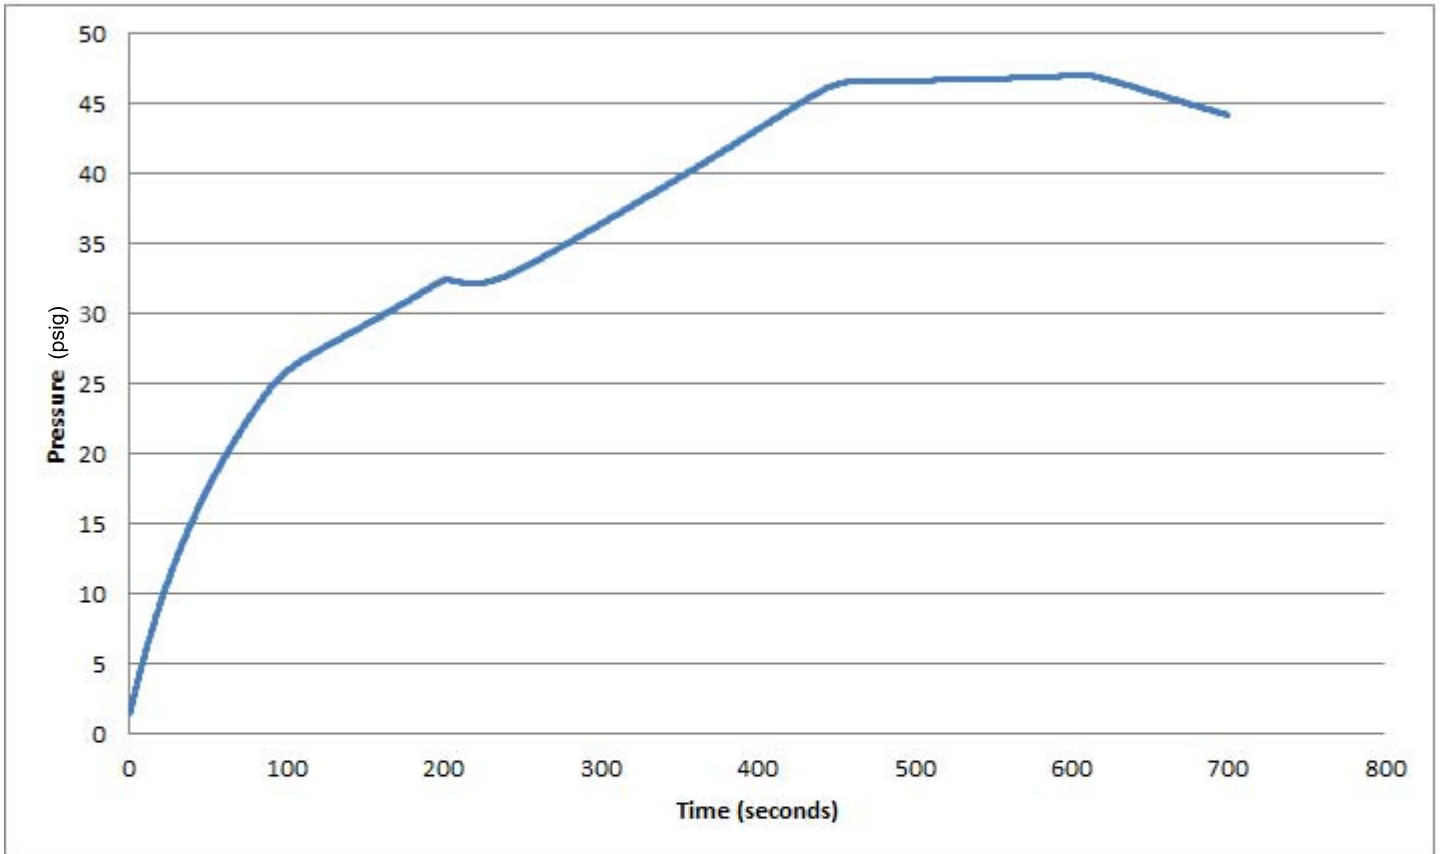


CALLAWAY PLANT
FIGURE 6.2.1-79
MAIN STEAM LINE BREAK ANALYSIS
CASE 24
CONTAINMENT PRESSURE (PSIG)
REV. 17 10/13

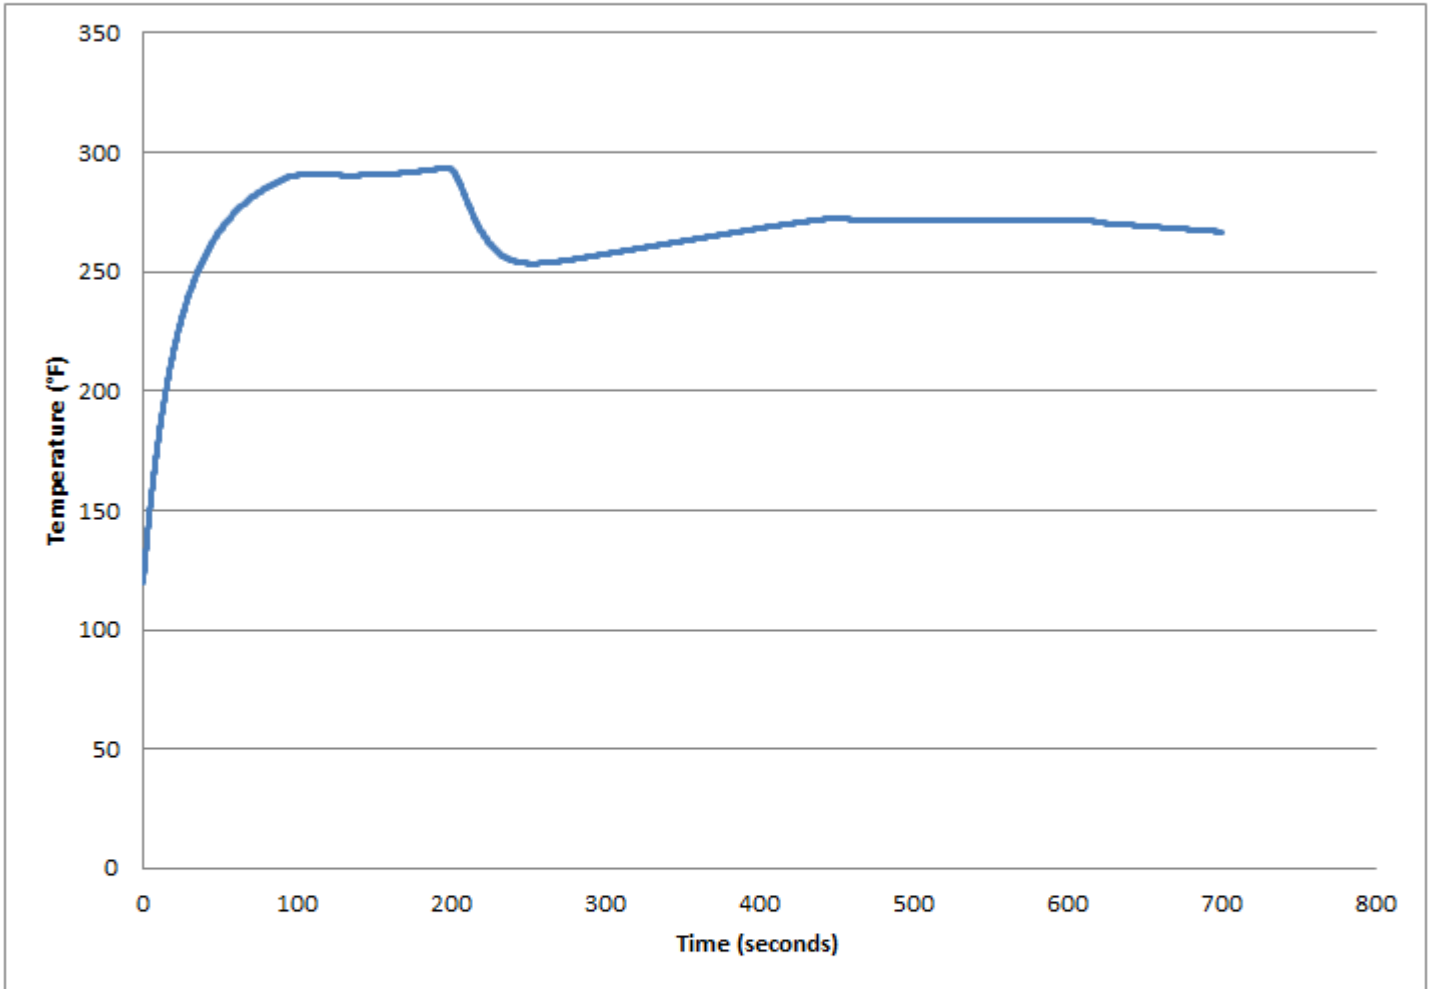


CALLAWAY PLANT
FIGURE 6.2.1-80
MAIN STEAM LINE BREAK ANALYSIS
CASE 24
CONTAINMENT TEMPERATURE (DEGREES F)
REV. 17 10/13

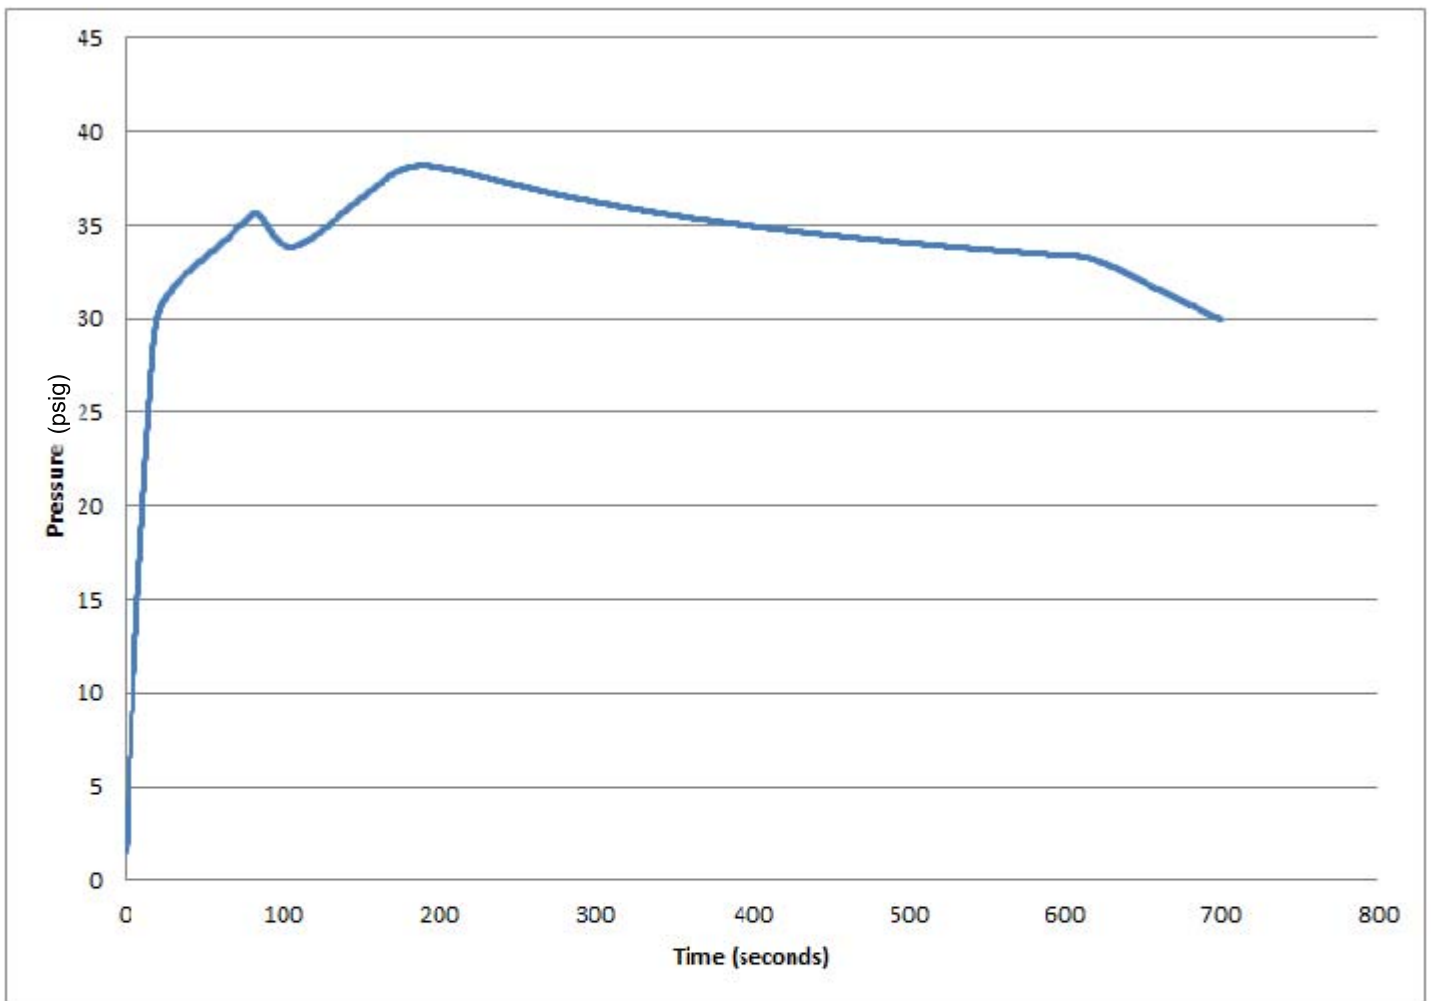

CALLAWAY PLANT
FIGURE 6.2.1-81
MAIN STEAM LINE BREAK ANALYSIS
CASE 1
CONTAINMENT PRESSURE (PSIG)
REV. 18 10/13

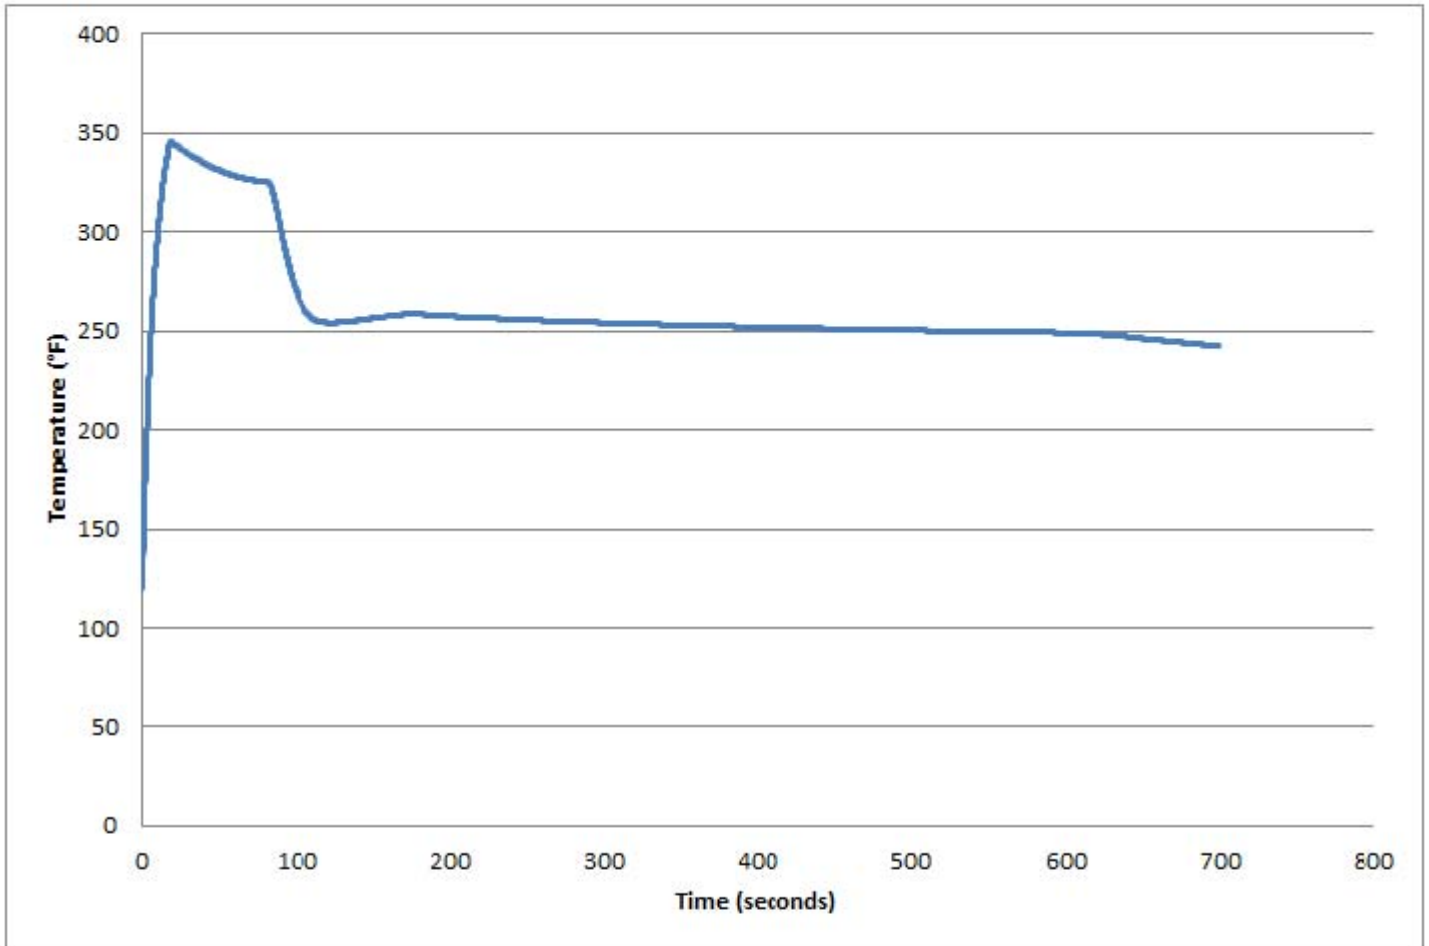

CALLAWAY PLANT
FIGURE 6.2.1-82
MAIN STEAM LINE BREAK ANALYSES
CASE 1
CONTAINMENT TEMPERATURE (DEGREES F)
REV. 18 10/13

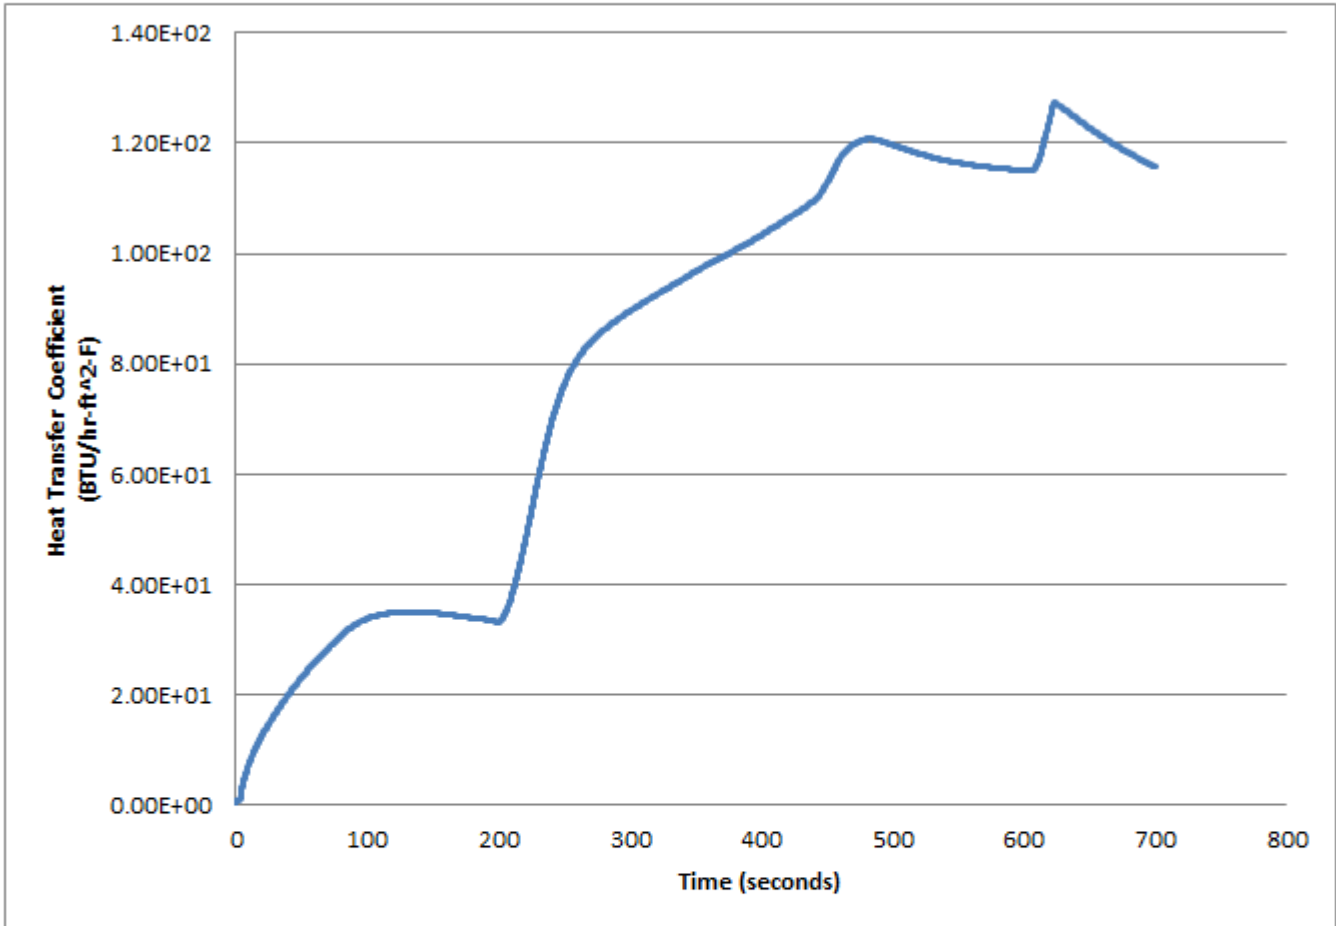

CALLAWAY PLANT


FIGURE 6.2.1-83

MAIN STEAM LINE BREAK ANALYSIS


CASE 24


UCHIDA CONDENSING HEAT TRANSFER COEFFICIENT

REV. 17 10/13

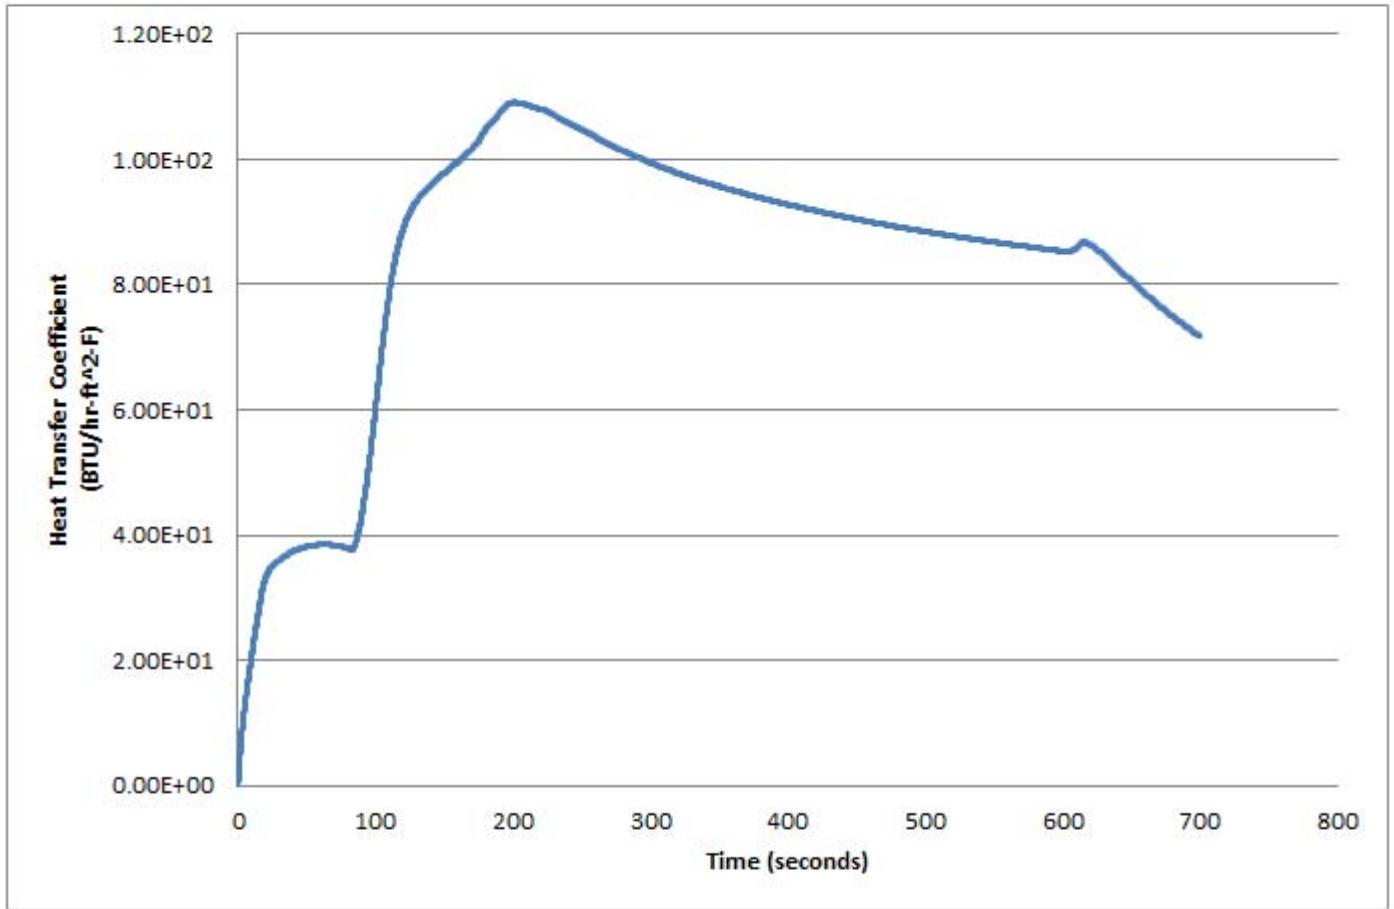

CALLAWAY PLANT
FIGURE 6.2.1-84
MAIN STEAM LINE BREAK ANALYSIS
CASE 1
UCHIDA CONDENSING HEAT TRANSFER COEFFICIENT
REV. 18 10/13

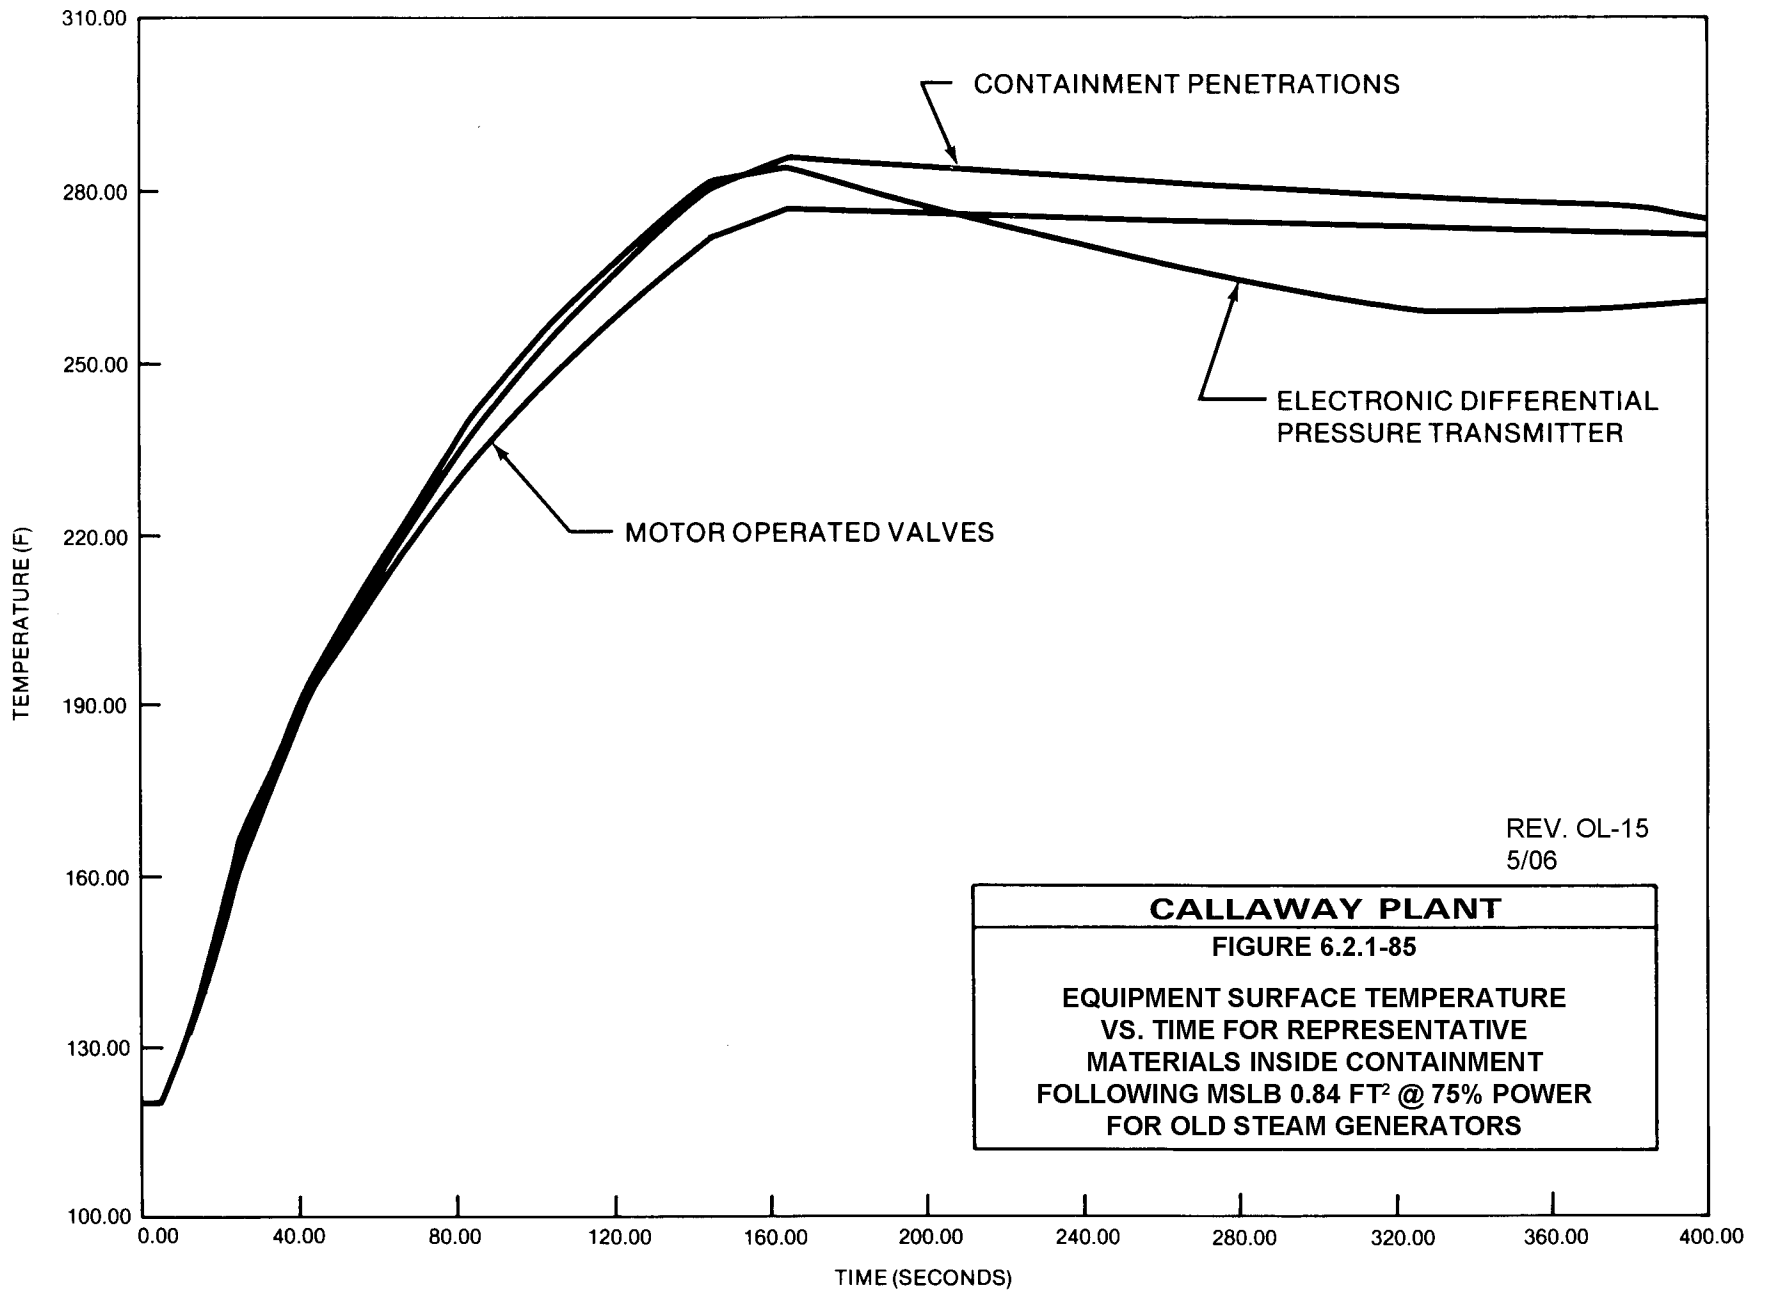

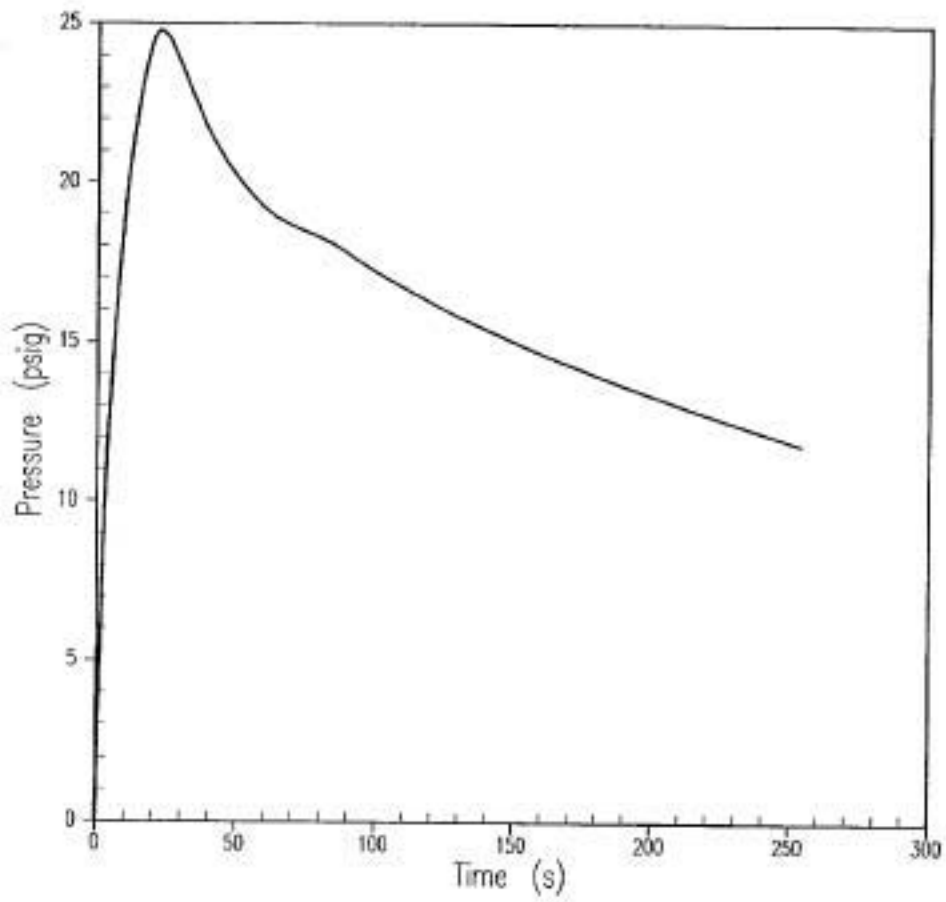


REV. OL-16
5/88

CALLAWAY PLANT

FIGURE 6.2.1-08

CONTAINMENT BACKPRESSURE
DECLG ($C_p=0.6$)
HIGHT_{AVE} MINIMUM SI

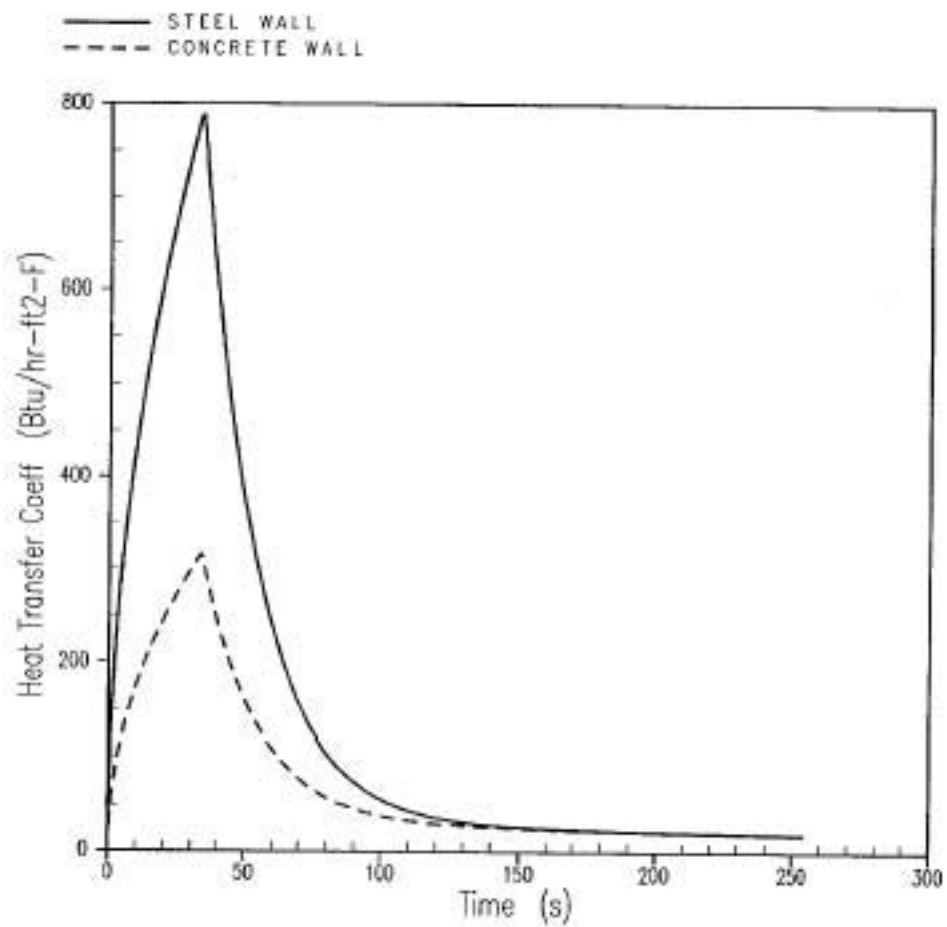


REV. 16
 10/06

CALLAWAY PLANT

FIGURE 6.2.1-87

CONDENSING WALL HEAT TRANSFER COEFFICIENT
 decay ($C_p = 0.6$)
 HIGH $T_{w/D}$ MINIMUM SI

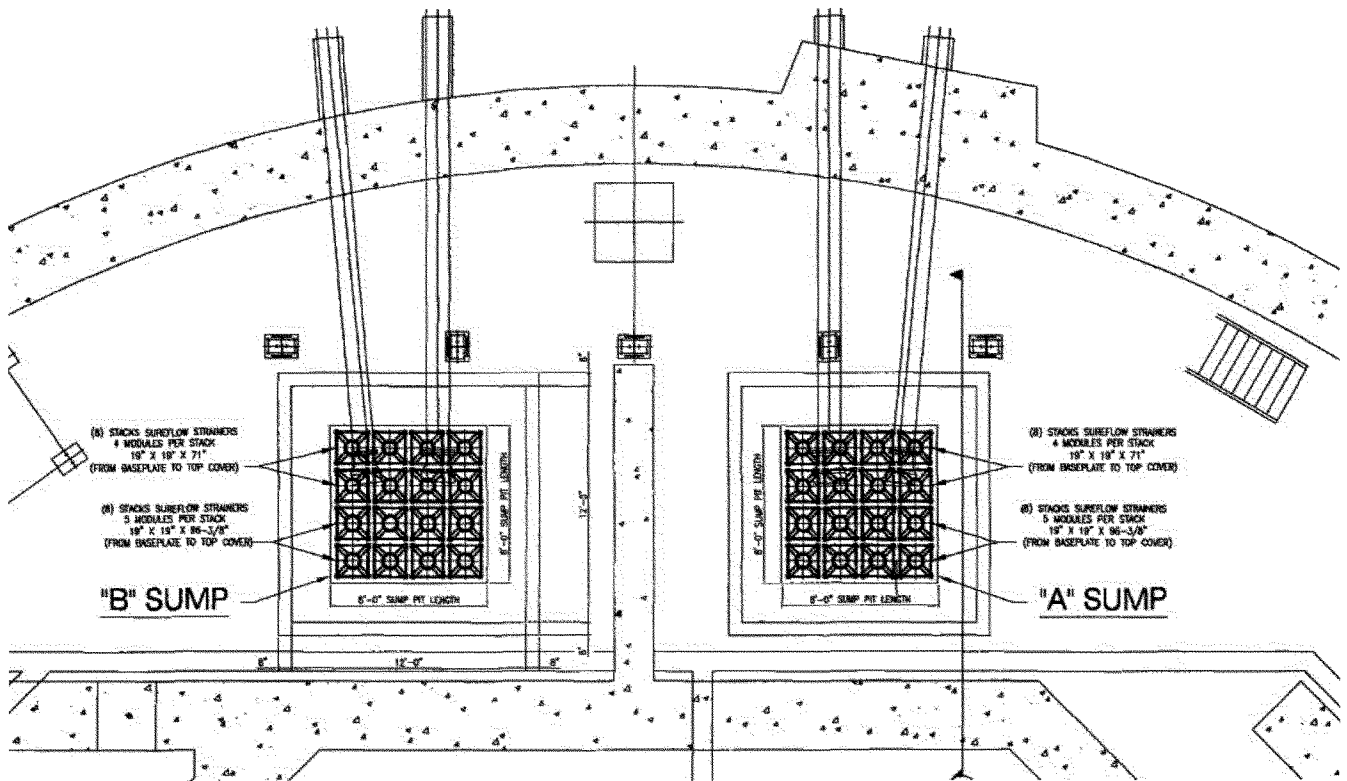


CALLAWAY PLANT


FIGURE 6.2.2-3
SHEET 1

RECIRCULATION SUMP STRAINER
ARRANGEMENT

REV. 10 10/07

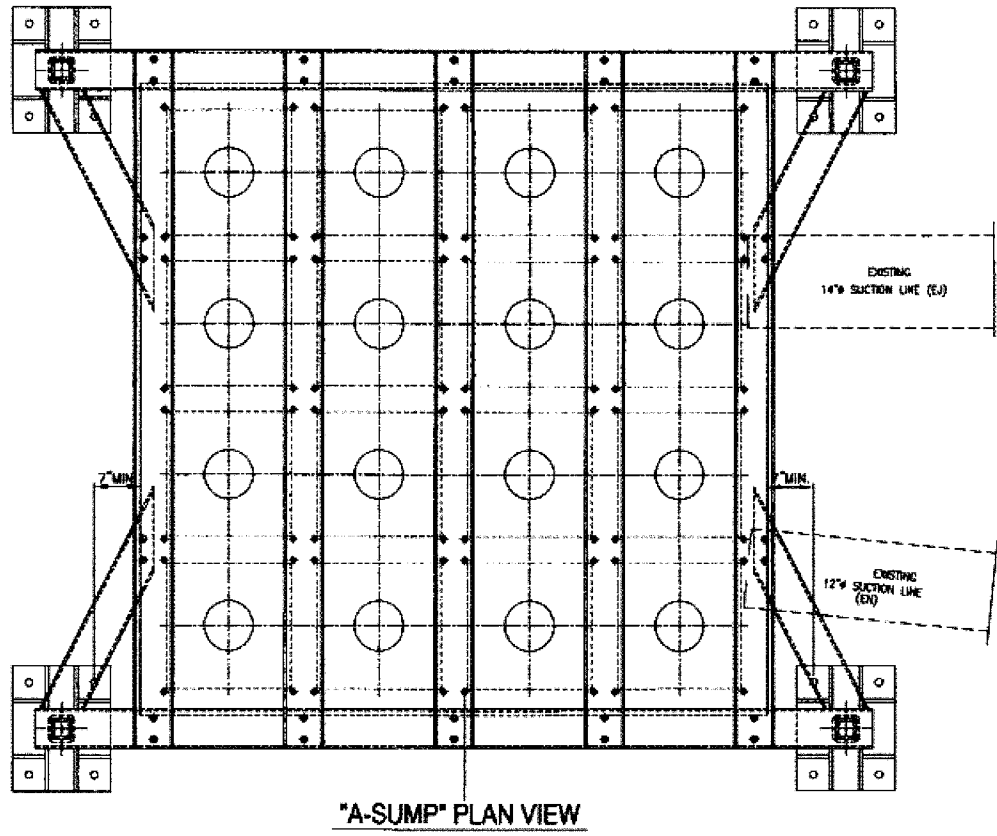


CALLAWAY PLANT
FIGURE 6.2.2-3 SHEET 2
RECIRCULATION SUMP STRAINER ARRANGEMENT
REV. 1 10/07

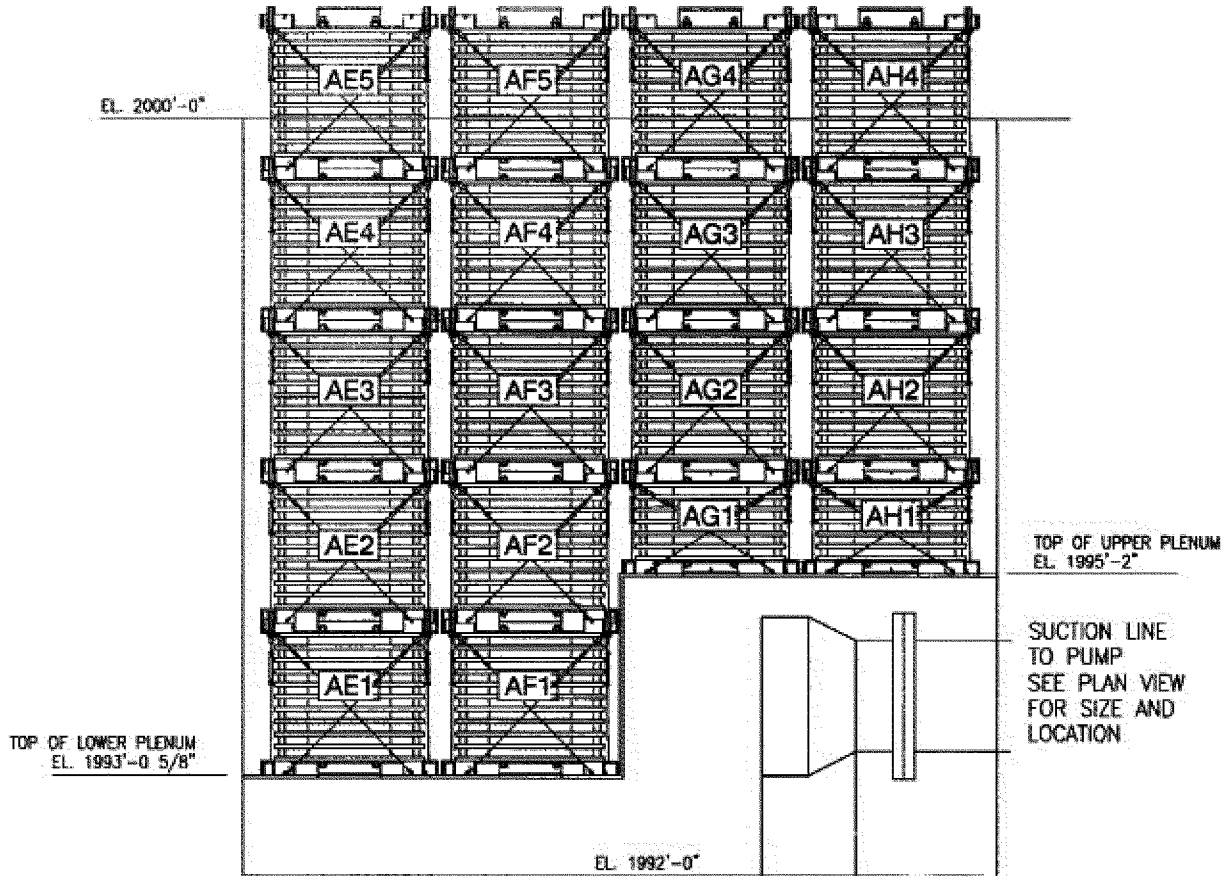

CALLAWAY PLANT
FIGURE 6.2.2-3 SHEET 3
RECIRCULATION SUMP STRAINER ARRANGEMENT
REV. 1 10/07

**FIGURE 6.2.2-3
SHEET 5 THROUGH 10**


DELETED

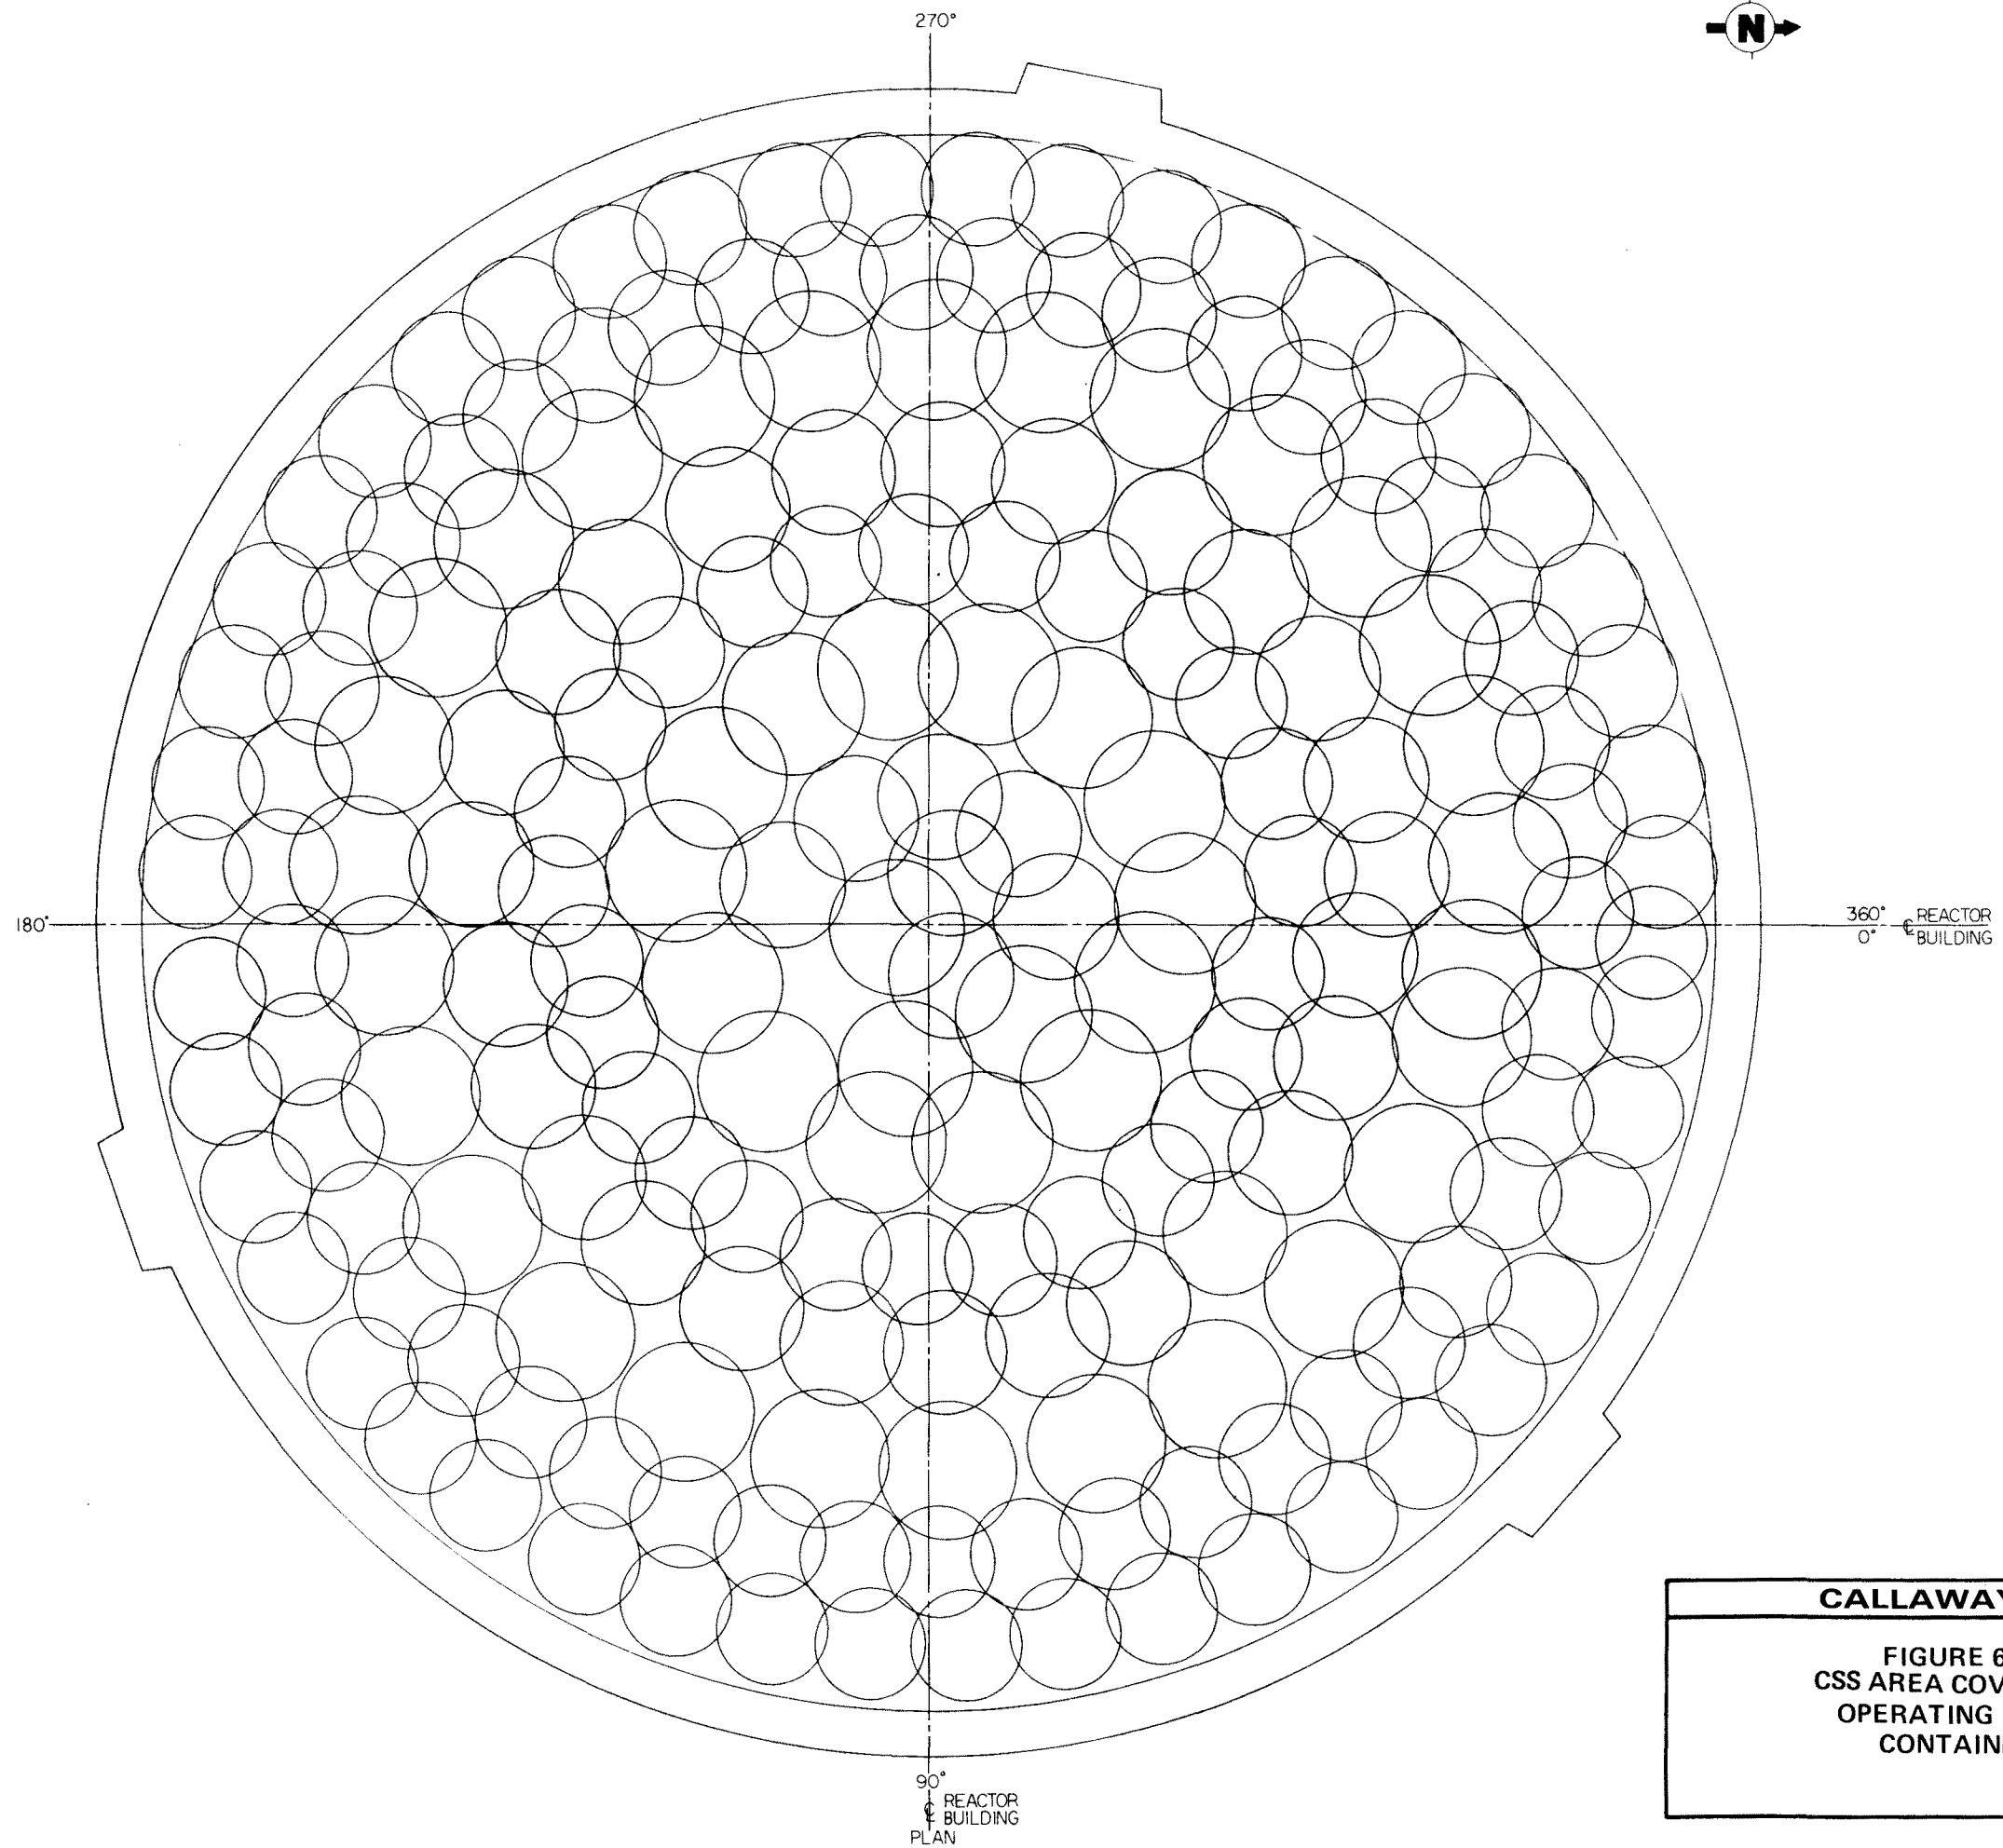

Rev. OL-0
6/86

CALLAWAY PLANT

**FIGURE 6.2.2-4
CSS AREA COVERAGE AT
OPERATING DECK OF
CONTAINMENT**

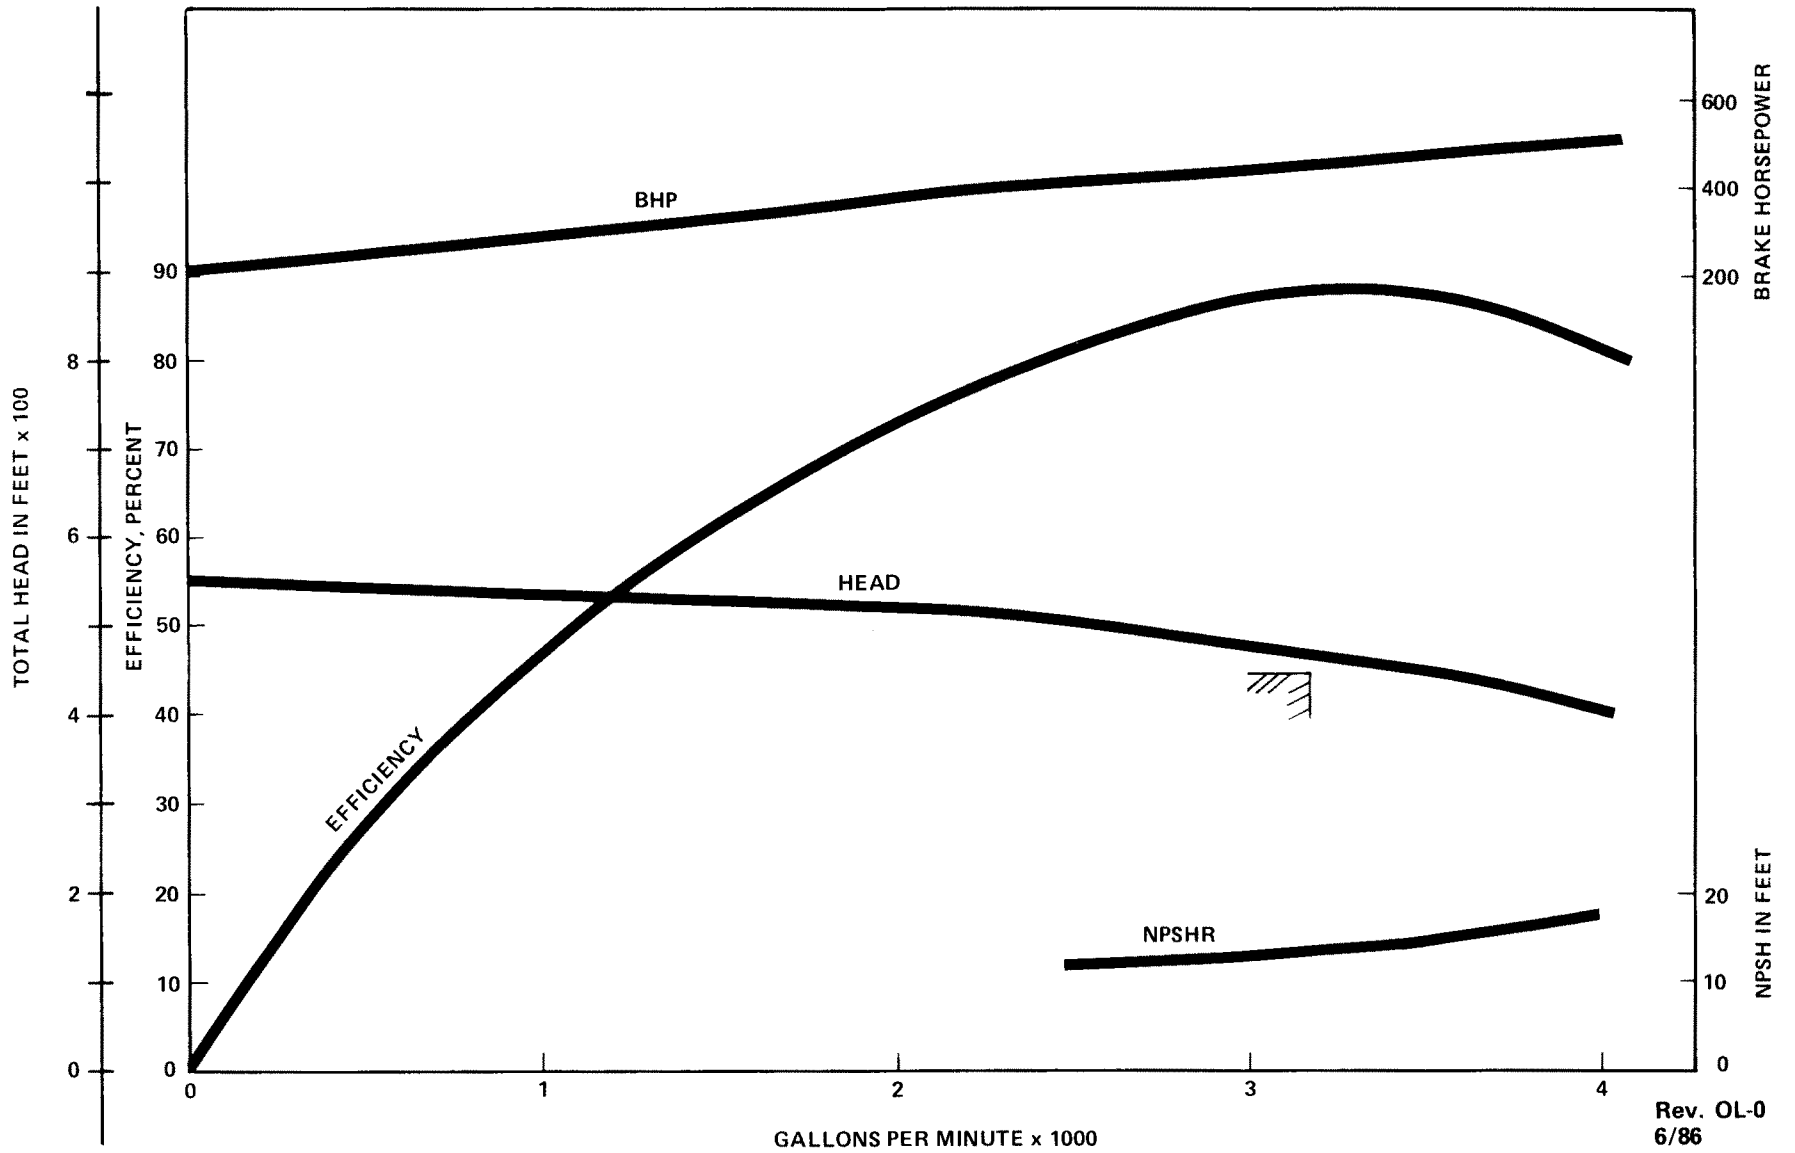


Rev. OL-0
6/86

CALLAWAY PLANT

FIGURE 6.2.2-5

CSS PUMP

PERFORMANCE CURVE

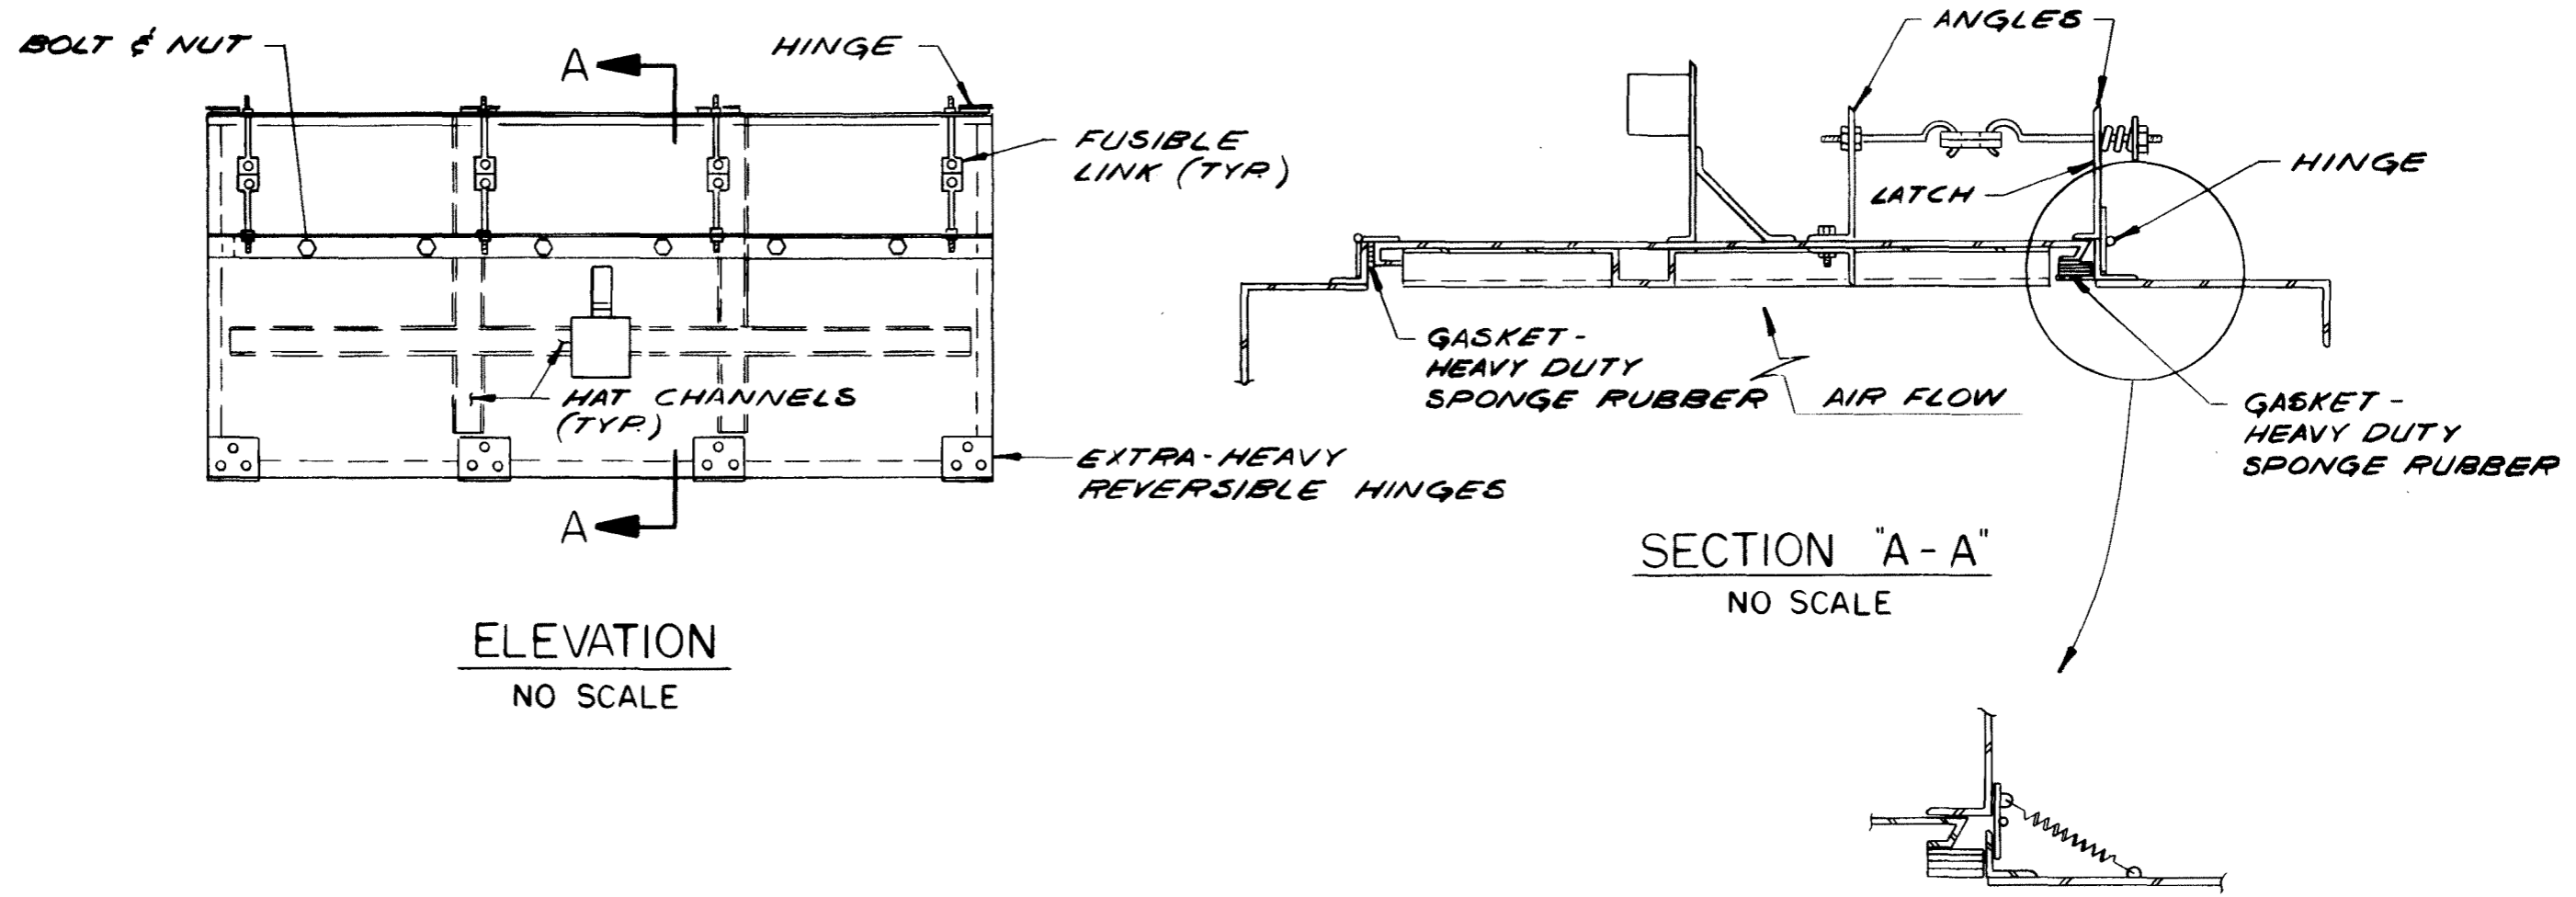

ELEVATION
NO SCALE

SECTION "A-A"
NO SCALE

Rev. OL-0
6/86

<p>CALLAWAY PLANT</p> <p>FIGURE 6.2.2-6 TYPICAL DETAIL OF FUSIBLE LINK PLATES ON CONTAINMENT AIR COOLERS</p>
--

VALVE NO.	LINE / VALVE SIZE, IN.	INSIDE / OUTSIDE CONT.	NORMAL FLOW DIRECTION	VALVE TYPE	VALVE OPERATOR	POWER SOURCE	PRIMARY ACTUATION SIGNAL	SECONDARY ACTUATION SIGNAL	MAXIMUM CLOSURE TIME (SEC.) (NOTE 4)	VALVE POSITION				
										NORMAL	SHUTDOWN	POWER FAILURE	POST ACCIDENT	
													PRIMARY	SECONDARY
ABPV0004	10/8	OUTSIDE	OUT	GLOBE	AIR	4	NONE	REM/MAN	20	CLOSED	CLOSED	CLOSED	CLOSED	OPEN
ABHV0011	28/28	OUTSIDE	OUT	GATE	HYDRAULIC (2)	1, 4	SLIS	NONE	(3)	OPEN	OPEN	CLOSED	CLOSED	N/A
ABHV0012	2/2	OUTSIDE	OUT	GLOBE	AIR	1, 4	SLIS	NONE	15	CLOSED	CLOSED	CLOSED	CLOSED	N/A
ABV0045-49	6/8 X 6	OUTSIDE	OUT	RELIEF	SELF ACT	N/A	N/A	N/A	N/A	CLOSED	CLOSED	N/A	N/A	N/A
ABL0010	1/2	OUTSIDE	OUT	GLOBE	AIR	1, 4	SLIS	NONE	15	OPEN	OPEN	CLOSED	CLOSED	N/A
ABV0050	1/1	OUTSIDE	OUT	GATE	MANUAL	N/A	N/A	N/A	N/A	CLOSED	CLOSED	N/A	CLOSED	N/A
(VALVES BELOW NOT SHOWN IN SKETCH)														
ABV0726 728, 730, 732	3/4 / 3/4	INSIDE	N/A	GLOBE	MANUAL	N/A	N/A	N/A	N/A	CLOSED	CLOSED	N/A	CLOSED	N/A
ABV0001	1/1	INSIDE	N/A	GLOBE	MANUAL	N/A	N/A	N/A	N/A	CLOSED	CLOSED	N/A	CLOSED	N/A

ENGINEERED SAFETY FEATURE SYSTEM	YES <input checked="" type="checkbox"/> NO <input type="checkbox"/>
FLUID CONTAINED:	STEAM
LENGTH OF PIPING TO OUTERMOST ISOLATION VALVE:	53.2 FT.
APPLICABLE GDC NO.	NONE

GENERAL COMMENTS:

THE CONTAINMENT PENETRATIONS ASSOCIATED WITH THE STEAM GENERATORS ARE NOT SUBJECT TO GDC-57, SINCE THE CONTAINMENT BARRIER INTEGRITY IS NOT BREACHED. THE BOUNDARY OR BARRIER AGAINST FISSION PRODUCT LEAKAGE TO THE ENVIRONMENT IS THE INSIDE OF THE STEAM GENERATOR TUBES AND THE OUTSIDE OF THE LINES EMANATING FROM THE STEAM GENERATOR SHELLS.

THE PENETRATION CONFIGURATION IS PRESENTED FOR FIGURE 6.2.4-1 COMPLETENESS. NONE OF THE VALVES SHOWN ARE CONTAINMENT ISOLATION VALVES.

NOTE 1: AS SHOWN ON FIGURE 10.3-1, THE STEAM GENERATOR SHELL EXTENDS TO THE VENT VALVES ON THE CONDENSATE POTS FOR THE MAIN STEAM FLOW TRANSMITTERS. THE STEAM GENERATOR AND STEAM PIPING/INSTRUMENTATION LINES INSIDE OF CONTAINMENT ARE NOT SHOWN HERE. REFERENCE FIG. 10.3-1 FOR DETAILS OF THE PIPING INSTRUMENTATION AND VALVE CONFIGURATION / IDENTIFICATION.


NOTE 2: OPERATOR UTILIZES SYSTEM-MEDIUM AS THE PROCESS FLUID.

NOTE 3: CLOSURE TIME IS SYSTEM PRESSURE DEPENDENT. MAX CLOSURE TIME CURVE IS DEFINED IN THE TECHNICAL SPECIFICATION BASES.

NOTE 4: MAXIMUM CLOSURE TIMES SPECIFIED IN THIS FIGURE ARE NOMINAL. DESIGN OR LICENSING-BASIS VALUES. PERFORMANCE-BASED VALVE OPERABILITY LIMITS FOR VALVE CLOSURE TIMES ARE SPECIFIED PER THE INSERVICE TESTING PROGRAM FOR CALLAWAY.

APPENDIX J REQUIREMENT

- TYPE A
 B
 C
 NONE

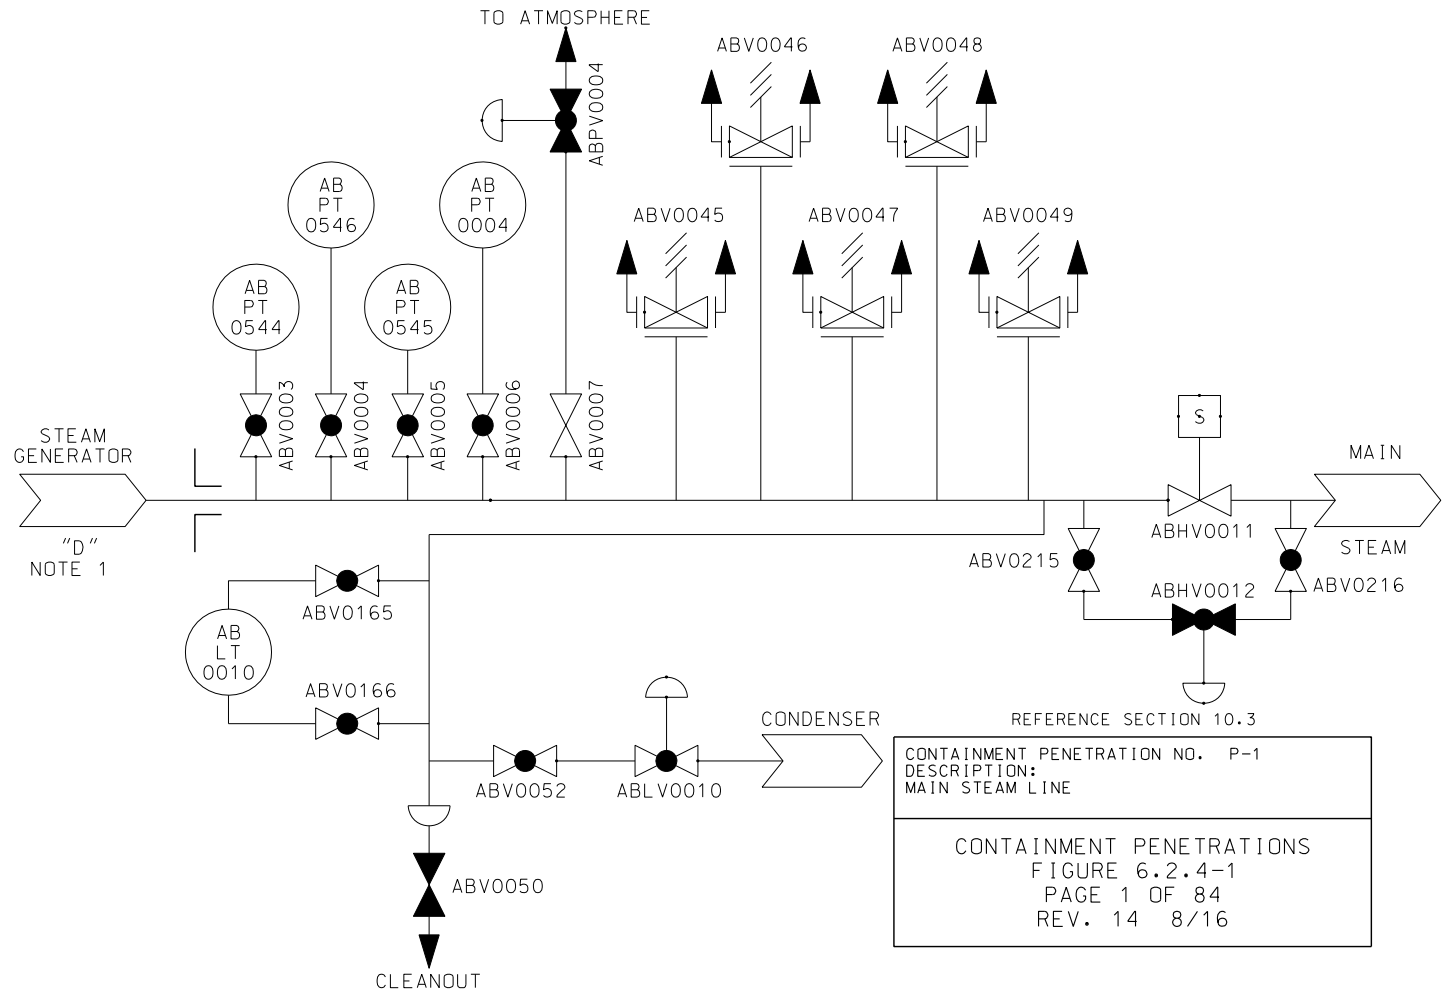

VALVE NO.	LINE/VALVE SIZE, IN.	INSIDE/OUTSIDE CONT.	NORMAL FLOW DIRECTION	VALVE TYPE	VALVE OPERATOR	POWER SOURCE	PRIMARY ACTUATION SIGNAL	SECONDARY ACTUATION SIGNAL	MAXIMUM CLOSURE TIME (SEC.) (NOTE 4)	VALVE POSITION				
										NORMAL	SHUTDOWN	POWER FAILURE	POST ACCIDENT	
													PRIMARY	SECONDARY
ABPV0001	10/8	OUTSIDE	OUT	GLOBE	AIR	1	NONE	REM/MAN	20	CLOSED	CLOSED	CLOSED	CLOSED	OPEN
ABHV0014	28/28	OUTSIDE	OUT	GATE	HYDRAULIC ⁽¹⁾	1, 4	SL IS	NONE	(3)	OPEN	OPEN	CLOSED	CLOSED	N/A
ABHV0015	2/2	OUTSIDE	OUT	GLOBE	AIR	1, 4	SL IS	NONE	15	CLOSED	CLOSED	CLOSED	CLOSED	N/A
ABV0055-59	6/8 X 6	OUTSIDE	OUT	RELIEF	SELF ACT	N/A	N/A	N/A	N/A	CLOSED	CLOSED	N/A	N/A	N/A
ABLV0009	1/2	OUTSIDE	OUT	GLOBE	AIR	1, 4	SL IS	NONE	15	OPEN	OPEN	CLOSED	CLOSED	N/A
ABV0060	1/1	OUTSIDE	OUT	GATE	MANUAL	N/A	N/A	N/A	N/A	CLOSED	CLOSED	N/A	CLOSED	N/A
(VALVES BELOW NOT SHOWN IN SKETCH)														
ABV0702, 704, 706, 708	3/4 / 3/4	INSIDE	N/A	GLOBE	MANUAL	N/A	N/A	N/A	N/A	CLOSED	CLOSED	N/A	CLOSED	N/A
ABV0012	1/1	INSIDE	N/A	GLOBE	MANUAL	N/A	N/A	N/A	N/A	CLOSED	CLOSED	N/A	CLOSED	N/A

ENGINEERED SAFETY FEATURE SYSTEM	YES <input checked="" type="checkbox"/> NO <input type="checkbox"/>
FLUID CONTAINED:	STEAM
LENGTH OF PIPING TO OUTERMOST ISOLATION VALVE:	56.6 FT.
APPLICABLE GDC NO.	NONE

GENERAL COMMENTS:

THE CONTAINMENT PENETRATIONS ASSOCIATED WITH THE STEAM GENERATORS ARE NOT SUBJECT TO GDC-57, SINCE THE CONTAINMENT BARRIER INTEGRITY IS NOT BREACHED. THE BOUNDARY OR BARRIER AGAINST FISSION PRODUCT LEAKAGE TO THE ENVIRONMENT IS THE INSIDE OF THE STEAM GENERATOR TUBES AND THE OUTSIDE OF THE LINES EMANATING FROM THE STEAM GENERATOR SHELLS.


THE PENETRATION CONFIGURATION IS PRESENTED FOR FIGURE 6.2.4-1 COMPLETENESS. NONE OF THE VALVES SHOWN ARE CONTAINMENT ISOLATION VALVES.

NOTE 1: AS SHOWN ON FIGURE 10.3-1, THE STEAM GENERATOR SHELL EXTENDS TO THE VENT VALVES ON THE CONDENSATE POTS FOR THE MAIN STEAM FLOW TRANSMITTERS. THE STEAM GENERATOR AND STEAM PIPING/INSTRUMENTATION LINES INSIDE OF CONTAINMENT ARE NOT SHOWN HERE. REFERENCE FIG. 10.3-1 FOR DETAILS OF THE PIPING INSTRUMENTATION AND VALVE CONFIGURATION / IDENTIFICATION.

NOTE 2: OPERATOR UTILIZES SYSTEM-MEDIUM AS THE PROCESS FLUID.

NOTE 3: CLOSURE TIME IS SYSTEM PRESSURE DEPENDENT. MAX CLOSURE TIME CURVE IS DEFINED IN THE TECHNICAL SPECIFICATION BASES.

NOTE 4: MAXIMUM CLOSURE TIMES SPECIFIED IN THIS FIGURE ARE NOMINAL. DESIGN OR LICENSING-BASIS VALUES. PERFORMANCE-BASED VALVE OPERABILITY LIMITS FOR VALVE CLOSURE TIMES ARE SPECIFIED PER THE INSERVICE TESTING PROGRAM FOR CALLAWAY.

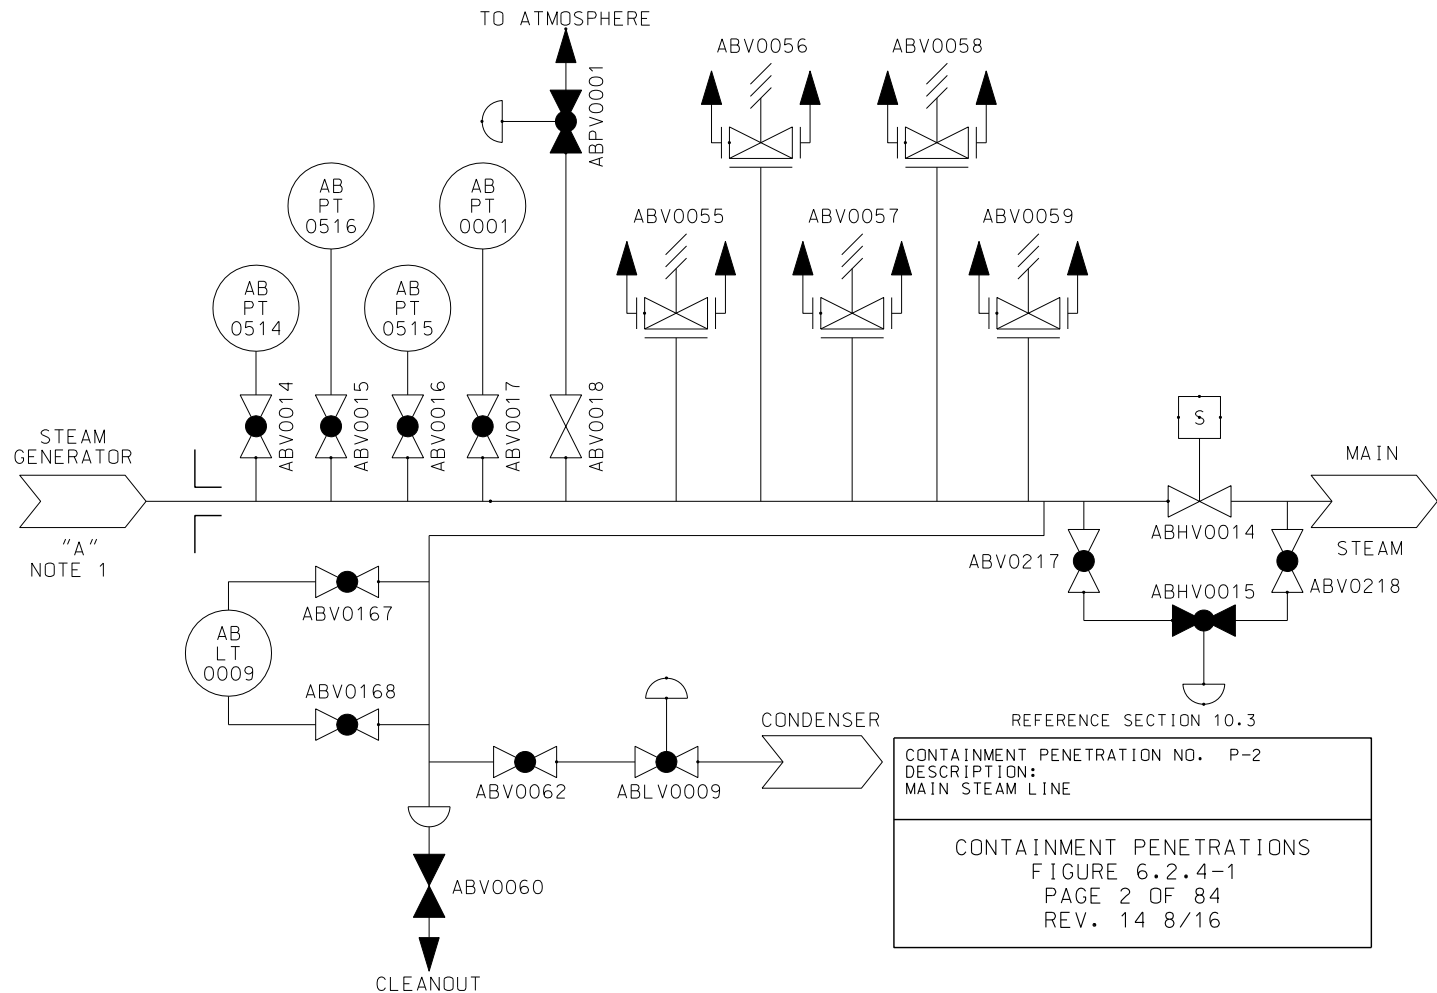

APPENDIX J REQUIREMENT

- TYPE A
- B
- C
- NONE

VALVE NO.	LINE/VALVE SIZE, IN.	INSIDE/OUTSIDE CONT.	NORMAL FLOW DIRECTION	VALVE TYPE	VALVE OPERATOR	POWER SOURCE	PRIMARY ACTUATION SIGNAL	SECONDARY ACTUATION SIGNAL	MAXIMUM CLOSURE TIME (SEC.)	VALVE POSITION				
										NORMAL	SHUTDOWN	POWER FAILURE	POST ACCIDENT	
													PRIMARY	SECONDARY
ABPV0002	10/8	OUTSIDE	OUT	GLOBE	AIR	2	NONE	REM/MAN	20	CLOSED	CLOSED	CLOSED	CLOSED	OPEN
ABHV0017	28/28	OUTSIDE	OUT	GATE	HYDRAULIC ⁽²⁾	1,4	SLIS	NONE	(3)	OPEN	OPEN	CLOSED	CLOSED	N/A
ABHV0018	2/2	OUTSIDE	OUT	GLOBE	AIR	1,4	SLIS	NONE	15	CLOSED	CLOSED	CLOSED	CLOSED	N/A
ABV0065-69	6/8 X 6	OUTSIDE	OUT	RELIEF	SELF ACT	N/A	N/A	N/A	N/A	CLOSED	CLOSED	N/A	N/A	N/A
ABLV0008	1/2	OUTSIDE	OUT	GLOBE	AIR	1,4	SLIS	NONE	15	OPEN	OPEN	CLOSED	CLOSED	N/A
ABV0070	1/1	OUTSIDE	OUT	GATE	MANUAL	N/A	N/A	N/A	N/A	CLOSED	CLOSED	N/A	CLOSED	N/A
ABHV0005	4/4	OUTSIDE	OUT	GLOBE	AIR	2	AFAS	NONE	10	CLOSED	CLOSED	OPEN	OPEN	N/A
ABHV0048	1/1	OUTSIDE	OUT	GLOBE	AIR	1	SLIS	NONE	5	OPEN	OPEN	CLOSED	CLOSED	N/A
ABV0710, 712, 714, 716	3/4 / 3/4	INSIDE	N/A	GLOBE	MANUAL	N/A	N/A	N/A	N/A	CLOSED	CLOSED	N/A	CLOSED	N/A
ABV0034	1/1	INSIDE	N/A	GLOBE	MANUAL	N/A	N/A	N/A	N/A	CLOSED	CLOSED	N/A	CLOSED	N/A

ENGINEERED SAFETY FEATURE SYSTEM YES NO

FLUID CONTAINED: STEAM

LENGTH OF PIPING TO OUTERMOST ISOLATION VALVE: 57.9 FT.

APPLICABLE GDC NO. NONE

GENERAL COMMENTS:

THE CONTAINMENT PENETRATIONS ASSOCIATED WITH THE STEAM GENERATORS ARE NOT SUBJECT TO GDC-57, SINCE THE CONTAINMENT BARRIER INTEGRITY IS NOT BREACHED. THE BARRIER OR BARRIER AGAINST FISSION PRODUCT LEAKAGE TO THE ENVIRONMENT IS THE INSIDE OF THE STEAM GENERATOR TUBES AND THE OUTSIDE OF THE LINES EMANATING FROM THE STEAM GENERATOR SHELLS.

THIS PENETRATION CONFIGURATION IS PRESENTED FOR FIGURE 6.2.1-4 COMPLETENESS. NONE OF THE VALVES SHOWN ARE CONTAINMENT ISOLATION VALVES.

VALVES ABV0710, 712, 714, 716 AND ABV0034 (SHOWN IN THE TABLE ABOVE) ARE NOT SHOWN IN SKETCH.


NOTE 1: AS SHOWN ON FIGURE 10.3-1, THE STEAM GENERATOR SHELL EXTENDS TO THE VENT VALVES ON THE CONDENSATE POTS FOR THE MAIN STEAM FLOW TRANSMITTERS. THE STEAM GENERATOR AND STEAM PIPING/INSTRUMENTATION LINES INSIDE OF CONTAINMENT ARE NOT SHOWN HERE. REFERENCE FIG.10.3-1 FOR DETAILS OF THE PIPING INSTRUMENTATION AND VALVE CONFIGURATION / IDENTIFICATION.

NOTE 2: OPERATOR UTILIZES SYSTEM-MEDIUM AS THE PROCESS FLUID.

NOTE 3: CLOSURE TIME IS SYSTEM PRESSURE DEPENDENT. MAX CLOSURE TIME CURVE IS DEFINED IN THE TECHNICAL SPECIFICATION BASES.

NOTE 4: MAXIMUM CLOSURE TIMES SPECIFIED IN THIS FIGURE ARE NOMINAL. DESIGN OR LICENSING-BASIS VALUES. PERFORMANCE-BASED VALVE OPERABILITY LIMITS FOR VALVE CLOSURE TIMES ARE SPECIFIED PER THE INSERVICE TESTING PROGRAM FOR CALLAWAY.

- APPENDIX J REQUIREMENT
- TYPE A
- B
- C
- NONE

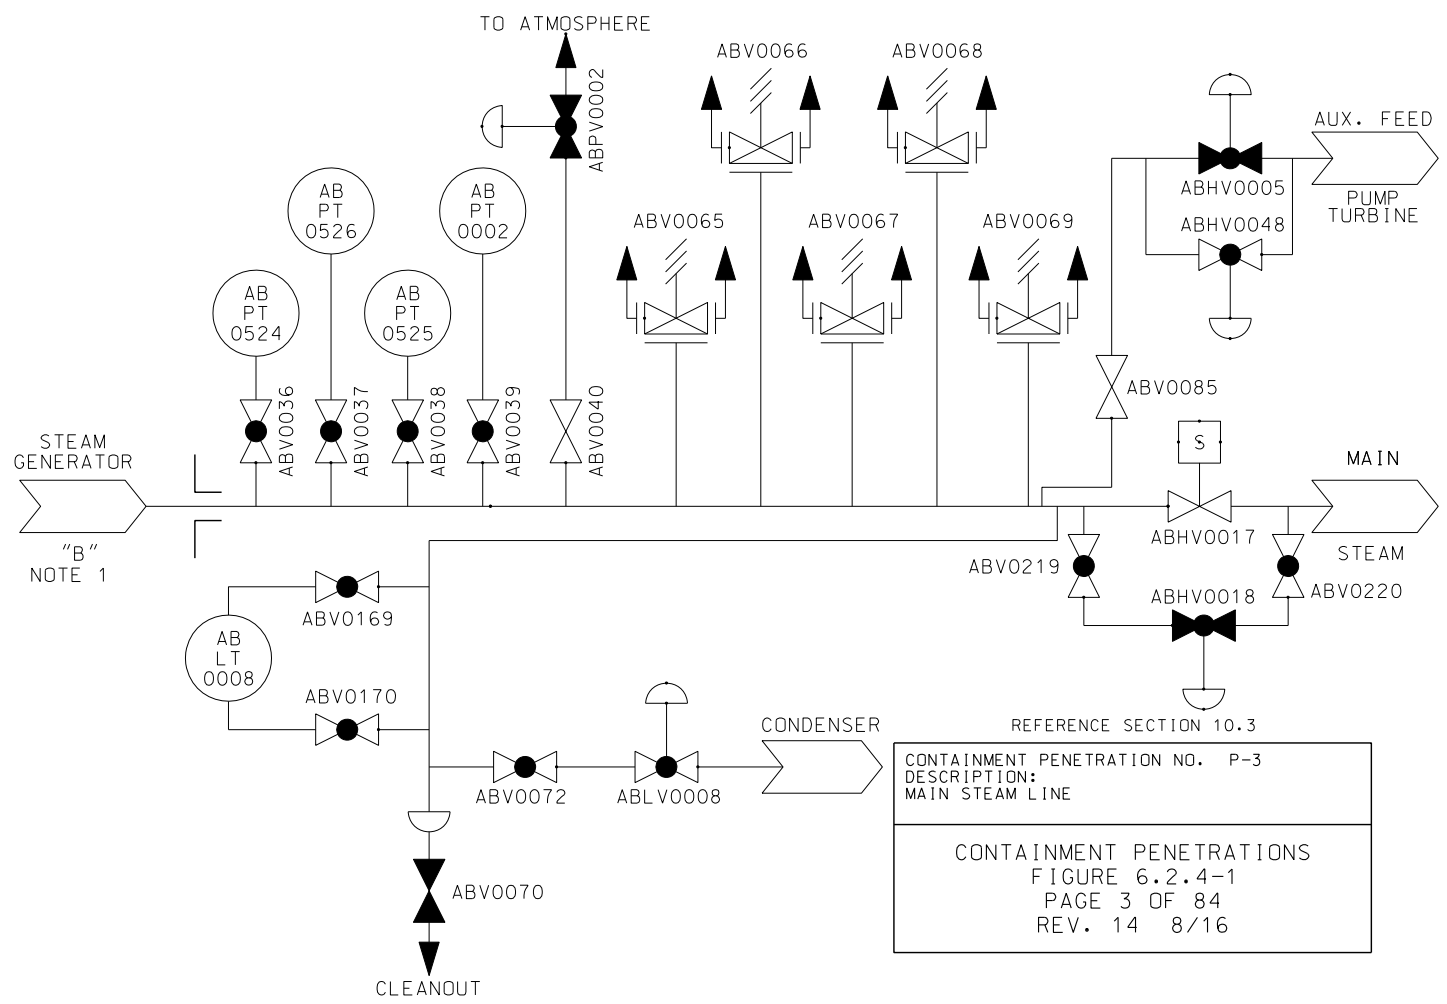

CONTAINMENT PENETRATION NO. P-3
 DESCRIPTION: MAIN STEAM LINE

CONTAINMENT PENETRATIONS
 FIGURE 6.2.4-1
 PAGE 3 OF 84
 REV. 14 8/16

VALVE NO.	LINE/ VALVE SIZE, IN.	INSIDE/ OUTSIDE CONT.	NORMAL FLOW DIRECTION	VALVE TYPE	VALVE OPERATOR	POWER SOURCE	PRIMARY ACTUATION SIGNAL	SECONDARY ACTUATION SIGNAL	MAXIMUM CLOSURE TIME (SEC.) (NOTE 4)	VALVE POSITION				
										NORMAL	SHUTDOWN	POWER FAILURE	POST ACCIDENT	
													PRIMARY	SECONDARY
ABPV0003	10/8	OUTSIDE	OUT	GLOBE	AIR	3	NONE	REM/MAN	20	CLOSED	CLOSED	CLOSED	CLOSED	OPEN
ABHV0020	28/28	OUTSIDE	OUT	GATE	HYDRAULIC (2)	1, 4	SL IS	NONE	(3)	OPEN	OPEN	CLOSED	CLOSED	N/A
ABHV0021	2/2	OUTSIDE	OUT	GLOBE	AIR	1, 4	SL IS	NONE	15	CLOSED	CLOSED	CLOSED	CLOSED	N/A
ABV0075-79	6/8 X 6	OUTSIDE	OUT	RELIEF	SELF ACT	N/A	N/A	N/A	N/A	CLOSED	CLOSED	N/A	N/A	N/A
ABL V0007	1/2	OUTSIDE	OUT	GLOBE	AIR	1, 4	SL IS	NONE	15	OPEN	OPEN	CLOSED	CLOSED	N/A
ABV0080	1/1	OUTSIDE	OUT	GATE	MANUAL	N/A	N/A	N/A	N/A	CLOSED	CLOSED	N/A	CLOSED	N/A
ABHV0006	4/4	OUTSIDE	OUT	GLOBE	AIR	2	AFAS	NONE	10	CLOSED	CLOSED	OPEN	OPEN	N/A
ABHV0049	1/1	OUTSIDE	OUT	GLOBE	AIR	1	SL IS	NONE	5	OPEN	OPEN	CLOSED	CLOSED	N/A
ABV0718, 720, 722, 724	3/4 / 3/4	INSIDE	N/A	GLOBE	MANUAL	N/A	N/A	N/A	N/A	CLOSED	CLOSED	N/A	CLOSED	N/A
ABV0023	1/1	INSIDE	N/A	GLOBE	MANUAL	N/A	N/A	N/A	N/A	CLOSED	CLOSED	N/A	CLOSED	N/A

ENGINEERED SAFETY FEATURE SYSTEM YES NO

FLUID CONTAINED: STEAM

LENGTH OF PIPING TO OUTERMOST ISOLATION VALVE: 56.2 FT.

APPLICABLE GDC NO. NONE

GENERAL COMMENTS:
THE CONTAINMENT PENETRATIONS ASSOCIATED WITH THE STEAM GENERATORS ARE NOT SUBJECT TO GDC-57, SINCE THE CONTAINMENT BARRIER INTEGRITY IS NOT BREACHED. THE BOUNDARY OR BARRIER AGAINST FISSION PRODUCT LEAKAGE TO THE ENVIRONMENT IS THE INSIDE OF THE STEAM GENERATOR TUBES AND THE OUTSIDE OF THE LINES EMANATING FROM THE STEAM GENERATOR SHELLS.

THE PENETRATION CONFIGURATION IS PRESENTED FOR FIGURE 6.2.4-1 COMPLETENESS. NONE OF THE VALVES SHOWN ARE CONTAINMENT ISOLATION VALVES.

VALVES ABV0718, 720, 722, 724 AND ABV0023 (SHOWN IN THE TABLE ABOVE) ARE NOT SHOWN IN THE SKETCH

NOTE 1: AS SHOWN ON FIGURE 10.3-1, THE STEAM GENERATOR SHELL EXTENDS TO THE VENT VALVES ON THE CONDENSATE POTS FOR THE MAIN STEAM FLOW TRANSMITTERS. THE STEAM GENERATOR AND STEAM PIPING/INSTRUMENTATION LINES INSIDE OF CONTAINMENT ARE NOT SHOWN HERE. REFERENCE FIG.10.3-1 FOR DETAILS OF THE PIPING INSTRUMENTATION AND VALVE CONFIGURATION / IDENTIFICATION.


NOTE 2: OPERATOR UTILIZES SYSTEM-MEDIUM AS THE PROCESS FLUID.

NOTE 3: CLOSURE TIME IS SYSTEM PRESSURE DEPENDENT. MAX CLOSURE TIME CURVE IS DEFINED IN THE TECHNICAL SPECIFICATION BASES.

NOTE 4: MAXIMUM CLOSURE TIMES SPECIFIED IN THIS FIGURE ARE NOMINAL. DESIGN OR LICENSING-BASIS VALUES. PERFORMANCE-BASED OPERABILITY LIMITS FOR VALVE CLOSURE TIMES ARE SPECIFIED PER THE INSERVICE TESTING PROGRAM FOR CALLAWAY.

APPENDIX J REQUIREMENT

- TYPE A
 B
 C
 NONE

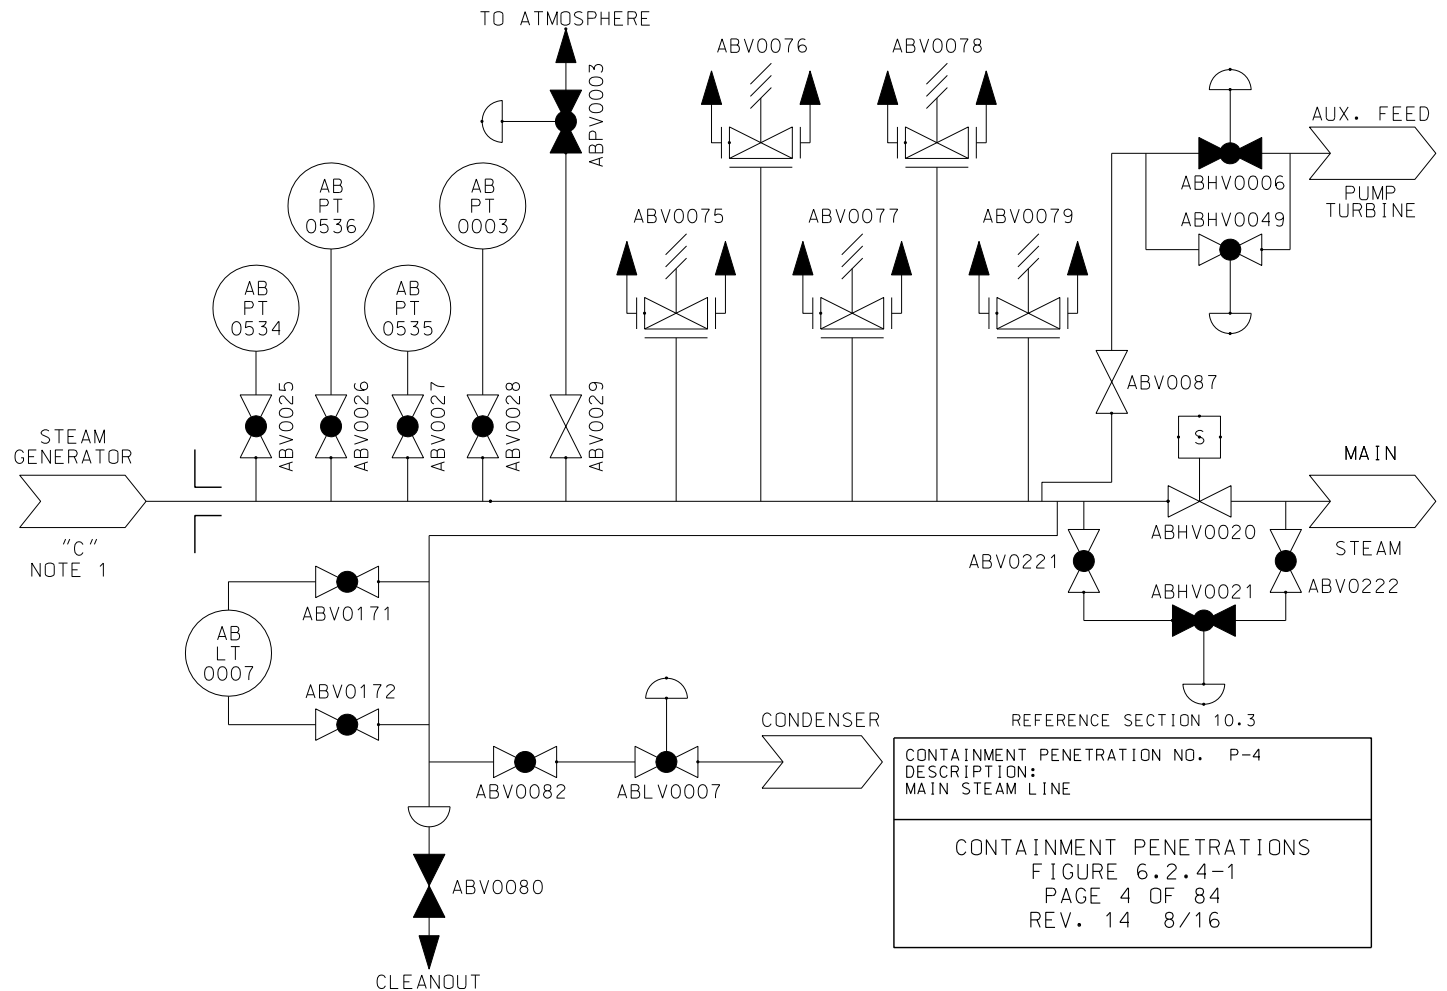

REFERENCE SECTION 10.3

CONTAINMENT PENETRATION NO. P-4
 DESCRIPTION:
 MAIN STEAM LINE

CONTAINMENT PENETRATIONS
 FIGURE 6.2.4-1
 PAGE 4 OF 84
 REV. 14 8/16

VALVE NO.	LINE/ VALVE SIZE, IN.	INSIDE/ OUTSIDE CONT.	NORMAL FLOW DIRECTION	VALVE TYPE	VALVE OPERATOR	POWER SOURCE	PRIMARY ACTUATION SIGNAL	SECONDARY ACTUATION SIGNAL	MAXIMUM CLOSURE TIME (SEC.) (NOTE 4)	VALVE POSITION				
										NORMAL	SHUTDOWN	POWER FAILURE	POST ACCIDENT	
													PRIMARY	SECONDARY
AEFV0042	14/14	OUTSIDE	IN	GATE	HYDRAULIC (2)	1, 4	FWIS	NONE	(3)	OPEN	OPEN	CLOSED	CLOSED	N/A
AEV0126	4/4	OUTSIDE	IN	CHECK	N/A	N/A	N/A	N/A	N/A	CLOSED	N/A	N/A	OPEN	N/A
AEFV0046	1/1	OUTSIDE	IN	GLOBE	AIR	4	FWIS	NONE	5	CLOSED	CLOSED	CLOSED	CLOSED	N/A
AEV0307	3/4 / 3/4	OUTSIDE	N/A	GLOBE	MANUAL	N/A	N/A	N/A	N/A	CLOSED	CLOSED	N/A	CLOSED	N/A
AEV0220	1/1	OUTSIDE	N/A	GATE	MANUAL	N/A	N/A	N/A	N/A	CLOSED	CLOSED	N/A	CLOSED	N/A
AEV0328	3/3	OUTSIDE	N/A	GATE	MANUAL	N/A	N/A	N/A	N/A	CLOSED	CLOSED	N/A	CLOSED	N/A
AEV0192	1/1	OUTSIDE	N/A	GLOBE	MANUAL	N/A	N/A	N/A	N/A	CLOSED	CLOSED	N/A	CLOSED	N/A
VALVES BELOW NOT SHOWN IN SKETCH														
AEV0714	3/4 / 3/4	INSIDE	N/A	GLOBE	MANUAL	N/A	N/A	N/A	N/A	CLOSED	CLOSED	N/A	CLOSED	N/A
AEV0716	3/4 / 3/4	INSIDE	N/A	GLOBE	MANUAL	N/A	N/A	N/A	N/A	CLOSED	CLOSED	N/A	CLOSED	N/A

ENGINEERED SAFETY FEATURE SYSTEM YES NO

FLUID CONTAINED: WATER

LENGTH OF PIPING TO OUTERMOST ISOLATION VALVE: 21.8 FT.

APPLICABLE GDC NO. NONE

GENERAL COMMENTS:

THE CONTAINMENT PENETRATIONS ASSOCIATED WITH THE STEAM GENERATORS ARE NOT SUBJECT TO GDC-57, SINCE THE CONTAINMENT BARRIER INTEGRITY IS NOT BREACHED. THE BOUNDARY OR BARRIER AGAINST FISSION PRODUCT LEAKAGE TO THE ENVIRONMENT IS THE INSIDE OF THE STEAM GENERATOR TUBES AND THE OUTSIDE OF THE LINES EMANATING FROM THE STEAM GENERATOR SHELLS.

THE PENETRATION CONFIGURATION IS PRESENTED FOR FIGURE 6.2.4-1 COMPLETENESS. NONE OF THE VALVES SHOWN ARE CONTAINMENT ISOLATION VALVES.

NOTE 1: AS SHOWN ON FIGURE 10.3-1, THE STEAM GENERATOR SHELL EXTENDS TO THE VENT VALVES ON THE CONDENSATE POTS FOR THE MAIN STEAM FLOW TRANSMITTERS. THE STEAM GENERATOR AND STEAM PIPING/INSTRUMENTATION LINES INSIDE OF CONTAINMENT ARE NOT SHOWN HERE. REFERENCE FIG.10.3-1 FOR DETAILS OF THE PIPING INSTRUMENTATION AND VALVE CONFIGURATION / IDENTIFICATION.


NOTE 2: SYSTEM-MEDIUM UTILIZING PROCESS FLUID.

NOTE 3: CLOSURE TIME IS SYSTEM PRESSURE DEPENDENT. MAX CLOSURE TIME CURVE IS DEFINED IN THE TECHNICAL SPECIFICATION BASES.

NOTE 4: MAXIMUM CLOSURE TIMES SPECIFIED IN THIS FIGURE ARE NOMINAL DESIGN OR LICENSING-BASIS VALUES. PERFORMANCE-BASED VALVE OPERABILITY LIMITS FOR VALVE CLOSURE TIMES ARE SPECIFIED PER THE INSERVICE TESTING PROGRAM FOR CALLAWAY.

APPENDIX J REQUIREMENT

- TYPE A
 B
 C
 NONE

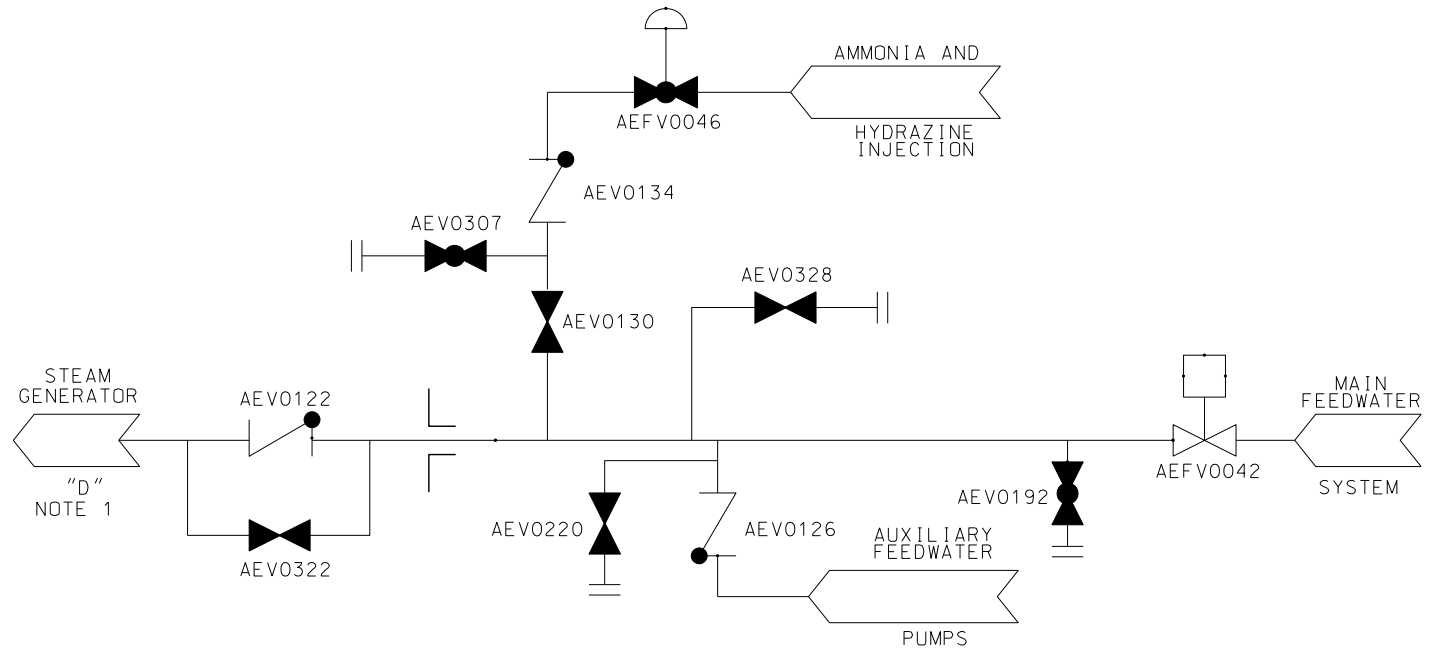

REFERENCE SECTION 10.4.7

CONTAINMENT PENETRATION NO. P-5
 DESCRIPTION:
 MAIN FEEDWATER LINE

CONTAINMENT PENETRATIONS
 FIGURE 6.2.4-1
 PAGE 5 OF 84
 REV. 17 8/16

VALVE NO.	LINE/ VALVE SIZE, IN.	INSIDE/ OUTSIDE CONT.	NORMAL FLOW DIRECTION	VALVE TYPE	VALVE OPERATOR	POWER SOURCE	PRIMARY ACTUATION SIGNAL	SECONDARY ACTUATION SIGNAL	MAXIMUM CLOSURE TIME (SEC.)	VALVE POSITION				
										NORMAL	SHUTDOWN	POWER FAILURE	POST ACCIDENT	
													PRIMARY	SECONDARY
AEFV0039	14/14	OUTSIDE	IN	GATE	HYDRAULIC	1, 4	FWIS	NONE	5	OPEN	OPEN	CLOSED	CLOSED	N/A
AEV0125	4/4	OUTSIDE	IN	CHECK	N/A	N/A	N/A	N/A	N/A	CLOSED	N/A	N/A	OPEN	N/A
AEFV0043	1/1	OUTSIDE	IN	GLOBE	AIR	1	FWIS	NONE	5	CLOSED	CLOSED	CLOSED	CLOSED	N/A
AEV0223	1/1	OUTSIDE	N/A	GATE	MANUAL	N/A	N/A	N/A	N/A	CLOSED	CLOSED	N/A	CLOSED	N/A
AEV0325	3/3	OUTSIDE	N/A	GATE	MANUAL	N/A	N/A	N/A	N/A	CLOSED	CLOSED	N/A	CLOSED	N/A
AEV0189	1/1	OUTSIDE	N/A	GLOBE	MANUAL	N/A	N/A	N/A	N/A	CLOSED	CLOSED	N/A	CLOSED	N/A
AEV0304	3/4 / 3/4	OUTSIDE	N/A	GLOBE	MANUAL	N/A	N/A	N/A	N/A	CLOSED	CLOSED	N/A	CLOSED	N/A
VALVES BELOW NOT SHOWN IN SKETCH														
AEV0702	3/4 / 3/4	INSIDE	N/A	GLOBE	MANUAL	N/A	N/A	N/A	N/A	CLOSED	CLOSED	N/A	CLOSED	N/A
AEV0704	3/4 / 3/4	INSIDE	N/A	GLOBE	MANUAL	N/A	N/A	N/A	N/A	CLOSED	CLOSED	N/A	CLOSED	N/A

ENGINEERED SAFETY FEATURE SYSTEM	YES <input checked="" type="checkbox"/> NO <input type="checkbox"/>
FLUID CONTAINED:	WATER
LENGTH OF PIPING TO OUTERMOST ISOLATION VALVE:	21.1 FT.
APPLICABLE GDC NO.	NONE

GENERAL COMMENTS:

THE CONTAINMENT PENETRATIONS ASSOCIATED WITH THE STEAM GENERATORS ARE NOT SUBJECT TO GDC-57, SINCE THE CONTAINMENT BARRIER INTEGRITY IS NOT BREACHED. THE BARRIER AGAINST FISSION PRODUCT LEAKAGE TO THE ENVIRONMENT IS THE INSIDE OF THE STEAM GENERATOR TUBES AND THE OUTSIDE OF THE LINES EMANATING FROM THE STEAM GENERATOR SHELLS.


THE PENETRATION CONFIGURATION IS PRESENTED FOR FIGURE 6.2.4-1 COMPLETENESS. NONE OF THE VALVES SHOWN ARE CONTAINMENT ISOLATION VALVES.

NOTE 1: THE STEAM GENERATOR AND LINES EMANATING FROM THE STEAM GENERATOR SHELL ARE NOT SHOWN HERE. REFERENCE FIG.10.4-6 FOR DETAILS OF THE PIPING, INSTRUMENTATION AND VALVE CONFIGURATION / IDENTIFICATION.

NOTE 2: SYSTEM-MEDIUM UTILIZING PROCESS FLUID.

NOTE 3: CLOSURE TIME IS SYSTEM PRESSURE DEPENDENT. MAX CLOSURE TIME CURVE IS DEFINED IN THE TECHNICAL SPECIFICATION BASES.

NOTE 4: MAXIMUM CLOSURE TIMES SPECIFIED IN THIS FIGURE ARE NOMINAL DESIGN OR LICENSING-BASIS VALUES. PERFORMANCE-BASED VALVE OPERABILITY LIMITS FOR VALVE CLOSURE TIMES ARE SPECIFIED PER THE INSERVICE TESTING PROGRAM FOR CALLAWAY.

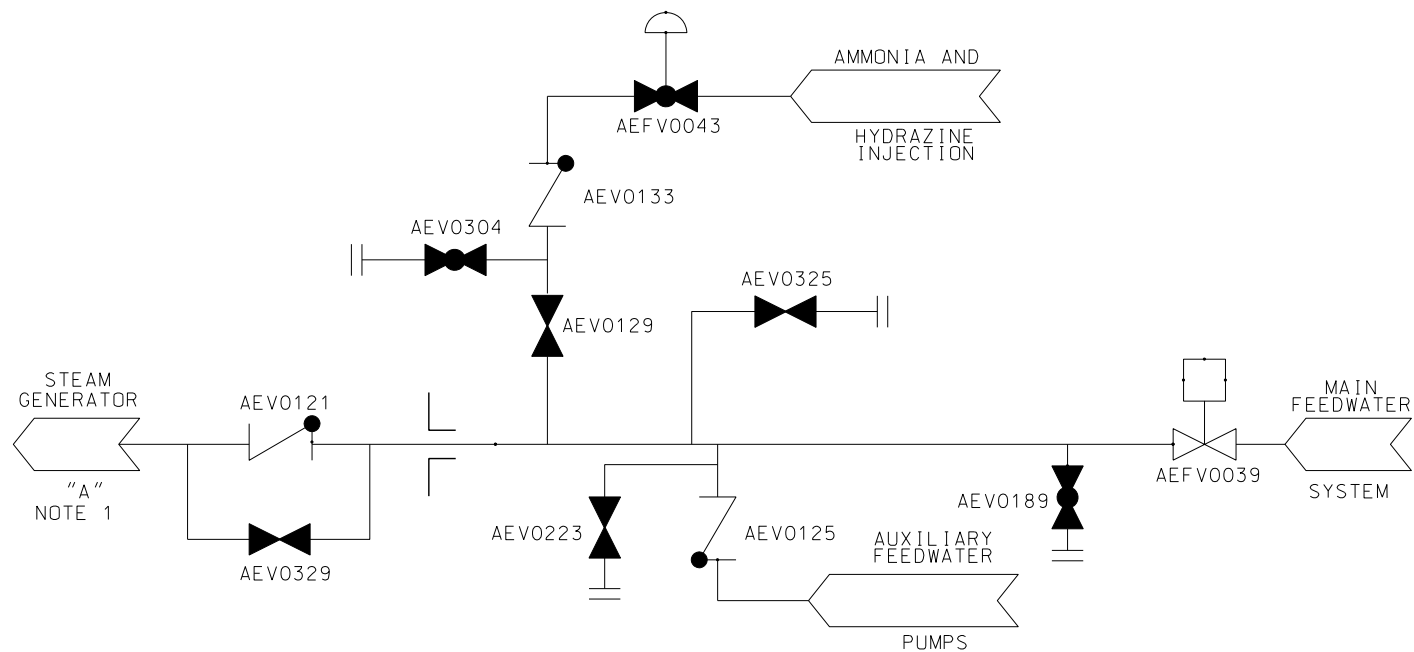

REFERENCE SECTION 10.4.7

CONTAINMENT PENETRATION NO. P-6 DESCRIPTION: MAIN FEEDWATER LINE
CONTAINMENT PENETRATIONS FIGURE 6.2.4-1 PAGE 6 OF 84 REV. 17 8/16

APPENDIX J REQUIREMENT

- TYPE A
 B
 C
 NONE

VALVE NO.	LINE/ VALVE SIZE, IN.	INSIDE/ OUTSIDE CONT.	NORMAL FLOW DIRECTION	VALVE TYPE	VALVE OPERATOR	POWER SOURCE	PRIMARY ACTUATION SIGNAL	SECONDARY ACTUATION SIGNAL	MAXIMUM CLOSURE TIME (SEC.) (NOTE 4)	VALVE POSITION				
										NORMAL	SHUTDOWN	POWER FAILURE	POST ACCIDENT	
													PRIMARY	SECONDARY
AEFV0040	14/14	OUTSIDE	IN	GATE	HYDRAULIC (2)	1, 4	FWIS	NONE	(3)	OPEN	OPEN	CLOSED	CLOSED	N/A
AEV0124	4/4	OUTSIDE	IN	CHECK	N/A	N/A	N/A	N/A	N/A	CLOSED	N/A	N/A	OPEN	N/A
AEFV0044	1/1	OUTSIDE	IN	GLOBE	AIR	4	FWIS	NONE	5	CLOSED	CLOSED	CLOSED	CLOSED	N/A
AEV0305	3/4 / 3/4	OUTSIDE	N/A	GLOBE	MANUAL	N/A	N/A	N/A	N/A	CLOSED	CLOSED	N/A	CLOSED	N/A
AEV0326	3/3	OUTSIDE	N/A	GATE	MANUAL	N/A	N/A	N/A	N/A	CLOSED	CLOSED	N/A	CLOSED	N/A
AEV0216	1/1	OUTSIDE	N/A	GATE	MANUAL	N/A	N/A	N/A	N/A	CLOSED	CLOSED	N/A	CLOSED	N/A
AEV0186	1/1	OUTSIDE	N/A	GLOBE	MANUAL	N/A	N/A	N/A	N/A	CLOSED	CLOSED	N/A	CLOSED	N/A
VALVES BELOW NOT SHOWN IN SKETCH														
AEV0706	3/4 / 3/4	INSIDE	N/A	GLOBE	MANUAL	N/A	N/A	N/A	N/A	CLOSED	CLOSED	N/A	CLOSED	N/A
AEV0708	3/4 / 3/4	INSIDE	N/A	GLOBE	MANUAL	N/A	N/A	N/A	N/A	CLOSED	CLOSED	N/A	CLOSED	N/A

ENGINEERED SAFETY FEATURE SYSTEM	YES <input checked="" type="checkbox"/> NO <input type="checkbox"/>
FLUID CONTAINED:	WATER
LENGTH OF PIPING TO OUTERMOST ISOLATION VALVE:	21.1 FT.
APPLICABLE GDC NO.	NONE

GENERAL COMMENTS:

THE CONTAINMENT PENETRATIONS ASSOCIATED WITH THE STEAM GENERATORS ARE NOT SUBJECT TO GDC-57, SINCE THE CONTAINMENT BARRIER INTEGRITY IS NOT BREACHED. THE BOUNDARY OR BARRIER AGAINST FISSION PRODUCT LEAKAGE TO THE ENVIRONMENT IS THE INSIDE OF THE STEAM GENERATOR TUBES AND THE OUTSIDE OF THE LINES EMANATING FROM THE STEAM GENERATOR SHELLS.


THE PENETRATION CONFIGURATION IS PRESENTED FOR FIGURE 6.2.4-1 COMPLETENESS. NONE OF THE VALVES SHOWN ARE CONTAINMENT ISOLATION VALVES.

NOTE 1: THE STEAM GENERATOR AND LINES EMANATING FROM THE STEAM GENERATOR SHELL ARE NOT SHOWN HERE. REFERENCE FIG.10.4-6 FOR DETAILS OF THE PIPING, INSTRUMENTATION AND VALVE CONFIGURATION / IDENTIFICATION.

NOTE 2: SYSTEM-MEDIUM UTILIZING PROCESS FLUID.

NOTE 3: CLOSURE TIME IS SYSTEM PRESSURE DEPENDENT. MAX CLOSURE TIME CURVE IS DEFINED IN THE TECHNICAL SPECIFICATION BASES.

NOTE 4: MAXIMUM CLOSURE TIMES SPECIFIED IN THIS FIGURE ARE NOMINAL DESIGN OR LICENSING-BASIS VALUES. PERFORMANCE-BASED VALVE OPERABILITY LIMITS FOR VALVE CLOSURE TIMES ARE SPECIFIED PER THE INSERVICE TESTING PROGRAM FOR CALLAWAY.

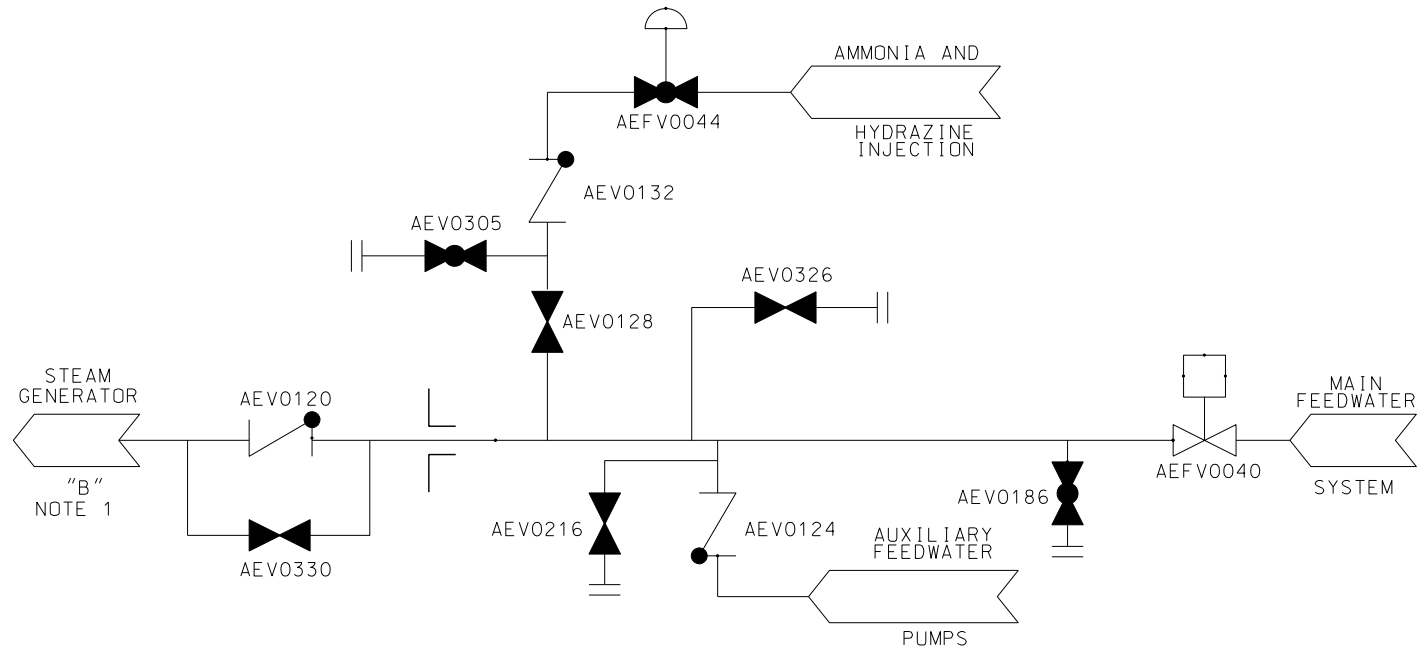

REFERENCE SECTION 10.4.7

CONTAINMENT PENETRATION NO. P-7 DESCRIPTION: MAIN FEEDWATER LINE
CONTAINMENT PENETRATIONS FIGURE 6.2.4-1 PAGE 7 OF 84 REV. 17 8/16

APPENDIX J REQUIREMENT

- TYPE A
 B
 C
 NONE

VALVE NO.	LINE/ VALVE SIZE, IN.	INSIDE/ OUTSIDE CONT.	NORMAL FLOW DIRECTION	VALVE TYPE	VALVE OPERATOR	POWER SOURCE	PRIMARY ACTUATION SIGNAL	SECONDARY ACTUATION SIGNAL	MAXIMUM CLOSURE TIME (SEC.) (NOTE 4)	VALVE POSITION				
										NORMAL	SHUTDOWN	POWER FAILURE	POST ACCIDENT	
													PRIMARY	SECONDARY
AEFV0041	14/14	OUTSIDE	IN	GATE	HYDRAULIC (2)	1, 4	FWIS	NONE	(3)	OPEN	OPEN	CLOSED	CLOSED	N/A
AEV0127	4/4	OUTSIDE	IN	CHECK	N/A	N/A	N/A	N/A	N/A	CLOSED	N/A	N/A	OPEN	N/A
AEFV0045	1/1	OUTSIDE	IN	GLOBE	AIR	1	FWIS	NONE	5	CLOSED	CLOSED	CLOSED	CLOSED	N/A
AEV0306	3/4 / 3/4	OUTSIDE	N/A	GLOBE	MANUAL	N/A	N/A	N/A	N/A	CLOSED	CLOSED	N/A	CLOSED	N/A
AEV0218	1/1	OUTSIDE	N/A	GATE	MANUAL	N/A	N/A	N/A	N/A	CLOSED	CLOSED	N/A	CLOSED	N/A
AEV0327	3/3	OUTSIDE	N/A	GATE	MANUAL	N/A	N/A	N/A	N/A	CLOSED	CLOSED	N/A	CLOSED	N/A
AEV0195	1/1	OUTSIDE	N/A	GLOBE	MANUAL	N/A	N/A	N/A	N/A	CLOSED	CLOSED	N/A	CLOSED	N/A
VALVES BELOW NOT SHOWN IN SKETCH														
AEV0710	3/4 / 3/4	INSIDE	N/A	GLOBE	MANUAL	N/A	N/A	N/A	N/A	CLOSED	CLOSED	N/A	CLOSED	N/A
AEV0712	3/4 / 3/4	INSIDE	N/A	GLOBE	MANUAL	N/A	N/A	N/A	N/A	CLOSED	CLOSED	N/A	CLOSED	N/A

ENGINEERED SAFETY FEATURE SYSTEM	YES <input checked="" type="checkbox"/> NO <input type="checkbox"/>
FLUID CONTAINED:	WATER
LENGTH OF PIPING TO OUTERMOST ISOLATION VALVE:	24.2 FT.
APPLICABLE GDC NO.	NONE

GENERAL COMMENTS:

THE CONTAINMENT PENETRATIONS ASSOCIATED WITH THE STEAM GENERATORS ARE NOT SUBJECT TO GDC-57, SINCE THE CONTAINMENT BARRIER INTEGRITY IS NOT BREACHED. THE BOUNDARY OR BARRIER AGAINST FISSION PRODUCT LEAKAGE TO THE ENVIRONMENT IS THE INSIDE OF THE STEAM GENERATOR TUBES AND THE OUTSIDE OF THE LINES EMANATING FROM THE STEAM GENERATOR SHELLS.


THE PENETRATION CONFIGURATION IS PRESENTED FOR FIGURE 6.2.4-1 COMPLETENESS. NONE OF THE VALVES SHOWN ARE CONTAINMENT ISOLATION VALVES.

NOTE 1: THE STEAM GENERATOR AND LINES EMANATING FROM THE STEAM GENERATOR SHELL ARE NOT SHOWN HERE. REFERENCE FIG.10.4-6 FOR DETAILS OF THE PIPING, INSTRUMENTATION AND VALVE CONFIGURATION / IDENTIFICATION.

NOTE 2: SYSTEM-MEDIUM UTILIZING PROCESS FLUID.

NOTE 3: CLOSURE TIME IS SYSTEM PRESSURE DEPENDENT. MAX CLOSURE TIME CURVE IS DEFINED IN THE TECHNICAL SPECIFICATION BASES.

NOTE 4: MAXIMUM CLOSURE TIMES SPECIFIED IN THIS FIGURE ARE NOMINAL DESIGN OR LICENSING-BASIS VALUES. PERFORMANCE-BASED VALVE OPERABILITY LIMITS FOR VALVE CLOSURE TIMES ARE SPECIFIED PER THE INSERVICE TESTING PROGRAM FOR CALLAWAY.

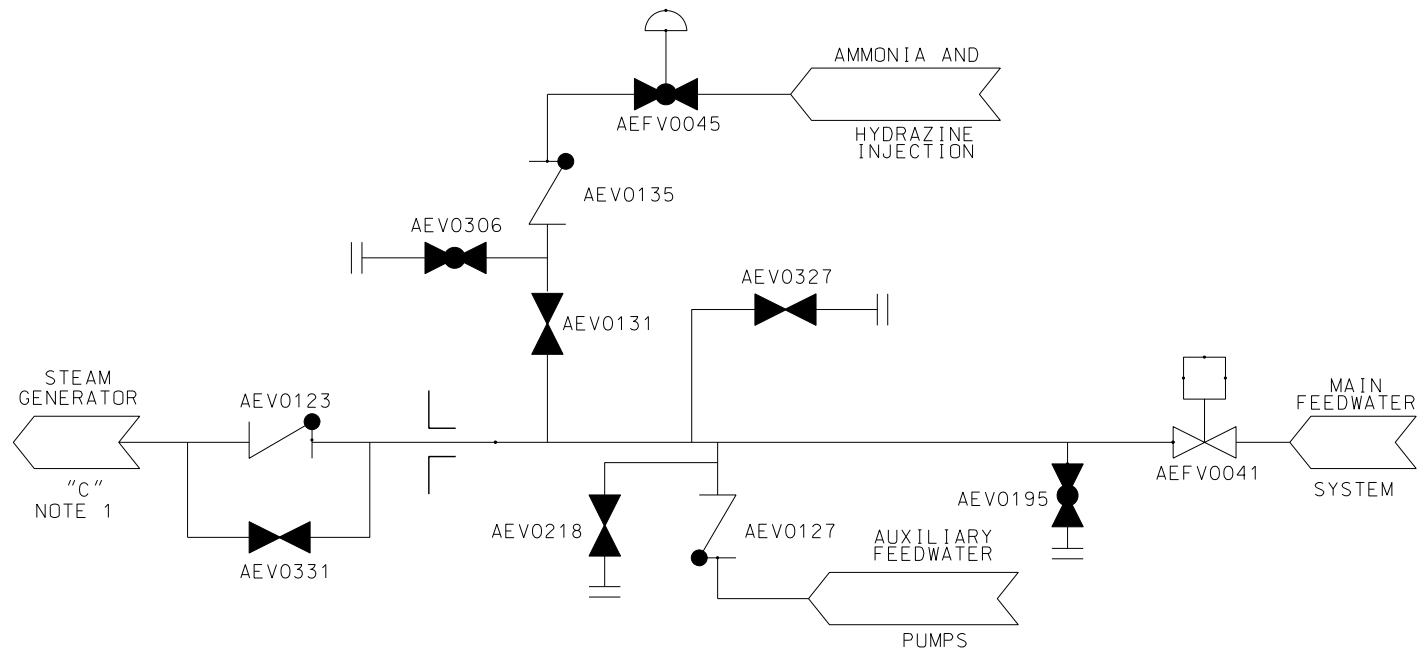

REFERENCE SECTION 10.4.7

CONTAINMENT PENETRATION NO. P-8 DESCRIPTION: MAIN FEEDWATER LINE
CONTAINMENT PENETRATIONS FIGURE 6.2.4-1 PAGE 8 OF 84 REV. 17 8/16

APPENDIX J REQUIREMENT

- TYPE A
 B
 C
 NONE

VALVE NO.	LINE/ VALVE SIZE, IN.	INSIDE/ OUTSIDE CONT.	NORMAL FLOW DIRECTION	VALVE TYPE	VALVE OPERATOR	POWER SOURCE	PRIMARY ACTUATION SIGNAL	SECONDARY ACTUATION SIGNAL	MAXIMUM CLOSURE TIME (SEC.) (NOTE 1)	VALVE POSITION				
										NORMAL	SHUTDOWN	POWER FAILURE	POST ACCIDENT	
													PRIMARY	SECONDARY
BMV0043	1/1	INSIDE	N/A	GLOBE	MANUAL	N/A	N/A	N/A	N/A	CLOSED	CLOSED	N/A	CLOSED	N/A
BMV0190	2/2	INSIDE	N/A	GLOBE	MANUAL	N/A	N/A	N/A	N/A	CLOSED	CLOSED	N/A	CLOSED	N/A
BMHV0004	4/4	OUTSIDE	OUT	GLOBE	AIR	1, 4	SGBSIS	NONE	10	OPEN	OPEN	CLOSED	CLOSED	N/A
BMV0768	3/4 / 3/4	INSIDE	N/A	GLOBE	MANUAL	N/A	N/A	N/A	N/A	CLOSED	CLOSED	N/A	CLOSED	N/A
BMV0769	3/4 / 3/4	INSIDE	N/A	GLOBE	MANUAL	N/A	N/A	N/A	N/A	CLOSED	CLOSED	N/A	CLOSED	N/A


ENGINEERED SAFETY FEATURE SYSTEM	YES <input checked="" type="checkbox"/> NO <input type="checkbox"/>
FLUID CONTAINED:	WATER
LENGTH OF PIPING TO OUTERMOST ISOLATION VALVE:	8.3 FT.
APPLICABLE GDC NO.	NONE

GENERAL COMMENTS:

THE CONTAINMENT PENETRATIONS ASSOCIATED WITH THE STEAM GENERATORS ARE NOT SUBJECT TO GDC-57, SINCE THE CONTAINMENT BARRIER INTEGRITY IS NOT BREACHED. THE BOUNDARY OR BARRIER AGAINST FISSION PRODUCT LEAKAGE TO THE ENVIRONMENT IS THE INSIDE OF THE STEAM GENERATOR TUBES AND THE OUTSIDE OF THE LINES EMANATING FROM THE STEAM GENERATOR SHELLS.

THE PENETRATION CONFIGURATION IS PRESENTED FOR FIGURE 6.2.4-1 COMPLETENESS. NONE OF THE VALVES SHOWN ARE CONTAINMENT ISOLATION VALVES.

NOTE 1: MAXIMUM CLOSURE TIMES SPECIFIED IN THIS FIGURE ARE NOMINAL DESIGN OR LICENSING-BASIS VALUES. PERFORMANCE-BASED VALVE OPERABILITY LIMITS FOR VALVE CLOSURE TIMES ARE SPECIFIED PER THE INSERVICE TESTING PROGRAM FOR CALLAWAY.

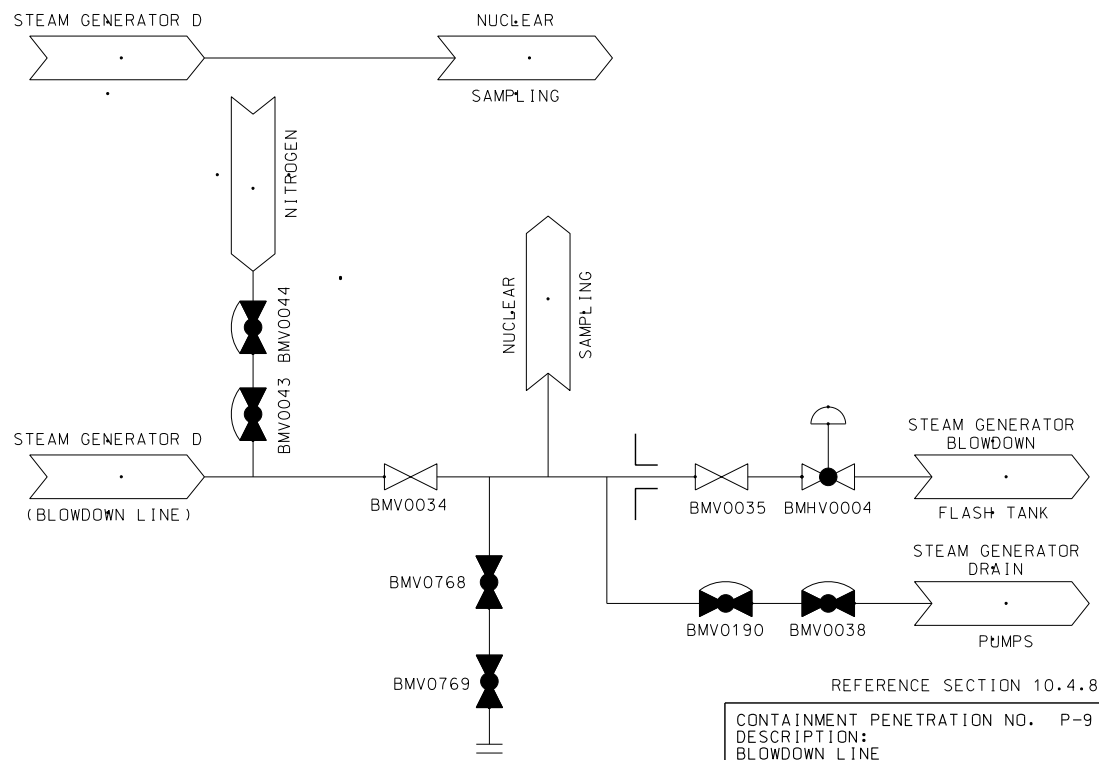

APPENDIX J REQUIREMENT

TYPE A
 B
 C
 NONE

REFERENCE SECTION 10.4.8

CONTAINMENT PENETRATION NO. P-9
DESCRIPTION: BLOWDOWN LINE STEAM GENERATOR BLOWDOWN SYSTEM
CONTAINMENT PENETRATIONS FIGURE 6.2.4-1 PAGE 9 OF 84 REV. 17 8/16


VALVE NO.	LINE/ VALVE SIZE, IN.	INSIDE/ OUTSIDE CONT.	NORMAL FLOW DIRECTION	VALVE TYPE	VALVE OPERATOR	POWER SOURCE	PRIMARY ACTUATION SIGNAL	SECONDARY ACTUATION SIGNAL	MAXIMUM CLOSURE TIME (SEC.) (NOTE 1)	VALVE POSITION				
										NORMAL	SHUTDOWN	POWER FAILURE	POST ACCIDENT	
													PRIMARY	SECONDARY
BMV0010	1/1	INSIDE	N/A	GLOBE	MANUAL	N/A	N/A	N/A	N/A	CLOSED	CLOSED	N/A	CLOSED	N/A
BMV0193	2/2	INSIDE	N/A	GLOBE	MANUAL	N/A	N/A	N/A	N/A	CLOSED	CLOSED	N/A	CLOSED	N/A
BMHV0001	4/4	OUTSIDE	OUT	GLOBE	AIR	1,4	SGBSIS	NONE	10	OPEN	OPEN	CLOSED	CLOSED	N/A
BMV0762	3/4 / 3/4	INSIDE	N/A	GLOBE	MANUAL	N/A	N/A	N/A	N/A	CLOSED	CLOSED	N/A	CLOSED	N/A
BMV0763	3/4 / 3/4	INSIDE	N/A	GLOBE	MANUAL	N/A	N/A	N/A	N/A	CLOSED	CLOSED	N/A	CLOSED	N/A

ENGINEERED SAFETY FEATURE SYSTEM	YES <input checked="" type="checkbox"/> NO <input type="checkbox"/>
FLUID CONTAINED:	WATER
LENGTH OF PIPING TO OUTERMOST ISOLATION VALVE:	5.5 FT.
APPLICABLE GDC NO.	NONE

GENERAL COMMENTS:
 THE CONTAINMENT PENETRATIONS ASSOCIATED WITH THE STEAM GENERATORS ARE NOT SUBJECT TO GDC-57, SINCE THE CONTAINMENT BARRIER INTEGRITY IS NOT BREACHED. THE BARRIER OR BARRIER AGAINST FISSION PRODUCT LEAKAGE TO THE ENVIRONMENT IS THE INSIDE OF THE STEAM GENERATOR TUBES AND THE OUTSIDE OF THE LINES EMANATING FROM THE STEAM GENERATOR SHELLS.

THE PENETRATION CONFIGURATION IS PRESENTED FOR FIGURE 6.2.4-1 COMPLETENESS. NONE OF THE VALVES SHOWN ARE CONTAINMENT ISOLATION VALVES.

NOTE 1: MAXIMUM CLOSURE TIMES SPECIFIED IN THIS FIGURE ARE NOMINAL DESIGN OR LICENSING-BASIS VALUES. PERFORMANCE-BASED VALVE OPERABILITY LIMITS FOR VALVE CLOSURE TIMES ARE SPECIFIED PER THE INSERVICE TESTING PROGRAM FOR CALLAWAY.

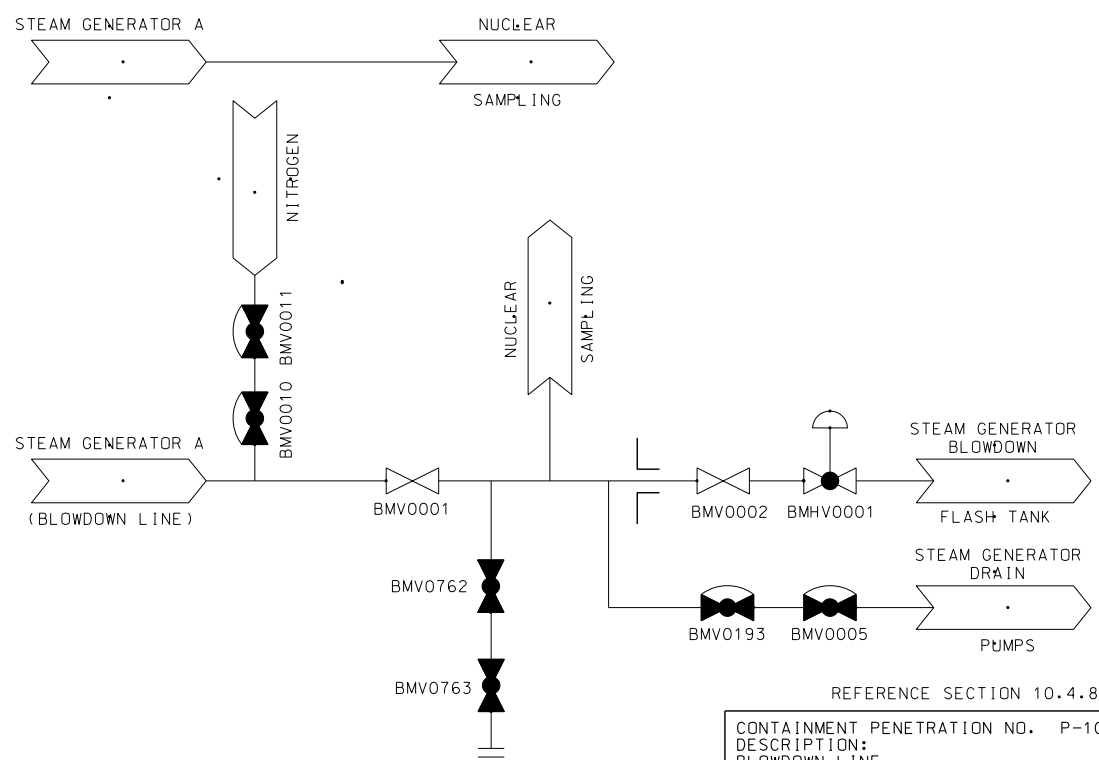

APPENDIX J REQUIREMENT
 TYPE A
 B
 C
 NONE

REFERENCE SECTION 10.4.8
 CONTAINMENT PENETRATION NO. P-10
 DESCRIPTION:
 BLOWDOWN LINE
 STEAM GENERATOR BLOWDOWN SYSTEM
 CONTAINMENT PENETRATIONS
 FIGURE 6.2.4-1
 PAGE 10 OF 84
 REV. 17 8/16

VALVE NO.	LINE/ VALVE SIZE, IN.	INSIDE/ OUTSIDE CONT.	NORMAL FLOW DIRECTION	VALVE TYPE	VALVE OPERATOR	POWER SOURCE	PRIMARY ACTUATION SIGNAL	SECONDARY ACTUATION SIGNAL	MAXIMUM CLOSURE TIME (SEC.) (NOTE 1)	VALVE POSITION				
										NORMAL	SHUTDOWN	POWER FAILURE	POST ACCIDENT	
													PRIMARY	SECONDARY
BMV0021	1/1	INSIDE	N/A	GLOBE	MANUAL	N/A	N/A	N/A	N/A	CLOSED	CLOSED	N/A	CLOSED	N/A
BMV0192	2/2	INSIDE	N/A	GLOBE	MANUAL	N/A	N/A	N/A	N/A	CLOSED	CLOSED	N/A	CLOSED	N/A
BMHV0002	4/4	OUTSIDE	OUT	GLOBE	AIR	1,4	SGBSIS	NONE	10	OPEN	OPEN	CLOSED	CLOSED	N/A
BMV0764	3/4 / 3/4	INSIDE	N/A	GLOBE	MANUAL	N/A	N/A	N/A	N/A	CLOSED	CLOSED	N/A	CLOSED	N/A
BMV0765	3/4 / 3/4	INSIDE	N/A	GLOBE	MANUAL	N/A	N/A	N/A	N/A	CLOSED	CLOSED	N/A	CLOSED	N/A


ENGINEERED SAFETY FEATURE SYSTEM	YES <input checked="" type="checkbox"/> NO <input type="checkbox"/>
FLUID CONTAINED:	WATER
LENGTH OF PIPING TO OUTERMOST ISOLATION VALVE:	6.0 FT.
APPLICABLE GDC NO.	NONE

GENERAL COMMENTS:

THE CONTAINMENT PENETRATIONS ASSOCIATED WITH THE STEAM GENERATORS ARE NOT SUBJECT TO GDC-57, SINCE THE CONTAINMENT BARRIER INTEGRITY IS NOT BREACHED. THE BOUNDARY OR BARRIER AGAINST FISSION PRODUCT LEAKAGE TO THE ENVIRONMENT IS THE INSIDE OF THE STEAM GENERATOR TUBES AND THE OUTSIDE OF THE LINES EMANATING FROM THE STEAM GENERATOR SHELLS.

THE PENETRATION CONFIGURATION IS PRESENTED FOR FIGURE 6.2.4-1 COMPLETENESS. NONE OF THE VALVES SHOWN ARE CONTAINMENT ISOLATION VALVES.

NOTE 1: MAXIMUM CLOSURE TIMES SPECIFIED IN THIS FIGURE ARE NOMINAL DESIGN OR LICENSING-BASIS VALUES. PERFORMANCE-BASED VALVE OPERABILITY LIMITS FOR VALVE CLOSURE TIMES ARE SPECIFIED PER THE INSERVICE TESTING PROGRAM FOR CALLAWAY.

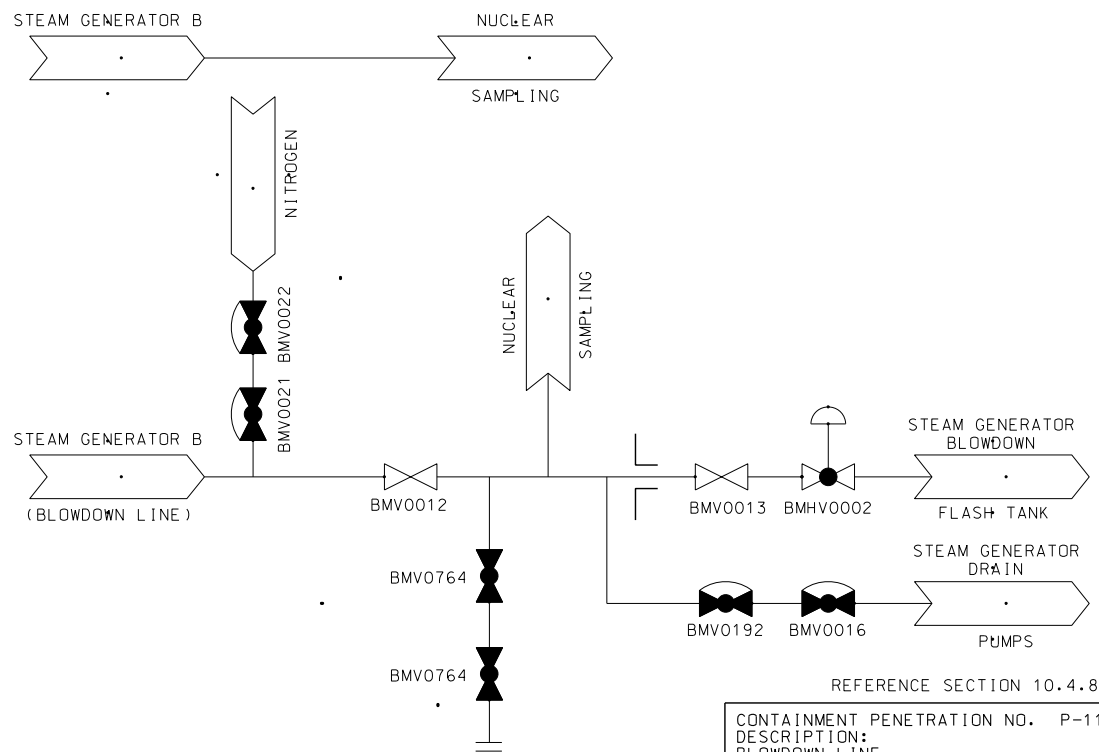

APPENDIX J REQUIREMENT

TYPE A
 B
 C
 NONE

REFERENCE SECTION 10.4.8

CONTAINMENT PENETRATION NO. P-11
 DESCRIPTION:
 BLOWDOWN LINE
 STEAM GENERATOR BLOWDOWN SYSTEM

CONTAINMENT PENETRATIONS
 FIGURE 6.2.4-1
 PAGE 11 OF 84
 REV. 17 8/16

VALVE NO.	LINE/ VALVE SIZE, IN.	INSIDE/ OUTSIDE CONT.	NORMAL FLOW DIRECTION	VALVE TYPE	VALVE OPERATOR	POWER SOURCE	PRIMARY ACTUATION SIGNAL	SECONDARY ACTUATION SIGNAL	MAXIMUM CLOSURE TIME (SEC.)	VALVE POSITION				
										NORMAL	SHUTDOWN	POWER FAILURE	POST ACCIDENT	
													PRIMARY	SECONDARY
BMV0032	1/1	INSIDE	N/A	GLOBE	MANUAL	N/A	N/A	N/A	N/A	CLOSED	CLOSED	N/A	CLOSED	N/A
BMV0191	2/2	INSIDE	N/A	GLOBE	MANUAL	N/A	N/A	N/A	N/A	CLOSED	CLOSED	N/A	CLOSED	N/A
BMHV0003	4/4	OUTSIDE	OUT	GLOBE	AIR	1, 4	SGBSIS	NONE	10	OPEN	OPEN	CLOSED	CLOSED	N/A
BMV0766	3/4 / 3/4	INSIDE	N/A	GLOBE	MANUAL	N/A	N/A	N/A	N/A	CLOSED	CLOSED	N/A	CLOSED	N/A
BMV0767	3/4 / 3/4	INSIDE	N/A	GLOBE	MANUAL	N/A	N/A	N/A	N/A	CLOSED	CLOSED	N/A	CLOSED	N/A


ENGINEERED SAFETY FEATURE SYSTEM	YES <input checked="" type="checkbox"/> NO <input type="checkbox"/>
FLUID CONTAINED:	WATER
LENGTH OF PIPING TO OUTERMOST ISOLATION VALVE:	6.9 FT.
APPLICABLE GDC NO.	NONE

GENERAL COMMENTS:

THE CONTAINMENT PENETRATIONS ASSOCIATED WITH THE STEAM GENERATORS ARE NOT SUBJECT TO GDC-57, SINCE THE CONTAINMENT BARRIER INTEGRITY IS NOT BREACHED. THE BARRIER AGAINST FISSION PRODUCT LEAKAGE TO THE ENVIRONMENT IS THE INSIDE OF THE STEAM GENERATOR TUBES AND THE OUTSIDE OF THE LINES EMANATING FROM THE STEAM GENERATOR SHELLS.

THE PENETRATION CONFIGURATION IS PRESENTED FOR FIGURE 6.2.4-1 COMPLETENESS. NONE OF THE VALVES SHOWN ARE CONTAINMENT ISOLATION VALVES.

NOTE 1: MAXIMUM CLOSURE TIMES SPECIFIED IN THIS FIGURE ARE NOMINAL DESIGN OR LICENSING-BASIS VALUES. PERFORMANCE-BASED VALVE OPERABILITY LIMITS FOR VALVE CLOSURE TIMES ARE SPECIFIED PER THE INSERVICE TESTING PROGRAM FOR CALLAWAY.

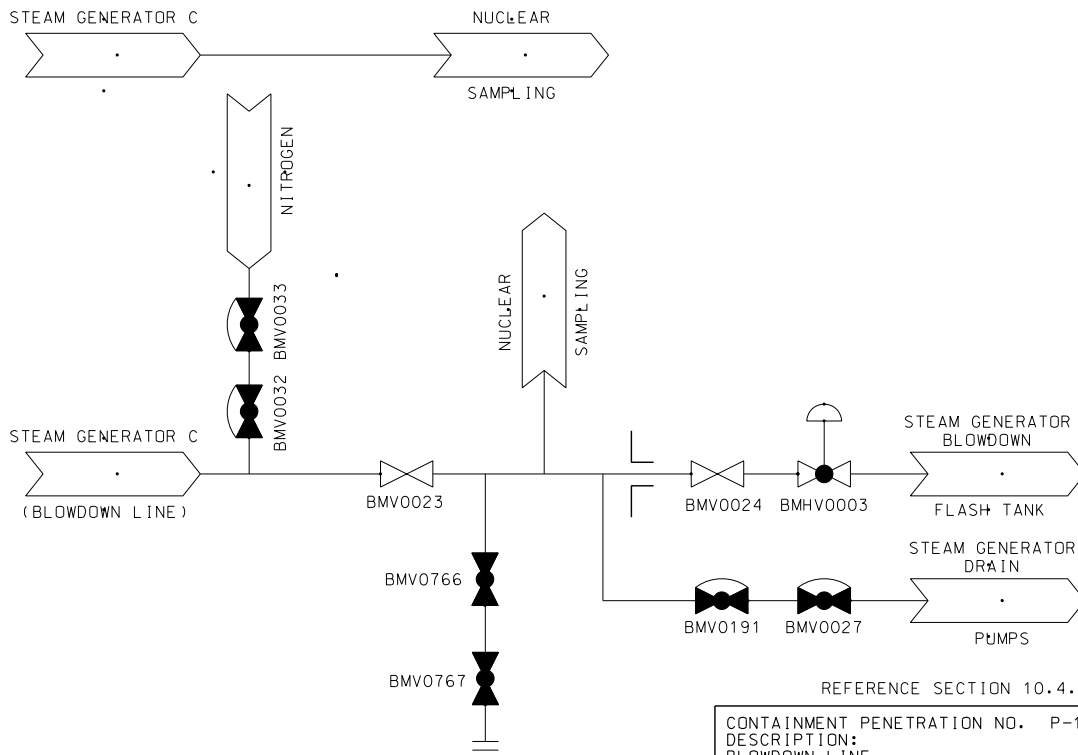

APPENDIX J REQUIREMENT

- TYPE A
- B
- C
- NONE

REFERENCE SECTION 10.4.8

CONTAINMENT PENETRATION NO. P-12 DESCRIPTION: BLOWDOWN LINE STEAM GENERATOR BLOWDOWN SYSTEM
CONTAINMENT PENETRATIONS FIGURE 6.2.4-1 PAGE 12 OF 84 REV. 17 8/16

VALVE NO.	LINE/ VALVE SIZE, IN.	INSIDE/ OUTSIDE CONT.	NORMAL FLOW DIRECTION	VALVE TYPE	VALVE OPERATOR	POWER SOURCE	PRIMARY ACTUATION SIGNAL	SECONDARY ACTUATION SIGNAL	MAXIMUM CLOSURE TIME (SEC.) (NOTE 1)	VALVE POSITION				
										NORMAL	SHUTDOWN	POWER FAILURE	POST ACCIDENT	
													PRIMARY	SECONDARY
ENHV0007	12/12	OUTSIDE	OUT	GATE	MOTOR	4	CIS-A	REM/MAN	30	CLOSED	CLOSED	AS IS	CLOSED	OPEN
ENV0083	1/1	OUTSIDE	N/A	GATE	MANUAL	N/A	N/A	N/A	N/A	CLOSED	CLOSED	N/A	CLOSED	N/A

ENGINEERED SAFETY FEATURE SYSTEM	YES <input checked="" type="checkbox"/> NO <input type="checkbox"/>
FLUID CONTAINED:	WATER
LENGTH OF PIPING TO OUTERMOST ISOLATION VALVE:	N/A
APPLICABLE GDC NO.	56

GENERAL COMMENTS:


THIS PENETRATION IS ASSOCIATED WITH THE CONTAINMENT SPRAY SYSTEM, WHICH IS REQUIRED TO MITIGATE THE CONSEQUENCES OF A LOCA. A SINGLE REMOTE-MANUAL ISOLATION IS PROVIDED, LOCATED WITHIN A WATERTIGHT COMPARTMENT OUTSIDE THE CONTAINMENT, FOR GREATER SYSTEM RELIABILITY. A SINGLE ACTIVE OR PASSIVE FAILURE CAN BE ACCOMMODATED SINCE THE SYSTEM IS CLOSED OUTSIDE THE CONTAINMENT AND IS DESIGNED AND CONSTRUCTED COMMENSURATE WITH THE DESIGN AND CONSTRUCTION OF THE CONTAINMENT.

LOCAL TESTING OF THE VALVE OR THE CLOSED SYSTEM OUTSIDE THE CONTAINMENT IS NOT REQUIRED SINCE THE SYSTEM IS OPERATED AND INSPECTED DURING NORMAL PLANT OPERATION TO ASSURE THAT THE INTEGRITY IS BEING MAINTAINED.

NOTE 1: MAXIMUM CLOSURE TIMES SPECIFIED IN THIS FIGURE ARE NOMINAL DESIGN OR LICENSING-BASIS VALUES. PERFORMANCE-BASED VALVE OPERABILITY LIMITS FOR VALVE CLOSURE TIMES ARE SPECIFIED PER THE INSERVICE TESTING PROGRAM FOR CALLAWAY.

APPENDIX J REQUIREMENT

- TYPE A
 B
 C
 NONE

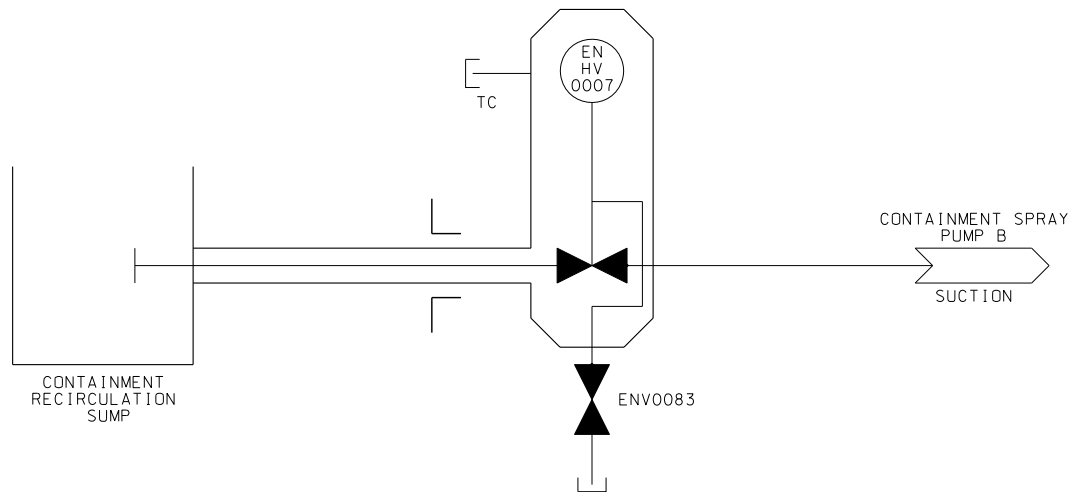

REFERENCE SECTION (S) 6.2.2

CONTAINMENT PENETRATION NO. P-13 DESCRIPTION: RECIRCULATION LINE CONTAINMENT SPRAY SYSTEM
CONTAINMENT PENETRATIONS FIGURE 6.2.4-1 PAGE 13 OF 84 REV. 11 3/08

VALVE NO.	LINE/ VALVE SIZE, IN.	INSIDE/ OUTSIDE CONT.	NORMAL FLOW DIRECTION	VALVE TYPE	VALVE OPERATOR	POWER SOURCE	PRIMARY ACTUATION SIGNAL	SECONDARY ACTUATION SIGNAL	MAXIMUM CLOSURE TIME (SEC.) (NOTE 1)	VALVE POSITION				
										NORMAL	SHUTDOWN	POWER FAILURE	POST ACCIDENT	
													PRIMARY	SECONDARY
EJHV8811B	14/14	OUTSIDE	OUT	GATE	MOTOR	4	NONE	SIS WITH RWST-LO	20	CLOSED	CLOSED	AS IS	CLOSED	OPEN
EJHV0022	1/1	OUTSIDE	OUT	GLOBE	SOLENOID	4	NONE	REM/MAN	5	CLOSED	CLOSED	CLOSED	CLOSED	OPEN
EJHV0042	1/1	OUTSIDE	N/A	GLOBE	MANUAL	N/A	N/A	N/A	N/A	CLOSED	CLOSED	N/A	CLOSED	N/A


ENGINEERED SAFETY FEATURE SYSTEM	YES <input checked="" type="checkbox"/> NO <input type="checkbox"/>
FLUID CONTAINED:	WATER
LENGTH OF PIPING TO OUTERMOST ISOLATION VALVE:	N/A
APPLICABLE GDC NO.	56

GENERAL COMMENTS:

THIS PENETRATION IS ASSOCIATED WITH THE RHR SYSTEM. RHR IS REQUIRED TO MITIGATE THE CONSEQUENCES OF A LOCA. A SINGLE REMOTE-MANUAL ISOLATION IS PROVIDED, LOCATED WITHIN A WATERTIGHT COMPARTMENT OUTSIDE THE CONTAINMENT, FOR GREATER SYSTEM RELIABILITY. A SINGLE ACTIVE OR PASSIVE FAILURE CAN BE ACCOMMODATED SINCE THE SYSTEM IS CLOSED OUTSIDE THE CONTAINMENT AND IS DESIGNED AND CONSTRUCTED COMMENSURATE WITH THE DESIGN AND CONSTRUCTION OF THE CONTAINMENT.

LOCAL TESTING OF THE RHR VALVE OR THE CLOSED SYSTEM OUTSIDE THE CONTAINMENT IS NOT REQUIRED SINCE THE SYSTEM IS OPERATED AND INSPECTED DURING NORMAL PLANT OPERATION TO ASSURE THAT THE INTEGRITY IS BEING MAINTAINED. THE END OF THE LINE CONTAINING EJHV0022 IS SEALED USING A WELDED PIPE CAP.

NOTE 1: MAXIMUM CLOSURE TIMES SPECIFIED IN THIS FIGURE ARE NOMINAL DESIGN OR LICENSING-BASIS VALUES. PERFORMANCE-BASED VALVE OPERABILITY LIMITS FOR VALVE CLOSURE TIMES ARE SPECIFIED PER THE INSERVICE TESTING PROGRAM FOR CALLAWAY.

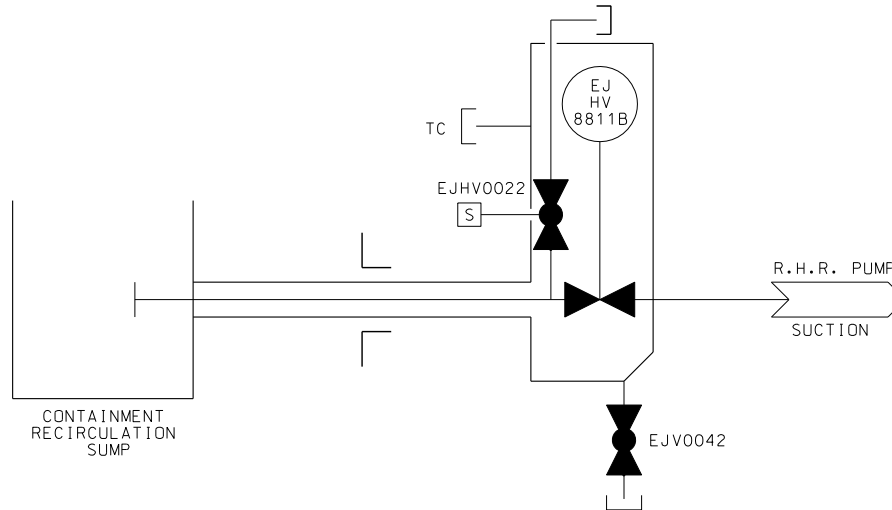

REFERENCE SECTION (S) 5.4.7 AND 6.3

CONTAINMENT PENETRATION NO. P-14 DESCRIPTION: RECIRCULATION LINE RESIDUAL HEAT REMOVAL SYSTEM
CONTAINMENT PENETRATIONS FIGURE 6.2.4-1 PAGE 14 OF 84 REV. 15 8/16

APPENDIX J REQUIREMENT

- TYPE A
 B
 C
 NONE

VALVE NO.	LINE/ VALVE SIZE, IN.	INSIDE/ OUTSIDE CONT.	NORMAL FLOW DIRECTION	VALVE TYPE	VALVE OPERATOR	POWER SOURCE	PRIMARY ACTUATION SIGNAL	SECONDARY ACTUATION SIGNAL	MAXIMUM CLOSURE TIME (SEC.) (NOTE 1)	VALVE POSITION				
										NORMAL	SHUTDOWN	POWER FAILURE	POST ACCIDENT	
													PRIMARY	SECONDARY
EJHV8811A	14/14	OUTSIDE	OUT	GATE	MOTOR	1	NONE	SIS WITH RWST-LO	20	CLOSED	CLOSED	AS IS	CLOSED	OPEN
EJHV0021	1/1	OUTSIDE	OUT	GLOBE	SOLENOID	1	NONE	REM/MAN	5	CLOSED	CLOSED	CLOSED	CLOSED	OPEN
EJV0041	1/1	OUTSIDE	N/A	GLOBE	MANUAL	N/A	N/A	N/A	N/A	CLOSED	CLOSED	N/A	CLOSED	N/A

ENGINEERED SAFETY FEATURE SYSTEM YES NO

FLUID CONTAINED: WATER


LENGTH OF PIPING TO OUTERMOST ISOLATION VALVE: N/A

APPLICABLE GDC NO. 56

GENERAL COMMENTS:

THIS PENETRATION IS ASSOCIATED WITH THE RHR. RHR IS REQUIRED TO MITIGATE THE CONSEQUENCES OF A LOCA. A SINGLE REMOTE-MANUAL ISOLATION IS PROVIDED, LOCATED WITHIN A WATERTIGHT COMPARTMENT OUTSIDE THE CONTAINMENT, FOR GREATER SYSTEM RELIABILITY. A SINGLE ACTIVE OR PASSIVE FAILURE CAN BE ACCOMMODATED SINCE THE SYSTEM IS CLOSED OUTSIDE THE CONTAINMENT AND IS DESIGNED AND CONSTRUCTED COMMENSURATE WITH THE DESIGN AND CONSTRUCTION OF THE CONTAINMENT.

LOCAL TESTING OF THE RHR VALVE OR THE CLOSED SYSTEM OUTSIDE THE CONTAINMENT IS NOT REQUIRED SINCE THE SYSTEM IS OPERATED AND INSPECTED DURING NORMAL PLANT OPERATION TO ASSURE THAT THE INTEGRITY IS BEING MAINTAINED. THE END OF THE LINE CONTAINING EJHV0021 IS SEALED USING A WELDED PIPE CAP.

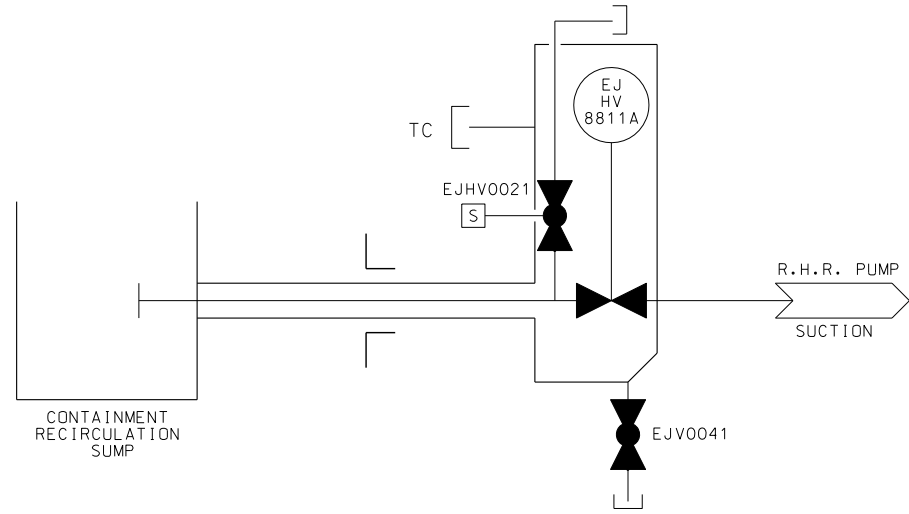

NOTE 1: MAXIMUM CLOSURE TIMES SPECIFIED IN THIS FIGURE ARE NOMINAL DESIGN OR LICENSING-BASIS VALUES. PERFORMANCE-BASED VALVE OPERABILITY LIMITS FOR VALVE CLOSURE TIMES ARE SPECIFIED PER THE INSERVICE TESTING PROGRAM FOR CALLAWAY.

APPENDIX J REQUIREMENT

TYPE A
 B
 C
 NONE

REFERENCE SECTION (S) 5.4.7 AND 6.3

CONTAINMENT PENETRATION NO. P-15
 DESCRIPTION:
 RECIRCULATION LINE
 RESIDUAL HEAT REMOVAL SYSTEM

CONTAINMENT PENETRATIONS
 FIGURE 6.2.4-1
 PAGE 15 OF 84
 REV. 15 8/16

VALVE NO.	LINE/VALVE SIZE, IN.	INSIDE/OUTSIDE CONT.	NORMAL FLOW DIRECTION	VALVE TYPE	VALVE OPERATOR	POWER SOURCE	PRIMARY ACTUATION SIGNAL	SECONDARY ACTUATION SIGNAL	MAXIMUM CLOSURE TIME (SEC.) (NOTE 1)	VALVE POSITION				
										NORMAL	SHUTDOWN	POWER FAILURE	POST ACCIDENT	
													PRIMARY	SECONDARY
ENHV0001	12/12	OUTSIDE	OUT	GATE	MOTOR	1	CIS-A	REM/MAN	30	CLOSED	CLOSED	AS IS	CLOSED	OPEN
ENV0084	1/1	OUTSIDE	N/A	GATE	MANUAL	N/A	N/A	N/A	N/A	CLOSED	CLOSED	N/A	CLOSED	N/A

ENGINEERED SAFETY FEATURE SYSTEM	YES <input checked="" type="checkbox"/> NO <input type="checkbox"/>
FLUID CONTAINED:	WATER
LENGTH OF PIPING TO OUTERMOST ISOLATION VALVE:	N/A
APPLICABLE GDC NO.	56

GENERAL COMMENTS:


THIS PENETRATION IS ASSOCIATED WITH THE CONTAINMENT SPRAY SYSTEM, WHICH IS REQUIRED TO MITIGATE THE CONSEQUENCES OF A LOCA. A SINGLE REMOTE-MANUAL ISOLATION IS PROVIDED, LOCATED WITHIN A WATERTIGHT COMPARTMENT OUTSIDE THE CONTAINMENT, FOR GREATER SYSTEM RELIABILITY. A SINGLE ACTIVE OR PASSIVE FAILURE CAN BE ACCOMMODATED SINCE THE SYSTEM IS CLOSED OUTSIDE THE CONTAINMENT AND IS DESIGNED AND CONSTRUCTED COMMENSURATE WITH THE DESIGN AND CONSTRUCTION OF THE CONTAINMENT.

LOCAL TESTING OF THE VALVE OR THE CLOSED SYSTEM OUTSIDE THE CONTAINMENT IS NOT REQUIRED SINCE THE SYSTEM IS OPERATED AND INSPECTED DURING NORMAL PLANT OPERATION TO ASSURE THAT THE INTEGRITY IS BEING MAINTAINED.

NOTE 1: MAXIMUM CLOSURE TIMES SPECIFIED IN THIS FIGURE ARE NOMINAL DESIGN OR LICENSING-BASIS VALUES. PERFORMANCE-BASED VALVE OPERABILITY LIMITS FOR VALVE CLOSURE TIMES ARE SPECIFIED PER THE INSERVICE TESTING PROGRAM FOR CALLAWAY.

APPENDIX J REQUIREMENT

- TYPE A
- B
- C
- NONE

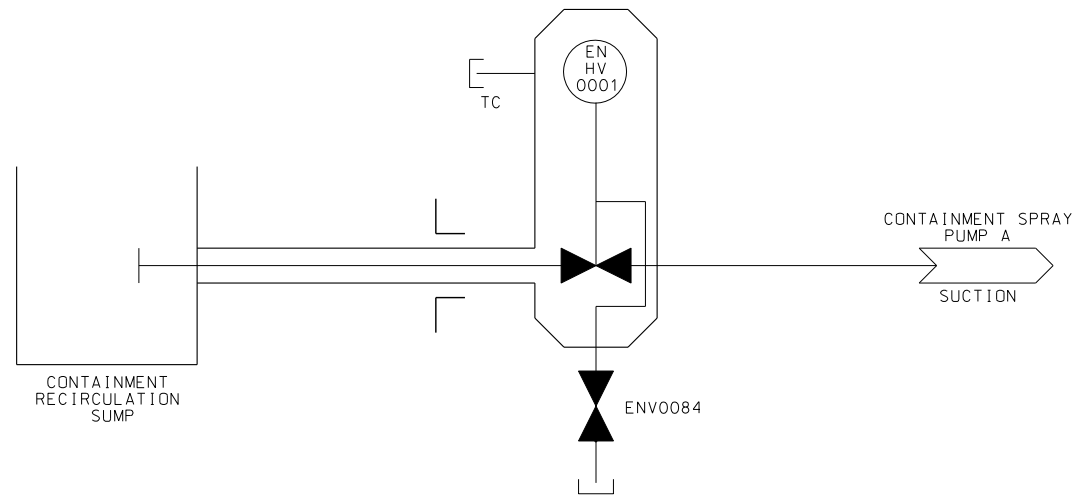

REFERENCE SECTION (S) 6.2.2

CONTAINMENT PENETRATION NO. P-16 DESCRIPTION: RECIRCULATION LINE CONTAINMENT SPRAY SYSTEM
CONTAINMENT PENETRATIONS FIGURE 6.2.4-1 PAGE 16 OF 84 REV. 12 8/16

VALVE NO.	LINE/ VALVE SIZE, IN.	INSIDE/ OUTSIDE CONT.	NORMAL FLOW DIRECTION	VALVE TYPE	VALVE OPERATOR	POWER SOURCE	PRIMARY ACTUATION SIGNAL	SECONDARY ACTUATION SIGNAL	MAXIMUM CLOSURE TIME (SEC.) (NOTE 1)	VALVE POSITION				
										NORMAL	SHUTDOWN	POWER FAILURE	POST ACCIDENT	
													PRIMARY	SECONDARY
EJHCV8825	3/4 / 3/4	INSIDE	IN	GLOBE	AIR	1	CIS-A	NONE	10	CLOSED	CLOSED	CLOSED	CLOSED	N/A
EJHV8840	10/10	OUTSIDE	IN	GATE	MOTOR	4	NONE	REM/MAN	15	CLOSED	CLOSED	AS IS	CLOSED	OPEN
EJV0056	1/1	OUTSIDE	N/A	GLOBE	MANUAL	N/A	N/A	N/A	N/A	CLOSED	CLOSED	N/A	CLOSED	N/A
EJV0124	1/1	INSIDE	N/A	GLOBE	MANUAL	N/A	N/A	N/A	N/A	CLOSED	CLOSED	N/A	CLOSED	N/A
EJV0122	3/4 / 3/4	INSIDE	N/A	GLOBE	MANUAL	N/A	N/A	N/A	N/A	CLOSED	CLOSED	N/A	CLOSED	N/A
EJV0118	1/1	INSIDE	N/A	GLOBE	MANUAL	N/A	N/A	N/A	N/A	CLOSED	CLOSED	N/A	CLOSED	N/A
EJV0120	1/1	INSIDE	N/A	GLOBE	MANUAL	N/A	N/A	N/A	N/A	CLOSED	CLOSED	N/A	CLOSED	N/A
EJ8841A	6/6	INSIDE	IN	CHECK	N/A	N/A	N/A	N/A	N/A	CLOSED	CLOSED	N/A	CLOSED	OPEN
EJ8841B	6/6	INSIDE	IN	CHECK	N/A	N/A	N/A	N/A	N/A	CLOSED	CLOSED	N/A	CLOSED	OPEN

ENGINEERED SAFETY
FEATURE SYSTEM YES NO

FLUID CONTAINED: WATER

LENGTH OF PIPING TO OUTERMOST
ISOLATION VALVE: 6.9 FT


APPLICABLE
GDC NO. 55

GENERAL COMMENTS:
THIS PENETRATION IS ASSOCIATED WITH THE RESIDUAL HEAT REMOVAL SYSTEM, WHICH IS REQUIRED TO MITIGATE THE CONSEQUENCES OF A LOCA. A CHECK VALVE IS PROVIDED FOR EACH BRANCH LINE INSIDE THE CONTAINMENT, AND A REMOTE-MANUAL ISOLATION VALVE IS PROVIDED OUTSIDE THE CONTAINMENT. A SINGLE ACTIVE OR PASSIVE FAILURE CAN BE ACCOMMODATED SINCE THE SYSTEM IS CLOSED OUTSIDE THE CONTAINMENT AND IS DESIGNED AND CONSTRUCTED COMMENSURATE WITH THE DESIGN AND CONSTRUCTION OF THE CONTAINMENT. LEAKAGE DETECTION FROM THIS LINE OUTSIDE THE CONTAINMENT IS PROVIDED, AS DESCRIBED IN SECTION 9.3.3.

LOCAL TESTING OF THE VALVES OR THE CLOSED SYSTEM OUTSIDE THE CONTAINMENT IS NOT REQUIRED SINCE THE SYSTEM IS OPERATED AND INSPECTED DURING NORMAL PLANT OPERATION TO ASSURE THAT THE INTEGRITY IS BEING MAINTAINED.

NOTE 1: MAXIMUM CLOSURE TIMES SPECIFIED IN THIS FIGURE ARE NOMINAL DESIGN OR LICENSING-BASIS VALUES. PERFORMANCE-BASED VALVE OPERABILITY LIMITS FOR VALVE CLOSURE TIMES ARE SPECIFIED PER THE INSERVICE TESTING PROGRAM FOR CALLAWAY.

- APPENDIX J REQUIREMENT
- TYPE A
 B
 C
 NONE

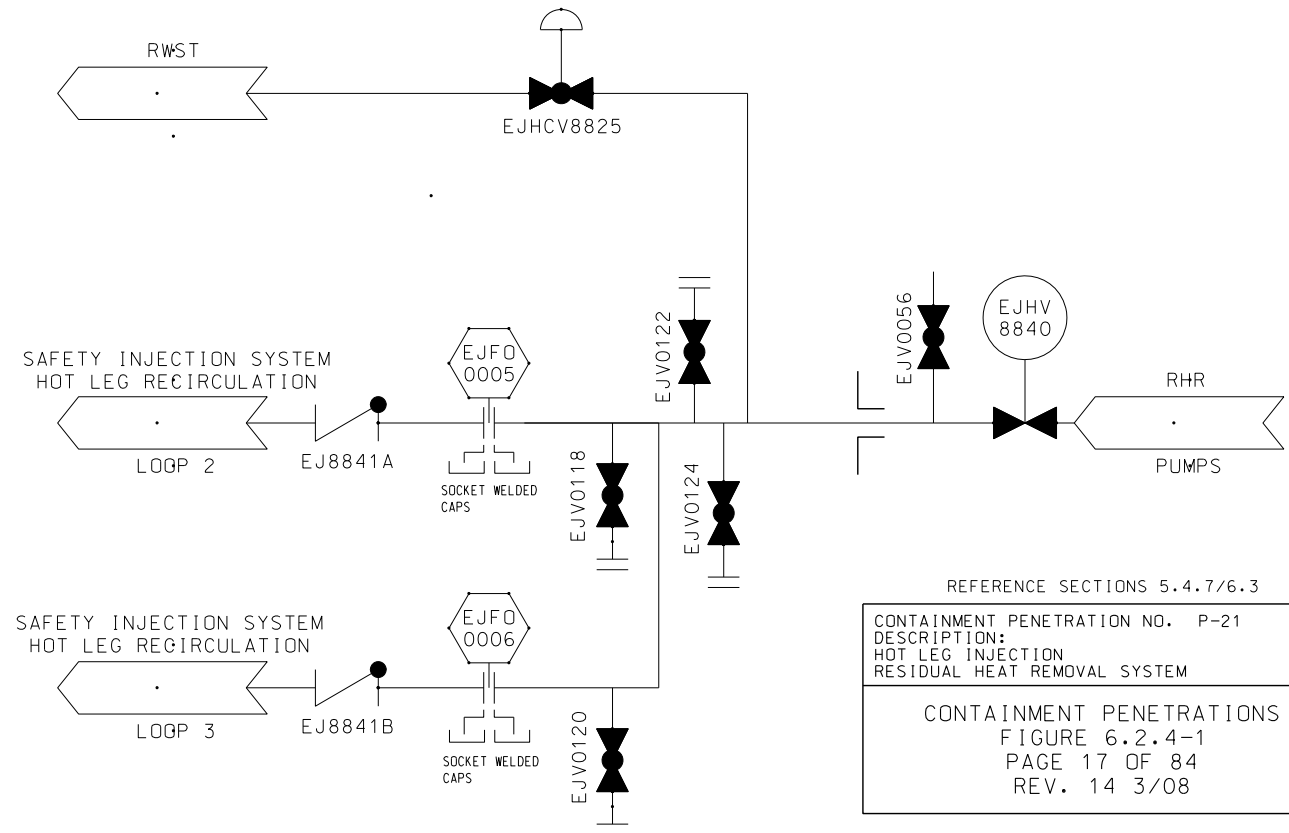

REFERENCE SECTIONS 5.4.7/6.3

CONTAINMENT PENETRATION NO. P-21
 DESCRIPTION:
 HOT LEG INJECTION
 RESIDUAL HEAT REMOVAL SYSTEM

CONTAINMENT PENETRATIONS
 FIGURE 6.2.4-1
 PAGE 17 OF 84
 REV. 14 3/08

VALVE NO.	LINE / VALVE SIZE, IN.	INSIDE / OUTSIDE CONT.	NORMAL FLOW DIRECTION	VALVE TYPE	VALVE OPERATOR	POWER SOURCE	PRIMARY ACTUATION SIGNAL	SECONDARY ACTUATION SIGNAL	MAXIMUM CLOSURE TIME (SEC.) (NOTE 1)	VALVE POSITION				
										NORMAL	SHUTDOWN	POWER FAILURE	POST ACCIDENT	
													PRIMARY	SECONDARY
BBHV8351B	2/2	OUTSIDE	IN	GLOBE	MOTOR	4	NONE	REM/MAN	10	OPEN	OPEN	AS IS	OPEN	CLOSED
BBV0354	1/1	OUTSIDE	N/A	GLOBE	MANUAL	N/A	N/A	N/A	N/A	CLOSED	CLOSED	N/A	CLOSED	N/A
BBV0246	3/4 / 3/4	OUTSIDE	N/A	GLOBE	MANUAL	N/A	N/A	N/A	N/A	CLOSED	CLOSED	N/A	CLOSED	N/A
BBV0148	2/2	INSIDE	IN	CHECK	N/A	N/A	N/A	N/A	N/A	OPEN	OPEN	N/A	OPEN	CLOSED

ENGINEERED SAFETY FEATURE SYSTEM	YES <input type="checkbox"/> NO <input checked="" type="checkbox"/>
FLUID CONTAINED:	WATER
LENGTH OF PIPING TO OUTERMOST ISOLATION VALVE:	7.2 FT.
APPLICABLE GDC NO.	55

GENERAL COMMENTS:


THIS PENETRATION PIPING HAS A HIGH PRESSURE WATER INFLOW WHICH PRECLUDES THE NEED FOR AUTOMATIC ISOLATION OF THIS PENETRATION. THE CVCS CHARGING PUMPS SUPPLY REACTOR COOLANT PUMP SEAL INJECTION WATER, AND THERE IS A POTENTIAL FOR DAMAGE TO THE REACTOR COOLANT PUMP IF UNDESIRE ISOLATION SHOULD OCCUR.

THE ISOLATION CAN BE AFFECTED BY REMOTE-MANUAL CLOSURE OF THE MOTOR-OPERATED VALVE BY THE OPERATOR WHEN REACTOR COOLANT PUMP SEAL WATER FLOW FROM THE CVCS CHARGING PUMPS IS TERMINATED AFTER THE CHARGING PUMPS COMPLETE THEIR SAFTY FUNCTION.

NOTE 1: MAXIMUM CLOSURE TIMES SPECIFIED IN THIS FIGURE ARE NOMINAL DESIGN OR LICENSING-BASIS VALUES. PERFORMANCE-BASED VALVE OPERABILITY LIMITS FOR VALVE CLOSURE TIMES ARE SPECIFIED PER THE INSERVICE TESTING PROGRAM FOR CALLAWAY.

APPENDIX J REQUIREMENT

- TYPE A
 B
 C
 NONE

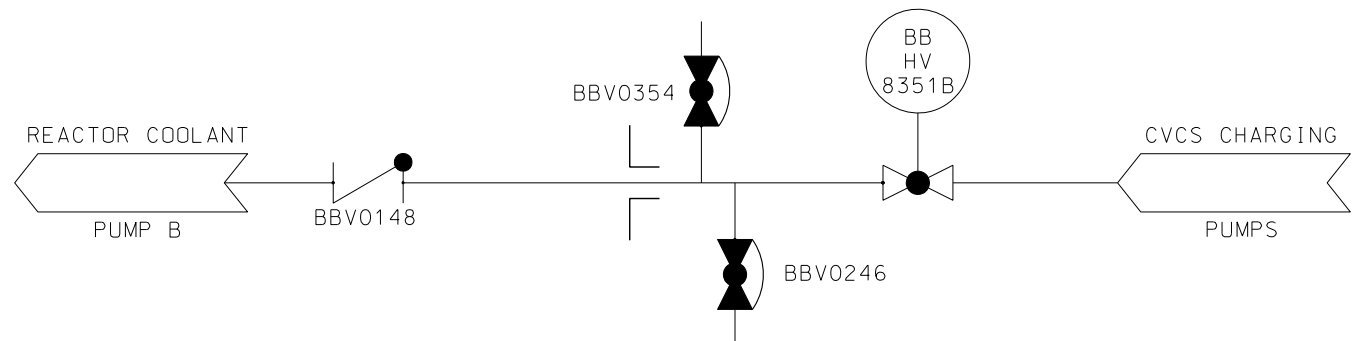

REFERENCE SECTION 5.4

CONTAINMENT PENETRATION NO. P-22
 DESCRIPTION: RCP - SEAL WATER SUPPLY
 REACTOR COOLANT SYSTEM

CONTAINMENT PENETRATIONS
 FIGURE 6.2.4-1
 PAGE 18 OF 84
 REV. 12 9/14


VALVE NO.	LINE / VALVE SIZE, IN.	INSIDE / OUTSIDE CONT.	NORMAL FLOW DIRECTION	VALVE TYPE	VALVE OPERATOR	POWER SOURCE	PRIMARY ACTUATION SIGNAL	SECONDARY ACTUATION SIGNAL	MAXIMUM CLOSURE TIME (SEC.) (NOTE 1)	VALVE POSITION				
										NORMAL	SHUTDOWN	POWER FAILURE	POST ACCIDENT	
													PRIMARY	SECONDARY
BGHV8160	3/3	INSIDE	OUT	GLOBE	AIR	1	CIS-A	NONE	10	OPEN	OPEN	CLOSED	CLOSED	N/A
BGV0363	1/1	OUTSIDE	N/A	GLOBE	MANUAL	N/A	N/A	N/A	N/A	CLOSED	CLOSED	N/A	CLOSED	N/A
BGHV8152	3/3	OUTSIDE	OUT	GLOBE	AIR	4	CIS-A	NONE	10	OPEN	OPEN	CLOSED	CLOSED	N/A

ENGINEERED SAFETY FEATURE SYSTEM	YES <input type="checkbox"/> NO <input checked="" type="checkbox"/>
FLUID CONTAINED:	WATER
LENGTH OF PIPING TO OUTERMOST ISOLATION VALVE:	6.5 FT.
APPLICABLE GDC NO.	55

GENERAL COMMENTS:

NONE

NOTE 1: MAXIMUM CLOSURE TIMES SPECIFIED IN THIS FIGURE ARE NOMINAL DESIGN OR LICENSING-BASIS VALUES. PERFORMANCE-BASED VALVE OPERABILITY LIMITS FOR VALVE CLOSURE TIMES ARE SPECIFIED PER THE INSERVICE TESTING PROGRAM FOR CALLAWAY.

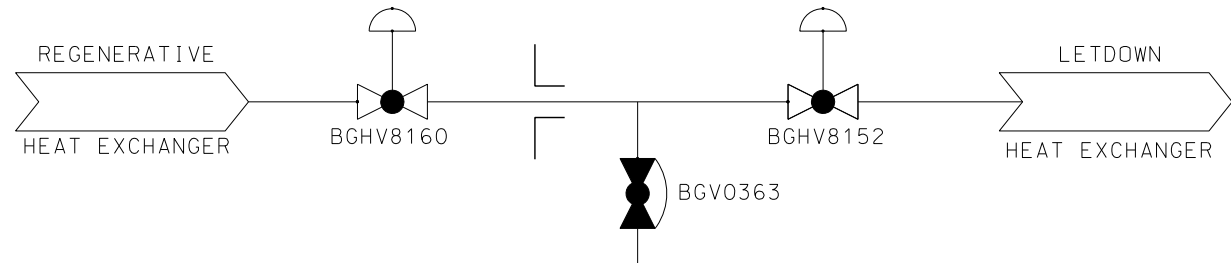

REFERENCE SECTION 9.3.4

CONTAINMENT PENETRATION NO. P-23 DESCRIPTION: NORMAL LETDOWN CHEMICAL AND VOLUME CONTROL SYSTEM
CONTAINMENT PENETRATIONS FIGURE 6.2.4-1 PAGE 19 OF 84 REV. 11 3/08

APPENDIX J REQUIREMENT

- TYPE A
- B
- C
- NONE


VALVE NO.	LINE / VALVE SIZE, IN.	INSIDE / OUTSIDE CONT.	NORMAL FLOW DIRECTION	VALVE TYPE	VALVE OPERATOR	POWER SOURCE	PRIMARY ACTUATION SIGNAL	SECONDARY ACTUATION SIGNAL	MAXIMUM CLOSURE TIME (SEC.) (NOTE 1)	VALVE POSITION				
										NORMAL	SHUTDOWN	POWER FAILURE	POST ACCIDENT	
													PRIMARY	SECONDARY
BGHV8112	2/2	INSIDE	OUT	GLOBE	MOTOR	1	CIS-A	NONE	10	OPEN	OPEN	AS IS	CLOSED	N/A
BGV0135	3/4 / 3/4	INSIDE	IN	CHECK	N/A	N/A	N/A	N/A	N/A	CLOSED	CLOSED	N/A	CLOSED	N/A
BGHV8100	2/2	OUTSIDE	OUT	GLOBE	MOTOR	4	CIS-A	NONE	10	OPEN	OPEN	AS IS	CLOSED	N/A
BGV0457	1/1	OUTSIDE	N/A	GLOBE	MANUAL	N/A	N/A	N/A	N/A	CLOSED	CLOSED	N/A	CLOSED	N/A

ENGINEERED SAFETY FEATURE SYSTEM	YES <input type="checkbox"/> NO <input checked="" type="checkbox"/>
FLUID CONTAINED:	WATER
LENGTH OF PIPING TO OUTERMOST ISOLATION VALVE:	7.8 FT.
APPLICABLE GDC NO.	55

GENERAL COMMENTS:

NONE

NOTE 1: MAXIMUM CLOSURE TIMES SPECIFIED IN THIS FIGURE ARE NOMINAL DESIGN OR LICENSING-BASIS VALUES. PERFORMANCE-BASED VALVE OPERABILITY LIMITS FOR VALVE CLOSURE TIMES ARE SPECIFIED PER THE INSERVICE TESTING PROGRAM FOR CALLAWAY.

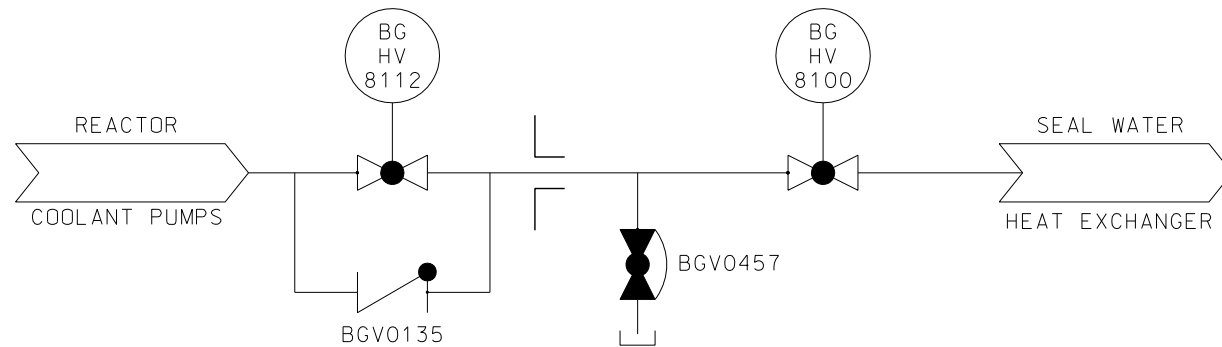

REFERENCE SECTION 9.3.4

CONTAINMENT PENETRATION NO. P-24
DESCRIPTION: RCP - SEAL WATER RETURN
CHEMICAL AND VOLUME CONTROL SYSTEM

CONTAINMENT PENETRATIONS
FIGURE 6.2.4-1
PAGE 20 OF 84
REV. 12 8/16

APPENDIX J REQUIREMENT

TYPE A
B
C
NONE


VALVE NO.	LINE / VALVE SIZE, IN.	INSIDE / OUTSIDE CONT.	NORMAL FLOW DIRECTION	VALVE TYPE	VALVE OPERATOR	POWER SOURCE	PRIMARY ACTUATION SIGNAL	SECONDARY ACTUATION SIGNAL	MAXIMUM CLOSURE TIME (SEC.) (NOTE 1)	VALVE POSITION				
										NORMAL	SHUTDOWN	POWER FAILURE	POST ACCIDENT	
													PRIMARY	SECONDARY
BLHV8047	3/3	OUTSIDE	IN	DIAPHRAGM	AIR	4	CIS-A	NONE	10	OPEN	OPEN	CLOSED	CLOSED	N/A
BLV0054	1/1	OUTSIDE	N/A	GLOBE	MANUAL	N/A	N/A	N/A	N/A	CLOSED	CLOSED	N/A	CLOSED	N/A
BL8046	3/3	INSIDE	IN	CHECK	N/A	N/A	N/A	N/A	N/A	OPEN	OPEN	N/A	CLOSED	N/A

ENGINEERED SAFETY FEATURE SYSTEM	YES <input type="checkbox"/> NO <input checked="" type="checkbox"/>
FLUID CONTAINED:	WATER
LENGTH OF PIPING TO OUTERMOST ISOLATION VALVE:	7.4 FT.
APPLICABLE GDC NO.	56

GENERAL COMMENTS:

NONE

NOTE 1: MAXIMUM CLOSURE TIMES SPECIFIED IN THIS FIGURE ARE NOMINAL DESIGN OR LICENSING-BASIS VALUES. PERFORMANCE-BASED VALVE OPERABILITY LIMITS FOR VALVE CLOSURE TIMES ARE SPECIFIED PER THE INSERVICE TESTING PROGRAM FOR CALLAWAY.

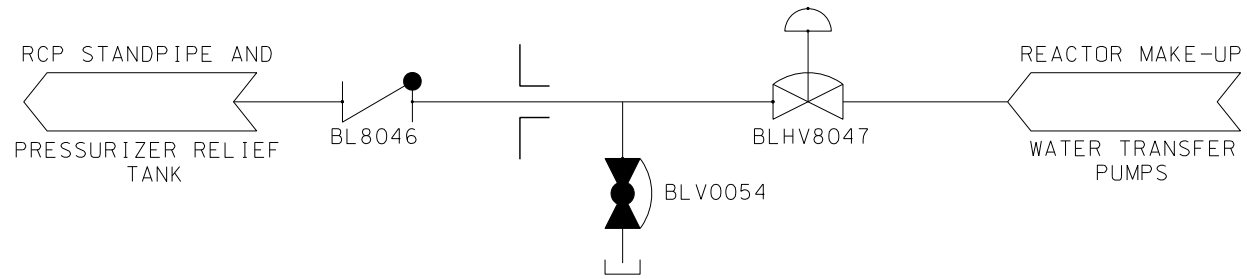

REFERENCE SECTION 9.2.7

CONTAINMENT PENETRATION NO. P-25
 DESCRIPTION: REACTOR MAKEUP WATER
 REACTOR MAKEUP WATER SYSTEM

CONTAINMENT PENETRATIONS
 FIGURE 6.2.4-1
 PAGE 21 OF 84
 REV. 11 3/08

APPENDIX J REQUIREMENT

- TYPE A
- B
- C
- NONE


VALVE NO.	LINE / VALVE SIZE, IN.	INSIDE / OUTSIDE CONT.	NORMAL FLOW DIRECTION	VALVE TYPE	VALVE OPERATOR	POWER SOURCE	PRIMARY ACTUATION SIGNAL	SECONDARY ACTUATION SIGNAL	MAXIMUM CLOSURE TIME (SEC.) (NOTE 1)	VALVE POSITION				
										NORMAL	SHUTDOWN	POWER FAILURE	POST ACCIDENT	
													PRIMARY	SECONDARY
HBHV7176	3/3	INSIDE	OUT	DIAPHRAGM	AIR	1	CIS-A	NONE	10	OPEN	OPEN	CLOSED	CLOSED	N/A
HBHV7136	3/3	OUTSIDE	OUT	DIAPHRAGM	AIR	4	CIS-A	NONE	10	OPEN	OPEN	CLOSED	CLOSED	N/A
HBV0419	1/1	OUTSIDE	N/A	GLOBE	MANUAL	N/A	N/A	N/A	N/A	CLOSED	CLOSED	N/A	CLOSED	N/A

ENGINEERED SAFETY FEATURE SYSTEM	YES <input type="checkbox"/> NO <input checked="" type="checkbox"/>
FLUID CONTAINED:	WATER
LENGTH OF PIPING TO OUTERMOST ISOLATION VALVE:	11.9 FT.
APPLICABLE GDC NO.	56

GENERAL COMMENTS:

NONE

NOTE 1: MAXIMUM CLOSURE TIMES SPECIFIED IN THIS FIGURE ARE NOMINAL DESIGN OR LICENSING-BASIS VALUES. PERFORMANCE-BASED VALVE OPERABILITY LIMITS FOR VALVE CLOSURE TIMES ARE SPECIFIED PER THE INSERVICE TESTING PROGRAM FOR CALLAWAY.

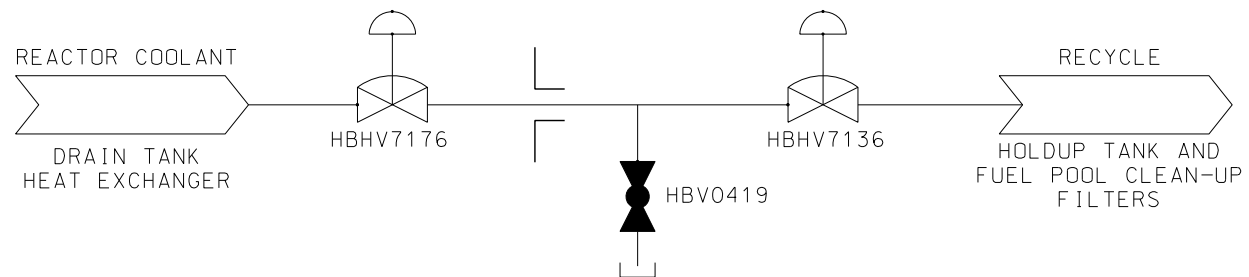

REFERENCE SECTION 11.2

CONTAINMENT PENETRATION NO. P-26 DESCRIPTION: REACTOR COOLANT DRAIN TANK DISCHARGE LIQUID RADWASTE SYSTEM
CONTAINMENT PENETRATIONS FIGURE 6.2.4-1 PAGE 22 OF 84 REV. 12 8/16

APPENDIX J REQUIREMENT

- TYPE A
 B
 C
 NONE

VALVE NO.	LINE/ VALVE SIZE, IN.	INSIDE/ OUTSIDE CONT.	NORMAL FLOW DIRECTION	VALVE TYPE	VALVE OPERATOR	POWER SOURCE	PRIMARY ACTUATION SIGNAL	SECONDARY ACTUATION SIGNAL	MAXIMUM CLOSURE TIME (SEC.) (NOTE 1)	VALVE POSITION				
										NORMAL	SHUTDOWN	POWER FAILURE	POST ACCIDENT	
													PRIMARY	SECONDARY
EJHV8809B	10/10	OUTSIDE	IN	GATE	MOTOR	4	NONE	REM/MAN	15	OPEN	OPEN	AS IS	OPEN	CLOSED
EJV0058	1/1	OUTSIDE	N/A	GLOBE	MANUAL	N/A	N/A	N/A	N/A	CLOSED	CLOSED	N/A	CLOSED	N/A
EJHCV8890B	3/4 / 3/4	INSIDE	IN	GLOBE	AIR	4	CIS-A	NONE	10	CLOSED	CLOSED	CLOSED	CLOSED	N/A
EJV0086	1/1	INSIDE	N/A	GLOBE	MANUAL	N/A	N/A	N/A	N/A	CLOSED	CLOSED	N/A	CLOSED	N/A
EJV0090	3/4 / 3/4	INSIDE	N/A	GLOBE	MANUAL	N/A	N/A	N/A	N/A	CLOSED	CLOSED	N/A	CLOSED	N/A
EP8818C	6/6	INSIDE	IN	CHECK	N/A	N/A	N/A	N/A	N/A	CLOSED	OPEN	N/A	OPEN	CLOSED
EP8818D	6/6	INSIDE	IN	CHECK	N/A	N/A	N/A	N/A	N/A	CLOSED	OPEN	N/A	OPEN	CLOSED
EJV0166	3/4 / 3/4	INSIDE	N/A	GLOBE	MANUAL	N/A	N/A	N/A	N/A	CLOSED	CLOSED	CLOSED	CLOSED	N/A
EJV0213	3/4 / 3/4	INSIDE	N/A	GLOBE	MANUAL	N/A	N/A	N/A	N/A	CLOSED	CLOSED	N/A	CLOSED	CLOSED


ENGINEERED SAFETY FEATURE SYSTEM	YES <input checked="" type="checkbox"/> NO <input type="checkbox"/>
FLUID CONTAINED:	WATER
LENGTH OF PIPING TO OUTERMOST ISOLATION VALVE:	13.3 FT
APPLICABLE GDC NO.	55

GENERAL COMMENTS:
 THIS PENETRATION IS ASSOCIATED WITH THE RESIDUAL HEAT REMOVAL SYSTEM, WHICH IS REQUIRED TO MITIGATE THE CONSEQUENCES OF A LOCA. A CHECK VALVE IS PROVIDED FOR EACH BRANCH LINE INSIDE THE CONTAINMENT, AND A REMOTE-MANUAL ISOLATION VALVE IS PROVIDED OUTSIDE THE CONTAINMENT. A SINGLE ACTIVE OR PASSIVE FAILURE CAN BE ACCOMMODATED SINCE THE SYSTEM IS CLOSED OUTSIDE THE CONTAINMENT AND IS DESIGNED AND CONSTRUCTED COMMENSURATE WITH THE DESIGN AND CONSTRUCTION OF THE CONTAINMENT. LEAKAGE DETECTION FROM THIS LINE OUTSIDE THE CONTAINMENT IS PROVIDED, AS DESCRIBED IN SECTION 9.3.3.

LOCAL TESTING OF THE VALVES OR THE CLOSED SYSTEM OUTSIDE THE CONTAINMENT IS NOT REQUIRED SINCE THE SYSTEM IS OPERATED AND INSPECTED DURING NORMAL PLANT OPERATION TO ASSURE THAT THE INTEGRITY IS BEING MAINTAINED.

NOTE 1: MAXIMUM CLOSURE TIMES SPECIFIED IN THIS FIGURE ARE NOMINAL DESIGN OR LICENSING-BASIS VALUES. PERFORMANCE-BASED VALVE OPERABILITY LIMITS FOR VALVE CLOSURE TIMES ARE SPECIFIED PER THE INSERVICE TESTING PROGRAM FOR CALLAWAY.

APPENDIX J REQUIREMENT
 TYPE A
 B
 C
 NONE

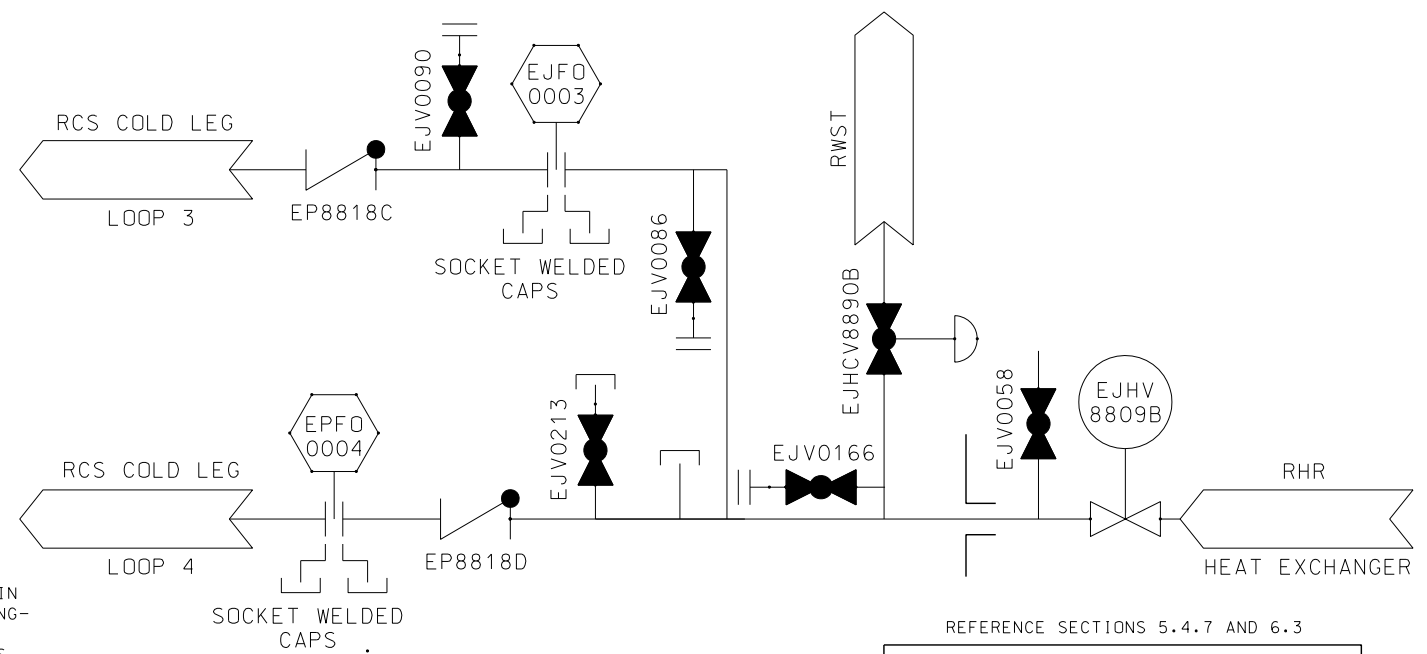

REFERENCE SECTIONS 5.4.7 AND 6.3

CONTAINMENT PENETRATION NO. P-27
DESCRIPTION: COLD LEG INJECTION RESIDUAL HEAT REMOVAL SYSTEM
CONTAINMENT PENETRATIONS FIGURE 6.2.4-1 PAGE 23 OF 84 REV. 17 11/10

VALVE NO.	LINE/ VALVE SIZE, IN.	INSIDE/ OUTSIDE CONT.	NORMAL FLOW DIRECTION	VALVE TYPE	VALVE OPERATOR	POWER SOURCE	PRIMARY ACTUATION SIGNAL	SECONDARY ACTUATION SIGNAL	MAXIMUM CLOSURE TIME (SEC.) (NOTE 1)	VALVE POSITION				
										NORMAL	SHUTDOWN	POWER FAILURE	POST ACCIDENT	
													PRIMARY	SECONDARY
EFHV0032	14/14	OUTSIDE	IN	BUTTERFLY	MOTOR	4	SIS	REM/MAN	40	OPEN	OPEN	AS IS	OPEN	CLOSED
EFHV0034	14/14	INSIDE	IN	BUTTERFLY	MOTOR	4	SIS	REM/MAN	35	OPEN	OPEN	AS IS	OPEN	CLOSED
EFV0278	1/1	INSIDE	N/A	GATE	MANUAL	N/A	N/A	N/A	N/A	CLOSED	CLOSED	N/A	CLOSED	N/A

ENGINEERED SAFETY FEATURE SYSTEM YES NO

FLUID CONTAINED: WATER

LENGTH OF PIPING TO OUTERMOST ISOLATION VALVE: 12.8 FT.

APPLICABLE GDC NO. 56

GENERAL COMMENTS:


THIS PENETRATION IS ASSOCIATED WITH THE ESSENTIAL SERVICE WATER SYSTEM, WHICH IS REQUIRED TO MITIGATE THE CONSEQUENCES OF A LOCA. A REMOTE-MANUAL POWER-OPERATED VALVE IS LOCATED INSIDE, AND A REMOTE-MANUAL POWER-OPERATED VALVE IS LOCATED OUTSIDE THE CONTAINMENT.

THESE VALVES ARE POWERED FROM THE SAME POWER SOURCE FOR GREATER SYSTEM RELIABILITY. A SINGLE ACTIVE OR PASSIVE FAILURE CAN BE ACCOMODATED SINCE THE SYSTEM IS A CLOSED SYSTEM INSIDE THE CONTAINMENT, WHICH IS DESIGNED AND CONSTRUCTED IN ACCORDANCE WITH ASME SECTION III, CLASS 3 REQUIREMENTS. THE ESSENTIAL SERVICE WATER LINES ARE NOT VENTED OR DRAINED DURING A TYPE A TEST SINCE THE AIR COOLERS MAY BE REQUIRED TO COOL THE CONTAINMENT. A TYPE C TEST IS PERFORMED.

NOTE 1: MAXIMUM CLOSURE TIMES SPECIFIED IN THIS FIGURE ARE NOMINAL DESIGN OR LICENSING-BASIS VALUES. PERFORMANCE-BASED VALVE OPERABILITY LIMITS FOR VALVE CLOSURE TIMES ARE SPECIFIED PER THE INSERVICE TESTING PROGRAM FOR CALLAWAY.

APPENDIX J REQUIREMENT

- TYPE A
 B
 C
 NONE

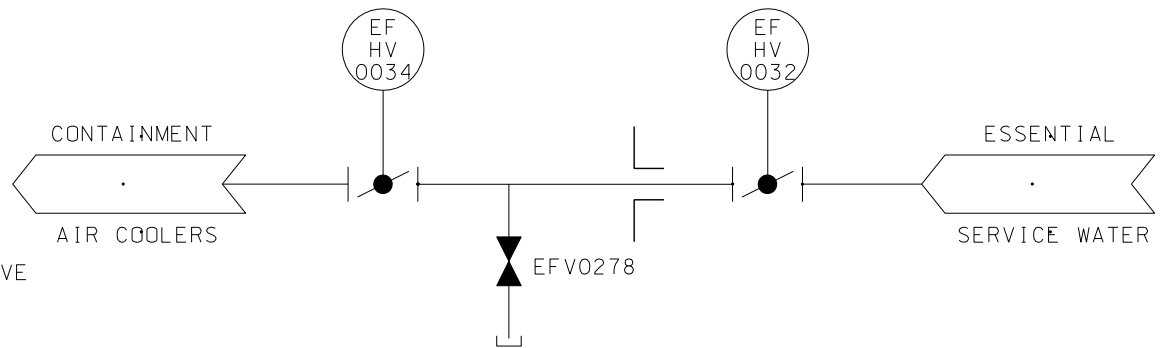

REFERENCE SECTION 9.2.1.2

CONTAINMENT PENETRATION NO. P-28 DESCRIPTION: ESW TO CONTAINMENT AIR COOLERS ESSENTIAL SERVICE WATER SYSTEM
CONTAINMENT PENETRATIONS FIGURE 6.2.4-1 PAGE 24 OF 84 REV. 12 8/16

VALVE NO.	LINE/VALVE SIZE, IN.	INSIDE/OUTSIDE CONT.	NORMAL FLOW DIRECTION	VALVE TYPE	VALVE OPERATOR	POWER SOURCE	PRIMARY ACTUATION SIGNAL	SECONDARY ACTUATION SIGNAL	MAXIMUM CLOSURE TIME (SEC.) (NOTE 1)	VALVE POSITION				
										NORMAL	SHUTDOWN	POWER FAILURE	POST ACCIDENT	
													PRIMARY	SECONDARY
EFHV0046	14/14	INSIDE	OUT	BUTTERFLY	MOTOR	4	SIS	REM/MAN	35	OPEN	OPEN	AS IS	OPEN	CLOSED
EFV0279	1/1	INSIDE	N/A	GATE	MANUAL	N/A	N/A	N/A	N/A	CLOSED	CLOSED	N/A	CLOSED	N/A
EFHV0050	14/14	OUTSIDE	OUT	BUTTERFLY	MOTOR	4	SIS	REM/MAN	30	CLOSED	CLOSED	AS IS	OPEN	CLOSED
EFHV0222	1/1	OUTSIDE	N/A	GATE	MANUAL	N/A	N/A	N/A	N/A	CLOSED	CLOSED	N/A	CLOSED	N/A
EFHV0048	10/10	OUTSIDE	OUT	BUTTERFLY	MOTOR	4	NONE	REM/MAN	30	OPEN	OPEN	AS IS	OPEN	CLOSED


ENGINEERED SAFETY FEATURE SYSTEM	YES <input checked="" type="checkbox"/> NO <input type="checkbox"/>
FLUID CONTAINED:	WATER
LENGTH OF PIPING TO OUTERMOST ISOLATION VALVE:	13.8
APPLICABLE GDC NO.	56

GENERAL COMMENTS:

THIS PENETRATION IS ASSOCIATED WITH THE ESSENTIAL SERVICE WATER SYSTEM, WHICH IS REQUIRED TO MITIGATE THE CONSEQUENCES OF A LOCA. A REMOTE-MANUAL POWER-OPERATED VALVE IS LOCATED INSIDE, AND A REMOTE-MANUAL POWER-OPERATED VALVE IS LOCATED OUTSIDE THE CONTAINMENT. THE SECOND ISOLATION VALVE OUTSIDE THE CONTAINMENT IS OPENED IN THE EVENT OF A DBA FOR SYSTEM SAFETY FUNCTIONS.

THESE VALVES ARE POWERED FROM THE SAME POWER SOURCE FOR GREATER SYSTEM RELIABILITY. A SINGLE ACTIVE OR PASSIVE FAILURE CAN BE ACCOMMODATED SINCE THE SYSTEM IS A CLOSED SYSTEM INSIDE THE CONTAINMENT, WHICH IS DESIGNED AND CONSTRUCTED IN ACCORDANCE WITH ASME SECTION III, CLASS 3 REQUIREMENTS. THE ESSENTIAL SERVICE WATER LINES ARE NOT VENTED OR DRAINED DURING A TYPE A TEST SINCE THE AIR COOLERS MAY BE REQUIRED TO COOL THE CONTAINMENT. A TYPE C TEST IS PERFORMED.

NOTE 1: MAXIMUM CLOSURE TIMES SPECIFIED IN THIS FIGURE ARE NOMINAL DESIGN OR LICENSING-BASIS VALUES. PERFORMANCE-BASED VALVE OPERABILITY LIMITS FOR VALVE CLOSURE TIMES ARE SPECIFIED PER THE INSERVICE TESTING PROGRAM FOR CALLAWAY.

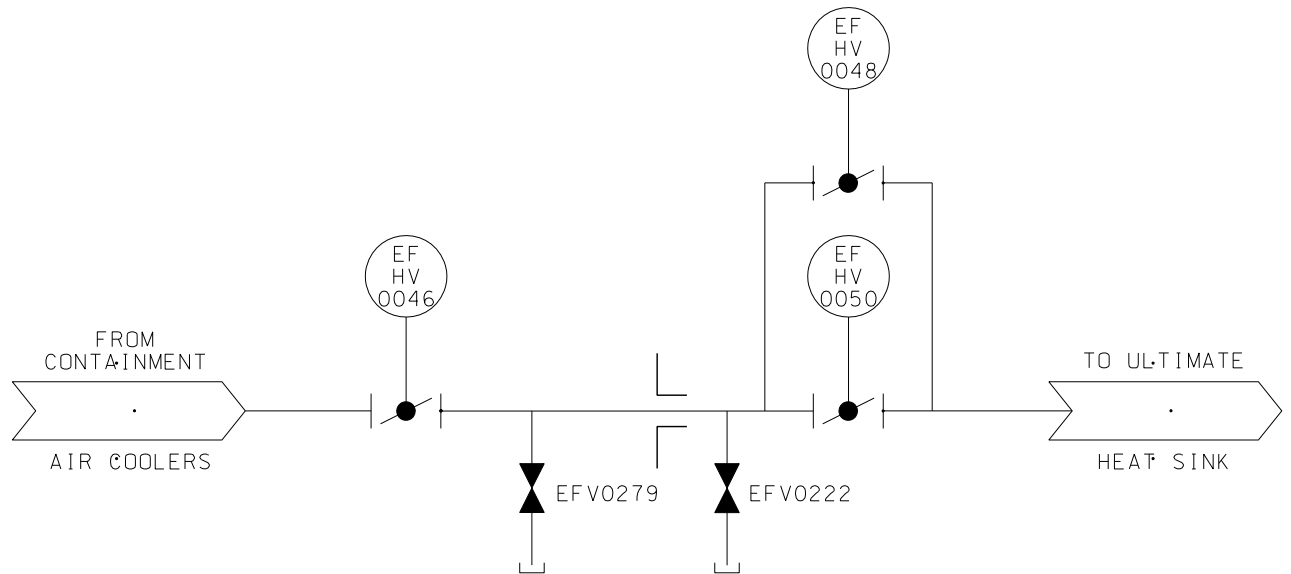

REFERENCE SECTION 9.2.1.2

CONTAINMENT PENETRATION NO. P-29
DESCRIPTION: ESW FROM CONTAINMENT AIR COOLERS ESSENTIAL SERVICE WATER SYSTEM
CONTAINMENT PENETRATIONS FIGURE 6.2.4-1 PAGE 25 OF 84 REV. 11 3/08

APPENDIX J REQUIREMENT

- TYPE A
 B
 C
 NONE


VALVE NO.	LINE / VALVE SIZE, IN.	INSIDE / OUTSIDE CONT.	NORMAL FLOW DIRECTION	VALVE TYPE	VALVE OPERATOR	POWER SOURCE	PRIMARY ACTUATION SIGNAL	SECONDARY ACTUATION SIGNAL	MAXIMUM CLOSURE TIME (SEC.) (NOTE 1)	VALVE POSITION				
										NORMAL	SHUTDOWN	POWER FAILURE	POST ACCIDENT	
													PRIMARY	SECONDARY
KAFV0029	1 1/2 / 2	OUTSIDE	IN	GLOBE	AIR	1	CIS-A	REM/MAN	5	OPEN	OPEN	CLOSED	CLOSED	OPEN
KAVO218	1 1/2 / 1 1/2	OUTSIDE	N/A	GATE	MANUAL	N/A	N/A	N/A	N/A	CLOSED	CLOSED	N/A	CLOSED	N/A
KAVO204	1 1/2 / 1 1/2	INSIDE	IN	CHECK	N/A	N/A	N/A	N/A	N/A	OPEN	OPEN	N/A	CLOSED	OPEN

ENGINEERED SAFETY FEATURE SYSTEM	YES <input type="checkbox"/> NO <input checked="" type="checkbox"/>
FLUID CONTAINED:	AIR
LENGTH OF PIPING TO OUTERMOST ISOLATION VALVE:	2.8 FT.
APPLICABLE GDC NO.	56

GENERAL COMMENTS:

NONE

NOTE 1: MAXIMUM CLOSURE TIMES SPECIFIED IN THIS FIGURE ARE NOMINAL DESIGN OR LICENSING-BASIS VALUES. PERFORMANCE-BASED VALVE OPERABILITY LIMITS FOR VALVE CLOSURE TIMES ARE SPECIFIED PER THE INSERVICE TESTING PROGRAM FOR CALLAWAY.

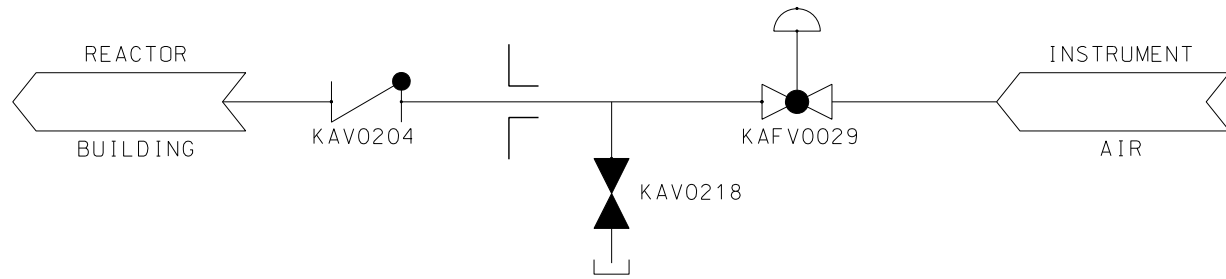

REFERENCE SECTION 9.3.1

APPENDIX J REQUIREMENT

- TYPE A
- B
- C
- NONE

CONTAINMENT PENETRATION NO. P-30 DESCRIPTION: INSTRUMENT AIR AND H ₂ CONTROL MAKEUP AIR COMPRESSED AIR SYSTEM
CONTAINMENT PENETRATIONS FIGURE 6.2.4-1 PAGE 26 OF 84 REV. 12 8/16


VALVE NO.	LINE / VALVE SIZE, IN.	INSIDE / OUTSIDE CONT.	NORMAL FLOW DIRECTION	VALVE TYPE	VALVE OPERATOR	POWER SOURCE	PRIMARY ACTUATION SIGNAL	SECONDARY ACTUATION SIGNAL	MAXIMUM CLOSURE TIME (SEC.) (NOTE 1)	VALVE POSITION				
										NORMAL	SHUTDOWN	POWER FAILURE	POST ACCIDENT	
													PRIMARY	SECONDARY
LFFV0095	6/6	INSIDE	OUT	GATE	MOTOR	1	CIS-A	NONE	30	OPEN	OPEN	AS IS	CLOSED	N/A
LFFV0096	6/6	OUTSIDE	OUT	GLOBE	AIR	4	CIS-A	NONE	4	SEE NOTES	SEE NOTES	CLOSED	CLOSED	N/A
LFV0093	1/1	OUTSIDE	N/A	GLOBE	MANUAL	N/A	N/A	N/A	N/A	CLOSED	CLOSED	N/A	CLOSED	N/A

ENGINEERED SAFETY FEATURE SYSTEM	YES <input type="checkbox"/> NO <input checked="" type="checkbox"/>
FLUID CONTAINED:	WATER
LENGTH OF PIPING TO OUTERMOST ISOLATION VALVE:	13.8 FT.
APPLICABLE GDC NO.	56

GENERAL COMMENTS:

VALVE LFFV0096 OPENS ONLY WHEN ONE OF THE CONTAINMENT SUMP PUMPS ARE OPERATING. THE CONTROL GRADE SIGNAL TO OPEN THE VALVE IS NEGATED WHEN A PROTECTION GRADE CIS-A SIGNAL IS RECEIVED.

NOTE 1: MAXIMUM CLOSURE TIMES SPECIFIED IN THIS FIGURE ARE NOMINAL DESIGN OR LICENSING-BASIS VALUES. PERFORMANCE-BASED VALVE OPERABILITY LIMITS FOR VALVE CLOSURE TIMES ARE SPECIFIED PER THE INSERVICE TESTING PROGRAM FOR CALLAWAY.

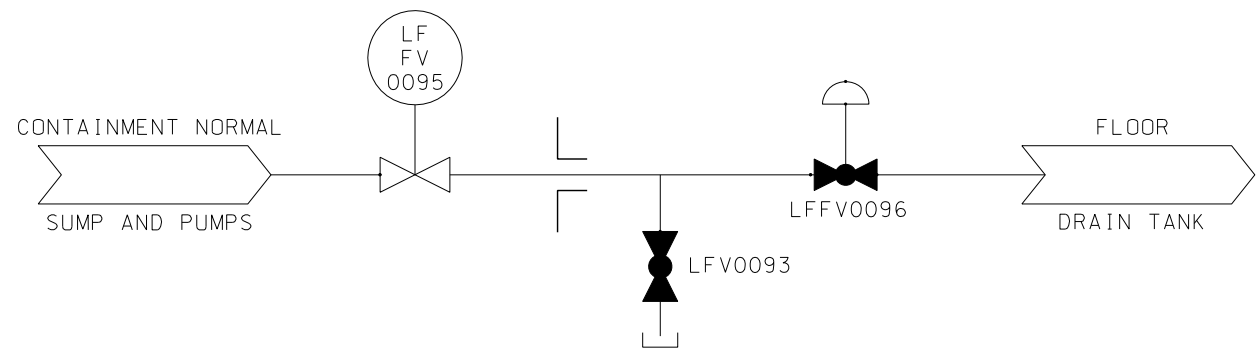

APPENDIX J REQUIREMENT

- TYPE A
- B
- C
- NONE

REFERENCE SECTION 9.3.3


CONTAINMENT PENETRATION NO. P-32 DESCRIPTION: CONTAINMENT NORMAL SUMP AND PUMPS DISCHARGE FLOOR AND EQUIPMENT DRAINAGE SYSTEM
CONTAINMENT PENETRATIONS FIGURE 6.2.4-1 PAGE 27 OF 84 REV. 11 3/08

VALVE NO.	LINE / VALVE SIZE, IN.	INSIDE / OUTSIDE CONT.	NORMAL FLOW DIRECTION	VALVE TYPE	VALVE OPERATOR	POWER SOURCE	PRIMARY ACTUATION SIGNAL	SECONDARY ACTUATION SIGNAL	MAXIMUM CLOSURE TIME (SEC.) (NOTE 1)	VALVE POSITION				
										NORMAL	SHUTDOWN	POWER FAILURE	POST ACCIDENT	
													PRIMARY	SECONDARY
GPV0010	1/1	OUTSIDE	N/A	GLOBE	MANUAL	N/A	N/A	N/A	N/A	CLOSED	CLOSED	N/A	CLOSED	N/A

ENGINEERED SAFETY FEATURE SYSTEM	YES <input checked="" type="checkbox"/> NO <input type="checkbox"/>
FLUID CONTAINED:	AIR
LENGTH OF PIPING TO OUTERMOST ISOLATION VALVE:	N/A
APPLICABLE GDC NO.	56

GENERAL COMMENTS:
 FLANGES ARE REMOVED ONLY DURING PERFORMANCE OF TYPE A TEST OR TO SUPPORT OTHER REFUELING ACTIVITIES.

NOTE 1: MAXIMUM CLOSURE TIMES SPECIFIED IN THIS FIGURE ARE NOMINAL DESIGN OR LICENSING-BASIS VALUES. PERFORMANCE-BASED VALVE OPERABILITY LIMITS FOR VALVE CLOSURE TIMES ARE SPECIFIED PER THE INSERVICE TESTING PROGRAM FOR CALLAWAY.

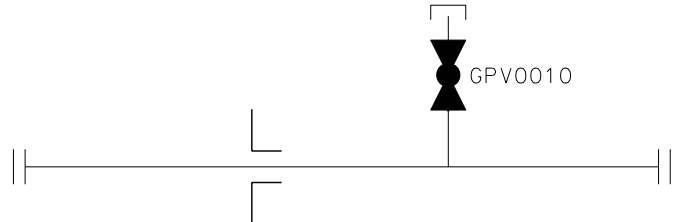

REFERENCE SECTION 6.2.6

CONTAINMENT PENETRATION NO. P-34 DESCRIPTION: CONTAINMENT PRESSURIZATION LINE CONTAINMENT ILRT SYSTEM
CONTAINMENT PENETRATIONS FIGURE 6.2.4-1 PAGE 28 OF 84 REV. 12 8/16

APPENDIX J REQUIREMENT
 TYPE A
 B
 C
 NONE

VALVE NO.	LINE / VALVE SIZE, IN.	INSIDE / OUTSIDE CONT.	NORMAL FLOW DIRECTION	VALVE TYPE	VALVE OPERATOR	POWER SOURCE	PRIMARY ACTUATION SIGNAL	SECONDARY ACTUATION SIGNAL	MAXIMUM CLOSURE TIME (SEC.)	VALVE POSITION				
										NORMAL	SHUTDOWN	POWER FAILURE	POST ACCIDENT	
													PRIMARY	SECONDARY
GPV0048	3/4 / 3/4	OUTSIDE	N/A	GLOBE	MANUAL	N/A	N/A	N/A	N/A	CLOSED	CLOSED	N/A	CLOSED	N/A

ENGINEERED SAFETY FEATURE SYSTEM	YES <input type="checkbox"/> NO <input checked="" type="checkbox"/>
FLUID CONTAINED:	AIR
LENGTH OF PIPING TO OUTERMOST ISOLATION VALVE:	N/A
APPLICABLE GDC NO.	56

GENERAL COMMENTS:

FLANGES ARE REMOVED ONLY DURING MAINTENANCE OPERATIONS IN MODE 5 OR 6 AND CORE ALTERATIONS WITH SPECIAL FLANGES AS REQUIRED WHEN AN AIRTIGHT CONDITION IS NECESSARY.

NOTE 1: MAXIMUM CLOSURE TIMES SPECIFIED IN THIS FIGURE ARE NOMINAL DESIGN OR LICENSING-BASIS VALUES. PERFORMANCE-BASED VALVE OPERABILITY LIMITS FOR VALVE CLOSURE TIMES ARE SPECIFIED PER THE INSERVICE TESTING PROGRAM FOR CALLAWAY.



APPENDIX J REQUIREMENT

- TYPE A
- B
- C
- NONE

REFERENCE SECTION 6.2.6

CONTAINMENT PENETRATION NO. P-36 DESCRIPTION: MAINTENANCE SPARE AIR AND CABLE ACCESS PENETRATIONS CONTAINMENT ILRT SYSTEM
CONTAINMENT PENETRATIONS FIGURE 6.2.4-1 PAGE 29 OF 84 REV. 11 3/08

VALVE NO.	LINE / VALVE SIZE, IN.	INSIDE / OUTSIDE CONT.	NORMAL FLOW DIRECTION	VALVE TYPE	VALVE OPERATOR	POWER SOURCE	PRIMARY ACTUATION SIGNAL	SECONDARY ACTUATION SIGNAL	MAXIMUM CLOSURE TIME (SEC.) (NOTE 1)	VALVE POSITION				
										NORMAL	SHUTDOWN	POWER FAILURE	POST ACCIDENT	
													PRIMARY	SECONDARY
BBHV8351C	2/2	OUTSIDE	IN	GLOBE	MOTOR	4	NONE	REM/MAN	10	OPEN	OPEN	AS IS	OPEN	CLOSED
BBV0356	1/1	OUTSIDE	N/A	GLOBE	MANUAL	N/A	N/A	N/A	N/A	CLOSED	CLOSED	N/A	CLOSED	N/A
BBV0247	3/4 / 3/4	OUTSIDE	N/A	GLOBE	MANUAL	N/A	N/A	N/A	N/A	CLOSED	CLOSED	N/A	CLOSED	N/A
BBV0178	2/2	INSIDE	IN	CHECK	N/A	N/A	N/A	N/A	N/A	OPEN	OPEN	N/A	OPEN	CLOSED

ENGINEERED SAFETY FEATURE SYSTEM	YES <input type="checkbox"/> NO <input checked="" type="checkbox"/>
FLUID CONTAINED:	WATER
LENGTH OF PIPING TO OUTERMOST ISOLATION VALVE:	12.2 FT.
APPLICABLE GDC NO.	55

GENERAL COMMENTS:


THIS PENETRATION PIPING HAS A HIGH PRESSURE WATER INFLOW WHICH PRECLUDES THE NEED FOR AUTOMATIC ISOLATION OF THIS PENETRATION. THE CVCS CHARGING PUMPS SUPPLY REACTOR COOLANT PUMP SEAL INJECTION WATER, AND THERE IS A POTENTIAL FOR DAMAGE TO THE REACTOR COOLANT PUMP IF UNDESIRE ISOLATION SHOULD OCCUR.

THE ISOLATION CAN BE AFFECTED BY REMOTE-MANUAL CLOSURE OF THE MOTOR-OPERATED VALVE BY THE OPERATOR WHEN REACTOR COOLANT PUMP SEAL WATER FLOW FROM THE CVCS CHARGING PUMPS IS TERMINATED AFTER THE CHARGING PUMPS COMPLETE THEIR SAFETY FUNCTION.

NOTE 1: MAXIMUM CLOSURE TIMES SPECIFIED IN THIS FIGURE ARE NOMINAL DESIGN OR LICENSING-BASIS VALUES. PERFORMANCE-BASED VALVE OPERABILITY LIMITS FOR VALVE CLOSURE TIMES ARE SPECIFIED PER THE INSERVICE TESTING PROGRAM FOR CALLAWAY.

APPENDIX J REQUIREMENT

TYPE A
 B
 C
 NONE

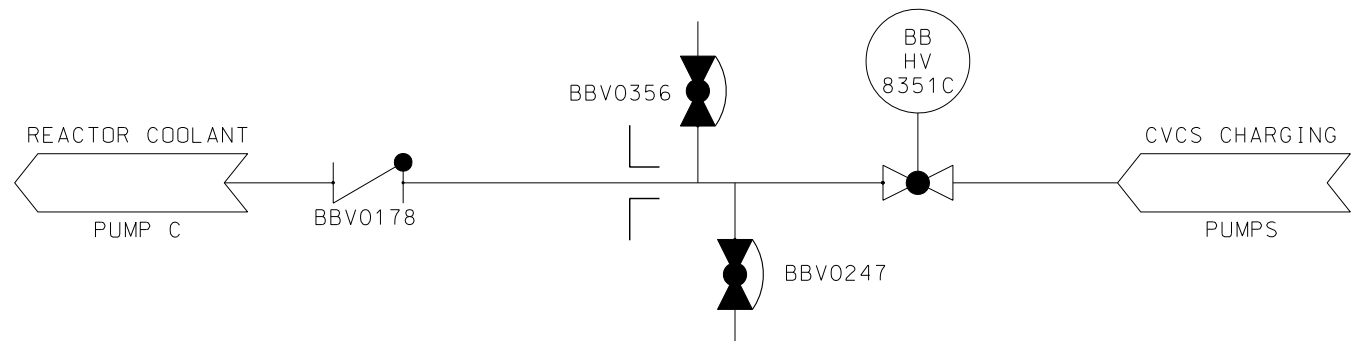

REFERENCE SECTION 5.4

CONTAINMENT PENETRATION NO. P-39
 DESCRIPTION: RCP - SEAL WATER SUPPLY
 REACTOR COOLANT SYSTEM

CONTAINMENT PENETRATIONS
 FIGURE 6.2.4-1
 PAGE 30 OF 84
 REV. 13 8/16

VALVE NO.	LINE / VALVE SIZE, IN.	INSIDE / OUTSIDE CONT.	NORMAL FLOW DIRECTION	VALVE TYPE	VALVE OPERATOR	POWER SOURCE	PRIMARY ACTUATION SIGNAL	SECONDARY ACTUATION SIGNAL	MAXIMUM CLOSURE TIME (SEC.) (NOTE 1)	VALVE POSITION				
										NORMAL	SHUTDOWN	POWER FAILURE	POST ACCIDENT	
													PRIMARY	SECONDARY
BBHV8351D	2/2	OUTSIDE	IN	GLOBE	MOTOR	4	NONE	REM/MAN	10	OPEN	OPEN	AS IS	OPEN	CLOSED
BBV0358	1/1	OUTSIDE	N/A	GLOBE	MANUAL	N/A	N/A	N/A	N/A	CLOSED	CLOSED	N/A	CLOSED	N/A
BBV0248	3/4 / 3/4	OUTSIDE	N/A	GLOBE	MANUAL	N/A	N/A	N/A	N/A	CLOSED	CLOSED	N/A	CLOSED	N/A
BBV0208	2/2	INSIDE	IN	CHECK	N/A	N/A	N/A	N/A	N/A	OPEN	OPEN	N/A	OPEN	CLOSED


ENGINEERED SAFETY FEATURE SYSTEM	YES <input type="checkbox"/> NO <input checked="" type="checkbox"/>
FLUID CONTAINED:	WATER
LENGTH OF PIPING TO OUTERMOST ISOLATION VALVE:	17.1 FT.
APPLICABLE GDC NO.	55

GENERAL COMMENTS:

THIS PENETRATION PIPING HAS A HIGH PRESSURE WATER INFLOW WHICH PRECLUDES THE NEED FOR AUTOMATIC ISOLATION OF THIS PENETRATION. THE CVCS CHARGING PUMPS SUPPLY REACTOR COOLANT PUMP SEAL INJECTION WATER, AND THERE IS A POTENTIAL FOR DAMAGE TO THE REACTOR COOLANT PUMP IF UNDESIRE ISOLATION SHOULD OCCUR.

THE ISOLATION CAN BE AFFECTED BY REMOTE-MANUAL CLOSURE OF THE MOTOR-OPERATED VALVE BY THE OPERATOR WHEN REACTOR COOLANT PUMP SEAL WATER FLOW FROM THE CVCS CHARGING PUMPS IS TERMINATED AFTER THE CHARGING PUMPS COMPLETE THEIR SAFTY FUNCTION.

NOTE 1: MAXIMUM CLOSURE TIMES SPECIFIED IN THIS FIGURE ARE NOMINAL DESIGN OR LICENSING-BASIS VALUES. PERFORMANCE-BASED VALVE OPERABILITY LIMITS FOR VALVE CLOSURE TIMES ARE SPECIFIED PER THE INSERVICE TESTING PROGRAM FOR CALLAWAY.

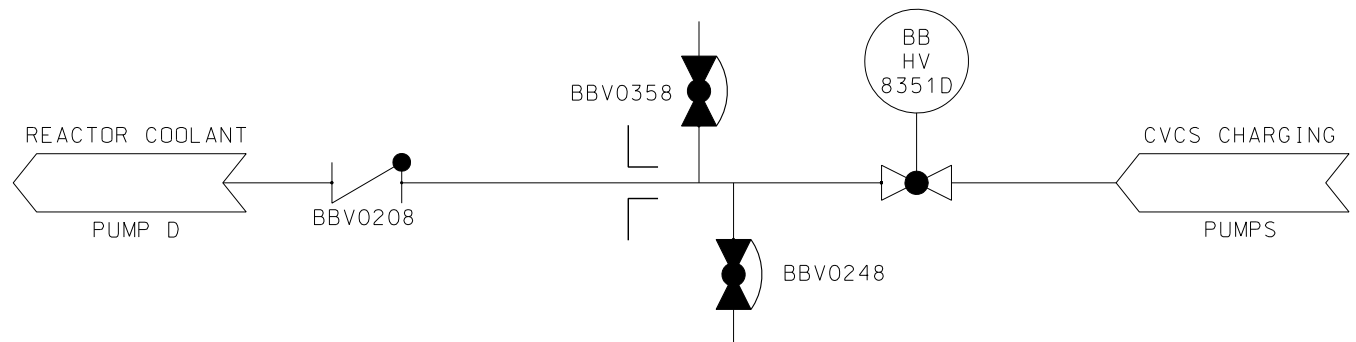

REFERENCE SECTION 5.4

CONTAINMENT PENETRATION NO. P-40
DESCRIPTION: RCP - SEAL WATER SUPPLY REACTOR COOLANT SYSTEM

CONTAINMENT PENETRATIONS
FIGURE 6.2.4-1
PAGE 31 OF 84
REV. 13 8/16

APPENDIX J REQUIREMENT

TYPE A
B
C
NONE

VALVE NO.	LINE / VALVE SIZE, IN.	INSIDE / OUTSIDE CONT.	NORMAL FLOW DIRECTION	VALVE TYPE	VALVE OPERATOR	POWER SOURCE	PRIMARY ACTUATION SIGNAL	SECONDARY ACTUATION SIGNAL	MAXIMUM CLOSURE TIME (SEC.) (NOTE 1)	VALVE POSITION				
										NORMAL	SHUTDOWN	POWER FAILURE	POST ACCIDENT	
													PRIMARY	SECONDARY
BBHV8351A	2/2	OUTSIDE	IN	GLOBE	MOTOR	4	NONE	REM/MAN	10	OPEN	OPEN	AS IS	OPEN	CLOSED
BBV0352	1/1	OUTSIDE	N/A	GLOBE	MANUAL	N/A	N/A	N/A	N/A	CLOSED	CLOSED	N/A	CLOSED	N/A
BBV0245	3/4 / 3/4	OUTSIDE	N/A	GLOBE	MANUAL	N/A	N/A	N/A	N/A	CLOSED	CLOSED	N/A	CLOSED	N/A
BBV0118	2/2	INSIDE	IN	CHECK	N/A	N/A	N/A	N/A	N/A	OPEN	OPEN	N/A	OPEN	CLOSED

ENGINEERED SAFETY FEATURE SYSTEM	YES <input type="checkbox"/> NO <input checked="" type="checkbox"/>
FLUID CONTAINED:	WATER
LENGTH OF PIPING TO OUTERMOST ISOLATION VALVE:	12.2 FT.
APPLICABLE GDC NO.	55

GENERAL COMMENTS:


THIS PENETRATION PIPING HAS A HIGH PRESSURE WATER INFLOW WHICH PRECLUDES THE NEED FOR AUTOMATIC ISOLATION OF THIS PENETRATION. THE CVCS CHARGING PUMPS SUPPLY REACTOR COOLANT PUMP SEAL INJECTION WATER, AND THERE IS A POTENTIAL FOR DAMAGE TO THE REACTOR COOLANT PUMP IF UNDESIRE ISOLATION SHOULD OCCUR.

THE ISOLATION CAN BE AFFECTED BY REMOTE-MANUAL CLOSURE OF THE MOTOR-OPERATED VALVE BY THE OPERATOR WHEN REACTOR COOLANT PUMP SEAL WATERFLOW FROM THE CVCS CHARGING PUMPS IS TERMINATED AFTER THE CHARGING PUMPS COMPLETE THEIR SAFETY FUNCTION.

NOTE 1: MAXIMUM CLOSURE TIMES SPECIFIED IN THIS FIGURE ARE NOMINAL DESIGN OR LICENSING-BASIS VALUES. PERFORMANCE-BASED VALVE OPERABILITY LIMITS FOR VALVE CLOSURE TIMES ARE SPECIFIED PER THE INSERVICE TESTING PROGRAM FOR CALLAWAY.

APPENDIX J REQUIREMENT

TYPE A
 B
 C
 NONE

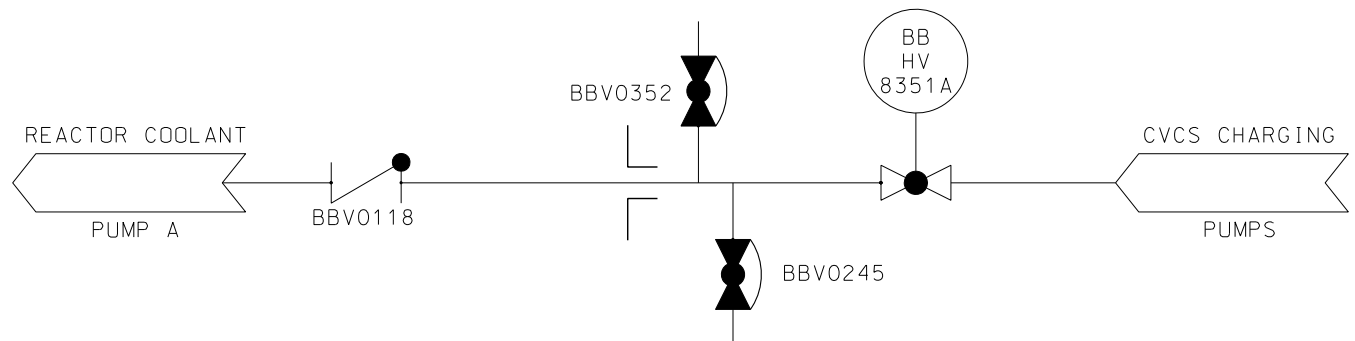

REFERENCE SECTION 5.4

CONTAINMENT PENETRATION NO. P-41 DESCRIPTION: RCP - SEAL WATER SUPPLY REACTOR COOLANT SYSTEM
CONTAINMENT PENETRATIONS FIGURE 6.2.4-1 PAGE 32 OF 84 REV. 12 9/14


VALVE NO.	LINE / VALVE SIZE, IN.	INSIDE / OUTSIDE CONT.	NORMAL FLOW DIRECTION	VALVE TYPE	VALVE OPERATOR	POWER SOURCE	PRIMARY ACTUATION SIGNAL	SECONDARY ACTUATION SIGNAL	MAXIMUM CLOSURE TIME (SEC.) (NOTE 1)	VALVE POSITION				
										NORMAL	SHUTDOWN	POWER FAILURE	POST ACCIDENT	
													PRIMARY	SECONDARY
HDV0016	2/2	OUTSIDE	IN	GLOBE	MANUAL	N/A	N/A	N/A	N/A	CLOSED	CLOSED	N/A	CLOSED	N/A
HDV0023	1/1	OUTSIDE	N/A	GLOBE	MANUAL	N/A	N/A	N/A	N/A	CLOSED	CLOSED	N/A	CLOSED	N/A
HDV0017	2/2	INSIDE	IN	GLOBE	MANUAL	N/A	N/A	N/A	N/A	CLOSED	CLOSED	N/A	CLOSED	N/A

ENGINEERED SAFETY FEATURE SYSTEM	YES <input type="checkbox"/> NO <input checked="" type="checkbox"/>
FLUID CONTAINED:	STEAM
LENGTH OF PIPING TO OUTERMOST ISOLATION VALVE:	10.9 FT.
APPLICABLE GDC NO.	56

GENERAL COMMENTS:

NONE

NOTE 1: MAXIMUM CLOSURE TIMES SPECIFIED IN THIS FIGURE ARE NOMINAL DESIGN OR LICENSING-BASIS VALUES. PERFORMANCE-BASED VALVE OPERABILITY LIMITS FOR VALVE CLOSURE TIME ARE SPECIFIED PER THE INSERVICE TESTING PROGRAM FOR CALLAWAY.

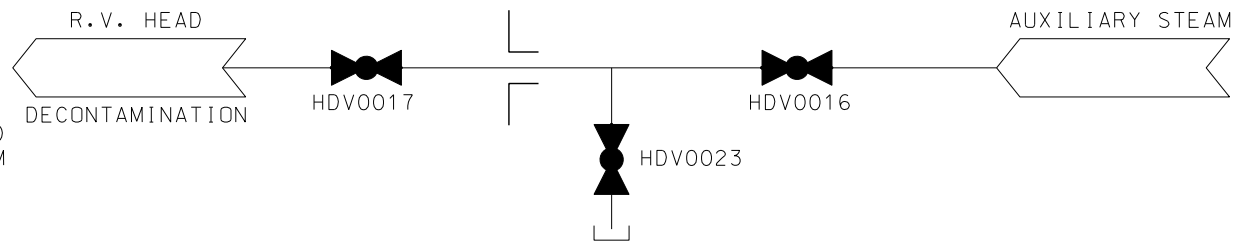

REFERENCE SECTION 12.3

CONTAINMENT PENETRATION NO. P-43
 DESCRIPTION: DECONTAMINATION STEAM DECONTAMINATION SYSTEM

CONTAINMENT PENETRATIONS
 FIGURE 6.2.4-1
 PAGE 33 OF 84
 REV. 11 3/08

APPENDIX J REQUIREMENT


- TYPE A
- B
- C
- NONE

VALVE NO.	LINE / VALVE SIZE, IN.	INSIDE / OUTSIDE CONT.	NORMAL FLOW DIRECTION	VALVE TYPE	VALVE OPERATOR	POWER SOURCE	PRIMARY ACTUATION SIGNAL	SECONDARY ACTUATION SIGNAL	MAXIMUM CLOSURE TIME (SEC.) (NOTE 1)	VALVE POSITION				
										NORMAL	SHUTDOWN	POWER FAILURE	POST ACCIDENT	
													PRIMARY	SECONDARY
HBHV7126	3/4 / 3/4	INSIDE	OUT	DIAPHRAGM	AIR	1	CIS-A	NONE	10	OPEN	OPEN	CLOSED	CLOSED	N/A
HBHV7150	3/4 / 3/4	OUTSIDE	OUT	DIAPHRAGM	AIR	4	CIS-A	NONE	10	OPEN	OPEN	CLOSED	CLOSED	N/A
HBV0420	3/4 / 3/4	OUTSIDE	N/A	GLOBE	MANUAL	N/A	N/A	N/A	N/A	CLOSED	CLOSED	N/A	CLOSED	N/A

ENGINEERED SAFETY FEATURE SYSTEM	YES <input type="checkbox"/> NO <input checked="" type="checkbox"/>
FLUID CONTAINED:	GAS
LENGTH OF PIPING TO OUTERMOST ISOLATION VALVE:	8.1 FT.
APPLICABLE GDC NO.	56

GENERAL COMMENTS:

NONE
 NOTE 1: MAXIMUM CLOSURE TIMES SPECIFIED IN THIS FIGURE ARE NOMINAL DESIGN OR LICENSING-BASIS VALUES. PERFORMANCE-BASED VALVE OPERABILITY LIMITS FOR VALVE CLOSURE TIMES ARE SPECIFIED PER THE INSERVICE TESTING PROGRAM FOR CALLAWAY.

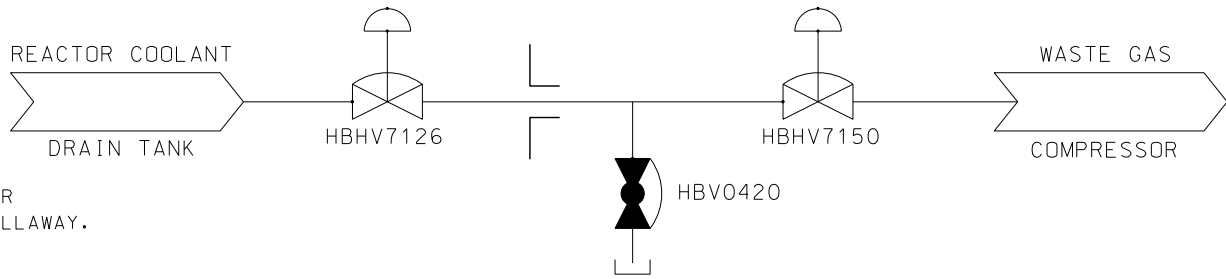

REFERENCE SECTION 11.2

CONTAINMENT PENETRATION NO. P-44
 DESCRIPTION: REACTOR COOLANT DRAIN TANK VENT LINE LIQUID RADWASTE SYSTEM

CONTAINMENT PENETRATIONS
 FIGURE 6.2.4-1
 PAGE 34 OF 84
 REV. 12 8/16

APPENDIX J REQUIREMENT

- TYPE A
- B
- C
- NONE

VALVE NO.	LINE / VALVE SIZE, IN.	INSIDE / OUTSIDE CONT.	NORMAL FLOW DIRECTION	VALVE TYPE	VALVE OPERATOR	POWER SOURCE	PRIMARY ACTUATION SIGNAL	SECONDARY ACTUATION SIGNAL	MAXIMUM CLOSURE TIME (SEC.) (NOTE 1)	VALVE POSITION				
										NORMAL	SHUTDOWN	POWER FAILURE	POST ACCIDENT	
													PRIMARY	SECONDARY
EPV0046	1/1	INSIDE	IN	CHECK	N/A	N/A	N/A	N/A	N/A	CLOSED	CLOSED	N/A	CLOSED	N/A
EPV0043	3/4 / 3/4	OUTSIDE	N/A	GLOBE	MANUAL	N/A	N/A	N/A	N/A	CLOSED	CLOSED	N/A	CLOSED	N/A
EPHV8880	1/1	OUTSIDE	IN	GLOBE	AIR	4	CIS-A	NONE	10	CLOSED	CLOSED	CLOSED	CLOSED	N/A

ENGINEERED SAFETY FEATURE SYSTEM YES NO

FLUID CONTAINED: GAS


LENGTH OF PIPING TO OUTERMOST ISOLATION VALVE: 13.0 FT.

APPLICABLE GDC NO. 56

GENERAL COMMENTS:

NONE

NOTE 1: MAXIMUM CLOSURE TIMES SPECIFIED IN THIS FIGURE ARE NOMINAL DESIGN OR LICENSING-BASIS VALUES. PERFORMANCE-BASED VALVE OPERABILITY LIMITS FOR VALVE CLOSURE TIMES ARE SPECIFIED PER THE INSERVICE TESTING PROGRAM FOR CALLAWAY.

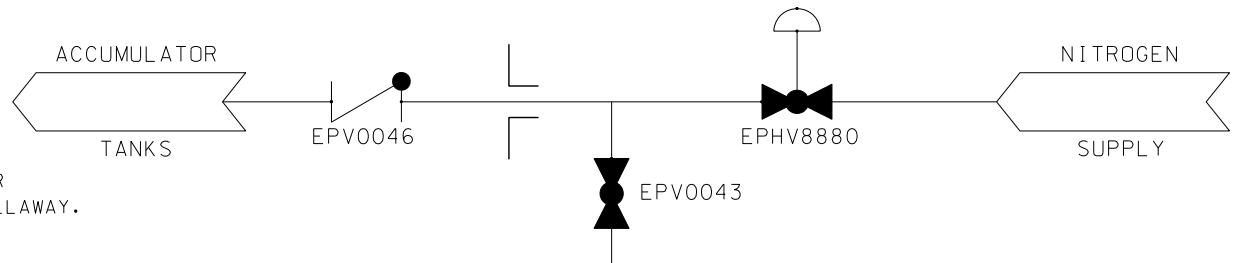

REFERENCE SECTION 6.3

CONTAINMENT PENETRATION NO. P-45 DESCRIPTION: NITROGEN SUPPLY LINE ACCUMULATOR SAFETY INJECTION SYSTEM
CONTAINMENT PENETRATIONS FIGURE 6.2.4-1 PAGE 35 OF 84 REV. 11 3/08

APPENDIX J REQUIREMENT

- TYPE A
- B
- C
- NONE

VALVE NO.	LINE/VALVE SIZE, IN.	INSIDE/OUTSIDE CONT.	NORMAL FLOW DIRECTION	VALVE TYPE	VALVE OPERATOR	POWER SOURCE	PRIMARY ACTUATION SIGNAL	SECONDARY ACTUATION SIGNAL	MAXIMUM CLOSURE TIME (SEC.) (NOTE 1)	VALVE POSITION				
										NORMAL	SHUTDOWN	POWER FAILURE	POST ACCIDENT	
													PRIMARY	SECONDARY
EMHV8802B	4/4	OUTSIDE	IN	GATE	MOTOR	4	NONE	REM/MAN	10	CLOSED	CLOSED	AS IS	CLOSED	OPEN
EMHV8824	3/4 / 3/4	INSIDE	OUT	GLOBE	AIR	1	CIS-A	NONE	NOTE 1	CLOSED	CLOSED	CLOSED	CLOSED	N/A
EMV0003	2/2	INSIDE	IN	CHECK	N/A	N/A	N/A	N/A	N/A	CLOSED	CLOSED	N/A	CLOSED	OPEN
EMV0004	2/2	INSIDE	IN	CHECK	N/A	N/A	N/A	N/A	N/A	CLOSED	CLOSED	N/A	CLOSED	OPEN
EMV0060	3/4 / 3/4	INSIDE	N/A	GLOBE	MANUAL	N/A	N/A	N/A	N/A	CLOSED	CLOSED	N/A	CLOSED	N/A
EMV0061	3/4 / 3/4	INSIDE	N/A	GLOBE	MANUAL	N/A	N/A	N/A	N/A	CLOSED	CLOSED	N/A	CLOSED	N/A
EMV0063	3/4 / 3/4	INSIDE	N/A	GLOBE	MANUAL	N/A	N/A	N/A	N/A	CLOSED	CLOSED	N/A	CLOSED	N/A
EMV0064	3/4 / 3/4	INSIDE	N/A	GLOBE	MANUAL	N/A	N/A	N/A	N/A	CLOSED	CLOSED	N/A	CLOSED	N/A
EMV0217	3/4 / 3/4	INSIDE	N/A	GLOBE	MANUAL	N/A	N/A	N/A	N/A	CLOSED	CLOSED	N/A	CLOSED	N/A
EMV0169	3/4 / 3/4	INSIDE	N/A	GLOBE	MANUAL	N/A	N/A	N/A	N/A	CLOSED	CLOSED	N/A	CLOSED	N/A
EMV0170	1/1	INSIDE	N/A	GLOBE	MANUAL	N/A	N/A	N/A	N/A	CLOSED	CLOSED	N/A	CLOSED	N/A
EMV0172	1/1	INSIDE	N/A	GLOBE	MANUAL	N/A	N/A	N/A	N/A	CLOSED	CLOSED	N/A	CLOSED	N/A
EMV0059	1/1	OUTSIDE	N/A	GLOBE	MANUAL	N/A	N/A	N/A	N/A	CLOSED	CLOSED	N/A	CLOSED	N/A

ENGINEERED SAFETY FEATURE SYSTEM	YES <input checked="" type="checkbox"/> NO <input type="checkbox"/>
FLUID CONTAINED:	WATER
LENGTH OF PIPING TO OUTERMOST ISOLATION VALVE:	13.7 FT
APPLICABLE GDC NO.	55

NOTES:
1. REFER TO T/S TABLE 16.6-1.

GENERAL COMMENTS:


THIS PENETRATION IS ASSOCIATED WITH THE HIGH PRESSURE COOLANT INJECTION SYSTEM, WHICH IS REQUIRED TO MITIGATE THE CONSEQUENCES OF A LOCA. A CHECK VALVE IS PROVIDED FOR EACH BRANCH LINE INSIDE THE CONTAINMENT, AND A REMOTE-MANUAL ISOLATION VALVE IS PROVIDED OUTSIDE THE CONTAINMENT. A SINGLE ACTIVE OR PASSIVE FAILURE CAN BE ACCOMMODATED SINCE THE SYSTEM IS CLOSED OUTSIDE THE CONTAINMENT AND IS DESIGNED AND CONSTRUCTED CONCURRENTLY WITH THE DESIGN AND CONSTRUCTION OF THE CONTAINMENT. LEAKAGE DETECTION FROM THIS LINE OUTSIDE THE CONTAINMENT IS PROVIDED, AS DESCRIBED IN SECTION 9.3.3.

LOCAL TESTING OF THE VALVES OR THE CLOSED SYSTEM OUTSIDE THE CONTAINMENT IS NOT REQUIRED SINCE THE SYSTEM IS OPERATED AND INSPECTED DURING NORMAL PLANT OPERATION TO ASSURE THAT THE INTEGRITY IS BEING MAINTAINED.

NOTE 1: MAXIMUM CLOSURE TIMES SPECIFIED IN THIS FIGURE ARE NOMINAL DESIGN OR LICENSING-BASIS VALUES. PERFORMANCE-BASED VALVE OPERABILITY LIMITS FOR VALVE CLOSURE TIMES ARE SPECIFIED PER THE INSERVICE TESTING PROGRAM FOR CALLAWAY.

APPENDIX J REQUIREMENT

TYPE A
 B
 C
 NONE

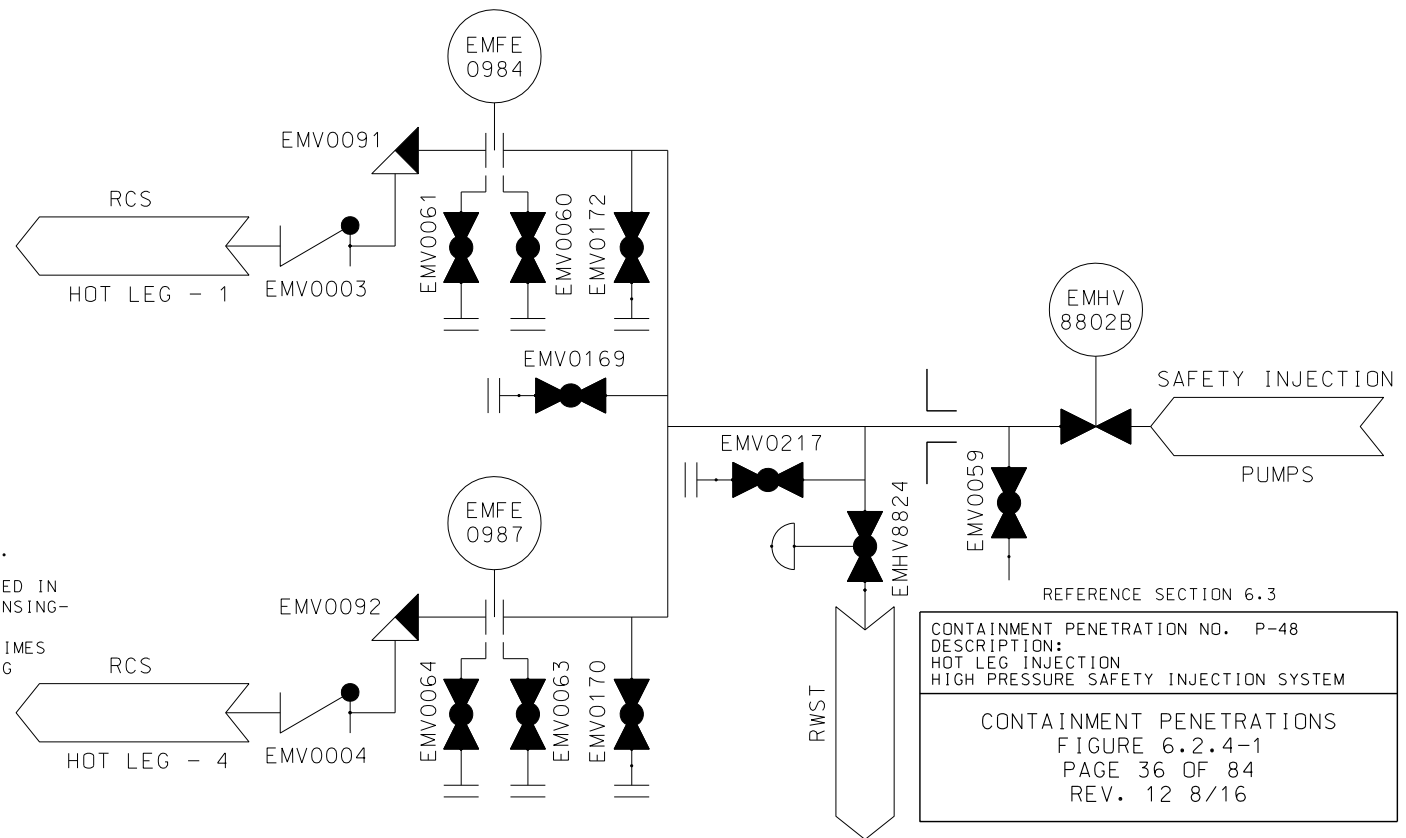

CONTAINMENT PENETRATION NO. P-48
 DESCRIPTION:
 HOT LEG INJECTION
 HIGH PRESSURE SAFETY INJECTION SYSTEM

CONTAINMENT PENETRATIONS
 FIGURE 6.2.4-1
 PAGE 36 OF 84
 REV. 12 8/16

VALVE NO.	LINE/VALVE SIZE, IN.	INSIDE/OUTSIDE CONT.	NORMAL FLOW DIRECTION	VALVE TYPE	VALVE OPERATOR	POWER SOURCE	PRIMARY ACTUATION SIGNAL	SECONDARY ACTUATION SIGNAL	MAXIMUM CLOSURE TIME (SEC.)	VALVE POSITION				
										NORMAL	SHUTDOWN	POWER FAILURE	POST ACCIDENT	
													PRIMARY	SECONDARY
EMHV8835	4/4	OUTSIDE	IN	GATE	MOTOR	4	NONE	REM/MAN	10	OPEN	OPEN	AS IS	OPEN	CLOSED
EMHV8823	3/4 / 3/4	INSIDE	OUT	GLOBE	AIR	1	CIS-A	NONE	10	CLOSED	CLOSED	CLOSED	CLOSED	N/A
EPV0020	2/2	INSIDE	IN	CHECK	N/A	N/A	N/A	N/A	N/A	CLOSED	CLOSED	N/A	OPEN	CLOSED
EPV0010	2/2	INSIDE	IN	CHECK	N/A	N/A	N/A	N/A	N/A	CLOSED	CLOSED	N/A	OPEN	CLOSED
EPV0040	2/2	INSIDE	IN	CHECK	N/A	N/A	N/A	N/A	N/A	CLOSED	CLOSED	N/A	OPEN	CLOSED
EPV0030	2/2	INSIDE	IN	CHECK	N/A	N/A	N/A	N/A	N/A	CLOSED	CLOSED	N/A	OPEN	CLOSED
EMV0067	1/1	OUTSIDE	N/A	GLOBE	MANUAL	N/A	N/A	N/A	N/A	CLOSED	CLOSED	N/A	CLOSED	N/A
EMV0068	3/4 / 3/4	INSIDE	N/A	GLOBE	MANUAL	N/A	N/A	N/A	N/A	CLOSED	CLOSED	N/A	CLOSED	N/A
THRU 075														
EMV0218	3/4 / 3/4	INSIDE	N/A	GLOBE	MANUAL	N/A	N/A	N/A	N/A	CLOSED	CLOSED	N/A	CLOSED	N/A
EMV0162, 164, 168	3/4 / 3/4	INSIDE	N/A	GLOBE	MANUAL	N/A	N/A	N/A	N/A	CLOSED	CLOSED	N/A	CLOSED	N/A
EMV0163, 165, 166, 167	1/1	INSIDE	N/A	GLOBE	MANUAL	N/A	N/A	N/A	N/A	CLOSED	CLOSED	N/A	CLOSED	N/A

ENGINEERED SAFETY FEATURE SYSTEM	YES <input checked="" type="checkbox"/> NO <input type="checkbox"/>
FLUID CONTAINED:	WATER
LENGTH OF PIPING TO OUTERMOST ISOLATION VALVE:	12.1 FT
APPLICABLE GDC NO.	55

GENERAL COMMENTS:


THIS PENETRATION IS ASSOCIATED WITH THE HIGH PRESSURE COOLANT INJECTION SYSTEM, WHICH IS REQUIRED TO MITIGATE THE CONSEQUENCES OF A LOCA. A CHECK VALVE IS PROVIDED FOR EACH BRANCH LINE INSIDE THE CONTAINMENT, AND A REMOTE-MANUAL ISOLATION VALVE IS PROVIDED OUTSIDE THE CONTAINMENT. A SINGLE ACTIVE OR PASSIVE FAILURE CAN BE ACCOMMODATED SINCE THE SYSTEM IS CLOSED OUTSIDE THE CONTAINMENT AND IS DESIGNED AND CONSTRUCTED COMMENSURATE WITH THE DESIGN AND CONSTRUCTION OF THE CONTAINMENT. LEAKAGE DETECTION FROM THIS LINE OUTSIDE THE CONTAINMENT IS PROVIDED, AS DESCRIBED IN SECTION 9.3.3.

LOCAL TESTING OF THE VALVES OR THE CLOSED SYSTEM OUTSIDE THE CONTAINMENT IS NOT REQUIRED SINCE THE SYSTEM IS OPERATED AND INSPECTED DURING NORMAL PLANT OPERATION TO ASSURE THAT THE INTEGRITY IS BEING MAINTAINED.

NOTE 1: MAXIMUM CLOSURE TIMES SPECIFIED IN THIS FIGURE ARE NOMINAL DESIGN OR LICENSING-BASIS VALUES. PERFORMANCE-BASED VALVE OPERABILITY LIMITS FOR VALVE CLOSURE TIMES ARE SPECIFIED PER THE INSERVICE TESTING PROGRAM FOR CALLAWAY.

APPENDIX J REQUIREMENT

- TYPE A
 B
 C
 NONE

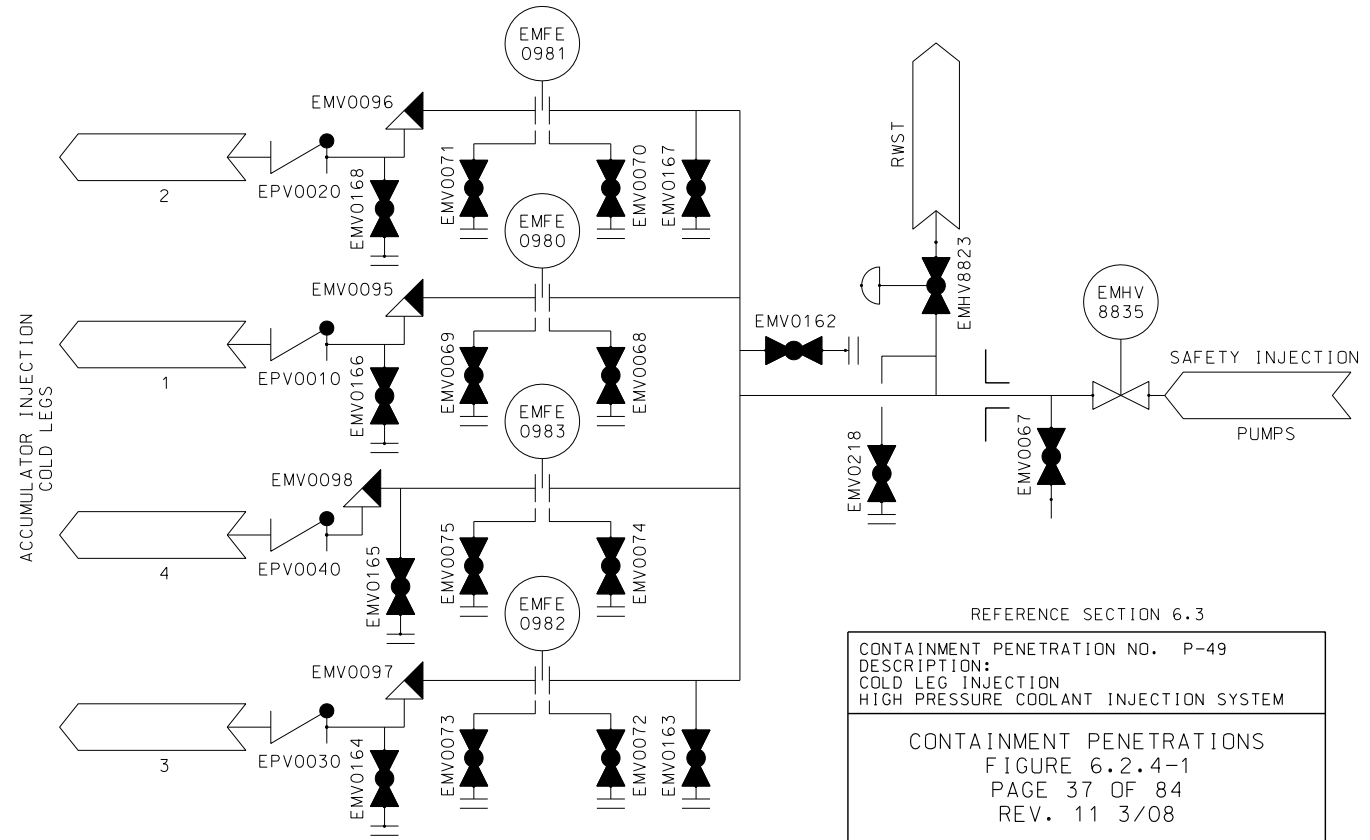

REFERENCE SECTION 6.3

CONTAINMENT PENETRATION NO. P-49
 DESCRIPTION:
 COLD LEG INJECTION
 HIGH PRESSURE COOLANT INJECTION SYSTEM

CONTAINMENT PENETRATIONS
 FIGURE 6.2.4-1
 PAGE 37 OF 84
 REV. 11/3/08

VALVE NO.	LINE / VALVE SIZE, IN.	INSIDE / OUTSIDE CONT.	NORMAL FLOW DIRECTION	VALVE TYPE	VALVE OPERATOR	POWER SOURCE	PRIMARY ACTUATION SIGNAL	SECONDARY ACTUATION SIGNAL	MAXIMUM CLOSURE TIME (SEC.) (NOTE 1)	VALVE POSITION				
										NORMAL	SHUTDOWN	POWER FAILURE	POST ACCIDENT	
													PRIMARY	SECONDARY
GPV0049	3/4 / 3/4	OUTSIDE	N/A	GLOBE	MANUAL	N/A	N/A	N/A	N/A	CLOSED	CLOSED	N/A	CLOSED	N/A

ENGINEERED SAFETY FEATURE SYSTEM	YES <input checked="" type="checkbox"/> NO <input type="checkbox"/>
FLUID CONTAINED:	AIR
LENGTH OF PIPING TO OUTERMOST ISOLATION VALVE:	N/A
APPLICABLE GDC NO.	56

GENERAL COMMENTS:

FLANGES ARE REMOVED ONLY DURING MAINTENANCE OPERATIONS IN MODE 5 OR 6 AND CORE ALTERATIONS WITH SPECIAL FLANGES AS REQUIRED WHEN AN AIRTIGHT CONDITION IS NECESSARY.

NOTE 1: MAXIMUM CLOSURE TIMES SPECIFIED IN THIS FIGURE ARE NOMINAL DESIGN OR LICENSING-BASIS VALUES. PERFORMANCE-BASED VALVE OPERABILITY LIMITS FOR VALVE CLOSURE TIMES ARE SPECIFIED PER THE INSERVICE TESTING PROGRAM FOR CALLAWAY.



APPENDIX J REQUIREMENT
 TYPE A
 B
 C
 NONE

NOTE 1: MAXIMUM CLOSURE TIMES SPECIFIED IN THIS FIGURE ARE NOMINAL DESIGN OR LICENSING-BASIS VALUES. PERFORMANCE-BASED VALVE OPERABILITY LIMITS FOR VALVE CLOSURE TIMES ARE SPECIFIED PER THE INSERVICE TESTING PROGRAM FOR CALLAWAY.

REFERENCE SECTION 6.2.6


CONTAINMENT PENETRATION NO. P-50 DESCRIPTION: MAINTENANCE SPARE AIR AND CABLE ACCESS PENETRATIONS CONTAINMENT ILRT SYSTEM
CONTAINMENT PENETRATIONS FIGURE 6.2.4-1 PAGE 38 OF 84 REV. 12 8/16

VALVE NO.	LINE / VALVE SIZE, IN.	INSIDE / OUTSIDE CONT.	NORMAL FLOW DIRECTION	VALVE TYPE	VALVE OPERATOR	POWER SOURCE	PRIMARY ACTUATION SIGNAL	SECONDARY ACTUATION SIGNAL	MAXIMUM CLOSURE TIME (SEC.) (NOTE 1)	VALVE POSITION				
										NORMAL	SHUTDOWN	POWER FAILURE	POST ACCIDENT	
													PRIMARY	SECONDARY
GPV0011	1/1	OUTSIDE	N/A	GLOBE	MANUAL	N/A	N/A	N/A	N/A	CLOSED	CLOSED	N/A	CLOSED	N/A
GPV0012	1/1	OUTSIDE	N/A	GLOBE	MANUAL	N/A	N/A	N/A	N/A	CLOSED	CLOSED	N/A	CLOSED	N/A

ENGINEERED SAFETY FEATURE SYSTEM	YES <input checked="" type="checkbox"/> NO <input type="checkbox"/>
FLUID CONTAINED:	AIR
LENGTH OF PIPING TO OUTERMOST ISOLATION VALVE:	N/A
APPLICABLE GDC NO.	56

GENERAL COMMENTS:
 FLANGES ARE REMOVED ONLY DURING PERFORMANCE OF TYPE A TEST OR TO SUPPORT OTHER REFUELING ACTIVITIES IN MODES 5 AND 6.

NOTE 1: MAXIMUM CLOSURE TIMES SPECIFIED IN THIS FIGURE ARE NOMINAL DESIGN OR LICENSING-BASIS VALUES. PERFORMANCE-BASED VALVE OPERABILITY LIMITS FOR VALVE CLOSURE TIMES ARE SPECIFIED PER THE INSERVICE TESTING PROGRAM FOR CALLAWAY.

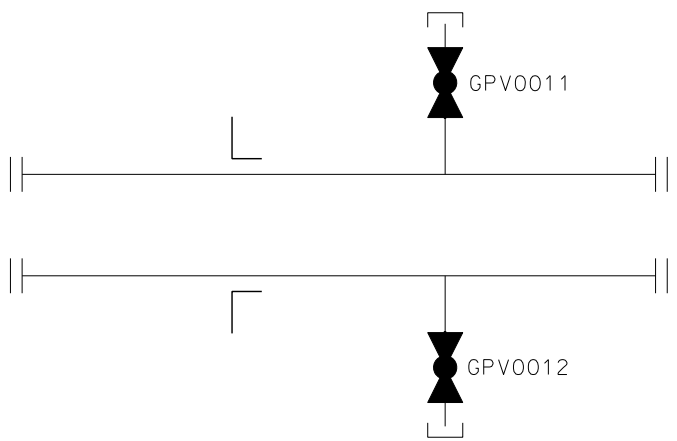

REFERENCE SECTION 6.2.6

CONTAINMENT PENETRATION NO. P-51 DESCRIPTION: PRESSURE SENSING LINES CONTAINMENT ILRT SYSTEM
CONTAINMENT PENETRATIONS FIGURE 6.2.4-1 PAGE 39 OF 84 REV. 11 3/08

APPENDIX J REQUIREMENT

TYPE A
 B
 C
 NONE

VALVE NO.	LINE/ VALVE SIZE, IN.	INSIDE/ OUTSIDE CONT.	NORMAL FLOW DIRECTION	VALVE TYPE	VALVE OPERATOR	POWER SOURCE	PRIMARY ACTUATION SIGNAL	SECONDARY ACTUATION SIGNAL	MAXIMUM CLOSURE TIME (SEC.)	VALVE POSITION				
										NORMAL	SHUTDOWN	POWER FAILURE	POST ACCIDENT	
													PRIMARY	SECONDARY
EJHV8701B	12/12	INSIDE	OUT	GATE	MOTOR	1	REM/MAN	NONE	120	CLOSED	OPEN	AS IS	CLOSED	N/A
EJ8708B	3/3	INSIDE	N/A	RELIEF	N/A	N/A	N/A	N/A	N/A	CLOSED	CLOSED	N/A	CLOSED	N/A


ENGINEERED SAFETY FEATURE SYSTEM	YES <input checked="" type="checkbox"/> NO <input type="checkbox"/>
FLUID CONTAINED:	WATER
LENGTH OF PIPING TO OUTERMOST ISOLATION VALVE:	N/A
APPLICABLE GDC NO.	55

GENERAL COMMENTS:
 THE RESIDUAL HEAT REMOVAL SYSTEM SUCTION LINE FROM THE REACTOR COOLANT SYSTEM CONTAINS TWO NORMALLY CLOSED, POWER-OPERATED REMOTE MANUAL VALVES IN SERIES INSIDE THE CONTAINMENT (I.E., EJHV8701B AND BBPV8702B). THESE VALVES ARE INTERLOCKED TO PREVENT THEM FROM BEING INADVERTENTLY OPENED. CONTAINMENT ISOLATION IS ASSURED BY SYSTEM ISOLATION VALVES CLOSEST TO THE CONTAINMENT (I.E., EJHV8701B AND EJ8708B) IN CONJUNCTION WITH THE CLOSED SYSTEM OUTSIDE THE CONTAINMENT, WHICH IS DESIGNED AND CONSTRUCTED COMMENSURATE WITH THE DESIGN AND CONSTRUCTION OF THE CONTAINMENT. LEAKAGE DETECTION FROM THIS LINE OUTSIDE THE CONTAINMENT IS PROVIDED, AS DESCRIBED IN SECTION 9.3.3.

LOCAL TESTING OF THE VALVE OR THE CLOSED SYSTEM OUTSIDE THE CONTAINMENT IS NOT REQUIRED SINCE THE SYSTEM IS OPERATED AND INSPECTED DURING NORMAL PLANT OPERATION TO ASSURE THAT THE INTEGRITY IS BEING MAINTAINED.

NOTE 1: MAXIMUM CLOSURE TIMES SPECIFIED IN THIS FIGURE ARE NOMINAL DESIGN OR LICENSING-BASIS VALUES. PERFORMANCE-BASED VALVE OPERABILITY LIMITS FOR VALVE CLOSURE TIMES ARE SPECIFIED PER THE INSERVICE TESTING PROGRAM FOR CALLAWAY.

APPENDIX J REQUIREMENT
 TYPE A
 B
 C
 NONE

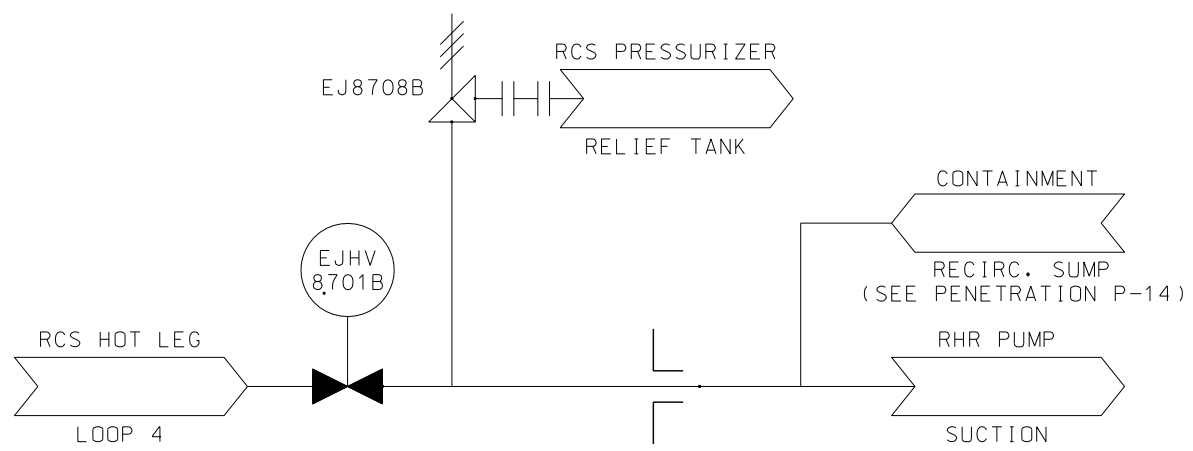

REFERENCE SECTIONS 5.4.7 AND 6.3

CONTAINMENT PENETRATION NO. P-52 DESCRIPTION: RHR SHUTDOWN LINES RESIDUAL HEAT REMOVAL SYSTEM
CONTAINMENT PENETRATIONS FIGURE 6.2.4-1 PAGE 40 OF 84 REV. 13 8/16


VALVE NO.	LINE / VALVE SIZE, IN.	INSIDE / OUTSIDE CONT.	NORMAL FLOW DIRECTION	VALVE TYPE	VALVE OPERATOR	POWER SOURCE	PRIMARY ACTUATION SIGNAL	SECONDARY ACTUATION SIGNAL	MAXIMUM CLOSURE TIME (SEC.) (NOTE 1)	VALVE POSITION				
										NORMAL	SHUTDOWN	POWER FAILURE	POST ACCIDENT	
													PRIMARY	SECONDARY
ECV0084	6/6	INSIDE	IN	GATE	MANUAL	N/A	N/A	N/A	N/A	CLOSED	OPEN	N/A	CLOSED	N/A
ECV0085	1/1	OUTSIDE	N/A	GLOBE	MANUAL	N/A	N/A	N/A	N/A	CLOSED	CLOSED	N/A	CLOSED	N/A
ECV0083	6/6	OUTSIDE	IN	GATE	MANUAL	N/A	N/A	N/A	N/A	CLOSED	OPEN	N/A	CLOSED	N/A

ENGINEERED SAFETY FEATURE SYSTEM	YES <input type="checkbox"/> NO <input checked="" type="checkbox"/>
FLUID CONTAINED:	WATER
LENGTH OF PIPING TO OUTERMOST ISOLATION VALVE:	3.0 FT.
APPLICABLE GDC NO.	56

GENERAL COMMENTS:

NONE

NOTE 1: MAXIMUM CLOSURE TIMES SPECIFIED IN THIS FIGURE ARE NOMINAL DESIGN OR LICENSING-BASIS VALUES. PERFORMANCE-BASED VALVE OPERABILITY LIMITS FOR VALVE CLOSURE TIMES ARE SPECIFIED PER THE INSERVICE TESTING PROGRAM FOR CALLAWAY.

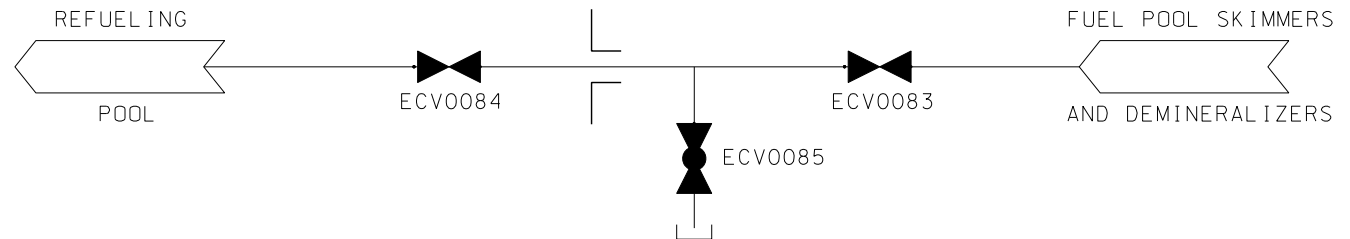

REFERENCE SECTION 9.1.3

CONTAINMENT PENETRATION NO. P-53
 DESCRIPTION: CLEANUP RETURN
 FUEL POOL COOLING AND CLEANUP SYSTEM

CONTAINMENT PENETRATIONS
 FIGURE 6.2.4-1
 PAGE 41 OF 84
 REV. 11 3/08

APPENDIX J REQUIREMENT

TYPE A
 B
 C
 NONE

VALVE NO.	LINE / VALVE SIZE, IN.	INSIDE / OUTSIDE CONT.	NORMAL FLOW DIRECTION	VALVE TYPE	VALVE OPERATOR	POWER SOURCE	PRIMARY ACTUATION SIGNAL	SECONDARY ACTUATION SIGNAL	MAXIMUM CLOSURE TIME (SEC.) (NOTE 1)	VALVE POSITION				
										NORMAL	SHUTDOWN	POWER FAILURE	POST ACCIDENT	
													PRIMARY	SECONDARY
ECV0087	6/6	INSIDE	OUT	GATE	MANUAL	N/A	N/A	N/A	N/A	CLOSED	OPEN	N/A	CLOSED	N/A
ECV0086	1/1	OUTSIDE	N/A	GLOBE	MANUAL	N/A	N/A	N/A	N/A	CLOSED	CLOSED	N/A	CLOSED	N/A
ECV0088	6/6	OUTSIDE	OUT	GATE	MANUAL	N/A	N/A	N/A	N/A	CLOSED	OPEN	N/A	CLOSED	N/A

ENGINEERED SAFETY FEATURE SYSTEM YES NO


FLUID CONTAINED: WATER

LENGTH OF PIPING TO OUTERMOST ISOLATION VALVE: 3.0 FT.

APPLICABLE GDC NO. 56

GENERAL COMMENTS:
NONE

NOTE 1: MAXIMUM CLOSURE TIMES SPECIFIED IN THIS FIGURE ARE NOMINAL DESIGN OR LICENSING-BASIS VALUES. PERFORMANCE-BASED VALVE OPERABILITY LIMITS FOR VALVE CLOSURE TIMES ARE SPECIFIED PER THE INSERVICE TESTING PROGRAM FOR CALLAWAY.

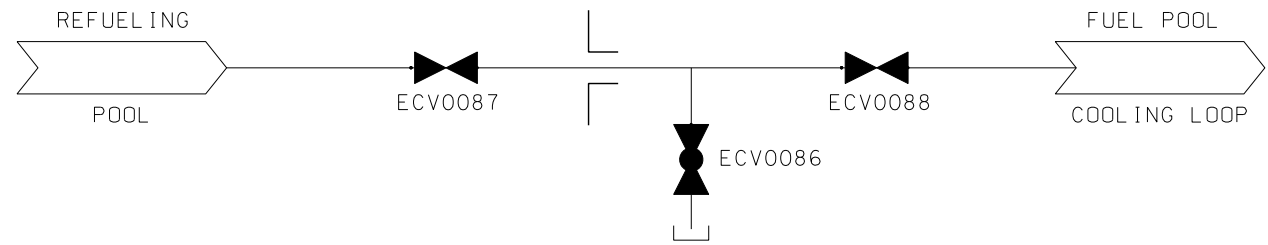

REFERENCE SECTION 9.1.3

CONTAINMENT PENETRATION NO. P-54
DESCRIPTION: REFUELING POOL CLEANUP LINE
FUEL POOL COOLING AND CLEANUP SYSTEM

CONTAINMENT PENETRATIONS
FIGURE 6.2.4-1
PAGE 42 OF 84
REV. 12 8/16

APPENDIX J REQUIREMENT

TYPE A
B
C
NONE


VALVE NO.	LINE / VALVE SIZE, IN.	INSIDE / OUTSIDE CONT.	NORMAL FLOW DIRECTION	VALVE TYPE	VALVE OPERATOR	POWER SOURCE	PRIMARY ACTUATION SIGNAL	SECONDARY ACTUATION SIGNAL	MAXIMUM CLOSURE TIME (SEC.) (NOTE 1)	VALVE POSITION				
										NORMAL	SHUTDOWN	POWER FAILURE	POST ACCIDENT	
													PRIMARY	SECONDARY
ECV0095	3/3	INSIDE	OUT	GATE	MANUAL	N/A	N/A	N/A	N/A	CLOSED	OPEN	N/A	CLOSED	N/A
ECV0094	1/1	OUTSIDE	N/A	GLOBE	MANUAL	N/A	N/A	N/A	N/A	CLOSED	CLOSED	N/A	CLOSED	N/A
ECV0096	3/3	OUTSIDE	OUT	GATE	MANUAL	N/A	N/A	N/A	N/A	CLOSED	OPEN	N/A	CLOSED	N/A

ENGINEERED SAFETY FEATURE SYSTEM	YES <input type="checkbox"/> NO <input checked="" type="checkbox"/>
FLUID CONTAINED:	WATER
LENGTH OF PIPING TO OUTERMOST ISOLATION VALVE:	2.8 FT.
APPLICABLE GDC NO.	56

GENERAL COMMENTS:

NONE

NOTE 1: MAXIMUM CLOSURE TIMES SPECIFIED IN THIS FIGURE ARE NOMINAL DESIGN OR LICENSING-BASIS VALUES. PERFORMANCE-BASED VALVE OPERABILITY LIMITS FOR VALVE CLOSURE TIMES ARE SPECIFIED PER THE INSERVICE TESTING PROGRAM FOR CALLAWAY.

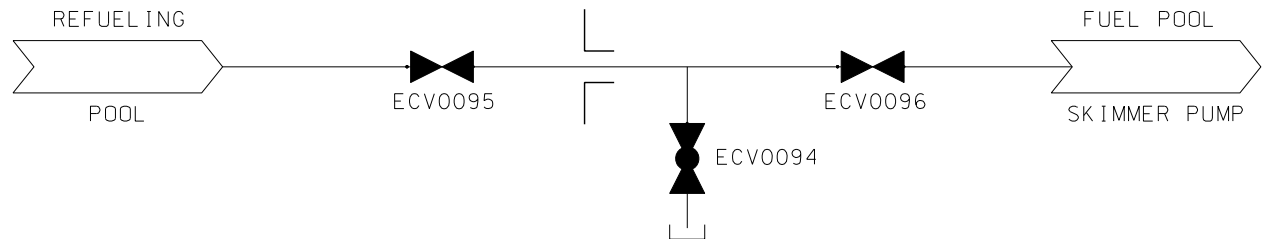

REFERENCE SECTION 9.1.3

CONTAINMENT PENETRATION NO. P-55
 DESCRIPTION: REFUELING POOL SKIMMER LINES
 FUEL POOL COOLING AND CLEANUP SYSTEM

APPENDIX J REQUIREMENT

- TYPE A
 B
 C
 NONE

CONTAINMENT PENETRATIONS
 FIGURE 6.2.4-1
 PAGE 43 OF 84
 REV. 11 3/08

VALVE NO.	LINE/ VALVE SIZE, IN.	INSIDE/ OUTSIDE CONT.	NORMAL FLOW DIRECTION	VALVE TYPE	VALVE OPERATOR	POWER SOURCE	PRIMARY ACTUATION SIGNAL	SECONDARY ACTUATION SIGNAL	MAXIMUM CLOSURE TIME (SEC.) (NOTE 1)	VALVE POSITION				
										NORMAL	SHUTDOWN	POWER FAILURE	POST ACCIDENT	
													PRIMARY	SECONDARY
GSHV0009	1/1	INSIDE	IN	GATE	SOLENOID	4	CIS-A	REM/MAN	5	CLOSED	CLOSED	CLOSED	CLOSED	OPEN
GSHV0008	1/1	OUTSIDE	IN	GATE	SOLENOID	4	CIS-A	REM/MAN	5	CLOSED	CLOSED	CLOSED	CLOSED	OPEN
GSV0032	1/1	OUTSIDE	N/A	GLOBE	MANUAL	N/A	N/A	N/A	N/A	CLOSED	CLOSED	N/A	CLOSED	N/A
GSHV0038	1/1	OUTSIDE	IN	GATE	SOLENOID	1	CIS-A	REM/MAN	5	OPEN	OPEN	CLOSED	CLOSED	OPEN
GSHV0039	1/1	INSIDE	IN	GATE	SOLENOID	4	CIS-A	REM/MAN	5	OPEN	OPEN	CLOSED	CLOSED	OPEN
GSV0058	1/1	OUTSIDE	N/A	GLOBE	MANUAL	N/A	N/A	N/A	N/A	CLOSED	CLOSED	N/A	CLOSED	N/A


ENGINEERED SAFETY FEATURE SYSTEM	YES <input checked="" type="checkbox"/> NO <input type="checkbox"/>
FLUID CONTAINED:	AIR
LENGTH OF PIPING TO OUTERMOST ISOLATION VALVE:	3.2 FT
APPLICABLE GDC NO.	56

GENERAL COMMENTS:

THIS PENETRATION IS ASSOCIATED WITH THE CONTAINMENT HYDROGEN CONTROL SYSTEM, WHICH IS REQUIRED TO MITIGATE THE CONSEQUENCES OF A LOCA.

ALTHOUGH THE SOLENOID-OPERATED CONTAINMENT ISOLATION VALVES FOR THE HYDROGEN MONITORING SYSTEM SAMPLING LINES ARE DESIGNED TO AUTOMATICALLY CLOSE IN RESPONSE TO A CIS-A SIGNAL, THEY ARE NORMALLY CLOSED AND DEACTIVATED TO PROVIDE A PASSIVE BARRIER TO THE RELEASE OF CONTAINMENT ATMOSPHERE VIA THE ASSOCIATED CONTAINMENT PENETRATIONS. THE VALVES ARE OPEN ONLY UNDER ADMINISTRATIVE CONTROL. IN ADDITION, AND ALTHOUGH NOT EXPLICITLY CREDITED AS A CONTAINMENT BARRIER, THE SAMPLING SYSTEM (DOWN STREAM OF THE CONTAINMENT ISOLATION VALVES) IS A CLOSED SYSTEM OUTSIDE THE CONTAINMENT AND IS DESIGNED AND CONSTRUCTED COMMENSURATE WITH THE DESIGN AND CONSTRUCTION OF THE CONTAINMENT.

NOTE 1: MAXIMUM CLOSURE TIMES SPECIFIED IN THIS FIGURE ARE NOMINAL DESIGN OR LICENSING-BASIS VALUES. PERFORMANCE-BASED VALVE OPERABILITY LIMITS FOR VALVE CLOSURE TIMES ARE SPECIFIED PER THE INSERVICE TESTING PROGRAM FOR CALLAWAY.

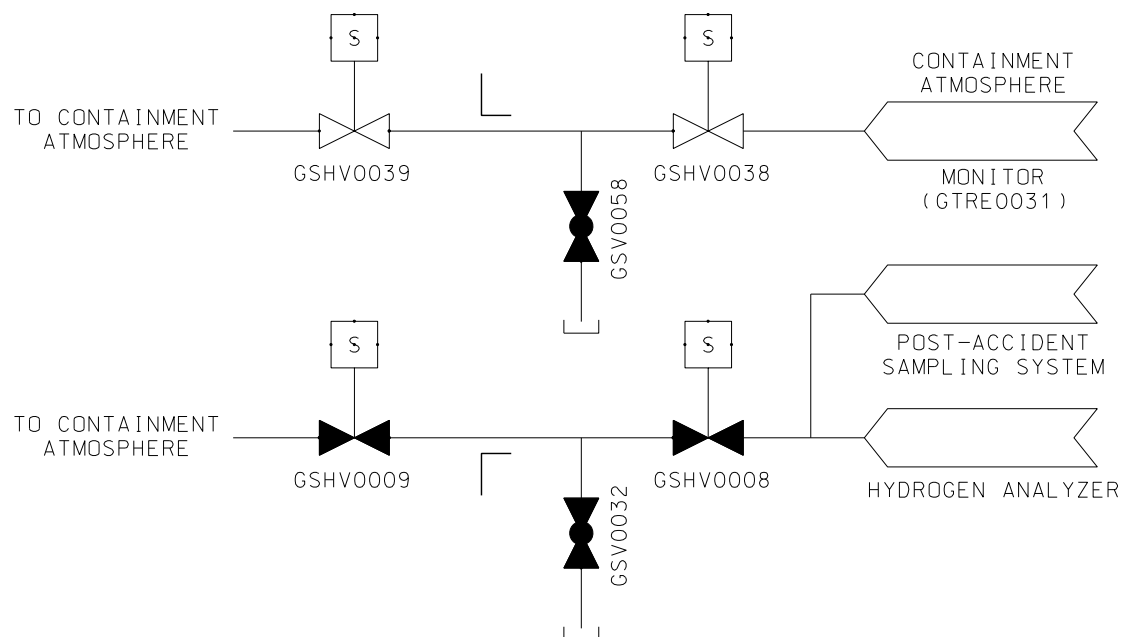

REFERENCE SECTION 6.2.5

CONTAINMENT PENETRATION NO. P-56
 DESCRIPTION:
 H₂ SAMPLE RETURN
 CONTAINMENT HYDROGEN CONTROL SYSTEM

CONTAINMENT PENETRATIONS
 FIGURE 6.2.4-1
 PAGE 44 OF 84
 REV. 15 9/14

APPENDIX J REQUIREMENT


TYPE A
 B
 C
 NONE

VALVE NO.	LINE / VALVE SIZE, IN.	INSIDE / OUTSIDE CONT.	NORMAL FLOW DIRECTION	VALVE TYPE	VALVE OPERATOR	POWER SOURCE	PRIMARY ACTUATION SIGNAL	SECONDARY ACTUATION SIGNAL	MAXIMUM CLOSURE TIME (SEC.) (NOTE 1)	VALVE POSITION				
										NORMAL	SHUTDOWN	POWER FAILURE	POST ACCIDENT	
													PRIMARY	SECONDARY

ENGINEERED SAFETY FEATURE SYSTEM	YES <input type="checkbox"/> NO <input checked="" type="checkbox"/>
FLUID CONTAINED:	AIR
LENGTH OF PIPING TO OUTERMOST ISOLATION VALVE:	NA
APPLICABLE GDC NO.	56

GENERAL COMMENTS:
 THE END OF THE LINE IS SEALED USING WELDED PIPE CAPS.

NOTE 1: MAXIMUM CLOSURE TIMES SPECIFIED IN THIS FIGURE ARE NOMINAL DESIGN OR LICENSING-BASIS VALUES. PERFORMANCE-BASED VALVE OPERABILITY LIMITS FOR VALVE CLOSURE TIMES ARE SPECIFIED PER THE INSERVICE TESTING PROGRAM FOR CALLAWAY.

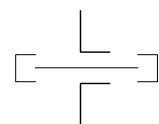

REFERENCE SECTION 18.2.3

CONTAINMENT PENETRATION NO. P-57 DESCRIPTION: SPARE
CONTAINMENT PENETRATIONS FIGURE 6.2.4-1 PAGE 45 OF 84 REV. 14 3/08

APPENDIX J REQUIREMENT

TYPE A
 B
 C
 NONE

VALVE NO.	LINE / VALVE SIZE, IN.	INSIDE / OUTSIDE CONT.	NORMAL FLOW DIRECTION	VALVE TYPE	VALVE OPERATOR	POWER SOURCE	PRIMARY ACTUATION SIGNAL	SECONDARY ACTUATION SIGNAL	MAXIMUM CLOSURE TIME (SEC.) (NOTE 1)	VALVE POSITION				
										NORMAL	SHUTDOWN	POWER FAILURE	POST ACCIDENT	
													PRIMARY	SECONDARY
EMV0006	1/1	INSIDE	IN	CHECK	N/A	N/A	N/A	N/A	N/A	CLOSED	CLOSED	N/A	CLOSED	N/A
EMV0182	3/4 / 3/4	OUTSIDE	N/A	GLOBE	MANUAL	N/A	N/A	N/A	N/A	CLOSED	CLOSED	N/A	CLOSED	N/A
EMV0123	3/4 / 3/4	OUTSIDE	N/A	GLOBE	MANUAL	N/A	N/A	N/A	N/A	CLOSED	CLOSED	N/A	CLOSED	N/A
EMHV8888	1/1	OUTSIDE	IN	GLOBE	AIR	4	CIS-A	NONE	NOTE 1	CLOSED	CLOSED	CLOSED	CLOSED	N/A

ENGINEERED SAFETY FEATURE SYSTEM YES NO


FLUID CONTAINED: WATER

LENGTH OF PIPING TO OUTERMOST ISOLATION VALVE: 7.6 FT.

APPLICABLE GDC NO. 56

GENERAL COMMENTS:

NOTE 1: MAXIMUM CLOSURE TIMES SPECIFIED IN THIS FIGURE ARE NOMINAL DESIGN OR LICENSING-BASIS VALUES. PERFORMANCE-BASED VALVE OPERABILITY LIMITS FOR VALVE CLOSURE TIMES ARE SPECIFIED PER THE INSERVICE TESTING PROGRAM FOR CALLAWAY.

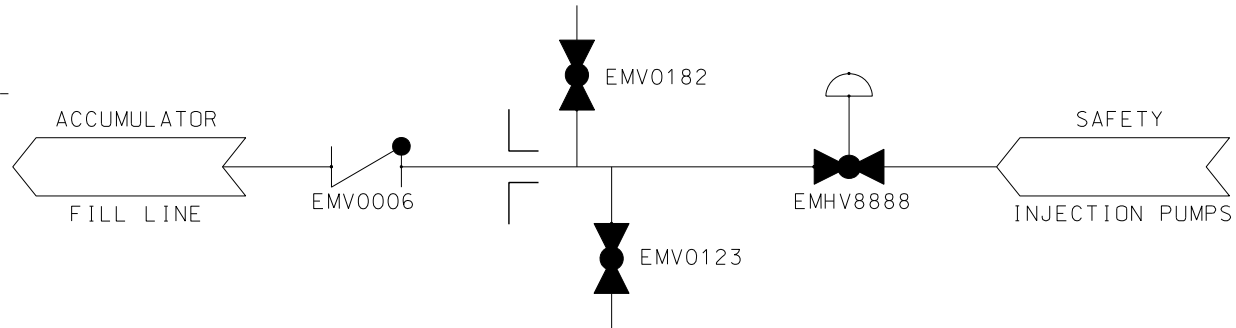

REFERENCE SECTION 6.3

CONTAINMENT PENETRATION NO. P-58
 DESCRIPTION: ACCUMULATOR FILL LINE
 HIGH PRESSURE COOLANT INJECTION SYSTEM

CONTAINMENT PENETRATIONS
 FIGURE 6.2.4-1
 PAGE 46 OF 84
 REV. 12 8/16

APPENDIX J REQUIREMENT


- TYPE A
 B
 C
 NONE

VALVE NO.	LINE / VALVE SIZE, IN.	INSIDE / OUTSIDE CONT.	NORMAL FLOW DIRECTION	VALVE TYPE	VALVE OPERATOR	POWER SOURCE	PRIMARY ACTUATION SIGNAL	SECONDARY ACTUATION SIGNAL	MAXIMUM CLOSURE TIME (SEC.) (NOTE 1)	VALVE POSITION				
										NORMAL	SHUTDOWN	POWER FAILURE	POST ACCIDENT	
													PRIMARY	SECONDARY
NONE	N/A	N/A	N/A	N/A	N/A	N/A	N/A	N/A	N/A	N/A	N/A	N/A	N/A	N/A

ENGINEERED SAFETY FEATURE SYSTEM	YES <input type="checkbox"/> NO <input checked="" type="checkbox"/>
FLUID CONTAINED:	WATER
LENGTH OF PIPING TO OUTERMOST ISOLATION VALVE:	N/A
APPLICABLE GDC NO.	55

GENERAL COMMENTS:

HYDRAULIC SENSORS PROVIDE ISOLATION OF RCS FROM THE CAPILLARY TUBING. THE CAPILLARY TUBING AND THE LIS'S SERVE AS THE SECOND BOUNDARY. THIS ARRANGEMENT IS SIMILAR TO THAT PROVIDED FOR THE CONTAINMENT PRESSURE TRANSMITTERS SHOWN ON SHEETS 80, 81, AND 84 OF 84.

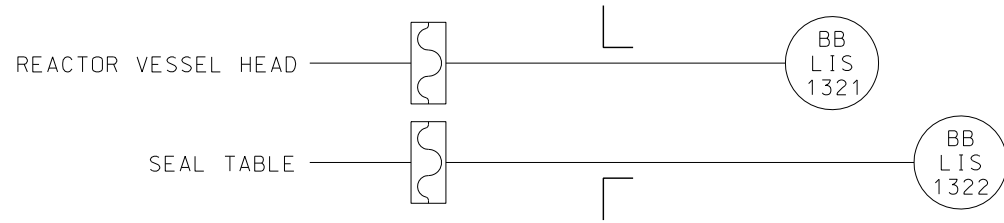

NOTE 1: MAXIMUM CLOSURE TIMES SPECIFIED IN THIS FIGURE ARE NOMINAL DESIGN OR LICENSING-BASIS VALUES. PERFORMANCE-BASED VALVE OPERABILITY LIMITS FOR VALVE CLOSURE TIMES ARE SPECIFIED PER THE INSERVICE TESTING PROGRAM FOR CALLAWAY.

APPENDIX J REQUIREMENT

TYPE A
 B
 C
 NONE

REFERENCE SECTION 18.2.13.2

CONTAINMENT PENETRATION NO. P-59 DESCRIPTION: RVLIS SAMPLE LINE REACTOR COOLANT SYSTEM
CONTAINMENT PENETRATIONS FIGURE 6.2.4-1 PAGE 47 OF 84 REV. 11 3/08


VALVE NO.	LINE / VALVE SIZE, IN.	INSIDE / OUTSIDE CONT.	NORMAL FLOW DIRECTION	VALVE TYPE	VALVE OPERATOR	POWER SOURCE	PRIMARY ACTUATION SIGNAL	SECONDARY ACTUATION SIGNAL	MAXIMUM CLOSURE TIME (SEC.) (NOTE 1)	VALVE POSITION				
										NORMAL	SHUTDOWN	POWER FAILURE	POST ACCIDENT	
													PRIMARY	SECONDARY
BBHV8026	1/1	INSIDE	BOTH	DIAPHRAGM	AIR	1	CIS-A	NONE	10	CLOSED	OPEN	CLOSED	CLOSED	N/A
BBHV8027	1/1	OUTSIDE	BOTH	DIAPHRAGM	AIR	4	CIS-A	NONE	10	CLOSED	OPEN	CLOSED	CLOSED	N/A

ENGINEERED SAFETY FEATURE SYSTEM	YES <input type="checkbox"/> NO <input checked="" type="checkbox"/>
FLUID CONTAINED:	GAS
LENGTH OF PIPING TO OUTERMOST ISOLATION VALVE:	8.2 FT.
APPLICABLE GDC NO.	56

GENERAL COMMENTS:

NONE

NOTE 1: MAXIMUM CLOSURE TIMES SPECIFIED IN THIS FIGURE ARE NOMINAL DESIGN OR LICENSING-BASIS VALUES. PERFORMANCE-BASED VALVE OPERABILITY LIMITS FOR VALVE CLOSURE TIMES ARE SPECIFIED PER THE INSERVICE TESTING PROGRAM FOR CALLAWAY.

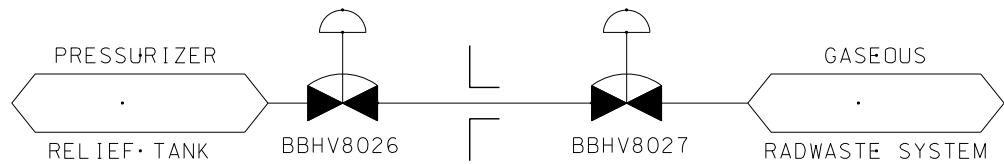

REFERENCE SECTION 5.4

CONTAINMENT PENETRATION NO. P-62 DESCRIPTION: PRESSURIZER PURGE AND VENT LINE REACTOR COOLANT SYSTEM
CONTAINMENT PENETRATIONS FIGURE 6.2.4-1 PAGE 48 OF 84 REV. 12 8/16

APPENDIX J REQUIREMENT


- TYPE A
- B
- C
- NONE

VALVE NO.	LINE / VALVE SIZE, IN.	INSIDE / OUTSIDE CONT.	NORMAL FLOW DIRECTION	VALVE TYPE	VALVE OPERATOR	POWER SOURCE	PRIMARY ACTUATION SIGNAL	SECONDARY ACTUATION SIGNAL	MAXIMUM CLOSURE TIME (SEC.) (NOTE 1)	VALVE POSITION				
										NORMAL	SHUTDOWN	POWER FAILURE	POST ACCIDENT	
													PRIMARY	SECONDARY
KAV0118	4/4	OUTSIDE	IN	GLOBE	MANUAL	N/A	N/A	N/A	N/A	CLOSED	CLOSED	N/A	CLOSED	N/A
KAV0163	1/1	OUTSIDE	N/A	GLOBE	MANUAL	N/A	N/A	N/A	N/A	CLOSED	CLOSED	N/A	CLOSED	N/A
KAV0039	4/4	INSIDE	IN	CHECK	N/A	N/A	N/A	N/A	N/A	CLOSED	CLOSED	N/A	CLOSED	N/A

ENGINEERED SAFETY FEATURE SYSTEM	YES <input type="checkbox"/> NO <input checked="" type="checkbox"/>
FLUID CONTAINED:	AIR
LENGTH OF PIPING TO OUTERMOST ISOLATION VALVE:	4.1 FT.
APPLICABLE GDC NO.	56

GENERAL COMMENTS:
NONE

NOTE 1: MAXIMUM CLOSURE TIMES SPECIFIED IN THIS FIGURE ARE NOMINAL DESIGN OR LICENSING-BASIS VALUES. PERFORMANCE-BASED VALVE OPERABILITY LIMITS FOR VALVE CLOSURE TIMES ARE SPECIFIED PER THE INSERVICE TESTING PROGRAM FOR CALLAWAY.

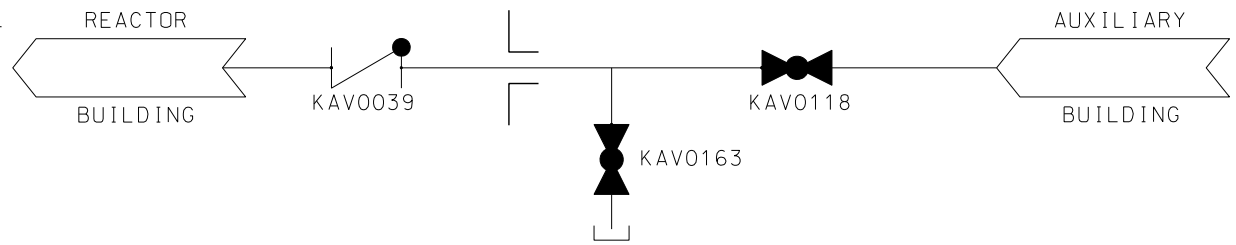

REFERENCE SECTION 9.3.1

CONTAINMENT PENETRATION NO. P-63
DESCRIPTION: SERVICE AIR COMPRESSED AIR SYSTEM

CONTAINMENT PENETRATIONS
FIGURE 6.2.4-1
PAGE 49 OF 84
REV. 11 3/08

APPENDIX J REQUIREMENT

- TYPE A
 B
 C
 NONE


VALVE NO.	LINE / VALVE SIZE, IN.	INSIDE / OUTSIDE CONT.	NORMAL FLOW DIRECTION	VALVE TYPE	VALVE OPERATOR	POWER SOURCE	PRIMARY ACTUATION SIGNAL	SECONDARY ACTUATION SIGNAL	MAXIMUM CLOSURE TIME (SEC.) (NOTE 1)	VALVE POSITION				
										NORMAL	SHUTDOWN	POWER FAILURE	POST ACCIDENT	
													PRIMARY	SECONDARY
SJHV0128	1/1	INSIDE	OUT	GLOBE	SOLENOID	1	CIS-A	NONE	5	CLOSED	OPEN	CLOSED	CLOSED	N/A
SJHV0129	1/1	OUTSIDE	OUT	GLOBE	SOLENOID	4	CIS-A	NONE	5	CLOSED	OPEN	CLOSED	CLOSED	N/A
SJHV0130	1/1	OUTSIDE	OUT	GLOBE	SOLENOID	1	CIS-A	NONE	5	CLOSED	CLOSED	CLOSED	CLOSED	N/A
SJVO106	1/1	OUTSIDE	N/A	GLOBE	MANUAL	N/A	N/A	N/A	N/A	CLOSED	CLOSED	N/A	CLOSED	N/A

ENGINEERED SAFETY FEATURE SYSTEM	YES <input type="checkbox"/> NO <input checked="" type="checkbox"/>
FLUID CONTAINED:	WATER
LENGTH OF PIPING TO OUTERMOST ISOLATION VALVE:	10.6 FT.
APPLICABLE GDC NO.	55

GENERAL COMMENTS:

NONE

NOTE 1: MAXIMUM CLOSURE TIMES SPECIFIED IN THIS FIGURE ARE NOMINAL DESIGN OR LICENSING-BASIS VALUES. PERFORMANCE-BASED VALVE OPERABILITY LIMITS FOR VALVE CLOSURE TIMES ARE SPECIFIED PER THE INSERVICE TESTING PROGRAM FOR CALLAWAY.

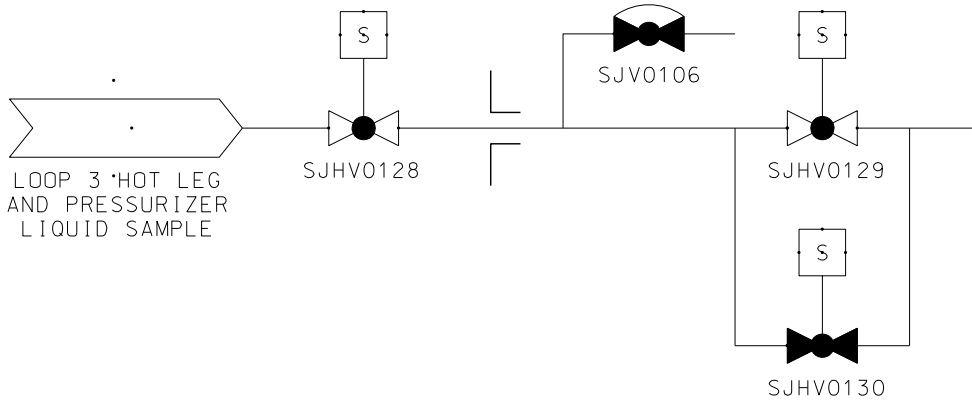

REFERENCE SECTION 18.2.3

CONTAINMENT PENETRATION NO. P-64
DESCRIPTION:
SAMPLE LINE
NUCLEAR SAMPLING SYSTEM
CONTAINMENT PENETRATIONS
FIGURE 6.2.4-1
PAGE 50 OF 84
REV. 15 11/08

APPENDIX J REQUIREMENT

- TYPE A
- B
- C
- NONE


VALVE NO.	LINE / VALVE SIZE, IN.	INSIDE / OUTSIDE CONT.	NORMAL FLOW DIRECTION	VALVE TYPE	VALVE OPERATOR	POWER SOURCE	PRIMARY ACTUATION SIGNAL	SECONDARY ACTUATION SIGNAL	MAXIMUM CLOSURE TIME (SEC.) (NOTE 1)	VALVE POSITION				
										NORMAL	SHUTDOWN	POWER FAILURE	POST ACCIDENT	
													PRIMARY	SECONDARY
GSHV0020	6/6	INSIDE	OUT	BUTTERFLY	MOTOR	1	CIS-A	REM/MAN	5	CLOSED	CLOSED	CLOSED	CLOSED	OPEN
GSHV0021	6/6	OUTSIDE	OUT	BUTTERFLY	MOTOR	4	CIS-A	REM/MAN	5	CLOSED	CLOSED	CLOSED	CLOSED	OPEN
GSV0041	1/1	OUTSIDE	N/A	GLOBE	MANUAL	N/A	N/A	N/A	N/A	CLOSED	CLOSED	N/A	CLOSED	N/A

ENGINEERED SAFETY FEATURE SYSTEM	YES <input checked="" type="checkbox"/> NO <input type="checkbox"/>
FLUID CONTAINED:	AIR
LENGTH OF PIPING TO OUTERMOST ISOLATION VALVE:	1.0 FT.
APPLICABLE GDC NO.	56

GENERAL COMMENTS:

NONE

NOTE 1: MAXIMUM CLOSURE TIMES SPECIFIED IN THIS FIGURE ARE NOMINAL DESIGN OR LICENSING-BASIS VALUES. PERFORMANCE-BASED VALVE OPERABILITY LIMITS FOR VALVE CLOSURE TIMES ARE SPECIFIED PER THE INSERVICE TESTING PROGRAM FOR CALLAWAY.

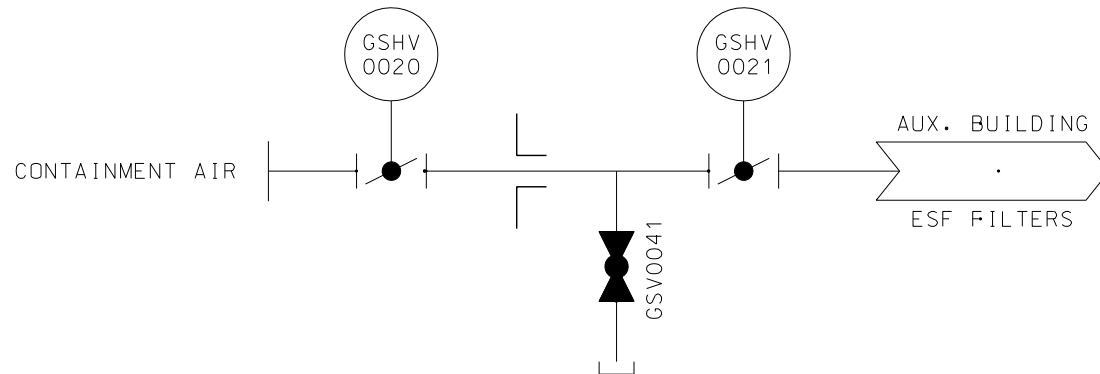

REFERENCE SECTION 6.2.5

CONTAINMENT PENETRATION NO. P-65 DESCRIPTION: CONTAINMENT H ₂ PURGE CONTAINMENT HYDROGEN CONTROL SYSTEM
CONTAINMENT PENETRATIONS FIGURE 6.2.4-1 PAGE 51 OF 84 REV. 11 3/08

APPENDIX J REQUIREMENT

- TYPE A
 B
 C
 NONE

VALVE NO.	LINE/ VALVE SIZE, IN.	INSIDE/ OUTSIDE CONT.	NORMAL FLOW DIRECTION	VALVE TYPE	VALVE OPERATOR	POWER SOURCE	PRIMARY ACTUATION SIGNAL	SECONDARY ACTUATION SIGNAL	MAXIMUM CLOSURE TIME (SEC.) (NOTE 1)	VALVE POSITION				
										NORMAL	SHUTDOWN	POWER FAILURE	POST ACCIDENT	
													PRIMARY	SECONDARY
ENHV0012	10/10	OUTSIDE	IN	GATE	MOTOR	4	CSAS	REM/MAN	15	CLOSED	CLOSED	AS IS	OPEN	CLOSED
ENVO080	1/1	OUTSIDE	N/A	GLOBE	MANUAL	N/A	N/A	N/A	N/A	CLOSED	CLOSED	N/A	CLOSED	N/A
ENVO017	10/10	INSIDE	IN	CHECK	N/A	N/A	N/A	N/A	N/A	CLOSED	CLOSED	N/A	OPEN	N/A

ENGINEERED SAFETY FEATURE SYSTEM	YES <input checked="" type="checkbox"/> NO <input type="checkbox"/>
FLUID CONTAINED:	WATER
LENGTH OF PIPING TO OUTERMOST ISOLATION VALVE:	16.6 FT
APPLICABLE GDC NO.	56

GENERAL COMMENTS:


THIS PENETRATION IS ASSOCIATED WITH THE CONTAINMENT SPRAY SYSTEM, WHICH IS REQUIRED TO MITIGATE THE CONSEQUENCES OF A LOCA. A CHECK VALVE IS PROVIDED INSIDE THE CONTAINMENT, AND A REMOTE-MANUAL ISOLATION VALVE IS PROVIDED OUTSIDE THE CONTAINMENT. A SINGLE ACTIVE OR PASSIVE FAILURE CAN BE ACCOMMODATED SINCE THE SYSTEM IS CLOSED OUTSIDE THE CONTAINMENT AND IS DESIGNED AND CONSTRUCTED COMMENSURATE WITH THE DESIGN AND CONSTRUCTION OF THE CONTAINMENT. LEAKAGE DETECTION FROM THIS LINE OUTSIDE THE CONTAINMENT IS PROVIDED, AS DESCRIBED IN SECTION 9.3.3.

LOCAL TESTING OF THE VALVES OR THE CLOSED SYSTEM OUTSIDE THE CONTAINMENT IS NOT REQUIRED SINCE THE SYSTEM IS OPERATED AND INSPECTED DURING NORMAL PLANT OPERATION TO ASSURE THAT THE INTEGRITY IS BEING MAINTAINED.

NOTE 1: MAXIMUM CLOSURE TIMES SPECIFIED IN THIS FIGURE ARE NOMINAL DESIGN OR LICENSING-BASIS VALUES. PERFORMANCE-BASED VALVE OPERABILITY LIMITS FOR VALVE CLOSURE TIMES ARE SPECIFIED PER THE INSERVICE TESTING PROGRAM FOR CALLAWAY.

APPENDIX J REQUIREMENT

TYPE A
 B
 C
 NONE

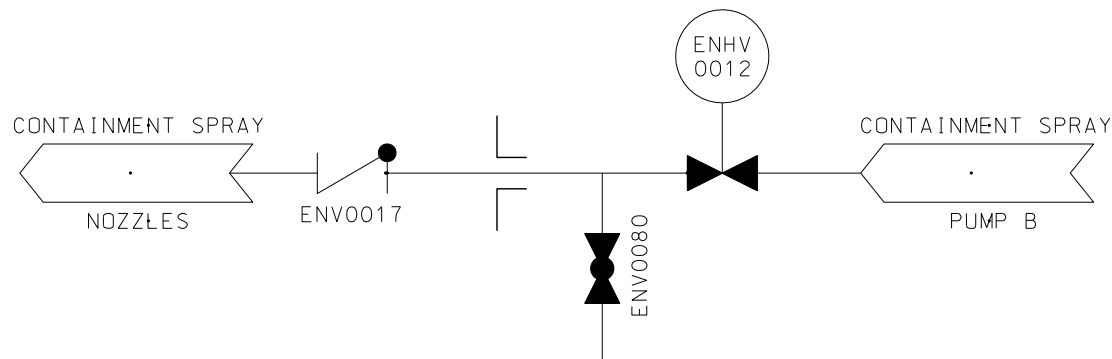

REFERENCE SECTION 6.2.2

CONTAINMENT PENETRATION NO. P-66
DESCRIPTION: CONTAINMENT SPRAY CONTAINMENT SPRAY SYSTEM
CONTAINMENT PENETRATIONS FIGURE 6.2.4-1 PAGE 52 OF 84 REV. 13 8/16

VALVE NO.	LINE / VALVE SIZE, IN.	INSIDE / OUTSIDE CONT.	NORMAL FLOW DIRECTION	VALVE TYPE	VALVE OPERATOR	POWER SOURCE	PRIMARY ACTUATION SIGNAL	SECONDARY ACTUATION SIGNAL	MAXIMUM CLOSURE TIME (SEC.) (NOTE 1)	VALVE POSITION				
										NORMAL	SHUTDOWN	POWER FAILURE	POST ACCIDENT	
													PRIMARY	SECONDARY
KCHV0253	4/4	OUTSIDE	IN	GATE	MOTOR	1	CIS-A	NONE	30	CLOSED	CLOSED	AS IS	CLOSED	N/A
KCV0478	4/4	INSIDE	IN	CHECK	N/A	N/A	N/A	N/A	N/A	CLOSED	CLOSED	N/A	CLOSED	N/A
KCV0431	1/1	INSIDE	N/A	GLOBE	MANUAL	N/A	N/A	N/A	N/A	CLOSED	CLOSED	N/A	CLOSED	N/A

ENGINEERED SAFETY FEATURE SYSTEM YES NO

FLUID CONTAINED: WATER


LENGTH OF PIPING TO OUTERMOST ISOLATION VALVE: 12.4 FT.

APPLICABLE GDC NO. 56

GENERAL COMMENTS:

NONE

NOTE 1: MAXIMUM CLOSURE TIMES SPECIFIED IN THIS FIGURE ARE NOMINAL DESIGN OR LICENSING-BASIS VALUES. PERFORMANCE-BASED VALVE OPERABILITY LIMITS FOR VALVE CLOSURE TIMES ARE SPECIFIED PER THE INSERVICE TESTING PROGRAM FOR CALLAWAY.

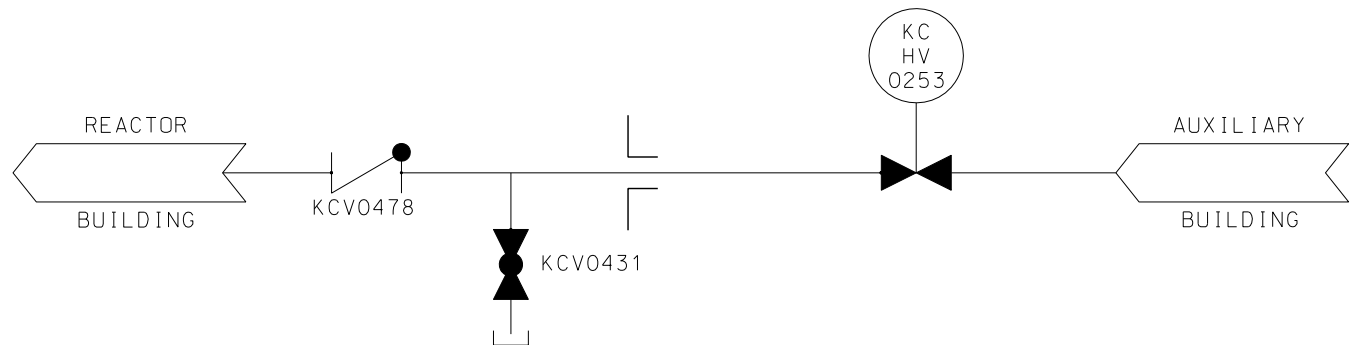

REFERENCE SECTION 9.5.1

CONTAINMENT PENETRATION NO. P-67
DESCRIPTION: CONTAINMENT FIRE PROTECTION FIRE PROTECTION SYSTEM

CONTAINMENT PENETRATIONS
FIGURE 6.2.4-1
PAGE 53 OF 84
REV. 11 3/08

APPENDIX J REQUIREMENT

- TYPE A
 B
 C
 NONE

VALVE NO.	LINE / VALVE SIZE, IN.	INSIDE / OUTSIDE CONT.	NORMAL FLOW DIRECTION	VALVE TYPE	VALVE OPERATOR	POWER SOURCE	PRIMARY ACTUATION SIGNAL	SECONDARY ACTUATION SIGNAL	MAXIMUM CLOSURE TIME (SEC.) (NOTE 1)	VALVE POSITION				
										NORMAL	SHUTDOWN	POWER FAILURE	POST ACCIDENT	
													PRIMARY	SECONDARY
GPV0050	3/4 / 3/4	OUTSIDE	N/A	GLOBE	MANUAL	N/A	N/A	N/A	N/A	CLOSED	CLOSED	N/A	CLOSED	N/A

ENGINEERED SAFETY FEATURE SYSTEM	YES <input checked="" type="checkbox"/> NO <input type="checkbox"/>
FLUID CONTAINED:	AIR
LENGTH OF PIPING TO OUTERMOST ISOLATION VALVE:	N/A
APPLICABLE GDC NO.	56

GENERAL COMMENTS:

FLANGES ARE REMOVED ONLY DURING MAINTENANCE OPERATIONS IN MODE 5 OR 6 AND CORE ALTERATIONS WITH SPECIAL FLANGES AS REQUIRED WHEN AN AIRTIGHT CONDITION IS NECESSARY.

NOTE 1: MAXIMUM CLOSURE TIMES SPECIFIED IN THIS FIGURE ARE NOMINAL DESIGN OR LICENSING-BASIS VALUES. PERFORMANCE-BASED VALVE OPERABILITY LIMITS FOR VALVE CLOSURE TIMES ARE SPECIFIED PER THE INSERVICE TESTING PROGRAM FOR CALLAWAY.



APPENDIX J REQUIREMENT

- TYPE A
- B
- C
- NONE

REFERENCE SECTION 6.2.6

CONTAINMENT PENETRATION NO. P-68 DESCRIPTION: MAINTENANCE SPARE AIR AND CABLE ACCESS PENETRATIONS CONTAINMENT ILRT SYSTEM
CONTAINMENT PENETRATIONS FIGURE 6.2.4-1 PAGE 54 OF 84 REV. 12 8/16


VALVE NO.	LINE / VALVE SIZE, IN.	INSIDE / OUTSIDE CONT.	NORMAL FLOW DIRECTION	VALVE TYPE	VALVE OPERATOR	POWER SOURCE	PRIMARY ACTUATION SIGNAL	SECONDARY ACTUATION SIGNAL	MAXIMUM CLOSURE TIME (SEC.) (NOTE 1)	VALVE POSITION				
										NORMAL	SHUTDOWN	POWER FAILURE	POST ACCIDENT	
													PRIMARY	SECONDARY
SJHV0012	1/1	INSIDE	OUT	GLOBE	SOLENOID	4	CIS-A	NONE	5	CLOSED	CLOSED	CLOSED	CLOSED	N/A
SJHV0013	1/1	OUTSIDE	OUT	GLOBE	SOLENOID	1	CIS-A	NONE	5	CLOSED	CLOSED	CLOSED	CLOSED	N/A
SJV0071	1/1	OUTSIDE	N/A	GLOBE	MANUAL	N/A	N/A	N/A	N/A	CLOSED	CLOSED	N/A	CLOSED	N/A

ENGINEERED SAFETY FEATURE SYSTEM	YES <input type="checkbox"/> NO <input checked="" type="checkbox"/>
FLUID CONTAINED:	STEAM
LENGTH OF PIPING TO OUTERMOST ISOLATION VALVE:	10.7 FT.
APPLICABLE GDC NO.	55

GENERAL COMMENTS:

NONE

NOTE 1: MAXIMUM CLOSURE TIMES SPECIFIED IN THIS FIGURE ARE NOMINAL DESIGN OR LICENSING-BASIS VALUES. PERFORMANCE-BASED VALVE OPERABILITY LIMITS FOR VALVE CLOSURE TIMES ARE SPECIFIED PER THE INSERVICE TESTING PROGRAM FOR CALLAWAY.

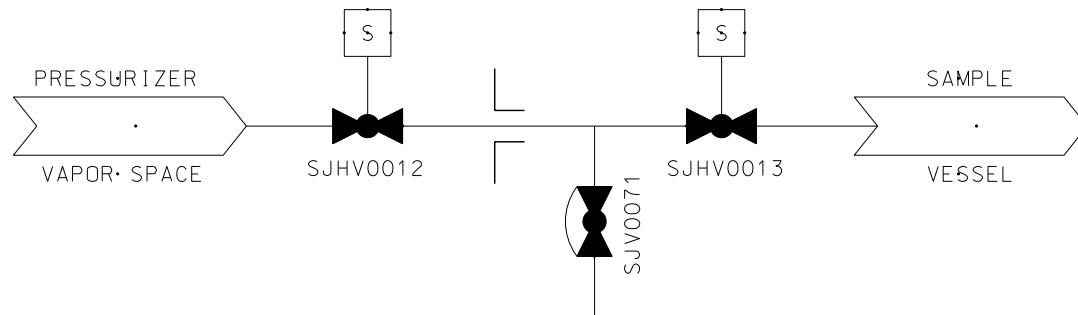

REFERENCE SECTION 9.3.2

CONTAINMENT PENETRATION NO. P-69
 DESCRIPTION:
 PRESSURIZER VAPOR SAMPLE LINE
 NUCLEAR SAMPLING SYSTEM

CONTAINMENT PENETRATIONS
 FIGURE 6.2.4-1
 PAGE 55 OF 84
 REV. 11 3/08

APPENDIX J REQUIREMENT

- TYPE A
- B
- C
- NONE

VALVE NO.	LINE/ VALVE SIZE, IN.	INSIDE/ OUTSIDE CONT.	NORMAL FLOW DIRECTION	VALVE TYPE	VALVE OPERATOR	POWER SOURCE	PRIMARY ACTUATION SIGNAL	SECONDARY ACTUATION SIGNAL	MAXIMUM CLOSURE TIME (SEC.) (NOTE 1)	VALVE POSITION				
										NORMAL	SHUTDOWN	POWER FAILURE	POST ACCIDENT	
													PRIMARY	SECONDARY
EFHV0031	14/14	OUTSIDE	IN	BUTTERFLY	MOTOR	1	SIS	REM/MAN	40	OPEN	OPEN	AS IS	OPEN	CLOSED
EFHV0033	14/14	INSIDE	IN	BUTTERFLY	MOTOR	1	SIS	REM/MAN	40	OPEN	OPEN	AS IS	OPEN	CLOSED
EFV0276	1/1	INSIDE	N/A	GATE	MANUAL	N/A	N/A	N/A	N/A	CLOSED	CLOSED	N/A	CLOSED	N/A

ENGINEERED SAFETY FEATURE SYSTEM YES NO

FLUID CONTAINED: WATER

LENGTH OF PIPING TO OUTERMOST ISOLATION VALVE: 11.4 FT.

APPLICABLE GDC NO. 56

GENERAL COMMENTS:


THIS PENETRATION IS ASSOCIATED WITH THE ESSENTIAL SERVICE WATER SYSTEM, WHICH IS REQUIRED TO MITIGATE THE CONSEQUENCES OF A LOCA. A REMOTE-MANUAL POWER-OPERATED VALVE IS LOCATED INSIDE, AND A REMOTE-MANUAL POWER-OPERATED VALVE IS LOCATED OUTSIDE THE CONTAINMENT.

THESE VALVES ARE POWERED FROM THE SAME POWER SOURCE FOR GREATER SYSTEM RELIABILITY. A SINGLE ACTIVE OR PASSIVE FAILURE CAN BE ACCOMMODATED SINCE THE SYSTEM IS A CLOSED SYSTEM INSIDE THE CONTAINMENT, WHICH IS DESIGNED AND CONSTRUCTED IN ACCORDANCE WITH ASME SECTION III, CLASS 3 REQUIREMENTS. THE ESSENTIAL SERVICE WATER LINES ARE NOT VENTED OR DRAINED DURING A TYPE A TEST SINCE THE AIR COOLERS MAY BE REQUIRED TO COOL THE CONTAINMENT. A TYPE C TEST IS PERFORMED.

NOTE 1: MAXIMUM CLOSURE TIMES SPECIFIED IN THIS FIGURE ARE NOMINAL DESIGN OR LICENSING-BASIS VALUES. PERFORMANCE-BASED VALVE OPERABILITY LIMITS FOR VALVE CLOSURE TIMES ARE SPECIFIED PER THE INSERVICE TESTING PROGRAM FOR CALLAWAY.

APPENDIX J REQUIREMENT

- TYPE A
 B
 C
 NONE

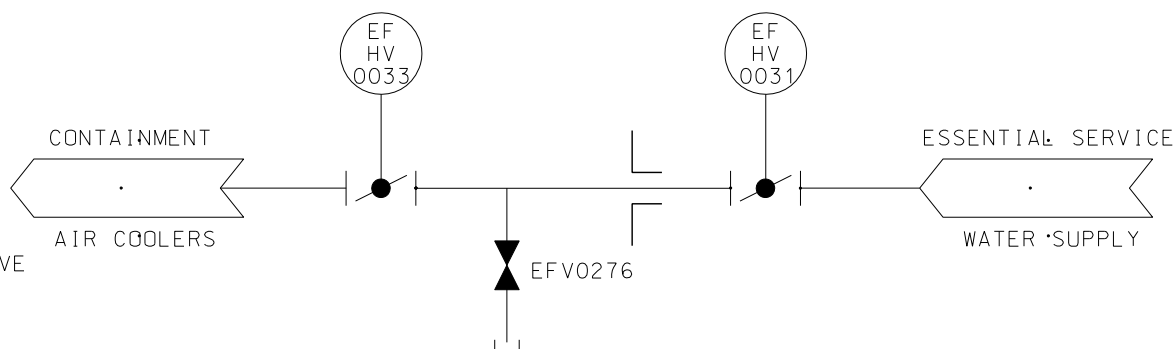

REFERENCE SECTION 9.2.1.2

CONTAINMENT PENETRATION NO. P-71 DESCRIPTION: ESW TO CONTAINMENT AIR COOLER ESSENTIAL SERVICE WATER SYSTEM
CONTAINMENT PENETRATIONS FIGURE 6.2.4-1 PAGE 56 OF 84 REV. 12 8/16

VALVE NO.	LINE/ VALVE SIZE, IN.	INSIDE/ OUTSIDE CONT.	NORMAL FLOW DIRECTION	VALVE TYPE	VALVE OPERATOR	POWER SOURCE	PRIMARY ACTUATION SIGNAL	SECONDARY ACTUATION SIGNAL	MAXIMUM CLOSURE TIME (SEC.) (NOTE 1)	VALVE POSITION				
										NORMAL	SHUTDOWN	POWER FAILURE	POST ACCIDENT	
													PRIMARY	SECONDARY
EFHV0045	14/14	INSIDE	OUT	BUTTERFLY	MOTOR	1	SIS	REM/MAN	40	OPEN	OPEN	AS IS	OPEN	CLOSED
EFV0277	1/1	INSIDE	N/A	GATE	MANUAL	N/A	N/A	N/A	N/A	CLOSED	CLOSED	N/A	CLOSED	N/A
EFHV0047	10/10	OUTSIDE	OUT	BUTTERFLY	MOTOR	1	NONE	REM/MAN	30	OPEN	OPEN	AS IS	OPEN	CLOSED
EFHV0049	14/14	OUTSIDE	OUT	BUTTERFLY	MOTOR	1	SIS	REM/MAN	30	CLOSED	CLOSED	AS IS	OPEN	CLOSED

ENGINEERED SAFETY FEATURE SYSTEM YES NO

FLUID CONTAINED: WATER

LENGTH OF PIPING TO OUTERMOST ISOLATION VALVE: 13.3 FT

APPLICABLE GDC NO. 56

GENERAL COMMENTS:


THIS PENETRATION IS ASSOCIATED WITH THE ESSENTIAL SERVICE WATER SYSTEM, WHICH IS REQUIRED TO MITIGATE THE CONSEQUENCES OF A LOCA. A REMOTE-MANUAL POWER-OPERATED VALVE IS LOCATED INSIDE, AND A REMOTE-MANUAL POWER-OPERATED VALVE IS LOCATED OUTSIDE THE CONTAINMENT. THE SECOND ISOLATION VALVE OUTSIDE THE CONTAINMENT IS OPENED IN THE EVENT OF A DBA FOR SYSTEM SAFETY FUNCTIONS.

THESE VALVES ARE POWERED FROM THE SAME POWER SOURCE FOR GREATER SYSTEM RELIABILITY. A SINGLE ACTIVE OR PASSIVE FAILURE CAN BE ACCOMMODATED SINCE THE SYSTEM IS A CLOSED SYSTEM INSIDE THE CONTAINMENT, WHICH IS DESIGNED AND CONSTRUCTED IN ACCORDANCE WITH ASME SECTION III, CLASS 3 REQUIREMENTS. THE ESSENTIAL SERVICE WATER LINES ARE NOT VENTED OR DRAINED DURING A TYPE A TEST SINCE THE AIR COOLERS MAY BE REQUIRED TO COOL THE CONTAINMENT. A TYPE C TEST IS PERFORMED.

NOTE 1: MAXIMUM CLOSURE TIMES SPECIFIED IN THIS FIGURE ARE NOMINAL DESIGN OR LICENSING-BASIS VALUES. PERFORMANCE-BASED VALVE OPERABILITY LIMITS FOR VALVE CLOSURE TIMES ARE SPECIFIED PER THE INSERVICE TESTING PROGRAM FOR CALLAWAY.

APPENDIX J REQUIREMENT

- TYPE A
- B
- C
- NONE

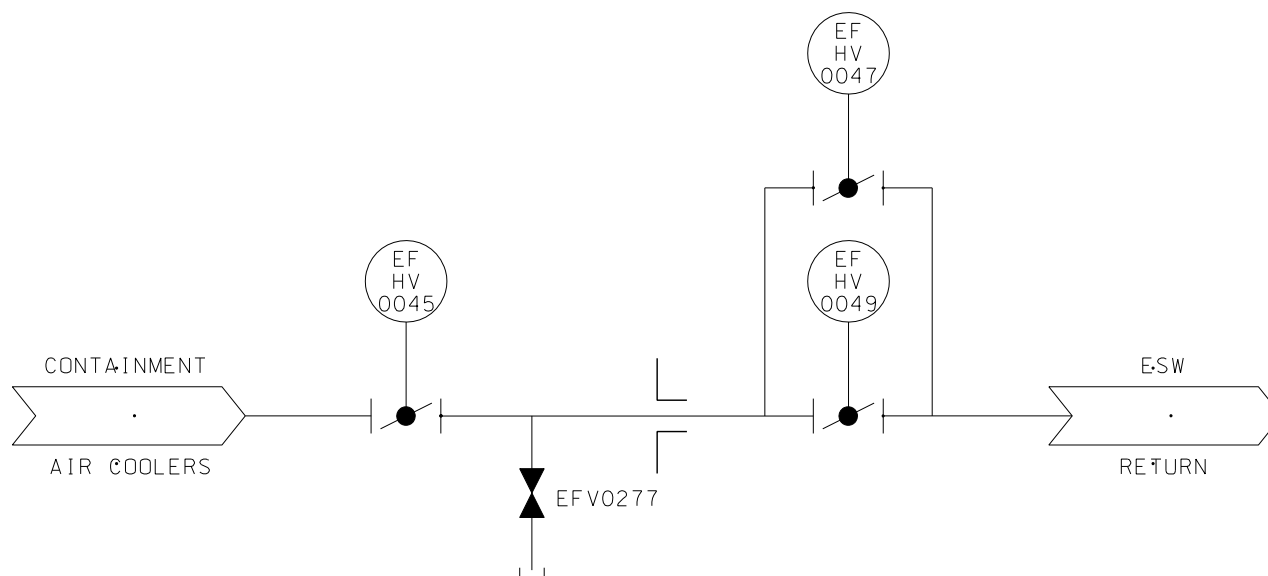

REFERENCE SECTION 9.2.1.2

CONTAINMENT PENETRATION NO. P-73
 DESCRIPTION:
 ESW FROM CONTAINMENT AIR COOLERS
 ESSENTIAL SERVICE WATER SYSTEM

CONTAINMENT PENETRATIONS
 FIGURE 6.2.4-1
 PAGE 57 OF 84
 REV. 11/3/08


VALVE NO.	LINE / VALVE SIZE, IN.	INSIDE / OUTSIDE CONT.	NORMAL FLOW DIRECTION	VALVE TYPE	VALVE OPERATOR	POWER SOURCE	PRIMARY ACTUATION SIGNAL	SECONDARY ACTUATION SIGNAL	MAXIMUM CLOSURE TIME (SEC.) (NOTE 1)	VALVE POSITION				
										NORMAL	SHUTDOWN	POWER FAILURE	POST ACCIDENT	
													PRIMARY	SECONDARY
EGHV0058	12/12	OUTSIDE	IN	GATE	MOTOR	1	CIS-B	NONE	30	OPEN	OPEN	AS IS	CLOSED	N/A
EGV0090	1/1	OUTSIDE	N/A	GLOBE	MANUAL	N/A	N/A	N/A	N/A	CLOSED	CLOSED	N/A	CLOSED	N/A
EGV0204	12/12	INSIDE	IN	CHECK	N/A	N/A	N/A	N/A	N/A	OPEN	OPEN	N/A	CLOSED	N/A
EGHV0127	12/12	OUTSIDE	IN	GATE	MOTOR	4	NONE	NONE	60	CLOSED	CLOSED	AS IS	CLOSED	N/A

ENGINEERED SAFETY FEATURE SYSTEM	YES <input type="checkbox"/> NO <input checked="" type="checkbox"/>
FLUID CONTAINED:	WATER
LENGTH OF PIPING TO OUTERMOST ISOLATION VALVE:	14.0 FT.
APPLICABLE GDC NO.	56

GENERAL COMMENTS:

ISOLATION SWITCH PROVIDED IN THE CONTROL ROOM FOR POWER LOCKOUT OF VALVE EGHV0127

NOTE 1: MAXIMUM CLOSURE TIMES SPECIFIED IN THIS FIGURE ARE NOMINAL DESIGN OR LICENSING-BASIS VALUES. PERFORMANCE-BASED VALVE OPERABILITY LIMITS FOR VALVE CLOSURE TIMES ARE SPECIFIED PER THE INSERVICE TESTING PROGRAM FOR CALLAWAY.

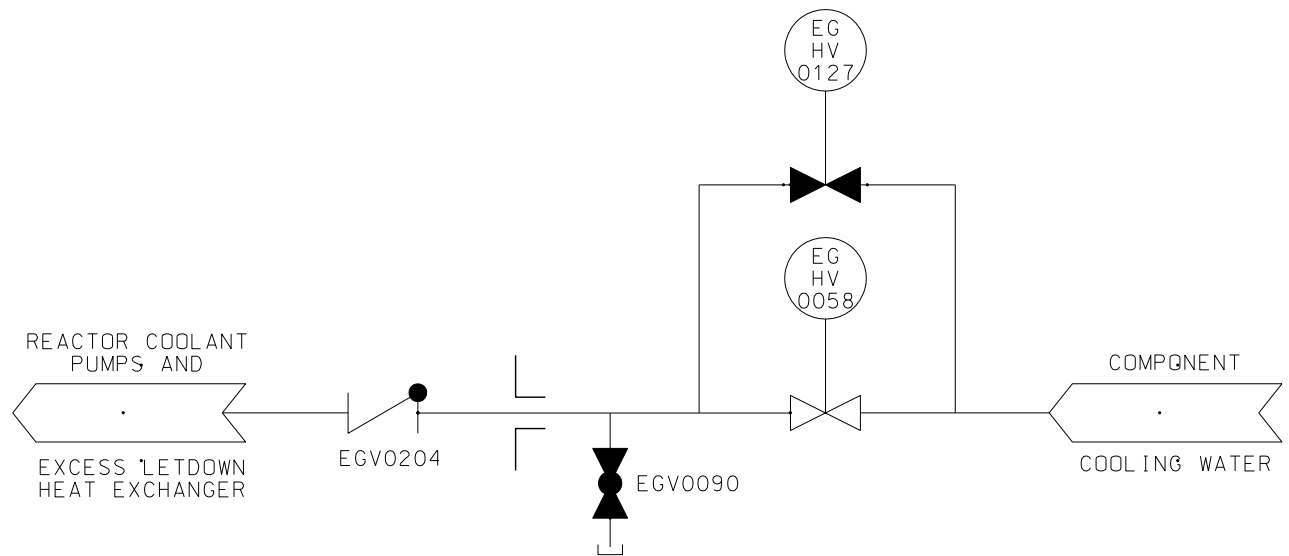

REFERENCE SECTION 9.2.2

CONTAINMENT PENETRATION NO. P-74
DESCRIPTION: CCW TO REACTOR COOLANT PUMPS COMPONENT COOLING WATER SYSTEM
CONTAINMENT PENETRATIONS FIGURE 6.2.4-1 PAGE 58 OF 84 REV. 16 8/16

APPENDIX J REQUIREMENT


- TYPE A
 B
 C
 NONE

VALVE NO.	LINE / VALVE SIZE, IN.	INSIDE / OUTSIDE CONT.	NORMAL FLOW DIRECTION	VALVE TYPE	VALVE OPERATOR	POWER SOURCE	PRIMARY ACTUATION SIGNAL	SECONDARY ACTUATION SIGNAL	MAXIMUM CLOSURE TIME (SEC.) (NOTE 1)	VALVE POSITION				
										NORMAL	SHUTDOWN	POWER FAILURE	POST ACCIDENT	
													PRIMARY	SECONDARY
EGHV0060	12/12	INSIDE	OUT	GATE	MOTOR	4	CIS-B	NONE	30	OPEN	OPEN	AS IS	CLOSED	N/A
EGV0372	1/1	OUTSIDE	N/A	GLOBE	MANUAL	N/A	NONE	N/A	N/A	CLOSED	CLOSED	N/A	CLOSED	N/A
EGHV0059	12/12	OUTSIDE	OUT	GATE	MOTOR	1	CIS-B	NONE	30	OPEN	OPEN	AS IS	CLOSED	N/A
EGHV0131	12/12	OUTSIDE	OUT	GATE	MOTOR	4	NONE	NONE	60	CLOSED	CLOSED	AS IS	CLOSED	N/A
EGHV0130	12/12	INSIDE	OUT	GATE	MOTOR	1	NONE	NONE	60	CLOSED	CLOSED	AS IS	CLOSED	N/A

ENGINEERED SAFETY FEATURE SYSTEM	YES <input type="checkbox"/> NO <input checked="" type="checkbox"/>
FLUID CONTAINED:	WATER
LENGTH OF PIPING TO OUTERMOST ISOLATION VALVE:	12.9 FT.
APPLICABLE GDC NO.	56

GENERAL COMMENTS:

ISOLATION SWITCH PROVIDED IN THE CONTROL ROOM FOR POWER LOCKOUT OF VALVES EGHV0130 AND EGHV0131.

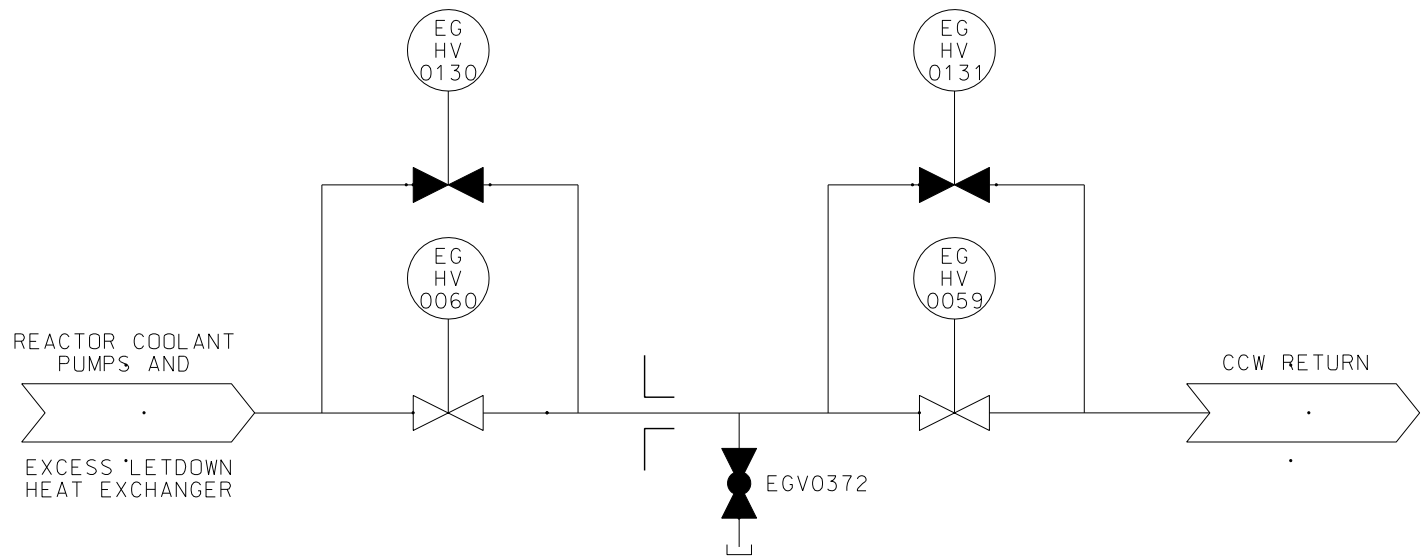

REFERENCE SECTION 9.2.2

CONTAINMENT PENETRATION NO. P-75
DESCRIPTION:
CCW RETURN
COMPONENT COOLING WATER SYSTEM
CONTAINMENT PENETRATIONS
FIGURE 6.2.4-1
PAGE 59 OF 84
REV. 15 3/08

APPENDIX J REQUIREMENT

- TYPE A
 B
 C
 NONE


VALVE NO.	LINE / VALVE SIZE, IN.	INSIDE / OUTSIDE CONT.	NORMAL FLOW DIRECTION	VALVE TYPE	VALVE OPERATOR	POWER SOURCE	PRIMARY ACTUATION SIGNAL	SECONDARY ACTUATION SIGNAL	MAXIMUM CLOSURE TIME (SEC.) (NOTE 1)	VALVE POSITION				
										NORMAL	SHUTDOWN	POWER FAILURE	POST ACCIDENT	
													PRIMARY	SECONDARY
EGHV0062	4/4	INSIDE	OUT	GATE	MOTOR	4	CIS-B	NONE	30	OPEN	OPEN	AS IS	CLOSED	N/A
EGV0371	1/1	OUTSIDE	N/A	GLOBE	MANUAL	N/A	N/A	N/A	N/A	CLOSED	CLOSED	N/A	CLOSED	N/A
EGHV0061	4/4	OUTSIDE	OUT	GATE	MOTOR	1	CIS-B	NONE	30	OPEN	OPEN	AS IS	CLOSED	N/A
EGHV0132	4/4	INSIDE	OUT	GATE	MOTOR	1	NONE	NONE	60	CLOSED	CLOSED	AS IS	CLOSED	N/A
EGHV0133	4/4	OUTSIDE	OUT	GATE	MOTOR	4	NONE	NONE	60	CLOSED	CLOSED	AS IS	CLOSED	N/A

ENGINEERED SAFETY FEATURE SYSTEM	YES <input type="checkbox"/> NO <input checked="" type="checkbox"/>
FLUID CONTAINED:	WATER
LENGTH OF PIPING TO OUTERMOST ISOLATION VALVE:	8.8 FT.
APPLICABLE GDC NO.	56

GENERAL COMMENTS:

ISOLATION SWITCH PROVIDED IN THE CONTROL ROOM FOR POWER LOCKOUT OF VALVES EGHV0132 AND EGHV0133.

NOTE 1: MAXIMUM CLOSURE TIMES SPECIFIED IN THIS FIGURE ARE NOMINAL DESIGN OR LICENSING-BASIS VALUES. PERFORMANCE-BASED VALVE OPERABILITY LIMITS FOR VALVE CLOSURE TIMES ARE SPECIFIED PER THE INSERVICE TESTING PROGRAM FOR CALLAWAY.

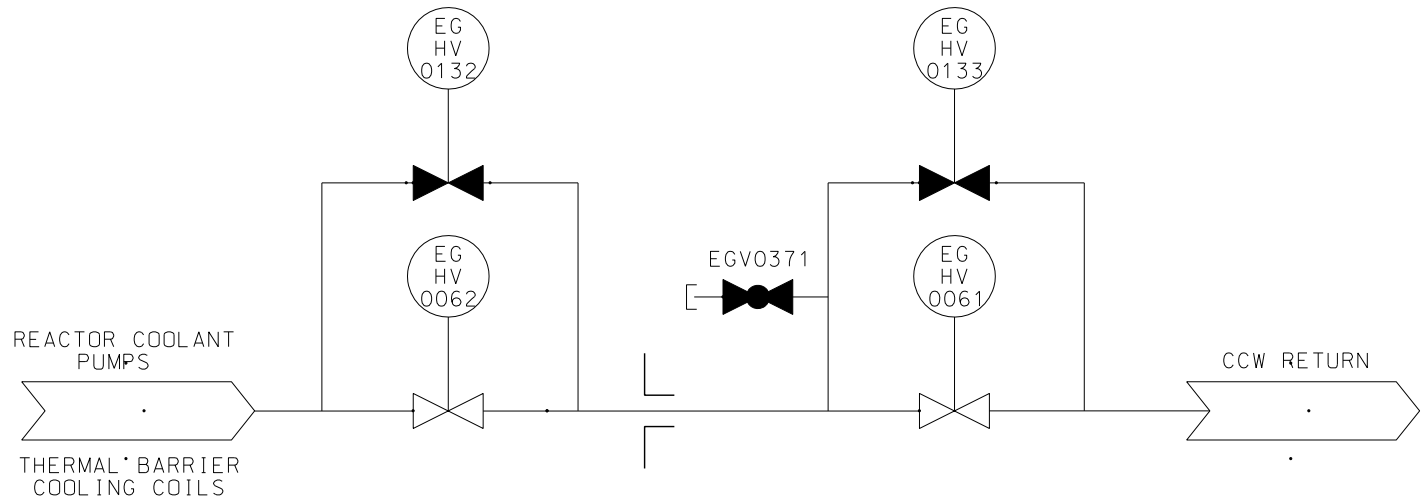

REFERENCE SECTION 9.2.2

CONTAINMENT PENETRATION NO. P-76
 DESCRIPTION:
 CCW FROM RCP THERMAL BARRIER COOLING COIL
 COMPONENT COOLING WATER SYSTEM

CONTAINMENT PENETRATIONS
 FIGURE 6.2.4-1
 PAGE 60 OF 84
 REV. 16 8/16

APPENDIX J REQUIREMENT


TYPE A
 B
 C
 NONE

VALVE NO.	LINE / VALVE SIZE, IN.	INSIDE / OUTSIDE CONT.	NORMAL FLOW DIRECTION	VALVE TYPE	VALVE OPERATOR	POWER SOURCE	PRIMARY ACTUATION SIGNAL	SECONDARY ACTUATION SIGNAL	MAXIMUM CLOSURE TIME (SEC.) (NOTE 1)	VALVE POSITION				
										NORMAL	SHUTDOWN	POWER FAILURE	POST ACCIDENT	
													PRIMARY	SECONDARY
BMV0045	3/3	INSIDE	OUT	GATE	MANUAL	N/A	N/A	N/A	N/A	CLOSED	CLOSED	N/A	CLOSED	N/A
BMV0302	1/1	OUTSIDE	N/A	GLOBE	MANUAL	N/A	N/A	N/A	N/A	CLOSED	CLOSED	N/A	CLOSED	N/A
BMV0046	3/3	OUTSIDE	OUT	GATE	MANUAL	N/A	N/A	N/A	N/A	CLOSED	CLOSED	N/A	CLOSED	N/A

ENGINEERED SAFETY FEATURE SYSTEM	YES <input type="checkbox"/> NO <input checked="" type="checkbox"/>
FLUID CONTAINED:	WATER
LENGTH OF PIPING TO OUTERMOST ISOLATION VALVE:	8.3 FT.
APPLICABLE GDC NO.	56

GENERAL COMMENTS:
 ALTHOUGH THE LINE PENETRATING CONTAINMENT VIA P-78 IS CONNECTED TO THE STEAM GENERATORS (AS A COMMON HEADER FOR THE STEAM GENERATOR DRAIN LINES). GDC 56 IS APPLICABLE TO THIS PENETRATION BECAUSE THE PIPING IMMEDIATELY UPSTREAM OF CONTAINMENT ISOLATION VALVE BMV0045 IS NOT ASME CLASS 2 PIPING.

NOTE 1: MAXIMUM CLOSURE TIMES SPECIFIED IN THIS FIGURE ARE NOMINAL DESIGN OR LICENSING-BASIS VALUES. PERFORMANCE-BASED VALVE OPERABILITY LIMITS FOR VALVE CLOSURE TIMES ARE SPECIFIED PER THE INSERVICE TESTING PROGRAM FOR CALLAWAY.

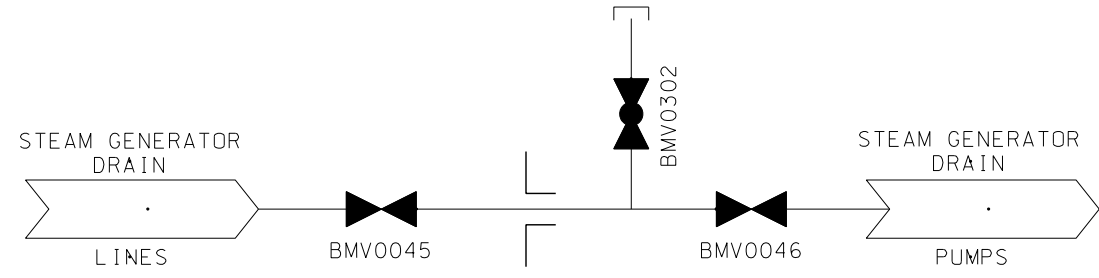

REFERENCE SECTION 10.4.8

CONTAINMENT PENETRATION NO. P-78
DESCRIPTION: STEAM GENERATOR DRAIN LINES STEAM GENERATOR BLOWDOWN SYSTEM
CONTAINMENT PENETRATIONS FIGURE 6.2.4-1 PAGE 61 OF 84 REV. 17 3/08

APPENDIX J REQUIREMENT

TYPE A
 B
 C
 NONE


VALVE NO.	LINE/VALVE SIZE, IN.	INSIDE/OUTSIDE CONT.	NORMAL FLOW DIRECTION	VALVE TYPE	VALVE OPERATOR	POWER SOURCE	PRIMARY ACTUATION SIGNAL	SECONDARY ACTUATION SIGNAL	MAXIMUM CLOSURE TIME (SEC.) (NOTE 1)	VALVE POSITION				
										NORMAL	SHUTDOWN	POWER FAILURE	POST ACCIDENT	
													PRIMARY	SECONDARY
EJHV8701A	12/12	INSIDE	OUT	GATE	MOTOR	1	REM/MAN	NONE	120	CLOSED	OPEN	AS IS	CLOSED	N/A
EJ8708A	3/3	INSIDE	N/A	RELIEF	N/A	N/A	N/A	N/A	N/A	CLOSED	CLOSED	N/A	CLOSED	N/A
EJV0154	3/4 / 3/4	INSIDE	N/A	GLOBE	MANUAL	N/A	N/A	N/A	N/A	CLOSED	CLOSED	N/A	CLOSED	N/A

ENGINEERED SAFETY FEATURE SYSTEM	YES <input checked="" type="checkbox"/> NO <input type="checkbox"/>
FLUID CONTAINED:	WATER
LENGTH OF PIPING TO OUTERMOST ISOLATION VALVE:	N/A
APPLICABLE GDC NO.	55

GENERAL COMMENTS:
 THE RESIDUAL HEAT REMOVAL SYSTEM SUCTION LINE FROM THE REACTOR COOLANT SYSTEM CONTAINS TWO NORMALLY CLOSED, POWER-OPERATED REMOTE MANUAL VALVES IN SERIES INSIDE THE CONTAINMENT (I.E., EJHV8701A AND EJ8708A). THESE VALVES ARE INTERLOCKED TO PREVENT THEM FROM BEING INADVERTENTLY OPENED. CONTAINMENT ISOLATION IS ASSURED BY SYSTEM ISOLATION VALVES CLOSEST TO THE CONTAINMENT (I.E., EJHV8701A AND EJ8708) IN CONJUNCTION WITH THE CLOSED SYSTEM OUTSIDE THE CONTAINMENT, WHICH IS DESIGNED AND CONSTRUCTED COMMENSURATE WITH THE DESIGN AND CONSTRUCTION OF THE CONTAINMENT. LEAKAGE DETECTION FROM THIS LINE OUTSIDE THE CONTAINMENT IS PROVIDED, AS DESCRIBED IN SECTION 9.3.3.

LOCAL TESTING OF THE CLOSED SYSTEM OUTSIDE THE CONTAINMENT IS NOT REQUIRED SINCE THE SYSTEM IS OPERATED AND INSPECTED DURING NORMAL PLANT OPERATION TO ASSURE THAT THE INTEGRITY IS BEING MAINTAINED.

NOTE 1: MAXIMUM CLOSURE TIMES SPECIFIED IN THIS FIGURE ARE NOMINAL DESIGN OR LICENSING-BASIS VALUES. PERFORMANCE-BASED VALVE OPERABILITY LIMITS FOR VALVE CLOSURE TIMES ARE SPECIFIED PER THE INSERVICE TESTING PROGRAM FOR CALLAWAY.

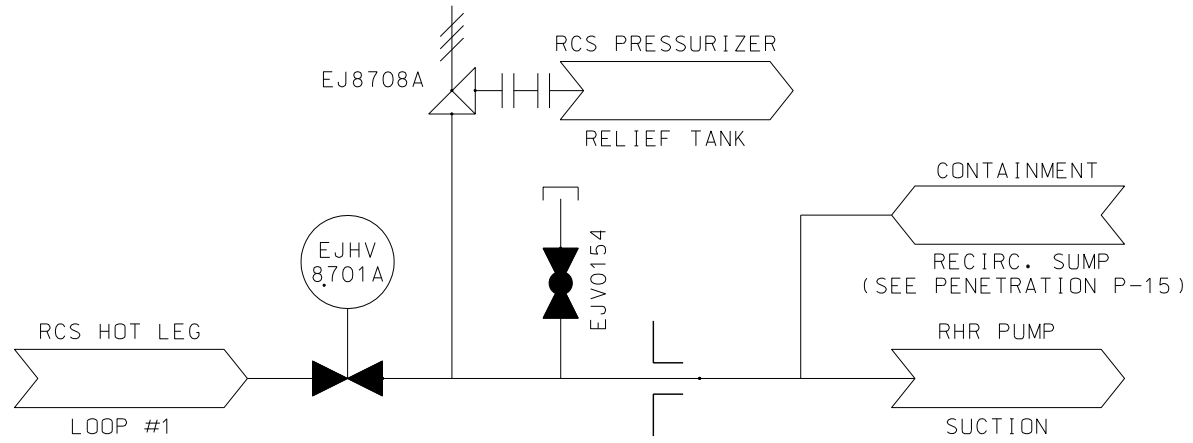

REFERENCE SECTIONS 5.4.7 AND 6.3

CONTAINMENT PENETRATION NO. P-79 DESCRIPTION: RHR SHUTDOWN LINES RESIDUAL HEAT REMOVAL SYSTEM
CONTAINMENT PENETRATIONS FIGURE 6.2.4-1 PAGE 62 OF 84 REV. 13 8/16

APPENDIX J REQUIREMENT

- TYPE A
- B
- C
- NONE


VALVE NO.	LINE / VALVE SIZE, IN.	INSIDE / OUTSIDE CONT.	NORMAL FLOW DIRECTION	VALVE TYPE	VALVE OPERATOR	POWER SOURCE	PRIMARY ACTUATION SIGNAL	SECONDARY ACTUATION SIGNAL	MAXIMUM CLOSURE TIME (SEC.) (NOTE 1)	VALVE POSITION				
										NORMAL	SHUTDOWN	POWER FAILURE	POST ACCIDENT	
													PRIMARY	SECONDARY
BGHV8105	3/3	OUTSIDE	IN	GATE	MOTOR	4	SIS	NONE	15	OPEN	OPEN	AS IS	CLOSED	N/A
BGV0342	1/1	INSIDE	N/A	GLOBE	MANUAL	N/A	N/A	N/A	N/A	CLOSED	CLOSED	N/A	CLOSED	N/A
BG8381	3/3	INSIDE	IN	CHECK	N/A	N/A	N/A	N/A	N/A	OPEN	OPEN	N/A	CLOSED	N/A

ENGINEERED SAFETY FEATURE SYSTEM	YES <input type="checkbox"/> NO <input checked="" type="checkbox"/>
FLUID CONTAINED:	WATER
LENGTH OF PIPING TO OUTERMOST ISOLATION VALVE:	17.6 FT.
APPLICABLE GDC NO.	55

GENERAL COMMENTS:

NONE

NOTE 1: MAXIMUM CLOSURE TIMES SPECIFIED IN THIS FIGURE ARE NOMINAL DESIGN OR LICENSING-BASIS VALUES. PERFORMANCE-BASED VALVE OPERABILITY LIMITS FOR VALVE CLOSURE TIMES ARE SPECIFIED PER THE INSERVICE TESTING PROGRAM FOR CALLAWAY.

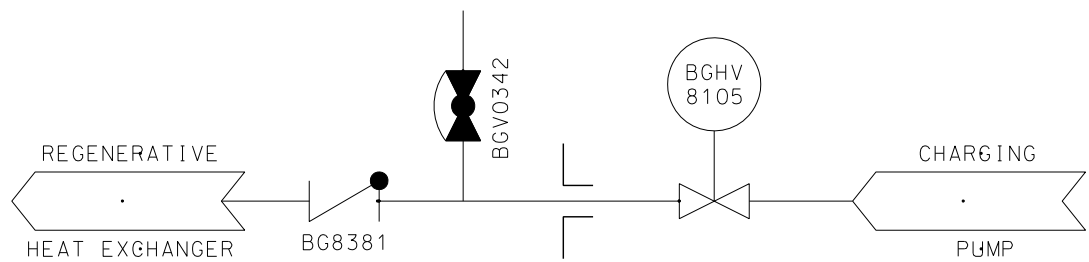

REFERENCE SECTION 9.3.4

CONTAINMENT PENETRATION NO. P-80 DESCRIPTION: CHARGING LINE CHEMICAL AND VOLUME CONTROL SYSTEM
CONTAINMENT PENETRATIONS FIGURE 6.2.4-1 PAGE 63 OF 84 REV. 15 3/08

APPENDIX J REQUIREMENT

- TYPE A
- B
- C
- NONE

VALVE NO.	LINE/ VALVE SIZE, IN.	INSIDE/ OUTSIDE CONT.	NORMAL FLOW DIRECTION	VALVE TYPE	VALVE OPERATOR	POWER SOURCE	PRIMARY ACTUATION SIGNAL	SECONDARY ACTUATION SIGNAL	MAXIMUM CLOSURE TIME (SEC.) (NOTE 1)	VALVE POSITION				
										NORMAL	SHUTDOWN	POWER FAILURE	POST ACCIDENT	
													PRIMARY	SECONDARY
EJHV8809A	10/10	OUTSIDE	IN	GATE	MOTOR	1	NONE	REM/MAN	15	OPEN	OPEN	AS IS	OPEN	CLOSED
EJV0054	1/1	OUTSIDE	N/A	GLOBE	MANUAL	N/A	N/A	N/A	N/A	CLOSED	CLOSED	N/A	CLOSED	N/A
EP8818A	6/6	INSIDE	IN	CHECK	N/A	N/A	N/A	N/A	N/A	CLOSED	OPEN	N/A	OPEN	CLOSED
EP8818B	6/6	INSIDE	IN	CHECK	N/A	N/A	N/A	N/A	N/A	CLOSED	OPEN	N/A	OPEN	CLOSED
EJHCV8890A	3/4 / 3/4	INSIDE	OUT	GLOBE	AIR	1	CIS-A	NONE	13	CLOSED	CLOSED	CLOSED	CLOSED	N/A
EJV0134	3/4 / 3/4	INSIDE	N/A	GLOBE	MANUAL	N/A	N/A	N/A	N/A	CLOSED	CLOSED	N/A	CLOSED	N/A
EJV0136	3/4 / 3/4	INSIDE	N/A	GLOBE	MANUAL	N/A	N/A	N/A	N/A	CLOSED	CLOSED	N/A	CLOSED	N/A
EJV0132	1/1	INSIDE	N/A	GLOBE	MANUAL	N/A	N/A	N/A	N/A	CLOSED	CLOSED	N/A	CLOSED	N/A

ENGINEERED SAFETY FEATURE SYSTEM YES NO

FLUID CONTAINED: WATER

LENGTH OF PIPING TO OUTERMOST ISOLATION VALVE: 18.7 FT

APPLICABLE GDC NO. 55


GENERAL COMMENTS:
 THIS PENETRATION IS ASSOCIATED WITH THE HIGH PRESSURE COOLANT INJECTION SYSTEM, WHICH IS REQUIRED TO MITIGATE THE CONSEQUENCES OF A LOCA. A CHECK VALVE IS PROVIDED FOR EACH BRANCH LINE INSIDE THE CONTAINMENT, AND A REMOTE-MANUAL ISOLATION VALVE IS PROVIDED OUTSIDE THE CONTAINMENT. A SINGLE ACTIVE OR PASSIVE FAILURE CAN BE ACCOMMODATED SINCE THE SYSTEM IS CLOSED OUTSIDE THE CONTAINMENT AND IS DESIGNED AND CONSTRUCTED COMMENSURATE WITH THE DESIGN AND CONSTRUCTION OF THE CONTAINMENT. LEAKAGE DETECTION FROM THIS LINE OUTSIDE THE CONTAINMENT IS PROVIDED, AS DESCRIBED IN SECTION 9.3.3.

LOCAL TESTING OF THE VALVES OR THE CLOSED SYSTEM OUTSIDE THE CONTAINMENT IS NOT REQUIRED SINCE THE SYSTEM IS OPERATED AND INSPECTED DURING NORMAL PLANT OPERATION TO ASSURE THAT THE INTEGRITY IS BEING MAINTAINED.

NOTE 1: MAXIMUM CLOSURE TIMES SPECIFIED IN THIS FIGURE ARE NOMINAL DESIGN OR LICENSING-BASIS VALUES. PERFORMANCE-BASED VALVE OPERABILITY LIMITS FOR VALVE CLOSURE TIMES ARE SPECIFIED PER THE INSERVICE TESTING PROGRAM FOR CALLAWAY.

APPENDIX J REQUIREMENT

- TYPE A
 B
 C
 NONE

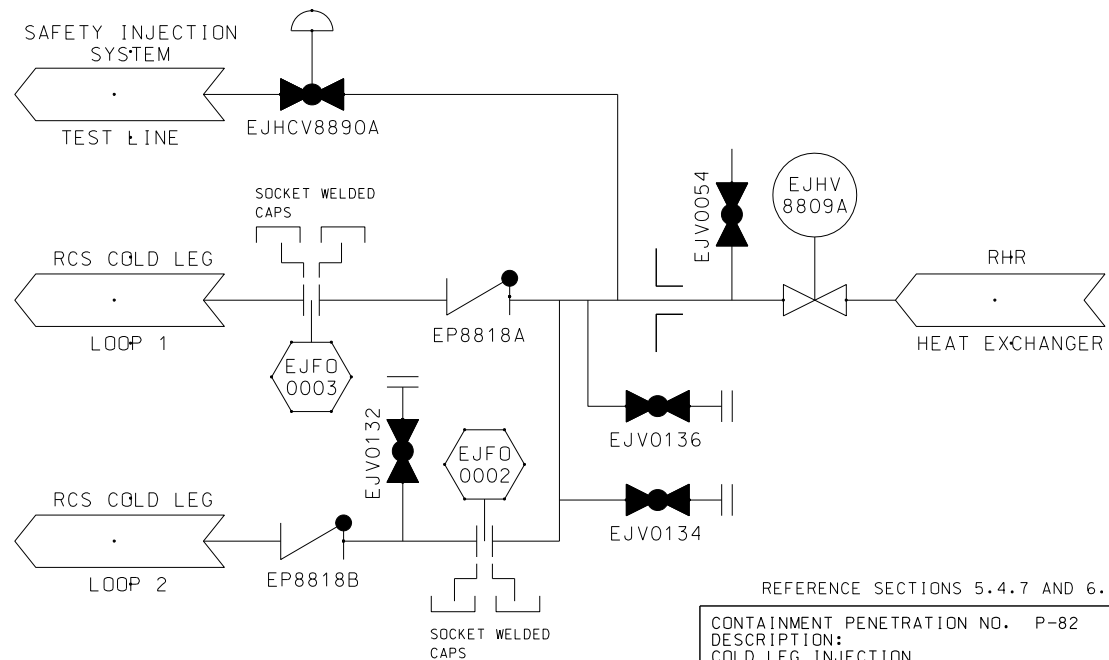

REFERENCE SECTIONS 5.4.7 AND 6.3

CONTAINMENT PENETRATION NO. P-82
 DESCRIPTION:
 COLD LEG INJECTION
 RESIDUAL HEAT REMOVAL SYSTEM

CONTAINMENT PENETRATIONS
 FIGURE 6.2.4-1
 PAGE 64 OF 84
 REV. 17 8/16


VALVE NO.	LINE/VALVE SIZE, IN.	INSIDE/OUTSIDE CONT.	NORMAL FLOW DIRECTION	VALVE TYPE	VALVE OPERATOR	POWER SOURCE	PRIMARY ACTUATION SIGNAL	SECONDARY ACTUATION SIGNAL	MAXIMUM CLOSURE TIME (SEC.) (NOTE 1)	VALVE POSITION				
										NORMAL	SHUTDOWN	POWER FAILURE	POST ACCIDENT	
													PRIMARY	SECONDARY
BMHV0022	3/8, 3/4 /1	INSIDE	OUT	GLOBE	SOLENOID	4	SGBSIS (AFAS)	REM/MAN	5	CLOSED	CLOSED	CLOSED	CLOSED	OPEN
BMHV0038	3/8, 3/4 /1	INSIDE	OUT	GLOBE	SOLENOID	4	SGBSIS (AFAS)	REM/MAN	5	OPEN	OPEN	CLOSED	CLOSED	OPEN
BMHV0068	3/4, 1/1	OUTSIDE	OUT	GLOBE	SOLENOID	1	SGBSIS (AFAS)	REM/MAN	5	OPEN	OPEN	CLOSED	CLOSED	OPEN
BMV0539	3/4 /3/4	OUTSIDE	N/A	GLOBE	MANUAL	N/A	N/A	N/A	N/A	CLOSED	CLOSED	N/A	CLOSED	N/A

ENGINEERED SAFETY FEATURE SYSTEM	YES <input checked="" type="checkbox"/> NO <input type="checkbox"/>
FLUID CONTAINED:	WATER
LENGTH OF PIPING TO OUTERMOST ISOLATION VALVE:	15.6 FT
APPLICABLE GDC NO.	NONE

GENERAL COMMENTS:
 THE CONTAINMENT PENETRATIONS ASSOCIATED WITH THE STEAM GENERATORS ARE NOT SUBJECT TO GDC-57, SINCE THE CONTAINMENT BARRIER INTEGRITY IS NOT BREACHED. THE BOUNDARY OR BARRIER AGAINST FISSION PRODUCT LEAKAGE TO THE ENVIRONMENT IS THE INSIDE OF THE STEAM GENERATOR TUBES AND THE OUTSIDE OF THE LINES EMANATING FROM THE STEAM GENERATOR SHELLS.

THE PENETRATION CONFIGURATION IS PRESENTED FOR FIGURE 6.2.4-1 COMPLETENESS. NONE OF THE VALVES SHOWN ARE CONTAINMENT ISOLATION VALVES.

NOTE 1: MAXIMUM CLOSURE TIMES SPECIFIED IN THIS FIGURE ARE NOMINAL. DESIGN OR LICENSING-BASIS VALUES. PERFORMANCE-BASED VALVE OPERABILITY LIMITS FOR VALVE CLOSURE TIMES ARE SPECIFIED PER THE INSERVICE TESTING PROGRAM FOR CALLAWAY.

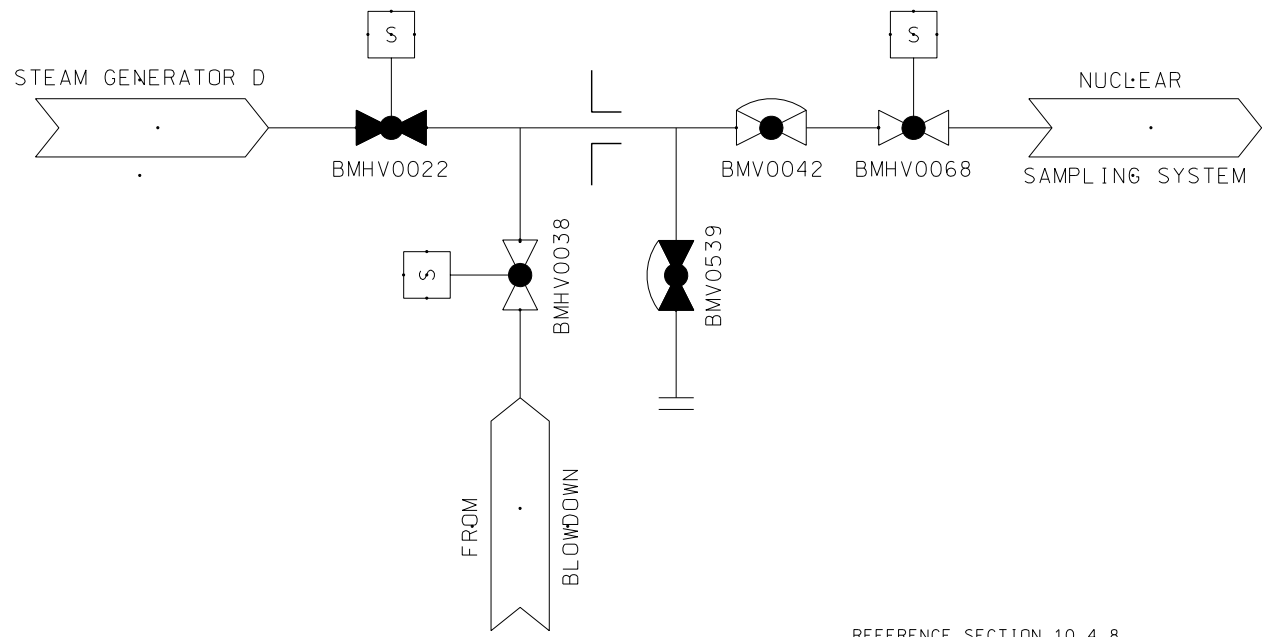

REFERENCE SECTION 10.4.8

CONTAINMENT PENETRATION NO. P-83
DESCRIPTION: STEAM GENERATOR D SAMPLE LINE STEAM GENERATOR BLOWDOWN SYSTEM
CONTAINMENT PENETRATIONS FIGURE 6.2.4-1 PAGE 65 OF 84 REV. 12 8/16

APPENDIX J REQUIREMENT

TYPE A
 B
 C
 NONE

VALVE NO.	LINE/ VALVE SIZE, IN.	INSIDE/ OUTSIDE CONT.	NORMAL FLOW DIRECTION	VALVE TYPE	VALVE OPERATOR	POWER SOURCE	PRIMARY ACTUATION SIGNAL	SECONDARY ACTUATION SIGNAL	MAXIMUM CLOSURE TIME (SEC.) (NOTE 1)	VALVE POSITION				
										NORMAL	SHUTDOWN	POWER FAILURE	POST ACCIDENT	
													PRIMARY	SECONDARY
BMHV0019	3/8 , 3/4 /1	INSIDE	OUT	GLOBE	SOLENOID	4	SGBSIS (AFAS)	REM/MAN	5	CLOSED	CLOSED	CLOSED	CLOSED	OPEN
BMHV0035	3/8 , 3/4 /1	INSIDE	OUT	GLOBE	SOLENOID	4	SGBSIS (AFAS)	REM/MAN	5	OPEN	OPEN	CLOSED	CLOSED	OPEN
BMHV0065	3/4 , 1/1	OUTSIDE	OUT	GLOBE	SOLENOID	1	SGBSIS (AFAS)	REM/MAN	5	OPEN	OPEN	CLOSED	CLOSED	OPEN
BMV0535	3/4 /3/4	OUTSIDE	N/A	GLOBE	MANUAL	N/A	N/A	N/A	N/A	CLOSED	CLOSED	N/A	CLOSED	N/A


ENGINEERED SAFETY FEATURE SYSTEM	YES <input checked="" type="checkbox"/> NO <input type="checkbox"/>
FLUID CONTAINED:	WATER
LENGTH OF PIPING TO OUTERMOST ISOLATION VALVE:	15.9 FT
APPLICABLE GDC NO.	NONE

GENERAL COMMENTS:

THE CONTAINMENT PENETRATIONS ASSOCIATED WITH THE STEAM GENERATORS ARE NOT SUBJECT TO GDC-57, SINCE THE CONTAINMENT BARRIER INTEGRITY IS NOT BREACHED. THE BOUNDARY OR BARRIER AGAINST FISSION PRODUCT LEAKAGE TO THE ENVIRONMENT IS THE INSIDE OF THE STEAM GENERATOR TUBES AND THE OUTSIDE OF THE LINES EMANATING FROM THE STEAM GENERATOR SHELLS.

THE PENETRATION CONFIGURATION IS PRESENTED FOR FIGURE 6.2.4-1 COMPLETENESS. NONE OF THE VALVES SHOWN ARE CONTAINMENT ISOLATION VALVES.

NOTE 1: MAXIMUM CLOSURE TIMES SPECIFIED IN THIS FIGURE ARE NOMINAL DESIGN OR LICENSING-BASIS VALUES. PERFORMANCE-BASED VALVE OPERABILITY LIMITS FOR VALVE CLOSURE TIMES ARE SPECIFIED PER THE INSERVICE TESTING PROGRAM FOR CALLAWAY.

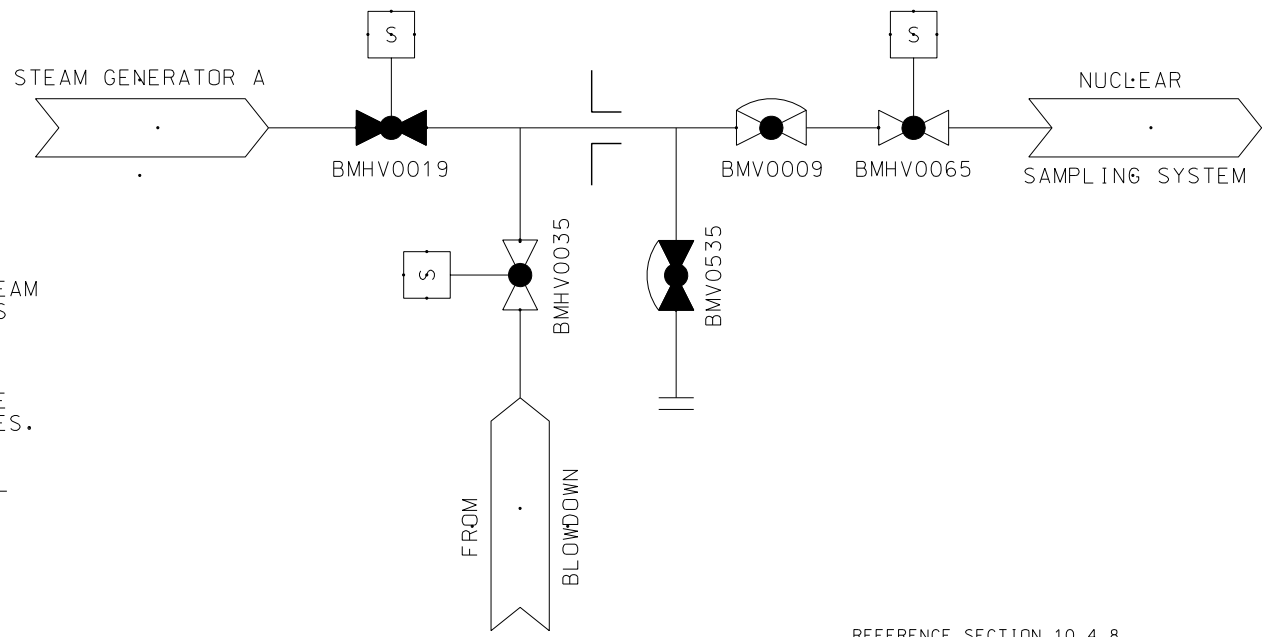

REFERENCE SECTION 10.4.8

CONTAINMENT PENETRATION NO. P-84
DESCRIPTION: STEAM GENERATOR A SAMPLE LINE STEAM GENERATOR BLOWDOWN SYSTEM
CONTAINMENT PENETRATIONS FIGURE 6.2.4-1 PAGE 66 OF 84 REV. 12 8/16

APPENDIX J REQUIREMENT

TYPE A
 B
 C
 NONE


VALVE NO.	LINE/VALVE SIZE, IN.	INSIDE/OUTSIDE CONT.	NORMAL FLOW DIRECTION	VALVE TYPE	VALVE OPERATOR	POWER SOURCE	PRIMARY ACTUATION SIGNAL	SECONDARY ACTUATION SIGNAL	MAXIMUM CLOSURE TIME (SEC.) (NOTE 1)	VALVE POSITION				
										NORMAL	SHUTDOWN	POWER FAILURE	POST ACCIDENT	
													PRIMARY	SECONDARY
BMHV0020	3/8, 3/4 /1	INSIDE	OUT	GLOBE	SOLENOID	4	SGBSIS (AFAS)	REM/MAN	5	CLOSED	CLOSED	CLOSED	CLOSED	OPEN
BMHV0036	3/8, 3/4 /1	INSIDE	OUT	GLOBE	SOLENOID	4	SGBSIS (AFAS)	REM/MAN	5	OPEN	OPEN	CLOSED	CLOSED	OPEN
BMHV0066	3/4, 1/1	OUTSIDE	OUT	GLOBE	SOLENOID	1	SGBSIS (AFAS)	REM/MAN	5	OPEN	OPEN	CLOSED	CLOSED	OPEN
BMV0542	3/4, 3/4	OUTSIDE	N/A	GLOBE	MANUAL	N/A	N/A	N/A	N/A	CLOSED	CLOSED	N/A	CLOSED	N/A

ENGINEERED SAFETY FEATURE SYSTEM	YES <input checked="" type="checkbox"/> NO <input type="checkbox"/>
FLUID CONTAINED:	WATER
LENGTH OF PIPING TO OUTERMOST ISOLATION VALVE:	15.9 FT
APPLICABLE GDC NO.	NONE

GENERAL COMMENTS:
 THE CONTAINMENT PENETRATIONS ASSOCIATED WITH THE STEAM GENERATORS ARE NOT SUBJECT TO GDC-57, SINCE THE CONTAINMENT BARRIER INTEGRITY IS NOT BREACHED. THE BOUNDARY OR BARRIER AGAINST FISSION PRODUCT LEAKAGE TO THE ENVIRONMENT IS THE INSIDE OF THE STEAM GENERATOR TUBES AND THE OUTSIDE OF THE LINES EMANATING FROM THE STEAM GENERATOR SHELLS.

THE PENETRATION CONFIGURATION IS PRESENTED FOR FIGURE 6.2.4-1 COMPLETENESS. NONE OF THE VALVES SHOWN ARE CONTAINMENT ISOLATION VALVES.

NOTE 1: MAXIMUM CLOSURE TIMES SPECIFIED IN THIS FIGURE ARE NOMINAL DESIGN OR LICENSING-BASIS VALUES. PERFORMANCE-BASED VALVE OPERABILITY LIMITS FOR VALVE CLOSURE TIMES ARE SPECIFIED PER THE INSERVICE TESTING PROGRAM FOR CALLAWAY.

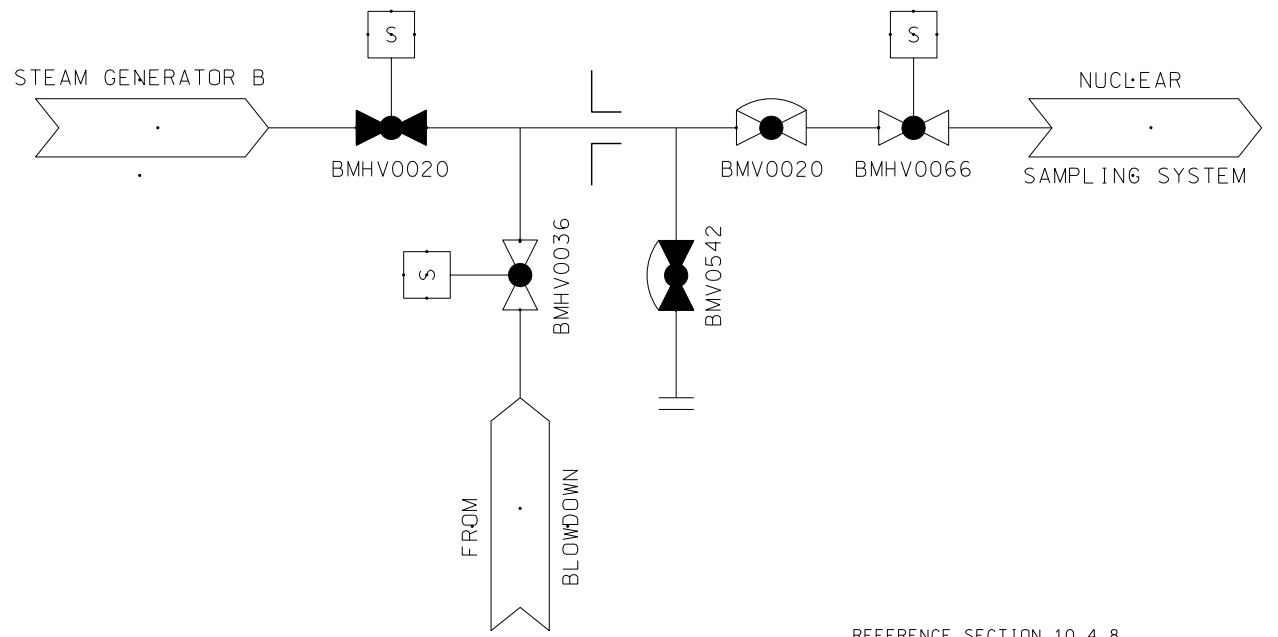

REFERENCE SECTION 10.4.8

CONTAINMENT PENETRATION NO. P-85
DESCRIPTION: STEAM GENERATOR B SAMPLE LINE STEAM GENERATOR BLOWDOWN SYSTEM
CONTAINMENT PENETRATIONS FIGURE 6.2.4-1 PAGE 67 OF 84 REV. 12 8/16

APPENDIX J REQUIREMENT

TYPE A
 B
 C
 NONE

VALVE NO.	LINE/VALVE SIZE, IN.	INSIDE/OUTSIDE CONT.	NORMAL FLOW DIRECTION	VALVE TYPE	VALVE OPERATOR	POWER SOURCE	PRIMARY ACTUATION SIGNAL	SECONDARY ACTUATION SIGNAL	MAXIMUM CLOSURE TIME (SEC.) (NOTE 1)	VALVE POSITION				
										NORMAL	SHUTDOWN	POWER FAILURE	POST ACCIDENT	
													PRIMARY	SECONDARY
BMHV0021	3/8, 3/4 /1	INSIDE	OUT	GLOBE	SOLENOID	4	SGBSIS (AFAS)	REM/MAN	5	CLOSED	CLOSED	CLOSED	CLOSED	OPEN
BMHV0037	3/8, 3/4 /1	INSIDE	OUT	GLOBE	SOLENOID	4	SGBSIS (AFAS)	REM/MAN	5	OPEN	OPEN	CLOSED	CLOSED	OPEN
BMHV0067	3/4, 1/1	OUTSIDE	OUT	GLOBE	SOLENOID	1	SGBSIS (AFAS)	REM/MAN	5	OPEN	OPEN	CLOSED	CLOSED	OPEN
BMV0537	3/4, 3/4	OUTSIDE	N/A	GLOBE	MANUAL	N/A	N/A	N/A	N/A	CLOSED	CLOSED	N/A	CLOSED	N/A

ENGINEERED SAFETY FEATURE SYSTEM YES NO

FLUID CONTAINED: WATER


LENGTH OF PIPING TO OUTERMOST ISOLATION VALVE: 15.9 FT

APPLICABLE GDC NO. NONE

GENERAL COMMENTS:
 THE CONTAINMENT PENETRATIONS ASSOCIATED WITH THE STEAM GENERATORS ARE NOT SUBJECT TO GDC-57, SINCE THE CONTAINMENT BARRIER INTEGRITY IS NOT BREACHED. THE BOUNDARY OR BARRIER AGAINST FISSION PRODUCT LEAKAGE TO THE ENVIRONMENT IS THE INSIDE OF THE STEAM GENERATOR TUBES AND THE OUTSIDE OF THE LINES EMANATING FROM THE STEAM GENERATOR SHELLS.

THE PENETRATION CONFIGURATION IS PRESENTED FOR FIGURE 6.2.4-1 COMPLETENESS. NONE OF THE VALVES SHOWN ARE CONTAINMENT ISOLATION VALVES.

NOTE 1: MAXIMUM CLOSURE TIMES SPECIFIED IN THIS FIGURE ARE NOMINAL DESIGN OR LICENSING-BASIS VALUES. PERFORMANCE-BASED VALVE OPERABILITY LIMITS FOR VALVE CLOSURE TIMES ARE SPECIFIED PER THE INSERVICE TESTING PROGRAM FOR CALLAWAY.

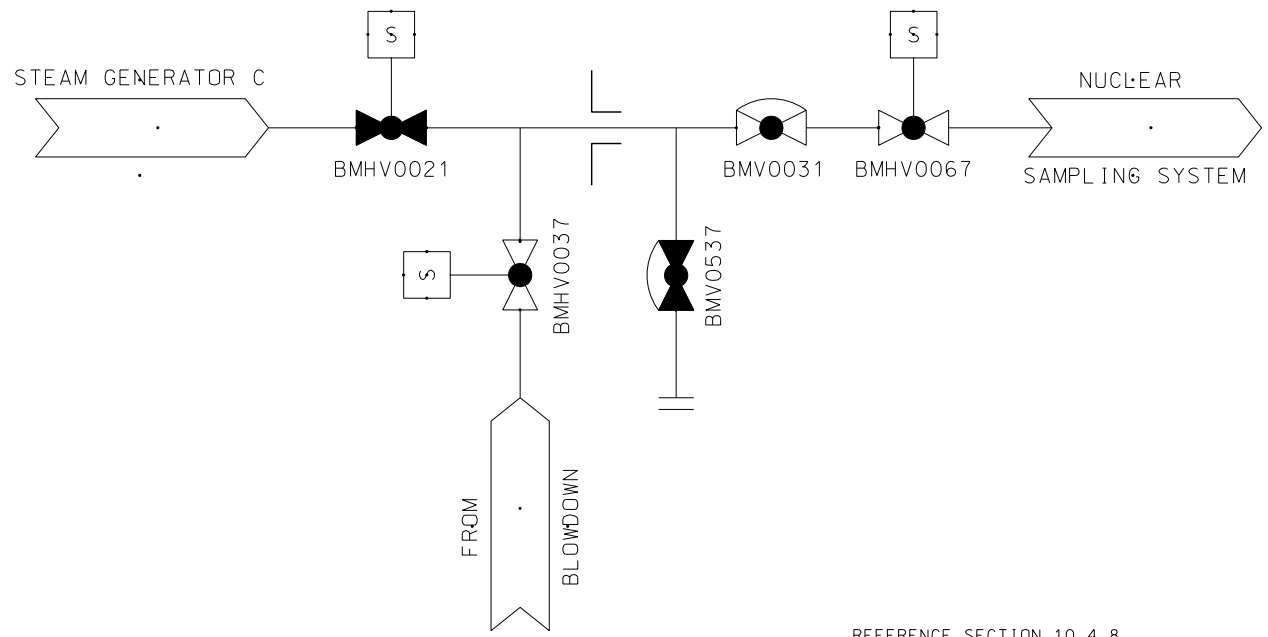

APPENDIX J REQUIREMENT
 TYPE A
 B
 C
 NONE

REFERENCE SECTION 10.4.8

CONTAINMENT PENETRATION NO. P-86
 DESCRIPTION:
 STEAM GENERATOR C SAMPLE LINE
 STEAM GENERATOR BLOWDOWN SYSTEM

CONTAINMENT PENETRATIONS
 FIGURE 6.2.4-1
 PAGE 68 OF 84
 REV. 12 8/16

VALVE NO.	LINE/ VALVE SIZE, IN.	INSIDE/ OUTSIDE CONT.	NORMAL FLOW DIRECTION	VALVE TYPE	VALVE OPERATOR	POWER SOURCE	PRIMARY ACTUATION SIGNAL	SECONDARY ACTUATION SIGNAL	MAXIMUM CLOSURE TIME (SEC.) (NOTE 1)	VALVE POSITION				
										NORMAL	SHUTDOWN	POWER FAILURE	POST ACCIDENT	
													PRIMARY	SECONDARY
EMHV8802A	4/4	OUTSIDE	IN	GATE	MOTOR	1	NONE	REM/MAN	10	CLOSED	CLOSED	AS IS	CLOSED	OPEN
EMHV8881	3/4 / 3/4	INSIDE	OUT	GLOBE	AIR	1	CIS-A	NONE	10	CLOSED	CLOSED	CLOSED	CLOSED	N/A
EMV0001	2/2	INSIDE	IN	CHECK	N/A	N/A	N/A	N/A	N/A	CLOSED	CLOSED	N/A	CLOSED	OPEN
EMV0002	2/2	INSIDE	IN	CHECK	N/A	N/A	N/A	N/A	N/A	CLOSED	CLOSED	N/A	CLOSED	OPEN
EMV0052	3/4 / 3/4	INSIDE	N/A	GLOBE	MANUAL	N/A	N/A	N/A	N/A	CLOSED	CLOSED	N/A	CLOSED	N/A
EMV0053	3/4 / 3/4	INSIDE	N/A	GLOBE	MANUAL	N/A	N/A	N/A	N/A	CLOSED	CLOSED	N/A	CLOSED	N/A
EMV0055	3/4 / 3/4	INSIDE	N/A	GLOBE	MANUAL	N/A	N/A	N/A	N/A	CLOSED	CLOSED	N/A	CLOSED	N/A
EMV0056	3/4 / 3/4	INSIDE	N/A	GLOBE	MANUAL	N/A	N/A	N/A	N/A	CLOSED	CLOSED	N/A	CLOSED	N/A
EMV0184	3/4 / 3/4	INSIDE	N/A	GLOBE	MANUAL	N/A	N/A	N/A	N/A	CLOSED	CLOSED	N/A	CLOSED	N/A
EMV0185	3/4 / 3/4	INSIDE	N/A	GLOBE	MANUAL	N/A	N/A	N/A	N/A	CLOSED	CLOSED	N/A	CLOSED	N/A
EMV0051	1/1	OUTSIDE	N/A	GLOBE	MANUAL	N/A	N/A	N/A	N/A	CLOSED	CLOSED	N/A	CLOSED	N/A
EMV0186	1/1	INSIDE	N/A	GLOBE	MANUAL	N/A	N/A	N/A	N/A	CLOSED	CLOSED	N/A	CLOSED	N/A
EMV0187	1/1	INSIDE	N/A	GLOBE	MANUAL	N/A	N/A	N/A	N/A	CLOSED	CLOSED	N/A	CLOSED	N/A

ENGINEERED SAFETY FEATURE SYSTEM	YES <input checked="" type="checkbox"/> NO <input type="checkbox"/>
FLUID CONTAINED:	WATER
LENGTH OF PIPING TO OUTERMOST ISOLATION VALVE:	12.1 FT
APPLICABLE GDC NO.	55

GENERAL COMMENTS:


THIS PENETRATION IS ASSOCIATED WITH THE HIGH PRESSURE COOLANT INJECTION SYSTEM, WHICH IS REQUIRED TO MITIGATE THE CONSEQUENCES OF A LOCA. A CHECK VALVE IS PROVIDED FOR EACH BRANCH LINE INSIDE THE CONTAINMENT, AND A REMOTE-MANUAL ISOLATION VALVE IS PROVIDED OUTSIDE THE CONTAINMENT. A SINGLE ACTIVE OR PASSIVE FAILURE CAN BE ACCOMMODATED SINCE THE SYSTEM IS CLOSED OUTSIDE THE CONTAINMENT AND IS DESIGNED AND CONSTRUCTED COMMENSURATE WITH THE DESIGN AND CONSTRUCTION OF THE CONTAINMENT. LEAKAGE DETECTION FROM THIS LINE OUTSIDE THE CONTAINMENT IS PROVIDED, AS DESCRIBED IN SECTION 9.3.3.

LOCAL TESTING OF THE VALVES OR THE CLOSED SYSTEM OUTSIDE THE CONTAINMENT IS NOT REQUIRED SINCE THE SYSTEM IS OPERATED AND INSPECTED DURING NORMAL PLANT OPERATION TO ASSURE THAT THE INTEGRITY IS BEING MAINTAINED.

NOTE 1: MAXIMUM CLOSURE TIMES SPECIFIED IN THIS FIGURE ARE NOMINAL DESIGN OR LICENSING-BASIS VALUES. PERFORMANCE-BASED VALVE OPERABILITY LIMITS FOR VALVE CLOSURE TIMES ARE SPECIFIED PER THE INSERVICE TESTING PROGRAM FOR CALLAWAY.

APPENDIX J REQUIREMENT

- TYPE A
 B
 C
 NONE

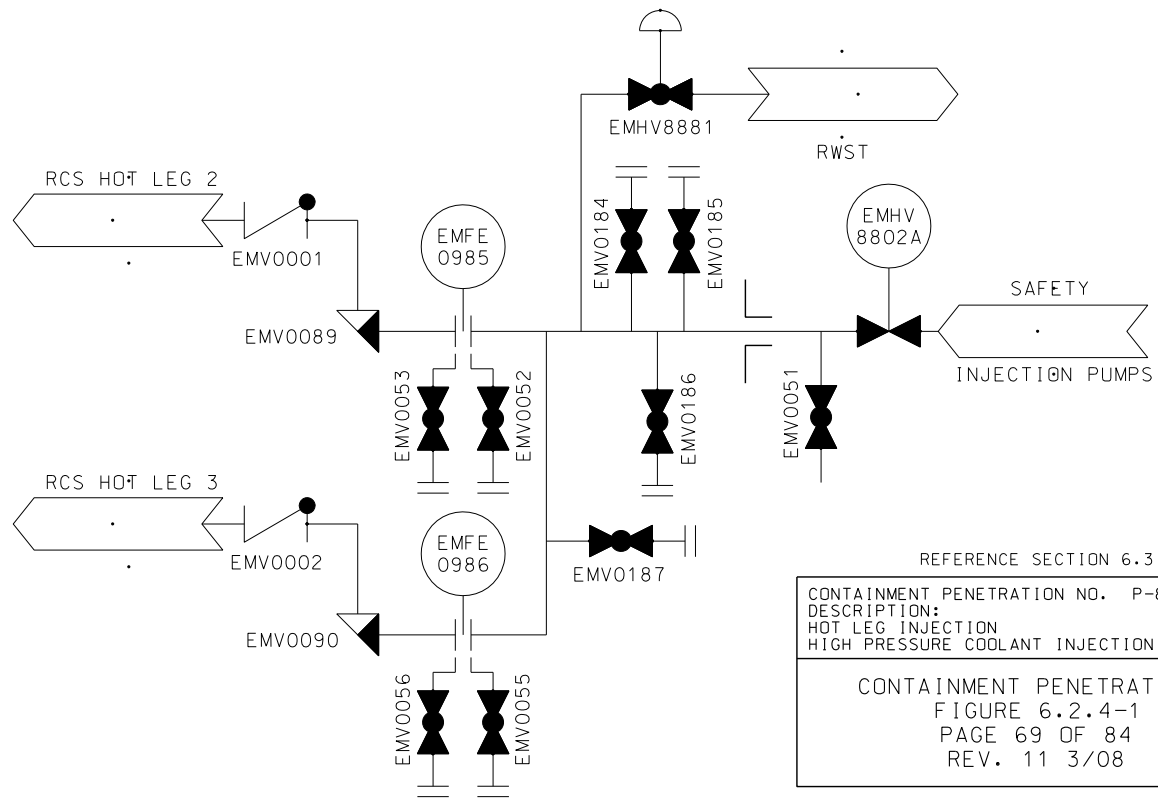

REFERENCE SECTION 6.3

CONTAINMENT PENETRATION NO. P-87
 DESCRIPTION:
 HOT LEG INJECTION
 HIGH PRESSURE COOLANT INJECTION SYSTEM

CONTAINMENT PENETRATIONS
 FIGURE 6.2.4-1
 PAGE 69 OF 84
 REV. 11/3/08

VALVE NO.	LINE/ VALVE SIZE, IN.	INSIDE/ OUTSIDE CONT.	NORMAL FLOW DIRECTION	VALVE TYPE	VALVE OPERATOR	POWER SOURCE	PRIMARY ACTUATION SIGNAL	SECONDARY ACTUATION SIGNAL	MAXIMUM CLOSURE TIME (SEC.) (NOTE 1)	VALVE POSITION				
										NORMAL	SHUTDOWN	POWER FAILURE	POST ACCIDENT	
													PRIMARY	SECONDARY
EMHV8801A	4/4	OUTSIDE	IN	GATE	MOTOR	1	SIS	NONE	15	CLOSED	CLOSED	AS IS	OPEN	N/A
EMHV8801B	4/4	OUTSIDE	IN	GATE	MOTOR	4	SIS	NONE	15	CLOSED	CLOSED	AS IS	OPEN	N/A
EMV0077	1/1	OUTSIDE	N/A	GLOBE	MANUAL	N/A	N/A	N/A	N/A	CLOSED	CLOSED	N/A	CLOSED	N/A
EMHV8843	3/4 / 3/4	INSIDE	IN	GLOBE	AIR	4	CIS-A	NONE	10	CLOSED	CLOSED	CLOSED	CLOSED	N/A
EM8815	3/3	INSIDE	IN	CHECK	N/A	N/A	N/A	N/A	N/A	CLOSED	CLOSED	N/A	OPEN	N/A

ENGINEERED SAFETY FEATURE SYSTEM	YES <input checked="" type="checkbox"/> NO <input type="checkbox"/>
FLUID CONTAINED:	WATER
LENGTH OF PIPING TO OUTERMOST ISOLATION VALVE:	N/A
APPLICABLE GDC NO.	55

GENERAL COMMENTS:


THIS PENETRATION IS ASSOCIATED WITH THE HIGH PRESSURE COOLANT INJECTION SYSTEM, WHICH IS REQUIRED TO MITIGATE THE CONSEQUENCES OF A LOCA. A CHECK VALVE AND A REMOTE-MANUAL ISOLATION VALVE ARE PROVIDED OUTSIDE THE CONTAINMENT. A SINGLE ACTIVE OR PASSIVE FAILURE CAN BE ACCOMMODATED SINCE THE SYSTEM IS CLOSED OUTSIDE THE CONTAINMENT AND IS DESIGNED AND CONSTRUCTED COMMENSURATE WITH THE DESIGN AND CONSTRUCTION OF THE CONTAINMENT. LEAKAGE DETECTION FROM THIS LINE OUTSIDE THE CONTAINMENT IS PROVIDED, AS DESCRIBED IN SECTION 9.3.3.

LOCAL TESTING OF THE VALVES OR THE CLOSED SYSTEM OUTSIDE THE CONTAINMENT IS NOT REQUIRED SINCE THE SYSTEM IS OPERATED AND INSPECTED DURING NORMAL PLANT OPERATION TO ASSURE THAT THE INTEGRITY IS BEING MAINTAINED.

NOTE 1: MAXIMUM CLOSURE TIMES SPECIFIED IN THIS FIGURE ARE NOMINAL DESIGN OR LICENSING-BASIS VALUES. PERFORMANCE-BASED VALVE OPERABILITY LIMITS FOR VALVE CLOSURE TIMES ARE SPECIFIED PER THE INSERVICE TESTING PROGRAM FOR CALLAWAY.

APPENDIX J REQUIREMENT

TYPE A
 B
 C
 NONE

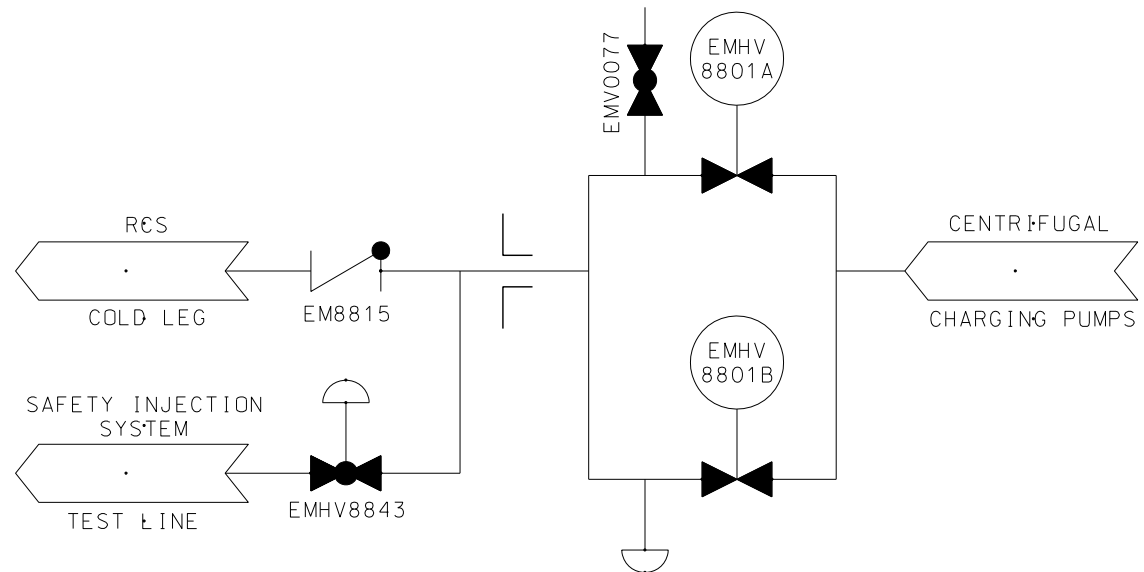

REFERENCE SECTION 6.3

CONTAINMENT PENETRATION NO. P-88
 DESCRIPTION:
 BORON INJECTION TO COLD LEGS
 HIGH PRESSURE COOLANT INJECTION SYSTEM

CONTAINMENT PENETRATIONS
 FIGURE 6.2.4-1
 PAGE 70 OF 84
 REV. 12 8/16

VALVE NO.	LINE/ VALVE SIZE, IN.	INSIDE/ OUTSIDE CONT.	NORMAL FLOW DIRECTION	VALVE TYPE	VALVE OPERATOR	POWER SOURCE	PRIMARY ACTUATION SIGNAL	SECONDARY ACTUATION SIGNAL	MAXIMUM CLOSURE TIME (SEC.)	VALVE POSITION				
										NORMAL	SHUTDOWN	POWER FAILURE	POST ACCIDENT	
													PRIMARY	SECONDARY
ENHV0006	10/10	OUTSIDE	IN	GATE	MOTOR	1	CSAS	REM/MAN	15	CLOSED	CLOSED	AS IS	OPEN	CLOSED
ENVO076	1/1	OUTSIDE	N/A	GLOBE	MANUAL	N/A	N/A	N/A	N/A	CLOSED	CLOSED	N/A	CLOSED	N/A
ENVO013	10/10	INSIDE	IN	CHECK	N/A	N/A	N/A	N/A	N/A	CLOSED	CLOSED	N/A	OPEN	CLOSED


ENGINEERED SAFETY FEATURE SYSTEM	YES <input checked="" type="checkbox"/> NO <input type="checkbox"/>
FLUID CONTAINED:	WATER
LENGTH OF PIPING TO OUTERMOST ISOLATION VALVE:	20.4 FT
APPLICABLE GDC NO.	56

GENERAL COMMENTS:
THIS PENETRATION IS ASSOCIATED WITH THE CONTAINMENT SPRAY SYSTEM, WHICH IS REQUIRED TO MITIGATE THE CONSEQUENCES OF A LOCA. A CHECK VALVE IS PROVIDED OUTSIDE THE CONTAINMENT, AND A REMOTE-MANUAL ISOLATION VALVE IS PROVIDED OUTSIDE THE CONTAINMENT. A SINGLE ACTIVE OR PASSIVE FAILURE CAN BE ACCOMMODATED SINCE TWO IN-SERIES VALVES (INSIDE/OUTSIDE) ARE CREDITED FOR THIS PENETRATION. IN ADDITION, THE SYSTEM IS CLOSED OUTSIDE THE CONTAINMENT AND IS DESIGNED AND CONSTRUCTED COMMENSURATE WITH THE DESIGN AND CONSTRUCTION OF THE CONTAINMENT. LEAKAGE DETECTION FROM THIS LINE OUTSIDE THE CONTAINMENT IS PROVIDED, AS DESCRIBED IN SECTION 9.3.3.

LOCAL TESTING OF THE VALVES OR THE CLOSED SYSTEM OUTSIDE THE CONTAINMENT IS NOT REQUIRED SINCE THE SYSTEM IS OPERATED AND INSPECTED DURING NORMAL PLANT OPERATION TO ASSURE THAT THE INTEGRITY IS BEING MAINTAINED.

NOTE 1: MAXIMUM CLOSURE TIMES SPECIFIED IN THIS FIGURE ARE NOMINAL DESIGN OR LICENSING-BASIS VALUES. PERFORMANCE-BASED VALVE OPERABILITY LIMITS FOR VALVE CLOSURE TIMES ARE SPECIFIED PER THE INSERVICE TESTING PROGRAM FOR CALLAWAY.

APPENDIX J REQUIREMENT
TYPE A
B
C
NONE

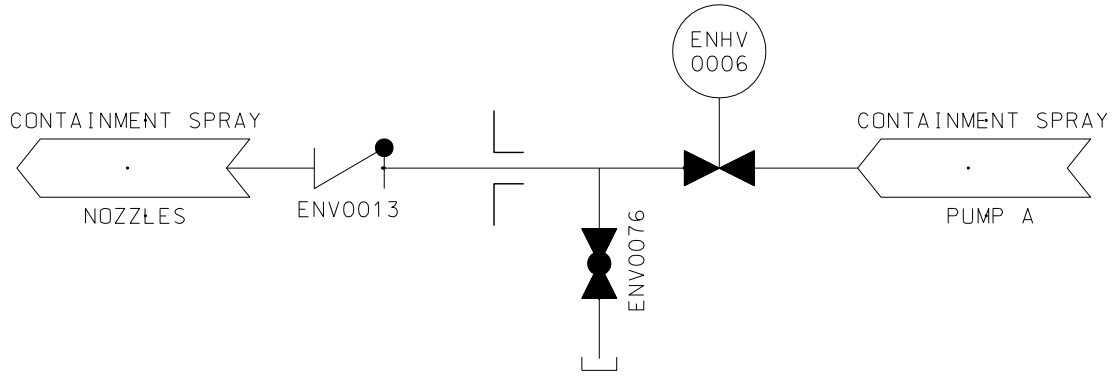

REFERENCE SECTION 6.2.2

CONTAINMENT PENETRATION NO. P-89 DESCRIPTION: CONTAINMENT SPRAY CONTAINMENT SPRAY SYSTEM
CONTAINMENT PENETRATIONS FIGURE 6.2.4-1 PAGE 71 OF 84 REV. 12 6/08


VALVE NO.	LINE / VALVE SIZE, IN.	INSIDE / OUTSIDE CONT.	NORMAL FLOW DIRECTION	VALVE TYPE	VALVE OPERATOR	POWER SOURCE	PRIMARY ACTUATION SIGNAL	SECONDARY ACTUATION SIGNAL	MAXIMUM CLOSURE TIME (SEC.) (NOTE 1)	VALVE POSITION				
										NORMAL	SHUTDOWN	POWER FAILURE	POST ACCIDENT	
													PRIMARY	SECONDARY
NONE	N/A	N/A	N/A	N/A	N/A	N/A	N/A	N/A	N/A	N/A	N/A	N/A	N/A	N/A

ENGINEERED SAFETY FEATURE SYSTEM	YES <input type="checkbox"/> NO <input checked="" type="checkbox"/>
FLUID CONTAINED:	WATER
LENGTH OF PIPING TO OUTERMOST ISOLATION VALVE:	N/A
APPLICABLE GDC NO.	55

GENERAL COMMENTS:

HYDRAULIC SENSORS PROVIDE ISOLATION OF RCS FROM THE CAPILLARY TUBING. THE CAPILLARY TUBING AND THE LIS'S SERVE AS THE SECOND BOUNDARY. THIS ARRANGEMENT IS SIMILAR TO THAT PROVIDED FOR THE CONTAINMENT PRESSURE TRANSMITTERS SHOWN ON SHEET 80, 81 AND 84 OF 84.

NOTE 1: MAXIMUM CLOSURE TIMES SPECIFIED IN THIS FIGURE ARE NOMINAL DESIGN OR LICENSING-BASIS VALUES. PERFORMANCE-BASED VALVE OPERABILITY LIMITS FOR VALVE CLOSURE TIMES ARE SPECIFIED PER THE INSERVICE TESTING PROGRAM FOR CALLAWAY.

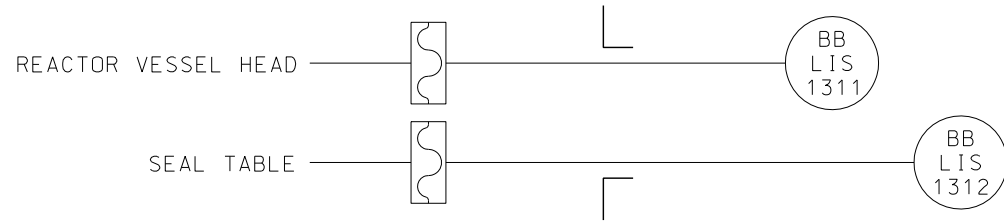

APPENDIX J REQUIREMENT

TYPE A
 B
 C
 NONE

REFERENCE SECTION 18.2.13.2

CONTAINMENT PENETRATION NO. P-91 DESCRIPTION: RVLIS SAMPLE LINE REACTOR COOLANT SYSTEM
CONTAINMENT PENETRATIONS FIGURE 6.2.4-1 PAGE 72 OF 84 REV. 12 8/16


VALVE NO.	LINE / VALVE SIZE, IN.	INSIDE / OUTSIDE CONT.	NORMAL FLOW DIRECTION	VALVE TYPE	VALVE OPERATOR	POWER SOURCE	PRIMARY ACTUATION SIGNAL	SECONDARY ACTUATION SIGNAL	MAXIMUM CLOSURE TIME (SEC.) (NOTE 1)	VALVE POSITION				
										NORMAL	SHUTDOWN	POWER FAILURE	POST ACCIDENT	
													PRIMARY	SECONDARY
EMHV8964	3/4 / 3/4	OUTSIDE	OUT	GLOBE	AIR	1	CIS-A	NONE	10	CLOSED	CLOSED	CLOSED	CLOSED	N/A
EMV0153	3/4 / 3/4	INSIDE	N/A	GLOBE	MANUAL	N/A	N/A	N/A	N/A	CLOSED	CLOSED	N/A	CLOSED	N/A
EMHV8871	3/4 / 3/4	INSIDE	OUT	GLOBE	AIR	4	CIS-A	NONE	10	CLOSED	CLOSED	CLOSED	CLOSED	N/A
EMV0038	3/4 / 3/4	OUTSIDE	N/A	GLOBE	MANUAL	N/A	N/A	N/A	N/A	CLOSED	CLOSED	CLOSED	CLOSED	N/A

ENGINEERED SAFETY FEATURE SYSTEM	YES <input checked="" type="checkbox"/> NO <input type="checkbox"/>
FLUID CONTAINED:	WATER
LENGTH OF PIPING TO OUTERMOST ISOLATION VALVE:	8.4 FT.
APPLICABLE GDC NO.	56

GENERAL COMMENTS:

NONE

NOTE 1: MAXIMUM CLOSURE TIMES SPECIFIED IN THIS FIGURE ARE NOMINAL DESIGN OR LICENSING-BASIS VALUES. PERFORMANCE-BASED VALVE OPERABILITY LIMITS FOR VALVE CLOSURE TIMES ARE SPECIFIED PER THE INSERVICE TESTING PROGRAM FOR CALLAWAY.

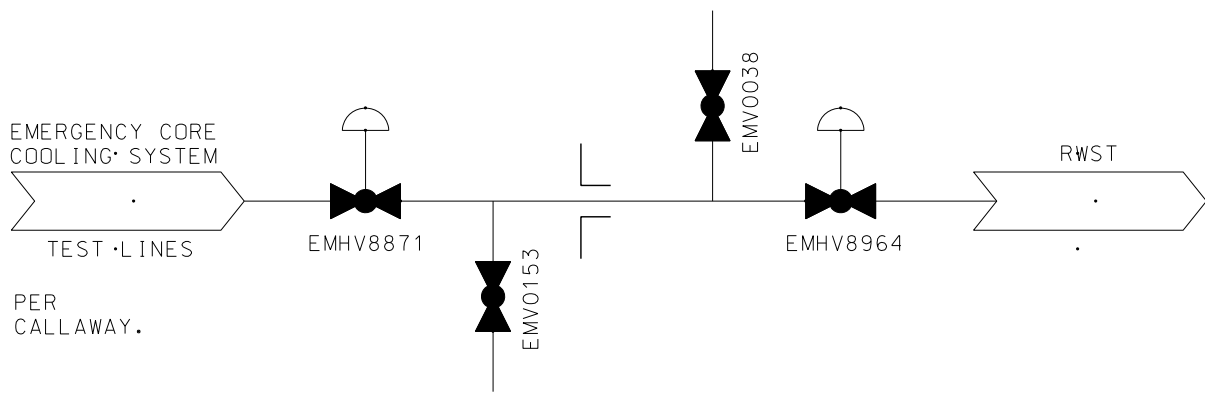

REFERENCE SECTION 6.3

CONTAINMENT PENETRATION NO. P-92
 DESCRIPTION:
 ECCS TEST LINE RETURN
 HIGH PRESSURE COOLANT INJECTION SYSTEM

CONTAINMENT PENETRATIONS
 FIGURE 6.2.4-1
 PAGE 73 OF 84
 REV. 16 3/08

APPENDIX J REQUIREMENT

- TYPE A
- B
- C
- NONE


VALVE NO.	LINE / VALVE SIZE, IN.	INSIDE / OUTSIDE CONT.	NORMAL FLOW DIRECTION	VALVE TYPE	VALVE OPERATOR	POWER SOURCE	PRIMARY ACTUATION SIGNAL	SECONDARY ACTUATION SIGNAL	MAXIMUM CLOSURE TIME (SEC.) (NOTE 1)	VALVE POSITION				
										NORMAL	SHUTDOWN	POWER FAILURE	POST ACCIDENT	
													PRIMARY	SECONDARY
SJHV0005	1/1	INSIDE	OUT	GLOBE	SOLENOID	4	CIS-A	NONE	5	CLOSED	CLOSED	CLOSED	CLOSED	N/A
SJHV0006	1/1	OUTSIDE	OUT	GLOBE	SOLENOID	1	CIS-A	NONE	5	CLOSED	CLOSED	CLOSED	CLOSED	N/A
SJVO069	1/1	OUTSIDE	N/A	GLOBE	MANUAL	N/A	N/A	N/A	N/A	CLOSED	CLOSED	N/A	CLOSED	N/A
SJHV0127	1/1	OUTSIDE	OUT	GLOBE	SOLENOID	4	CIS-A	NONE	5	CLOSED	CLOSED	CLOSED	CLOSED	N/A

ENGINEERED SAFETY FEATURE SYSTEM	YES <input type="checkbox"/> NO <input checked="" type="checkbox"/>
FLUID CONTAINED:	WATER
LENGTH OF PIPING TO OUTERMOST ISOLATION VALVE:	8.4 FT.
APPLICABLE GDC NO.	55

GENERAL COMMENTS:

NONE

NOTE 1: MAXIMUM CLOSURE TIMES SPECIFIED IN THIS FIGURE ARE NOMINAL DESIGN OR LICENSING-BASIS VALUES. PERFORMANCE-BASED VALVE OPERABILITY LIMITS FOR VALVE CLOSURE TIMES ARE SPECIFIED PER THE INSERVICE TESTING PROGRAM FOR CALLAWAY.

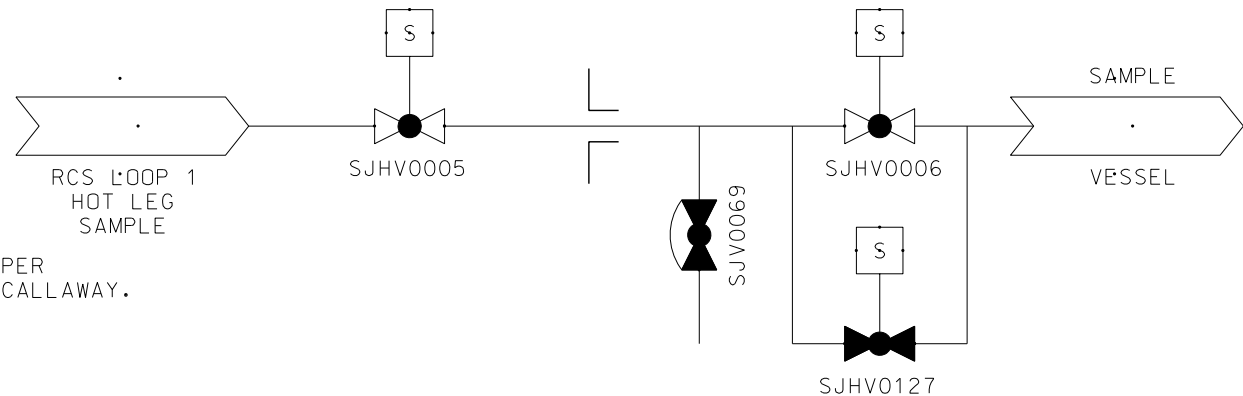

REFERENCE SECTION 9.3.2

CONTAINMENT PENETRATION NO. P-93
 DESCRIPTION:
 RCS LIQUID SAMPLE LINE
 NUCLEAR SAMPLING SYSTEM

CONTAINMENT PENETRATIONS
 FIGURE 6.2.4-1
 PAGE 74 OF 84
 REV. 13 8/16

APPENDIX J REQUIREMENT

TYPE A
 B
 C
 NONE


VALVE NO.	LINE / VALVE SIZE, IN.	INSIDE / OUTSIDE CONT.	NORMAL FLOW DIRECTION	VALVE TYPE	VALVE OPERATOR	POWER SOURCE	PRIMARY ACTUATION SIGNAL	SECONDARY ACTUATION SIGNAL	MAXIMUM CLOSURE TIME (SEC.) (NOTE 1)	VALVE POSITION				
										NORMAL	SHUTDOWN	POWER FAILURE	POST ACCIDENT	
													PRIMARY	SECONDARY
SJHV0018	1/1	INSIDE	OUT	GLOBE	SOLENOID	4	CIS-A	NONE	5	CLOSED	CLOSED	CLOSED	CLOSED	N/A
SJHV0019	1/1	OUTSIDE	OUT	GLOBE	SOLENOID	1	CIS-A	NONE	5	CLOSED	CLOSED	CLOSED	CLOSED	N/A
SJV0066	1/1	OUTSIDE	N/A	GLOBE	MANUAL	N/A	N/A	N/A	N/A	CLOSED	CLOSED	N/A	CLOSED	N/A

ENGINEERED SAFETY FEATURE SYSTEM	YES <input type="checkbox"/> NO <input checked="" type="checkbox"/>
FLUID CONTAINED:	WATER
LENGTH OF PIPING TO OUTERMOST ISOLATION VALVE:	8.6 FT.
APPLICABLE GDC NO.	55

GENERAL COMMENTS:

NONE

NOTE 1: MAXIMUM CLOSURE TIMES SPECIFIED IN THIS FIGURE ARE NOMINAL DESIGN OR LICENSING-BASIS VALUES. PERFORMANCE-BASED VALVE OPERABILITY LIMITS FOR VALVE CLOSURE TIMES ARE SPECIFIED PER THE INSERVICE TESTING PROGRAM FOR CALLAWAY.

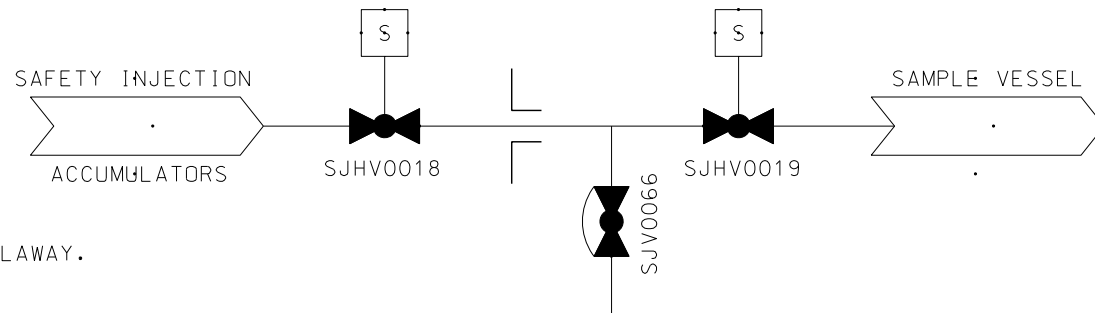

REFERENCE SECTION 9.3.2

CONTAINMENT PENETRATION NO. P-95
DESCRIPTION: ACCUMULATOR SAMPLING NUCLEAR SAMPLING SYSTEM
CONTAINMENT PENETRATIONS FIGURE 6.2.4-1 PAGE 75 OF 84 REV. 11 3/08

APPENDIX J REQUIREMENT

- TYPE A
- B
- C
- NONE

VALVE NO.	LINE/VALVE SIZE, IN.	INSIDE/OUTSIDE CONT.	NORMAL FLOW DIRECTION	VALVE TYPE	VALVE OPERATOR	POWER SOURCE	PRIMARY ACTUATION SIGNAL	SECONDARY ACTUATION SIGNAL	MAXIMUM CLOSURE TIME (SEC.) (NOTE 1)	VALVE POSITION				
										NORMAL	SHUTDOWN	POWER FAILURE	POST ACCIDENT	
													PRIMARY	SECONDARY
GSHV0018	1/1	INSIDE	IN	GATE	SOLENOID	1	CIS-A	REM/MAN	5	CLOSED	CLOSED	CLOSED	CLOSED	OPEN
GSHV0017	1/1	OUTSIDE	IN	GATE	SOLENOID	1	CIS-A	REM/MAN	5	CLOSED	CLOSED	CLOSED	CLOSED	OPEN
GSV0036	1/1	OUTSIDE	N/A	GLOBE	MANUAL	N/A	N/A	N/A	N/A	CLOSED	CLOSED	N/A	CLOSED	N/A
GSHV0033	1/1	OUTSIDE	IN	GATE	SOLENOID	4	CIS-A	REM/MAN	5	OPEN	OPEN	CLOSED	CLOSED	OPEN
GSHV0034	1/1	INSIDE	IN	GATE	SOLENOID	1	CIS-A	REM/MAN	5	OPEN	OPEN	CLOSED	CLOSED	OPEN
GSV0052	1/1	OUTSIDE	N/A	GLOBE	MANUAL	N/A	N/A	N/A	N/A	CLOSED	CLOSED	N/A	CLOSED	N/A

ENGINEERED SAFETY FEATURE SYSTEM	YES <input checked="" type="checkbox"/> NO <input type="checkbox"/>
FLUID CONTAINED:	AIR
LENGTH OF PIPING TO OUTERMOST ISOLATION VALVE:	4.3 FT.
APPLICABLE GDC NO.	56


GENERAL COMMENTS:

THIS PENETRATION IS ASSOCIATED WITH THE CONTAINMENT HYDROGEN CONTROL SYSTEM, WHICH IS REQUIRED TO MITIGATE THE CONSEQUENCES OF A LOCA. ALTHOUGH THE SOLENOID-OPERATED CONTAINMENT ISOLATION VALVES FOR THE HYDROGEN MONITORING SYSTEM SAMPLING LINES ARE DESIGNED TO AUTOMATICALLY CLOSE IN RESPONSE TO A CIS-A SIGNAL. THEY ARE NORMALLY CLOSED AND DEACTIVATED TO PROVIDE A PASSIVE BARRIER TO RELEASE OF CONTAINMENT ATMOSPHERE VIA THE ASSOCIATED CONTAINMENT PENETRATIONS. THE VALVES ARE OPENED ONLY UNDER ADMINISTRATIVE CONTROL. IN ADDITION, AND ALTHOUGH NOT EXPLICITLY CREDITED AS CONTAINMENT BARRIER, THE SAMPLING SYSTEM (DOWNSTREAM OF THE CONTAINMENT ISOLATION VALVES) IS A CLOSED SYSTEM OUTSIDE CONTAINMENT WHICH IS DESIGNED AND CONSTRUCTED COMMENSURATE WITH THE DESIGN AND CONSTRUCTION OF THE CONTAINMENT.

NOTE 1: MAXIMUM CLOSURE TIMES SPECIFIED IN THIS FIGURE ARE NOMINAL DESIGN OR LICENSING-BASIS VALUES. PERFORMANCE-BASED VALVE OPERABILITY LIMITS FOR VALVE CLOSURE TIMES ARE SPECIFIED PER THE INSERVICE TESTING PROGRAM FOR CALLAWAY.

APPENDIX J REQUIREMENT

- TYPE A
 B
 C
 NONE

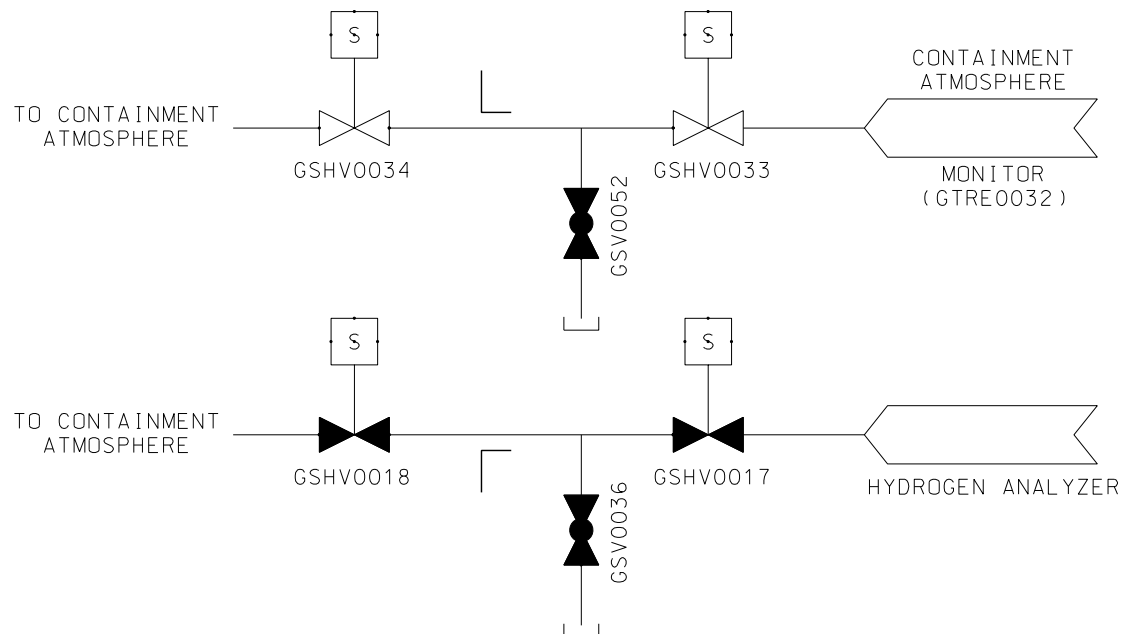

REFERENCE SECTION 6.2.5

CONTAINMENT PENETRATION NO. P-97
 DESCRIPTION:
 H₂ SAMPLE RETURN
 CONTAINMENT HYDROGEN CONTROL SYSTEM


CONTAINMENT PENETRATIONS
 FIGURE 6.2.4-1
 PAGE 76 OF 84
 REV. 15 9/14

VALVE NO.	LINE / VALVE SIZE, IN.	INSIDE / OUTSIDE CONT.	NORMAL FLOW DIRECTION	VALVE TYPE	VALVE OPERATOR	POWER SOURCE	PRIMARY ACTUATION SIGNAL	SECONDARY ACTUATION SIGNAL	MAXIMUM CLOSURE TIME (SEC.) (NOTE 1)	VALVE POSITION				
										NORMAL	SHUTDOWN	POWER FAILURE	POST ACCIDENT	
													PRIMARY	SECONDARY
KBV0001	2/2	INSIDE	N/A	GLOBE	MANUAL	N/A	N/A	N/A	N/A	CLOSED	CLOSED	N/A	CLOSED	N/A
KBV0002	2/2	OUTSIDE	N/A	GLOBE	MANUAL	N/A	N/A	N/A	N/A	CLOSED	CLOSED	N/A	CLOSED	N/A

ENGINEERED SAFETY FEATURE SYSTEM	YES <input type="checkbox"/> NO <input checked="" type="checkbox"/>
FLUID CONTAINED:	AIR
LENGTH OF PIPING TO OUTERMOST ISOLATION VALVE:	2.8 FT.
APPLICABLE GDC NO.	56

GENERAL COMMENTS:
NONE

NOTE 1: MAXIMUM CLOSURE TIMES SPECIFIED IN THIS FIGURE ARE NOMINAL DESIGN OR LICENSING-BASIS VALUES. PERFORMANCE-BASED VALVE OPERABILITY LIMITS FOR VALVE CLOSURE TIMES ARE SPECIFIED PER THE INSERVICE TESTING PROGRAM FOR CALLAWAY.

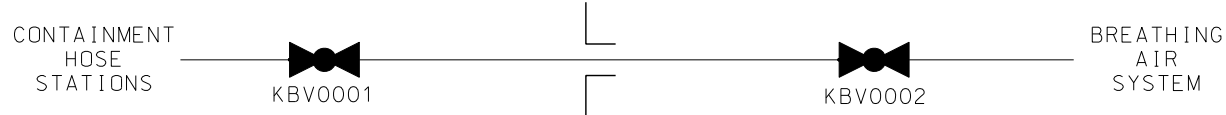

REFERENCE SECTION 9.5.1

CONTAINMENT PENETRATION NO. P-98
DESCRIPTION: BREATHING AIR SYSTEM

CONTAINMENT PENETRATIONS
FIGURE 6.2.4-1
PAGE 77 OF 84
REV. 11 3/08

APPENDIX J REQUIREMENT
TYPE A
B
C
NONE

VALVE NO.	LINE/VALVE SIZE, IN.	INSIDE/OUTSIDE CONT.	NORMAL FLOW DIRECTION	VALVE TYPE	VALVE OPERATOR	POWER SOURCE	PRIMARY ACTUATION SIGNAL	SECONDARY ACTUATION SIGNAL	MAXIMUM CLOSURE TIME (SEC.) (NOTE 1)	VALVE POSITION				
										NORMAL	SHUTDOWN	POWER FAILURE	POST ACCIDENT	
													PRIMARY	SECONDARY
GSHV0003	1/1	OUTSIDE	OUT	GATE	SOLENOID	4	CIS-A	REM/MAN	5	CLOSED	CLOSED	CLOSED	CLOSED	OPEN
GSHV0004	1/1	INSIDE	OUT	GATE	SOLENOID	4	CIS-A	REM/MAN	5	CLOSED	CLOSED	CLOSED	CLOSED	OPEN
GSHV0005	1/1	INSIDE	OUT	GATE	SOLENOID	4	CIS-A	REM/MAN	5	CLOSED	CLOSED	CLOSED	CLOSED	OPEN
GSV0029	1/1	OUTSIDE	N/A	GLOBE	MANUAL	N/A	N/A	N/A	N/A	CLOSED	CLOSED	N/A	CLOSED	N/A
GSHV0036	1/1	INSIDE	OUT	GATE	SOLENOID	4	CIS-A	REM/MAN	5	OPEN	OPEN	CLOSED	CLOSED	OPEN
GSHV0037	1/1	OUTSIDE	OUT	GATE	SOLENOID	1	CIS-A	REM/MAN	5	OPEN	OPEN	CLOSED	CLOSED	OPEN
GSV0056	1/1	OUTSIDE	N/A	GLOBE	MANUAL	N/A	N/A	N/A	N/A	CLOSED	CLOSED	N/A	CLOSED	N/A

ENGINEERED SAFETY FEATURE SYSTEM	YES <input checked="" type="checkbox"/> NO <input type="checkbox"/>
FLUID CONTAINED:	AIR
LENGTH OF PIPING TO OUTERMOST ISOLATION VALVE:	4.3 FT
APPLICABLE GDC NO.	56


GENERAL COMMENTS:

THIS PENETRATION IS ASSOCIATED WITH THE CONTAINMENT HYDROGEN CONTROL SYSTEM, WHICH IS REQUIRED TO MITIGATE THE CONSEQUENCES OF A LOCA. ALTHOUGH THE SOLENOID-OPERATED CONTAINMENT ISOLATION VALVES FOR THE HYDROGEN MONITORING SYSTEM SAMPLING LINES ARE DESIGNED TO AUTOMATICALLY CLOSE IN RESPONSE TO A CIS-A SIGNAL. THEY ARE NORMALLY CLOSED AND DEACTIVATED TO PROVIDE A PASSIVE BARRIER TO RELEASE OF CONTAINMENT ATMOSPHERE VIA THE ASSOCIATED CONTAINMENT PENETRATIONS. THE VALVES ARE OPENED ONLY UNDER ADMINISTRATIVE CONTROL. IN ADDITION, AND ALTHOUGH NOT EXPLICITLY CREDITED AS CONTAINMENT BARRIER, THE SAMPLING SYSTEM (DOWNSTREAM OF THE CONTAINMENT ISOLATION VALVES) IS A CLOSED SYSTEM OUTSIDE CONTAINMENT WHICH IS DESIGNED AND CONSTRUCTED COMMENSURATE WITH THE DESIGN AND CONSTRUCTION OF THE CONTAINMENT.

NOTE 1: MAXIMUM CLOSURE TIMES SPECIFIED IN THIS FIGURE ARE NOMINAL DESIGN OR LICENSING-BASIS VALUES. PERFORMANCE-BASED VALVE OPERABILITY LIMITS FOR VALVE CLOSURE TIMES ARE SPECIFIED PER THE INSERVICE TESTING PROGRAM FOR CALLAWAY.

APPENDIX J REQUIREMENT

- TYPE A
 B
 C
 NONE

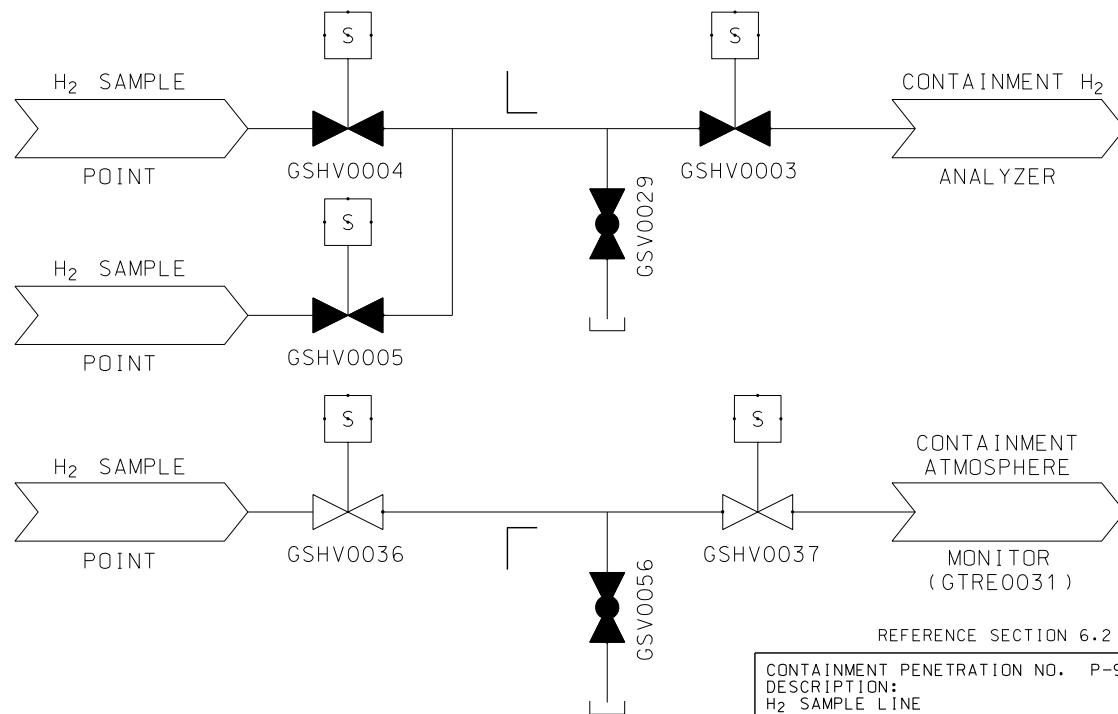

REFERENCE SECTION 6.2

CONTAINMENT PENETRATION NO. P-99
DESCRIPTION: H ₂ SAMPLE LINE CONTAINMENT HYDROGEN CONTROL SYSTEM
CONTAINMENT PENETRATIONS FIGURE 6.2.4-1 PAGE 78 OF 84 REV. 15 9/14

VALVE NO.	LINE/ VALVE SIZE, IN.	INSIDE/ OUTSIDE CONT.	NORMAL FLOW DIRECTION	VALVE TYPE	VALVE OPERATOR	POWER SOURCE	PRIMARY ACTUATION SIGNAL	SECONDARY ACTUATION SIGNAL	MAXIMUM CLOSURE TIME (SEC.) (NOTE 1)	VALVE POSITION				
										NORMAL	SHUTDOWN	POWER FAILURE	POST ACCIDENT	
													PRIMARY	SECONDARY
GSHV0012	1/1	OUTSIDE	OUT	GATE	SOLENOID	1	CIS-A	REM/MAN	5	CLOSED	CLOSED	CLOSED	CLOSED	OPEN
GSHV0013	1/1	INSIDE	OUT	GATE	SOLENOID	1	CIS-A	REM/MAN	5	CLOSED	CLOSED	CLOSED	CLOSED	OPEN
GSHV0014	1/1	INSIDE	OUT	GATE	SOLENOID	1	CIS-A	REM/MAN	5	CLOSED	CLOSED	CLOSED	CLOSED	OPEN
GSV0033	1/1	OUTSIDE	N/A	GLOBE	MANUAL	N/A	N/A	N/A	N/A	CLOSED	CLOSED	N/A	CLOSED	N/A
GSHV0031	1/1	INSIDE	OUT	GATE	SOLENOID	1	CIS-A	REM/MAN	5	OPEN	OPEN	CLOSED	CLOSED	OPEN
GSHV0032	1/1	OUTSIDE	OUT	GATE	SOLENOID	4	CIS-A	REM/MAN	5	OPEN	OPEN	CLOSED	CLOSED	OPEN
GSV0050	1/1	OUTSIDE	N/A	GLOBE	MANUAL	N/A	N/A	N/A	N/A	CLOSED	CLOSED	N/A	CLOSED	N/A

ENGINEERED SAFETY FEATURE SYSTEM	YES <input checked="" type="checkbox"/> NO <input type="checkbox"/>
FLUID CONTAINED:	AIR
LENGTH OF PIPING TO OUTERMOST ISOLATION VALVE:	11.9 FT
APPLICABLE GDC NO.	56


GENERAL COMMENTS:

THIS PENETRATION IS ASSOCIATED WITH THE CONTAINMENT HYDROGEN CONTROL SYSTEM, WHICH IS REQUIRED TO MITIGATE THE CONSEQUENCES OF A LOCA. ALTHOUGH THE SOLENOID-OPERATED CONTAINMENT ISOLATION VALVES FOR THE HYDROGEN MONITORING SYSTEM SAMPLING LINES ARE DESIGNED TO AUTOMATICALLY CLOSE IN RESPONSE TO A CIS-A SIGNAL. THEY ARE NORMALLY CLOSED AND DEACTIVATED TO PROVIDE A PASSIVE BARRIER TO RELEASE OF CONTAINMENT ATMOSPHERE VIA THE ASSOCIATED CONTAINMENT PENETRATIONS. THE VALVES ARE OPENED ONLY UNDER ADMINISTRATIVE CONTROL. IN ADDITION, AND ALTHOUGH NOT EXPLICITLY CREDITED AS CONTAINMENT BARRIER, THE SAMPLING SYSTEM (DOWNSTREAM OF THE CONTAINMENT ISOLATION VALVES) IS A CLOSED SYSTEM OUTSIDE CONTAINMENT WHICH IS DESIGNED AND CONSTRUCTED COMMENSURATE WITH THE DESIGN AND CONSTRUCTION OF THE CONTAINMENT.

NOTE 1: MAXIMUM CLOSURE TIMES SPECIFIED IN THIS FIGURE ARE NOMINAL DESIGN OR LICENSING-BASIS VALUES. PERFORMANCE-BASED VALVE OPERABILITY LIMITS FOR VALVE CLOSURE TIMES ARE SPECIFIED PER THE INSERVICE TESTING PROGRAM FOR CALLAWAY.

APPENDIX J REQUIREMENT

TYPE A
 B
 C
 NONE

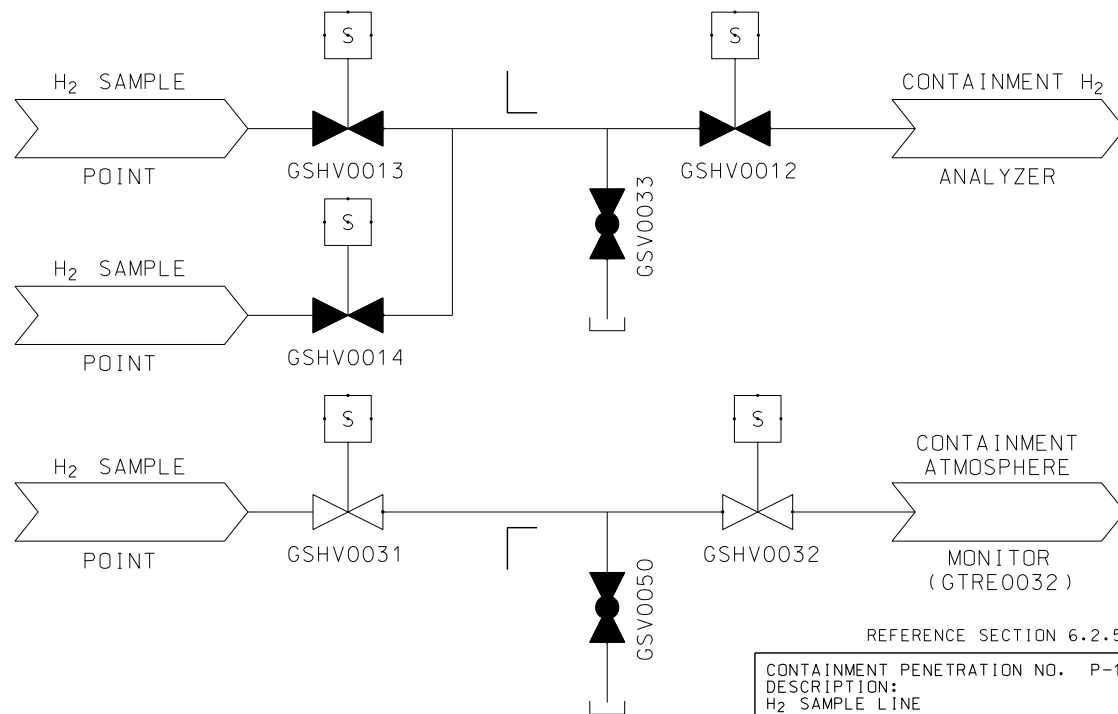

REFERENCE SECTION 6.2.5

CONTAINMENT PENETRATION NO. P-101 DESCRIPTION: H ₂ SAMPLE LINE CONTAINMENT HYDROGEN CONTROL SYSTEM
CONTAINMENT PENETRATIONS FIGURE 6.2.4-1 PAGE 79 OF 84 REV. 16 9/14

VALVE NO.	LINE / VALVE SIZE, IN.	INSIDE / OUTSIDE CONT.	NORMAL FLOW DIRECTION	VALVE TYPE	VALVE OPERATOR	POWER SOURCE	PRIMARY ACTUATION SIGNAL	SECONDARY ACTUATION SIGNAL	MAXIMUM CLOSURE TIME (SEC.) (NOTE 1)	VALVE POSITION				
										NORMAL	SHUTDOWN	POWER FAILURE	POST ACCIDENT	
													PRIMARY	SECONDARY
NONE	N/A	N/A	N/A	N/A	N/A	N/A	N/A	N/A	N/A	N/A	N/A	N/A	N/A	N/A

ENGINEERED SAFETY FEATURE SYSTEM YES NO

FLUID CONTAINED: WATER


LENGTH OF PIPING TO OUTERMOST ISOLATION VALVE: N/A

APPLICABLE GDC NO. 56

GENERAL COMMENTS:

GNPT0936
 THERE ARE FOUR INSTRUMENT LINES WHICH PENETRATE THE CONTAINMENT AND WHICH ARE REQUIRED TO REMAIN FUNCTIONAL FOLLOWING A LOCA OR STEAM BREAK. THESE LINES SENSE THE PRESSURE OF CONTAINMENT ATMOSPHERE ON THE INSIDE AND ARE CONNECTED TO PRESSURE TRANSMITTERS ON THE OUTSIDE. SIGNALS FROM THESE TRANSMITTERS CAN INITIATE SAFETY INJECTION AND CONTAINMENT ISOLATION ON HIGH CONTAINMENT PRESSURE. THEY ALSO, UPON HIGH-3 CONTAINMENT PRESSURE, PRODUCE THE ONLY SIGNAL TO INITIATE CONTAINMENT SPRAY. IN VIEW OF THIS FUNCTION, IT IS ESSENTIAL THAT THE LINE REMAIN OPEN AND NOT BE ISOLATED FOLLOWING AN ACCIDENT. BASED ON THIS REQUIREMENT, A SEALED SENSING LINE, AS DESCRIBED BELOW, IS USED.

THIS CHANNEL HAS A SEPARATE PENETRATION, AND THE PRESSURE TRANSMITTER IS LOCATED IMMEDIATELY ADJACENT TO THE OUTSIDE OF THE CONTAINMENT WALL. IT IS CONNECTED TO A SEALED BELLOWS, LOCATED IMMEDIATELY ADJACENT TO THE INSIDE CONTAINMENT WALL, BY MEANS OF A SEALED FLUID FILLED TUBE. THIS TUBING, ALONG WITH THE TRANSMITTER AND BELLOWS, IS CONSERVATIVELY DESIGNED AND SUBJECT TO STRICT QUALITY CONTROL AND TO REGULAR IN-SERVICE INSPECTIONS TO ASSURE ITS INTEGRITY. THIS ARRANGEMENT PROVIDES A DOUBLE BARRIER (ONE INSIDE AND ONE OUTSIDE) BETWEEN THE CONTAINMENT AND THE OUTSIDE ATMOSPHERE. SHOULD A LEAK OCCUR OUTSIDE THE CONTAINMENT, THE SEALED BELLOWS INSIDE THE CONTAINMENT, WHICH IS DESIGNED TO WITHSTAND FULL CONTAINMENT DESIGN PRESSURE, WILL PREVENT THE ESCAPE OF THE CONTAINMENT ATMOSPHERE. SHOULD A LEAK OCCUR INSIDE THE CONTAINMENT, THE DIAPHRAGM IN THE TRANSMITTER, WHICH IS DESIGNED TO WITHSTAND FULL CONTAINMENT DESIGN PRESSURE, WILL PREVENT ANY ESCAPE FROM THE CONTAINMENT. THIS ARRANGEMENT PROVIDES AUTOMATIC DOUBLE-BARRIER ISOLATION WITHOUT OPERATOR ACTION AND WITHOUT SACRIFICING ANY RELIABILITY. BECAUSE OF THIS SEALED FLUID FILLED SYSTEM, A POSTULATED SEVERANCE OF THE LINE DURING EITHER NORMAL OPERATION OR ACCIDENT CONDITIONS WILL NOT RESULT IN ANY RELEASE FROM THE CONTAINMENT.

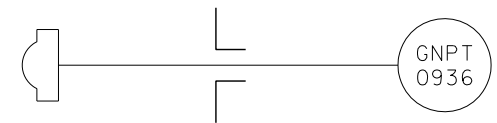

APPENDIX J REQUIREMENT
 TYPE A
 B
 C
 NONE

NOTE 1: MAXIMUM CLOSURE TIMES SPECIFIED IN THIS FIGURE ARE NOMINAL DESIGN OR LICENSING-BASIS VALUES. PERFORMANCE-BASED VALVE OPERABILITY LIMITS FOR VALVE CLOSURE TIMES ARE SPECIFIED PER THE INSERVICE TESTING PROGRAM FOR CALLAWAY.

REFERENCE SECTION 6.3, 9.4

CONTAINMENT PENETRATION NO. P-103
 DESCRIPTION:
 CONTAINMENT PRESSURE TRANSMITTERS
 CONTAINMENT COOLING SYSTEM

CONTAINMENT PENETRATIONS
 FIGURE 6.2.4-1
 PAGE 80 OF 84
 REV. 16 8/16

VALVE NO.	LINE / VALVE SIZE, IN.	INSIDE / OUTSIDE CONT.	NORMAL FLOW DIRECTION	VALVE TYPE	VALVE OPERATOR	POWER SOURCE	PRIMARY ACTUATION SIGNAL	SECONDARY ACTUATION SIGNAL	MAXIMUM CLOSURE TIME (SEC.) (NOTE 1)	VALVE POSITION				
										NORMAL	SHUTDOWN	POWER FAILURE	POST ACCIDENT	
													PRIMARY	SECONDARY
NONE	N/A	N/A	N/A	N/A	N/A	N/A	N/A	N/A	N/A	N/A	N/A	N/A	N/A	N/A

ENGINEERED SAFETY FEATURE SYSTEM YES NO

FLUID CONTAINED: WATER

LENGTH OF PIPING TO OUTERMOST ISOLATION VALVE: N/A

APPLICABLE GDC NO. 56

GENERAL COMMENTS:

GNPT0935 AND GNPT0937
 THERE ARE FOUR INSTRUMENT LINES WHICH PENETRATE THE CONTAINMENT AND WHICH ARE REQUIRED TO REMAIN FUNCTIONAL FOLLOWING A LOCA OR STEAM BREAK. THESE LINES SENSE THE PRESSURE OF CONTAINMENT ATMOSPHERE ON THE INSIDE AND ARE CONNECTED TO PRESSURE TRANSMITTERS ON THE OUTSIDE. SIGNALS FROM THESE TRANSMITTERS CAN INITIATE SAFETY INJECTION AND CONTAINMENT ISOLATION ON HIGH CONTAINMENT PRESSURE. THEY ALSO, UPON HIGH-3 CONTAINMENT PRESSURE, PRODUCE THE ONLY SIGNAL TO INITIATE CONTAINMENT SPRAY. IN VIEW OF THIS FUNCTION, IT IS ESSENTIAL THAT THE LINE REMAIN OPEN AND NOT BE ISOLATED FOLLOWING AN ACCIDENT. BASED ON THIS REQUIREMENT, A SEALED SENSING LINE, AS DESCRIBED BELOW, IS USED.


GNPT0938 IS A WIDE RANGE CONTAINMENT PRESSURE TRANSMITTER REQUIRED BY NUREG-0737 AND REGULATORY GUIDE 1.97.

APPENDIX J REQUIREMENT

TYPE A
 B
 C
 NONE

EACH PRESSURE TRANSMITTER IS LOCATED IMMEDIATELY ADJACENT TO THE OUTSIDE OF THE CONTAINMENT WALL. IT IS CONNECTED TO A SEALED BELLOWS, LOCATED IMMEDIATELY ADJACENT TO THE INSIDE CONTAINMENT WALL, BY MEANS OF A SEALED FLUID FILLED TUBE. THIS TUBING, ALONG WITH THE TRANSMITTER AND BELLOWS, IS CONSERVATIVELY DESIGNED AND SUBJECT TO STRICT QUALITY CONTROL AND TO REGULAR IN-SERVICE INSPECTIONS TO ASSURE ITS INTEGRITY. THIS ARRANGEMENT PROVIDES A DOUBLE BARRIER (ONE INSIDE AND ONE OUTSIDE) BETWEEN THE CONTAINMENT AND THE OUTSIDE ATMOSPHERE. SHOULD A LEAK OCCUR OUTSIDE THE CONTAINMENT, THE SEALED BELLOWS INSIDE THE CONTAINMENT, WHICH IS DESIGNED TO WITHSTAND FULL CONTAINMENT DESIGN PRESSURE, WILL PREVENT THE ESCAPE OF THE CONTAINMENT ATMOSPHERE. SHOULD A LEAK OCCUR INSIDE THE CONTAINMENT, THE DIAPHRAGM IN THE TRANSMITTER, WHICH IS DESIGNED TO WITHSTAND FULL CONTAINMENT DESIGN PRESSURE, WILL PREVENT ANY ESCAPE FROM THE CONTAINMENT. THIS ARRANGEMENT PROVIDES AUTOMATIC DOUBLE-BARRIER ISOLATION WITHOUT OPERATOR ACTION AND WITHOUT SACRIFICING ANY RELIABILITY. BECAUSE OF THIS SEALED FLUID FILLED SYSTEM, A POSTULATED SEVERANCE OF THE LINE DURING EITHER NORMAL OPERATION OR ACCIDENT CONDITIONS WILL NOT RESULT IN ANY RELEASE FROM THE CONTAINMENT.

NOTE 1: MAXIMUM CLOSURE TIMES SPECIFIED IN THIS FIGURE ARE NOMINAL DESIGN OR LICENSING-BASIS VALUES. PERFORMANCE-BASED VALVE OPERABILITY LIMITS FOR VALVE CLOSURE TIMES ARE SPECIFIED PER THE INSERVICE TESTING PROGRAM FOR CALLAWAY.

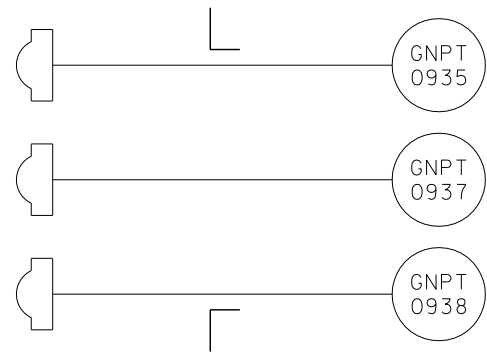

REFERENCE SECTION 6.3, 9.4

CONTAINMENT PENETRATION NO. P-104
 DESCRIPTION:
 CONTAINMENT PRESSURE TRANSMITTERS
 CONTAINMENT COOLING SYSTEM

CONTAINMENT PENETRATIONS
 FIGURE 6.2.4-1
 PAGE 81 OF 84
 REV. 15 3/08

VALVE NO.	LINE / VALVE SIZE, IN.	INSIDE / OUTSIDE CONT.	NORMAL FLOW DIRECTION	VALVE TYPE	VALVE OPERATOR	POWER SOURCE	PRIMARY ACTUATION SIGNAL	SECONDARY ACTUATION SIGNAL	MAXIMUM CLOSURE TIME (SEC.) (NOTE 1)	VALVE POSITION				
										NORMAL	SHUTDOWN	POWER FAILURE	POST ACCIDENT	
													PRIMARY	SECONDARY
GTHZ0009	36/36	OUTSIDE	OUT	BUTTERFLY	AIR	1	CPIS	NONE	10	CLOSED	OPEN	CLOSED	CLOSED	N/A
GTHZ0008	36/36	INSIDE	OUT	BUTTERFLY	AIR	4	CPIS	NONE	10	CLOSED	OPEN	CLOSED	CLOSED	N/A
GTHZ0012	18/18	OUTSIDE	OUT	BUTTERFLY	AIR	1	CPIS	NONE	5	NOTE 1	CLOSED	CLOSED	CLOSED	N/A
GTHZ0011	18/18	INSIDE	OUT	BUTTERFLY	AIR	4	CPIS	NONE	5	NOTE 1	CLOSED	CLOSED	CLOSED	N/A
GTVO236	3/4 / 3/4	OUTSIDE	N/A	GLOBE	MANUAL	N/A	N/A	N/A	N/A	CLOSED	CLOSED	N/A	CLOSED	N/A


ENGINEERED SAFETY FEATURE SYSTEM	YES <input checked="" type="checkbox"/> NO <input type="checkbox"/>
FLUID CONTAINED:	AIR
LENGTH OF PIPING TO OUTERMOST ISOLATION VALVE:	6.3 FT.
APPLICABLE GDC NO.	56

GENERAL COMMENTS:

NOTE 1

THIS VALVE IS INTERMITTENTLY OPENED TO PROVIDE FOR CONTAINMENT MINI-PURGE DURING POWER OPERATION.

NOTE 1: MAXIMUM CLOSURE TIMES SPECIFIED IN THIS FIGURE ARE NOMINAL DESIGN OR LICENSING-BASIS VALUES. PERFORMANCE-BASED VALVE OPERABILITY LIMITS FOR VALVE CLOSURE TIMES ARE SPECIFIED PER THE INSERVICE TESTING PROGRAM FOR CALLAWAY.

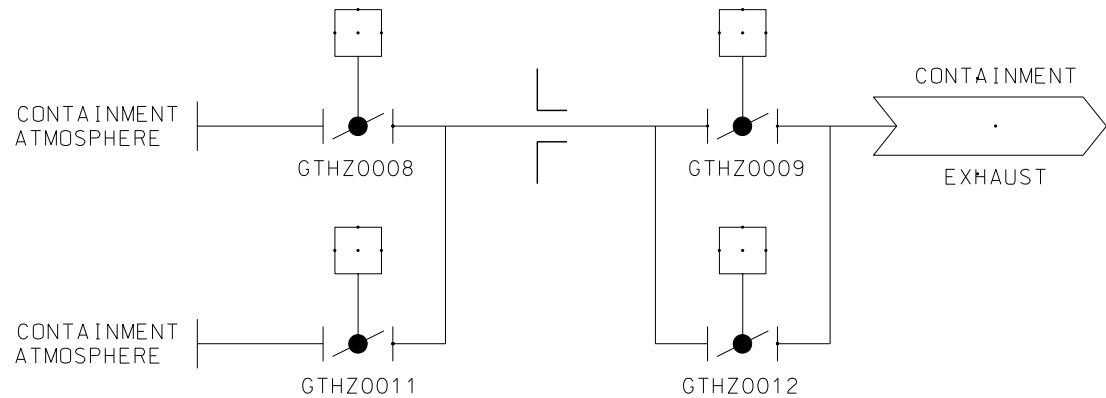

REFERENCE SECTION 9.4

CONTAINMENT PENETRATION NO. V-160
DESCRIPTION:
SHUTDOWN PURGE EXHAUST
CONTAINMENT PURGE SYSTEM

CONTAINMENT PENETRATIONS
FIGURE 6.2.4-1
PAGE 82 OF 84
REV. 14 3/08

APPENDIX J REQUIREMENT

- TYPE A
B
C
NONE

VALVE NO.	LINE / VALVE SIZE, IN.	INSIDE / OUTSIDE CONT.	NORMAL FLOW DIRECTION	VALVE TYPE	VALVE OPERATOR	POWER SOURCE	PRIMARY ACTUATION SIGNAL	SECONDARY ACTUATION SIGNAL	MAXIMUM CLOSURE TIME (SEC.)	VALVE POSITION				
										NORMAL	SHUTDOWN	POWER FAILURE	POST ACCIDENT	
													PRIMARY	SECONDARY
GTHZ0007	36/36	INSIDE	IN	BUTTERFLY	AIR	1	CPIS	NONE	10	CLOSED	OPEN	CLOSED	CLOSED	N/A
GTHZ0005	18/18	INSIDE	IN	BUTTERFLY	AIR	1	CPIS	NONE	5	NOTE 1	CLOSED	CLOSED	CLOSED	N/A
GTHZ0004	18/18	OUTSIDE	IN	BUTTERFLY	AIR	4	CPIS	NONE	5	NOTE 1	CLOSED	CLOSED	CLOSED	N/A
GTHZ0006	36/36	OUTSIDE	IN	BUTTERFLY	AIR	4	CPIS	NONE	10	CLOSED	OPEN	CLOSED	CLOSED	N/A
GTVO235	3/4 / 3/4	OUTSIDE	N/A	GLOBE	MANUAL	N/A	N/A	N/A	N/A	CLOSED	CLOSED	N/A	CLOSED	N/A


ENGINEERED SAFETY FEATURE SYSTEM	YES <input checked="" type="checkbox"/> NO <input type="checkbox"/>
FLUID CONTAINED:	AIR
LENGTH OF PIPING TO OUTERMOST ISOLATION VALVE:	6.3 FT.
APPLICABLE GDC NO.	56

GENERAL COMMENTS:

NOTE 1

THIS VALVE IS INTERMITTENTLY OPENED TO PROVIDE FOR CONTAINMENT MINI-PURGE DURING POWER OPERATION.

NOTE 1: MAXIMUM CLOSURE TIMES SPECIFIED IN THIS FIGURE ARE NOMINAL DESIGN OR LICENSING-BASIS VALUES. PERFORMANCE-BASED VALVE OPERABILITY LIMITS FOR VALVE CLOSURE TIMES ARE SPECIFIED PER THE INSERVICE TESTING PROGRAM FOR CALLAWAY.

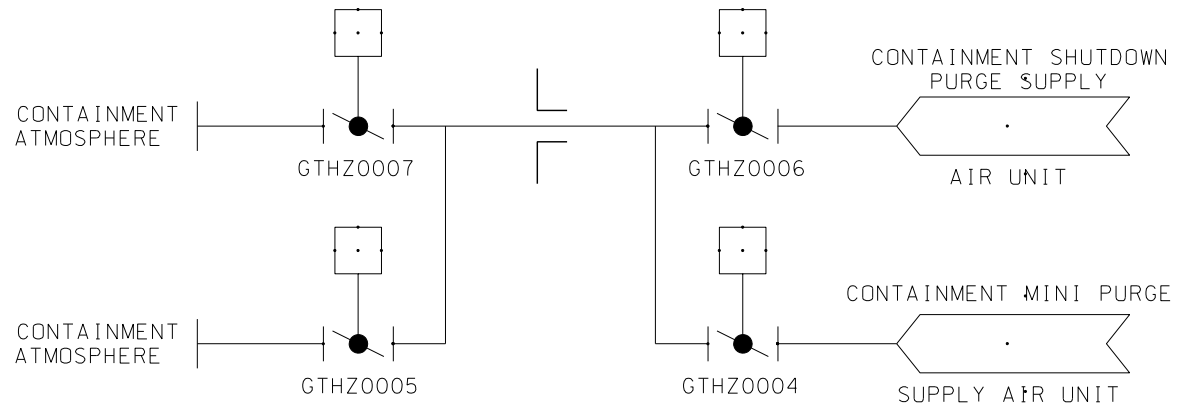

REFERENCE SECTION 9.4

CONTAINMENT PENETRATION NO. V-161
 DESCRIPTION:
 SHUTDOWN PURGE SUPPLY
 CONTAINMENT PURGE SYSTEM

CONTAINMENT PENETRATIONS
 FIGURE 6.2.4-1
 PAGE 83 OF 84
 REV. 14 3/08

APPENDIX J REQUIREMENT

- TYPE A
 B
 C
 NONE

VALVE NO.	LINE / VALVE SIZE, IN.	INSIDE / OUTSIDE CONT.	NORMAL FLOW DIRECTION	VALVE TYPE	VALVE OPERATOR	POWER SOURCE	PRIMARY ACTUATION SIGNAL	SECONDARY ACTUATION SIGNAL	MAXIMUM CLOSURE TIME (SEC.) (NOTE 1)	VALVE POSITION				
										NORMAL	SHUTDOWN	POWER FAILURE	POST ACCIDENT	
													PRIMARY	SECONDARY
NONE	N/A	N/A	N/A	N/A	N/A	N/A	N/A	N/A	N/A	N/A	N/A	N/A	N/A	N/A

ENGINEERED SAFETY FEATURE SYSTEM YES NO

FLUID CONTAINED: WATER

LENGTH OF PIPING TO OUTERMOST ISOLATION VALVE: N/A

APPLICABLE GDC NO. 56

GENERAL COMMENTS:

GNPT0934
 THERE ARE FOUR INSTRUMENT LINES WHICH PENETRATE THE CONTAINMENT AND WHICH ARE REQUIRED TO REMAIN FUNCTIONAL FOLLOWING A LOCA OR STEAM BREAK. THESE LINES SENSE THE PRESSURE OF CONTAINMENT ATMOSPHERE ON THE INSIDE AND ARE CONNECTED TO PRESSURE TRANSMITTERS ON THE OUTSIDE. SIGNALS FROM THESE TRANSMITTERS CAN INITIATE SAFETY INJECTION AND CONTAINMENT ISOLATION ON HIGH CONTAINMENT PRESSURE. THEY ALSO, UPON HIGH-3 CONTAINMENT PRESSURE, PRODUCE THE ONLY SIGNAL TO INITIATE CONTAINMENT SPRAY. IN VIEW OF THIS FUNCTION, IT IS ESSENTIAL THAT THE LINE REMAIN OPEN AND NOT BE ISOLATED FOLLOWING AN ACCIDENT. BASED ON THIS REQUIREMENT, A SEALED SENSING LINE, AS DESCRIBED BELOW, IS USED.


GNPT0939 IS A WIDE RANGE CONTAINMENT PRESSURE TRANSMITTER REQUIRED BY NUREG-0737 AND REGULATORY GUIDE 1.97.

APPENDIX J REQUIREMENT

TYPE A
 B
 C
 NONE

EACH PRESSURE TRANSMITTER IS LOCATED IMMEDIATELY ADJACENT TO THE OUTSIDE OF THE CONTAINMENT WALL. IT IS CONNECTED TO A SEALED BELLOWS, LOCATED IMMEDIATELY ADJACENT TO THE INSIDE CONTAINMENT WALL, BY MEANS OF A SEALED FLUID FILLED TUBE. THIS TUBING, ALONG WITH THE TRANSMITTER AND BELLOWS, IS CONSERVATIVELY DESIGNED AND SUBJECT TO STRICT QUALITY CONTROL AND TO REGULAR IN-SERVICE INSPECTIONS TO ASSURE ITS INTEGRITY. THIS ARRANGEMENT PROVIDES A DOUBLE BARRIER (ONE INSIDE AND ONE OUTSIDE) BETWEEN THE CONTAINMENT AND THE OUTSIDE ATMOSPHERE. SHOULD A LEAK OCCUR OUTSIDE THE CONTAINMENT, THE SEALED BELLOWS INSIDE THE CONTAINMENT, WHICH IS DESIGNED TO WITHSTAND FULL CONTAINMENT DESIGN PRESSURE, WILL PREVENT THE ESCAPE OF THE CONTAINMENT ATMOSPHERE. SHOULD A LEAK OCCUR INSIDE THE CONTAINMENT, THE DIAPHRAGM IN THE TRANSMITTER, WHICH IS DESIGNED TO WITHSTAND FULL CONTAINMENT DESIGN PRESSURE, WILL PREVENT ANY ESCAPE FROM THE CONTAINMENT. THIS ARRANGEMENT PROVIDES AUTOMATIC DOUBLE-BARRIER ISOLATION WITHOUT OPERATOR ACTION AND WITHOUT SACRIFICING ANY RELIABILITY. BECAUSE OF THIS SEALED FLUID FILLED SYSTEM, A POSTULATED SEVERANCE OF THE LINE DURING EITHER NORMAL OPERATION OR ACCIDENT CONDITIONS WILL NOT RESULT IN ANY RELEASE FROM THE CONTAINMENT.


NOTE 1: MAXIMUM CLOSURE TIMES SPECIFIED IN THIS FIGURE ARE NOMINAL DESIGN OR LICENSING-BASIS VALUES. PERFORMANCE-BASED VALVE OPERABILITY LIMITS FOR VALVE CLOSURE TIMES ARE SPECIFIED PER THE INSERVICE TESTING PROGRAM FOR CALLAWAY.

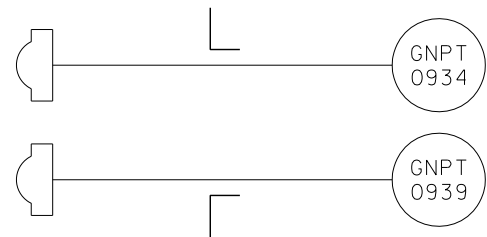

REFERENCE SECTION 6.3.9.4

CONTAINMENT PENETRATION NO. E-256
 DESCRIPTION:
 CONTAINMENT PRESSURE TRANSMITTERS
 CONTAINMENT COOLING SYSTEM



CONTAINMENT PENETRATIONS
 FIGURE 6.2.4-1
 PAGE 84 OF 84
 REV. 16 8/16

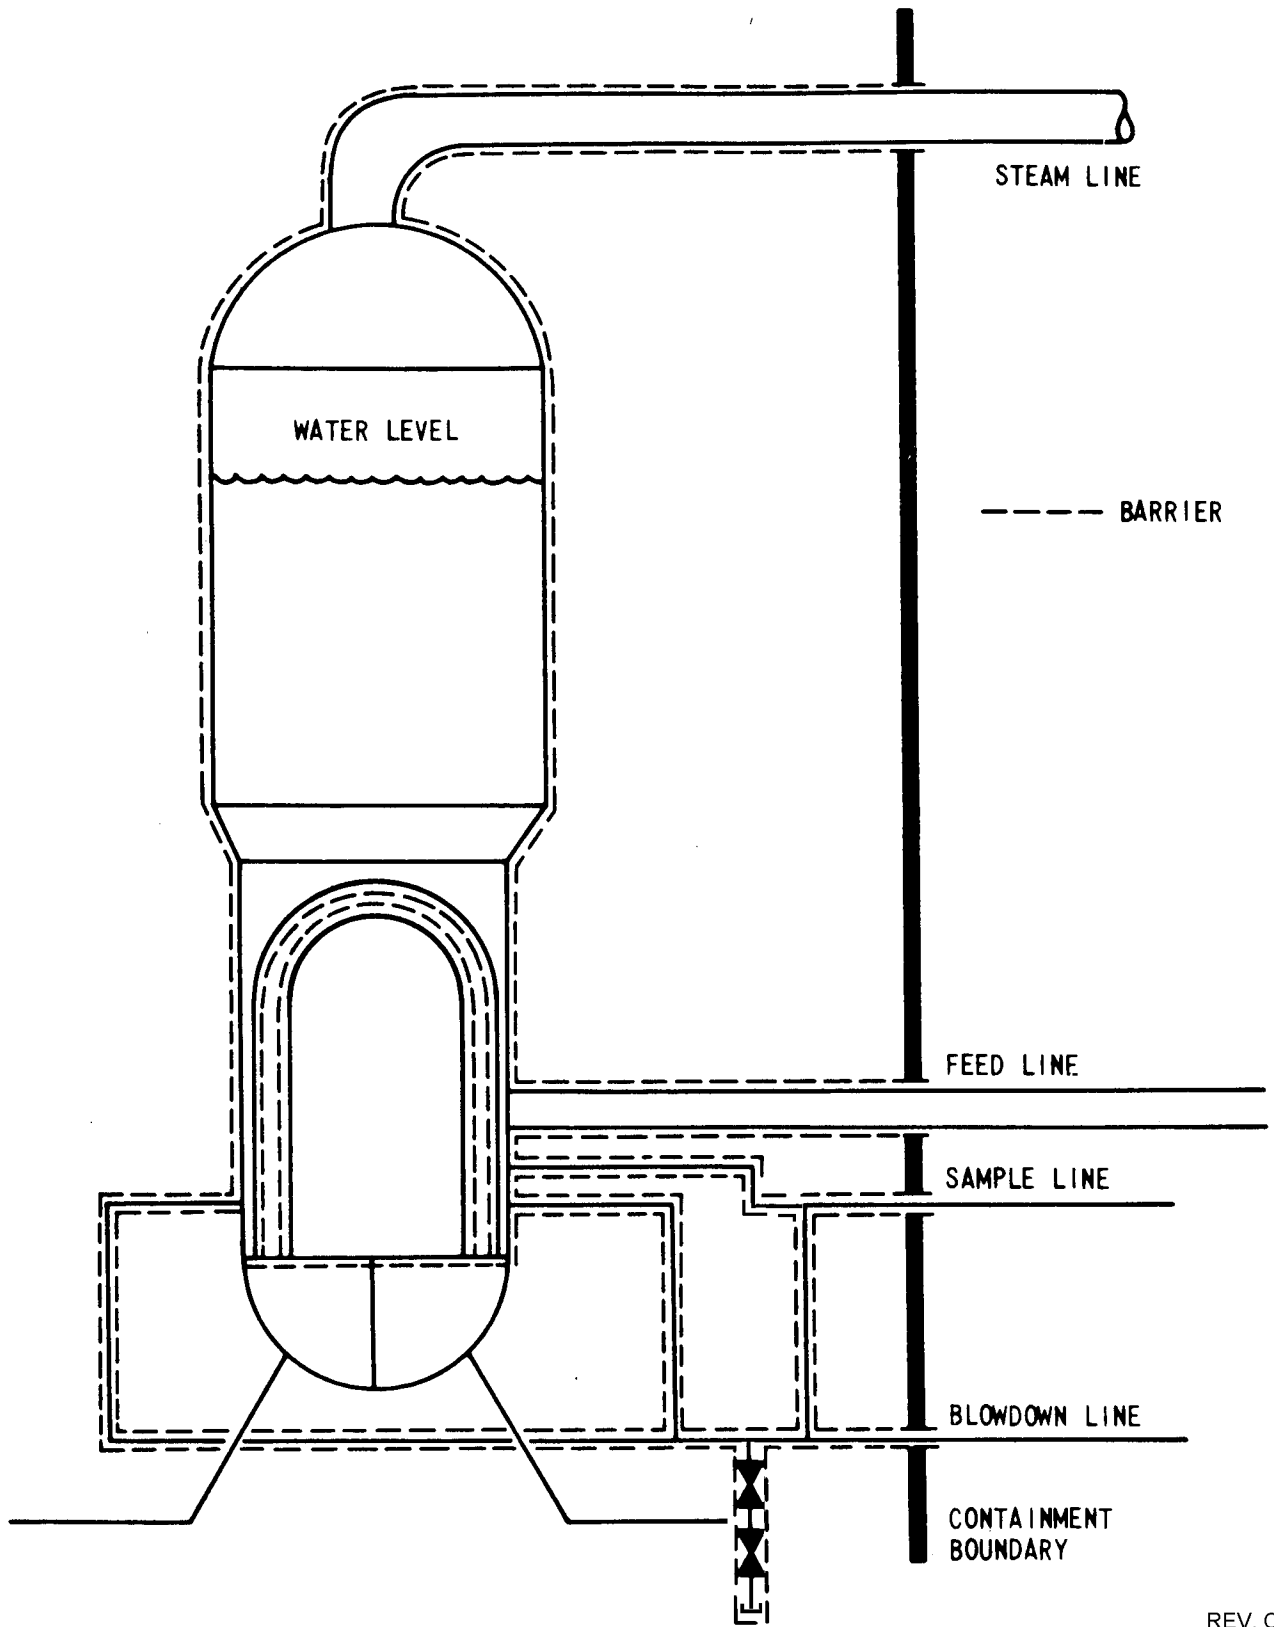

REV. OL-15
5/06

CALLAWAY PLANT
<p>FIGURE 6.2.4-2</p> <p>STEAM GENERATOR AND ASSOCIATED SYSTEMS AS A BARRIER TO THE RELEASE OF RADIOACTIVITY POST LOCA</p>

REV.	DATE	DRAWN	BY
1	0210	GDC	DJB
2	0324	DJB	TJM
3	0628	DJB	TJM
4	0917	DJB	TJM
5	0812	RLW	TWS
6	1028	RLW	TWS
7	0419	RLW	TWS
8	0202	RLW	TWS
9	0210	RLW	TWS
10	1028	RLW	TWS

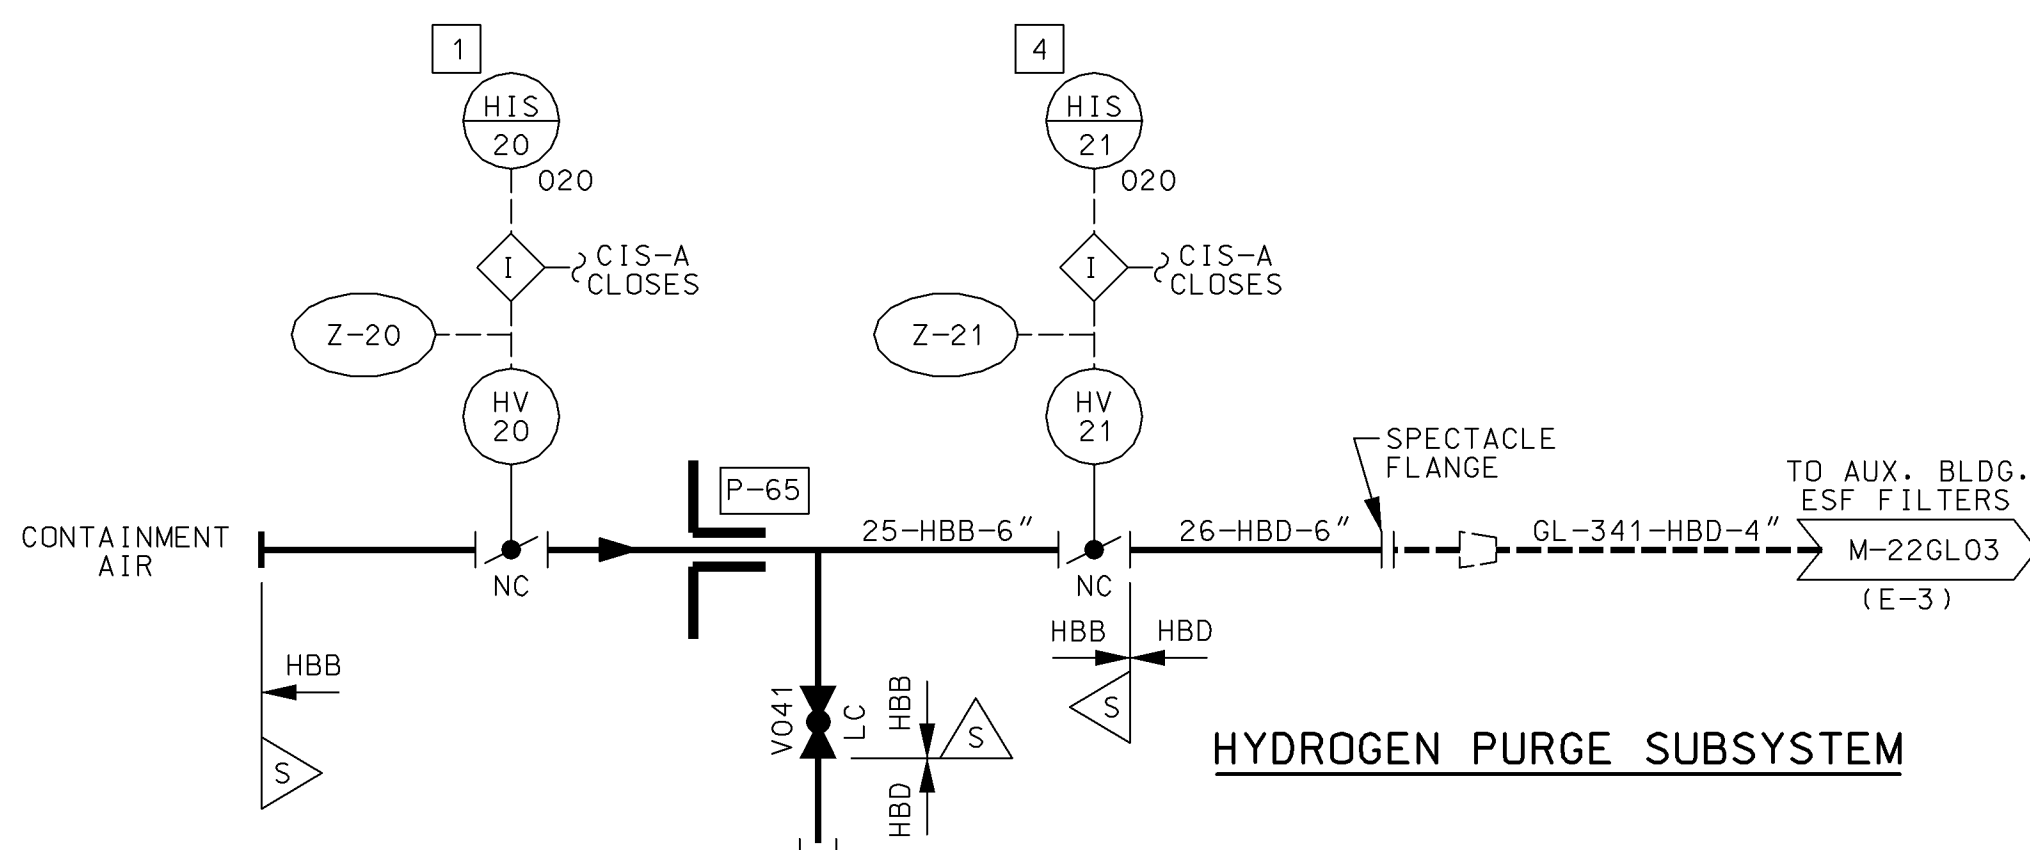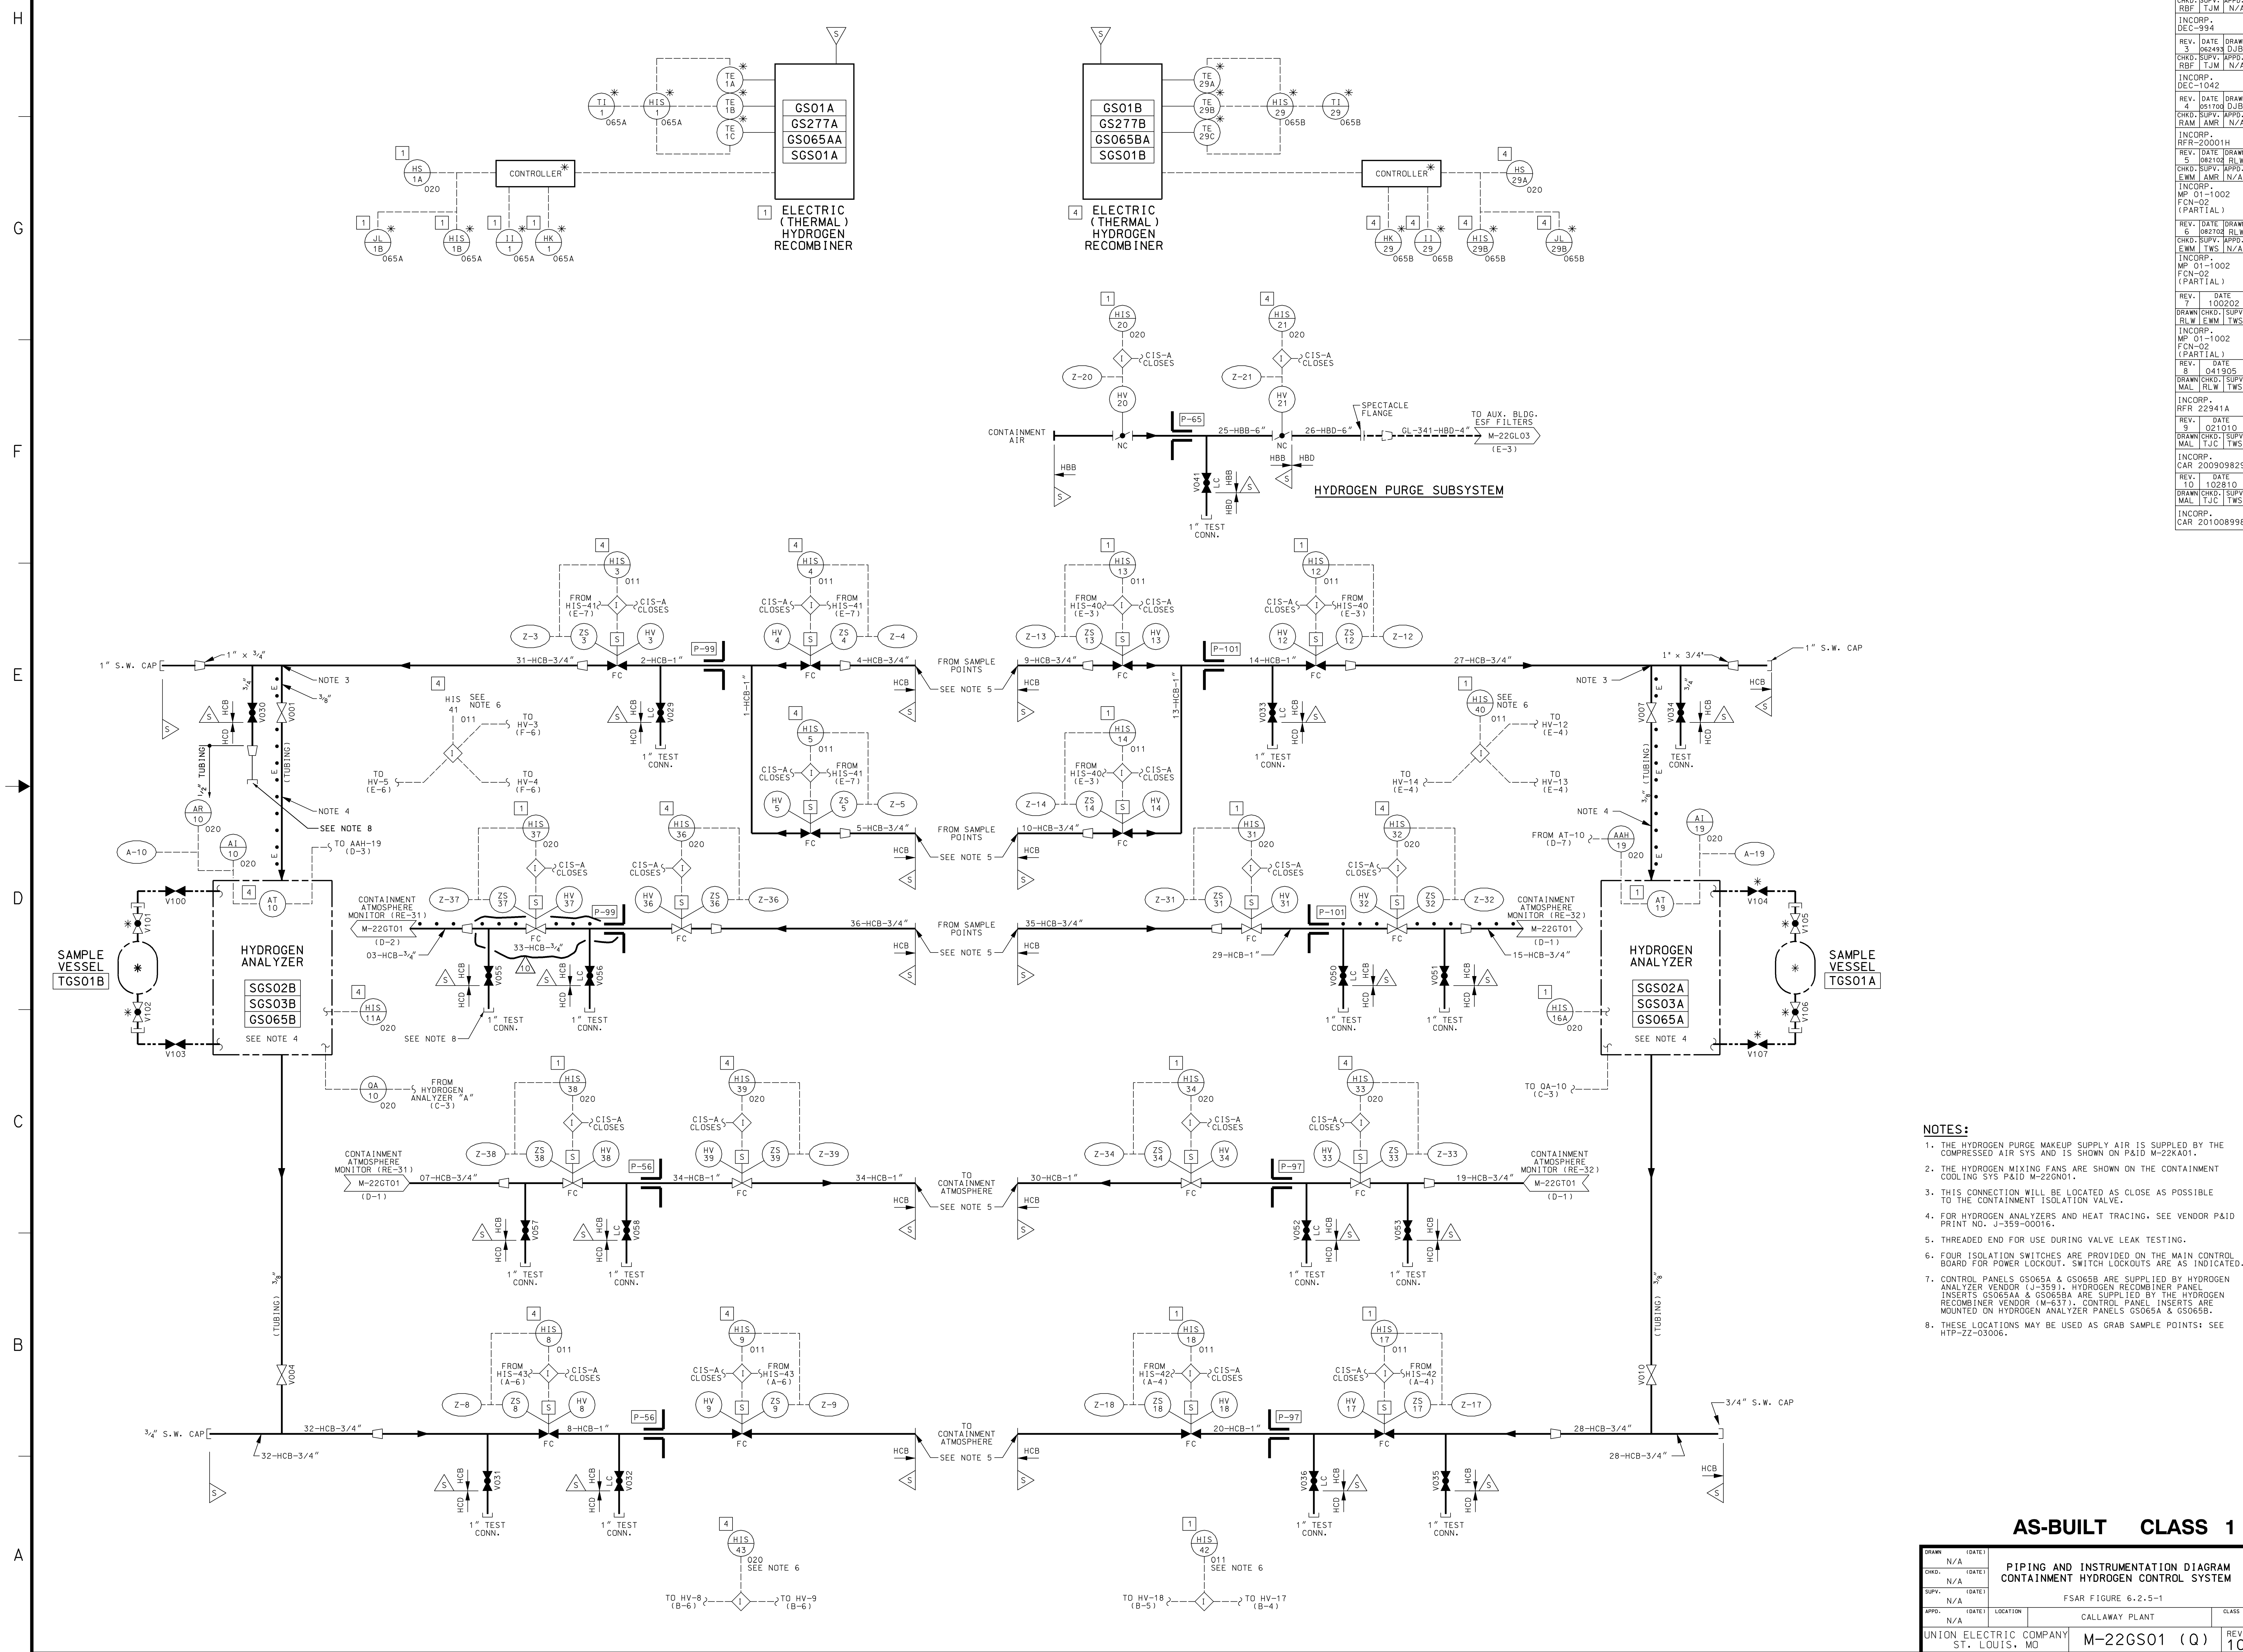


- NOTES:**
1. THE HYDROGEN PURGE MAKEUP SUPPLY AIR IS SUPPLIED BY THE COMPRESSED AIR SYS AND IS SHOWN ON P&ID M-22KA01.
 2. THE HYDROGEN MIXING FANS ARE SHOWN ON THE CONTAINMENT COOLING SYS P&ID M-22GN01.
 3. THIS CONNECTION WILL BE LOCATED AS CLOSE AS POSSIBLE TO THE CONTAINMENT ISOLATION VALVE.
 4. FOR HYDROGEN ANALYZERS AND HEAT TRACING, SEE VENDOR P&ID PRINT NO. J-359-00016.
 5. THREADED END FOR USE DURING VALVE LEAK TESTING.
 6. FOUR ISOLATION SWITCHES ARE PROVIDED ON THE MAIN CONTROL BOARD FOR POWER LOCKOUT. SWITCH LOCKOUTS ARE AS INDICATED.
 7. CONTROL PANELS GS065A & GS065B ARE SUPPLIED BY HYDROGEN ANALYZER VENDOR (J-359). HYDROGEN RECOMBINER PANEL INSERTS GS065AA & GS065BA ARE SUPPLIED BY THE HYDROGEN RECOMBINER VENDOR (M-637). CONTROL PANEL INSERTS ARE MOUNTED ON HYDROGEN ANALYZER PANELS GS065A & GS065B.
 8. THESE LOCATIONS MAY BE USED AS GRAB SAMPLE POINTS; SEE HTF-ZZ-03006.

AS-BUILT CLASS 1

DRAWN	N/A	DATE	
CHKD.	N/A	DATE	
SUPV.	N/A	DATE	
APPD.	N/A	LOCATION	CALLAWAY PLANT
UNION ELECTRIC COMPANY ST. LOUIS, MO			REV. 10


PIPING AND INSTRUMENTATION DIAGRAM
CONTAINMENT HYDROGEN CONTROL SYSTEM
FSAR FIGURE 6-2.5-1

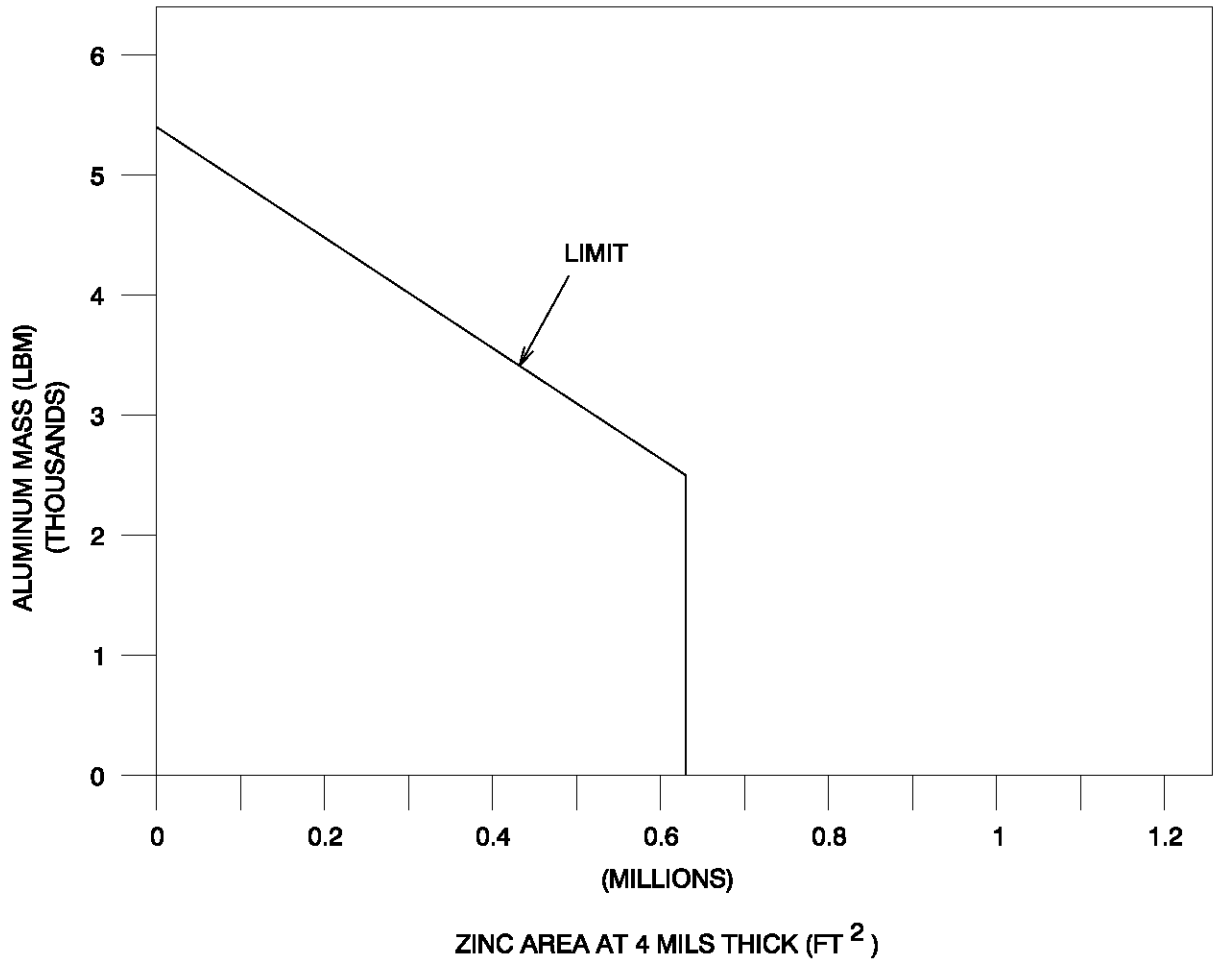


CALLAWAY PLANT

**FIGURE 6.2.5-2
REV OL-8 11/95**

**MAXIMUM ALLOWABLE
QUANTITIES OF ALUMINUM
AND ZINC IN CONTAINMENT**

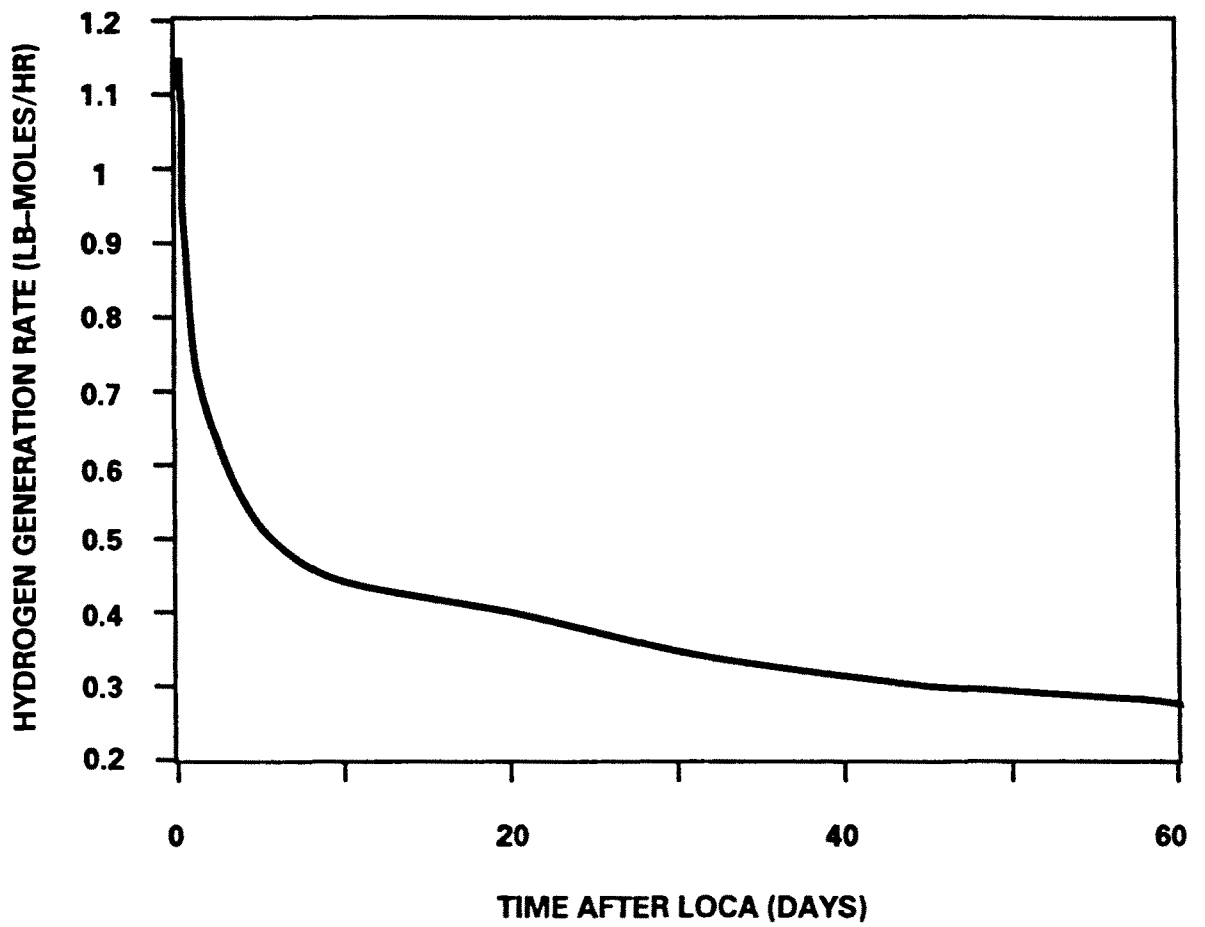


CALLAWAY PLANT	
FIGURE 6.2.5-4	REV 0L-3 6/89
HYDROGEN GENERATION IN CONTAINMENT	

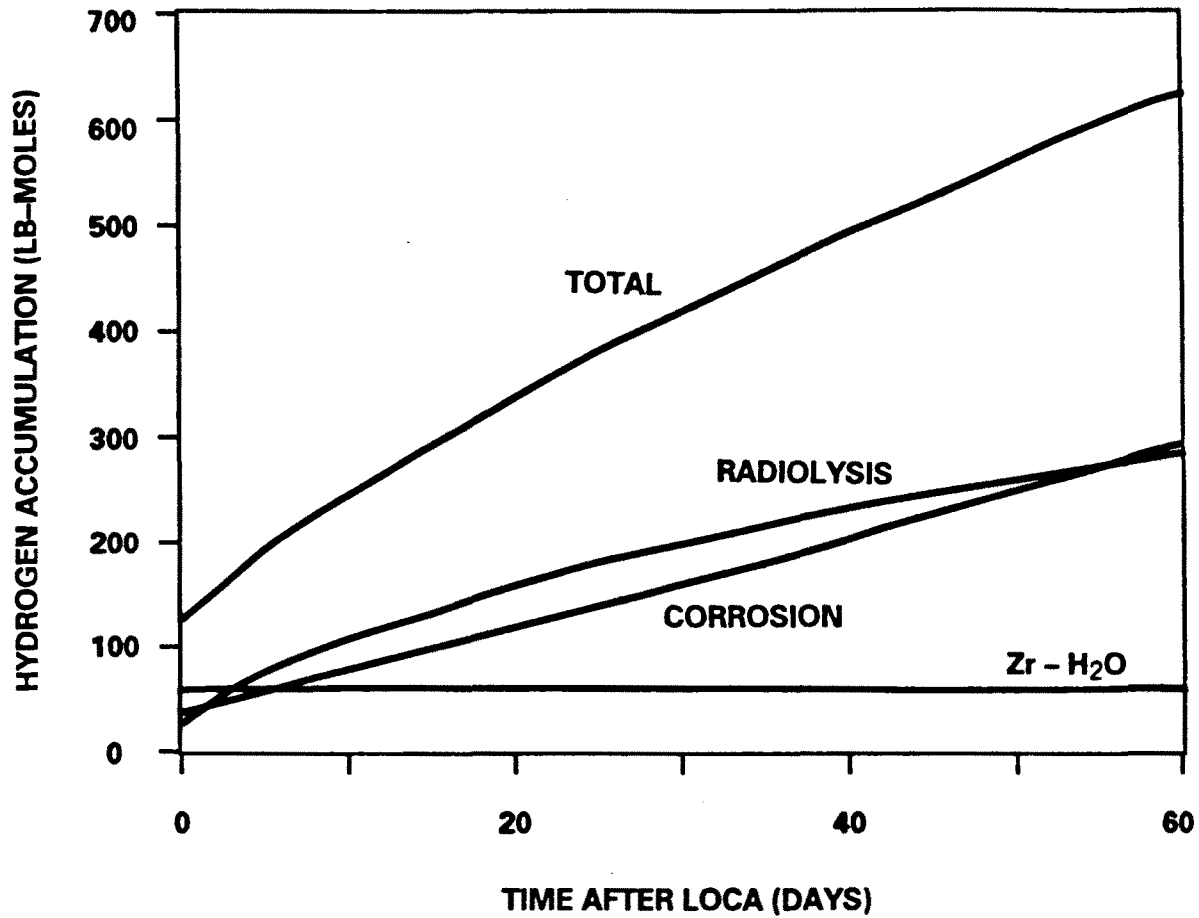

CALLAWAY PLANT

FIGURE 6.2.5-5 REV 0L-3
6/89


**HYDROGEN ACCUMULATION IN
CONTAINMENT**

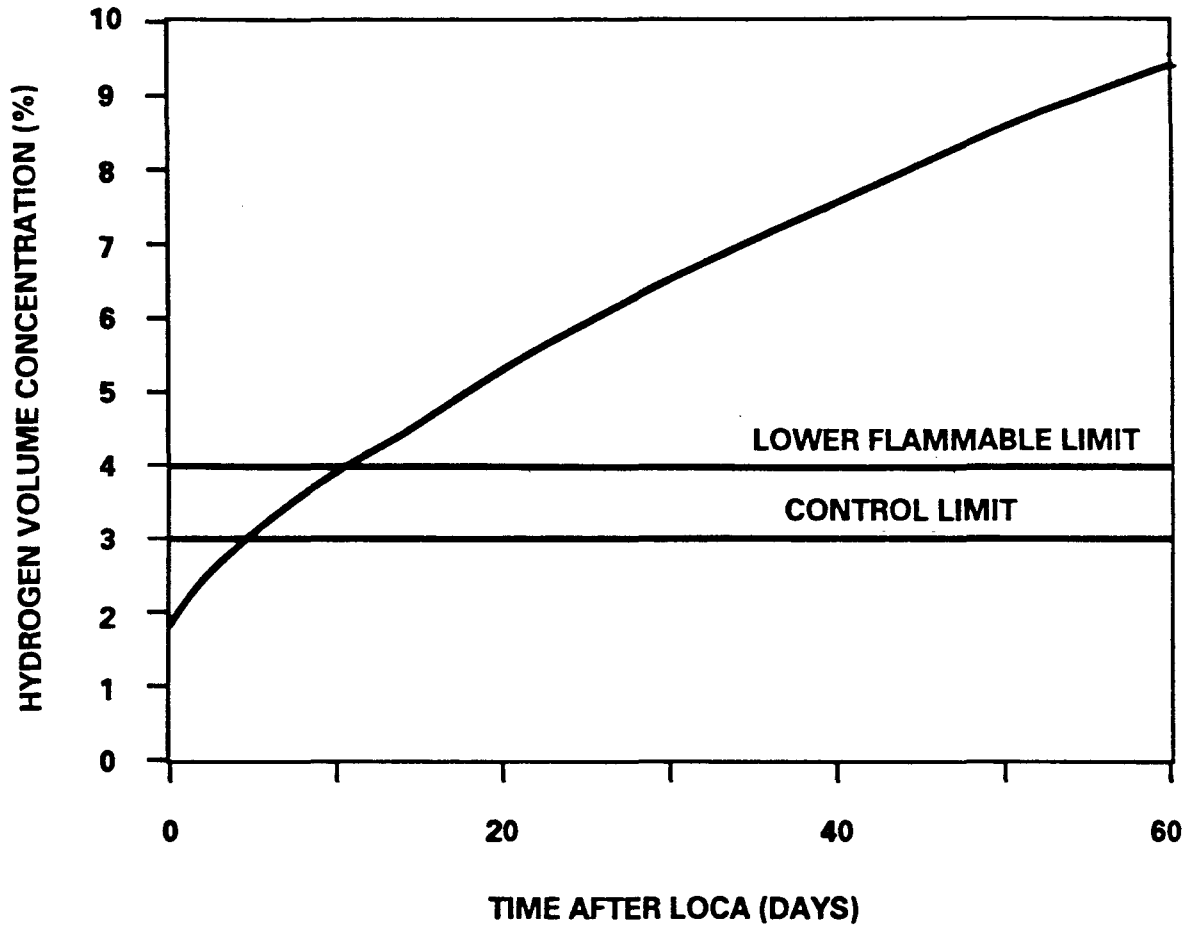




CALLAWAY PLANT

FIGURE 6.2.5-6 REV 0L-3
6/89



**HYDROGEN VOLUME CONCENTRATION
IN CONTAINMENT ASSUMING NO
PREVENTIVE ACTION TAKEN**

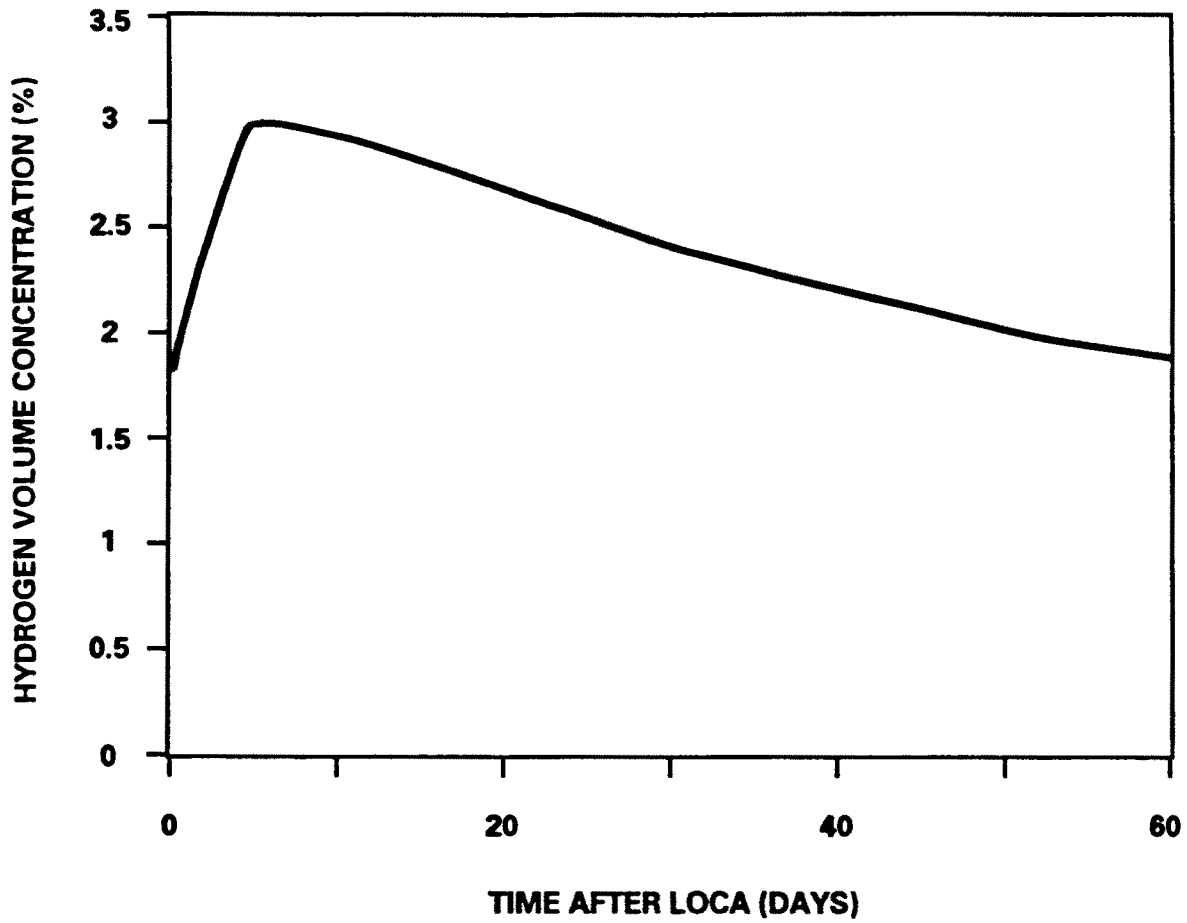

CALLAWAY PLANT	
FIGURE 6.2.5-7	REV 0L-3 6/89
HYDROGEN VOLUME CONCENTRATION IN CONTAINMENT WITH PURGING AFTER 5.1 DAYS	

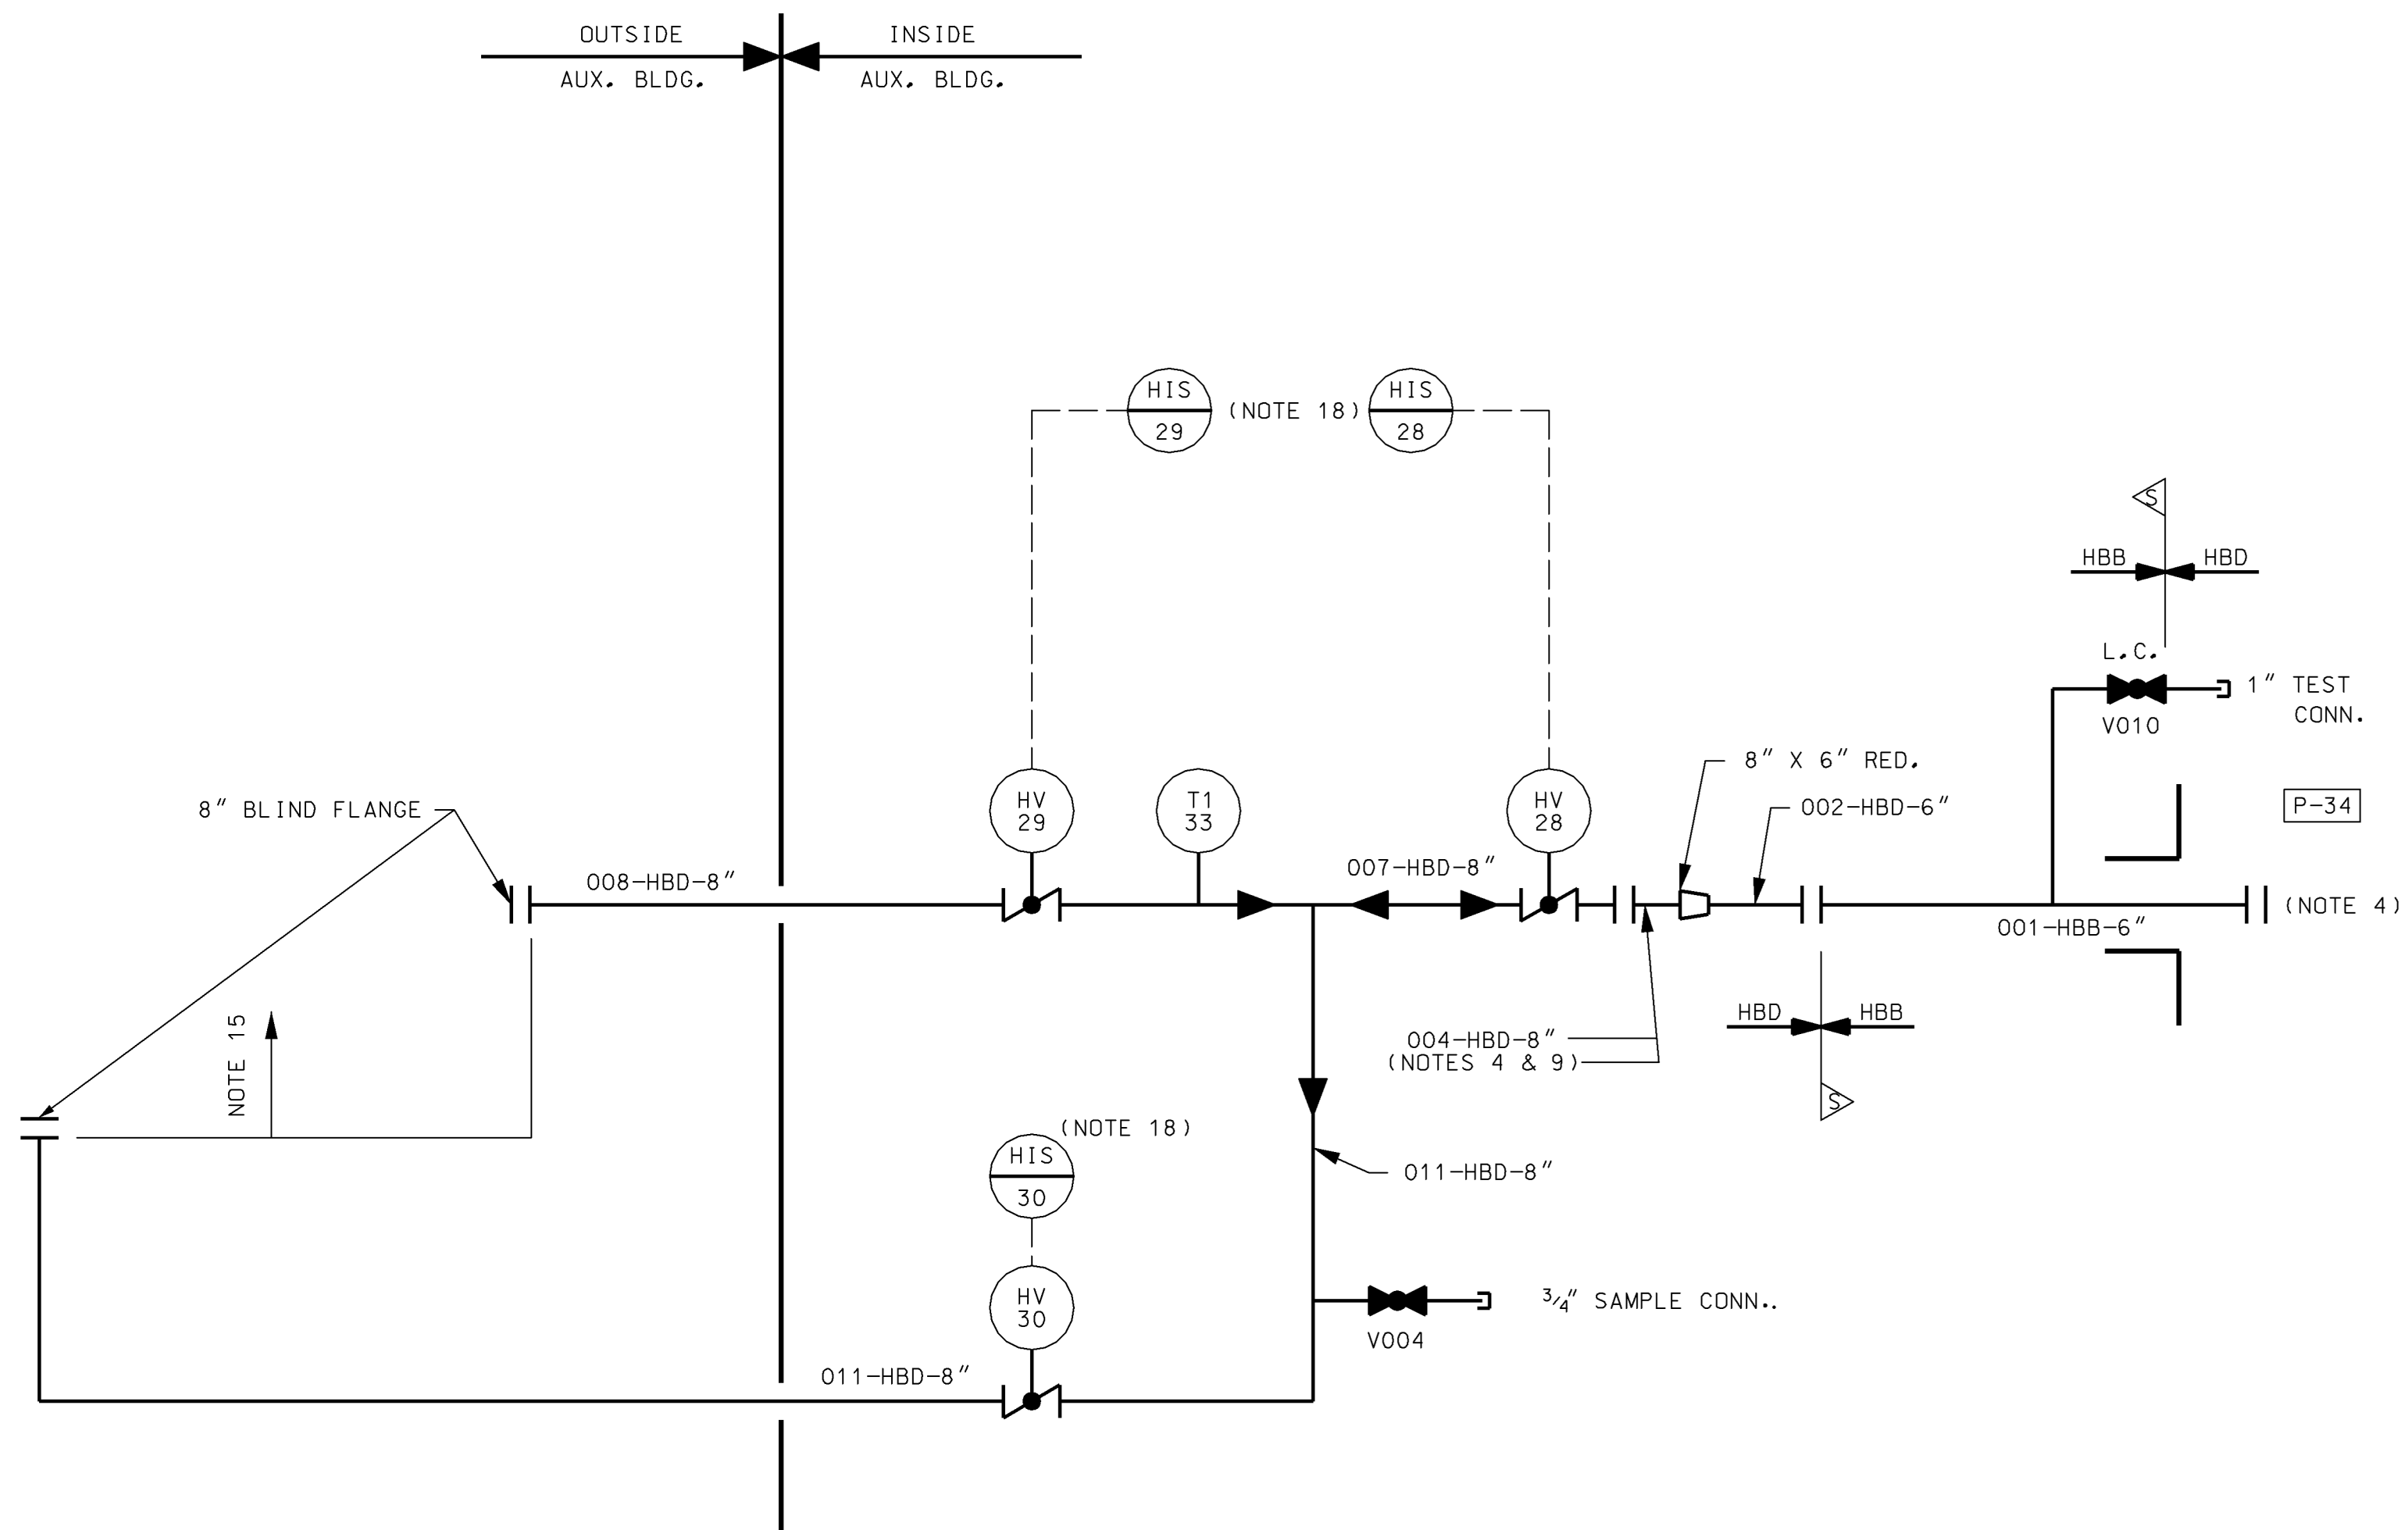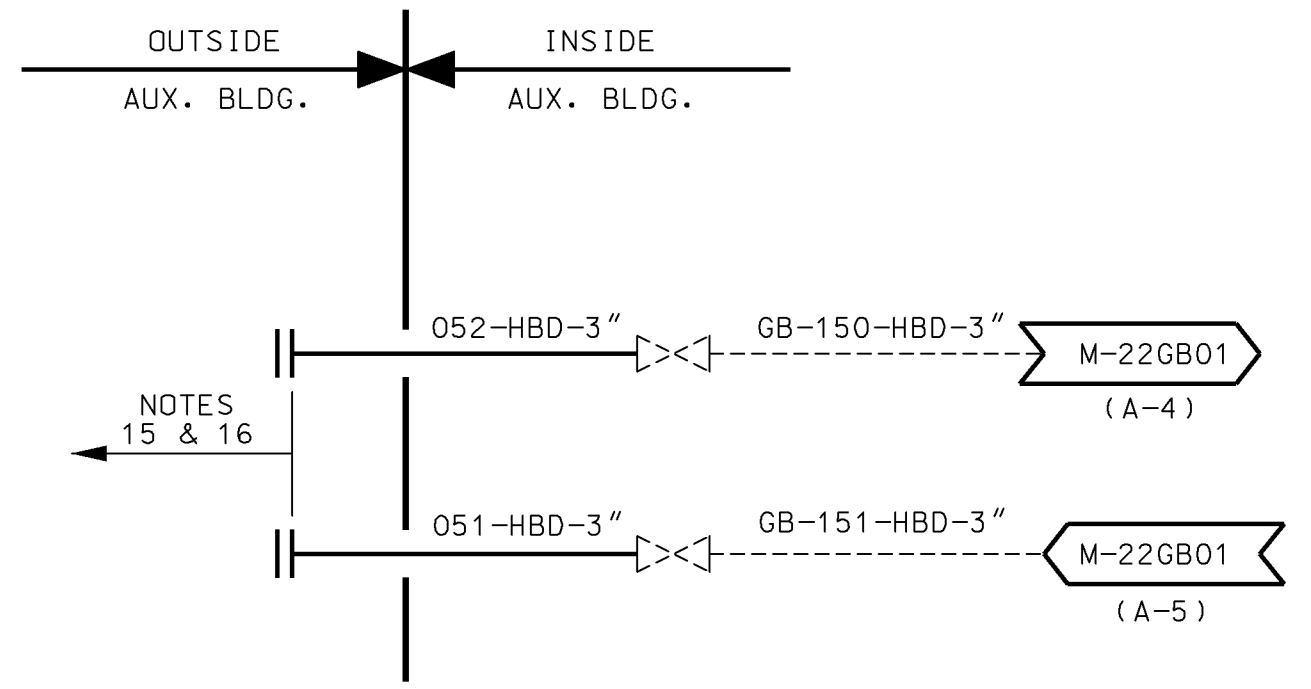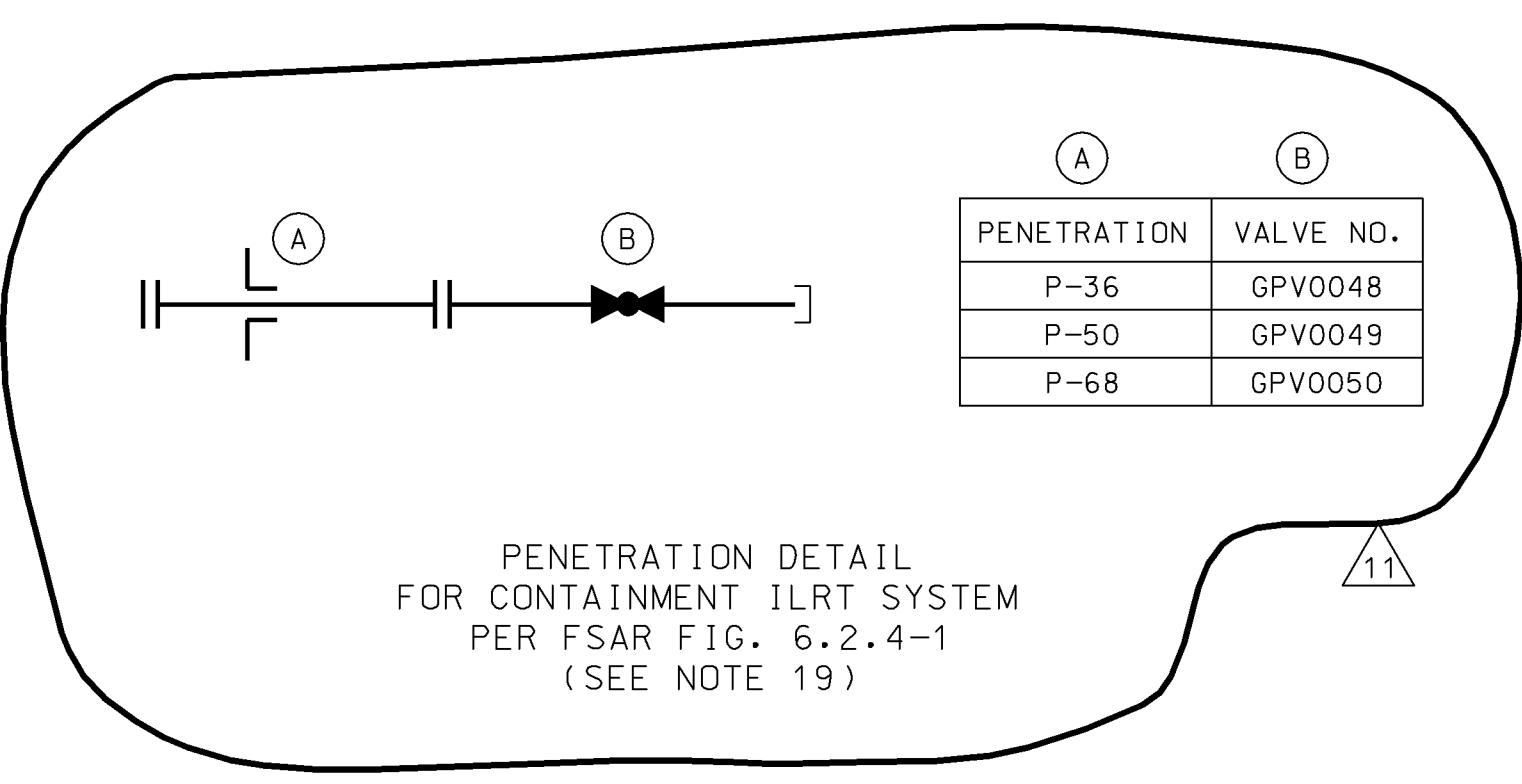


CTMT. TEMPERATURE MONITORS (24) (NOTE 8)

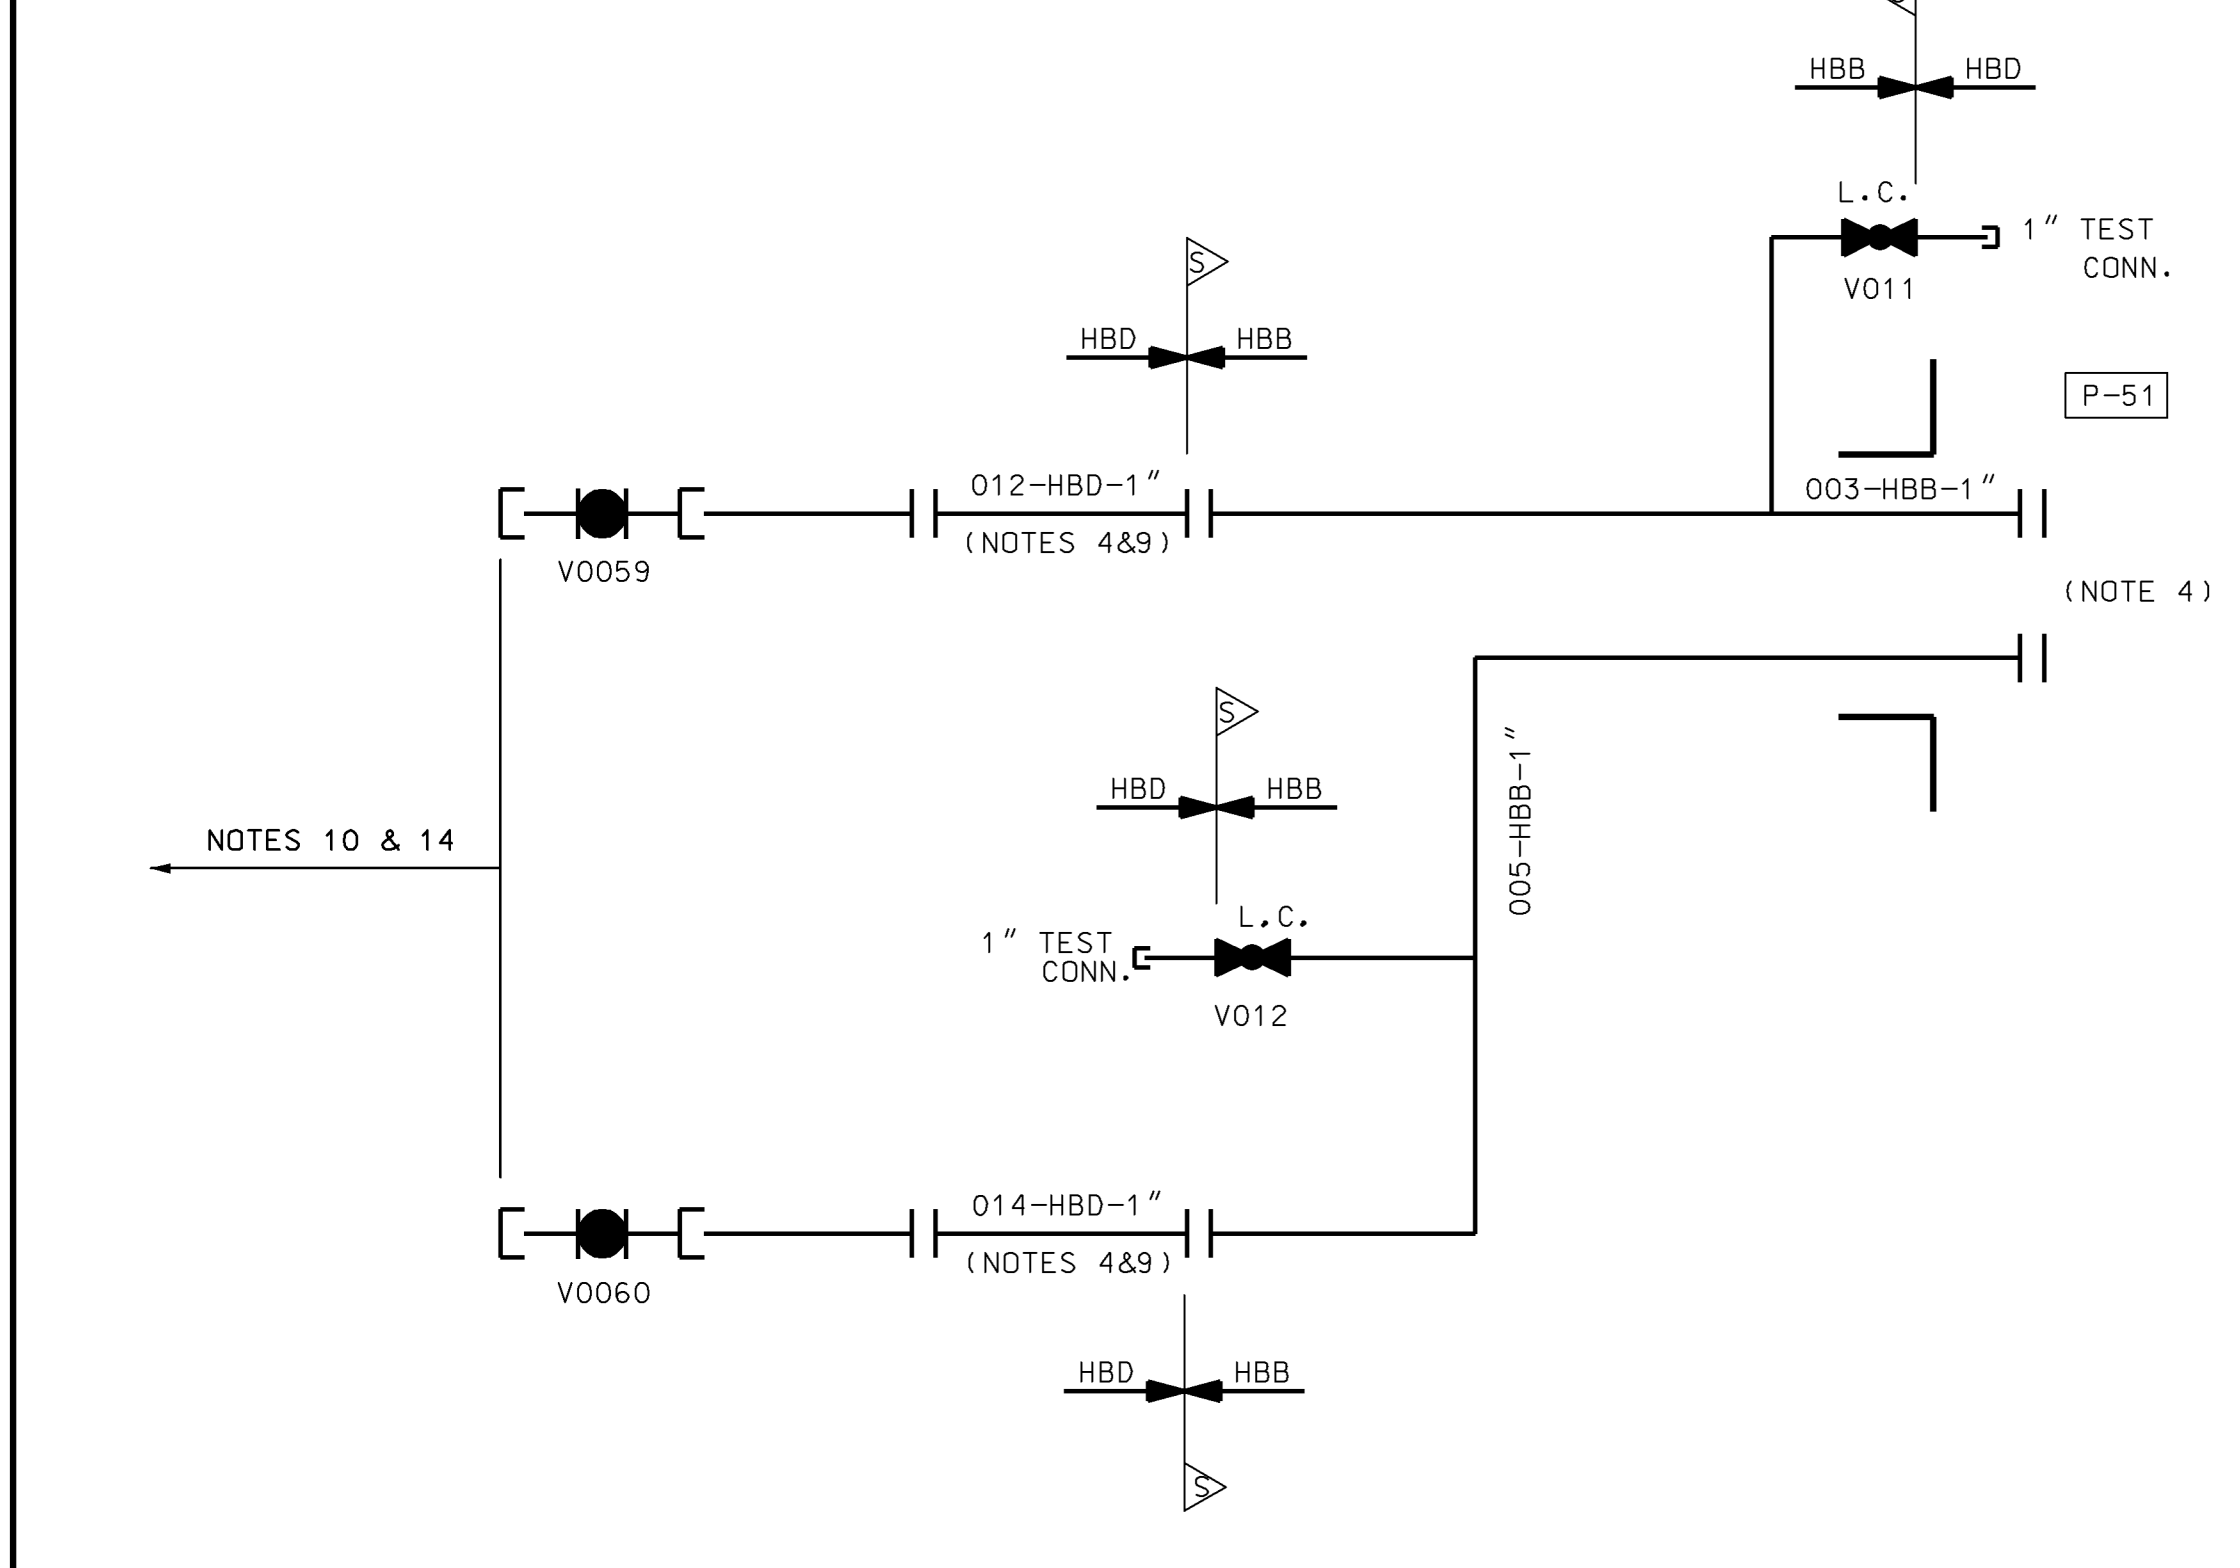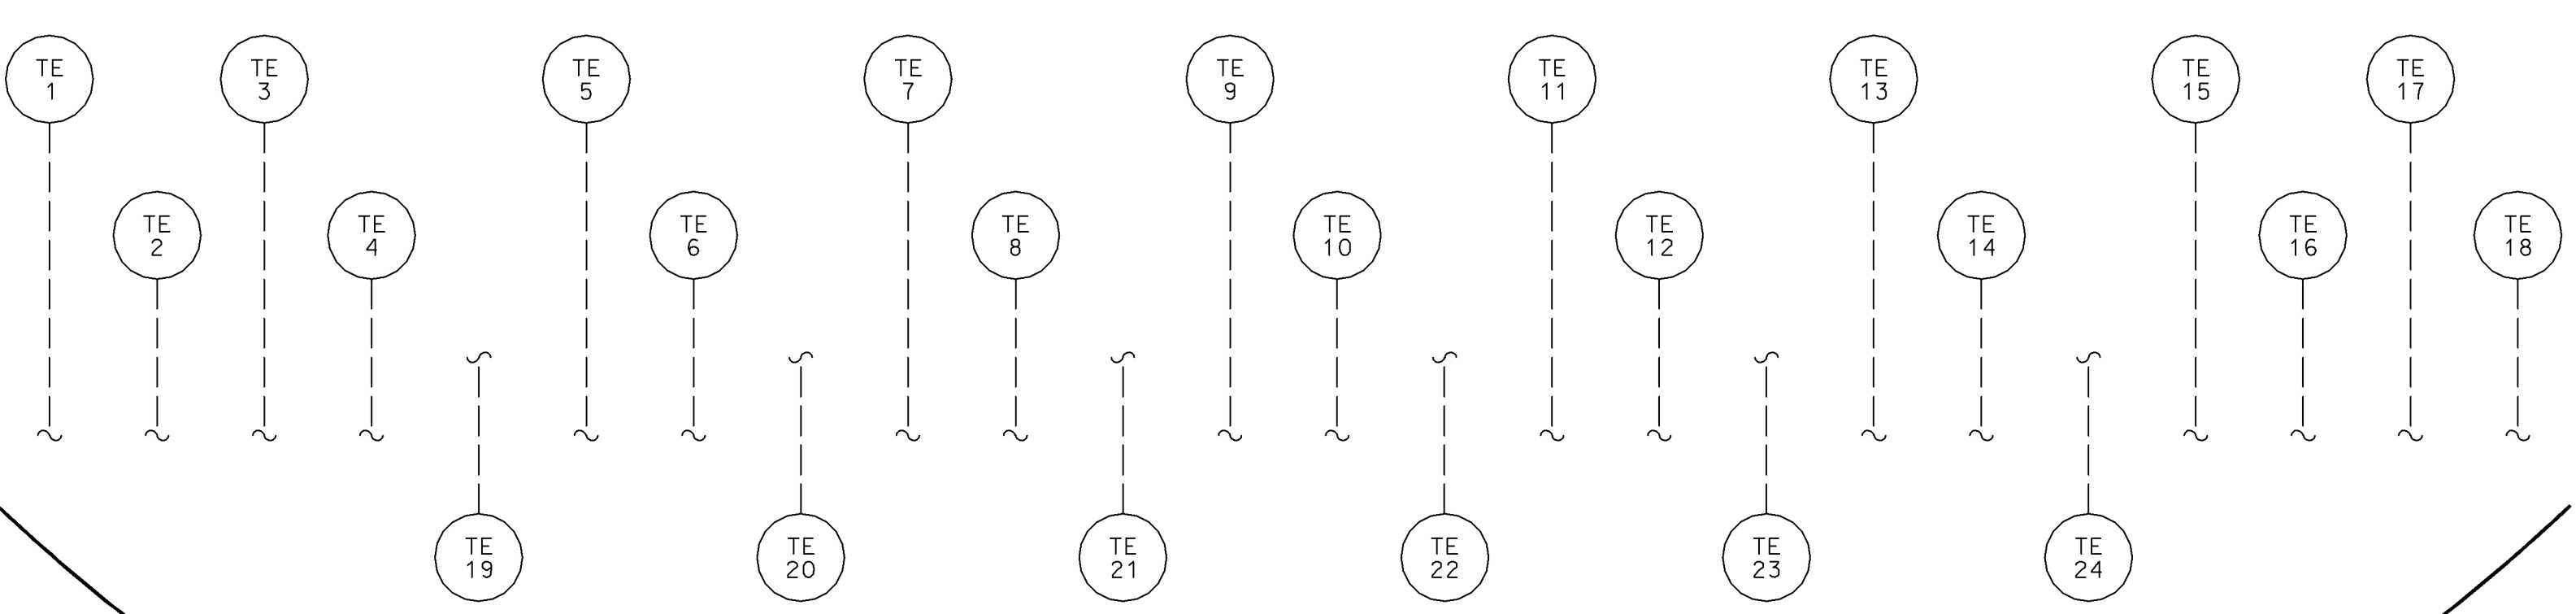

NOTES:

- DELETED.
- DELETED.
- DELETED.
- BLIND FLANGE TO BE INSTALLED DURING NORMAL OPERATION.
- DELETED.
- DELETED.
- EACH RELATIVE HUMIDITY SENSOR WILL BE PAIRED WITH A TEMPERATURE SENSOR TO PROVIDE DEWPOINT INFORMATION.
- CTMT TEMP. MONITORS, DEWPOINT MONITORS, PANELS AND ASSOCIATED INSTRUMENTATION (INCLUDING INTER-CONNECTIONS) CAN BE PROVIDED BY THE UTILITY. SEE E-23GP02 AND E-23GP03 FOR INSTRUMENTATION DETAILS. OPTIONAL VENDOR INSTRUMENTATION AND DATA ACQUISITION EQUIPMENT CAN USE THE INSTALLED CABLING AS SHOWN ON E-23GP02 AND E-23GP03.
- SPOOL PIECE INSTALLED ONLY DURING ILRT.
- FLOW AND PRESSURE INSTRUMENTATION FOR ILRT ACTIVITIES ARE INSTALLED AT THESE CONNECTION POINTS.
- DELETED.
- DELETED.
- DELETED.
- CAP TO BE INSTALLED FOR NORMAL PLANT OPERATION.
- BLIND FLANGES INSTALLED DURING NORMAL PLANT OPERATION. AIR COMPRESSORS AND ASSOCIATED SUPPORT EQUIPMENT FOR ILRT ACTIVITIES ARE INSTALLED AT THESE CONNECTION POINTS. THIS EQUIPMENT IS SUPPLIED BY THE UTILITY.
- BLIND FLANGES REMOVED AND HOSE CONNECTIONS INSTALLED DURING USE FOR RWST COOLING.
- DATA CAN BE TRANSMITTED IN A DIGITAL FORMAT TO THE PLANT COMPUTER. DIGITAL INTERFACE IS LOCATED IN CABINET GP-348.
- GPHIS28, GPHIS29 AND GPHIS30 ARE LOCATED ON THE WALL ACROSS FROM THE VALVES AT AUX. BLDG. EL. 2000' COL. LINES AN-A13 (GRID LOCATION AFDS).
- THIS DETAIL DOES NOT APPLY TO THE PERFORMANCE OF TYPE A TESTS.

CTMT. DEWPOINT MONITORS (NOTES 7, 8 & 17)

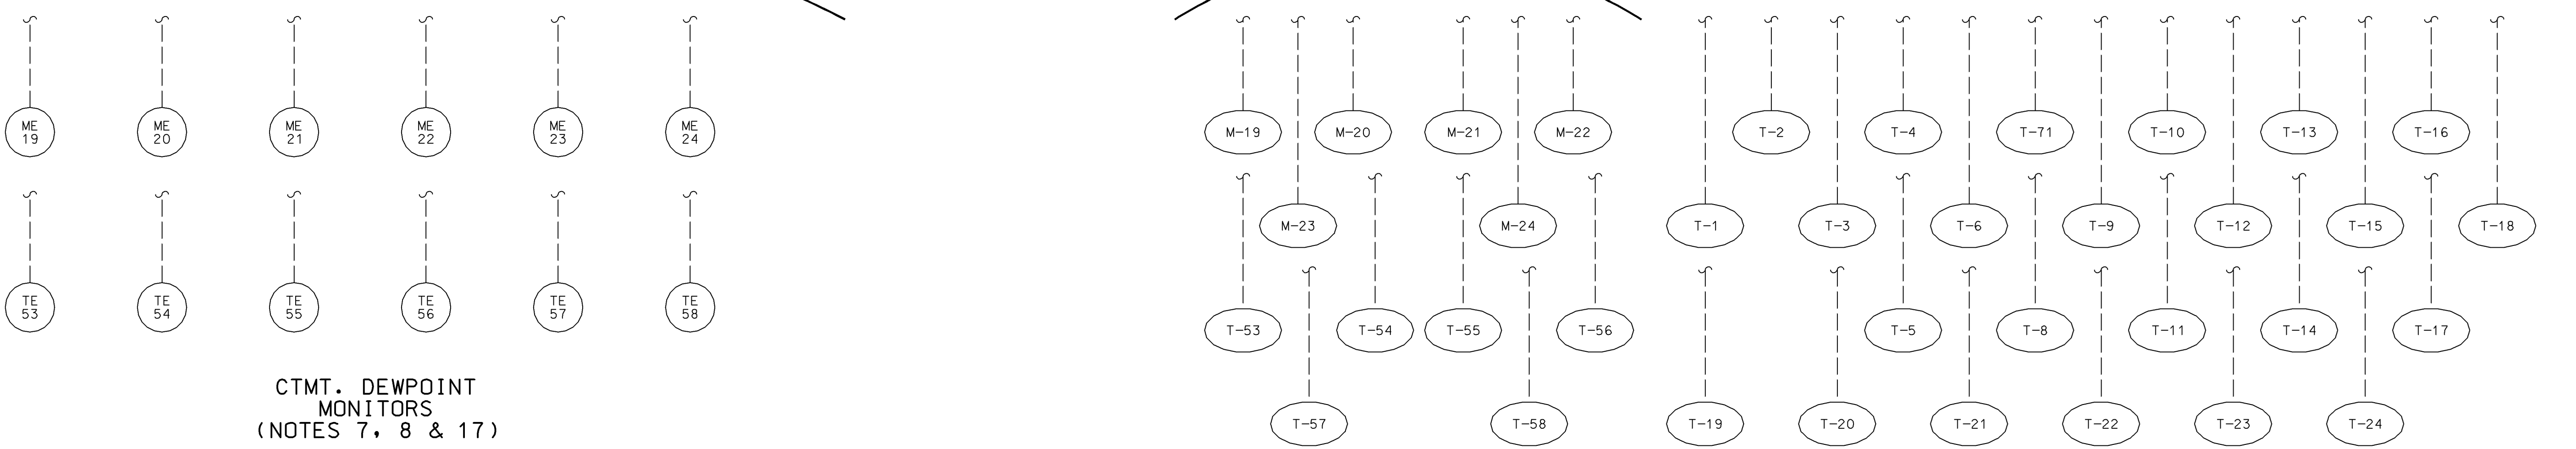

AS-BUILT CLASS 1

DRAWN	N/A	(DATE)	
CHKD.	N/A	(DATE)	
SUPV.	N/A	(DATE)	
APPR.	N/A	(DATE)	
UNION ELECTRIC COMPANY		ST. LOUIS, MO	
CALLAWAY ENERGY CENTER			
M-22GP01(Q)			
REV.	11		

Callaway
Final Safety Analysis Report
Revision OL-22

Chapter 6 drawings
FSAR Figures 6.2.1-76, 6.2.2-2, sheet 1
and 6.2.2-7
are withheld Per
Regulatory Issue Summary 2015-17