




9305040166-01

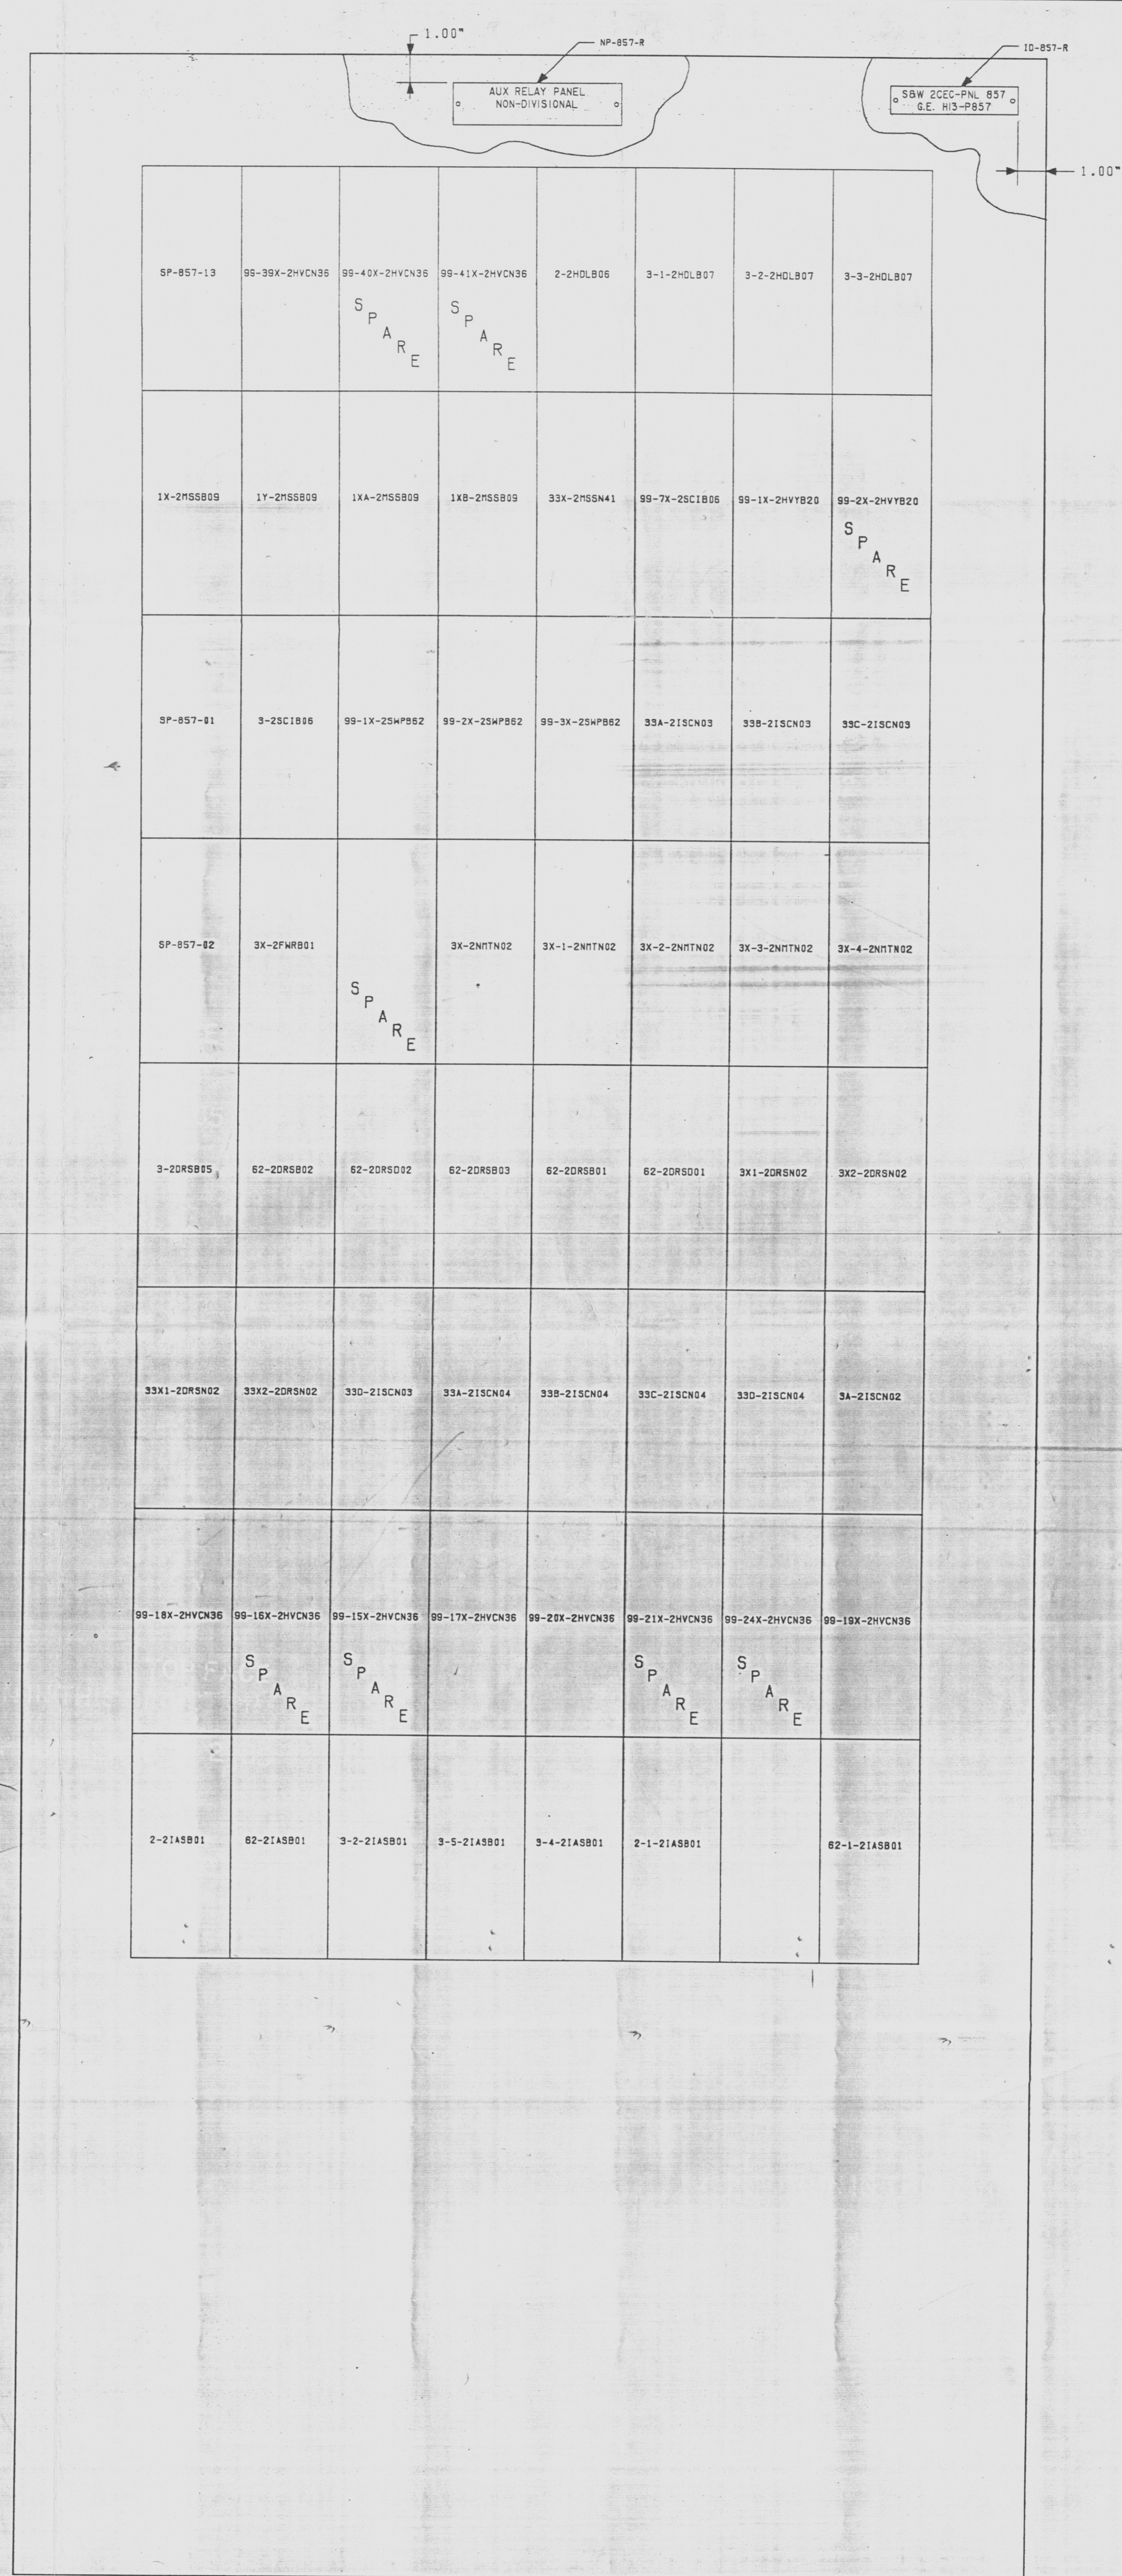

- NOTES:
- SCALE: NONE
  - SEE EQUIPMENT LIST ESK-4CEC128.
  - PROVIDE ACCESS DOORS ON EACH BAY.
  - UNLESS OTHERWISE NOTED, ALL RELAYS ARE TYPE GP.
  - RELAYS, TIMERS, ETC., SHOWN IN ASSIGNED LOCATIONS, BUT WITH OUT-LINE & SIZE OMITTED FOR CLARITY.
  - PROVIDE MFG. PNL. FOR DEVICES AS SHOWN.
  - FUSES TO BE INSIDE CABINET BAY, POINTED ON SIDE PANELS. SEE EQUIPMENT LIST.
  - UNLESS OTHERWISE SPECIFIED, ALL DIMENSIONS SHOWN ARE IN INCHES.

AS-BUILT DEVICE LOCATION REQUIRED
33A-21SCN03
33B-21SCN03
33C-21SCN03
33D-21SCN03
33A-21SCN04
33B-21SCN04
33C-21SCN04
33D-21SCN04

9. FOR ALL PANEL ENTRIES, NAMEPLATES WILL BE SUPPLIED IN ACCORDANCE WITH ESK-28, FIGURE XXXI-A. ENGRAVING TO BE 2 LINES AS FOLLOWS:  
CONTACT SSS  
PRIOR TO PANEL ENTRY

REDRAWN  
12

ARRANGEMENT  
AUXILIARY RELAY PANEL 2CEC-PNL857  
NINE MILE POINT NUCLEAR STATION-UNIT 2  
NIAGARA MOHAWK POWER CORPORATION  
STONE & WEBSTER ENGINEERING CORPORATION  
12177-ESK-4CEC28A

9305040166