


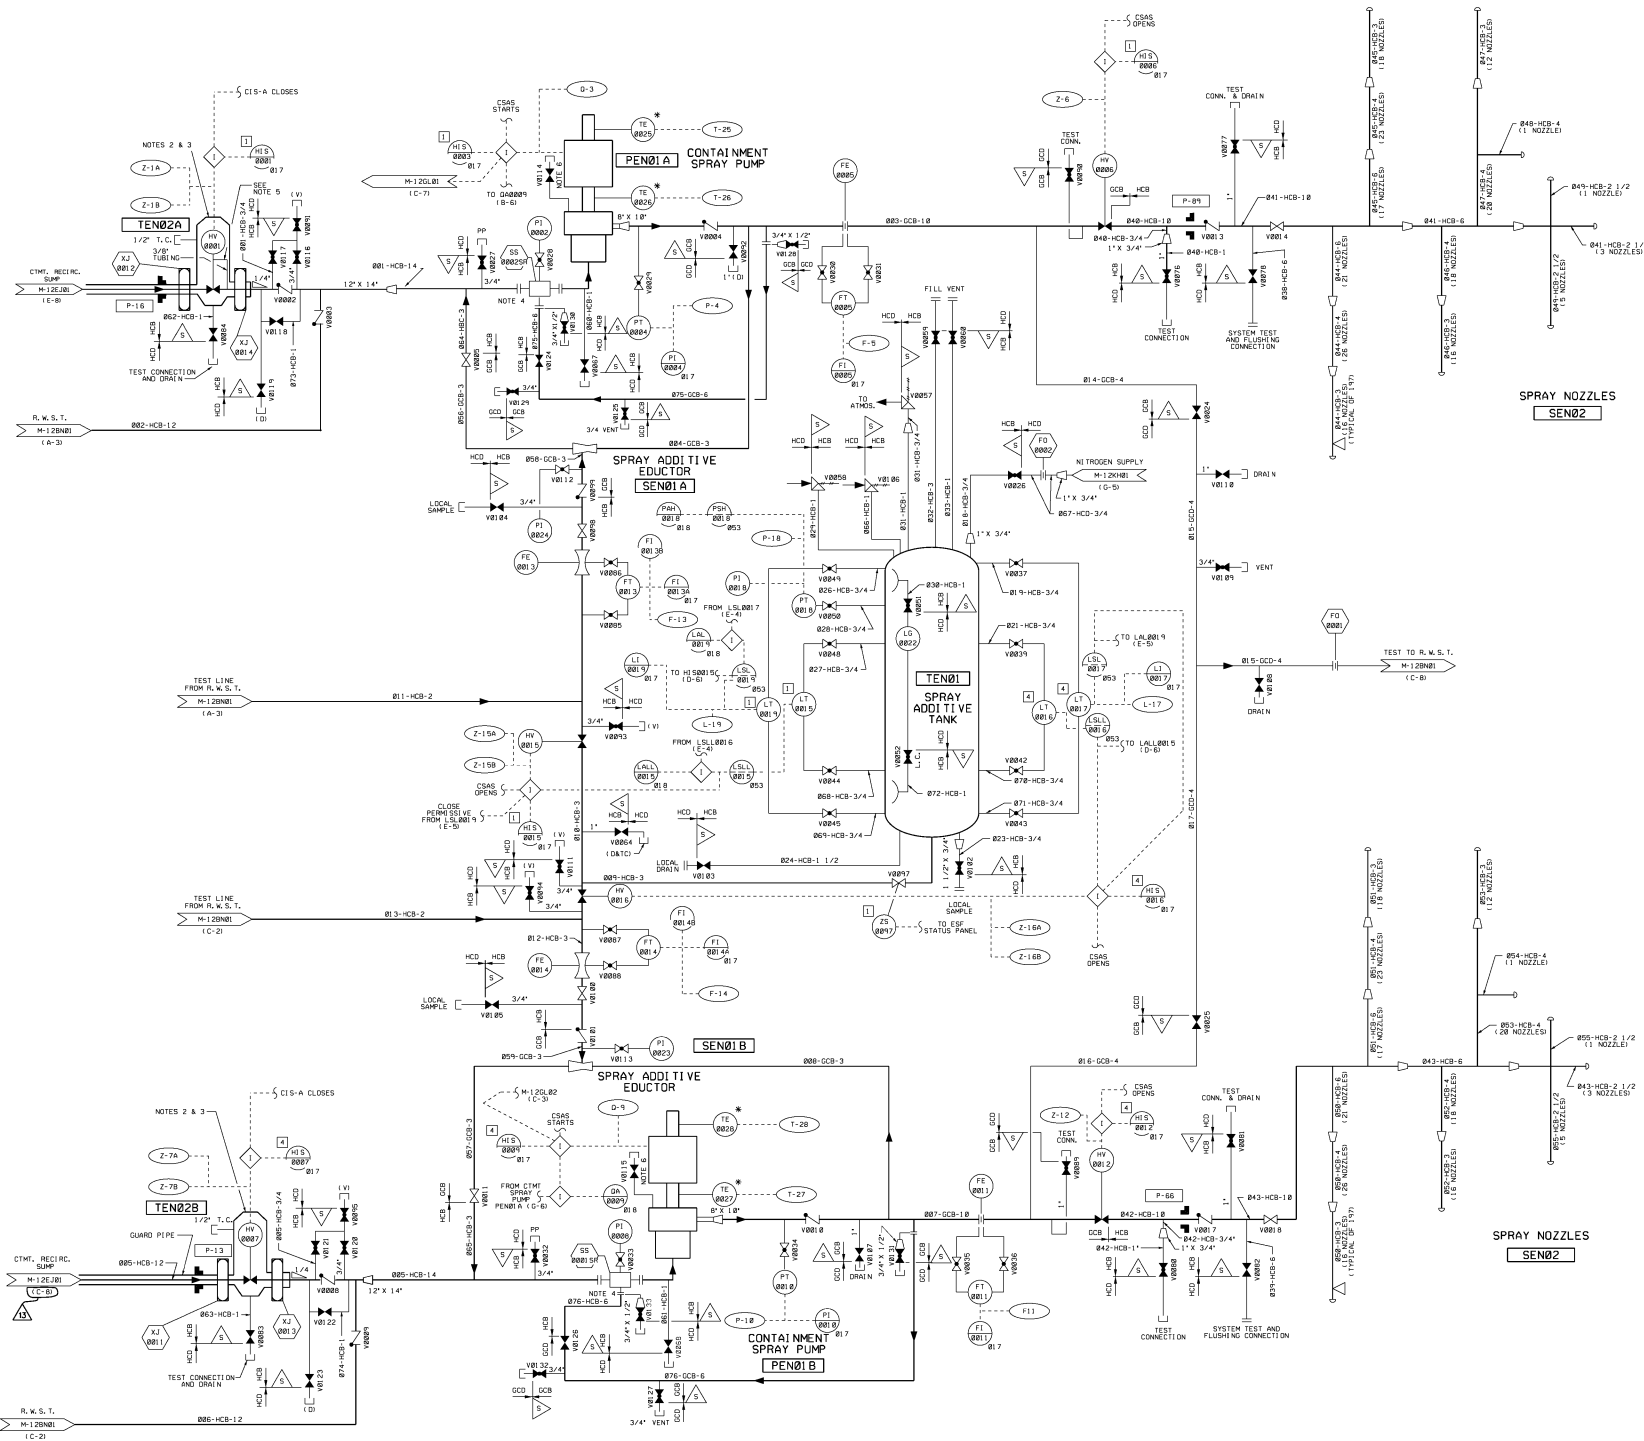

NOTES

1. DELETED.
2. DELETED.
3. SEAL WELDED CAP TO BE INSTALLED ON 1/2 INCH TEST CONNECTION AFTER HYDROTEST HAS BEEN PERFORMED.
4. REMOVABLE SPOOL WITH SPACER RING INSTALLED. REPLACEMENT FOR START-UP STRAINER.
5. VALVE ENV002 IS EQUIPPED WITH AN ANTI PRESSURE LOCKING BYPASS. SEE M-220-0011.
6. VENDOR SUPPLIED/ISSUED MOUNTED SEAL RINGING (REF. M-000-00002). VENT VALVES ENV014 & ENV015 ADDED PER CHG. PKG. 04/00A.

SPRAY NOZZLES

SEN02

SPRAY NOZZLES

SEN02

USAR FIG. 6.2.2-1-00

ESSENTIAL DRAWING

REVISION	INCORPORATED OR 00083426	CHANGE
DATE	04/00	FILE NO.
DESIGNED BY	REL	DESIGNED BY
REVIEWED BY	REL	REVIEWED BY

WOLF CREEK NUCLEAR OPERATING CORPORATION

PIPING AND INSTRUMENTATION

DIAGRAM CONTAINMENT

SPRAY SYSTEM


DRAWN BY M-12EN01

REVISION 13


DATE 13

TABLE FOR PIPE NOZZLES									
SEQ. NO.	DET. NO.	POS. ON PIPE	PIPE SIZE	AZ.	EL.	SEE NOTE			
1	2	3	4	5	6	7	8	9	10
1	1	"A"	3"	4-27"	EL. 2105'-8"	-14"			
2	1	"B"	3"	5-27"		+16"			
3	1	"C"	3"	6-26"		-59"			
4	1	"D"	3"	11-25"		-14"			
5	1	"E"	3"	13-23"		+19"			
6	1	"F"	3"	18-22"		-58"			
7	1	"G"	3"	19-22"		-11"			
8	1	"H"	3"	21-22"		+17"			
9	1	"I"	3"	26-21"		-16"			
10	1	"J"	3"	29-18"		+15"			
11	1	"K"	3"	31-17"		-61"			
12	1	"L"	3"	34-16"		-17"			
13	1	"M"	3"	36-15"		+15"			
14	1	"N"	3"	41-15"		-19"			
15	1	"O"	3"	45-15"		-63"			
16	1	"P"	3"	48-14"		+11"			
17	1	"Q"	3"	49-10"		+17"			
18	1	"R"	3"	51-10"		+14"			
19	1	"S"	3"	54-10"		+22"			
20	1	"T"	3"	55-8"		-16"			
21	1	"U"	3"	59-9"		+15"			
22	1	"V"	3"	64-10"		-15"			
23	1	"W"	3"	66-10"		+13"			
24	1	"X"	3"	67-10"		-60"			
25	1	"Y"	3"	71-10"		-16"			
26	1	"Z"	3"	74-11"		+14"			
27	1	"AA"	3"	78-10"		-60"			
28	1	"AB"	3"	79-10"		-16"			
29	1	"AC"	3"	81-10"		+15"			
30	1	"AD"	3"	84-10"		+16"			
31	1	"AE"	3"	89-10"		-57"			
32	1	"AF"	3"	94-11"		-13"			
33	1	"AG"	3"	101-11"		-14"			
34	1	"AH"	3"	102-11"		-58"			
35	1	"AI"	3"	104-11"		+17"			
36	1	"AJ"	3"	109-10"		-14"			
37	1	"AK"	3"	111-10"		-16"			
38	1	"AL"	3"	114-8"		-58"			
39	1	"AM"	3"	116-7"		-13"			
40	1	"AN"	3"	119-7"		+16"			
41	1	"AO"	3"	124"		+10"			
42	1	"AP"	3"	126"		+14"			
43	1	"AQ"	3"	127"		-61"			
44	1	"AR"	3"	131"		-15"			
45	1	"AS"	3"	134"		+15"			
46	1	"AT"	3"	138"		-15"			
47	1	"AU"	3"	139"		-60"			
48	1	"AV"	3"	141"		+14"			
49	1	"AW"	3"	145-55"		-16"			
50	1	"AX"	3"	148-55"		+13"			
51	1	"AY"	3"	150-55"		-60"			
52	1	"AZ"	3"	153-54"		-15"			
53	1	"BA"	3"	155-54"		+15"			
54	1	"BB"	3"	160-55"		-17"			
55	1	"BC"	3"	164"		+15"			
56	1	"BD"	3"	168"		-15"			
57	1	"BE"	3"	171"		+14"			
58	1	"BF"	3"	174"		-14"			
59	1	"BG"	3"	177"		+16"			
60	1	"BH"	3"	179"		-14"			
61	1	"BI"	3"	184-34"		+12"			
62	1	"BJ"	3"	185-34"		-58"			
63	1	"BK"	3"	191-35"		-13"			
64	1	"BL"	3"	193-35"		+15"			
65	1	"BM"	3"	195-34"		-58"			
66	1	"BN"	3"	199-34"		+16"			
67	1	"BO"	3"	201-34"		-14"			
68	1	"BP"	3"	203-34"		+16"			
69	1	"BQ"	3"	205-34"		-60"			
70	1	"BR"	3"	211-30"		-14"			
71	1	"BS"	3"	214-29"		+15"			
72	1	"BT"	3"	216-27"		-16"			
73	1	"BU"	3"	222-26"		-60"			
74	1	"BV"	3"	224-26"		+16"			
75	1	"BW"	3"	229-26"		-13"			
76	1	"BX"	3"	231-24"		+17"			
77	1	"BY"	3"	234-24"		-58"			
78	1	"BZ"	3"	236-23"		+12"			
79	1	"CA"	3"	244-22"		-14"			
80	1	"CB"	3"	246-22"		+16"			
81	1	"CC"	3"	247-21"		-60"			
82	1	"CD"	3"	251-20"		-14"			
83	1	"CE"	3"	254-19"		+15"			
84	1	"CF"	3"	258-16"		-60"			
85	1	"CG"	3"	259-16"		-14"			
86	1	"CH"	3"	261-16"		+15"			
87	1	"CI"	3"	266-14"		-14"			
88	1	"CJ"	3"	269-14"		+17"			
89	1	"CK"	3"	271-13"		-59"			
90	1	"CL"	3"	274-12"		-14"			
91	1	"CM"	3"	276-12"		+16"			
92	1	"CN"	3"	281-12"		-12"			
93	1	"CO"	3"	284-13"		+19"			
94	1	"CP"	3"	289-13"		-13"			
95	1	"CQ"	3"	291-13"		+18"			
96	1	"CR"	3"	294-13"		-58"			
97	1	"CS"	3"	296-14"		-12"			
98	1	"CT"	3"	299-14"		+19"			
99	1	"CU"	3"	304-13"		-16"			
100	1	"CV"	3"	306-12"		+12"			
101	1	"CW"	3"	307-12"		-12"			
102	1	"CX"	3"	308-12"		+19"			
103	1	"CY"	3"	311-11"		-13"			
104	1	"CZ"	3"	314-11"		+12"			
105	1	"DA"	3"	318-10"		-16"			
106	1	"DB"	3"	319-11"		-60"			
107	1	"DC"	3"	321-11"		+13"			
108	1	"DD"	3"	324-9"		+14"			
109	1	"DE"	3"	331-8"		-60"			
110	1	"DF"	3"	334-7"		+15"			
111	1	"DG"	3"	342-6"		-60"			
112	1	"DH"	3"	344-6"		+15"			
113	1	"DI"	3"	349-6"		-15"			
114	1	"DJ"	3"	351-9"		+15"			
115	1	"DK"	3"	354-10"		-59"			
116	1	"DL"	3"	356-9"		-15"			
117	1	"DM"	3"	359-12"		+18"			

1	2	3	C	G	4°-30'	EL. 2170'-3"	-60"
2	3	4	H		7"		-30"
3	2	1	E				+10"
4	1	2	F		12"		-60"
5	3	4	H		15"		-29"
6	2	1	E		17"		+9"
7	3	4	H		23"		-27"
8	2	1	E		25"		+11"
9	1	2	C		27"		-58"
10	3	4	H		32-11"		-27"
11	2	1	E		34-12"		+9"
12	3	4	H		39-11"		-29"
13	2	1	E		41-20"		+9"
14	1	2	C		42-14"		-59"
15	3	4	H		47-13"		-28"
16	2	1	E	G	49-13"		+10"
17	3	4	H	4	55-9"		-29"
18	2	1	E		57-9"		+8"
19	1	2	C		58-9"		-26"
20	3	4	H		65-9"		+3"
21	2	1	E		69-9"		-27"
22	3	4	H		71-9"		-59"
23	1	2	C		72-9"		-27"
24	2	1	E		73-10"		-29"
25	3	4	H		75-9"		+10"
26	2	1	E		81-9"		-26"
27	3	4	H		87-11"		-60"
28	1	2	C		89-11"		+8"
29	2	1	E		95-11"		-26"
30	3	4	H		97-11"		+10"
31	2	1	E		102-10"		-58"
32	1	2	C		103-10"		-28"
33	3	4	H		105-10"		+8"
34	2	1	E		111-7"		-27"
35	3	4	H		113-6"		+11"
36	2	1	E		117-4"		-55"
37	1	2	C		119"		-29"
38	3	4	H		121"		+9"
39	2	1	E	4	128"		-26"
40	3	4	H	3	129"		+10"
41	2	1	E		129"		-57"
42	1	2	C		131-4-46"		-27"
43	3	4	H		134-5-53"		+12"
44	2	1	E		136-5-54"		-27"
45	3	4	H		142-5-50"		+12"
46	2	1	E		144-4-57"		-58"
47	1	2	C		145-4-57"		+10"
48	3	4	H		151-4-46"		-26"
49	2	1	E		152-4-45"		+10"
50	3	4	H		158-4-42"		-28"
51	2	1	E		160-4-42"		+10"
52	1	2	C		161-4-43"		-57"
53	3	4	H		164-4-43"		-27"
54	2	1	E		168-4-43"		+10"
55	3	4	H		174-4-44"		-28"
56	2	1	E		175-4-44"		+10"
57	2	1	E	3	176-4-44"	EL. 2170'-3"	+10"
58	1	2	C	G	180-3-30"	EL. 2170'-3"	-60"
59	3	4	H		187"		-29"
60	2	1	E		189"		+8"
61	1	2	C		192"		-60"
62	3	4	H		195"		-30"
63	2	1	E		197"		+7"
64	3	4	H		203"		-30"
65	2	1	E		205"		+6"
66	1	2	C		207"		-60"
67	3	4	H		212-8-8"		-28"
68	2	1	E		214-8-8"		+8"
69	3	4	H		219-7-7"		-28"
70	2	1	E		221-7-7"		+6"
71	1	2	C		222-8-8"		-59"
72	3	4	H		227-7-7"		-28"
73	2	1	E	G	228-8-8"		+8"
74	3	4	H	4	235-8-8"		-29"
75	2	1	E		237-7-7"		+8"
76	1	2	C		238-8-8"		-60"
77	3	4	H		243-7-7"		-30"
78	2	1	E		249-8-8"		+7"
79	3	4	H		251-7-7"		-30"
80	1	2	C		252-7-7"		-60"
81	2	1	E		253-7-7"		+7"
82	3	4	H		259-5-5"		-30"
83	2	1	E		261-5-5"		+10"
84	3	4	H		267"		-30"
85	1	2	C		268"		-60"
86	2	1	E		269"		+8"
87	3	4	H		275"		-30"
88	2	1	E		277"		+6"
89	1	2	C		282"		-63"
90	3	4	H		283"		-30"
91	2	1	E		285"		+7"
92	3	4	H		291"		-31"
93	2	1	E		293-5-5"		+7"
94	1	2	C		297-5-5"		-62"
95	3	4	H		299-6-6"		-32"
96	2	1	E	4	301-7-7"		+6"
97	3	4	H	3	308"		-32"
98	2	1	E	5	309"		+7"
99	1	2	C		312-5-5"		-65"
100	3	4	H		315"		-32"
101	2	1	E		317"		+6"
102	3	4	H		323"		-33"
103	2	1	E		325"		+5"
104	1	2	C		328"		-60"
105	3	4	H		332"		-32"
106	2	1	E		335"		+6"
107	3	4	H		339"		-30"
108	2	1	E		341"		+8"
109	1	2	C		342"		-61"
110	3	4	H		347"		-33"
111	2	1	E		349"		+4"
112	3	4	H		354-5-55"		-32"
113	1	2	C		355-5-55"		+6"
114	2	1	E	3	356-5-55"	EL. 2170'-3"	-32"
1	2	3	D	3	G	EL. 2195'-3"	-33-30"
2	2	3	F		6"		-38"
3	1	2	C		12"		-57"
4	1	2	C		18"		-5"
5	2	3	F		22"		-38"
6	1	2	D		23"		-5"
7	1	2	C		34"		-56"
8	2	3	F		36"		-35-30"
9	1	2	C		46"		-45-30"
10	2	3	F		48"		-39-30"
11	1	2	C		52"		-57-30"
12	1	2	D		60"		+2"
13	2	3	F		64"		-50"
14	1	2	C		74"		-2"
15	2	3	F		82"		-38-30"
16	1	2	C	3	78"	EL. 2195'-3"	-57"

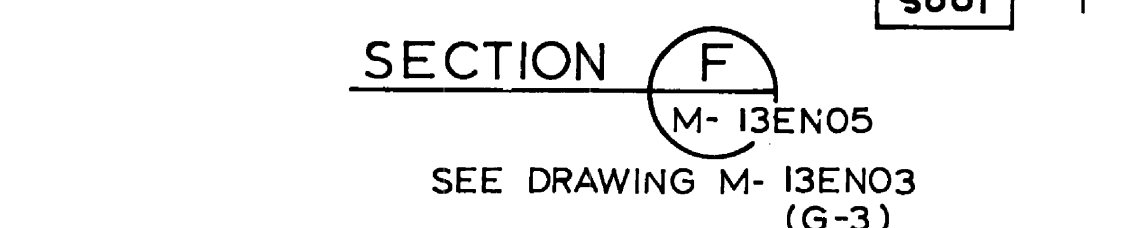

- ## NOTES:
1. FOR GENERAL NOTES AND REFERENCES SEE DRAWING M-13EN01.
 2. WORK THIS DRAWING WITH DRAWING M-13EN03 AND M-13EN04.
 3. LINE NUMBERS 40-HCB-10⁰ AND 42-HCB-10⁰ SHALL BE SCHEDULE 80S.
 4. THIS DRAWING WAS EXPANDED FROM M-13EN03 AND M-13EN04.
 5. ELEVATIONS, DIMENSIONS, & LOCATING DIMENSIONS REFERENCED TO THIS NOTE REFLECT THE "AS-BUILT" (A.B.) CONDITION. ASSOCIATED DIMS. THAT ARE WITHIN ALLOWABLE TOLERANCES HAVE NOT BEEN ADJUSTED.
 6. FOR AS-BUILT ELEVATIONS AND RADII OF SPRAY-RINGS SEE DWG M-CJ3EN04 (9).



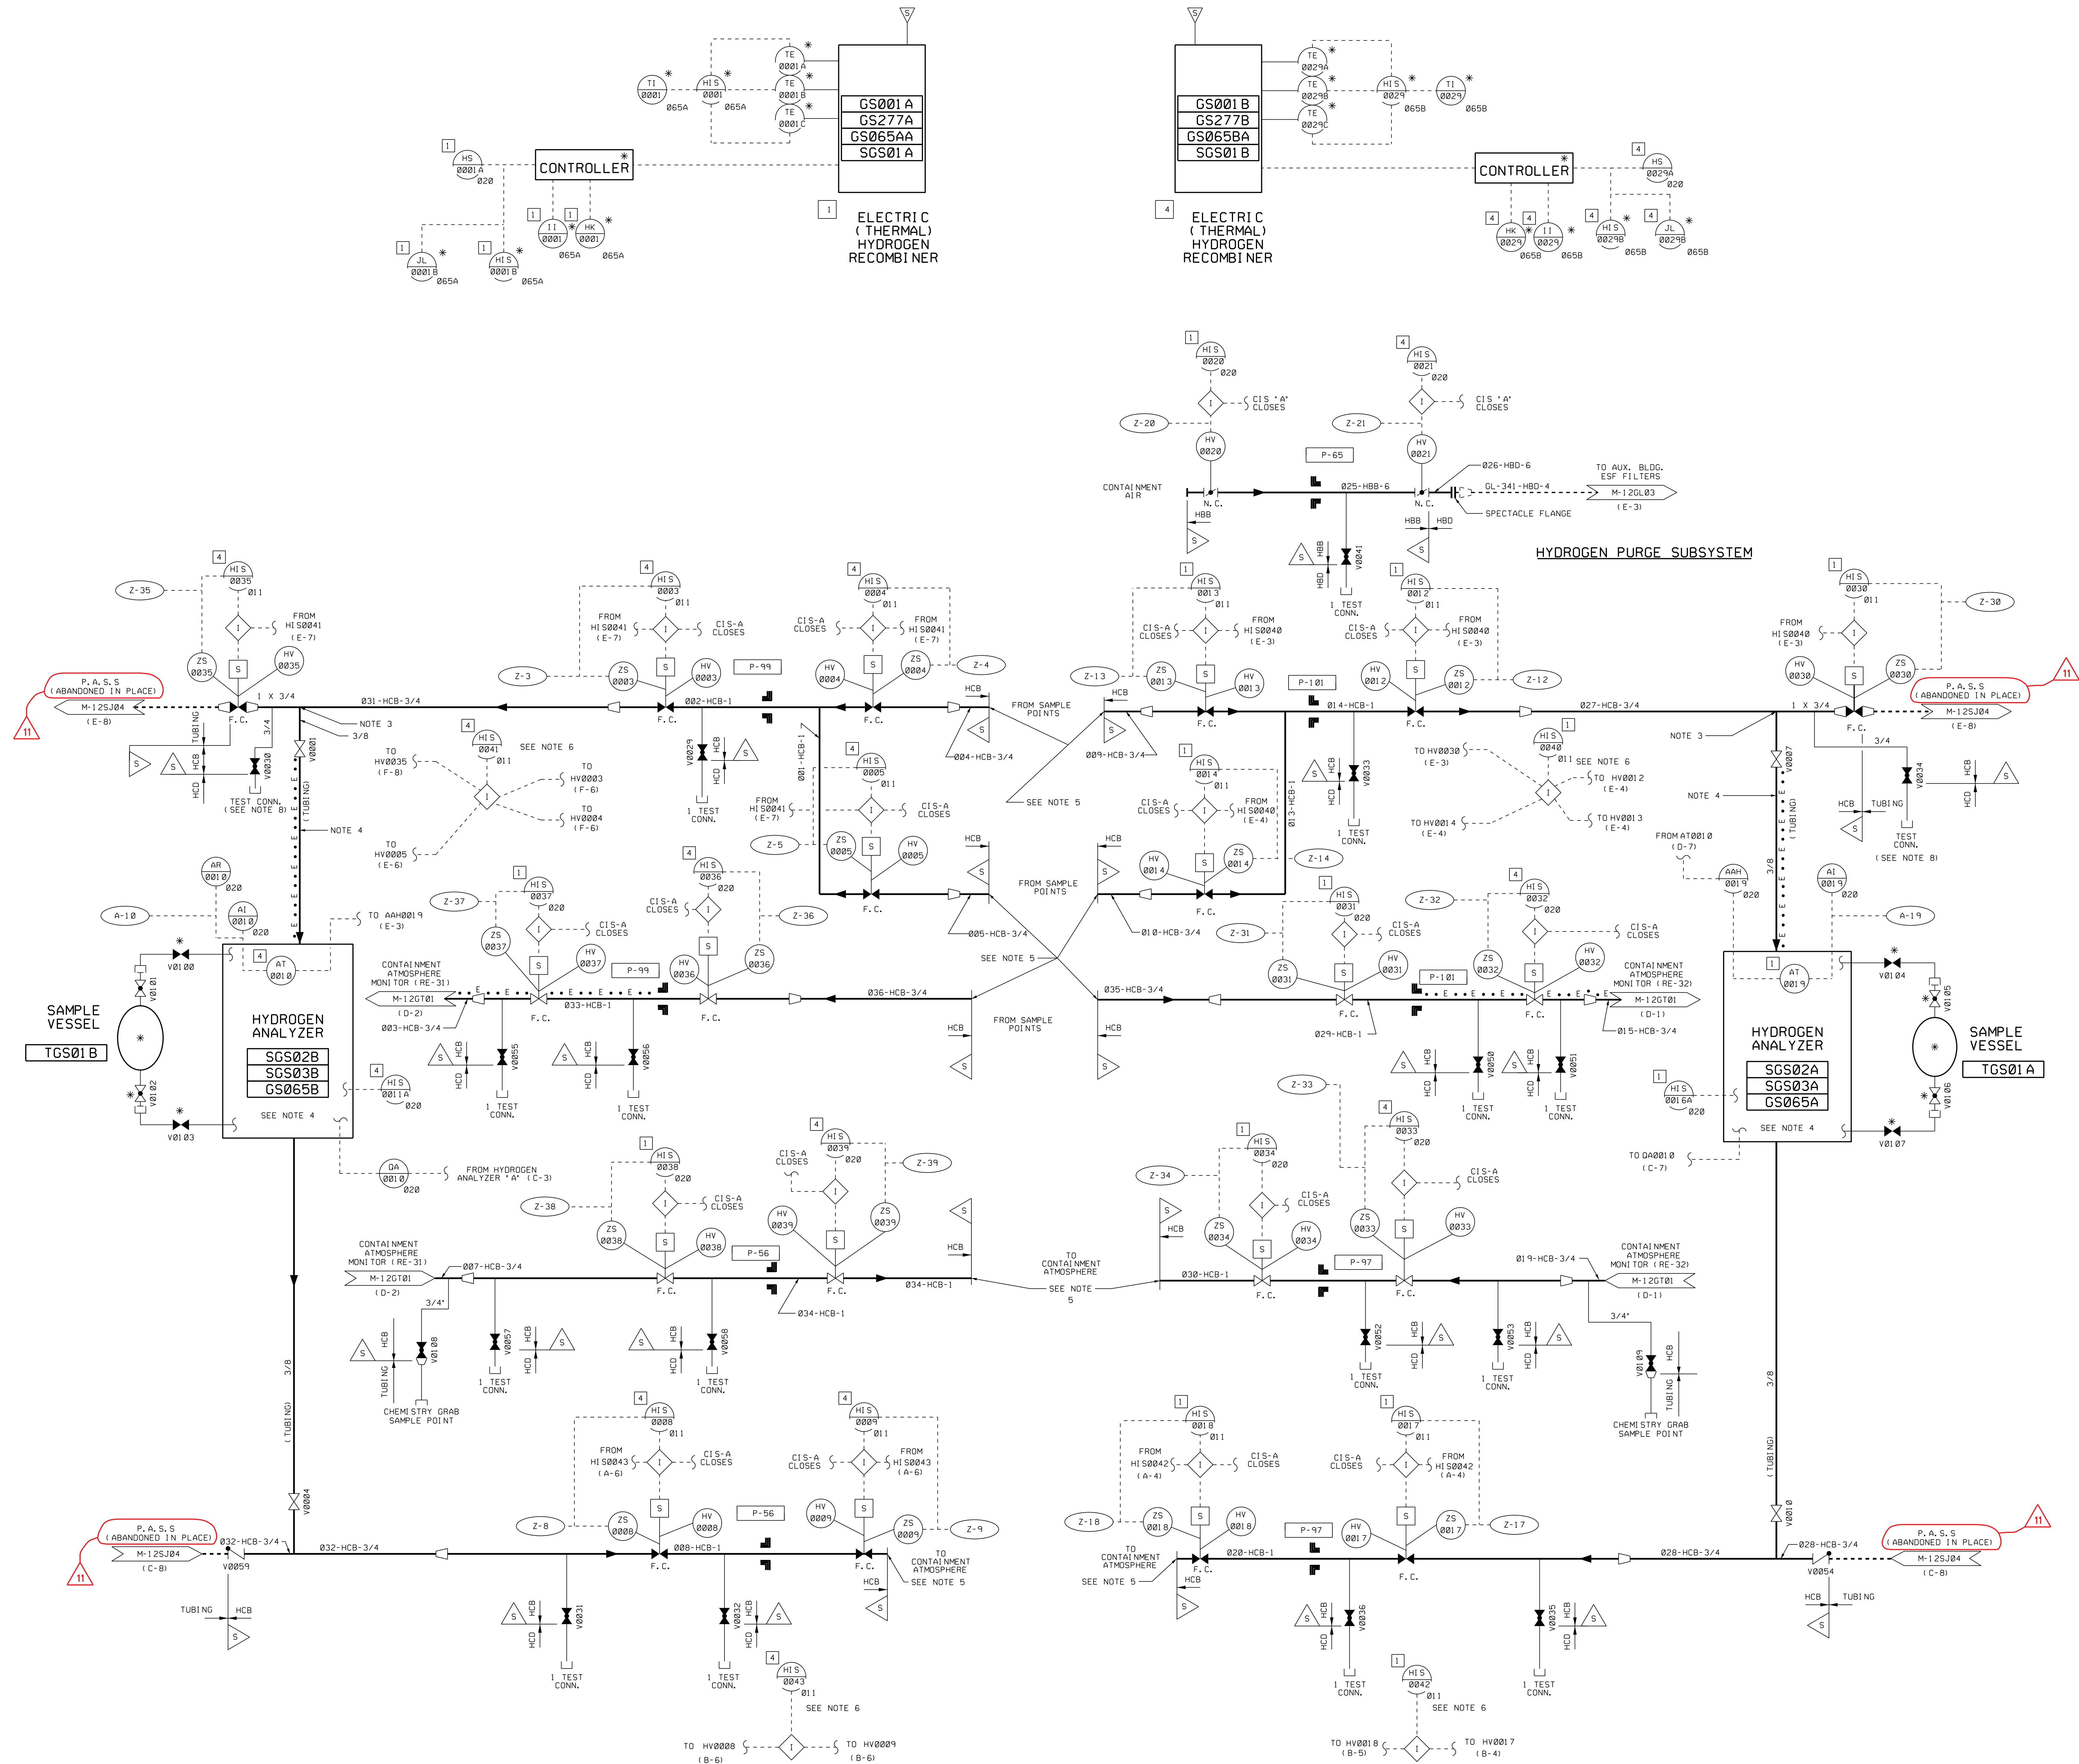


- NOTES
1. THE HYDROGEN PURGE MAKEUP SUPPLY AIR IS SUPPLIED BY THE COMPRESSED AIR SYS. AND IS SHOWN ON P & I.D. M-12G001.
 2. THE HYDROGEN MIXING FANS ARE SHOWN ON THE CONTAINMENT COOLING SYS. P & I.D. M-12G001.
 3. THIS CONNECTION WILL BE LOCATED AS CLOSE AS POSSIBLE TO THE CONTAINMENT ISOLATION VALVE.
 4. FOR HYDROGEN ANALYZERS & HEAT TRACING. SEE VENDOR P & I.D. PRINT NO. J-359-00016.
 5. THREADED END FOR USE DURING VALVE LEAK TESTING.
 6. FOUR ISOLATION SWITCHES ARE PROVIDED ON THE MAIN CONTROL BOARD FOR POWER LOCKOUT. SWITCH LOCKOUTS ARE AS INDICATED.
 7. CONTROL PANELS GS065A & GS065B ARE SUPPLIED BY HYDROGEN ANALYZER VENDOR (J-359). HYDROGEN RECOMBINER PANEL INSERTS GS065AA & GS065BA ARE SUPPLIED BY THE HYDROGEN RECOMBINER VENDOR (M-637). CONTROL PANEL INSERTS ARE MOUNTED ON HYDROGEN ANALYZER PANELS GS065A & GS065B.
 8. THIS VALVE SHALL NOT BE USED FOR CHEMISTRY SAMPLING (REF. PIR 99-1978).

USAR FIG. 6.2.5-1

ESSENTIAL DRAWING			
REVISED	INCORPORATED	CHANGE	06187
ISSUED	CHG. DOC.	FIG. NO.	
THIS DWG. SUPERSEDES		REV.	THIS DWG. SUPERSEDES
REVISION NOTES: REF. WIP-M-12G001-008-A-1 PER CP *06187; CHANGES REINSTATED FROM REVISION 09.			
WOLF CREEK		ELECTRONIC APPROVAL	
NUCLEAR OPERATING CORPORATION			
PIPING & INSTRUMENTATION DIAGRAM CONTAINMENT HYDROGEN CONTROL SYSTEM			
SCALE	DRAWING NUMBER	SHEET	REV
NONE	M-12GS01	11	

34444 E SIZE

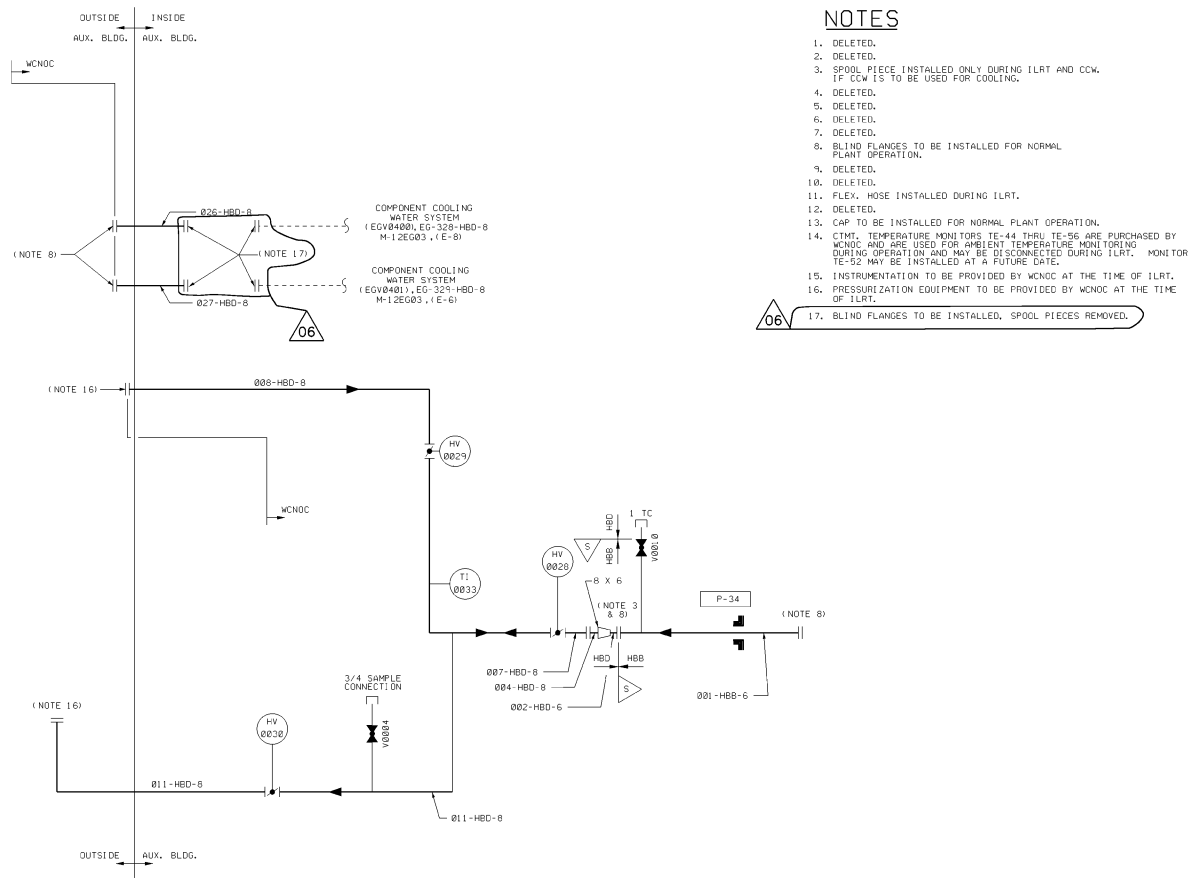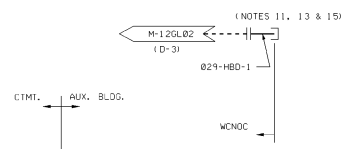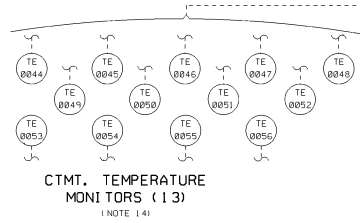


- NOTES**
1. DELETED.
 2. DELETED.
 3. SPOOL PIECE INSTALLED ONLY DURING ILRT AND CCW. IF CCW IS TO BE USED FOR COOLING.
 4. DELETED.
 5. DELETED.
 6. DELETED.
 7. DELETED.
 8. BLIND FLANGES TO BE INSTALLED FOR NORMAL PLANT OPERATION.
 9. DELETED.
 10. DELETED.
 11. FLEX. HOSE INSTALLED DURING ILRT.
 12. DELETED.
 13. CAP TO BE INSTALLED FOR NORMAL PLANT OPERATION.
 14. CTMT. TEMPERATURE MONITORS TE-44 THRU TE-56 ARE PURCHASED BY WCNOG AND ARE USED FOR AMBIENT TEMPERATURE MONITORING DURING OPERATION AND MAY BE DISCONNECTED DURING ILRT. MONITOR TE-52 MAY BE INSTALLED AT A FUTURE DATE.
 15. INSTRUMENTATION TO BE PROVIDED BY WCNOG AT THE TIME OF ILRT.
 16. PRESSURIZATION EQUIPMENT TO BE PROVIDED BY WCNOG AT THE TIME OF ILRT.
 17. BLIND FLANGES TO BE INSTALLED, SPOOL PIECES REMOVED.

USAR FIG. 6.2.6-1-00

ESSENTIAL DRAWING


REVISION	INCORPORATED	CR#00003872	CHANGE
ISSUED	CHG. DOC.		FILE NO.
THIS INC. SUPERSEDES BY		REV.	THIS INC. SUPERSEDES
REVISION NOTES			
WOLF CREEK		ELECTRONIC APPROVAL	
NUCLEAR OPERATING CORPORATION			
PIPING & INSTRUMENTATION DIAGRAM			
CONTAINMENT INTEGRATED			
LEAK RATE TEST			
SCALE	DRAWING NUMBER	SHEET	REV
NONE	M-12GP01	34444	06

M-12GP01-1-06

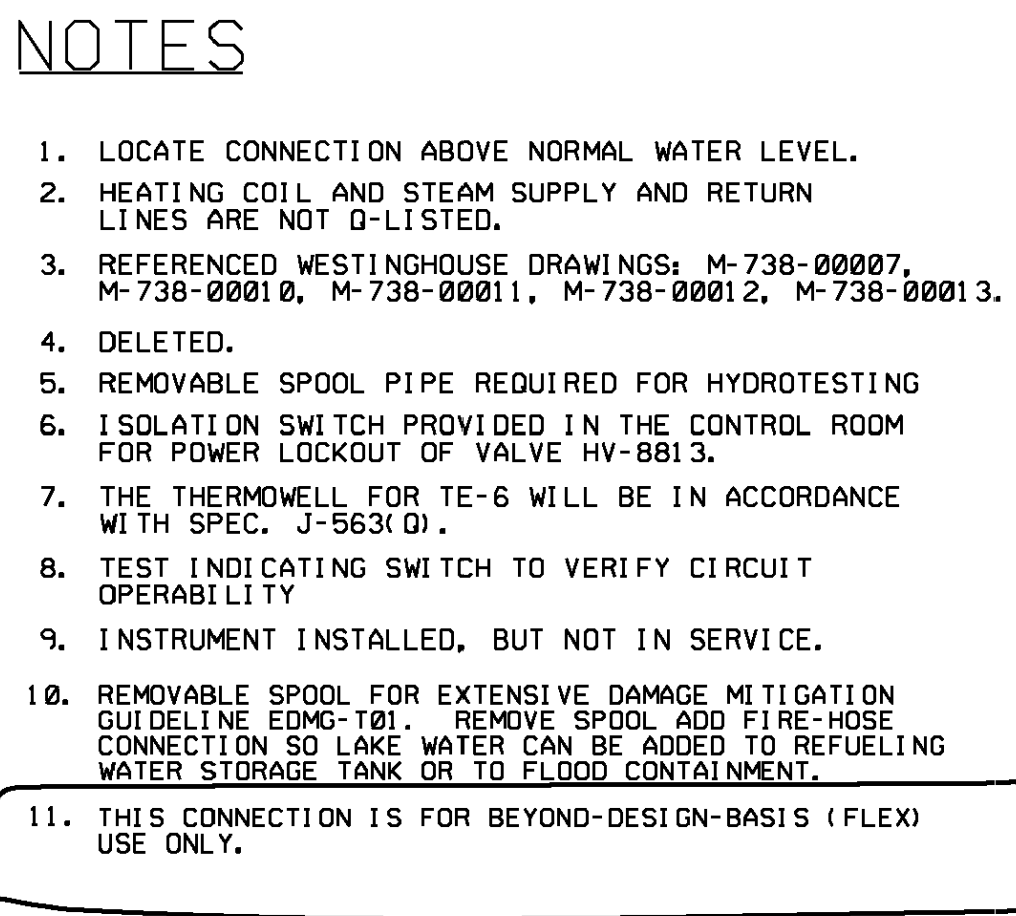

REFERENCE:

ANY REVISION TO THIS DRAWING MAY REQUIRE A REVISION TO
THE HIGH PRESSURE COOLANT INJECTION SYS. TEST LINE
P & I. D. M-12EM03.

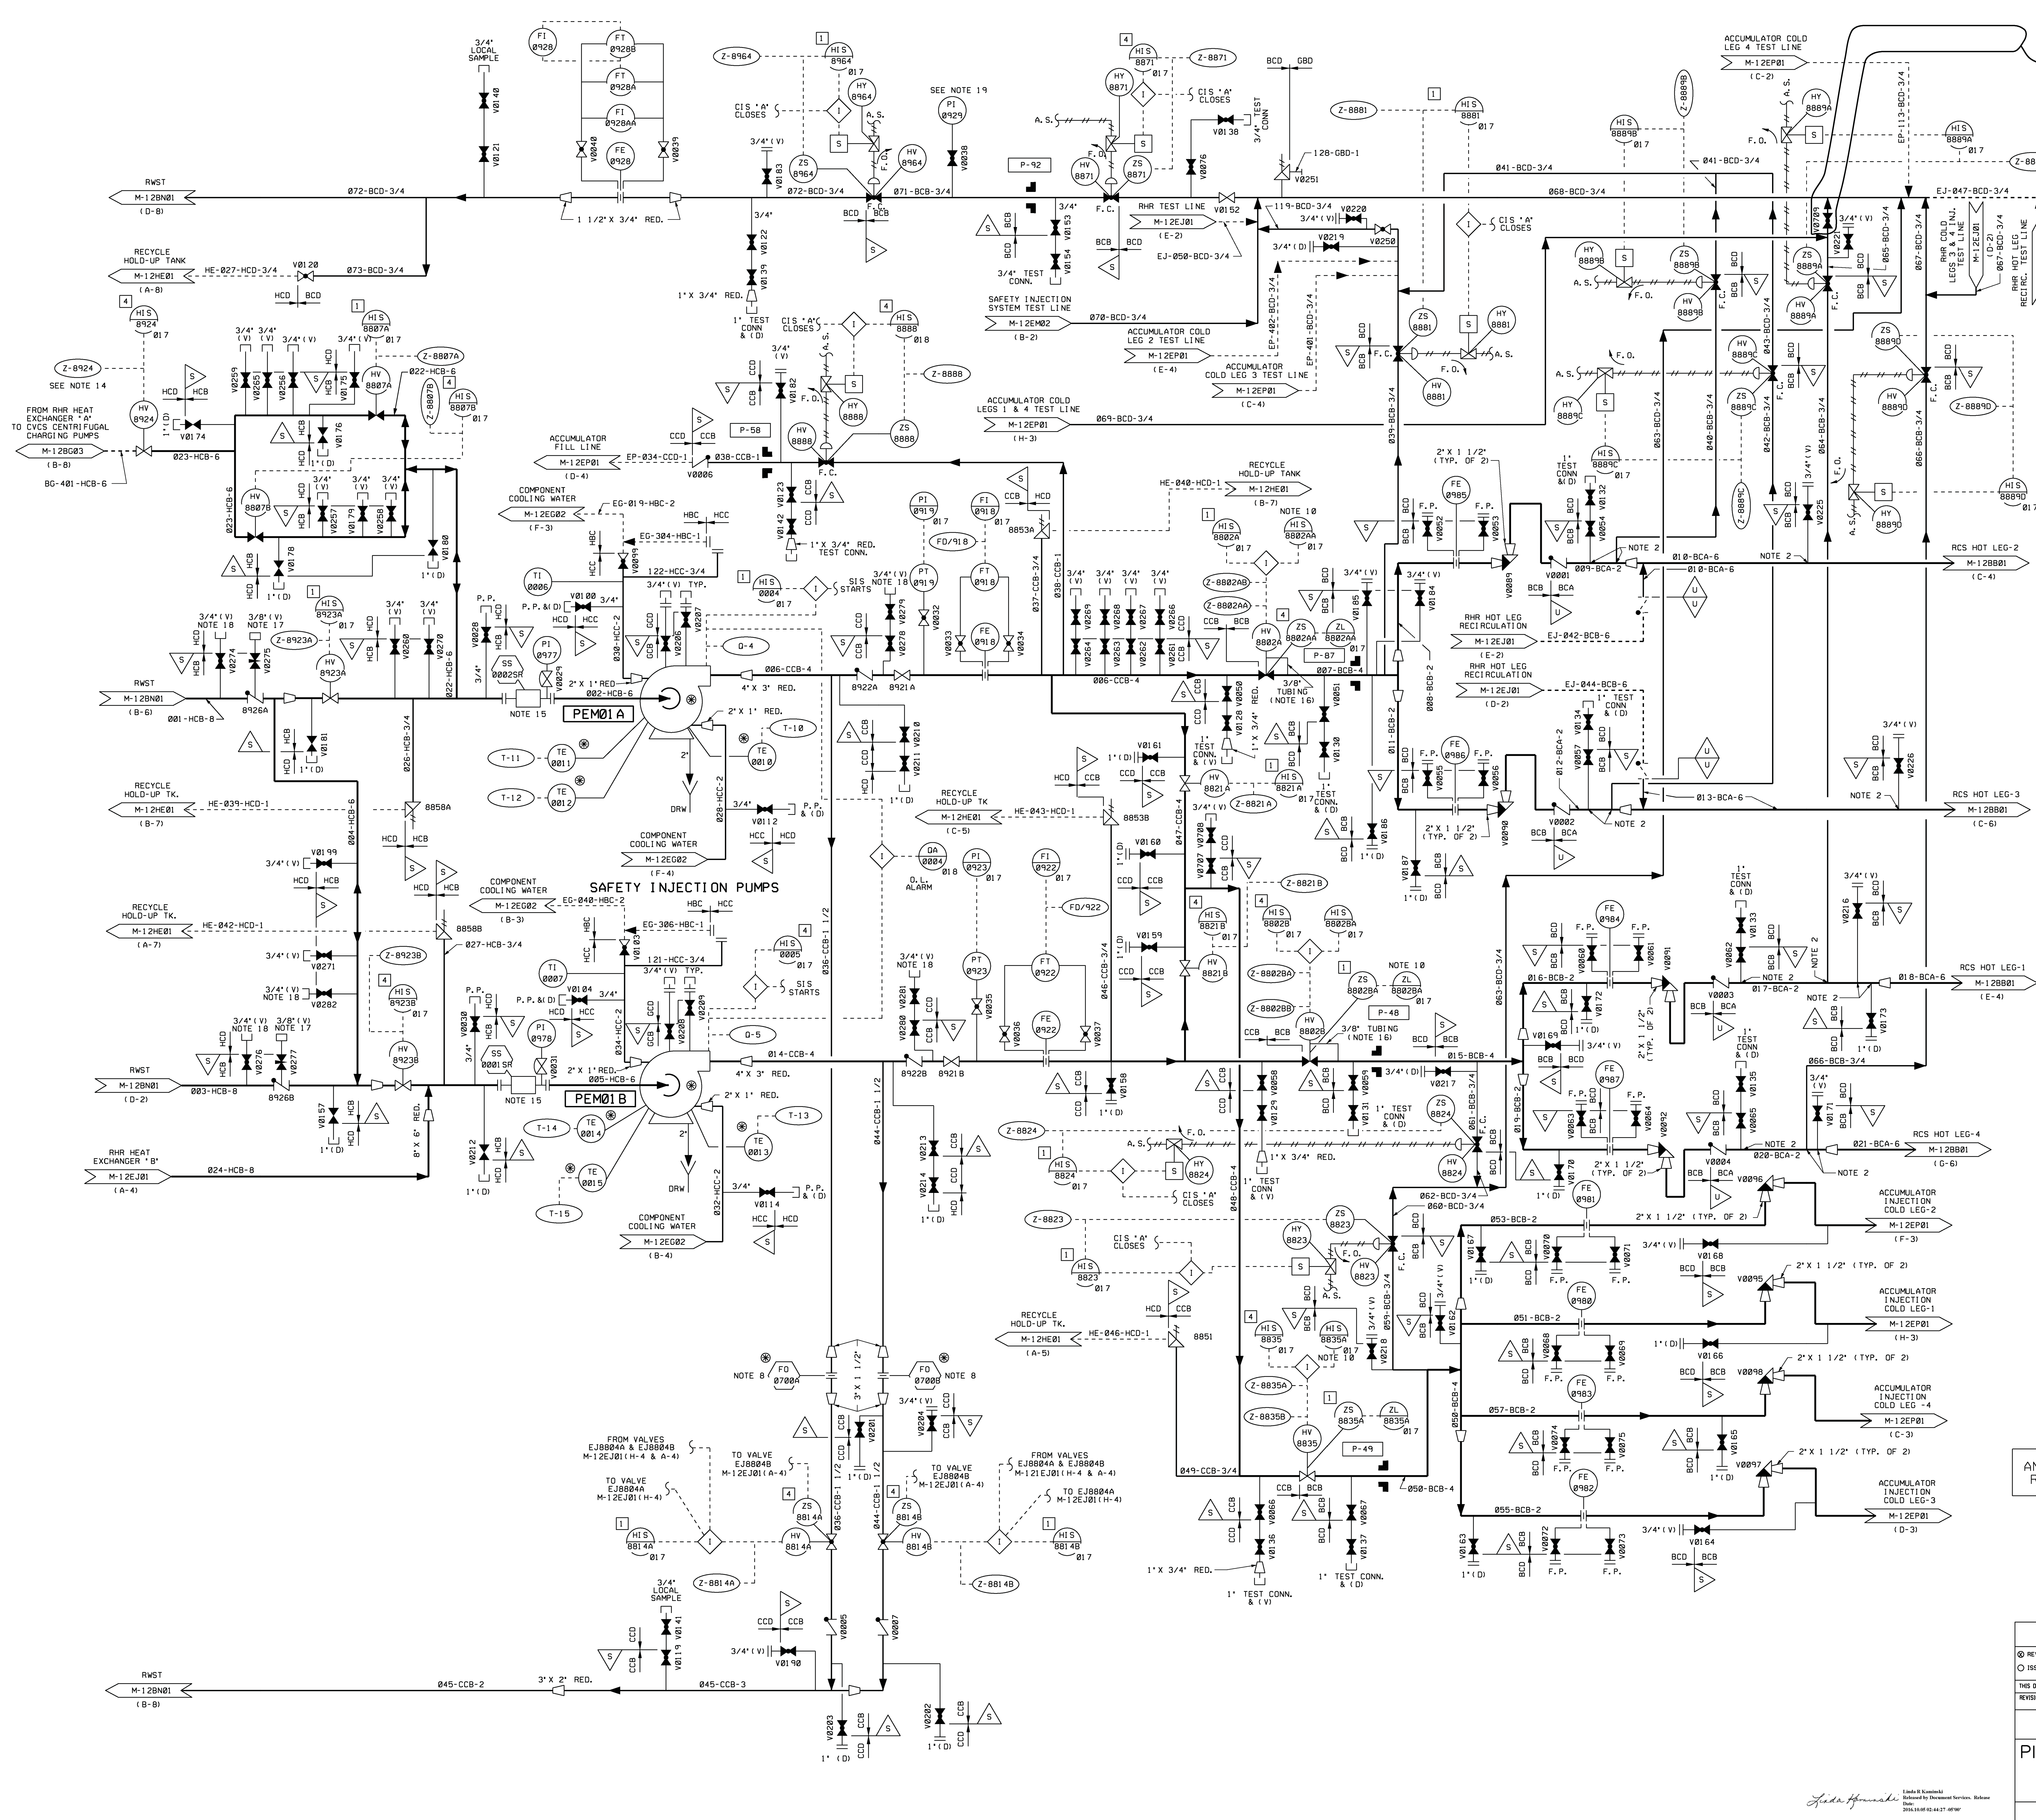

- ### NOTES
1. DELETED.
 2. DRILLED RESTRICTION 3/8" IN DIAMETER, POINT AT WHICH QUALITY GROUP CLASSIFICATION IS CHANGED FROM "A" TO "B". INSERVICE INSPECTION WILL BE PERFORMED ON CLASS "A" PIPE UP TO THIS ORIFICE.
 3. SEE WESTINGHOUSE DRAWINGS M-738-00011, M-738-00012, AND M-738-00013.
 4. DELETED.
 5. DELETED.
 6. PIPING CONTAINING 12 PERCENT BORIC ACID WILL HAVE TEES WITH A CLEANOUT TO PERMIT CLEANING OF SYSTEM AS REQUIRED.
 7. FOR PAID LEGEND AND SYMBOLS SEE DRAWING M-020101 THRU M-020104.
 8. MINIFLOW ORIFICE SUPPLIED BY SI PUMP VENDOR.
 9. HEAT TRACING NON-CLASS 1E.
 10. ISOLATION SWITCH PROVIDED IN THE CONTROL ROOM FOR POWER LOCKOUT OF VALVES 8802A, B AND 8805.
 11. DELETED.
 12. DELETED.
 13. ALL WELDS IN ASME SECTION III CLASS 1 COMPONENTS AND ASME SECTION III CLASS 1 PIPING OF NOMINAL PIPE SIZE GREATER THAN 1" MAY BE SUBJECT TO VOLUMETRIC EXAMINATION DURING THE PRESERVICE INSPECTION (PSI) AND/OR THE INSERVICE INSPECTION (ISI). PROGRAMS THE SPECIFIC WELDS AND THEIR INSPECTION REQUIREMENTS ARE DELINEATED IN THE APPLICABLE PSI/ISI WORK PLANS PROVIDED UNDER SPECIFICATION M-189. BOUNDARIES OF THESE PIPING SYSTEMS ARE IDENTIFIED WITH A SYMBOL FOR CLARITY.
 14. CIRCUIT BREAKER FOR EMHV824 SHALL BE LOCKED OPEN AT ALL TIMES. A STEM BLOCKING DEVICE MAY BE INSTALLED ON VALVE EMHV824 TO MAINTAIN THE VALVE IN THE OPEN POSITION AS REQUIRED BY PWR 4145.
 15. REMOVABLE SPUD WITH SPACER RING INSTALLED. REPLACEMENT FOR START-UP STRAINER.
 16. VALVES EMHV8802A & EMHV8802B ARE EQUIPPED WITH AN ANTI PRESSURE LOCKING BYPASS. SEE M-724-02023.
 17. VENT INSTALLED IN THE BONNET OF THE CHECK VALVE USING 3/8" INSTRUMENT FITTINGS AND VALVE.
 18. VENT INSTALLED WITH CAM AND GROOVE ADAPTER AND DUST CAP WITH BUNA-N GASKET.
 19. BLOCK ISOLATION VALVE ON EMP1929 CLOSED UNDER NORMAL OPERATING CONDITION AND SERVES AS SECONDARY ISOLATION FOR CMT PENETRATION.

ANY REVISION TO THIS DRAWING MAY REQUIRE A REVISION TO M-12EM03.

USAR FIG. 6.3-1-02

ESSENTIAL DRAWING

O REVISION		INCORPORATED	WIP-M-12EM01-041-A-1	CHANGE		014917
O ISSUED					PKG. NO.	
THIS DNG. SUPERSEDES BY			REV.	THIS DNG. SUPERSEDES		REV.
REVISION NOTES						
ADDED VALVE EM-V0709 & REMOVED TMO 15-015-EM-00.						
WOLF CREEK NUCLEAR OPERATING CORPORATION					ELECTRONIC APPROVAL	
PIPING & INSTRUMENTATION DIAGRAM HIGH PRESSURE COOLANT INJECTION SYSTEM						
SCALE		DRAWING NUMBER			SHEET	REV.
NONE		M-12EM01			1	4.



- ANY REVISION TO THIS DRAWING MAY REQUIRE
A REVISION TO M-126M03.

USAR FIG. 6.3-1-04

ESSENTIAL DRAWING

☒ INCORPORATED ☐ ISSUED	WIP-M-12EP01-008-A-1 CHEL DOC.	CHANGE 01223 PEG, NDL
---	-----------------------------------	--------------------------

THIS UNIT SUPERSEDED BY	REV.	THIS UNIT SUPERSEDES	REV.
REVISION NOTES:			
WOLF CREEK		ELECTRON	

WOLF CREEK NUCLEAR OPERATING CORPORATION	APPROVAL
PIPING & INSTRUMENTATION DIAGRAM	

PIPING & INSTRUMENTATION DIAGR.
ACCUMULATOR SAFETY INJECTION

SCALE	DRAWING NUMBER	SHEET
NONE	M-12EP01	


M-