


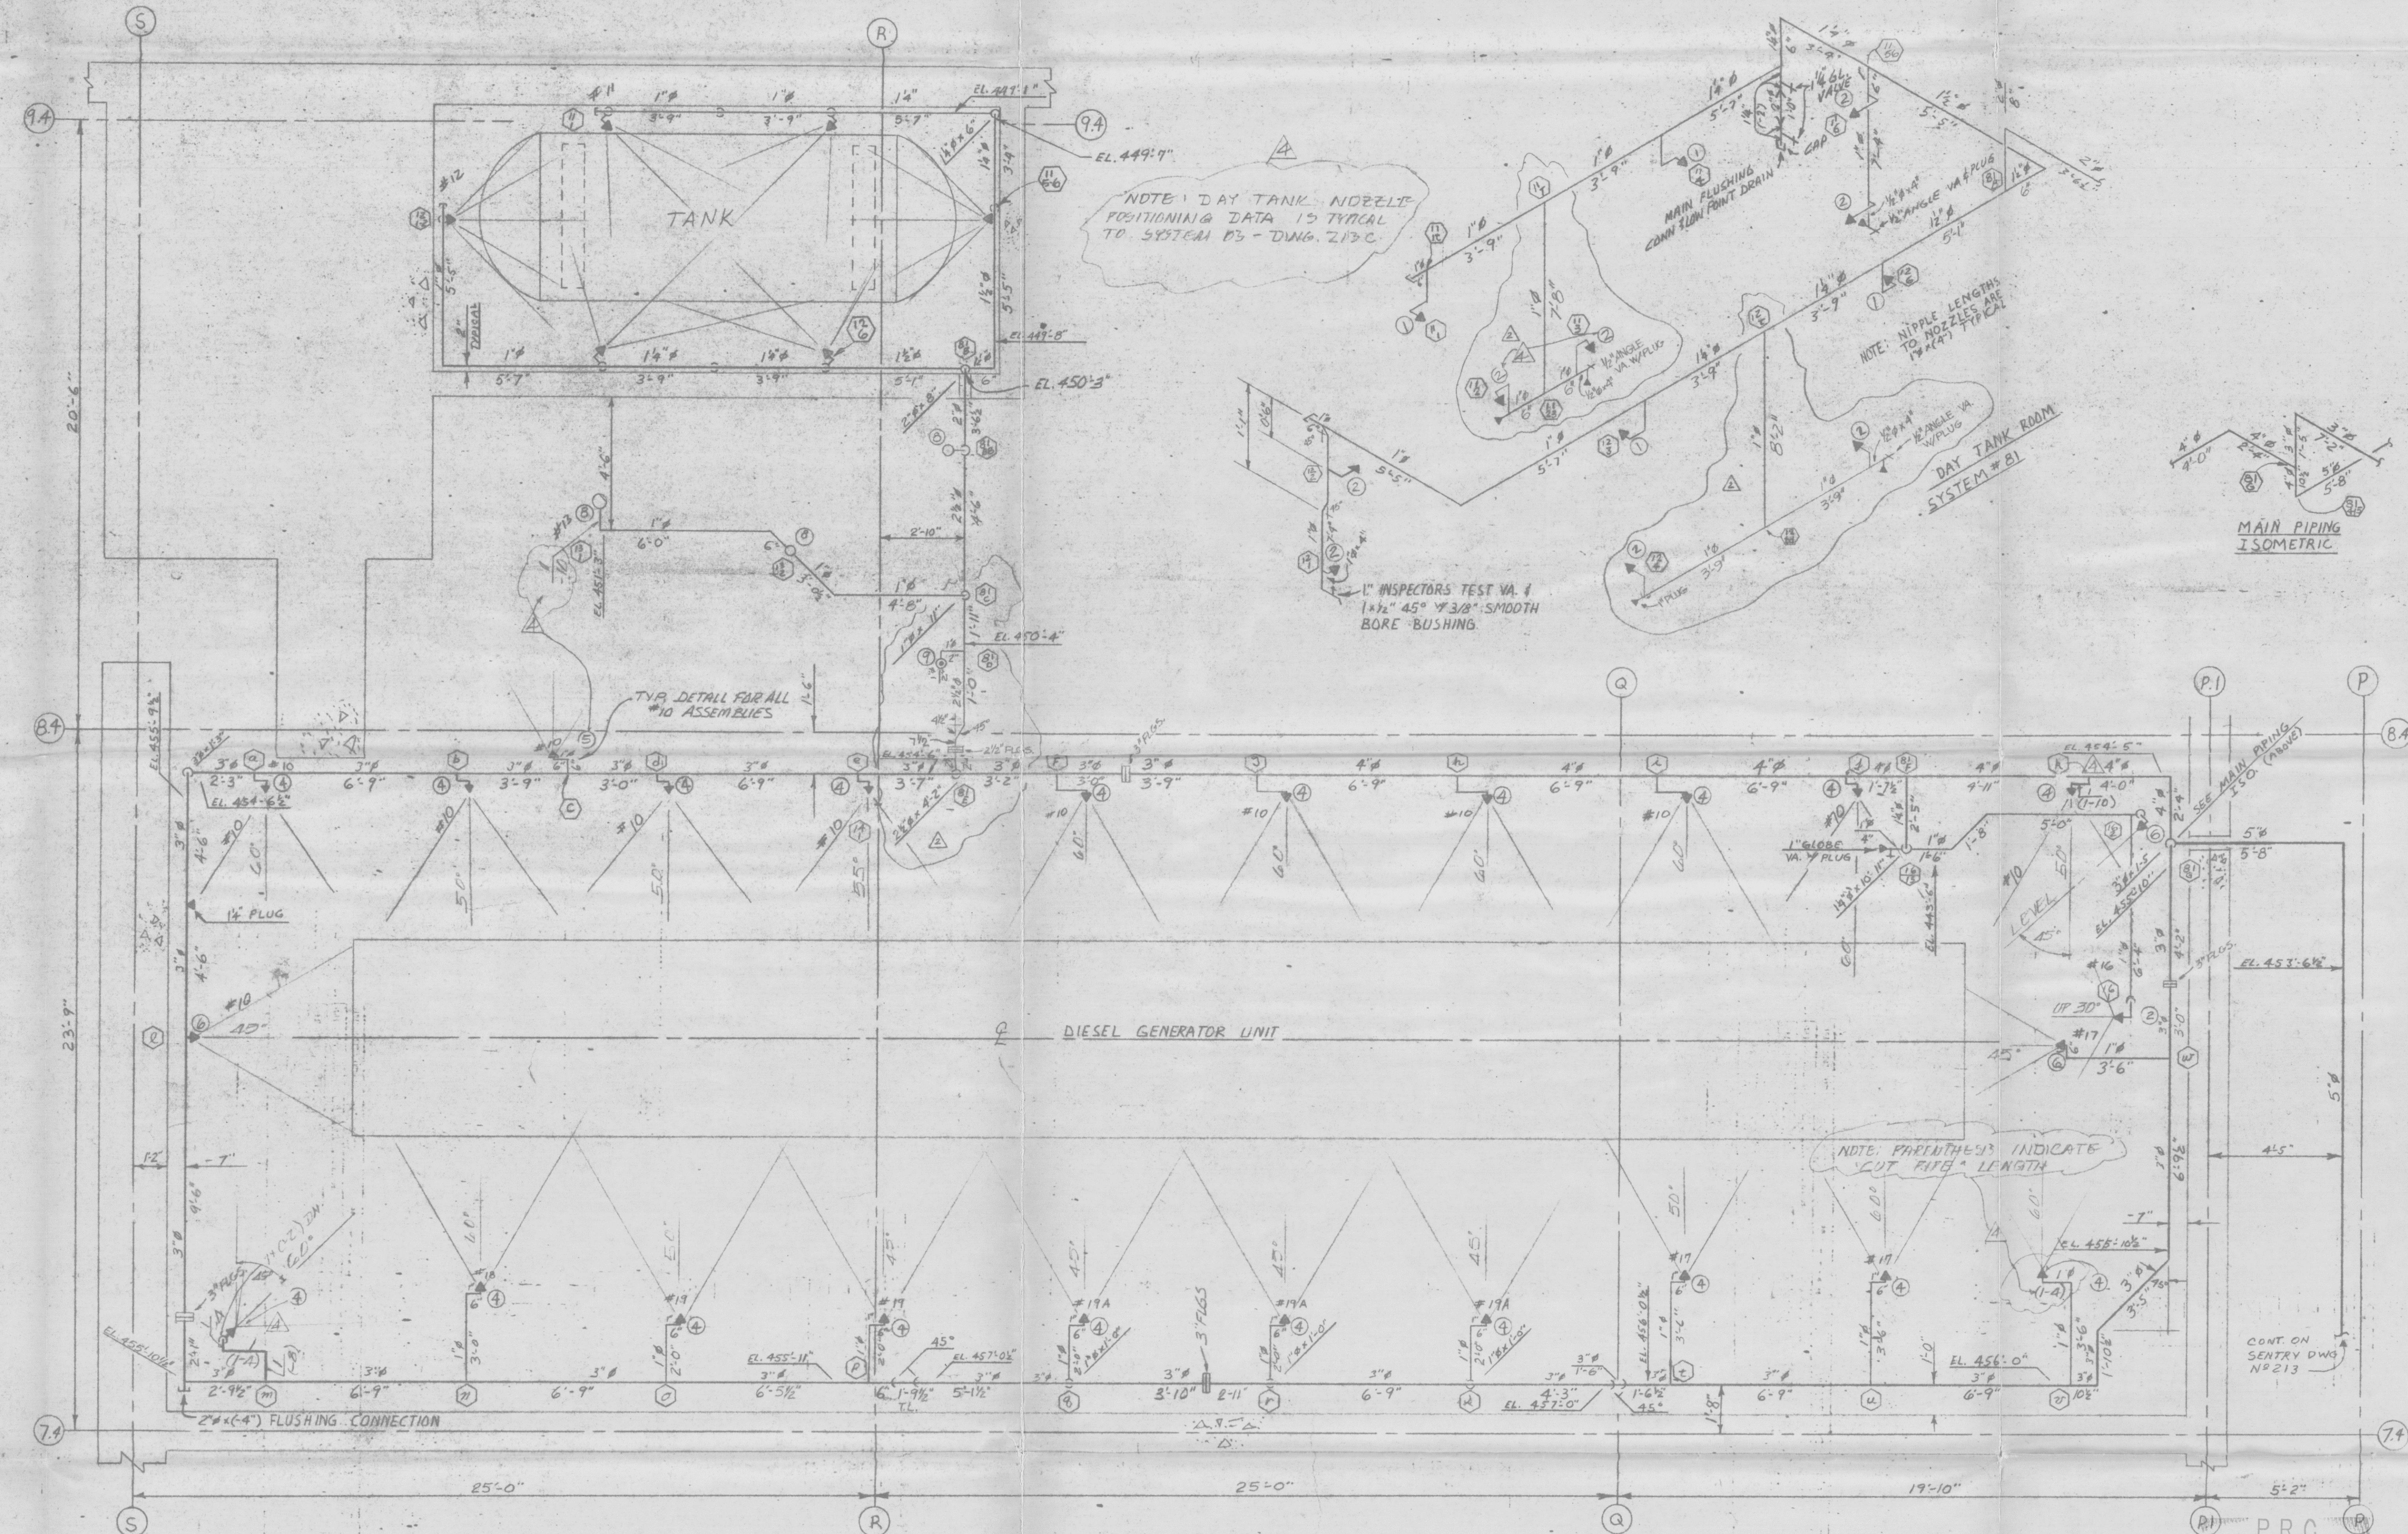

MATERIAL LIST
SEE SENTRY DWG. NO. 213

HANGERS
A U-HOOK
B COACH SCREW ROD
C CLAMP
D TOP BEAM CLAMP
E EYE ROD
F FLUSH SPOOL
G CEILING FLANGE
H SIDE BEAM BRKT
J U-BOLT
K SHORT CLIP
L C-ROD
M TOGGLE NUT
N MACH THD ROD
P POWDER DR STUD
R WEDGE ANCHOR
T
U
V
W
X
Y

TWO WAY EARTHQUAKE BRACE
FOUR WAY EARTHQUAKE BRACE
HIDES STRUCTURE TO PIPE

SPRINKLER	SIZE	TYPE	QUANTITY
1/2" SPRAY	1/2"	1/2"	1
3/4" SPRAY	3/4"	3/4"	1
1/2" SIDEWALL	1/2"	1/2"	1
1/2" DRY	1/2"	1/2"	1

TEMP. RATING	150°	200°	250°	300°	350°	400°
1/2" SPRAY	1	1	1	1	1	1
3/4" SPRAY	1	1	1	1	1	1
1/2" SIDEWALL	1	1	1	1	1	1
1/2" DRY	1	1	1	1	1	1

SPRINKLER	SIZE	TYPE	QUANTITY
1/2" SPRAY	1/2"	1/2"	1
3/4" SPRAY	3/4"	3/4"	1
1/2" SIDEWALL	1/2"	1/2"	1
1/2" DRY	1/2"	1/2"	1

NOTES:
FOR NOZZLE DESIGNATIONS SEE SENTRY DWG. NO. 213.
VALVE NUMBERS ARE ON SENTRY DWGS. NO. 212 & 214.
FOR GENERAL NOTES & DETAILS SEE SENTRY DWGS. 212 & 214.

HYDRAULIC DEMAND INFO ALL SYSTEMS SEE SENTRY DWG. NO. 213.

REV.	REV. PER	REV.
1	REV. PER B&R	1
2	COMMENTS LWD-12-18-80	2
3	REV. AS-BUILT (PLAN)	3
4	REV. AS-BUILT (ISO)	4
5	REV. AS-BUILT (NOZZLE POSITIONING)	5

APPROVAL
S.A.S.C.
Contract No. 2808-217
Title No. 1524
Date: 6-21-82
By: [Signature]

QUALITY CLASS II
SEISMIC CLASS I

REV.	REV. PER	REV.
1	REV. PER B&R	1
2	COMMENTS LWD-12-18-80	2
3	REV. AS-BUILT (PLAN)	3
4	REV. AS-BUILT (ISO)	4
5	REV. AS-BUILT (NOZZLE POSITIONING)	5

TITLE
WASHINGTON PUBLIC POWER
SUPPLY SYSTEM
HANFORD #2 CONTRACT 2808-217
DIESEL GENERATOR BUILDING
PRE-ACTION SYSTEM #81
SENTRY AUTOMATIC SPRINKLER CO. INC.
1108 - 54th Ave. East
Tucson (AZ), Washington 98424
(206) 822-6644

ENGINEER JMC DATE 5-23-80 DWG NO. 213 B JOB NO. 74-00081

8311090397 E