

**WNP-2**

**INSERVICE INSPECTION  
PROGRAM PLAN**

**INTERVAL - 2**

**VOLUME 1**

**Program Plan**

**WASHINGTON PUBLIC POWER  
SUPPLY SYSTEM**

9501130103 941227  
PDR ADOCK 05000397  
Q PDR



NUCLEAR PLANT 2

WNP-2  
INSERVICE INSPECTION PROGRAM PLAN  
Inspection Interval - 2  
December, 1994  
Revision 0

Owner: Washington Public Power Supply System  
3000 George Washington Way  
Richland, Washington 99352

Plant: WNP-2, located 11 miles north of Richland, Washington on the U.S. Department of Energy Hanford Reservation.

Commercial Service Date: December 13, 1984

Capacity: 1,145 MWe

Reactor Pressure Vessel	Manufacturer: CBIN	Serial Number: T-45
	State No.: N/A	Nat'l Bd. No.: CBIN-8

Prepared By: *D. Hanes* 12-5-94  
ISI Engineer Date

Reviewed By: *[Signature]* 12-5-94  
Supervisor, NDE/ISI Services Date

*R. M. [Signature]* 12-6-94  
Manager, Materials & Inspection Date

*C. R. Noyes* 12/7/94  
Manager, Engineering Programs Date

*Jeffrey Benjamin* 12/7/94  
Manager, Quality Assessments Date

*[Signature]* 12/7/94  
Plant Operating Committee Date

Approved By: *[Signature]* 12/14/94  
Plant Manager Date

Concurrence: *[Signature]* 12/15/94  
Authorized Nuclear Inservice Inspector Date

## 1.0 TABLE OF CONTENTS

## VOLUME 1 PROGRAM PLAN

## Approval Page

- 1.0 Table of Contents
- 2.0 Record of Revisions
  - 2.1 Amendments
  - 2.2 Page Revision Status
- 3.0 References
- 4.0 Program Description
  - 4.1 Introduction
  - 4.2 Program Philosophy
  - 4.3 Program Scope
  - 4.4 Program Summary
- 5.0 Code Compliance
  - 5.1 Modifications to Reference Code
    - 5.1.1 Code Edition and Addenda - 10 CFR 50.55a
    - 5.1.2 Relief Requests
    - 5.1.3 Code Cases
    - 5.1.4 Use of Later Editions and Addenda of ASME Section XI
  - 5.2 ASME Section XI, 1989 Edition
    - 5.2.1 IWA General Requirements
    - 5.2.2 IWB Requirements for Class 1 Components
    - 5.2.3 IWC Requirements for Class 2 Components
    - 5.2.4 IWD Requirements for Class 3 Components
    - 5.2.5 IWE Requirements for Class MC Components
    - 5.2.6 IWF Requirements for Class 1,2,3, and MC Component Supports
    - 5.2.7 RPV Visual (proposed Article IWG)
    - 5.2.8 Erosion - Corrosion Program
    - 5.2.9 IWL
    - 5.2.10 IWP
    - 5.2.11 IWV
    - 5.2.12 Appendix I
    - 5.2.13 Appendix II
    - 5.2.14 Appendix III
    - 5.2.15 Appendix IV
    - 5.2.16 Appendix V
    - 5.2.17 Appendix VI
    - 5.2.18 Appendix VII

## 1.0 TABLE OF CONTENTS

- 5.2.19 Appendix VIII
- 5.2.20 Non-mandatory Appendices
- 5.3 Repair/Replacement Program
- 6.0 FSAR - NRC Commitments
  - 6.1 Introduction
  - 6.2 FSAR Commitments
  - 6.3 Technical Specifications
  - 6.4 Regulatory Guides
  - 6.5 Generic Letters
  - 6.6 Other Commitments
- 7.0 Calibration Blocks
- 8.0 Procedure List
  - 8.1 Administrative
  - 8.2 NDE/Testing
  - 8.3 Evaluation - Analysis
  - 8.4 Plant Technical Specifications

**VOLUME 2 / VOLUME 3****Boundary Diagrams, Schedule, Weld and Component Diagrams**

- 9.0 Boundary Diagrams / Schedules / Weld and Component Diagrams
  - 9.1 Containment Penetrations
    - 9.1.1 Exemptions
    - 9.1.2 Boundary Diagram
    - 9.1.3 Examination Schedule
    - 9.1.4 Weld and Component Diagrams
  - 9.2 CCH
    - 9.2.1 Exemptions
    - 9.2.2 Boundary Diagram
    - 9.2.3 Examination Schedule
    - 9.2.4 Weld and Component Diagrams
  - 9.3 CRD
    - 9.3.1 Exemptions
    - 9.3.2 Boundary Diagram
    - 9.3.3 Examination Schedule
    - 9.3.4 Weld and Component Diagrams
  - 9.4 FPC
    - 9.4.1 Exemptions
    - 9.4.2 Boundary Diagram
    - 9.4.3 Examination Schedule
    - 9.4.4 Weld and Component Diagrams
  - 9.5 HPCS

## 1.0 TABLE OF CONTENTS

	9.5.1	Exemptions
	9.5.2	Boundary Diagram
	9.5.3	Examination Schedule
	9.5.4	Weld and Component Diagrams
9.6	LPCS	
	9.6.1	Exemptions
	9.6.2	Boundary Diagram
	9.6.3	Examination Schedule
	9.6.4	Weld and Component Diagrams
9.7	MS	
	9.7.1	Exemptions
	9.7.2	Boundary Diagram
	9.7.3	Examination Schedule
	9.7.4	Weld and Component Diagrams
9.8	RCC	
	9.8.1	Exemptions
	9.8.2	Boundary Diagram
	9.8.3	Examination Schedule
	9.8.4	Weld and Component Diagrams
9.9	RCIC	
	9.9.1	Exemptions
	9.9.2	Boundary Diagram
	9.9.3	Examination Schedule
	9.9.4	Weld and Component Diagrams
9.10	RFW	
	9.10.1	Exemptions
	9.10.2	Boundary Diagram
	9.10.3	Examination Schedule
	9.10.4	Weld and Component Diagrams
9.11	RHR	
	9.11.1	Exemptions
	9.11.2	Boundary Diagram
	9.11.3	Examination Schedule
	9.11.4	Weld and Component Diagrams
9.12	RPV	
	9.12.1	Exemptions
	9.12.2	Boundary Diagram
	9.12.3	Examination Schedule
	9.12.4	Weld and Component Diagrams
9.13	RRC	
	9.13.1	Exemptions
	9.13.2	Boundary Diagram
	9.13.3	Examination Schedule

## 1.0 TABLE OF CONTENTS

	9.13.4	Weld and Component Diagrams
9.14	RWCU	
	9.14.1	Exemptions
	9.14.2	Boundary Diagram
	9.14.3	Examination Schedule
	9.14.4	Weld and Component Diagrams
9.15	SLC	
	9.15.1	Exemptions
	9.15.2	Boundary Diagram
	9.15.3	Examination Schedule
	9.15.4	Weld and Component Diagrams
9.16	SW	
	9.16.1	Exemptions
	9.16.2	Boundary Diagram
	9.16.3	Examination Schedule
	9.16.4	Weld and Component Diagrams
9.17	MISC	Miscellaneous
	9.17.1	Weld and Component Diagrams

## 2.0 RECORD OF REVISIONS

### 2.1 Amendments

This section will summarize amendments as they are issued.



## 2.2 Page Revision Status

<u>Title</u>	<u>Sheet</u>	<u>Revision</u>
VOLUME 1 PROGRAM PLAN		
Approval Page		0
1.0 Table of Contents	1-1	0
	1-2	0
	1-3	0
	1-4	0
2.0 Record of Revisions	2-1	0
	2-2	0
	2-3	0
	2-4	0
	2-5	0
	2-6	0
	2-7	0
	2-8	0
	2-9	0
	2-10	0
	2-11	0
	2-12	0
	2-13	0
	2-14	0
	2-15	0
	2-16	0
	2-17	0
	2-18	0
	2-19	0
	2-20	0
	2-21	0
	2-22	0
	2-23	0
3.0 References	3-1	0
	3-2	0
4.0 Program Description	4-1	0
	4-2	0
	4-3	0
5.0 Code Compliance	5-1	0

## 2.2 Page Revision Status

<u>Title</u>	<u>Sheet</u>	<u>Revision</u>
	5-2	0
	5-3	0
Table 5.1.2.1	5-4	0
	5-5	0
Table 5.1.2.2	5-6	0
Figure 5.1.2.1	5-7	0
Figure 5.1.2.2	5-8	0
Figure 5.1.2.3	5-9	0
	5-10	0
	5-11	0
Table 5.1.2.3	5-12	0
Figure 5.1.2.4	5-13	0
	5-14	0
	5-15	0
	5-16	0
Figure 5.1.2. 5	5-17	0
Figure 5.1.2.6	5-18	0
	5-19	0
	5-20	0
	5-21	0
	5-22	0
	5-23	0
	5-24	0
	5-25	0
	5-26	0
	5-27	0
	5-28	0
	5-29	0
	5-30	0
	5-31	0
	5-32	0
	5-33	0
	5-34	0
	5-35	0
	5-36	0
	5-37	0
	5-38	0
	5-39	0
	5-40	0
	5-41	0

## 2.2 Page Revision Status

<u>Title</u>	<u>Sheet</u>	<u>Revision</u>
Table 5.2.1	5-42	0
	5-43	0
	5-44	0
	5-45	0
	5-74	0
5-76	0	
5-77	0	
5-78	0	
5-79	0	
5-80	0	
5-81	0	
5-82	0	
5-83	0	

## 2.2 Page Revision Status

<u>Title</u>	<u>Sheet</u>	<u>Revision</u>
	5-84	0
	5-86	0
	5-87	0
	5-88	0
	5-89	0
6.0 FSAR - NRC Commitments	6-1	0
Figure 6.1.1	6-2	0
Figure 6.1.2	6-3	0
Table 6.2.1	6-4	0
Table 6.2.1	6-5	0
Table 6.2.1	6-6	0
Table 6.2.1	6-7	0
Table 6.2.1	6-8	0
Table 6.2.1	6-9	0
Table 6.2.1	6-10	0
Table 6.2.1	6-11	0
Table 6.2.1	6-12	0
Table 6.2.1	6-13	0
Table 6.2.1	6-14	0
Table 6.2.1	6-15	0
Table 6.2.1	6-16	0
Table 6.2.1	6-17	0
Table 6.2.1	6-18	0
Table 6.2.1	6-19	0
	6-20	0
	6-21	0
	6-22	0
Table 6.4.1	6-23	0
	6-24	0
	6-25	0
7.0 Calibration Blocks	7-1	0
Table 7.1	7-2	0
Table 7.1	7-3	0
Table 7.1	7-4	0
Table 7.1	7-5	0
Table 7.1	7-6	0
Table 7.1	7-7	0
Table 7.1	7-8	0
Table 7.1	7-9	0

## 2.2 Page Revision Status

<u>Title</u>	<u>Sheet</u>	<u>Revision</u>
Table 7.1	7-10	0
Table 7.1	7-11	0
UTCBC-101	1	2
UTCBC-102	1	2
UTCBC-104	1	1
UTCBC-105	1	2
UTCBC-106	1	2
UTCBC-107	1	1
UTCBC-108	1	1
UTCBC-109	1	2
UTCBC-110	1	1
UTCBC-111	1	2
UTCBC-203	1	1
UTCBC-204	1	1
UTCBC-205	1	1
UTCBC-206	1	1
UTCBC-207	1	1
UTCBC-208	1	1
UTCBC-209	1	1
UTCBC-210	1	3
UTCBC-211	1	3
UTCBC-220	1	7
UTCBC-221	1	6
UTCBC-223	1	2
UTCBC-224	1	2
UTCBC-225	1	1
UTCBC-226	1	1
UTCBC-229	1	1
UTCBC-230	1	1
UTCBC-231	1	1
UTCBC-232	1	1
UTCBC-233	1	0
UTCBC-234	1	0
UTCBC-250	2	0
UTCBC-251	2	3
8.0 Procedure List	8-1	0
	8-2	0





## 2.2 Page Revision Status

<u>Title</u>	<u>Sheet</u>	<u>Revision</u>
	1	1
CRD-201	2	1
	3	2
	1	1
CRD-202	2	1
	3	2
9.4 FPC - Fuel Pool Cooling	9-19	0
Boundary Diagrams	9-20	0
ISI-226	1	7
	1A	5
	2	6
Examination Schedule	9-21	0
Table 9.1.4	14-29	0
Weld & Component Diag.	9-22	0
FPC-201	1	2
FPC-202	1	1
FPC-301	1	2
	2	2
	3	2
	4	2
	5	3
	6	3
	7	2
	8	3
FPC-302	1	2
	2	1
	3	2
	4	1
FPC-303	1	2
	2	2
	3	1
	4	1
FPC-304	1	2
	2	2
	3	2
	4	1
	5	1
FPC-305	1	2
	2	2



## 2.2 Page Revision Status

<u>Title</u>	<u>Sheet</u>	<u>Revision</u>
	3	2
	4	2
	5	2
	6	2
	7	2
	8	2
	9	3
	10	2
	11	1
FPC-306	1	3
FPC-307	1	2
FPC-308	1	2
	3	2
FPC-309	1	0
FPC-310	1	0
FPC-311	1	0
	2	0
	3	0
FPC-312	1	0
FPC-313	1	0
9.5 HPCS - High Pressure Core Spray		
	9-23	0
Boundary Diagrams	9-24	0
ISI-220-1		5
Examination Schedule	9-25	0
Table 9.1.4	30-48	0
Weld & Component Diag.	9-26	0
HPCS-101	1	4
	2	6
HPCS-201	1	3
	2	6
	3	1
HPCS-202	1	4
	2	4
	3	3
	4	3
	5	3
	6	4
HPCS-203	1	1

## 2.2 Page Revision Status

<u>Title</u>	<u>Sheet</u>	<u>Revision</u>
HPCS-204	1	1
	2	2
HPCS-205	1	1
	2	2
9.6 LPCS - Low Pressure Core Spray		
9-27		0
Boundary Diagrams	9-28	0
ISI-220-2		5
Examination Schedule	9-29	0
Table 9.1.4	49-62	0
Weld & Component Diag.	9-30	0
LPCS-101	1	4
	2	5
LPCS-201	1	3
	2	4
LPCS-202	1	3
	2	3
	3	3
	4	3
	5	4
LPCS-203	1	1
LPCS-204	1	1
	2	1
LPCS-205	1	1
	2	1
	3	1
	4	2
LPCS-206	1	2
	2	1
LPCS-207	1	2
	2	1
	3	1

## VOLUME 2 BOUNDARY DIAGRAMS, SCHEDULE, AND COMPONENT DIAGRAMS

9.7 MS - Main Steam	9-31	0
Boundary Diagrams	9-32	0
ISI-229	1	5
	1A	5
	2	5

## 2.2 Page Revision Status

<u>Title</u>	<u>Sheet</u>	<u>Revision</u>
	2A	5
	3	3
	4	3
Examination Schedule	9-33	0
Table 9.1.4	63-190	0
Weld & Component Diag.	9-34	0
MS-101	1	6
	2	6
	3	1
MS-102	1	7
	2	6
MS-103	1	6
	2	4
MS-104	1	5
	2	6
MS-105	1	3
	2	3
	3	3
MS-106	1	4
	2	2
	3	2
	4	2
MS-107	1	0
MS-108	1	0
MS-109	1	0
MS-110	1	0
MS-201	1	4
	2	6
	3	7
	4	5
	5	1
MS-202	1	5
	2	6
	3	6
	4	4
	5	1
MS-203	1	5
	2	4
	3	6
	4	4
	5	2

## 2.2 Page Revision Status

<u>Title</u>	<u>Sheet</u>	<u>Revision</u>
MS-204	1	4
	2	5
	3	5
	4	4
	5	1
MS-205	1	3
MS-206	1	3
MS-207	1	0
	2	0
MS-208	1	0
	2	0
MS-209	1	0
	2	0
MS-210	1	0
	2	0
MS-211	1	0
	2	0
MS-212	1	0
	2	0
MS-213	1	0
	2	0
MS-214	1	0
	2	0
MS-215	1	0
	2	0
MS-216	1	0
	2	0
MS-217	1	0
	2	0
MS-218	1	0
	2	0
MS-219	1	0
	2	0
MS-220	1	0
	2	0
MS-221	1	0
	2	0
MS-222	1	0
	2	0
MS-223	1	0
	2	0

## 2.2 Page Revision Status

<u>Title</u>	<u>Sheet</u>	<u>Revision</u>
MS-224	1	0
	2	0
MS-301	1	2
	2	1
	3	1
MS-302	1	1
	2	2
	3	1
MS-303	1	1
	2	2
	3	1
MS-304	1	1
	2	1
	3	2
MS-305	1	1
	2	1
	3	1
MS-306	1	1
	2	2
	3	1
MS-307	1	1
	2	1
	3	1
MS-308	1	1
	2	1
	3	1
	4	1
MS-309	1	1
	2	1
	3	1
MS-310	1	1
	2	1
	3	1
MS-311	1	1
	2	1
	3	1
MS-312	1	1
	2	1
	3	1
MS-313	1	1
	2	1

## 2.2 Page Revision Status

<u>Title</u>	<u>Sheet</u>	<u>Revision</u>
	3	1
MS-314	1	1
	2	1
	3	1
MS-315	1	1
	2	1
	3	1
MS-316	1	1
	2	1
	3	1
MS-317	1	1
	2	1
	3	2
MS-318	1	1
	2	1
	3	2
9.8 RCC - Reactor Closed Cooling		
	9-35	0
Boundary Diagrams	9-36	0
ISI-225	1	4
	2	4
	3	4
	4	3
Examination Schedule	9-37	0
Table 9.1.4	191-197	0
Weld & Component Diag.	9-38	0
RCC-201	1	1
RCC-202	1	2
RCC-301	1	2
	2	2
	3	3
RCC-302	1	2
	2	3
RRC-303	1	1
	2	1
RCC-304	1	1
	2	1
9.9 RCIC - Reactor Core Isolation Cooling		
	9-39	0

## 2.2 Page Revision Status

<u>Title</u>	<u>Sheet</u>	<u>Revision</u>
Boundary Diagrams	9-40	0
ISI-219	1	7
	2	4
Examination Schedule	9-41	0
Table 9.1.4	198-225	0
Weld & Component Diag.	9-42	0
RCIC-101	1	5
	2	7
	3	5
RCIC-102	1	5
	2	5
	3	7
RCIC-103	1	2
RCIC-201	1	5
	2	3
RCIC-202	1	2
	2	2
	3	2
	4	2
	5	2
RCIC-203	1	3
	2	3
	3	2
RCIC-204	1	3
	2	3
	3	2
	4	5
RCIC-205	1	3
	2	3
	3	3
	4	3
	5	3
	6	3
	6A	3
	7	2
9.10 RFW- Reactor Feedwater	9-43	0
Boundary Diagrams	9-44	0
ISI-229	9-45	0
Examination Schedule	9-46	0
Table 9.1.4	226-244	0

## 2.2 Page Revision Status

<u>Title</u>	<u>Sheet</u>	<u>Revision</u>
Weld & Component Diag.	9-47	0
RFW-101	1	4
	2	3
	3	5
	4	5
	5	5
RFW-102	1	5
	2	3
	3	5
	4	5
	5	5
RFW-103	1	4

## VOLUME 3 BOUNDARY DIAGRAMS, SCHEDULE, AND COMPONENT DIAGRAMS

## 9.11 RHR - Residual Heat Removal

	9-48	0
	9-49	0
Boundary Diagrams	9-50	0
ISI-221	1	7
	1A	7
	2	6
	2A	6
	3	7
	4	3
Examination Schedule	9-51	0
Table 9.1.4	245-354	0
Weld & Component Diag.	9-52	0
RHR-101	1	8
RHR-102	1	8
RHR-103	1	8
RHR-104	1	5
RHR-105	1	5
RHR-106	1	6
RHR-108	1	3
RHR-201	1	5
	2	4
	3	3
	4	3
	5	6



## 2.2 Page Revision Status

<u>Title</u>	<u>Sheet</u>	<u>Revision</u>
	6	2
	7	4
	8	3
	9	4
	10	3
	11	6
RHR-202	1	2
	2	4
RHR-203	1	3
	2	4
	3	6
	4	3
	5	2
RHR-204	1	2
	2	3
	3	2
	4	2
RHR-205	1	4
	2	3
	3	5
	4	4
RHR-206	1	4
	2	3
	3	5
RHR-207	1	3
	2	3
	3	4
	4	4
	5	4
	6	4
	7	5
	8	4
	9	4
	10	4
	11	5
	12	4
	13	4
	14	5
	15	5
	16	5
	17	3

## 2.2 Page Revision Status

<u>Title</u>	<u>Sheet</u>	<u>Revision</u>
	18	2
RHR-208	1	2
	2	3
	3	2
	4	2
	5	2
RHR-209	1	4
	2	5
RHR-210	1	3
	2	2
	3	4
	4	5
	5	4
	6	1
RHR-211	1	3
	2	4
	3	3
RHR-212	1	2
RHR-213	1	2
RHR-214	1	1

9.12 RPV - Reactor Pressure Vessel	9-53	0
Boundary Diagrams	9-54	0
No Boundary Diagram for this system		
Examination Schedule	9-55	0
Table 9.1.4	355-396	0
Weld & Component Diag.	9-56	0
RPV-101	1	5
RPV-102	1	3
RPV-103	1	2
RPV-104	1	0
RPV-105	1	1
RPV-106	1	1
RPV-107	1	1
RPV-108	1	1
RPV-109	1	1
RPV-110	1	1
RPV-111	1	1
RPV-112	1	1

## 2.2 Page Revision Status

<u>Title</u>	<u>Sheet</u>	<u>Revision</u>
RPV-113	1	1
RPV-114	1	1
RPV-115	1	1
RPV-116	1	0
RPV-201	1	0
RPV-401	1	0
RPV-402	1	0
9.13 RRC - Reactor Recirculation		
	9-57	0
Boundary Diagrams	9-58	0
ISI-230	1	6
	2	6
	3	6
Examination Schedule	9-59	0
Table 9.1.4	397-451	0
Weld & Component Diag.	9-60	0
RRC-101	1	6
	2	5
	3	4
	4	3
	5	3
	6	3
	7	3
	8	3
RRC-102	1	5
	2	6
	3	5
	4	3
	5	3
	6	3
	7	3
	8	3
RRC-103	1	2
RRC-104	1	5
RRC-105	1	3
RRC-106	1	3
RRC-107	1	3
RRC-108	1	3
RRC-109	1	3
RRC-110	1	3

## 2.2 Page Revision Status

<u>Title</u>	<u>Sheet</u>	<u>Revision</u>
RRC-111	1	2
RRC-112	1	2
RRC-113	1	2
9.14 RWCU - Reactor Water Cleanup		
	9-61	0
Boundary Diagrams	9-62	0
ISI-223	1	4
	2	4
Examination Schedule	9-63	0
Table 9.1.4	452-462	0
Weld & Component Diag.	9-64	0
RWCU-101	1	4
	2	5
	3	4
	4	5
	5	4
RWCU-301	1	3
RWCU-302	1	2
RWCU-303	1	2
	2	2
	3	4
RWCU-304	1	3
	2	2
	3	2
RWCU-305	1	3
9.15 SLC - Stand-by Liquid Control		
	9-65	0
Boundary Diagrams	9-66	0
ISI-222	1	4
Examination Schedule	9-67	0
Table 9.1.4	463-466	0
Weld & Component Diag.	9-68	0
SLC-101	1	1
	2	1
	3	1
	4	2
	5	1
	6	1
	7	1

## 2.2 Page Revision Status

<u>Title</u>	<u>Sheet</u>	<u>Revision</u>
9.16 SW - Standby Service Water		
	9-69	0
Boundary Diagrams	9-70	0
ISI-224	1	6
	1A	6
	2	5
	2A	5
	3	5
	3A	5
	4	6
	4A	6
	5	7
	6	5
	7	3
	7A	3
Examination Schedule	9-71	0
Table 9.1.4	467-500	0
Weld & Component Diag.	9-72	0
SW-301	1	1
	2	2
	3	2
	4	2
	5	3
	6	2
SW-302	1	4
SW-303	1	1
	2	3
	3	3
	4	2
	5	2
	6	2
	7	2
	8	3
SW-304	1	3
SW-305	1	2
	2	2
	3	2
	4	3
SW-306	1	4
SW-307	1	2
	2	3

## 2.2 Page Revision Status

<u>Title</u>	<u>Sheet</u>	<u>Revision</u>
	3	3
	4	2
	5	2
SW-308	1	3
SW-309	1	2
SW-310	1	3
SW-311	1	2
SW-312	1	2
	2	1
SW-313	1	2
SW-314	1	2
	2	1
SW-315	1	2
9.17 Miscellaneous		
Weld & Component Diag.	9-74	0
CEP-201	1	1
CEP-202	1	1
CSP-201	1	1
CSP-202	1	1
DE-401	1	1
	2	1
DE-402	1	1
DE-403	1	1
	2	1
DE-404	1	1
	2	1
DE-405	1	1
	2	1
HY-201	1	1
HY-202	1	1
HY-203	1	1
MD-201	1	0
MD-202	1	0
MD-203	1	0
MD-204	1	0
MD-205	1	0
MD-206	1	2
MSLC-101	1	0
MSLC-102	1	1
MSLC-103	1	1

## 2.2 Page Revision Status

<u>Title</u>	<u>Sheet</u>	<u>Revision</u>
MSLC-104	1	0
MSLC-201	1	0
	2	0
	3	0
MSLC-202	1	0
	2	1
	3	0
MSLC-203	1	0
	2	0
	3	0
MSLC-204	1	0
	2	1
	3	0
MSLC-205	1	0
MSLC-206	1	0
MSLC-207	1	0
	2	0
	3	0
	4	0
SGT-201	1	1
SGT-202	1	1
VR-401	1	1
	2	1

**3.0 REFERENCES**

1. ASME Boiler and Pressure Vessel Code, Section XI, entitled "Rules for Inservice Inspection of Nuclear Power Plant Components", ASME Section XI, 1989 Edition, no Addenda
2. ASME Boiler and Pressure Vessel Code, Section XI, entitled "Rules for Inservice Inspection of Nuclear Power Plant Components", ASME Section XI, 1992 Edition, Addenda through 1993
3. ASME Boiler and Pressure Vessel Code, Section XI, entitled "Rules for Inservice Inspection of Nuclear Power Plant Components", ASME Section XI, Interpretations Volume 30, XI-1-92-01, page 242, XI-1-92-04, page 243, Interpretations Volume 34, XI-1-92-56, page 281
4. ASME/ANSI OM Part 4, 1987 Edition
5. Generic Letter 83-15 "Regulatory Guide 1.150, Ultrasonic Testing of Reactor Vessel Welds During Preservice and Inservice Examinations", Revision 1
6. Generic Letter 88-01, "NRC Position on IGSCC in BWR Austenitic Stainless Steel Piping"
7. Generic Letter 88-01 Supplement 1 "NRC Position on Intergranular Stress Corrosion Cracking (IGSCC) in BWR Austenitic Stainless Steel Piping"
8. Generic Letter 89-09 "ASME Section III Component Replacement"
9. Generic Letter 90-05 "Guidance for Performing Temporary Non-Code Repair of ASME Code Class 1, 2, and 3 Piping"
10. Generic Letter 90-09 "Alternative Requirements for Snubber Visual Inspection Intervals and Corrective Actions"
11. Generic Letter 94-03 "Intergranular Stress Corrosion Cracking of Core Shrouds in Boiling Water Reactors"
12. Letter, Nuclear Regulatory Commission to Mr. G.C. Sorensen, "Issuance of Amendment No. 77 to Facility Operating Licence No. NPF-21 - WPPSS Nuclear Project No. 2 (TAC No. 66885)" dated March 1, 1990.
13. Regulatory Guide 1.147 "Inservice Inspection Code Case Acceptability ASME Section XI Division 1" Revision 11 (dated October 1994)
14. Supply System letter G02-83-523, G.D. Bouchey to Mr. A. Schwencer, "PSI Summary Report Clarification" dated June 15, 1983.



15. Supply System letter G02-90-024, "Request for Amendment to Technical Specifications, Final Feedwater Temperature Reduction (FFTR)", dated February 14, 1990
16. Supply System letter G02-94-202, "Reponse to Generic Letter 94-03, Intergranular Stress Corrosion Cracking of Core Shrouds", dated August 24, 1994
17. Title 10 Code of Federal Regulations Part 50 Section 50.55a, dated December 31, 1992
18. WNP-2 Final Safety Analysis Report (FSAR)

## 4.0 PROGRAM DESCRIPTION

### 4.1 INTRODUCTION

This Inservice Inspection (ISI) Program Plan is applicable to the Washington Public Power Supply System Nuclear Plant No. 2 (WNP-2). This single unit Boiling Water Reactor (BWR) power plant is located 11 miles north of Richland, Washington, on the Hanford Reservation. The plant employs a General Electric (GE) supplied Nuclear Steam Supply System (NSSS) designated as BWR/5. The reactor is contained within an over-under drywell/wetwell containment vessel designated Mark II. The plants net rated electrical output is 1,145 MWe. The plant received its operating license December 20, 1983 and was placed into commercial operation December 13, 1984.

This Program Plan has been prepared as the controlling document governing the inservice examination activities at WNP-2 during the second 10-year inspection interval. The requirements for inservice examinations are outlined in the ASME Boiler and Pressure Vessel Code, Section XI, entitled "Rules for Inservice Inspection of Nuclear Power Plant Components", Title 10 Code of Federal Regulations Part 50 Section 50.55a (10 CFR 50.55a), and various other regulatory and licensing documents including Inspection and Enforcement Bulletins, Generic Letters, Regulatory Guides and the Final Safety Analysis Report (FSAR).

### 4.2 PROGRAM PHILOSOPHY

The overall intent of the Supply System in preparing the WNP-2 Inservice Inspection (ISI) Program Plan is to develop a program which reflects a good balance of the following objectives and constraints:

1. To the maximum extent practical, comply with the approved codes, regulations, and commitments governing the inservice inspection of WNP-2 during the second 10-year inspection interval.
2. Minimize the cost and schedule impact of the required examination activities during plant operation and refueling outages.
3. Develop a program which includes the philosophy of the latest published addenda of ASME Section XI.

The Supply System believes that the WNP-2 Inservice Inspection Program Plan reflects the above philosophy and as such will result in a program of inspections which are in the best interest of the health and safety of the general public.

### 4.3 PROGRAM SCOPE

The scope of this plan is limited to nondestructive examinations of ASME Section III Class 1, 2 and 3 piping systems, components and examination and testing of component supports. Inservice testing of pumps and valves, required by subsection IWP and IWV of ASME

Section XI, is not included in this plan, but is the subject of a separate document.

This Program Plan governs all manual and automated nondestructive examinations, evaluations, and reporting activities required by ASME Section XI as invoked by 10CFR50.55a and applicable augmented examination requirements.

#### 4.4 PROGRAM SUMMARY

Following is a listing of the Program Plan Sections with brief summaries of the purpose and content of certain sections. This summary is intended to orient the reader with the organization of the Program Plan. Details regarding the use of a given section are found in the introduction to that section.

##### 1.0 TABLE OF CONTENTS

##### 2.0 RECORD OF PROGRAM PLAN REVISIONS

Identifies latest revision of each page of the Program Plan.

##### 3.0 REFERENCES

Lists references used to develop this program plan.

##### 4.0 PROGRAM DESCRIPTION

Contains an overview of the Program Plan.

##### 5.0 CODE COMPLIANCE

Identifies applicable Code commitments, Code cases, Code exemptions and Code applicability. Contains requests for relief.

##### 6.0 FSAR/NRC COMMITMENTS/AUGMENTED EXAMINATIONS

Identifies FSAR and other regulatory commitments and applicable augmented inspection requirements.

##### 7.0 UT CALIBRATION STANDARDS

Tabulates the various ultrasonic calibration standards, their material, their applicability, and their identification numbers. Also included are design drawings for each standard.

##### 8.0 PROCEDURES

Lists the procedures that are used to develop and implement this program.

## 9.0 BOUNDARY DIAGRAMS, EXAMINATION SCHEDULE AND WELD AND COMPONENT DIAGRAMS

Illustrates on piping isometric-type diagrams, each pipe spool and associated welds and components which require examination per the ISI Boundary Diagrams in Section 9.0. Each weld and component requiring surface, visual (VT-1, VT-3) or volumetric examination is assigned a unique ISI identification number which is used exclusively in referring to that weld or component on all examination diagrams, tables, examination records, and reports. The first part of this section contains the table listing each examination area. The last part of this section contains the Weld and Component Identification Diagrams. This section is divided by systems. Each system section contains the exemptions that are being applied to it, the boundary diagram, a summary of Code examination categories containing the number of items in each and how many are scheduled for examination and weld and component diagrams showing the location of the items being examined.

**5.0 CODE COMPLIANCE****5.1 REFERENCE CODE****5.1.1 Code Edition and Addenda - 10 CFR 50.55a**

Inservice inspection of nuclear power plant components is required by federal law as stated in the Code of Federal Regulations, Title 10, Part 50 (10CFR50), Paragraph 50.55a. According to that document the applicable edition of ASME Section XI for the second inservice inspection interval at WNP-2 is the 1989 Edition, no Addenda [see 10CFR50.55a (g)(4)(i), dated December 31, 1992]. Therefore, the Reference Code is the 1989 Edition, no Addenda of the ASME Boiler and Pressure Vessel Code Section XI. The 10 CFR 50.55a document has not approved for use Article IWE of this Edition. This program plan does not address Article IWE.

**5.1.2 Relief Requests**

This section contains the Supply System's relief requests from the Referenced Code requirements. The Supply System has determined that the items in this section are not practical to examine to the requirements of the Reference Code, present a hardship to examine, or that an alternative examination will provide a better examination. Each item is supported by the basis for not performing the examination per the Reference Code.

All requests for relief in this section, except as noted, apply during the entire second inspection interval. The alternate examinations will be performed during the second inspection interval.

The following relief requests are included in this section:

<u>Request #</u>	<u>Description</u>
2ISI-01	Reactor pressure vessel welds in Examination Category B-A that can not be fully examined.
2ISI-02	Reactor pressure vessel welds in Examination Category B-D welds that can not be fully examined.
2ISI-03	Reactor pressure vessel closure head nuts Examination Category B-G-1.
2ISI-04	IWA-5244, standby service water (SW) buried piping.
2ISI-05	Relief from doing pneumatic test on MSRV downcomers Examination Category D-A.
2ISI-06	IWA-5250(a)(2) Flange leaks during pressure testing - CRD bolting
2ISI-07	IWA-5250(a)(2) Flange leaks during pressure testing

- 2ISI-08 Examination Category B-K-1 welded attachments that can not be fully examined due to excessive radiation dose.
- 2ISI-09 Examination Category C-C welded attachments that can not be fully examined due to plant design.
- 2ISI-10 Examination Category D-B welded attachments
- 2ISI-11 IWF-5300(a) Snubber Examination
- 2ISI-12 IWA-4340 Defect Removal
- 2ISI-13 Use of Code Case N-416-1
- 2ISI-14 IWA-5250(a)(2) Flange leaks after repairs or replacements

## RELIEF REQUEST NO. 2ISI-01

**Welds for Which Relief is Requested**

ASME Section XI Examination Category B-A, pressure retaining welds in reactor pressure vessel.

<u>Ident. No.</u>	<u>Description</u>	<u>Item No.</u>	<u>ISI Diagram No.</u>
AB	#1-#2 SC CRC WD	B1.11	RPV-101 (Figure 5.1.2.1)
AD	#3-#4 SC CRC WD	B1.11	RPV-101 (Figure 5.1.2.1)
AE	#4 SC-FL CRC WD	B1.30	RPV-116 (Figure 5.1.2.2)
DG	BOT HD DOL at 270°	B1.21	RPV-102 (Figure 5.1.2.3)
DR	BOT HD DOL at 90°	B1.21	RPV-102 (Figure 5.1.2.3)
DA	BTM HD MRD at 272°	B1.22	RPV-102 (Figure 5.1.2.3)
DB	BTM HD MRD at 332°	B1.22	RPV-102 (Figure 5.1.2.3)
DC	BTM HD MRD at 32°	B1.22	RPV-102 (Figure 5.1.2.3)
DD	BTM HD MRD at 92°	B1.22	RPV-102 (Figure 5.1.2.3)
DE	BTM HD MRD at 152°	B1.22	RPV-102 (Figure 5.1.2.3)
DF	BTM HD MRD at 212°	B1.22	RPV-102 (Figure 5.1.2.3)

**Section XI Requirements**

Section XI, Table IWB-2500-1, Examination Category B-A, items B1.11, B1.21, B1.22, and B1.30 requires a volumetric examination of the weld and adjacent base metal as defined in Figures IWB-2500-1, IWB-2500-3, and IWB-2500-4.

**Code Requirement from Which Relief is Requested**

Relief is requested from performing a volumetric examination of 100% of the examination volumes defined in Figures IWB-2500-1, IWB-2500-3, and IWB-2500-4.

**Basis for Relief**

Relief is requested from ASME Section XI examination requirements on the basis of partial inaccessibility of the welds due to plant design. Design of the Reactor Pressure Vessel and biological shield wall were completed prior to promulgation of amendments to 10CFR50.55a. The design limits access to less than 100% of these welds. Table 5.1.2.1 illustrates the coverage obtained during the first inspection interval and reasons full Code coverage was not obtained.

**Table 5.1.2.1 Examination Coverage Obtained First Inspection Interval**

Weld Number	Description	ISO No.	% of Weld Volume	
			Examinable	Remarks
AB	#1-#2 SC CRC WD	RPV-101	79%	See Note 1
AD	#3-#4 SC CRC WD	RPV-101	83%	See Note 2
AE	#4 SC-FL CRC WD	RPV-101	49%	See Note 3
DA	BTM HD MRD at 272°	RPV-102	78%	See Note 4
DB	BTM HD MRD at 332°	RPV-102	78%	See Note 4
DC	BTM HD MRD at 32°	RPV-102	78%	See Note 4
DD	BTM HD MRD at 92°	RPV-102	78%	See Note 4
DE	BTM HD MRD at 152°	RPV-102	78%	See Note 4
DF	BTM HD MRD at 212°	RPV-102	78%	See Note 4
DG	BOT HD DOL at 270°	RPV-102	17%	See Note 5
DR	BOT HD DOL at 90°	RPV-102	17%	See Note 5

**Notes to Table**

1. Examination coverage limited by weld taper.
2. Examination coverage limited by RPV stabilizer lugs.
3. Design of flange limits examination to one side.
4. Only 21" starting from the intersection of weld AA and 14" starting from the intersection of weld AJ can be examined due to the vessel skirt. (Approximately one foot is not being examined on each weld).
5. Only 12" to 23" on each end of the weld, starting from the intersection of weld AJ, can be examined due to CRD penetrations and housings.

**Alternative Examinations**

Each weld will be examined per Section XI requirements to the extent defined in Table 5.1.2.1 above.

**Justification for the Granting of Relief**

There will be no adverse impact on plant quality and safety by doing only a partial Code examination of these welds.

1. The Class 1 RPV welds have passed radiographic, magnetic particle and ultrasonic examinations in accordance with ASME Section III requirements.
2. Examinations of the RPV welds during the first inspection interval did not reveal any unacceptable indications.



3. The identified welds will be subject to a system pressure test in accordance with ASME Section XI Code Case N-498 requirements.
4. Leak detection systems identify significant leakage in the areas of the subject welds. Appropriate operator action would occur due to leak detection system alarms.
5. Other similar welds in the vessel will receive full Code examinations. During the first inspection interval 84% of the total weld volume in the RPV received a complete Code volume examination. No unacceptable indications were found. Table 5.1.2.2 presents the coverage obtained during the first inspection interval.
6. The welds examined represent a large and representative sample of the reactor pressure vessel. The integrity of the RPV can be verified by examination of this sample.

#### Implementation Schedule

This relief request will be implemented during the third inspection period of the second inspection interval.

Table 5.1.2.2 Examination Coverage Obtained During First Inspection Interval

RPV COVERAGE						
Ident. No.	Description	Weld length (inches)	Weld Area (square inch)	Weld Volume (cubic inches)	Percent Examined	Volume Scanned (cubic inches)
AA	BTM HD-SC#1 WD	840	71.8	60312	99.8	60191
AB	#1-#2 SC CRC WD	840	70.5	59220	79.7	47198
AC	#2-#3 SC CRC WD	840	57.9	48636	92.4	44940
AD	#3-#4 SC CRC WD	840	60.7	50988	83.6	42626
AE	#4 SC-FL CRC WD	792	74.3	58846	49.4	29070
AG	TOP HD-FLG WELD	783	36.6	28658	95.1	27254
AH	TOP HD DOL PLT	516	31.4	16202	100.0	16202
AJ	BOT HD DOL WELD	684	70.4	48154	100.0	48154
BA	#1 SC VRT W@45	130	119.8	15574	90.8	14141
BB	#1 SC VRT W@135	130	119.8	15574	91.9	14313
BC	#1 SC VRT W@225	130	119.8	15574	91.2	14203
BD	#1 SC VRT W@315	130	119.8	15574	92.8	14453
BE	#2 SC VRT W@ 10	175	53.2	9310	98.1	9133
BF	#2 SC VRT W@100	175	53.2	9310	95.6	8900
BG	#2 SC VRT W@190	175	53.2	9310	98.1	9133
BH	#2 SC VRT W@280	175	53.2	9310	93.7	8723
BJ	#3 SC VRT W@ 50	169	61.9	10461	91.7	9593
BK	#3 SC VRT W@170	169	61.9	10461	96.8	10126
BH	#3 SC VRT W@290	169	61.9	10461	92.1	9635
BN	#4 SC VRT W@330	146	66.8	9746	100.0	9746
BP	#4 SC VRT W@ 90	146	66.8	9746	100.0	9746
BR	#4 SC VRT W@210	146	66.8	9746	100.0	9746
DA	BOT HD MRD @272	56	62.7	3499	78.6	2750
DB	BOT HD MRD @332	56	62.7	3499	78.6	2750
DC	BOT HD MRD @ 32	56	62.7	3499	78.6	2750
DD	BOT HD MRD @ 92	56	62.7	3499	78.6	2750
DE	BOT HD MRD @152	56	62.7	3499	78.6	2750
DF	BOT HD MRD @212	56	62.7	3499	78.6	2750
DG	BOT HD DOL /270	219	77.3	16944	16.7	2830
DH	TOP HD MRD @15	78	41.0	3198	100.0	3198
DJ	TOP HD MRD @75	78	41.0	3198	100.0	3198
DK	TOP HD MRD @135	78	41.0	3198	100.0	3198
DM	TOP HD MRD @195	78	41.0	3198	100.0	3198
DN	TOP HD MRD @255	78	41.0	3198	100.0	3198
DP	TOP HD MRD @315	78	41.0	3198	100.0	3198
DR	BOT HD DOL / 90	219	77.3	16944	16.7	2830

 Total Weld Length  
 9,541 inches

 Total Weld Volume  
 605,241 cubic inches


 Total Weld Volume Scanned  
 508,574 cubic inches

Percent of Total Volume Examined = 84.0

Figure 5.1.21

5-7

FILE CODE#1

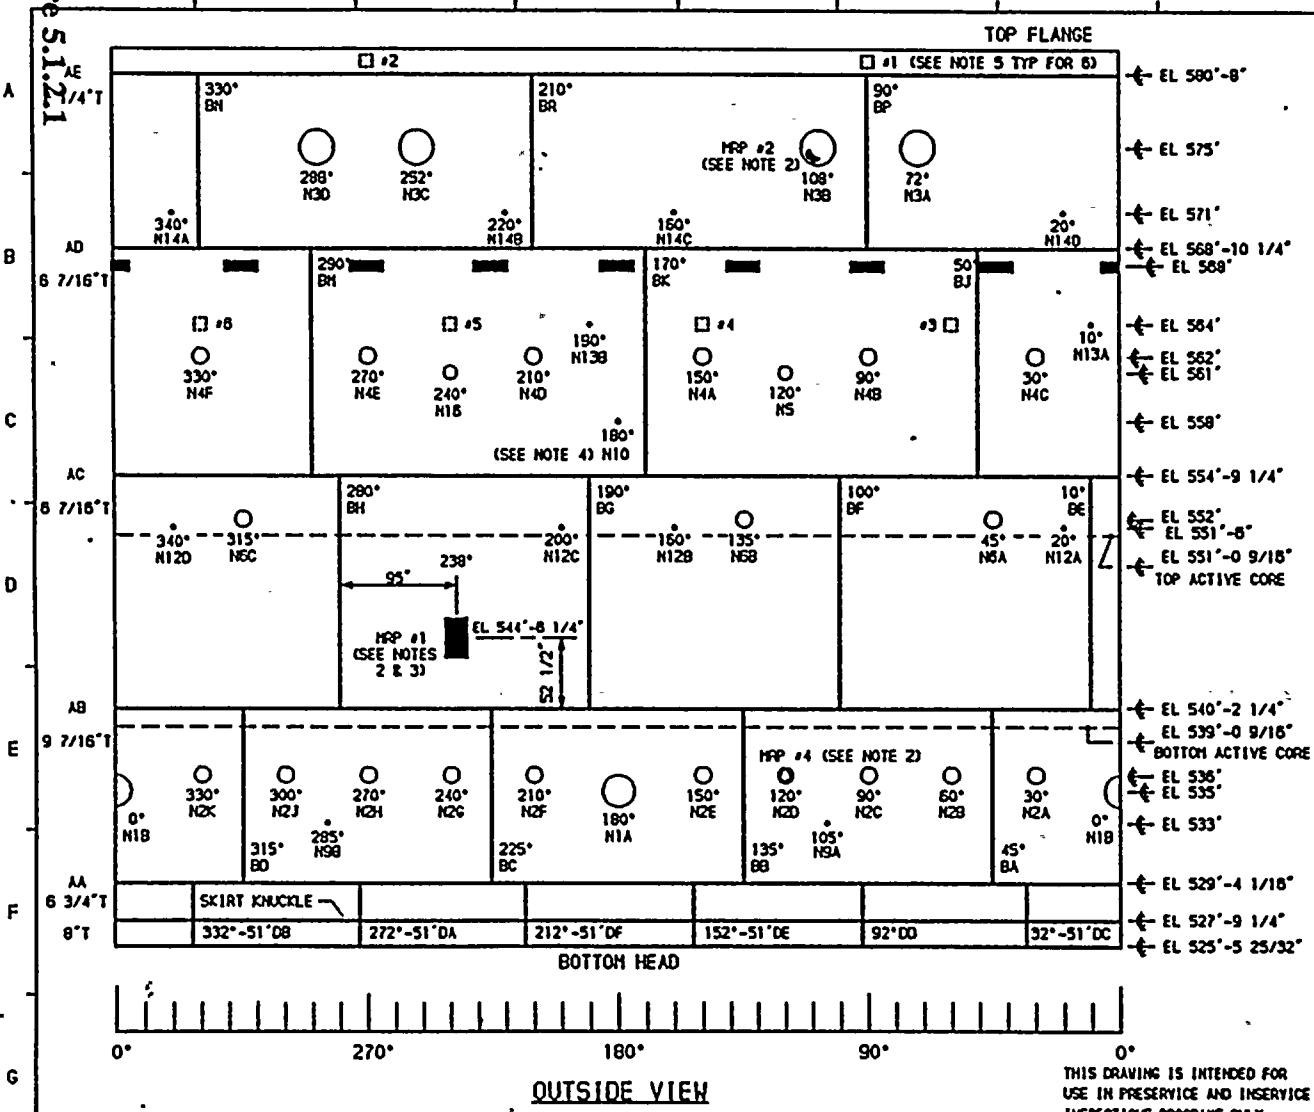

**NOTES:**

- REFER TO PROGRAM PLAN & SCHEDULE TABLES FOR EXAMINATION & CALIBRATION BLOCK REQUIREMENTS.
- "MFP" INDICATES MAJOR REPAIR AREA. MFP #3 AT N2E NOZZLE TO SAFE-END WELD PREP IS NOT SHOWN.
- MFP #1 IS 2 3/4" TO 3 7/8" IN DEPTH & IS 15" WIDE BY 30" HIGH. NOTE THAT MFP #1 AREA CENTER IS DIMENSIONALLY REFERENCED.
- FOR DETAILS OF NOZZLE ASSEMBLY SEE RPV-113.
- CLADDING PATCH LOCATIONS:  
#1 AT 90° AZ  
#2 AT 270° AZ  
    (CARE 21" BELOW FLANGE LIP)  
#3 AT 60° AZ  
#4 AT 150° AZ  
#5 AT 240° AZ  
#8 AT 330° AZ  
    (CARE 24" ABOVE THE N4 NOZZLES)
- STABILIZER LUGS LOCATED 7" BELOW N5 NOZZLES.  
#A AT 0° AZ           #E AT 180° AZ  
#B AT 45° AZ         #F AT 225° AZ  
#C AT 90° AZ        #G AT 270° AZ  
#D AT 135° AZ       #H AT 315° AZ

**REFERENCES:**

BURNS & ROE DRAWING  
H008 REV 2

QUALITY CLASS. 1      ASME CODE CLASS. 1  
ENGR. K HANNAH      DRWING. K-MCA      DATE. 2-23-79

WASHINGTON PUBLIC POWER  
SUPPLY SYSTEM  
RIDLAND, WASHINGTON 99352

MFP-2  
WELD & COMPONENT  
IDENTIFICATION DIAGRAM


TITLE:  
REACTOR PRESSURE VESSEL ROLL-OUT

DWG NO. RPV-101      REV 5

NO	DATE	REVISION	BY	CHKD	APVD	NON DTA (IND)	SCH	NOMINAL WALL THICKNESS	MATERIAL SPECIFICATION	MATL TYPE	CAL BLOCK NO
5	8-8-84	ADDED STABILIZER LUGS. SEE NOTE 6.	K-MCA	DPR	DW						
4	12-8-82	CORRECTED N14E LOCATION GRAPHICALLY ADDED N21N14A, N20M129 LOC. IN DRAWING	K-MCA	DPR	DRM						
3	12-2-81	EL 531'-6" WAS 531' LOWERED ACTIVE CORE TO COINCIDE.	K-MCA	DPR	TFN						
2	11-5-80	ADDED ELEVATIONS - ACTIVE CORE	K-MCA	TFN	DMP						
1	7-17-79	REVISED NOZZLE LETTERS PER AS BUILT. ADDED NOTES 4 & 5.	K-MCA	TFN	DMP						
0	12-22-78	ISSUED FOR USE	K-MCA	TFN	DMP						
A	5-17-78	ISSUED FOR INFORMATION ONLY	K-MCA	DMP	DMP						


THIS DRAWING IS INTENDED FOR USE IN PRESERVICE AND INSERVICE INSPECTIONS PROGRAMS ONLY.

Figure 5.1.2.2

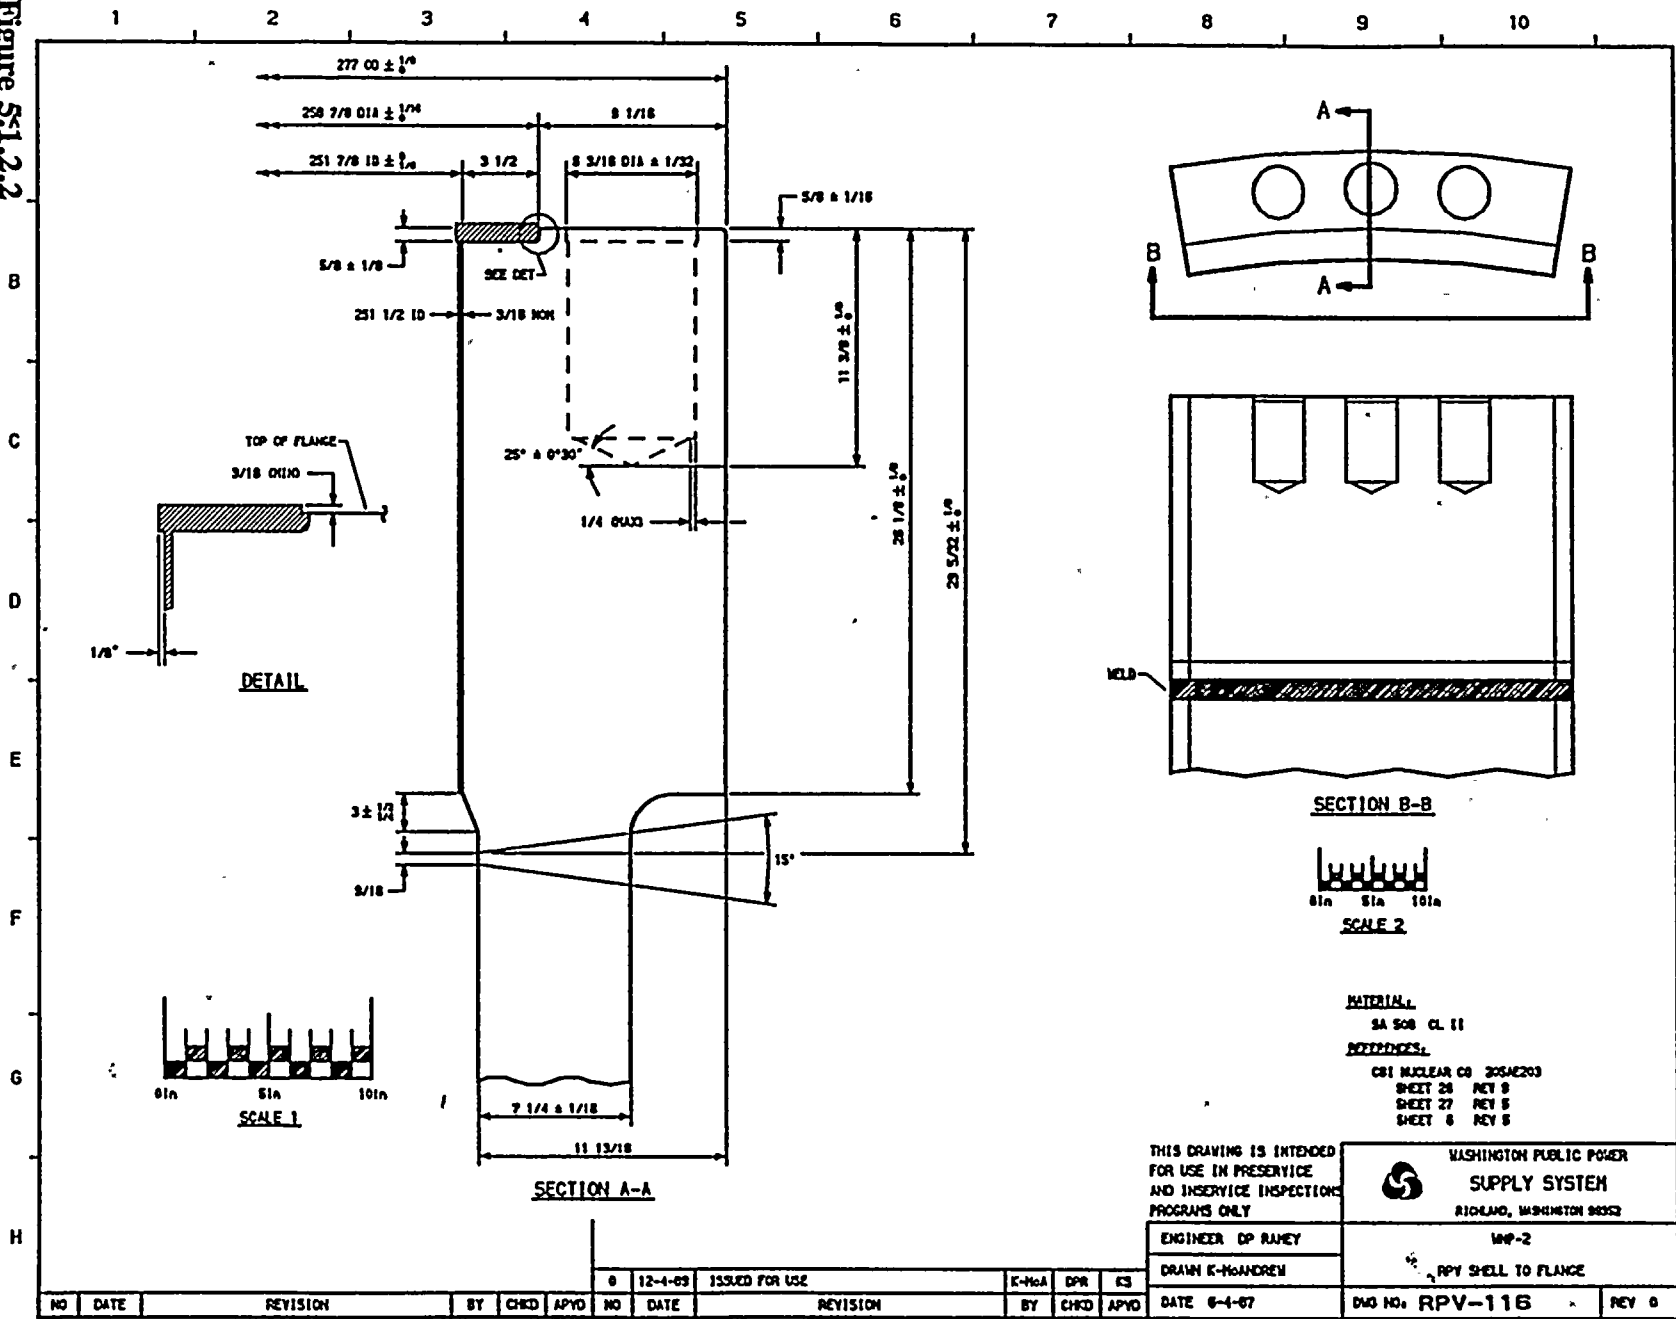

ISI PROGRAM PLAN  
INTERVAL - 2  
REVISION 0  
DECEMBER, 1994

Figure 5.1.2.3

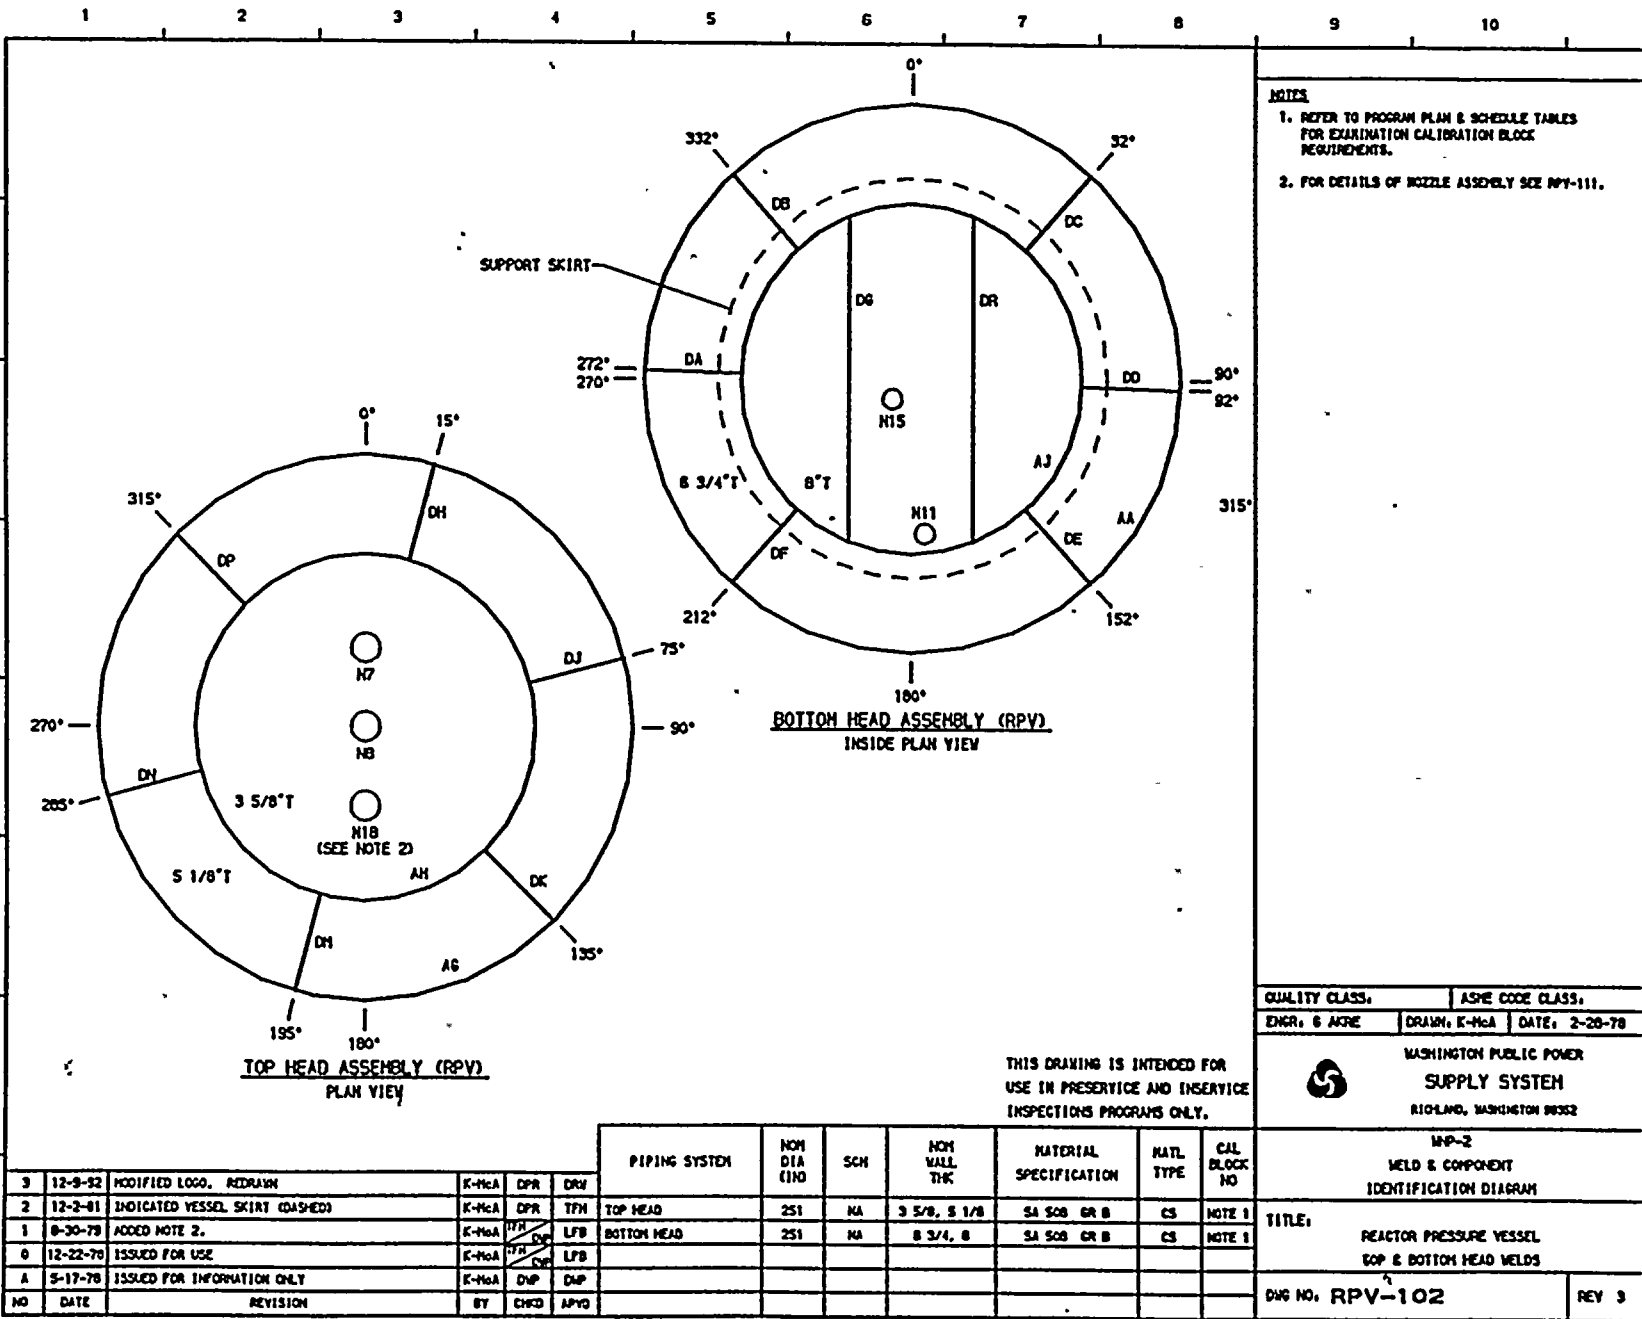

5-9

FILE: CODDE1

## RELIEF REQUEST NO. 2ISI-02

**Welds for Which Relief is Requested**

ASME Section XI Examination Category B-D, item B3.90, pressure retaining welds in reactor pressure vessel. See table below.

<u>Weld No.</u>	<u>Description</u>	<u>Diagram No.</u> (see Figure 5.1.2.4)
N1-0	RRC NZ-V @ 0	RPV-101
N1-180	RRC NZ-V @ 180	RPV-101
N2-120	RRC NZ-V @ 120	RPV-101
N2-150	RRC NZ-V @ 150	RPV-101
N2-210	RRC NZ-V @ 210	RPV-101
N2-240	RRC NZ-V @ 240	RPV-101
N2-270	RRC NZ-V @ 270	RPV-101
N2-30	RRC NZ-V @ 30	RPV-101
N2-300	RRC NZ-V @ 300	RPV-101
N2-330	RRC NZ-V @ 330	RPV-101
N2-60	RRC NZ-V @ 60	RPV-101
N2-90	RRC NZ-V @ 90	RPV-101
N3-108	MS NZ-V @ 108	RPV-101
N3-252	MS NZ-V @ 252	RPV-101
N3-288	MS NZ-V @ 288	RPV-101
N3-72	MS NZ-V @ 72	RPV-101
N4-150	FW NZ-V @ 150	RPV-101
N4-210	FW NZ-V @ 210	RPV-101
N4-270	FW NZ-V @ 270	RPV-101
N4-30	FW NZ-V @ 30	RPV-101
N4-330	FW NZ-V @ 330	RPV-101
N4-90	FW NZ-V @ 90	RPV-101
N5-120	LPCS NZ-V @ 120	RPV-101
N6-135	LPCI NZ-V @ 135	RPV-101
N6-315	LPCI NZ-V @ 315	RPV-101
N6-45	LPCI NZ-V @ 45	RPV-101
N16-240	HPCS NZ-V @ 240	RPV-101

**Section XI Requirements**

ASME Section XI, Table IWB-2500-1, Examination Category B-D, item B3.90 requires a volumetric examination of the weld and adjacent base metal as defined in Figure IWB-2500-7(b).

**Code Requirement from Which Relief is Requested**

Relief is requested from performing a volumetric examination of 100% of the examination volume defined in Figure IWB-2500-7(b).

### **Basis for Requesting Relief**

Relief is requested from ASME Section XI examination requirements on the basis of partial inaccessibility of the weld due to configuration. The design of the vessel to nozzle weld prevents examination of 100% of the volume defined in Figure IWB-2500-7(b) with equipment available.

### **Alternative Examinations**

Each weld will be examined per Section XI requirements to the extent defined in Table 5.1.2.3.

### **Justification for the Granting of Relief**

There will be no adverse impact on plant quality and safety by doing only a partial Code examination of these welds.

1. The Class 1 RPV welds have passed radiographic, magnetic particle and ultrasonic examinations in accordance with Section III.
2. No unacceptable indications were found during the first inspection interval examinations.
3. The identified welds will be subject to a system pressure test in accordance with ASME Section XI Code Case N-498 requirements.
4. Leak detection systems identify significant leakage in the areas of the subject welds. Appropriate operator action would occur due to leak detection system alarms.
5. No automatic inspection system in use today can effectively examine 100% of the required Code volume. Additional manual examinations will not significantly increase, if at all, the volume examined.
6. The achievable coverage will detect flaws in the inner volume where they are most likely to occur.
7. The percent of achievable examination volume is significant and representative of the item B3.90 welds. RPV nozzle weld integrity will be ensured by completing the percent of the welds defined in Table 5.1.2.3.

### **Implementation Schedule**

Seven (7) of the examinations will be performed during the first inspection period and the remaining ones will be performed during the third inspection period.

Table 5.1.2.3 Examination Coverage Obtained First Inspection Interval


Identification No.	Description	Diagram No.	% Volume Examined 45 Degree	% Volume Examined 60 Degree
N1-0	RRC NZ-V @ 0	RPV-101	75	81
N1-180	RRC NZ-V @ 180	RPV-101	75	81
N2-120	RRC NZ-V @ 120	RPV-101	75	81
N2-150	RRC NZ-V @ 150	RPV-101	75	81
N2-210	RRC NZ-V @ 210	RPV-101	75	81
N2-240	RRC NZ-V @ 240	RPV-101	75	81
N2-270	RRC NZ-V @ 270	RPV-101	75	81
N2-30	RRC NZ-V @ 30	RPV-101	75	81
N2-300	RRC NZ-V @ 300	RPV-101	75	81
N2-330	RRC NZ-V @ 330	RPV-101	75	81
N2-60	RRC NZ-V @ 60	RPV-101	75	81
N2-90	RRC NZ-V @ 90	RPV-101	75	81
N3-108	MS NZ-V @ 108	RPV-101	86	90
N3-252	MS NZ-V @ 252	RPV-101	86	90
N3-288	MS NZ-V @ 288	RPV-101	86	90
N3-72	MS NZ-V @ 72	RPV-101	86	90
N4-150	FW NZ-V @ 150	RPV-101	71	79
N4-210	FW NZ-V @ 210	RPV-101	71	79
N4-270	FW NZ-V @ 270	RPV-101	71	79
N4-30	FW NZ-V @ 30	RPV-101	71	79
N4-330	FW NZ-V @ 330	RPV-101	71	79
N4-90	FW NZ-V @ 90	RPV-101	71	79
N5-120	LPCS NZ-V @ 120	RPV-101	86	90
N6-135	LPCI NZ-V @ 135	RPV-101	72	79
N6-315	LPCI NZ-V @ 315	RPV-101	72	79
N6-45	LPCI NZ-V @ 45	RPV-101	72	79
N16-240	HPCS NZ-V @ 240	RPV-101	72	80



Figure 5.1.2.4

S-13

FILE CODE 1

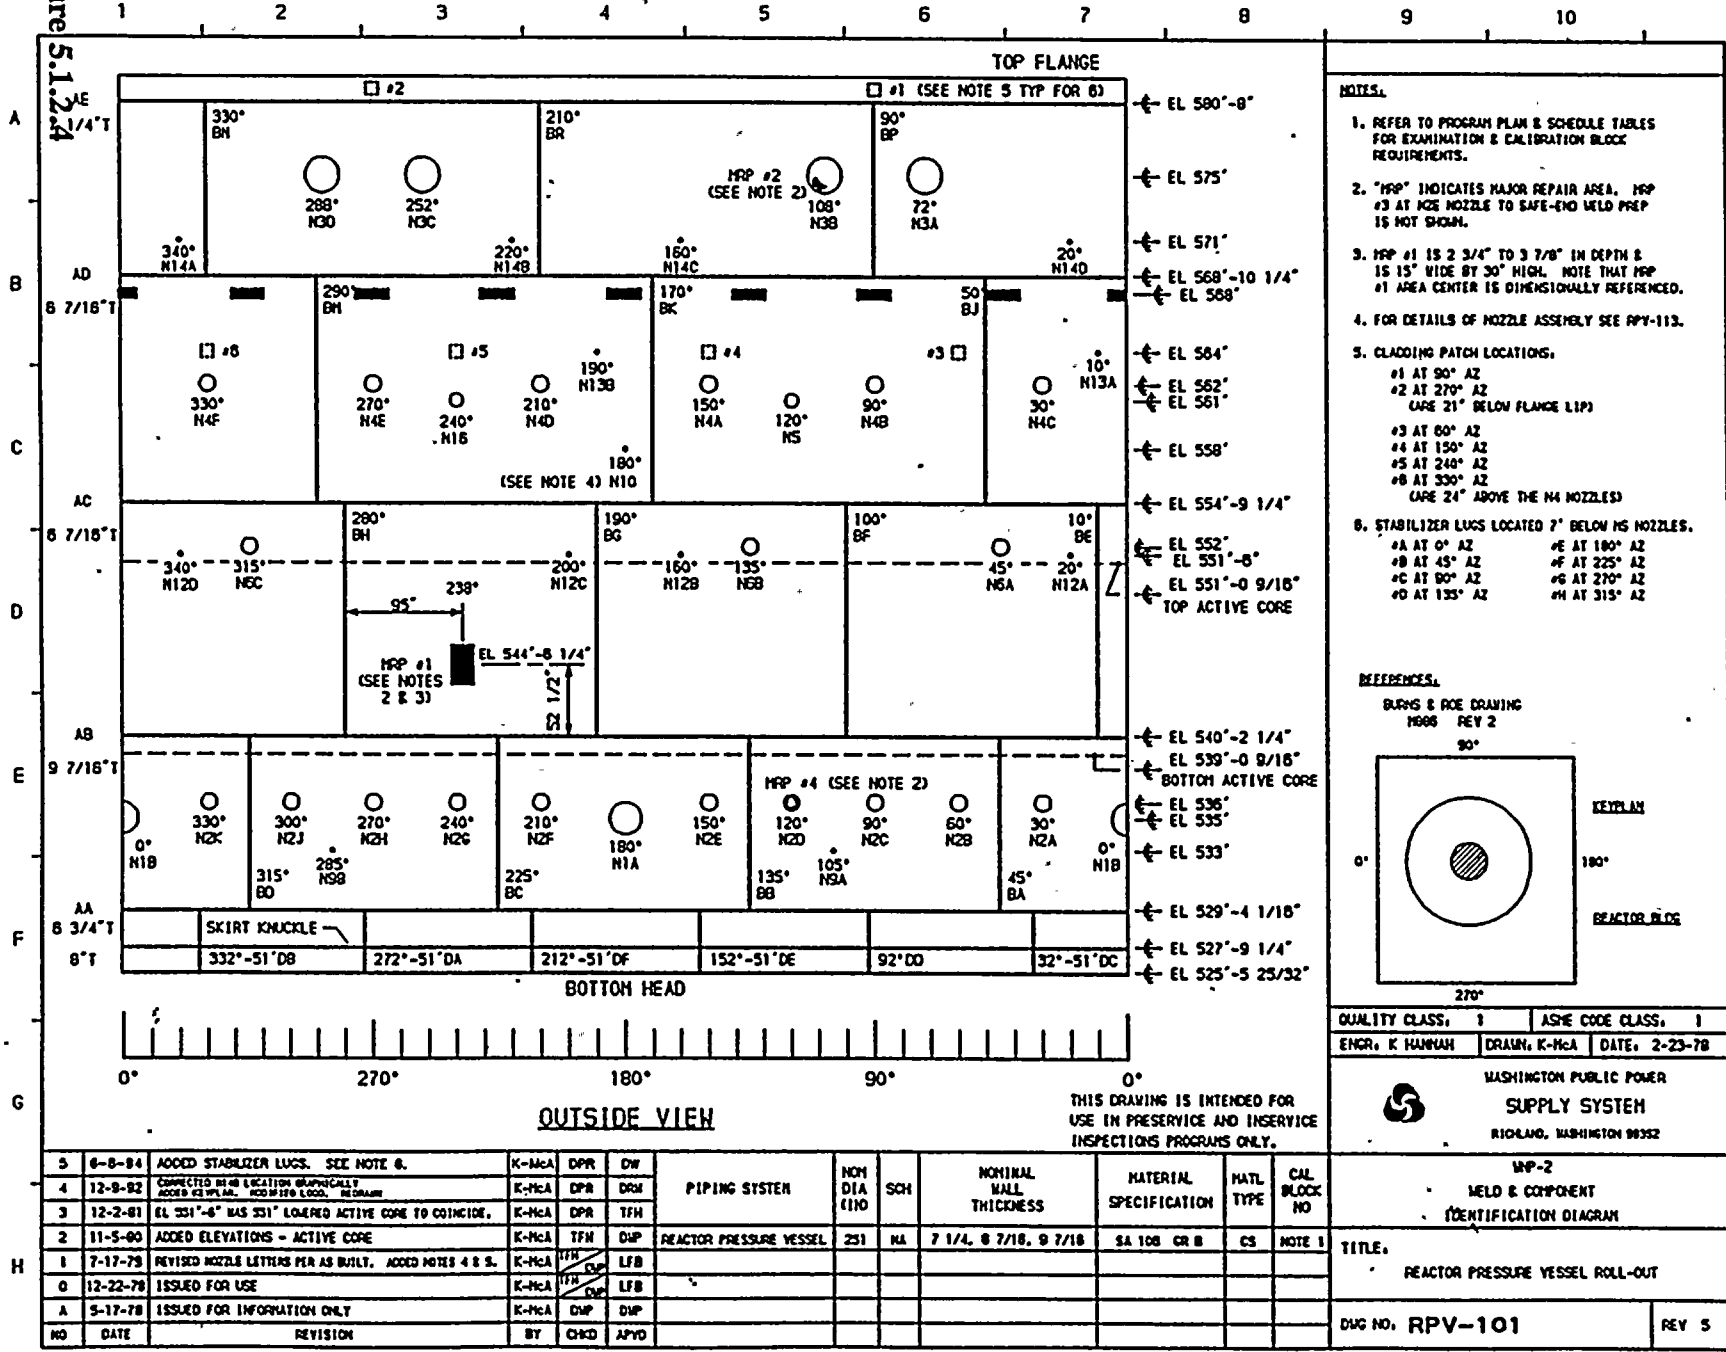

## RELIEF REQUEST NO. 2ISI-03

**Components for Which Relief is Requested**

ASME Section XI Examination Category B-G-1, Item Number B6.10, reactor pressure vessel nuts.

<u>Component No.</u>	<u>Description</u>	<u>Diagram No.</u> (see section 9.0)
RPV NUT 36-1-n where n is 1A through 76A	RPV NUT	RPV-101

**Section XI Requirements**

ASME Section XI, Table IWB-2500-1, Examination Category B-G-1, item B6.10 requires a surface examination of the nut.

**Code Requirement from Which Relief is Requested**

Relief is requested from ASME Section XI, Table IWB-2500-1, Examination Category B-G-1, item B6.10 requirement to perform a 100% surface examination of the nut.

**Basis for Requesting Relief**

A meaningful surface examination of the thread area cannot be achieved with the protective phosphate coating.

**Alternative Examinations**

A volumetric (ultrasonic) examination of the nut will be performed to augment the surface examination. The ultrasonic examination will consist of a L-wave from the end and shear wave in four directions (two parallel to axis and two perpendicular to axis). A spare RPV nut will be used for the calibration standard.

**Justification for the Granting of Relief**

This alternative examination of the RPV nuts provides for a more thorough examination. This examination technique was used during the first inspection interval. During the first inspection interval no unacceptable indications were found.

**RELIEF REQUEST NO. 2ISI-04****Components for Which Relief is Requested**

ASME Section III Code Class 3 service water (SW) buried piping.

The buried portions of the following systems are affected by this relief request:

SW Loop A Supply 20" SW (1)-2  
SW Loop B Supply 20" SW (2)-2

**Section XI Requirements**

ASME Section XI (IWA-5244) requires a test to determine the change in flow between ends of nonisolatable, redundant buried piping.

**Code Requirement from Which Relief is Requested**

Relief is requested from ASME Section XI IWA-5244 to perform a test to determine the change in flow between the ends of buried piping.

**Basis for Requesting Relief**

The design of the piping in the service water pump houses prevents direct flow monitoring. Figures 5.1.2.5 and 5.1.2.6 show the dimensions between the pump, valves and elbow. The close proximity of these items does not allow sufficient stable flow required for meaningful flow measurement. The direct measurement of flow at this end of the buried piping is impossible.

**Alternate Examination**

In place of the Code required flow test, WNP-2 will verify that the flow during operation is adequate to perform the systems required function. This will be accomplished by verifying the flow and pump discharge pressure is within the acceptable range per the last pump and valve surveillance. In addition, each inspection period the area between the pump house and reactor building where the buried piping runs will be observed for anomalies or disturbances which may indicate a leak.

**Justification for the Granting of Relief**

There will be no decrease in plant quality and safety by performing the alternate examinations. Per the Pump Inservice Test Program, the pumps in both SW Loops A and B are tested quarterly to verify that they are operating correctly and providing adequate flow. Per Section XI IWA-5244 verification of adequate flow is an acceptable test to perform as the VT-2 visual examination for buried piping. In addition to being recognized by the Code, the alternate examination would be performed more frequently,

quarterly versus once per inspection period. Based on more frequent testing, Code acceptability and system function, the performance of the alternate examination will not decrease plant quality or safety.

**Implementation Schedule**

This relief request will be implemented at the end of the first inspection period of the second inspection interval.



**ISI PROGRAM PLAN**  
**INTERVAL - 2**  
**REVISION 0**  
**DECEMBER, 1994**

Figure 5.1.2.5

S-17

FILE: CODDEI


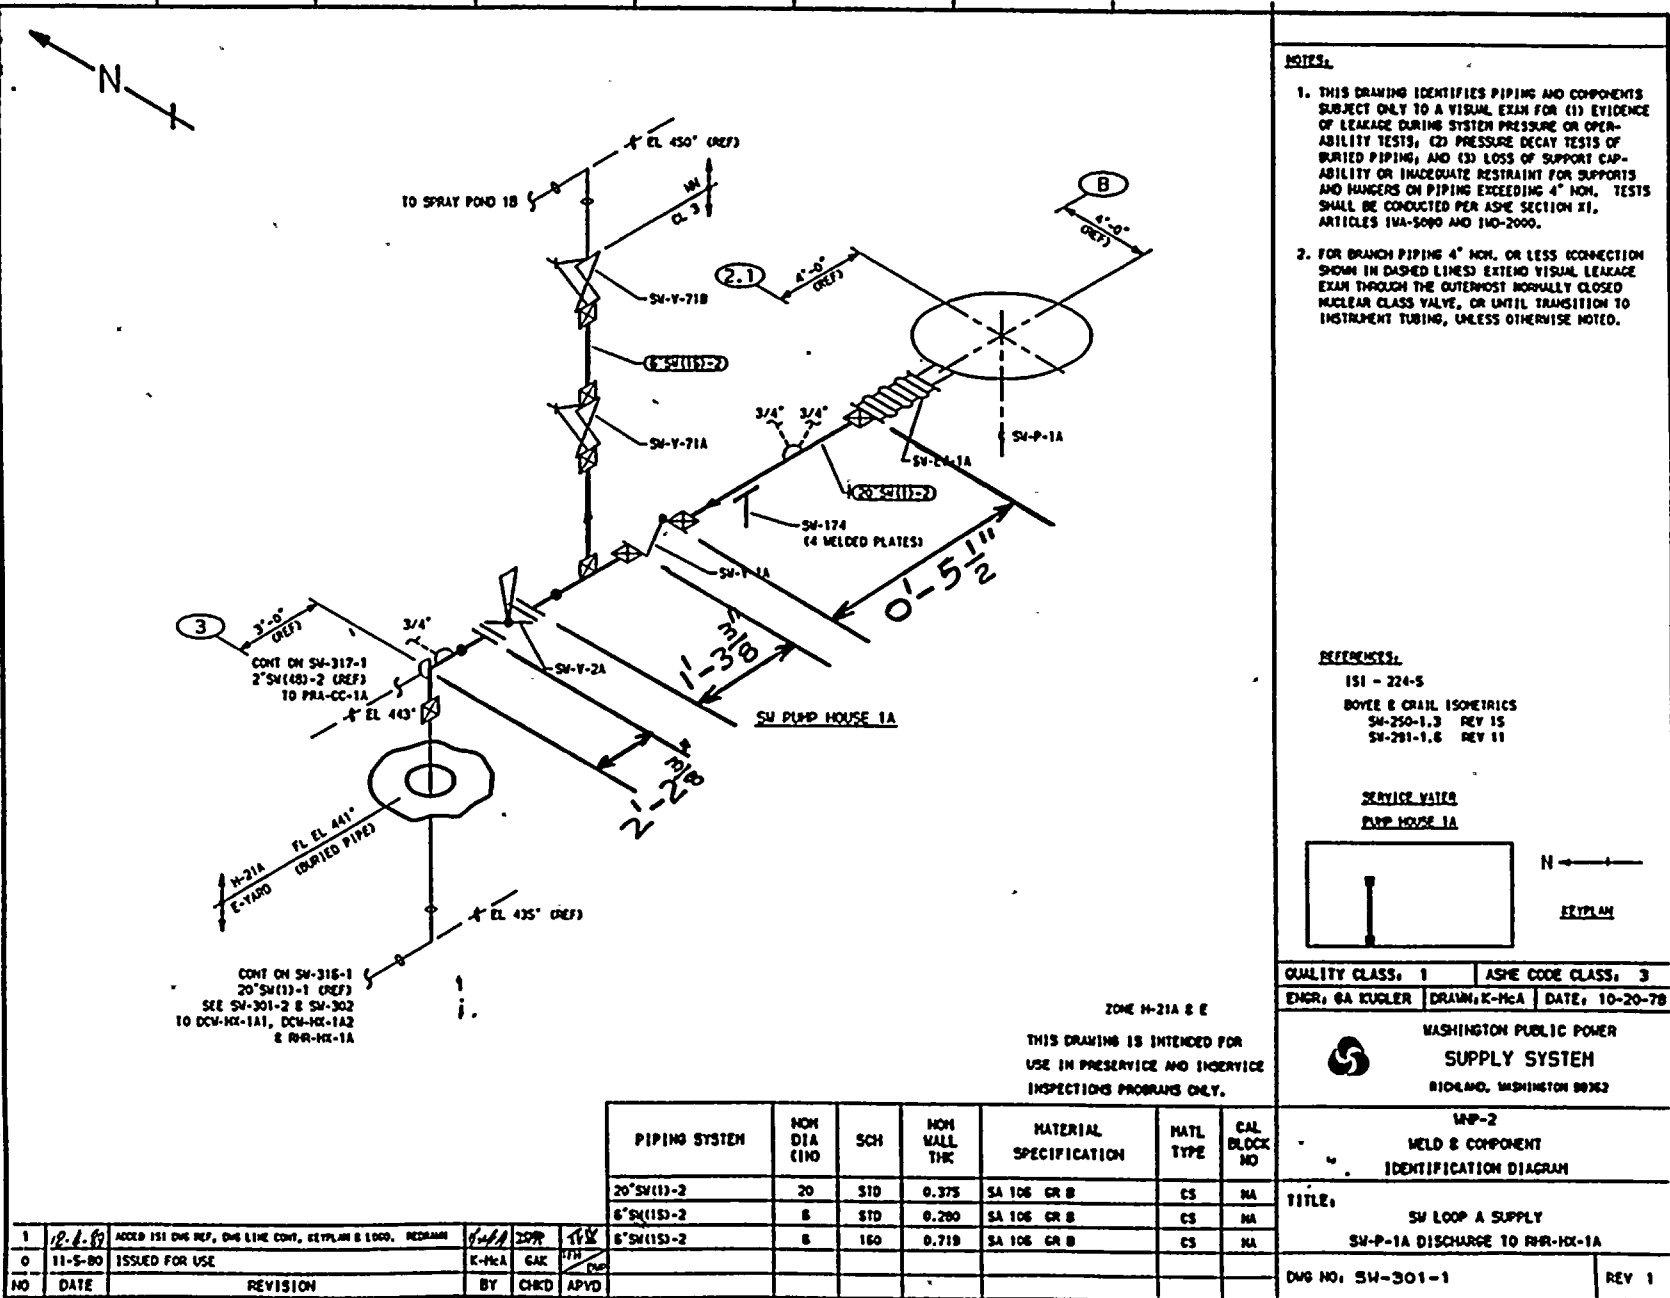


Figure 5.1.2.6

5-18

File: CODE1

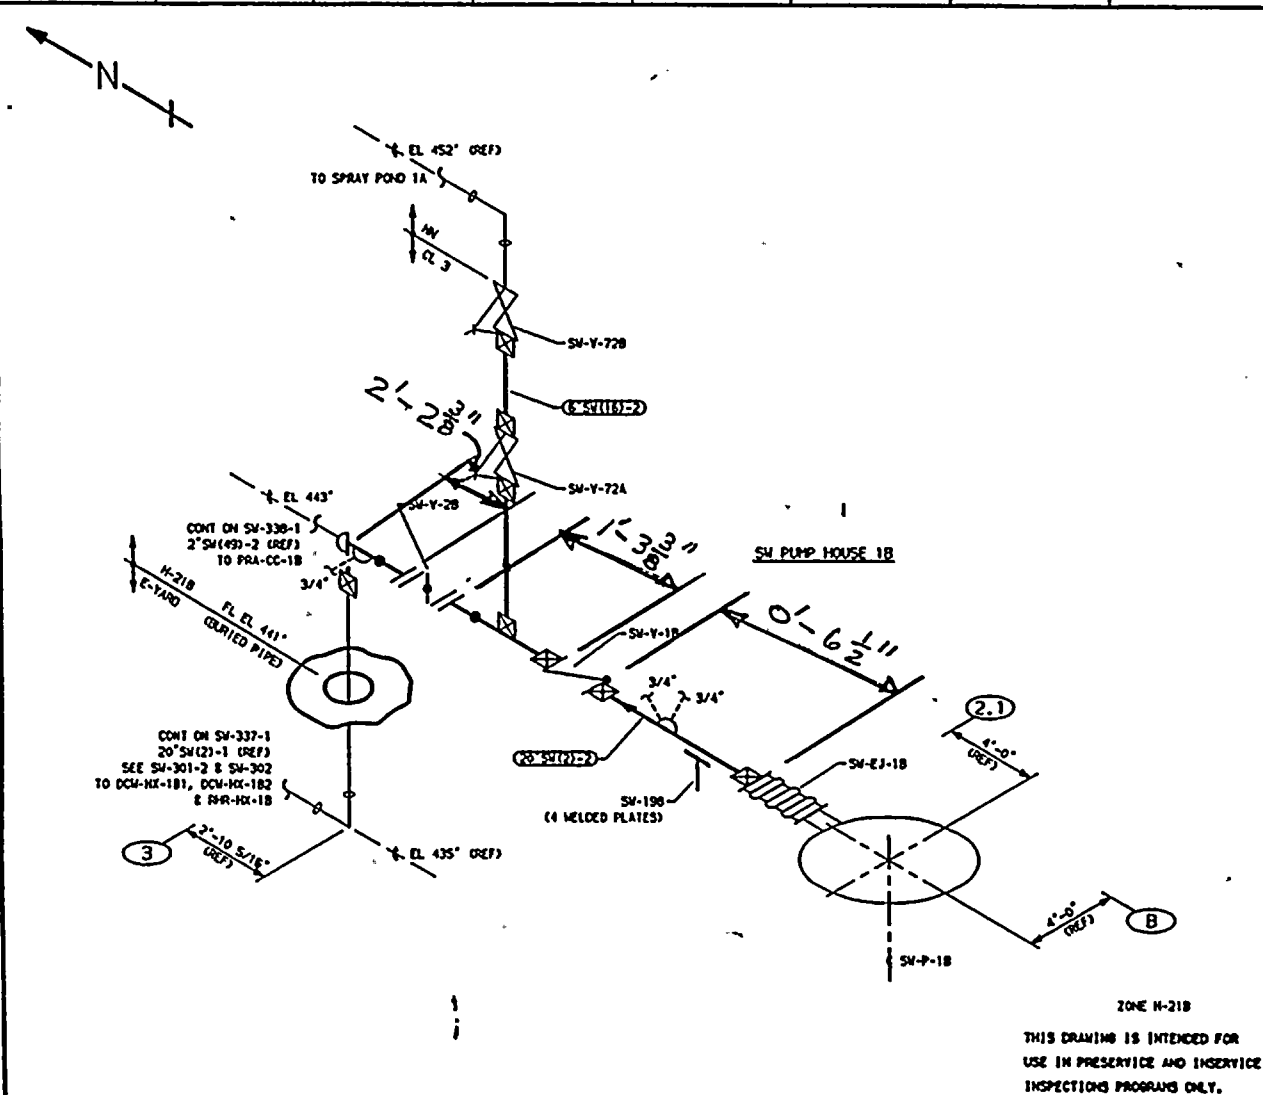


**NOTES:**

1. THIS DRAWING IDENTIFIES PIPING AND COMPONENTS SUBJECT ONLY TO A VISUAL EXAM FOR (1) EVIDENCE OF LEAKAGE DURING SYSTEM PRESSURE OR OPERABILITY TESTS; (2) PRESSURE DECAY TESTS OF BURIED PIPING; AND (3) LOSS OF SUPPORT CAPABILITY OR INADEQUATE RESTRAINT FOR SUPPORTS AND HANGERS ON PIPING EXCEEDING 4" NOM. TESTS SHALL BE CONDUCTED PER ASME SECTION XI, ARTICLES 1WA-5000 AND 1WD-2000.
2. FOR BRANCH PIPING 4" NOM. OR LESS (CONNECTION SHOWN IN DASHED LINES) EXTEND VISUAL LEAKAGE EXAM THROUGH THE OUTERMOST NORMALLY CLOSED NUCLEAR CLASS VALVE, OR UNTIL TRANSITION TO INSTRUMENT TUBING, UNLESS OTHERWISE NOTED.

**REFERENCES:**

- ISI - 224-S & 224-AA
- BOYCE & CRILL ISOMETRICS
- SW-251-1.3 REV 12
- SW-292-1.5 REV 9

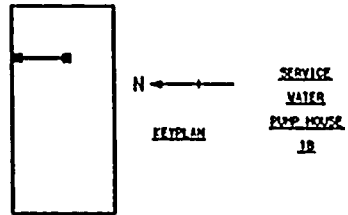

QUALITY CLASS: 1	ASME CODE CLASS: 3
ENGR: GA KUGLER	DRAWN: K-McA DATE: 2-5-78

WASHINGTON PUBLIC POWER  
SUPPLY SYSTEM  
RICHLAND, WASHINGTON 99352

WMP-2  
WELD & COMPONENT  
IDENTIFICATION DIAGRAM

TITLE: SW LOOP B SUPPLY  
SW-P-1B DISCHARGE

DWG NO: SW-305-1 REV 2

THIS DRAWING IS INTENDED FOR  
USE IN PRESERVICE AND INSERVICE  
INSPECTIONS PROGRAMS ONLY.

PIPING SYSTEM	NOM DIA (IN)	SCH	NOM WALL THK	MATERIAL SPECIFICATION	MATL TYPE	CAL BLOCK NO
20" SW(2)-2	20	STD	0.375	SA 106 GR B	CS	NA
6" SW(1B)-2	6	STD	0.200	SA 106 GR B	CS	NA
6" SW(1B)-2	6	160	0.719	SA 106 GR B	CS	NA

NO	DATE	REVISION	BY	CHKD	APVD
2	12-1-89	ADDED 2ND DWS REF, DWS LINE CONT, KEYPLAN & LOGS, REDRAWN	K-McA	DPR	TJH
1	1-27-84	RELOCATED SW-198 ADDED KEYPLAN	K-McA	DPR	TJH
0	11-5-80	ISSUED FOR USE	K-McA	CJK	TJH

## RELIEF REQUEST 2ISI-05

## Components for Which Relief is Requested

ASME Class 3, Section XI Examination Category D-A item number D1.10, pressure retaining boundary, main steam relief valve discharge piping (piping located in drywell). ASME Class 2 main steam relief valve discharge piping upgraded from ASME Class 3 (piping located in wetwell).

This relief request includes the 18 main steam relief valves and associated discharge lines identified by the following line numbers and illustrated on the corresponding ISI weld and component identification diagrams ( diagrams located in section 9.0).

<u>Line number</u>	<u>ISI Diagram Number</u>	<u>Material Specification</u>
10MS(18)-2-1	MS-301-1, -2, -3	10" Sch 80, SA-106 Gr. B
10MS(18)-2-2	MS-302-1, -2, -3	10" Sch 80, SA-106 Gr. B
10MS(18)-2-3	MS-303-1, -2, -3	10" Sch 80, SA-106 Gr. B
10MS(18)-2-4	MS-304-1, -2, -3	10" Sch 80, SA-106 Gr. B
10MS(18)-2-10	MS-305-1, -2, -3	10" Sch 80, SA-106 Gr. B
10MS(18)-2-11	MS-306-1, -2, -3	10" Sch 80, SA-106 Gr. B
10MS(18)-2-12	MS-307-1, -2, -3	10" Sch 80, SA-106 Gr. B
10MS(18)-2-13	MS-308-1, -2, -3	10" Sch 80, SA-106 Gr. B
10MS(18)-2-14	MS-309-1, -2, -3	10" Sch 80, SA-106 Gr. B
10MS(18)-2-9	MS-310-1, -2, -3	10" Sch 80, SA-106 Gr. B
10MS(18)-2-8	MS-311-1, -2, -3	10" Sch 80, SA-106 Gr. B
10MS(18)-2-7	MS-312-1, -2, -3	10" Sch 80, SA-106 Gr. B
10MS(18)-2-6	MS-313-1, -2, -3	10" Sch 80, SA-106 Gr. B
10MS(18)-2-5	MS-314-1, -2, -3	10" Sch 80, SA-106 Gr. B
10MS(18)-2-18	MS-315-1, -2, -3	10" Sch 80, SA-106 Gr. B
10MS(18)-2-17	MS-316-1, -2, -3	10" Sch 80, SA-106 Gr. B
10MS(18)-2-16	MS-317-1, -2, -3	10" Sch 80, SA-106 Gr. B
10MS(18)-2-15	MS-318-1, -2, -3	10" Sch 80, SA-106 Gr. B

	<u>Pressure</u>	<u>Temperature</u>
design	500 psig	470 degree F
operating	388-465 psig	445-463 degree F

The range of operating pressures and temperatures is due to the location and settings of the relief valves that discharge into these piping systems.

## Section XI Requirements

Table IWD-2500-1 requires pressure testing and VT-2 examination of item D1.10 per IWD-5221 and IWD-5223.



IWA-5214 requires pressure testing and VT-2 examination of repairs and replacements.

IWD-5223, System Hydrostatic Test, paragraph (f) requires a pneumatic test (at a pressure of 90% of the pipe submergence head of water) that demonstrates leakage integrity be performed in lieu of the system hydrostatic test. The test pressure is 6.6 psig.

It is also the intent of the Code that the pneumatic test described in IWD-5223(f) be performed for the system leakage test required by Table IWD-2500-1 ( see interpretation XI-1-92-04, Section XI, Interpretations Volume 30, page 243).

### **Code Requirements from Which Relief is Requested**

Relief is requested from performing the pneumatic pressure test of IWD-5223(f) on the systems designated in section titled "Components for Which Relief is Requested" for Examination Category D-A, item D1.10 and for performing IWA-5214 pressure test on the Class 3 discharge side of the relief valves after repairs and replacement of the main steam relief valves and vacuum breaker valves on these systems.

### **Basis for Requesting Relief**

The pressure test at less than two (2) percent of the operating pressure of the system does not add to the public safety. The test adds unnecessarily to the plants radiological exposure burden (approximately 1.6 person rems per outage). This test has been eliminated in the 1992 Edition, 1992 Addenda to Section XI (see page 207 1992 Addenda to ASME Section XI).

### **Alternative Examinations**

No alternative to this test is proposed since this test has been eliminated from the later Section XI Code.

### **Justification for the Granting of Relief**

The test pressure required by the Code (6.6 psig) is significantly less than (less than 2%) the operating pressure of the discharge lines (388-465 psig). The test pressure does not assure integrity of the piping and adds unnecessarily to the plants radiological burden.

Additionally, the Code required test has been deleted in the 1992 Edition, 1992 Addenda of ASME Section XI.

Approximately 1.6 person rems are expended each time this test is performed.

### **Implementation Schedule**

This relief request will be implemented during the second inspection interval.

**RELIEF REQUEST 2ISI-06****Components for Which Relief is Requested**

Table IWB-2500-1, Examination Category B-P, items B15.10 and B15.11, control rod drive (CRD) flange bolting. WNP-2's reactor vessel has 185 CRD flanges located in the reactor pressure vessel (RPV) bottom head. Each flange has 8 cap screws.

**Section XI Requirements**

The CRD flanges are subject to a system leakage test at the end of every refueling outage (item B15.10) and a hydrostatic test every inspection interval (item B15.11). If leakage is observed at the bolted connection of these flanges, corrective action per [IWA-5250(a)(2)] requires all the bolting from that flange be removed and VT-3 visually examined for corrosion and evaluated per IWA-3100. The purpose of this requirement is to determine if bolting degradation has occurred.

**Code requirement from Which Relief is Requested**

Removal of bolting per IWA-5250(a)(2) to perform a visual examination.

**Basis for Requesting Relief**

Relief is requested from the corrective action of [IWA-5250(a)(2)] based on the hardship to remove the cap screws from these flanges at the end of a refueling outage. The pressure test is performed just prior to startup when the equipment required for cap screw removal has been removed from under the RPV. To remove all the bolting from a leaking drive will require depressurization of the RPV and reassembly of the equipment necessary to remove the bolting. The dose rates under the RPV in the area where bolting removal will occur are estimated to be between 200 mRem/hr at the knees and 600 mRem/hr at the head.

**Alternative**

Relief is requested to use the following alternative examination for satisfying the requirements of IWA-5250(a)(2). When control rod drives are exchanged, perform a VT-1 visual examination on the removed bolting. This VT-1 examination will be in accordance with Table IWB-2500-1 Examination Category B-G-2, Item Number B7.80.

**Justification for the Granting of Relief**

Approximately 30-40 CRD flanges are disassembled for CRD exchange every 2 years. During this activity all the CRD cap screws from the disassembled flanges are required to be VT-1 visually examined in accordance with Examination Category B-G-2, item number B7.80. The provisions of this examination are to determine if degradation of the bolting has occurred. All the CRD flanges are disassembled and the cap screws examined

within an approximate 10 year cycle.

During the first 10 year inservice inspection interval, 187 sets of CRD cap screws received a VT-1 visual examination after removal. All new cap screws receive a Preservice Inspection VT-1 examination prior to installation. Corrosion pitting has been observed on the cap screw's shank. Metallurgical evaluation of the worst case from two outages was performed. The analysis concluded that the pitting was shallow and the ASME acceptance standards were not exceeded. No cap screws that exhibited pitting corrosion were reused. No failed bolting was found during the first 10 year inspection interval. This demonstrates that the VT-1 examinations required by Examination Category B-G-2, item number B7.80 provide an effective method to detect the early signs of bolting degradation.

WNP-2 is a Boiling Water Reactor (BWR) that does not utilize a process system with a borated water chemistry, except the standby liquid control system, like a Pressurized Water Reactor (PWR). The corrosiveness of leaking borated water in a PWR is known but is not applicable to WNP-2. The alternatives described provide assurance that corrosive conditions are evaluated.

There will be no adverse impact on plant quality and safety by implementing the alternative measures. The alternative examination to perform VT-1 examination on removed bolting provides a superior method of detecting bolting degradation than that required by IWA-5250(a)(2). The sample size (every cap screw within an approximate 10 year period) and frequency (approximately 16-20% of the cap screws examined every two years) provides assurance that bolting degradation will be detected.

### **Implementation Schedule**

This relief request will be implemented during the second inspection interval.

**RELIEF REQUEST 2ISI-07****Components for Which Relief is Requested**

All bolted connections within the ASME Section XI pressure test boundary in non-borated systems except:

- 1) Control Rod Drives and;
- 2) Bolted connections that were assembled as part of a Section XI repair and replacement activity and have not been subject to inservice conditions.

**Section XI Requirements**

If during pressure tests a bolted connection within the test boundary leaks it is subject to the corrective action of IWA-5250(a)(2). This would require all the connection's bolting to be removed and visually examined to VT-3 requirements.

**Code Requirements from Which Relief is Requested**

Removal of bolting per IWA-5250(a)(2) to perform a VT-3 visual examination.

**Basis for Requesting Relief**

Removing all the bolting from a leaking joint and performing a VT-3 visual examination on the bolting places a hardship on the plant. Bolting degradation due to bolted connection leaks would not occur at bolting that was not exposed to the leaking fluid. The Code requirement, if met, will require all the bolting at a leaking joint to be removed even if it is not in contact with the leaking fluid. This will result in unnecessary work for, and radiation exposure to, plant personnel.

**Alternative Corrective Action**

Relief is requested to use the corrective measures described in the following paragraphs.

For bolted connections that are shown to have metal-to-metal contact ("hard joints"), torque the bolted connection up to the maximum torque allowed for this joint while this joint is under pressure. If the leak stops no further action will take place. If the leak does not stop, the leakage will be evaluated for further corrective action.

For bolted connections other than hard joints, remove one bolt closest to the leak, perform a VT-3 examination for corrosion, and evaluate in accordance with IWA-3100.

### Justification for the Granting of Relief

For bolted connections classified as hard joints, the retorquing of the bolting to no greater value than that allowed for that specific joint will provide a more positive test that the bolting is not degraded than removing the bolting and performing a visual examination on it. The retorquing will demonstrate that the bolting has not failed. In addition to being a demonstration of the bolting integrity, the retorquing should stop the leakage condition, which can cause degradation of the bolting.

Where removal of the bolting is the corrective action, the removal of only one bolt is supported by subparagraph IWA-5250(a)(2) of ASME Section XI, 1992 Edition, 1993 Addenda. By removing the bolt closest to the leak, the worst case condition will be examined. Bolting that is not in contact with the leaking fluid will not be unnecessarily removed. This will avoid unnecessary radiation exposure to plant personnel.

WNP-2 is a Boiling Water Reactor (BWR) that does not utilize a process system with a borated water chemistry, except the standby liquid control system, like a Pressurized Water Reactor (PWR). The corrosiveness of leaking borated water in a PWR is known but is not applicable to WNP-2. The alternatives described provide assurance that corrosive conditions are evaluated.

There will be no adverse impact on plant quality and safety by implementing the alternate corrective measures. The alternate corrective measures will demonstrate bolting integrity and provide reasonable assurance that bolting degradation caused by leakage at the bolted connection will be detected.

Specific radiation exposure savings from this alternative corrective action cannot be calculated since they are bolted connection dependant.

### Implementation Schedule

This alternate examination will be implemented during the entire second inspection interval.

## RELIEF REQUEST 2ISI-08

### Welds for Which Relief is Requested

ASME Section XI Examination Category B-K-1, Item Number B10.10, integral attachment welds for piping, pumps, and valves.

<u>Identification No.</u>	<u>Description</u>	<u>ISI Diagram No.</u> (see section 9.0)
RRC-HA-1(W)	4 WELDED LUGS	RRC-101-1
RRC-HB-1(W)	4 WELDED LUGS	RRC-102-1

### Section XI Requirements

ASME Section XI, Table IWB-2500-1, Examination Category B-K-1, item B10.10 requires a surface or volumetric examination of the weld and adjacent base metal.

### Code Requirement from Which Relief is Requested

Relief is requested from performing a surface examination of 100% of the examination surface.

### Basis for Requesting Relief

Relief is requested from ASME Section XI examination requirements for the two item B10.10 welds on the basis of high dose required to prepare for and perform the examinations. The welds identified in this relief request require disassembly of a component support collar to gain access to perform a 100% Code examination. Radiation dose rates in the area of these welds are 400mR/hr. To access the remaining portion of these welds will require the disassembly of the collars preventing full Code coverage. The component supports associated with these welds are twin variable springs supporting a 24 inch diameter pipe. The support has a vertical load of approximately 24,000 pounds. To access the welds the piping being supported by these springs will need to be temporarily supported so the collars can be disassembled. After the examination the collars will be reassembled, temporary supports removed, and the variable springs rebalanced. It is anticipated that total exposure to examine the remaining portions of attachment welds RRC-HA-1(W) and RRC-HB-1(W) will exceed 4 person rem.

### Alternative Examinations

The accessible portion of the item B10.10 attachment welds RRC-HA-1(W) and RRC-HB-1(W), without removing the component support, will be examined per Section XI requirements.

**Justification for the Granting of Relief**

There will be no adverse impact on plant quality and safety by doing only a partial Code examination of the item B10.10 welds.

1. During the first inspection interval, weld RRC-HA-1(W) received a dye penetrant examination of 75% of the required examination surface and weld RRC-HB-1(W) received a dye penetrant examination of 50% of the required surface. No unacceptable indications were found.
2. The percent of Examination Category B-K-1 welds examined exceeds 95% of total welds in this category. No unacceptable indications were found in category B-K-1 welds during the first inspection interval.
3. Other Examination Category B-K-1 welds will receive full Code surface examination coverage. There is a total of forty-two (42) attachment welds in Examination Category B-K-1. The integrity of the Class 1 attachment welds is verified by performing examinations on this large representative sample.

## RELIEF REQUEST 2ISI-09

**Welds for Which Relief is Requested**

ASME Section XI Examination Category C-C, Item Number C3.20, integral attachment welds for piping, pumps, and valves.

<u>Identification No.</u>	<u>Description</u>	<u>ISI Diagram No.</u>
RHR-77(W)	Welded Attachment	RHR-205-1
RHR-410(W)	Welded Attachment	RHR-203-2

**Section XI Requirements**

Section XI requires examination of 100% of each category C-C weld. All integral attachment welds require examination.

**Code Requirement from Which Relief is Requested**

Relief is requested from performing a surface examination of 100% of the Examination Category C-C items.

**Basis for Requesting Relief**

Relief is requested from ASME Section XI examination requirements for the two item C3.20 welds on the basis of inaccessibility of the welds due to their location in separate pipe chases where access will place a hardship on the plant to gain access. Access is gained by removing the steel and lead brick shielding walls.

**Alternative Examinations**

No alternate examination is proposed for these item C3.20 welds.

**Justification for the Granting of Relief**

There will be no adverse impact on plant quality and safety by not doing a Code examination of the two (2) item C3.20 welds.

1. The percent of category C-C welds examined exceeds 96% of total welds in this category. No unacceptable indications were found in category C-C during the first inspection interval.



2. Other similar welds in this system and in the area of the subject welds have or will receive full Code surface examination coverage. The total number of item C3.20 welds is fifty-five (55). Performing surface examination of 53 of the 55 welded attachments in Item C3.20 represents a significantly large and representative sample of this type of weld. The integrity of the attachment welds is verified by sampling.

### **Implementation Schedule**

This relief request will be implemented during the third inspection period of the second inspection interval.

## RELIEF REQUEST 2ISI-10

**Welds for Which Relief is Requested**

Welded Attachments ASME Examination Category D-B (item number D2.20).

Ident. No.	Diagram	Description	Category	Item No.
SW-90(W)	SW-307	Welded Attach	D-B	D2.20
SW-123(W)	SW-301	Welded Attach	D-B	D2.20
SW-439(W)	SW-303	Welded Attach	D-B	D2.20
SW-946N(W)	SW-314	Welded Attach	D-B	D2.20
SW-951N(W)	SW-315	Welded Attach	D-B	D2.20

**Section XI Requirements**

Section XI requires a visual examination (VT-3) of Examination Category D-B welded attachments.

**Code Requirement from Which Relief is Requested**

Relief is requested from performing a visual examination (VT-3) of the class 3 attachment welds listed above.

**Basis for Requesting Relief**

The welded attachments are completely or partially inaccessible to examination. The welded attachments are within fire barriers or enclosed in cubicles or pipe chases.

**Alternate Examinations**

The welded attachments are completely or partially inaccessible to all examination techniques. No alternate examinations are proposed.

### Justification for the Granting of Relief

There will be no adverse impact on plant quality and safety. During the first inspection period the following percent of items were examined:

<u>Examination Category</u>	<u>Percent Examined</u>	<u>Number Examined</u>
D-B	>96%	141

No unacceptable indications were found during these examinations.

The class 3 welded attachments in category D-B examined during the first inspection interval represent greater than 96% of the total welded attachments in this category.

The sample size in this category is reasonably large and representative and assures continued plant quality and safety.

### Implementation Schedule

This relief request will be implemented during the second inspection interval.

**RELIEF REQUEST 2ISI-11****Component**

All ASME Section III Code Class 1, 2, and 3 snubbers.

**Code Requirement Requesting Relief From**

ASME Section XI, 1989 Edition, no Addenda requires that snubbers be examined using the VT-3 method in accordance with ASME/ANSI OM Part 4, 1987 Edition [IWF-5300(a)].

**Number of Snubbers**

The snubbers are listed in Section 6.0, Table 6.2.1.

**Basis for Requesting Relief**

Snubber examinations are currently performed under WNP-2 Technical Specification 3/4.7.4 which was previously amended per Generic Letter 90-09, "Alternative Requirements for Snubber Visual Inspection Intervals and Corrective Actions". The stated purpose of the generic letter was to provide alternative guidance to snubber inspection schedules which were excessively restrictive. The alternative schedule was provided to alleviate the expenditure of unnecessary resources and prevent radiological exposure associated with the over restrictive examination schedule. The implementation of ASME/ANSI OM-1987 would return the snubber examination program to the state which existed prior to the publication of Generic Letter 90-09, effectively cancelling the benefits intended through the Generic Letter.

**Alternative Examinations**

As an alternative to the visual examinations required by IWF-5300(a) WNP-2 will perform the visual examinations per Technical Specification "3/4.7.4 Snubbers", governing snubber examination and testing.

**Impact on Plant Quality and Safety**

The current program as defined by the Technical Specification provides for a level of quality and safety equal to or greater than that of the proposed OM Code. The OM Code provides for failure mode grouping of snubbers which fail visual examination, meaning only those snubbers identified as being in that group would require shortened examination intervals. Under the existing Technical Specification program all snubbers in the population would be placed in a shortened inspection interval. On this basis the existing Technical Specification program is more conservative in corrective action than the OM Code requirements.

The existing Technical Specification has been approved by the NRC. The alternative examination criteria is based on Generic Letter 90-09. It is the Supply System's position that examinations conducted per the Technical Specification provide an equal or greater level of quality and safety than examinations under ASME Section XI IWF-5300(a).

**RELIEF REQUEST 2ISI-12****Component**

Defect removal for ASME Section III, Code Class 1, 2, and 3 piping systems and components.

**ASME Section XI Requirements**

ASME Section XI, IWA-4340 requires that after the final grinding, the affected surfaces including surfaces of the cavities prepared for welding, shall be examined by magnetic particle (MT) or liquid penetrant (PT) method to ensure that the indication has been reduced to an acceptable level.

**ASME Section XI Requirement from Which Relief is Requested**

Relief is requested from performing magnetic particle (MT) or liquid penetrant (PT) examination when defect elimination removes the full thickness of the weld where the back side of the weld joint is not accessible for removal of the examination material.

**Basis for Relief**

The basis for the relief is that when the full thickness of the joint is removed the defect is removed and the back side is not accessible, the NDE material cannot be properly applied or removed and a meaningful examination cannot be performed. In addition, ASME requirements have been clarified in the 1983 Edition of ASME Section III and 1992 Edition of ASME Section XI.

**Alternative**

The unacceptable indications will be removed by mechanical means or by the thermal gouging method as specified by ASME Section III, Code Case N-275, "Repair Of Welds". The area prepared for repair will be examined by magnetic particle (MT) or liquid penetrant (PT) method in accordance with ASME Section III, NX-5110 and the acceptance standards of ASME Section III, NX-5300 as specified by ASME Section III, Code Case N-275. The NDE examination is not required where the full thickness of the weld is removed and where the back side of the weld joint assembly is not accessible for removal of the NDE examination material as specified by ASME Section III, Code Case N-275. The completed weld repair will be NDE examined in accordance with ASME Section III, NX-4453.4 as specified by ASME Section III, Code Case N-275. Gouging through the wall in order to qualify for use of the ASME Section III, Code Case N-275 will not be used.

### Justification for the Granting of Relief

There will be no adverse impact on plant quality and safety by implementing the above discussed alternative since ASME Section III requirements for defect removal were previously implemented in conjunction with the requirements of ASME Section III, Code Case N-275 during construction of the piping systems.

ASME Section III, Code Case N-275 was previously approved for use in Regulatory Guide 1.84. This Code Case was annulled on December 31, 1983 and was incorporated in ASME Section III, NX-4453.1, 1983 Edition. The surface examination using magnetic particle (MT) or liquid penetrant (PT) methods of a through wall excavation, without ID access, results in NDE material such as magnetic particle powder or liquid penetrant dye or developer becoming entrained in a plant piping system and creates a difficulty in obtaining a meaningful NDE examination. The ASME Section III related piping systems and components at WNP-2 were constructed (material, designed, fabricated, installed, examined and tested) in accordance with ASME Section III requirements. The ASME Section III requirements which were implemented during construction are also implemented during defect removal for ASME Section XI repairs in conjunction with the requirements of ASME Section III, Code Case N-275, "Repair Of Welds".

Gouging through the wall in order to qualify for use of the ASME Section III, Code Case N-275 will not be used.

ASME Section III and ASME Section XI, IWA-4331(a), Page 34 of 1992 Edition with 1993 Addenda clarifies that magnetic particle (MT) or liquid penetrant (PT) examination is not required when defect elimination removes the full thickness of the weld where the back side of the weld joint is not accessible for removal of the examination material.

### Implementation Schedule

This relief request for defect removal for ASME Section III, Code Class 1, 2, and 3 piping systems and components will be implemented during the second ten (10) year interval whenever defect removal is required during ASME Section XI repair activities.

**RELIEF REQUEST 2ISI-13****Component**

Welded joints in ASME Section III, Code Class 1, 2, and 3 piping systems and components.

**ASME Section XI Requirements**

ASME Section XI, IWA-5214 and IWA-4700 requires hydrostatic test on ASME Section III, Code Class 1, 2, and 3 welded joints. Hydrostatic test is required on those welded joints which were made during the course of welded repairs or installation of replacements by welding.

**ASME Section XI Requirement from Which Relief is Requested**

Relief is requested from performing hydrostatic test on welded joints in ASME Section III Code Class 1, 2, and 3 piping systems and components as required by ASME Section XI, IWA-5214 and IWA-4700.

**Basis for Relief**

Relief is requested from ASME Section XI hydrostatic test requirements on the basis of ASME Section XI Code Case N-416-1, "Alternative Pressure Test Requirements for Welded Repairs or Installation of Replacement Items by Welding, Class 1, 2, and 3". This Code Case allows alternative examination and testing requirements in lieu of performing the hydrostatic test on the welded joints.

**Alternative**

The non-destructive examination (NDE) on the welded joints in ASME Section III related piping systems and components will be performed in accordance with Code Case N-416-1 and applicable ASME Section III requirements. Code Case N-416-1 requires that the NDE examination and acceptance criteria shall be in accordance with ASME Section III, 1992 Edition requirements.

The VT-2 visual examination during pressure test on the welded joints in ASME Section III related piping systems and components will be performed at nominal operating pressure in accordance with Code Case N-416-1 and ASME Section XI, IWA-5000 requirements. Code Case N-416-1 requires that the VT-2 visual examination shall be performed in conjunction with a system leakage test in accordance with ASME Section XI, 1992 Edition requirements. The nominal operating pressure will be within a value that is obtained when the system is in service and the nominal operating temperature will be equal to the fluid state conditions for that pressure. In addition, welded joints less than 2" nominal pipe size (NPS) in ASME Section III, Code Class 3 piping systems and components will be NDE examined by either magnetic particle (MT) or liquid penetrant



(PT) examination in lieu of visual examination as required by ASME Section III, ND-5000, 1992 Edition.

### **Justification for the Granting of Relief**

There will be no adverse impact on plant quality and safety by implementing Code Case N-416-1 requirements on ASME Section III Code Class 1, 2, and 3 welded joints due to the use of NDE examination and NDE examination acceptance criteria of ASME Section III, 1992 Edition and the alternate pressure test requirements at nominal operating pressure.

The ASME Section III related piping systems and components at WNP-2 were constructed (material, designed, fabricated, installed, examined and tested) in accordance with ASME Section III requirements.

The welded repairs or installation of replacement by welding will be performed in accordance with ASME Section XI, 1989 Edition and ASME Section III, (Code Edition and Addenda applicable to the component) requirements except that the NDE and pressure test requirements will be in accordance with Code Case N-416-1.

The final welds for welded joints in ASME Section III, Code Class 1 (NB) and 2 (NC) piping systems and components will be NDE examined in accordance with ASME Section III, NX-5000, 1992 Edition requirements. The NDE examination acceptance criteria for Code Class 1 and 2 will also be in accordance with ASME Section III, NX-5000, 1992 Edition requirements as required by Code Case N-416-1. The final welds for welded joints over 2" nominal pipe size (NPS) in ASME Section III, Code Class 3 piping systems and components will be NDE examined by either magnetic particle (MT) or liquid penetrant (PT) examination as required by ASME Section III, ND-5000, 1992 Edition. The NDE examination acceptance criteria will also be in accordance with ASME Section III, ND-5000, 1992 Edition requirements as required by Code Case N-416-1. The final welds for welded joints less than 2" nominal pipe size (NPS) in ASME Section III, Code Class 3 piping systems and components will be NDE examined by either magnetic particle (MT) or liquid penetrant (PT) examination in lieu of visual examination as required by ASME Section III, ND-5000, 1992 Edition.

The VT-2 visual examination will be performed in conjunction with a system leakage test in accordance with ASME Section XI, IWA-5000, 1992 Edition requirements as required by Code Case N-416-1.

The purpose of the hydrostatic test on the welded joints is to verify the leak tightness of the joint. The ability to identify a potential leak in the welded joint would be the same during a system leakage test at nominal operating pressure per Code Case N-416-1 as it would be at an elevated pressure test of 1.1 X design pressure through 1.25 X design pressure for the hydrostatic test of ASME Section XI.

### **Implementation Schedule**

This relief request for use of Code Case N-416-1 requirements will be implemented during the second ten (10) year interval whenever a hydrostatic test is required subsequent to welded repairs or installation of replacements by welding is performed in accordance with ASME Section XI and ASME Section III requirements.

**RELIEF REQUEST 2ISI-14****Component**

Bolted mechanical joints in ASME Section III, Code Class 1, 2, and 3 piping systems and components when disassembled and reassembled during the course of ASME Section XI repair and replacement activities.

**ASME Section XI Requirements**

ASME Section XI, IWA-5250(a)(2) requires that if leakage is observed during VT-2 visual examination during the system pressure test at bolted mechanical joints, 1) remove all the bolting material associated with that joint, 2) perform VT-3 visual examination for localized general corrosion on the removed bolting material associated with that joint, 3) if the localized general corrosion reduces the bolting material cross sectional area by more than 5%, replace the unacceptable (corroded) bolting material.

ASME Section XI, IWA-5250(a)(2) requirements apply only to those bolted mechanical joints with repair or replacement bolting material and are not applicable to bolted mechanical joints disassembled and reassembled during or a result of associated maintenance activities. This is supported by ASME Interpretation No 29, XI-1-86-13R.

**ASME Section XI Requirement from Which Relief is Requested**

Relief is requested from removal of bolting and performing VT-3 visual examination on bolting material for bolted mechanical joints in ASME Section III, Code Class 1, 2, and 3 piping systems and components disassembled and reassembled during the course of ASME Section XI repair and replacement activities as required by ASME Section XI, IWA-5250(a)(2).

**Basis for Relief**

Relief is requested from ASME Section XI, IWA-5250(a)(2), removal and VT-3 visual examination of bolting material for bolted mechanical joints when leakage is observed during VT-2 visual examination during the system pressure test following ASME Section XI repair and replacement activities. The alternatives addressed below will provide an equivalent determination of whether the bolting material is degraded. These alternatives provide acceptable detection of bolting corrosion in a Boiling Water Reactor (BWR) service with process systems not using borated water.

**Alternative**

The following alternatives will be implemented to comply with the intent of ASME Section XI, IWA-5250(a)(2) requirements. These alternative requirements will be implemented when bolting material is replaced for bolted mechanical joints in ASME Section III, Code Class 1, 2, and 3 piping systems and components during the course of

ASME Section XI repair and replacement activities and are not applicable to bolted mechanical joints disassembled and reassembled during, or a result of, associated maintenance activities.

Bolted mechanical joints in air or gaseous systems will have a VT-2 visual examination performed of the bolting material as required by ASME Section XI. Any leakage observed from the bolted mechanical joint during VT-2 visual examination will be evaluated for acceptability or corrective action.

Bolted mechanical joints in other than air or gaseous systems where all *new replacement* bolting material is used will have a VT-2 visual examination performed on the bolted mechanical joint during system pressure test. If leakage is observed from the bolted mechanical joint during the VT-2 visual examination it will be evaluated for acceptability or corrective action.

Bolted mechanical joints in other than air or gaseous systems where *existing* bolting material has been removed and is being reused will have a VT-3 visual examination performed on the bolting material prior to installation. If leakage is observed from the bolted mechanical joint during the VT-2 visual examination during system pressure test it will be evaluated for acceptability or corrective action. Existing bolting material reused without a VT-3 visual examination would include the bolting not required to be removed as part of the repair or replacement activity. This bolting would be included in the ASME Section XI system pressure test boundary.

Bolting material for mechanical joints for Control Rod Drives (CRD) will have a VT-1 visual examination performed on all the reused *existing and/or new replacement* bolting material prior to installation. If leakage is observed from the bolted mechanical joint during the VT-2 visual examination during system pressure test it will be evaluated for acceptability or corrective action.

### Justification for the Granting of Relief

ASME Section XI, IWA-5250(a)(2), 1989 Edition would literally require complete removal and inspection of all the bolting of a bolted mechanical joint for evaluation if leakage occurs at the bolted mechanical joint during the system pressure test following ASME Section XI repair and replacement activities, even though the leakage could be very small and considered acceptable or known to stabilize or stop after a period of time. This could require an unnecessary cooldown or shutdown of the plant, including extra unnecessary radiation exposure of personnel, and a delay in plant startup following an outage. The alternatives presented provide assurance that the bolted mechanical joints are adequately evaluated for a Boiling Water Reactor (BWR) plant to provide an acceptable level of quality and safety.

The purpose of ASME Section XI, IWA-5250(a)(2) is to determine if inservice leakage has degraded the bolting material. By installing new replacement bolting material or performing a VT-3 examination on the existing bolting material prior to reinstalling, the

integrity of the bolting material is assured prior to performing the pressure test for repair and replacement activities. ASME Interpretation No 30, XI-1-92-01 supports exclusion of ASME Section XI, IWA-5250(a)(2) for new or VT-3 examined bolting material.

Bolting material subject to leakage from process systems such as air or gaseous are not subject to a corrosive environment and therefore do not warrant removal for VT-3 visual examination.

WNP-2 is a Boiling Water Reactor (BWR) that does not utilize a process system with a borated water chemistry (except the Standby Liquid Control system) like a Pressurized Water Reactor (PWR). The corrosiveness of leaking borated water in a PWR is not applicable to WNP-2. The alternatives described provide assurance that corrosive conditions are evaluated.

Bolting material that has been replaced (new) would not warrant a VT-3 visual examination of the bolting material if leakage was observed. The purpose of the VT-3 visual examination is to examine for localized general corrosion. The localized general corrosion is not expected to be observed on the new replacement bolting material since the bolting material has not been through the service conditions associated with the piping system. If leakage is observed during VT-2 visual examination during the system pressure test, the leakage from the bolted mechanical joint would be evaluated for acceptability to determine the corrosive effects on the bolting material or the corrective action.

VT-3 visual examination performed on the existing bolting material for mechanical joints prior to reassembly establishes a baseline that bolting corrosion is not present prior to installation. Therefore leakage observed during the VT-2 visual examination during the system pressure test, for the joint would be evaluated for acceptability to determine the corrosion effects on the bolting material or for corrective action. Bolting not removed and not part of the repair or replacement activity are included in the ASME Section XI system pressure test boundary (relief request 2ISI-07).

The VT-1 visual examination performed on the reused existing and/or replacement (new) bolting material for the Control Rod Drives (CRD) bolted mechanical joints prior to reassembly establishes a baseline that the bolting corrosion is not present prior to installation. If leakage is observed during VT-2 visual examination during the system pressure test, the leakage from the bolted mechanical joint would be evaluated for acceptability to determine the corrosive effects on the bolting material or the corrective action.

### **Implementation Schedule**

This relief request will be implemented during the second ten (10) year interval whenever bolted mechanical joints in ASME Section III, Code Class 1, 2, and 3 piping systems and components are disassembled and reassembled as a result of ASME Section XI repair and replacement activities.

### 5.1.3 Code Cases

The Supply System has reviewed the Code Cases in effect for applicability to the WNP-2 Inservice Inspection Program. The Code Cases listed below, accepted by the NRC in Regulatory Guide 1.147 "Inservice Inspection Code Case Acceptability ASME Section XI Division 1" Revision 11 (dated October 1994) will be used in the WNP-2 ISI Program. The extent of applicability of the Code Cases will be as defined in the NRC acceptance of the Code Cases as contained in the latest revision of Regulatory Guide 1.147 unless modified below.

- |         |  |
|---------|--|
| N-236-1 | Repair and Replacement of Class MC Vessels   |
| N-432   | Repair Welding Using Automatic or Machine Gas Tungsten-Arc Welding (GTAW) Temper Bead Technique                  |
| N-460   | Alternative Examination Coverage Class 1 and Class 2 Welds   |
| N-489   | Alternative Rules for Level III NDE Qualification Examinations   |
| N-491   | Alternative Rules for Examination of Class 1, 2, 3, and MC Component Supports of Light-Water Cooled Power Plants |
| N-503   | Limited Certification of Non-destructive Examination Personnel   |

Additional Code Cases may be added to this list as they are reviewed and accepted by the NRC.

### 5.1.4 Use of Later Editions and Addenda of ASME Section XI

This section identifies the editions and addenda issued after the 1989 Edition of ASME Section XI that are incorporated into this Inservice Inspection Program Plan as allowed by 10 CFR 50.55a(g)(4)(iv). Per 10 CFR 50.55a(g)(4)(iv) the NRC has approved for use at WNP-2 the following portions from later editions and addenda:

At this time there are no subsequent editions or addenda of ASME Section XI being used at WNP-2.

## 5.2 ASME SECTION XI, 1989 EDITION

Areas where additional information or clarification of WNP-2's implementation of Section XI are addressed in this section. If an area of the Code is not addressed in this section, the Supply System does not feel any clarification is necessary and intends to fully comply with that Code requirement.

### 5.2.1 IWA General Requirements

*IWA-1000 Scope and Responsibility*

The following is a summary of the owner's responsibilities under Section XI and where in this Program Plan additional information can be found on how these responsibilities are being carried out. The format of this discussion follows the format of IWA-1400, so direct correlation between the owner's responsibilities and implementation at WNP-2 can be made.

#### **IWA-1400 Owner's Responsibilities**

- (a) System inspection boundaries showing appropriate Code classes are defined on the ISI Boundary Diagrams located in Section 9.0. With each diagram is included a summary sheet of exemptions that are being applied to that system.
- (b) The construction design specifications included provisions for inservice inspection access. Current design procedures include provisions for ISI access.
- (c) This document contains the plans and schedules for filing with the regulatory and enforcement authorities.
- (d) A list of examination procedures is included in Section 8.0, Procedure List. Weld & Component Diagrams are included for each system in Section 9.0 of this Plan.
- (e) Qualification of personnel is maintained under the Qualification and Certification Program administrated by the Quality Assurance organization.
- (f) The Supply System has a contract with an Authorized Inspection Agency to provide inspection services.
- (g) WNP-2 schedules as part of each refueling outage the appropriate examinations and tests to comply with this requirement.
- (h) The procedures used to implement this program identify the recording criteria.
- (i) The procedures used to implement this program identify the evaluation criteria.
- (j) WNP-2 maintains a program that governs the repair and replacement of ASME Section III items per the requirements of ASME Section XI. A discussion of the repair and replacement program is in section 5.3 "Repair and Replacement Program".
- (k) Examination and test data and personnel qualification records are controlled through procedures listed in Section 8.0 of this plan.
- (l) WNP-2 retains all the inspection, examination, testing, repair, and replacement records for the service life of the component or system. The control of these records is through procedures listed in Section 8.0 of this plan.
- (m) WNP-2 retains and maintains the calibration blocks necessary to carry out the examinations defined in Section XI. A description of these blocks is included in Section 7.0 of this plan.
- (n) The WNP-2 quality assurance program is documented in the "Operational Quality Assurance Program Description".
- (o) WNP-2 has not required implementation of IWB-3410.2.

#### ***IWA-2000 Examination and Inspection***

The following discusses how WNP-2 Inservice Inspection Program Plan addresses the requirements of IWA-2420.

#### **IWA-2420 Inspection Plans and Schedules**



- (a)(1) The Edition and Addenda of Section XI that applies to this Plan is defined in Section 5.1, Reference Code
- (2) The classification of the components and the system Code class boundaries are defined on the ISI Boundary Diagrams and the Weld and Component Diagrams found in Section 9.0.
- (3) The components subject to examination and test are identified in the Weld and Component Schedule in Section 9.0.
- (4) The Code category and item numbers for each component and the examination to be performed is defined in the Weld and Component Schedule in Section 9.0.
- (5) Relief requests are found in Section 5.1.2 and define the examination or test that is not being satisfied and presents an alternative examination, if appropriate.
- (6) Code Cases being used in this program are identified in Section 5.1.3.
- (b) The schedule for implementation is found in the Weld and Component Schedule in Section 9.0.

#### IWA-2430 Inspection Intervals.

As in the first interval, WNP-2 will follow the Inspection Program B for all items in this second inspection interval. The first inspection interval was not extended. This program is written to incorporate a 12-month refueling cycle into the inspection schedule. The inspection interval is defined in Table 5.2.1.

TABLE 5.2.1

 SECOND INSPECTION INTERVAL ENDING 12/12/2004  
 12 MONTH REFUELING CYCLE

Inspection Period	Refueling <sup>1</sup> Outage	From <sup>2</sup>	To <sup>2</sup>
1		<u>12/13/94</u>	<u>09/15/98</u>
	10	04/15/95	06/01/95
	11	04/15/96	06/01/96
	12	04/15/97	06/01/97
	13	04/15/98	06/01/98
2		<u>09/16/98</u>	<u>09/15/01</u>
	14	04/15/99	06/01/99
	15	04/15/00	06/01/00
3	16	04/15/01	06/01/01
		<u>09/16/01</u>	<u>12/12/04</u>
	17	04/15/02	06/01/02
	18	04/15/03	06/01/03
	19	04/15/04	06/01/04
(1) Assuming one refueling or maintenance outage each year. Actual timing of the spring outages may vary due to BPA's hydroelectric capacity and WNP-2's maintenance schedule.  (2) These dates are approximate and are included here for illustration purposes.			

## IWA-2440 Application of Code Cases

The Code Cases used in this Program are identified in section 5.1.3, Code Cases.

## IWA-2600 Weld Reference System

WNP-2 established a weld reference system during the preservice examinations. The welds were stamped with a unique identifying number. These numbers are identified on the weld and component identification diagrams. Reference marks were also stamped on the pipe in the area of the weld to designate points around the weld (0, 90, 180, etc degrees). This reference system meets the requirements of Appendix III, III-4300.

*IWA-4000 Repair Procedures*

See section 5.3 Repair and Replacement Program

*IWA-5000 System Pressure Tests*

IWA-5250 - See relief requests 2ISI-06, 2ISI-07, and 2ISI-14.

IWA-5260 - This section applies only to the system tests described in IWA-5211(d) and (e). See IWA-5212(d).

*IWA-6000 Records and Reports*

Following the completion of the WNP-2 inservice inspection for each refueling outage, an Inservice Inspection Summary Report will be prepared by the Supply System and filed with the Nuclear Regulatory Commission (NRC) and Washington State's Department of Labor and Industries. The report will satisfy the reporting requirements of the Reference Code, Article IWA-6000, "Records and Reports".

The WNP-2 Inservice Inspection Report will include at least the following information:

1. Abstract of examinations and tests performed, including Form NIS-1, since the last refueling outage.
2. Summary of examination and results, including disposition of significant indications.
3. NIS-2 forms for repairs and replacements completed between the filing of the last NIS-1 form and the end of the present refueling outage.

The ISI Summary Report will be submitted to the NRC and the State of Washington within 90 days (IWA-6230) after the examinations have been completed for a particular refueling outage. WNP-2 will use the date the plant begins supplying electricity to the grid as the date the outage is over and the 90 day clock starts.

*IWA-7000 Replacements*

See section 5.3 Repair and Replacement Program

*IWA-9000 Glossary*

Terms and abbreviations used in this document will conform to Article IWA-9000. The following terms and abbreviations, not included in Article IWA-9000, are defined below as they are used in this document.

**Access** - The ability to perform nondestructive examinations (NDE) on a weld or component in accordance with applicable Codes, Standards, and Regulatory Requirements. Access may include: ability to physically reach the point of examination; proper weld contouring and surface finish; proper weld geometry; adequate clearances from a weld to adjacent structures, fittings, restraints; removability of insulation; adequate radiation protection; and lighting.

**Alternative Examination** - Examination, approved by the NRC, performed in lieu of the Code requirements. Alternative examinations are normally submitted as part of relief requests.

**Analysis** - Process of determining the pertinent characteristics of an indication--such as its origin (crack, porosity, lamination, etc.), location, orientation, and may include sizing.

**ANII** - Authorized Nuclear Inservice Inspector also referred to as the Inspector

**Augmented Requirement** - In addition to or if more stringent in place of the Reference Code.

**BPA** - Bonneville Power Administration - The organization that receives and markets the power generated by WNP-2

**BOP** - Balance of Plant

**Calibration Block (Standard)** - An NDE calibration device used to simulate defects in a weld or component, the purpose of which is to calibrate ultrasonic or other NDE equipment.

**CHR** - Containment heat removal

**Code Acceptance Standards** - Acceptance standards for flaw indications as defined in ASME Section XI, IWB-3000 and IWC-3000.

**Commission** - Nuclear Regulatory Commission

**ECC** - Emergency Core Cooling

**Enforcement Agency** - Washington State Department of Labor and Industries

**Examination** - A performance of a nondestructive examination (NDE) method such as visual observation, radiography, ultrasonic, liquid penetrant, and magnetic particle.

**Examination Equipment** - Instruments, mechanical devices, data acquisition systems, tracks, film, sources, etc., used to accomplish a nondestructive examination.

**Examiner** - Person performing a nondestructive examination.

**FFWTR** - Final feedwater temperature reduction ("coastdown")

**Inaccessible** - An examination area which is within the scope of this document which cannot be

fully examined in compliance with the applicable Codes, Standards, and Regulations due to insufficient access.

*Inspection Interval* - The 10 years following initial start of power unit commercial operation, and each subsequent 10 years.

*Inspection Period* - The inspection interval is divided into three inspection periods, 1st period, 0-3 years; 2nd period, 4-7 years; and 3rd period, 8-10 years of plant service.

*Inservice Inspection (ISI)* - Inspection and examination activities performed in accordance with ASME Section XI, which include preservice inspection (PSI) activities.

*Nominal Operating Pressure* - The pressure attained when the system is in service

*Nominal Operating Temperature* - The temperature equal to the fluid state conditions for the nominal operating pressure.

*NPS* - Nominal Pipe Size

*NRC* - Nuclear Regulatory Commission

*NSSS* - Nuclear Steam Supply System

*Owner Recording Criteria* - Requirements the Owner places on ISI examinations in addition to the requirements of the Reference Code.

*Preservice Inspection (PSI)* - Inspection activities performed before the plant enters service.

*RPV* - Reactor Pressure Vessel

*Reactor coolant pressure boundary, RCPB* - "Reactor coolant pressure boundary" means all those pressure-containing components of boiling and pressurized water-cooled nuclear power reactors, such as pressure vessels, piping, pumps, and valves, which are:

- (1) Part of the reactor coolant system, or
- (2) Connected to the reactor coolant system, up to and including any and all of the following:
  - (i) The outermost containment isolation valve in system piping which penetrates primary reactor containment,
  - (ii) The second of two valves normally closed during normal reactor operation in system piping which does not penetrate primary reactor containment,
  - (iii) The reactor coolant system safety and relief valves.

For nuclear power reactors of the direct cycle boiling water type, the reactor coolant system extends to and includes the outermost containment isolation valve in the main steam and feedwater piping ( from 10 CFR 50 Section 50.2(v); revised January 1, 1975 Section XI references this definition).

**Recordable Indication** - An indication which equals or exceeds Owner recording criteria. The Owner recording criteria may be more restrictive than the Code requirements, but will not be less restrictive than the Code requirements.

**Regulatory Agency** - Nuclear Regulatory Commission

**Reportable Indication** - Any indication which equals or exceeds Code reporting criteria.

**Reference Code** - The ASME Section XI Edition and Addenda and any portions of later editions or addenda with which the ISI Program Plan complies.

**RHR** - Residual heat removal

**Safety-Related** - Systems or parts of systems defined in FSAR Table 3.2-1 as Quality Control Class I.

**Sizing of Indications** - Application of the sizing criteria given in ASME Section XI, IWB-3000 and IWC-3000, to determine the size of a flaw indication--part of the evaluation process.

**Snubber** - A device which provides restraint to a component or system during a sudden application of forces but allows essentially free motion during thermal movement.

**Supply System** - Washington Public Power Supply System

**Surface Examination** - Liquid penetrant or magnetic particle examinations performed in accordance with the applicable Codes, Standards, and Regulations.

**System Designations** - WNP-2

CCH - Control Room Chilled Water

CRD - Control Rod Drive

EDR - Equipment Drain Processing

FDR - Floor Drain Processing

FPC - Fuel Pool Cooling

LPCS - Low Pressure Core Spray

HPCS - High Pressure Core Spray

MS - Main Steam

RCC - Reactor Closed Cooling

RCIC - Reactor Core Isolation Cooling

RFW- Reactor Feedwater

RHR - Residual Heat Removal

RWCU - Reactor Water Cleanup

RRC - Reactor Recirculation

SW - Standby Service Water

SLC - Stand-by Liquid Control

### 5.2.2 IWB Requirements for Class 1 Components

#### *IWB-1000 Scope and Responsibility*

IWB-1210 Components subject to examination - examination requirements

IWB-1220 - The exemptions allowed by this paragraph have been applied to each Class 1 system requiring volumetric and/or surface examinations. The application of these exemptions to each system is defined in Section 9.0.

- a) IWB-1220(a) The Supply System will exempt from volumetric and surface examination components that are of such size and shape so that upon postulated rupture the resultant coolant flow from the reactor coolant system under normal plant operating conditions is within the capacity of the makeup systems which are operable from on-site emergency power. This exemption is applied to all Class 1 ISI boundaries as follows:
- 1) Class 1 piping penetrating the RPV below the normal reactor water level and 1.5 inch NPS or less, and
  - 2) Class 1 piping penetrating the RPV above the normal reactor water level and 3.0 inch NPS or less.

The above exemption is supported by Calculation Number ME-02-78-01-1.

- b) The examination boundaries extend up to the transition to instrument tubing. Instrument tubing is not within the scope of Section XI.

#### *IWB-2000 Examination and Inspection*

IWB-2410 Inspection Program

This Inservice Inspection Program Plan will comply with Inspection Program B.

**IWB-2420 Successive Inspections**

Examinations will be performed in the same sequence as established in the first inspection interval as follows:

1. Exams will be performed in the same period as they were performed during first inspection interval;
2. Exams will be performed in the order they were performed in the first interval to the extent practical. The order may vary to accommodate performing exams in the same plant area due to outage planning and ALARA considerations.



Table IWB-2500-1

EXAMINATION CATEGORY B-A PRESSURE RETAINING WELDS IN REACTOR VESSEL				
ITEM NO.	DESCRIPTION	COMPLIES WITH SECTION XI	REQUEST FOR RELIEF NO.	NOTES
B1.10	Shell Welds			
B1.11	Circumferential	No	2ISI-01	
B1.12	Longitudinal	No	2ISI-01	
B1.20	Head Welds			
B1.21	Circumferential	No	2ISI-01	
B1.22	Meridianial	No	2ISI-01	
B1.30	Shell-to-Flange Weld	No	2ISI-01	
B1.40	Head-to-Flange Weld	Yes		
B1.50	Repair Welds			
B1.51	Beltline Region	Yes		

EXAMINATION CATEGORY B-B PRESSURE RETAINING WELDS IN VESSELS OTHER THAN RPV				
ITEM NO.	DESCRIPTION	COMPLIES WITH SECTION XI	REQUEST FOR RELIEF NO.	NOTES
A11	There are no Class 1 pressure vessels at WNP-2 other than the reactor vessel.	N/A		

EXAMINATION CATEGORY B-D PENETRATION WELDS OF NOZZLES IN VESSELS				
ITEM NO.	DESCRIPTION	COMPLIES WITH SECTION XI	REQUEST FOR RELIEF NO.	NOTES
B3.90 B3.100	Reactor Vessel Nozzle-to-Vessel Welds Nozzle Inside Radius Sections	No Yes	2ISI-02	1
All Other Item No.	Pertain to PWRs WNP-2 is a BWR	N/A		
<p>Notes</p> <p>1 An augmented UT examination of the Feedwater nozzle bore and inner radius (IR) will be performed per the requirements in section 6.2.3. The feedwater IR has 3 examination requirements: 1) Section XI - every 10 years; 2) NUREG 0619 - 1 IR each of first 6 outages of interval; 3) 1 IR every time FFWR is implemented.</p>				

EXAMINATION CATEGORY B-D PENETRATION WELDS OF NOZZLES IN VESSELS				
ITEM NO.	DESCRIPTION	COMPLIES WITH SECTION XI	REQUEST FOR RELIEF NO.	NOTES
B3.90 B3.100	Reactor Vessel Nozzle-to-Vessel Welds Nozzle Inside Radius Sections	No Yes	2ISI-02	1
All Other Item No.	Pertain to PWRs WNP-2 is a BWR	N/A		
<p>Notes</p> <p>1 An augmented UT examination of the Feedwater nozzle bore and inner radius (IR) will be performed per the requirements in section 6.2.3. The feedwater IR has 3 examination requirements: 1) Section XI - every 10 years; 2) NUREG 0619 - 1 IR each of first 6 outages of interval; 3) 1 IR every time FFWTR is implemented.</p>				

EXAMINATION CATEGORY B-E PRESSURE RETAINING PARTIAL PENETRATION WELDS IN VESSELS				
ITEM NO.	DESCRIPTION	COMPLIES WITH SECTION XI	REQUEST FOR RELIEF NO.	NOTES
B4.10	Partial Penetration Welds	Yes		
B4.11	Vessel Nozzles	Yes		
B4.12	Control Rod Drive Nozzles	Yes		
B4.13	Instrumentation Nozzles	Yes		
B4.20	Pressurizer Heater Penetration Welds	N/A		



EXAMINATION CATEGORY B-F PRESSURE RETAINING DISSIMILAR METAL WELDS				
ITEM NO.	DESCRIPTION	COMPLIES WITH SECTION XI	REQUEST FOR RELIEF NO.	NOTES
B5.10	Reactor Vessel Nominal Pipe Size $\geq 4$ in. Nozzle- to-Safe End Butt Welds	Yes		
B5.20	Nominal Pipe Size $< 4$ in. Nozzle- to-Safe End Butt Welds	Yes		
B5.30	Nozzle-to-Safe End Socket Welds	N/A		
B5.130	Piping Nominal Pipe Size $\geq 4$ in. Dissimilar Metal Butt Welds	Yes		
B5.140	Nominal Pipe Size $< 4$ in. Dissimilar Metal Butt Welds	Yes		
B5.150	Dissimilar Metal Socket Welds	N/A		
All Other Item No.	WNP-2 is a BWR. These items pertain to PWR	N/A		

EXAMINATION CATEGORY B-G-1 PRESSURE RETAINING BOLTING GREATER THAN 2 IN. DIAMETER				
ITEM NO.	DESCRIPTION	COMPLIES WITH SECTION XI	REQUEST FOR RELIEF NO.	NOTES
B6.10	Reactor Vessel Closure Head Nuts	No	ISI-2-004	
B6.20	Closure Studs, in place	Yes		
B6.30	Closure Studs, when removed	Yes		
B6.40	Threads in Flange	Yes		
B6.50	Closure Washers, Bushings	Yes		
B6.150	Piping	N/A		
B6.160	No piping bolting greater than 2 in. diameter			
B6.170				
	Pumps			
B6.180	Bolts and Studs	Yes		
B6.190	Flange Surfaces when connection disassembled	Yes		
B6.200	Nuts, Bushings and Washers	Yes		
	Valves			
B6.210	Bolts and Studs	Yes		
B6.220	Flange surfaces when connection disassembled	Yes		
B6.230	Nuts, Bushing and Washers	Yes		



EXAMINATION CATEGORY B-G-1 PRESSURE RETAINING BOLTING GREATER THAN 2 IN. DIAMETER				
ITEM NO.	DESCRIPTION	COMPLIES WITH SECTION XI	REQUEST FOR RELIEF NO.	NOTES
All other Item No.	WNP-2 is a BWR. The other Item No. apply to PWRs			

EXAMINATION CATEGORY B-G-2 PRESSURE RETAINING BOLTING 2 IN. AND LESS IN DIAMETER				
ITEM NO.	DESCRIPTION	COMPLIES WITH SECTION XI	REQUEST FOR RELIEF NO.	NOTES
B7.10	Reactor Vessel Bolts, Studs, and Nuts	Yes		
B7.50	Piping Bolts, Studs, and Nuts	Yes		
B7.60	Pumps Bolts, Studs, and Nuts	Yes		
B7.70	Valves Bolts, Studs, and Nuts	Yes		
B7.80	CRD Housings Bolts, Studs, and Nuts when disassembled	Yes		
All other Item No.	WNP-2 is a BWR. The other Item No. apply to PWRs			

EXAMINATION CATEGORY B-H INTEGRAL ATTACHMENTS FOR VESSELS				
ITEM NO.	DESCRIPTION	COMPLIES WITH SECTION XI	REQUEST FOR RELIEF NO.	NOTES
B8.10	Reactor Vessel Integrally Welded Attachments	Yes		
All other Item No.	WNP-2 is a BWR. The other Item No. apply to PWRs			

EXAMINATION CATEGORY B-J PRESSURE RETAINING WELDS IN PIPING				
ITEM NO.	DESCRIPTION	COMPLIES WITH SECTION XI	REQUEST FOR RELIEF NO.	NOTES
B9.10	Nominal Pipe Size $\geq 4$ in.			
B9.11	Circumferential Welds	Yes		
B9.12	Longitudinal Welds	Yes		
B9.20	Nominal Pipe Size $< 4$ in.			
B9.21	Circumferential Welds	Yes		
B9.22	Longitudinal Welds	Yes		
B9.30	Branch Pipe Connection Welds			
B9.31	Nominal Pipe Size $\geq 4$ in.	Yes		
B9.32	Nominal Pipe Size $< 4$ in.	Yes		
B9.40	Socket Welds	Yes		

EXAMINATION CATEGORY B-J PRESSURE RETAINING WELDS IN PIPING				
ITEM NO.	DESCRIPTION	COMPLIES WITH SECTION XI	REQUEST FOR RELIEF NO.	NOTES
Notes				
<p>Selection of welds is defined in note (1) of this table. The first selection criteria say to pick welds that are terminal ends and ones that exceed certain stress and usage criteria. The note goes on to say to then pick enough additional welds to examine so that the total welds equals 25% of the total welds in the system. When making this selection per terminal ends and stress and usage criteria the number of welds exceeds 25% of the RCPB welds. It is our interpretation of this note that the intent of the Code was to examine 25% of the welds, choosing them on the basis of note (1)a, b and c until you were examining 25% of the RCPB welds. If you could not identify 25% of welds through these first three criteria then you pick enough other welds to make the total 25%. This interpretation is supported by ASME Section XI interpretation XI-1-92-56.</p>				
<p>The Reactor Coolant Pressure Boundary is defined as the ASME Section III Code Class 1 portion of the following systems:</p>				
<u>System</u>	<u>Boundary Diagram</u>	<u>Description</u>		
HPCS	ISI-220	From RPV to HPCS-V-4		
LPCS	ISI-220	From RPV to LPCS-V-5		
MS	ISI-229	From RPV to MS-V-28A		
		From RPV to MS-V-28B		
		From RPV to MS-V-28C		
		From RPV to MS-V-28D		
		RPV nozzle N8 to MS-V-2		
RCIC	ISI-219	RPV nozzle N7 to RCIC-V-13 and RHR-V-23		
		MS line RCIC-V-64		
RHR	ISI-221	RHR-V-112A to RHR-V-53A		
		RHR-V-112B to RHR-V-53B		
		RHR-V-113 to RHR-V-8		
		RPV nozzle N6A to RHR-V-42A		
		RPV nozzle N6B to RHR-V-42B		
RPV		RPV nozzle N6C to RHR-V-42C		
		Instrument penetrations - From the RPV nozzle to the point of transition to instrument tubing outside containment.		
RRC	ISI-230	All Code Class 1 portions		

EXAMINATION CATEGORY B-K-1 INTEGRAL ATTACHMENTS FOR PIPING, PUMPS AND VALVES				
ITEM NO.	DESCRIPTION	COMPLIES WITH SECTION XI	REQUEST FOR RELIEF NO.	NOTES
B10.10	Piping Integrally Welded Attachments	No	2ISI-08	
B10.20	Pumps Integrally Welded Attachments	Yes		
B10.30	Valves Integrally Welded Attachments. WNP-2 does not have any valves with integrally welded attachments.	N/A		

EXAMINATION CATEGORIES B-L-1, B-M-1 PRESSURE RETAINING WELDS IN PUMP CASINGS AND VALVE BODIES				
EXAMINATION CATEGORIES B-L-2, B-M-2 PUMP CASINGS AND VALVE BODIES				
ITEM NO.	DESCRIPTION	COMPLIES WITH SECTION XI	REQUEST FOR RELIEF NO.	NOTES
B12.10	<p>Pumps</p> <p>Pump Casing Welds - WNP-2 does not have Class 1 pumps with casing welds.</p>	N/A		
B12.20	Pump Casing (B-L-2)	Yes		
B12.30	<p>Valves</p> <p>Valves, NPS less than 4 in. valve body welds - WNP-2 does not have Class 1 valves with body welds.</p>	N/A		
B12.40	<p>Valves, NPS 4 in or larger. valve body welds - WNP-2 does not have Class 1 valves with body welds.</p>	N/A		
B12.50	Valve body exceeding NPS 4 in. (B-M-2)	Yes		

EXAMINATION CATEGORY B-N-1, B-N-2 - INTERIOR OF REACTOR VESSEL, INTEGRALLY WELDED CORE SUPPORT STRUCTURES AND INTERIOR ATTACHMENTS TO REACTOR VESSELS				
ITEM NO.	DESCRIPTION	COMPLIES WITH SECTION XI	REQUEST FOR RELIEF NO.	NOTES
B13.10	Reactor Vessel Vessel Interior	Yes		
	Reactor Vessel (BWR)			
B13.20	Interior Attachments Within Beltline Region (B-N-2)	Yes		
B13.30	Interior Attachments Beyond Beltline Region (B-N-2)	Yes		
B13.40	Core Support Structure (B-N-2)	Yes		
All remaining Item No.	WNP-2 is a BWR. The other Item No. apply to PWRs			



EXAMINATION CATEGORY B-O PRESSURE RETAINING WELDS IN CONTROL ROD HOUSINGS				
ITEM NO.	DESCRIPTION	COMPLIES WITH SECTION XI	REQUEST FOR RELIEF NO.	NOTES
B14.10	Reactor Vessel Welds in CRD Housing	Yes		Exempt by IWB-1220(a)

EXAMINATION CATEGORY B-P PRESSURE RETAINING BOUNDARY				
ITEM NO.	DESCRIPTION	COMPLIES WITH SECTION XI	REQUEST FOR RELIEF NO.	NOTES
B15.10	Reactor Vessel Pressure Retaining Boundary (System Leakage Test)	Yes		
B15.11	Pressure Retaining Boundary (System Hydro Test)	Yes		
B15.50	Piping Pressure Retaining Boundary (System Leakage Test)	Yes		
B15.51	Pressure Retaining Boundary (System Hydro Test)	Yes		
B15.60	Pumps Pressure Retaining Boundary (System Leakage Test)	Yes		
B15.61	Pressure Retaining Boundary (System Hydro Test)	Yes		
B15.70	Valves Pressure Retaining Boundary (System Leakage Test)	Yes		
B15.71	Pressure Retaining Boundary (System Hydro Test)	Yes		

EXAMINATION CATEGORY B-P PRESSURE RETAINING BOUNDARY				
ITEM NO.	DESCRIPTION	COMPLIES WITH SECTION XI	REQUEST FOR RELIEF NO.	NOTES
All remaining Item No.	WNP-2 is a BWR. The other Item No. apply to PWRs			
Notes				

*IWB-3000 Acceptance Standards*

No comments or clarifications of this section.

*IWB-4000 Repair Procedures*

See section 5.3 Repair - Replacement Program

*IWB-5000 System Pressure Tests*

WNP-2 will implement Code Case N-498 for Class 1 and 2 pressure testing. See Section 5.1.3.

*IWB-7000 Replacements*

See section 5.3 Repair and Replacement Program

**5.2.3 IWC Requirements for Class 2 Components**

*IWC-1000 Scope and Responsibility*

The exemptions allowed by paragraphs IWC-1220 and IWC-1230 have been applied to each Class 2 system requiring a volumetric and/or surface examination. The portions of the system where these exemptions have been applied are detailed in the Boundary Diagram tables found after each Boundary Diagram in Section 9.0.

*IWC-2000 Examination and Inspection*

Table IWC-2500-1

EXAMINATION CATEGORY C-A PRESSURE RETAINING WELDS IN PRESSURE VESSELS				
ITEM NO.	DESCRIPTION	COMPLIES WITH SECTION XI	REQUEST FOR RELIEF NO.	NOTES
C1.10	Shell Circumferential Welds	Yes		
C1.20	Head Circumferential Welds	Yes		
C1.30	Tubesheet-to-Shell Weld	Yes		

EXAMINATION CATEGORY C-B PRESSURE RETAINING NOZZLE WELDS IN VESSELS				
ITEM NO.	DESCRIPTION	COMPLIES WITH SECTION XI	REQUEST FOR RELIEF NO.	NOTES
C2.10	Nozzles in Vessels $\leq \frac{1}{2}$ in. Nominal Thickness	Yes		
C2.11	Nozzle-to-Shell (or Head) Weld	Yes		
C2.20	Nozzles in Vessels $> \frac{1}{2}$ in. Nominal Thickness	Yes		
C2.21	Nozzle-to-Shell (or Head) Weld	Yes		
C2.22	Nozzle inside radius section	NA		
All other Item Numbers	Not applicable to WNP-2	NA		

EXAMINATION CATEGORY C-C INTEGRAL ATTACHMENTS FOR VESSELS, PIPING, PUMPS AND VALVES				
ITEM NO.	DESCRIPTION	COMPLIES WITH SECTION XI	REQUEST FOR RELIEF NO.	NOTES
C3.10	Pressure Vessels Integrally Welded Attachments	Yes		
C3.20	Piping Integrally Welded Attachments	No	2ISI-09	
C3.30	Pumps Integrally Welded Attachments WNP-2 does not have any Class 2 pumps with integrally welded attachments.	N/A		
C3.40	Valves Integrally Welded Attachments WNP-2 does not have any Class 2 valves with integrally welded attachments.	N/A		

EXAMINATION CATEGORY C-D PRESSURE RETAINING BOLTING GREATER THAN 2 IN. IN DIAMETER				
ITEM NO.	DESCRIPTION	COMPLIES WITH SECTION XI	REQUEST FOR RELIEF NO.	NOTES
All	WNP-2 does not have any Class 2 bolting greater than 2 in. diameter.	N/A		



EXAMINATION CATEGORY C-F-1 PRESSURE RETAINING WELDS IN AUSTENITIC STAINLESS STEEL OR HIGH ALLOY PIPING				
ITEM NO.	DESCRIPTION	COMPLIES WITH SECTION XI	REQUEST FOR RELIEF NO.	NOTES
All	WNP-2 does not have any Class 2 austenitic stainless steel or high alloy piping.	N/A		

EXAMINATION CATEGORY C-F-2 PRESSURE RETAINING WELDS IN CARBON AND LOW ALLOY STEEL PIPING				
ITEM NO.	DESCRIPTION	COMPLIES WITH SECTION XI	REQUEST FOR RELIEF NO.	NOTES
C5.50	Piping welds $\geq 3/8$ in. Nominal wall thickness for piping $> \text{NPS4}$			
C5.51	Circumferential weld	Yes		
C5.52	Longitudinal weld	Yes		
C5.60	Not applicable, applies to PWR			
C5.61				
C5.62				
C5.70	Socket welds	Yes		
C5.80	Pipe branch connections of branch piping $\geq \text{NPS2}^*$	Yes		
C5.81	Circumferential weld	Yes		
C5.82	Longitudinal weld	NA		
* $\geq \text{NPS4}$ for BWR				

EXAMINATION CATEGORY C-G PRESSURE RETAINING WELDS IN PUMPS AND VALVES				
ITEM NO.	DESCRIPTION	COMPLIES WITH SECTION XI	REQUEST FOR RELIEF NO.	NOTES
C6.10	Pump Casing Welds	No		See note 1
C6.20	Valve Body Welds WNP-2 does not have any Class 2 valves with body welds.	N/A		

EXAMINATION CATEGORY C-G PRESSURE RETAINING WELDS IN PUMPS AND VALVES				
ITEM NO.	DESCRIPTION	COMPLIES WITH SECTION XI	REQUEST FOR RELIEF NO.	NOTES
<p>Note</p> <p>1. The RHR pumps were designed prior to the requirement to perform Class 2 component examinations for inservice inspection. The pump casings are embedded in a pump pit which allows no access from the outside surface. The upper flange is at floor level. The welds are accessible from the inside, if the pump impeller is removed. Removal of the pump impeller is considered impractical and not in the interest of safety, both from a potential pump damage or reassembly error and from a radiation exposure standpoint. Also per 10CFR50.55a (g) (4) access is not required to be upgraded to the Inservice Inspection Code. Diagram RHR-213 in Section 9.0 illustrates the pump installation details.</p> <p>The welds are inaccessible to all examination methods. If the internals are removed for maintenance the Supply System will evaluate whether inservice examination is practical.</p>				

EXAMINATION CATEGORY C-H ALL PRESSURE RETAINING COMPONENTS				
ITEM NO.	DESCRIPTION	COMPLIES WITH SECTION XI	REQUEST FOR RELIEF NO.	NOTES
C7.10	Pressure Vessels Pressure Retaining Components (System Leakage Test)	Yes		
C7.20	Pressure Retaining Components (System Hydro Test)	Yes		
C7.30	Piping Pressure Retaining Components (System Leakage Test)	Yes		
C7.40	Pressure Retaining Components (System Hydro Test)	Yes		
C7.50	Pumps Pressure Retaining Components (System Leakage Test)	Yes		
C7.60	Pressure Retaining Components (System Hydro Test)	Yes		

EXAMINATION CATEGORY C-H ALL PRESSURE RETAINING COMPONENTS				
ITEM NO.	DESCRIPTION	COMPLIES WITH SECTION XI	REQUEST FOR RELIEF NO.	NOTES
C7.70	Valves Pressure Retaining Components (System Leakage Test)	Yes		
C7.80	Pressure Retaining Components (System Hydro Test)	Yes		

*IWC-3000 Acceptance Standards*

No comments or clarifications.

*IWC-4000 Repair Procedures*

See section 5.3 Repair and Replacement Program

*IWC-5000 System Pressure Tests*

No comments or clarifications.

*IWC-7000 Replacements*

See section 5.3 Repair - Replacement Program

**5.2.4 IWD Requirements for Class 3 Components**

*IWD-1000 Scope and Responsibility*

The exemptions allowed by paragraph IWD-1220 have been applied to each Class 3 system requiring examination under Table IWD 2500-1. The portions of the system where these exemptions have been applied are detailed in the Boundary Diagram tables found after each Boundary Diagram in Section 7.0.

*IWD-2000 Examination and Inspection*

Table IWD-2500-1

EXAMINATION CATEGORY D-A SYSTEM IN SUPPORT OF REACTOR SHUTDOWN FUNCTION				
ITEM NO.	DESCRIPTION	COMPLIES WITH SECTION XI	REQUEST FOR RELIEF NO.	NOTES
D1.10	Pressure Retaining Components	Yes		
D1.20	Integral Attachment - Component Supports and Restraints	Yes		
D1.30	Integral Attachment Mechanical Snubbers	Yes		
D1.40	Integral Attachment Spring type supports	Yes		
D1.50	Integral Attachment Constant load type supports	Yes		
D1.60	Integral Attachment Shock Absorbers	N/A		



Table IWD-2500-1

EXAMINATION CATEGORY D-A SYSTEM IN SUPPORT OF REACTOR SHUTDOWN FUNCTION				
ITEM NO.	DESCRIPTION	COMPLIES WITH SECTION XI	REQUEST FOR RELIEF NO.	NOTES
D1.10	Pressure Retaining Components	Yes		
D1.20	Integral Attachment - Component Supports and Restraints	Yes		
D1.30	Integral Attachment Mechanical Snubbers	Yes		
D1.40	Integral Attachment Spring type supports	Yes		
D1.50	Integral Attachment Constant load type supports	Yes		
D1.60	Integral Attachment Shock Absorbers	N/A		

EXAMINATION CATEGORY D-B, SYSTEMS IN SUPPORT OF EMERGENCY CORE COOLING, CONTAINMENT HEAT REMOVAL, ATMOSPHERE CLEANUP, AND RESIDUAL HEAT REMOVAL				
ITEM NO.	DESCRIPTION	COMPLIES WITH SECTION XI	REQUEST FOR RELIEF NO.	NOTES
D2.10	Pressure Retaining Components	Yes		
D2.20	Integral Attachment - Component Supports and Restraints	No	2ISI-10	
D2.30	Integral Attachment Mechanical Snubbers	Yes		
D2.40	Integral Attachment Spring type supports	Yes		
D2.50	Integral Attachment Constant load type supports	Yes		
D2.60	Integral Attachment Shock Absorbers	N/A		

EXAMINATION CATEGORY D-C SYSTEMS IN SUPPORT OF RESIDUAL HEAT REMOVAL FROM SPENT FUEL STORAGE POOL				
ITEM NO.	DESCRIPTION	COMPLIES WITH SECTION XI	REQUEST FOR RELIEF NO.	NOTES
D3.10	Pressure Retaining Components	Yes		
D3.20	Integral Attachment - Component Supports and Restraints	Yes		
D3.30	Integral Attachment Mechanical Snubbers	Yes		
D3.40	Integral Attachment Spring type supports	Yes		
D3.50	Integral Attachment Constant load type supports	Yes		
D3.60	Integral Attachment Shock Absorbers	N/A		

Table IWD-2500-1 Examination Category D-A

Relief request 2ISI-06

Table IWD-2500-1 Examination Category D-B

Relief request 2ISI-11

Table IWD-2500-1 Examination Category D-C

Relief request 2ISI-11

*IWD-3000 Acceptance Standards*

No comments or clarifications for this section.

*IWD-4000 Repair Procedures*

See section 5.3 Repair and Replacement Program

*IWD-5000 System Pressure Tests*

No comments or clarifications for this section.

*IWD-7000 Replacements*

See section 5.3 Repair and Replacement Program

**5.2.5 IWE Requirements for Class MC Components**

This subsection of the Reference Code has not been approved for use by the NRC, therefore it is not addressed in this ISI Program Plan. Repair and replacement work on the containment will be performed per Code Case N-236-1. See section 5.3.

**5.2.6 IWF Requirements for Class 1, 2, 3, and MC Component Supports**

*IWF-1000 Scope and Responsibility (Use Code Case N-491)*

WNP-2 will apply the exemptions described in -1230 of Code Case N-491 to all component supports. WNP-2's position on inaccessible supports encapsulated by guard pipe includes pipe supports that are within concrete wall penetrations were the penetrations are filled with fire seal foam. The fire seal makes the support inaccessible to examination.

*IWF-2000 Examination and Inspection (Use Code Case N-491)*

Table IWF-2500-1 identifies the item numbers associated with each component support. The table requires, per note (1), the owner to add an identifying symbol to the end of each item number to distinguish between the different types of supports (springs, one dimensional, etc.). To comply with this requirement, the following item numbers will be used:

F1.10A	Class 1 piping support rigid, rod, anchor, strut
F1.10B	Class 1 piping support constant load type support
F1.10C	Class 1 piping support spring
F1.10D	Class 1 piping support snubber
F1.20A	Class 2 piping support rigid, rod, anchor, strut
F1.20B	Class 2 piping support constant load type support
F1.20C	Class 2 piping support spring
F1.20D	Class 2 piping support snubber
F1.30A	Class 3 piping support rigid, rod, anchor, strut
F1.30B	Class 3 piping support constant load type support
F1.30C	Class 3 piping support spring
F1.30D	Class 3 piping support snubber
F1.40A	Supports other than piping rigid, rod, anchor, strut
F1.40B	Supports other than piping constant load type support
F1.40C	Supports other than piping spring
F1.40D	Supports other than piping snubber

EXAMINATION CATEGORY F-A SUPPORTS				
ITEM NO.	DESCRIPTION	COMPLIES WITH SECTION XI	REQUEST FOR RELIEF NO.	NOTES
F1.10 F1.10A F1.10B F1.10C F1.10D	Class 1 Piping Supports rigid, rod, anchor, strut constant load type support spring snubber	Yes		The item numbers are from Code Case N-491.
F1.20 F1.20A F1.20B F1.20C F1.20D	Class 2 Piping Supports rigid, rod, anchor, strut constant load type support spring snubber	Yes		
F1.30 F1.30A F1.30B F1.30C F1.30D	Class 3 Piping Supports rigid, rod, anchor, strut constant load type support spring snubber	Yes		
F1.40 F1.40A F1.40B F1.40C F1.40D	Supports Other than Piping Supports (Class 1, 2, 3, and MC) rigid, rod, anchor, strut constant load type support spring snubber	Yes		

*IWF-3000 Standards for Examination Evaluation (Use Code Case N-491)*

Code Case N-491 will be used in place of this article.

*IWF-4000 Repair Procedures (Use ASME Section XI, 1989 Edition, no Addenda)*

See section 5.3 Repair and Replacement Program

*IWF-5000 Inservice Inspection Requirements for Snubbers (Use ASME Section XI, 1989 Edition, no Addenda)*

IWF-5300(b) requires inservice tests of snubbers to be conducted per ASME/ANSI OM (Part 4), 1987 Code. The NRC has not approved the use of this Code for snubber testing. WNP-2 will continue to test its safety-related snubbers to the Technical Specification requirements. No relief request is required since the test requirements referenced by this paragraph of the Code have not been approved by the NRC (see Federal Register, Volume 57 No. 152 starting page 34666, dated August 6, 1992).

*IWF-7000 Replacements*

See section 5.3 Repair - Replacement Program

**5.2.7 RPV Visual (proposed Article IWG)**

The requirements for RPV internal examination are contained in category B-N-1, B-N-2 and augmented requirements found in section 6.0.

**5.2.8 Erosion/Corrosion**

Addressed in "WNP-2 Pipe Wall Thinning Program Plan" issued internally as a separate document.

**5.2.9 IWL**

This subsection of the Reference Code is not applicable to WNP-2. WNP-2 containment is class MC not CC.

**5.2.10 IWP**

Pump testing is addressed in the "WNP-2 Pump and Valve Program Plan" issued as a separate document.

**5.2.11 IWV**

Valve testing is addressed in the "WNP-2 Pump and Valve Program Plan" issued as a separate

document.

**5.2.12 Appendix I**

No comments or clarifications for this section.

**5.2.13 Appendix II**

The Supply System will issue NIS-1 and NIS-2 forms that contains the information found on these sample forms.

**5.2.14 Appendix III**

No comments or clarifications for this section.

**5.2.15 Appendix IV**

WNP-2 is a boiling water reactor (BWR) and does not have a steam generator. This appendix is not applicable to this plant.

**5.2.16 Appendix V**

This appendix addresses inquiries to the ASME Boiler and Pressure Vessel Committee. WNP-2 will follow this appendix in its inquiries to the Committee.

**5.2.17 Appendix VI**

No comments or clarifications for this section.

**5.2.18 Appendix VII**

No comments or clarifications for this section.

**5.2.19 Appendix VIII**

This Appendix is not included in the Reference Code.

**5.2.20 Non-mandatory Appendices**

Non-mandatory Appendix F has been used for guidance in preparing this ISI Program Plan. Appendix J from the 1992 Edition of ASME Section XI will be used for guidance in the repair and replacement program.



### 5.3 Repair and Replacement Program

Repair and replacement requirements of ASME Section III components are found in several articles of ASME Section XI. This section will describe the WNP-2 repair and replacement program. Requirements are found in the following:

#### ASME Section XI

IWA-4000, IWA-7000  
IWB-4000, IWB-7000  
IWC-4000, IWC-7000  
IWD-4000, IWD-7000  
IWF-4000, IWF-7000

#### Code Cases

N-236-1 Repair and Replacement of Class MC Vessels  
N-416-1 Alternate Pressure Test Requirements for Welded Repairs or Installation of Replacement Items by Welding, Class 1, 2 and 3 Section XI, Division 1  
N-389 Alternative Rules for Repairs, Replacements, or Modifications, Section XI, Division 1

Guidance for repairs and replacements is found in the following:

#### ASME Section XI

Appendix J, 1992 Edition

#### Generic Letters

89-09 ASME Section III Component Replacement  
90-05 Guidance for Performing Temporary Non-Code Repair of ASME Code Class 1, 2, and 3 Piping

A repair or replacement plan will be prepared for each repair or replacement or series of similar repair or replacement per the Reference Code. The plan may be a generic procedure (i.e., repair of pumps and valves). The repair or replacement plan will generally conform to the ASME Section III edition and addenda the component was constructed to. If this construction Code is not used, the Supply System will reconcile the Code used for the repair or replacement with the construction Code.

Repairs or replacements, including modifications, to ASME Section III Code Class 1, 2, and 3 components and NF supports will be performed under the rules of the referenced Code. Repairs or replacements to ASME Section III Code Class MC components will be performed using Code Case N-236 "Repairs and Replacements of Class MC Vessels".

Temporary non Code repairs will be considered on a case-by-case basis. Guidance from Generic Letter 90-05 will be used.

Replacements for piping systems, components, parts, and appurtenances which were originally constructed to ASME Section III, Code Class 1, 2, and 3 requirements, but are not available in full compliance with the stamping and documentation requirements of ASME Section III, will be procured in accordance with Generic Letter 89-09.

The Supply System intends to use Appendix J "Guide to Plant Maintenance Activities and Section XI Repairs and Replacements" from ASME Section XI, 1992 Edition. Guidance from this appendix will be used to assist the Supply System to determine the applicability of Article IWA-4000 for repairs and Article IWA-7000 for replacements.

## 6.0 FSAR - NRC COMMITMENTS

### 6.1 INTRODUCTION

This section of the ISI Program Plan contains inservice inspection commitments between WNP-2 and the Nuclear Regulatory Commission (Commission) which are outside the scope of ASME Section XI. These commitments are found in the Final Safety Analysis Report (FSAR) and WNP-2 responses to regulatory documents like Generic Letters, Inspection Bulletins, Regulatory Guides and plant specific issues. Since this section is not required by ASME Section XI the examinations performed to this section, unless they are also used to comply with ASME Section requirements, are not reviewed or concurred with by the Authorized Nuclear Inservice Inspector (ANII).

### 6.2 FSAR COMMITMENTS

The Supply System committed in the WNP-2 FSAR to perform inservice inspections pursuant to the requirements of 10CFR50.55a(g). Based on this commitment the mandatory inservice inspection Code is defined in section 5.0. Compliance to this Code is described in section 5.0.

- |   |   |
|---|---|
| 6.2.1 FSAR Section 3.6.2.1.2.1(a)<br>FSAR Section 5.2.4.9 | Augmented High Energy Piping Examination<br>Augmented Inservice Inspection to Protect Against<br>Postulated Piping Failures |
|---|---|

These sections of the FSAR committed the Supply System to a program of augmented inservice inspection to provide 100% examination, each inspection interval, of all pressure boundary welds in high energy piping systems exceeding one inch nominal diameter between containment isolation valves.

Augmented inservice inspections will be implemented on high energy piping systems which penetrate containment for which the effects of postulated pipe breaks would be unacceptable. This program will entail a volumetric examination of all circumferential butt welds (surface examination for socket welds) between the first pipe whip restraint beyond the inside containment isolation valve, and the first pipe whip restraint beyond the outside containment isolation valve on high energy lines greater than one inch which penetrate the containment. (see Fig. 6.1.2A) If there is no inside/outside containment isolation valve, the augmented inservice inspection will extend to the first pipe whip restraint beyond the containment penetration or up to the Class 2 boundary, whichever comes first. (see Fig. 6.1.2B and Fig. 6.1.2C) If there is no pipe whip restraint located beyond the inside/outside containment isolation valve, the augmented inservice inspection boundary will extend to the isolation valve. (see Fig. 6.1.2D) Where two containment isolation valves in series are located outside containment, the above criteria will be applied to the outermost valve. (see Fig. 6.1.2E)

This program will include branch lines which fall within the augmented inservice inspection boundary to the first pipe whip restraint beyond the branch line isolation valve or the first normally closed valve, whichever comes first. (see Fig. 6.1.2A)



If no pipe whip restraint and/or isolation (normally closed) valve is located on the branch line, the same criteria stated above for main run line will be applied.

The augmented inservice inspection boundary is identified on ISI Boundary Diagrams and on Weld and Component Identification Diagrams in Section 9.0 as follows:

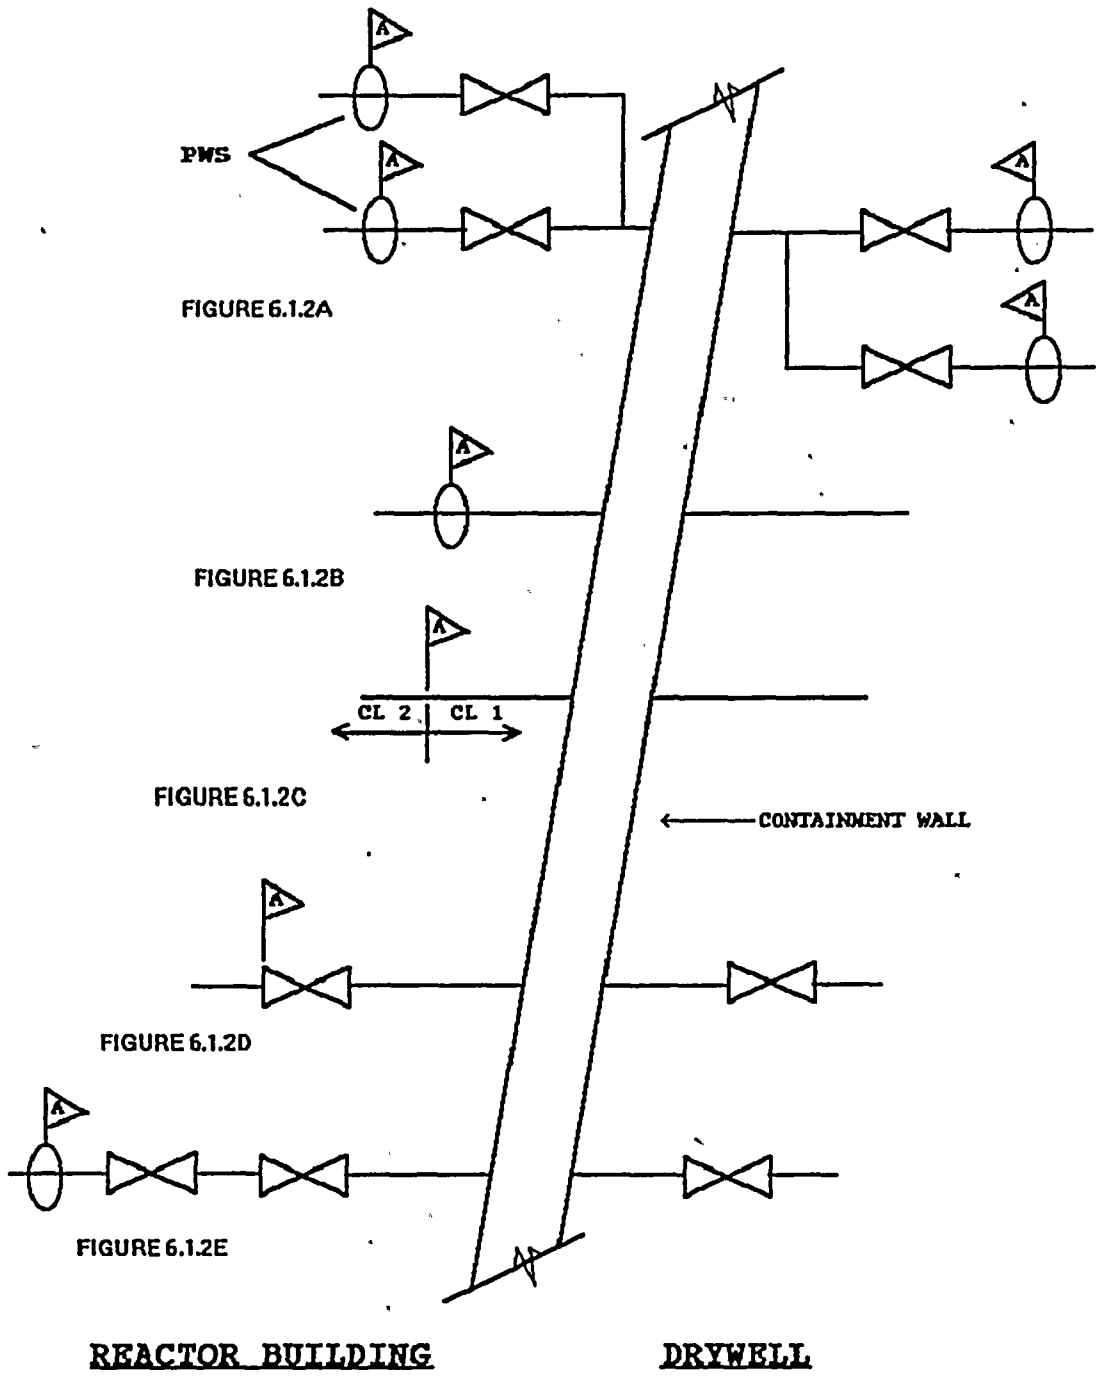


Figure 6.1.1  
 Augmented ISI Boundary  
 for High Energy Piping

Augmented inservice inspection will be implemented on high energy piping systems associated with the following penetrations:

Penetration No.	System	Boundary Diagram (Sec. 9.0)	Location
X-18A	Main Steam	ISI-229-1A	C-8
X-18B	Main Steam	ISI-229-1A	E-8
X-18C	Main Steam	ISI-229-2A	C-3
X-18D	Main Steam	ISI-229-2A	E-3
X-21	RCIC	ISI-219-1	D-9
X-45	RCIC	ISI-219-1	G-8
X-17A	RFW	ISI-229-1A	C-8
X-17B	RFW	ISI-229-1B	C-3
X-14	RWCU	ISI-223-1	C-2

These examinations will be done once each inspection interval.



REACTOR BUILDING

DRYWELL

Figure 6.1.2  
Augmented High Energy  
Examination Line Boundary

6.2.2 FSAR Section 3.9.3.4  
 Section 3.9.3.4.1.e

 Component Supports  
 Operability Assurance of Snubbers

This FSAR section committed to providing a list of safety-related snubbers in the ISI Program Plan and to specify snubber inspection, testing, accessibility, maintenance and repair/replacement requirements. The list of safety-related snubbers is provided in Table 6.2.1. The snubber examination, testing and maintenance program is defined in Plant Procedures 7.4.7.4.1 "Snubber Visual Inspection and Acceptance Criteria", 7.4.7.4.2 "Snubber Functional Test and Acceptance Criteria", and 10.2.29 "Installation, Modification and Inspection of Pipe Supports". The examination and testing requirements are found in Technical Specification 3/4.7.4.

Table 6.2.1 Safety Related Snubbers					
Identification No.	Pos.	Description	Diagram No.	Pg	Accessible
CEP-905S	UA	PSA-1/2 SNUBBER	CEP-201		Y
CEP-907S	UA	PSA-1/2 SNUBBER	CEP-201		Y
CEP-908N	UA	PSA-3 SNUBBER	CEP-202		Y
DE-2	UA	PSA-3 SNUBBER	DE-405	01	Y
DE-23	UA	PSA-3 SNUBBER	DE-403		Y
DE-2836-15	UA	PSA-1/2 SNUBBER	DE-405	02	Y
DE-2837-17	UA	PSA-1/4 SNUBBER	DE-403		Y
DE-2838-18	UA	PSA-1/4 SNUBBER	DE-404	02	Y
DE-2839-14B	UA	PSA-1/4 SNUBBER	DE-401	02	Y
DE-3	E	PSA-3 SN(2)	DE-405		Y
DE-3	W	PSA-3 SN(2)	DE-405		Y
DE-49	UA	PSA-3 SNUBBER	DE-404		Y
DE-57	UA	PSA-3 SNUBBER	DE-402		Y
DE-59	UA	PSA-3 SNUBBER	DE-401	01	Y
DE-902N	BM	PSA-1 SN(2)	DE-405		Y
DE-902N	TP	PSA-1 SN(2)	DE-405		Y
EDR-903N	N	PSA-1/2 SN(2)	EDR-201		Y
EDR-903N	S	PSA-1/2 SN(2)	EDR-201		Y
EDR-905N	UA	PSA-1 SNUBBER	EDR-201		Y
FPC-227	UA	PSA-3 SNUBBER	FPC-305	09	Y

Table 6.2.1 Safety Related Snubbers					
Identification No.	Pos.	Description	Diagram No.	Pg	Accessible
FPC-43	UA	PSA-3 SNUBBER	FPC-301	08	Y
FPC-65	UA	PSA-1 SNUBBER	FPC-301	04	Y
FPC-908N	E	PSA-1 SN(2)	FPC-301	08	Y
FPC-908N	W	PSA-1 SN(2)	FPC-301	08	Y
FPC-918N	UA	PSA-1 SNUBBER	FPC-301	04	Y
HPCS-47	N	PSA-3 SN(2)	HPCS-201	02	Y
HPCS-47	S	PSA-3 SN(2)	HPCS-201	02	Y
HPCS-905N	UA	PSA-10 SNUBBER	HPCS-202	06	Y
HPCS-924N	E	PSA-3 SN(2)	HPCS-202	06	Y
HPCS-924N	W	PSA-3 SN(2)	HPCS-202	06	Y
HPCS-925N	UA	PSA-3 SNUBBER	HPCS-202	06	Y
HY-4235-110	UA	PSA-1/4 SNUBBER	HY-201		Y
HY-4236-110	UA	PSA-1/4 SNUBBER	HY-202		Y
HY-4237-110	UA	PSA-1/4 SNUBBER	HY-203		Y
LPCS-28	UA	PSA-3 SNUBBER	LPCS-101	01	Y
MD-1285-11B	UA	PSA-1/4 SNUBBER	MD-201		N
MD-1285-14A	UA	PSA-1/2 SNUBBER	MD-201		N
MD-1285-14C	UA	PSA-1/4 SNUBBER	MD-204		N
MD-1285-14D	UA	PSA-1/2 SNUBBER	MD-204		N
MD-1287-11	UA	PSA-1/4 SNUBBER	MD-202		N
MD-1287-15	UA	PSA-1 SNUBBER	MD-202		N
MD-1288-17	UA	PSA-1 SNUBBER	MD-203		N
MD-1288-18	UA	PSA-1/4 SNUBBER	MD-203		N
MD-1290-11B	UA	PSA-1/4 SNUBBER	MD-204		N
MD-1364-12A	UA	PSA-1/4 SNUBBER	MD-206		N
MD-74	UA	PSA-1 SNUBBER	MD-205		N
MS-1001N	UA	PSA-35 SNUBBER	MS-203	02	N
MS-1002N	N	PSA-10 SN(2)	MS-203	02	N
MS-1002N	S	PSA-10 SN(2)	MS-203	02	N



Table 6.2.1 Safety Related Snubbers					
Identification No.	Pos.	Description	Diagram No.	Pg	Accessible
MS-1003N	E	PSA-10 SN(2)	MS-203	01	N
MS-1003N	W	PSA-10 SN(2)	MS-203	01	N
MS-1005N	UA	PSA-35 SNUBBER	MS-204	04	N
MS-114	N	PSA-10 SN(2)	MS-201	02	N
MS-114	S	PSA-10 SN(2)	MS-201	02	N
MS-135	UA	PSA-35 SNUBBER	MS-201	01	N
MS-1368-12	UA	PSA-1/2 SNUBBER	MS-105	02	N
MS-1368-13	UA	PSA-1/2 SNUBBER	MS-105	02	N
MS-1369-12	UA	PSA-1/2 SNUBBER	MS-105	03	N
MS-1369-13	UA	PSA-1/2 SNUBBER	MS-105	03	N
MS-145	UA	PSA-10 SNUBBER	MS-202	04	N
MS-147	N	PSA-35 SN(2)	MS-202	03	N
MS-147	S	PSA-35 SN(2)	MS-202	03	N
MS-148	UA	PSA-10 SNUBBER	MS-202	03	N
MS-151	BM	PSA-3 SN(2)	MS-202	03	N
MS-151	TP	PSA-3 SN(2)	MS-202	03	N
MS-162	BM	PSA-10 SN(2)	MS-202	02	N
MS-162	TP	PSA-10 SN(2)	MS-202	02	N
MS-167	BM	PSA-10 SN(2)	MS-202	02	N
MS-167	TP	PSA-10 SN(2)	MS-202	02	N
MS-174	UA	PSA-35 SNUBBER	MS-202	01	N
MS-177	N	PSA-3 SN(2)	MS-202	03	N
MS-177	S	PSA-3 SN(2)	MS-202	03	N
MS-255	UA	PSA-1 SNUBBER	MS-206		N
MS-2619-11	UA	PSA-1/4 SNUBBER	MS-106	01	N
MS-2619-13	UA	PSA-1 SNUBBER	MS-106	01	N
MS-2619-42C	UA	PSA-1/2 SNUBBER	MS-106	04	N
MS-2619-45	UA	PSA-1/4 SNUBBER	MS-106	04	N
MS-27	BM	PSA-10 SN(2)	MS-203	03	N



Table 6.2.1 Safety Related Snubbers					
Identification No.	Pos.	Description	Diagram No.	Pg	Accessible
MS-27	TP	PSA-10 SN(2)	MS-203	03	N
MS-38	BM	PSA-10 SN(2)	MS-203	02	N
MS-38	TP	PSA-10 SN(2)	MS-203	02	N
MS-4448-12	UA	PSA-1/4 SNUBBER	MS-108		N
MS-4448-413	UA	PSA-1/4 SNUBBER	MS-109		N
MS-4448-46	UA	PSA-1/4 SNUBBER	MS-109		N
MS-45	UA	PSA-35 SNUBBER	MS-203	01	N
MS-48	UA	PSA-3 SNUBBER	MS-203	03	N
MS-72	UA	PSA-35 SNUBBER	MS-204	11	N
MS-91	E	PSA-3 SN(2)	MS-201	03	N
MS-91	W	PSA-3 SN(2)	MS-201	03	N
MS-954N	UA	PSA-3 SNUBBER	MS-206		N
MS-96	BM	PSA-10 SN(2)	MS-201	03	N
MS-96	TP	PSA-10 SN(2)	MS-201	03	N
MS-993N	BM	PSA-10 SN(2)	MS-201	02	N
MS-993N	TP	PSA-10 SN(2)	MS-201	02	N
MS-996N	BM	PSA-10 SN(2)	MS-202	02	N
MS-996N	TP	PSA-10 SN(2)	MS-202	02	N
MS-998N	N	PSA-10 SN(2)	MS-202	02	N
MS-998N	S	PSA-10 SN(2)	MS-202	02	N
MS-999N	UA	PSA-10 SNUBBER	MS-203	03	N
MS-SC-1	UA	PSA-100 SNUBBER	MS-103	02	N
MS-SC-10	UA	PSA-35 SNUBBER	MS-103	01	N
MS-SC-2	UA	PSA-100 SNUBBER	MS-103	02	N
MS-SC-3	UA	PSA-35 SNUBBER	MS-103	02	N
MS-SC-4	UA	PSA-35 SNUBBER	MS-103	02	N
MS-SC-5	UA	PSA-35 SNUBBER	MS-103	01	N
MS-SC-6	UA	PSA-35 SNUBBER	MS-103	01	N
MS-SC-7	UA	PSA-35 SNUBBER	MS-103	01	N

Table 6.2.1 Safety Related Snubbers					
Identification No.	Pos.	Description	Diagram No.	Pg	Accessible
MS-SC-8	UA	PSA-35 SNUBBER	MS-103	01	N
MS-SC-9	UA	PSA-35 SNUBBER	MS-103	01	N
MSLC-2821-12	BM	PSA-1/4 SN(2)	MSLC-102		N
MSLC-2821-12	TP	PSA-1/4 SN(2)	MSLC-102		N
MSLC-2821-22	UA	PSA-1 SNUBBER	MSLC-202		N
MSRV-1A-3	UA	PSA-10 SNUBBER	MS-301	01	N
MSRV-1B-2	UA	PSA-10 SNUBBER	MS-305	01	N
MSRV-1C-1	UA	PSA-10 SNUBBER	MS-310	01	N
MSRV-1C-2	UA	PSA-35 SNUBBER	MS-310	01	N
MSRV-1C-3	UA	PSA-35 SNUBBER	MS-310	01	N
MSRV-1C-4	UA	PSA-10 SNUBBER	MS-310	02	N
MSRV-1C-5	UA	PSA-10 SNUBBER	MS-310	02	N
MSRV-1C-7	UA	PSA-10 SNUBBER	MS-310	01	N
MSRV-1D-3	UA	PSA-10 SNUBBER	MS-315	02	N
MSRV-2A-2	UA	PSA-10 SNUBBER	MS-302	01	N
MSRV-2B-3	UA	PSA-35 SNUBBER	MS-306	01	N
MSRV-2C-1	UA	PSA-10 SNUBBER	MS-311	01	N
MSRV-2C-2	UA	PSA-10 SNUBBER	MS-311	01	N
MSRV-2C-3	UA	PSA-10 SNUBBER	MS-311	01	N
MSRV-2C-4	UA	PSA-10 SNUBBER	MS-311	02	N
MSRV-2C-5	UA	PSA-10 SNUBBER	MS-311	02	N
MSRV-2C-6	UA	PSA-10 SNUBBER	MS-311	02	N
MSRV-2C-7	UA	PSA-10 SNUBBER	MS-311	03	N
MSRV-2C-8	UA	PSA-10 SNUBBER	MS-311	01	N
MSRV-2C-9	UA	PSA-10 SNUBBER	MS-311	02	N
MSRV-2D-2	UA	PSA-10 SNUBBER	MS-316	01	N
MSRV-3A-2	UA	PSA-10 SNUBBER	MS-303	01	N
MSRV-3B-2	UA	PSA-10 SNUBBER	MS-307	01	N
MSRV-3B-3	UA	PSA-10 SNUBBER	MS-307	01	N

Table 6.2.1 Safety Related Snubbers					
Identification No.	Pos.	Description	Diagram No.	Pg	Accessible
MSRV-3C-1	UA	PSA-35 SNUBBER	MS-312	01	N
MSRV-3C-2	UA	PSA-10 SNUBBER	MS-312	01	N
MSRV-3C-3	UA	PSA-10 SNUBBER	MS-312	01	N
MSRV-3C-5	UA	PSA-10 SNUBBER	MS-312	02	N
MSRV-3C-6	UA	PSA-10 SNUBBER	MS-312	02	N
MSRV-3C-7	UA	PSA-10 SNUBBER	MS-312	02	N
MSRV-3C-8	UA	PSA-10 SNUBBER	MS-312	02	N
MSRV-3D-4	UA	PSA-10 SNUBBER	MS-317	01	N
MSRV-4A-2	UA	PSA-10 SNUBBER	MS-304	01	N
MSRV-4B-3	UA	PSA-10 SNUBBER	MS-308	01	N
MSRV-4C-1	UA	PSA-10 SNUBBER	MS-313	01	N
MSRV-4C-2	UA	PSA-10 SNUBBER	MS-313	01	N
MSRV-4C-3	UA	PSA-10 SNUBBER	MS-313	01	N
MSRV-4C-5	UA	PSA-10 SNUBBER	MS-313	02	N
MSRV-4C-6	UA	PSA-10 SNUBBER	MS-313	02	N
MSRV-4C-7	UA	PSA-10 SNUBBER	MS-313	02	N
MSRV-4C-8	UA	PSA-35 SNUBBER	MS-313	02	N
MSRV-4C-9	E	PSA-3 SN(2)	MS-313	03	N
MSRV-4C-9	W	PSA-3 SN(2)	MS-313	03	N
MSRV-4D-2	UA	PSA-10 SNUBBER	MS-318	01	N
MSRV-5B-3	UA	PSA-10 SNUBBER	MS-309	01	N
MSRV-5C-1	UA	PSA-10 SNUBBER	MS-314	01	N
MSRV-5C-2	UA	PSA-10 SNUBBER	MS-314	01	N
MSRV-5C-3	UA	PSA-35 SNUBBER	MS-314	01	N
MSRV-5C-4	UA	PSA-35 SNUBBER	MS-314	02	N
MSRV-5C-5	UA	PSA-10 SNUBBER	MS-314	02	N
MSRV-5C-6	UA	PSA-10 SNUBBER	MS-314	02	N
MSRV-5C-7	UA	PSA-10 SNUBBER	MS-314	02	N
MSRV-5C-8	UA	PSA-35 SNUBBER	MS-314	02	N

Table 6.2.1 Safety Related Snubbers					
Identification No.	Pos.	Description	Diagram No.	Pg	Accessible
MSRV-5C-9	UA	PSA-10 SNUBBER	MS-314	03	N
RCIC-1	UA	PSA-1 SNUBBER	RCIC-203	01	Y
RCIC-100	E	PSA-1/2 SN(2)	RCIC-205	6A	Y
RCIC-100	W	PSA-1/2 SN(2)	RCIC-205	6A	Y
RCIC-1490-13	UA	PSA-1/2 SNUBBER	RCIC-206	01	Y
RCIC-1C-6	E	PSA-3 SN(2)	RCIC-101	02	N
RCIC-1C-6	W	PSA-3 SN(2)	RCIC-101	02	N
RCIC-1C-9	UA	PSA-10 SNUBBER	RCIC-101	01	N
RCIC-2562-25	UA	PSA-1/2 SNUBBER	RCIC-213		Y
RCIC-26	UA	PSA-3 SNUBBER	RCIC-203	03	Y
RCIC-38	E	PSA-1 SN(2)	RCIC-201	01	Y
RCIC-38	W	PSA-1 SN(2)	RCIC-201	01	Y
RCIC-4	UA	PSA-1 SNUBBER	RCIC-203	02	Y
RCIC-943N	UA	PSA-10 SNUBBER	RCIC-201	01	Y
RCIC-944N	BM	PSA-3 SN(2)	RCIC-201	01	Y
RCIC-944N	TP	PSA-3 SN(2)	RCIC-201	01	Y
RCIC-945N	UA	PSA-10 SNUBBER	RCIC-201	01	Y
RCIC-948N	E	PSA-3 SN(2)	RCIC-102	01	Y
RCIC-948N	W	PSA-3 SN(2)	RCIC-102	01	Y
RCIC-961N	UA	PSA-1/4 SNUBBER	RCIC-201	02	Y
RCIC-968S	UA	PSA-1 SNUBBER	RCIC-103		N
RCIC-971N	UA	PSA-1 SNUBBER	RCIC-203	02	Y
RFW-146	NE	PSA-10 SN(2)	RFW-101	01	N
RFW-146	SW	PSA-10 SN(2)	RFW-101	01	N
RFW-151	UA	PSA-35 SNUBBER	RFW-101	03	N
RFW-162	E	PSA-10 SN(2)	RFW-102	01	N
RFW-162	W	PSA-10 SN(2)	RFW-102	01	N
RFW-171	UA	PSA-10 SNUBBER	RFW-102	03	N
RFW-180	UA	PSA-1 SNUBBER	RFW-103		N

Table 6.2.1 Safety Related Snubbers					
Identification No.	Pos.	Description	Diagram No.	Pg	Accessible
RFW-915N	UA	PSA-10 SNUBBER	RFW-102	03	N
RFW-929N	UA	PSA-10 SNUBBER	RFW-101	03	N
RFW-942N	BM	PSA-1 SN(2)	RFW-103		N
RFW-942N	TP	PSA-1 SN(2)	RFW-103		N
RHR-1000N	UA	PSA-3 SNUBBER	RHR-201	03	Y
RHR-1001N	N	PSA-3 SN(2)	RHR-201	03	Y
RHR-1001N	S	PSA-3 SN(2)	RHR-201	03	Y
RHR-1002N	BM	PSA-3 SN(2)	RHR-207	04	Y
RHR-1002N	TP	PSA-3 SN(2)	RHR-207	04	Y
RHR-1021N	E	PSA-3 SN(2)	RHR-210	01	Y
RHR-1021N	W	PSA-3 SN(2)	RHR-210	01	Y
RHR-1022N	N	PSA-35 SN(2)	RHR-201	11	Y
RHR-1022N	S	PSA-35 SN(2)	RHR-201	11	Y
RHR-121	E	PSA-10 SN(2)	RHR-206	01	Y
RHR-121	W	PSA-10 SN(2)	RHR-206	01	Y
RHR-137	E	PSA-10 SN(2)	RHR-205	04	Y
RHR-137	W	PSA-10 SN(2)	RHR-205	04	Y
RHR-142	E	PSA-1 SN(2)	RHR-201	04	Y
RHR-142	W	PSA-1 SN(2)	RHR-201	04	Y
RHR-150	NW	PSA-3 SN(2)	RHR-203	03	Y
RHR-150	SE	PSA-3 SN(2)	RHR-203	03	Y
RHR-160	UA	PSA-3 SNUBBER	RHR-201	01	Y
RHR-183	E	PSA-10 SN(2)	RHR-207	18	Y
RHR-183	W	PSA-10 SN(2)	RHR-207	18	Y
RHR-20	UA	PSA-1/2 SNUBBER	RHR-208	03	Y
RHR-200	UA	PSA-1/2 SNUBBER	RHR-222		Y
RHR-206	UA	PSA-1 SNUBBER	RHR-221		Y
RHR-210	UA	PSA-1/2 SNUBBER	RHR-221	01	Y
RHR-214	UA	PSA-1/2 SNUBBER	RHR-221	01	Y

Table 6.2.1 Safety Related Snubbers					
Identification No.	Pos.	Description	Diagram No.	Pg	Accessible
RHR-218	E	PSA-10 SN(2)	RHR-207	15	Y
RHR-218	W	PSA-10 SN(2)	RHR-207	15	Y
RHR-2264-11	UA	PSA-1/4 SNUBBER	RHR-108		N
RHR-2264-22	UA	PSA-1 SNUBBER	RHR-108		N
RHR-23	E	PSA-1/4 SN(2)	RHR-228		Y
RHR-23	W	PSA-1/4 SN(2)	RHR-228		Y
RHR-235	UA	PSA-10 SNUBBER	RHR-201	08	Y
RHR-244	UA	PSA-35 SNUBBER	RHR-201	11	Y
RHR-256	UA	PSA-35 SNUBBER	RHR-202	02	Y
RHR-260	UA	PSA-10 SNUBBER	RHR-201	11	Y
RHR-264	N	PSA-3 SN(2)	RHR-201	07	Y
RHR-264	S	PSA-3 SN(2)	RHR-201	07	Y
RHR-269	UA	PSA-3 SNUBBER	RHR-201	07	Y
RHR-270	UA	PSA-3 SNUBBER	RHR-201	07	Y
RHR-271	N	PSA-3 SN(2)	RHR-201	07	Y
RHR-271	S	PSA-3 SN(2)	RHR-201	07	Y
RHR-273	UA	PSA-3 SNUBBER	RHR-203	01	Y
RHR-274	UA	PSA-3 SNUBBER	RHR-203	01	Y
RHR-275	UA	PSA-3 SNUBBER	RHR-203	01	Y
RHR-276	N	PSA-3 SN(2)	RHR-203	01	Y
RHR-276	S	PSA-3 SN(2)	RHR-203	01	Y
RHR-277	UA	PSA-3 SNUBBER	RHR-203	01	Y
RHR-282	UA	PSA-35 SNUBBER	RHR-103		N
RHR-286	E	PSA-10 SN(2)	RHR-103		N
RHR-286	W	PSA-10 SN(2)	RHR-103		N
RHR-287	UA	PSA-35 SNUBBER	RHR-103		N
RHR-290	UA	PSA-1/2 SNUBBER	RHR-221	02	Y
RHR-301	UA	PSA-3 SNUBBER	RHR-210	01	Y
RHR-311	E	PSA-3 SN(2)	RHR-210	01	Y



Table 6.2.1 Safety Related Snubbers					
Identification No.	Pos.	Description	Diagram No.	Pg	Accessible
RHR-311	W	PSA-3 SN(2)	RHR-210	01	Y
RHR-325	UA	PSA-1/2 SNUBBER	RHR-232		Y
RHR-326	E	PSA-1/4 SN(2)	RHR-232	01	Y
RHR-326	W	PSA-1/4 SN(2)	RHR-232	01	Y
RHR-332	UA	PSA-1 SNUBBER	RHR-232		Y
RHR-333	UA	PSA-1/2 SNUBBER	RHR-232	02	Y
RHR-334	UA	PSA-1/4 SNUBBER	RHR-232		Y
RHR-345	E	PSA-1 SN(2)	RHR-210	03	Y
RHR-345	W	PSA-1 SN(2)	RHR-210	03	Y
RHR-357	UA	PSA-10 SNUBBER	RHR-201	05	Y
RHR-359	UA	PSA-3 SNUBBER	RHR-201	05	Y
RHR-361	UA	PSA-3 SNUBBER	RHR-201	05	Y
RHR-373	UA	PSA-1 SNUBBER	RHR-232		Y
RHR-381	E	PSA-10 SN(2)	RHR-101		N
RHR-381	W	PSA-10 SN(2)	RHR-101		N
RHR-382	UA	PSA-35 SNUBBER	RHR-101		N
RHR-383	UA	PSA-35 SNUBBER	RHR-101		N
RHR-388	E	PSA-10 SN(2)	RHR-102		N
RHR-388	W	PSA-10 SN(2)	RHR-102		N
RHR-389	UA	PSA-35 SNUBBER	RHR-102		N
RHR-39	N	PSA-3 SN(2)	RHR-211	01	Y
RHR-39	S	PSA-3 SN(2)	RHR-211	01	Y
RHR-390	UA	PSA-35 SNUBBER	RHR-102		N
RHR-400	UA	PSA-1/2 SNUBBER	RHR-233		Y
RHR-401	BM	PSA-1/2 SN(2)	RHR-233	04	Y
RHR-401	TP	PSA-1/2 SN(2)	RHR-233	04	Y
RHR-403	UA	PSA-1 SNUBBER	RHR-233	04	Y
RHR-405	UA	PSA-3 SNUBBER	RHR-203	01	Y
RHR-406	UA	PSA-3 SNUBBER	RHR-203	01	Y

Table 6.2.1 Safety Related Snubbers					
Identification No.	Pos.	Description	Diagram No.	Pg	Accessible
RHR-414	N	PSA-3 SN(2)	RHR-203	02	Y
RHR-414	S	PSA-3 SN(2)	RHR-203	02	Y
RHR-416	BM	PSA-10 SN(2)	RHR-203	02	Y
RHR-416	TP	PSA-10 SN(2)	RHR-203	02	Y
RHR-419	E	PSA-3 SN(2)	RHR-203	03	Y
RHR-419	W	PSA-3 SN(2)	RHR-203	03	Y
RHR-42	UA	PSA-3 SNUBBER	RHR-211	03	Y
RHR-437	N	PSA-3 SN(2)	RHR-207	07	Y
RHR-437	S	PSA-3 SN(2)	RHR-207	07	Y
RHR-442	UA	PSA-1/2 SNUBBER	RHR-233	01	Y
RHR-443	UA	PSA-1/2 SNUBBER	RHR-233	01	Y
RHR-448	UA	PSA-1/2 SNUBBER	RHR-233		Y
RHR-449	N	PSA-1/2 SN(2)	RHR-233		Y
RHR-449	S	PSA-1/2 SN(2)	RHR-233		Y
RHR-453	UA	PSA-1/4 SNUBBER	RHR-233	03	Y
RHR-454	UA	PSA-1/2 SNUBBER	RHR-233	03	Y
RHR-4605-41A	UA	PSA-1/4 SNUBBER	RHR-217	04	Y
RHR-463	UA	PSA-3 SNUBBER	RHR-207	09	Y
RHR-465	N	PSA-3 SN(2)	RHR-207	09	Y
RHR-465	S	PSA-3 SN(2)	RHR-207	09	Y
RHR-466	UA	PSA-3 SNUBBER	RHR-207	09	Y
RHR-472	UA	PSA-3 SNUBBER	RHR-207	09	Y
RHR-479	E	PSA-3 SN(2)	RHR-207	10	Y
RHR-479	W	PSA-3 SN(2)	RHR-207	10	Y
RHR-481	UA	PSA-35 SNUBBER	RHR-207	10	Y
RHR-485	UA	PSA-10 SNUBBER	RHR-207	10	Y
RHR-492	N	PSA-3 SN(2)	RHR-207	12	Y
RHR-492	S	PSA-3 SN(2)	RHR-207	12	Y
RHR-494	UA	PSA-10 SNUBBER	RHR-207	13	N



Table 6.2.1 Safety Related Snubbers					
Identification No.	Pos.	Description	Diagram No.	Pg	Accessible
RHR-495	BM	PSA-35 SN(2)	RHR-207	13	N
RHR-495	TP	PSA-35 SN(2)	RHR-207	13	N
RHR-496	UA	PSA-10 SNUBBER	RHR-207	13	N
RHR-50	BM	PSA-3 SNB/STRUT	RHR-211	02	Y
RHR-50	TP	PSA-3 SNB/STRUT	RHR-211	02	Y
RHR-500	UA	PSA-10 SNUBBER	RHR-207	13	Y
RHR-502	UA	PSA-35 SNUBBER	RHR-207	14	Y
RHR-503	UA	PSA-35 SNUBBER	RHR-207	14	Y
RHR-52	UA	PSA-3 SNUBBER	RHR-207	08	Y
RHR-548	E	PSA-3 SN(2)	RHR-207	03	Y
RHR-548	W	PSA-3 SN(2)	RHR-207	03	Y
RHR-551	E	PSA-3 SN(2)	RHR-207	03	Y
RHR-551	W	PSA-3 SN(2)	RHR-207	03	Y
RHR-558	UA	PSA-3 SNUBBER	RHR-207	06	Y
RHR-562	UA	PSA-3 SNUBBER	RHR-207	06	Y
RHR-563	N	PSA-1 SN(2)	RHR-207	06	Y
RHR-563	S	PSA-1 SN(2)	RHR-207	06	Y
RHR-59	UA	PSA-10 SNUBBER	RHR-205	02	Y
RHR-60	UA	PSA-3 SNUBBER	RHR-205	02	Y
RHR-61	UA	PSA-10 SNUBBER	RHR-205	02	Y
RHR-67	UA	PSA-3 SNUBBER	RHR-205	01	Y
RHR-87	UA	PSA-10 SNUBBER	RHR-103		Y
RHR-9	UA	PSA-3 SNUBBER	RHR-228		Y
RHR-901N	N	PSA-3 SN(2)	RHR-207	15	N
RHR-901N	S	PSA-3 SN(2)	RHR-207	15	N
RHR-902N	UA	PSA-10 SNUBBER	RHR-207	16	Y
RHR-903N	UA	PSA-3 SNUBBER	RHR-207	17	Y
RHR-906N	NW	PSA-10 SN(2)	RHR-207	18	Y
RHR-906N	SE	PSA-10 SN(2)	RHR-207	18	Y

Table 6.2.1 Safety Related Snubbers					
Identification No.	Pos.	Description	Diagram No.	Pg	Accessible
RHR-907N	UA	PSA-35 SNUBBER	RHR-102		Y
RHR-908N	BM	PSA-3 SN(2)	RHR-207	12	Y
RHR-908N	TP	PSA-3 SN(2)	RHR-207	12	Y
RHR-912N	UA	PSA-10 SNUBBER	RHR-207	15	Y
RHR-913N	UA	PSA-3 SNUBBER	RHR-207	17	Y
RHR-914N	UA	PSA-10 SNUBBER	RHR-207	18	Y
RHR-915N	UA	PSA-10 SNUBBER	RHR-207	16	Y
RHR-922N	UA	PSA-1 SNUBBER	RHR-207	05	Y
RHR-940N	BM	PSA-3 SN(2)	RHR-224		Y
RHR-940N	TP	PSA-3 SN(2)	RHR-224		Y
RHR-941N	UA	PSA-10 SNUBBER	RHR-101		Y
RHR-942N	N	PSA-1 SN(2)	RHR-207	05	Y
RHR-942N	S	PSA-1 SN(2)	RHR-207	05	Y
RHR-943N	UA	PSA-3 SNUBBER	RHR-207	01	Y
RHR-944N	UA	PSA-3 SNUBBER	RHR-207	01	Y
RHR-945N	E	PSA-1 SN(2)	RHR-207	05	Y
RHR-945N	W	PSA-1 SN(2)	RHR-207	05	Y
RHR-946N	UA	PSA-3 SNUBBER	RHR-203	05	Y
RHR-947N	BM	PSA-3 SN(2)	RHR-203	03	Y
RHR-947N	TP	PSA-3 SN(2)	RHR-203	03	Y
RHR-948N	BM	PSA-3 SN(2)	RHR-203	03	Y
RHR-948N	TP	PSA-3 SN(2)	RHR-203	03	Y
RHR-952N	UA	PSA-3 SNUBBER	RHR-203	04	Y
RHR-954N	E	PSA-1 SN(2)	RHR-216		Y
RHR-954N	W	PSA-1 SN(2)	RHR-216		Y
RHR-959N	NE	PSA-3 SN(2)	RHR-224		Y
RHR-959N	SW	PSA-3 SN(2)	RHR-224		Y
RHR-962N	UA	PSA-10 SNUBBER	RHR-207	18	Y
RHR-974N	UA	PSA-3 SNUBBER	RHR-203	03	Y

Table 6.2.1 Safety Related Snubbers					
Identification No.	Pos.	Description	Diagram No.	Pg	Accessible
RHR-977N	N	PSA-3 SN(2)	RHR-203	04	Y
RHR-977N	S	PSA-3 SN(2)	RHR-203	04	Y
RHR-980N	UA	PSA-10 SNUBBER	RHR-207	04	Y
RHR-983N	UA	PSA-1/2 SNUBBER	RHR-232	03	Y
RHR-986N	UA	PSA-1 SNUBBER	RHR-203	04	Y
RHR-993N	UA	PSA-1 SNUBBER	RHR-221		Y
RHR-998N	UA	PSA-3 SNUBBER	RHR-207	08	Y
RHR-SA-32	E	PSA-10 SN(2)	RHR-105		N
RHR-SA-32	W	PSA-10 SN(2)	RHR-105		N
RHR-SA-33	UA	PSA-10 SNUBBER	RHR-105		N
RHR-SA-34	UA	PSA-35 SNUBBER	RHR-105		N
RHR-SA-38	UA	PSA-10 SNUBBER	RHR-105		N
RHR-SA-50	UA	PSA-35 SNUBBER	RRC-105		N
RHR-SA-51	UA	PSA-35 SNUBBER	RRC-105		N
RHR-SA-52	UA	PSA-10 SNUBBER	RRC-105		N
RHR-SA-53	UA	PSA-10 SNUBBER	RHR-104		N
RHR-SA-56	UA	PSA-10 SNUBBER	RHR-104		N
RHR-SB-33	UA	PSA-10 SNUBBER	RHR-106		N
RHR-SB-37	UA	PSA-10 SNUBBER	RHR-106		N
RHR-SB-38	UA	PSA-10 SNUBBER	RHR-106		N
RRC-1549-62	UA	PSA-1/4 SNUBBER	RRC-113		N
RRC-1946-32	UA	PSA-1/4 SNUBBER	RRC-112		N
RRC-1C-1	BM	PSA-1 SN(2)	RRC-104		N
RRC-1C-1	TP	PSA-1 SN(2)	RRC-104		N
RRC-1C-900N	BM	PSA-1 SN(2)	RRC-104		N
RRC-1C-900N	TP	PSA-1 SN(2)	RRC-104		N
RRC-4470-31	UA	PSA-1 SNUBBER	RRC-111		N
RRC-SA-3	UA	PSA-100 SNUBBER	RRC-103		N
RRC-SA-4	UA	PSA-100 SNUBBER	RRC-103		N

Table 6.2.1 Safety Related Snubbers					
Identification No.	Pos.	Description	Diagram No.	Pg	Accessible
RRC-SA-5	UA	PSA-100 SNUBBER	RRC-103		N
RRC-SA-6	UA	PSA-100 SNUBBER	RRC-103		N
RRC-SA-65	UA	PSA-35 SNUBBER	RRC-101	02	N
RRC-SA-7	UA	PSA-35 SNUBBER	RRC-101	02	N
RRC-SB-3	UA	PSA-100 SNUBBER	RRC-103		N
RRC-SB-4	UA	PSA-100 SNUBBER	RRC-103		N
RRC-SB-5	UA	PSA-100 SNUBBER	RRC-103		N
RRC-SB-6	UA	PSA-100 SNUBBER	RRC-103		N
RRC-SB-65	UA	PSA-35 SNUBBER	RRC-102	02	N
RRC-SB-7	UA	PSA-35 SNUBBER	RRC-102	02	N
RRC-SB-8	UA	PSA-35 SNUBBER	RRC-102	02	N
RRC-SB-9	UA	PSA-35 SNUBBER	RRC-102	02	N
RWCU-1C-16	UA	PSA-1 SNUBBER	RWCU-101	01	N
RWCU-1C-17	NW	PSA-1 SN(2)	RWCU-101	01	N
RWCU-1C-17	SE	PSA-1 SN(2)	RWCU-101	01	N
RWCU-1C-2	UA	PSA-1 SNUBBER	RWCU-101	04	N
RWCU-1C-3	E	PSA-3 SN(2)	RWCU-101	04	N
RWCU-1C-3	W	PSA-3 SN(2)	RWCU-101	04	N
RWCU-1C-5	UA	PSA-3 SNUBBER	RWCU-101	03	N
RWCU-1C-6	UA	PSA-3 SNUBBER	RWCU-101	03	N
RWCU-1C-7	UA	PSA-3 SNUBBER	RWCU-101	02	N
RWCU-1C-8	UA	PSA-3 SNUBBER	RWCU-101	03	N
RWCU-927N	UA	PSA-3 SNUBBER	RWCU-301		Y
RWCU-928N	UA	PSA-10 SNUBBER	RWCU-301		Y
SGT-11	BM	PSA-10 SN(2)	SGT-202		Y
SGT-11	TP	PSA-10 SN(2)	SGT-202		Y
SGT-19	UA	PSA-3 SNUBBER	SGT-201		Y
SGT-23	BM	PSA-3 SN(2)	SGT-202		Y
SGT-23	TP	PSA-3 SN(2)	SGT-202		Y

Table 6.2.1 Safety Related Snubbers					
Identification No.	Pos.	Description	Diagram No.	Pg	Accessible
SLC-4475-21	UA	PSA-1 SNUBBER	SLC-101	05	N
SW-124	N	PSA-35 SN(2)	SW-301	06	Y
SW-124	S	PSA-35 SN(2)	SW-301	06	Y
SW-29	NE	PSA-10 SN(4)	SW-305	03	Y
SW-29	NW	PSA-10 SN(4)	SW-305	03	Y
SW-29	SE	PSA-10 SN(4)	SW-305	03	Y
SW-29	SW	PSA-10 SN(4)	SW-305	03	Y
VR-3	E	PSA-1/2 SN(2)	VR-401	01	Y
VR-3	W	PSA-1/2 SN(2)	VR-401	01	Y
VR-6	UA	PSA-1 SNUBBER	VR-401		N
VR-8	UA	PSA-1 SNUBBER	VR-401		N
VR-900N	UA	PSA-1/2 SNUBBER	VR-401		Y
VR-901N	UA	PSA-1/2 SNUBBER	VR-401		Y
VR-902N	UA	PSA-1/2 SNUBBER	VR-401	01	Y
KEY					
BM	Bottom	SE	Southeast		
E	East	SW	Southwest		
N	North	TP	Top		
NE	Northeast	UA	Unassigned - Consists of a single snubber		
NW	Northwest	W	West		
S	South				
Accessible - This column indicates if the snubber is accessible during plant operations.					



**6.2.3 FSAR Section 5.2.4: Inservice Inspection and Testing of the Reactor Coolant Pressure Boundary**

Inservice inspections will be performed in accordance with the requirements of 10 CFR 50.55a subparagraph (g) to the extent practical.

**FSAR 5.2.4.10 Augmented Inservice Inspection of RPV Feedwater Nozzles**

An augmented inservice inspection program will be implemented to examine the reactor feedwater nozzle inner radii for cracks. Per Supply System's response to FSAR question 121.8 and NUREG 0619 (letter G02-82-36, dated January 13, 1982) the augmented program will consist of the following:

Ultrasonic examination of one feedwater nozzle each refueling outage;

If an indication is found to result from service induced cracks propagating from the nozzle inner surfaces, the following actions will be taken:

- a. All remaining feedwater nozzles will be examined using UT (from the OD) and penetrant techniques during the refueling outage in which the cracking is verified.
- b. Remove by local grinding all surface indications determined to be service induced cracks.
- c. The integrity of the RFW thermal sleeve to safe end joints will be determined by an inspection method such as a leak test.
- d. Appropriate corrective action will be taken as required and as practical to prevent recurrence of crack initiation.
- e. A RFW nozzle examination program for subsequent refueling outages will be modified to include an external ultrasonic examination of all feedwater nozzle radii, bore and safe end regions for each scheduled refueling outage for 3 consecutive outages. If no new indications are discovered or if new indications are determined to not result from service induced cracks at the nozzle inner surfaces, the original Supply System program will be resumed.
- f. Surface examination of accessible nozzle inner radius surfaces will continue to be used throughout plant life only to confirm or characterize new UT indications.

If no indications resulting from service induced cracks are found after six refueling

outages, subsequent inservice examinations will be performed in accordance with normal ASME Section XI requirements.

The UT examination technique will be similar to the technique used in the preservice examinations and the first inspection interval. The technique and personnel will be qualified on the WNP-2 Feedwater Nozzle Mockup.

**FSAR 5.2.4.11      Augmented Inservice Inspection for Intergranular Stress Corrosion Cracking (IGSCC)**

An augmented inservice inspection of all piping and components which are considered susceptible to IGSCC will be performed. The program will follow the guidelines set forth in Generic Letter 88-01, "NRC Position on IGSCC in BWR Austenitic Stainless Steel Piping" and supplements, as modified by Supply System responses and NRC SERs on these responses.

The examinations will be performed on piping and components;

- 1) made of nonconforming material,
- 2) four (4) inches or larger in nominal diameter and
- 3) containing reactor coolant at a temperature above 200°F during power operation.

The augmented program will consist of the following:

- 1) Examine at least 25% of the Category B welds and 12% of the Category A welds within six years of the refueling outage scheduled for Spring, 1989 (RF89A);
- 2) Within 10 years of RF89A, examine at least 50% of Category B welds and at least 25% of Category A welds;
- 3) Examine all Category C welds by the end of refueling outage eleven (R11), then all Category C welds every 10 years (at least 50% within 6 years of refueling outage eleven.
- 3) Examine all Category D welds every three years.
- 4) In addition to complying with the ASME Section XI Code committed to by this ISI Program Plan, detailed procedures, equipment and personnel will be qualified by the formal program conducted in accordance with the NRC/EPRI/BWROG Coordination Plan at the EPRI NDE Center in Charlotte, North Carolina;

- 5) If one or more cracked welds are found during a sample inspection, an additional sample of welds will be examined during that outage. The sample will contain the approximate same number of welds as the original sample. Unless there exists a technical reason to select a different distribution, the additional sample will be similar in distribution (pipe size, system and location) to the original sample. If additional cracked welds are found, all welds in that IGSCC Category will be examined unless the sample was chosen on a technical basis. In that case all the IGSCC Category welds that meet that technical basis will be examined.
- 6) The Supply System will use ASME Section XI Section IWB-3600 of the 1989 Edition, no Addenda of the ASME Boiler and Pressure Vessel Code for methods and criteria for crack evaluation and repair. The Commission will be notified if a flaw is found that does not meet Section XI, Section IWB-3500 criteria for continued operation without evaluation. Prior to resuming operation, an evaluation of the flaw justifying continued operation and/or the repair plans will be submitted to the Commission.

#### FSAR 5.2.4.12 ASME Section XI Repairs and Replacements

See section 5.2.21 Repair and Replacement Program

#### 6.2.4 FSAR Section 6.6: Inservice Inspection of ASME III Code Class 2 and 3 Components

Inservice inspections of Class 2 and 3 components will be performed in accordance with the requirements of 10 CFR 50.55a Subparagraph (g) to the extent practical.

#### FSAR 6.6.8 Augmented Inservice Inspection to Protect Against Postulated Piping Failures

An augmented inservice inspection program is not applicable to WNP-2 as there is no Class 2 or 3 piping greater than 1-inch penetrating the containment, classified as high energy during normal operation.

### 6.3 TECHNICAL SPECIFICATIONS

The following technical specifications contain requirements applicable to this ISI Program Plan.

- 4.0.5 Surveillance
- 3/4.7.4 Snubber Examination and Testing
- 6.10.3 Records Retention

## 6.4 NRC REGULATORY GUIDES

The Supply System has reviewed the augmented inservice inspection requirements found in the NRC Regulatory Guides listed in Table 6.4.1. Following careful review and consideration of those augmented requirements, the WNP-2 Inservice Inspection Program Plan has been written to comply with the Regulatory Guides which are applicable to WNP-2. A brief statement of applicability is given for each Guide in Table 6.4.1.

Some Regulatory Guides have been addressed through Generic Letters. See next section on Generic Letters.

Table 6.4.1 NRC Regulatory Guide Review for Applicability to WNP-2 ISI Program Plan		
1.26, Rev 3	Quality Group Classifications and Standard for Water, Steam, and Radioactive Waste Containing Components in Nuclear Power Plants.	Applicable; WNP-2 ISI Program Plan is written to comply.
1.65, Rev. 0	Materials and Inspections for Reactor Pressure Vessel Closure Studs.	Applicable; WNP-2 ISI Program Plan complies through incorporation of ASME Section XI examination requirements.
1.147, Rev. 11	Inservice Inspection Code Case Acceptability ASME Section XI Division I.	Applicable; The Code cases being used are identified in Section 5.1.3
1.150, Rev. 1	UT of Reactor Vessel Welds during Preservice and Inservice Inspection.	Applicable; WNP-2 will comply with Appendix A of this Reg. Guide.

## 6.5 GENERIC LETTERS

83-15 Implementation of Regulatory Guide 1.150, "Ultrasonic Testing of Reactor Vessel Welds During Preservice and Inservice Examinations, Revision 1

WNP-2 uses the guidance in Appendix A of this Regulatory Guide.

88-01 Supplement 1 "NRC Position on Intergranular Stress Corrosion Cracking (IGSCC) in BWR Austenitic Stainless Steel Piping"

See section 6.2.3.

**89-09 ASME Section III Component Replacements**

See section 5.3 Repair and Replacement Program

**90-05 Guidance for Performing Temporary Non-Code Repair of ASME Code Class 1, 2, and 3 Piping**

See section 5.3 Repair and Replacement Program

**90-09 Alternative Requirements for Snubber Visual Inspection Intervals and Corrective Actions**

See relief request 2ISI-11 in section 5.1.2.

**94-03 Intergranular Stress Corrosion Cracking of Core Shrouds in Boiling Water Reactors**

See section 6.6.5.

**6.6 OTHER COMMITMENTS****6.6.1 Jet Pump Holddown Beams**

The augmented examination commitment made during the first inservice inspection interval is no longer valid. The beams that were subject to this requirement were replaced with a later design during refueling outage nine (R9) in the Spring of 1994. WNP-2 will address additional examination of the jet pump beams when General Electric issues their examination recommendations of the new beams. Prior to this time, WNP-2 will schedule a volumetric examination every ten (10) years.

**6.6.2 Core Spray Spargers**

An augmented inservice inspection program that complies with IE Bulletin 80-13 will be implemented to examine the reactor core spray spargers. This program will entail remote underwater TV examinations of the core spray spargers and the segment of piping between the inlet nozzle and the vessel shroud. The examination will be performed once every twenty-four months. This differs from the first Inspection Interval in that WNP-2 performed the examination every refueling outage. WNP-2 is on an annual refueling schedule as opposed to an eighteen (18) or twenty-four (24) month cycle which is the industry standard. This will bring WNP-2's inspection schedule more in line with the rest of the industry.

**6.6.3. CRD Scram Discharge Headers**

During the first inservice inspection interval, the inservice inspection for the CRD scram discharge headers (SDH) consisted of a visual examination of all welds for evidence of leakage once an inspection period and a volumetric examination of 10% of the circumferential welds greater than 4 NPS once each inspection interval. The welds subject to

volumetric examination were the same ones which received a preservice examination. (Reference letter number G02-83-523, G.D. Bouchey to Mr. A. Schwencer, "PSI Summary Report Clarification" dated June 15, 1983.). During the second inspection interval the SDH welds will be incorporated into the ASME Section XI Examination Category C-F-2 scope. Seven and one-half (7.5) percent of the SDH welds will be subject to both a volumetric and surface examination.

#### 6.6.4 Final Feedwater Temperature Reduction

When final feedwater temperature reduction (FFWTR) or "coastdown" is used to extend the fuel cycle, one feedwater nozzle inner radii will be examined at the next refueling outage per Section 6.3.2. This commitment is contained in Supply System letter G02-90-024, dated February 14, 1990 and NRC SER dated March 1, 1990 (Supply System letter G02-90-024, "Request for Amendment to Technical Specifications, Final Feedwater Temperature Reduction (FFTR)", dated February 14, 1990 and Letter, Nuclear Regulatory Commission to Mr. G.C. Sorensen, "Issuance of Amendment No. 77 to Facility Operating Licence No. NPF-21 - WPPSS Nuclear Project No. 2 (TAC No. 66885)" dated March 1, 1990). The feedwater nozzle selected for examination will be the nozzle with the longest time since the previous examination.

#### 6.6.5 RPV Core Shroud

Generic Letter 94-03, "Intergranular Stress Corrosion Cracking of Core Shrouds in Boiling Water Reactors" was issued July 25, 1994. The Supply System responded via letter G02-94-202 dated August 24, 1994 (Supply System letter G02-94-202, "Response to Generic Letter 94-03, Intergranular Stress Corrosion Cracking of Core Shrouds", dated August 24, 1994). In this letter the Supply System committed to performing an examination on the core shroud during the Spring 1996 (R-11) refuel outage. This commitment also included the provision to notify the NRC no later than three months prior to performing the examination.

## 7.0 CALIBRATION BLOCKS

The design drawings at the end of this section illustrate the ultrasonic calibration blocks which will be used to perform ultrasonic examinations at WNP-2. Table 7.1 lists those blocks being used for the RPV, including top and bottom heads, the nozzle-to-shell welds and inner radii, and the nozzle safe end welds. Table 7.2 lists those blocks being used for the Class 1 and 2 piping systems. These tables include the block identification number which will be used exclusively whenever referencing the calibration block on data sheets or other records, and the corresponding design drawing number. The block identification number is the same number referenced from the Program Plan and Schedule Tables and the Weld and Component Identification Diagrams found in Section 9.0 "Boundary Diagrams / Schedules / Weld and Component Diagrams".

Table 7.1  
 RPV  
 Calibration Blocks

Block No.	Application	Drawing No.	Mat'l.	Dia	Thickness	Material Specification
UT-101	Nozzle to safe-end N1	UTCB-101	CS-SS	22	1-29/32	SA-508 SA-336
UT-102	Nozzle to safe-end N4, N5, N6, N16	UTCB-102	CS-INCO	12	1-1/8 1-5/16	SA-508, SB-166
UT-103	Not Used					
UT-104	Nozzle to safe-end N3	UTCB-104	CS-CS	24	1-5/8	SA-508 Gr. B
UT-105	Safe-end to Stub	UTCB-105	INCO- INCO	12	15/16	SB-166-70
UT-106	Safe-end or Stub to Safe-end extension N4, N5, N6, N16	UTCB-106	INCO-CS	10/12	13/16	SB-166, SA-508
UT-107	Nozzle to flange N7 N18	UTCB-107	CS-CS	6	1-3/4	SA-508
UT-108	Nozzle to flange N8	UTCB-108	CS-CS	4	1-1/4	SA-508
UT-109	Nozzle to safe-end N9	UTCB-109	CS-SS	4	3/4	SA-508



Table 7.1 RPV Calibration Blocks						
Block No.	Application	Drawing No.	Mat'l.	Dia	Thickness	Material Specification
UT-110	Nozzle safe-end N10	UTC B-110	CS-CS	5	3/4	SA-508
UT-111	Nozzle to safe-end N2	UTC B-111	CS-SS	12	1-1/4	SA-508, SA-182 F 316L
UT-112	Not Used					
UT-113	Not Used					
UT-114	Not Used					
UT-115	Top head dollar plates	UTC B-203	CS	N/A	3-5/8	SA-533 Gr. B
UT-116	Top head radial plates	UTC B-204	CS	N/A	5-1/8	SA-533 Gr. B
UT-117	Bottom head dollar plates	UTC B-205	CS	NA	8	SA-533 Gr. B
UT-118	Bottom head radial plates	UTC B-206	CS	NA	6-3/4	SA-533 Gr. B
UT-119	Shell Course #1	UTC B-207	CS	NA	9-3/4	SA-533 Gr. B
UT-120	Shell Course #2 & #3	UTC B-208	CS	NA	6-9/16	SA-533 Gr. B

Table 7.1 RPV Calibration Blocks						
Block No.	Application	Drawing No.	Mat'l.	Dia	Thickness	Material Specification
UT-121	Shell Course #4	UTCB-209	CS	NA	7-1/4	SA-533 Gr. B
UT-122	N4 Nozzle inner radius & bore mockup	UTCB-250	CS	NA	NA	SA-533 Gr. B, SA-508
UT-123	RPV Flange to shell course #4	UTCB-251	CS	NA	NA	SA-508
UT-124	Not Used					
UT-125	Not Used					
UT-126	Not Used					
UT-127	Not Used					
UT-128	Not Used					
UT-129	Not Used					
UT-130	RPV Studs	UTCB-210	CS	6	NA	SA-540 Gr. 23
UT-131	Not Used					
UT-132	RPV Nuts	UTCB-211	CS	NA	5-1/8	SA-533 Gr. B

Table 7-2 Piping and Miscellaneous Calibration Blocks							
Block No.	Application	Drawing No.	Mat'l.	Dia.	Thickness	Material Specification	Notes
UT-1	30MS(1)-4	UTC B-220	CS	30	1.250	SA-155 KCF-70	
UT-2	28MS(1)-4	UTC B-220	CS	28	1.420	SA-155 KCF-70	
UT-3	26MS(1)-4	UTC B-220	CS	26	1.125	SA-155 KCF-70	
UT-4	26MS(1)-4	UTC B-224	CS	26	1.125	SA-106 Gr. B	
UT-5	24RFW(1)-4	UTC B-220	CS	24	1.812	SA-106 Gr. B	
UT-6	24MS(1)-4	UTC B-220	CS	24	1.218	SA 106 Gr. B	
UT-7	24RRC(1)-4S 24RRC(2)-4S	UTC B-220	SS	24	1.140	SA-358 Gr. 304	
UT-8	20RHR(1)-2	UTC B-233	CS	20	0.500	SA-106 Gr. B	
UT-9	20RHR(2)-4S 20RRC(6)-4S	UTC B-220	SS	20	1.031	SA-358 Gr. 304	1
UT-10	20RHR(2)-4	UTC B-220	CS	20	1.031	SA-106 Gr. B	
UT-11	18RFW(1)-4	UTC B-220	CS	18	1.375	SA-106 Gr. B	
UT-12	18MS(1)-4	UTC B-220	CS	18	0.938	SA-106 Gr. B	
UT-13R	16RRC(1)-4S	UTC B-220	SS	16	0.758	SA-358 Gr. 304	7
UT-14	14RHR(1)-4	UTC B-221	CS	14	0.750	SA-106 Gr. B	
UT-15	12RFW(1)-4	UTC B-221	CS	12	1.000	SA-106 Gr. B	

Table 7-2 Piping and Miscellaneous Calibration Blocks							
Block No.	Application	Drawing No.	Mat'l.	Dia.	Thickness	Material Specification	Notes
UT-16	12HPCS(1)-4 12LPCS(1)-4 12RHR(1)-4	UTCB-221	CS	12	0.844	SA-106 Gr. B	2
UT-17	12HPCS(1)-4 12LPCS(1)-4	UTCB-221	CS	12	0.688	SA-106 Gr. B	
UT-18	12LPCS(1)-2 12LPCS(3)-2 12RHR(1)-2	UTCB-232	CS	12	0.375	SA-106 Gr. B	
UT-19	12RHR(1)-4S 12RRC(1)-4S 12RRC(7)-4S	UTCB-221	SS	12	0.688	SA-358 Gr. 304	3
UT-20	18RHR(1)-1 18RHR(1)-2 18RHR(2)-1 18RHR(2)-2	UTCB-232	CS	18	0.375	SA-106 Gr. B	
UT-21	10RCIC(12)-4	UTCB-221	CS	10	0.719	SA-106 Gr. B	
UT-22	10HPCS(1)-4 10LPCS(1)-4 10RCIC(12)-4	UTCB-221	CS	10	0.594	SA-106 Gr. B	
UT-23	10RCIC(12)-4	UTCB-221	CS	10	0.844	SA-106 Gr. B	

Table 7-2 Piping and Miscellaneous Calibration Blocks							
Block No.	Application	Drawing No.	Mat'l.	Dia.	Thickness	Material Specification	Notes
UT-24	8MS(1)-4	UTCB-221	CS	8	0.906	SA-106 Gr. B	
UT-25	8RCIC(12)-4 8RHR(20)-4	UTCB-221	CS	8	0.594	SA-106 Gr. B	
UT-26	8RRC(1)-4S	UTCB-221	SS	8	0.500	SA-376 Tp. 304	
UT-27	6RCIC(1)-4 6RCIC(6)-4	UTCB-221	CS	6	0.562	SA-106 Gr. B	
UT-28	6RCIC(1)-4 6RFW(11)-4 6RHR(10)-4 6RWCU(2)-4 6RWCU(3)-4 6RWCU(4)-4	UTCB-221	CS	6	0.432	SA-106 Gr. B	
UT-29	4RRC(4)-4S 4RRC(8)-4S	UTCB-221	SS	4	0.337	SA-312 Tp. 304	6

Block No.	Application	Drawing No.	Mat'l.	Dia.	Thickness	Material Specification	Notes
UT-30	4HPCS(1)-4 4HPCS(4) 4LPCS(1)-4 4MS(12)-4 4RCIC(10)-4 4RCIC(13)-4 4RFW(11)-4 4RRC(51)-4 4RWCU(3)-4 4RWCU(4)	UTCB-221	CS	4	0.337	SA-106 Gr. B	
UT-32	5RFW(11)-4	UTCB-221	CS	5	0.500	SA-106 Gr. B	4
UT-33	24RFW(1)-4	UTCB-220	CS	24	2.343	SA-106 Gr. B	
UT-34	CRD Scram Discharge Volume	UTCB-230	CS	12	0.688	SA-106 Gr. B	
UT-35	CRD Scram Discharge Volume	UTCB-231	CS	8	0.500	SA-106 Gr. B	
UT-36	CRD Scram Discharge Volume	UTCB-231	CS	6	0.432	SA-106 Gr. B	
UT-37	18RHR(1)-2 18RHR(20)-2 18RHR(4)-2	UTCB-232	CS	18	0.438	SA-106	

Block No.	Application	Drawing No.	Mat'l.	Dia.	Thickness	Material Specification	Notes
UT-38	14LPCS(1)-1 14RHR(1)-1	UTCBC-232	CS	14	0.375	SA-106 Gr. B	
UT-39	16LPCS(1)-2	UTCBC-232	CS	16	0.375	SA-106 Gr. B	
UT-40	MS Flued Head	UTCBC-222	CS	FLAT	5.000	SA-105	5
UT-41	RRC Pump Studs	UTCBC-223	CS	3-1/4	N/A	SA-193 Gr. 7	
UT-42		UTCBC-225	CS	Flat	1.000	SA-516 Gr. 70	
UT-43	RRC Flow Control Valve	UTCBC-226	CS	2-3/4	14-1/4	SA-193 Gr. B7	
UT-44	3MS(20)-4	UTCBC-229	CS	3	0.437	SA-106 Gr. B	
UT-45	20LPCS(10)-1 20RHR(2)-2 20RHR(8)-2	UTCBC-232	CS	20	0.375	SA-106 Gr. B	
UT-48	16RHR(1)-2 16RHR(5)-2	UTCBC-233	CS	16	0.500	SA-106 Gr. B	
UT-49	16HPCS(1)-4 16HPCS(9)-4	UTCBC-233	CS	16	1.031	SA-106 Gr. B	

Table 7-2 Piping and Miscellaneous Calibration Blocks							
Block No.	Application	Drawing No.	Mat'l.	Dia.	Thickness	Material Specification	Notes
UT-50	24LPCS(2)-1 24RHR(1)-2 24RHR(2)-2 24RHR(3)-1	UTCB-232	CS	24	0.375	SA-106 Gr. B	
UT-51	24CSP(1)-1 30CSP(1)-1	UTCB-234	CS	24	0.500	SA-106	8




**Table 7-2  
Piping and Miscellaneous  
Calibration Blocks**

Block No.	Application	Drawing No.	Mat'l.	Dia.	Thickness	Material Specification	Notes
<b>Notes:</b>							
1	This block is for use on 20" RHR(2)-4S which is of material specifications SA-312 rather than SA-358. This is acceptable based on the acoustic similarity of the two materials.						
2	For these piping systems, the UT calibration block is for use on the schedule 100 elbows only.						
3	This block is for use on 12" RHR(1)-4S which is of material specifications SA-312 rather than SA-358. This is acceptable based on the acoustic similarity of the two materials.						
4	See detail for special 5" thermal sleeve on RFW-101-1 in Section 15.0, "WELD ID DIAGRAMS".						
5	See detail for flued head fitting on MS-101-3. This block is intended for use along with pipe block UT-3.						
6	This block is for use on 4" RRC (8)-4S which is of material specification SA-312 rather than SA-376. This is acceptable based on the acoustic similarity of the two materials. Appendix III-3411 allows this substitution.						
7	UT-13R is used in place of UT-13 which was lost prior to being used for ISI. Both blocks were made from the same pipe section.						
8	This calibration block is not used on ASME Section XI welds. It is used on 24" and 30" CSP.						




1 2 3 4 5 6 7 8 9 10


A  
B  
C  
D  
E  
F  
G  
H

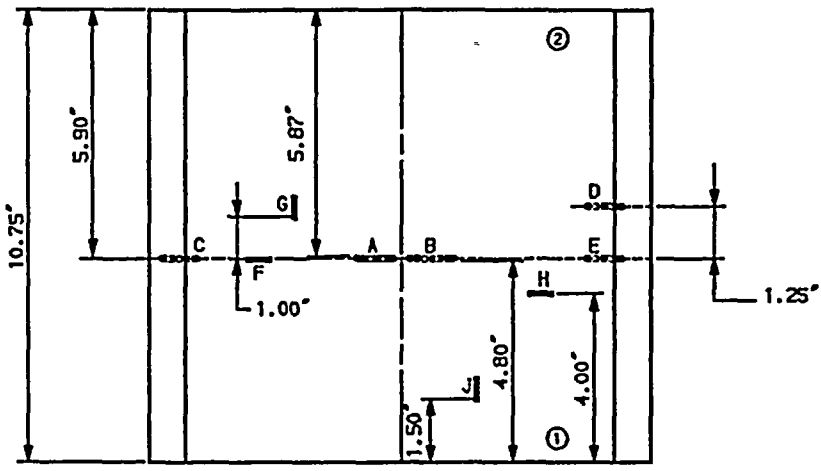

PLAN VIEW

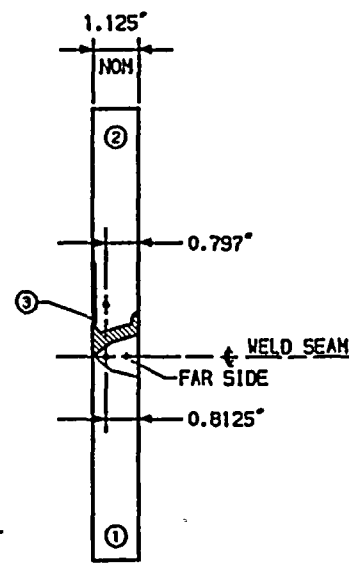

END VIEW

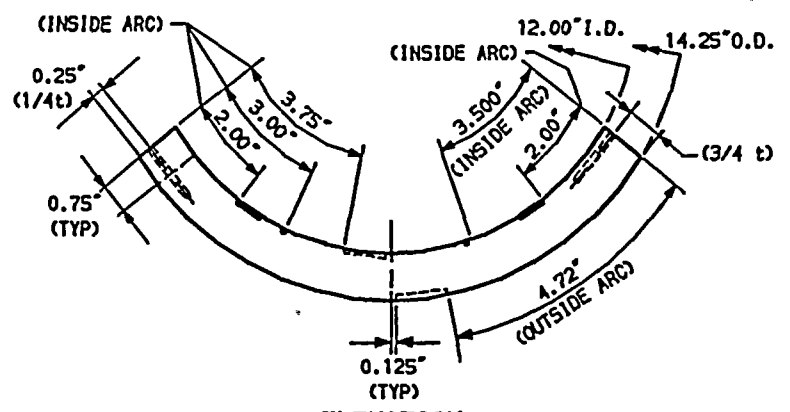

ELEVATION

EDM NOTCHES			
NOTCH	LENGTH	WIDTH	DEPTH
F	0.50	0.030	0.274
G	0.50	0.030	0.280
H	0.50	0.030	0.110
J	0.50	0.030	0.109

**NOTES**  
 NOTCHES F & G  
 20X BASE METAL PLUS  
 0.20" CLAD ON WELD  
 NOTCHES H & J  
 10X BASE METAL ON  
 SAFE-END SIDE

NOTCH	LENGTH	WIDTH	DEPTH
A	1.219	0.126	0.114
B	1.219	0.126	0.118

HOLE	DIAMETER	LENGTH
C	0.126	1.484
D	0.127	1.484
E	0.127	1.484

NO.	MATERIAL	HEAT NUMBER
①	SB 166 (600) INCONEL	NX 7733
②	SA 508 CL 2 CS	522308
③	INCONEL 182	

**REFERENCES:**  
 CBI NUCLEAR CO.  
 YPF #3613-649 REV 0  
 ISI DRAWINGS  
 RPY-108 REV 1  
 RPY-109 REV 1  
 RPY-110 REV 1

THIS DRAWING IS INTENDED  
 FOR USE IN PRESERVICE  
 AND INSERVICE INSPECTION  
 PROGRAMS ONLY

WASHINGTON PUBLIC POWER  
 SUPPLY SYSTEM  
 RICHLAND, WASHINGTON 98922

NO	DATE	REVISION	BY	CHKD	APVD
2	5-15-82	INCORPORATED AS BUILT EDM NOTCHES. REDRAWN	K-MGA	DPR	DM
1	12-2-81	ADDED HEAT NUMBERS	K-MGA	DPR	TYH
0	7-31-79	ISSUED FOR USE, AS BUILT	K-MGA	TH	LFB


ENGINEER T HOYLE  
 DRAWN K-MGANDREN  
 DATE 5-31-79

NOZZLE TO SAFE-END, M4, M5, M6, & M18  
 UT CALIBRATION BLOCK, UT-102  
 Dwg No. **UTCB-102** REV 2


NO	DATE	REVISION	BY	CHKD	APVD	NO	DATE	REVISION	BY	CHKD	APVD	DATE	DWG NO.	REV
												5-31-79	UTCB-102	2




A  
B  
C  
D  
E  
F  
G  
H

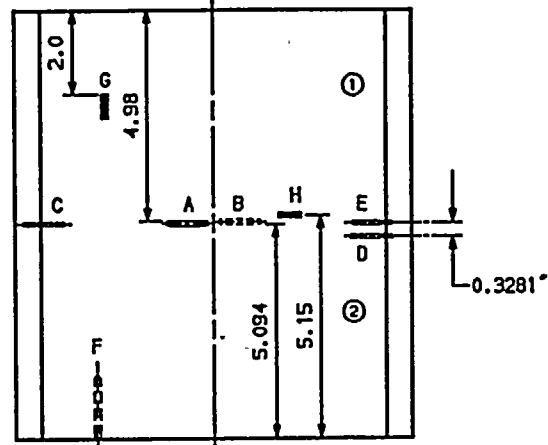

PLAN VIEW

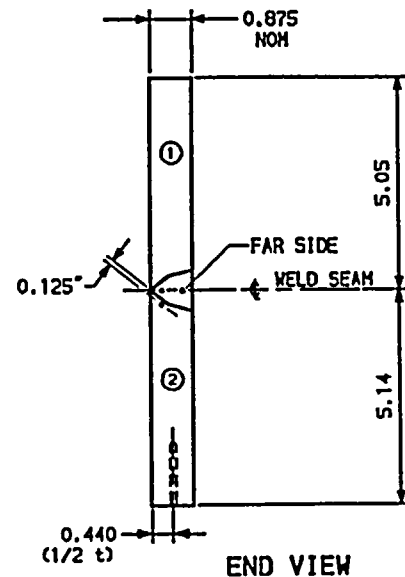

END VIEW

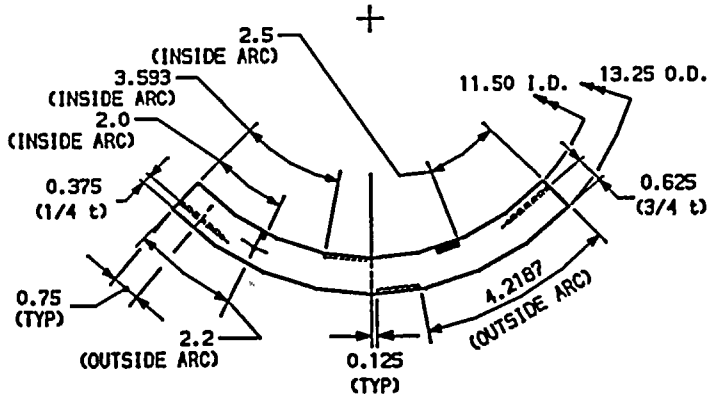

ELEVATION

HOLE	DIAMETER	LENGTH
F	0.09375	1.53

EDM NOTCH	LENGTH	WIDTH	DEPTH
G	0.5	0.3	0.085
H	0.5	0.3	0.085

NOTCH	LENGTH	WIDTH	DEPTH
A	1.03125	0.127	0.090
B	1.03125	0.127	0.081

HOLE	DIAMETER	LENGTH
C	0.094	1.500
D	0.096	1.453
E	0.096	1.484

NO	MATERIAL	HEAT NUMBER
①	SB 166 (600) INCONEL	HX 7733
②	SB 166 (600) INCONEL	HX 7733

REFERENCES:  
 CBI NUCLEAR CO.  
 VPF #3133-519 REV 1  
 151 DRAWING  
 RPY-108 REV 1

NOTES  
 1. ALL DIMENSIONS ARE IN INCHES.

THIS DRAWING IS INTENDED FOR USE IN PRESERVICE AND INSERVICE INSPECTIONS PROGRAMS ONLY

WASHINGTON PUBLIC POWER SUPPLY SYSTEM  
 RICKLAND, WASHINGTON 98952

NO	DATE	REVISION	BY	CHKD	APVD
2	10-2-82	INCORPORATED AS BUILT EDM NOTCHES. REDRAWN	K-M&A	DPR	DRV
1	12-2-81	ADDED HEAT NUMBERS	K-M&A	DPR	TFH
0	7-31-79	ISSUED FOR USE, AS BUILT	K-M&A	TFH	LFB


ENGINEER T HOYLE  
 DRAWN K-M&ANDREX  
 DATE 5-30-79

MP-2  
 SAFE-END TO SAFE-END STUD, M4  
 UT CALIBRATION BLOCK, UT-105  
 DWG NO: **UTCB-105** REV 2


NO	DATE	REVISION	BY	CHKD	APVD	NO	DATE	REVISION	BY	CHKD	APVD	DATE	DWG NO.	REV
												5-30-79	UTCB-105	2

1 2 3 4 5 6 7 8 9 10


A  
B  
C  
D  
E  
F  
G  
H

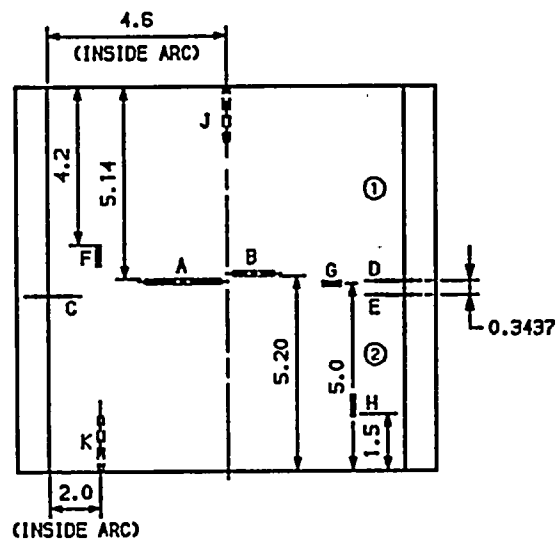

PLAN VIEW

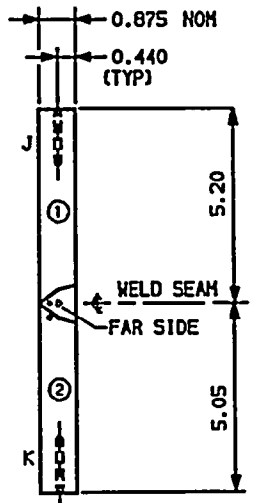

END VIEW

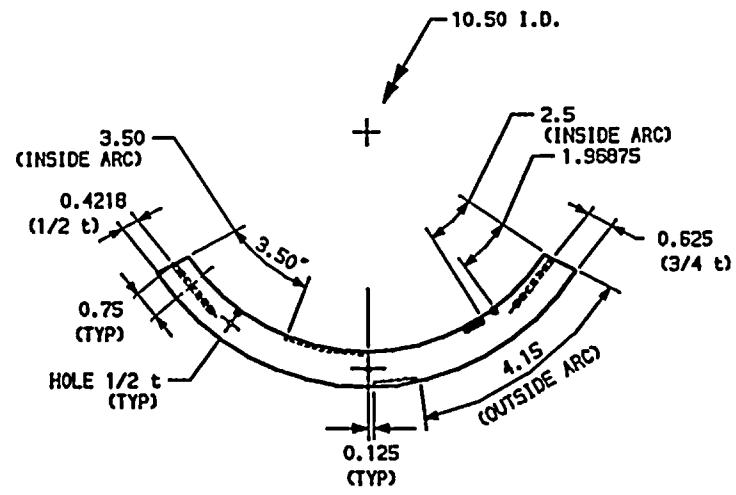

ELEVATION

HOLE	DIAMETER	LENGTH
J	0.09375	1.52
K	0.09375	1.52

EDM NOTCH	LENGTH	WIDTH	DEPTH
F	0.5	0.3	0.082
G	0.5	0.3	0.082
H	0.5	0.3	0.082

NOTCH	LENGTH	WIDTH	DEPTH
A	1.9375	0.126	0.091
B	1.1250	0.126	0.091

HOLE	DIAMETER	LENGTH
C	0.091	1.500
D	0.095	1.500
E	0.095	1.500

NO	MATERIAL	HEAT NUMBER
①	SA 508 CL 1 CS	718419
②	S8 166 (600) INCONEL	HX 7733

REFERENCES:  
 CBI NUCLEAR CO.  
 YPF #3613-650 REV 0  
 ISI DRAWINGS  
 RPY-108 REV 0  
 RPY-109 REV 0  
 RPY-110 REV 0

NOTES  
 1. ALL DIMENSIONS ARE IN INCHES.

THIS DRAWING IS INTENDED FOR USE IN PRESERVICE AND INSERVICE INSPECTIONS PROGRAMS ONLY


WASHINGTON PUBLIC POWER SUPPLY SYSTEM  
 RICHLAND, WASHINGTON 98552

2	10-2-82	INCORPORATED AS BUILT EDM NOTCHES. REDRAWN	K-MGA	DPR	DNV	ENGINEER T MOYLE
1	12-2-81	ADDED HEAT NUMBERS	K-MGA	DPR	TTH	
0	7-31-79	ISSUED FOR USE, AS BUILT	K-MGA	TRF	LFB	DRAWN K-MANDREK


NO	DATE	REVISION	BY	CHKD	APVD	NO	DATE	REVISION	BY	CHKD	APVD	DATE	DWG NO.	REV
							8-31-78						UTCB-108	2

MP-2  
 SAFE-END TO SAFE-END EXTENSION, W4, W5,  
 W6 & W18 UT CALIBRATION BLOCK, UT-106



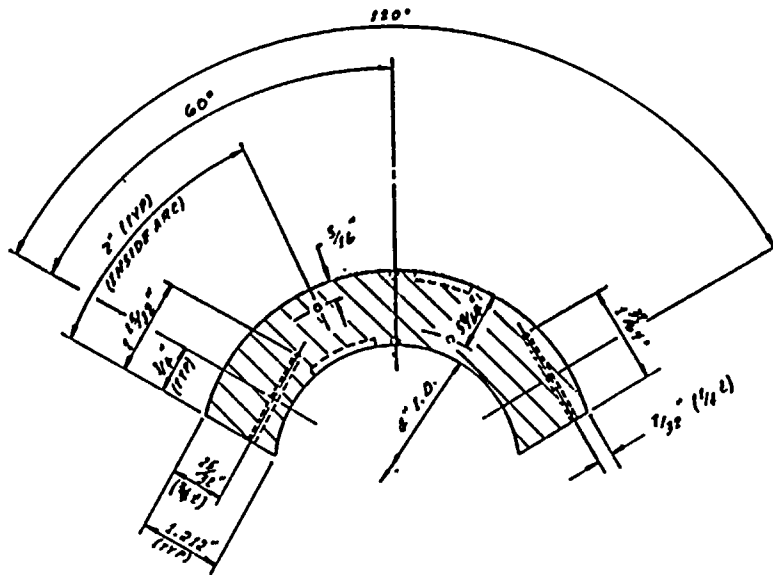

SECTION A-A

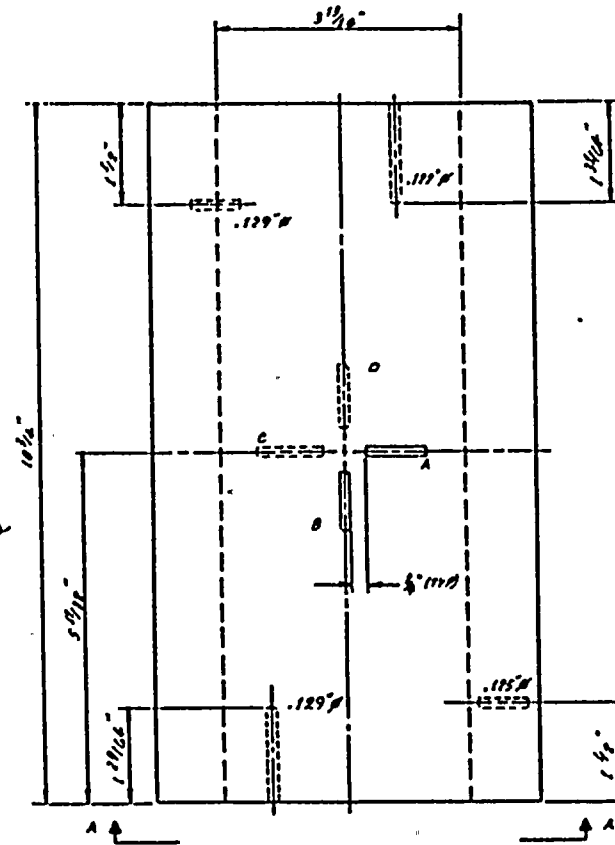

NOTCH	LENGTH	WIDTH	DEPTH
A	3 1/32"	.127"	.112"
B	6 1/64"	.126"	.114"
C	1 1/32"	.125"	.103"
D	1 1/32"	.125"	.115"

MATERIAL

SA 308 CL II HEAT NR 223605

REFERENCE

- CBX NUCLEAR CO  
VPF # 3199-590 REV 0
- ISS DRAWING  
RPV-112 REV 0

THIS DRAWING IS INTENDED FOR USE IN PRESERVICE AND INSERVICE INSPECTION PROGRAMS ONLY

ENGINEER T. MOYER

DRAWN BY McAndrew

DATE 6-19-79

**WASHINGTON PUBLIC POWER SUPPLY SYSTEM**  
RICHLAND, WASHINGTON 99352  
WPPSS-2

NOZZLE TO FLANGE, NO UT CALIBRATION BLOCK, UT-108

DWG NO UTCS-108


REV 1

NO	DATE	REVISION	BY	CHKD	APPVD
1	1/22/81	ADDED HEAT NR & I.D. DIM.	JCH	JMR	TKC
2	3/11/79	ISSUED FOR USE, AS BUILT	JCH	JMR	TKC




A  
B  
C  
D  
E  
F  
G  
H

1 2 3 4 5 6 7 8 9 10

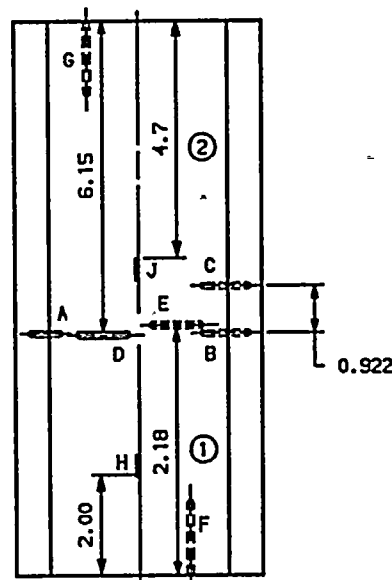

**PLAN VIEW**

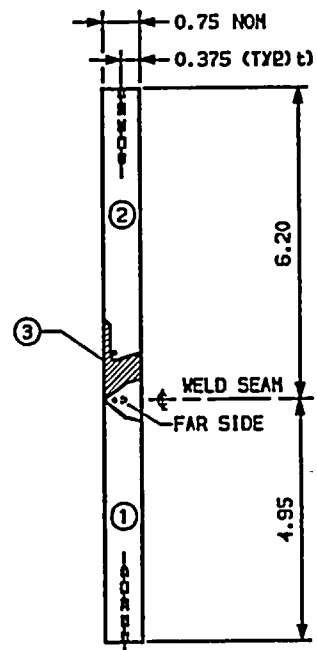


**END VIEW**

HOLE	DIAMETER	LENGTH
F	0.09375	1.55
G	0.09375	1.53

EDM NOTCH	LENGTH	WIDTH	DEPTH
H	0.5	0.3	0.070
J	0.5	0.3	0.200

HOLE	DIAMETER	LENGTH
A	0.095	1.2187
B	0.095	1.5625
C	0.095	1.5312

NOTCH	LENGTH	WIDTH	DEPTH
D	1.1562	0.126	0.078
E	1.1875	0.126	0.076

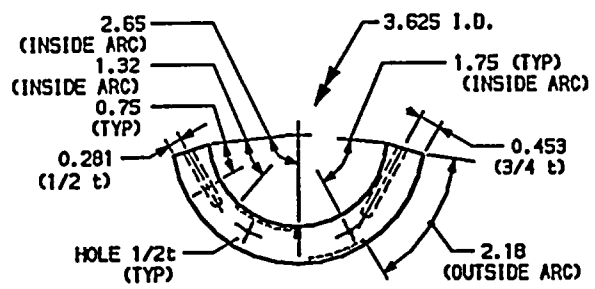

**ELEVATION**

NO	MATERIAL	HEAT NUMBER
①	SA 336 CL F8 S5	5977
②	SA 508 CL 2 CS	113382
③	INCONEL 182	

REFERENCES:  
CBI NUCLEAR CO.  
VPP #3613-652 REV 0

NOTES  
1. ALL DIMENSIONS ARE IN INCHES.

THIS DRAWING IS INTENDED FOR USE IN PRESERVICE AND INSERVICE INSPECTION PROGRAMS ONLY


	<b>WASHINGTON PUBLIC POWER SUPPLY SYSTEM</b> RIDLAND, WASHINGTON 98852
	WPP-2 JET PUMP INSTRUMENTATION, NS UT CALIBRATION BLOCK, UT-109
ENGINEER T HOYLE DRAWN K-MOANDREW DATE 7-12-79	DNO NO: <b>UTCB-109</b> REV 2

NO	DATE	REVISION	BY	CHKD	APVD
2	10-2-82	INCORPORATED AS BUILT EDM NOTCHES. REGRAM	K-MoA	DPR	DPW
1	12-2-81	ADDED HEAT NUMBERS	K-MoA	DPR	TTH
0	7-31-79	ISSUED FOR USE, AS BUILT	K-MoA	DPW	LFB


NO	DATE	REVISION	BY	CHKD	APVD	NO	DATE	REVISION	BY	CHKD	APVD	DATE	DNO NO.	REV
												7-12-79	UTCB-109	2




A  
B  
C  
D  
E  
F  
G  
H

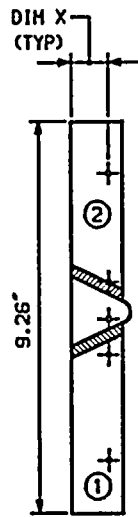


END VIEW

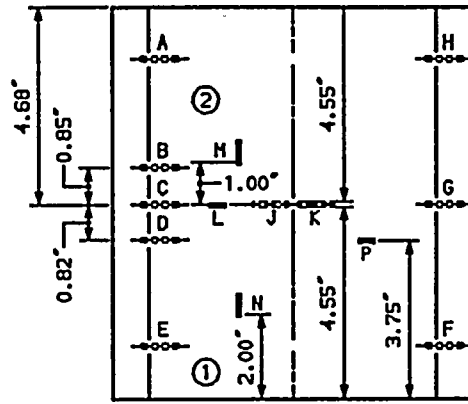

PLAN VIEW

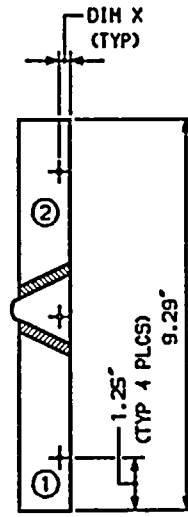

END VIEW

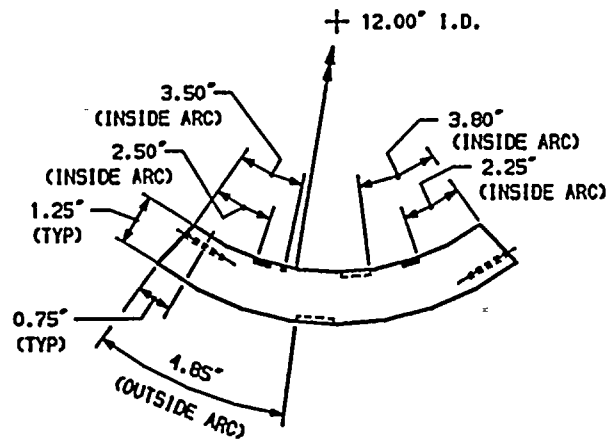

ELEVATION

EDM NOTCHES			
NOTCH	LENGTH	WIDTH	DEPTH
L	0.50	0.030	0.248
M	0.50	0.030	0.249
N	0.50	0.030	0.126
P	0.50	0.030	0.121

NOTCH	LENGTH	WIDTH	DEPTH
J	1.234	0.133	0.114-0.124
K	1.171	0.126	0.104-0.109

HOLE	DIAMETER	LENGTH	DIM X
A	0.125	1.51	0.90
B	0.126	1.53	0.90
C	0.125	1.50	0.91
D	0.126	1.50	0.88
E	0.126	1.50	0.89
F	0.125	1.50	0.29
G	0.125	1.57	0.28
H	0.126	1.54	0.27

NO.	MATERIAL	HEAT NUMBER
①	SA 182 GR F316L SS	77086
②	SA 508 CL 2 CS	224637

REFERENCES:

APPE / GE ORDER #F-20165A  
SHOP SHEET 1 REV 3

THIS DRAWING IS INTENDED FOR USE IN PRESERVICE AND INSERVICE INSPECTIONS PROGRAMS ONLY



WASHINGTON PUBLIC POWER  
SUPPLY SYSTEM  
RIDGELAND, WASHINGTON 98582

NO	DATE	REVISION	BY	CHKD	APVD
2	5-15-82	INCORPORATED AS BUILT EDM NOTCHES, REDRAWN	K-MoA	DPR	DRM
1	12-2-81	ADDED HEAT NUMBERS & I.D. DIM	K-MoA	DPR	TFH
0	9-17-79	ISSUED FOR USE, AS BUILT	K-MoA	TH	LFB

ENGINEER T MOYLE  
DRAWN K-MoANDREW  
DATE 9-27-79


WPP-2 NOZZLE TO SAFE-ENO, M2 UT CALIBRATION BLOCK, UT-111
DWG NO. UTCB-111
REV 2

NO	DATE	REVISION	BY	CHKD	APVD
NO	DATE	REVISION	BY	CHKD	APVD








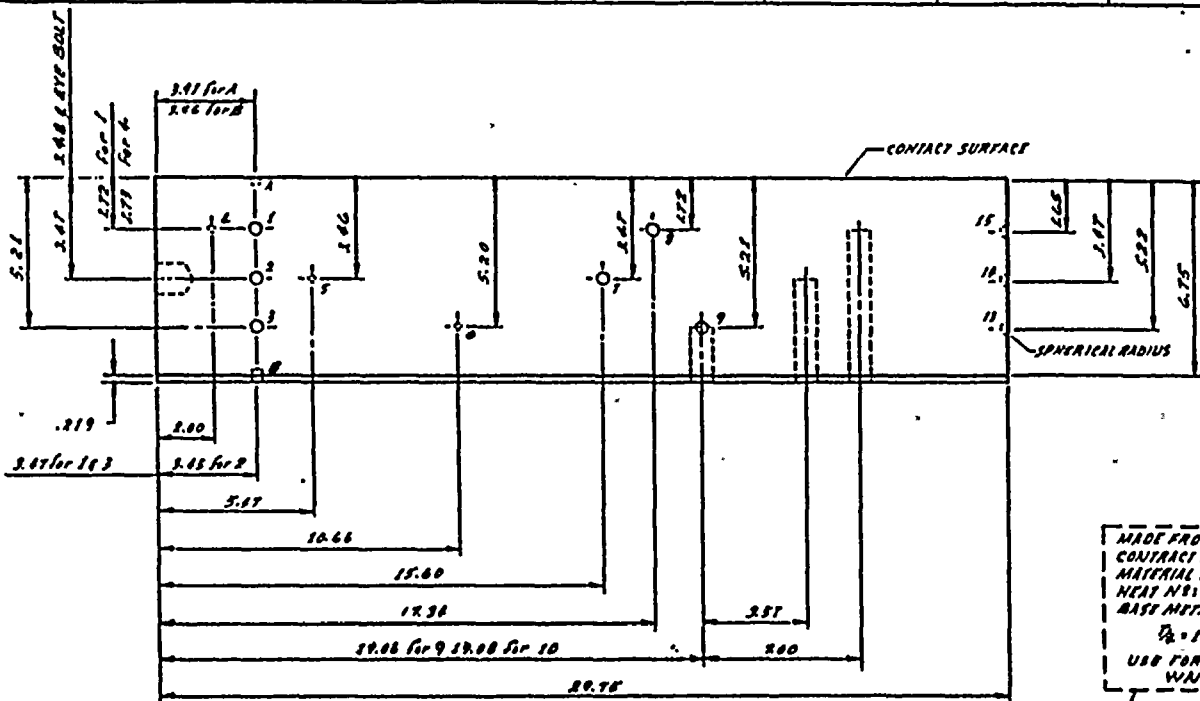

HOLES	Ø	DEPTH
1	.316	3.10
2	.316	3.11
3	.316	2.96
4	.192	3.09
5	.190	3.06
6	.190	3.06
7	.316	3.10
8	.316	2.76
9	.316	3.15
10	.77	1.81
11	.76	3.56
12	.77	5.16
13	.320	—
14	.312	—
15	.320	—

NOTCHES	A	B
LENGTH	2.00	2.00
WIDTH	.125	.128
DEPTH	.171	.152

MADE FROM: 607 HD DOL Q  
 CONTRACT NO: 12-2607  
 MATERIAL SPEC: SA 533 GR B CL 1  
 HEAT NO: B 5190-1  
 BAST METAL THK: 0.3/4  
 $V_1 = 1.78$ ,  $V_2 = 3.87$   $3/4 = 0.30$   
 USE FOR BOTTOM HEAD RAD. PLATE  
 WNP-2 UT-118

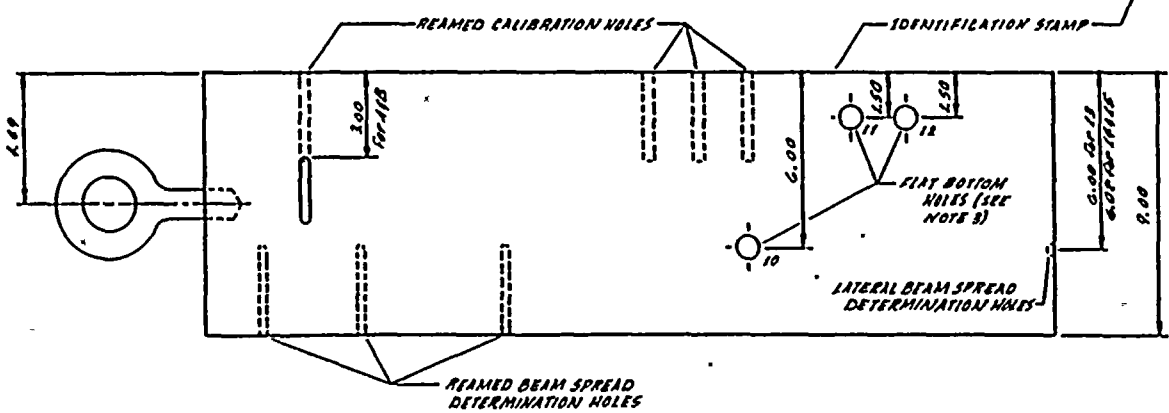

- NOTES:**
1. AS DESIGNED (CORN FABRICATED CALIBRATION BLOCK. (SEE REF DWG FOR FABRICATION NOTES, REQUIREMENTS, PART NO, & CUTTING SHEET))
  2. DUE TO VESSEL CURVATURE METAL PATH DISTANCES WILL BE LONGER ON THE VESSEL THAN THIS BLOCK.
  3. THE 1/2 & (11) & 3/4 & (12) FLAT BOTTOM HOLES ARE LOCATED CLOSER TO THE CONTACT SURFACE THAN 3/4 & 3/4 RESPECTIVELY. USE AS BUILT DIMENSIONS.
  4. ALL DIMENSIONS ARE IN INCHES.
  5. WHEN USING NOTCHES FOR EVALUATION, USE AS BUILT DIMENSIONS - THEY ARE NOT 2 1/4 NOTCHES.

**REFERENCE**  
 CBI NUCLEAR CO.  
 205 AB OPP SH 118 REV 2


THIS DRAWING IS INTENDED FOR USE IN PRESERVICE AND INSERVICE INSPECTION PROGRAMS ONLY

**WASHINGTON PUBLIC POWER SUPPLY SYSTEM**  
 RICHLAND, WASHINGTON 99222  
 WNP-2

ENGINEER J HOYLE  
 DRAWN R/M ANDREW

UT CALIBRATION BLOCK, UT 118  
 RPY BOTTOM HEAD RADIAL PLATES

NO	DATE	REVISION	BY	CHKD	APPVD	NO	DATE	REVISION	BY	CHKD	APPVD	DATE	DWG NO	REV
						1	1-14-80	AS BUILT	JCH	AB	SD	1-14-80	UTCB-206	1

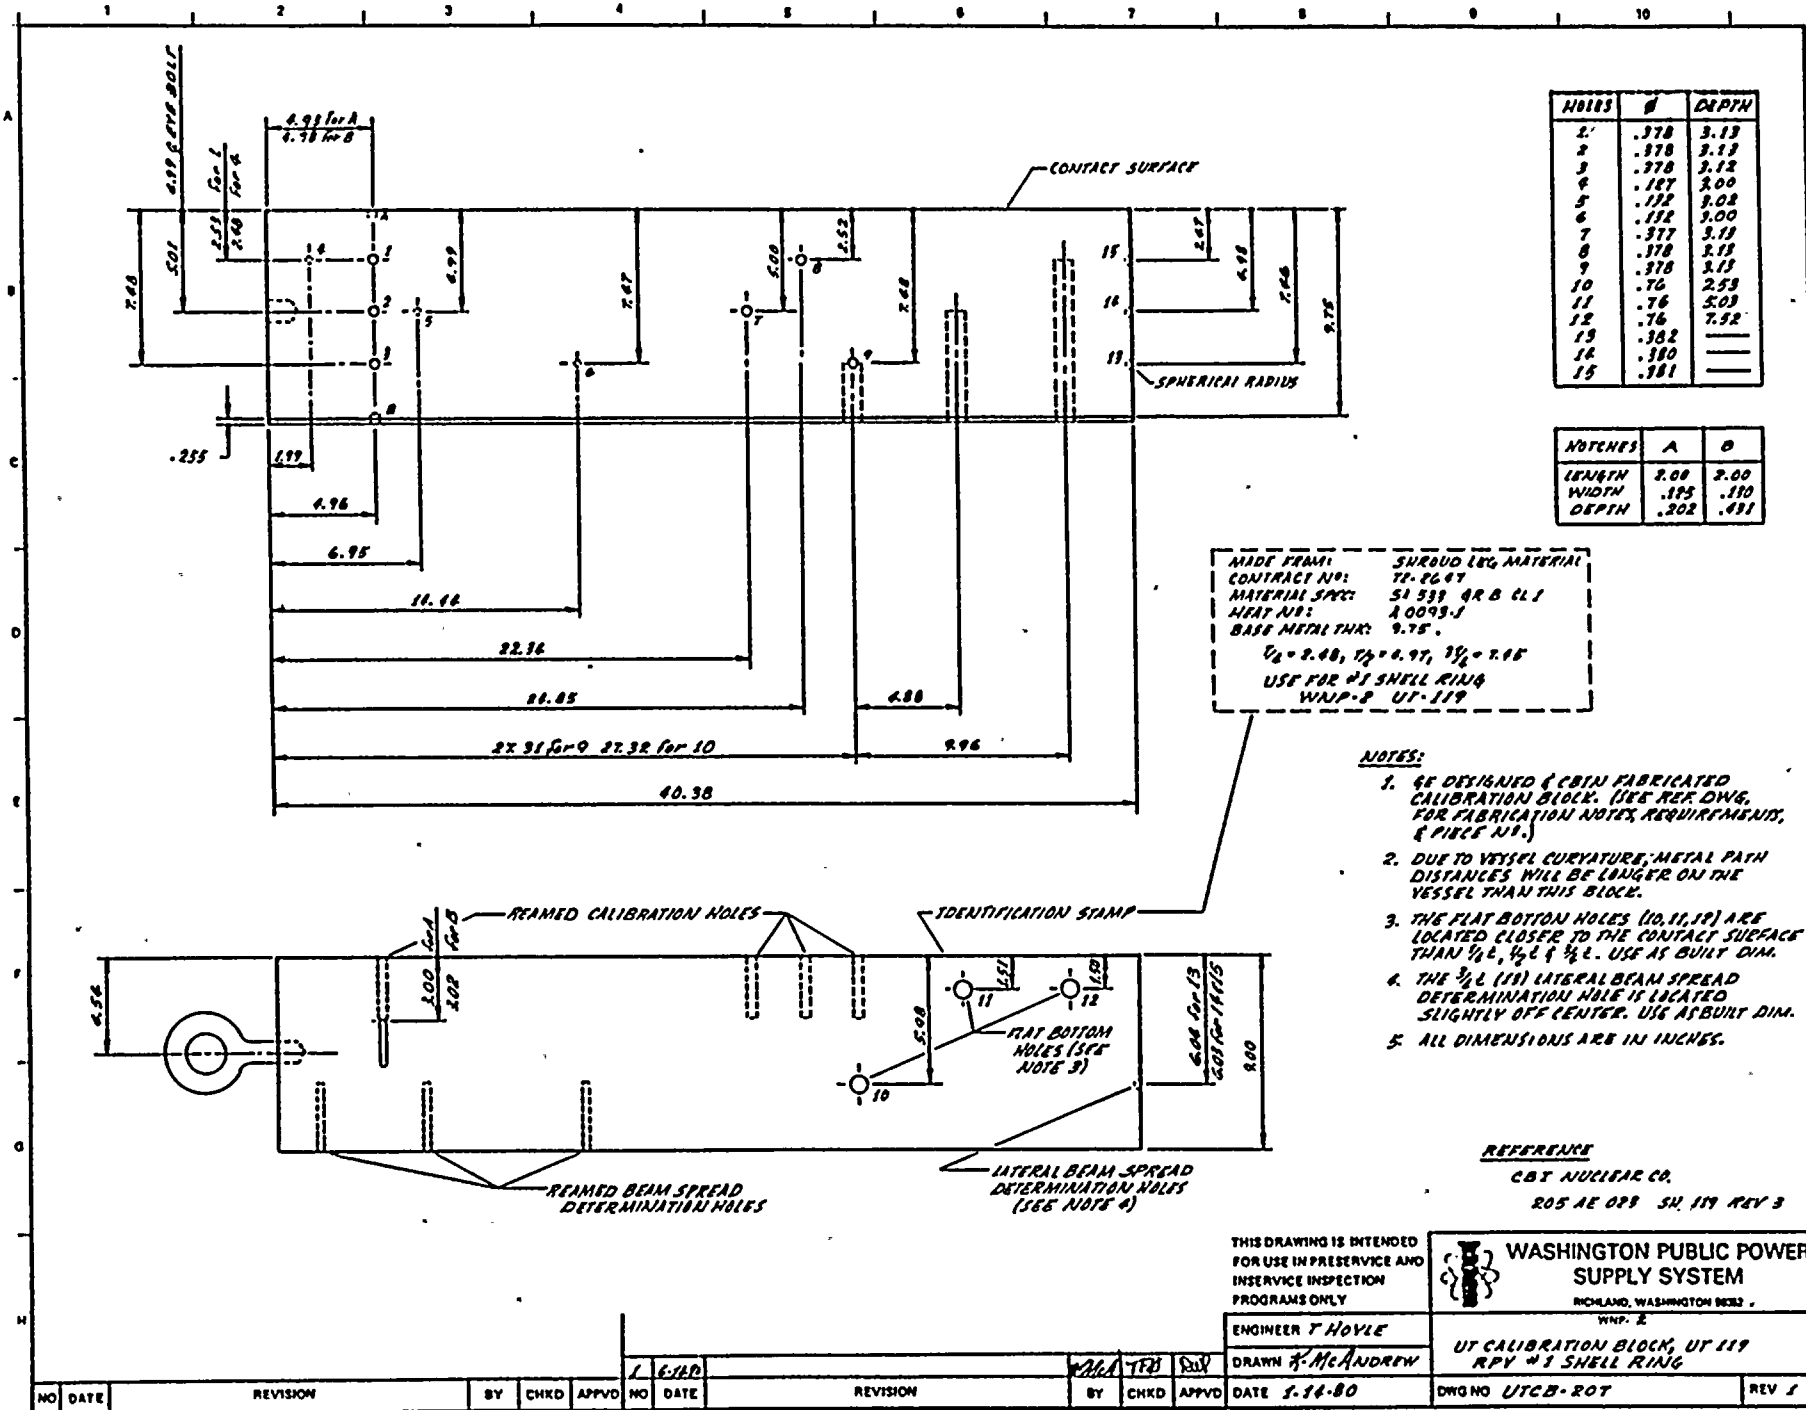

THIS DRAWING IS INTENDED FOR USE IN PRESERVICE AND INSERVICE INSPECTION PROGRAMS ONLY

**WASHINGTON PUBLIC POWER SUPPLY SYSTEM**  
 RICHLAND, WASHINGTON 99352  
 WNP-2


ENGINEER T HOYLE  
 DRAWN K. McANDREW  
 DATE 5-14-80

UT CALIBRATION BLOCK, UT 119 RPY #1 SHELL RING  
 DWG NO UTCB-207  
 REV 1

NO	DATE	REVISION	BY	CHKD	APPVD	NO	DATE	REVISION	BY	CHKD	APPVD	DATE	NO	DATE	REVISION
1	5-14-80											5-14-80			






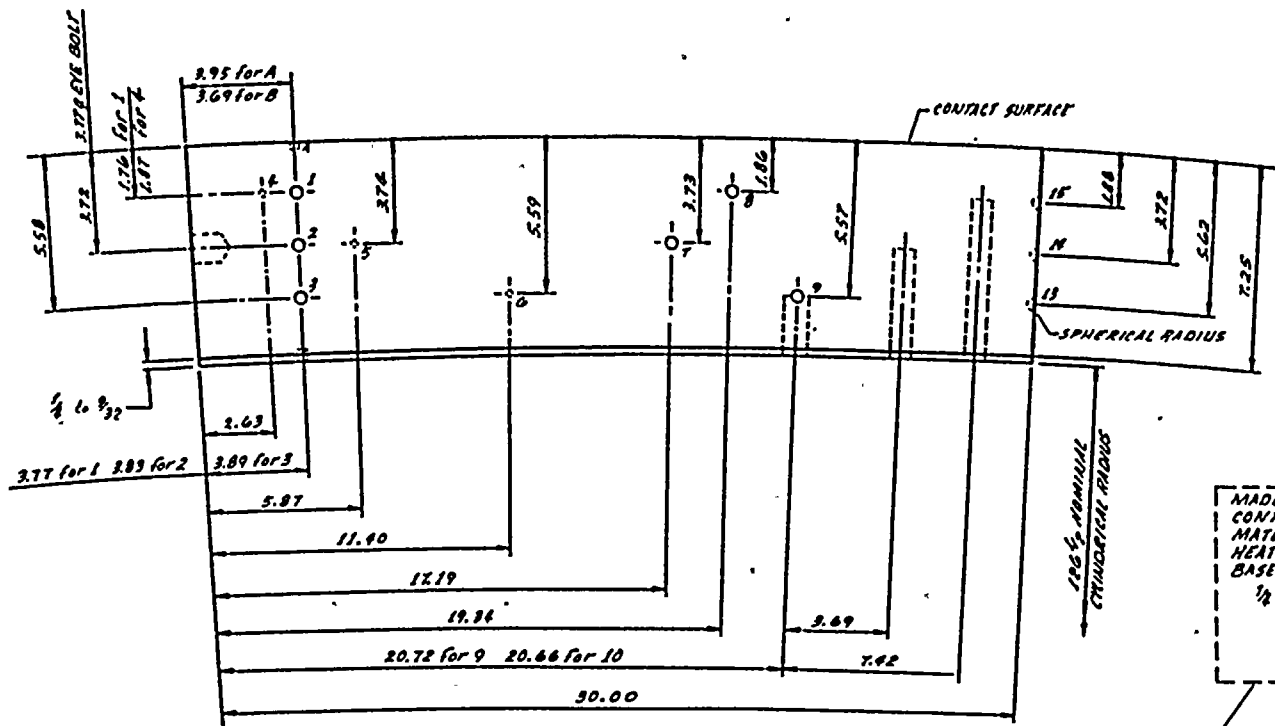

HOLES	Ø	DEPTH
1	.314	3.06
2	.314	3.06
3	.312	3.08
4	.312	2.97
5	.312	2.98
6	.312	2.99
7	.312	3.04
8	.311	3.05
9	.311	3.04
10	.75	2.00
11	.75	3.96
12	.75	5.85
13	.312	—
14	.312	—
15	.312	—

NOTCHES	A	B
LENGTH	1.99	1.98
WIDTH	.115	.116
DEPTH	.162	.105

MADE FROM: #6 SHELL RING  
 CONTRACT NO: TP-2067  
 MATERIAL SPEC: SA 533 GR B C I  
 HEAT NO: C 1875  
 BASE METAL THX: 7/16  
 1/2 = 1.86, 3/4 = 3.72, 5/8 = 5.58  
 3/4 DIA HOLES  
 1/2 = 1.78, 3/4 = 3.67  
 WNP-2 UT.121

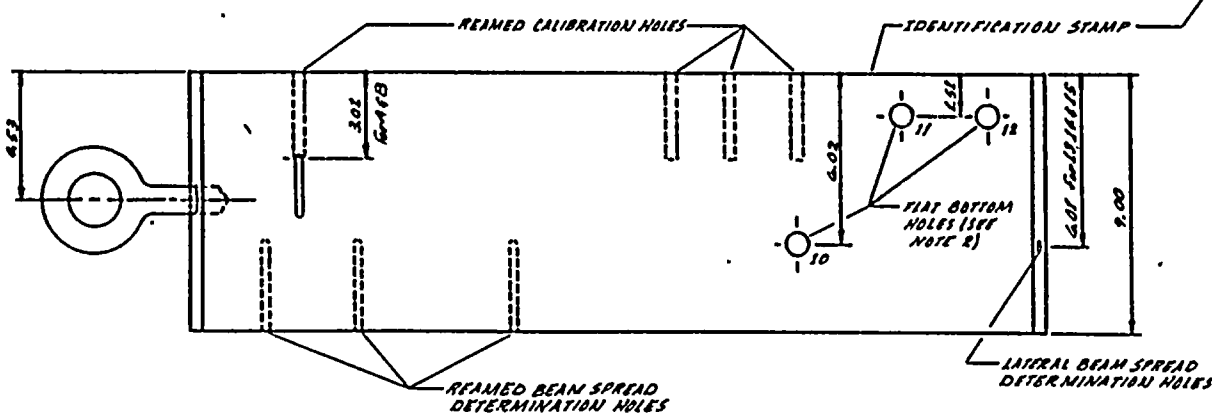

- NOTES:**
1. AS DESIGNED & FABRICATED CURVED CALIBRATION BLOCK. (SEE REF. DWG. FOR FABRICATION NOTES, REQUIREMENTS, PIECE NO & CUTTING SKETCH)
  2. THE 1/2 (10) & 3/4 (11) FLAT BOTTOM HOLES ARE CLOSER TO THE CONTACT SURFACE THAN 1/4 & 3/8 C RESPECTIVELY. USE AS BUILT DIM.
  3. ALL DIMENSIONS ARE IN INCHES.

**REFERENCE**  
 CBI NUCLEAR CO  
 205 AE 023 SH 121 REV 3


THIS DRAWING IS INTENDED FOR USE IN PRESERVICE AND INSERVICE INSPECTION PROGRAMS ONLY

**WASHINGTON PUBLIC POWER SUPPLY SYSTEM**  
 RICHLAND, WASHINGTON 99352  
 WNP-2


ENGINEER T HOYLE  
 DRAWN J. McANDREW  
 DATE 1-15-80

UT CALIBRATION BLOCK, UT 121  
 RPV #6 SHELL RING  
 DWG NO UTCD-209  
 REV 1

NO	DATE	REVISION	BY	CHKD	APPVD
1	6-10-80	AS BUILT			

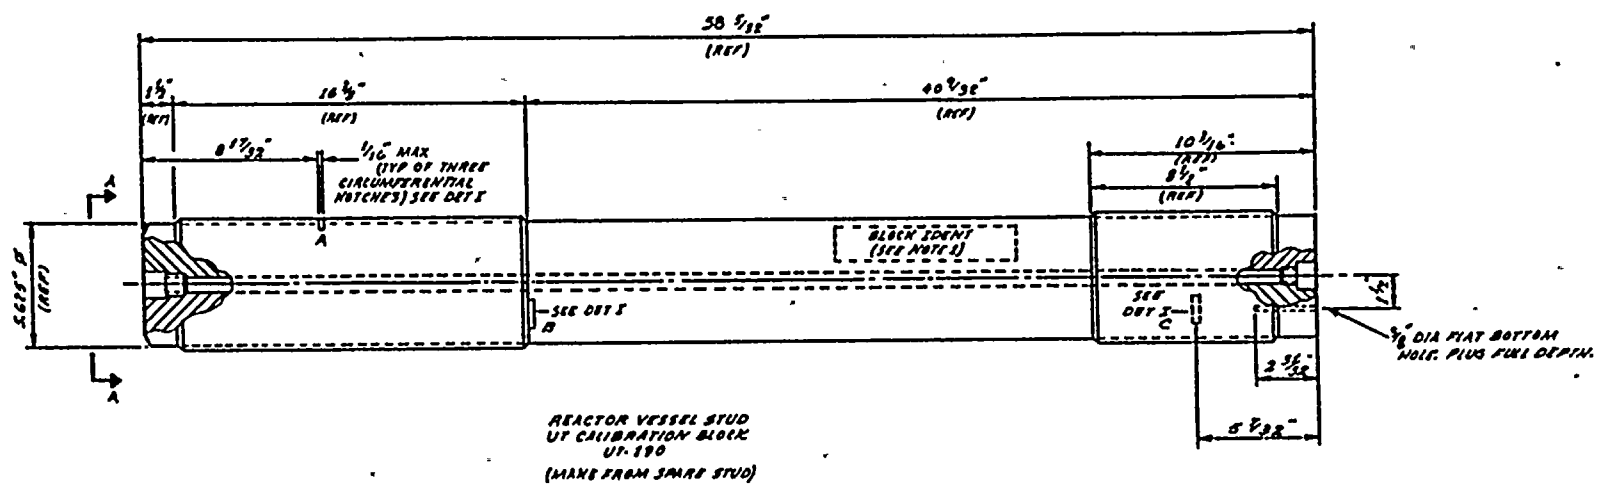

NOTCHES	A	B	C
LENGTH	0.379	0.379	0.372
WIDTH	0.0625	0.0625	0.0625
DEPTH	0.166	0.169	0.157

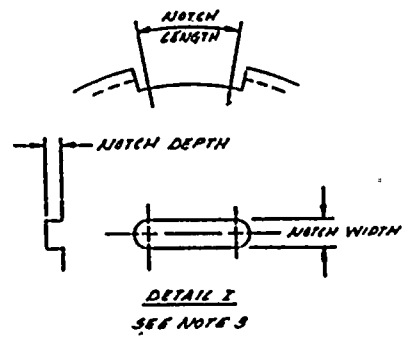

Daniel W. Porter

- NOTES:**
1. STUD STAMPED ON SHAFT WITH 1/2" HIGH STEEL STAMP WITH CH BLOCK N° UT-130.
  2. 1/32 INCH MACHINING TOLERANCES ARE APPLICABLE UNLESS OTHERWISE NOTED.
  3. LOCATE NOTCHES 120° APART AS SHOWN IN SECTION A-A.
- REFERENCES:**
- CBT NUCLEAR CO.  
205 AC 628 SHX, BY REV 1


THIS DRAWING IS INTENDED FOR USE IN PRESERVICE AND INSERVICE INSPECTION PROGRAMS ONLY

**WASHINGTON PUBLIC POWER SUPPLY SYSTEM**  
RICHLAND, WASHINGTON 99352


WPP-2  
RPV STUD  
UT CALIBRATION BLOCK

ENGINEER NG HALLAS  
DRAWN J. McANDREW  
DATE 7.18.78  
DWG NO UTCB-150  
REV 3

NO	DATE	REVISION	BY	CHKD	APPVD	NO	DATE	REVISION	BY	CHKD	APPVD	DATE
1	7-18-78	ISSUED FOR CONSTRUCTION	JM	TH	TH	1	7-18-78	ISSUED FOR CONSTRUCTION	JM	TH	TH	7-18-78
2	7-18-78	CHANGED NOTCH DEF. IN F-6	JM	TH	TH	2	7-18-78	CHANGED NOTCH DEF. IN F-6	JM	TH	TH	7-18-78
3	7-18-78	PERMANENT SUBSTITUTION OF SAE 5140 FOR SAE 5140	JM	TH	TH	3	7-18-78	PERMANENT SUBSTITUTION OF SAE 5140 FOR SAE 5140	JM	TH	TH	7-18-78
4	7-18-78	AS BUILT	JM	TH	TH	4	7-18-78	AS BUILT	JM	TH	TH	7-18-78

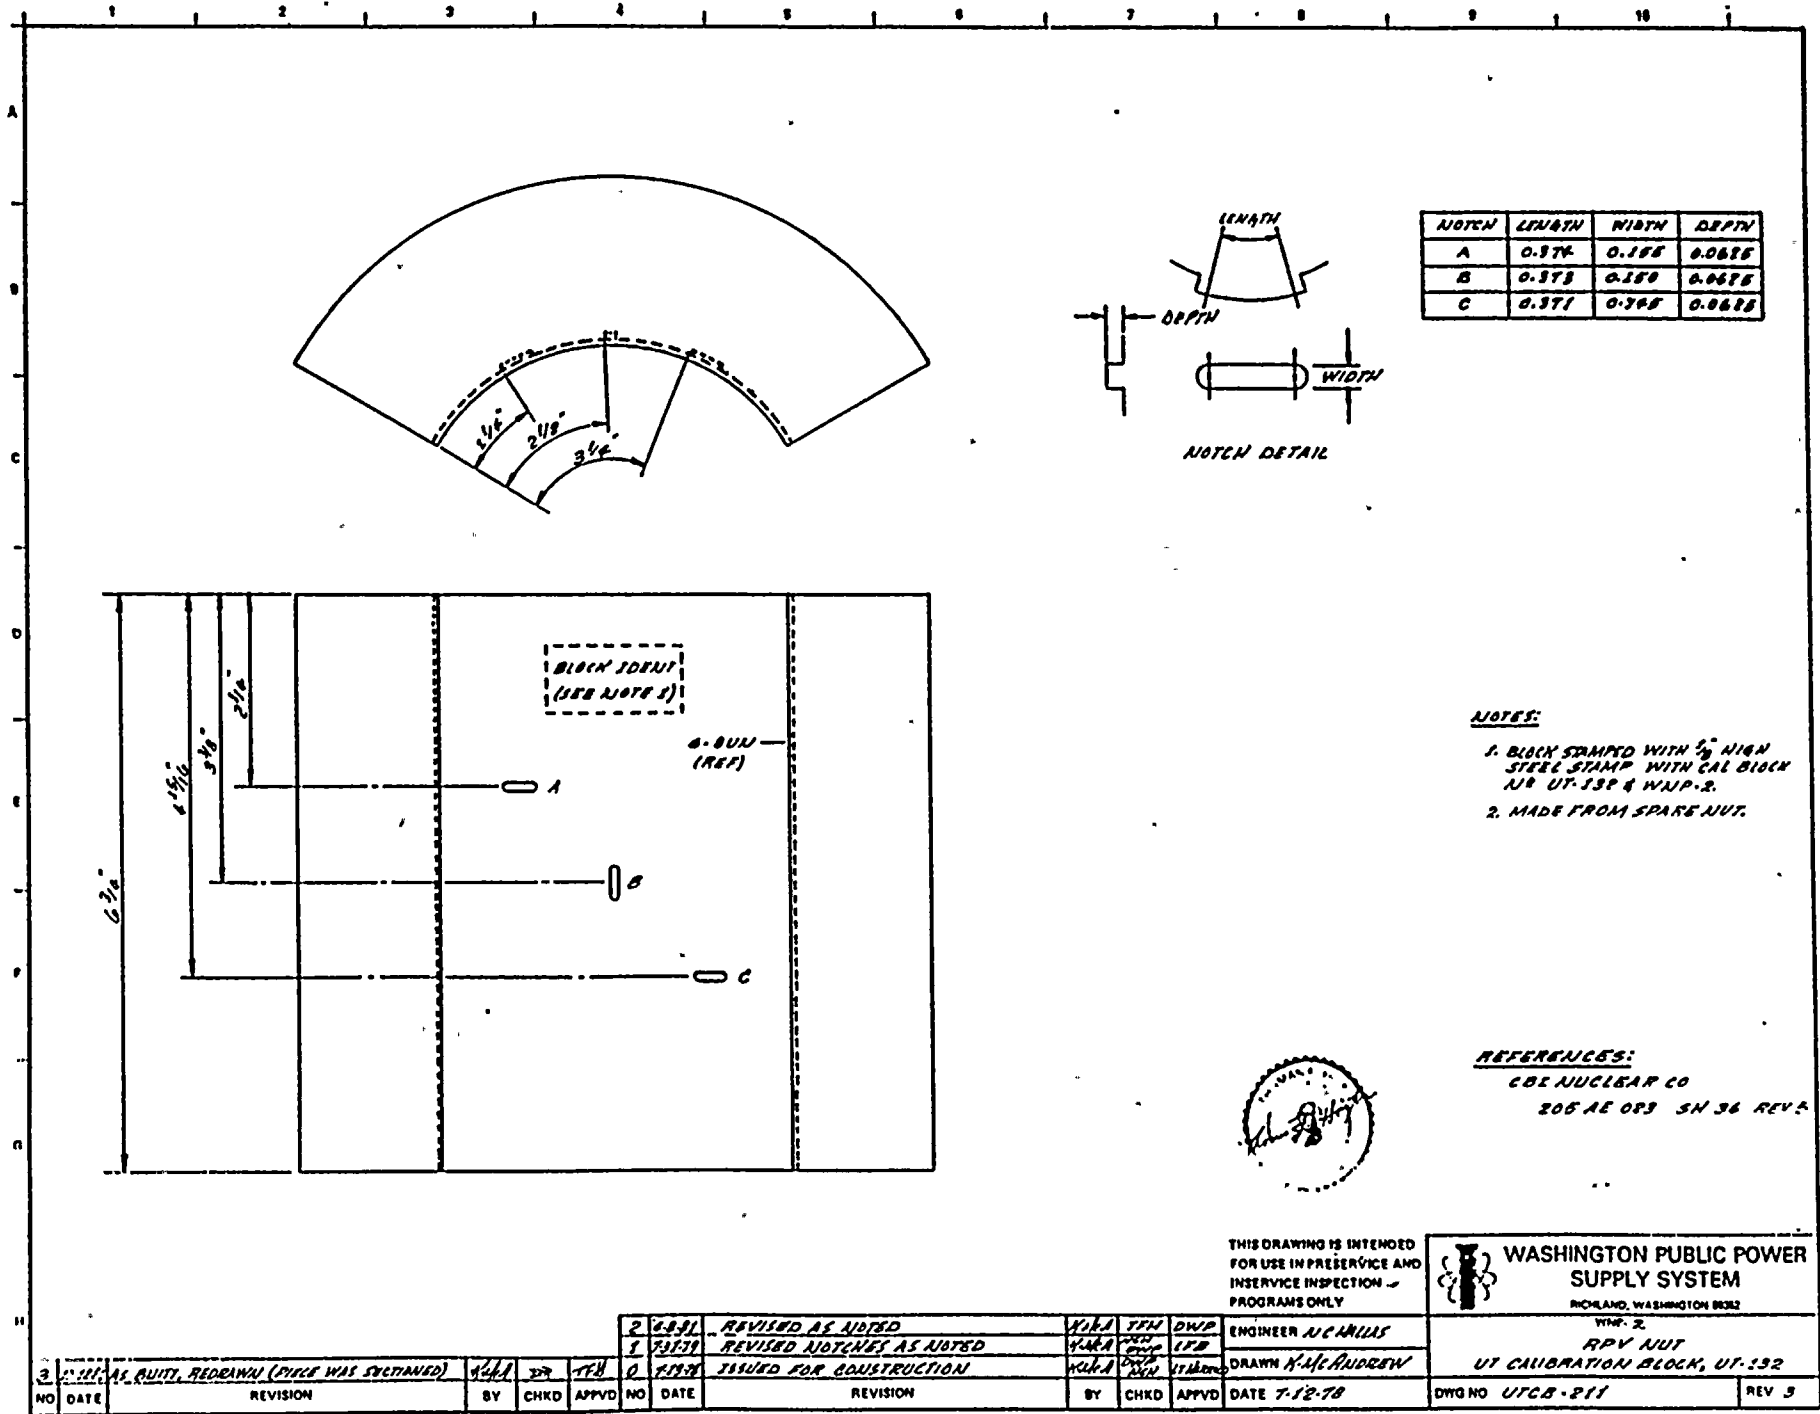

NOTCH	LENGTH	WIDTH	DEPTH
A	0.374	0.185	0.0615
B	0.373	0.189	0.0675
C	0.371	0.185	0.0675

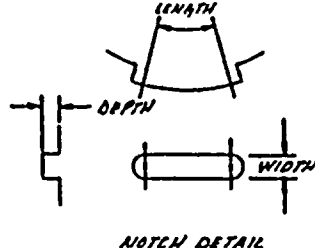

**NOTES:**

1. BLOCK STAMPED WITH 2" HIGH STEEL STAMP WITH CAL BLOCK NR UT-132 & WJLP-2.
2. MADE FROM SPARE NUT.


**REFERENCES:**  
 CBE NUCLEAR CO  
 205 AE 023 SH 36 REV 2





THIS DRAWING IS INTENDED FOR USE IN PRESERVICE AND INSERVICE INSPECTION PROGRAMS ONLY

**WASHINGTON PUBLIC POWER SUPPLY SYSTEM**  
 WJLP-2  
 RRV NUT  
 UT CALIBRATION BLOCK, UT-132

NO	DATE	REVISION	BY	CHKD	APPVD	NO	DATE	REVISION	BY	CHKD	APPVD	DATE	DWG NO	REV
3	11/11/78	AL. QUITY, REDRAWN (CIRCLE WAS SUPPLEMENTED)	ALQ	SR	TEH	0	7/12/78	ISSUED FOR CONSTRUCTION	KUL	TEH	WJLP	7-12-78	UTCB-211	3
2	6/29/78	REVISED AS NOTED				1	7/12/78	REVISED NOTCHES AS NOTED	KUL	TEH	WJLP			
1	7/12/78	REVISED NOTCHES AS NOTED				0	7/12/78	ISSUED FOR CONSTRUCTION	KUL	TEH	WJLP			

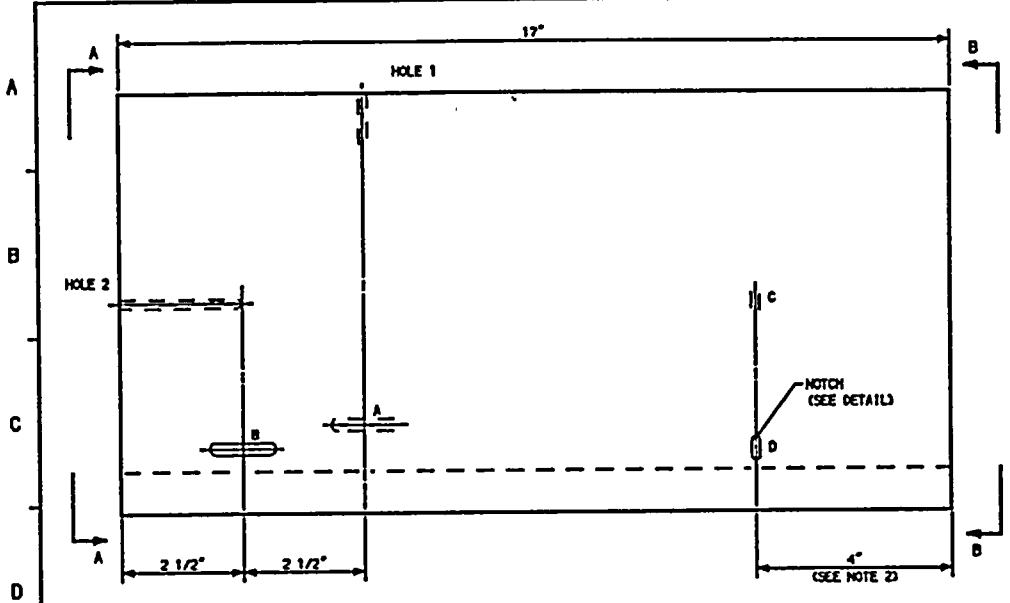

CAL BLOCK NUMBER	NOM. PIPE SIZE	NOM. WALL THK "t"	MATERIAL SPEC	NOTCH DEPTH	HOLE DIA "d"	HEAT NUMBER
UT-1	30	1.250	SA 155 KCF-70	0.123 0.118	0.122 0.110	1/8"
UT-2	28	1.420	SA 155 KCF-70	0.127 0.130	0.125 0.111	1/8"
UT-3	28	1.125	SA 155 KCF-70	0.109 0.108	0.113 0.109	1/8"
UT-4	SEE UTCB-224					
UT-5	24	1.812	SA 108 GR 8	0.152 0.155	0.151 0.154	1/8"
UT-6	24	1.218	SA 108 GR 8	0.113 0.110	0.130 0.115	1/8"
UT-7	24	1.140	SA 358 GR 304	0.109 0.110	0.108 0.108	1/8"
UT-8	SEE UTCB-233					
UT-9	20	1.031	SA 358 GR 304	0.103 0.109	0.106 0.104	1/8"
UT-10	20	1.031	SA 108 GR 8	0.105 0.098	0.093 0.108	1/8"
UT-11	18	1.375	SA 108 GR 8	0.124 0.128	0.120 0.125	1/8"
UT-12	18	0.938	SA 108 GR 8	0.093 0.092	0.095 0.092	3/32"
UT-13	16	1.035	SA 358 GR 304	0.075 0.077	0.075 0.078	3/32"
UT-33	24	2.343	SA 108 GR 8	0.186 0.193	0.186 0.182	3/16"
UT-13R	16	1.035	SA 358 GR 304	0.073 0.073	0.077 0.078	3/32"

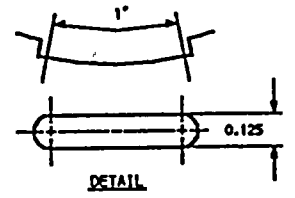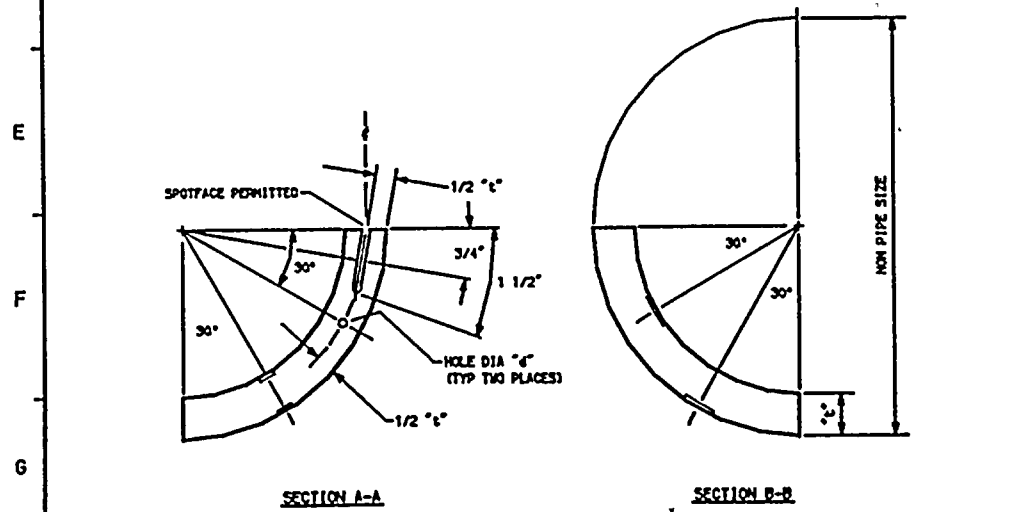

- NOTES**
- BLOCKS STAMPED WITH 1/8" HIGH STEEL STAMP WITH IMP-2, CAL BLOCK NUMBER, NOM PIPE SIZE, MATERIAL AND HEAT NUMBER.
  - DIMENSION 2 1/2" FOR UT-1.
  - DELETED
  - DELETED
  - ALL DIMENSIONS ARE IN INCHES.
  - NOTCH BOTTOM CURVATURE CONFORMS TO PIPE WALL CURVATURE.

THIS DRAWING IS INTENDED FOR USE IN PRESENCE AND INSERVICE INSPECTIONS PROGRAMS ONLY


WASHINGTON PUBLIC POWER  
SUPPLY SYSTEM  
RICHLAND, WASHINGTON 98852

IMP-2  
UT CALIBRATION BLOCKS


DWG NO: UTCB-220 REV 7

NO	DATE	REVISION	BY	CHKD	APVD	NO	DATE	REVISION	BY	CHKD	APVD
7	5-14-80	ADDED UT-13R, AS BUILT. NUMBERED HOLES.	K-McA	OJ	TFH	3	3-28-79	AS BUILT, UT-1, 3, 5, 8, 10, 11 & 12.	K-McA	NOH	LFB
6	12-4-83	ADDED LOGO & REF DIM FOR UT-8. REDRAWN	K-McA	DPR	TFH	2	2-2-78	CORRECTED Z DIMENSIONS. DELETED UT-4.	K-McA	DMP	LFB
5	12-2-81	CORRECTED HEAT NO. FOR UT-8	K-McA	DPR	TFH	1	1-2-78	TABLE REVISED. HOLE DEPTH CHANGED.	K-McA	TFH	LFB
4	7-17-78	AS BUILT UT-2, 7, 9, 13 & 33.	K-McA	TFH	LFB	0	7-13-78	ISSUED FOR CONSTRUCTION	K-McA	DMP	LTH



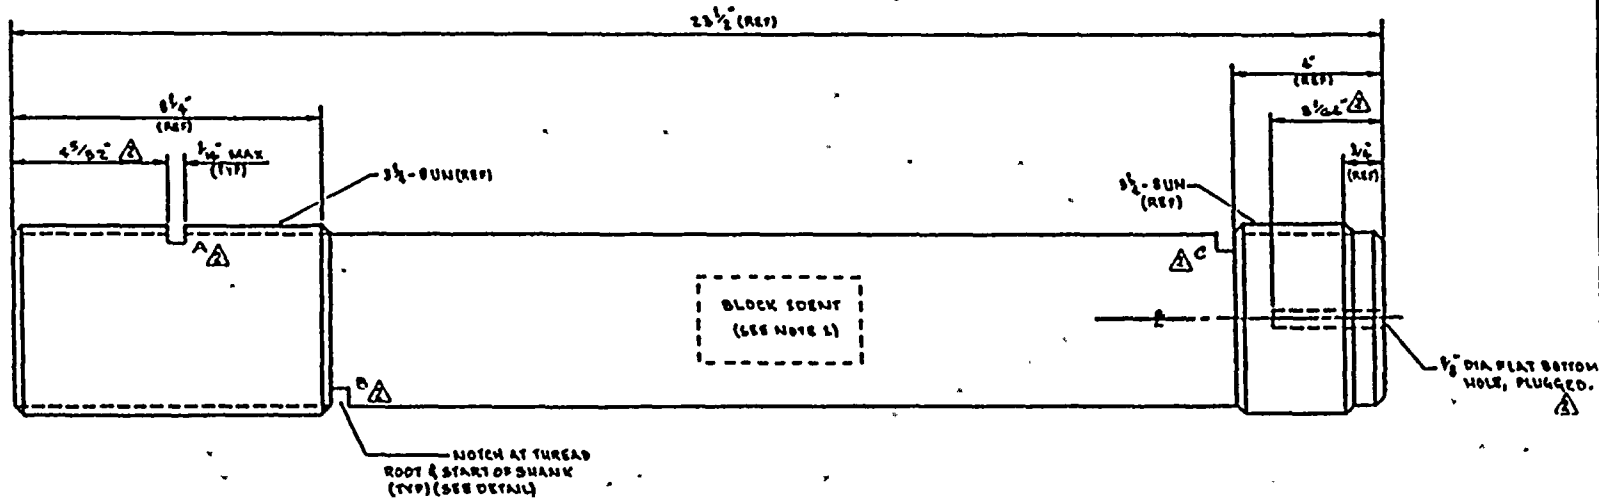

NOTCH	LENGTH	WIDTH	DEPTH
A	.252	1/16"	.101
B	.248	1/16"	.100
C	.253	1/16"	.100

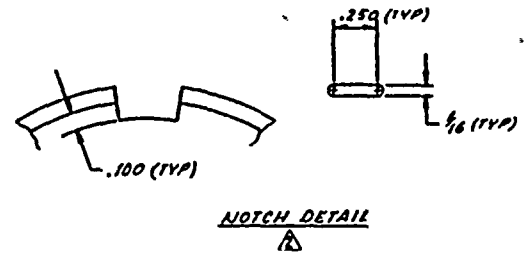

RECIRC PUMP STUD  
UT CALIBRATION BLOCK  
UT-41  
(MAKE FROM SPARE STUD)


- NOTES:**
1. STUD SHANK STAMPED WITH 1/8" HIGH STEEL STAMP WITH CAL BLOCK NO, UT-41 & WNP-2.
  2. DELETED.
  3. NOTCHES LOCATED 120° APART.
  4. NOTCHES ARE PERPENDICULAR TO THE AXIS OF THE STUD.



Daniel W. Porter  
THIS DRAWING IS INTENDED  
FOR USE IN PRESENCE AND  
INSERVICE INSPECTION  
PROGRAMS ONLY

**WASHINGTON PUBLIC POWER  
SUPPLY SYSTEM**  
RICHLAND, WASHINGTON 99185

NO	DATE	REVISION	BY	CHKD	APPVD
E	11-85	AS BUILT REVISED AS NOTED	PH	EP	HE
I	6-86	CORRECTED NOTCH DETAIL	PH	EP	HE
D	1-87	ISSUED FOR CONSTRUCTION	PH	EP	HE

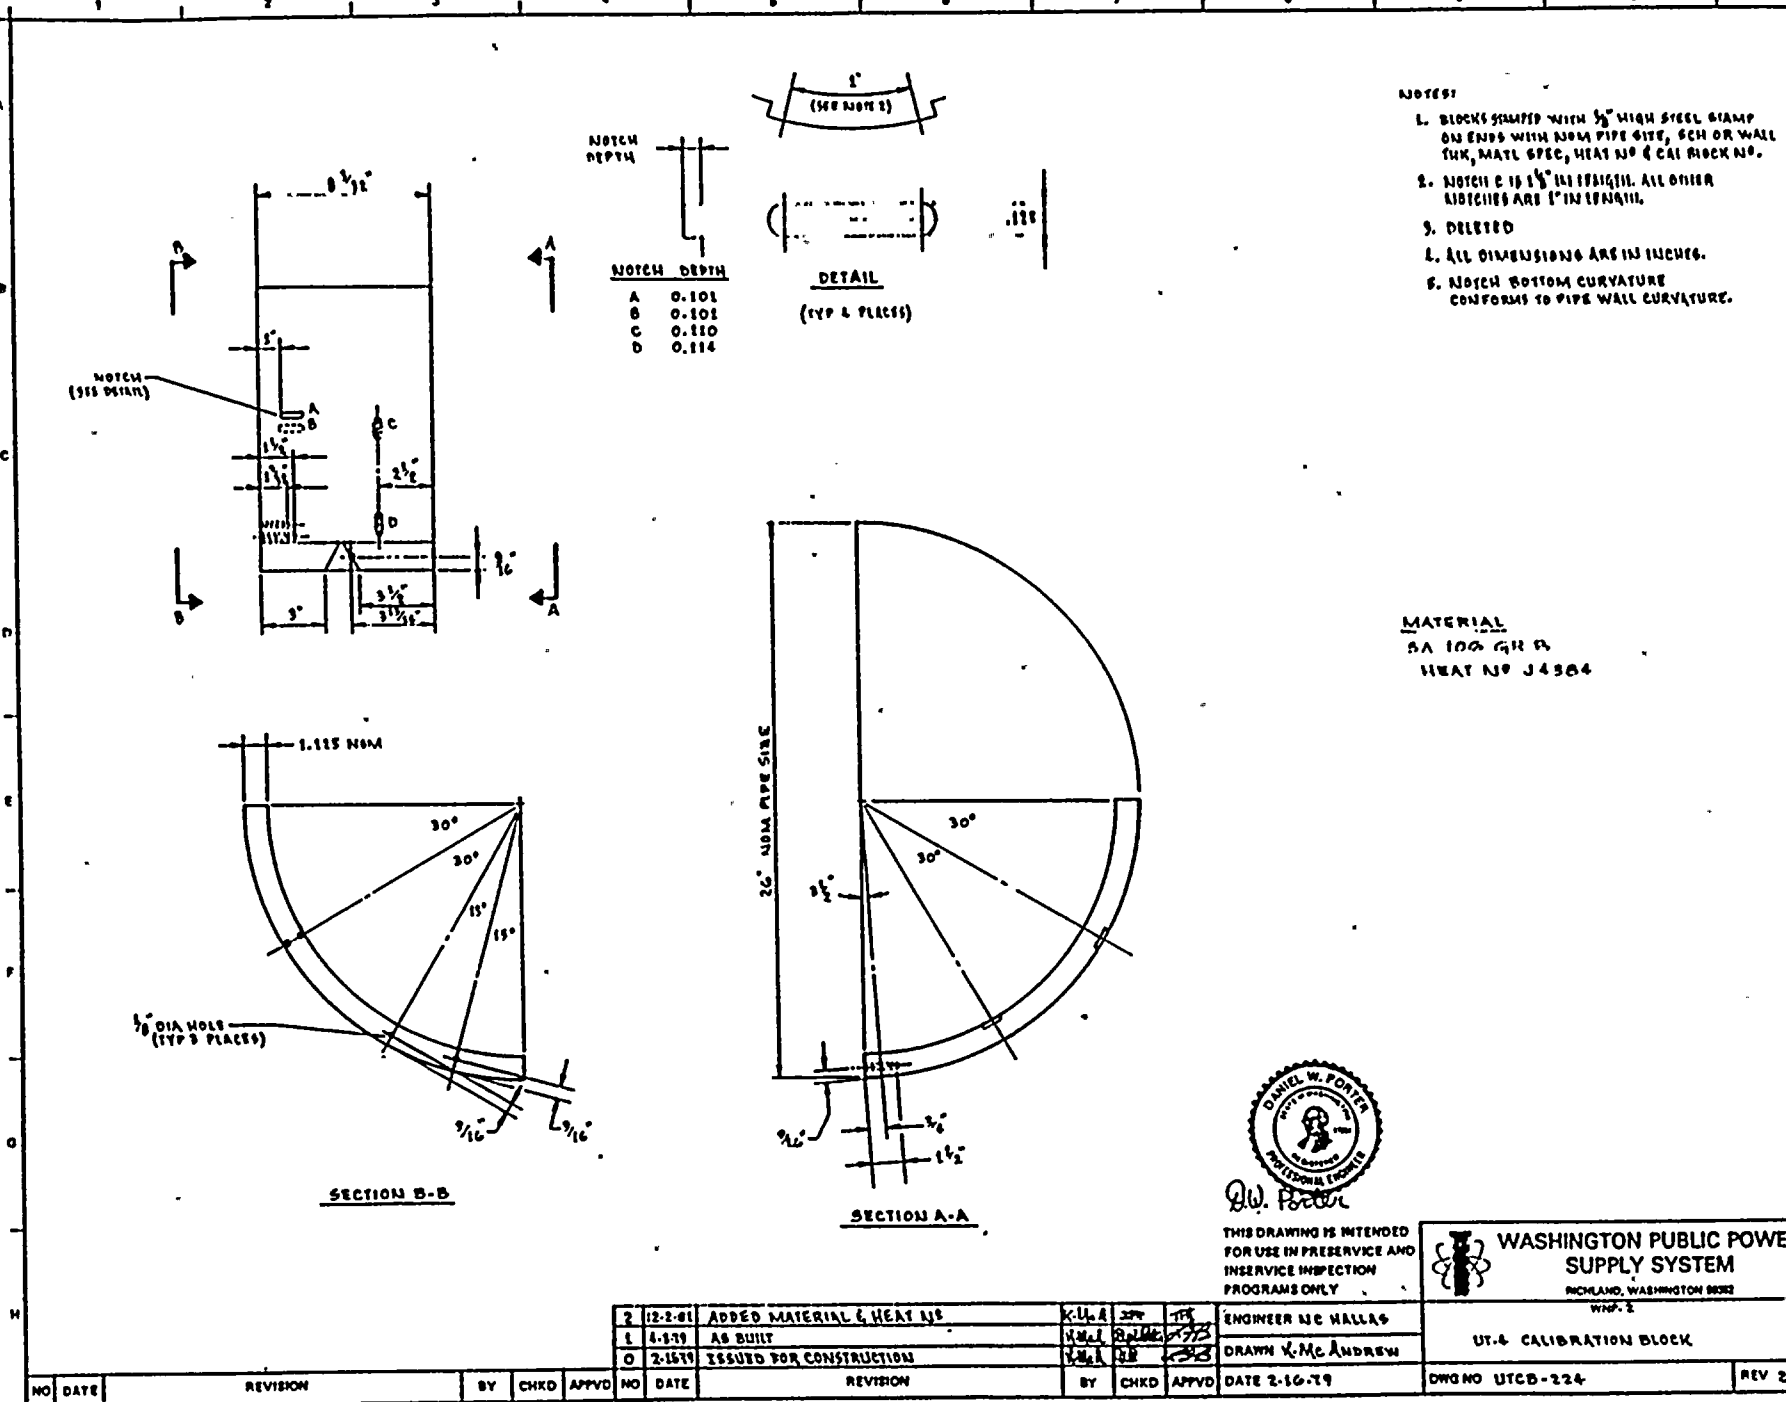

- NOTES
1. BLOCKS STAMPED WITH  $\frac{3}{8}$ " HIGH STEEL STAMP ON ENDS WITH NOM PIPE SIZE, SCH OR WALL THK, MATL SPEC, HEAT NO & CAST BLOCK NO.
  2. NOTCH C IS  $1\frac{1}{2}$ " IN LENGTH. ALL OTHER NOTCHES ARE 1" IN LENGTH.
  3. DELETED
  4. ALL DIMENSIONS ARE IN INCHES.
  5. NOTCH BOTTOM CURVATURE CONFORMS TO PIPE WALL CURVATURE.

MATERIAL  
SA 100 GR B  
HEAT NO J4504



D.W. Porter

THIS DRAWING IS INTENDED FOR USE IN PRESERVICE AND INSERVICE INSPECTION PROGRAMS ONLY

WASHINGTON PUBLIC POWER SUPPLY SYSTEM  
RICHLAND, WASHINGTON 99352

NO	DATE	REVISION	BY	CHKD	APPVD
2	12-2-01	ADDED MATERIAL & HEAT NOS	K.L.A.	277	T.P.
1	1-1-79	AS BUILT	K.M.A.	R.M.E.	A.J.S.
0	2-16-79	ISSUED FOR CONSTRUCTION	K.M.A.	S.P.	A.J.S.

NO	DATE	REVISION	BY	CHKD	APPVD
	2-16-79				












1 2 3 4 5 6 7 8 9 10

A  
B  
C  
D  
E  
F  
G  
H

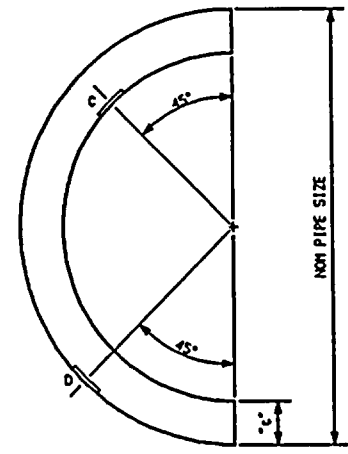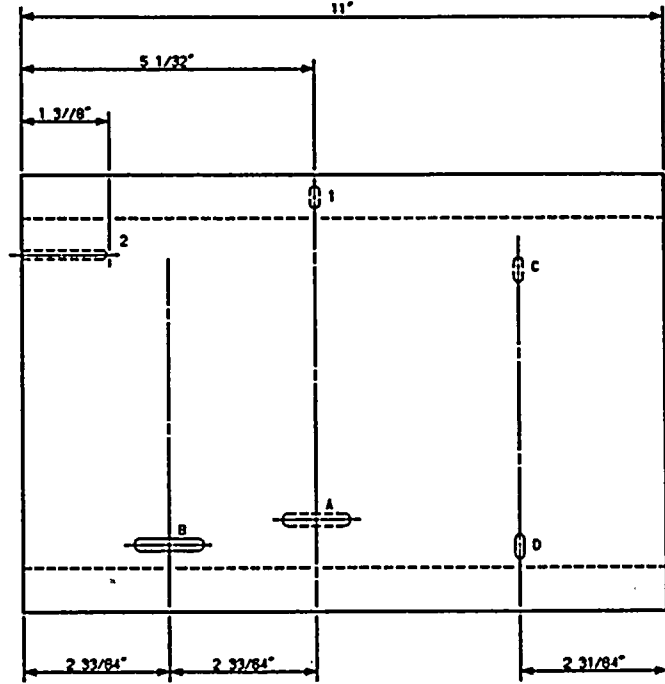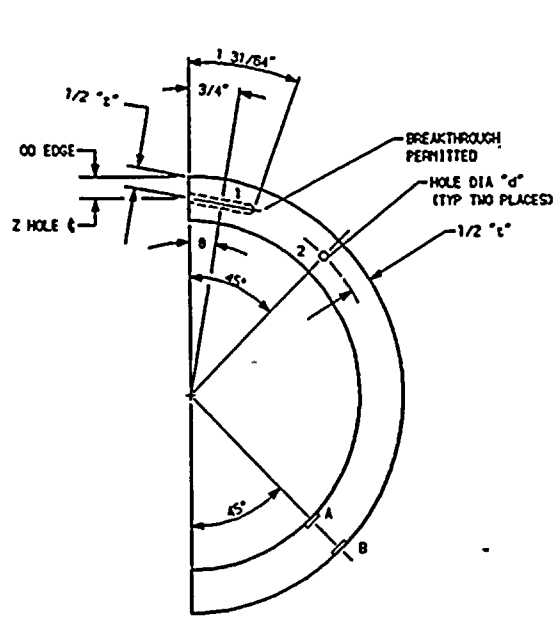

NOTCH	LENGTH	WIDTH	DEPTH
A	0.953	a 0.133 b 0.133 c 0.133	d 0.041 e 0.041
B	0.989	a 0.127 b 0.126 c 0.129	d 0.048 e 0.048
C	0.959	a 0.134 b 0.132 c 0.150	d 0.043 e 0.051
D	0.959	a 0.132 b 0.132 c 0.135	d 0.048 e 0.038

HOLE	DIAMETER	LENGTH
1	0.093	1.484
2	0.093	1.375

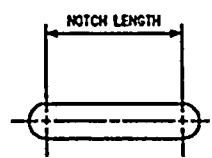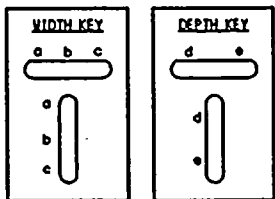

NOTCH DETAIL  
(TYPICAL FOUR PLACES EXCEPT FOR CURVATURE. SEE NOTE 6.)

- NOTES**
1. BLOCKS STAMPED WITH 1/8" HIGH STEEL STAMP ON ENDS WITH WMP-2, CAL BLOCK NUMBER, NOM PIPE SIZE, SCH OR WALL THK, MATL SPEC, AND HEAT NUMBER.
  2. TOLERANCE FOR  $\phi$  IS  $\pm 1/4"$ .
  3. TOLERANCE FOR Z IS  $\pm 0.005$ .
  4. STANDARD MACHINE TOLERANCES ARE APPLICABLE UNLESS OTHERWISE NOTED.
  5. ALL DIMENSIONS ARE IN INCHES.
  6. NOTCH BOTTOM CURVATURE CONFORMS TO PIPE WALL CURVATURE.
  7. DO NOT USE FOR SECT XI EXAMS, NOTCH DEPTH DOES NOT MEET SECT XI REQUIREMENTS.

CAL BLOCK NUMBER	NOM. PIPE SIZE	NOM. WALL THK "t"	MATERIAL SPEC	NOTCH DEPTH	HOLE DIA "d"	HEAT NUMBER
UT-44	3	0.437	SA 106 GR B	0.044 $\pm$ 0.002	3/32	N15462

THIS DRAWING IS INTENDED FOR USE IN PRESERVICE AND INSERVICE INSPECTIONS PROGRAMS ONLY

WASHINGTON PUBLIC POWER  
SUPPLY SYSTEM  
RIDLAND, WASHINGTON 99352

WMP-2  
UT CALIBRATION BLOCK UT-44

ENGINEER DP RAHEY  
DRM K-McANDREW

DATE 2-8-82  
DWC No. **UTCB-229** REV 1

NO	DATE	REVISION	BY	CHKD	APVD	NO	DATE	REVISION	BY	CHKD	APVD
1	1-25-93	AS BUILT							K-McA	DPR	DRM
0	9-18-83	ISSUED FOR CONSTRUCTION							K-McA	DM	TFH




1 2 3 4 5 6 7 8 9 10

A  
B  
C  
D  
E  
F  
G  
H

t > 1/2														
CAL BLOCK NUMBER	NOMINAL PIPE SIZE	SCHEDULE	WALL THICKNESS	Ks1°	Ls.100	01s.25°	02s.25°	03s.25°	NOTCH DEPTH ± 0.005 ± 0.010	A ± 0.010	B ± 0.010	HOLE DIAMETER ± 0.010	HEAT NUMBER	MATERIAL SPEC
UT-34	12	80	0.688	57.5	7.25	14.3	21.5	7.2	.067	.172	.518	3/32"	150675	SA 333 GR 8


HOLE	DIAMETER	LENGTH
1	0.033	1.408
2	0.033	1.448
3	0.033	1.500
4	0.033	1.500

NOTCH	LENGTH (NOTE 5)	WIDTH	DEPTH
A	1.002	0.190	0.008
B	1.036	0.188	0.064
C	1.032	0.188	0.060
D	1.014	0.188	0.063

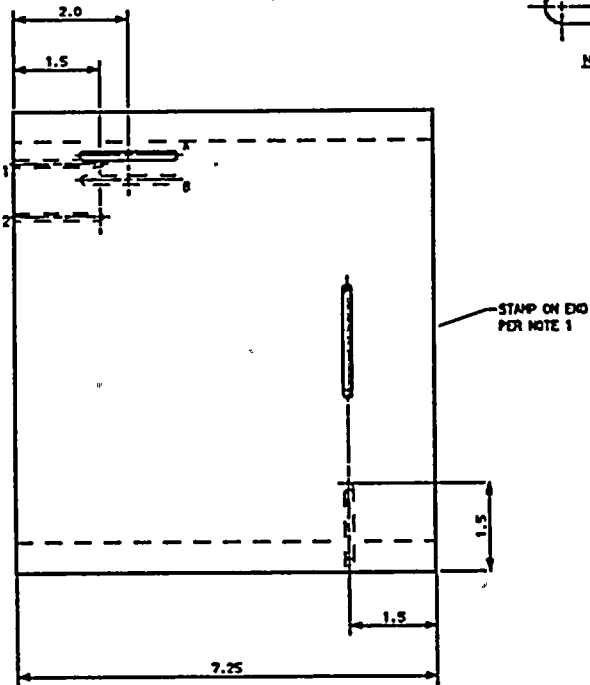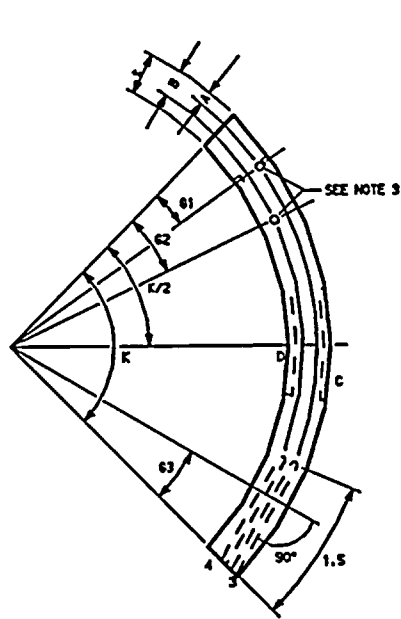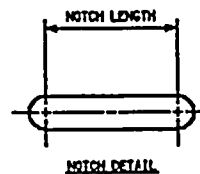

- NOTES**
- BLOCKS STAMPED WITH 1/8" HIGH STEEL STAMP WITH MIP-2, CAL BLOCK NUMBER, NOM PIPE SIZE, MATERIAL, AND HEAT NUMBER.
  - NOTCH BOTTOM CURVATURE CONFORMS TO PIPE WALL CURVATURE.
  - HOLE PARALLEL TO AXIAL SURFACE WITHIN ± .010.
  - HOLES ARE TO BE DRILLED AND REAMED.
  - NOTCH SIDES PERPENDICULAR TO THE SURFACE WITHIN ± 5°.
  - NOTCH WIDTH .250 MAX.
  - ALL DIMENSIONS ARE IN INCHES.
  - MACHINED SURFACE TO BE 250 RMS MAX.
  - LENGTH 1.000 MINIMUM.

THIS DRAWING IS INTENDED FOR USE IN PRESERVICE AND INSERVICE INSPECTIONS PROGRAMS ONLY

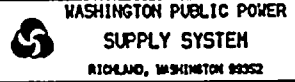

NO	DATE	REVISION	BY	CHKD	APVD
1	4-18-90	AS BUILT			
0	7-21-83	ISSUED FOR CONSTRUCTION			




ENGINEER	DP RANEY
DRAWN	K-MOANDREY
DATE	8-27-83

MIP-2	
UT CALIBRATION BLOCK UT-34	
DWG NO:	UTCB-230
REV	1

NO	DATE	REVISION	BY	CHKD	APVD
----	------	----------	----	------	------

1 2 3 4 5 6 7 8 9 10

A  
B  
C  
D  
E  
F  
G  
H

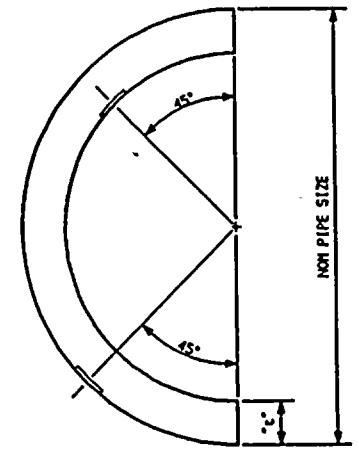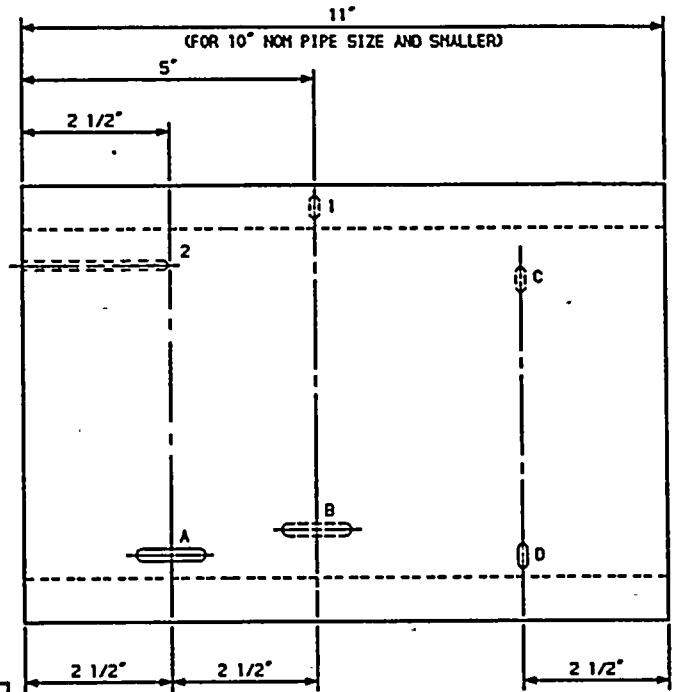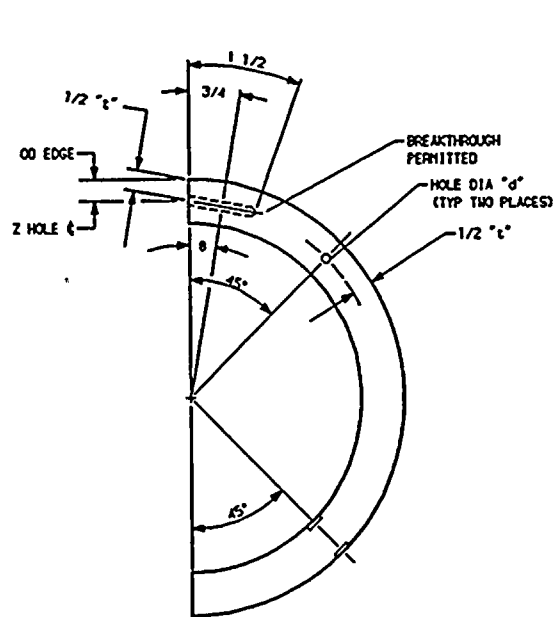

UT-35


NOTCH	LENGTH	WIDTH	DEPTH
A	1.023	0.125	0.048
B	1.023	0.151 0.131	0.044
C	1.000	0.130	0.045
D	1.025	0.124	0.044

UT-36

NOTCH	LENGTH	WIDTH	DEPTH
A	1.043	0.123	0.044
B	1.045	0.128	0.047
C	1.045	0.124	0.043
D	1.067	0.124	0.047

HOLE	DIAMETER	LENGTH	WIDTH KEY
1	0.093	1.500	a b
2	0.093	2.500	a b

HOLE	DIAMETER	LENGTH
1	0.093	1.500
2	0.093	2.500

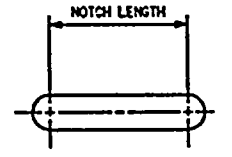

NOTCH DETAIL  
(TYPICAL FOUR PLACES EXCEPT FOR CURVATURE. SEE NOTE 6.3)

- NOTES
1. BLOCKS STAMPED WITH 1/8" HIGH STEEL STAMP ON ENDS WITH WP-2, CAL BLOCK NUMBER, NOM PIPE SIZE, SCH OR WALL THK, MATL SPEC, AND HEAT NUMBER.
  2. TOLERANCE FOR  $\theta$  IS  $\pm 1/4^\circ$ .
  3. TOLERANCE FOR Z IS  $\pm 0.005$ .
  4. STANDARD MACHINE TOLERANCES ARE APPLICABLE UNLESS OTHERWISE NOTED.
  5. ALL DIMENSIONS ARE IN INCHES.
  6. NOTCH BOTTOM CURVATURE CONFORMS TO PIPE WALL CURVATURE.
  7. NOTCH WIDTH ACCEPTABLE MAX WIDTH IS 0.250 IN. PER SECT XI 1990 M 80 APPENDIX III-3430.

CAL BLOCK NUMBER	NOM. PIPE SIZE	NOM. WALL THK "t"	MATERIAL SPEC	NOTCH DEPTH	HOLE DIA "d"	$\theta$	Z	HEAT NUMBER
UT-35	8	0.500	SA 106 GR B	0.050 $\pm$ 0.011	3/32	10.5°	0.181	N14592
UT-36	8	0.432	SA 106 GR B	0.043 $\pm$ 0.011	3/32	13.5°	0.126	N14448

THIS DRAWING IS INTENDED FOR USE IN PRESERVICE AND INSERVICE INSPECTIONS PROGRAMS ONLY

WASHINGTON PUBLIC POWER SUPPLY SYSTEM  
RICHLAND, WASHINGTON 99352

ENGINEER	DP RAMEY
DRWN	K-McANDREW
DATE	6-17-83

WP-2
UT CALIBRATION BLOCKS UT-35 & UT-36
DWG NO. UTCB-231
REV 1

NO	DATE	REVISION	BY	CHKD	APVD	NO	DATE	REVISION	BY	CHKD	APVD
1	1-25-83	AS BUILT							K-McA	DPR	DRM
0	7-14-83	ISSUED FOR CONSTRUCTION							K-McA	DPR	TFH

A  
B  
C  
D  
E  
F  
G  
H

t < 0.500									
CAL. BLOCK NUMBER	NOMINAL PIPE SIZE	SCHEDULE	WALL THICKNESS	Kx1°	Lx.100	61x.25°	Cx.010	HEAT NUMBER	MATERIAL SPEC
UT-18	12	STD	0.375	45.0°	5.5	13.5°	0.188	J814481	SA 108 GR B
UT-37	18	30	0.438	32.0°	8.0	9.6°	0.219	L20182	SA 108 GR B
UT-38	14	STD	0.375	39.0°	5.5	12.3°	0.188	L25099	SA 108 GR B
UT-39	16	STD	0.375	34.0°	5.5	10.7°	0.188	L00727	SA 106 GR B
UT-45	20	STD	0.375	27.0°	5.5	9.6°	0.188	M15878	SA 106 GR B
UT-20	18	STD	0.375	30.0°	5.5	9.6°	0.188	L21507	SA 106 GR B
UT-50	24	STD	0.375	23.0°	5.5	7.2°	0.188	K33206	SA 108 GR B

UT-18			
NOTCH	LENGTH	WIDTH	DEPTH
A	1.002	0.188	0.041
B	1.006	0.188	0.042
C	1.015	0.188	0.039
D	1.010	0.188	0.039
HOLE	DIAMETER	LENGTH	
1	0.094	1.494	

UT-20			
NOTCH	LENGTH	WIDTH	DEPTH
A	1.000	0.190	0.037
B	1.009	0.187	0.041
C	1.008	0.183	0.038
D	1.018	0.189	0.037
HOLE	DIAMETER	LENGTH	
1	0.094	1.435	




UT-37			
NOTCH	LENGTH	WIDTH	DEPTH
A	1.128	0.190	0.048
B	1.008	0.199	0.046
C	1.009	0.191	0.044
D	1.003	0.191	0.041
HOLE	DIAMETER	LENGTH	
1	0.094	1.491	

UT-38			
NOTCH	LENGTH	WIDTH	DEPTH
A	1.000	0.188	0.039
B	1.015	0.191	0.042
C	1.006	0.191	0.039
D	1.000	0.191	0.038
HOLE	DIAMETER	LENGTH	
1	0.094	1.477	

UT-39			
NOTCH	LENGTH	WIDTH	DEPTH
A	1.009	0.190	0.038
B	1.000	0.187	0.040
C	1.014	0.183	0.035
D	1.000	0.187	0.033
HOLE	DIAMETER	LENGTH	
1	0.094	1.500	

UT-45			
NOTCH	LENGTH	WIDTH	DEPTH
A	1.005	0.190	0.038
B	1.037	0.190	0.043
C	1.010	0.190	0.043
D	1.009	0.187	0.035
HOLE	DIAMETER	LENGTH	
1	0.094	1.500	

UT-50			
NOTCH	LENGTH	WIDTH	DEPTH
A	1.002	0.187	0.043
B	1.000	0.189	0.039
C	1.012	0.188	0.040
D	1.000	0.185	0.042
HOLE	DIAMETER	LENGTH	
1	0.094	1.500	

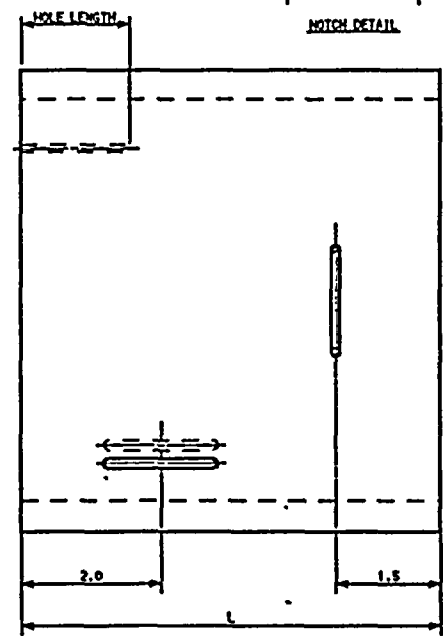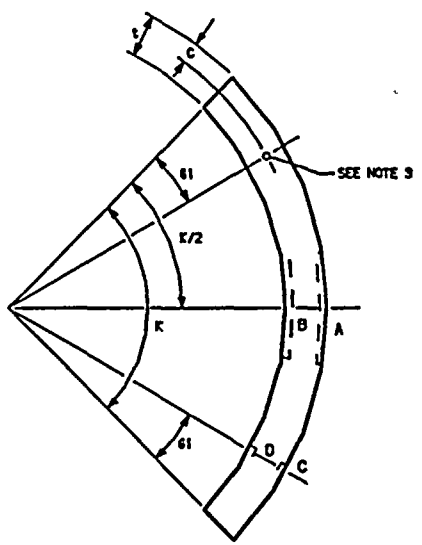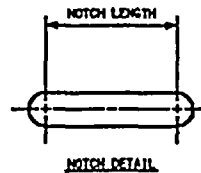

- NOTES**
- BLOCKS STAMPED WITH 1/8" HIGH STEEL STAMP WITH WP-2, CAL. BLOCK NUMBER, NOM PIPE SIZE, MATERIAL, AND HEAT NUMBER.
  - NOTCH BOTTOM CURVATURE CONFORMS TO PIPE WALL CURVATURE.
  - HOLE PARALLEL TO AXIAL SURFACE WITHIN ± .010.
  - HOLES ARE DRILLED AND REAMED.
  - NOTCH SIDES PERPENDICULAR TO THE SURFACE WITHIN ± 5°.
  - NOTCH WIDTH .250 MAX.
  - ALL DIMENSIONS ARE IN INCHES.
  - MACHINED SURFACE TO BE 250 RMS MAX.

THIS DRAWING IS INTENDED FOR USE IN PRESERVICE AND INSERVICE INSPECTIONS PROGRAMS ONLY

WASHINGTON PUBLIC POWER SUPPLY SYSTEM  
RICHLAND, WASHINGTON 99352

ENGINEER DP RAMEY  
DRAWN K-MOANDREN  
DATE 9-25-83




WP-2  
UT CALIBRATION BLOCK  
DWG NO: UTCB-232 REV 1

NO	DATE	REVISION	BY	CHKD	APVD	NO	DATE	REVISION	BY	CHKD	APVD
1	1-9-80	AS BUILT							K-MoA	DPR	TPH
2	1-23-85	ISSUED FOR CONSTRUCTION							K-MoA	DPR	TPH



A  
B  
C  
D  
E  
F  
G  
H

t > 0.500														
CAL. BLOCK NUMBER	NOMINAL PIPE SIZE	SCHEDULE	WALL THICKNESS	K <sub>1</sub> °	L <sub>1</sub> .100	61 <sub>1</sub> .25°	62 <sub>1</sub> .25°	63 <sub>1</sub> .25°	NOTCH DEPTH ±.005	A1 <sub>1</sub> .010	B1 <sub>1</sub> .010	HOLE DIAMETER ±.010	HEAT NUMBER	MATERIAL SPEC
UT-48	18	40	0.500	37°	8.25	10.7°	18.1°	5.4°	0.050	0.125	0.375	3/32"	XXXX	SA 106 GR B
UT-49	18	100	1.031	53°	9.2	10.7°	18.1°	5.4°	0.098	0.250	0.773	1/8"	XXXX	SA 106 GR B
UT-8	20	30	0.500	30°	8.25	8.6°	13°	4.5°	0.050	0.125	0.375	3/32"	XXXX	SA 106 GR B

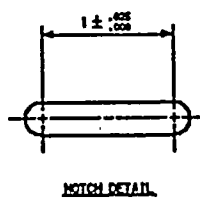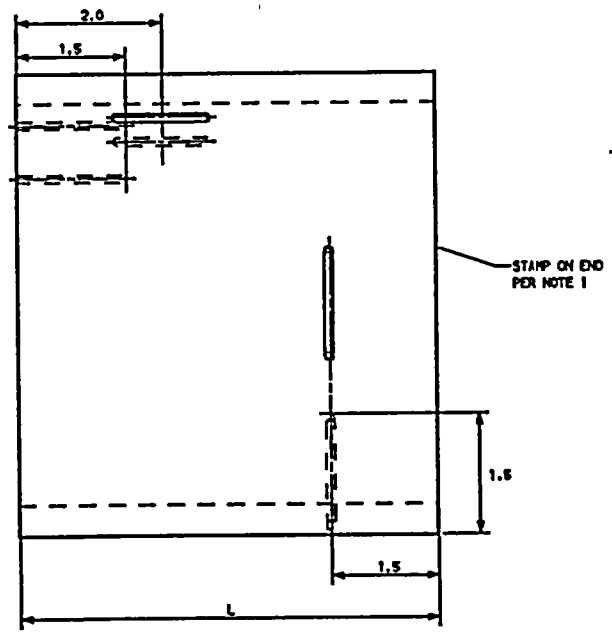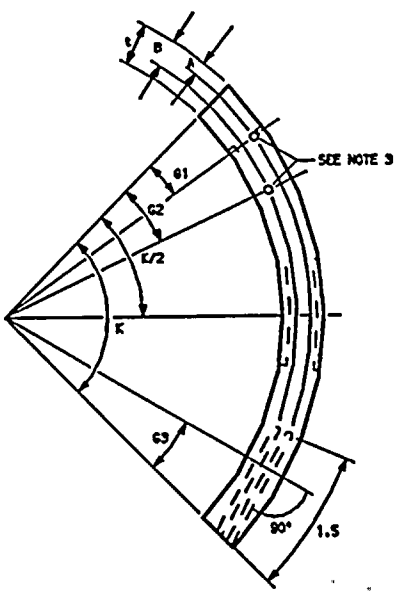

- NOTES**
1. STAMP BLOCKS WITH 1/8" HIGH STEEL STAMP WITH WNP-2, CAL. BLOCK NUMBER, NOM PIPE SIZE, MATERIAL, AND HEAT NUMBER.
  2. NOTCH BOTTOM CURVATURE CONFORMS TO PIPE WALL CURVATURE.
  3. HOLE PARALLEL TO AXIAL SURFACE WITHIN ± .010.
  4. HOLES ARE TO BE DRILLED AND REAMED.
  5. NOTCH SIDES PERPENDICULAR TO THE SURFACE WITHIN ± 5°.
  6. NOTCH WIDTH .250 MAX.
  7. ALL DIMENSIONS ARE IN INCHES.
  8. MACHINED SURFACE TO BE 250 RMS MAX.

THIS DRAWING IS INTENDED FOR USE IN PRESERVICE AND INSERVICE INSPECTIONS PROGRAMS ONLY




<p>WASHINGTON PUBLIC POWER SUPPLY SYSTEM RICHLAND, WASHINGTON 98852</p>	ENGINEER DP RAMEY	WNP-2						
	DRAWN K-McANDREW	UT CALIBRATION BLOCK						
NO. DATE	REVISION	BY CHKD APVD	NO. DATE	REVISION	BY CHKD APVD	DATE 9-25-65	DWG NO. <b>UTCB-233</b>	REV 0

0	1-25-65	ISSUED FOR CONSTRUCTION	K-McA	DPR	TPH
NO.	DATE	REVISION	BY	CHKD	APVD



$t > 1/2$

CAL. BLOCK NUMBER	NOMINAL PIPE SIZE	SCHEDULE	WALL THICKNESS t	KA1°	L4.100	614.25°	624.25°	634.25°	NOTCH DEPTH ±.005	AA.010	BA.010	HOLE DIAMETER ±.010	HEAT NUMBER	MATERIAL SPEC
UT-51	24	EXTRA STRONG	0.500	25.0	6.25	7.2°	10.75°	3.6°	0.050	0.125	0.376	3/32"	XXXX	SA 106 GR B
UT-52	30	EXTRA STRONG	0.500	20.0	6.25	5.7°	8.5°	2.9°	0.050	0.125	0.376	3/32"	XXXX	SA 155 CL 1 C 50

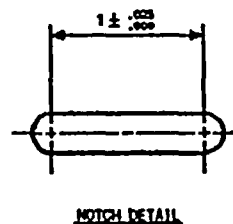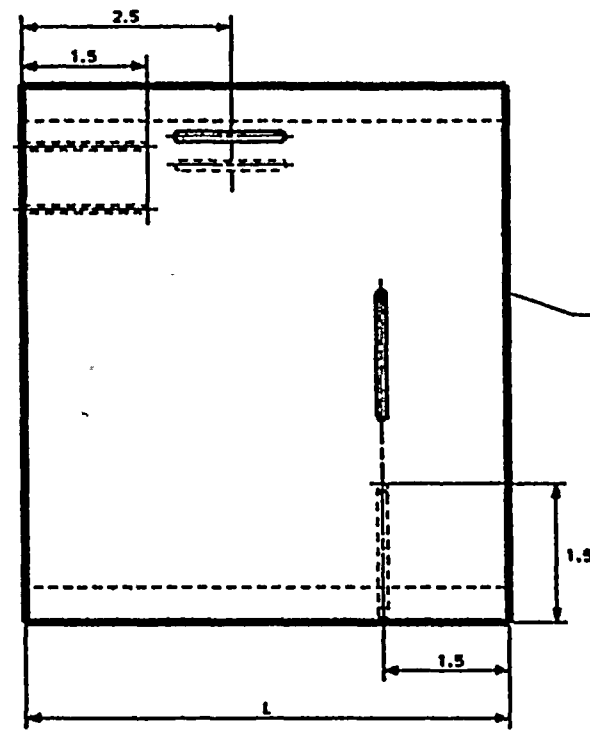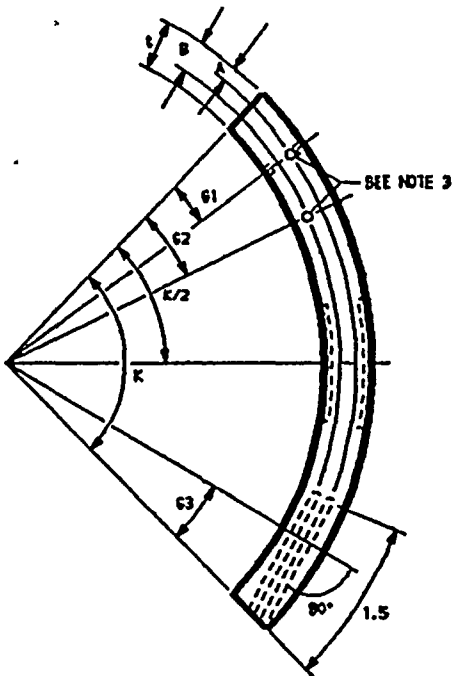


- NOTES**
1. STAMP BLOCKS WITH 1/8" HIGH STEEL STAMP WITH WMP-2, CAL. BLOCK NUMBER, NOM PIPE SIZE, MATERIAL, AND HEAT NUMBER.
  2. NOTCH BOTTOM CURVATURE CONFORMS TO PIPE WALL CURVATURE.
  3. HOLE PARALLEL TO AXIAL SURFACE WITHIN ± .010.
  4. HOLES ARE TO BE DRILLED AND REAMED.
  5. NOTCH SIDES PERPENDICULAR TO THE SURFACE WITHIN ± 5°.
  6. NOTCH WIDTH .250 MAX.
  7. ALL DIMENSIONS ARE IN INCHES.
  8. MACHINED SURFACE TO BE 250 RMS MAX.

THIS DRAWING IS INTENDED FOR USE IN PRESERVICE AND INSERVICE INSPECTION PROGRAMS ONLY

 <b>WASHINGTON PUBLIC POWER SUPPLY SYSTEM</b> RICHMOND, WASHINGTON 98862	WMP-2
	UT CALIBRATION BLOCK
ENGINEER: DP RABEY DRAWN: K-MANDREY	DATE: 9-14-96 DWG NO: UTCB-234 REV: 0

NO	DATE	REVISION	BY	CHKD	APVD	NO	DATE	REVISION	BY	CHKD	APVD
0	3-3-87	ISSUED FOR CONSTRUCTION							K-MCA	DPR	TTH

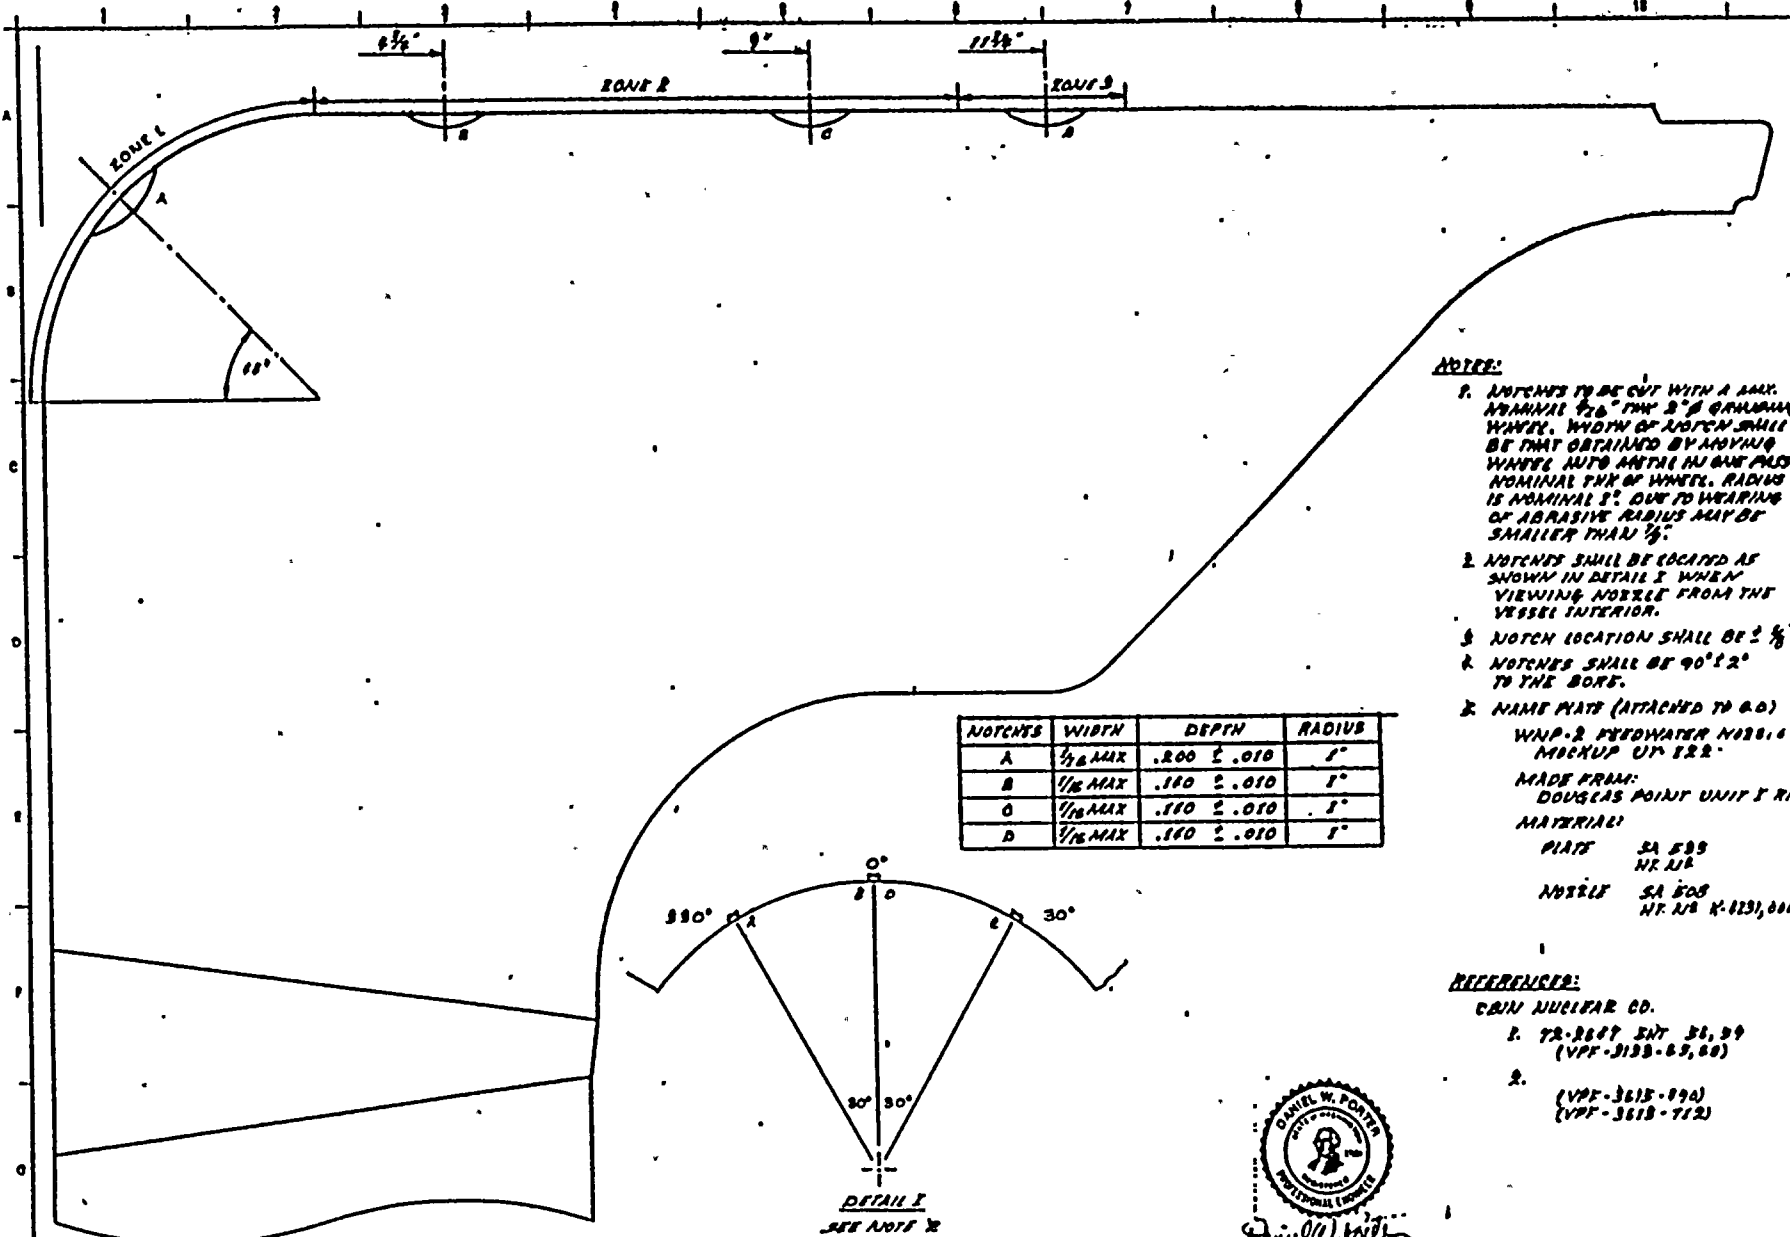

NOTCHES	WIDTH	DEPTH	RADIUS
A	1/8 MAX	.200 ± .010	1"
B	1/16 MAX	.150 ± .010	1"
C	1/16 MAX	.150 ± .010	1"
D	1/16 MAX	.150 ± .010	1"

- NOTE:**
- NOTCHES TO BE CUT WITH A MAX. NOMINAL 1/16" THK 2" Ø GRINDING WHEEL. WIDTH OF NOTCH SHALL BE THAT OBTAINED BY MOVING WHEEL INTO NOTCH IN ONE PASS - NOMINAL THK OF WHEEL. RADIUS IS NOMINAL 1". DUE TO WEAR OF ABRASIVE RADIUS MAY BE SMALLER THAN 1".
  - NOTCHES SHALL BE LOCATED AS SHOWN IN DETAIL I WHEN VIEWING NOZZLE FROM THE VESSEL INTERIOR.
  - NOTCH LOCATION SHALL BE ± 1/8".
  - NOTCHES SHALL BE 90° ± 2° TO THE BORE.
  - NAME PLATE (ATTACHED TO B.O.)  
WNP-2 FEEDWATER NOZZLE  
MOCKUP UT-122
  - MADE FROM:  
DOUGLAS POINT UNIT 1 RPY  
MATERIAL:  
PLATE SA 508  
HX 11A  
NOZZLE SA 508  
HX 11A K-1231, 0116

- REFERENCES:**
- CBM NUCLEAR CO.  
TR-2647 INT 31, 39  
(VPP-3133-6-3, 68)
  - (VPP-3613-890)  
(VPP-3613-712)




Daniel W. Porter  
THIS DRAWING IS INTENDED FOR USE IN PRESERVICE AND INSERVICE INSPECTION PROGRAMS ONLY

**WASHINGTON PUBLIC POWER SUPPLY SYSTEM**  
RICHLAND, WASHINGTON 99352  
WNP-2


WNP-2 FW NOZZLE MOCKUP, UT-122  
DWG NO UTCB-250 SN 2 of 2 REV 0

NO	DATE	REVISION	BY	CHKD	APPVD	NO	DATE	REVISION	BY	CHKD	APPVD	DATE	NO	DATE	REVISION
												6-21-81			

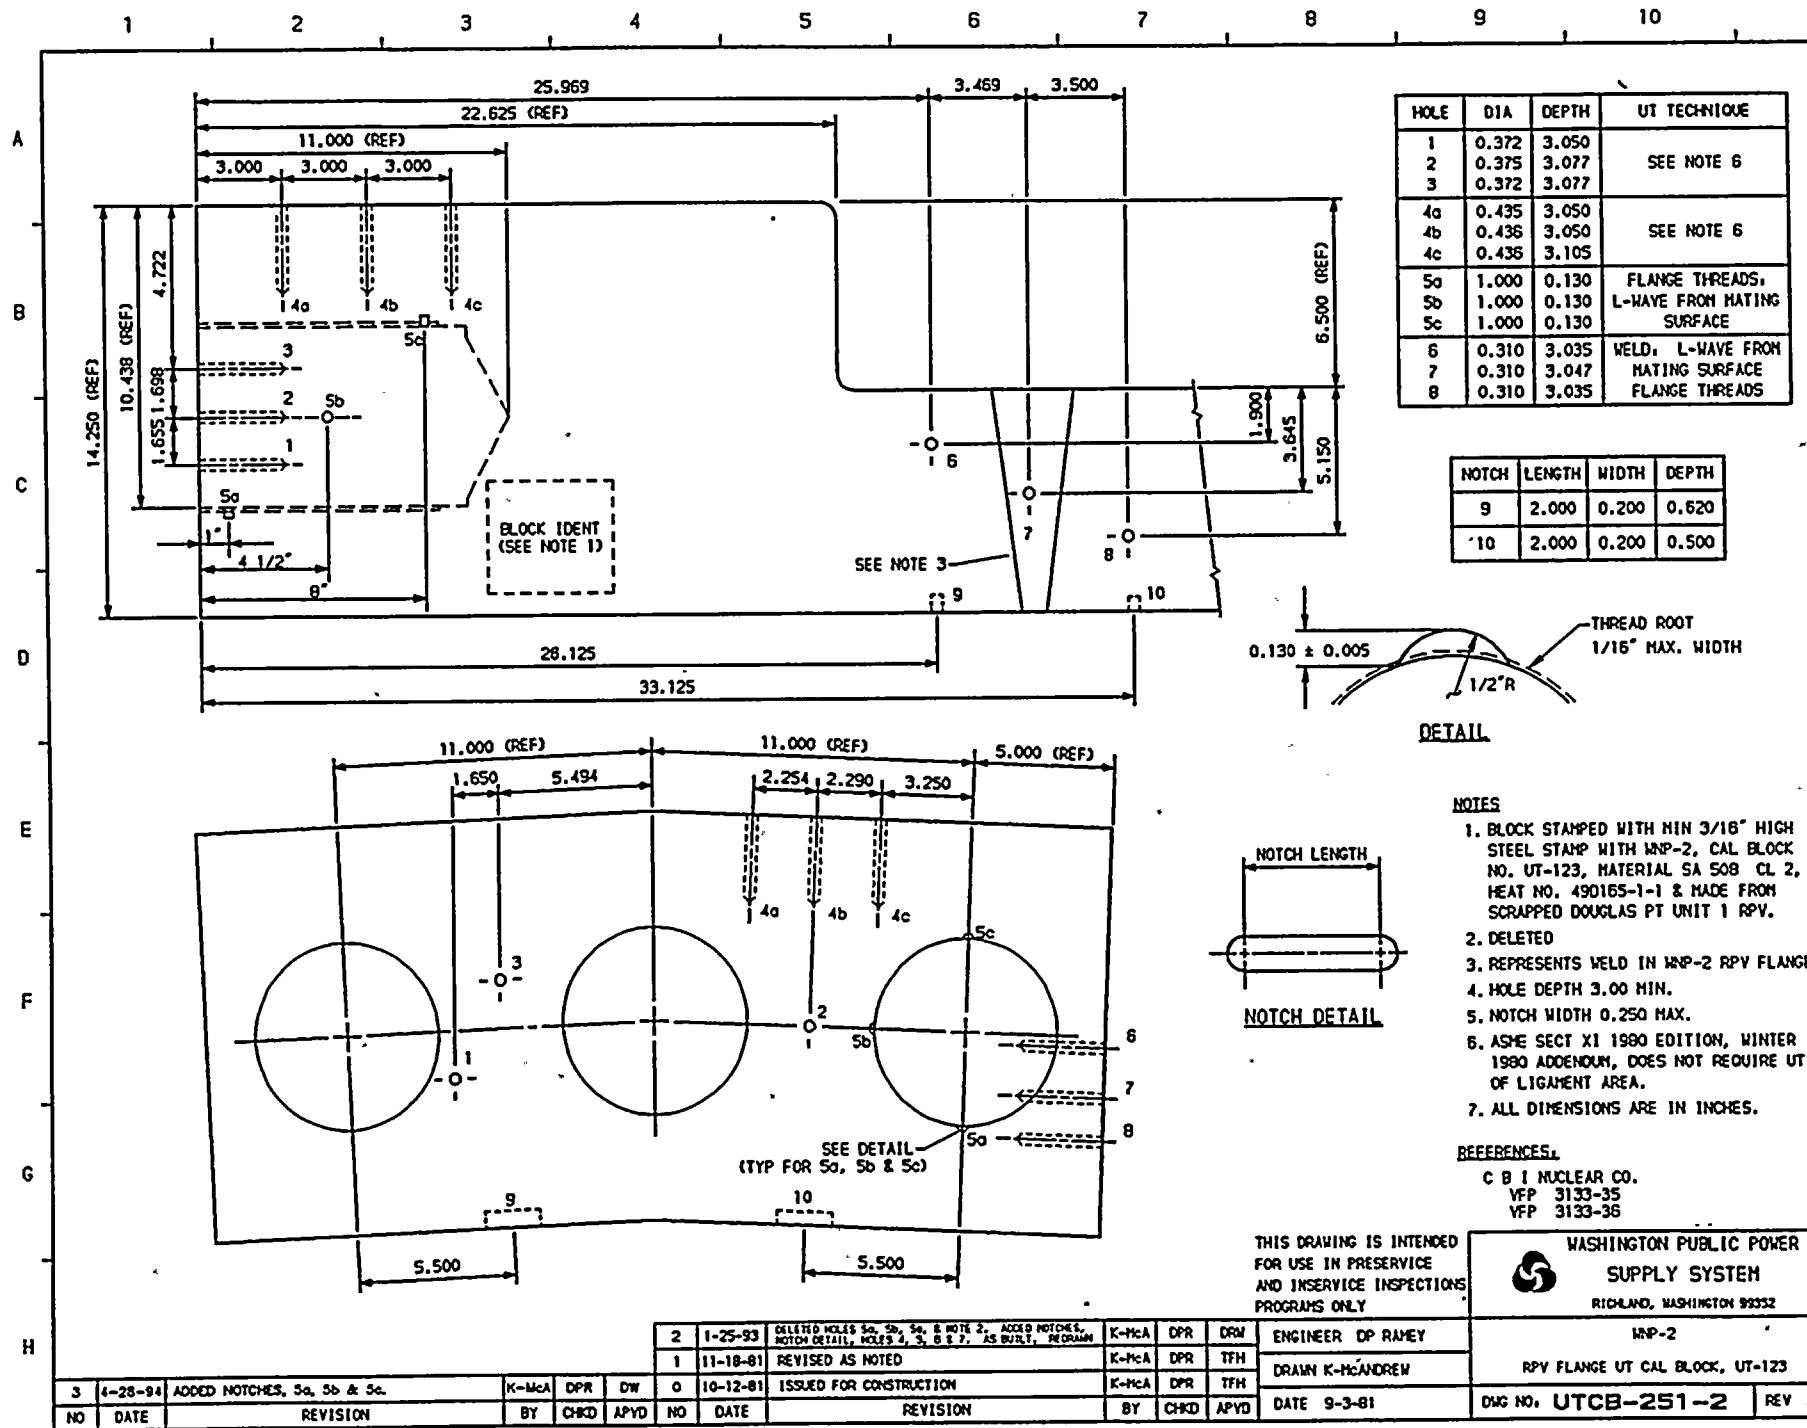


HOLE	DIA	DEPTH	UT TECHNIQUE
1	0.372	3.050	SEE NOTE 6
2	0.375	3.077	
3	0.372	3.077	
4a	0.435	3.050	SEE NOTE 6
4b	0.436	3.050	
4c	0.436	3.105	
5a	1.000	0.130	FLANGE THREADS, L-WAVE FROM MATING SURFACE
5b	1.000	0.130	
5c	1.000	0.130	
6	0.310	3.035	WELD, L-WAVE FROM MATING SURFACE FLANGE THREADS
7	0.310	3.047	
8	0.310	3.035	

NOTCH	LENGTH	WIDTH	DEPTH
9	2.000	0.200	0.520
10	2.000	0.200	0.500

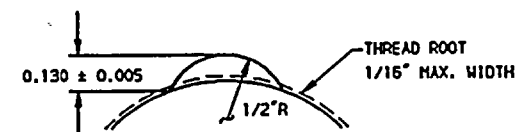

DETAIL

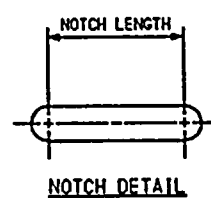

NOTES

1. BLOCK STAMPED WITH MIN 3/16" HIGH STEEL STAMP WITH WNP-2, CAL BLOCK NO. UT-123, MATERIAL SA 508 CL 2, HEAT NO. 490165-1-1 & MADE FROM SCRAPPED DOUGLAS PT UNIT 1 RPV.
2. DELETED
3. REPRESENTS WELD IN WNP-2 RPV FLANGE
4. HOLE DEPTH 3.00 MIN.
5. NOTCH WIDTH 0.250 MAX.
6. ASME SECT XI 1980 EDITION, WINTER 1980 ADDENDUM, DOES NOT REQUIRE UT OF LIGAMENT AREA.
7. ALL DIMENSIONS ARE IN INCHES.

REFERENCES:

C B I NUCLEAR CO.  
VFP 3133-35  
VFP 3133-36

THIS DRAWING IS INTENDED FOR USE IN PRESERVICE AND INSERVICE INSPECTIONS PROGRAMS ONLY

WASHINGTON PUBLIC POWER  
SUPPLY SYSTEM  
RICHLAND, WASHINGTON 99352

WNP-2  
RPV FLANGE UT CAL BLOCK, UT-123  
DNG NO. UTCB-251-2 REV 3

NO	DATE	REVISION	BY	CHKD	APYD	NO	DATE	REVISION	BY	CHKD	APYD	DATE	NO	DATE	REVISION
3	4-28-94	ADDED NOTCHES, 5a, 5b & 5c.	K-MCA	DPR	DW	0	10-12-81	ISSUED FOR CONSTRUCTION	K-MCA	DPR	TFH	DATE 9-3-81			

## 8.0 PROCEDURE LIST

This section lists the procedures that are used to implement the requirements found in this ISI Program Plan.

### 8.1 Administrative

#### Nuclear Operating Standards -

NOS 33	"Inservice Inspections"
NOS 21	"ASME Pressure Boundary Work"

#### Engineering Directorate Procedures

EDP 4.4	"Preparation of Inservice Inspection Program Plans"
EDP 4.5	"Conduct of Inservice Inspection"
EDP 4.6	"Preparation of Preservice Inspection/ Inservice Inspection Summary Reports"
EDP 4.8	"Transmittal and Storage of Preservice Inspection and Inservice Inspection Quality Assurance Records"
EDP 4.9	"Processing of ASME Section XI NIS-1 and NIS-2 Forms"

#### Plant Procedure Manual

PPM 1.3.30	"Repair, Replacement and Testing of ASME Items" (Repair/Replacement Program)
PPM 8.3.1	"ISI, IST and Appendix J Examination and Testing Program Administration and Control"
PPM 10.2.29	"Installation, Modification and Inspection of Pipe Supports"

"Operational Quality Assurance Program Description"

"Program Manual for Qualification and Certification of Examination, Testing and Inspection Personnel"

"Record Management Standards"

### 8.2 NDE/TESTING

#### Plant Procedure Manual

PPM 8.3.4	"Non-Destructive Testing and Examination Program" (Plant approval of NDE procedures)
-----------	--

### Non-Destructive Examinations and Inspection Manual

QCI 3-3	"Liquid Penetrant Examination (WNP-2)"
QCI 4-3	"Magnetic Particle Examination (WNP-2)"
QCI 6-2	"Ultrasonic Examination of Austenitic Steel Piping Welds"
QCI 6-3	"Ultrasonic Examination of Dissimilar Metal Welds (Manual)"
QCI 6-4	"Ultrasonic Examination Feedwater Nozzle Inner Radii"
QCI 6-13	"Ultrasonic Examination of Ferritic Piping Welds (WNP2)"
QCI 6-14	"Ultrasonic Examination of Bolting Larger than 2" Diameter"
QCI 6-16	"Examination of WNP-2 Reactor Pressure Vessel Welds"
QCI 6-23	"Ultrasonic Transducer Evaluation"
QCI 6-25	"Ultrasonic Sizing of Planar Flaws in Piping Systems"
QCI 6-26	"Examination of Reactor Vessel Threads in Flange"
QCI 6-27	"Examination of Class 2 Pressure Vessel Welds"
QCI 7-1	"Visual Examination (VT-1/VT-3)"
QCI 7-2	"Visual Examination (VT-2)"
QCI 7-3	"Visual Examination (VT-3 component supports)"
QCI 12-10	"Layout of Welds and System Components for WNP-2 Preservice Examination"

### Vendor Procedures

### 8.3 Evaluation - Analysis

#### Engineering Directorate Procedures

EI 4.1	"Evaluation Procedure for Unacceptable Flaws Found in ASME Class 1 Austenitic Piping Caused by IGSCC"
--------	---

#### Non-Destructive Examinations and Inspection Manual

QCI 12-8	"NDE Data Evaluation"
----------	-----------------------

### 8.4 Plant Technical Specification

Section 4.0.5	"Surveillance Requirements for Inservice Inspection"
Section 3.4.7.4	"Snubbers"

## 9.0 Boundary Diagrams, Schedules, and Weld and Component Diagrams

This section contains the following information on each system within the ASME Section XI inspection boundary:

- 1) Exemptions applied
- 2) Boundary Diagrams
- 3) Schedule Table 9.1.4
- 4) Weld & Component Diagrams.

### Exemptions applied

The Code exemptions from IWX-1200 that are applied to the system are tabulated for reference back to the ASME Section XI Code that defines the exemption.

### Boundary Diagrams

The ISI Boundary Diagrams on the following pages provide schematic views of the examination requirements for each system which contains components subject to examination within the scope of the applicable Codes, standards, and regulations listed in Section 5.0, "Code Compliance" and Section 6.0, "FSAR - NRC Commitments". The key to the symbolism used on these drawings is found on ISI-200, found at the end of this section.

These drawings illustrate the overall piping system examination requirements, distinguishing between systems requiring volumetric, surface and visual examinations (dashed lines), those requiring surface and visual examinations but not volumetric (dash-dot-lines), and those requiring only a visual examination during pressure tests (solid lines). Examination items such as hangers, instruments, thermal wells, and leak off connections are not typically shown on the ISI Boundary Diagrams in order to maintain drawing clarity. Detailed item-by-item examination requirements for all examination items in each of these piping systems is given in the Weld & Component Identification Diagrams and Schedule Table 9.1.4 found in the following Section.

### Schedule Table 9.1.4

Following the Boundary Diagrams is that portion of the Schedule Table 9.1.4 that is applicable to that system. These tables list and describe each weld and component shown on the diagrams, in order as they appear, tracing the line in the direction of flow. They further define the Section XI examination category; the item number, and the examination method for each examination item.

The following tables, 9.1.1, 9.1.2, and 9.1.3 provide keys to the abbreviations used in the schedule Table 9.1.4 columns "Requmt", "Out. Code", and "Rel. Req" respectively. The column "Requmt" is used to identify requirements and basis for each item in the table. The column "Out. Code" is used to identify the items that are being examined for

ASME Section XI, for other regulatory commitments, or both. The column "Rel. Req" is used to identify any relief requests associated with the item.

### Weld & Component Diagrams

This section of the WNP-2 ISI Program Plan contains Weld and Component Identification Diagrams for each system subject to inservice inspection. The diagrams identify each weld, component, and component support subject to inspection by illustrating the system in piping isometric format. For piping systems or portions thereof which require volumetric and/or surface examination, each weld and component is assigned an ISI identification number unique to that item. This number will be used exclusively for identification of welds and components on data sheets, reports, etc. For systems requiring only a visual examination for evidence of leakage, no ISI numbers are assigned.

Also shown on the diagram are such items as platforms, floors, walls, ladders, elevations and azimuths, compartment names, details, penetrations, and various notes; these are intended to aid the examination crew in locating and gaining access to the items to be examined and to note potential access restrictions.

Table 9.1:1

 Key to Abbreviations  
 Used in Schedule Table 9.1.4  
 Column "Reqmnt"

Abbreviation	Definition
1	Examine 16 - 34% 1st per., 50 - 67% 2nd per., 100% 3rd per.
2	Examine 7.5% of these welds each interval
3	Examine 25% of these component supports each interval
4	Examine 15% of these component supports each interval
5	Examine 10% of these component supports each interval
6	Examine 100% of these component supports each interval
7	Snubber
8	Examine each interval
9	Examine 25% of these welds each interval. Table IWB 2500-1, B-J, note 1
<	Weld stress below Table IWB 2500-1 B-J, note (1)(b)
>	Weld stress exceeds Table IWB 2500-1 B-J, note (1)(b)
A	GL 88-01 category "A" weld. Examine at least 25% every 10 years
B	GL 88-01 category "B" weld. Examine at least 50% every 10 years
C	Not used
D	GL 88-01 category "D" weld. Examine 100% every 2 Refueling Outages
E	Perform toward or at end of inspection interval
F	GL 88-01 category "F" weld. Examine every Refueling Outage
G	Structural Discontinuity
H	Augmented exam for high energy lines penetrating containment
I	Pipe wall < 3/8 Nominal wall thickness, Table IWC 2500-1, C-F-2, note 2
J	Can be deferred to end of interval
K	Examine with corresponding component support
L	Examine with intersecting circumferential weld
M	Augmented FW nozzle exam. 1 FW noz each RO 1st 6 RO of interval
N	Examine next ISI outage (indication)
O	Examine each refueling outage
P	Examine each inspection period
Q	Not used
R	Examine only when removed
S	Steam condensing mode de-energized
T	Terminal End
U	Examine when disassembled.
V	Item deleted
W	Not used
X	Can be examined in place
Y	Special exam - not ASME Section XI
Z	ISI exam not required.



**Table 9.1.2**

---

Key to Abbreviations  
 Used in Schedule Table 9.1.4  
 Column "Out. Code"

C. = ASME Section XI  
 E = Examine for ASME Section XI  
 F = FSAR  
 G = Generic Letter 88-01  
 H = FSAR Section 5.2.5.9

---

**Table 9.1.3**

---

Key to Abbreviations Used  
 in Schedule Table 9.1.4  
 Column "Rel. Req"

01 Relief request 2ISI-01, Category B-A  
 02 Relief request 2ISI-02, Category B-D  
 03 Relief request 2ISI-03, Category B-G-1  
 04 Relief request 2ISI-04, IWA-5244, Standby Service Water Buried Piping  
 05 Relief request 2ISI-05, Category D-A, MSRV Pneumatic Test  
 08 Relief request 2ISI-08, Category B-K-1  
 09 Relief request 2ISI-09, Category C-C  
 10 Relief request 2ISI-10, Category D-B  
 11 Relief request 2ISI-11, IWF-5300(a) Snubber Examination

---

9-5

file: BNDSCHD

	1	2	3	4	5	6	7	8	9	10																																																								
A	<b>ISI BOUNDARY DIAGRAM SYMBOLS</b>			<b>GENERAL SYMBOLS</b>				<b>WELD NUMBERING SYSTEM SAMPLES</b>																																																										
	<p>PIPING SYSTEMS REQUIRING VISUAL, SURFACE AND VOLUMETRIC EXAMINATIONS.</p> <p>PIPING SYSTEMS REQUIRING VISUAL AND SURFACE EXAMINATIONS.</p> <p>PIPING SYSTEMS REQUIRING ONLY A VISUAL (VT-1, 2, 3 OR 4) EXAMINATION.</p> <p>PIPING SYSTEMS FOR WHICH NO EXAMINATION IS REQUIRED PER ASME SECTION XI.</p>			<p>GATE VALVE, NORMALLY OPEN/NORMALLY CLOSED, RESPECTIVELY</p> <p>CLOSE VALVE, NORMALLY OPEN/NORMALLY CLOSED, RESPECTIVELY</p> <p>CLOSE, STOP CHECK VALVE</p> <p>CHECK VALVE</p> <p>BUTTERFLY VALVE</p> <p>PLUG OR BALL VALVE</p> <p>DIAPHRAGM VALVE</p> <p>UNION CONNECTION</p> <p>RELIEF VALVE</p>				<p>28 MS(1) A-4 LD LONGITUDINAL WELD, DOWNSTREAM OF WELD #4 WELD SEQUENCE NUMBER LOOP OF MULTIPLE STREAM SYSTEM SYSTEM NAME AND NUMBER PIPE SIZE (NOMINAL INCHES)</p> <p>28 MS(1) A-4 LU LONGITUDINAL WELD, UPSTREAM OF WELD #4</p> <p>28 MS(1) A-4 BD BOLTING, DOWNSTREAM OF WELD #4</p> <p>28 MS(1) A-4 BU BOLTING, UPSTREAM OF WELD #4</p> <p>12 LPCS(1)-2/3/4 Y-14 FOR BRANCH LINES REQUIRING ONLY A VISUAL EXAMINATION VALVE WHICH ESTABLISHES LIMIT OF VISUAL EXAMINATION BRANCH CONNECTION SIZE</p> <p>12 LPCS(1)-17/4 LPCS(1)-4 WELDOLET TO MAIN LINE WELD, BRANCH LINE REQUIRES SURFACE OR VOLUMETRIC EXAMINATION BRANCH LINE SYSTEM NAME AND NUMBER AS SHOWN ON BOUNDARY DIAGRAM BRANCH CONNECTION (WELDOLET) SIZE</p>																																																										
B	<p>AUGMENTED ISI BOUNDARY</p> <p>CONTAINMENT PENETRATION, TYPICAL</p> <p>BULKHEAD PENETRATION, TYPICAL</p> <p>FLOW ARROW</p>			<p style="text-align: center;"><b>WELD &amp; COMPONENT IDENTIFICATION DIAGRAM SYMBOLS</b></p> <p>SHOP WELD</p> <p>FIELD WELD</p> <p>WELDOLET, SOCKOLET, SWEEPolet BRANCH CONNECTION</p> <p>SPRING HANGER, NON-WELDED AND WELDED ATTACHMENTS, RESPECTIVELY</p> <p>SNUGGER OR SHOCK ABSORBER, NON-WELDED AND WELDED ATTACHMENTS, RESPECTIVELY</p> <p>RIGID HANGER, NON-WELDED AND WELDED ATTACHMENTS, RESPECTIVELY</p> <p>PIPE WHIP RESTRAINT (PWS), GUIDE</p> <p>CONTAINMENT PENETRATION</p> <p>VESSEL NOZZLE, TYPICAL</p>				<p style="text-align: center;"><b>INDEX TO BOUNDARY DIAGRAMS</b></p> <p>151-200 LEGEND</p> <p>151-217 DEMINERALIZED WATER (DW), EQUIPMENT DRAIN, RADIOACTIVE (EWR), FLOOR DRAIN, RADIOACTIVE (FRD), MISCELLANEOUS WASTE, RADIOACTIVE (MWR)</p> <p>151-219 REACTOR CORE ISOLATION COOLING (RCIC)</p> <p>151-220 HIGH PRESSURE CORE SPRAY (HPCS), LOW PRESSURE CORE SPRAY (LPCS)</p> <p>151-221 RESIDUAL HEAT REMOVAL (RHR)</p> <p>151-222 STANDBY LIQUID CONTROL (SLC)</p> <p>151-223 REACTOR WATER CLEANUP (RWCU)</p> <p>151-224 STANDBY SERVICE WATER (SSW)</p> <p>151-225 REACTOR CLOSED COOLING (RCC)</p> <p>151-226 FUEL POOL COOLING (FPCC)</p> <p>151-228 CONTROL ROD DRIVE (CRD)</p> <p>151-229 MAIN STEAM (MS), REACTOR FEED WATER (RFW)</p> <p>151-230 REACTOR RECIRCULATION COOLING (RRC)</p>																																																										
C	<p>REDUCER (INDICATES LINE SIZE CHANGE ONLY) CONNECTION TO COMPONENT</p> <p>TRAP</p> <p>PIPE CAP, WELDED PIPE CAP, THREADED, RESPECTIVELY</p> <p>FILTER</p> <p>"Y" TYPE STRAINER</p> <p>CONICAL STRAINER, IN-LINE</p> <p>FLANGE</p> <p>FLOW ELEMENT</p> <p>EXPANSION JOINT</p> <p>RUPTURE DISK</p> <p>SPECTACLE FLANGE</p>											<p style="text-align: center;"><b>SYSTEM NAME &amp; NUMBER AS SHOWN</b></p> <p>12 LPCS (1)-4</p> <p>SYSTEM PRESSURE RATINGS: 1 = 150 PSI      4 = 900 PSI 2 = 300 PSI      5 = 1500 PSI 3 = 600 PSI      6 = 2500 PSI</p> <p>SYSTEM NUMBER</p> <p>SYSTEM NAME</p> <p>PIPE SIZE (NOMINAL INCHES)</p>				<p style="text-align: center;"><b>THIS DRAWING IS INTENDED FOR USE IN PRESERVICE AND INSERVICE INSPECTIONS PROGRAMS ONLY</b></p> <div style="display: flex; justify-content: space-between;"> <div style="width: 45%;"> <p>WASHINGTON PUBLIC POWER SUPPLY SYSTEM RICHLAND, WASHINGTON 99352</p> <p>ENGINEER D PORTER</p> <p>DRAWN K-McANDREW</p> <p>DATE 5-10-78</p> </div> <div style="width: 45%; text-align: center;"> <p>WP-2 INSERVICE INSPECTION BOUNDARY DIAGRAM LEGEND</p> <p>DWG NO. <b>ISI-200</b></p> <p>REV 3</p> </div> </div>																																																		
D	<p>CONNECTION TO COMPONENT</p> <p>TRAP</p> <p>PIPE CAP, WELDED PIPE CAP, THREADED, RESPECTIVELY</p> <p>FILTER</p> <p>"Y" TYPE STRAINER</p> <p>CONICAL STRAINER, IN-LINE</p> <p>FLANGE</p> <p>FLOW ELEMENT</p> <p>EXPANSION JOINT</p> <p>RUPTURE DISK</p> <p>SPECTACLE FLANGE</p> <p>ORIFICE, SINGLE</p> <p>ORIFICE, MULTIPLE</p> <p>FLEX HOSE</p> <p>FLOW NOZZLE</p> <p>CROSS</p> <p>EXCESS FLOW CHECK VALVE</p> <p>EXPLOSIVELY ACTUATED SHEAR PLUG VALVE</p> <p>SOLENOID VALVE WITH BUILT IN FLOW CONTROL</p>			<p style="text-align: center;"><b>SYSTEM NAME &amp; NUMBER AS SHOWN</b></p> <p>12 LPCS (1)-4</p> <p>SYSTEM PRESSURE RATINGS: 1 = 150 PSI      4 = 900 PSI 2 = 300 PSI      5 = 1500 PSI 3 = 600 PSI      6 = 2500 PSI</p> <p>SYSTEM NUMBER</p> <p>SYSTEM NAME</p> <p>PIPE SIZE (NOMINAL INCHES)</p>				<p style="text-align: center;"><b>THIS DRAWING IS INTENDED FOR USE IN PRESERVICE AND INSERVICE INSPECTIONS PROGRAMS ONLY</b></p> <div style="display: flex; justify-content: space-between;"> <div style="width: 45%;"> <p>WASHINGTON PUBLIC POWER SUPPLY SYSTEM RICHLAND, WASHINGTON 99352</p> <p>ENGINEER D PORTER</p> <p>DRAWN K-McANDREW</p> <p>DATE 5-10-78</p> </div> <div style="width: 45%; text-align: center;"> <p>WP-2 INSERVICE INSPECTION BOUNDARY DIAGRAM LEGEND</p> <p>DWG NO. <b>ISI-200</b></p> <p>REV 3</p> </div> </div>																																																										
E	<p>ORIFICE, SINGLE</p> <p>ORIFICE, MULTIPLE</p> <p>FLEX HOSE</p> <p>FLOW NOZZLE</p> <p>CROSS</p> <p>EXCESS FLOW CHECK VALVE</p> <p>EXPLOSIVELY ACTUATED SHEAR PLUG VALVE</p> <p>SOLENOID VALVE WITH BUILT IN FLOW CONTROL</p>											<p style="text-align: center;"><b>SYSTEM NAME &amp; NUMBER AS SHOWN</b></p> <p>12 LPCS (1)-4</p> <p>SYSTEM PRESSURE RATINGS: 1 = 150 PSI      4 = 900 PSI 2 = 300 PSI      5 = 1500 PSI 3 = 600 PSI      6 = 2500 PSI</p> <p>SYSTEM NUMBER</p> <p>SYSTEM NAME</p> <p>PIPE SIZE (NOMINAL INCHES)</p>				<p style="text-align: center;"><b>THIS DRAWING IS INTENDED FOR USE IN PRESERVICE AND INSERVICE INSPECTIONS PROGRAMS ONLY</b></p> <div style="display: flex; justify-content: space-between;"> <div style="width: 45%;"> <p>WASHINGTON PUBLIC POWER SUPPLY SYSTEM RICHLAND, WASHINGTON 99352</p> <p>ENGINEER D PORTER</p> <p>DRAWN K-McANDREW</p> <p>DATE 5-10-78</p> </div> <div style="width: 45%; text-align: center;"> <p>WP-2 INSERVICE INSPECTION BOUNDARY DIAGRAM LEGEND</p> <p>DWG NO. <b>ISI-200</b></p> <p>REV 3</p> </div> </div>																																																		
F	<p>ORIFICE, SINGLE</p> <p>ORIFICE, MULTIPLE</p> <p>FLEX HOSE</p> <p>FLOW NOZZLE</p> <p>CROSS</p> <p>EXCESS FLOW CHECK VALVE</p> <p>EXPLOSIVELY ACTUATED SHEAR PLUG VALVE</p> <p>SOLENOID VALVE WITH BUILT IN FLOW CONTROL</p>			<p style="text-align: center;"><b>SYSTEM NAME &amp; NUMBER AS SHOWN</b></p> <p>12 LPCS (1)-4</p> <p>SYSTEM PRESSURE RATINGS: 1 = 150 PSI      4 = 900 PSI 2 = 300 PSI      5 = 1500 PSI 3 = 600 PSI      6 = 2500 PSI</p> <p>SYSTEM NUMBER</p> <p>SYSTEM NAME</p> <p>PIPE SIZE (NOMINAL INCHES)</p>				<p style="text-align: center;"><b>THIS DRAWING IS INTENDED FOR USE IN PRESERVICE AND INSERVICE INSPECTIONS PROGRAMS ONLY</b></p> <div style="display: flex; justify-content: space-between;"> <div style="width: 45%;"> <p>WASHINGTON PUBLIC POWER SUPPLY SYSTEM RICHLAND, WASHINGTON 99352</p> <p>ENGINEER D PORTER</p> <p>DRAWN K-McANDREW</p> <p>DATE 5-10-78</p> </div> <div style="width: 45%; text-align: center;"> <p>WP-2 INSERVICE INSPECTION BOUNDARY DIAGRAM LEGEND</p> <p>DWG NO. <b>ISI-200</b></p> <p>REV 3</p> </div> </div>																																																										
G	<p>ORIFICE, SINGLE</p> <p>ORIFICE, MULTIPLE</p> <p>FLEX HOSE</p> <p>FLOW NOZZLE</p> <p>CROSS</p> <p>EXCESS FLOW CHECK VALVE</p> <p>EXPLOSIVELY ACTUATED SHEAR PLUG VALVE</p> <p>SOLENOID VALVE WITH BUILT IN FLOW CONTROL</p>											<p style="text-align: center;"><b>SYSTEM NAME &amp; NUMBER AS SHOWN</b></p> <p>12 LPCS (1)-4</p> <p>SYSTEM PRESSURE RATINGS: 1 = 150 PSI      4 = 900 PSI 2 = 300 PSI      5 = 1500 PSI 3 = 600 PSI      6 = 2500 PSI</p> <p>SYSTEM NUMBER</p> <p>SYSTEM NAME</p> <p>PIPE SIZE (NOMINAL INCHES)</p>				<p style="text-align: center;"><b>THIS DRAWING IS INTENDED FOR USE IN PRESERVICE AND INSERVICE INSPECTIONS PROGRAMS ONLY</b></p> <div style="display: flex; justify-content: space-between;"> <div style="width: 45%;"> <p>WASHINGTON PUBLIC POWER SUPPLY SYSTEM RICHLAND, WASHINGTON 99352</p> <p>ENGINEER D PORTER</p> <p>DRAWN K-McANDREW</p> <p>DATE 5-10-78</p> </div> <div style="width: 45%; text-align: center;"> <p>WP-2 INSERVICE INSPECTION BOUNDARY DIAGRAM LEGEND</p> <p>DWG NO. <b>ISI-200</b></p> <p>REV 3</p> </div> </div>																																																		
H	<p>ORIFICE, SINGLE</p> <p>ORIFICE, MULTIPLE</p> <p>FLEX HOSE</p> <p>FLOW NOZZLE</p> <p>CROSS</p> <p>EXCESS FLOW CHECK VALVE</p> <p>EXPLOSIVELY ACTUATED SHEAR PLUG VALVE</p> <p>SOLENOID VALVE WITH BUILT IN FLOW CONTROL</p>			<p style="text-align: center;"><b>SYSTEM NAME &amp; NUMBER AS SHOWN</b></p> <p>12 LPCS (1)-4</p> <p>SYSTEM PRESSURE RATINGS: 1 = 150 PSI      4 = 900 PSI 2 = 300 PSI      5 = 1500 PSI 3 = 600 PSI      6 = 2500 PSI</p> <p>SYSTEM NUMBER</p> <p>SYSTEM NAME</p> <p>PIPE SIZE (NOMINAL INCHES)</p>				<p style="text-align: center;"><b>THIS DRAWING IS INTENDED FOR USE IN PRESERVICE AND INSERVICE INSPECTIONS PROGRAMS ONLY</b></p> <div style="display: flex; justify-content: space-between;"> <div style="width: 45%;"> <p>WASHINGTON PUBLIC POWER SUPPLY SYSTEM RICHLAND, WASHINGTON 99352</p> <p>ENGINEER D PORTER</p> <p>DRAWN K-McANDREW</p> <p>DATE 5-10-78</p> </div> <div style="width: 45%; text-align: center;"> <p>WP-2 INSERVICE INSPECTION BOUNDARY DIAGRAM LEGEND</p> <p>DWG NO. <b>ISI-200</b></p> <p>REV 3</p> </div> </div>																																																										
<table border="1" style="width: 100%; border-collapse: collapse;"> <tr> <td style="width: 5%;">3</td> <td style="width: 10%;">12-1-92</td> <td style="width: 20%;">ADDED LOGO</td> <td style="width: 10%;">K-McA</td> <td style="width: 5%;">DPR</td> <td style="width: 5%;">DRW</td> <td style="width: 5%;">0</td> <td style="width: 10%;">1-9-79</td> <td style="width: 20%;">ISSUED FOR USE</td> <td style="width: 5%;">K-McA</td> <td style="width: 5%;">DPR</td> <td style="width: 5%;">TFM</td> <td style="width: 5%;"></td> <td style="width: 10%;">ENGINEER D PORTER</td> </tr> <tr> <td>2</td> <td>1-24-85</td> <td>REVISED FOR ISI</td> <td>K-McA</td> <td>DPR</td> <td>TFM</td> <td>A</td> <td>5-10-78</td> <td>ISSUED FOR INFORMATION ONLY</td> <td>K-McA</td> <td>DMP</td> <td>DMP</td> <td></td> <td>DRAWN K-McANDREW</td> </tr> <tr> <td>NO</td> <td>DATE</td> <td>REVISION</td> <td>BY</td> <td>CHKD</td> <td>APVD</td> <td>NO</td> <td>DATE</td> <td>REVISION</td> <td>BY</td> <td>CHKD</td> <td>APVD</td> <td>DATE</td> <td>DWG NO. <b>ISI-200</b></td> </tr> <tr> <td colspan="12"></td> <td style="text-align: right;">REV 3</td> </tr> </table>												3	12-1-92	ADDED LOGO	K-McA	DPR	DRW	0	1-9-79	ISSUED FOR USE	K-McA	DPR	TFM		ENGINEER D PORTER	2	1-24-85	REVISED FOR ISI	K-McA	DPR	TFM	A	5-10-78	ISSUED FOR INFORMATION ONLY	K-McA	DMP	DMP		DRAWN K-McANDREW	NO	DATE	REVISION	BY	CHKD	APVD	NO	DATE	REVISION	BY	CHKD	APVD	DATE	DWG NO. <b>ISI-200</b>													REV 3
3	12-1-92	ADDED LOGO	K-McA	DPR	DRW	0	1-9-79	ISSUED FOR USE	K-McA	DPR	TFM		ENGINEER D PORTER																																																					
2	1-24-85	REVISED FOR ISI	K-McA	DPR	TFM	A	5-10-78	ISSUED FOR INFORMATION ONLY	K-McA	DMP	DMP		DRAWN K-McANDREW																																																					
NO	DATE	REVISION	BY	CHKD	APVD	NO	DATE	REVISION	BY	CHKD	APVD	DATE	DWG NO. <b>ISI-200</b>																																																					
												REV 3																																																						

Table 9.1.4  
Washington Public Power Supply System  
ISI Program Plan and Schedule  
(Grouped by Drawing No. and Walkdown Order)

9.0 Boundary Diagrams, Schedule, WAD & Component Diagrams

Pg	Identification No.	Description	Category	Item No.	Method	Per.	Out.	Reqmt.	Code	Out. Freq.	Rel. Req.	Remarks
												<p>---&gt; Remarks</p> <p>---&gt; Identifies any relief requests or requirements other than Section XI. See Table 9.1.3</p> <p>---&gt; Defines how often examination is performed in outages</p> <p>---&gt; See Table 9.1.2. Identifies source of examination requirements</p> <p>---&gt; See Table 9.1.1.</p> <p>---&gt; Outage examination is scheduled</p> <p>---&gt; Inspection period examination is scheduled</p> <p>---&gt; Examination method. VOL = volumetric, SUR = surface, VT-1, VT-2, VT-3 = visual</p> <p>---&gt; Section XI item number</p> <p>---&gt; Section XI category</p> <p>---&gt; Description of item</p> <p>---&gt; Unique item identification number</p> <p>---&gt; Drawing sheet number</p>

9-6

file: BNDSCHD

ISI PROGRAM PLAN  
INTERVAL - 2  
REVISION 0  
DECEMBER, 1994

## 9.1 Containment Penetrations

Boundary Diagram ISI-217

## 9.1.1 Exemptions Applied:

## IWB-1220

(a)	NA	No Class 1 piping within system
(b)(1)	NA	
(b)(2)	NA	
(c)	NA	

## IWC-1221

(a)	Yes	All piping 4 NPS and smaller
(b)	NA <sup>1</sup>	
(c)	Yes	
(d)	NA <sup>1</sup>	
(e)	NA <sup>1</sup>	
(f)	Yes	

IWC-1222 NA

IWD-1220.1 NA No Class 3 piping within system

IWD-1220.2 NA No Class 3 piping within system

Code Case N-491

-1230 Yes

The following systems are covered by this boundary diagram:

DW Demineralized Water  
EDR Equipment Drain Radioactive  
FDR Floor Drain Radioactive  
MWR Miscellaneous Waste Radioactive.

These containment isolation systems perform no pressure isolation function. The ASME Section XI visual examination for evidence of leakage will be satisfied by the 10CFR 50 Appendix J tests.

---

<sup>1</sup> WNP-2 is a BWR

9.1.2 Boundary Diagrams





### 9.1.3 Examination Schedule




There are no items in these systems that are tested under the Section XI program. These items are tested under the Appendix J program.



9.1.4 Weld and Component Diagrams

1 2 3 4 5 6 7 8 9 10

A  
B  
C  
D  
E  
F  
G  
H

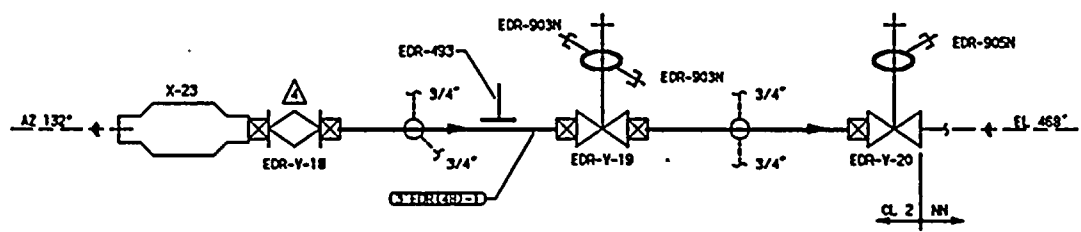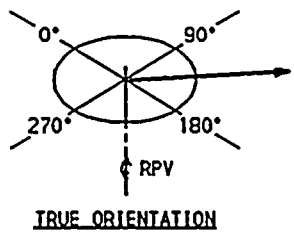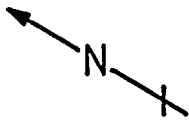


**NOTES:**

1. THIS DRAWING IDENTIFIES PIPING AND COMPONENTS SUBJECT TO A VISUAL EXAM FOR EVIDENCE OF LEAKAGE DURING SYSTEM HYDRO OR OPERABILITY TESTS. TESTS ARE TO BE CONDUCTED PER THE REQUIREMENTS OF ASME SECTION XI, PARAGRAPH 17A-5000.
2. FOR BRANCH PIPING 4" NOM. OR LESS (CONNECTION SHOWN IN DASHED LINES) EXTEND VISUAL LEAKAGE EXAM THROUGH THE OUTERMOST NORMALLY CLOSED NUCLEAR CLASS VALVE, OR UNTIL TRANSITION TO INSTRUMENT TUBING, UNLESS OTHERWISE NOTED.
3. DRAWING IS SHOWN IN ELEVATION FOR CLARITY.
4. EDR-904N & EDR-906N WERE DELETED PER BOC 087-0151-0A-071.

**REFERENCES:**

- ISI - 217
- BOYEE & CRAIG ISOMETRIC  
EDR-526-7.9 REV 11

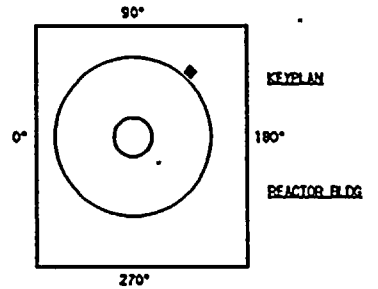

ZONE R-23

THIS DRAWING IS INTENDED FOR USE IN PRESERVICE AND INSERVICE INSPECTIONS PROGRAMS ONLY.

QUALITY CLASS: 1	ASME CODE CLASS: 2
ENGR: D TIMMINS	DATE: 3-13-79


WASHINGTON PUBLIC POWER  
**SUPPLY SYSTEM**  
RICHLAND, WASHINGTON 99352

WPP-2  
WELD & COMPONENT  
IDENTIFICATION DIAGRAM

TITLE:  
DRYWELL TO EQUIPMENT DRAIN SUMP

DWG NO. EDR-201      REV 4

NO	DATE	REVISION	BY	CHKD	APVD	PIPING SYSTEM	NOM DIA (IN)	SCH	NOM WALL THK	MATERIAL SPECIFICATION	MATL TYPE	CAL BLOCK NO
4	1-22-94	REVISED PER BOC 087-0151-0A-071.	K-McA	DPR	DW							
3	12-9-92	ADDED NOTE 4. MODIFIED EDR-903N.	K-McA	DPR	DRV	3"EDR(48)-1	3	40	0.218	SA 106 GR B	CS	NA
2	10-18-87	ADDED SHUTTERS, ISI DWG REF & LOCS. MOD KEYPLAN REDRAWN	K-McA	DPR	TFH							
1	1-24-84	CHG EDR-493 TO WELDED, ADDED KEYPLAN	K-McA	DPR	TFH							
0	7-31-79	ISSUED FOR USE	K-McA	TFH	LFB							

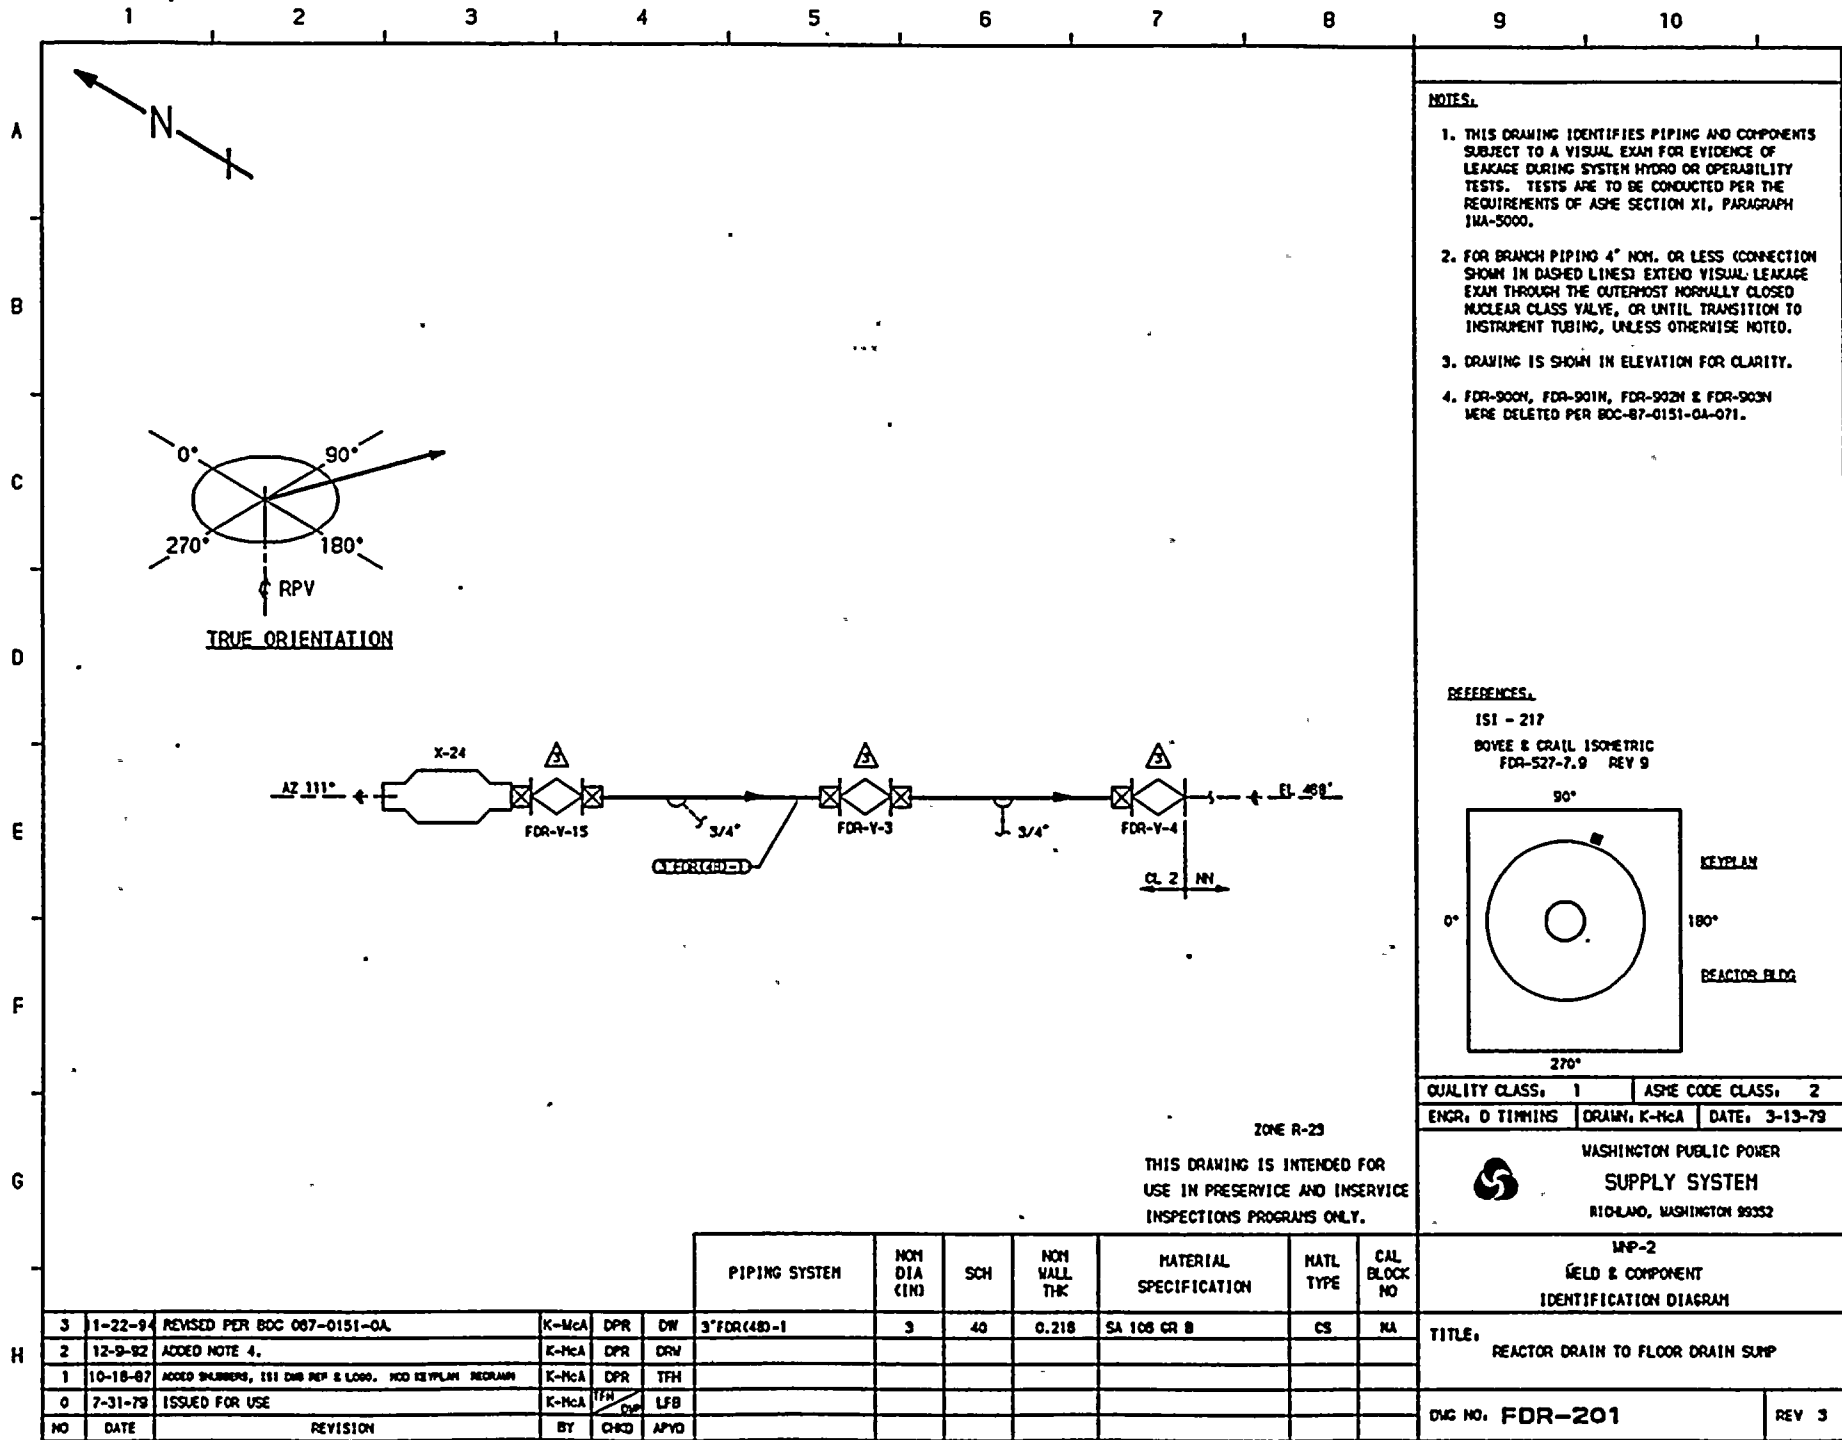



## 9.2 CCH Control Room Emergency Chilled Water System

### Boundary Diagram ISI-275

#### Exemptions Applied:

#### IWB-1220

(a)	NA	No Class 1 piping within system
(b)(1)	NA	
(b)(2)	NA	
(c)	NA	

IWC-1221            NA    No Class 2 piping within system

#### IWC-1222

(a)	NA
(b)	NA
(c)	NA
(d)	NA

IWD-1220.1        Yes

IWD-1220.2        Yes

#### Code Case N-491

-1230            Yes

9.2.2 Boundary Diagrams



9.2.3 Examination Schedule




WNP-2  
Interval 2  
CCH - Control Room Chilled Water

Table 9.1.4  
Washington Public Power Supply System  
ISI Program Plan and Schedule  
(Grouped by Drawing No. and Walkdown Order)

Revision 0

Pg	Identification No.	Description	Category	Item No.	Method	Per.	Out.	Reqmt.	Code	Out. Freq.	Rel. Req.	Remarks
Diagram No. CCH-301												
	CCH-PB-301(L)	LK PRES BNDRY	D-B	D2.10	VT-2	1	13	P	CE	3		
	CCH-PB-301(H)	HYDRO PRES BNDR	D-B	D2.10	VT-2	3	19	E	CE	10		
Diagram No. CCH-302												
	CCH-PB-302(L)	LK PRES BNDRY	D-B	D2.10	VT-2	1	13	P	CE	3		
	CCH-PB-302(H)	HYDRO PRES BNDR	D-B	D2.10	VT-2	3	19	E	CE	10		
Diagram No. CCH-303												
	CCH-PB-303(L)	LK PRES BNDRY	D-B	D2.10	VT-2	1	13	P	CE	3		
	CCH-PB-303(H)	HYDRO PRES BNDR	D-B	D2.10	VT-2	3	19	E	CE	10		
Diagram No. CCH-304												
	CCH-PB-304(L)	LK PRES BNDRY	D-B	D2.10	VT-2	1	13	P	CE	3		
	CCH-PB-304(H)	HYDRO PRES BNDR	D-B	D2.10	VT-2	3	19	E	CE	10		
Diagram No. CCH-305												
	CCH-PB-305(L)	LK PRES BNDRY	D-B	D2.10	VT-2	1	13	P	CE	3		
	CCH-PB-305(H)	HYDRO PRES BNDR	D-B	D2.10	VT-2	3	19	E	CE	10		
Diagram No. CCH-306												
	CCH-PB-306(L)	LK PRES BNDRY	D-B	D2.10	VT-2	1	13	P	CE	3		
	CCH-PB-306(H)	HYDRO PRES BNDR	D-B	D2.10	VT-2	3	19	E	CE	10		

9.2.4 Weld and Component Diagrams

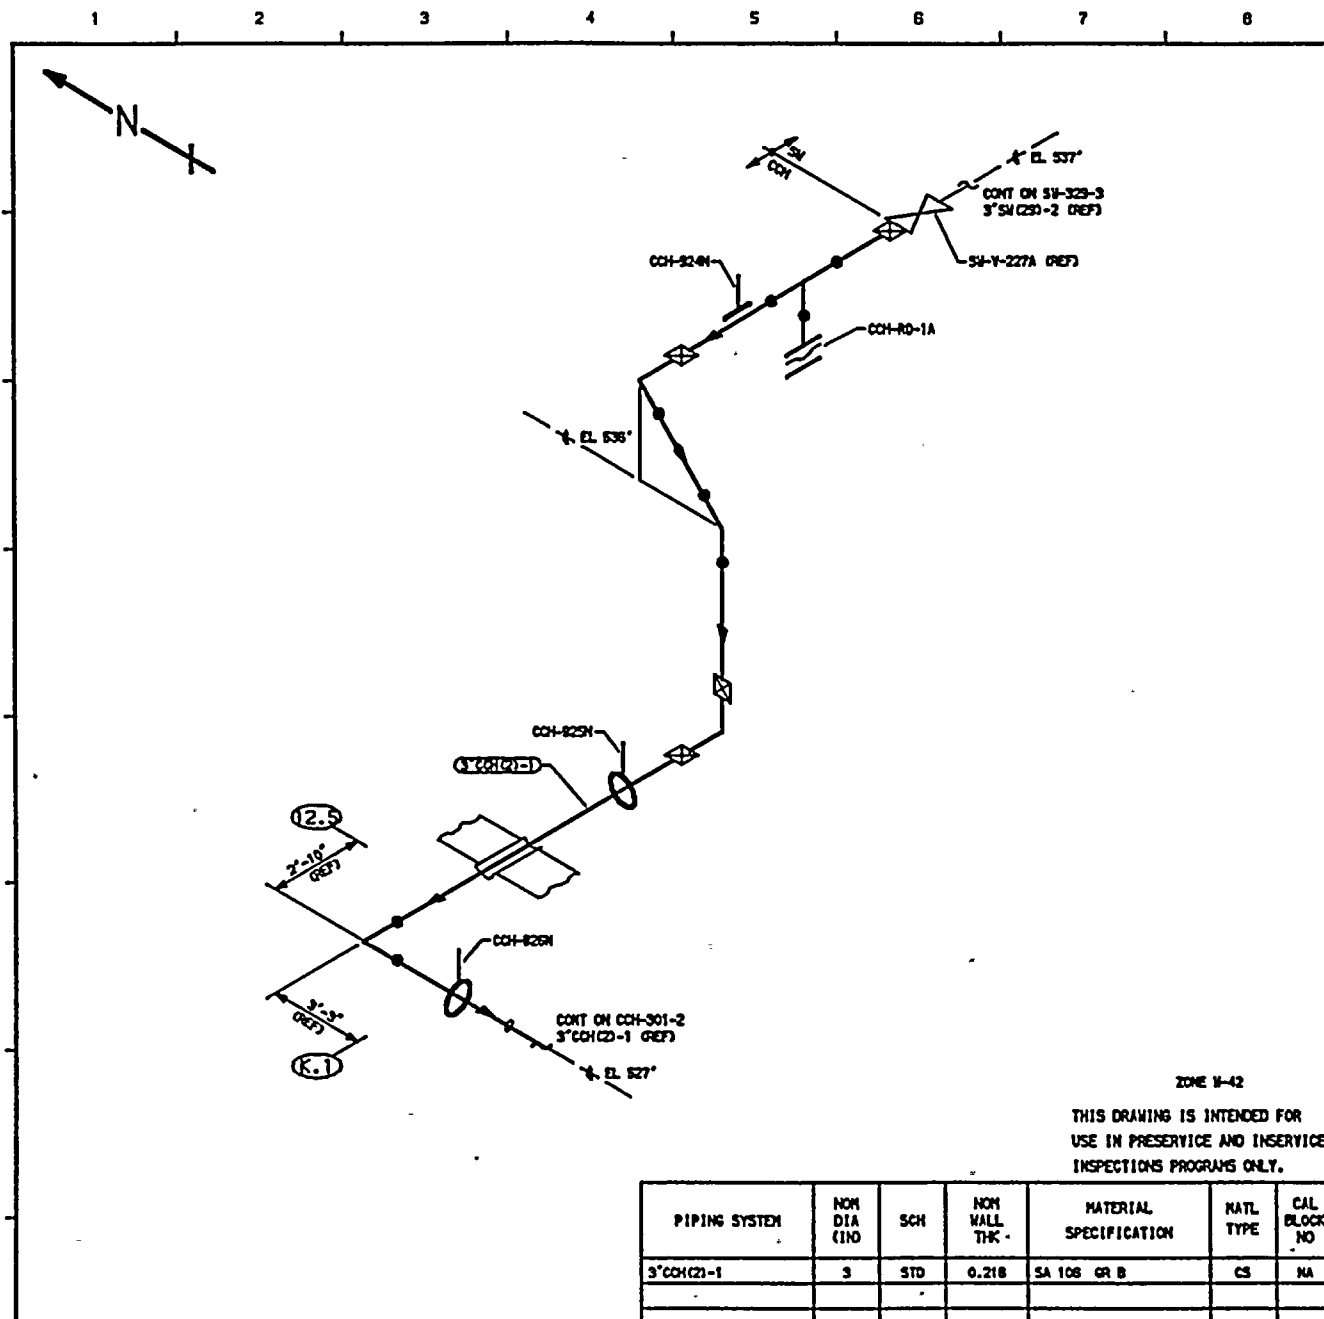


**NOTES:**

1. THIS DRAWING IDENTIFIES PIPING AND COMPONENTS SUBJECT ONLY TO A VISUAL EXAM FOR (1) EVIDENCE OF LEAKAGE DURING SYSTEM PRESSURE OR OPERABILITY TESTS, (2) PRESSURE DECAY TESTS OF BURIED PIPING, AND (3) LOSS OF SUPPORT CAPABILITY OR INADEQUATE RESTRAINT FOR SUPPORTS AND HANGERS ON PIPING EXCEEDING 4" NOM. TESTS SHALL BE CONDUCTED PER ASME SECTION XI, ARTICLES 1WA-5000 AND 1WD-2000.

**REFERENCES:**

191 - 275  
 BOYCE & ORAIL ISOMETRIC  
 CCH-107-1.7 REV 4

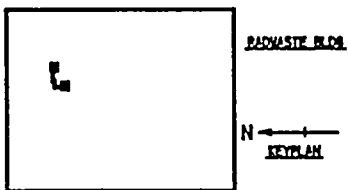

QUALITY CLASS, 1      ASME CODE CLASS, 3  
 ENGR. K-McANDREW    DRAWN. K-McA      DATE: 1-28-68

WASHINGTON PUBLIC POWER  
 SUPPLY SYSTEM  
 RICHLAND, WASHINGTON 99352

WPP-2  
 WELD & COMPONENT  
 IDENTIFICATION DIAGRAM

TITLE:  
 CCH-P-1A SUCTION FROM WMA-CC-51A-1


DWG NO. CCH-301-1      REV 0

ZONE 11-42  
 THIS DRAWING IS INTENDED FOR  
 USE IN PRESERVICE AND INSERVICE  
 INSPECTIONS PROGRAMS ONLY.

PIPING SYSTEM	NOM DIA (INO)	SCH	NOM WALL THK	MATERIAL SPECIFICATION	NATL TYPE	CAL BLOCK NO
3" CCH(2)-1	3	STD	0.218	SA 106 GR B	CS	NA


NO	DATE	REVISION	BY	CHKD	APVD
0	10-16-67	ISSUED FOR USE	K-McA	DPR	TTH



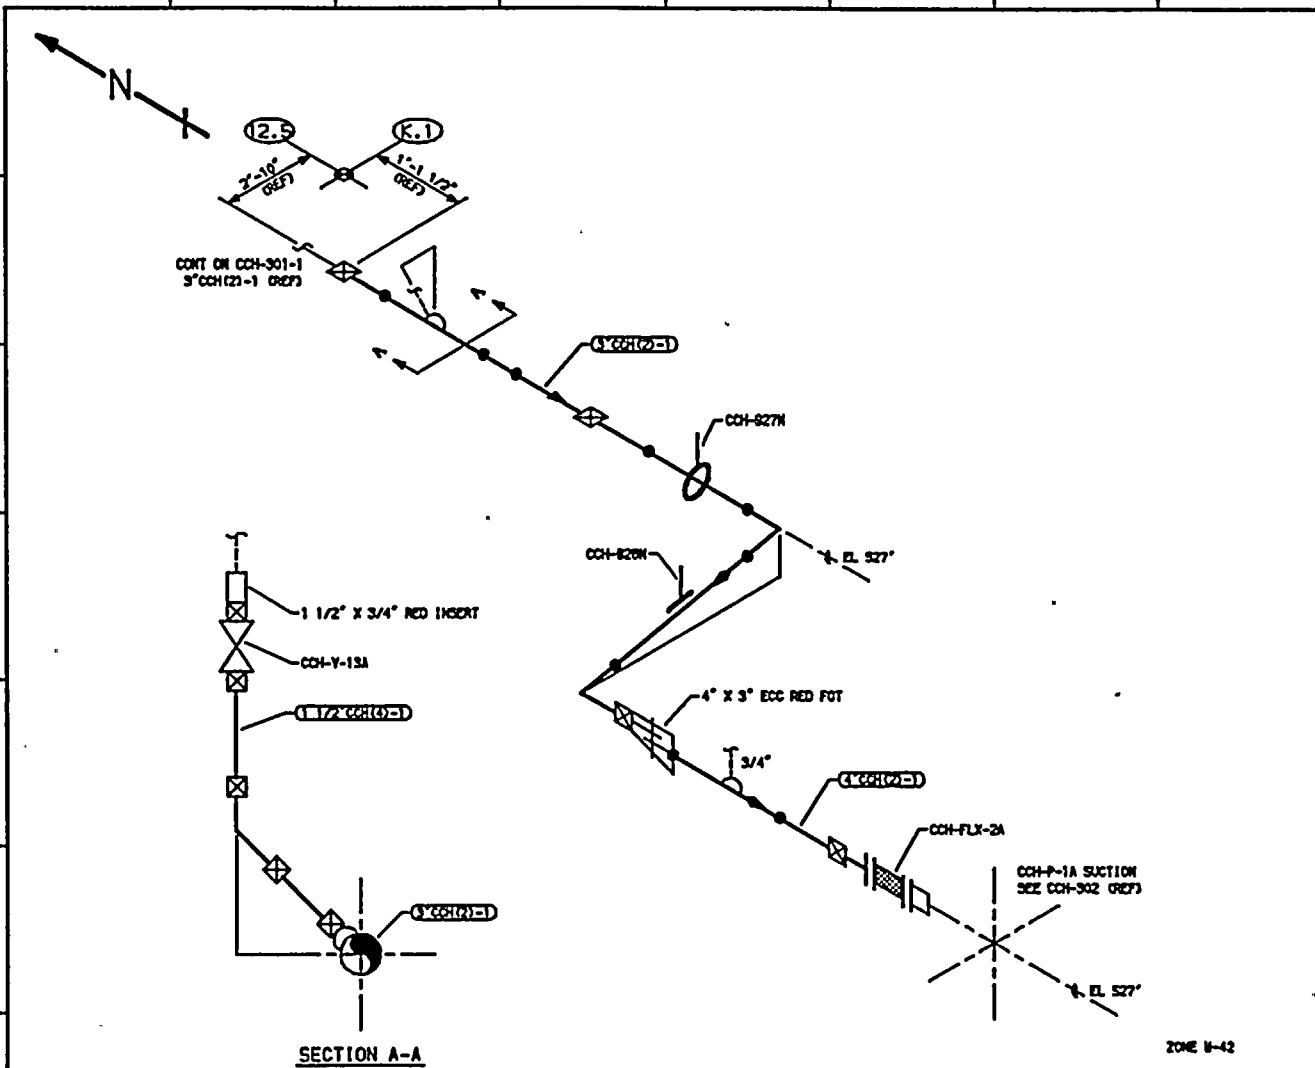

- NOTES:**
1. THIS DRAWING IDENTIFIES PIPING AND COMPONENTS SUBJECT ONLY TO A VISUAL EXAM FOR (1) EVIDENCE OF LEAKAGE DURING SYSTEM PRESSURE OR OPERABILITY TESTS; (2) PRESSURE DECAY TESTS OF BURIED PIPING; AND (3) LOSS OF SUPPORT CAPABILITY OR INADEQUATE RESTRAINT FOR SUPPORTS AND HANGERS ON PIPING EXCEEDING 4" NOM. TESTS SHALL BE CONDUCTED PER ASME SECTION XI, ARTICLES 1MA-5000 AND 1MO-2000.
  2. FOR BRANCH PIPING 4" NOM. OR LESS CONNECTION SHOWN IN DASHED LINES) EXTEND VISUAL LEAKAGE EXAM THROUGH THE OUTERMOST NORMALLY CLOSED NUCLEAR CLASS VALVE, OR UNTIL TRANSITION TO INSTRUMENT TUBING, UNLESS OTHERWISE NOTED.

**REFERENCES:**  
 ISI - 275  
 BOYCE & CRAIG ISOMETRICS  
 CCH-107-1.7 REY 4  
 CCH-1001-1 REY 4

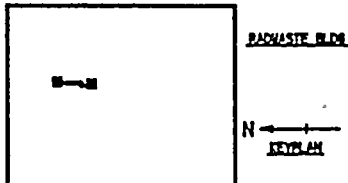

QUALITY CLASS: 1 ASME CODE CLASS: 3  
 ENGR: K-McANDREW DRAWN: K-McA DATE: 1-20-88

WASHINGTON PUBLIC POWER  
 SUPPLY SYSTEM  
 RICHLAND, WASHINGTON 99352

WMP-2  
 WELD & COMPONENT  
 IDENTIFICATION DIAGRAM


TITLE:  
 CCH-P-1A SUCTION FROM WMA-CC-51A-1

DWG NO: CCH-301-2 REV 0

ZONE W-42  
 THIS DRAWING IS INTENDED FOR  
 USE IN PRESERVICE AND INSERVICE  
 INSPECTIONS PROGRAMS ONLY.

PIPING SYSTEM	NOM DIA (IN)	SCH	NOM WALL THK	MATERIAL SPECIFICATION	MATL TYPE	CAL BLOCK NO
3" CCH(2)-1	3	STD	0.218	SA 106 GR B	CS	NA
1 1/2" CCH(4)-1	1 1/2	80	0.200	SA 106 GR B	CS	NA
4" CCH(2)-1	4	STD	0.237	SA 106 GR B	CS	NA

NO	DATE	REVISION	BY	CHKD	APVD
0	10-18-87	ISSUED FOR USE	K-McA	DPR	TTH

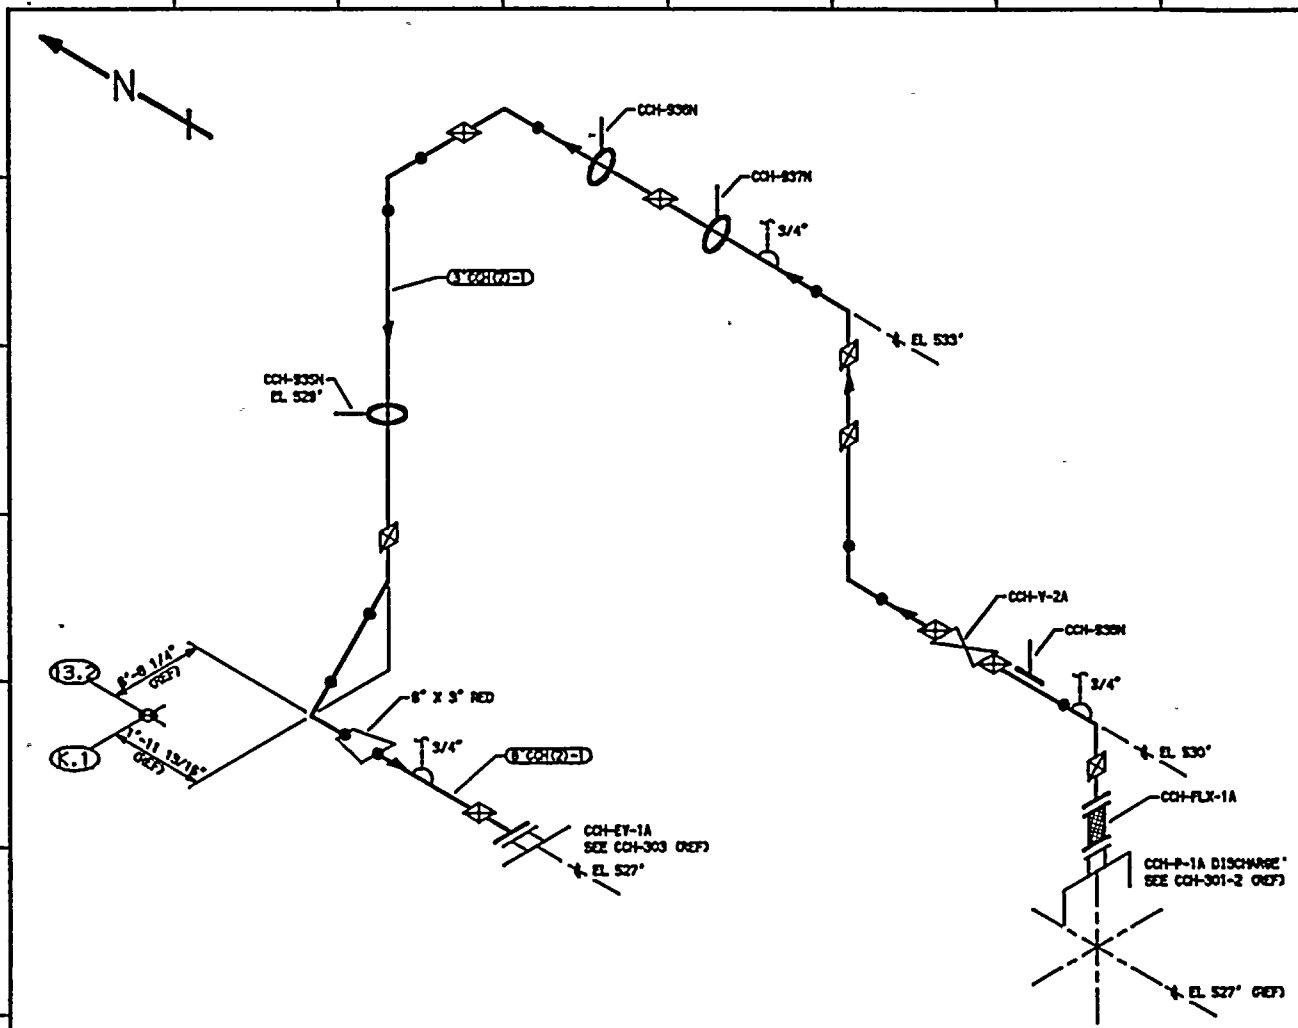

- NOTES:**
1. THIS DRAWING IDENTIFIES PIPING AND COMPONENTS SUBJECT ONLY TO A VISUAL EXAM FOR (1) EVIDENCE OF LEAKAGE DURING SYSTEM PRESSURE OR OPERABILITY TESTS, (2) PRESSURE DECAY TESTS OF BURIED PIPING, AND (3) LOSS OF SUPPORT CAPABILITY OR INADEQUATE RESTRAINT FOR SUPPORTS AND HANGERS ON PIPING EXCEEDING 4" NOM. TESTS SHALL BE CONDUCTED PER ASME SECTION XI, ARTICLES 11A-5000 AND 11D-2000.
  2. FOR BRANCH PIPING 4" NOM. OR LESS CONNECTION SHOWN IN DASHED LINES EXTEND VISUAL LEAKAGE EXAM THROUGH THE OUTERMOST NORMALLY CLOSED NUCLEAR CLASS VALVE, OR UNTIL TRANSITION TO INSTRUMENT TUBING, UNLESS OTHERWISE NOTED.

**REFERENCES:**

ISI - 275  
 BOYCE & CRAIG ISOMETRIC  
 CCH-101-1.6 REV 5

RADIOACTIVE BLDG  
 N  
 KEYPLAN

QUALITY CLASS: 1	ASME CODE CLASS: 3
ENGR: K-McANDREW	DRAWN: K-McA DATE: 1-30-68

WASHINGTON PUBLIC POWER  
 SUPPLY SYSTEM  
 RICHLAND, WASHINGTON 99352

THIS DRAWING IS INTENDED FOR  
 USE IN PRESERVICE AND INSERVICE  
 INSPECTIONS PROGRAMS ONLY.

PIPING SYSTEM	NOM DIA (IN)	SCH	NOM WALL THK	MATERIAL SPECIFICATION	MATL TYPE	CAL BLOCK NO
3" CCH(2)-1	3	STD	0.218	SA 106 GR B	CS	NA
6" CCH(2)-1	6	STD	0.280	SA 106 GR B	CS	NA


WPP-2  
 WELD & COMPONENT  
 IDENTIFICATION DIAGRAM

TITLE:  
 CCH-P-1A DISCHARGE TO CCH-EY-1A

0	10-18-67	ISSUED FOR USE	K-McA	DPR	TFM
NO	DATE	REVISION	BY	CHKD	APVD

DWG NO: CCH-302

REV 0

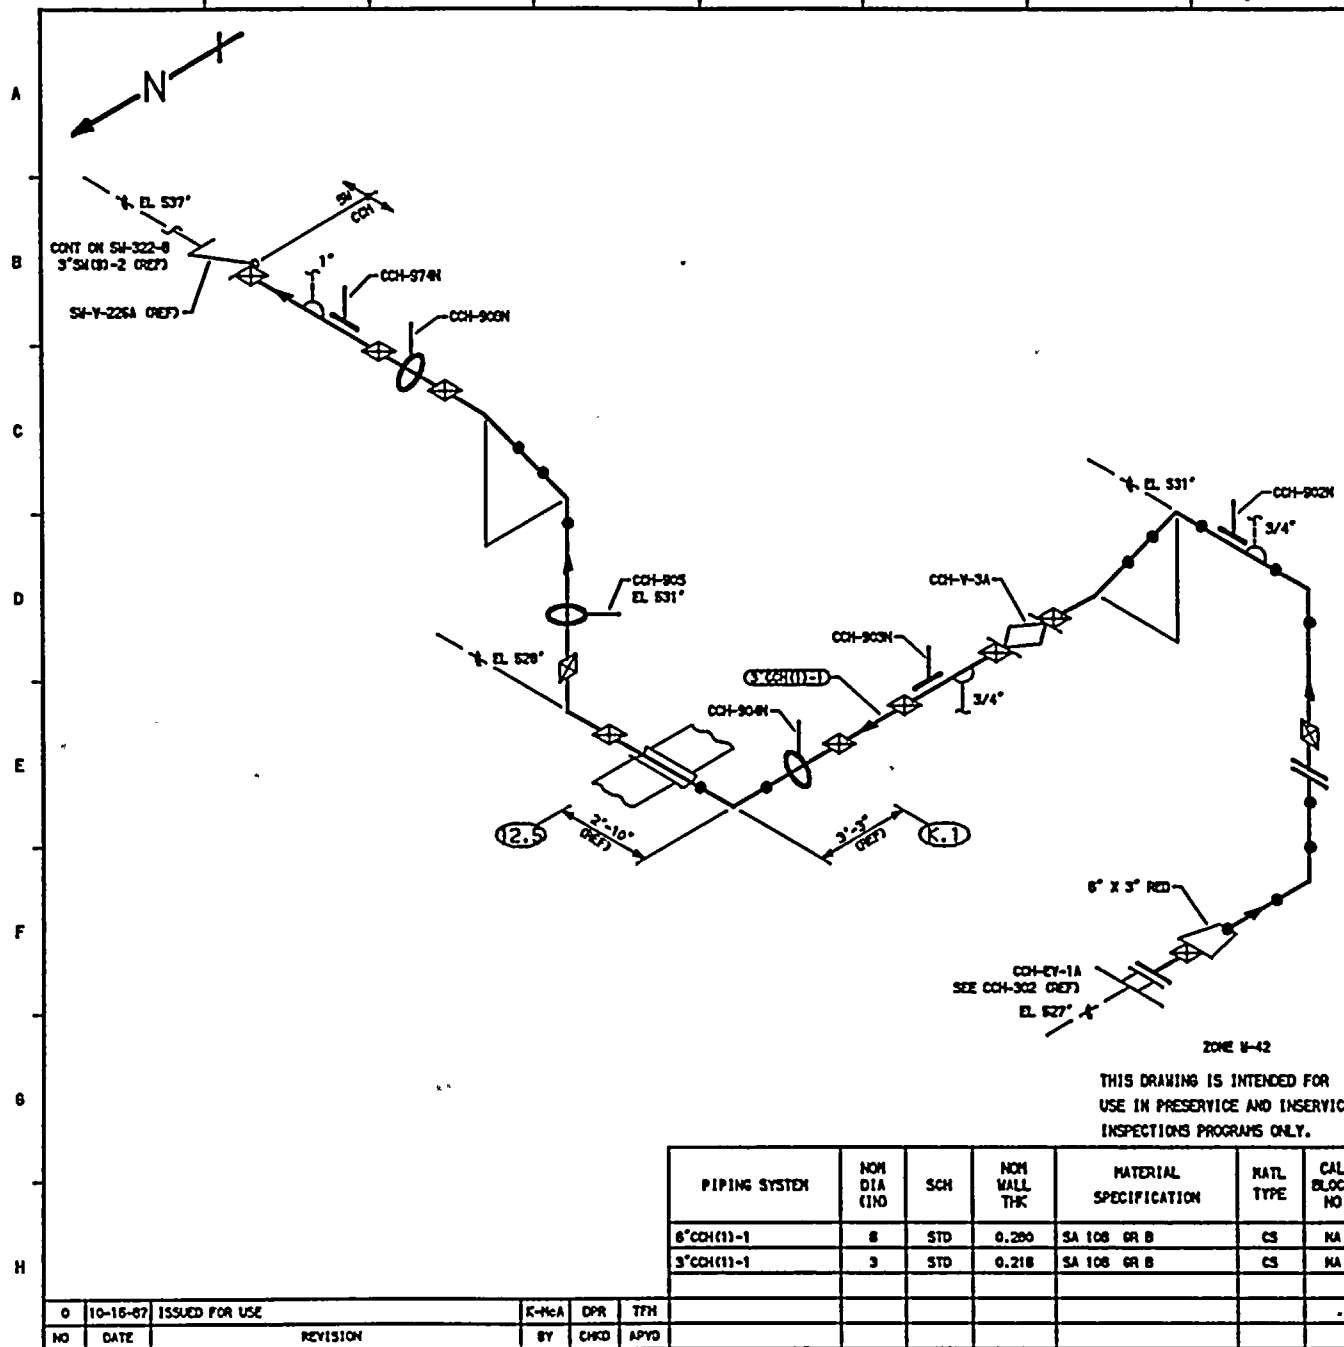

- NOTES:**
1. THIS DRAWING IDENTIFIES PIPING AND COMPONENTS SUBJECT ONLY TO A VISUAL EXAM FOR (1) EVIDENCE OF LEAKAGE DURING SYSTEM PRESSURE OR OPERABILITY TESTS; (2) PRESSURE DECAY TESTS OF BURIED PIPING; AND (3) LOSS OF SUPPORT CAPABILITY OR INADEQUATE RESTRAINT FOR SUPPORTS AND HANGERS ON PIPING EXCEEDING 4" NOM. TESTS SHALL BE CONDUCTED PER ASME SECTION XI, ARTICLES 1WA-5000 AND 1WO-2000.
  2. FOR BRANCH PIPING 4" NOM. OR LESS (CONNECTION SHOWN IN DASHED LINES) EXTEND VISUAL LEAKAGE EXAM THROUGH THE OUTERMOST NORMALLY CLOSED NUCLEAR CLASS VALVE, OR UNTIL TRANSITION TO INSTRUMENT TUBING, UNLESS OTHERWISE NOTED.

**REFERENCES:**

ISI - 275  
 BOYCE & GRILL ISOMETRIC  
 CCH-100-1.7 REV 5

PACK WASTE BLDG  
 N  
 KEYPLAN

QUALITY CLASS: 1 ASME CODE CLASS: 3  
 ENGR: K-McANDREW DRAWN: K-McA DATE: 1-30-68

WASHINGTON PUBLIC POWER  
 SUPPLY SYSTEM  
 RICHLAND, WASHINGTON 99352


WP-2  
 WELD & COMPONENT  
 IDENTIFICATION DIAGRAM

TITLE:  
 CCH-EY-1A SUPPLY LINE TO WNA-CC-51A-1

DWG NO: CCH-303 REV 0

PIPING SYSTEM	NOM DIA (IN)	SCH	NOM WALL THK	MATERIAL SPECIFICATION	RATL TYPE	CAL BLOCK NO
6" CCH(1)-1	6	STD	0.280	SA 106 GR B	CS	NA
3" CCH(1)-1	3	STD	0.218	SA 106 GR B	CS	NA

NO	DATE	REVISION	BY	CHKD	APPD
0	10-16-67	ISSUED FOR USE	K-McA	DPR	TFH

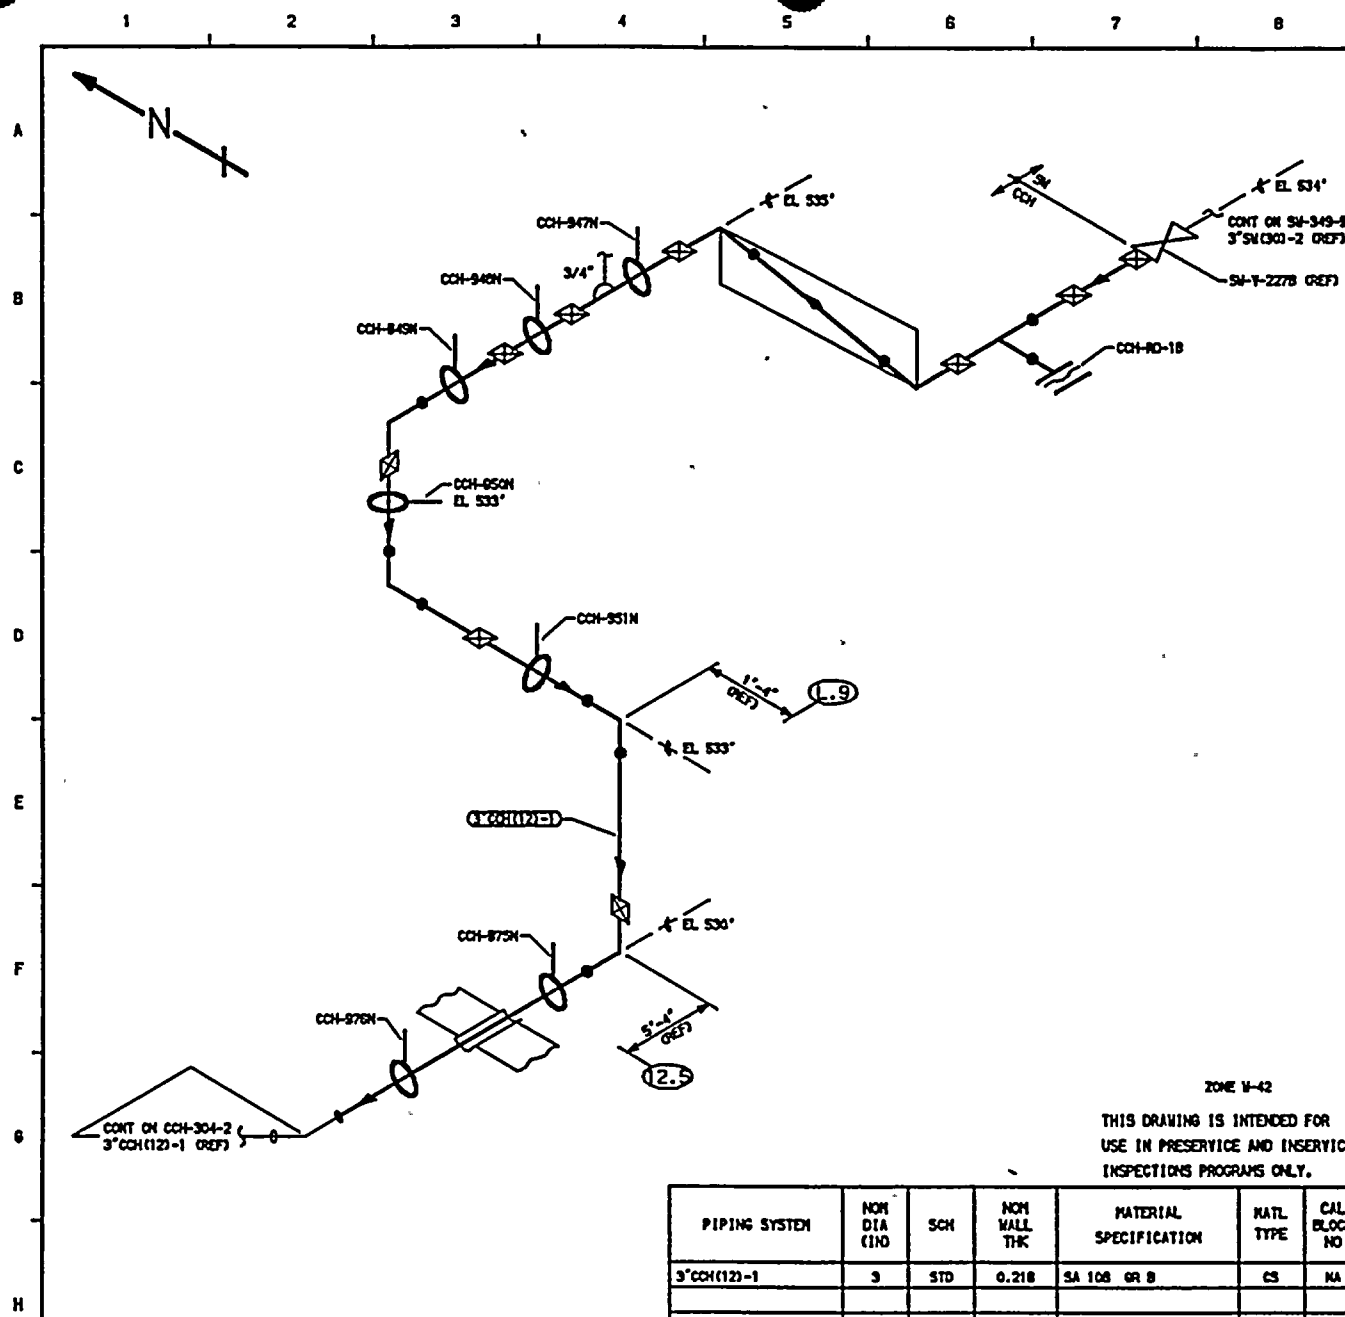

- NOTES:**
1. THIS DRAWING IDENTIFIES PIPING AND COMPONENTS SUBJECT ONLY TO A VISUAL EXAM FOR (1) EVIDENCE OF LEAKAGE DURING SYSTEM PRESSURE OR OPERABILITY TESTS; (2) PRESSURE DECAY TESTS OF BURIED PIPING; AND (3) LOSS OF SUPPORT CAPABILITY OR INADEQUATE RESTRAINT FOR SUPPORTS AND HANGERS ON PIPING EXCEEDING 4" NOM. TESTS SHALL BE CONDUCTED PER ASME SECTION XI, ARTICLES IMA-5000 AND IMA-2000.
  2. FOR BRANCH PIPING 4" NOM. OR LESS CONNECTION SHOWN IN DASHED LINES EXTEND VISUAL LEAKAGE EXAM THROUGH THE OUTERMOST NORMALLY CLOSED NUCLEAR CLASS VALVE, OR UNTIL TRANSITION TO INSTRUMENT TUBING, UNLESS OTHERWISE NOTED.

**REFERENCES:**

ISI - 275  
 BOYCE & ORAIL ISOMETRIC  
 CCH-100-1.0 REV 4

WASTE BLDR  
 N  
 KEYPLAN

ZONE V-42  
 THIS DRAWING IS INTENDED FOR  
 USE IN PRESERVICE AND INSERVICE  
 INSPECTIONS PROGRAMS ONLY.

PIPING SYSTEM	NOM DIA (1N)	SCH	NOM WALL THK	MATERIAL SPECIFICATION	MATL TYPE	CAL BLOCK NO
3" CCH(12)-1	3	STD	0.218	SA 106 GR B	CS	NA

QUALITY CLASS: 1	ASME CODE CLASS: 3
ENGR: K-McANDREW	DRAWN: K-McA   DATE: 1-30-68

WASHINGTON PUBLIC POWER  
 SUPPLY SYSTEM  
 RICHMOND, WASHINGTON 98352


WP-2  
 WELD & COMPONENT  
 IDENTIFICATION DIAGRAM

TITLE:  
 CCH-P-1B SUCTION FROM WWA-CC-518-1

0	10-16-67	ISSUED FOR USE	K-McA	DPR	TTH				
NO	DATE	REVISION	BY	CHKD	APVD				

DWG NO: CCH-304-1      REV 0



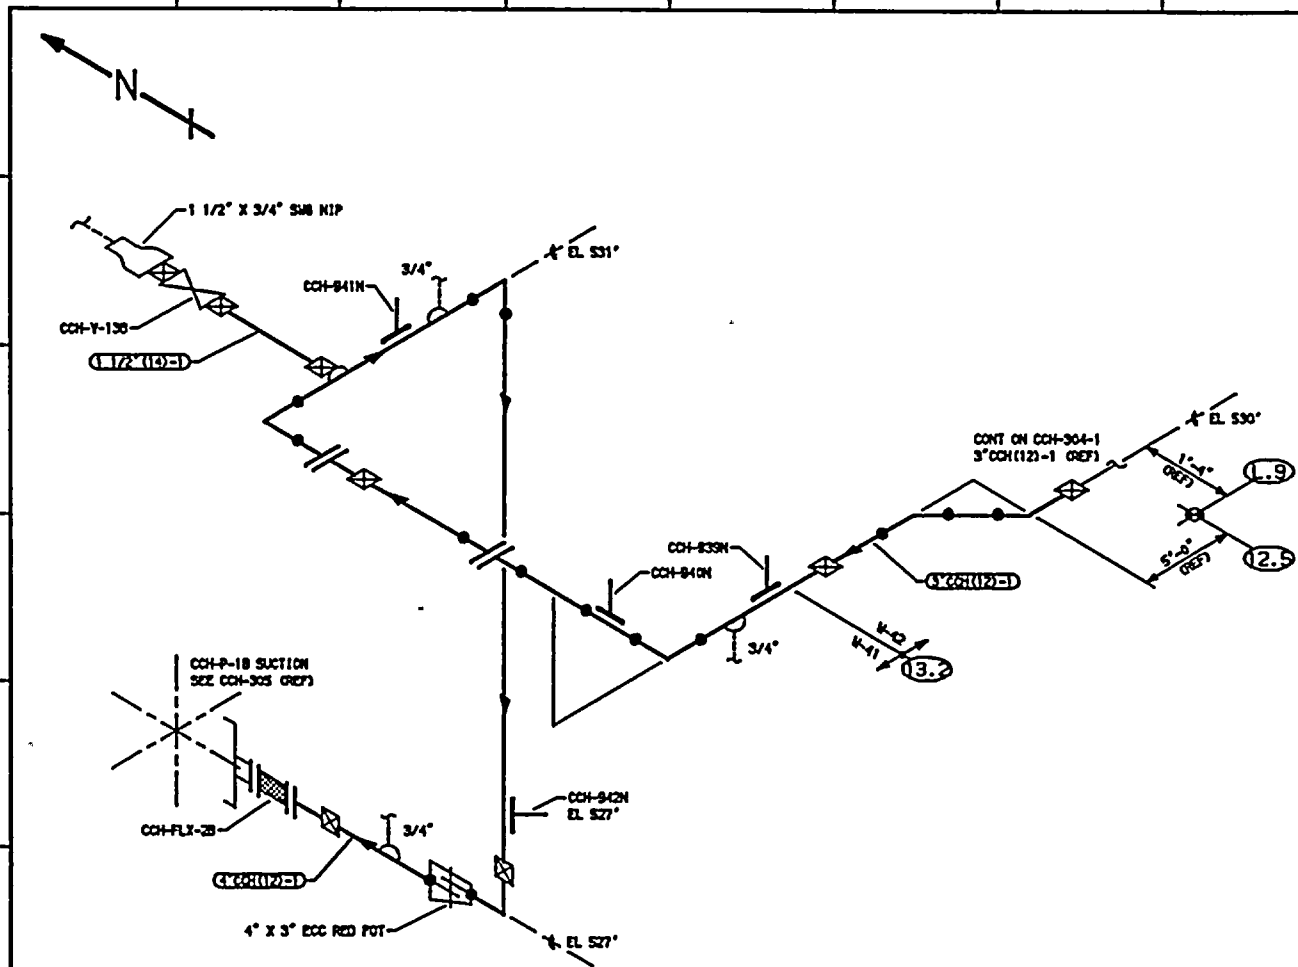

- NOTES:**
1. THIS DRAWING IDENTIFIES PIPING AND COMPONENTS SUBJECT ONLY TO A VISUAL EXAM FOR (1) EVIDENCE OF LEAKAGE DURING SYSTEM PRESSURE OR OPERABILITY TESTS, (2) PRESSURE DECAY TESTS OF BURIED PIPING, AND (3) LOSS OF SUPPORT CAPABILITY OR INADEQUATE RESTRAINT FOR SUPPORTS AND MANGERS ON PIPING EXCEEDING 4" NOM. TESTS SHALL BE CONDUCTED PER ASME SECTION XI, ARTICLES 1MA-5000 AND 1MD-2000.
  2. FOR BRANCH PIPING 4" NOM. OR LESS CONNECTION SHOWN IN DASHED LINES) EXTEND VISUAL LEAKAGE EXAM THROUGH THE CUTTERMOST NORMALLY CLOSED NUCLEAR CLASS VALVE, OR UNTIL TRANSITION TO INSTRUMENT TUBING, UNLESS OTHERWISE NOTED.

**REFERENCES:**

131 - 275  
 BOYCE & CRAIG ISOMETRICS  
 CCH-100-1.5 REV 3  
 CCH-1000-1 REV 4

ZONES W-42 & W-41  
 THIS DRAWING IS INTENDED FOR  
 USE IN PRESERVICE AND INSERVICE  
 INSPECTIONS PROGRAMS ONLY.


PIPING SYSTEM	NOM DIA (IN)	SCH	NOM WALL THK	MATERIAL SPECIFICATION	MATL TYPE	CAL BLOCK NO
3" CCH(112)-1	3	STD	0.218	SA 106 GR B	CS	NA
1 1/2" CCH(114)-1	1 1/2	80	0.200	SA 106 GR B	CS	NA
4" CCH(112)-1	4	STD	0.237	SA 106 GR B	CS	NA

NO	DATE	REVISION	BY	CHKD	APVD
0	10-16-87	ISSUED FOR USE	K-McA	DPR	TTH

QUALITY CLASS: 1	ASME CODE CLASS: 3
ENGR: K-McANDREW	DATE: 2-3-88
 WASHINGTON PUBLIC POWER SUPPLY SYSTEM RICHLAND, WASHINGTON 99352	
WFP-2 WELD & COMPONENT IDENTIFICATION DIAGRAM	
TITLE: CCH-P-18 SUCTION FROM WMA-CC-518-1	
DWG NO: CCH-304-2	REV 0

1 2 3 4 5 6 7 8 9 10

A  
B  
C  
D  
E  
F  
G  
H

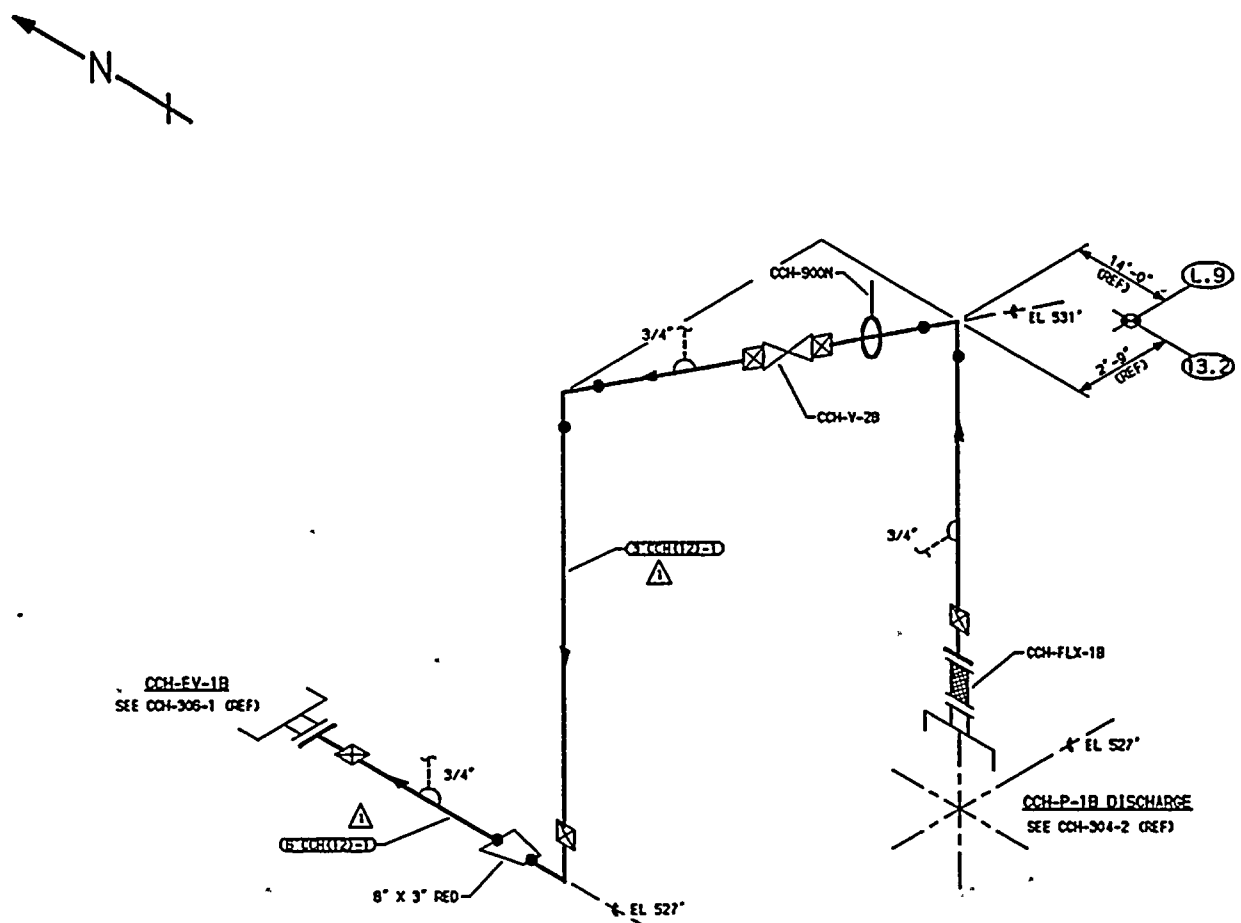


**NOTES:**

1. THIS DRAWING IDENTIFIES PIPING AND COMPONENTS SUBJECT ONLY TO A VISUAL EXAM FOR (1) EVIDENCE OF LEAKAGE DURING SYSTEM PRESSURE OR OPERABILITY TESTS; (2) PRESSURE DECAY TESTS OF BURIED PIPING; AND (3) LOSS OF SUPPORT CAPABILITY OR INADEQUATE RESTRAINT FOR SUPPORTS AND HANGERS ON PIPING EXCEEDING 4" NOM. TESTS SHALL BE CONDUCTED PER ASME SECTION XI, ARTICLES 1WA-5000 AND 1W-2000.
2. FOR BRANCH PIPING 4" NOM. OR LESS (CONNECTION SHOWN IN DASHED LINES) EXTEND VISUAL LEAKAGE EXAM THROUGH THE OUTERMOST NORMALLY CLOSED NUCLEAR CLASS VALVE, OR UNTIL TRANSITION TO INSTRUMENT TUBING, UNLESS OTHERWISE NOTED.

**REFERENCES:**

- 151 - 275
- BOYCE & GRAIL ISOMETRIC
- CCH-105-1.3 REV 4

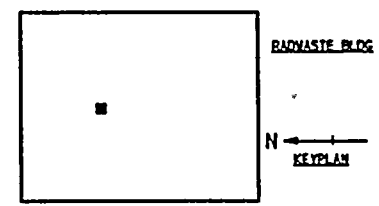

ZONE V-41

THIS DRAWING IS INTENDED FOR USE IN PRESERVE AND INSERVICE INSPECTIONS PROGRAMS ONLY.

PIPING SYSTEM	NOM DIA (IN)	SCH	NOM WALL THK	MATERIAL SPECIFICATION	MATL TYPE	CAL BLOCK NO
3" CCH(12)-1	3	STD	0.218	SA 106 GR B	CS	NA
8" CCH(12)-1	8	STD	0.290	SA 106 GR B	CS	NA

QUALITY CLASS, 1	ASME CODE CLASS, 3
ENGR, K-McANDREW	DRAWN, K-McA DATE, 2-4-88


WASHINGTON PUBLIC POWER  
SUPPLY SYSTEM  
RICHLAND, WASHINGTON 99352

INP-2  
WELD & COMPONENT  
IDENTIFICATION DIAGRAM

TITLE:  
CCH-P-1B DISCHARGE TO CCH-EV-1B

DWG NO. CCH-305 REV 1

NO	DATE	REVISION	BY	CHKD	APVD
1	1-22-84	CORRECTED SYSTEM LINE NUMBER.	K-McA	DPR	DW
0	10-18-87	ISSUED FOR USE	K-McA	DPR	TFH

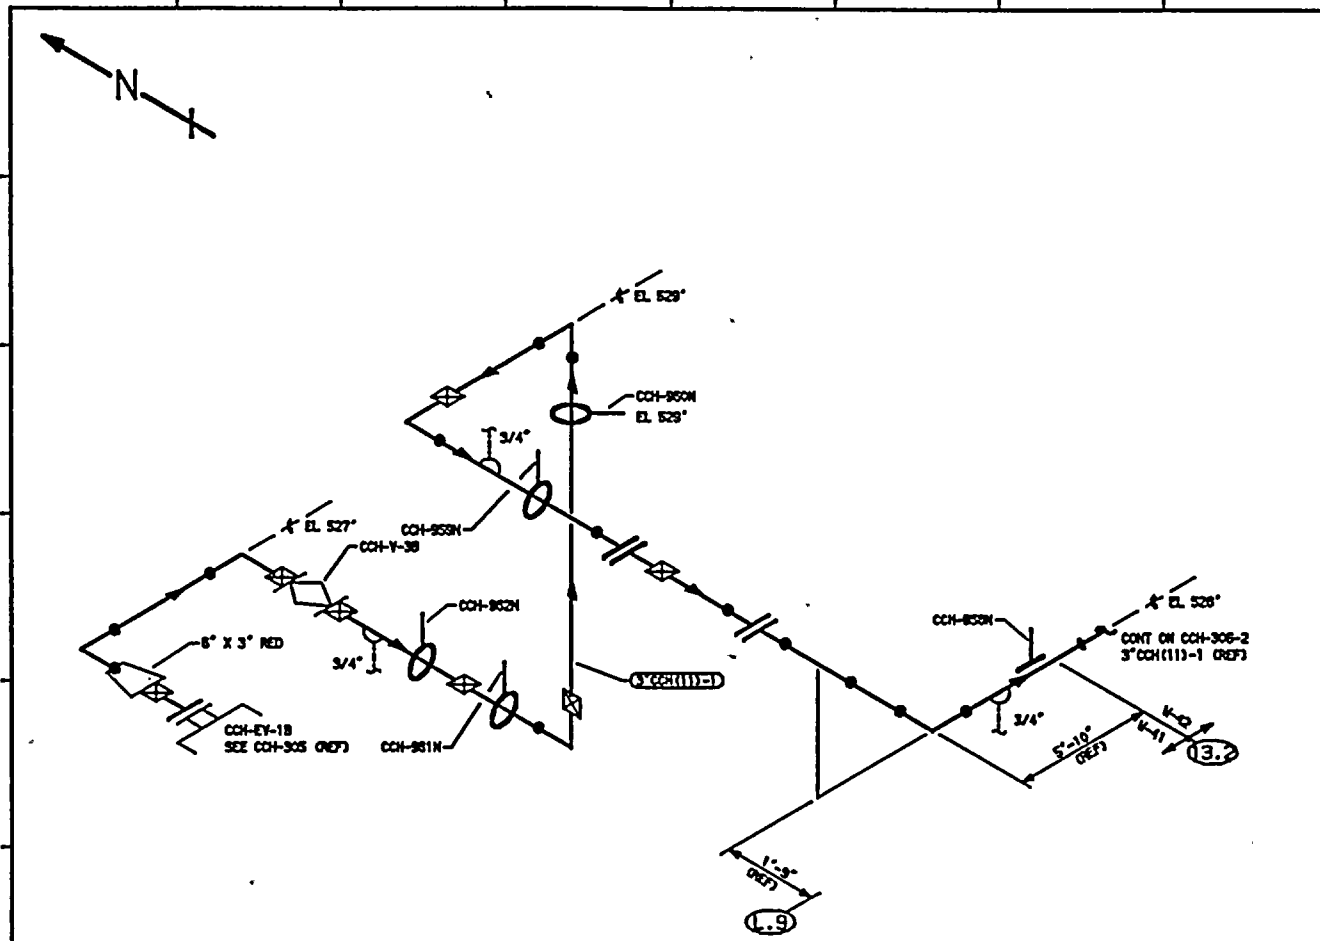


**NOTES:**

1. THIS DRAWING IDENTIFIES PIPING AND COMPONENTS SUBJECT ONLY TO A VISUAL EXAM FOR (1) EVIDENCE OF LEAKAGE DURING SYSTEM PRESSURE OR OPERABILITY TESTS, (2) PRESSURE DECAY TESTS OF BURIED PIPING, AND (3) LOSS OF SUPPORT CAPABILITY OR INADEQUATE RESTRAINT FOR SUPPORTS AND HANGERS ON PIPING EXCEEDING 4" NOM. TESTS SHALL BE CONDUCTED PER ASME SECTION XI, ARTICLES 1WA-5000 AND 1WD-2000.
2. FOR BRANCH PIPING 4" NOM. OR LESS (CONNECTION SHOWN IN DASHED LINES) EXTEND VISUAL LEAKAGE EXAM THROUGH THE OUTERMOST NORMALLY CLOSED NUCLEAR CLASS VALVE, OR UNTIL TRANSITION TO INSTRUMENT TUBING, UNLESS OTHERWISE NOTED.

**REFERENCES:**

ISI - 275  
 BOYCE & CRAIG ISOMETRIC  
 CCH-103-1.0 REV 4

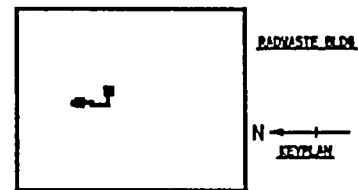

ZONES U-41 & U-42

THIS DRAWING IS INTENDED FOR  
 USE IN PRESERVICE AND INSERVICE  
 INSPECTIONS PROGRAMS ONLY.

PIPING SYSTEM	NOM DIA (IN)	SCH	NOM WALL THK	MATERIAL SPECIFICATION	MATL TYPE	CAL BLOCK NO
8" CCH(111)-1	8	STD	0.280	SA 106 GR B	CS	NA
3" CCH(111)-1	3	STD	0.218	SA 106 GR B	CS	NA

QUALITY CLASS: 1	ASME CODE CLASS: 3
ENGR: K-McANDREW	DATE: 2-4-08

WASHINGTON PUBLIC POWER  
 SUPPLY SYSTEM  
 RICHLAND, WASHINGTON 99352


WFP-2  
 WELD & COMPONENT  
 IDENTIFICATION DIAGRAM

TITLE:  
 CCH-EY-18 SUPPLY LINE TO WIA-CC-518-1

NO	DATE	REVISION	BY	CHKD	APVD
0	10-16-07	ISSUED FOR USE	K-McA	DPR	TTH

DWG NO. CCH-306-1      REV 0



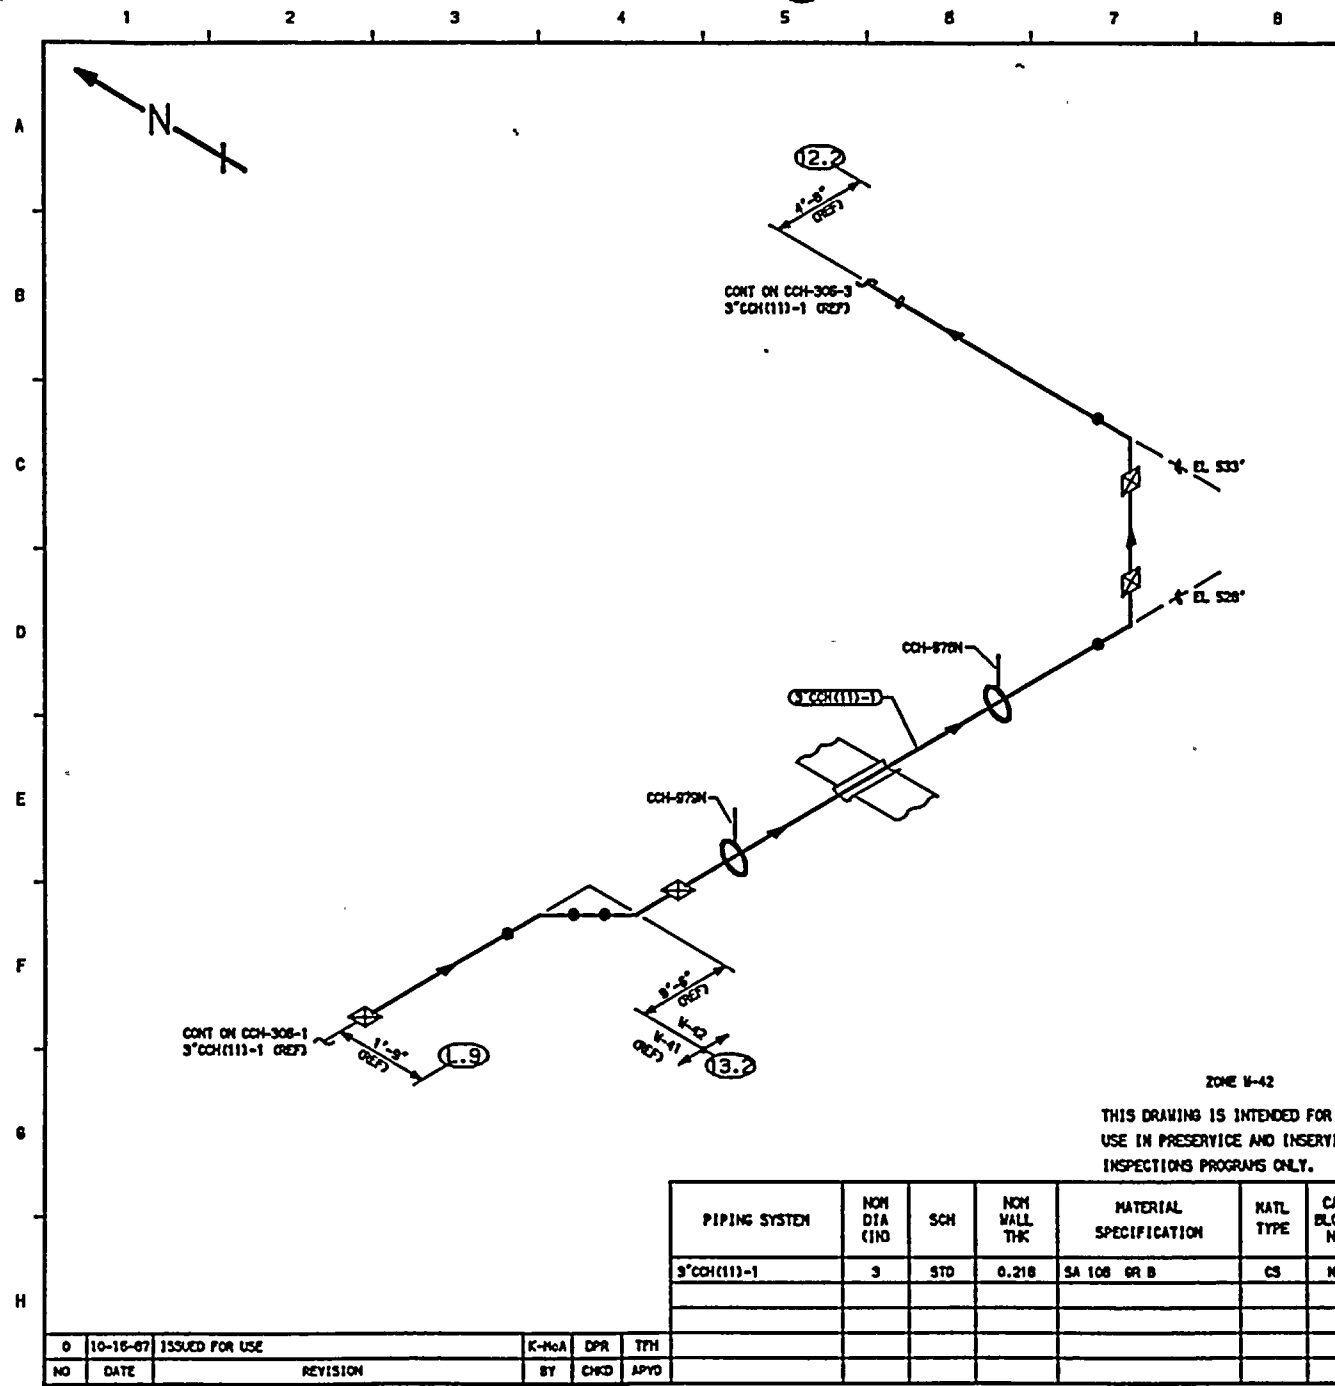

- NOTES:**
1. THIS DRAWING IDENTIFIES PIPING AND COMPONENTS SUBJECT ONLY TO A VISUAL EXAM FOR (1) EVIDENCE OF LEAKAGE DURING SYSTEM PRESSURE OR OPERABILITY TESTS, (2) PRESSURE DECAY TESTS OF BURIED PIPING, AND (3) LOSS OF SUPPORT CAPABILITY OR INADEQUATE RESTRAINT FOR SUPPORTS AND HANGERS ON PIPING EXCEEDING 4" NOM. TESTS SHALL BE CONDUCTED PER ASME SECTION XI, ARTICLES 1WA-5000 AND 1WD-2000.
  2. FOR BRANCH PIPING 4" NOM. OR LESS (CONNECTION SHOWN IN DASHED LINES) EXTEND VISUAL LEAKAGE EXAM THROUGH THE OUTERMOST NORMALLY CLOSED NUCLEAR CLASS VALVE, OR UNTIL TRANSITION TO INSTRUMENT TUBING, UNLESS OTHERWISE NOTED.

**REFERENCES:**

ISI - 275  
 BOYCE & CRILL ISOMETRICS  
 CCH-103-1.8 REV 4  
 CCH-104-1.14 REV 5

7

RADWASTE BLDG

N  
KEYPLAN

QUALITY CLASS: 1      ASME CODE CLASS: 3  
 ENGR: K-McANDREW    DRAWN: K-McA      DATE: 2-5-68

**WASHINGTON PUBLIC POWER  
 SUPPLY SYSTEM**  
 RICHLAND, WASHINGTON 99352

**WPP-2  
 WELD & COMPONENT  
 IDENTIFICATION DIAGRAM**


**TITLE:**  
 CCH-EY-1B SUPPLY LINE TO WNA-CC-51B-1

DWG NO: CCH-306-2      REV 0

ZONE U-42  
 THIS DRAWING IS INTENDED FOR  
 USE IN PRESERVICE AND INSERVICE  
 INSPECTIONS PROGRAMS ONLY.

PIPING SYSTEM	NOM DIA (IN)	SCH	NOM WALL THK	MATERIAL SPECIFICATION	MATL TYPE	CAL BLOCK NO
3"CCH(111)-1	3	STD	0.218	SA 106 GR B	CS	NA

NO	DATE	REVISION	BY	CHKD	APVD	K-McA	DPR	TTH
0	10-16-67	ISSUED FOR USE						

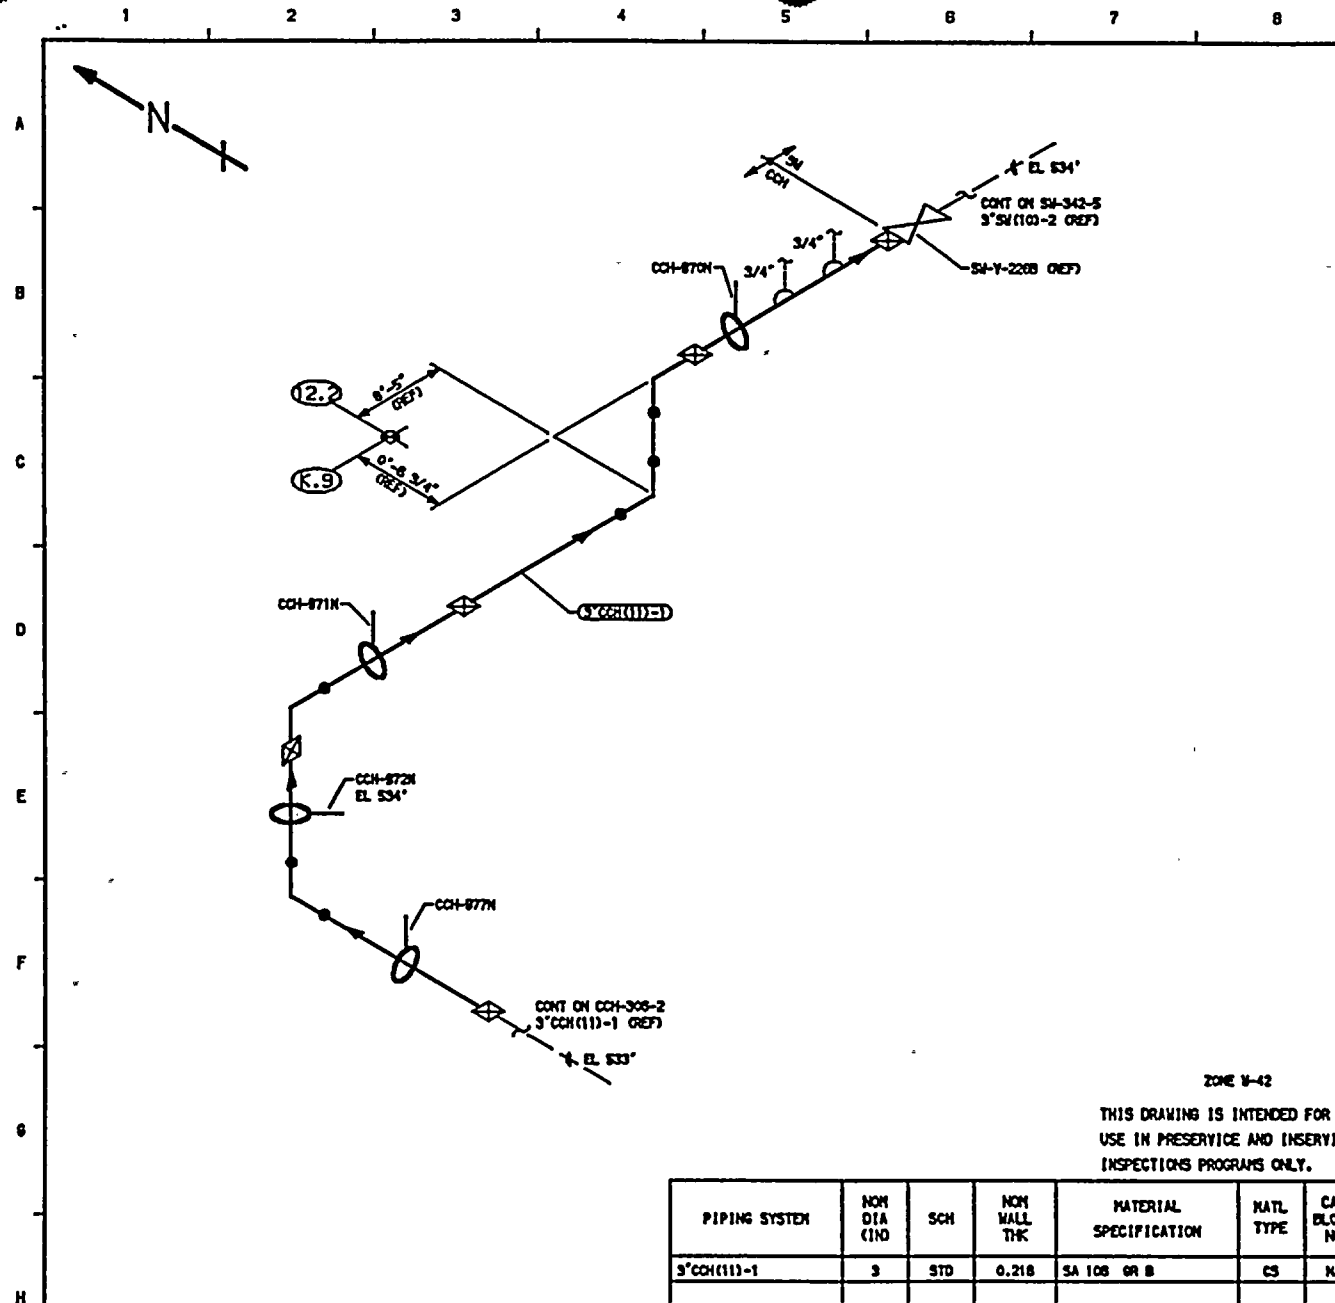

- NOTES:**
1. THIS DRAWING IDENTIFIES PIPING AND COMPONENTS SUBJECT ONLY TO A VISUAL EXAM FOR (1) EVIDENCE OF LEAKAGE DURING SYSTEM PRESSURE OR OPERABILITY TESTS, (2) PRESSURE DECAY TESTS OF BURIED PIPING, AND (3) LOSS OF SUPPORT CAPABILITY OR INADEQUATE RESTRAINT FOR SUPPORTS AND HANGERS ON PIPING EXCEEDING 4" NOM. TESTS SHALL BE CONDUCTED PER ASME SECTION XI, ARTICLES IMA-5000 AND IMA-2000.
  2. FOR BRANCH PIPING 4" NOM. OR LESS (CONNECTION SHOWN IN DASHED LINES) EXTEND VISUAL LEAKAGE EXAM THROUGH THE OUTERMOST NORMALLY CLOSED NUCLEAR CLASS VALVE, OR UNTIL TRANSITION TO INSTRUMENT TUBING, UNLESS OTHERWISE NOTED.

**REFERENCES:**

ISI - 275  
 BOYCE & ORILL ISOMETRIC  
 CCH-104-1.14 REV 5

RAHWASTE HLDG

N  
KEYPLAN

ZONE V-42

THIS DRAWING IS INTENDED FOR  
 USE IN PRESERVICE AND INSERVICE  
 INSPECTIONS PROGRAMS ONLY.

PIPING SYSTEM	NOM DIA (110)	SCH	NOM WALL THK	MATERIAL SPECIFICATION	MATL TYPE	CAL BLOCK NO
3"CCH(111)-1	3	STD	0.218	SA 106 GR B	CS	NA

QUALITY CLASS: 1	ASME CODE CLASS: 3
ENGR: K-McANDREW	DRAWN: K-McA   DATE: 2-5-68

WASHINGTON PUBLIC POWER  
 SUPPLY SYSTEM  
 RICHLAND, WASHINGTON 99352

WPP-2  
 WELD & COMPONENT  
 IDENTIFICATION DIAGRAM

TITLE:  
 CCH-EV-1B SUPPLY LINE TO WNA-CC-51B-1

0	10-16-67	ISSUED FOR USE	K-McA	DPR	TTH
NO	DATE	REVISION	BY	CHKD	APVD

DWG NO: CCH-306-3 REV 0

## 9.3 CRD Control Rod Drive System

## Boundary Diagram ISI-228

## Exemptions Applied:

## IWB-1220

(a)	NA
(b)(1)	NA
(b)(2)	NA
(c)	NA

IWC-1221      NA      CRD system is not within the RHR, ECC, or CHR systems.

## IWC-1222

(a)	Yes	All piping 4 NPS and smaller
(b)	Yes	All components 4 NPS and smaller
(c)	No	
(d)	No	

IWD-1220.1      NA      No Class 3 piping within CRD

IWD-1220.2      NA      No Class 3 piping within CRD

 
## Code Case N-491


-1230      Yes

Supply System will include the scram discharge volume welds in the scope of ASME class 2 welds. During the previous inspection period 10% of the welds in the scram discharge volume were examined using a volumetric technique. Reference letter G02-83-523, G. D. Bouchey to A. Schwencer, "PSI Summary Report Clarification" dated June 15, 1983, Generic Letter 81-35 and NUREG 0803.

9.3.2 Boundary Diagrams





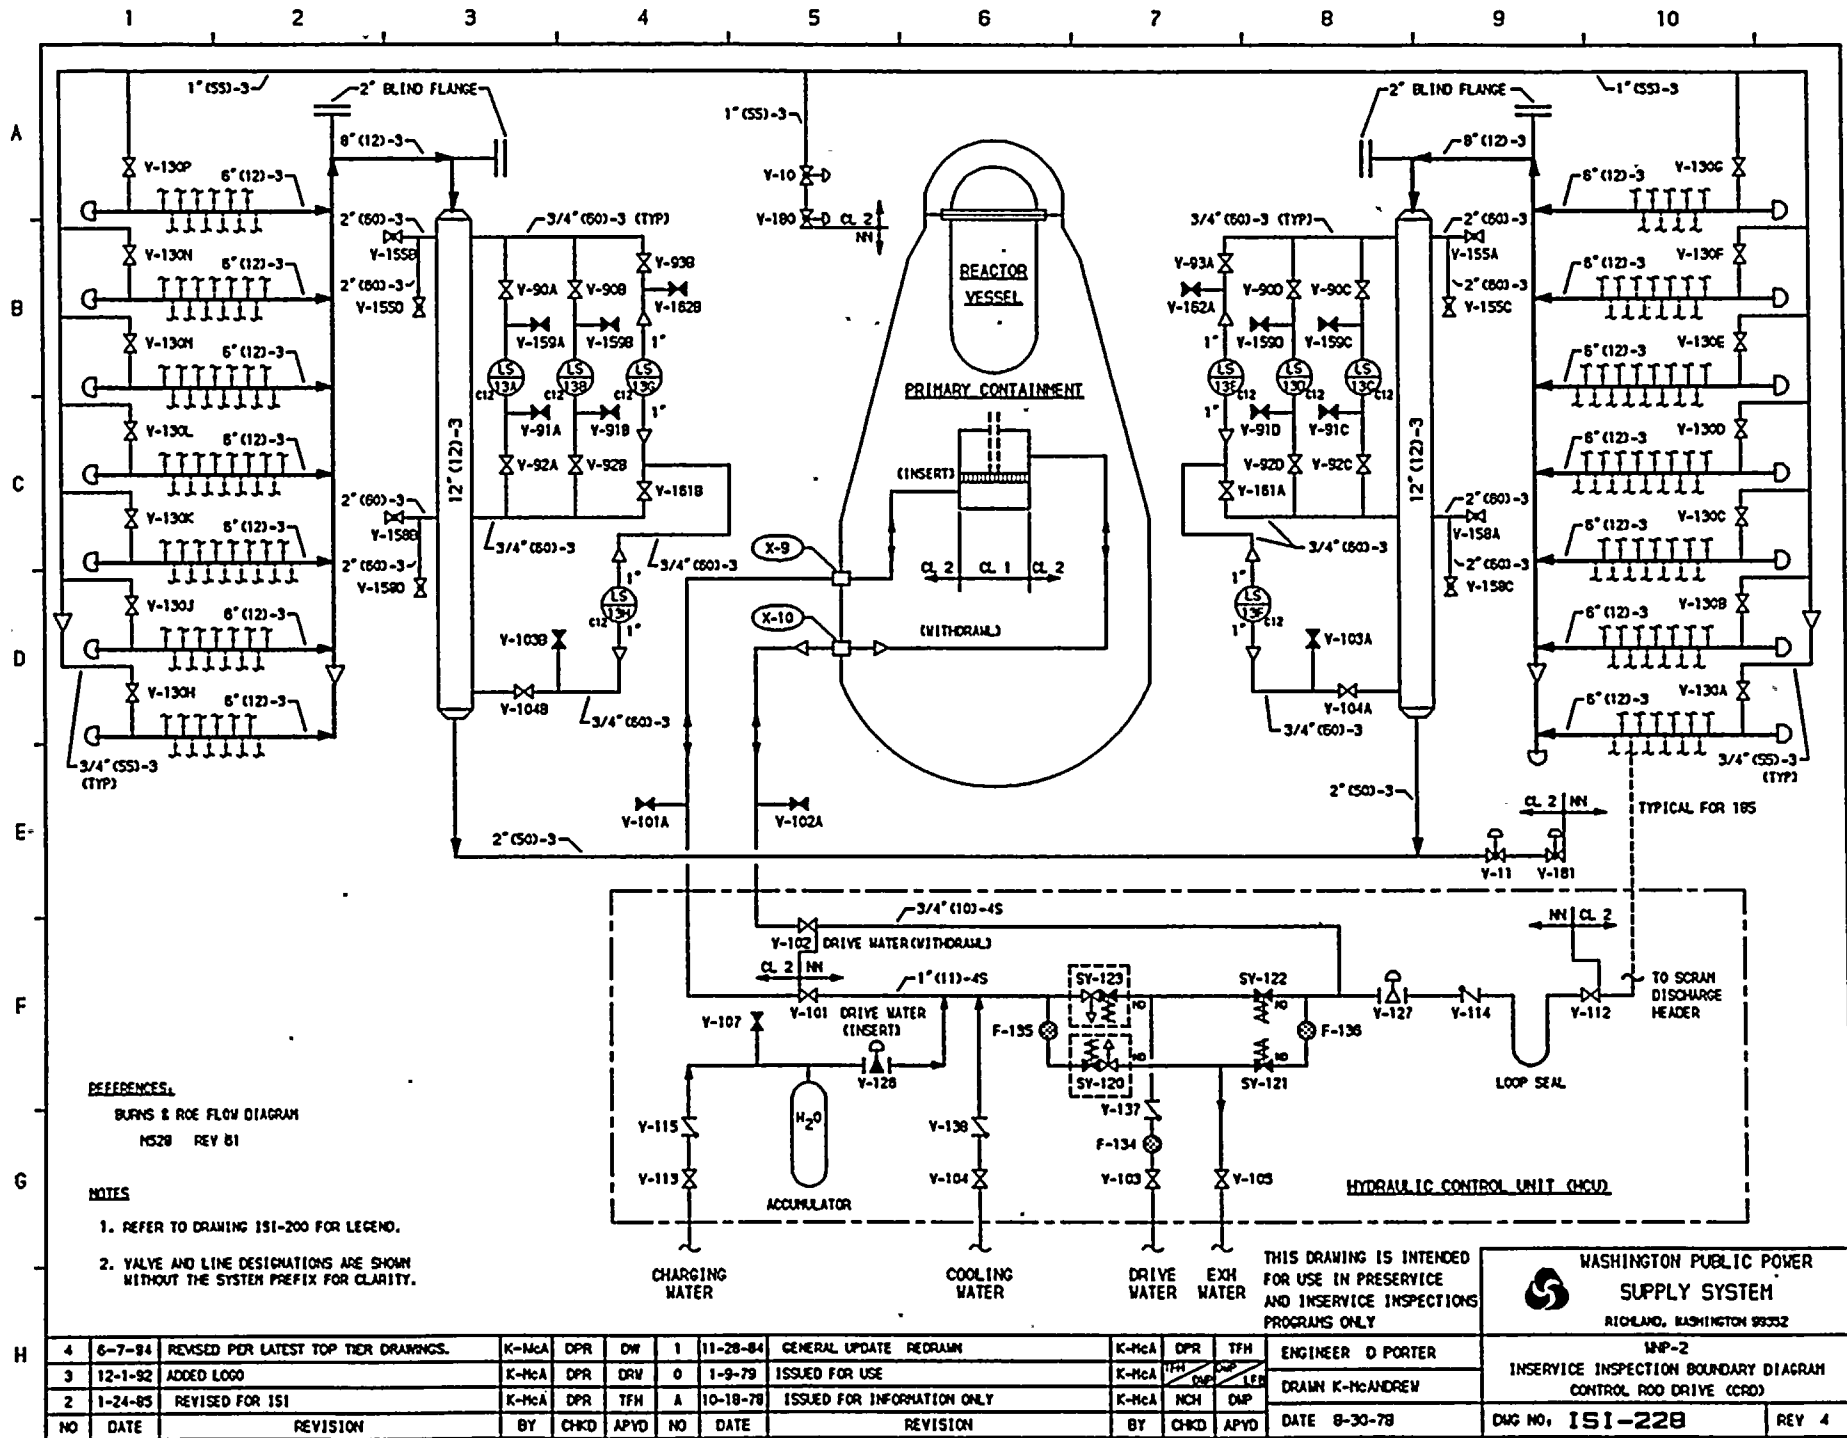

**REFERENCES:**  
 BURNS & ROE FLOW DIAGRAM  
 MS28 REV 81

**NOTES:**  
 1. REFER TO DRAWING ISI-200 FOR LEGEND.  
 2. VALVE AND LINE DESIGNATIONS ARE SHOWN WITHOUT THE SYSTEM PREFIX FOR CLARITY.

THIS DRAWING IS INTENDED FOR USE IN PRESERVICE AND INSERVICE INSPECTIONS PROGRAMS ONLY

**WASHINGTON PUBLIC POWER SUPPLY SYSTEM**  
 RICHMOND, WASHINGTON 98352

NO	DATE	REVISION	BY	CHKD	APVD	NO	DATE	REVISION	BY	CHKD	APVD	DATE	DWG NO.	REV
4	6-7-84	REVISED FOR LATEST TOP TIER DRAWINGS.	K-McA	DPR	DW	1	11-28-84	GENERAL UPDATE REDRAWN	K-McA	DPR	TFH	ENGINEER D PORTER	WPP-2 INSERVICE INSPECTION BOUNDARY DIAGRAM CONTROL ROD DRIVE (CRD)	REV 4
3	12-1-82	ADDED LOGO	K-McA	DPR	DRV	0	1-9-79	ISSUED FOR USE	K-McA	TFH	DWP	DRAWN K-McANDREW		
2	1-24-85	REVISED FOR ISI	K-McA	DPR	TFH	A	10-18-78	ISSUED FOR INFORMATION ONLY	K-McA	NCH	DIP	DATE 8-30-78		

9.3.3 Examination Schedule



WNP-2  
Interval 2  
CRD - Control Rod Drive

Table 9.1.4  
Washington Public Power Supply System  
ISI Program Plan and Schedule  
(Grouped by Drawing No. and Walkdown Order)

Revision 0

Pg	Identification No.	Description	Category	Item No.	Method	Per.	Out.	Reqmt.	Code	Out. Freq.	Rel. Req.	Remarks
Diagram No. CRD-201												
	CRD-PB-201(L)	LK PRES BNDRY	C-H	C7.30	VT-2	1	13	P	CE	3		
	CRD-PB-201(H)	HYDRO PRES BNDR	C-H	C7.40	VT-2	3	19	E	CE	10		
01	6CRD(12)A-1	CAP TO PIPE	C-F-2	C5.51	SUR			2	C	0		
					VOL			2	C	0		
	G306	RIGID	F-A	F1.20A	VT-3			4	C	0		
	6CRD(12)A-2	PIPE TO PIPE	C-F-2	C5.51	SUR			2	C	0		
					VOL			2	C	0		
	6CRD(12)A-3	PIPE TO ELL	C-F-2	C5.51	SUR	1	11	21	CE	10		
					VOL	1	11	21	CE	10		
	6CRD(12)A-4	ELL TO PIPE	C-F-2	C5.51	SUR	3	19	21	CE	10		
					VOL	3	19	21	CE	10		
	G500	RIGID	F-A	F1.20A	VT-3			4	C	0		
	6CRD(12)A-5	PIPE TO RED	C-F-2	C5.51	SUR			2	C	0		
					VOL			2	C	0		
	8CRD(12)A-1	RED TO TEE	C-F-2	C5.51	SUR			2	C	0		
					VOL			2	C	0		
	6CRD(12)A-6	CAP TO PIPE	C-F-2	C5.51	SUR			2	C	0		
					VOL			2	C	0		
	G613	RIGID	F-A	F1.20A	VT-3			4	C	0		
	6CRD(12)A-7	PIPE TO TEE	C-F-2	C5.51	SUR	3	19	21	CE	10		
					VOL	3	19	21	CE	10		

WNP-2  
Interval 2  
CRD - Control Rod Drive

Table 9.1.4  
Washington Public Power Supply System  
ISI Program Plan and Schedule  
(Grouped by Drawing No. and Walkdown Order)

Revision 0

Pg	Identification No.	Description	Category	Item No.	Method	Per.	Out.	Reqmt.	Code	Out. Freq.	Rel. Req.	Remarks
Diagram No. CRD-201												
01	8CRD(12)A-2	TEE TO PIPE	C-F-2	C5.51	SUR VOL			2 2	C C	0 0		
	8CRD(12)A-3	ELL TO ELL	C-F-2	C5.51	SUR VOL	3 3	19 19	21 21	CE CE	10 10		
	8CRD(12)A-4	ELL TO ELL	C-F-2	C5.51	SUR VOL			2 2	C C	0 0		
	8CRD(12)A-5	ELL TO TEE	C-F-2	C5.51	SUR VOL			2 2	C C	0 0		
	6CRD(12)A-8	CAP TO PIPE	C-F-2	C5.51	SUR VOL			2 2	C C	0 0		
	G319	RIGID	F-A	F1.20A	VT-3	1	10	41	CE	10		
	6CRD(12)A-9	PIPE TO PIPE	C-F-2	C5.51	SUR VOL			2 2	C C	0 0		
	6CRD(12)A-10	ELL TO TEE	C-F-2	C5.51	SUR VOL			2 2	C C	0 0		
	8CRD(12)A-6	TEE TO PIPE	C-F-2	C5.51	SUR VOL			2 2	C C	0 0		
	G501	RIGID	F-A	F1.20A	VT-3			4	C	0		
	8CRD(12)A-7	PIPE TO TEE	C-F-2	C5.51	SUR VOL			2 2	C C	0 0		
	6CRD(12)A-11	CAP TO PIPE	C-F-2	C5.51	SUR			2	C	0		

WNP-2  
Interval 2  
CRD - Control Rod Drive

Table 9.1.4  
Washington Public Power Supply System  
ISI Program Plan and Schedule  
(Grouped by Drawing No. and Walkdown Order)

Revision 0

Pg	Identification No.	Description	Category	Item No.	Method	Per.	Out.	Reqt.	Code	Out. Freq.	Rel. Req.	Remarks
Diagram No. CRD-201												
01	6CRD(12)A-11	CAP TO PIPE	C-F-2	C5.51	VOL			2	C	0		
	G323	RIGID	F-A	F1.20A	VT-3	1	10	41	CE	10		
	6CRD(12)A-12	PIPE TO ELL	C-F-2	C5.51	SUR	3	19	21	CE	10		
					VOL	3	19	21	CE	10		
..	6CRD(12)A-13	ELL TO TEE	C-F-2	C5.51	SUR			2	C	0		
					VOL			2	C	0		
	8CRD(12)A-17	ELL TO PIPE	C-F-2	C5.51	SUR			2	C	0		
					VOL			2	C	0		
02	8CRD(12)A-8	TEE T PIPE	C-F-2	C5.51	SUR			2	C	0		
					VOL			2	C	0		
	G513	RIGID	F-A	F1.20A	VT-3			41	C	0		
	8CRD(12)A-9	PIPE TO TEE	C-F-2	C5.51	SUR			2	C	0		
					VOL			2	C	0		
	6CRD(12)A-14	CAP TO PIPE	C-F-2	C5.51	SUR			2	C	0		
					VOL			2	C	0		
	G327	RIGID	F-A	F1.20A	VT-3			4	C	0		
	6CRD(12)A-15	PIPE TO ELL	C-F-2	C5.51	SUR			2	C	0		
					VOL			2	C	0		
	6CRD(12)A-16	ELL TO TEE	C-F-2	C5.51	SUR			2	C	0		
					VOL			2	C	0		
	8CRD(12)A-10	TEE TO PIPE	C-F-2	C5.51	SUR			2	C	0		

WNP-2  
Interval 2  
CRD - Control Rod Drive

Table 9.1.4  
Washington Public Power Supply System  
ISI Program Plan and Schedule  
(Grouped by Drawing No. and Walkdown Order)

Revision 0

Pg	Identification No.	Description	Category	Item No.	Method	Per.	Out.	Requmt.	Code	Out. Freq.	Rel. Req.	Remarks
Diagram No. CRD-201												
02	8CRD(12)A-10	TEE TO PIPE	C-F-2	C5.51	VOL			2	C	0		
	G503	RIGID	F-A	F1.20A	VT-3	1	10	41	CE	10		
	8CRD(12)A-11	PIPE TO TEE	C-F-2	C5.51	SUR			2	C	0		
					VOL			2	C	0		
	6CRD(12)A-17	CAP TO PIPE	C-F-2	C5.51	SUR			2	C	0		
					VOL			2	C	0		
	G333	RIGID	F-A	F1.20A	VT-3			4	C	0		
	6CRD(12)A-18	PIPE TO ELL	C-F-2	C5.51	SUR	1	11	21	CE	10		
					VOL	1	11	21	CE	10		
	6CRD(12)A-19	ELL TO PIPE	C-F-2	C5.51	SUR			2	C	0		
					VOL			2	C	0		
	8CRD(12)A-12	TEE TO PIPE	C-F-2	C5.51	SUR			2	C	0		
					VOL			2	C	0		
	8CRD(12)A-13	PIPE TO TEE	C-F-2	C5.51	SUR	3	19	21	CE	10		
					VOL	3	19	21	CE	10		
	6CRD(12)A-20	CAP TO PIPE	C-F-2	C5.51	SUR			2	C	0		
					VOL			2	C	0		
	G339	RIGID	F-A	F1.20A	VT-3			4	C	0		
	6CRD(12)A-21	PIPE TO ELL	C-F-2	C5.51	SUR			2	C	0		
					VOL			2	C	0		
	6CRD(12)A-22	ELL TO TEE	C-F-2	C5.51	SUR			2	C	0		



WNP-2  
Interval 2  
CRD - Control Rod Drive

Table 9.1.4  
Washington Public Power Supply System  
ISI Program Plan and Schedule  
(Grouped by Drawing No. and Walkdown Order)

Revision 0

Pg	Identification No.	Description	Category	Item No.	Method	Per.	Out.	Reqmt.	Code	Out. Freq.	Rel. Req.	Remarks
Diagram No. CRD-201												
02	6CRD(12)A-22	ELL TO TEE	C-F-2	C5.51	VOL			2	C	0		
	8CRD(12)A-14	TEE TO ELL	C-F-2	C5.51	SUR VOL			2 2	C C	0 0		
	8CRD(12)A-15	ELL TO PIPE	C-F-2	C5.51	SUR VOL	3 3	19 19	21 21	CE CE	10 10		
	8CRD(12)A-16	PIPE TO ELL	C-F-2	C5.51	SUR VOL			2 2	C C	0 0		
03	G504	RIGID	F-A	F1.20A	VT-3			4	C	0		
	8CRD(12)A-18	PIPE TO ELL	C-F-2	C5.51	SUR VOL			2 2	C C	0 0		
	8CRD(12)A-18/2FLG	PIPET TO EL	NA	NA	SUR			2	C	0		
	8CRD(12)A-19	ELL TO PIPE	C-F-2	C5.51	SUR VOL	3 3	19 19	21 21	CE CE	10 10		
	G519	RIGID	F-A	F1.20A	VT-3			41	C	0		
	G506	RIGID	F-A	F1.20A	VT-3	1	10	41	CE	10		
	8CRD(12)A-20	PIPE TO ELL	C-F-2	C5.51	SUR VOL			2 2	C C	0 0		
	8CRD(12)A-21	ELL TO PIPE	C-F-2	C5.51	SUR VOL			2 2	C C	0 0		
	8CRD(12)A-22	PIPE TO ELL	C-F-2	C5.51	SUR VOL			2 2	C C	0 0		

WNP-2  
Interval 2  
CRD - Control Rod Drive

Table 9.1.4  
Washington Public Power Supply System  
ISI Program Plan and Schedule  
(Grouped by Drawing No. and Walkdown Order)

Revision 0

Pg	Identification No.	Description	Category	Item No.	Method	Per.	Out.	Reqmt.	Code	Out. Freq.	Rel. Req.	Remarks
Diagram No. CRD-201												
03	8CRD(12)A-22/2FLG	PIPET TO EL	NA	NA	SUR	3	19	21	CE	10		
	12CRD(12)A-1	ELL TO PIPE	C-F-2	C5.51	SUR			2	C	0		
					VOL			2	C	0		
	12CRD(12)A-2	PIPE TO PIPE	C-F-2	C5.51	SUR			2	C	0		
					VOL			2	C	0		
	12CRD(12)A-3	PIPE TO CAP	C-F-2	C5.51	SUR	3	19	21	CE	10		
					VOL	3	19	21	CE	10		
	SDV-A(CS)	SDV BASE	F-A	F1.40A	VT-3	1	11	41	CE	10		

WNP-2  
Interval 2  
CRD - Control Rod Drive

Table 9.1.4  
Washington Public Power Supply System  
ISI Program Plan and Schedule  
(Grouped by Drawing No. and Walkdown Order)

Revision 0

Pg	Identification No.	Description	Category	Item No.	Method	Per.	Out.	Requmt.	Code	Out. Freq.	Rel. Req.	Remarks
Diagram No. CRD-202												
	CRD-PB-202(L)	LK PRES BNDRY	C-H	C7.30	VT-2	1	13	P	CE	3		
	CRD-PB-202(H)	HYDRO PRES BNDR	C-H	C7.40	VT-2	3	19	E	CE	10		
01	8CRD(12)B-1	CAP TO PIPE	C-F-2	C5.51	SUR VOL			2 2	C C	0 0		
	6CRD(12)B-1	CAP TO PIPE	C-F-2	C5.51	SUR VOL			2 2	C C	0 0		
	G601	RIGID	F-A	F1.20A	VT-3			4	C	0		
	6CRD(12)B-2	PIPE TO ELL	C-F-2	C5.51	SUR VOL			2 2	C C	0 0		
	6CRD(12)B-3	ELL TO PIPE	C-F-2	C5.51	SUR VOL			2 2	C C	0 0		
	8CRD(12)B-2	TEE TO PIPE	C-F-2	C5.51	SUR VOL			2 2	C C	0 0		
	G603	RIGID	F-A	F1.20A	VT-3			4	C	0		
	8CRD(12)B-3	PIPE TO TEE	C-F-2	C5.51	SUR VOL			2 2	C C	0 0		
	6CRD(12)B-4	CAP TO PIPE	C-F-2	C5.51	SUR VOL			2 2	C C	0 0		
	G432	RIGID	F-A	F1.20A	VT-3			4	C	0		
	6CRD(12)B-5	PIPE TO ELL	C-F-2	C5.51	SUR VOL			2 2	C C	0 0		

WNP-2  
Interval 2  
CRD - Control Rod Drive

Table 9.1.4  
Washington Public Power Supply System  
ISI Program Plan and Schedule  
(Grouped by Drawing No. and Walkdown Order)

Revision 0

Pg	Identification No.	Description	Category	Item No.	Method	Per.	Out.	Reqmt.	Code	Out. Freq.	Rel. Req.	Remarks
Diagram No. CRD-202												
01	6CRD(12)B-6	ELL TO PIPE	C-F-2	C5.51	SUR VOL			2 2	C C	0 0		
	8CRD(12)B-4	TEE TO PIPE	C-F-2	C5.51	SUR VOL			2 2	C C	0 0		
	8CRD(12)B-5	PIPE TO TEE	C-F-2	C5.51	SUR VOL			2 2	C C	0 0		
	6CRD(12)B-7	CAP TO PIPE	C-F-2	C5.51	SUR VOL			2 2	C C	0 0		
	G426	RIGID	F-A	F1.20A	VT-3	1	10	41	CE	10		
	6CRD(12)B-8	PIPE TO ELL	C-F-2	C5.51	SUR VOL			2 2	C C	0 0		
	6CRD(12)B-9	ELL TO PIPE	C-F-2	C5.51	SUR VOL			2 2	C C	0 0		
	8CRD(12)B-6	TEE TO PIPE	C-F-2	C5.51	SUR VOL			2 2	C C	0 0		
	G604	RIGID	F-A	F1.20A	VT-3	1	10	41	CE	10		
	G605	RIGID	F-A	F1.20A	VT-3	1	10	41	CE	10		
	6CRD(12)B-12	ELL TO PIPE	C-F-2	C5.51	SUR VOL			2 2	C C	0 0		
02	8CRD(12)B-7	PIPE TO TEE	C-F-2	C5.51	SUR VOL			2 2	C C	0 0		

WNP-2  
Interval 2  
CRD - Control Rod Drive

Table 9.1.4  
Washington Public Power Supply System  
ISI Program Plan and Schedule  
(Grouped by Drawing No. and Walkdown Order)

Revision 0

Pg	Identification No.	Description	Category	Item No.	Method	Per.	Out.	Reqmt.	Code	Out. Freq.	Rel. Req.	Remarks
Diagram No. CRD-202												
02	6CRD(12)B-10	CAP TO PIPE	C-F-2	C5.51	SUR		2		C	0		
					VOL		2		C	0		
	G422	RIGID	F-A	F1.20A	VT-3		4		C	0		
	6CRD(12)B-11	PIPE TO ELL	C-F-2	C5.51	SUR		2		C	0		
					VOL		2		C	0		
	6CRD(12)B-13	PIPE TO TEE	C-F-2	C5.51	SUR		2		C	0		
					VOL		2		C	0		
	8CRD(12)B-8	TEE TO PIPE	C-F-2	C5.51	SUR		2		C	0		
					VOL		2		C	0		
	G606	RIGID	F-A	F1.20A	VT-3		4		C	0		
	8CRD(12)B-9	PIPE TO TEE	C-F-2	C5.51	SUR		2		C	0		
					VOL		2		C	0		
	6CRD(12)B-14	CAP TO PIPE	C-F-2	C5.51	SUR		2		C	0		
					VOL		2		C	0		
	G418	RIGID	F-A	F1.20A	VT-3		4		C	0		
	6CRD(12)B-15	PIPE TO ELL	C-F-2	C5.51	SUR		2		C	0		
					VOL		2		C	0		
	6CRD(12)B-16	ELL TO PIPE	C-F-2	C5.51	SUR		2		C	0		
					VOL		2		C	0		
	6CRD(12)B-17	PIPE TO TEE	C-F-2	C5.51	SUR		2		C	0		
					VOL		2		C	0		

WNP-2  
Interval 2  
CRD - Control Rod Drive

Table 9.1.4  
Washington Public Power Supply System  
ISI Program Plan and Schedule  
(Grouped by Drawing No. and Walkdown Order)

Revision 0

Pg	Identification No.	Description	Category	Item No.	Method	Per.	Out.	Reqt.	Code	Out. Freq.	Rel. Req.	Remarks
Diagram No. CRD-202												
02	8CRD(12)B-10	TEE TO PIPE	C-F-2	C5.51	SUR		2		C	0		
					VOL		2		C	0		
	8CRD(12)B-11	PIPE TO TEE	C-F-2	C5.51	SUR		2		C	0		
					VOL		2		C	0		
	6CRD(12)B-18	CAP TO PIPE	C-F-2	C5.51	SUR		2		C	0		
					VOL		2		C	0		
	G600	RIGID	F-A	F1.20A	VT-3		4		C	0		
	6CRD(12)B-19	PIPE TO ELL	C-F-2	C5.51	SUR		2		C	0		
					VOL		2		C	0		
	6CRD(12)B-20	ELL TO TEE	C-F-2	C5.51	SUR		2		C	0		
					VOL		2		C	0		
	8CRD(12)B-12	TEE TO ELL	C-F-2	C5.51	SUR		2		C	0		
					VOL		2		C	0		
03	8CRD(12)B-13	ELL TO PIPE	C-F-2	C5.51	SUR		2		C	0		
					VOL		2		C	0		
	8CRD(12)B-14	PIPE TO ELL	C-F-2	C5.51	SUR		2		C	0		
					VOL		2		C	0		
	8CRD(12)B-15	ELL TO PIPE	C-F-2	C5.51	SUR		2		C	0		
					VOL		2		C	0		
	G607	RIGID	F-A	F1.20A	VT-3		4		C	0		
	8CRD(12)B-16	PIPE TO TEE	C-F-2	C5.51	SUR		2		C	0		

WNP-2  
Interval 2  
CRD - Control Rod Drive

Table 9.1.4  
Washington Public Power Supply System  
ISI Program Plan and Schedule  
(Grouped by Drawing No. and Walkdown Order)

Revision 0

Pg	Identification No.	Description	Category	Item No.	Method	Per.	Out.	Reqmt.	Code	Out. Freq.	Rel. Req.	Remarks
Diagram No. CRD-202												
03	8CRD(12)B-16	PIPE TO TEE	C-F-2	C5.51	VOL		2		C	0		
	6CRD(12)B-21	CAP TO PIPE	C-F-2	C5.51	SUR		2		C	0		
					VOL		2		C	0		
	6CRD(12)B-22	PIPE TO ELL	C-F-2	C5.51	SUR		2		C	0		
					VOL		2		C	0		
	6CRD(12)B-23	ELL TO PIPE	C-F-2	C5.51	SUR		2		C	0		
					VOL		2		C	0		
	6CRD(12)B-24	PIPE TO TEE	C-F-2	C5.51	SUR		2		C	0		
					VOL		2		C	0		
	8CRD(12)B-17	TEE TO PIPE	C-F-2	C5.51	SUR		2		C	0		
					VOL		2		C	0		
	8CRD(12)B-18	PIPE TO ELL	C-F-2	C5.51	SUR		2		C	0		
					VOL		2		C	0		
	8CRD(12)B-18/2FLG	PIPET TO EL	NA	NA	SUR		2		C	0		
	8CRD(12)B-19	ELL TO PIPE	C-F-2	C5.51	SUR		2		C	0		
					VOL		2		C	0		
	G608	RIGID	F-A	F1.20A	VT-3		4		C	0		
	8CRD(12)B-20	PIPE TO ELL	C-F-2	C5.51	SUR		2		C	0		
					VOL		2		C	0		
	8CRD(12)B-21	ELL TO PIPE	C-F-2	C5.51	SUR		2		C	0		
					VOL		2		C	0		

WNP-2  
Interval 2  
CRD - Control Rod Drive


Table 9.1.4  
Washington Public Power Supply System  
ISI Program Plan and Schedule  
(Grouped by Drawing No. and Walkdown Order)

Revision 0

Pg	Identification No.	Description	Category	Item No.	Method	Per.	Out.	Requst.	Code	Out. Freq.	Rel. Req.	Remarks
Diagram No. CRD-202												
03	8CRD(12)B-22	PIPE TO ELL	C-F-2	C5.51	SUR		2		C	0		
					VOL		2		C	0		
	8CRD(12)B-22/2FLG	PIPET TO EL	NA	NA	SUR		2		C	0		
	12CRD(12)B-1	ELL TO PIPE	C-F-2	C5.51	SUR		2		C	0		
					VOL		2		C	0		
	12CRD(12)B-2	PIPE TO PIPE	C-F-2	C5.51	SUR		2		C	0		
					VOL		2		C	0		
	12CRD(12)B-3	PIPE TO CAP	C-F-2	C5.51	SUR		2		C	0		
					VOL		2		C	0		
	SDV-B(CS)	SDV BASE	F-A	F1.40A	VT-3	1	11	41	CE	10		




9.3.4 Weld and Component Diagrams

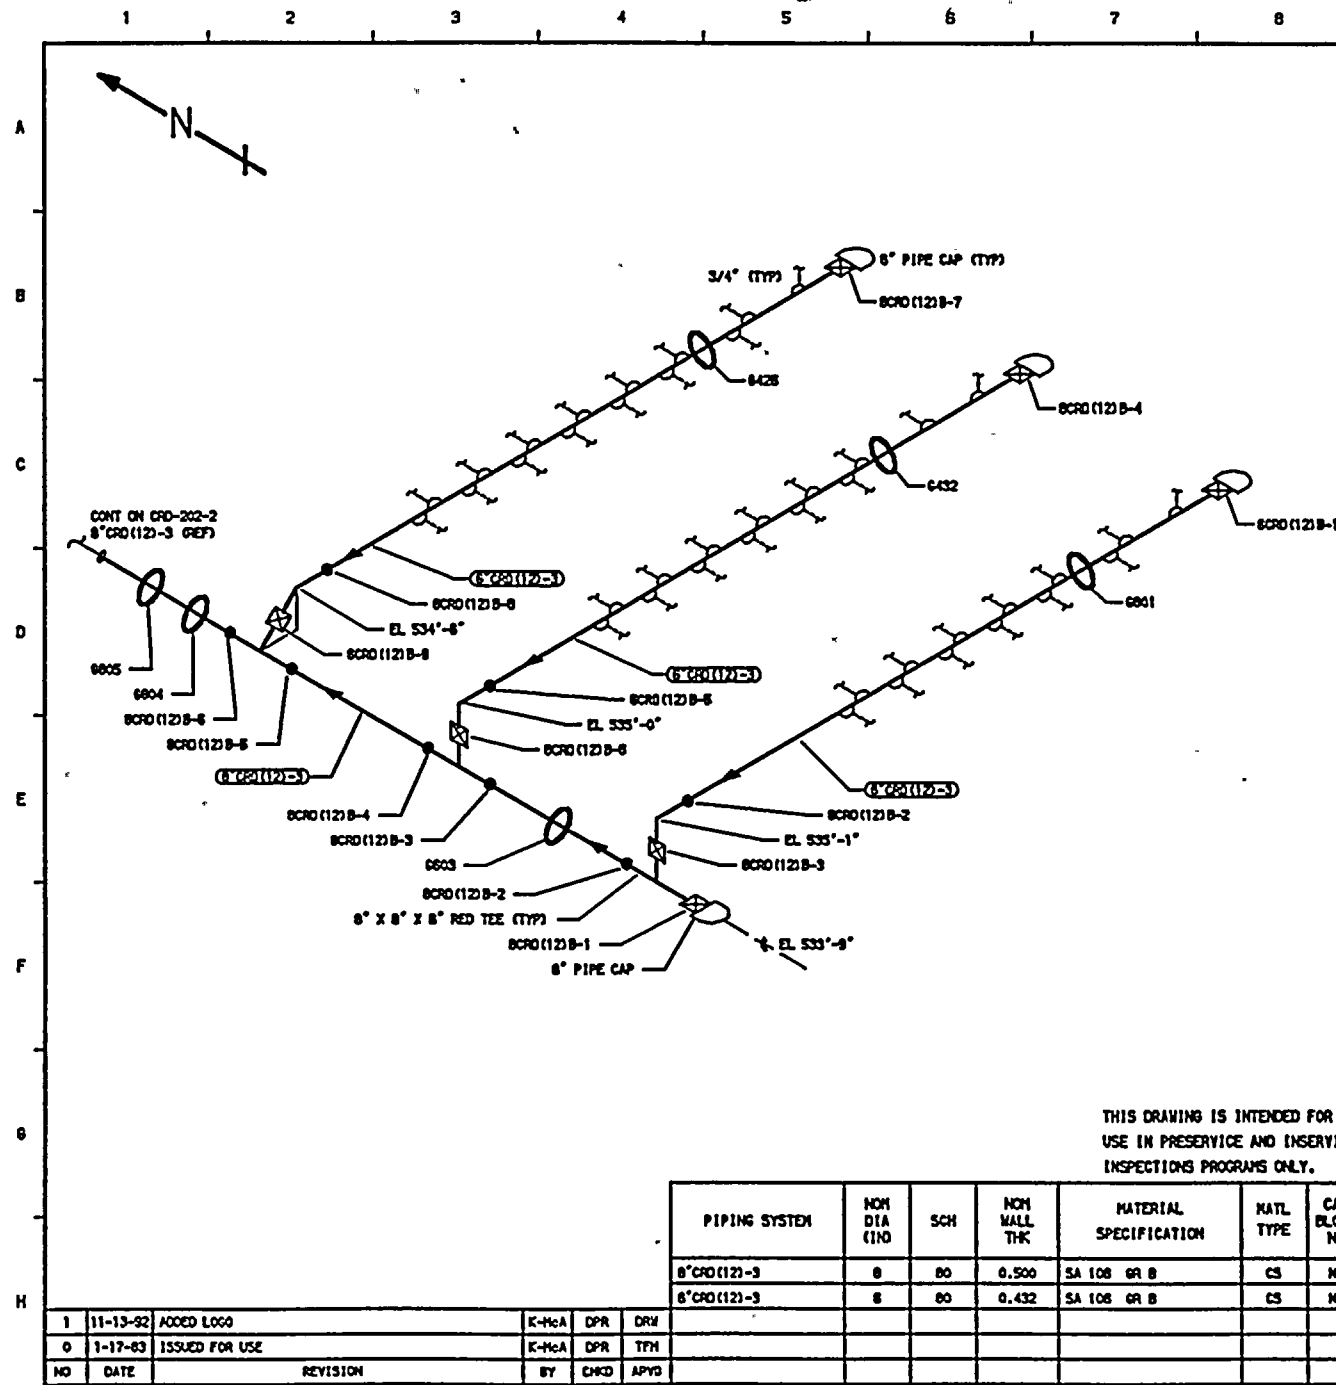

- NOTES:**
1. THIS DRAWING IDENTIFIES PIPING AND COMPONENTS SUBJECT TO A VISUAL EXAM FOR EVIDENCE OF LEAKAGE DURING SYSTEM HYDRO OR OPERABILITY TESTS. TESTS ARE TO BE CONDUCTED PER THE REQUIREMENTS OF ASME SECTION XI, PARAGRAPH IWA-5000.
  2. FOR BRANCH PIPING 4" NOM. OR LESS CONNECTION SHOWN IN DASHED LINES) EXTEND VISUAL LEAKAGE EXAM THROUGH THE OUTERMOST NORMALLY CLOSED NUCLEAR CLASS VALVE, OR UNTIL TRANSITION TO INSTRUMENT TUBING, UNLESS OTHERWISE NOTED.

- REFERENCES:**
- ISI - 228
- GENERAL ELECTRIC DWGS
- SK-X01-750-02 SH 28 REV 0
  - SK-X01-750-02 SH 42 REV 0
  - SK-X01-750-02 SH 41 REV 0
  - SK-X01-750-02 SH 40 REV 0

QUALITY CLASS, 1	ASME CODE CLASS, 2
ENGR. K-McANDREW	DATE: 12-28-62


  
**WASHINGTON PUBLIC POWER**  
**SUPPLY SYSTEM**  
 RICHLAND, WASHINGTON 99352


THIS DRAWING IS INTENDED FOR  
USE IN PRESERVICE AND INSERVICE  
INSPECTIONS PROGRAMS ONLY.

PIPING SYSTEM	NOM DIA (IN)	SCH	NOM WALL THK	MATERIAL SPECIFICATION	MATL TYPE	CAL BLOCK NO
8"CRD(112)-3	8	80	0.500	SA 106 GR B	CS	NA
6"CRD(112)-3	6	80	0.432	SA 106 GR B	CS	NA

<b>WPP-2</b> <b>WELD &amp; COMPONENT</b> <b>IDENTIFICATION DIAGRAM</b>
<b>TITLE:</b> CONTROL ROD DRIVE SYSTEM SCRAM DISCHARGE HEADER B
<b>DWG NO:</b> CRD-202-1 <span style="float: right;"><b>REV 1</b></span>

NO	DATE	REVISION	BY	CHKD	APVD
1	11-13-62	ADDED LOGO	K-McA	DPR	DRM
0	1-17-63	ISSUED FOR USE	K-McA	DPR	TFH



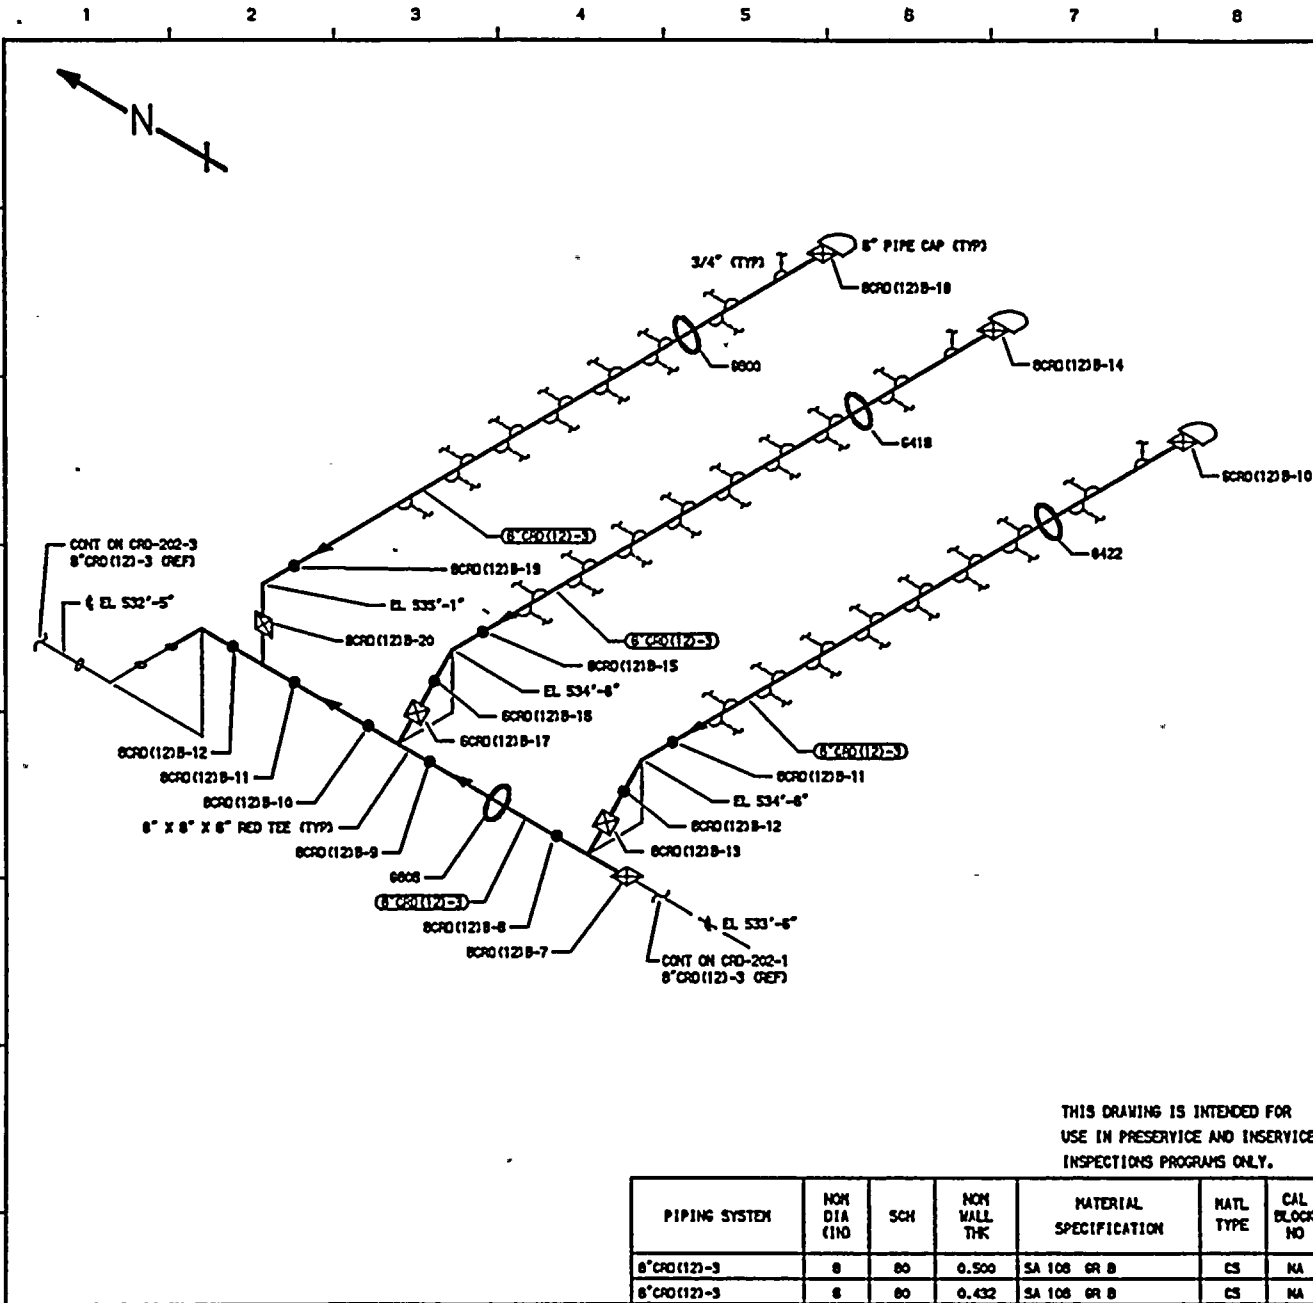

- NOTES:**
1. THIS DRAWING IDENTIFIES PIPING AND COMPONENTS SUBJECT TO A VISUAL EXAM FOR EVIDENCE OF LEAKAGE DURING SYSTEM HYDRO OR OPERABILITY TESTS. TESTS ARE TO BE CONDUCTED PER THE REQUIREMENTS OF ASME SECTION XI, PARAGRAPH IWA-5000.
  2. FOR BRANCH PIPING 4" NOM. OR LESS CONNECTION SHOWN IN DASHED LINES EXTEND VISUAL LEAKAGE EXAM THROUGH THE OUTERMOST NORMALLY CLOSED NUCLEAR CLASS VALVE, OR UNTIL TRANSITION TO INSTRUMENT TUBING, UNLESS OTHERWISE NOTED.

- REFERENCES:**
- ISI - 228
  - GENERAL ELECTRIC DWGS
    - SK-X01-75C-02 SH 27 REV 0
    - SK-X01-75C-02 SH 39 REV 0
    - SK-X01-75C-02 SH 36 REV 0
    - SK-X01-75C-02 SH 37 REV 0

QUALITY CLASS, 1 ASME CODE CLASS, 2  
 ENGR: K-McANDREW DRAWN: K-McA DATE: 12-28-82

WASHINGTON PUBLIC POWER  
 SUPPLY SYSTEM  
 RICHLAND, WASHINGTON 99352

THIS DRAWING IS INTENDED FOR  
 USE IN PRESERVICE AND INSERVICE  
 INSPECTIONS PROGRAMS ONLY.


PIPING SYSTEM	NOM DIA (INO)	SCH	NOM WALL THK	MATERIAL SPECIFICATION	MATL TYPE	CAL BLOCK NO
8" CRO (12) B-3	8	80	0.500	SA 106 GR B	CS	NA
8" CRO (12) B-3	8	80	0.432	SA 106 GR B	CS	NA

WPP-2  
 WELD & COMPONENT  
 IDENTIFICATION DIAGRAM

TITLE: CONTROL ROD DRIVE SYSTEM  
 SCRAM DISCHARGE HEADER B

NO	DATE	REVISION	BY	CHKD	APVD
1	11-13-82	ADDED LOGO	K-McA	DPR	DRW
0	1-17-83	ISSUED FOR USE	K-McA	DPR	TFH

DWG NO. CRO-202-2 REV 1

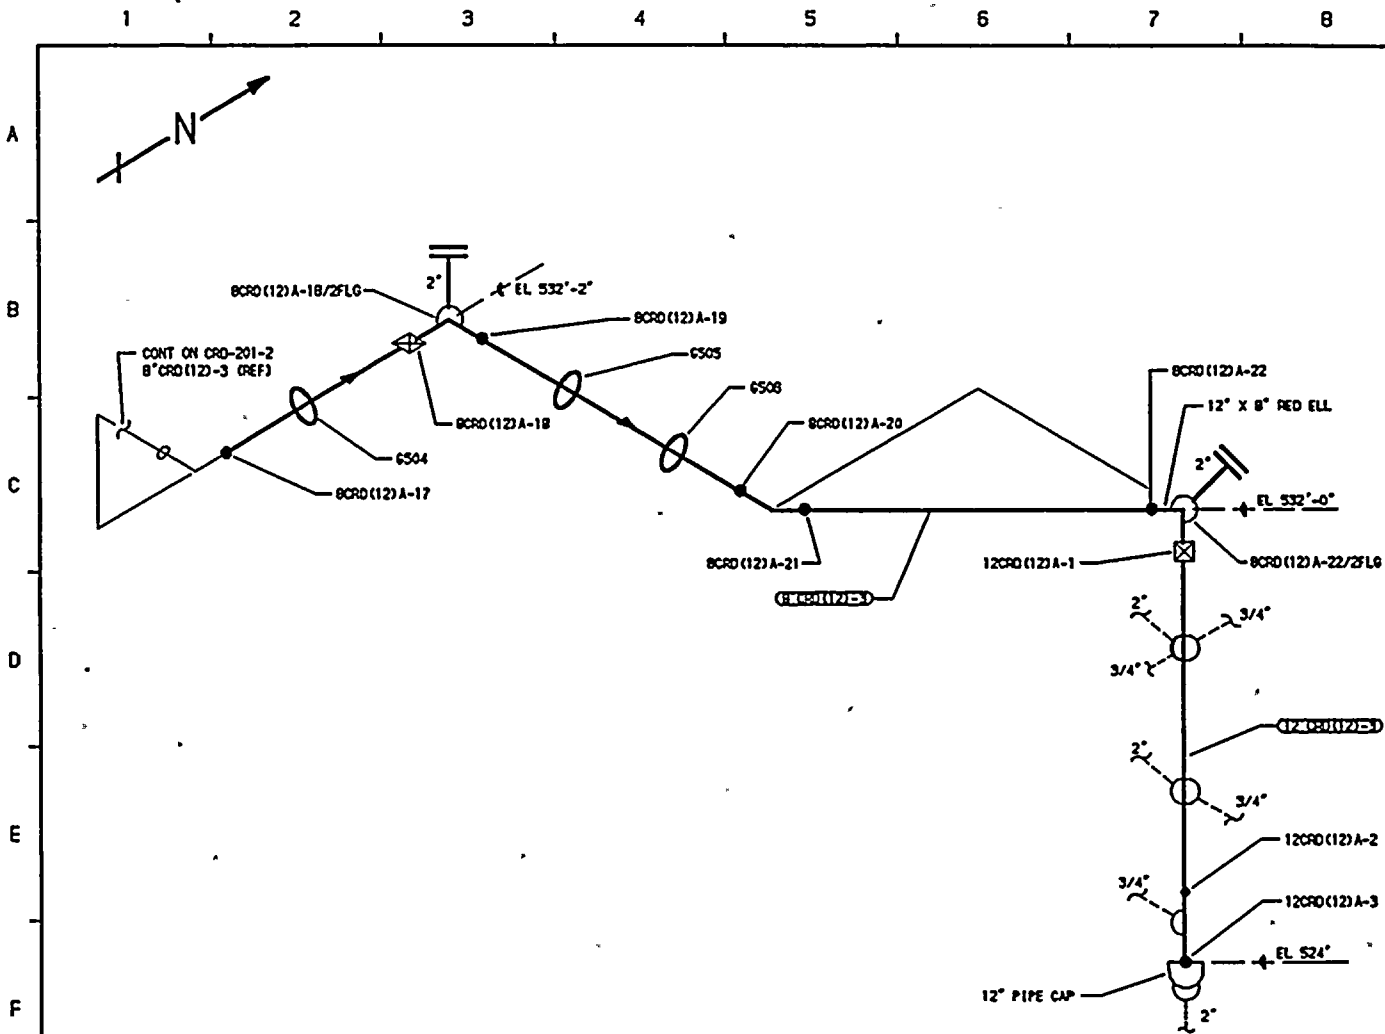

**NOTES.**

1. THIS DRAWING IDENTIFIES PIPING AND COMPONENTS SUBJECT TO A VISUAL EXAM FOR EVIDENCE OF LEAKAGE DURING SYSTEM HYDRO OR OPERABILITY TESTS. TESTS ARE TO BE CONDUCTED PER THE REQUIREMENTS OF ASME SECTION XI, PARAGRAPH 11A-5000.
2. FOR BRANCH PIPING 4" NOM. OR LESS (CONNECTION SHOWN IN DASHED LINES) EXTEND VISUAL LEAKAGE EXAM THROUGH THE OUTERMOST NORMALLY CLOSED NUCLEAR CLASS VALVE, OR UNTIL TRANSITION TO INSTRUMENT TUBING, UNLESS OTHERWISE NOTED.
3. PIPE FLANGES WERE INSTALLED ON 12" CRD LINE PER SECTION XI PLAN NO. 2-C878. WELDS WERE NOT STAMPED AS THERE WASN'T ROOM.

**REFERENCES.**

- 151 - 229  
 GENERAL ELECTRIC DWGS  
 SK-X01-75C-02 SH 23 REV 0  
 SK-X01-75C-02 SH 24 REV 0  
 BURNS AND ROE DWGS  
 CRD-1000-1 REV 4  
 CRD-1002-1 REV 3

QUALITY CLASS: 1	ASME CODE CLASS: 2
ENGR. K-McANDREW	DRAWN. K-McA DATE: 12-26-82



WASHINGTON PUBLIC POWER  
 SUPPLY SYSTEM  
 RICHLAND, WASHINGTON 99352


THIS DRAWING IS INTENDED FOR  
 USE IN PRESERVICE AND INSERVICE  
 INSPECTIONS PROGRAMS ONLY.

PIPING SYSTEM	NOM DIA (IN)	SCH	NOM WALL THK	MATERIAL SPECIFICATION	MATL TYPE	CAL BLOCK NO
8" CRD (12)-3	8	80	0.500	SA 106 GR B	CS	NA
12" CRD (12)-3	12	80	0.688	SA 106 GR B	CS	NA

MWP-2 WELD & COMPONENT IDENTIFICATION DIAGRAM	
TITLE: CONTROL ROD DRIVE SYSTEM SCRAM DISCHARGE HEADER A	
DWG NO. CRD-201-3	REV 2

NO	DATE	REVISION	BY	CHKD	APVD
2	9-18-83	ADDED TWO NEW WELDS & WELD NUMBERS FOR PIPELET FLANGES ZONE B-3, C-7 & NOTE 3.	K-McA	DPR	DRW
1	11-13-82	ADDED LOGO	K-McA	DPR	DRW
0	1-17-83	ISSUED FOR USE	K-McA	DPR	TFH



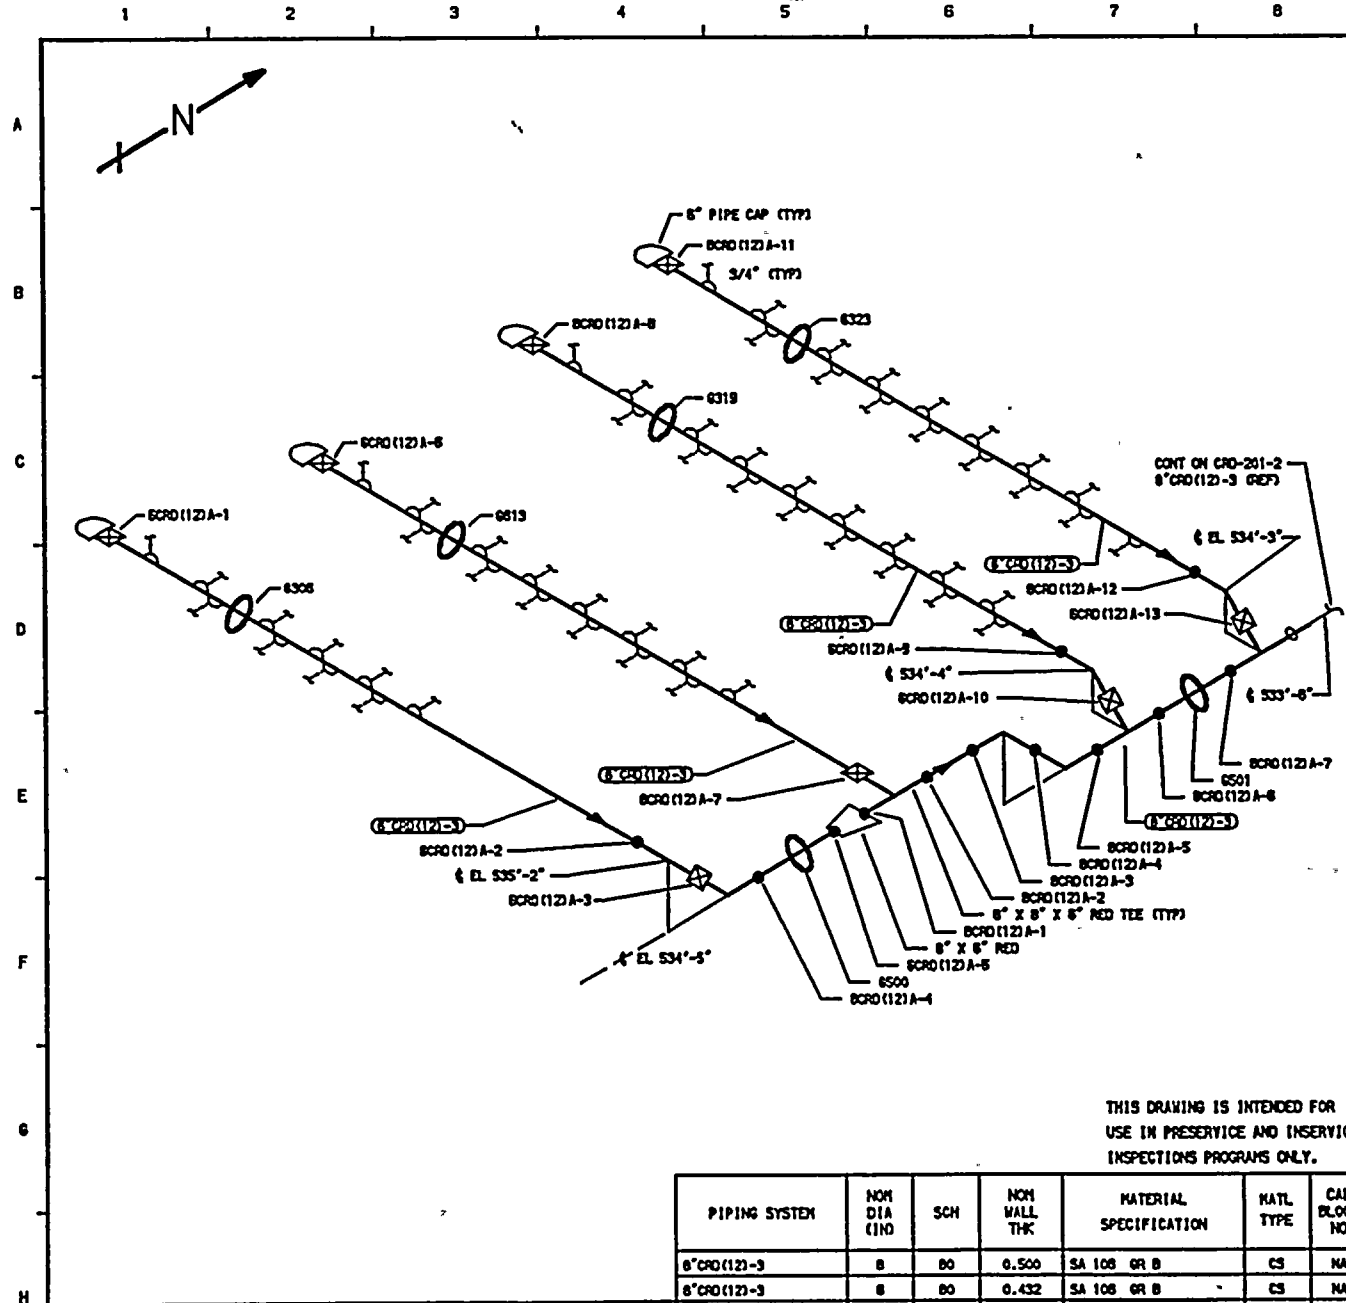

- NOTES:**
1. THIS DRAWING IDENTIFIES PIPING AND COMPONENTS SUBJECT TO A VISUAL EXAM FOR EVIDENCE OF LEAKAGE DURING SYSTEM HYDRO OR OPERABILITY TESTS. TESTS ARE TO BE CONDUCTED PER THE REQUIREMENTS OF ASME SECTION XI, PARAGRAPH IWA-5000.
  2. FOR BRANCH PIPING 4" NOM. OR LESS CONNECTION SHOWN IN DASHED LINES EXTEND VISUAL LEAKAGE EXAM THROUGH THE OUTERMOST NORMALLY CLOSED NUCLEAR CLASS VALVE, OR UNTIL TRANSITION TO INSTRUMENT TUBING, UNLESS OTHERWISE NOTED.

- REFERENCES:**
- 151 - 228
  - GENERAL ELECTRIC DWGS
  - SK-X01-75C-02 SH 22 REY 0
  - SK-X01-75C-02 SH 28 REY 0
  - SK-X01-75C-02 SH 30 REY 0
  - SK-X01-75C-02 SH 31 REY 0
  - SK-X01-75C-02 SH 32 REY 0

QUALITY CLASS: 1 ASME CODE CLASS: 2  
 ENGR: K-McANDREWM DRAWN: K-McA DATE: 12-23-82

WASHINGTON PUBLIC POWER  
 SUPPLY SYSTEM  
 RIO-LAND, WASHINGTON 98352

WNP-2  
 WELD & COMPONENT  
 IDENTIFICATION DIAGRAM


TITLE: CONTROL ROD DRIVE SYSTEM  
 SCRAM DISCHARGE HEADER A

DWG NO: CRD-201-1 REV 1

THIS DRAWING IS INTENDED FOR  
 USE IN PRESERVICE AND INSERVICE  
 INSPECTIONS PROGRAMS ONLY.

PIPING SYSTEM	NOM DIA (IN)	SCH	NOM WALL THK	MATERIAL SPECIFICATION	MATL TYPE	CAL BLOCK NO
8"CRD(12)-3	8	80	0.500	SA 108 GR B	CS	NA
8"CRD(12)-3	8	80	0.432	SA 108 GR B	CS	NA

NO	DATE	REVISION	BY	CHKD	APVD
1	11-13-82	ADDED LOGO	K-McA	DPR	DRM
0	1-17-83	ISSUED FOR USE	K-McA	DPR	TPH

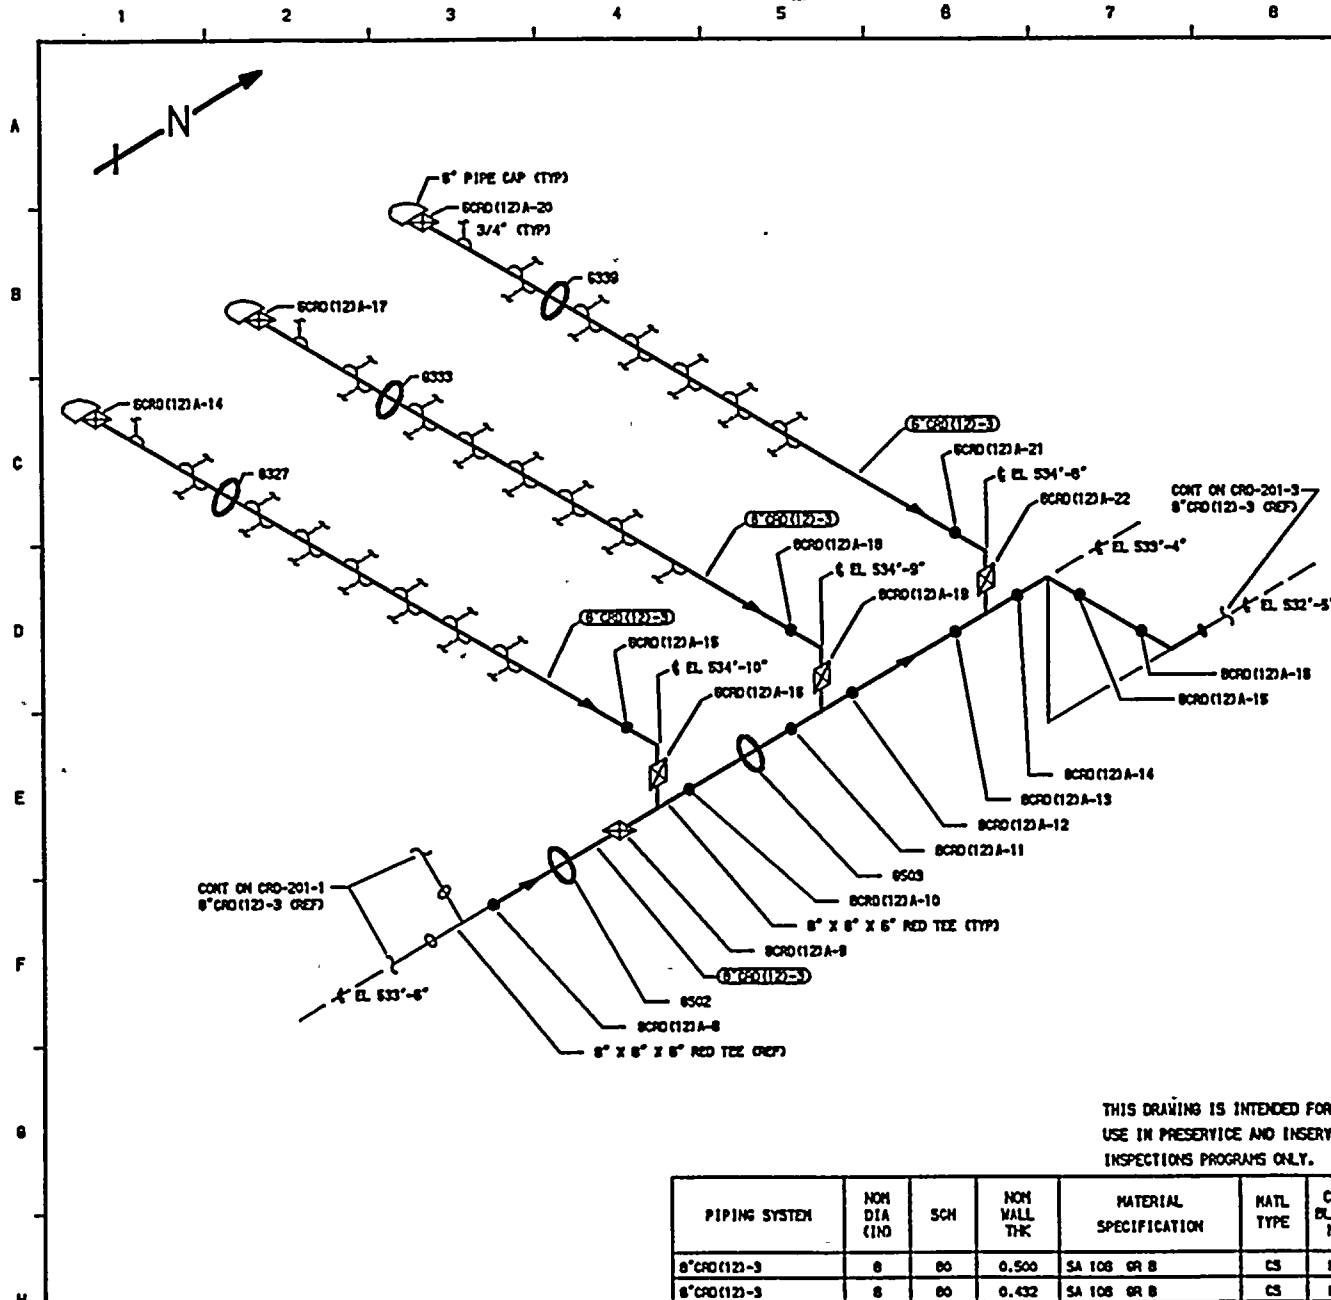

- NOTES:**
1. THIS DRAWING IDENTIFIES PIPING AND COMPONENTS SUBJECT TO A VISUAL EXAM FOR EVIDENCE OF LEAKAGE DURING SYSTEM HYDRO OR OPERABILITY TESTS. TESTS ARE TO BE CONDUCTED PER THE REQUIREMENTS OF ASME SECTION XI, PARAGRAPH IWA-5000.
  2. FOR BRANCH PIPING 4" NOM. OR LESS CONNECTION SHOWN IN DASHED LINES EXTEND VISUAL LEAKAGE EXAM THROUGH THE OUTERMOST NORMALLY CLOSED NUCLEAR CLASS VALVE, OR UNTIL TRANSITION TO INSTRUMENT TUBING, UNLESS OTHERWISE NOTED.

- REFERENCES:**
- ISI - 228
- GENERAL ELECTRIC DWS
- SK-X01-75C-02 SH 22 REV 0
  - SK-X01-75C-02 SH 23 REV 0
  - SK-X01-75C-02 SH 33 REV 0
  - SK-X01-75C-02 SH 34 REV 0
  - SK-X01-75C-02 SH 35 REV 0

QUALITY CLASS: 1 ASME CODE CLASS: 2  
 ENGR. K-McANDREEM DRAWN: K-McA DATE: 12-23-82



WASHINGTON PUBLIC POWER  
 SUPPLY SYSTEM  
 RIGLAND, WASHINGTON 98302

THIS DRAWING IS INTENDED FOR  
 USE IN PRESERVICE AND INSERVICE  
 INSPECTIONS PROGRAMS ONLY.

PIPING SYSTEM	NOM DIA (IN)	SCH	NOM WALL THK	MATERIAL SPECIFICATION	MATL TYPE	CAL BLOCK NO
8"CRD(12)-3	8	80	0.500	SA 108 GR B	CS	NA
8"CRD(12)-3	8	80	0.432	SA 108 GR B	CS	NA


NO	DATE	REVISION	BY	CHKD	APVD
1	11-13-82	ADDED LOGO	K-McA	DPR	DRM
0	1-17-83	ISSUED FOR USE	K-McA	DPR	TTH

WMP-2  
 WELD & COMPONENT  
 IDENTIFICATION DIAGRAM

TITLE:  
 CONTROL ROD DRIVE SYSTEM  
 SCRAM DISCHARGE HEADER A

DWG NO: CRD-201-2 REV 1



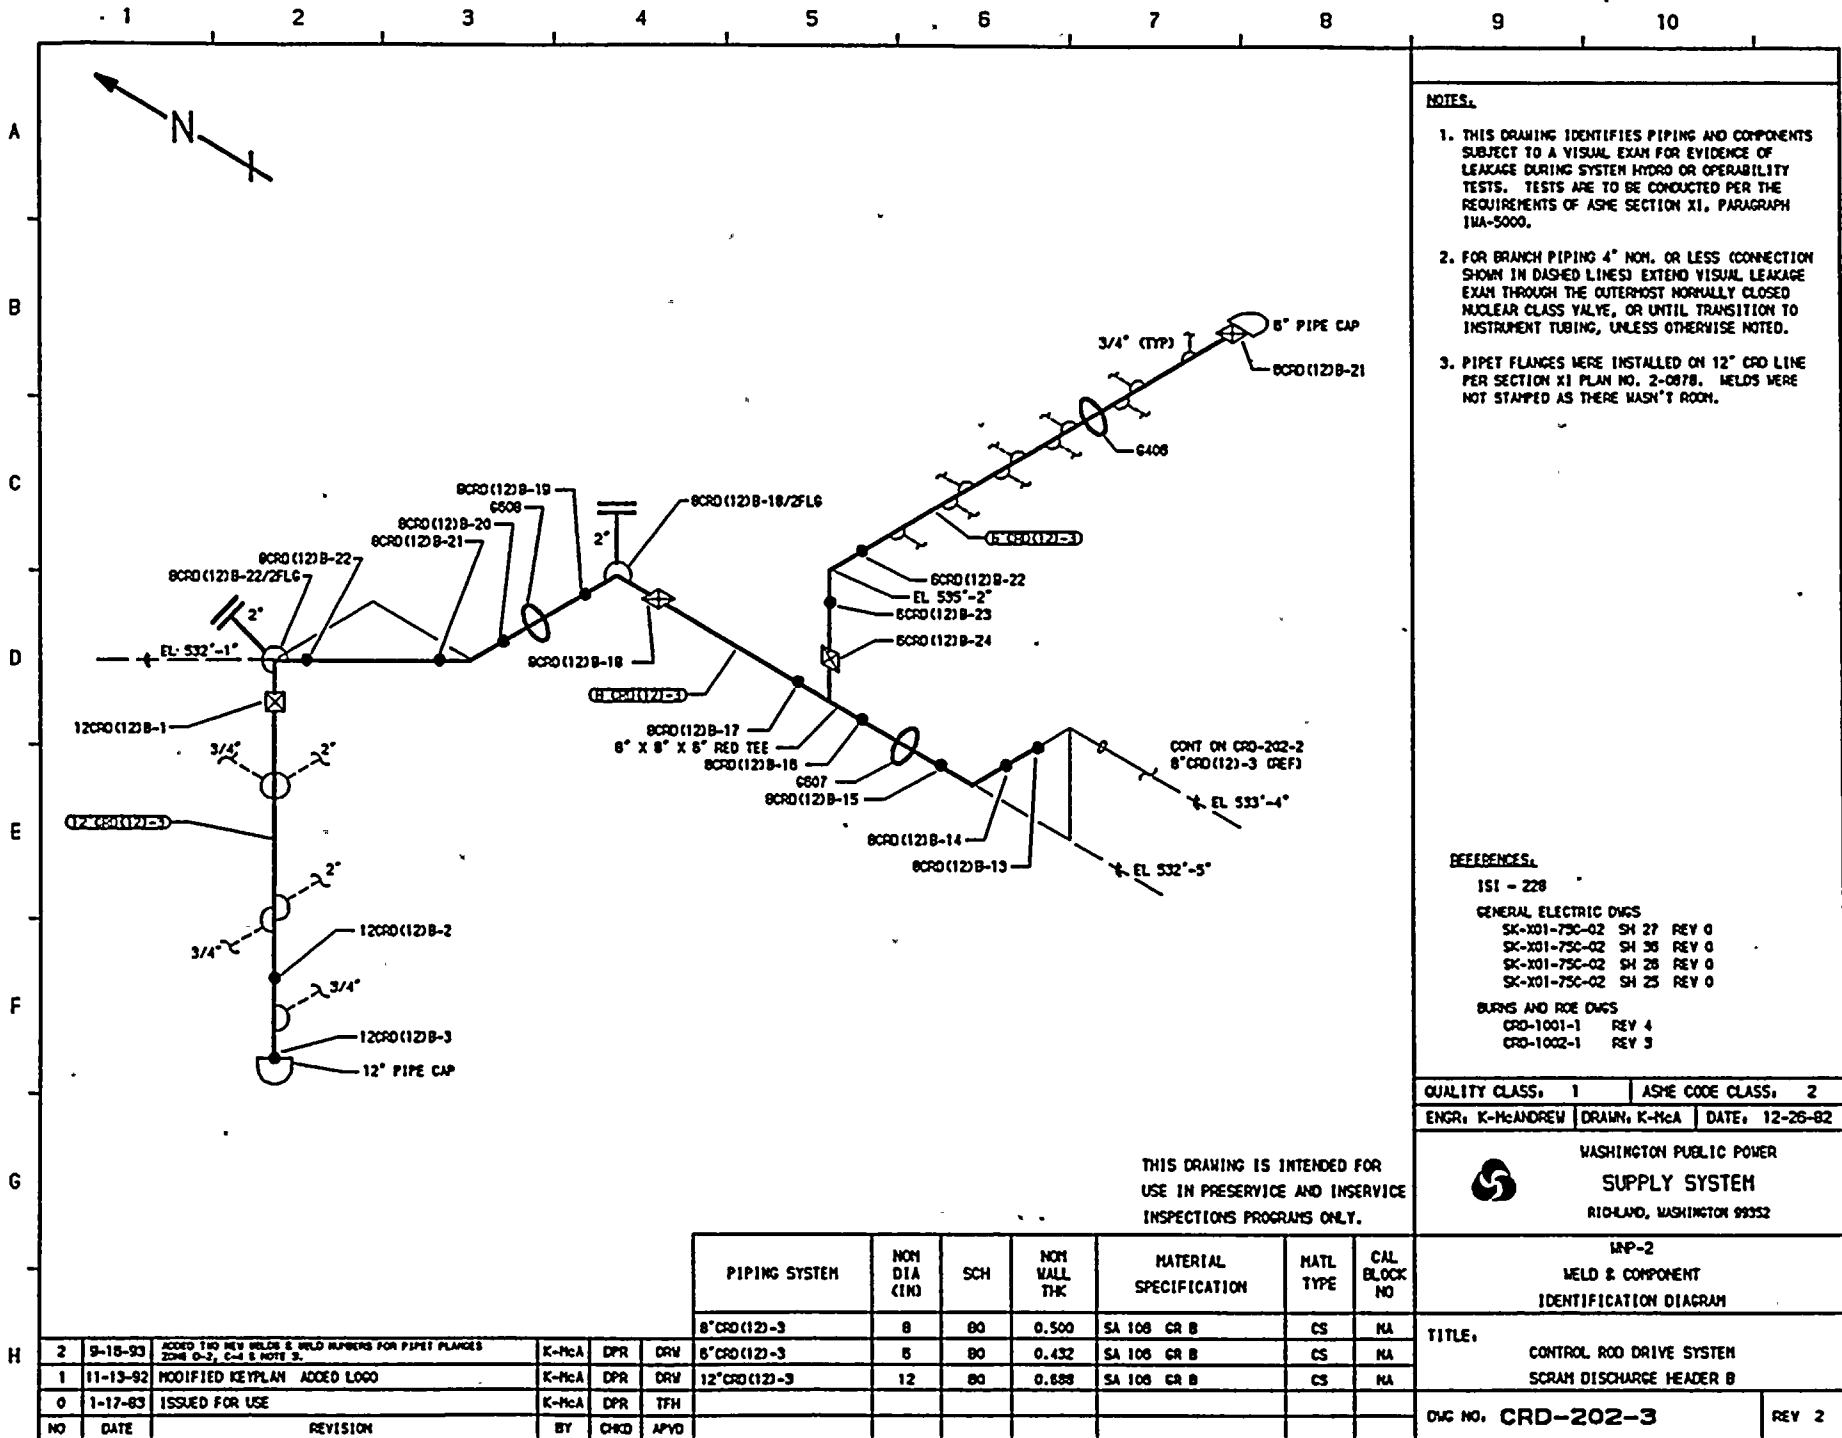

- NOTES.**
1. THIS DRAWING IDENTIFIES PIPING AND COMPONENTS SUBJECT TO A VISUAL EXAM FOR EVIDENCE OF LEAKAGE DURING SYSTEM HYDRO OR OPERABILITY TESTS. TESTS ARE TO BE CONDUCTED PER THE REQUIREMENTS OF ASME SECTION XI, PARAGRAPH IWA-5000.
  2. FOR BRANCH PIPING 4" NOM. OR LESS (CONNECTION SHOWN IN DASHED LINES) EXTEND VISUAL LEAKAGE EXAM THROUGH THE OUTERMOST NORMALLY CLOSED NUCLEAR CLASS VALVE, OR UNTIL TRANSITION TO INSTRUMENT TUBING, UNLESS OTHERWISE NOTED.
  3. PIPET FLANGES WERE INSTALLED ON 12" CRD LINE PER SECTION XI PLAN NO. 2-0878. WELDS WERE NOT STAMPED AS THERE WASN'T ROOM.

- REFERENCES.**
- ISI - 228
  - GENERAL ELECTRIC DWGS
    - SK-X01-75C-02 SH 27 REV 0
    - SK-X01-75C-02 SH 38 REV 0
    - SK-X01-75C-02 SH 28 REV 0
    - SK-X01-75C-02 SH 25 REV 0
  - BURNS AND ROE DWGS
    - CRD-1001-1 REV 4
    - CRD-1002-1 REV 3

QUALITY CLASS, 1 ASME CODE CLASS, 2  
 ENGR, K-McANDREW DRAIN, K-McA DATE, 12-26-82

WASHINGTON PUBLIC POWER  
 SUPPLY SYSTEM  
 RICHLAND, WASHINGTON 99352

MP-2  
 WELD & COMPONENT  
 IDENTIFICATION DIAGRAM

TITLE: CONTROL ROD DRIVE SYSTEM  
 SCRAM DISCHARGE HEADER B

DWG NO. CRD-202-3 REV 2

THIS DRAWING IS INTENDED FOR  
 USE IN PRESERVICE AND INSERVICE  
 INSPECTIONS PROGRAMS ONLY.

PIPING SYSTEM	NOM DIA (IN)	SCH	NOM WALL THK	MATERIAL SPECIFICATION	MATL TYPE	CAL BLOCK NO
8" CRD (12)-3	8	80	0.500	SA 106 GR B	CS	NA
8" CRD (12)-3	8	80	0.432	SA 106 GR B	CS	NA
12" CRD (12)-3	12	80	0.688	SA 106 GR B	CS	NA

NO	DATE	REVISION	BY	CHKD	APVD
2	9-18-83	ADDED TWO NEW BOLDS & WELD NUMBERS FOR PIPET FLANGES ZONE D-3, C-4 & NOTE 3.	K-McA	DPR	DRV
1	11-13-82	MODIFIED KEYPLAN ADDED LOGO	K-McA	DPR	DRV
0	1-17-83	ISSUED FOR USE	K-McA	DPR	TFH

## 9.4 FPC Fuel Pool Cooling System

## Boundary Diagram ISI-226

## Exemptions Applied:

IWB-1220

(a)	NA
(b)(1)	NA
(b)(2)	NA
(c)	NA

IWC-1221

NA	FPC system is not within the RHR, ECC, or CHR systems.
----	--

IWC-1222

(a)	Yes	All piping 4 NPS and smaller
(b)	Yes	All components 4 NPS and smaller
(c)	Yes	Entire FPC system operates below 275 psig and 200 degrees F.
(d)	No	

IWD-1220.1

Yes	
-----	--


IWD-1220.2

Yes	FPC does not support RHR, CHR or ECC systems. Entire FPC system operates below 275 psig and 200 degrees F. All attachment welds in FPC system within items D3.20, D3.30, D3.40, D3.50 and D3.60 are not required to be examined using the VT-3 method.
-----	--

Code Case N-491  
-1230

Yes	
-----	--

9.4.2 Boundary Diagrams

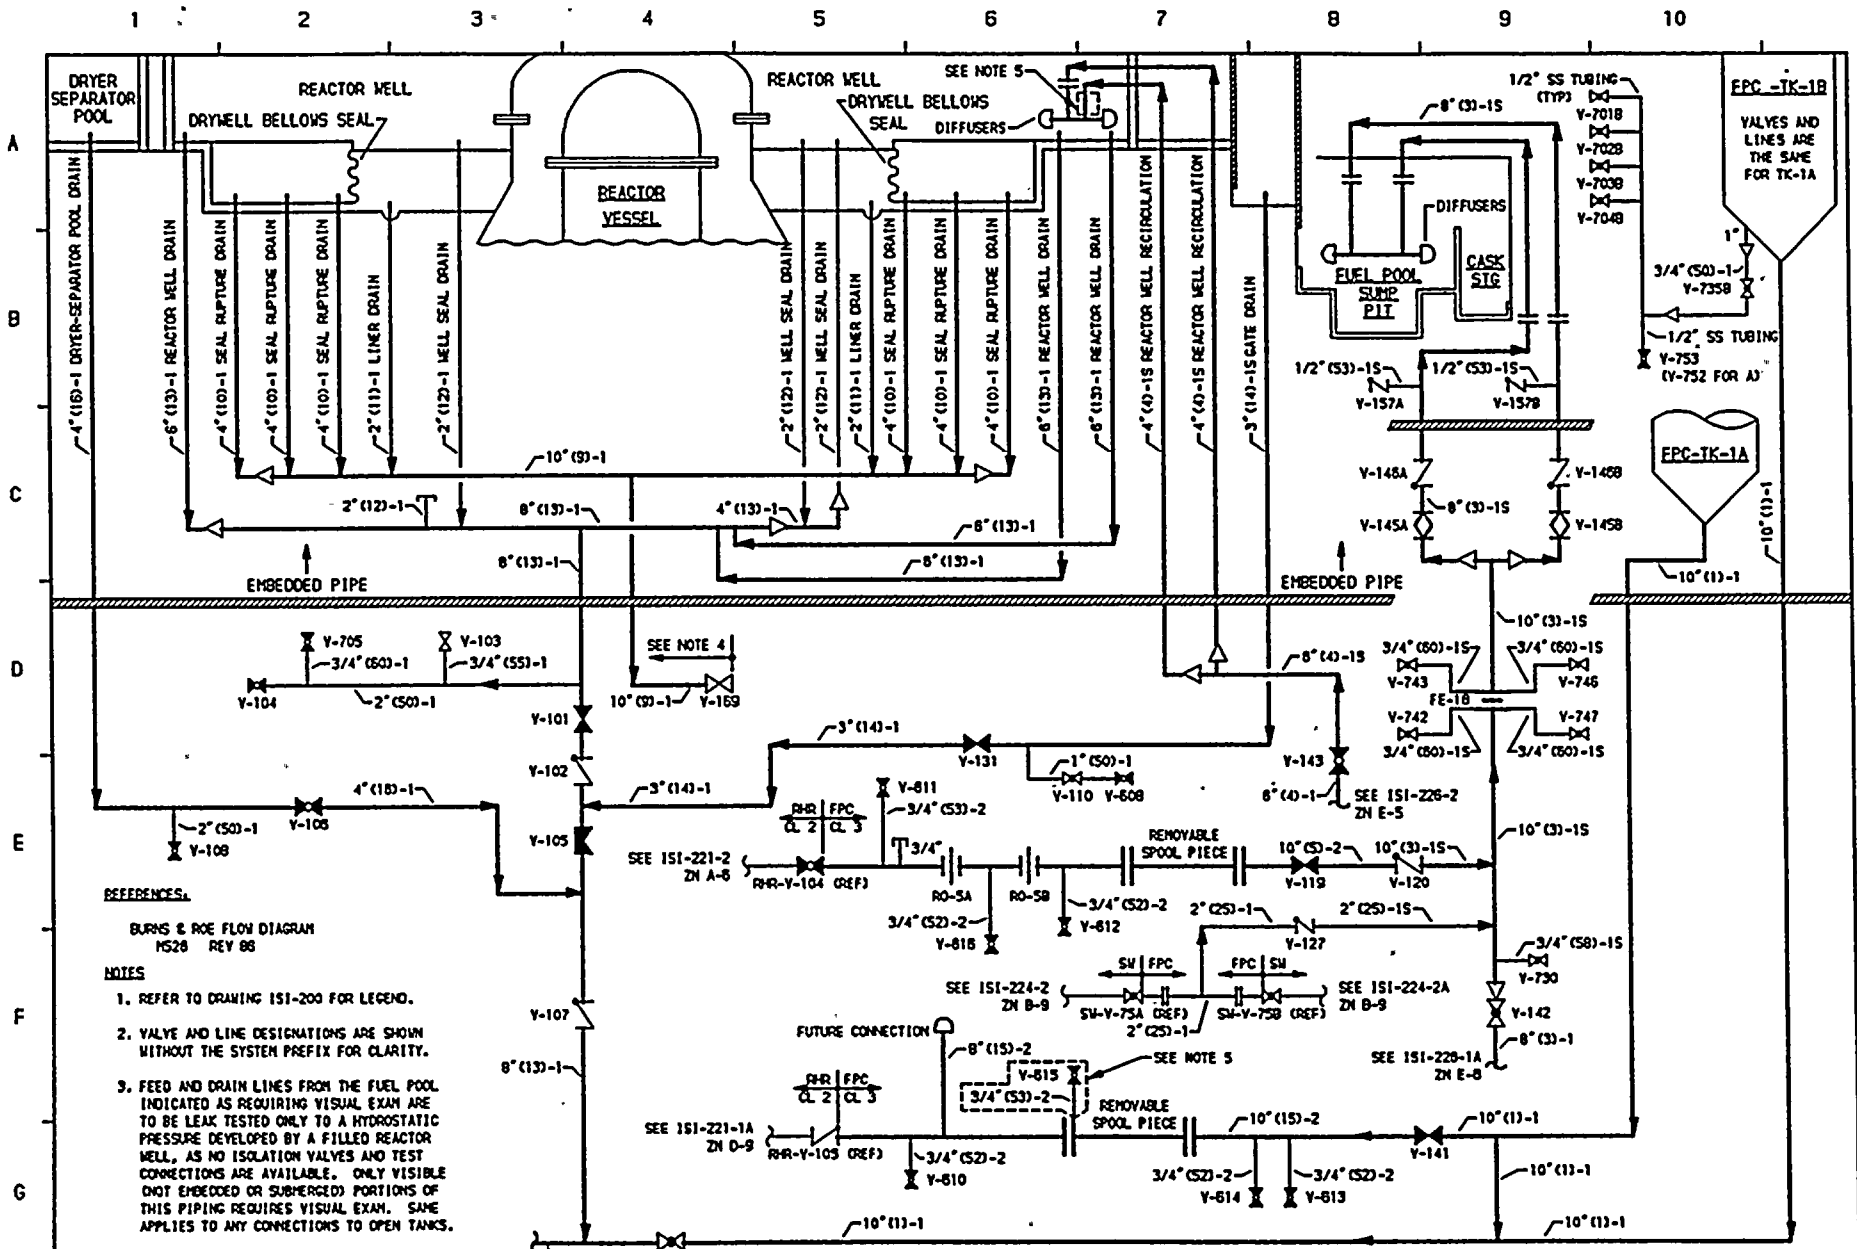

**REFERENCES**

BURNS & ROE FLOW DIAGRAM  
HS28 REV 88

**NOTES**

 
1. REFER TO DRAWING ISI-200 FOR LEGEND.
2. VALVE AND LINE DESIGNATIONS ARE SHOWN WITHOUT THE SYSTEM PREFIX FOR CLARITY.
3. FEED AND DRAIN LINES FROM THE FUEL POOL INDICATED AS REQUIRING VISUAL EXAM ARE TO BE LEAK TESTED ONLY TO A HYDROSTATIC PRESSURE DEVELOPED BY A FILLED REACTOR WELL, AS NO ISOLATION VALVES AND TEST CONNECTIONS ARE AVAILABLE. ONLY VISIBLE (NOT EMBEDDED OR SUBMERGED) PORTIONS OF THIS PIPING REQUIRES VISUAL EXAM. SAME APPLIES TO ANY CONNECTIONS TO OPEN TANKS.
4. ALL PIPING FOR 10" FPC(S)-1 UPSTREAM OF FPC-V-169 IS FABRICATED TO ASME SEC III, CODE CLASS 3 BUT NOT STAMPED.
5. CONFIGURATIONS COMPLY WITH CONSTRUCTION DRAWINGS.


THIS DRAWING IS INTENDED FOR USE IN PRESERVICE AND INSERVICE INSPECTIONS PROGRAMS ONLY

**WASHINGTON PUBLIC POWER  
SUPPLY SYSTEM**  
RICHLAND, WASHINGTON 99302

NO	DATE	REVISION	BY	CHKD	APVD	NO	DATE	REVISION	BY	CHKD	APVD	DATE	DWG NO.	REV
7	6-7-94	REVISED PER LATEST TOP TIER DRAWINGS.	K-McA	DPR	DW	4	12-4-89	REVISED 8" FPC(S)-15 FROM FPC-TK-18 TO FUEL POOL SUMP PIT, ADDING DIFFUSERS, ACCORD LOGS.	K-McA	OJ	TFH	8-20-78	ISI-226-1	7
6	12-1-92	DELETED FPC-RO-3, ADDED FPC-RO-5A & FPC-RO-5B, ZONE 4-3 PER BWC-82-0028-04.	K-McA	DPR	DRV	3	1-24-85	REVISED FOR ISI	K-McA	OJ	TFH			
5	2-20-92	CHG V-110 TO OPEN, ADDED V-608 ZN E-8	K-McA	DPR	DW	4	12-4-89	REVISED 8" FPC(S)-15 FROM FPC-TK-18 TO FUEL POOL SUMP PIT, ADDING DIFFUSERS, ACCORD LOGS.	K-McA	OJ	TFH			
4	12-4-89	REVISED 8" FPC(S)-15 FROM FPC-TK-18 TO FUEL POOL SUMP PIT, ADDING DIFFUSERS, ACCORD LOGS.	K-McA	DPR	DW	4	12-4-89	REVISED 8" FPC(S)-15 FROM FPC-TK-18 TO FUEL POOL SUMP PIT, ADDING DIFFUSERS, ACCORD LOGS.	K-McA	OJ	TFH			
3	1-24-85	REVISED FOR ISI	K-McA	DPR	DRV	3	1-24-85	REVISED FOR ISI	K-McA	OJ	TFH			

ENGINEER D PORTER  
DRAIN K-McANDREW  
INSERVICE INSPECTION BOUNDARY DIAGRAM  
FUEL POOL COOLING (FPC)  
DATE 8-20-78  
DWG NO. **ISI-226-1** REV 7



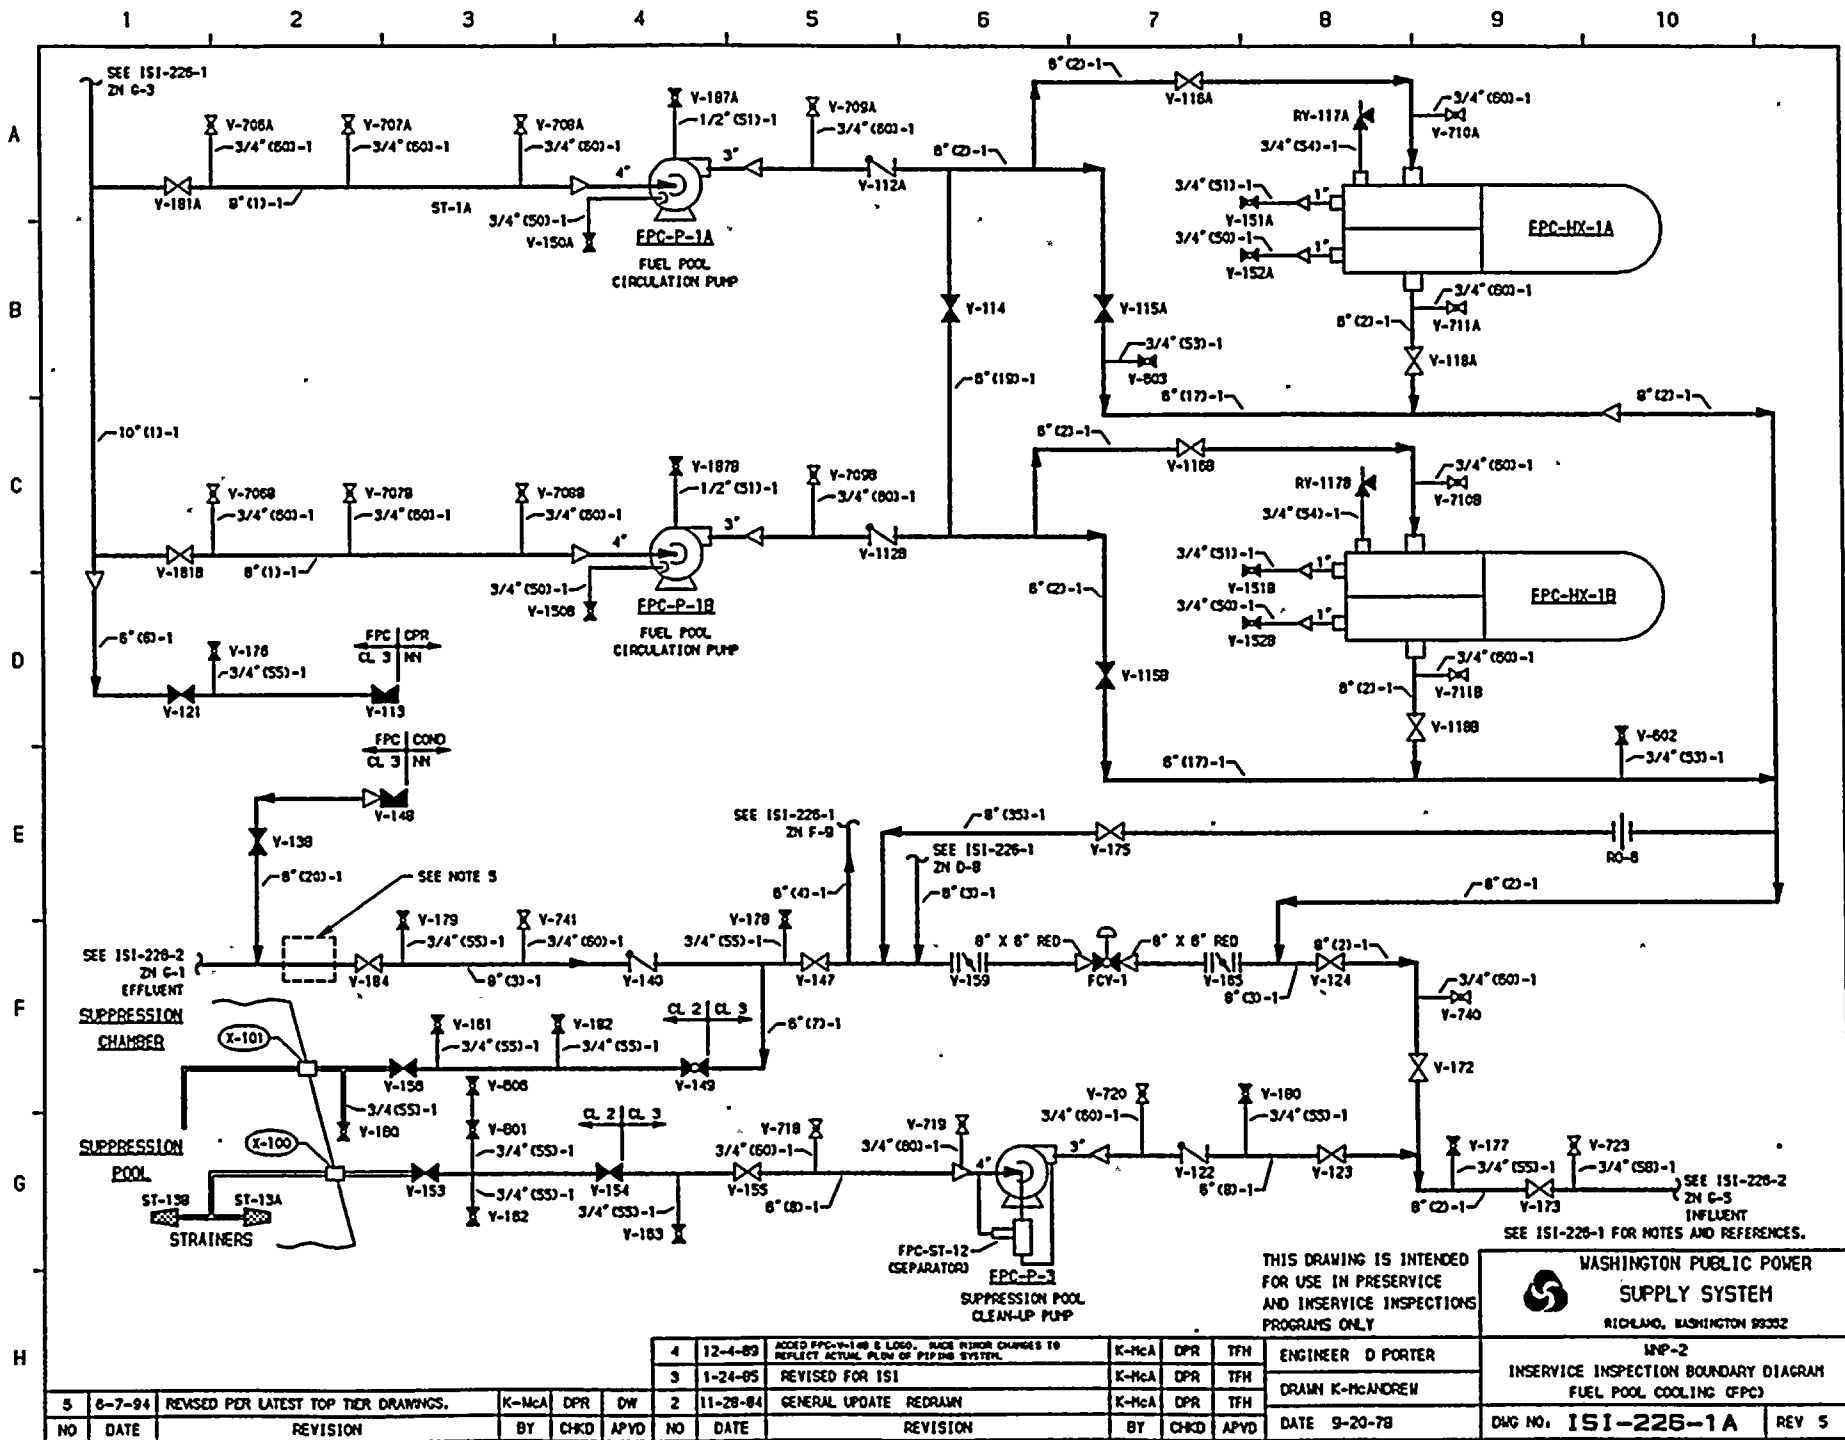

THIS DRAWING IS INTENDED FOR USE IN PRESERVICE AND INSERVICE INSPECTIONS PROGRAMS ONLY


WASHINGTON PUBLIC POWER  
SUPPLY SYSTEM  
RICHMOND, WASHINGTON 98332

NO	DATE	REVISION	BY	CHKD	APVD	NO	DATE	REVISION	BY	CHKD	APVD	DATE	NO	DATE	REVISION	BY	CHKD	APVD	
4	12-4-89	ADDED EPC-P-1A & LOGS. MADE MINOR CHANGES TO REFLECT ACTUAL FLOW OF FPC SYSTEM.	K-MCA	DPR	TFH	4	12-4-89	ADDED EPC-P-1A & LOGS. MADE MINOR CHANGES TO REFLECT ACTUAL FLOW OF FPC SYSTEM.	K-MCA	DPR	TFH	9-20-78	5	6-7-94	REVISED PER LATEST TOP TIER DRAWINGS.	K-MCA	DPR	DW	
3	1-24-85	REVISED FOR ISI	K-MCA	DPR	TFH	3	1-24-85	REVISED FOR ISI	K-MCA	DPR	TFH								
2	11-28-84	GENERAL UPDATE REDRAWN	K-MCA	DPR	TFH	2	11-28-84	GENERAL UPDATE REDRAWN	K-MCA	DPR	TFH								

WNP-2  
INSERVICE INSPECTION BOUNDARY DIAGRAM  
FUEL POOL COOLING (FPC)  
DWG NO: ISI-226-1A  
REV 5

19



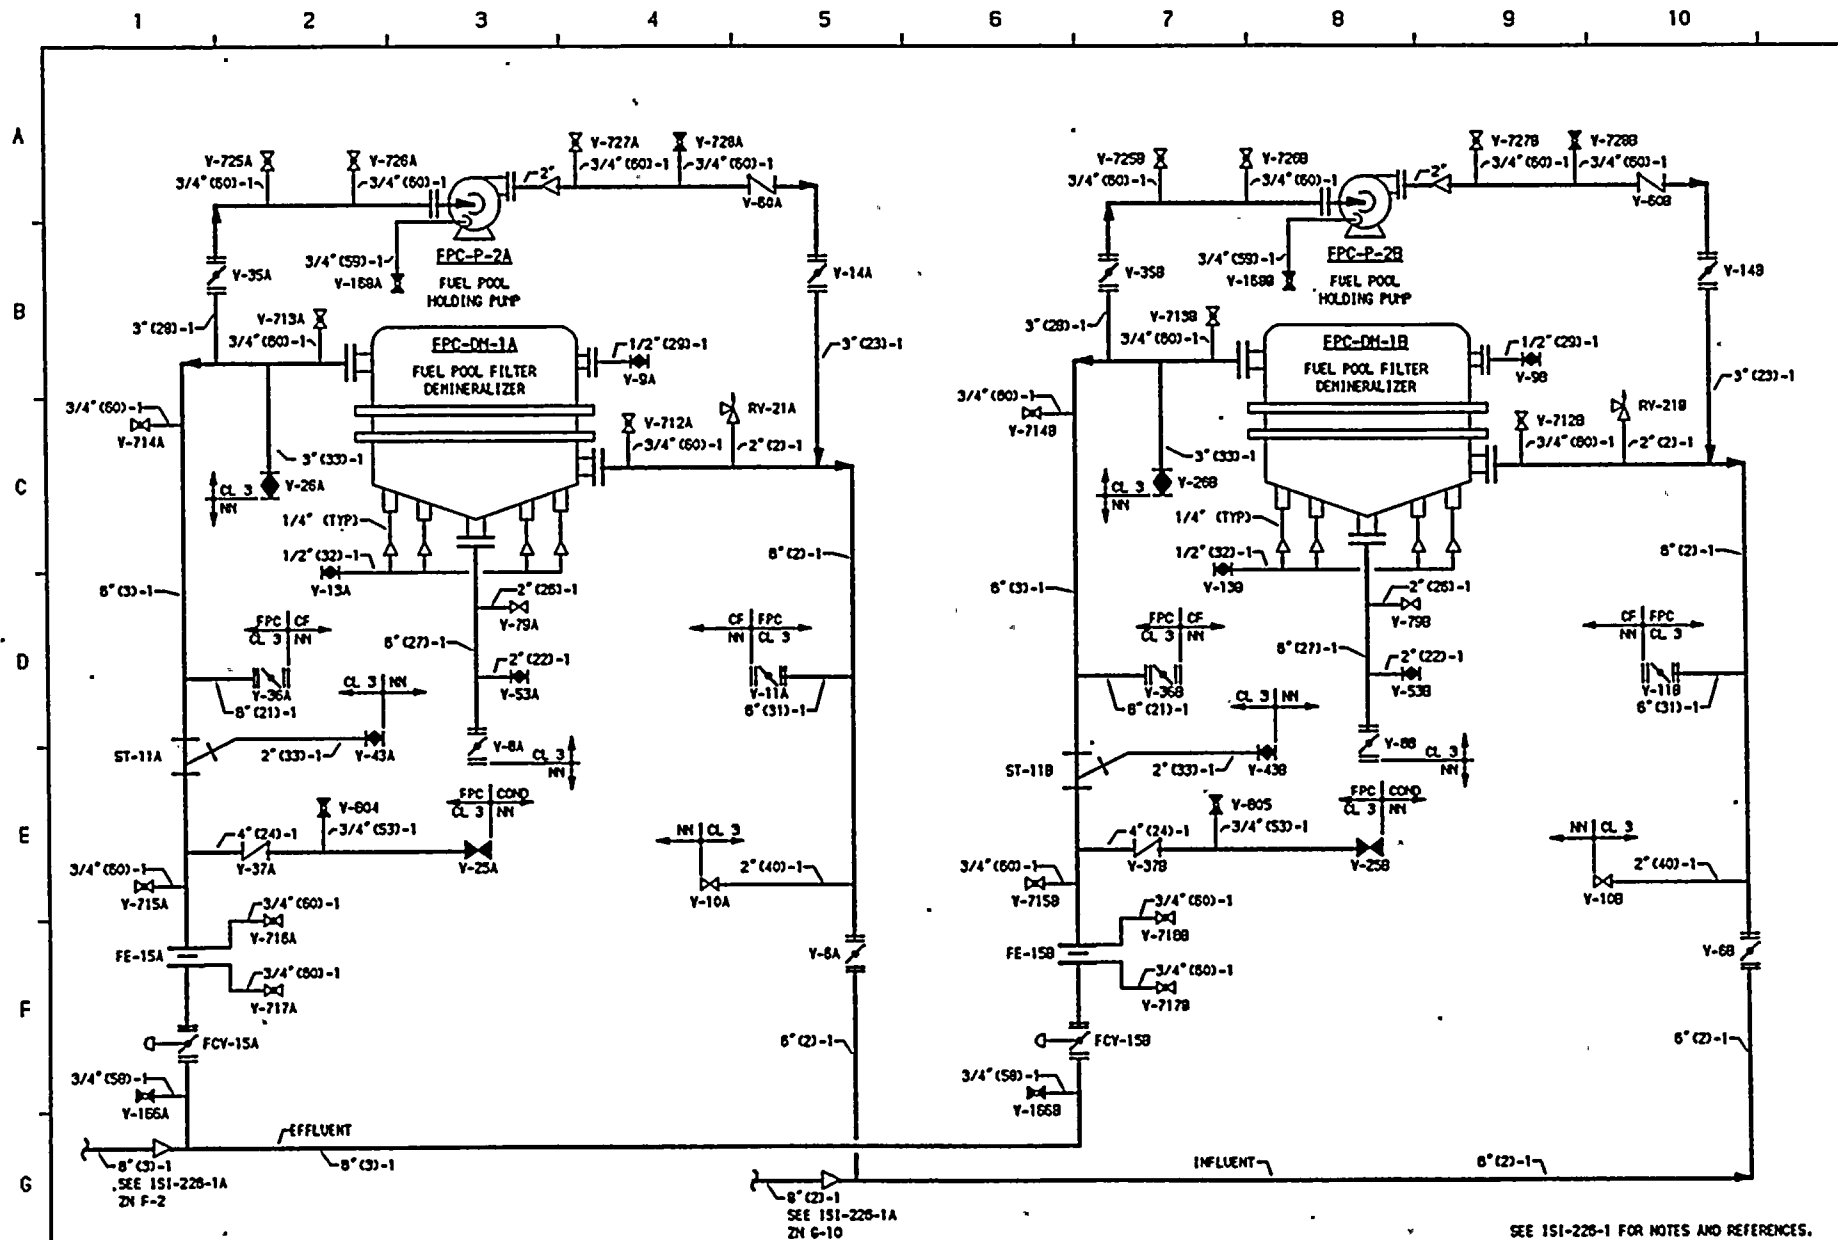

SEE ISI-226-1 FOR NOTES AND REFERENCES.

THIS DRAWING IS INTENDED FOR USE IN PRESERVICE AND INSERVICE INSPECTIONS PROGRAMS ONLY



WASHINGTON PUBLIC POWER  
SUPPLY SYSTEM  
RIDLAND, WASHINGTON 99332

NO	DATE	REVISION	BY	CHKD	APVD	NO	DATE	REVISION	BY	CHKD	APVD	DATE	DWG NO.	REV
5	12-4-89	EXTENDED FPC-ST-11A & 11B PIPING TO NH, ADDED LOGS.	K-McA	DPR	TFH	3	11-28-84	GENERAL UPDATE REDRAIN	K-McA	DPR	TFH	9-20-78	ISI-226-2	6
4	1-24-85	REVISED FOR ISI	K-McA	DPR	TFH	3	11-28-84	GENERAL UPDATE REDRAIN	K-McA	DPR	TFH	9-20-78	ISI-226-2	6
3	11-28-84	GENERAL UPDATE REDRAIN	K-McA	DPR	TFH	3	11-28-84	GENERAL UPDATE REDRAIN	K-McA	DPR	TFH	9-20-78	ISI-226-2	6
6	8-7-84	REVISED PER LATEST TOP TIER DRAWINGS.	K-McA	DPR	DW	3	11-28-84	GENERAL UPDATE REDRAIN	K-McA	DPR	TFH	9-20-78	ISI-226-2	6

INSERVICE INSPECTION BOUNDARY DIAGRAM  
FUEL POOL COOLING (FPC)

DWG NO. ISI-226-2 REV 6



9.4.3 Examination Schedule

WNP-2  
Interval 2  
FPC - Fuel Pool Cooling

Table 9.1.4  
Washington Public Power Supply System  
ISI Program Plan and Schedule  
(Grouped by Drawing No. and Walkdown Order)

Revision 0

Pg	Identification No.	Description	Category	Item No.	Method	Per.	Out.	Reqmt.	Code	Out. Freq.	Rel. Req.	Remarks
Diagram No. FPC-201												
	FPC-903N	ANCHOR	F-A	F1.20A	VT-3	1	10	41	CE	10		
	FPC-170	BOX	F-A	F1.20A	VT-3			4	C	0		
	FPC-172	BOX	F-A	F1.20A	VT-3			4	C	0		
	FPC-237	BOX	F-A	F1.20A	VT-3			4	C	0		
	FPC-238	BOX	F-A	F1.20A	VT-3			4	C	0		
	FPC-239	BOX	F-A	F1.20A	VT-3			4	C	0		
	FPC-PB-201(L)	LK PRES BNDRY	C-H	C7.30	VT-2	1	13	P	CE	3		
	FPC-PB-201(H)	HYDRO PRES BNDR	C-H	C7.40	VT-2	3	19	E	CE	10		

WNP-2  
Interval 2  
FPC - Fuel Pool Cooling

Table 9.1.4  
Washington Public Power Supply System  
ISI Program Plan and Schedule  
(Grouped by Drawing No. and Walkdown Order)

Revision 0

Pg	Identification No.	Description	Category	Item No.	Method	Per.	Out.	Reqmt.	Code	Out. Freq.	Rel. Req.	Remarks
Diagram No. FPC-301												
	FPC-PB-301(L)	LK PRES BNDRY	D-C	D3.10	VT-2	1	13	P	CE	3		
	FPC-PB-301(H)	HYDRO PRES BNDR	D-C	D3.10	VT-2	3	19	E	CE	10		
01	FPC-54	BOX	F-A	F1.30A	VT-3			5	C	0		
	FPC-55	BOX	F-A	F1.30A	VT-3			5	C	0		
	FPC-56	BOX	F-A	F1.30A	VT-3			5	C	0		
02	FPC-51	BOX	F-A	F1.30A	VT-3			5	C	0		
	FPC-52	BOX	F-A	F1.30A	VT-3			5	C	0		
	FPC-53	BOX	F-A	F1.30A	VT-3			5	C	0		
03	FPC-130	BOX	F-A	F1.30A	VT-3			5	C	0		
	FPC-129	BOX	F-A	F1.30A	VT-3			5	C	0		
	FPC-128	BOX	F-A	F1.30A	VT-3			5	C	0		
	FPC-127	BOX	F-A	F1.30A	VT-3			5	C	0		
04	FPC-65	PSA-1 SNUBBER	F-A	F1.30D	VT-3	2	16	51	CE	10		
	FPC-916N	SPRING	F-A	F1.30C	VT-3			5	C	0		
	FPC-918N	PSA-1 SNUBBER	F-A	F1.30D	VT-3			5	C	0		
	FPC-88	SPRING	F-A	F1.30C	VT-3			5	C	0		
	FPC-101	RIGID	F-A	F1.30A	VT-3			5	C	0		

WNP-2  
Interval 2  
FPC - Fuel Pool Cooling

Table 9.1.4  
Washington Public Power Supply System  
ISI Program Plan and Schedule  
(Grouped by Drawing No. and Walkdown Order)

Revision 0

Pg	Identification No.	Description	Category	Item No.	Method	Per.	Out.	Reqmt.	Code	Out. Freq.	Rel. Req.	Remarks
Diagram No. FPC-301												
05	FPC-86	SPRING	F-A	F1.30C	VT-3	1	10	51	CE	10		
	FPC-P-1A(CS)	PUMP BASE	F-A	F1.40A	VT-3	1	10	61	CE	10		
06	FPC-87	BOX	F-A	F1.30A	VT-3			5	C	0		
	FPC-P-1B(CS)	PUMP BASE	F-A	F1.40A	VT-3	1	10	61	CE	10		
07	FPC-57	BOX	F-A	F1.30A	VT-3			5	C	0		
	FPC-58	BOX	F-A	F1.30A	VT-3			5	C	0		
	FPC-919N	RIGID	F-A	F1.30A	VT-3			5	C	0		
	FPC-59	BOX	F-A	F1.30A	VT-3			5	C	0		
	FPC-60	BOX	F-A	F1.30A	VT-3			5	C	0		
	FPC-61	SPRING	F-A	F1.30C	VT-3			5	C	0		
08	FPC-62	BOX	F-A	F1.30A	VT-3			5	C	0		
	FPC-63	BOX	F-A	F1.30A	VT-3			5	C	0		
	FPC-64	BOX	F-A	F1.30A	VT-3			5	C	0		
	FPC-44	ANCHOR	F-A	F1.30A	VT-3			5	C	0		
	FPC-42	STRUT	F-A	F1.30A	VT-3			5	C	0		
	FPC-43	PSA-3 SHUBBER	F-A	F1.30D	VT-3			5	C	0		

WNP-2  
 Interval 2  
 FPC - Fuel Pool Cooling

Table 9.1.4  
 Washington Public Power Supply System  
 ISI Program Plan and Schedule  
 (Grouped by Drawing No. and Walkdown Order)

Revision 0

Pg	Identification No.	Description	Category	Item No.	Method	Per.	Out.	Reqmt.	Code	Out. Freq.	Rel. Req.	Remarks
Diagram No. FPC-301												
08	FPC-909N	RIGID	F-A	F1.30A	VT-3	2	15	51	CE	10		
	FPC-908N	PSA-1 SHUBBER	F-A	F1.30D	VT-3			5	C	0		
	FPC-41	SPRING	F-A	F1.30C	VT-3	2	15	51	CE	10		
	FPC-40	STRUT	F-A	F1.30A	VT-3	2	15	51	CE	10		
	FPC-39	SPRING	F-A	F1.30C	VT-3			5	C	0		

WNP-2  
Interval 2  
FPC - Fuel Pool Cooling

Table 9.1.4  
Washington Public Power Supply System  
ISI Program Plan and Schedule  
(Grouped by Drawing No. and Walkdown Order)

Revision 0

Pg	Identification No.	Description	Category	Item No.	Method	Per.	Out.	Requmt.	Code	Out. Freq.	Rel. Req.	Remarks
Diagram No. FPC-302												
	FPC-PB-302(L)	LK PRES BNDRY	D-C	D3.10	VT-2	1	13	P	CE	3		
	FPC-PB-302(H)	HYDRO PRES BNDR	D-C	D3.10	VT-2	3	19	E	CE	10		
01	FPC-208	BOX	F-A	F1.30A	VT-3			5	C	0		
	FPC-184	SPRING	F-A	F1.30C	VT-3			5	C	0		
	FPC-182	BOX	F-A	F1.30A	VT-3			5	C	0		
02	FPC-185	BOX	F-A	F1.30A	VT-3			5	C	0		
	FPC-186	SPRING	F-A	F1.30C	VT-3			5	C	0		
	FPC-HX-1A(CS)	HX BASE	F-A	F1.40A	VT-3	1	10	61	CE	10		
03	FPC-179	BOX	F-A	F1.30A	VT-3			5	C	0		
	FPC-180	BOX	F-A	F1.30A	VT-3			5	C	0		
	FPC-181	BOX	F-A	F1.30A	VT-3			5	C	0		
04	FPC-177	SPRING	F-A	F1.30C	VT-3			5	C	0		
	FPC-178	BOX	F-A	F1.30A	VT-3			5	C	0		

WNP-2  
Interval 2  
FPC - Fuel Pool Cooling

Table 9.1.4  
Washington Public Power Supply System  
ISI Program Plan and Schedule  
(Grouped by Drawing No. and Walkdown Order)

Revision 0

Pg	Identification No.	Description	Category	Item No.	Method	Per.	Out.	Reqmt.	Code	Out. Freq.	Rel. Req.	Remarks
Diagram No. FPC-303												
	FPC-PB-303(L)	LK PRES BNDRY	D-C	D3.10	VT-2	1	13	P	CE	3		
	FPC-PB-303(H)	HYDRO PRES BKDR	D-C	D3.10	VT-2	3	19	E	CE	10		
01	FPC-193	SPRING	F-A	F1.30C	VT-3			5	C	0		
	FPC-207	BOX	F-A	F1.30A	VT-3			5	C	0		
	FPC-192	BOX	F-A	F1.30A	VT-3			5	C	0		
	FPC-191	BOX	F-A	F1.30A	VT-3			5	C	0		
02	FPC-188	BOX	F-A	F1.30A	VT-3			5	C	0		
	FPC-187	BOX	F-A	F1.30A	VT-3			5	C	0		
03	FPC-190	SPRING	F-A	F1.30C	VT-3			5	C	0		
	FPC-HX-1B(CS)	HX BASE	F-A	F1.40A	VT-3	1	10	61	CE	10		
04	FPC-189	SPRING	F-A	F1.30C	VT-3			5	C	0		

WNP-2  
Interval 2  
FPC - Fuel Pool Cooling

Table 9.1.4  
Washington Public Power Supply System  
ISI Program Plan and Schedule  
(Grouped by Drawing No. and Walkdown Order)

Revision 0

Pg	Identification No.	Description	Category	Item No.	Method	Per.	Out.	Requmt.	Code	Out. Freq.	Rel. Req.	Remarks
Diagram No. FPC-304												
	FPC-PB-304(L)	LK PRES BNDRY	D-C	D3.10	VT-2	1	13	P	CE	3		
	FPC-PB-304(H)	HYDRO PRES BNDR	D-C	D3.10	VT-2	3	19	E	CE	10		
01	FPC-194	BOX	F-A	F1.30A	VT-3			5	C	0		
	FPC-195	BOX	F-A	F1.30A	VT-3			5	C	0		
	FPC-196	BOX	F-A	F1.30A	VT-3			5	C	0		
	FPC-197	BOX	F-A	F1.30A	VT-3			5	C	0		
	FPC-198	BOX	F-A	F1.30A	VT-3			5	C	0		
	FPC-199	BOX	F-A	F1.30A	VT-3			5	C	0		
02	FPC-200	BOX	F-A	F1.30A	VT-3			5	C	0		
	FPC-202	BOX	F-A	F1.30A	VT-3			5	C	0		
	FPC-906N	BOX	F-A	F1.30A	VT-3			5	C	0		
	FPC-203	BOX	F-A	F1.30A	VT-3			5	C	0		
	FPC-204	BOX	F-A	F1.30A	VT-3			5	C	0		
	FPC-205	RIGID	F-A	F1.30A	VT-3			5	C	0		
03	FPC-98	RIGID	F-A	F1.30A	VT-3			5	C	0		INACCESS. DUE TO FOAMFILLED WATER-TIGHT BOOT.
	FPC-102	RIGID	F-A	F1.30A	VT-3			5	C	0		



WNP-2  
Interval 2  
FPC - Fuel Pool Cooling

Table 9.1.4  
Washington Public Power Supply System  
ISI Program Plan and Schedule  
(Grouped by Drawing No. and Walkdown Order)

Revision 0

Pg	Identification No.	Description	Category	Item No.	Method	Per.	Out.	Requ.	Code	Out. Freq.	Rel. Req.	Remarks
Diagram No. FPC-304												
03	FPC-103	RIGID	F-A	F1.30A	VT-3		5		C	0		
	FPC-104	RIGID	F-A	F1.30A	VT-3		5		C	0		
	FPC-105	RIGID	F-A	F1.30A	VT-3		5		C	0		
	FPC-106	RIGID	F-A	F1.30A	VT-3		5		C	0		
	FPC-107	RIGID	F-A	F1.30A	VT-3		5		C	0		
	FPC-108	RIGID	F-A	F1.30A	VT-3		5		C	0		
	FPC-109	RIGID	F-A	F1.30A	VT-3		5		C	0		
	FPC-110	RIGID	F-A	F1.30A	VT-3		5		C	0		
04	FPC-111	BOX	F-A	F1.30A	VT-3		5		C	0		
	FPC-113	BOX	F-A	F1.30A	VT-3		5		C	0		
	FPC-114	RIGID	F-A	F1.30A	VT-3		5		C	0		INACCESSABLE LOCATED IN CLOSED-CUBICLE.
	FPC-DH-1A(CS)	DEMIM BASE	F-A	F1.40A	VT-3	1	10	61	CE	10		
05	FPC-112	STRUT	F-A	F1.30A	VT-3		5		C	0		
	FPC-116	RIGID	F-A	F1.30A	VT-3		5		C	0		
	FPC-DH-1B(CS)	DEMIM BASE	F-A	F1.40A	VT-3	1	10	61	CE	10		

WNP-2  
Interval 2  
FPC - Fuel Pool Cooling

Table 9.1.4  
Washington Public Power Supply System  
ISI Program Plan and Schedule  
(Grouped by Drawing No. and Walkdown Order)

Revision 0

Pg	Identification No.	Description	Category	Item No.	Method	Per.	Out.	Requst.	Code	Out. Freq.	Rel. Req.	Remarks
Diagram No. FPC-305												
	FPC-PB-305(L)	LK PRES BNDRY	D-C	D3.10	VT-2	1	13	P	CE	3		
	FPC-PB-305(H)	HYDRO PRES BNDR	D-C	D3.10	VT-2	3	19	E	CE	10		
01	FPC-83	RIGID	F-A	F1.30A	VT-3			5	C	0		
	FPC-82	RIGID	F-A	F1.30A	VT-3			5	C	0		
	FPC-79	RIGID	F-A	F1.30A	VT-3			5	C	0		
	FPC-78	BOX	F-A	F1.30A	VT-3			5	C	0		
02	FPC-93	RIGID	F-A	F1.30A	VT-3			5	C	0		
	FPC-92	RIGID	F-A	F1.30A	VT-3			5	C	0		
	FPC-91	STRUT	F-A	F1.30A	VT-3			5	C	0		
03	FPC-77	RIGID	F-A	F1.30A	VT-3			5	C	0		
	FPC-76	BOX	F-A	F1.30A	VT-3			5	C	0		
	FPC-75	RIGID	F-A	F1.30A	VT-3			5	C	0		
	FPC-74	RIGID	F-A	F1.30A	VT-3			5	C	0		
	FPC-73	BOX	F-A	F1.30A	VT-3			5	C	0		
	FPC-72	RIGID	F-A	F1.30A	VT-3			5	C	0		
	FPC-71	BOX	F-A	F1.30A	VT-3			5	C	0		
	FPC-68	RIGID	F-A	F1.30A	VT-3			5	C	0		

WNP-2  
Interval 2  
FPC - Fuel Pool Cooling

Table 9.1.4  
Washington Public Power Supply System  
ISI Program Plan and Schedule  
(Grouped by Drawing No. and Walkdown Order)

Revision 0

Pg	Identification No.	Description	Category	Item No.	Method	Per.	Out.	Requmt.	Code	Out. Freq.	Rel. Req.	Remarks
Diagram No. FPC-305												
03	FPC-69	RIGID	F-A	F1.30A	VT-3		5		C	0		
04	FPC-70	RIGID	F-A	F1.30A	VT-3		5		C	0		
	FPC-67	RIGID	F-A	F1.30A	VT-3		5		C	0		
	FPC-66	RIGID	F-A	F1.30A	VT-3		5		C	0		
	FPC-168	BOX	F-A	F1.30A	VT-3		5		C	0		
	FPC-167	BOX	F-A	F1.30A	VT-3		5		C	0		
	FPC-166	BOX	F-A	F1.30A	VT-3		5		C	0		
	FPC-911N	BOX	F-A	F1.30A	VT-3		5		C	0		
	FPC-165	BOX	F-A	F1.30A	VT-3		5		C	0		
05	FPC-206	BOX	F-A	F1.30A	VT-3		5		C	0		
	FPC-164	BOX	F-A	F1.30A	VT-3		5		C	0		
	FPC-163	BOX	F-A	F1.30A	VT-3		5		C	0		
	FPC-201	RIGID	F-A	F1.30A	VT-3		5		C	0		
	FPC-162	BOX	F-A	F1.30A	VT-3		5		C	0		
06	FPC-160	RIGID	F-A	F1.30A	VT-3		5		C	0		
	FPC-161	BOX	F-A	F1.30A	VT-3		5		C	0		

WNP-2  
Interval 2  
FPC - Fuel Pool Cooling

Table 9.1.4  
Washington Public Power Supply System  
ISI Program Plan and Schedule  
(Grouped by Drawing No. and Walkdown Order)

Revision 0

Pg	Identification No.	Description	Category	Item No.	Method	Per.	Out.	Requmt.	Code	Out. Freq.	Rel. Req.	Remarks
Diagram No. FPC-305												
07	FPC-913N	BOX	F-A	F1.30A	VT-3		5		C	0		
	FPC-912N	BOX	F-A	F1.30A	VT-3		5		C	0		
	FPC-211	STRUT	F-A	F1.30A	VT-3		5		C	0		
	FPC-213	BOX	F-A	F1.30A	VT-3		5		C	0		
	FPC-231	BOX	F-A	F1.30A	VT-3		5		C	0		
08	FPC-214	BOX	F-A	F1.30A	VT-3		5		C	0		
	FPC-215	BOX	F-A	F1.30A	VT-3		5		C	0		
	FPC-216	BOX	F-A	F1.30A	VT-3		5		C	0		
	FPC-240	BOX	F-A	F1.30A	VT-3		5		C	0		
09	FPC-230	SPRING	F-A	F1.30C	VT-3		5		C	0		
	FPC-227	PSA-3 SHUBBER	F-A	F1.30D	VT-3		5		C	0		
	FPC-226	SPRING	F-A	F1.30C	VT-3		5		C	0		
	FPC-225	STRUT	F-A	F1.30A	VT-3		5		C	0		
	FPC-224	BOX	F-A	F1.30A	VT-3		5		C	0		
	FPC-223	ANCHOR	F-A	F1.30A	VT-3		5		C	0		
	FPC-209	BOX	F-A	F1.30A	VT-3		5		C	0		
	FPC-210	BOX	F-A	F1.30A	VT-3		5		C	0		

WNP-2  
Interval 2  
FPC - Fuel Pool Cooling

Table 9.1.4  
Washington Public Power Supply System  
ISI Program Plan and Schedule  
(Grouped by Drawing No., and Walkdown Order)

Revision 0

Pg	Identification No.	Description	Category	Item No.	Method	Per. Out.	Reqmt.	Code	Out. Freq.	Rel. Req.	Remarks
Diagram No. FPC-305											
10	FPC-159	BOX	F-A	F1.30A	VT-3		5	C		0	
	FPC-158	BOX	F-A	F1.30A	VT-3		5	C		0	
11	FPC-915N	RIGID	F-A	F1.30A	VT-3		5	C		0	

WNP-2  
Interval 2  
FPC - Fuel Pool Cooling

Table 9.1.4  
Washington Public Power Supply System  
ISI Program Plan and Schedule  
(Grouped by Drawing No. and Walkdown Order)

Revision 0

Pg	Identification No.	Description	Category	Item No.	Method	Per.	Out.	Reqmt.	Code	Out. Freq.	Rel. Req.	Remarks
Diagram No. FPC-306												
	FPC-126	STRUT	F-A	F1.30A	VT-3	3	17	51	CE	10		
	FPC-123	BOX	F-A	F1.30A	VT-3	3	17	51	CE	10		
	FPC-122	ANCHOR	F-A	F1.30A	VT-3			5	C	0		
	FPC-120	BOX	F-A	F1.30A	VT-3			5	C	0		
	FPC-119	SPRING	F-A	F1.30C	VT-3			5	C	0		
	FPC-118	RIGID	F-A	F1.30A	VT-3	2	14	51	CE	10		
	FPC-P-3(CS)	PUMP BASE	F-A	F1.40A	VT-3	1	10	61	CE	10		

WNP-2  
Interval 2  
FPC - Fuel Pool Cooling

Table 9.1.4  
Washington Public Power Supply System  
ISI Program Plan and Schedule  
(Grouped by Drawing No. and Walkdown Order)

Revision 0

Pg	Identification No.	Description	Category	Item No.	Method	Per.	Out.	Reqmt.	Code	Out. Freq.	Rel. Req.	Remarks
Diagram No. FPC-307												
	FPC-45	BOX	F-A	F1.30A	VT-3		5		C	0		
	FPC-99	BOX	F-A	F1.30A	VT-3		5		C	0		
	FPC-914N	RIGID	F-A	F1.30A	VT-3		5		C	0		
	FPC-47	BOX	F-A	F1.30A	VT-3		5		C	0		
	FPC-48	BOX	F-A	F1.30A	VT-3		5		C	0		
	FPC-49	BOX	F-A	F1.30A	VT-3		5		C	0		
	FPC-100	BOX	F-A	F1.30A	VT-3		5		C	0		
	FPC-50	BOX	F-A	F1.30A	VT-3		5		C	0		
	FPC-907N	RIGID	F-A	F1.30A	VT-3		5		C	0		

WNP-2  
Interval 2  
FPC - Fuel Pool Cooling

Table 9.1.4  
Washington Public Power Supply System  
ISI Program Plan and Schedule  
(Grouped by Drawing No. and Walkdown Order)

Revision 0

Pg	Identification No.	Description	Category	Item No.	Method	Per.	Out.	Reqmt.	Code	Out. Freq.	Rel. Req.	Remarks
Diagram No. FPC-308												
01	FPC-5	SPRING	F-A	F1.30C	VT-3		5		C	0		
	FPC-6	STRUT	F-A	F1.30A	VT-3		5		C	0		
02	FPC-8	STRUT	F-A	F1.30A	VT-3		5		C	0		
	FPC-9	BOX	F-A	F1.30A	VT-3		5		C	0		
	FPC-10	BOX	F-A	F1.30A	VT-3		5		C	0		
	FPC-11	BOX	F-A	F1.30A	VT-3		5		C	0		
	FPC-12	STRUT	F-A	F1.30A	VT-3		5		C	0		
	FPC-13	BOX	F-A	F1.30A	VT-3		5		C	0		
	FPC-14	STRUT	F-A	F1.30A	VT-3		5		C	0		
03	FPC-17	STRUT	F-A	F1.30A	VT-3		5		C	0		
	FPC-18	SPRING	F-A	F1.30C	VT-3		5		C	0		
04	FPC-19	BOX	F-A	F1.30A	VT-3		5		C	0		
	FPC-20	STRUT	F-A	F1.30A	VT-3		5		C	0		
	FPC-21	STRUT	F-A	F1.30A	VT-3		5		C	0		
	FPC-22	SPRING	F-A	F1.30C	VT-3		5		C	0		




WNP-2  
Interval 2  
FPC - Fuel Pool Cooling

Table 9.1.4  
Washington Public Power Supply System  
ISI Program Plan and Schedule  
(Grouped by Drawing No. and Walkdown Order)

Revision 0


Pg	Identification No.	Description	Category	Item No.	Method	Per.	Out.	Reqmt.	Code	Out. Freq.	Rel. Req.	Remarks
Diagram No. FPC-325												
01	FPC-246	BOX	F-A	F1.30A	VT-3		5		C	0		UNDERWATER IN FP REMOTE EXAMINATION
	FPC-247	BOX	F-A	F1.30A	VT-3		5		C	0		UNDERWATER IN FP REMOTE EXAMINATION
	FPC-248	BOX	F-A	F1.30A	VT-3		5		C	0		UNDERWATER IN FP REMOTE EXAMINATION
02	FPC-243	BOX	F-A	F1.30A	VT-3		5		C	0		UNDERWATER IN FP REMOTE EXAMINATION
	FPC-244	BOX	F-A	F1.30A	VT-3		5		C	0		UNDERWATER IN FP REMOTE EXAMINATION
	FPC-245	BOX	F-A	F1.30A	VT-3		5		C	0		UNDERWATER IN FP REMOTE EXAMINATION

9.4.4 Weld and Component Diagrams

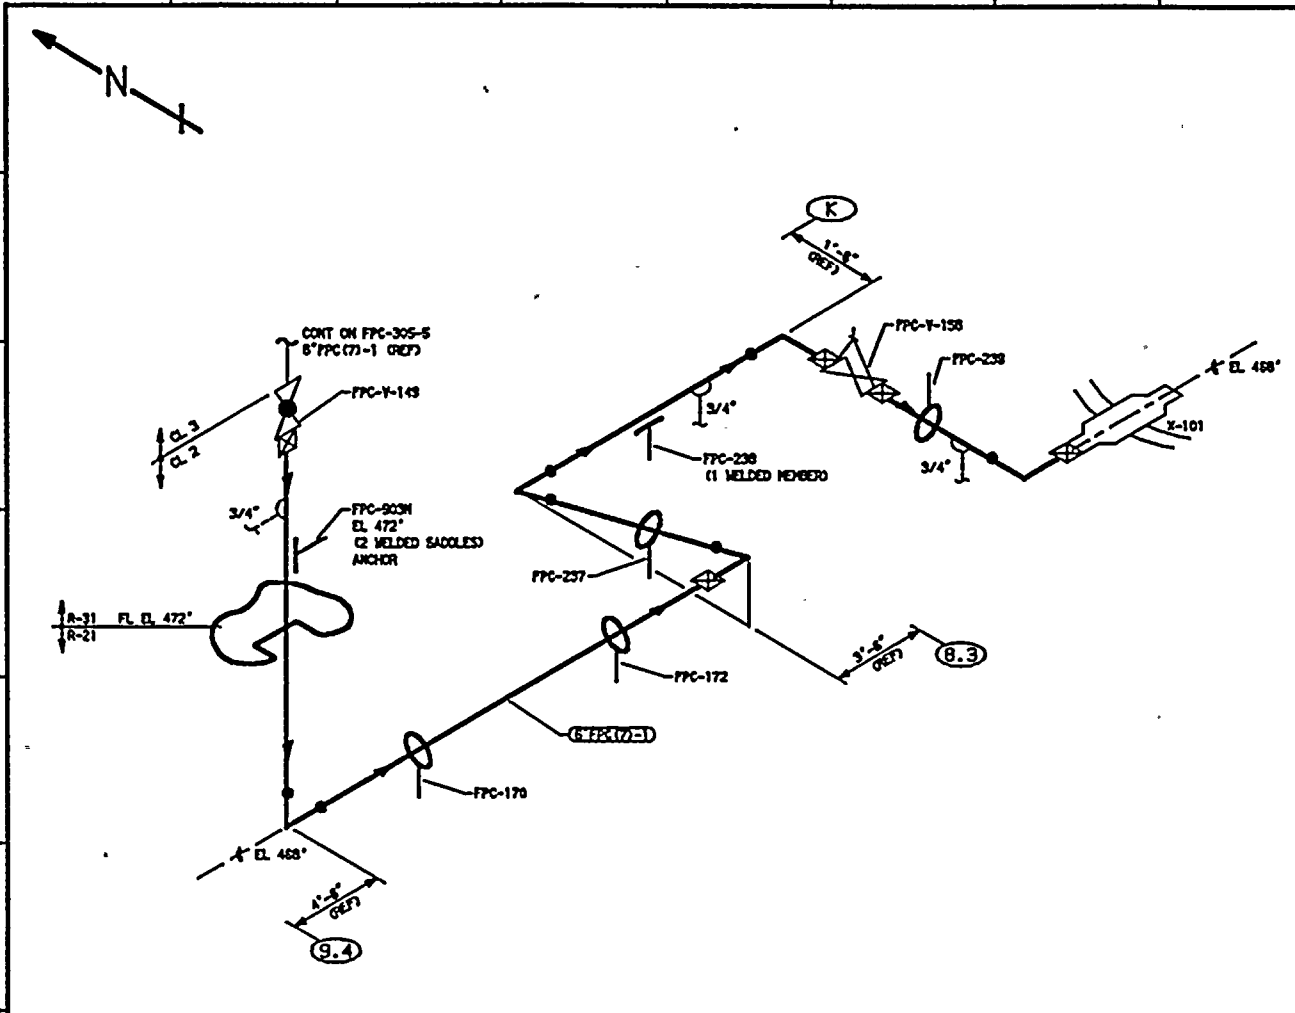

- NOTES:**
1. THIS DRAWING IDENTIFIES PIPING AND COMPONENTS SUBJECT TO A VISUAL EXAM FOR EVIDENCE OF LEAKAGE DURING SYSTEM HYDRO OR OPERABILITY TESTS. TESTS ARE TO BE CONDUCTED PER THE REQUIREMENTS OF ASME SECTION XI, PARAGRAPH 1XA-5000.
  2. FOR BRANCH PIPING 4" NOM. OR LESS (CONNECTION SHOWN IN DASHED LINES) EXTEND VISUAL LEAKAGE EXAM THROUGH THE OUTERMOST NORMALLY CLOSED NUCLEAR CLASS VALVE, OR UNTIL TRANSITION TO INSTRUMENT TUBING, UNLESS OTHERWISE NOTED.

**REFERENCES:**  
 ISI - 228-1A  
 BOYCE & CRILL ISOMETRIC  
 FPC-840-10.12 REV 8

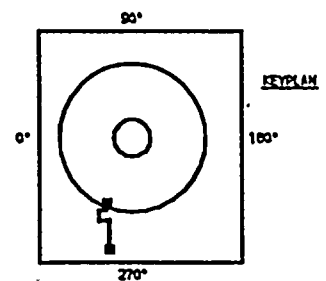

ZONES R-31 & R-21  
 THIS DRAWING IS INTENDED FOR  
 USE IN PRESERVICE AND INSERVICE  
 INSPECTIONS PROGRAMS ONLY.

QUALITY CLASS: 1	ASME CODE CLASS: 2
ENGR: K-MoANDREW	DATE: 4-23-78

**WASHINGTON PUBLIC POWER  
 SUPPLY SYSTEM**  
 RICHLAND, WASHINGTON POWER


PIPING SYSTEM	NOM DIA (IN)	SCH	NOM WALL THK	MATERIAL SPECIFICATION	MATL TYPE	CAL BLOCK NO
8" FPC (7)-1	8	STD	0.200	SA 106 GR B	CS	NA

WRP-2  
 WELD & COMPONENT  
 IDENTIFICATION DIAGRAM

NO	DATE	REVISION	BY	CHKD	APVD
2	10-16-87	GENERAL UPDATE, ADDED 3/4" CONN, REDRAWN	K-MoA	DPR	TTH
1	1-24-84	REVISED AS NOTED ADDED KEYPLAN	K-MoA	DPR	TTH
0	12-2-81	ISSUED FOR USE	K-MoA	DPR	TTH


TITLE:  
 FPC RETURN TO SUPPRESSION POOL

DWG NO: FPC-201      REV 2

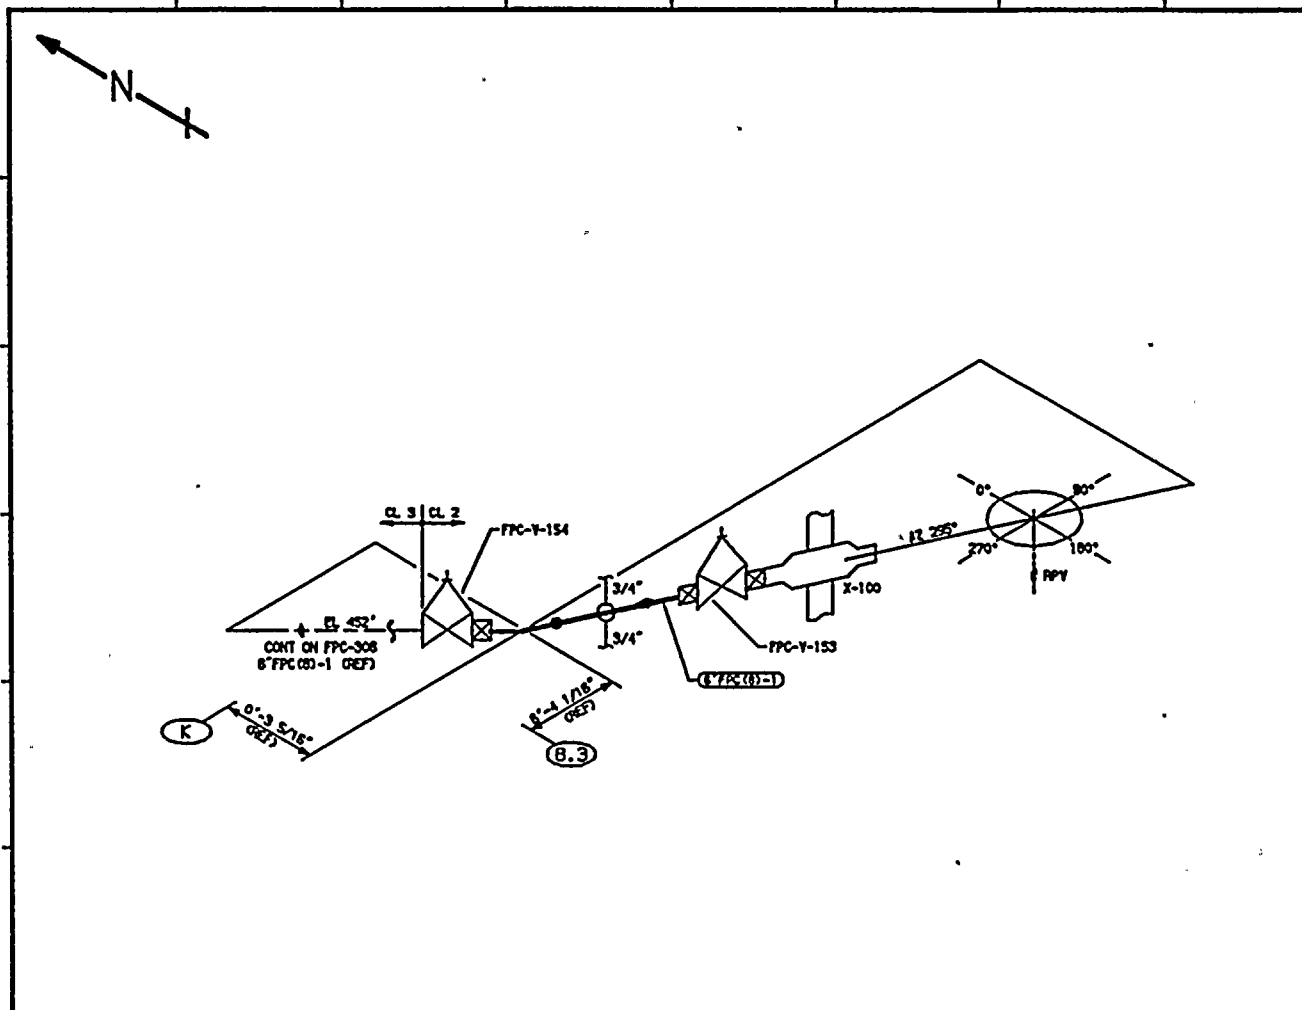

- NOTES:**
1. THIS DRAWING IDENTIFIES PIPING AND COMPONENTS SUBJECT TO A VISUAL EXAM FOR EVIDENCE OF LEAKAGE DURING SYSTEM HYDRO OR OPERABILITY TESTS. TESTS ARE TO BE CONDUCTED PER THE REQUIREMENTS OF ASME SECTION XI, PARAGRAPH 11A-5000.
  2. FOR BRANCH PIPING 4" NOM. OR LESS CONNECTION SHOWN IN DASHED LINES) EXTEND VISUAL LEAKAGE EXAM THROUGH THE OUTERMOST NORMALLY CLOSED NUCLEAR CLASS VALVE, OR UNTIL TRANSITION TO INSTRUMENT TUBING, UNLESS OTHERWISE NOTED.

**REFERENCES:**  
 151 - 226-1A  
 BOYCE & CRAIG ISOMETRIC  
 FPC-633-1.2 REV 11

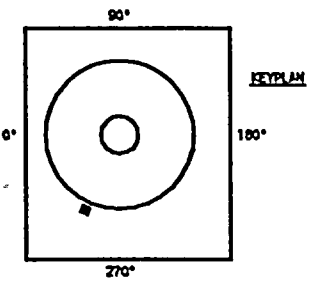

ZONE R-11  
 THIS DRAWING IS INTENDED FOR  
 USE IN PRESERVIVE AND ISOMETRIC  
 INSPECTIONS PROGRAMS ONLY.

QUALITY CLASS. 1 | ASME CODE CLASS. 2  
 ENGR. K-McANDREW | DRAWN: K-McA | DATE: 4-27-79

**WASHINGTON PUBLIC POWER  
 SUPPLY SYSTEM**  
 RICHLAND, WASHINGTON BECK


PIPING SYSTEM	NOM DIA (IN)	SCH	NOM WALL THK	MATERIAL SPECIFICATION	MATL TYPE	CAL. BLOCK NO
8" FPC (B)-1	8	STD	0.250	SA 106 GR B	CS	NA

WPP-2  
 WELD & COMPONENT  
 IDENTIFICATION DIAGRAM

TITLE:  
 SUPPRESSION POOL TO FPC-P-3 SUCTION

NO	DATE	REVISION	BY	CHKD	APVD
1	10-16-87	GENERAL UPDATE, ADDED KEYPLAN, REDRAWN	K-McA	DPR	TTH
0	12-2-81	ISSUED FOR USE	K-McA	DPR	TTH

DWG NO. FPC-202 | REV 1

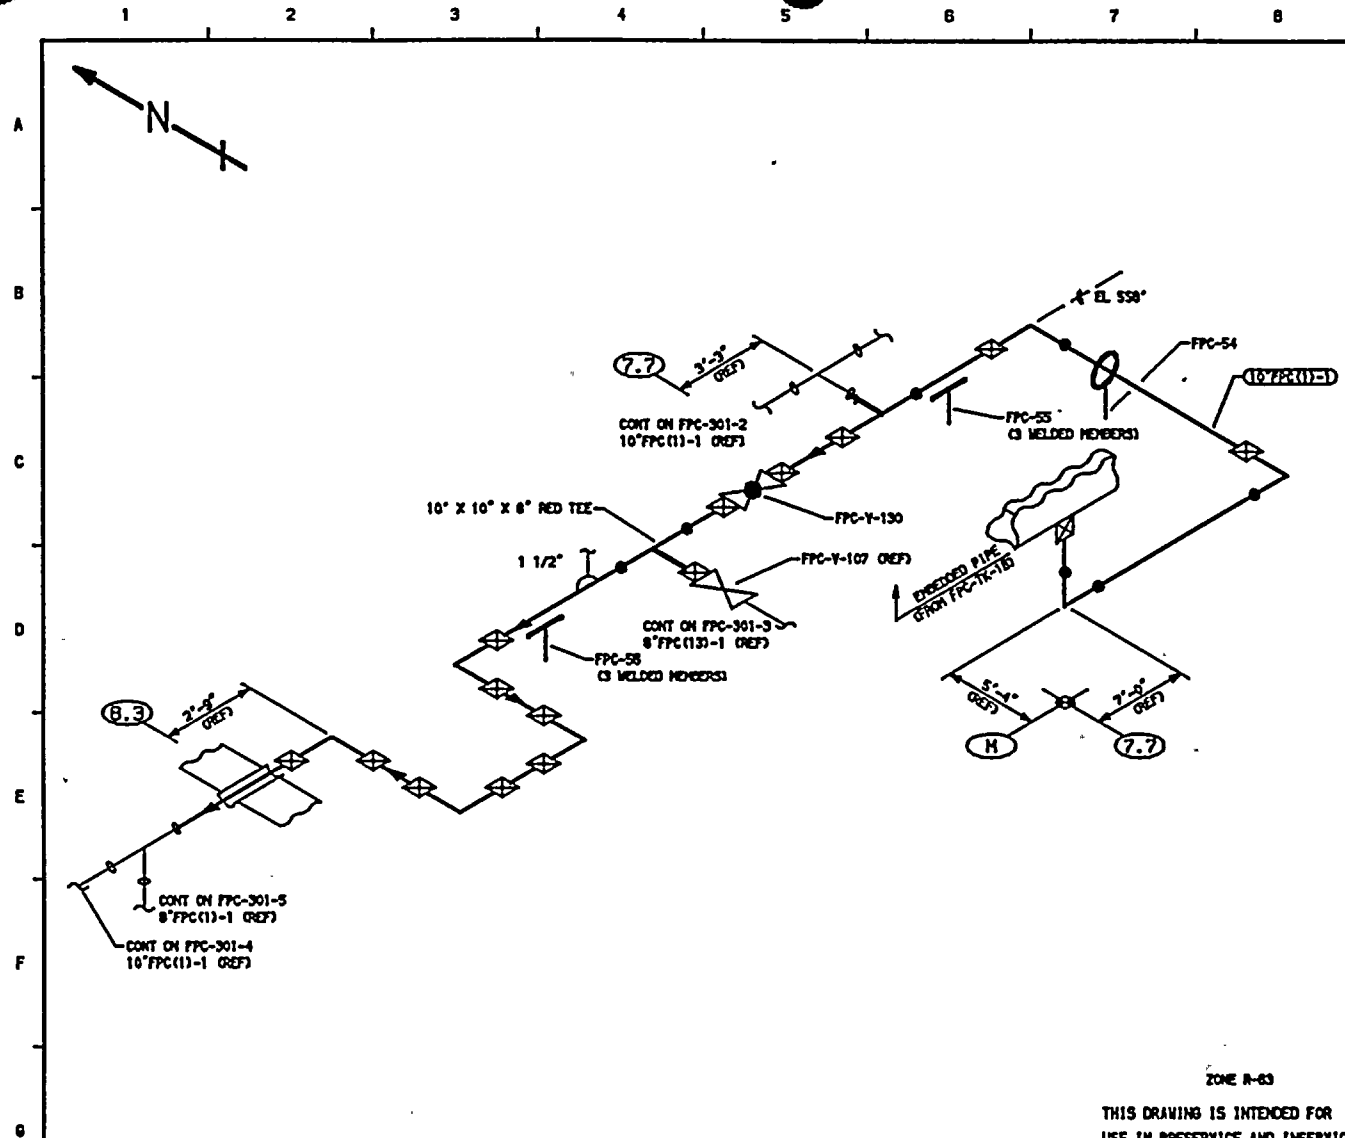


**NOTES:**

- THIS DRAWING IDENTIFIES PIPING AND COMPONENTS SUBJECT ONLY TO A VISUAL EXAM FOR (1) EVIDENCE OF LEAKAGE DURING SYSTEM PRESSURE OR OPERABILITY TESTS, (2) PRESSURE DECAY TESTS OF BURIED PIPING, AND (3) LOSS OF SUPPORT CAPABILITY OR INADEQUATE RESTRAINT FOR SUPPORTS AND HANGERS ON PIPING EXCEEDING 4" NOM. TESTS SHALL BE CONDUCTED PER ASME SECTION XI, ARTICLES 11A-5000 AND 11A-2000.

**REFERENCES:**

ISI - 228-1 & 228-1A  
 BOYCE & CRAIG ISOMETRIC  
 FPC-804-4, 6 REV 5

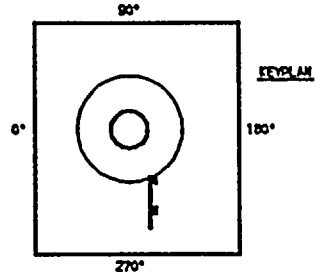

ZONE R-63  
 THIS DRAWING IS INTENDED FOR  
 USE IN PRESERVICE AND INSERVICE  
 INSPECTIONS PROGRAMS ONLY.

PIPING SYSTEM	NOM DIA (IN)	SCH	NOM WALL THK	MATERIAL SPECIFICATION	MATL TYPE	CAL BLOCK NO
10" FPC(11)-1	10	STD	0.365	SA 106 GR B	CS	NA

NO	DATE	REVISION	BY	CHKD	APVD
2	11-13-82	ADDED ONE LINE CONT & LOGAL. MODIFIED KEYPLAN & ISI OUR REFERENCE.	K-McA	DPR	DRY
1	1-24-84	GENERAL UPDATE REDRAWN	K-McA	DPR	TTH
0	12-2-81	ISSUED FOR USE	K-McA	DPR	TTH


QUALITY CLASS, 11	ASME CODE CLASS, 3
ENGR, K-McANDREW	DATE, 3-21-79

**WASHINGTON PUBLIC POWER  
 SUPPLY SYSTEM**  
 RICHLAND, WASHINGTON 99352

WPP-2  
 WELD & COMPONENT  
 IDENTIFICATION DIAGRAM

TITLE:  
 FUEL POOL CIRCULATION FROM FPC-TK-1B

DWG NO. FPC-301-1      REV 2

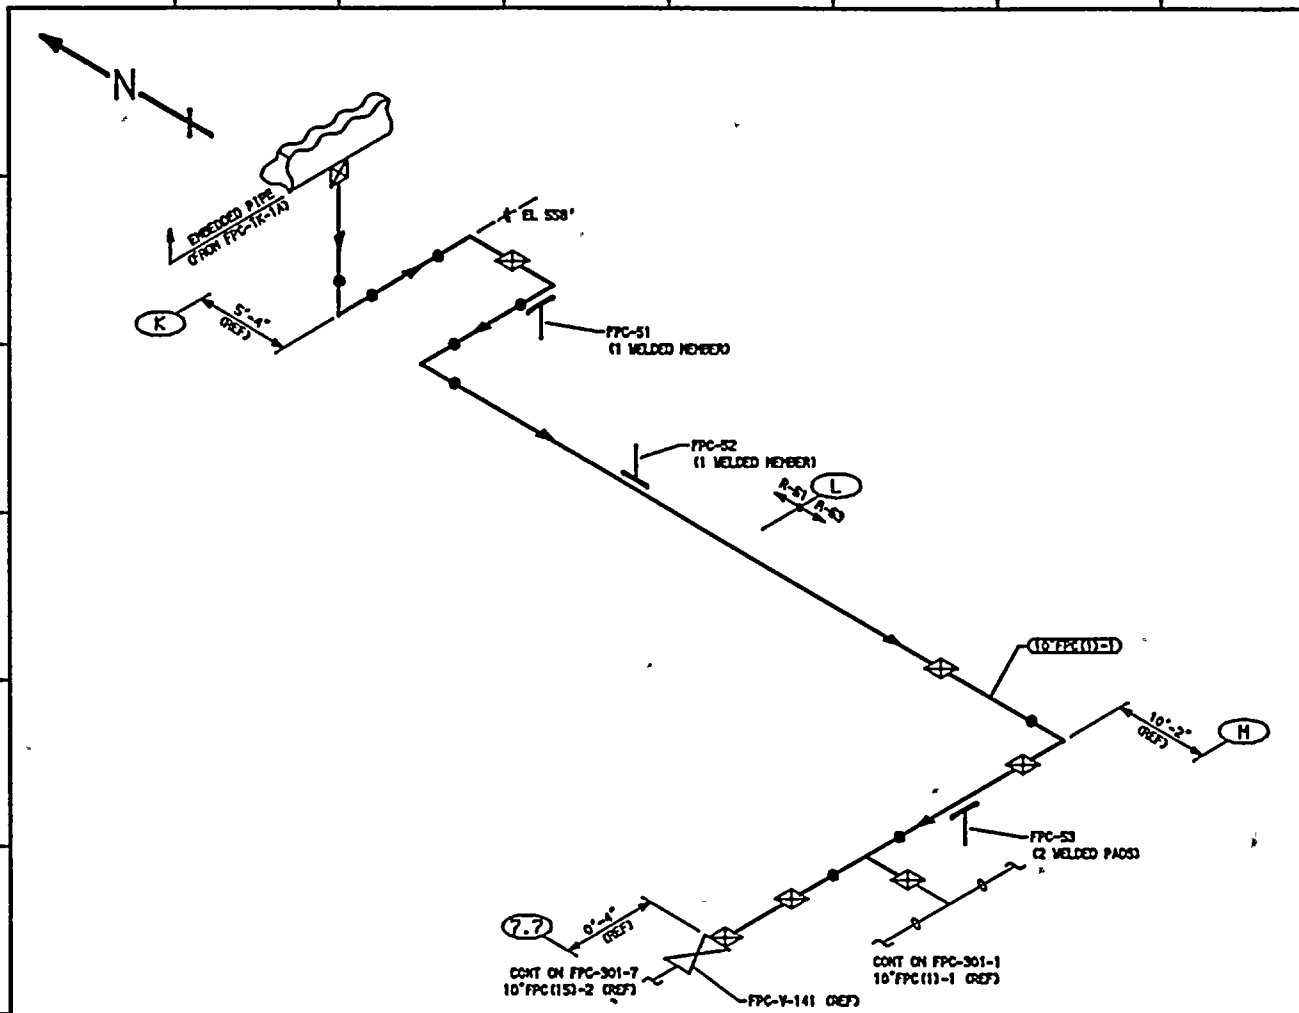


**NOTES:**

1. THIS DRAWING IDENTIFIES PIPING AND COMPONENTS SUBJECT ONLY TO A VISUAL EXAM FOR (1) EVIDENCE OF LEAKAGE DURING SYSTEM PRESSURE OR OPENABILITY TESTS, (2) PRESSURE DECAY TESTS OF BURIED PIPING, AND (3) LOSS OF SUPPORT CAPABILITY OR INADEQUATE RESTRAINT FOR SUPPORTS AND HANGERS ON PIPING EXCEEDING 4" NOM. TESTS SHALL BE CONDUCTED PER ASME SECTION XI, ARTICLES IMA-5000 AND IMA-2000.

**REFERENCES:**

151 - 228-1  
 BOYCE & CRAIG ISOMETRIC  
 FPC-804-1.3 REV B

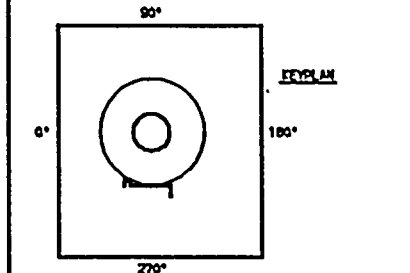

ZONES R-01 & R-03  
 THIS DRAWING IS INTENDED FOR  
 USE IN PRESERVICE AND INSERVICE  
 INSPECTIONS PROGRAMS ONLY.

QUALITY CLASS, II ASME CODE CLASS, 3  
 ENGR. K-McANDREW DRAWN. K-McA DATE. 3-22-79

WASHINGTON PUBLIC POWER  
 SUPPLY SYSTEM  
 RICHLAND, WASHINGTON 99352


PIPING SYSTEM	NOM DIA (INO)	SCH	NOM WALL THK	MATERIAL SPECIFICATION	MATL TYPE	CAL BLOCK NO
10" FPC (11)-1	10	STD	0.365	SA 106 GR B	CS	NA

NO	DATE	REVISION	BY	CHKD	APPD
2	11-13-82	ADDED 151 DRAWING REFERENCE & DRAWING LINE CONTINUATION, MODIFIED KEYPLAN & LOGO, RECDRAW	K-McA	DPR	DRW
1	1-24-84	REVISED AS NOTED, ADDED KEYPLAN	K-McA	DPR	TFH
0	12-2-81	ISSUED FOR USE	K-McA	DPR	TFH

WPP-2  
 WELD & COMPONENT  
 IDENTIFICATION DIAGRAM


TITLE:  
 FUEL POOL CIRCULATION FROM FPC-TK-1A

DWG NO. FPC-301-2 REV 2

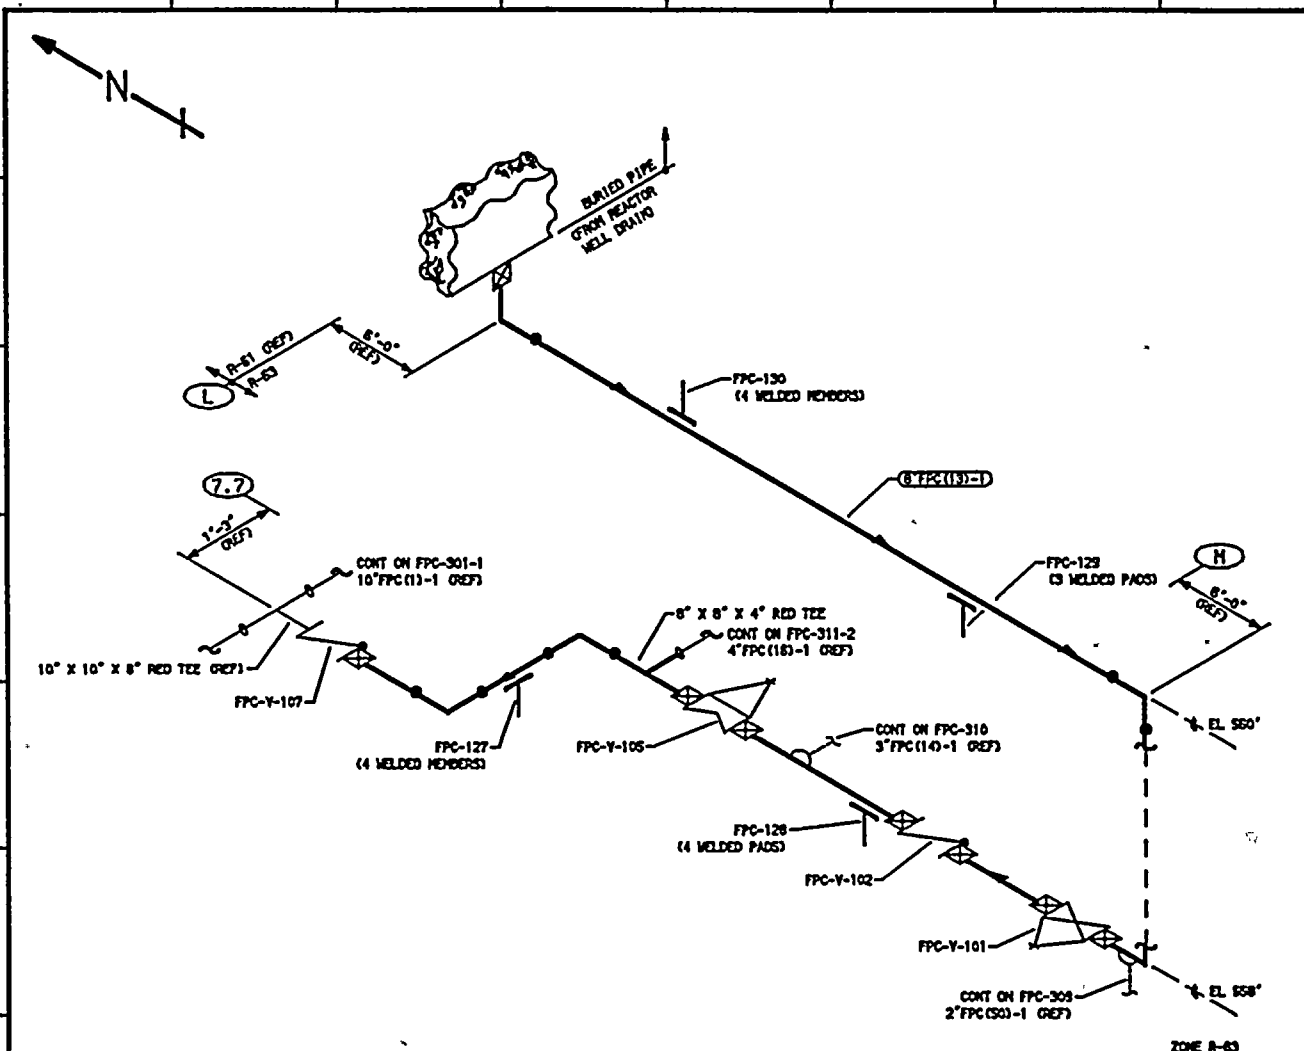

- NOTES:**
1. THIS DRAWING IDENTIFIES PIPING AND COMPONENTS SUBJECT ONLY TO A VISUAL EXAM FOR (1) EVIDENCE OF LEAKAGE DURING SYSTEM PRESSURE OR OPERABILITY TESTS; (2) PRESSURE DECAY TESTS OF BURIED PIPING; AND (3) LOSS OF SUPPORT CAPABILITY OR INADEQUATE RESTRAINT FOR SUPPORTS AND HANGERS ON PIPING EXCEEDING 4" NOM. TESTS SHALL BE CONDUCTED PER ASME SECTION XI, ARTICLES 1WA-5000 AND 1W-2000.
  2. FOR BRANCH PIPING 4" NOM. OR LESS (CONNECTION SHOWN IN DASHED LINES) EXTEND VISUAL LEAKAGE EXAM THROUGH THE OUTERMOST NORMALLY CLOSED NUCLEAR CLASS VALVE, OR UNTIL TRANSITION TO INSTRUMENT TUBING, UNLESS OTHERWISE NOTED.

**REFERENCES:**  
 151 - 226-1  
 BOYCE & CRILL ISOMETRIC  
 FPC-600-1.4 REV B

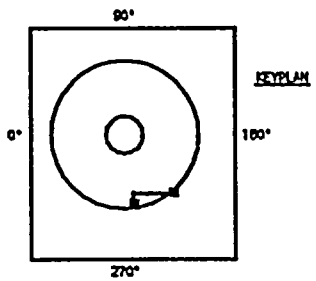

QUALITY CLASS: 2 | ASME CODE CLASS: 3  
 ENGR: K-MoANDREW | DRAIN: K-MoA | DATE: 3-22-79

WASHINGTON PUBLIC POWER  
 SUPPLY SYSTEM  
 RICHLAND, WASHINGTON 99352

MP-2  
 WELD & COMPONENT  
 IDENTIFICATION DIAGRAM

TITLE:  
 FUEL POOL CIRCULATION FROM REACTOR WELL DRAIN

DWG NO: FPC-301-3 | REV 2


THIS DRAWING IS EXTENDED FOR  
 USE IN PRESERVICE AND INSERVICE  
 INSPECTIONS PROGRAMS ONLY.

PIPING SYSTEM	NOM DIA (IN)	SCH	NOM WALL THK	MATERIAL SPECIFICATION	MATL TYPE	CAL BLOCK NO
8" FPC (113)-1	8	STD	0.322	SA 108 GR B	CS	NA

NO	DATE	REVISION	BY	CHKD	APVD
2	10-16-87	GENERAL UPDATE, ADDED DWG CONT, REDRAWN	K-MoA	DPR	TPH
1	1-24-84	REVISED AS NOTED ADDED KEYPLAN	K-MoA	DPR	TPH
0	12-2-81	ISSUED FOR USE	K-MoA	DPR	TPH





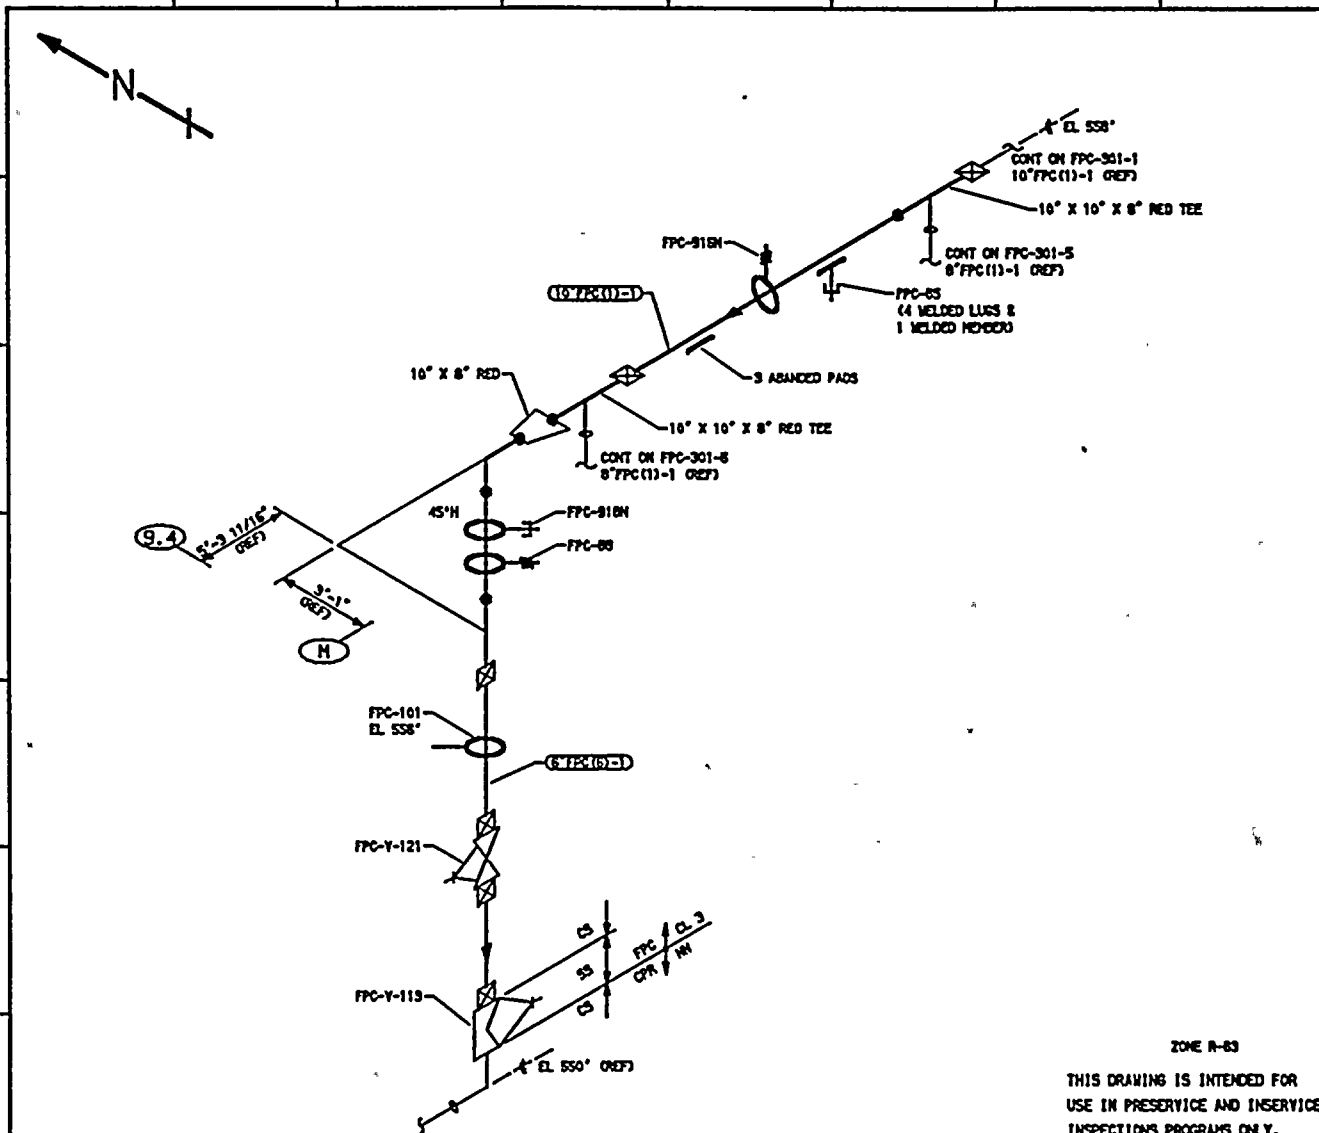


**NOTES:**

1. THIS DRAWING IDENTIFIES PIPING AND COMPONENTS SUBJECT ONLY TO A VISUAL EXAM FOR (1) EVIDENCE OF LEAKAGE DURING SYSTEM PRESSURE OR OPERABILITY TESTS, (2) PRESSURE DECAY TESTS OF BURIED PIPING, AND (3) LOSS OF SUPPORT CAPABILITY OR INADEQUATE RESTRAINT FOR SUPPORTS AND HANGERS ON PIPING EXCEEDING 4" NOM. TESTS SHALL BE CONDUCTED PER ASME SECTION XI, ARTICLES IMA-5000 AND IMA-2000.

**REFERENCES:**

ISI - 228-1A  
 BOYCE & CRAIG ISOMETRICS  
 FPC-804-7.9 REV B

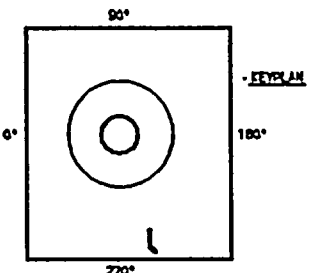

ZONE R-83  
 THIS DRAWING IS INTENDED FOR  
 USE IN PRESERVICE AND INSERVICE  
 INSPECTIONS PROGRAMS ONLY.

PIPING SYSTEM	NOM DIA (IN)	SCH	NOM WALL THK	MATERIAL SPECIFICATION	MATL TYPE	CAL BLOCK NO
8" FPC 03-1	8	STD	0.280	SA 106 GR B	CS	NA
10" FPC (11)-1	10	STD	0.365	SA 106 GR B	CS	NA

NO	DATE	REVISION	BY	CHKD	APVD
2	11-13-82	ADDED ISI DRAWING REFERENCE & DRAWING LINE CONTINUATION, MODIFIED KEYPLAN & LEGEND, REVISION	K-McA	DPR	DRV
1	1-24-84	REVISED AS NOTED. ADDED KEYPLAN	K-McA	DPR	TFH
0	12-2-81	ISSUED FOR USE	K-McA	DPR	TFH

QUALITY CLASS: 11	ASME CODE CLASS: 3
ENGR: K-McANDREW	DRWN: K-McA DATE: 3-22-79


WASHINGTON PUBLIC POWER  
 SUPPLY SYSTEM  
 R10LAND, WASHINGTON 98302

MNP-2  
 WELD & COMPONENT  
 IDENTIFICATION DIAGRAM

TITLE:  
 FUEL POOL CIRCULATION TO FPC-P-1A & 1B


DWG NO. FPC-301-4  
 REV 2



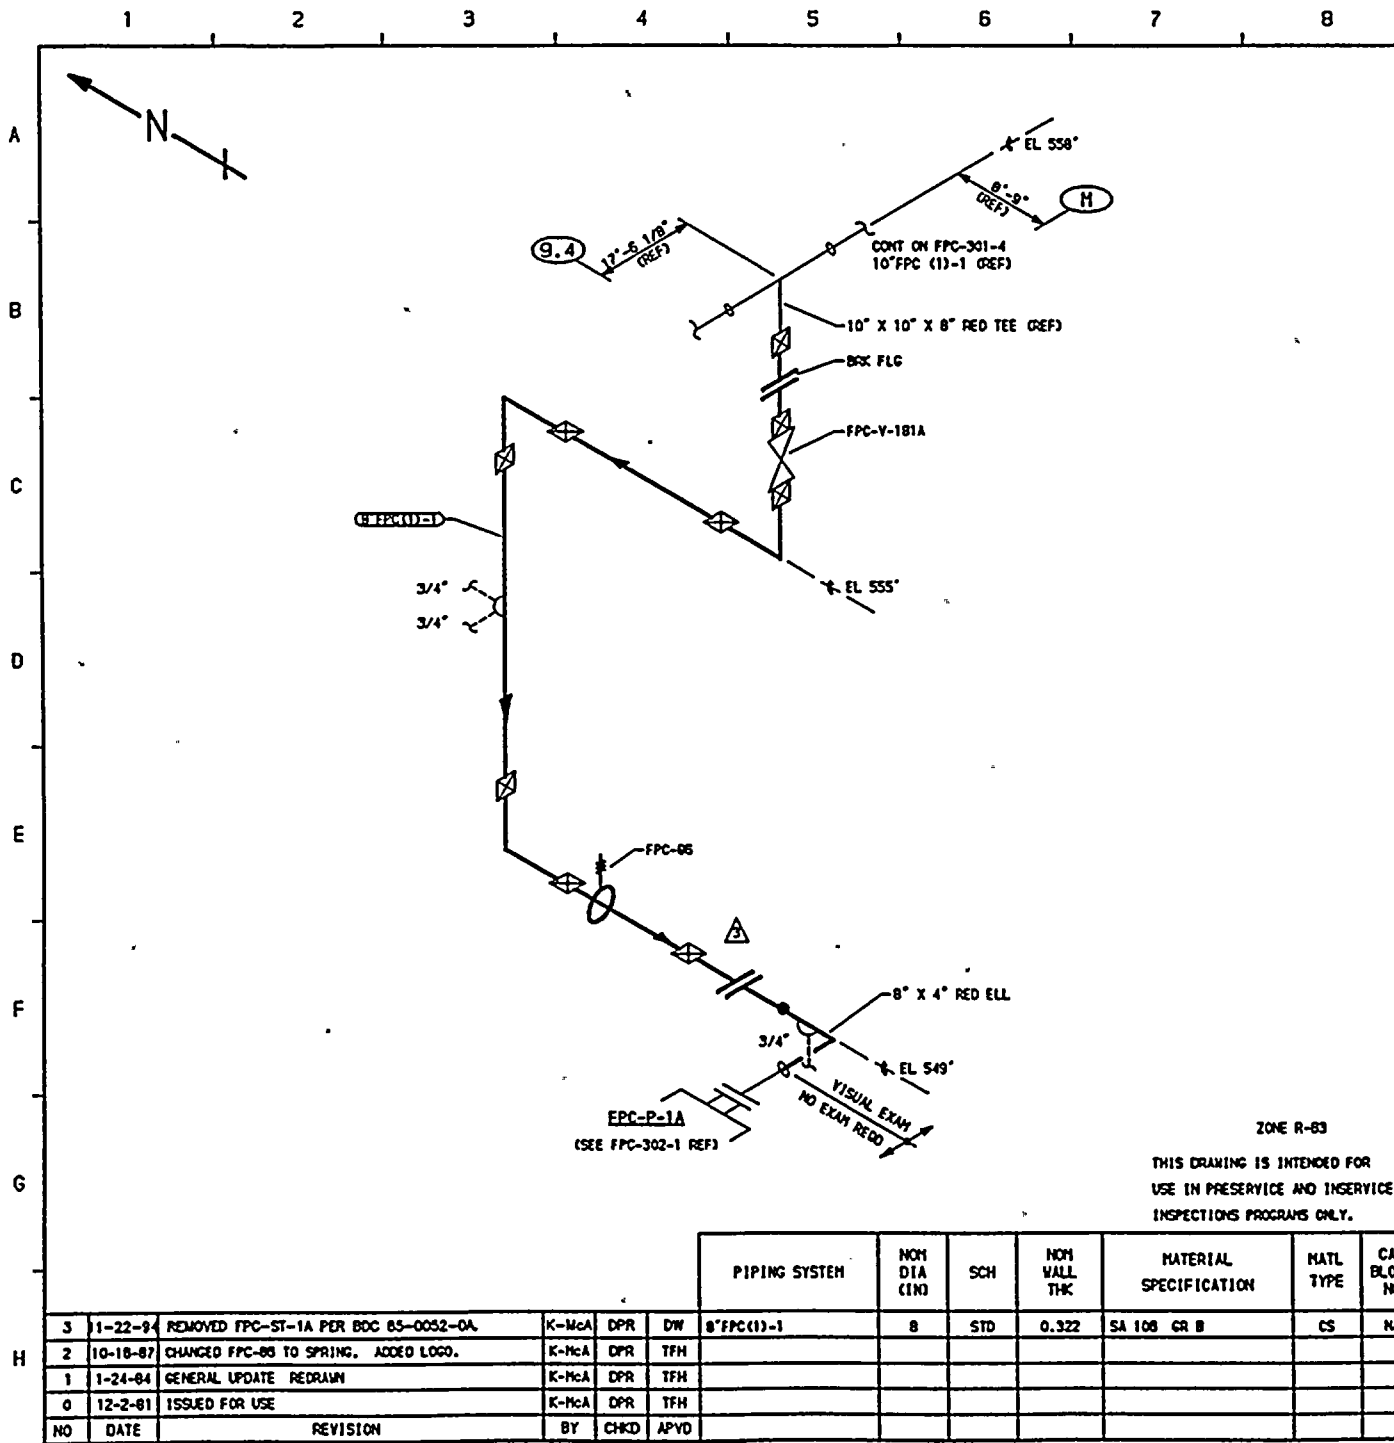

- NOTES:**
1. THIS DRAWING IDENTIFIES PIPING AND COMPONENTS SUBJECT ONLY TO A VISUAL EXAM FOR (1) EVIDENCE OF LEAKAGE DURING SYSTEM PRESSURE OR OPERABILITY TESTS; (2) PRESSURE DECAY TESTS OF BURIED PIPING; AND (3) LOSS OF SUPPORT CAPABILITY OR INADEQUATE RESTRAINT FOR SUPPORTS AND HANGERS ON PIPING EXCEEDING 4" NOM. TESTS SHALL BE CONDUCTED PER ASME SECTION XI, ARTICLES 1NA-5000 AND 1ND-2000.
  2. FOR BRANCH PIPING 4" NOM. OR LESS (CONNECTION SHOWN IN DASHED LINES) EXTEND VISUAL LEAKAGE EXAM THROUGH THE OUTERMOST NORMALLY CLOSED NUCLEAR CLASS VALVE, OR UNTIL TRANSITION TO INSTRUMENT TUBING, UNLESS OTHERWISE NOTED.
  3. EXTEND VISUAL LEAKAGE EXAM THROUGH FPC-P-1A DRAIN PIPING TO FPC-V-150A.

**REFERENCES:**  
 ISI - 225-1A  
 BOYEE & CRAIG ISOMETRIC  
 FPC-804-10.12 REV 11

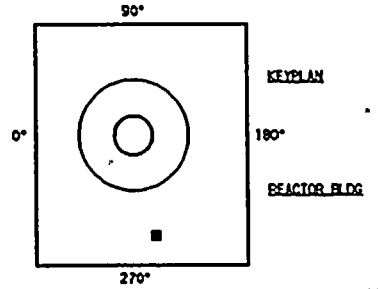

ZONE R-83  
 THIS DRAWING IS INTENDED FOR USE IN PRESERVICE AND INSERVICE INSPECTIONS PROGRAMS ONLY.

QUALITY CLASS, 2	ASME CODE CLASS, 3
ENGR, K-McANDREW	DRAWN, K-McA DATE, 3-23-79

WASHINGTON PUBLIC POWER  
**SUPPLY SYSTEM**  
 RICHLAND, WASHINGTON 99352

WPP-2  
 WELD & COMPONENT  
 IDENTIFICATION DIAGRAM

TITLE:	FPC-P-1A SECTION FROM FPC-TK-1A & 1B, REACTOR WELL DRAIN
DWG NO.	FPC-301-5
REV	3


	PIPING SYSTEM	NOM DIA (IN)	SCH	NOM WALL THK	MATERIAL SPECIFICATION	NATL TYPE	CAL BLOCK NO
3	8" FPC(1)-1	8	STD	0.322	SA 106 GR B	CS	NA

NO	DATE	REVISION	BY	CHKD	APVD
3	11-22-94	REMOVED FPC-ST-1A PER BOC 85-0052-0A.	K-McA	DPR	DW
2	10-18-87	CHANGED FPC-S8 TO SPRING. ADDED LOGO.	K-McA	DPR	TFH
1	1-24-84	GENERAL UPDATE REDRAIN	K-McA	DPR	TFH
0	12-2-81	ISSUED FOR USE	K-McA	DPR	TFH



1 2 3 4 5 6 7 8 9 10

A  
B  
C  
D  
E  
F  
G  
H

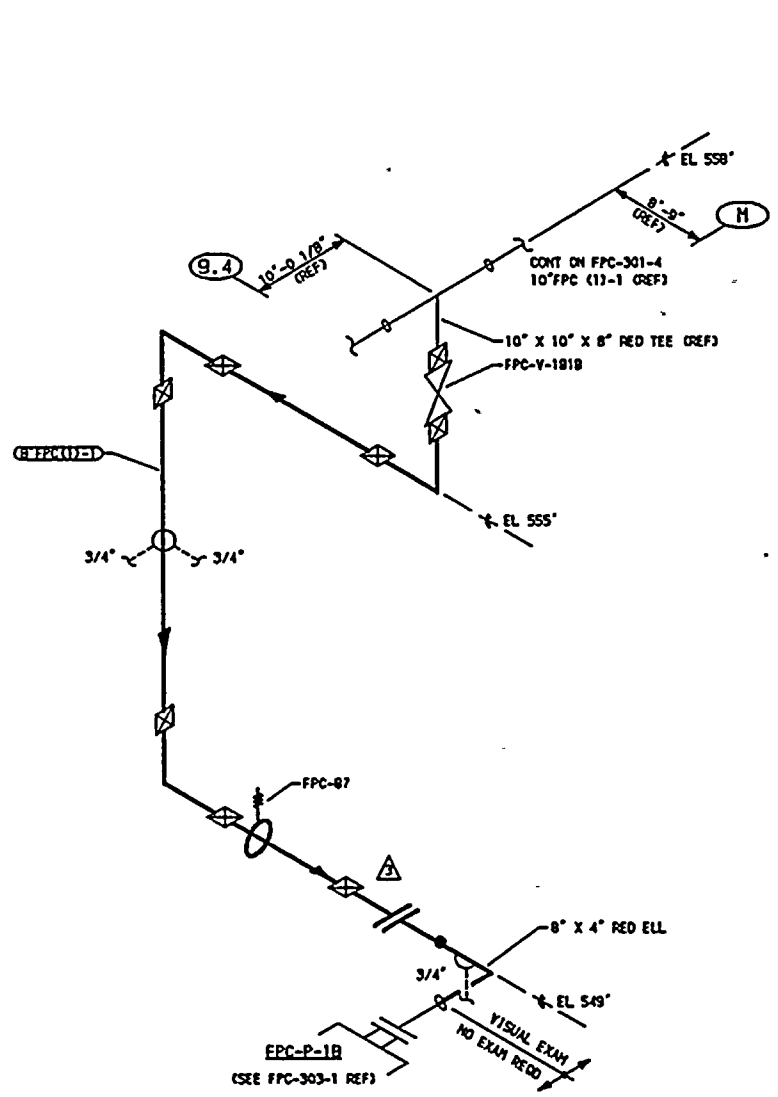

ZONE R-83


THIS DRAWING IS INTENDED FOR  
USE IN PRESERVICE AND INSERVICE  
INSPECTIONS PROGRAMS ONLY.

**NOTES.**

1. THIS DRAWING IDENTIFIES PIPING AND COMPONENTS SUBJECT ONLY TO A VISUAL EXAM FOR (1) EVIDENCE OF LEAKAGE DURING SYSTEM PRESSURE OR OPERABILITY TESTS, (2) PRESSURE DECAY TESTS OF BURIED PIPING, AND (3) LOSS OF SUPPORT CAPABILITY OR INADEQUATE RESTRAINT FOR SUPPORTS AND HANGERS ON PIPING EXCEEDING 4" NOM. TESTS SHALL BE CONDUCTED PER ASME SECTION XI, ARTICLES 1WA-5000 AND 1ND-2000.
2. FOR BRANCH PIPING 4" NOM. OR LESS (CONNECTION SHOWN IN DASHED LINES) EXTEND VISUAL LEAKAGE EXAM THROUGH THE OUTERMOST NORMALLY CLOSED NUCLEAR CLASS VALVE, OR UNTIL TRANSITION TO INSTRUMENT TUBING, UNLESS OTHERWISE NOTED.
3. EXTEND VISUAL LEAKAGE EXAM THROUGH FPC-P-1B DRAIN PIPING TO FPC-Y-150B.

**REFERENCES.**

- ISI - 226-1A
- BOYEE & CRAIL ISOMETRIC  
FPC-804-14.17 REV 13

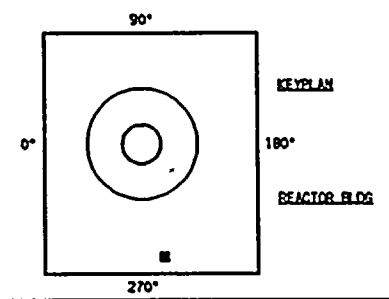


QUALITY CLASS, 2	ASME CODE CLASS, 3
ENGR, K-McANDREW	DATE, 3-23-79

WASHINGTON PUBLIC POWER  
**SUPPLY SYSTEM**  
RICHLAND, WASHINGTON 99352

WNP-2  
WELD & COMPONENT  
IDENTIFICATION DIAGRAM

TITLE,	FPC-P-1B SUCTION FROM FPC-TK-1A & 1B, REACTOR WELL DRAIN
DWG NO. FPC-301-B	REV 3

NO	DATE	REVISION	BY	CHKD	APVD	PIPING SYSTEM	NOM OIA (IN)	SCH	NOM WALL THK	MATERIAL SPECIFICATION	MATL TYPE	CAL BLOCK NO
3	11-22-84	REMOVED FPC-ST-1B PER BDC 85-0052-0A.	K-McA	DPR	DW	8" FPC(1)-1	8	STD	0.322	SA 106 GR B	CS	NA
2	10-18-87	CHANGED FPC-87 TO SPRING. ADDED LOGO.	K-McA	DPR	TFH							
1	1-24-84	GENERAL UPDATE REDRAWN	K-McA	DPR	TFH							
0	12-2-81	ISSUED FOR USE	K-McA	DPR	TFH							

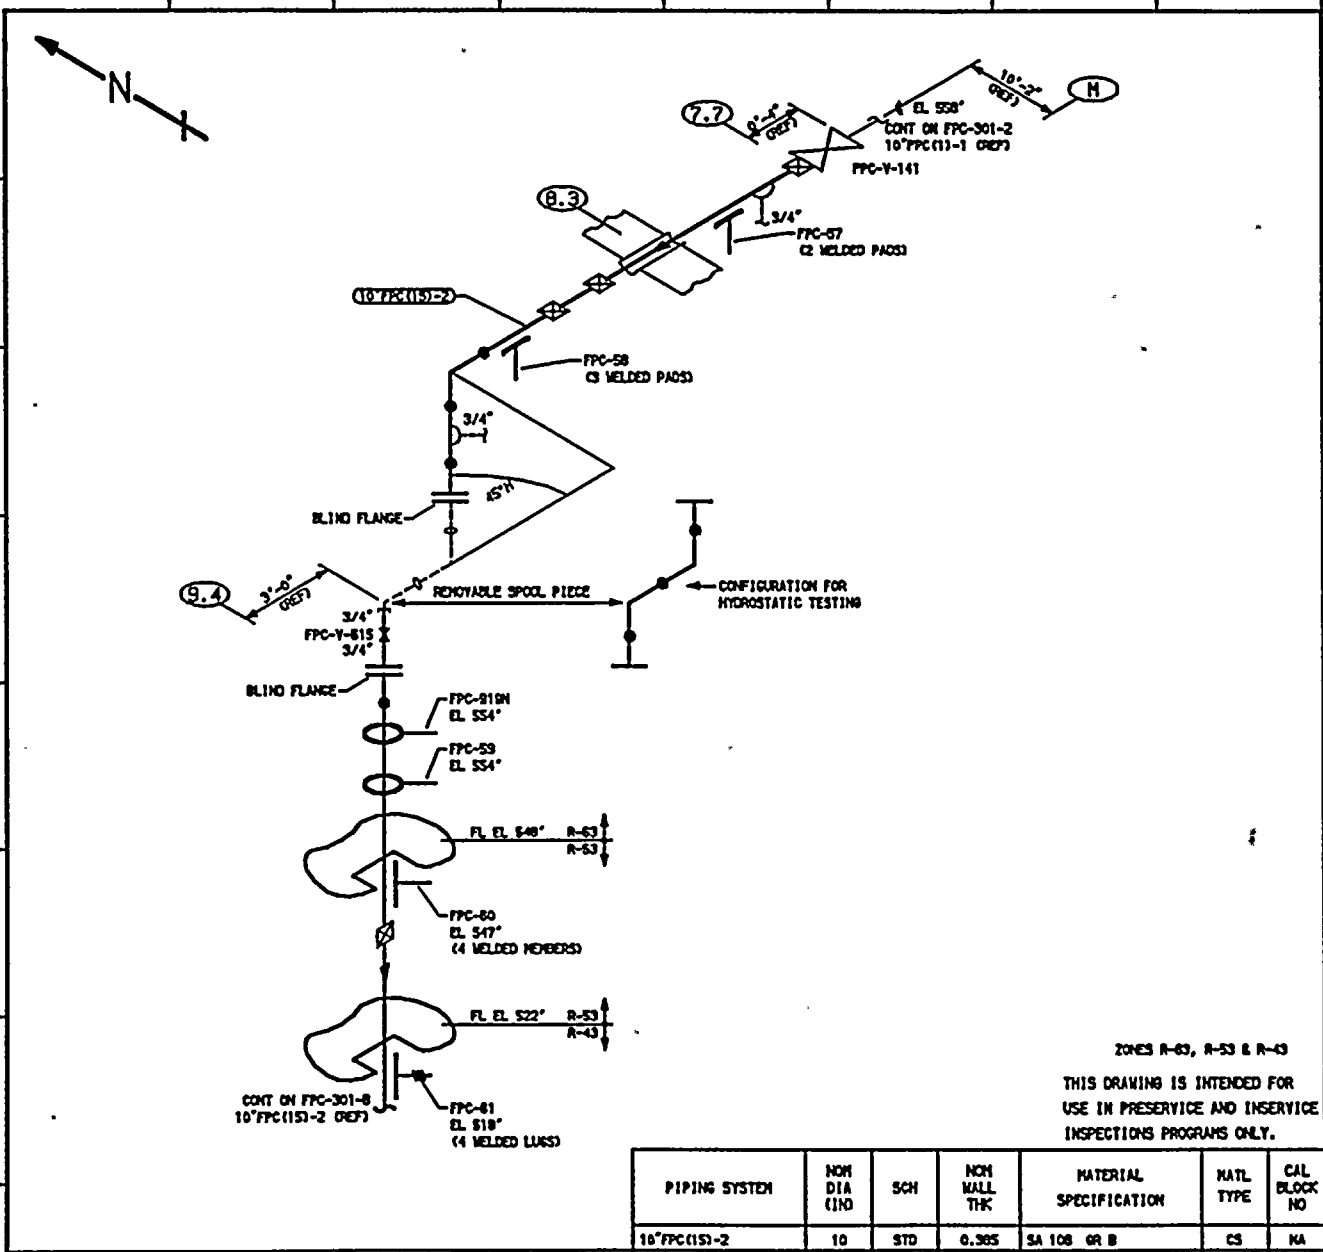


**NOTES:**

1. THIS DRAWING IDENTIFIES PIPING AND COMPONENTS SUBJECT ONLY TO A VISUAL EXAM FOR (1) EVIDENCE OF LEAKAGE DURING SYSTEM PRESSURE OR OPERABILITY TESTS; (2) PRESSURE DECAY TESTS OF BURIED PIPING; AND (3) LOSS OF SUPPORT CAPABILITY OR INADEQUATE RESTRAINT FOR SUPPORTS AND HANGERS ON PIPING EXCEEDING 4" NOM. TESTS SHALL BE CONDUCTED PER ASME SECTION XI, ARTICLES IWA-5000 AND IWD-2000.

**REFERENCES:**

ISI - 226-1  
 BOYCE & CRAIG ISOMETRICS  
 FPC-805-1.4 REV B  
 FPC-805-5.8 REV S

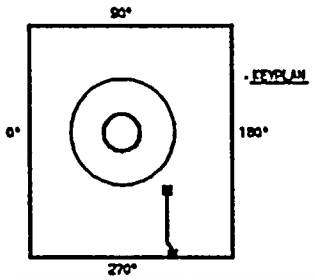

ZONES R-63, R-53 & R-43  
 THIS DRAWING IS INTENDED FOR USE IN PRESERVICE AND INSERVICE INSPECTIONS PROGRAMS ONLY.

PIPING SYSTEM	NOM DIA (IN)	SCH	NOM WALL THK	MATERIAL SPECIFICATION	MATL TYPE	CAL BLOCK NO
10" FPC (15)-2	10	STD	0.305	SA 106 GR B	CS	NA

NO	DATE	REVISION	BY	CHKD	APVD
2	11-13-82	ADDED ISI DRAWING REFERENCE & DRAWING LINE CONTINUATION, MODIFIED KEY PLAN & LOGS, REVISION	K-McA	DPR	DRV
1	1-24-84	GENERAL UPDATE	K-McA	DPR	TTH
0	12-2-81	ISSUED FOR USE	K-McA	DPR	TTH

QUALITY CLASS, II | ASME CODE CLASS, 3  
 ENGR, K-McANDREWM | DRAWN, K-McA | DATE, 4-5-79




WASHINGTON PUBLIC POWER  
 SUPPLY SYSTEM  
 RIALAND, WASHINGTON 98352

MFP-2  
 WELD & COMPONENT IDENTIFICATION DIAGRAM

TITLE:  
 FPC INTERTIE RFR-P-2A SUCTION

DWG NO. FPC-301-7 | REV 2



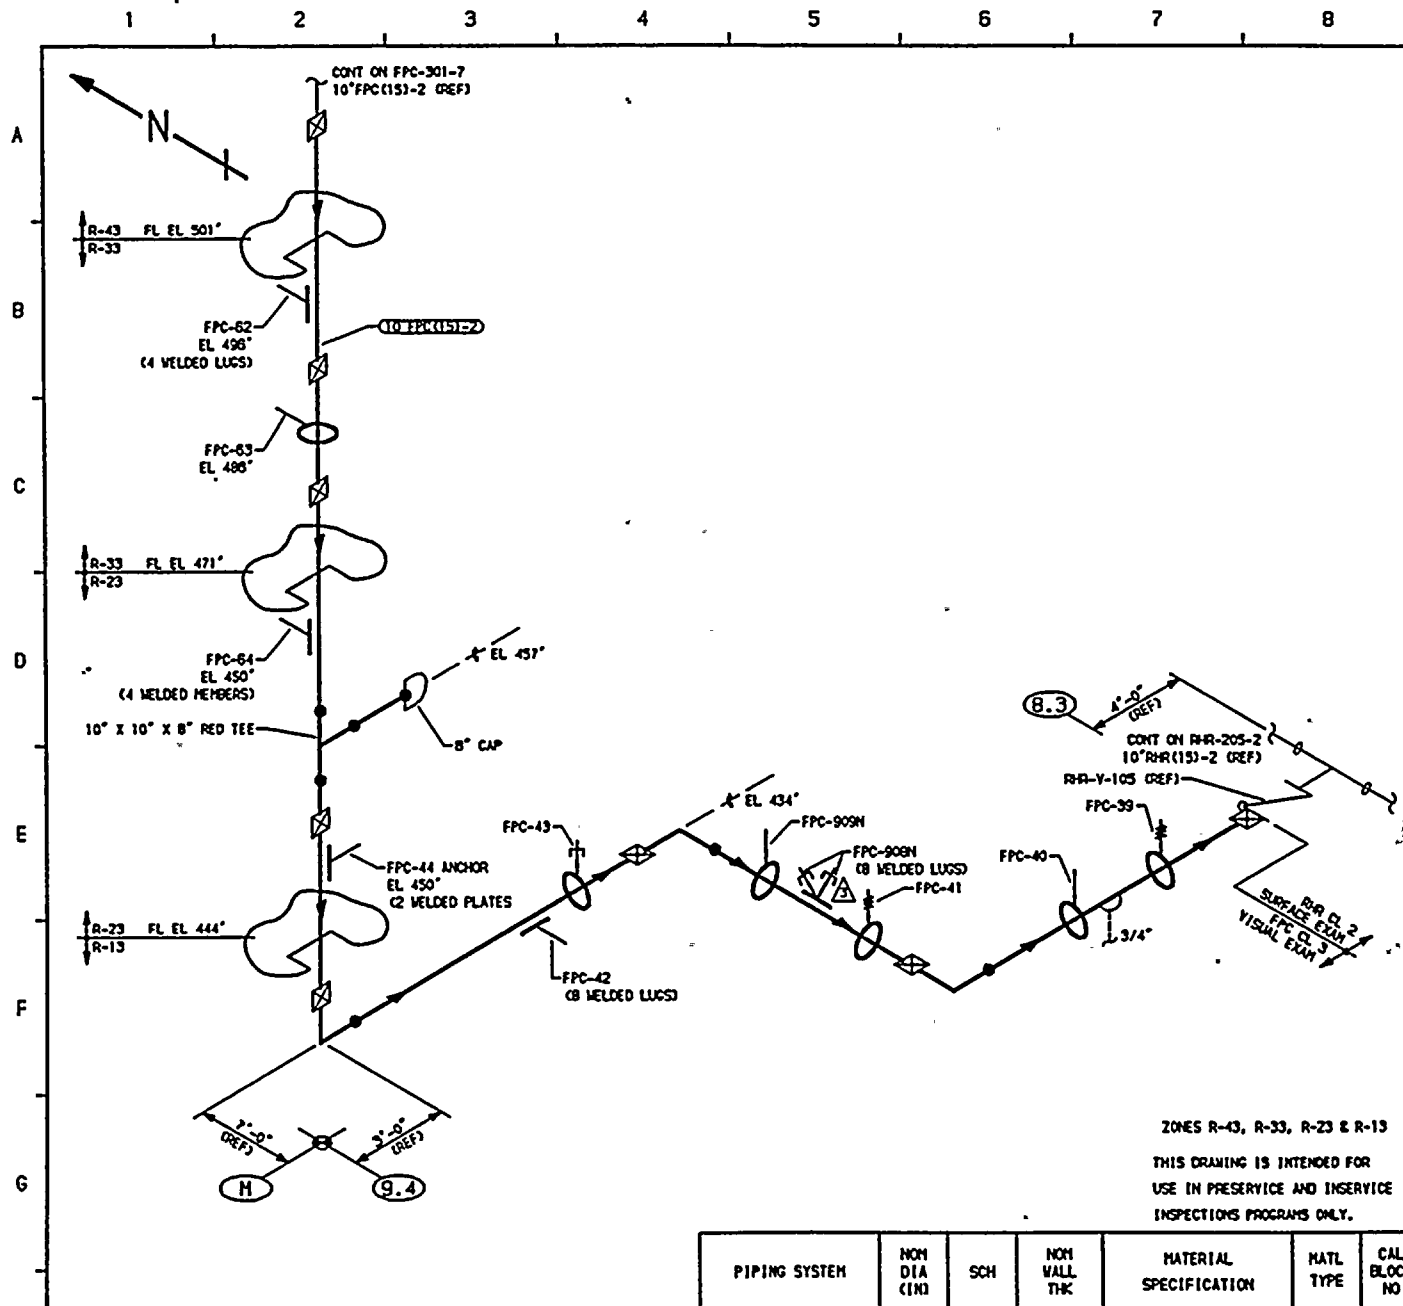


**NOTES:**

1. THIS DRAWING IDENTIFIES PIPING AND COMPONENTS SUBJECT ONLY TO A VISUAL EXAM FOR (1) EVIDENCE OF LEAKAGE DURING SYSTEM PRESSURE OR OPERABILITY TESTS; (2) PRESSURE DECAY TESTS OF BURIED PIPING; AND (3) LOSS OF SUPPORT CAPABILITY OR INADEQUATE RESTRAINT FOR SUPPORTS AND HANGERS ON PIPING EXCEEDING 4" NOM. TESTS SHALL BE CONDUCTED PER ASME SECTION XI, ARTICLES INA-5000 AND IND-2000.

**REFERENCES:**

ISI - 221-1  
 BOYEE & GRILL ISOMETRICS  
 FPC-605-5.9 REV 5  
 FPC-605-10.12 REV 6

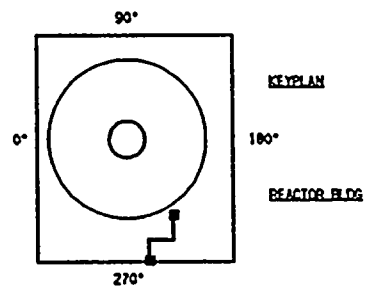

ZONES R-43, R-33, R-23 & R-13  
 THIS DRAWING IS INTENDED FOR USE IN PRESERVICE AND INSERVICE INSPECTIONS PROGRAMS ONLY.

QUALITY CLASS: 2 | ASME CODE CLASS: 3  
 ENGR: K-McANDREW | DRAWN: K-McA | DATE: 4-6-79

WASHINGTON PUBLIC POWER  
**SUPPLY SYSTEM**  
 RICHLAND, WASHINGTON 99352


WNP-2  
 WELD & COMPONENT  
 IDENTIFICATION DIAGRAM

TITLE:  
 FPC INTERTIE RHR-P-2A SUCTION

DWG NO. **FPC-301-B** | REV 3


NO	DATE	REVISION	BY	CHKD	APVD	PIPING SYSTEM	NOM DIA (IN)	SCH	NOM WALL THK	MATERIAL SPECIFICATION	MATL TYPE	CAL BLOCK NO
3	1-22-84	MODIFIED FPC-909H	K-McA	DPR	DW	10" FPC(15)-2	10	STD	0.385	SA 106 GR B	CS	NA
2	10-18-87	CHG FPC-41 TO SPWTH, FPC-42 TO BIFID & FPC-43 TO BRNDR. ACCED 1E1 DNG REF, LINE CONT & LOSS. NO KEYPLAN, REGRM.	K-McA	DPR	TFH							
1	1-24-84	REVISED AS NOTED ACCED KEYPLAN	K-McA	DPR	TFH							
0	12-2-81	ISSUED FOR USE	K-McA	DPR	TFH							



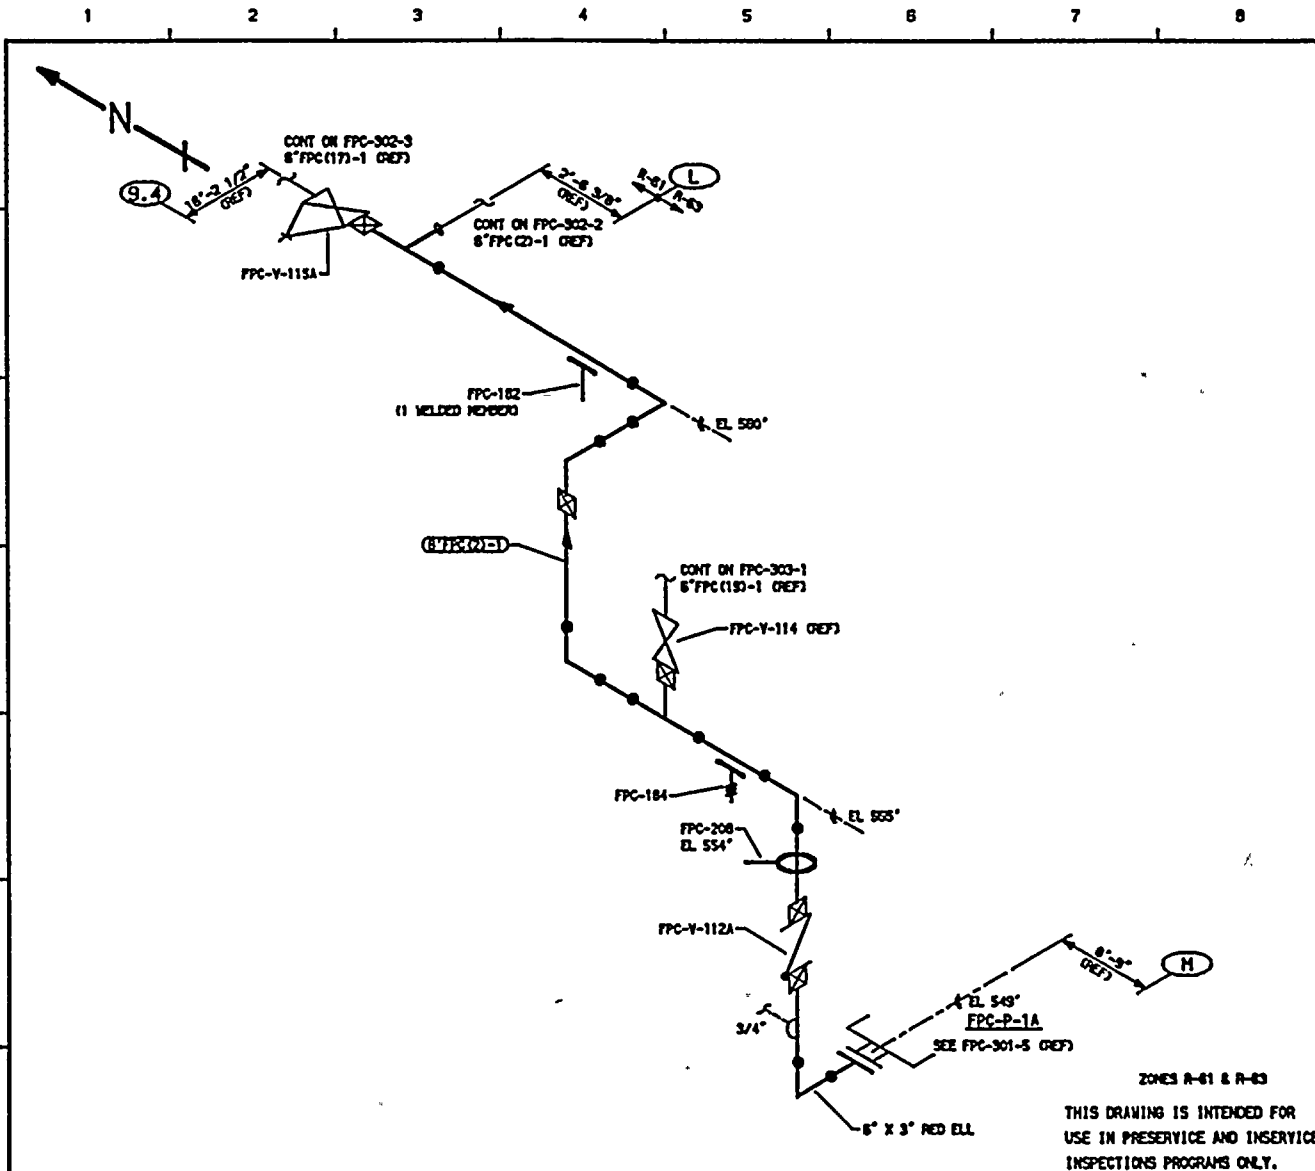

- NOTES:**
1. THIS DRAWING IDENTIFIES PIPING AND COMPONENTS SUBJECT ONLY TO A VISUAL EXAM FOR (1) EVIDENCE OF LEAKAGE DURING SYSTEM PRESSURE OR OPERABILITY TESTS, (2) PRESSURE DECAY TESTS OF BURIED PIPING, AND (3) LOSS OF SUPPORT CAPABILITY OR INADEQUATE RESTRAINT FOR SUPPORTS AND HANGERS ON PIPING EXCEEDING 4" NOM. TESTS SHALL BE CONDUCTED PER ASME SECTION XI, ARTICLES 1WA-5000 AND 1WO-2000.
  2. FOR BRANCH PIPING 4" NOM. OR LESS CONNECTION SHOWN IN DASHED LINES) EXTEND VISUAL LEAKAGE EXAM THROUGH THE OUTERMOST NORMALLY CLOSED NUCLEAR CLASS VALVE, OR UNTIL TRANSITION TO INSTRUMENT TUBING, UNLESS OTHERWISE NOTED.

**REFERENCES:**  
 151 - 228-1A  
 BOYCE & CRAIG ISOMETRIC  
 FPC-636-1.3 REV B

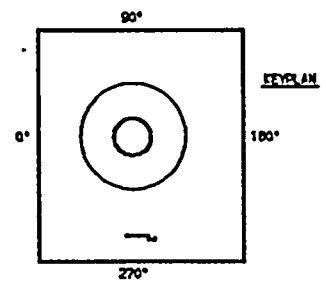

QUALITY CLASS: 11 | ASME CODE CLASS: 3  
 ENGR: K-McANDREWM | DRAWN: K-McA | DATE: 4-8-79

WASHINGTON PUBLIC POWER  
 SUPPLY SYSTEM  
 RYLAND, WASHINGTON 90332

WP-2  
 WELD & COMPONENT  
 IDENTIFICATION DIAGRAM

TITLE:  
 FPC-P-1A TO FPC-DM-1A & 1B


DWG NO: FPC-302-1 | REV 2

PIPING SYSTEM	NOM DIA (INO)	SCH	NOM WALL THK	MATERIAL SPECIFICATION	MATL TYPE	CAL BLOCK NO
8" FPC(C)-1	8	STD	0.280	SA 106 GR B	CS	NA

NO	DATE	REVISION	BY	CHKD	APVD
2	11-13-82	ADDED 151 DRAWING REFERENCE & DRAWING LINE CONTINUATION, REVISED KEYPLAN & LONG. RECORD	K-McA	DPR	DRM
1	1-27-84	REVISED AS NOTED. ADDED KEYPLAN	K-McA	DPR	TFH
0	12-2-81	ISSUED FOR USE	K-McA	DPR	TFH


ZONES R-61 & R-63  
 THIS DRAWING IS INTENDED FOR USE IN PRESERVICE AND INSERVICE INSPECTIONS PROGRAMS ONLY.

A  
B  
C  
D  
E  
F  
G  
H

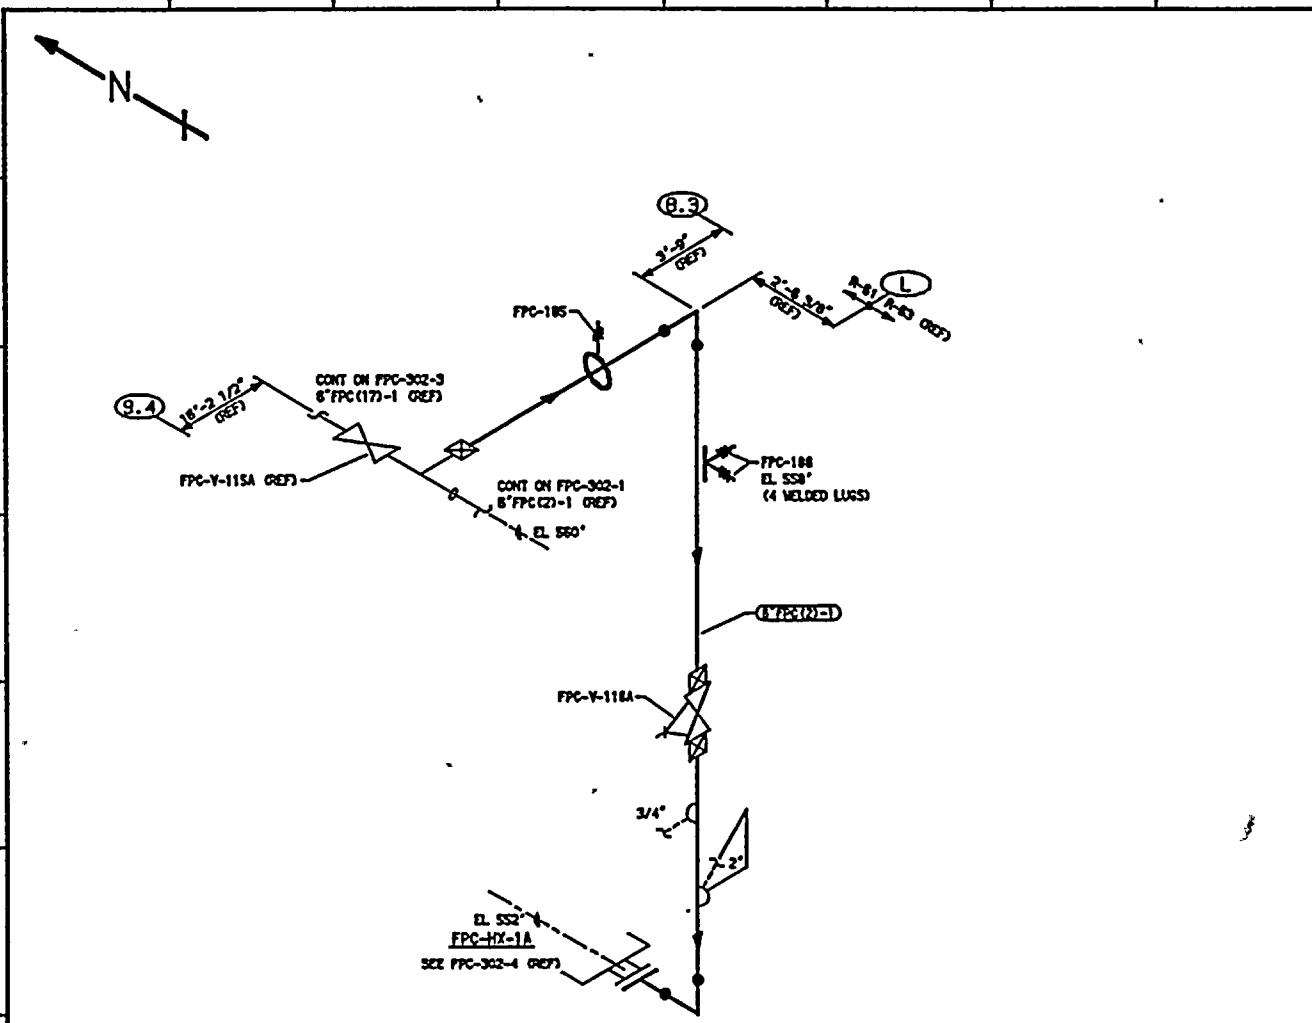


- NOTES:**
1. THIS DRAWING IDENTIFIES PIPING AND COMPONENTS SUBJECT ONLY TO A VISUAL EXAM FOR (1) EVIDENCE OF LEAKAGE DURING SYSTEM PRESSURE OR OPERABILITY TESTS; (2) PRESSURE DECAY TESTS OF BURIED PIPING; AND (3) LOSS OF SUPPORT CAPABILITY OR INADEQUATE RESTRAINT FOR SUPPORTS AND HANGERS ON PIPING EXCEEDING 4" NOM. TESTS SHALL BE CONDUCTED PER ASME SECTION II, ARTICLES 11A-5000 AND 11A-2000.
  2. FOR BRANCH PIPING 4" NOM. OR LESS CONNECTION SHOWN IN DASHED LINES EXTEND VISUAL LEAKAGE EXAM THROUGH THE OUTERMOST NORMALLY CLOSED NUCLEAR CLASS VALVE, OR UNTIL TRANSITION TO INSTRUMENT TUBING, UNLESS OTHERWISE NOTED.

**REFERENCES:**  
 ISI - 228-1A  
 BOYCE & CRAIG ISOMETRIC  
 FPC-838-8.7 REV 7

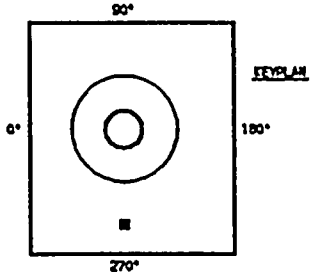

QUALITY CLASS, 11 ASME CODE CLASS, 3  
 ENGR. K-McANDREW DRAWN. K-McA DATE. 4-9-79

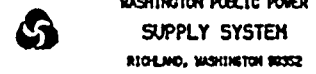

MP-2  
 WELD & COMPONENT  
 IDENTIFICATION DIAGRAM


TITLE:  
 FPC-P-1A DISCHARGE TO FPC-HX-1A

DWG NO. FPC-302-2 REV 1

ZONE R-63  
 THIS DRAWING IS INTENDED FOR  
 USE IN PRESERVICE AND INSERVICE  
 INSPECTIONS PROGRAMS ONLY.


PIPING SYSTEM	NOM DIA (IN)	SCH	NOM WALL THK	MATERIAL SPECIFICATION	MATL TYPE	CAL BLOCK NO
8" FPC C21-1	8	STD	0.200	SA 106 GR B	CS	NA

NO	DATE	REVISION	BY	CHKD	APVD
1	11-13-82	ADDED SEE DRAWING REFERENCE & DRAWING LINE CONTINUATION, MODIFIED SETBACK & LEGS, RE-DRAWN	K-McA	DPR	DRW
0	12-2-81	ISSUED FOR USE	K-McA	DPR	TTH

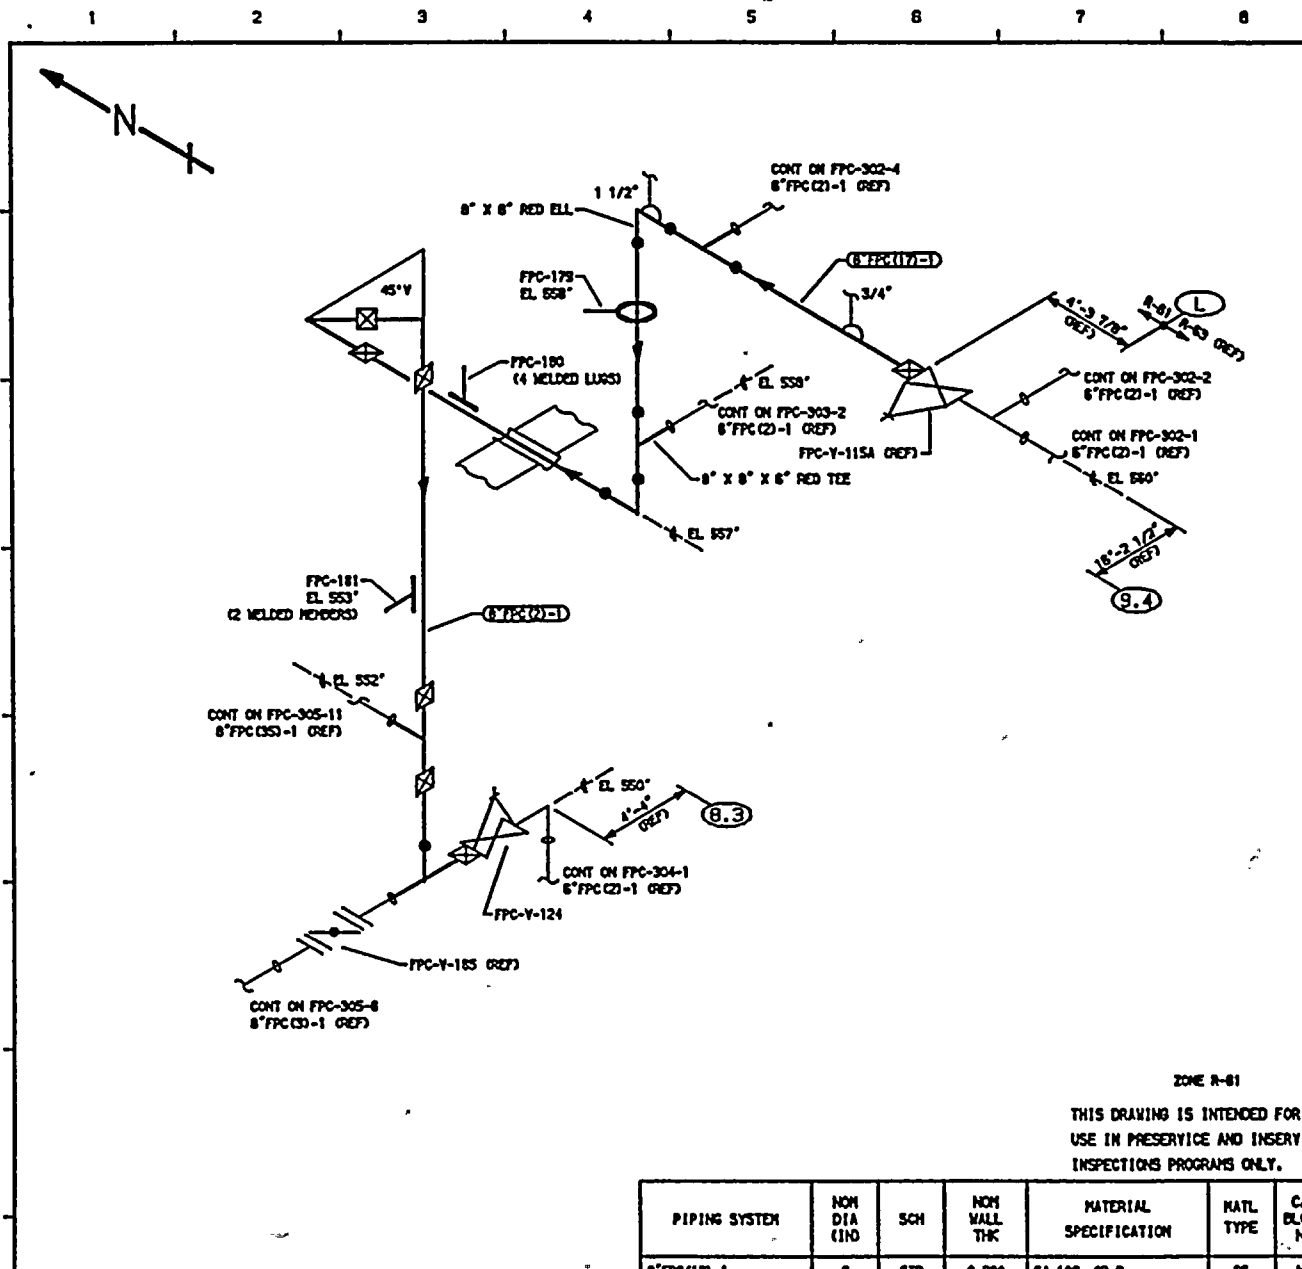

- NOTES:**
1. THIS DRAWING IDENTIFIES PIPING AND COMPONENTS SUBJECT ONLY TO A VISUAL EXAM FOR (1) EVIDENCE OF LEAKAGE DURING SYSTEM PRESSURE OR OPERABILITY TESTS, (2) PRESSURE DECAY TESTS OF BURIED PIPING, AND (3) LOSS OF SUPPORT CAPABILITY OR INADEQUATE RESTRAINT FOR SUPPORTS AND HANGERS ON PIPING EXCEEDING 4" NOM. TESTS SHALL BE CONDUCTED PER ASME SECTION XI, ARTICLES IMA-5000 AND IMA-2000.
  2. FOR BRANCH PIPING 4" NOM. OR LESS CONNECTION SHOWN IN DASHED LINES) EXTEND VISUAL LEAKAGE EXAM THROUGH THE OUTERMOST NORMALLY CLOSED NUCLEAR CLASS VALVE, OR UNTIL TRANSITION TO INSTRUMENT TUBING, UNLESS OTHERWISE NOTED.

- REFERENCES:**
- ISI - 226-1A
  - BOYCE & GRILL ISOMETRIC FPC-636-4.5 REV 11

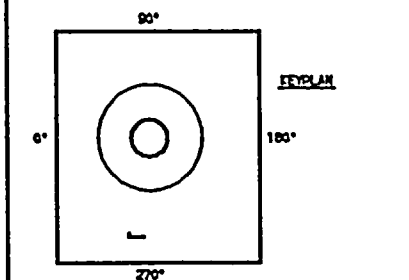

QUALITY CLASS: 11 ASME CODE CLASS: 3  
 ENGR: K-McANDREW DRAWN: K-McA DATE: 4-11-79

WASHINGTON PUBLIC POWER  
 SUPPLY SYSTEM  
 RICHLAND, WASHINGTON 99352

WPP-2  
 WELD & COMPONENT  
 IDENTIFICATION DIAGRAM


TITLE: FPC-P-1A DISCHARGE TO FPC-OH-1A R1B

DWG NO. FPC-302-3 REV 2

ZONE R-01  
 THIS DRAWING IS INTENDED FOR  
 USE IN PRESERVICE AND INSERVICE  
 INSPECTIONS PROGRAMS ONLY.

PIPING SYSTEM	NOM DIA (110)	SCH	NOM WALL THK	MATERIAL SPECIFICATION	MATL TYPE	CAL BLOCK NO
8" FPC (117)-1	8	STD	0.280	SA 106 GR B	CS	NA
8" FPC (2)-1	8	STD	0.322	SA 106 GR B	CS	NA

NO	DATE	REVISION	BY	CHKD	APVD
2	11-13-82	ADDED 111 DRAWING REFERENCE & DRAWING LINE CONTINUATION, MODIFIED KEYPLAN & LOGO, REVISION	K-McA	DPR	DRW
1	1-24-84	REVISED AS NOTED. ADDED KEYPLAN	K-McA	DPR	TTH
0	12-2-81	ISSUED FOR USE	K-McA	DPR	TTH

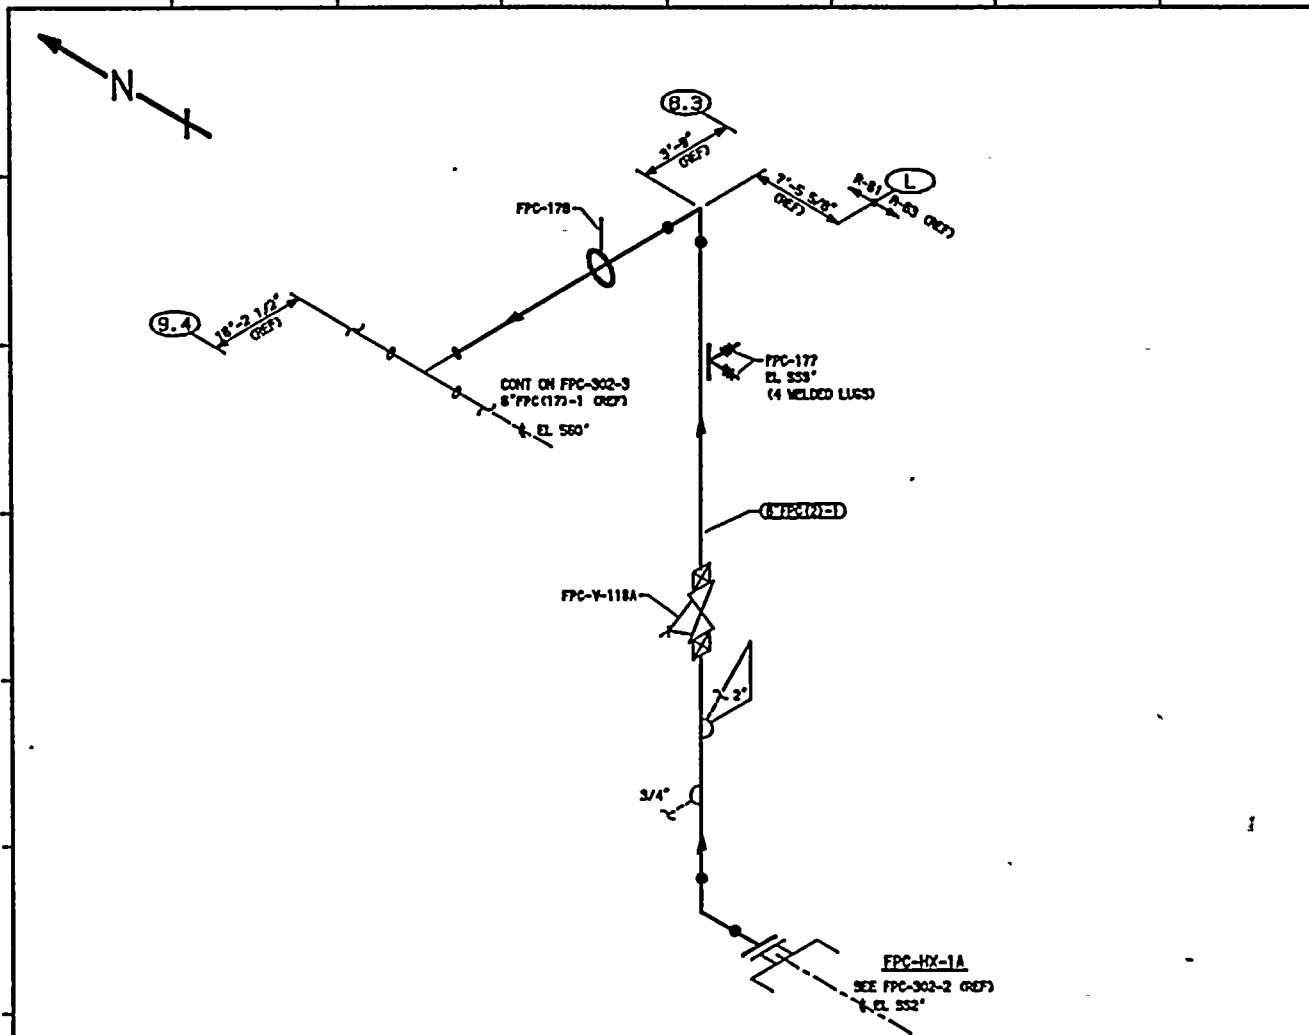


ZONE R-61

THIS DRAWING IS INTENDED FOR  
USE IN PRESERVICE AND INSERVICE  
INSPECTIONS PROGRAMS ONLY.

PIPING SYSTEM	NOM DIA (IN)	SCH	NOM WALL THK	MATERIAL SPECIFICATION	MATL TYPE	CAL BLOCK NO
8" FPC C2-1	8	STD	0.200	SA 106 GR B	CS	NA

- NOTES:**
1. THIS DRAWING IDENTIFIES PIPING AND COMPONENTS SUBJECT ONLY TO A VISUAL EXAM FOR (1) EVIDENCE OF LEAKAGE DURING SYSTEM PRESSURE OR OPERABILITY TESTS; (2) PRESSURE DECAY TESTS OF BURIED PIPING; AND (3) LOSS OF SUPPORT CAPABILITY OR INADEQUATE RESTRAINT FOR SUPPORTS AND HANGERS ON PIPING EXCEEDING 4" NOM. TESTS SHALL BE CONDUCTED PER ASME SECTION XI, ARTICLES IMA-5000 AND IMA-2000.
  2. FOR BRANCH PIPING 4" NOM. OR LESS CONNECTION SHOWN IN DASHED LINES) EXTEND VISUAL LEAKAGE EXAM THROUGH THE OUTERMOST NORMALLY CLOSED NUCLEAR CLASS VALVE, OR UNTIL TRANSITION TO INSTRUMENT TUBING, UNLESS OTHERWISE NOTED.

**REFERENCES:**  
ISI - 228-1A  
BOYCE & CRAIG ISOMETRIC  
FPC-638-8.8 REV 8

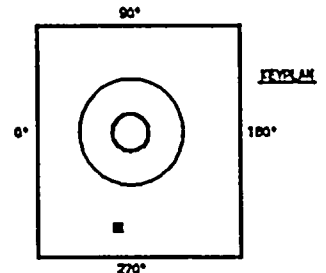

QUALITY CLASS: 11 ASME CODE CLASS: 3  
ENGR: K-McANDREW DRAWN: K-McA DATE: 4-11-79




WASHINGTON PUBLIC POWER  
SUPPLY SYSTEM  
RIDLAND, WASHINGTON 98382

WPP-2  
WELD & COMPONENT  
IDENTIFICATION DIAGRAM

TITLE: FPC-HX-1A TO FPC-DM-1A & 1B


DWG NO. FPC-302-4 REV 1

NO	DATE	REVISION	BY	CHKD	APVD
1	11-13-82	ADDED ISI DRAWING REFERENCE & DRAWING LINE CONTINUATION. MODIFIED FEYPLAN & LEGEND. REDESIGN	K-McA	DPR	DRW
0	12-2-81	ISSUED FOR USE	K-McA	DPR	TTH

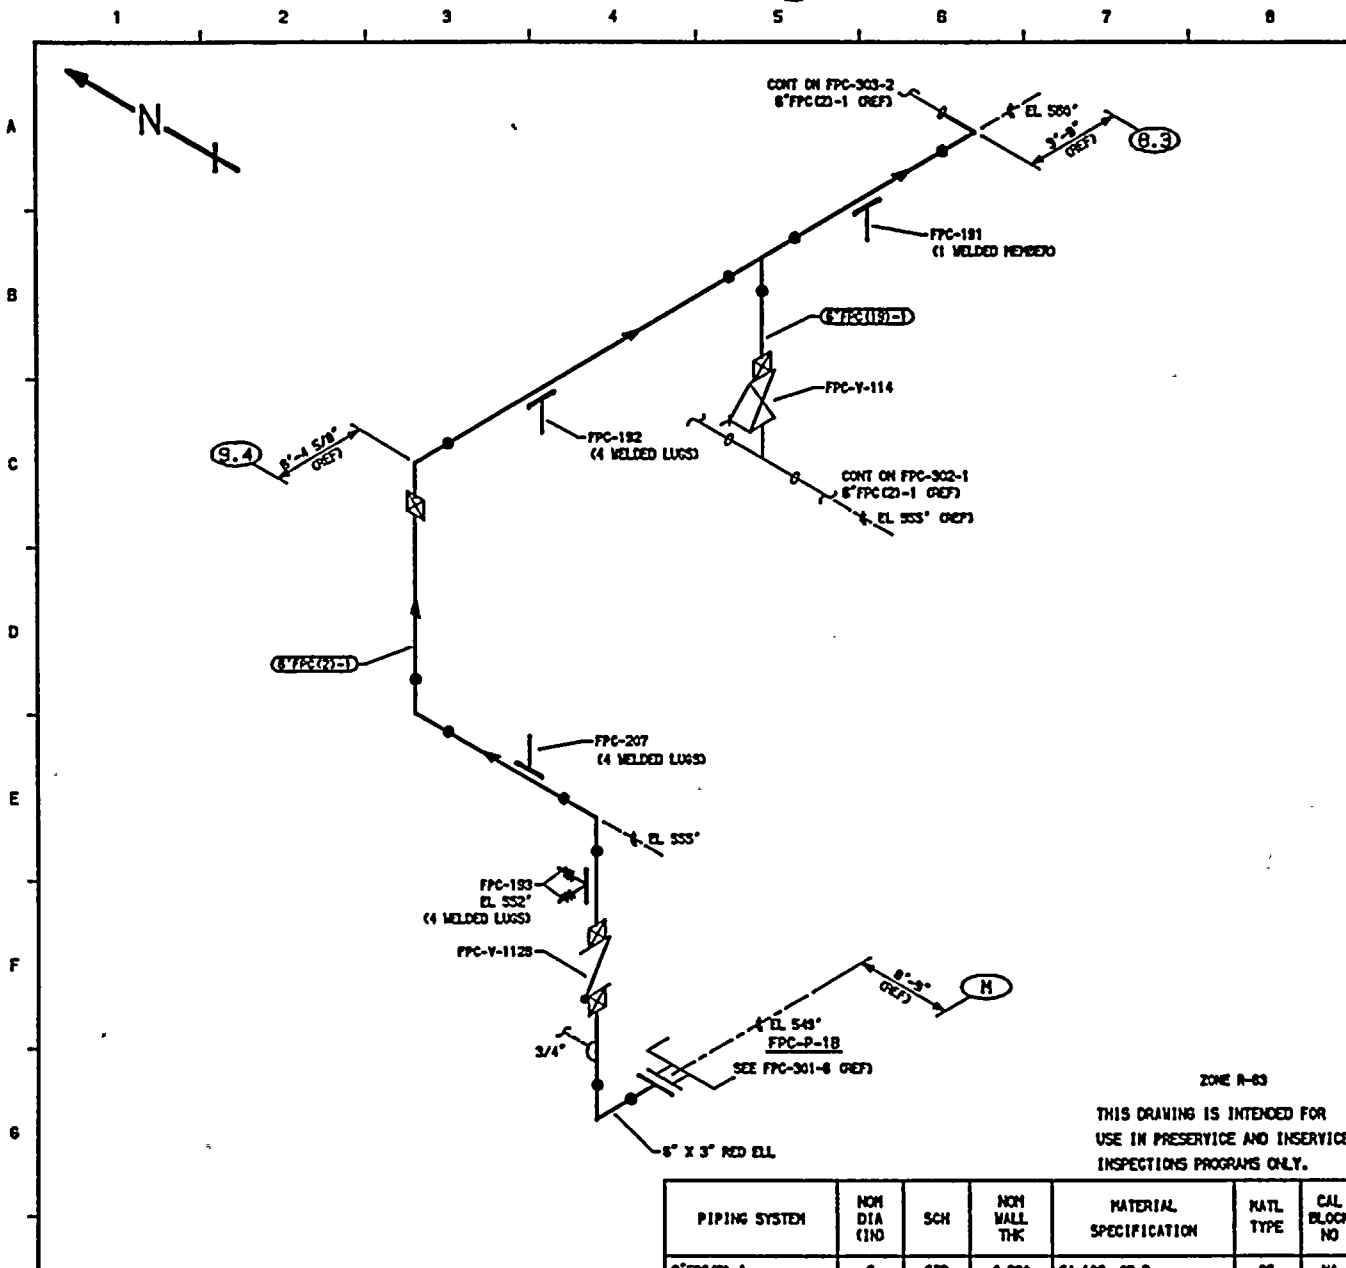

- NOTES:**
1. THIS DRAWING IDENTIFIES PIPING AND COMPONENTS SUBJECT ONLY TO A VISUAL EXAM FOR (1) EVIDENCE OF LEAKAGE DURING SYSTEM PRESSURE OR OPERABILITY TESTS, (2) PRESSURE DECAY TESTS OF BURIED PIPING, AND (3) LOSS OF SUPPORT CAPABILITY OR INADEQUATE RESTRAINT FOR SUPPORTS AND HANGERS ON PIPING EXCEEDING 4" NOM. TESTS SHALL BE CONDUCTED PER ASME SECTION XI, ARTICLES 11A-5000 AND 11A-2000.
  2. FOR BRANCH PIPING 4" NOM. OR LESS (CONNECTION SHOWN IN DASHED LINES) EXTEND VISUAL LEAKAGE EXAM THROUGH THE OUTERMOST NORMALLY CLOSED NUCLEAR CLASS VALVE, OR UNTIL TRANSITION TO INSTRUMENT TUBING, UNLESS OTHERWISE NOTED.

**REFERENCES:**  
 ISI - 226-1A  
 BOYCE & CRAIL ISOMETRIC  
 FPC-837-1.4 REV 5

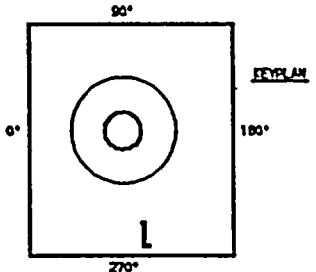

QUALITY CLASS: 11 ASME CODE CLASS: 3  
 ENGR: K-McANDREW | DRAWN: K-McA | DATE: 4-8-79

WASHINGTON PUBLIC POWER  
 SUPPLY SYSTEM  
 RICHLAND, WASHINGTON 99352

WP-2  
 WELD & COMPONENT  
 IDENTIFICATION DIAGRAM


TITLE: FPC-P-18 TO FPC-DH-1A & 1B


DWG NO. FPC-303-1 REV 2

ZONE R-83  
 THIS DRAWING IS INTENDED FOR  
 USE IN PRESERVICE AND INSERVICE  
 INSPECTIONS PROGRAMS ONLY.

PIPING SYSTEM	NOM DIA (IN)	SCH	NOM WALL THK	MATERIAL SPECIFICATION	MATL TYPE	CAL BLOCK NO
8" FPC (2) -1	8	STD	0.280	SA 106 GR B	CS	NA
8" FPC (1) -1	8	STD	0.280	SA 106 GR B	CS	NA


NO	DATE	REVISION	BY	CHKD	APVD
2	11-13-82	ADDED ISI DRAWING REFERENCE & DRAWING LINE CONTINUATION. MODIFIED KEYPLAN & LOGS. RE-DRAWN	K-McA	DPR	DRW
1	1-24-84	REVISED AS NOTED. ADDED KEYPLAN	K-McA	DPR	TTH
0	12-2-81	ISSUED FOR USE	K-McA	DPR	TTH

 

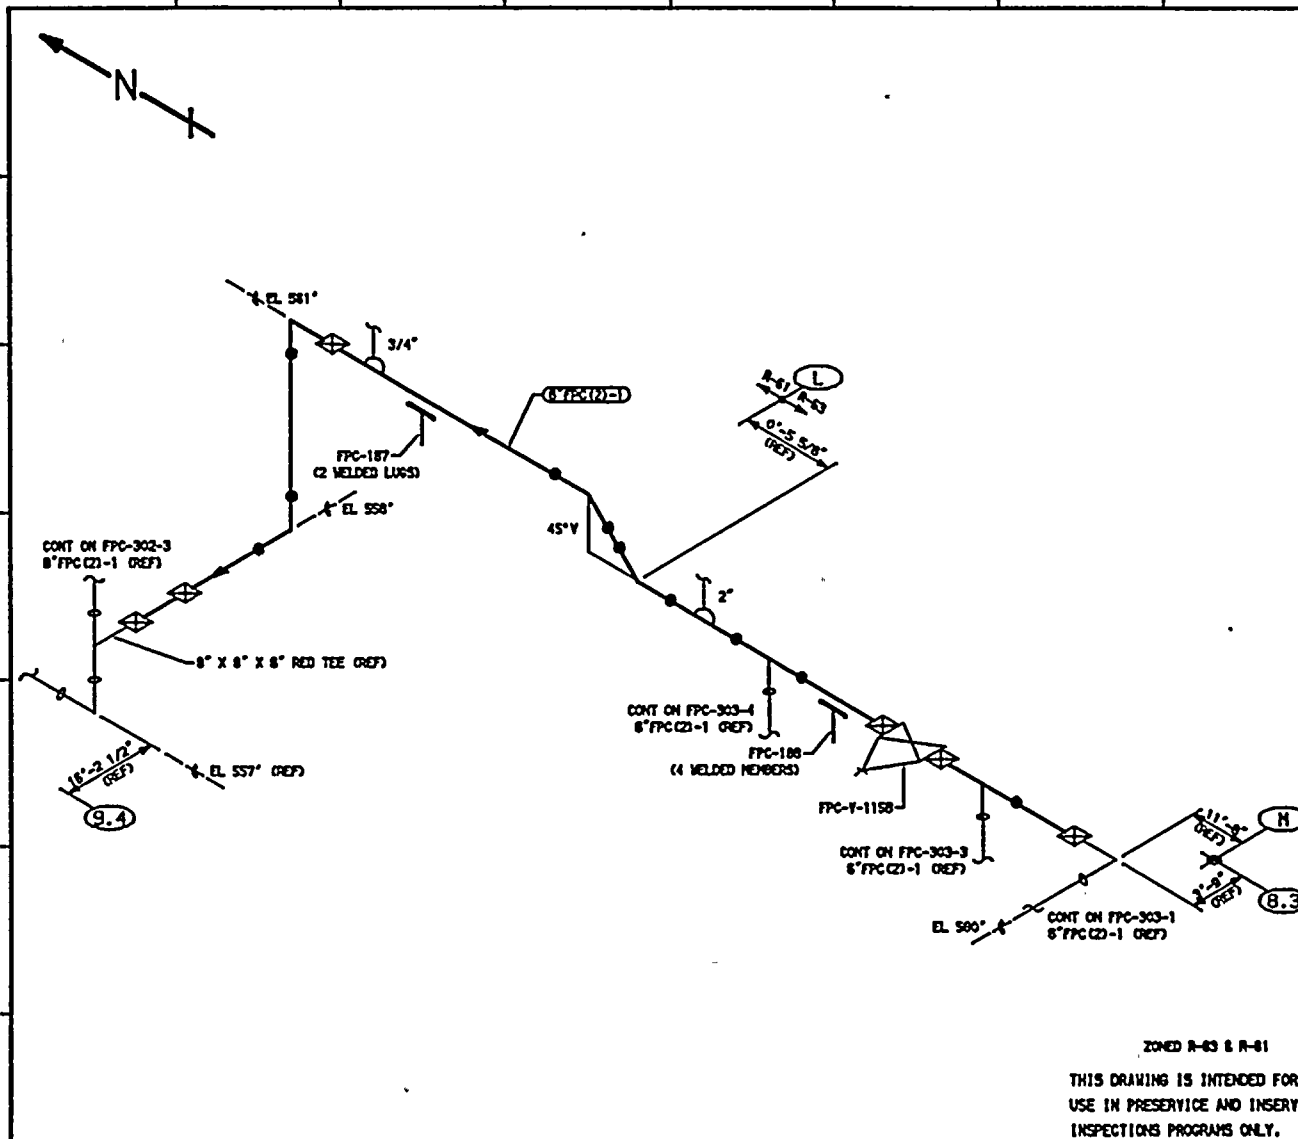

- NOTES:**
- THIS DRAWING IDENTIFIES PIPING AND COMPONENTS SUBJECT ONLY TO A VISUAL EXAM FOR (1) EVIDENCE OF LEAKAGE DURING SYSTEM PRESSURE OR OPERABILITY TESTS, (2) PRESSURE DECAY TESTS OF BURIED PIPING, AND (3) LOSS OF SUPPORT CAPABILITY OR INADEQUATE RESTRAINT FOR SUPPORTS AND HANGERS ON PIPING EXCEEDING 4" NOM. TESTS SHALL BE CONDUCTED PER ASME SECTION XI, ARTICLES 1WA-5000 AND 1WD-2000.
  - FOR BRANCH PIPING 4" NOM. OR LESS CONNECTION SHOWN IN DASHED LINES EXTEND VISUAL LEAKAGE EXAM THROUGH THE OUTERMOST NORMALLY CLOSED NUCLEAR CLASS VALVE, OR UNTIL TRANSITION TO INSTRUMENT TUBING, UNLESS OTHERWISE NOTED.

**REFERENCES:**  
 ISI - 228-1A  
 BOYCE & CRALL ISOMETRIC  
 FPC-637-5.7 REV B

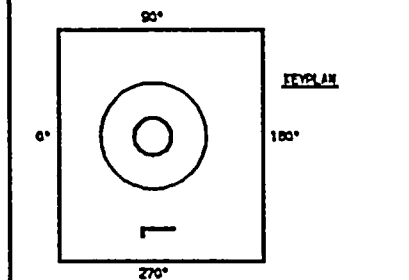

QUALITY CLASS: 11 ASME CODE CLASS: 3  
 ENGR. K-McANDREEM DRAWN: K-McA DATE: 4-11-79

WASHINGTON PUBLIC POWER  
 SUPPLY SYSTEM  
 RICHLAND, WASHINGTON 99352

MP-2  
 WELD & COMPONENT  
 IDENTIFICATION DIAGRAM


TITLE:  
 FPC-P-1B DISCHARGE TO FPC-DH-1A & 1B

DWG NO. FPC-303-2 REV 2

ZONED R-83 & R-81  
 THIS DRAWING IS INTENDED FOR  
 USE IN PRESERVICE AND INSERVICE  
 INSPECTIONS PROGRAMS ONLY.


PIPING SYSTEM	NOM DIA (IN)	SCH	NOM WALL THK	MATERIAL SPECIFICATION	MATL TYPE	CAL BLOCK NO
8" FPC(C2)-1	8	STD	0.200	SA 106 GR B	CS	NA

NO	DATE	REVISION	BY	CHKD	APVD
2	11-13-82	ADDED ISI DRAWING REFERENCE & ORIGIN LINE CONTINUATION. MODIFIED KEYPLAN & LOGO. RECDRAW	K-McA	DPR	DRW
1	1-24-84	REVISED AS NOTED. ADDED KEYPLAN	K-McA	DPR	TPH
0	12-2-81	ISSUED FOR USE	K-McA	DPR	TPH

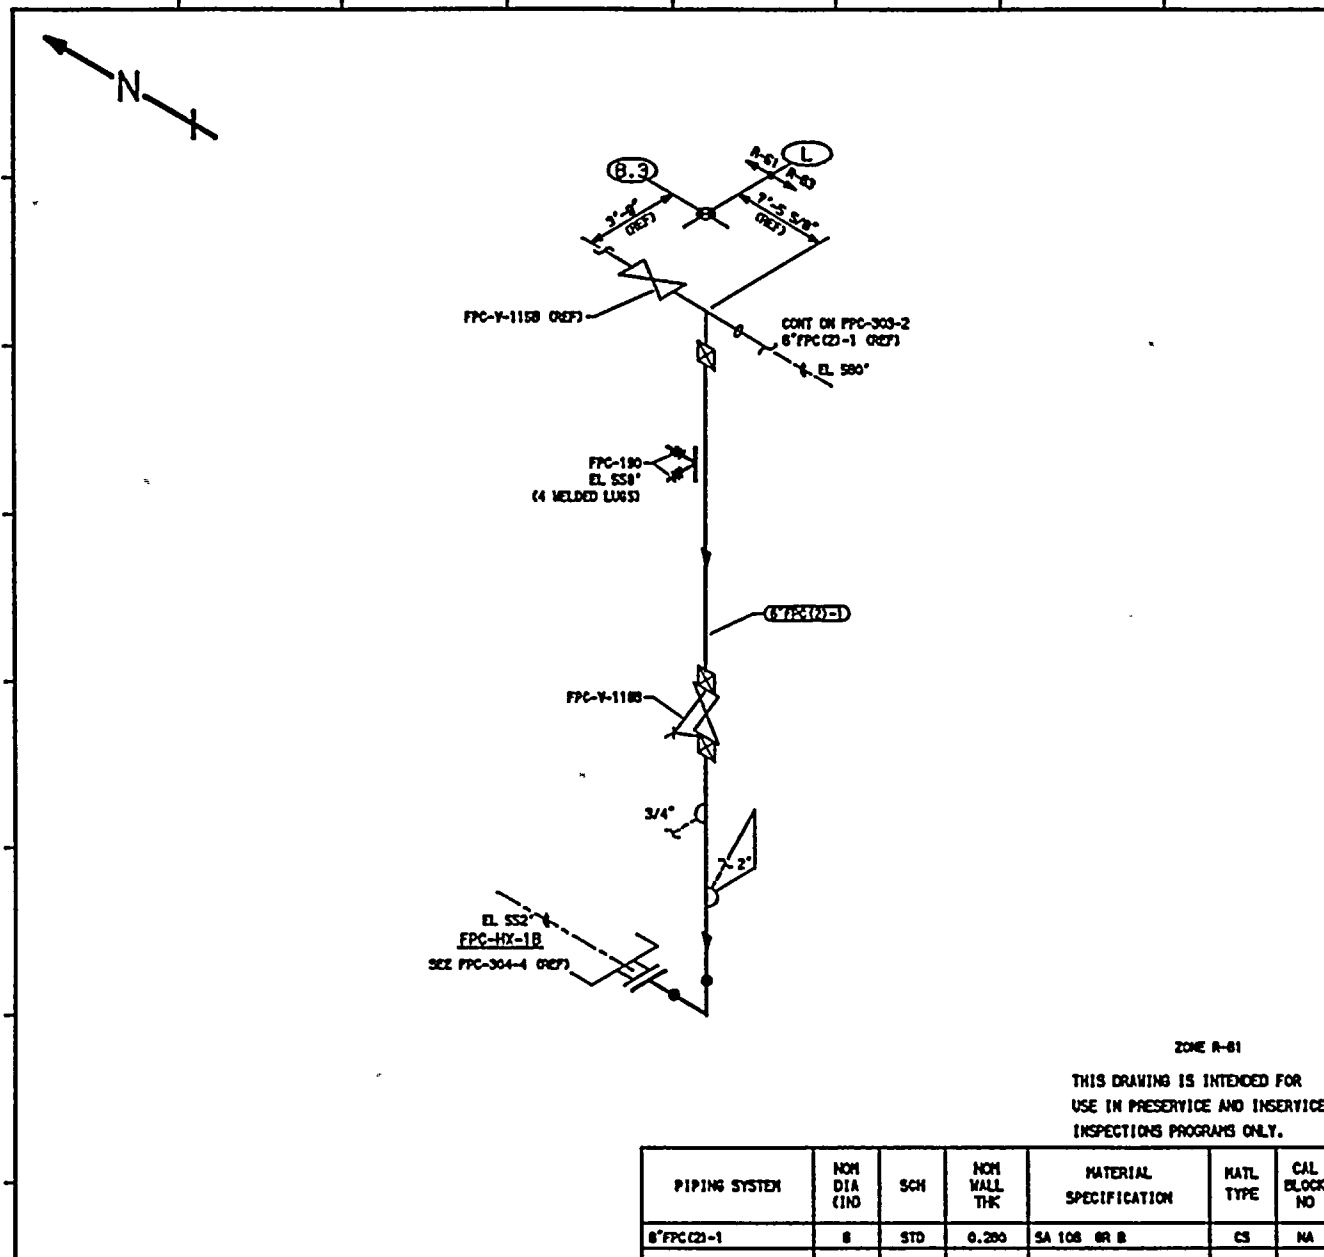

- NOTES:**
1. THIS DRAWING IDENTIFIES PIPING AND COMPONENTS SUBJECT ONLY TO A VISUAL EXAM FOR (1) EVIDENCE OF LEAKAGE DURING SYSTEM PRESSURE OR OPERABILITY TESTS; (2) PRESSURE DECAY TESTS OF BURIED PIPING; AND (3) LOSS OF SUPPORT CAPABILITY OR INADEQUATE RESTRAINT FOR SUPPORTS AND HANGERS ON PIPING EXCEEDING 4" NOM. TESTS SHALL BE CONDUCTED PER ASME SECTION XI, ARTICLES IMA-5000 AND IMA-2000.
  2. FOR BRANCH PIPING 4" NOM. OR LESS CONNECTION SHOWN IN DASHED LINES EXTEND VISUAL LEAKAGE EXAM THROUGH THE OUTERMOST NORMALLY CLOSED NUCLEAR CLASS VALVE, OR UNTIL TRANSITION TO INSTRUMENT TUBING, UNLESS OTHERWISE NOTED.

**REFERENCES:**  
 ISI - 228-1A  
 BOYCE & CRAIG ISOMETRIC  
 FPC-837-8.9 REV 9

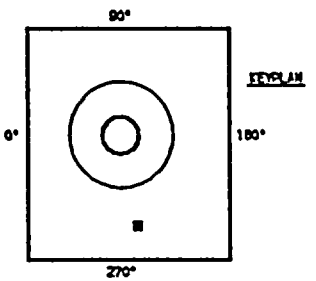

QUALITY CLASS, 11	ASME CODE CLASS, 3
ENGR, K-McANDREW	DATE, 4-11-79



WASHINGTON PUBLIC POWER  
**SUPPLY SYSTEM**  
 RICHLAND, WASHINGTON 99352

MP-2  
 WELD & COMPONENT  
 IDENTIFICATION DIAGRAM


**TITLE:**  
 FPC-HX-1B TO FPC-DM-1A & 1B

DWG NO. FPC-303-3 REV 1

NO	DATE	REVISION	BY	CHKD	APVD
1	11-13-82	ADD 111 DRAWING REFERENCE & DRAWING LINE CONTINUATION, MODIFIED ISOMETRIC & LOGO, RECDRAW	K-McA	DPR	DRW
0	12-2-81	ISSUED FOR USE	K-McA	DPR	TFH






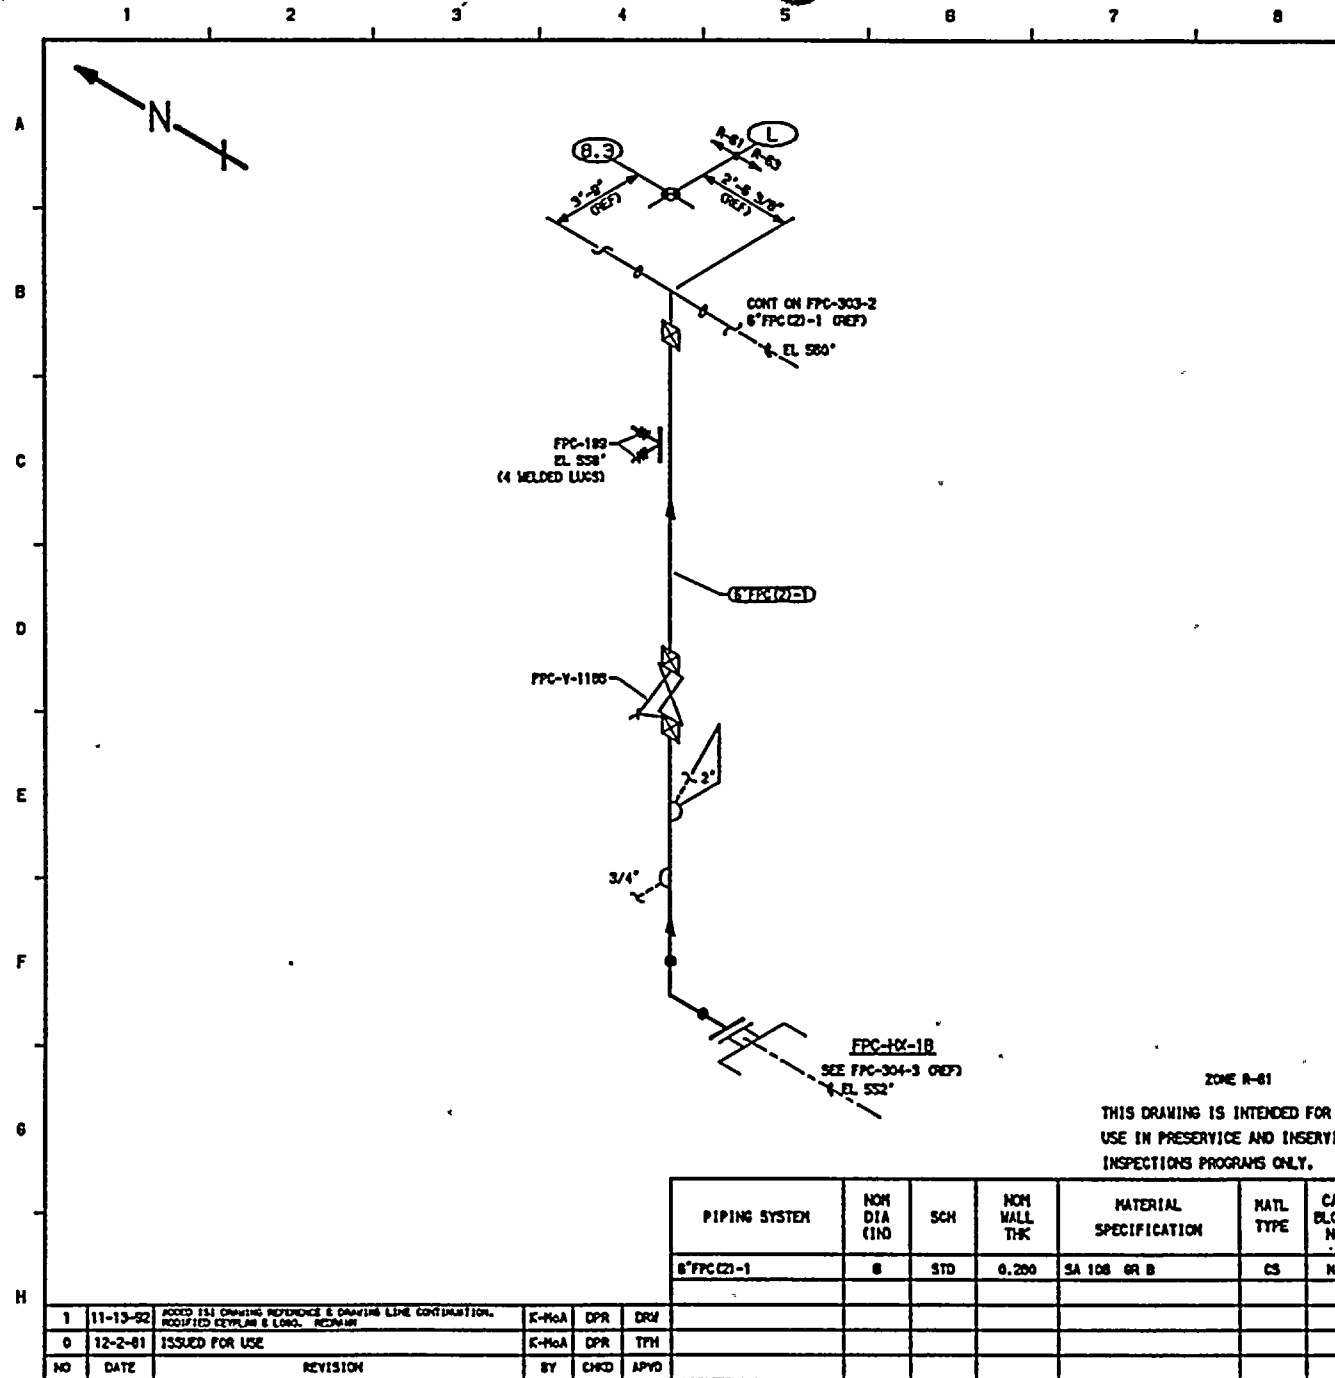

- NOTES:**
1. THIS DRAWING IDENTIFIES PIPING AND COMPONENTS SUBJECT ONLY TO A VISUAL EXAM FOR (1) EVIDENCE OF LEAKAGE DURING SYSTEM PRESSURE OR OPERABILITY TESTS, (2) PRESSURE DECAY TESTS OF BURIED PIPING, AND (3) LOSS OF SUPPORT CAPABILITY OR INADEQUATE RESTRAINT FOR SUPPORTS AND HANGERS ON PIPING EXCEEDING 4" NOM. TESTS SHALL BE CONDUCTED PER ASME SECTION XI, ARTICLES 1WA-5000 AND 1WD-2000.
  2. FOR BRANCH PIPING 4" NOM. OR LESS (CONNECTION SHOWN IN DASHED LINES) EXTEND VISUAL LEAKAGE EXAM THROUGH THE OUTERMOST NORMALLY CLOSED NUCLEAR CLASS VALVE, OR UNTIL TRANSITION TO INSTRUMENT TUBING, UNLESS OTHERWISE NOTED.

**REFERENCES:**  
 ISI - 226-1A  
 BOYCE & GRAIL ISOMETRIC  
 FPC-637-10.11 REV B

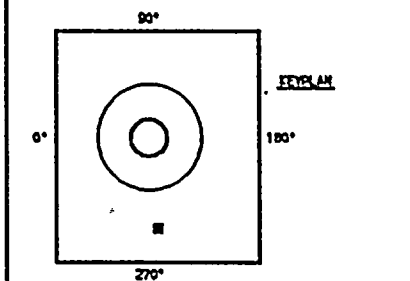

QUALITY CLASS, 11 ASME CODE CLASS, 3  
 ENGR, K-McANDREW DRAWN, K-McA DATE, 4-11-79

WASHINGTON PUBLIC POWER  
 SUPPLY SYSTEM  
 RICHLAND, WASHINGTON 99352

MP-2  
 WELD & COMPONENT  
 IDENTIFICATION DIAGRAM


TITLE: FPC-10X-1B TO FPC-0M-1A & 1B

DWG NO. FPC-303-4 REV 1

ZONE R-61  
 THIS DRAWING IS INTENDED FOR  
 USE IN PRESERVICE AND INSERVICE  
 INSPECTIONS PROGRAMS ONLY.

PIPING SYSTEM	NOM DIA (IN)	SCH	NOM WALL THK	MATERIAL SPECIFICATION	MATL TYPE	CAL BLOCK NO
6" FPC (2)-1	6	STD	0.250	SA 106 GR B	CS	NA

NO	DATE	REVISION	BY	CHKD	APVD
1	11-13-82	ADDED ISI DRAWING REFERENCE & DRAWING LINE CONTOURING. MODIFIED KEYPLAN & LOGO. KCM/MP	K-McA	DPR	DRM
0	12-2-81	ISSUED FOR USE	K-McA	DPR	TPH

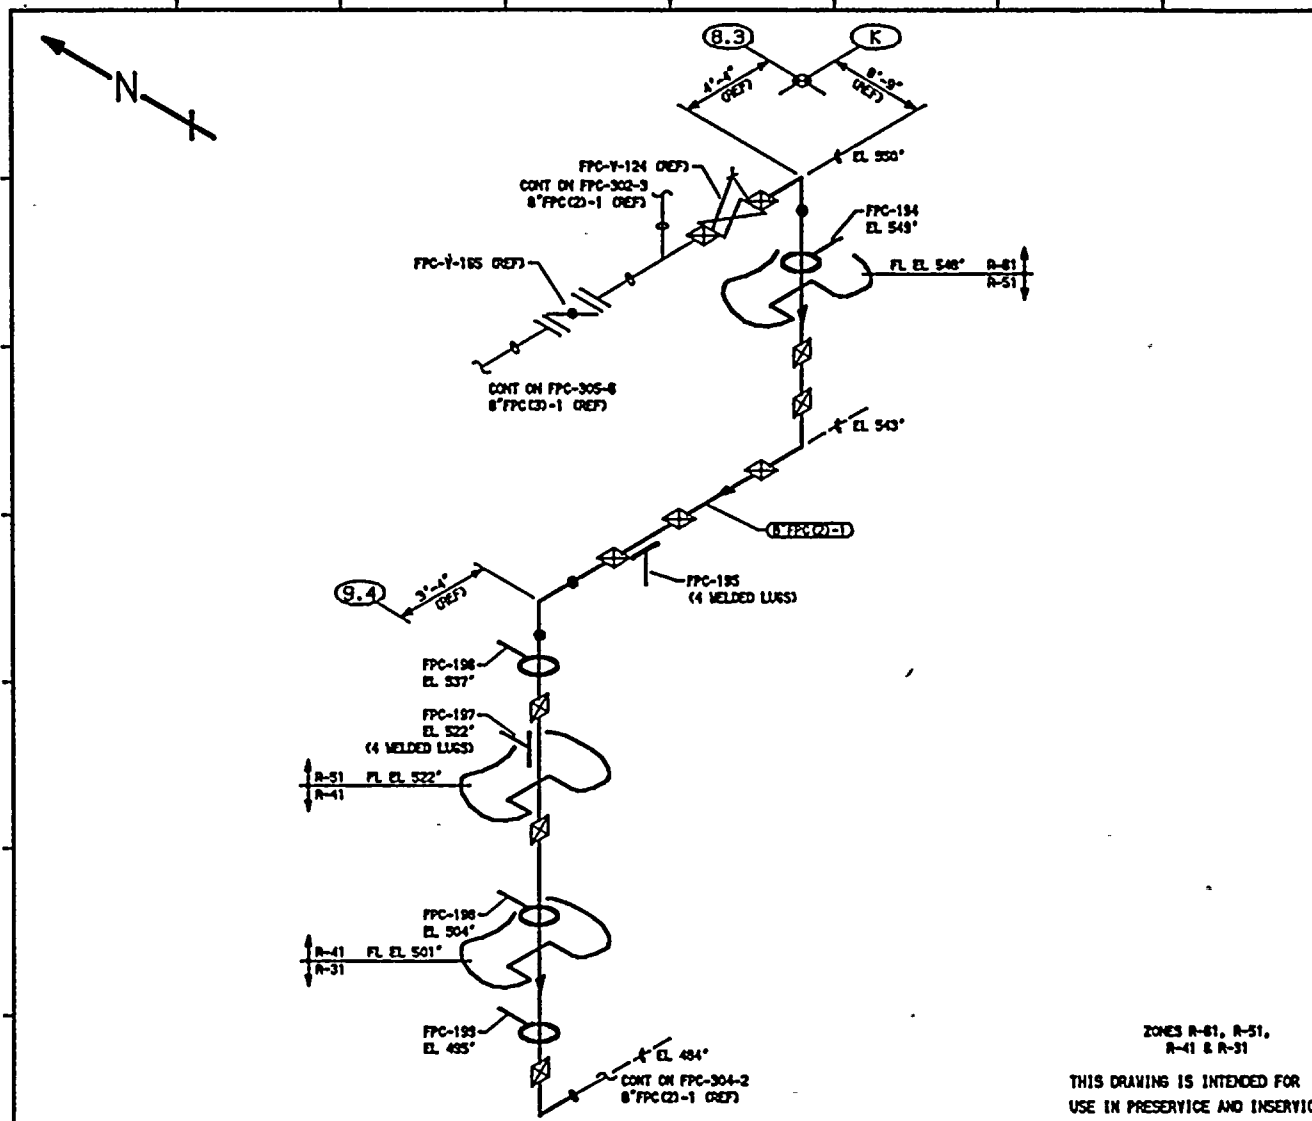


**NOTES:**

1. THIS DRAWING IDENTIFIES PIPING AND COMPONENTS SUBJECT ONLY TO A VISUAL EXAM FOR (1) EVIDENCE OF LEAKAGE DURING SYSTEM PRESSURE OR OPERABILITY TESTS; (2) PRESSURE DECAY TESTS OF BURIED PIPING; AND (3) LOSS OF SUPPORT CAPABILITY OR INADEQUATE RESTRAINT FOR SUPPORTS AND HANGERS ON PIPING EXCEEDING 4" NOM. TESTS SHALL BE CONDUCTED PER ASME SECTION XI, ARTICLES 1MA-5000 AND 1MD-2000.

**REFERENCES:**

ISI - 228-1A  
 BOYCE & ORAIL ISOMETRIC  
 FPC-636-10.13 REV B

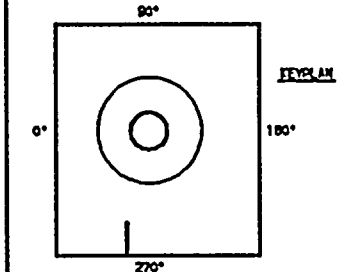

ZONES R-41, R-51,  
 R-41 & R-51

THIS DRAWING IS INTENDED FOR  
 USE IN PRESERVICE AND INSERVICE  
 INSPECTIONS PROGRAMS ONLY.

QUALITY CLASS, 11	ASME CODE CLASS, 3
ENGR, K-McANDREW	DATE, 4-12-79

WASHINGTON PUBLIC POWER  
 SUPPLY SYSTEM  
 RICHLAND, WASHINGTON 99352

PIPING SYSTEM	NOM DIA (INO)	SCH	NOM WALL THK	MATERIAL SPECIFICATION	MATL TYPE	CAL BLOCK NO
8" FPC (2)-1	8	STD	0.322	SA 108 GR B	CS	NA


NO	DATE	REVISION	BY	CHKD	APVD
2	11-13-82	ADDED ISI DRAWING REFERENCE & CHANGING LINE CONVENTION. REVISIONED KEYPLAN & LOG.	K-McA	DPR	DPV
1	1-24-84	REVISED AS NOTED. ADDED KEYPLAN	K-McA	DPR	TFH
0	12-2-81	ISSUED FOR USE	K-McA	DPR	TFH

WPP-2  
 WELD & COMPONENT  
 IDENTIFICATION DIAGRAM

TITLE:  
 FPC-P-1A & 1B DISCHARGE TO FPC-DN-1A & 1B


DWG NO. FPC-304-1

REV 2

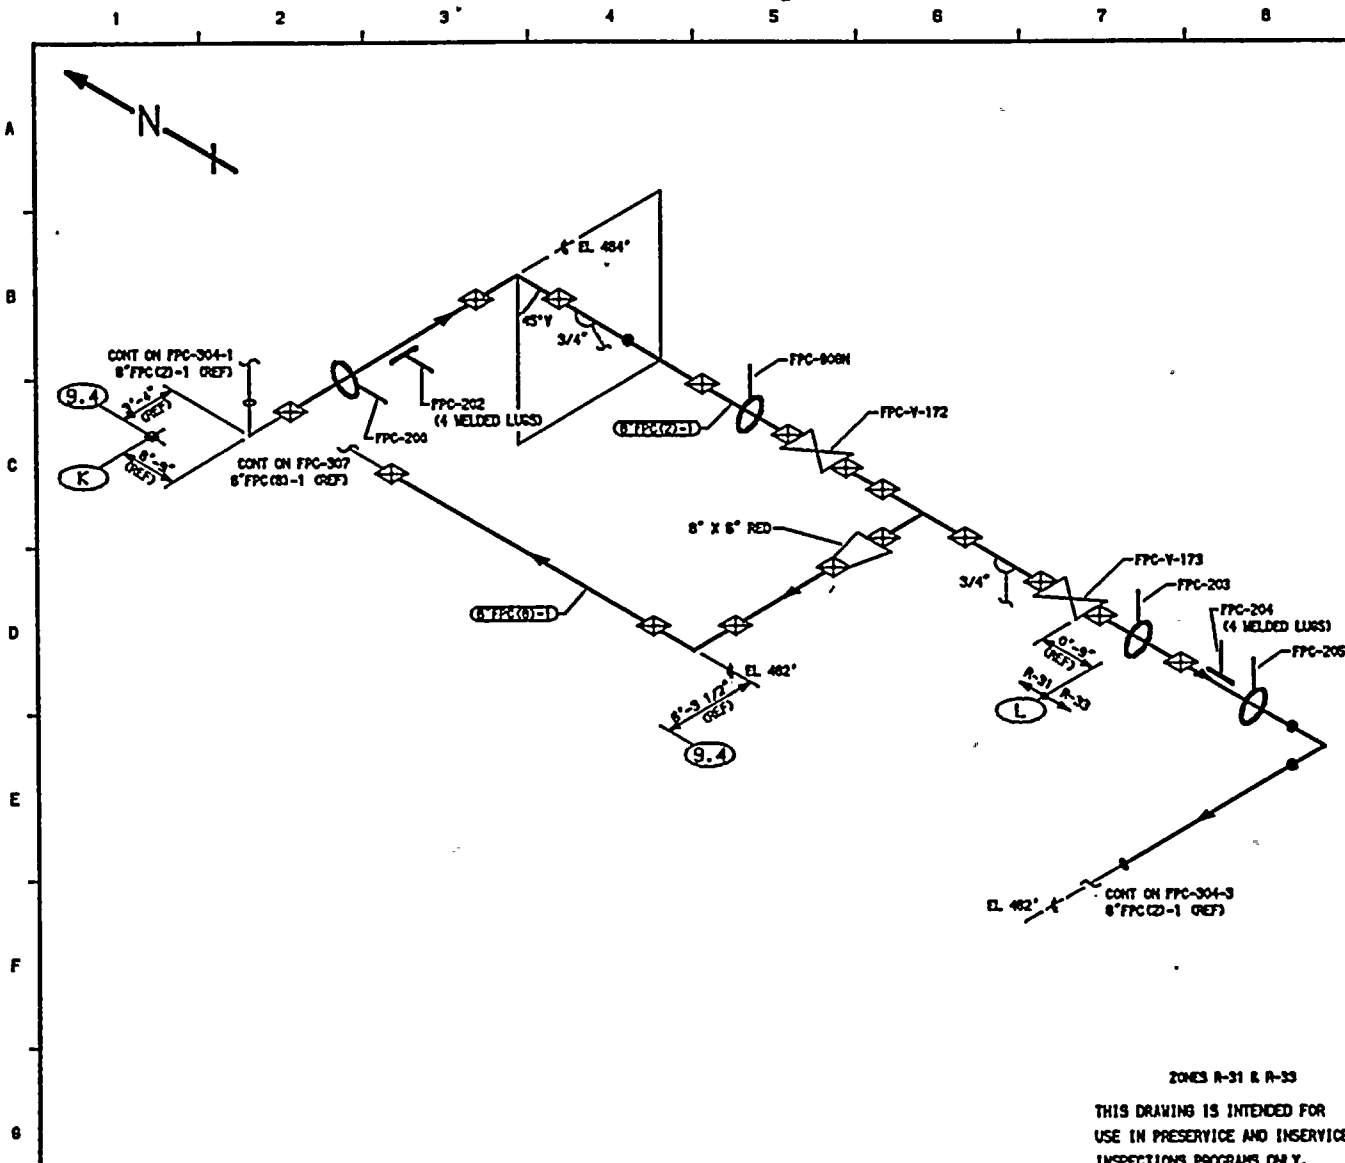

- NOTES:**
1. THIS DRAWING IDENTIFIES PIPING AND COMPONENTS SUBJECT ONLY TO A VISUAL EXAM FOR (1) EVIDENCE OF LEAKAGE DURING SYSTEM PRESSURE OR OPERABILITY TESTS; (2) PRESSURE DECAY TESTS OF BURIED PIPING; AND (3) LOSS OF SUPPORT CAPABILITY OR INADEQUATE RESTRAINT FOR SUPPORTS AND HANGERS ON PIPING EXCEEDING 4" NOM. TESTS SHALL BE CONDUCTED PER ASME SECTION XI, ARTICLES IMA-5000 AND IMA-2000.
  2. FOR BRANCH PIPING 4" NOM. OR LESS CONNECTION SHOWN IN DASHED LINES EXTEND VISUAL LEAKAGE EXAM THROUGH THE OUTERMOST NORMALLY CLOSED NUCLEAR CLASS VALVE, OR UNTIL TRANSITION TO INSTRUMENT TUBING, UNLESS OTHERWISE NOTED.

**INTRODUCTION:**  
 ISI - 228-1A  
 BOYCE & CRAIG ISOMETRIC  
 PFP-636-14.15 REV 13

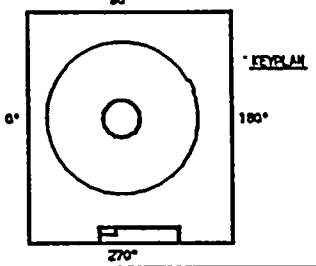

QUALITY CLASS, 11 ASME CODE CLASS, 3  
 ENGR: K-McANDREW DRAWN: K-McA DATE: 4-12-79

WASHINGTON PUBLIC POWER  
 SUPPLY SYSTEM  
 RICHLAND, WASHINGTON 99352

ZONES R-31 & R-33  
 THIS DRAWING IS INTENDED FOR  
 USE IN PRESERVICE AND INSERVICE  
 INSPECTIONS PROGRAMS ONLY.


PIPING SYSTEM	NOM DIA (IN)	SCH	NOM WALL THK	MATERIAL SPECIFICATION	NATL TYPE	CAL BLOCK NO
8" FPC (B)-1	8	STD	0.280	SA 106 GR B	CS	NA
8" FPC (C)-1	8	STD	0.322	SA 106 GR B	CS	NA

NO	DATE	REVISION	BY	CHKD	APVD
2	11-13-82	ACCD DRAWING LINE CONTINUATION & LOGS. MODIFIED IS1 DRAFTER REFERENCE & KEYPLAN.	K-McA	DPR	DRV
1	1-24-84	REVISED AS NOTED. ACCD KEYPLAN	K-McA	DPR	TTH
0	12-2-81	ISSUED FOR USE	K-McA	DPR	TTH


INP-2  
 WELD & COMPONENT  
 IDENTIFICATION DIAGRAM

TITLE:  
 FPC-P-1A & 1B DISCHARGE  
 TO FPC-DH-1A & 1B

DWG NO: FPC-304-2 REV 2

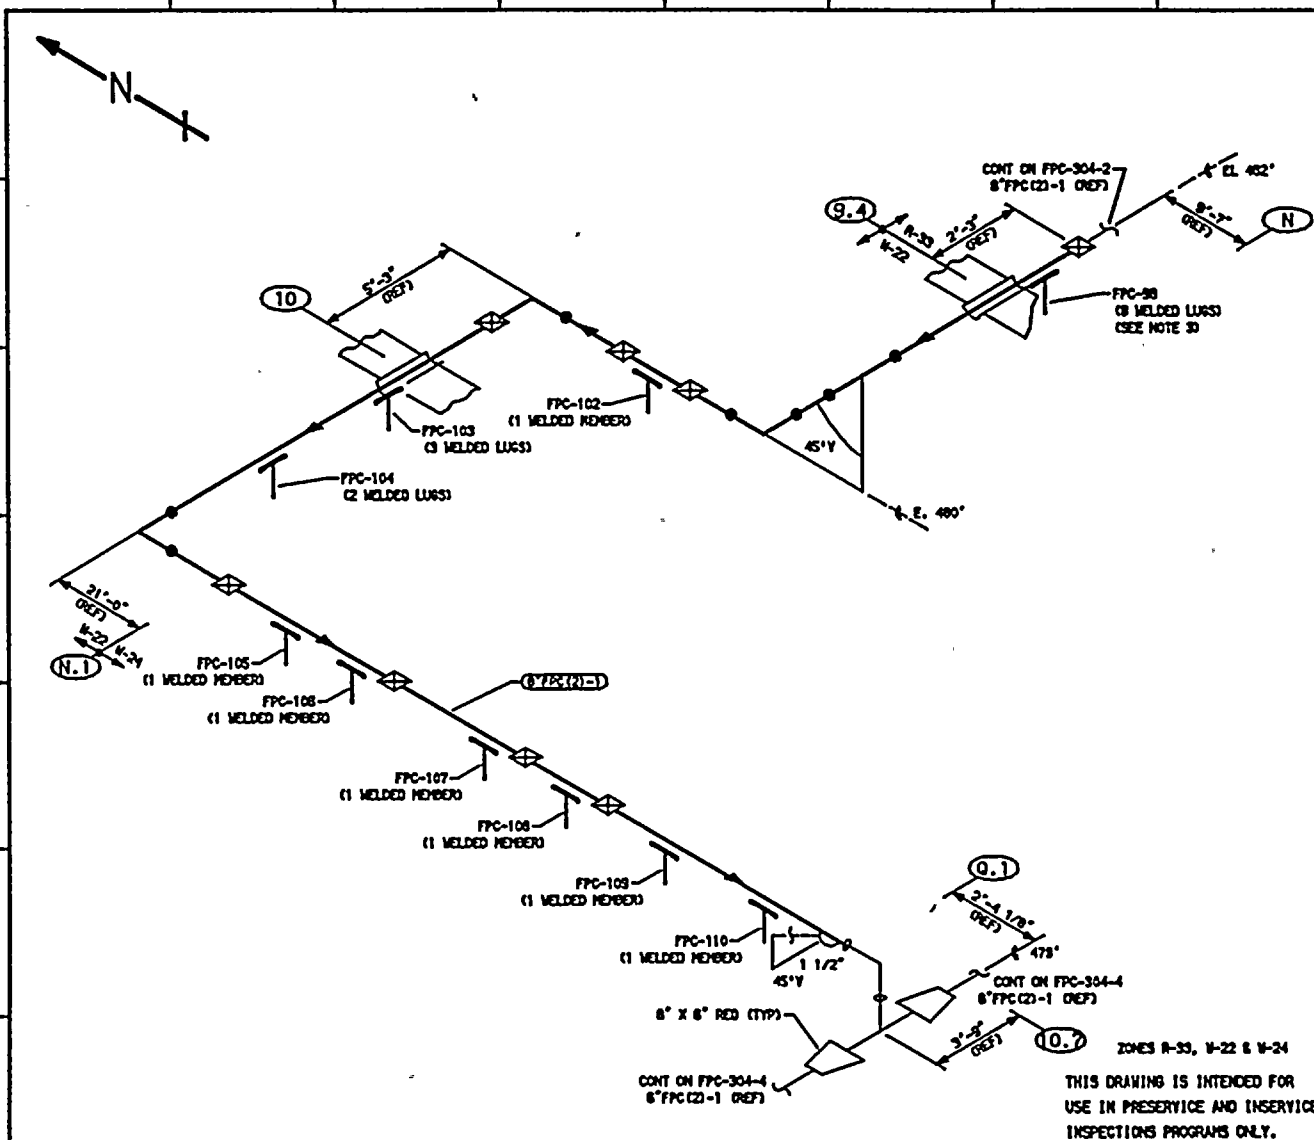

- NOTES:**
1. THIS DRAWING IDENTIFIES PIPING AND COMPONENTS SUBJECT ONLY TO A VISUAL EXAM FOR (1) EVIDENCE OF LEAKAGE DURING SYSTEM PRESSURE OR OPERABILITY TESTS, (2) PRESSURE DECAY TESTS OF BURIED PIPING, AND (3) LOSS OF SUPPORT CAPABILITY OR INADEQUATE RESTRAINT FOR SUPPORTS AND HANGERS ON PIPING EXCEEDING 4" NOM. TESTS SHALL BE CONDUCTED PER ASME SECTION XI, ARTICLES 11A-5000 AND 11A-2000.
  2. FOR BRANCH PIPING 4" NOM. OR LESS CONNECTION SHOWN IN DASHED LINES) EXTEND VISUAL LEAKAGE EXAM THROUGH THE OUTERMOST NORMALLY CLOSED NUCLEAR CLASS VALVE, OR UNTIL TRANSITION TO INSTRUMENT TUBING, UNLESS OTHERWISE NOTED.
  3. COMPONENT SUPPORT IS INACCESSIBLE DUE TO FOAM FILLED WATER TIGHT BOOT.

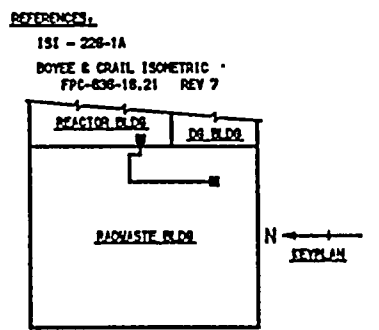

QUALITY CLASS, 11	ASME CODE CLASS, 3
ENGR, K-McANDREWM	DATE, 4-12-79

WASHINGTON PUBLIC POWER  
 SUPPLY SYSTEM  
 RIDLAND, WASHINGTON 98352

PIPING SYSTEM	NOM DIA (IN)	SCH	NOM WALL THK	MATERIAL SPECIFICATION	MATL TYPE	CAL BLOCK NO
8" FPC (2)-1	8	STD	0.322	SA 106 GR B	CS	NA


NO	DATE	REVISION	BY	CHKD	APVD
2	11-13-82	ADDED ISI DRAWING REFERENCE & DRAWING LINE CONTINUATION, MODIFIED KEYPLAN & LOGO. RECDRAWN	K-McA	DPR	DRW
1	1-24-84	REVISED AS NOTED. ADDED KEYPLAN	K-McA	DPR	TPH
0	12-2-81	ISSUED FOR USE	K-McA	DPR	TPH

WP-2  
 WELD & COMPONENT  
 IDENTIFICATION DIAGRAM

TITLE:  
 FPC-P-1A & 1B DISCHARGE TO FPC-DH-1A & 1B


DWG NO. FPC-304-3

REV 2

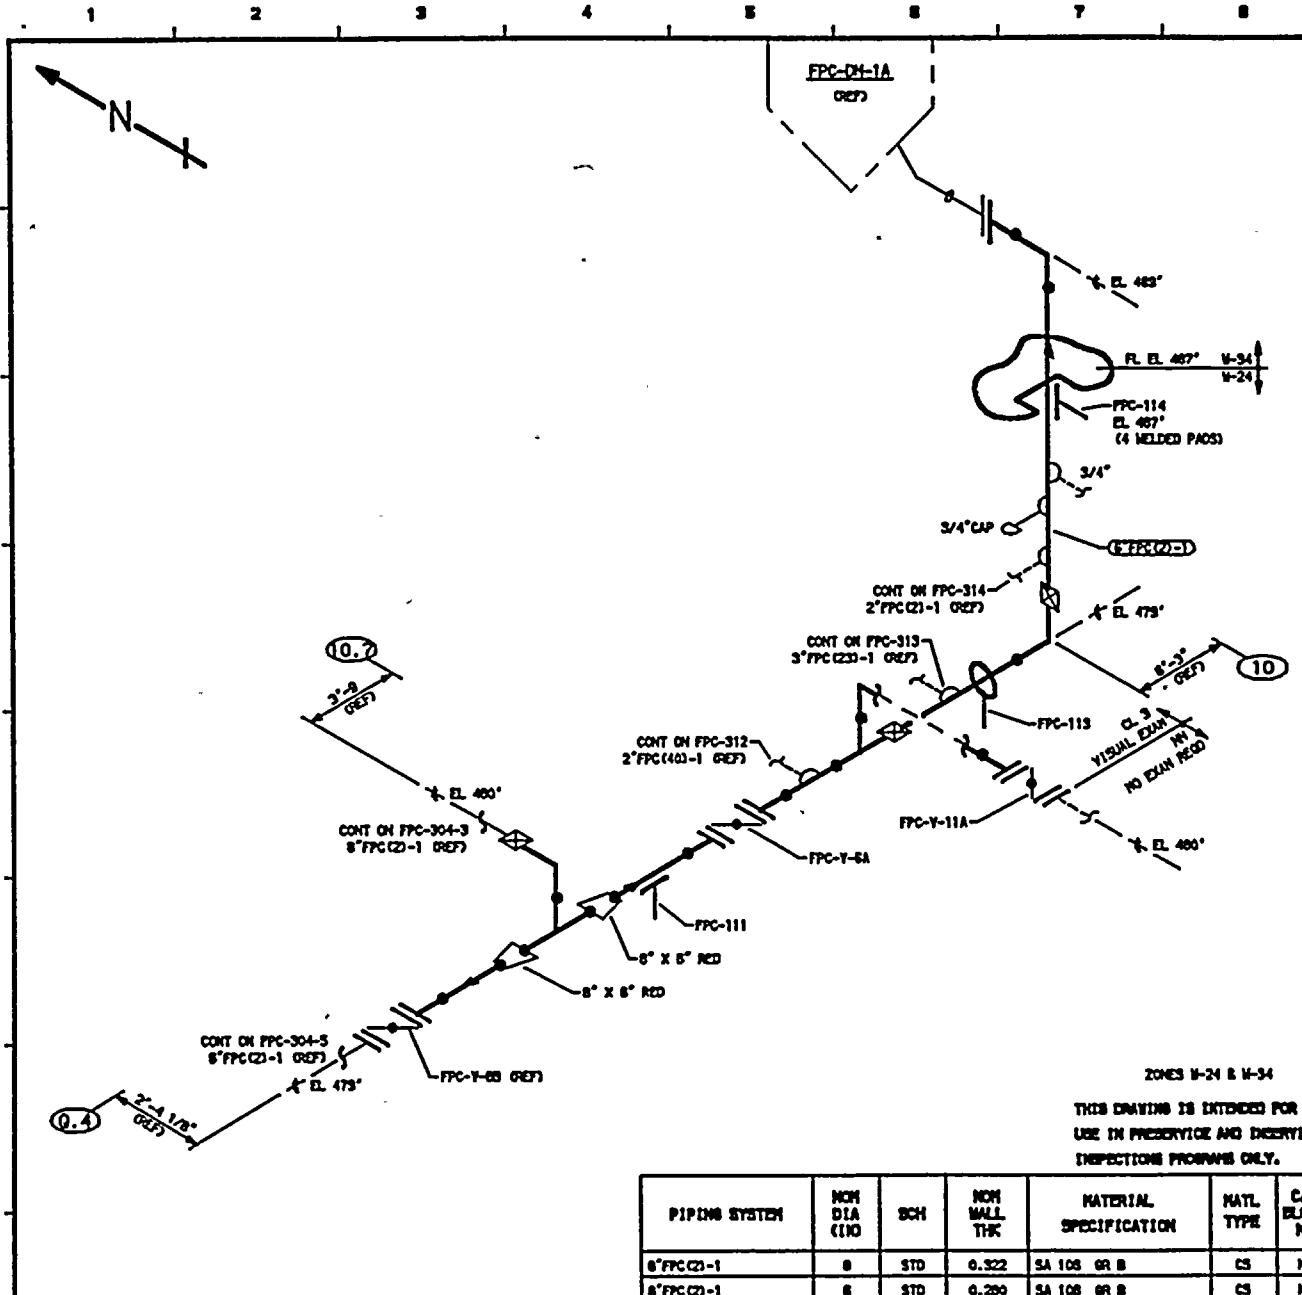

- NOTES:**
1. THIS DRAWING IDENTIFIES PIPING AND COMPONENTS SUBJECT ONLY TO A VISUAL EXAM FOR (1) EVIDENCE OF LEAKAGE DURING SYSTEM PRESSURE OR OPERABILITY TESTS, (2) PRESSURE DECAY TESTS OF BURIED PIPING, AND (3) LOSS OF SUPPORT CAPABILITY OR INADEQUATE RESTRAINT FOR SUPPORTS AND HANGERS ON PIPING EXCEEDING 4" NOM. TESTS SHALL BE CONDUCTED PER ASME SECTION XI, ARTICLES 11A-5000 AND 11A-2000.
  2. FOR BRANCH PIPING 4" NOM. OR LESS CONNECTION SHOWN IN DASHED LINES) EXTEND VISUAL LEAKAGE EXAM THROUGH THE OUTERMOST NORMALLY CLOSED NUCLEAR CLASS VALVE, OR UNTIL TRANSITION TO INSTRUMENT TUBING, UNLESS OTHERWISE NOTED.

**REFERENCE:**  
 ISI - 228-2  
 BOYCE & CRAIG ISOMETRICS  
 FPC-836-22.24 REV 3  
 FPC-836-25.26 REV 4

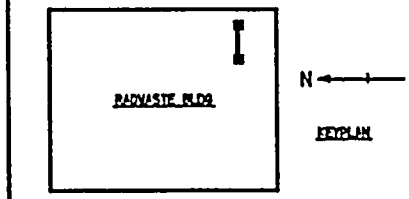

QUALITY CLASS: 2      ASME CODE CLASS: 3  
 ENGR: K-MOANDREX    DRAWN: K-MoA    DATE: 4-12-78

WASHINGTON PUBLIC POWER  
 SUPPLY SYSTEM  
 RICHLAND, WASHINGTON 99352

WPP-2  
 WELD & COMPONENT  
 IDENTIFICATION DIAGRAM


TITLE:  
 FPC-P-1A & 1B DISCHARGE TO FPC-DH-1A & 1B

DWG NO: FPC-304-4      REV 1

ZONES U-24 & U-34  
 THIS DRAWING IS EXTENDED FOR  
 USE IN PRESERVICE AND EMERGENCY  
 INSPECTIONS PROGRAMS ONLY.


PIPING SYSTEM	NOM DIA (IN)	SCH	NOM WALL THK	MATERIAL SPECIFICATION	MATL TYPE	CAL BLOCK NO
8" FPC(C2)-1	8	STD	0.322	SA 108 GR B	CS	NA
8" FPC(C2)-1	8	STD	0.290	SA 108 GR B	CS	NA

NO	DATE	REVISION	BY	CHKD	APVD
1	10-18-87	ADDED DWS CONT, KEYPLAN, REDRAWN	K-MoA	DPR	TFH
0	12-2-81	ISSUED FOR USE	K-MoA	DPR	TFH

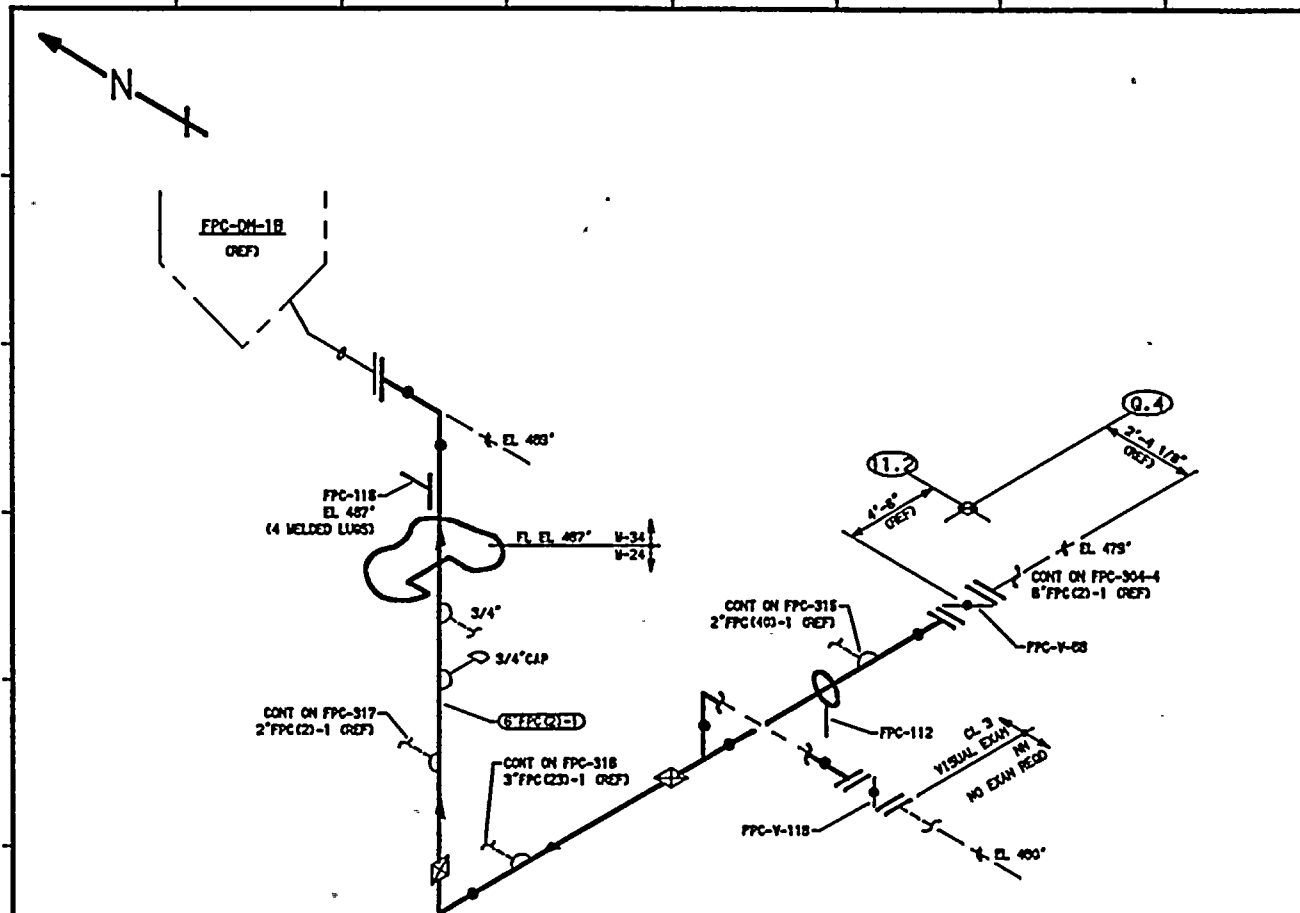

- NOTES:**
1. THIS DRAWING IDENTIFIES PIPING AND COMPONENTS SUBJECT ONLY TO A VISUAL EXAM FOR (1) EVIDENCE OF LEAKAGE DURING SYSTEM PRESSURE OR OPERABILITY TESTS; (2) PRESSURE DECAY TESTS OF BURIED PIPING; AND (3) LOSS OF SUPPORT CAPABILITY OR INADEQUATE RESTRAINT FOR SUPPORTS AND HANGERS ON PIPING EXCEEDING 4" NOM. TESTS SHALL BE CONDUCTED PER ASME SECTION XI, ARTICLES 1WA-5000 AND 1W-2000.
  2. FOR BRANCH PIPING 4" NOM. OR LESS CONNECTION SHOWN IN DASHED LINES) EXTEND VISUAL LEAKAGE EXAM THROUGH THE OUTERMOST NORMALLY CLOSED NUCLEAR CLASS VALVE, OR UNTIL TRANSITION TO INSTRUMENT TUBING, UNLESS OTHERWISE NOTED.

- REFERENCES:**
- ISI - 226-2
  - BOYCE & GRILL ISOMETRICS  
FPC-436-22.24 REV 3  
FPC-636-27.26 REV 4

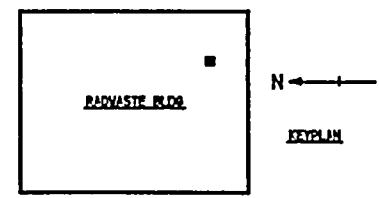

ZONES W-24 & W-34  
THIS DRAWING IS INTENDED FOR USE IN PRESERVICE AND EMERGENCY INSPECTIONS PROGRAMS ONLY.

PIPING SYSTEM	NOM DIA (IN)	SCH	NOM WALL THK	MATERIAL SPECIFICATION	MATL TYPE	CAL BLOCK NO
8" FPC(C2)-1	8	STD	0.200	SA 106 GR B	CS	NA

QUALITY CLASS: 2 | ASME CODE CLASS: 3  
ENGR: K-MoANDREU | DRAWN: K-MoA | DATE: 4-12-78

**WASHINGTON PUBLIC POWER SUPPLY SYSTEM**  
RICHLAND, WASHINGTON BUREAU

**WPP-2 WELD & COMPONENT IDENTIFICATION DIAGRAM**


TITLE:  
FPC-P-1A & 1B DISCHARGE TO FPC-DH-1B

NO	DATE	REVISION	BY	CHKD	APVD
1	10-15-67	ADDED DWG CONT, KEYPLAN, REDRAW	K-MoA	DPR	TFH
0	12-2-61	ISSUED FOR USE	K-MoA	DPR	TFH

DWG NO: FPC-304-5 | REV 1






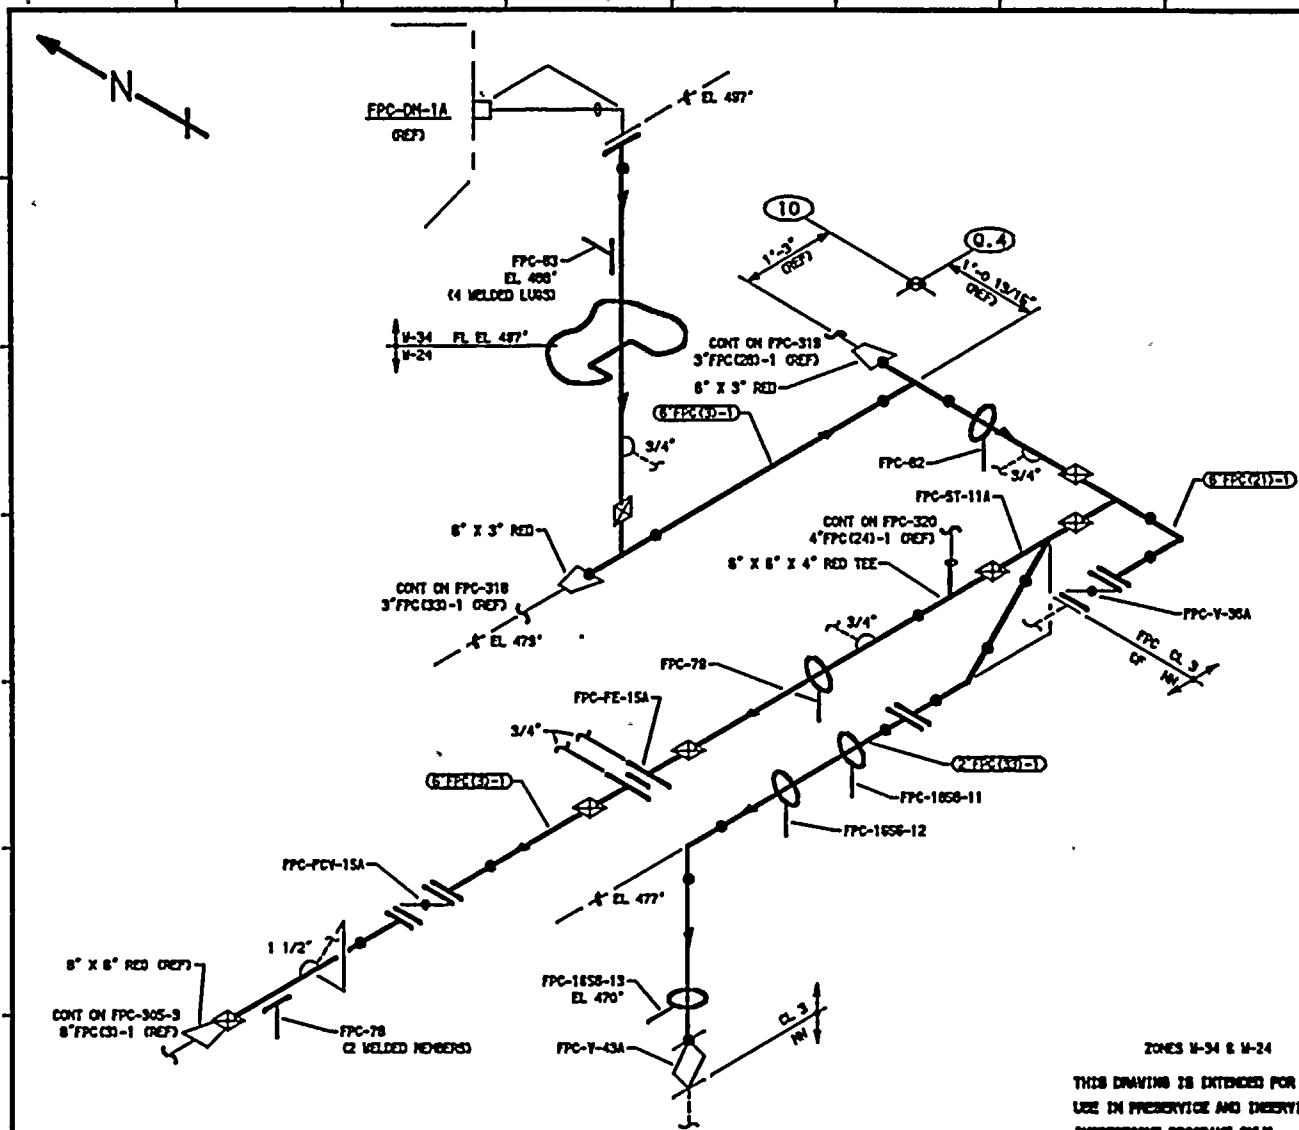

- NOTES:**
1. THIS DRAWING IDENTIFIES PIPING AND COMPONENTS SUBJECT ONLY TO A VISUAL EXAM FOR (1) EVIDENCE OF LEAKAGE DURING SYSTEM PRESSURE OR OPERABILITY TESTS, (2) PRESSURE DECAY TESTS OF BURIED PIPING, AND (3) LOSS OF SUPPORT CAPABILITY OR INADEQUATE RESTRAINT FOR SUPPORTS AND HANGERS ON PIPING EXCEEDING 4" NOM. TESTS SHALL BE CONDUCTED PER ASME SECTION II, ARTICLES 11A-5000 AND 11D-2000.
  2. FOR BRANCH PIPING 4" NOM. OR LESS (CONNECTION SHOWN IN DASHED LINES) EXTEND VISUAL LEAKAGE EXAM THROUGH THE OUTERMOST NORMALLY CLOSED NUCLEAR CLASS VALVE, OR UNTIL TRANSITION TO INSTRUMENT TUBING, UNLESS OTHERWISE NOTED.

- REFERENCES:**
- ISI - 228-2
  - BOYCE & CRAIG ISOMETRICS
  - FPC-840-24.25 REY 2
  - FPC-840-20.23 REY 5
  - FPC-1858-1 REY 5

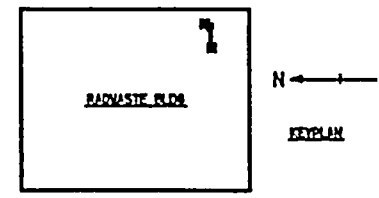

QUALITY CLASS. 2 ASME CODE CLASS. 3  
 ENGR. K-McANDREWM DRAWN. K-McA DATE. 4-17-78

WASHINGTON PUBLIC POWER  
 SUPPLY SYSTEM  
 RICHMOND, WASHINGTON 98942

WPP-2  
 WELD & COMPONENT  
 IDENTIFICATION DIAGRAM


TITLE: FPC-DN-1A RETURN

DWG NO. FPC-305-1 REY 2

ZONES U-34 & U-24  
 THIS DRAWING IS INTENDED FOR  
 USE IN PRESERVICE AND INSERVICE  
 INSPECTIONS PROGRAMS ONLY.


PIPING SYSTEM	NOM DIA (IN)	SCH	NOM WALL THK	MATERIAL SPECIFICATION	MATL TYPE	CAL BLOCK NO
8" FPC C31-1	8	STD	0.280	SA 106 GR B	CS	NA
8" FPC C213-1	8	STD	0.280	SA 106 GR B	CS	NA
2" FPC C333-1	2	80	0.218	SA 106 GR B	CS	NA

NO	DATE	REVISION	BY	CHKD	APVD
2	10-16-87	ADDED CONT DWG, 2" FPC C333-1, REDRAIN	K-McA	DPR	TFH
1	1-24-84	REVISED AS NOTED ADDED KEYPLAN	K-McA	DPR	TFH
0	12-2-81	ISSUED FOR USE	K-McA	DPR	TFH

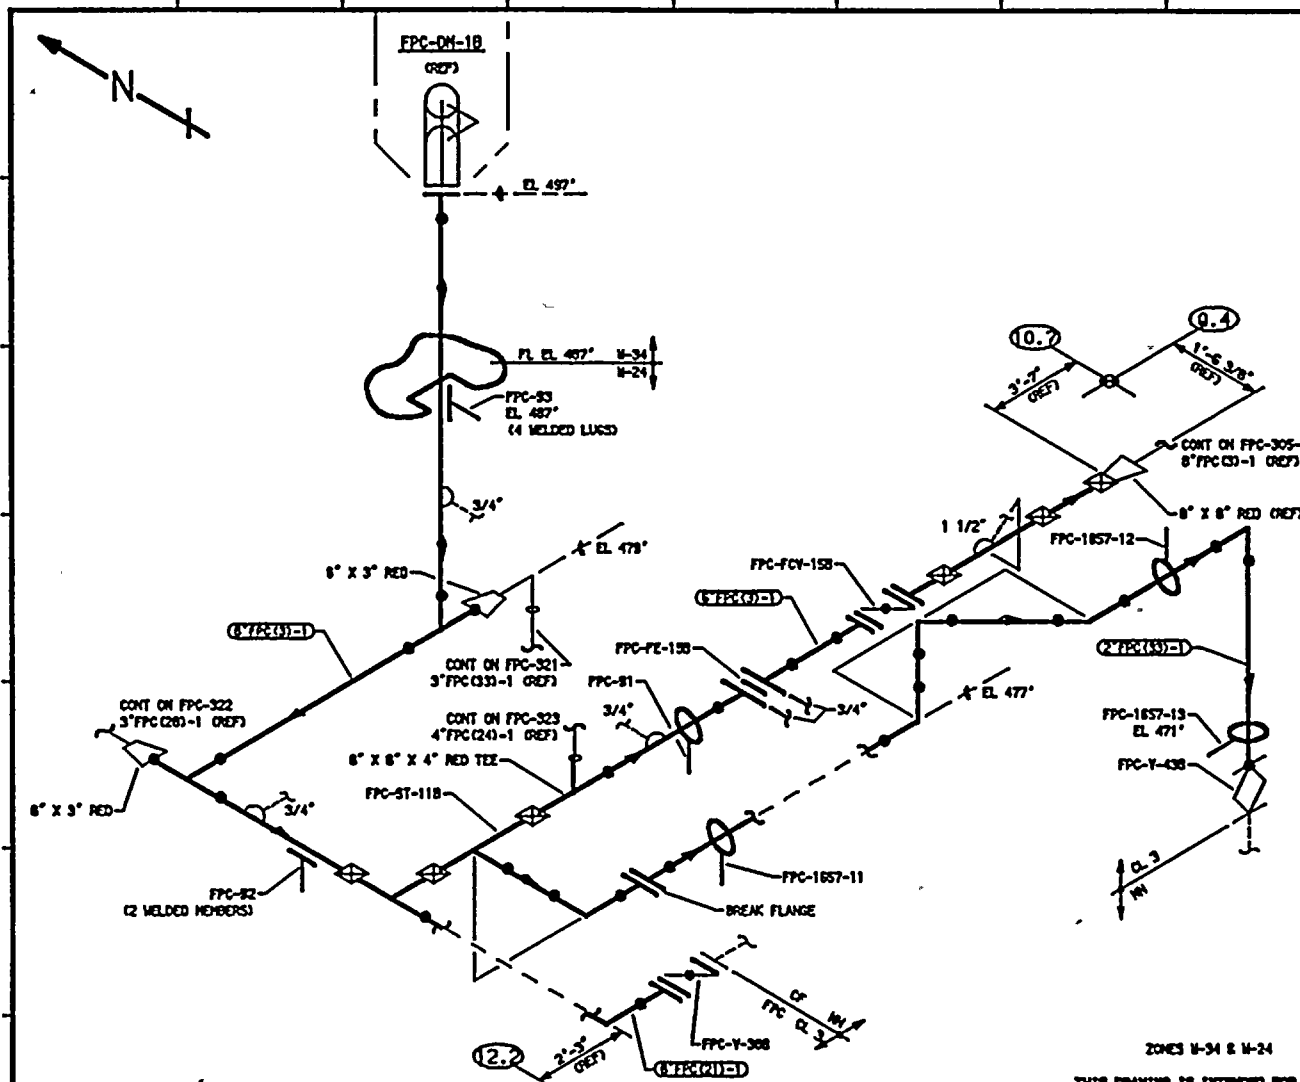

- NOTES:**
1. THIS DRAWING IDENTIFIES PIPING AND COMPONENTS SUBJECT ONLY TO A VISUAL EXAM FOR (1) EVIDENCE OF LEAKAGE DURING SYSTEM PRESSURE OR OPERABILITY TESTS; (2) PRESSURE DECAY TESTS OF BURIED PIPING; AND (3) LOSS OF SUPPORT CAPABILITY OR INADEQUATE RESTRAINT FOR SUPPORTS AND HANGERS ON PIPING EXCEEDING 4" NOM. TESTS SHALL BE CONDUCTED PER ASME SECTION XI, ARTICLES 1WA-5000 AND 1W-2000.
  2. FOR BRANCH PIPING 4" NOM. OR LESS CONNECTION SHOWN IN DASHED LINES EXTEND VISUAL LEAKAGE EXAM THROUGH THE OUTERMOST NORMALLY CLOSED NUCLEAR CLASS VALVE, OR UNTIL TRANSITION TO INSTRUMENT TUBING, UNLESS OTHERWISE NOTED.

- REFERENCES:**
- 151 - 226-2
  - BOYCE & CRILL (ISOMETRICS)
  - FPC-840-29.30 REV 3
  - FPC-840-28.28 REV 6
  - FPC-1857-1 REV 2

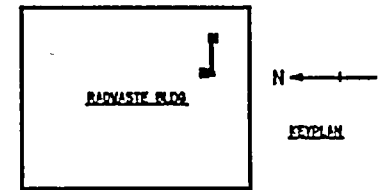

ZONES M-34 & M-24  
 THIS DRAWING IS INTENDED FOR  
 USE IN PRE-SERVICE AND IN-SERVICE  
 INSPECTIONS PROGRAMS ONLY.

PIPING SYSTEM	NOM DIA (IN)	SCH	NOM WALL THK	MATERIAL SPECIFICATION	MATL TYPE	CAL BLOCK NO
6" FPC (33)-1	6	STD	0.250	SA 106 GR B	CS	NA
6" FPC (21)-1	6	STD	0.250	SA 106 GR B	CS	NA
2" FPC (33)-1	2	80	0.218	SA 106 GR B	CS	NA

NO	DATE	REVISION	BY	CHKD	APVD
2	10-16-87	ADDED CONT DWG, 2" FPC (33)-1, REDRAWN	K-NoA	DPR	TFH
1	1-24-84	REVISED AS NOTED ADDED KEYPLAN	K-NoA	DPR	TFH
0	12-2-81	ISSUED FOR USE	K-NoA	DPR	TFH


QUALITY CLASS: 2 | ASME CODE CLASS: 3  
 ENGR: K-NoANDREH | DRAWING: K-NoA | DATE: 4-18-78

WASHINGTON PUBLIC POWER  
 SUPPLY SYSTEM  
 ROCKLAND, WASHINGTON BUREAU

WPP-2  
 WELD & COMPONENT  
 IDENTIFICATION DIAGRAM

TITLE: FPC-DN-1B RETURN

DWG NO. FPC-305-2 | REV 2

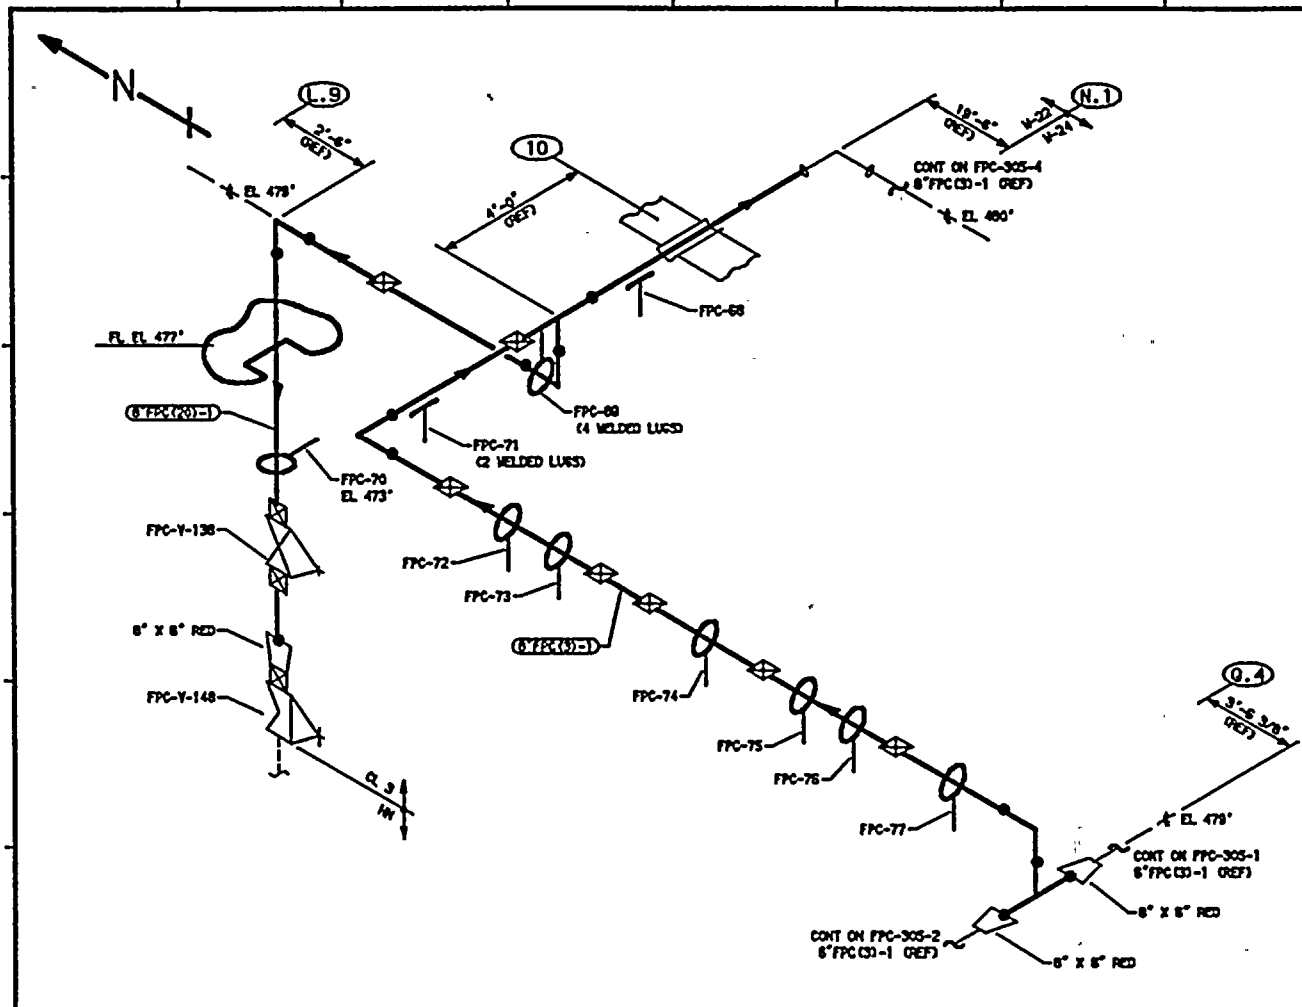


**NOTES:**

- THIS DRAWING IDENTIFIES PIPING AND COMPONENTS SUBJECT ONLY TO A VISUAL EXAM FOR (1) EVIDENCE OF LEAKAGE DURING SYSTEM PRESSURE OR OPERABILITY TESTS, (2) PRESSURE DECAY TESTS OF BURIED PIPING, AND (3) LOSS OF SUPPORT CAPABILITY OR INADEQUATE RESTRAINT FOR SUPPORTS AND HANGERS ON PIPING EXCEEDING 4" NOM. TESTS SHALL BE CONDUCTED PER ASME SECTION XI, ARTICLES 11A-5000 AND 11A-2000.

**REFERENCES:**

ISI - 228-1A  
 BOYCE & CRILL ISOMETRICS  
 FPC-840-17.13 REV 2  
 FPC-840-13.18 REV 9

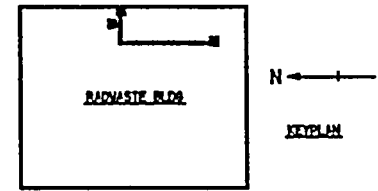

ZONES W-24 & W-34

THIS DRAWING IS INTENDED FOR USE IN PRESERVICE AND INSERVICE INSPECTIONS PROGRAMS ONLY.

PIPING SYSTEM	NOM DIA (INO)	SCH	NOM WALL THK	MATERIAL SPECIFICATION	MATL TYPE	CAL BLOCK NO
8" FPC CD-1	8	STD	0.322	SA 106 GR B	CS	NA
8" FPC CD-1	8	STD	0.322	SA 106 GR B	CS	NA

NO	DATE	REVISION	BY	CHKD	APVD
2	10-18-87	ADDED 8" X 6" RED, FPC-Y-146, REDRAWN	K-MoA	DPR	TFH
1	1-24-84	REVISED AS NOTED ADDED KEYPLAN	K-MoA	DPR	TFH
0	12-2-81	ISSUED FOR USE	K-MoA	DPR	TFH

QUALITY CLASS: 2 ASME CODE CLASS: 3  
 ENGR: K-MoANDREW | DRAWN: K-MoA | DATE: 4-18-78




WASHINGTON PUBLIC POWER  
 SUPPLY SYSTEM  
 RICHLAND, WASHINGTON BASE


MWP-2  
 WELD & COMPONENT  
 IDENTIFICATION DIAGRAM

TITLE:  
 FPC-DH-1A & 1B RETURN

DWG NO: FPC-305-3 REV 2

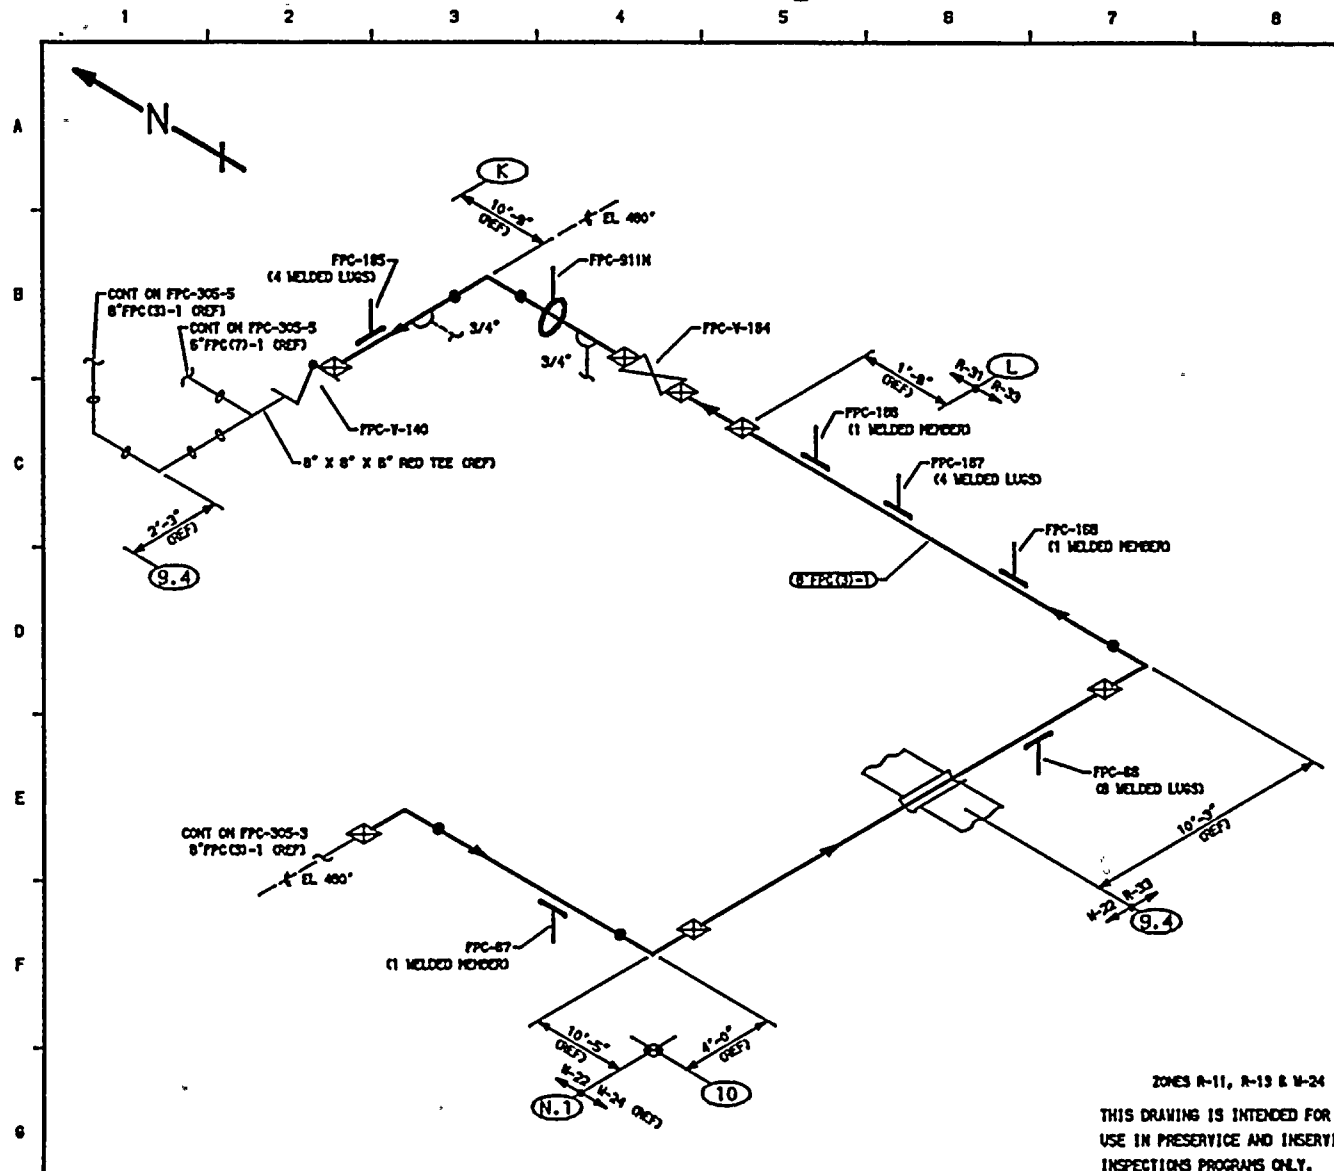

- NOTES:**
1. THIS DRAWING IDENTIFIES PIPING AND COMPONENTS SUBJECT ONLY TO A VISUAL EXAM FOR (1) EVIDENCE OF LEAKAGE DURING SYSTEM PRESSURE OR OPERABILITY TESTS, (2) PRESSURE DECAY TESTS OF BURIED PIPING, AND (3) LOSS OF SUPPORT CAPABILITY OR INADEQUATE RESTRAINT FOR SUPPORTS AND HANGERS ON PIPING EXCEEDING 4" NOM. TESTS SHALL BE CONDUCTED PER ASME SECTION XI, ARTICLES 1NA-5000 AND 1NO-2000.
  2. FOR BRANCH PIPING 4" NOM. OR LESS (CONNECTION SHOWN IN DASHED LINES) EXTEND VISUAL LEAKAGE EXAM THROUGH THE OUTERMOST NORMALLY CLOSED NUCLEAR CLASS VALVE, OR UNTIL TRANSITION TO INSTRUMENT TUBING, UNLESS OTHERWISE NOTED.

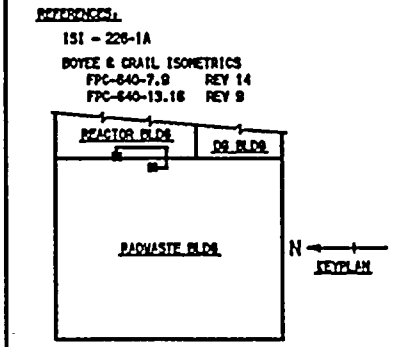

QUALITY CLASS: 11 ASME CODE CLASS: 3  
 ENGR: K-McANDREW DRAWN: K-McA DATE: 4-19-79

WASHINGTON PUBLIC POWER  
 SUPPLY SYSTEM  
 R10LAND, WASHINGTON 98352

ZONES R-11, R-13 & W-24  
 THIS DRAWING IS INTENDED FOR  
 USE IN PRESERVICE AND INSERVICE  
 INSPECTIONS PROGRAMS ONLY.


PIPING SYSTEM	NOM DIA (IN)	SCH	NOM WALL THK	MATERIAL SPECIFICATION	MATL TYPE	CAL BLOCK NO
8" FPC(3)-1	8	STD	0.322	SA 106 GR B	CS	NA

NO	DATE	REVISION	BY	CHKD	APVD
2	11-13-82	ADDED ISI DRAWING REFERENCE & DRAWING LINE CONTINUATION, MODIFIED KEYPLAN & LOGO, REDESIGN	K-McA	DPR	DRV
1	1-24-84	REVISED AS NOTED, ADDED KEYPLAN	K-McA	DPR	TTH
0	12-2-81	ISSUED FOR USE	K-McA	DPR	TTH

WP-2  
 WELD & COMPONENT  
 IDENTIFICATION DIAGRAM


TITLE:  
 FPC-DH-1A & 1B RETURN

DWG NO: FPC-305-4 REV 2

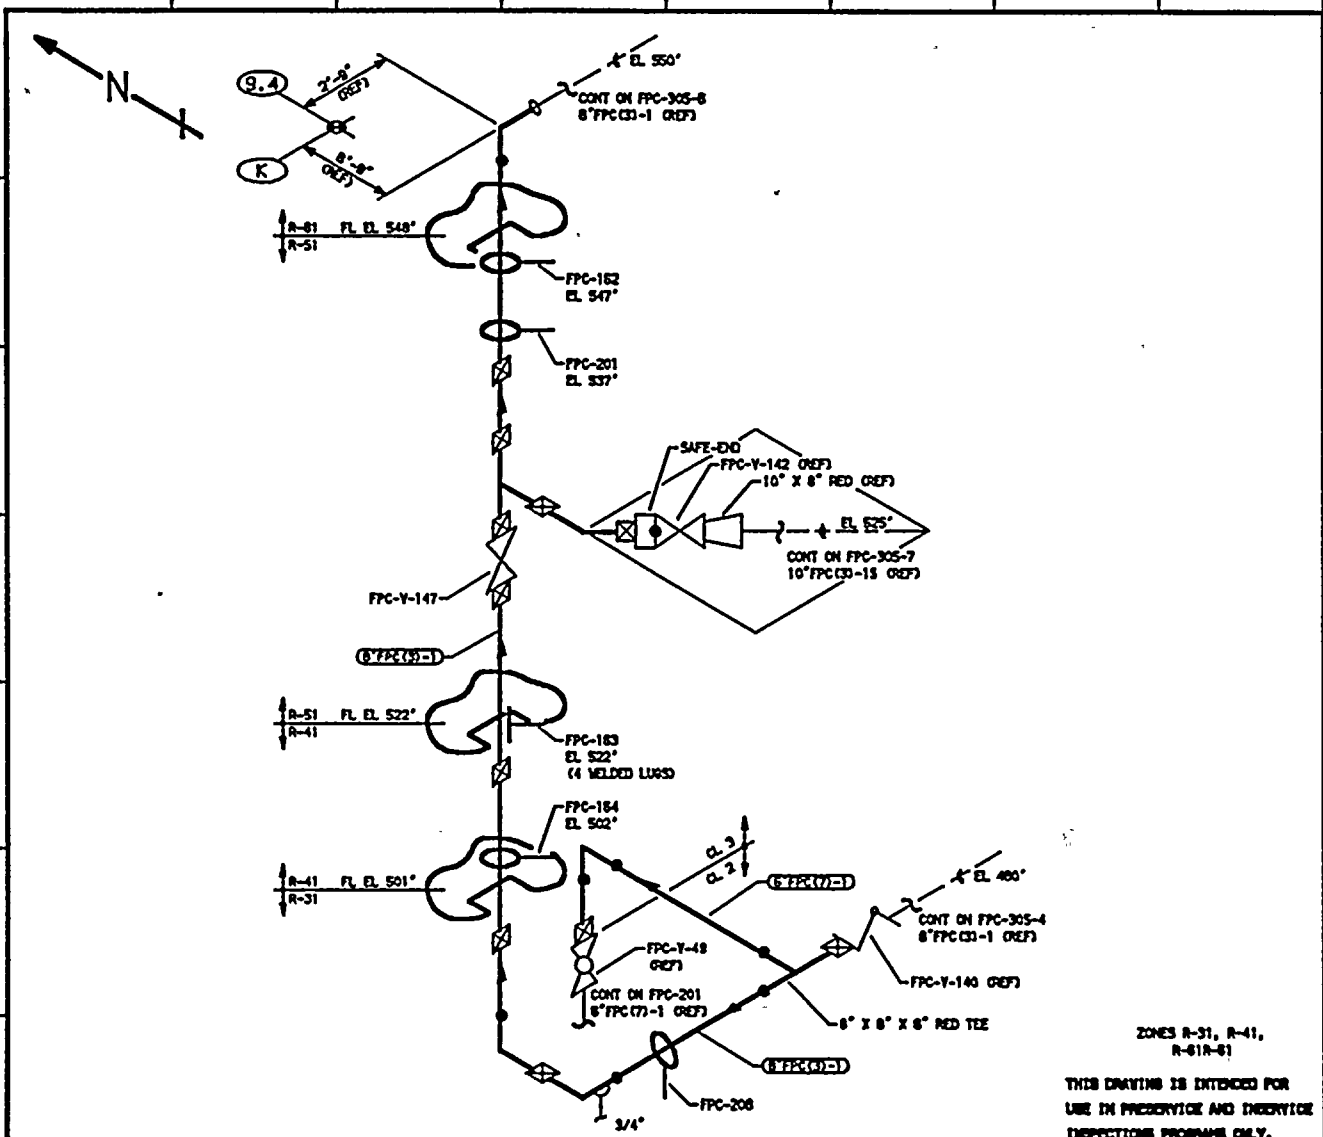

- NOTES:**
1. THIS DRAWING IDENTIFIES PIPING AND COMPONENTS SUBJECT ONLY TO A VISUAL EXAM FOR (1) EVIDENCE OF LEAKAGE DURING SYSTEM PRESSURE OR OPERABILITY TESTS; (2) PRESSURE DECAY TESTS OF BURIED PIPING; AND (3) LOSS OF SUPPORT CAPABILITY OR INADEQUATE RESTRAINT FOR SUPPORTS AND HANGERS ON PIPING EXCEEDING 4" NOM. TESTS SHALL BE CONDUCTED PER ASME SECTION XI, ARTICLES 11A-5000 AND 11A-2000.
  2. FOR BRANCH PIPING 4" NOM. OR LESS (CONNECTION SHOWN IN DASHED LINES) EXTEND VISUAL LEAKAGE EXAM THROUGH THE OUTERMOST NORMALLY CLOSED NUCLEAR CLASS VALVE, OR UNTIL TRANSITION TO INSTRUMENT TUBING, UNLESS OTHERWISE NOTED.

- REFERENCES:**
- 151 - 226-1A
  - BOYCE & ORAL ISOMETRICS
  - FPC-840-1.8 REV 8
  - FPC-840-7.8 REV 14

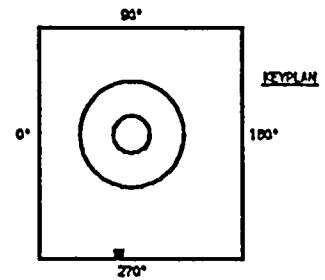

ZONES R-31, R-41, R-61R-61

THIS DRAWING IS INTENDED FOR USE IN PRESERVICE AND INSERVICE INSPECTIONS PROGRAMS ONLY.

QUALITY CLASS. 2 | ASME CODE CLASS. 3  
 ENGR. K-MoANDREW | DRAWN. K-MoA | DATE. 4-18-78



WASHINGTON PUBLIC POWER  
 SUPPLY SYSTEM  
 RICHLAND, WASHINGTON 99352


PIPING SYSTEM	NOM DIA (IN)	SCH	NOM WALL THK	MATERIAL SPECIFICATION	MATL TYPE	CAL BLOCK NO
8" FPC (3)-1	8	STD	0.322	SA 106 GR B	CS	NA
8" FPC (7)-1	8	STD	0.280	SA 106 GR B	CS	NA

NO	DATE	REVISION	BY	CHKD	APPD
2	10-16-87	CHANGED FPC-210 TO FPC-201. CORRECTED NUMBER ELEVATIONS. ADDED (1) FOR REF. (LINE CONT. & LONG. NO KEYPLAN REDRAWN)	K-MoA	DPR	TFM
1	1-24-84	GENERAL UPDATE REDRAWN	K-MoA	DPR	TFM
0	12-2-81	ISSUED FOR USE	K-MoA	DPR	TFM

WPP-2  
 WELD & COMPONENT  
 IDENTIFICATION DIAGRAM

TITLE:  
 FPC-DH-1A & 1B RETURN


DWG NO: FPC-305-5 | REV 2

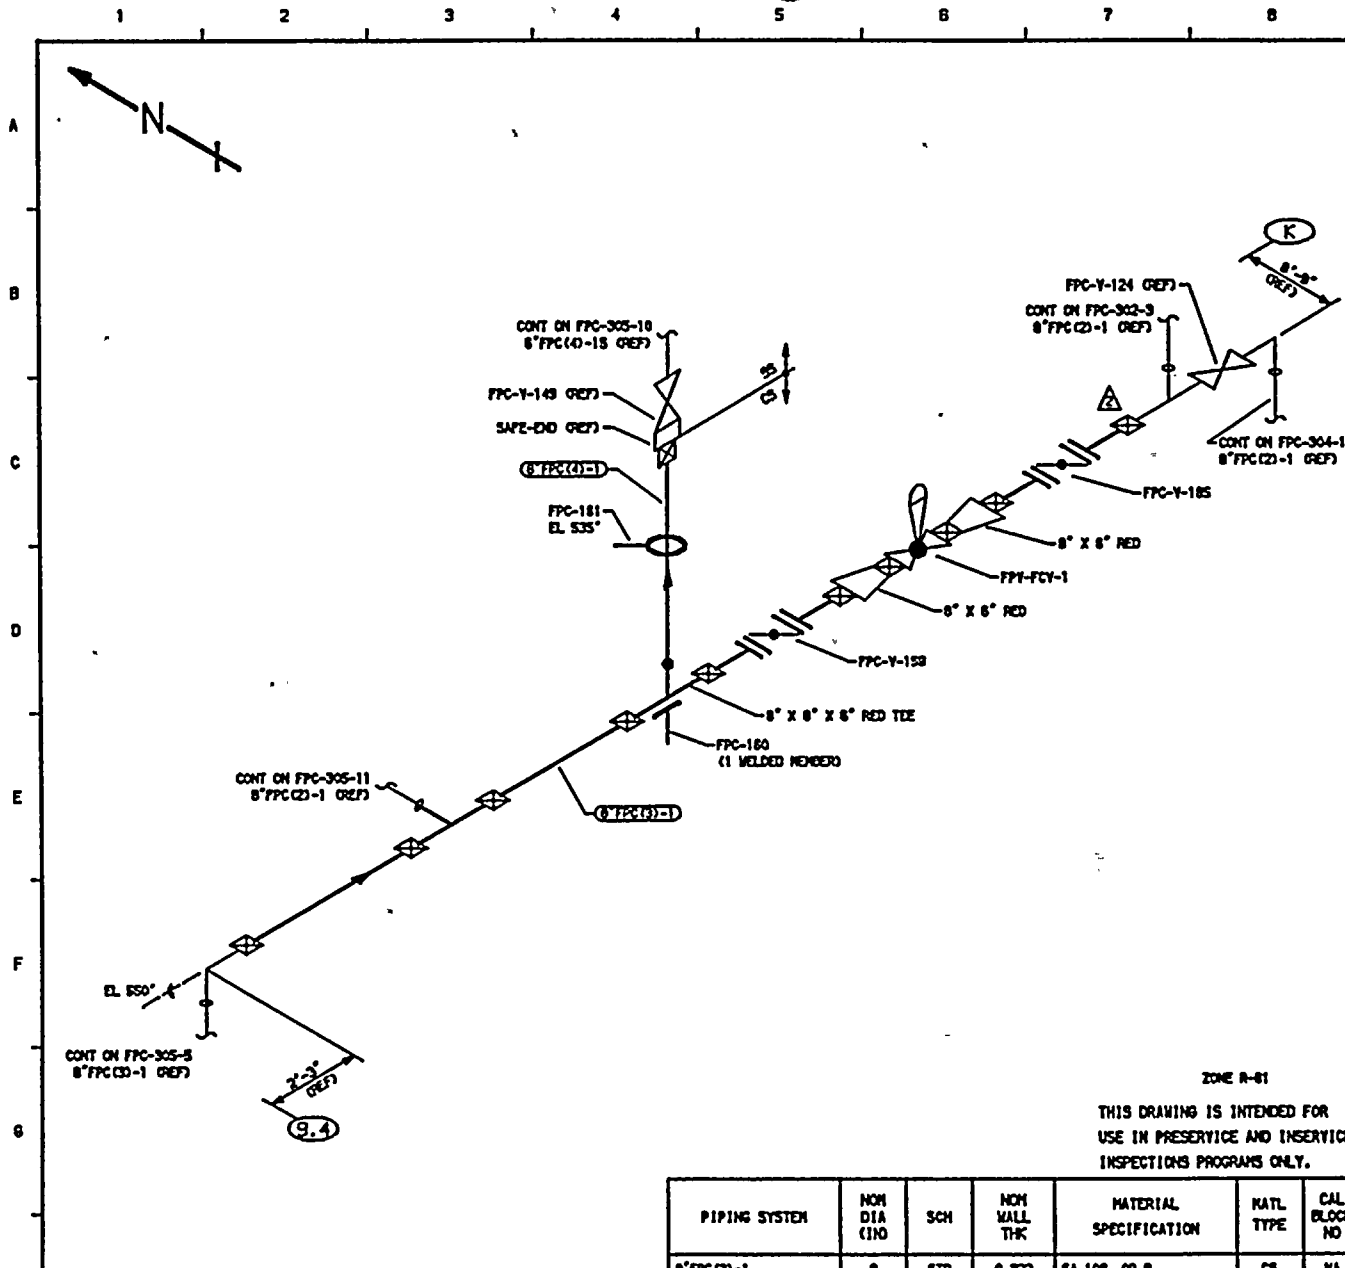

- NOTES:**
1. THIS DRAWING IDENTIFIES PIPING AND COMPONENTS SUBJECT ONLY TO A VISUAL EXAM FOR (1) EVIDENCE OF LEAKAGE DURING SYSTEM PRESSURE OR OPERABILITY TESTS; (2) PRESSURE DECAY TESTS OF BURIED PIPING; AND (3) LOSS OF SUPPORT CAPABILITY OR INADEQUATE RESTRAINT FOR SUPPORTS AND HANGERS ON PIPING EXCEEDING 4" NOM. TESTS SHALL BE CONDUCTED PER ASME SECTION XI, ARTICLES 1WA-5000 AND 1WD-2000.
  2. FOR BRANCH PIPING 4" NOM. OR LESS (CONNECTION SHOWN IN DASHED LINES) EXTEND VISUAL LEAKAGE EXAM THROUGH THE OUTERMOST NORMALLY CLOSED NUCLEAR CLASS VALVE, OR UNTIL TRANSITION TO INSTRUMENT TUBING, UNLESS OTHERWISE NOTED.

**REFERENCES:**

ISI - 226-1A  
 BOYCE & GRILL ISOMETRIC  
 FPC-640-1.B REV 9

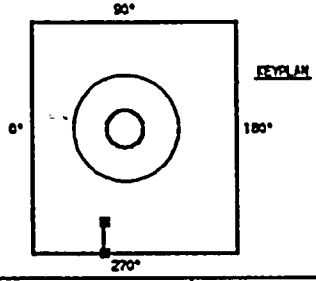

ZONE R-81

THIS DRAWING IS INTENDED FOR USE IN PRESERVICE AND INSERVICE INSPECTIONS PROGRAMS ONLY.

QUALITY CLASS: 11	ASME CODE CLASS: 3
ENGR: K-McANDREW	DRAWN: K-McA DATE: 4-23-79



WASHINGTON PUBLIC POWER  
 SUPPLY SYSTEM  
 RIDGELAND, WASHINGTON 98362


PIPING SYSTEM	NOM DIA (INO)	SCH	NOM WALL THK	MATERIAL SPECIFICATION	MATL TYPE	CAL BLOCK NO
8" FPC C3-1	8	STD	0.322	SA 106 GR B	CS	NA
8" FPC (4)-1	8	STD	0.280	SA 106 GR B	CS	NA

NO	DATE	REVISION	BY	CHKD	APVD
2	11-13-82	ADDED ISI DRAWING REFERENCE, DRAWING LINE CONTINUATION & FIELD WELD IN C-7, MODIFIED KEYPLAN & LOGS, REGRAB	K-McA	DPR	DRM
1	1-24-84	REVISED AS NOTED, ADDED KEYPLAN	K-McA	DPR	TPH
0	12-2-81	ISSUED FOR USE	K-McA	DPR	TPH
		REVISION			

INP-2  
 WELD & COMPONENT  
 IDENTIFICATION DIAGRAM


TITLE:  
 FPC-DH-1A & 1B RETURN

DWG NO: FPC-305-8  
 REV 2

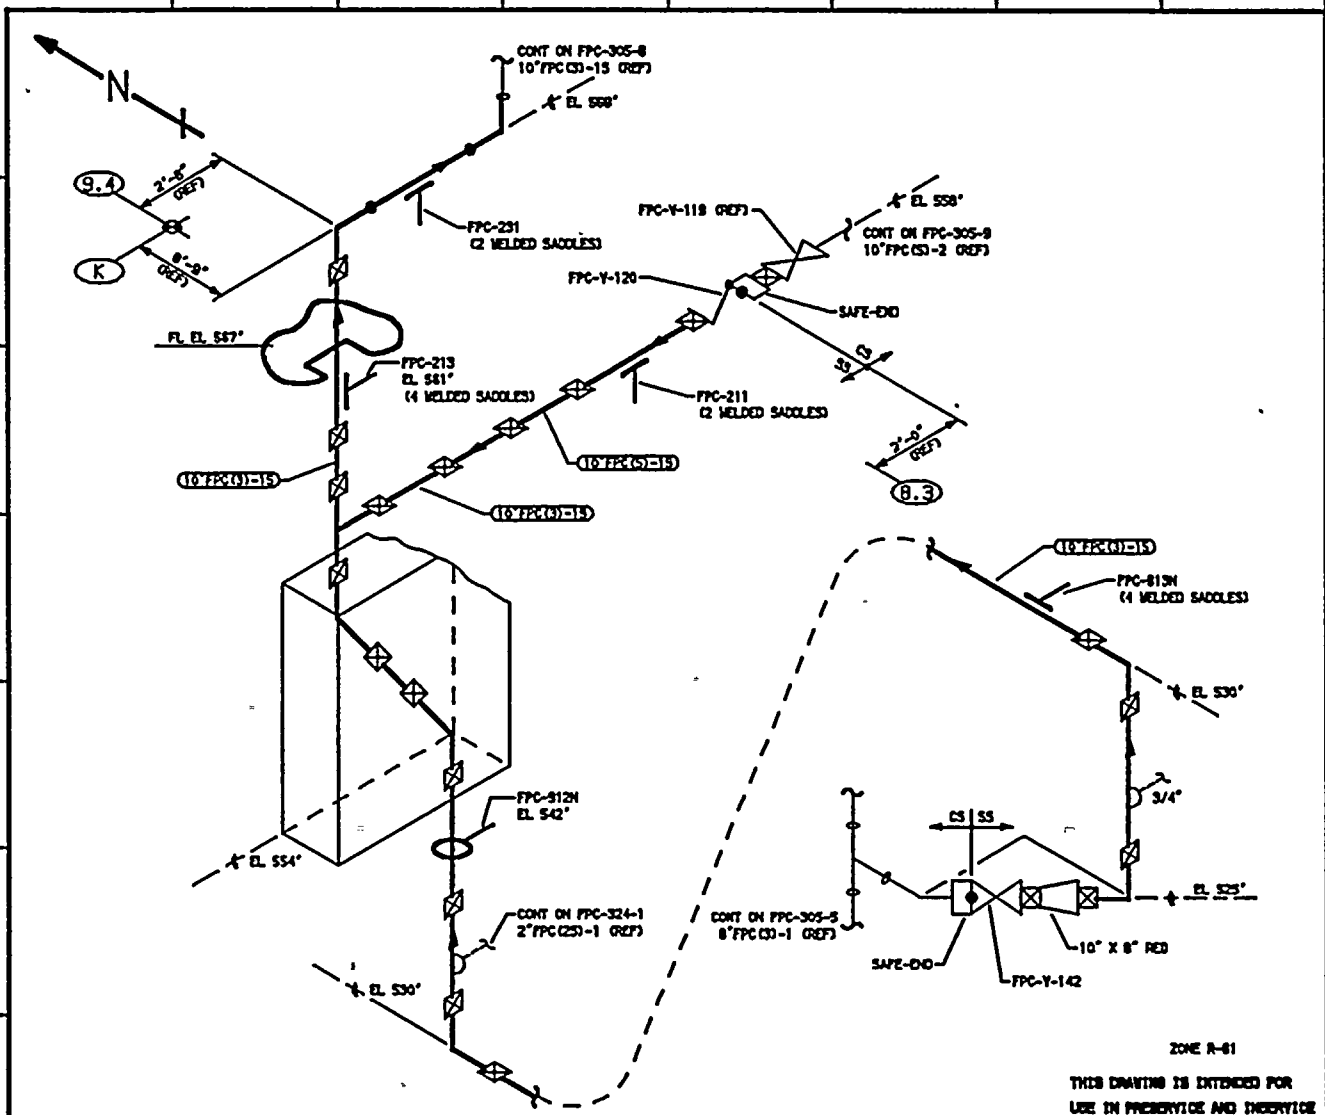

- NOTES:**
1. THIS DRAWING IDENTIFIES PIPING AND COMPONENTS SUBJECT ONLY TO A VISUAL EXAM FOR (1) EVIDENCE OF LEAKAGE DURING SYSTEM PRESSURE OR OPERABILITY TESTS, (2) PRESSURE DECAY TESTS OF BURIED PIPING, AND (3) LOSS OF SUPPORT CAPABILITY OR INADEQUATE RESTRAINT FOR SUPPORTS AND HANGERS ON PIPING EXCEEDING 4" NOM. TESTS SHALL BE CONDUCTED PER ASME SECTION XI, ARTICLES 11A-2000 AND 11D-2000.
  2. FOR BRANCH PIPING 4" NOM. OR LESS (CONNECTION SHOWN IN DASHED LINES) EXTEND VISUAL LEAKAGE EXAM THROUGH THE OUTERMOST NORMALLY CLOSED NUCLEAR CLASS VALVE, OR UNTIL TRANSITION TO INSTRUMENT TUBING, UNLESS OTHERWISE NOTED.

- REFERENCES:**
- 151 - 220-1
  - BOYCE & CRILL ISOMETRICS
  - FPC-670-1.2 REV 10
  - FPC-048-1.13 REV 8

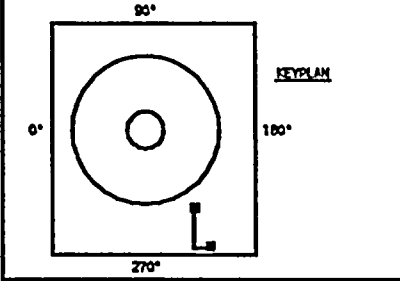

QUALITY CLASS: 2 ASME CODE CLASS: 3  
 ENGR: K-MoANDRESEN DRAWING: K-MoA DATE: 7-24-81

WASHINGTON PUBLIC POWER  
 SUPPLY SYSTEM  
 RICHLAND, WASHINGTON 99352

MWP-2  
 WELD & COMPONENT  
 IDENTIFICATION DIAGRAM


TITLE:  
 FPC-DH-1A 81B RETURN & NHR STEAM INLET

DWG NO: FPC-305-7 REV 2

ZONE R-61  
 THIS DRAWING IS INTENDED FOR  
 USE IN PRE-SERVICE AND INSERVICE  
 INSPECTION PROGRAMS ONLY.


PIPING SYSTEM	NOM DIA (IN)	SCH	NOM WALL THK	MATERIAL SPECIFICATION	MATL TYPE	CAL BLOCK NO
10" FPC CS-15	10	10S	0.185	SA 312 TP 304	SS	NA
10" FPC CS-15	10	10S	0.185	SA 312 TP 304	SS	NA

NO	DATE	REVISION	BY	CHKD	APPVD
2	10-18-87	ADDED 181 DWG REF, DASH LINE CONT, LOGO & SHOP WELDS BETWEEN VALVES & SAFE-DIOS, MODIFIED KEYPLAN, RECDRAW	K-MoA	DPR	TFH
1	1-24-84	REVISED AS NOTED ADDED KEYPLAN	K-MoA	DPR	TFH
0	12-2-81	ISSUED FOR USE	K-MoA	DPR	TFH

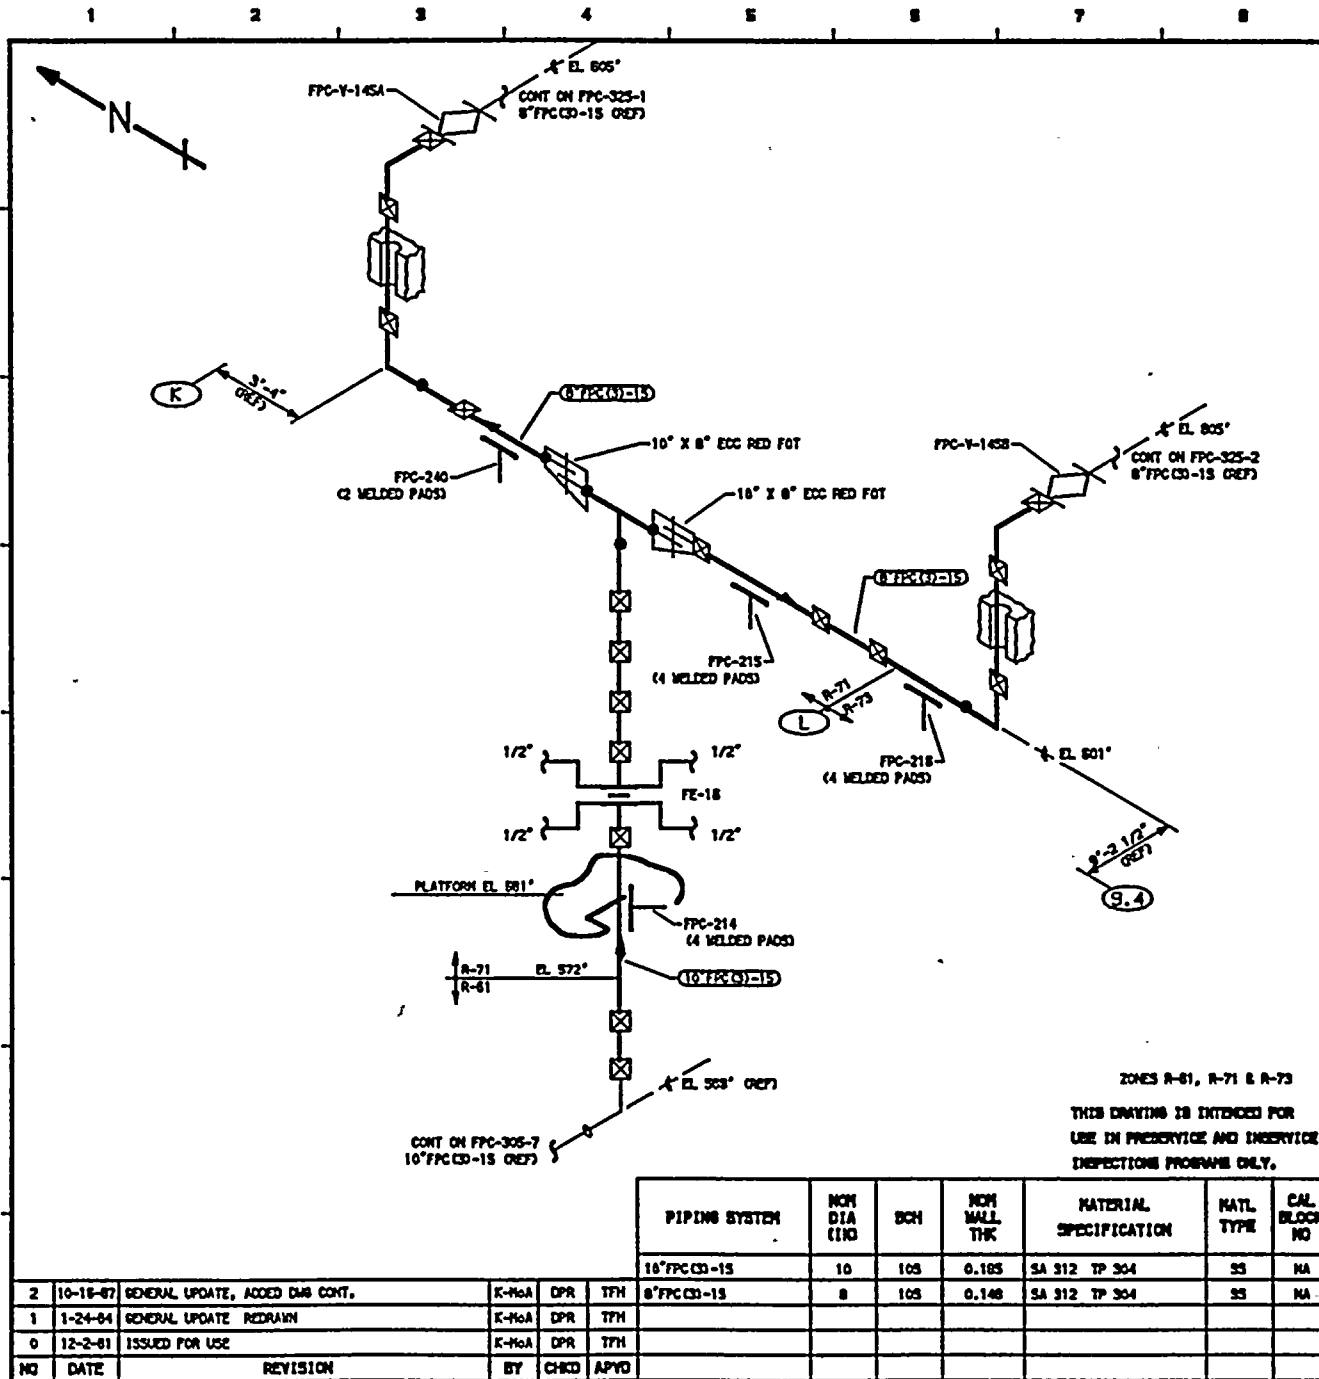

- NOTES:**
1. THIS DRAWING IDENTIFIES PIPING AND COMPONENTS SUBJECT ONLY TO A VISUAL EXAM FOR (1) EVIDENCE OF LEAKAGE DURING SYSTEM PRESSURE OR OPERABILITY TESTS, (2) PRESSURE DECAY TESTS OF BURIED PIPING, AND (3) LOSS OF SUPPORT CAPABILITY OR INADEQUATE RESTRAINT FOR SUPPORTS AND HANGERS ON PIPING EXCEEDING 4" NOM. TESTS SHALL BE CONDUCTED PER ASME SECTION XI, ARTICLES 1WA-5000 AND 1WD-2000.
  2. FOR BRANCH PIPING 4" NOM. OR LESS CONNECTION SHOWN IN DASHED LINES) EXTEND VISUAL LEAKAGE EXAM THROUGH THE OUTERMOST NORMALLY CLOSED NUCLEAR CLASS VALVE, OR UNTIL TRANSITION TO INSTRUMENT TUBING, UNLESS OTHERWISE NOTED.

- REFERENCES:**
- 131 - 226-1
  - DOVEZ & CRILL ISOMETRICS
  - FPC-670-3.6 REV 8
  - FPC-670-7.11 REV 9
  - FPC-670-12.18 REV 7

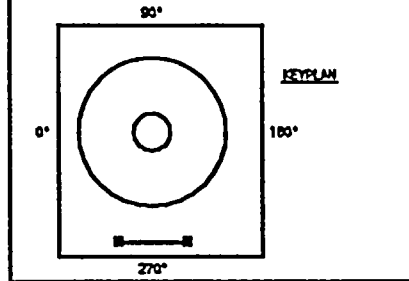

QUALITY CLASS, 2 ASME CODE CLASS, 3  
 ENGR. K-MoA/DREI DRAWN. K-MoA DATE: 4-24-78

WASHINGTON PUBLIC POWER  
 SUPPLY SYSTEM  
 RICHLAND, WASHINGTON 99352

WPP-2  
 WELD & COMPONENT  
 IDENTIFICATION DIAGRAM

TITLE:  
 FPC-DM-1A & 1B TO DIFFUSERS


DWG NO. FPC-305-8 REV 2

PIPING SYSTEM	NOM DIA (INO)	SCH	NOM WALL THK	MATERIAL SPECIFICATION	MATL TYPE	CAL BLOCK NO
10" FPC CD-15	10	10S	0.185	SA 312 TP 304	SS	NA
8" FPC CD-15	8	10S	0.148	SA 312 TP 304	SS	NA

NO	DATE	REVISION	BY	CHKD	APVD
2	10-18-87	GENERAL UPDATE, ADDED DWS CONT.	K-MoA	DPR	TTH
1	1-24-84	GENERAL UPDATE REDRAWN	K-MoA	DPR	TTH
0	12-2-81	ISSUED FOR USE	K-MoA	DPR	TTH


ZONES R-61, R-71 & R-73  
 THIS DRAWING IS INTENDED FOR  
 USE IN PRESERVICE AND INSERVICE  
 INSPECTIONS PROGRAMS ONLY.



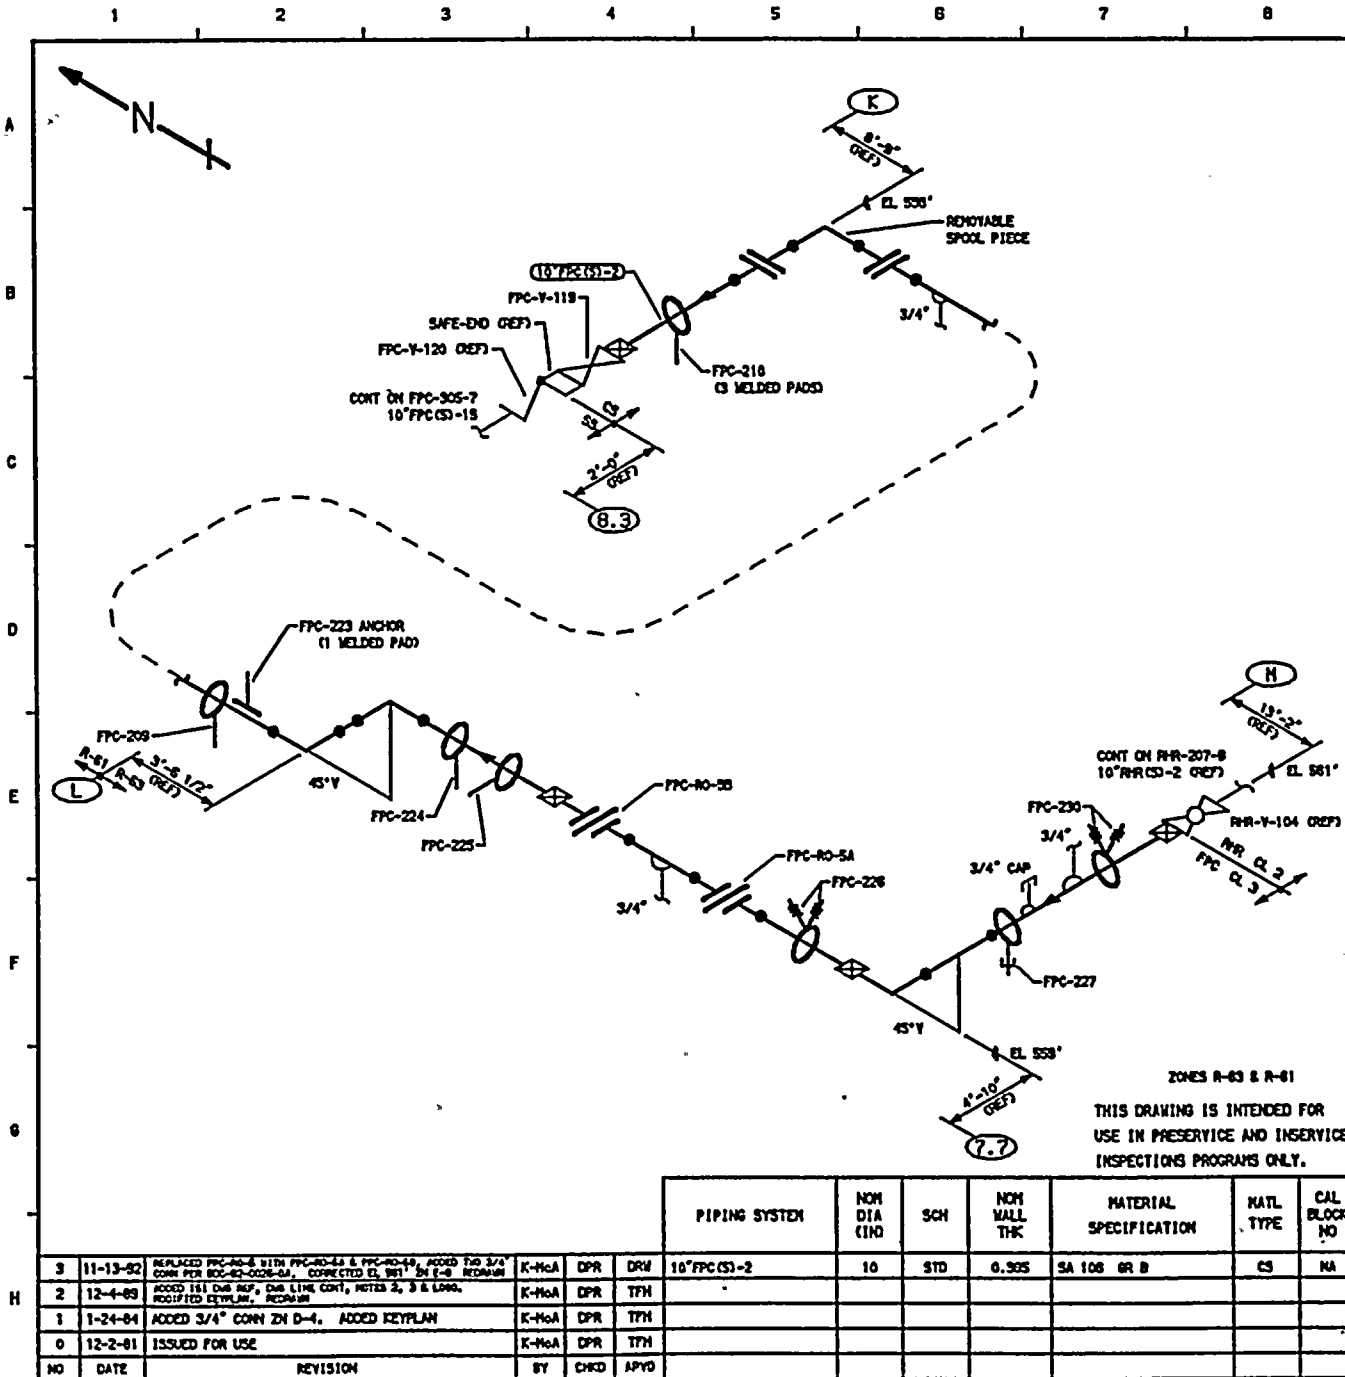

- NOTES:**
1. THIS DRAWING IDENTIFIES PIPING AND COMPONENTS SUBJECT ONLY TO A VISUAL EXAM FOR (1) EVIDENCE OF LEAKAGE DURING SYSTEM PRESSURE OR OPERABILITY TESTS, (2) PRESSURE DECAY TESTS OF BURIED PIPING, AND (3) LOSS OF SUPPORT CAPABILITY OR INADEQUATE RESTRAINT FOR SUPPORTS AND HANGERS ON PIPING EXCEEDING 4" NOM. TESTS SHALL BE CONDUCTED PER ASME SECTION XI, ARTICLES IWA-5000 AND IWA-2000.
  2. FPC-225 CHANGED FROM SHUBBER TO STRUT PER DOC-05-0525-0A.
  3. FPC-228 & FPC-229 HAVE BEEN DELETED PER DOC-07-0156.

**REFERENCES:**  
 ISI - 228-1  
 BOYCE & CRAIG ISOMETRIC  
 FPC-071-1.4 REV 11

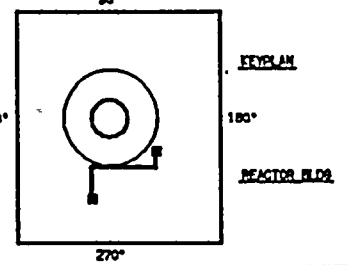

QUALITY CLASS: 1	ASME CODE CLASS: 3
ENGR: K-McANDREW	DATE: 4-26-79

WASHINGTON PUBLIC POWER  
 SUPPLY SYSTEM  
 RICHLAND, WASHINGTON 99352

ZONES R-03 & R-01  
 THIS DRAWING IS INTENDED FOR  
 USE IN PRESERVICE AND INSERVICE  
 INSPECTIONS PROGRAMS ONLY.


NO	DATE	REVISION	BY	CHKD	APVD	PIPING SYSTEM	NOM DIA (IN)	SCH	NOM WALL THK	MATERIAL SPECIFICATION	NATL TYPE	CAL BLOCK NO
3	11-13-82	REPLACED FPC-RO-4 WITH FPC-RO-4A & FPC-RO-4B, ADDED TWO 3/4" CONN FOR DOC-02-0226-0A. CORRECTED EL. 581' IN D-3 REVISION	K-McA	DPR	DRW	10" FPC(S)-2	10	STD	0.305	SA 106 GR B	CS	NA
2	12-4-89	ADDED ISI ONE REF; ONE LINE CONT, PAGES 2, 3 & LOGS. MODIFIED KEYPLAN. REVISION	K-McA	DPR	TFH							
1	1-24-84	ADDED 3/4" CONN IN D-4. ADDED KEYPLAN	K-McA	DPR	TFH							
0	12-2-81	ISSUED FOR USE	K-McA	DPR	TFH							

WFP-2  
 WELD & COMPONENT  
 IDENTIFICATION DIAGRAM

TITLE:  
 FPC - RHR INTERTIE INLET

DWG NO: FPC-305-9

REV 3

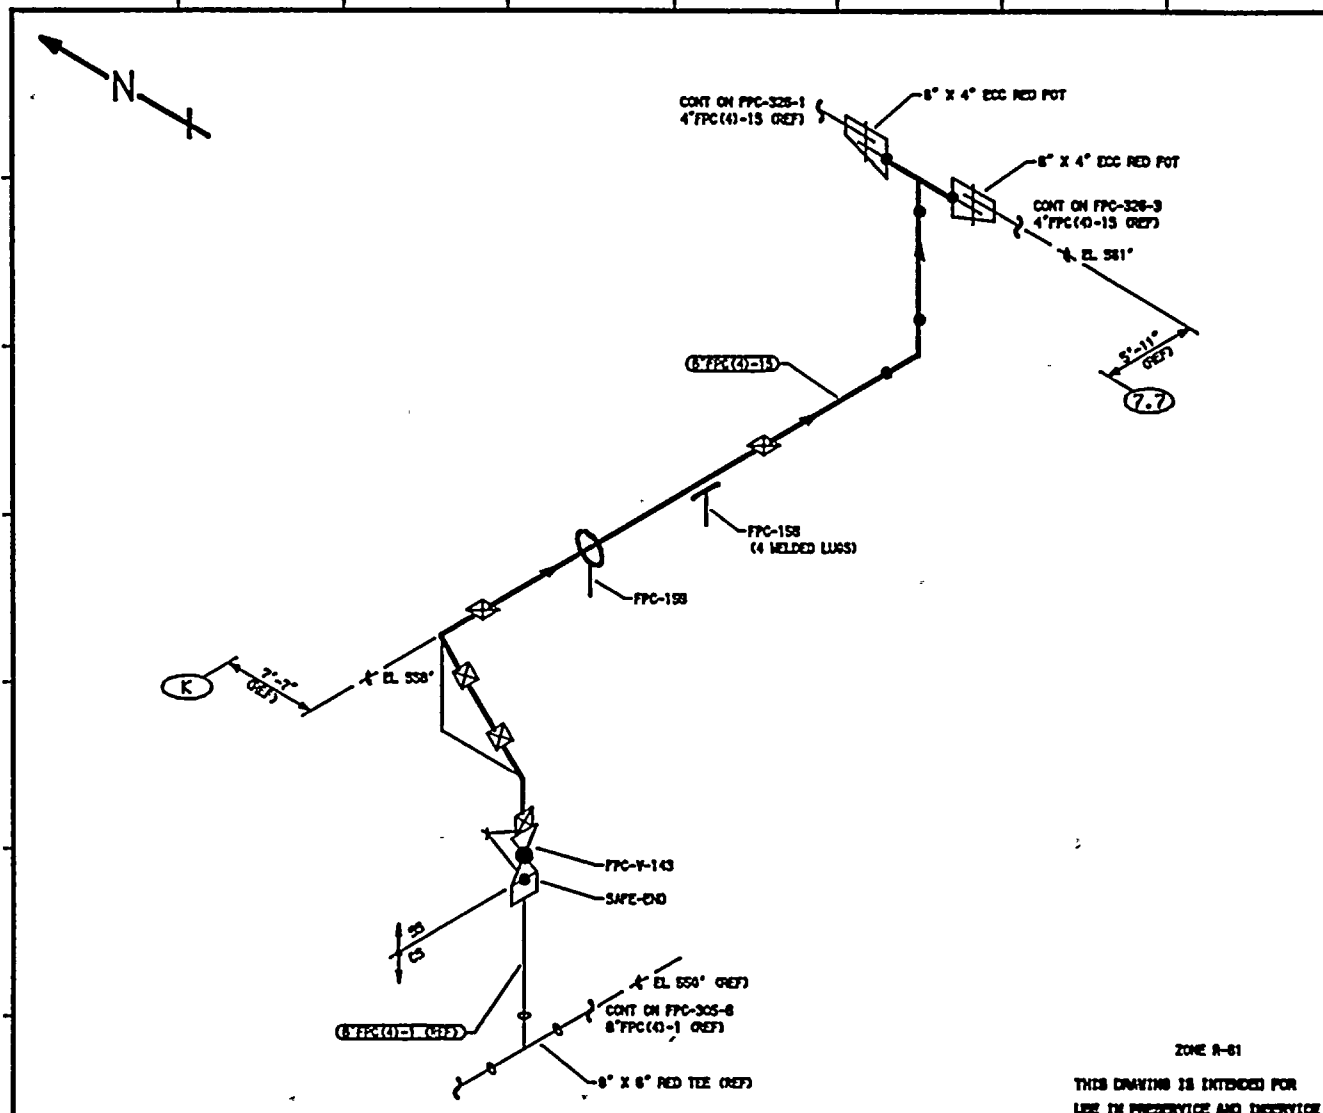


**NOTES:**

1. THIS DRAWING IDENTIFIES PIPING AND COMPONENTS SUBJECT ONLY TO A VISUAL EXAM FOR (1) EVIDENCE OF LEAKAGE DURING SYSTEM PRESSURE OR OPERABILITY TESTS, (2) PRESSURE DECAY TESTS OF BURIED PIPING, AND (3) LOSS OF SUPPORT CAPABILITY OR INADEQUATE RESTRAINT FOR SUPPORTS AND HANGERS ON PIPING EXCEEDING 4" NOM. TESTS SHALL BE CONDUCTED PER ASME SECTION XI, ARTICLES 1WA-5000 AND 1WA-2000.

**REFERENCES:**

151 - 226-1  
 BOYCE & ORALL ISOMETRIC  
 FPC-663-1.7 REV 5

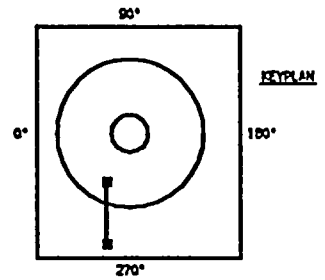

ZONE R-61

THIS DRAWING IS INTENDED FOR USE IN PRESERVICE AND SERVICE INSPECTIONS PROGRAMS ONLY.

PIPING SYSTEM	NOM DIA (IN)	SCH	NOM WALL THK	MATERIAL SPECIFICATION	MATL TYPE	CAL. BLOCK NO
8" FPC(4)-15	8	10S	0.134	SA 312 TP 304	SS	NA

NO	DATE	REVISION	BY	CHKD	APVD
2	10-16-87	GENERAL UPDATE, REDRAWN	K-MoA	DPR	TFH
1	1-24-84	REVISED AS NOTED ADDED KEYPLAN	K-MoA	DPR	TFH
0	12-2-81	ISSUED FOR USE	K-MoA	DPR	TFH

QUALITY CLASS, 2 | ASME CODE CLASS, 3  
 ENGR: K-MoANDREU | DRAWN: K-MoA | DATE: 4-25-79




WASHINGTON PUBLIC POWER  
 SUPPLY SYSTEM  
 RICHLAND, WASHINGTON STATE

WPP-2  
 WELD & COMPONENT  
 IDENTIFICATION DIAGRAM

TITLE:  
 FPC-04-1A & 1B TO DIFFUSERS

DWG NO. FPC-305-10 | REV 2

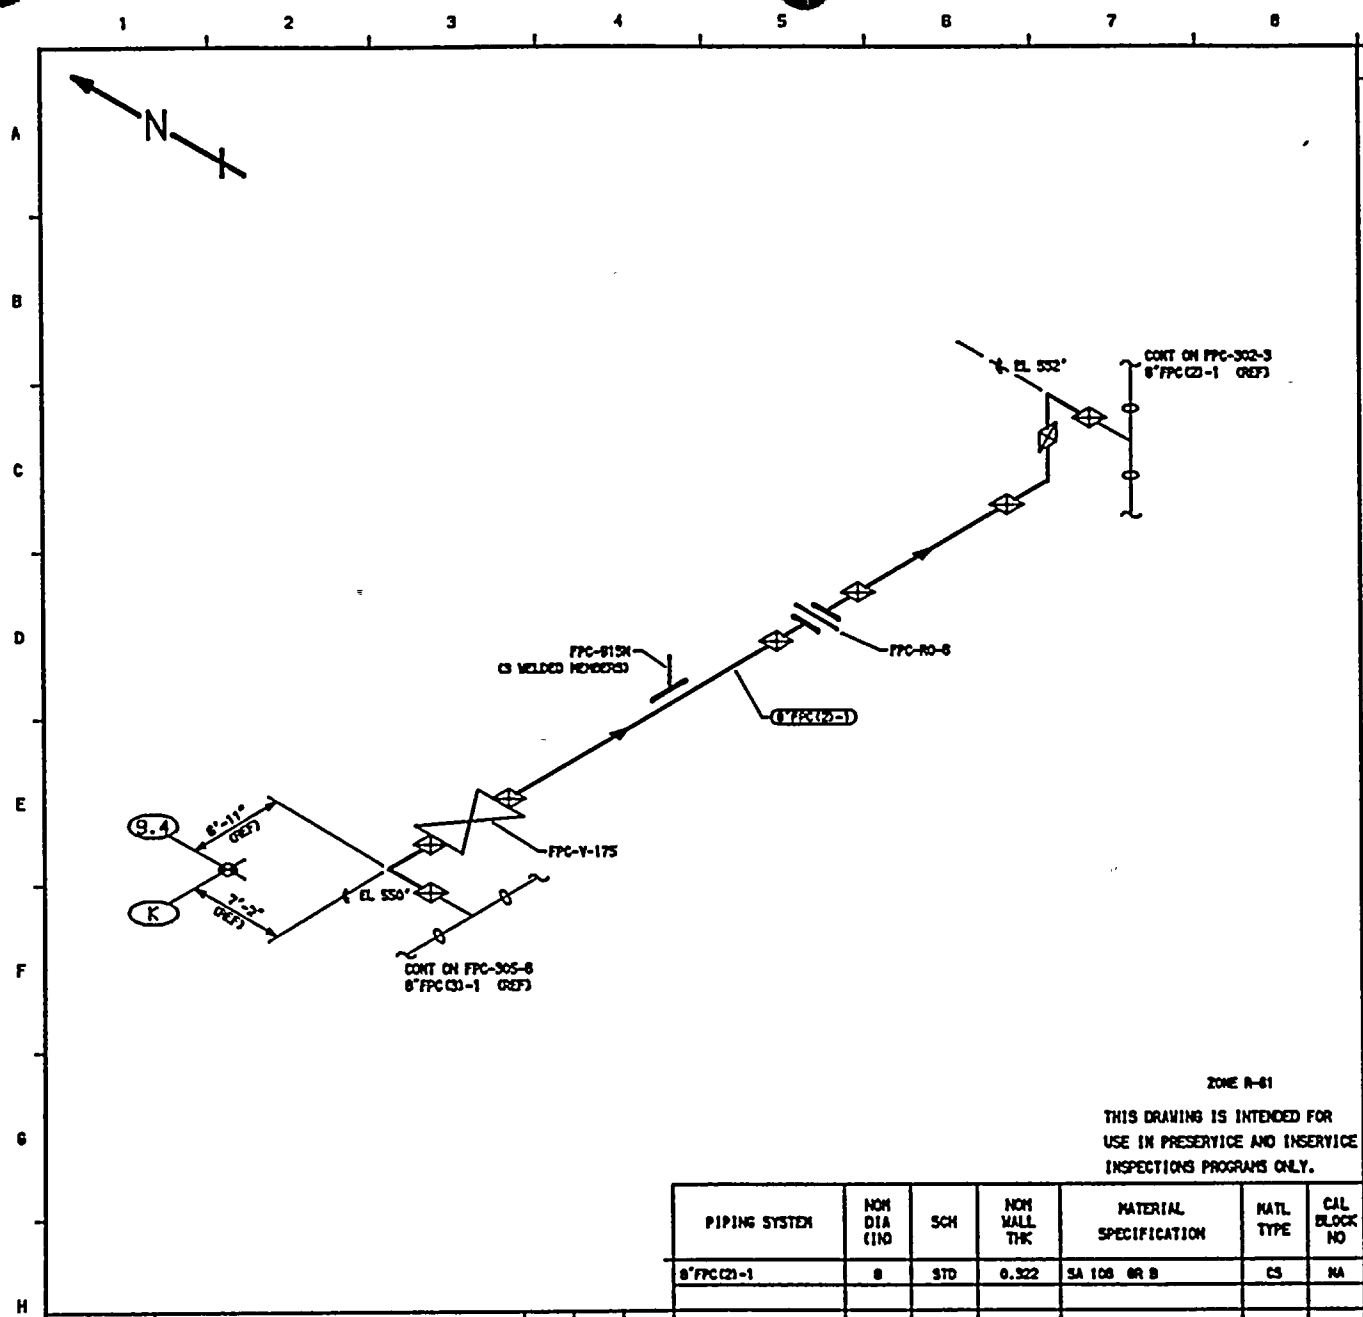


**NOTES:**

1. THIS DRAWING IDENTIFIES PIPING AND COMPONENTS SUBJECT ONLY TO A VISUAL EXAM FOR (1) EVIDENCE OF LEAKAGE DURING SYSTEM PRESSURE OR OPERABILITY TESTS; (2) SYSTEM PRESSURE DECAY TESTS OF BURIED PIPING; AND (3) LOSS OF SUPPORT CAPABILITY OR INADEQUATE RESTRAINT FOR SUPPORTS AND HANGERS ON PIPING EXCEEDING 4" NOM. TESTS SHALL BE CONDUCTED PER ASME SECTION XI, ARTICLES 1WA-5000 AND 1WA-2000.

**REFERENCES:**

ISI - 226-1A  
 BOYCE & CRALL ISOMETRIC  
 FPC-640-31.40 REV B

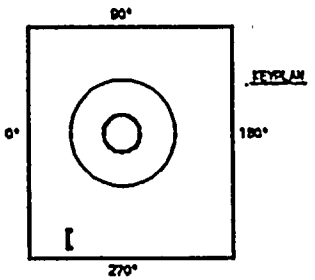

ZONE R-61

THIS DRAWING IS INTENDED FOR  
 USE IN PRESERVICE AND INSERVICE  
 INSPECTIONS PROGRAMS ONLY.

QUALITY CLASS: 11 | ASME CODE CLASS: 3  
 ENGR: K-McANDREW | DRAWN: K-McA | DATE: 1-5-64



WASHINGTON PUBLIC POWER  
 SUPPLY SYSTEM  
 RINGLAND, WASHINGTON 98352

PIPING SYSTEM	NOM DIA (IN)	SCH	NOM WALL THK	MATERIAL SPECIFICATION	MATL TYPE	CAL BLOCK NO
8" FPC(C)-1	8	STD	0.322	SA 108 GR B	CS	NA


WP-2  
 WELD & COMPONENT  
 IDENTIFICATION DIAGRAM

TITLE:  
 BY-PASS BETWEEN INFLUENT &  
 EFFLUENT TO REACTOR

NO	DATE	REVISION	BY	CHKD	APVD
1		ADDED LOGO, MODIFIED ISI DWG REF & KEYPLAN			
0	1-24-64	ISSUED FOR USE	K-McA	DPR	TPH

DWG NO. FPC-305-11 | REV 1



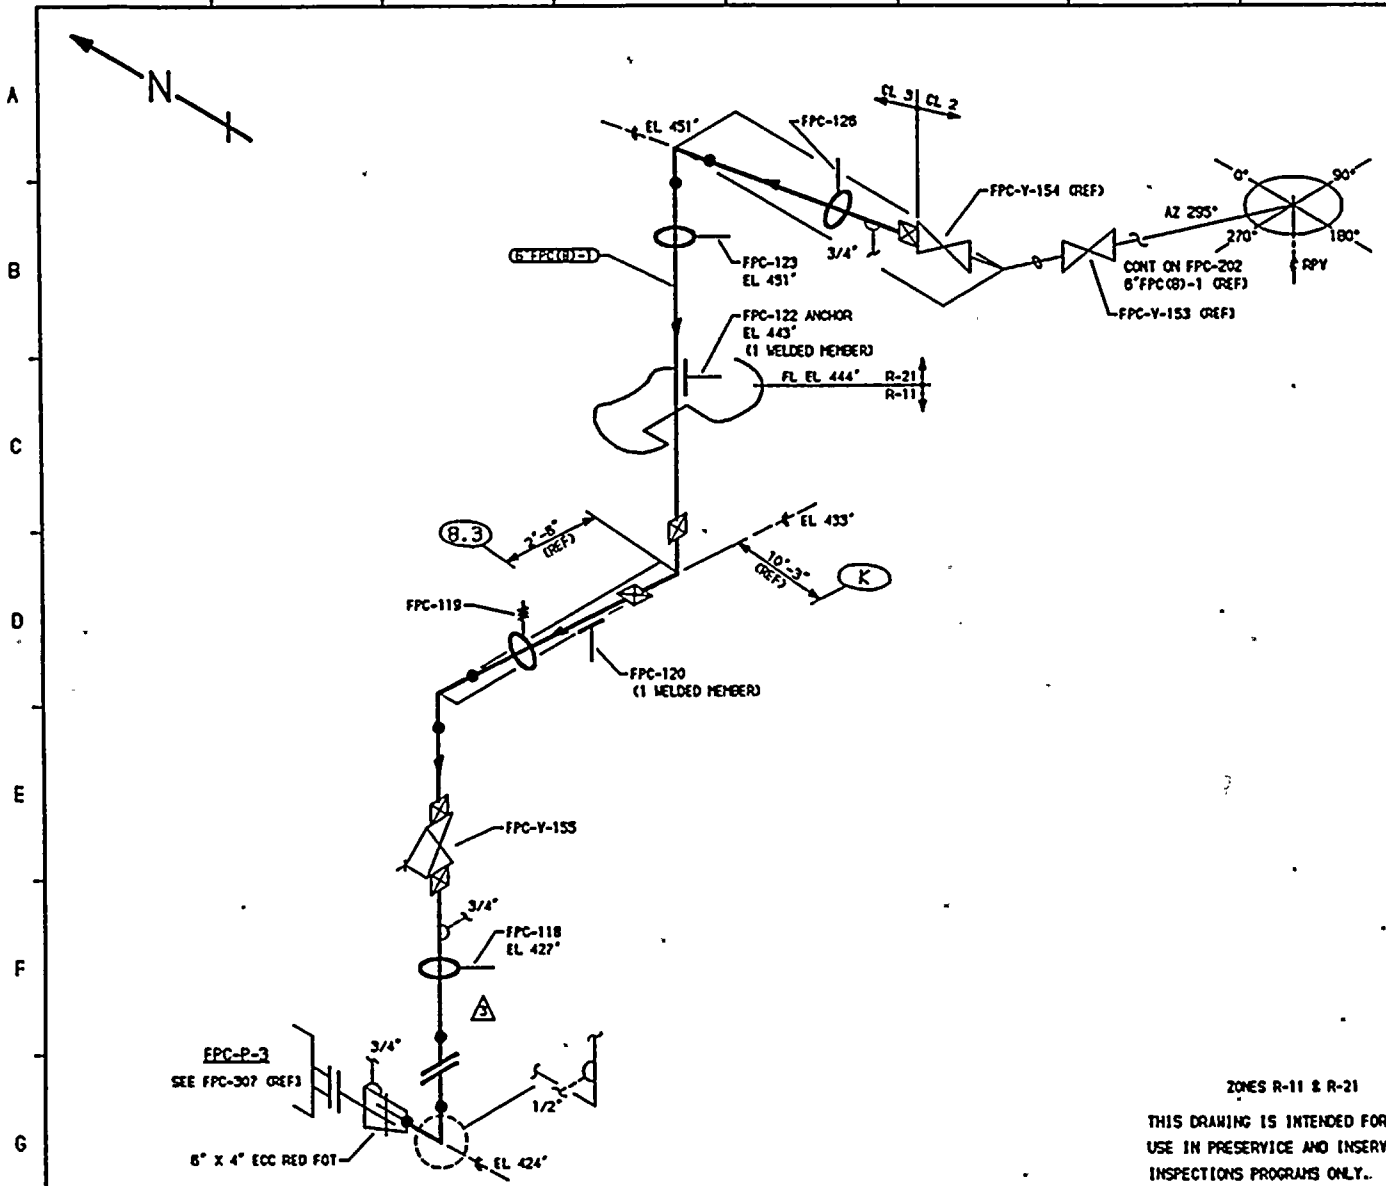


**NOTES:**

1. THIS DRAWING IDENTIFIES PIPING AND COMPONENTS SUBJECT ONLY TO A VISUAL EXAM FOR (1) EVIDENCE OF LEAKAGE DURING SYSTEM PRESSURE OR OPERABILITY TESTS, (2) PRESSURE DECAY TESTS OF BURIED PIPING, AND (3) LOSS OF SUPPORT CAPABILITY OR INADEQUATE RESTRAINT FOR SUPPORTS AND HANGERS ON PIPING EXCEEDING 4" NOM. TESTS SHALL BE CONDUCTED PER ASME SECTION XI, ARTICLES 1MA-5000 AND 1MO-2000.
2. FOR BRANCH PIPING 4" NOM. OR LESS (CONNECTION SHOWN IN DASHED LINES) EXTEND VISUAL LEAKAGE EXAM THROUGH THE OUTERMOST NORMALLY CLOSED NUCLEAR CLASS VALVE, OR UNTIL TRANSITION TO INSTRUMENT TUBING, UNLESS OTHERWISE NOTED.

**REFERENCES:**

IS1 - 226-1A  
 BOYCE & ORRILL ISOMETRICS  
 FPC-899-1.2 REV 11  
 FPC-639-3.5 REV 9

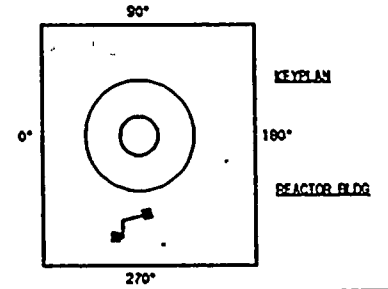

QUALITY CLASS: II ASME CODE CLASS: 3  
 ENGR: K-McANDREW DRAWN: K-McA DATE: 4-27-79



WASHINGTON PUBLIC POWER  
**SUPPLY SYSTEM**  
 RICHLAND, WASHINGTON 99352


ZONES R-11 & R-21

THIS DRAWING IS INTENDED FOR  
 USE IN PRESERVICE AND INSERVICE  
 INSPECTIONS PROGRAMS ONLY.

PIPING SYSTEM*	NOM DIA (IN)	SCH	NOM WALL THK	MATERIAL SPECIFICATION	MATL TYPE	CAL BLOCK NO
6" FPC(8)-1	6	STD	0.290	SA 106 GR B	CS	NA


WPP-2 WELD & COMPONENT IDENTIFICATION DIAGRAM	
TITLE: SUPPRESSION POOL TO FPC-P-3 SUCTION	
DWG NO. FPC-308	REV 3

NO	DATE	REVISION	BY	CHKD	APVD
3	1-22-94	REMOVED FPC-ST-3 PER BDC-85-0052-0A.	K-McA	DPR	DW
2	11-13-92	ADDED IS1 DRAWING REFERENCE & DRAWING LINE CONTINUATION. MODIFIED KEYPLAN & LOGO. REKEYPLAN	K-McA	DPR	DRW
1	1-24-84	REVISED AS NOTED. ADDED KEYPLAN	K-McA	DPR	TFH
0	12-2-81	ISSUED FOR USE	K-McA	DPR	TFH

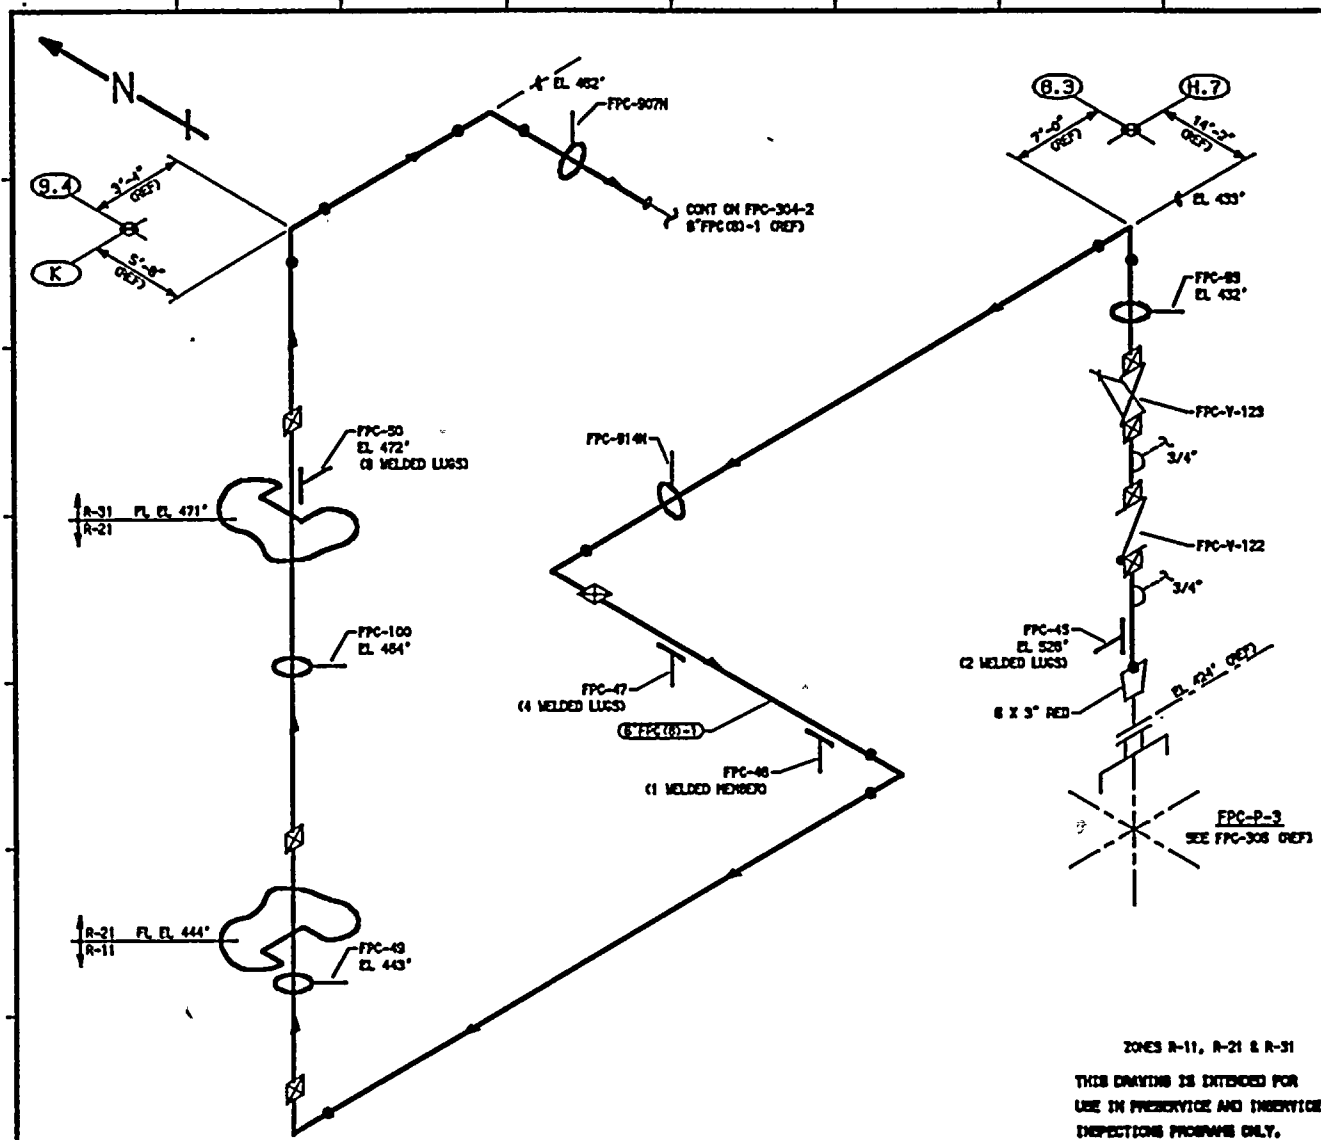

- NOTES:**
1. THIS DRAWING IDENTIFIES PIPING AND COMPONENTS SUBJECT ONLY TO A VISUAL EXAM FOR (1) EVIDENCE OF LEAKAGE DURING SYSTEM PRESSURE OR OPERABILITY TESTS, (2) PRESSURE DECAY TESTS OF BURIED PIPING, AND (3) LOSS OF SUPPORT CAPABILITY OR INADEQUATE RESTRAINT FOR SUPPORTS AND HANGERS ON PIPING EXCEEDING 4" NOM. TESTS SHALL BE CONDUCTED PER ASME SECTION XI, ARTICLES 1MA-5000 AND 1MO-2000.
  2. FOR BRANCH PIPING 4" NOM. OR LESS CONNECTION SHOWN IN DASHED LINES EXTEND VISUAL LEAKAGE EXAM THROUGH THE OUTERMOST NORMALLY CLOSED NUCLEAR CLASS VALVE, OR UNTIL TRANSITION TO INSTRUMENT TUBING, UNLESS OTHERWISE NOTED.

- REFERENCES:**
- 151 - 226-1A
  - BOYCE & CRILL ISOMETRICS
  - FPC-630-1.3 REV 9
  - FPC-630-4.7 REV 7

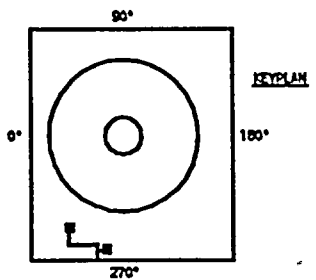

QUALITY CLASS: 2 | ASME CODE CLASS: 3  
 ENGR: K-MoANDREX | DRAWING: K-MoA | DATE: 4-30-78

WASHINGTON PUBLIC POWER  
 SUPPLY SYSTEM  
 KICHLAND, WASHINGTON 98926

ZONES R-11, R-21 & R-31  
 THIS DRAWING IS EXTENDED FOR  
 USE IN PRESERVICE AND INSERVICE  
 INSPECTIONS PROGRAMS ONLY.


PIPING SYSTEM	NOM DIA (IN)	SCH	NOM WALL THK	MATERIAL SPECIFICATION	MATL TYPE	CAL BLOCK NO
8" FPC 03-1	8	STD	0.200	SA 106 GR B	CS	NA

NO	DATE	REVISION	BY	CHKD	APPVD
2	10-16-87	ADDED (1) DIA REF, DIA LINE CONT, LOSS & FPC-307H, DELETED FPC-48, MODIFIED KEYPLAN, REMOVED	K-MoA	DPR	TPH
1	1-24-84	REVISED AS NOTED. ADDED KEYPLAN.	K-MoA	DPR	TPH
0	12-2-81	ISSUED FOR USE	K-MoA	DPR	TPH

MP-3  
 WELD & COMPONENT  
 IDENTIFICATION DIAGRAM


TITLE: FPC-P-3 DISCHARGE

DWG NO: FPC-307 | REV 2

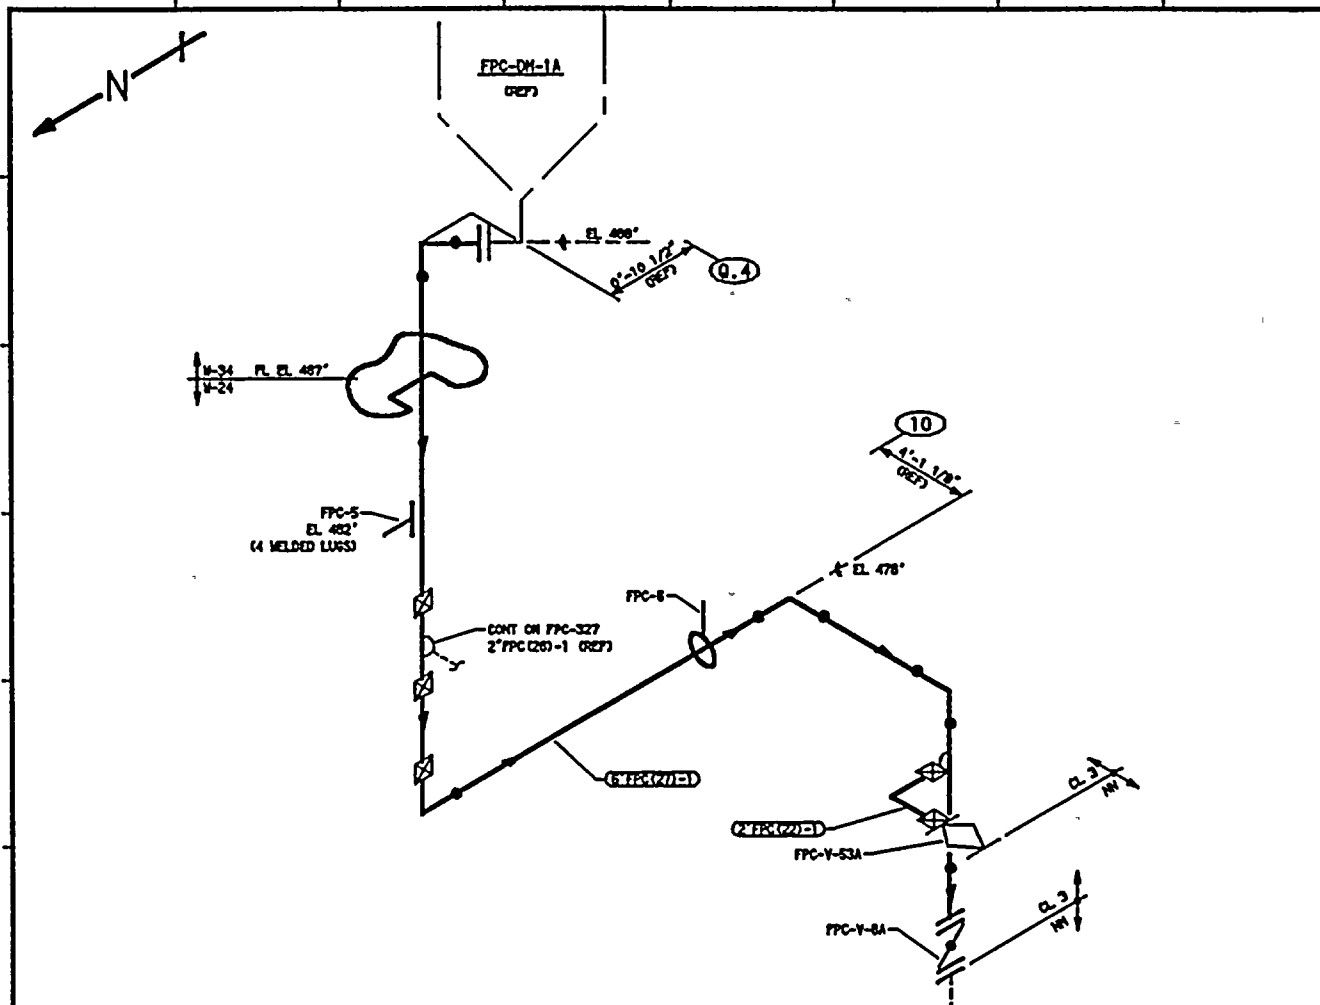

- NOTES:**
1. THIS DRAWING IDENTIFIES PIPING AND COMPONENTS SUBJECT ONLY TO A VISUAL EXAM FOR (1) EVIDENCE OF LEAKAGE DURING SYSTEM PRESSURE OR OPERABILITY TESTS, (2) PRESSURE DECAY TESTS OF BURIED PIPING, AND (3) LOSS OF SUPPORT CAPABILITY OR INADEQUATE RESTRAINT FOR SUPPORTS AND HANGERS ON PIPING EXCEEDING 4" NOM. TESTS SHALL BE CONDUCTED PER ASME SECTION XI, ARTICLES 11A-5000 AND 11A-2000.
  2. FOR BRANCH PIPING 4" NOM. OR LESS CONNECTION SHOWN IN DASHED LINES) EXTEND VISUAL LEAKAGE EXAM THROUGH THE OUTERMOST NORMALLY CLOSED NUCLEAR CLASS VALVE, OR UNTIL TRANSITION TO INSTRUMENT TUBING, UNLESS OTHERWISE NOTED.

**REFERENCES:**  
 ISI - 228-2  
 BOYCE & CRILL ISOMETRIC  
 FPC-778-1.3 REV 2

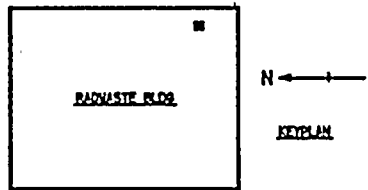

ZONES U-34 & U-24

THIS DRAWING IS INTENDED FOR  
 USE IN PRESERVICE AND INSERVICE  
 INSPECTION PROGRAMS ONLY.

PIPING SYSTEM	NOM DIA (IN)	SCH	NOM WALL THK	MATERIAL SPECIFICATION	MATL TYPE	CAL BLOCK NO
8" FPC C22-1	8	STD	0.290	SA 106 GR B	CS	NA
2" FPC C22-1	2	80	0.218	SA 106 GR B	CS	NA

NO	DATE	REVISION	BY	CHKD	APYD
2	10-16-87	ADDED CONT DIM, 2" FPC C22-1. DELETED NH PIPING, REDRAWN	K-MoA	DPR	TFH
1	1-24-84	REVISED AS NOTED ADDED KEYPLAN	K-MoA	DPR	TFH
0	12-2-81	ISSUED FOR USE	K-MoA	DPR	TFH


QUALITY CLASS: 2 | ASME CODE CLASS: 3  
 ENGR: K-MoANDREX | DRAWN: K-MoA | DATE: 4-30-78

WASHINGTON PUBLIC POWER  
 SUPPLY SYSTEM  
 RICHMOND, WASHINGTON 98801

WPP-2  
 WELD & COMPONENT  
 IDENTIFICATION DIAGRAM


TITLE:  
 FPC-DH-1A TO FOR-TX-22

DWG NO: FPC-308-1 | REV 2

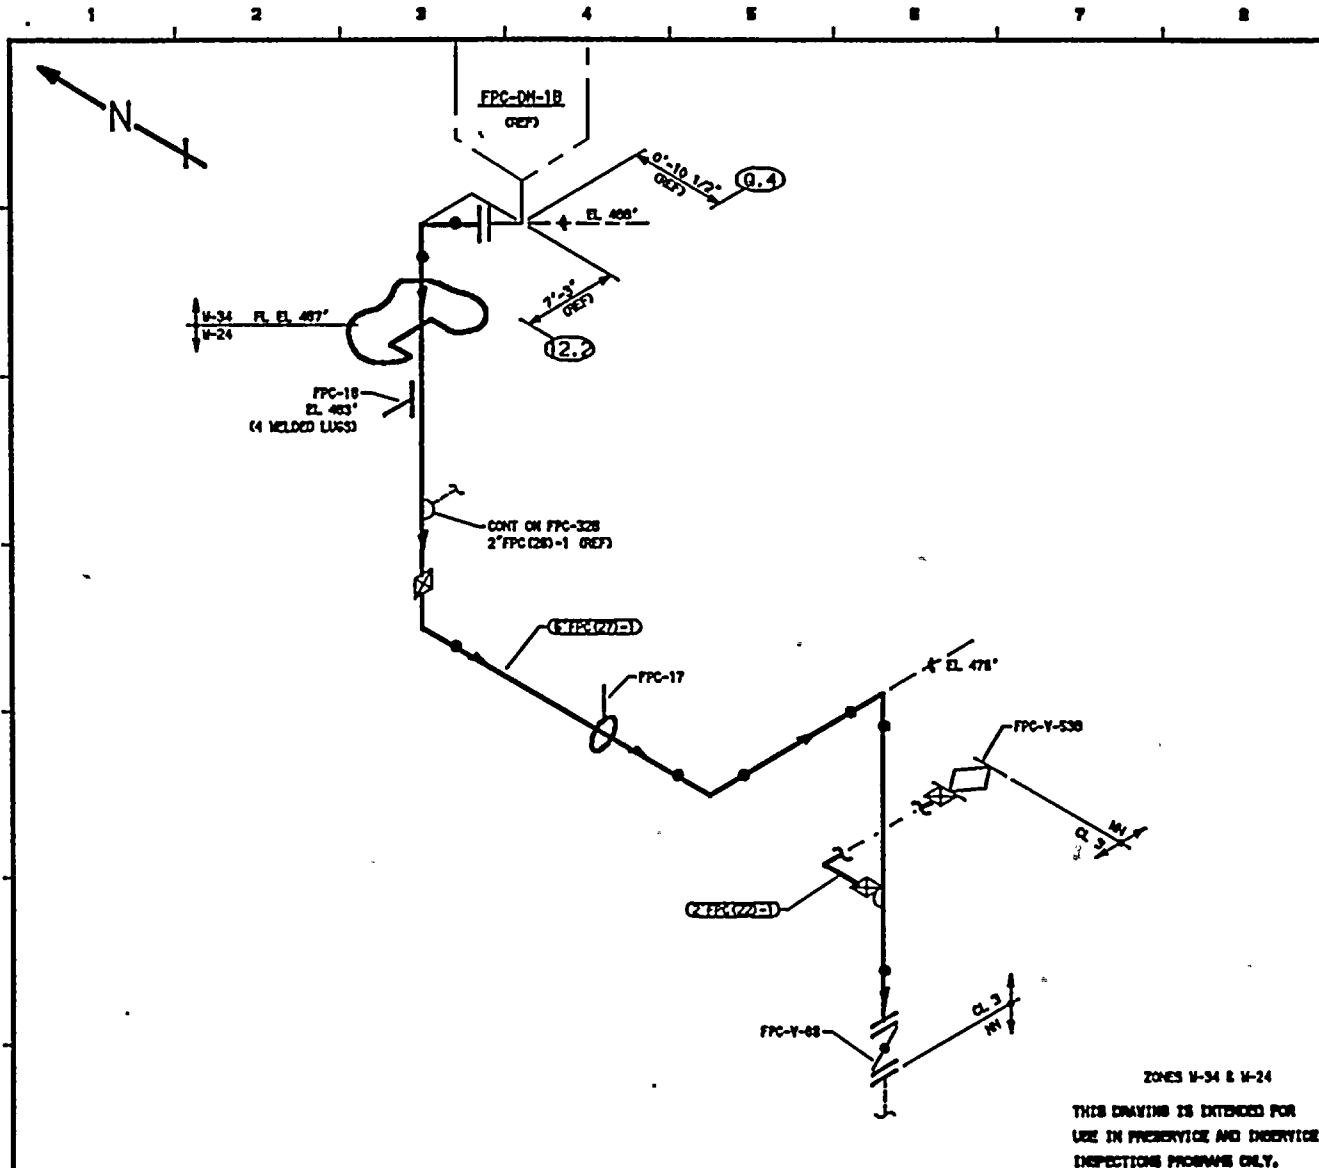

- NOTES:**
1. THIS DRAWING IDENTIFIES PIPING AND COMPONENTS SUBJECT ONLY TO A VISUAL EXAM FOR (1) EVIDENCE OF LEAKAGE DURING SYSTEM PRESSURE OR OPERABILITY TESTS, (2) PRESSURE DECAY TESTS OF BURIED PIPING, AND (3) LOSS OF SUPPORT CAPABILITY OR INADEQUATE RESTRAINT FOR SUPPORTS AND HANGERS ON PIPING EXCEEDING 4" NOM. TESTS SHALL BE CONDUCTED PER ASME SECTION II, ARTICLES 11M-5000 AND 11M-2000.
  2. FOR BRANCH PIPING 4" NOM. OR LESS (CONNECTION SHOWN IN DASHED LINES) EXTEND VISUAL LEAKAGE EXAM THROUGH THE OUTERMOST NORMALLY CLOSED NUCLEAR CLASS VALVE, OR UNTIL TRANSITION TO INSTRUMENT TUBING, UNLESS OTHERWISE NOTED.

**REFERENCES:**  
 ISI - 228-2  
 BOYCE & CRILL ISOMETRIC  
 FPC-778-10.13 REY 1

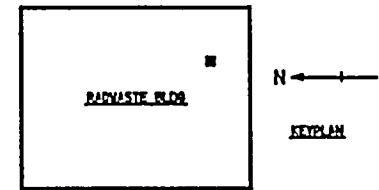

QUALITY CLASS: 2 | ASME CODE CLASS: 3  
 ENOR: K-MoANDREM | DRAWN: K-MoA | DATE: 5-1-78

**WASHINGTON PUBLIC POWER  
 SUPPLY SYSTEM**  
 RICHLAND, WASHINGTON 99352

WPP-2  
 WELD & COMPONENT  
 IDENTIFICATION DIAGRAM

TITLE:  
 FPC-DH-1B TO FDR-TX-22


DWG NO: FPC-308-3 | REV 2

ZONES W-34 & W-24  
 THIS DRAWING IS EXTENDED FOR  
 USE IN PRESERVICE AND INSERVICE  
 INSPECTIONS PROGRAMS ONLY.

PIPING SYSTEM	NOM DIA (IN)	SCH	NOM WALL THK	MATERIAL SPECIFICATION	MATL TYPE	CAL BLOCK NO
8" FPC (22)-1	8	STD	0.260	SA 106 GR B	CS	NA
2" FPC (22)-1	2	80	0.218	SA 106 GR B	CS	NA


NO	DATE	REVISION	BY	CHKD	APVD
2	10-16-87	ADDED CONT DWG, 2" FPC (22)-1, DELETED IN PIPING, REDRAWN	K-MoA	DPR	TFH
1	1-24-84	REVISED AS NOTED ADDED KEYPLAN	K-MoA	DPR	TFH
0	12-2-81	ISSUED FOR USE	K-MoA	DPR	TFH
		REVISION			



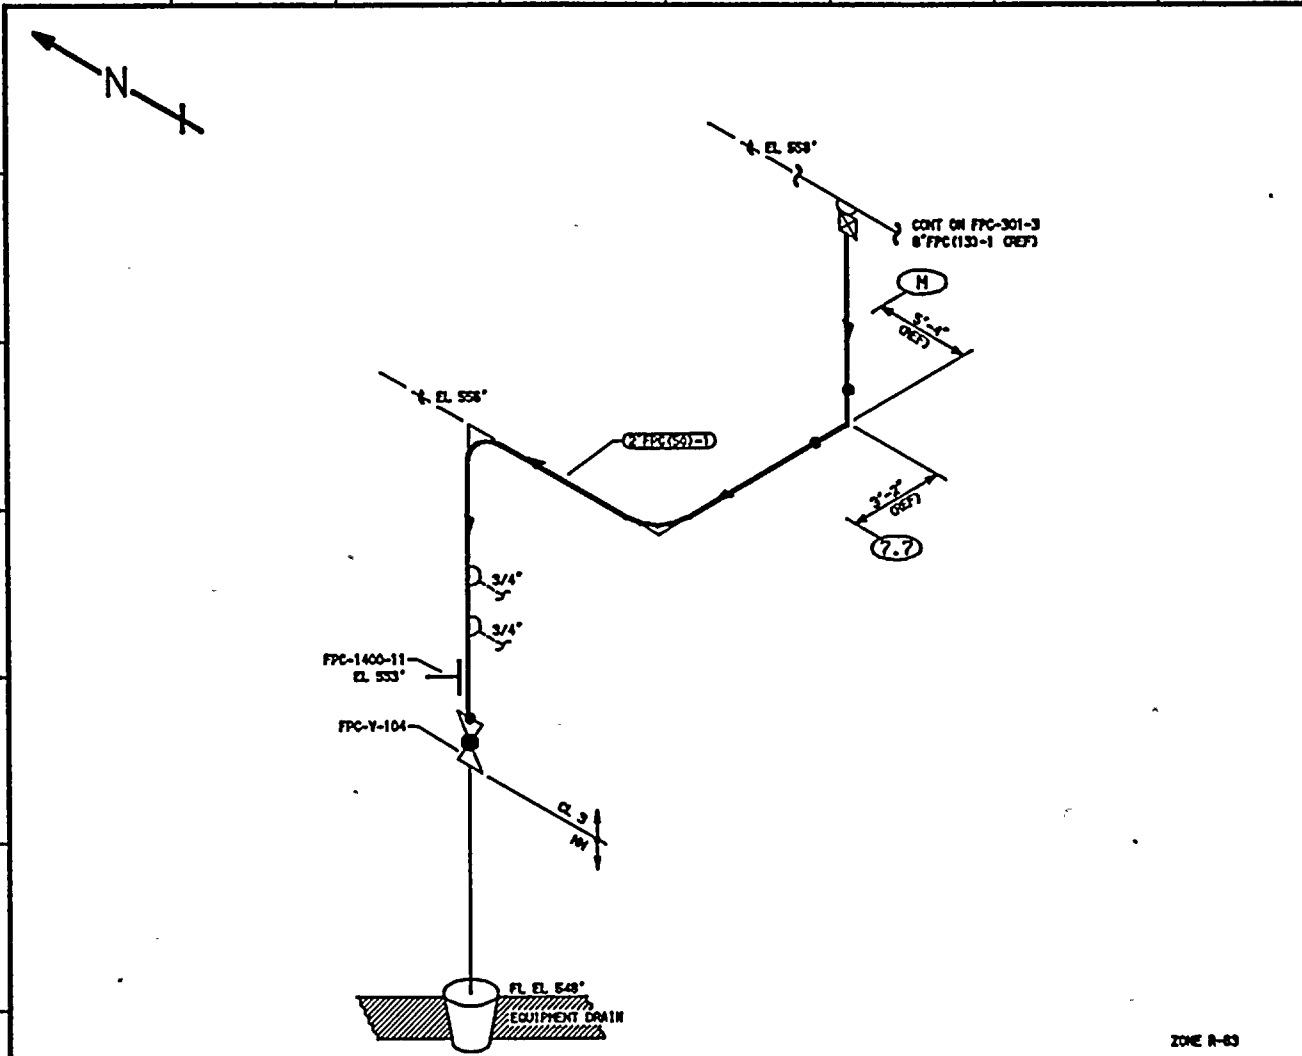

- NOTES.**
1. THIS DRAWING IDENTIFIES PIPING AND COMPONENTS SUBJECT ONLY TO A VISUAL EXAM FOR (1) EVIDENCE OF LEAKAGE DURING SYSTEM PRESSURE OR OPERABILITY TESTS, (2) PRESSURE DECAY TESTS OF BURIED PIPING, AND (3) LOSS OF SUPPORT CAPABILITY OR INADEQUATE RESTRAINT FOR SUPPORTS AND HANGERS ON PIPING EXCEEDING 4" NOM. TESTS SHALL BE CONDUCTED PER ASME SECTION XI, ARTICLES 11A-5000 AND 11A-2000.
  2. FOR BRANCH PIPING 4" NOM. OR LESS (CONNECTION SHOWN IN DASHED LINES) EXTEND VISUAL LEAKAGE EXAM THROUGH THE OUTERMOST NORMALLY CLOSED NUCLEAR CLASS VALVE, OR UNTIL TRANSITION TO INSTRUMENT TUBING, UNLESS OTHERWISE NOTED.

**REFERENCES.**  
 ISI - 226-1  
 BOYCE & CRAIG ISOMETRIC  
 FPC-1400-1 REV 5

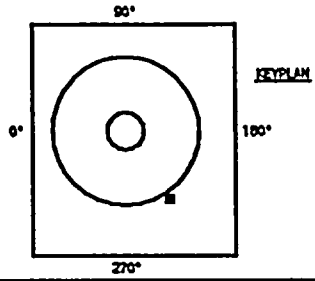

QUALITY CLASS: 2 ASME CODE CLASS: 3  
 ENGR: K-MoANDREX | DRAWN: K-MoA | DATE: 11-13-03

WASHINGTON PUBLIC POWER  
 SUPPLY SYSTEM  
 BOZEMAN, MONTGOMERY WISSE

MP-2  
 WELD & COMPONENT  
 IDENTIFICATION DIAGRAM

TITLE:  
 FUEL POOL CIRCULATION TO EQUIPMENT DRAIN

DWG NO: FPC-303 REV 0


ZONE R-63

THIS DRAWING IS INTENDED FOR  
 USE IN PRE-SERVICE AND IN-SERVICE  
 INSPECTIONS PROGRAMS ONLY.

PIPING SYSTEM	NOM DIA (IN)	SCH	NOM WALL THK	MATERIAL SPECIFICATION	MATL TYPE	CAL BLOCK NO
2" FPC(SG)-1	2	80	0.218	SA 106 GR B	CS	NA


NO	DATE	REVISION	BY	CHKD	APVD	K-MoA	DPR	TYM
0	10-16-07	ISSUED FOR USE						



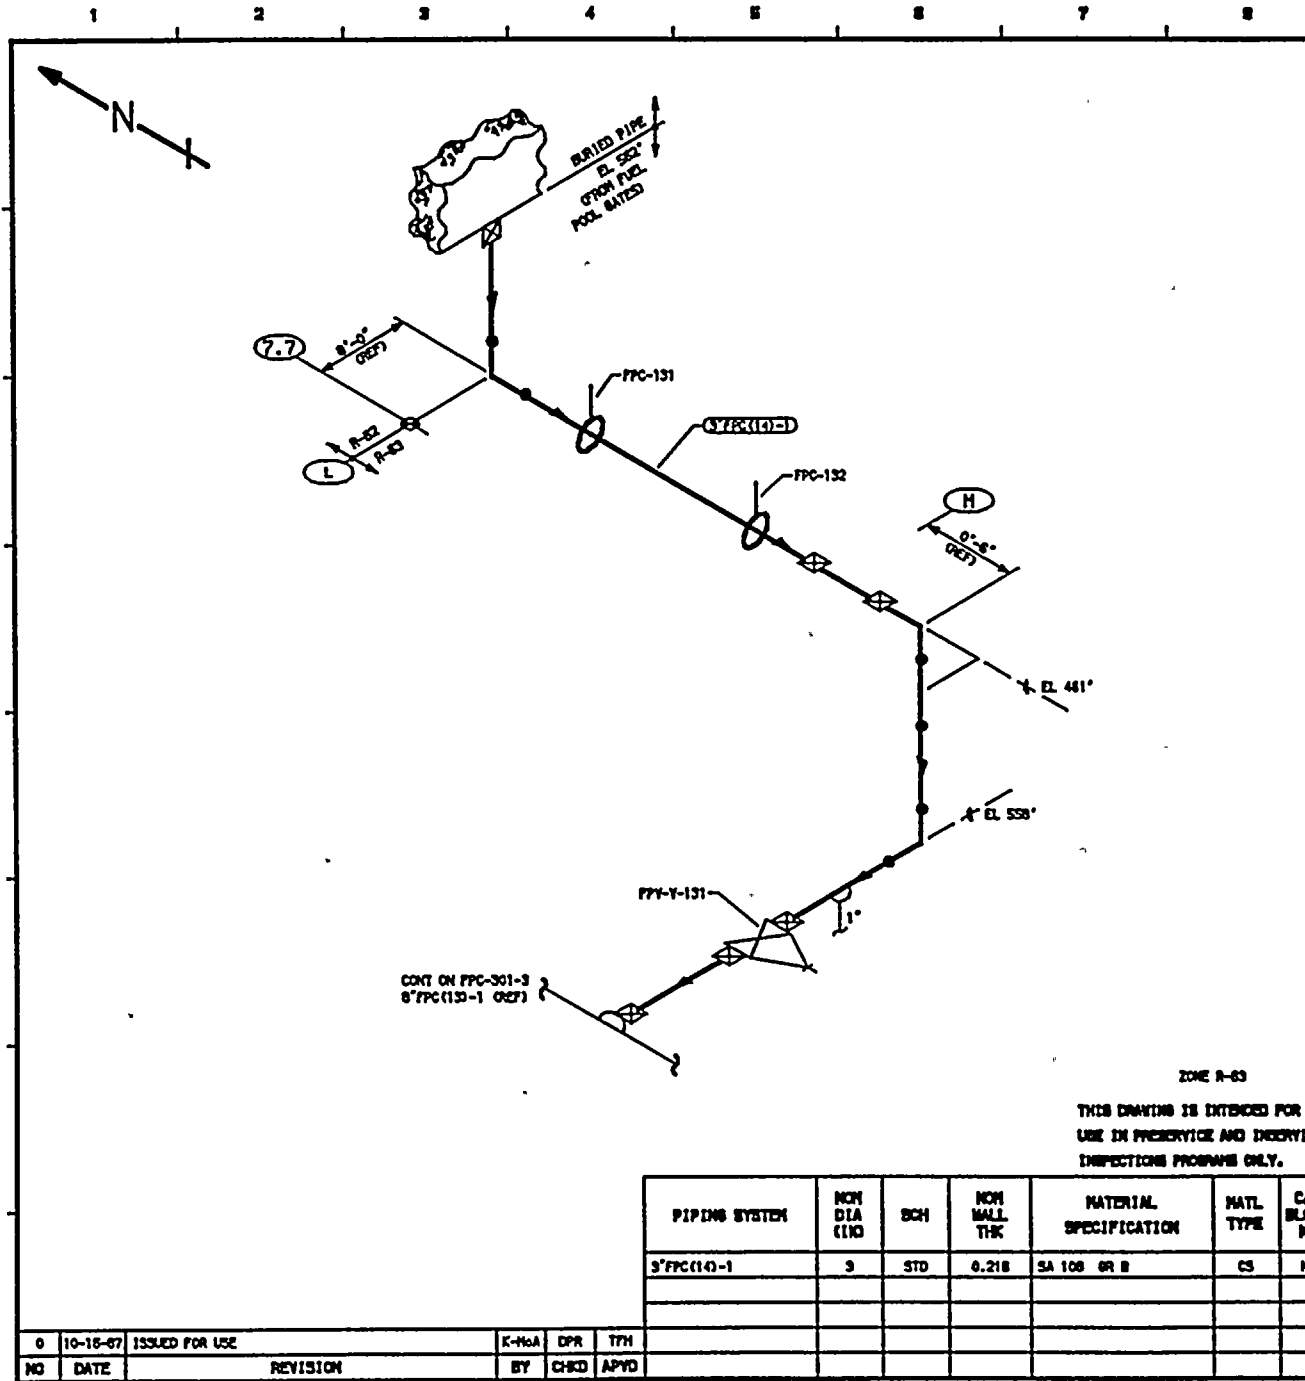

- NOTES:**
1. THIS DRAWING IDENTIFIES PIPING AND COMPONENTS SUBJECT ONLY TO A VISUAL EXAM FOR (1) EVIDENCE OF LEAKAGE DURING SYSTEM PRESSURE OR OPERABILITY TESTS; (2) PRESSURE DECAY TESTS OF BURIED PIPING; AND (3) LOSS OF SUPPORT CAPABILITY OR INADEQUATE RESTRAINT FOR SUPPORTS AND HANGERS ON PIPING EXCEEDING 4" NOM. TESTS SHALL BE CONDUCTED PER ASME SECTION XI, ARTICLES 11A-5000 AND 11A-2000.
  2. FOR BRANCH PIPING 4" NOM. OR LESS CONNECTION SHOWN IN DASHED LINES) EXTEND VISUAL LEAKAGE EXAM THROUGH THE OUTERMOST NORMALLY CLOSED NUCLEAR CLASS VALVE, OR UNTIL TRANSITION TO INSTRUMENT TUBING, UNLESS OTHERWISE NOTED.

**REFERENCES:**  
 131 - 225-1  
 BOYCE & CRAIG ISOMETRIC  
 FPC-810-1 REV 8

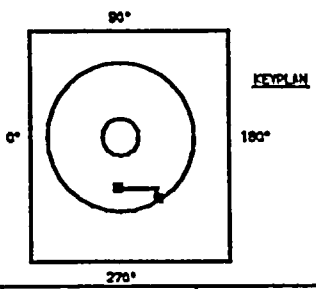

QUALITY CLASS: 2      ASME CODE CLASS: 3  
 ENGR: K-MoANDREW | DRAWN: K-MoA | DATE: 10-29-83

**WASHINGTON PUBLIC POWER  
 SUPPLY SYSTEM**  
 RICHLAND, WASHINGTON 99354

WPP-2  
 WELD & COMPONENT  
 IDENTIFICATION DIAGRAM


TITLE:  
 FUEL POOL GATES TP FUEL POOL CIRCULATION

DWG NO: FPC-310      REV 0

ZONE R-63  
 THIS DRAWING IS EXTENDED FOR  
 USE IN PRESERVICE AND INSERVICE  
 INSPECTIONS PROGRAMS ONLY.

PIPING SYSTEM	NOM DIA (10)	SCH	NOM WALL THK	MATERIAL SPECIFICATION	MATL TYPE	CAL BLOCK NO
9" FPC(10)-1	3	STD	0.218	SA 106 GR B	CS	NA

NO	DATE	REVISION	BY	CHKD	APVD
0	10-16-87	ISSUED FOR USE	K-MoA	DPR	TTH

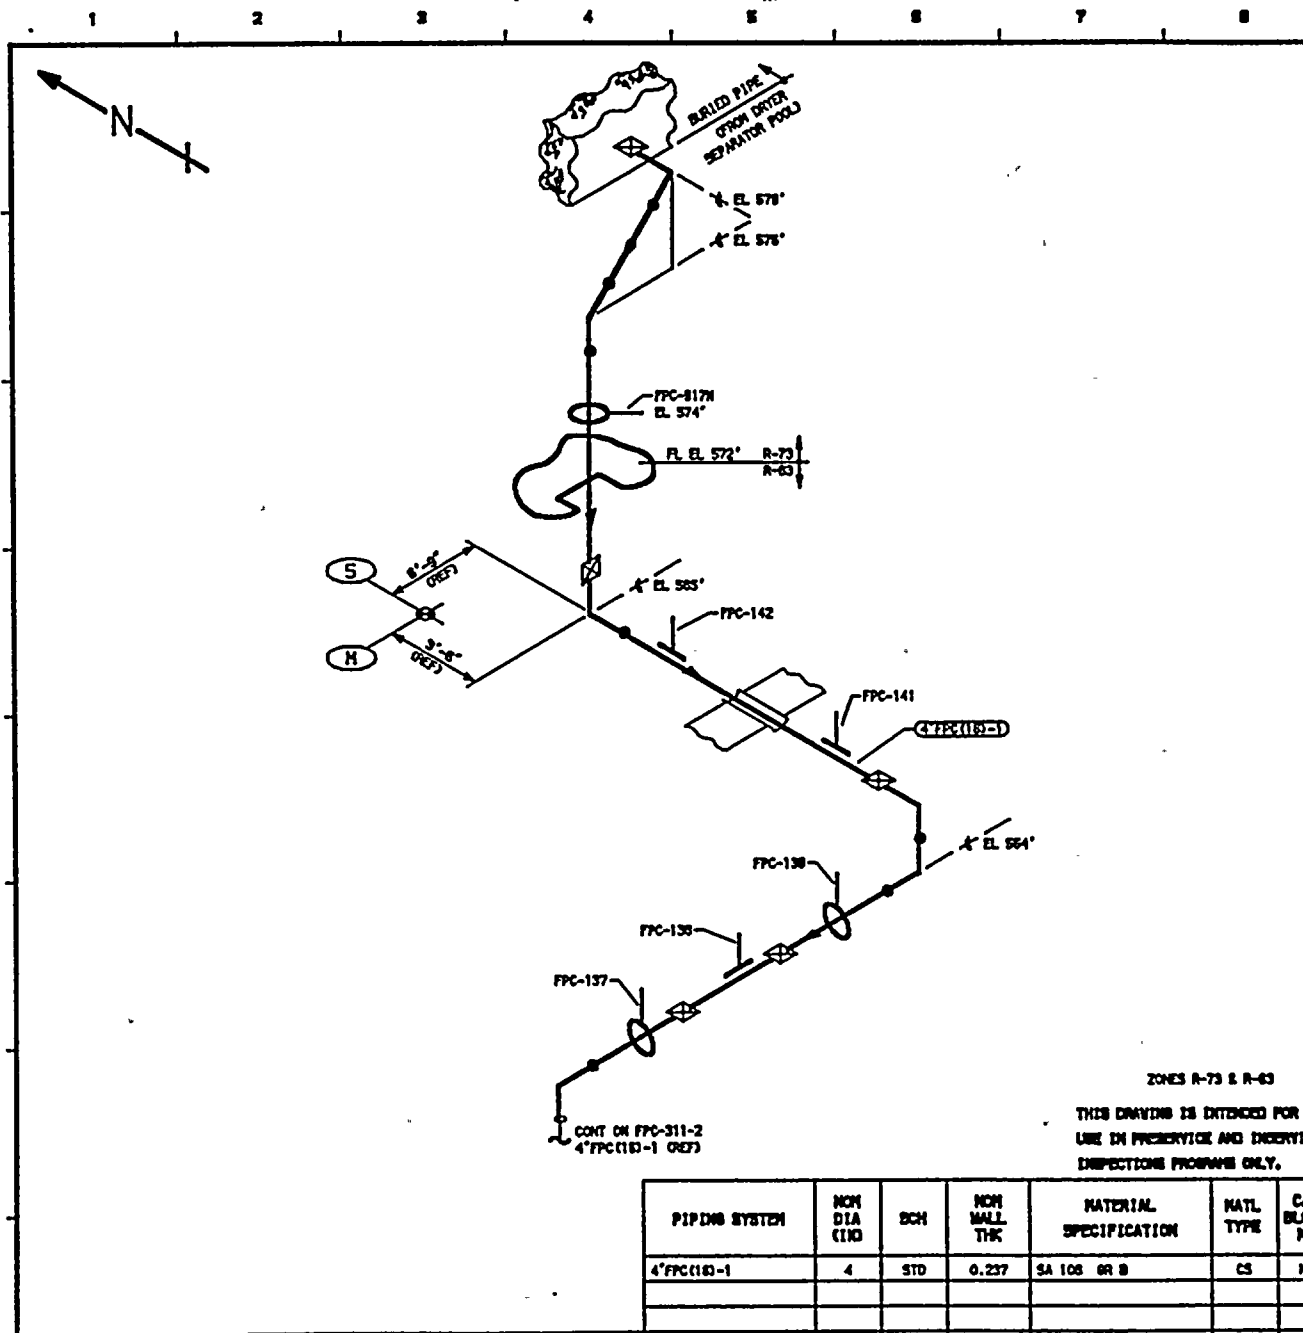


**NOTES:**

1. THIS DRAWING IDENTIFIES PIPING AND COMPONENTS SUBJECT ONLY TO A VISUAL EXAM FOR (1) EVIDENCE OF LEAKAGE DURING SYSTEM PRESSURE OR OPERABILITY TESTS, (2) PRESSURE DECAY TESTS OF BURIED PIPING, AND (3) LOSS OF SUPPORT CAPABILITY OR INADEQUATE RESTRAINT FOR SUPPORTS AND HANGERS ON PIPING EXCEEDING 4" NOM. TESTS SHALL BE CONDUCTED PER ASME SECTION XI, ARTICLES IMA-5000 AND IMA-2000.

**REFERENCES:**

ISI - 228-1  
 BOYCE & CRAIG ISOMETRIC  
 FPC-803-1.7 REV 5

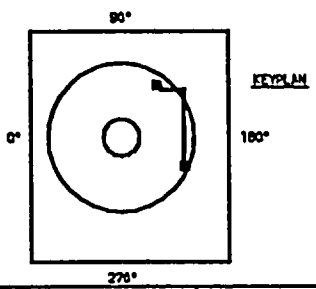

QUALITY CLASS, 2      ASME CODE CLASS, 3  
 ENGR. K-MoANDREX | DRAWN K-MoA | DATE: 10-23-83

**WASHINGTON PUBLIC POWER  
 SUPPLY SYSTEM**  
 BOLDING, WASHINGTON 99006

**WPP-2  
 WELD & COMPONENT  
 IDENTIFICATION DIAGRAM**

TITLE:  
 DRYER SEPARATOR POOL TO FUEL POOL CIRCULATION


DWG NO: FPC-311-1      REV 0

ZONES R-73 & R-63  
 THIS DRAWING IS EXTENDED FOR  
 USE IN PRESERVICE AND INSERVICE  
 INSPECTION PROGRAMS ONLY.

PIPING SYSTEM	NOM DIA (IN)	SCH	NOM WALL THK	MATERIAL SPECIFICATION	MATL TYPE	CAL BLOCK NO
4" FPC (183)-1	4	STD	0.237	SA 108 GR B	CS	NA


NO	DATE	REVISION	BY	CHKD	APVD	K-MoA	DPR	TPH
0	10-18-87	ISSUED FOR USE						



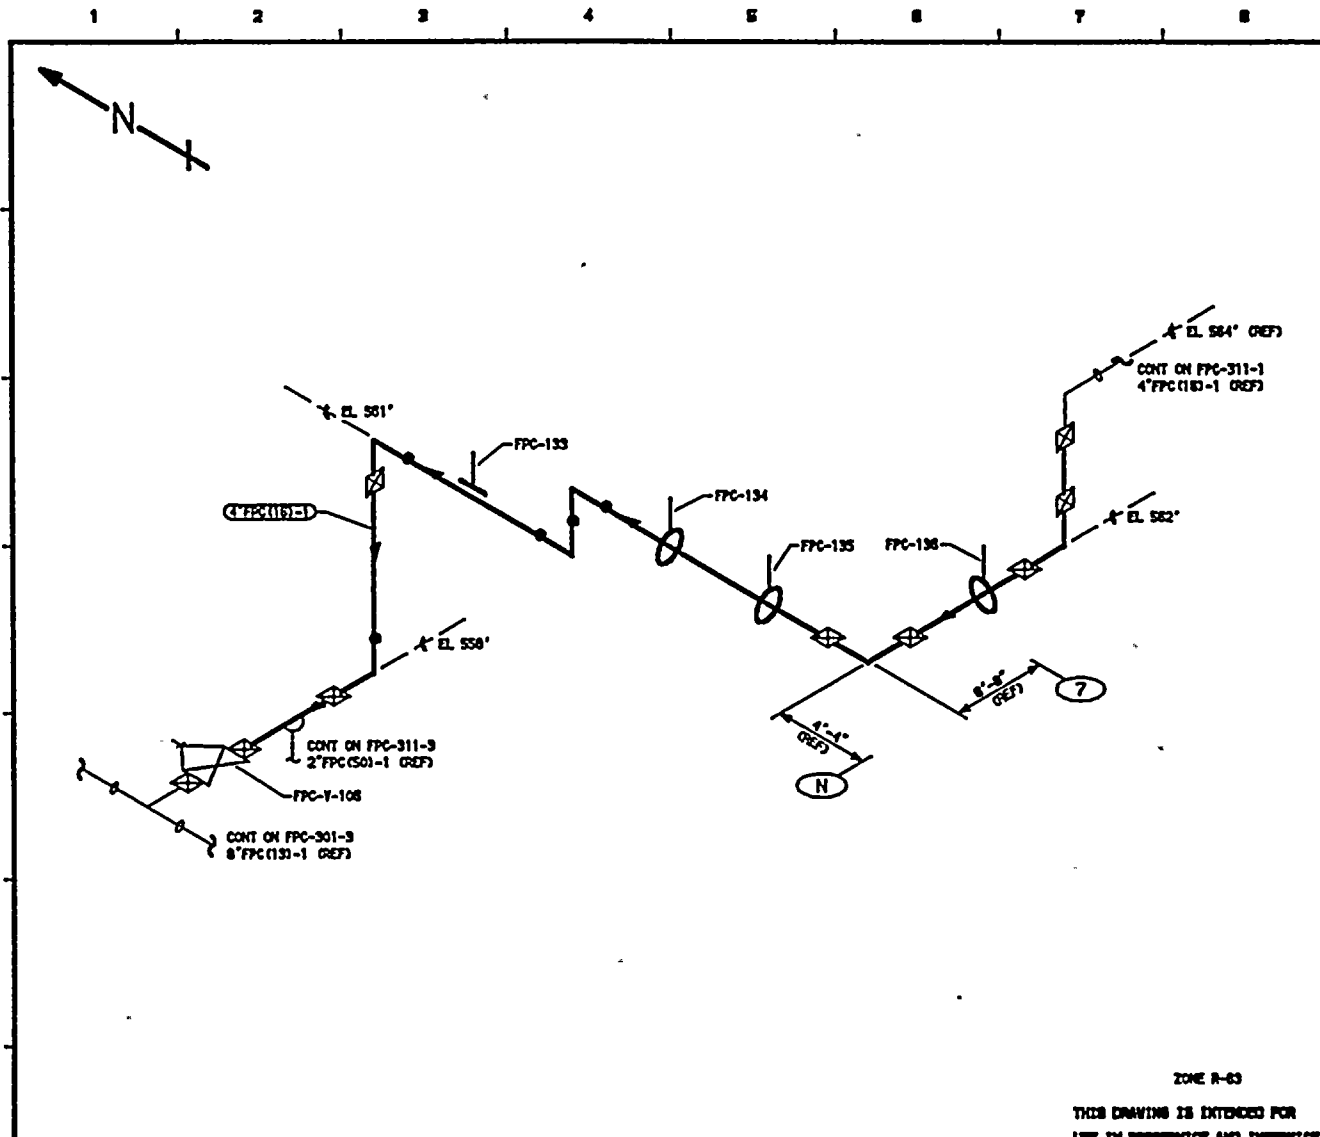

- NOTES:**
1. THIS DRAWING IDENTIFIES PIPING AND COMPONENTS SUBJECT ONLY TO A VISUAL EXAM FOR (1) EVIDENCE OF LEAKAGE DURING SYSTEM PRESSURE OR OPERABILITY TESTS, (2) PRESSURE DECAY TESTS OF BURIED PIPING, AND (3) LOSS OF SUPPORT CAPABILITY OR INADEQUATE RESTRAINT FOR SUPPORTS AND HANGERS ON PIPING EXCEEDING 4" NOM. TESTS SHALL BE CONDUCTED PER ASME SECTION XI, ARTICLES 11A-5000 AND 11D-2000.
  2. FOR BRANCH PIPING 4" NOM. OR LESS (CONNECTION SHOWN IN DASHED LINES) EXTEND VISUAL LEAKAGE EXAM THROUGH THE OUTERMOST NORMALLY CLOSED NUCLEAR CLASS VALVE, OR UNTIL TRANSITION TO INSTRUMENT TUBING, UNLESS OTHERWISE NOTED.

**REFERENCES:**  
 131 - 228-1  
 BOYCE & CRAIG ISOMETRIC  
 FPC-603-1.7 REV 5

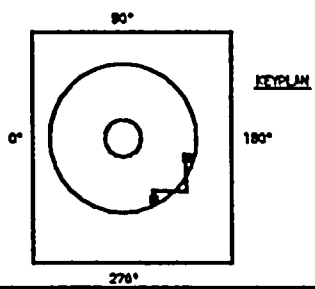

QUALITY CLASS: 2 ASME CODE CLASS: 3  
 ENGR: K-McANDREW DRAWN: K-McA DATE: 10-29-65

**WASHINGTON PUBLIC POWER  
 SUPPLY SYSTEM**  
 RICHLAND, WASHINGTON 99352

**MWP-2  
 WELD & COMPONENT  
 IDENTIFICATION DIAGRAM**

**TITLE:**  
 DRYER SEPARATOR POOL TO FUEL POOL CIRCULATION


DWG NO: FPC-311-2 REV 0

ZONE R-63

THIS DRAWING IS INTENDED FOR  
 USE IN PRESERVICE AND INSERVICE  
 INSPECTIONS PROGRAMS ONLY.

PIPING SYSTEM	NOM DIA (IN)	SCH	NOM WALL THK	MATERIAL SPECIFICATION	MATL TYPE	CAL BLOCK NO
4" FPC(113)-1	4	STD	0.237	SA 106 GR B	CS	NA


NO	DATE	REVISION	BY	CHKD	APVD
0	10-16-67	ISSUED FOR USE	K-McA	DPR	TFH

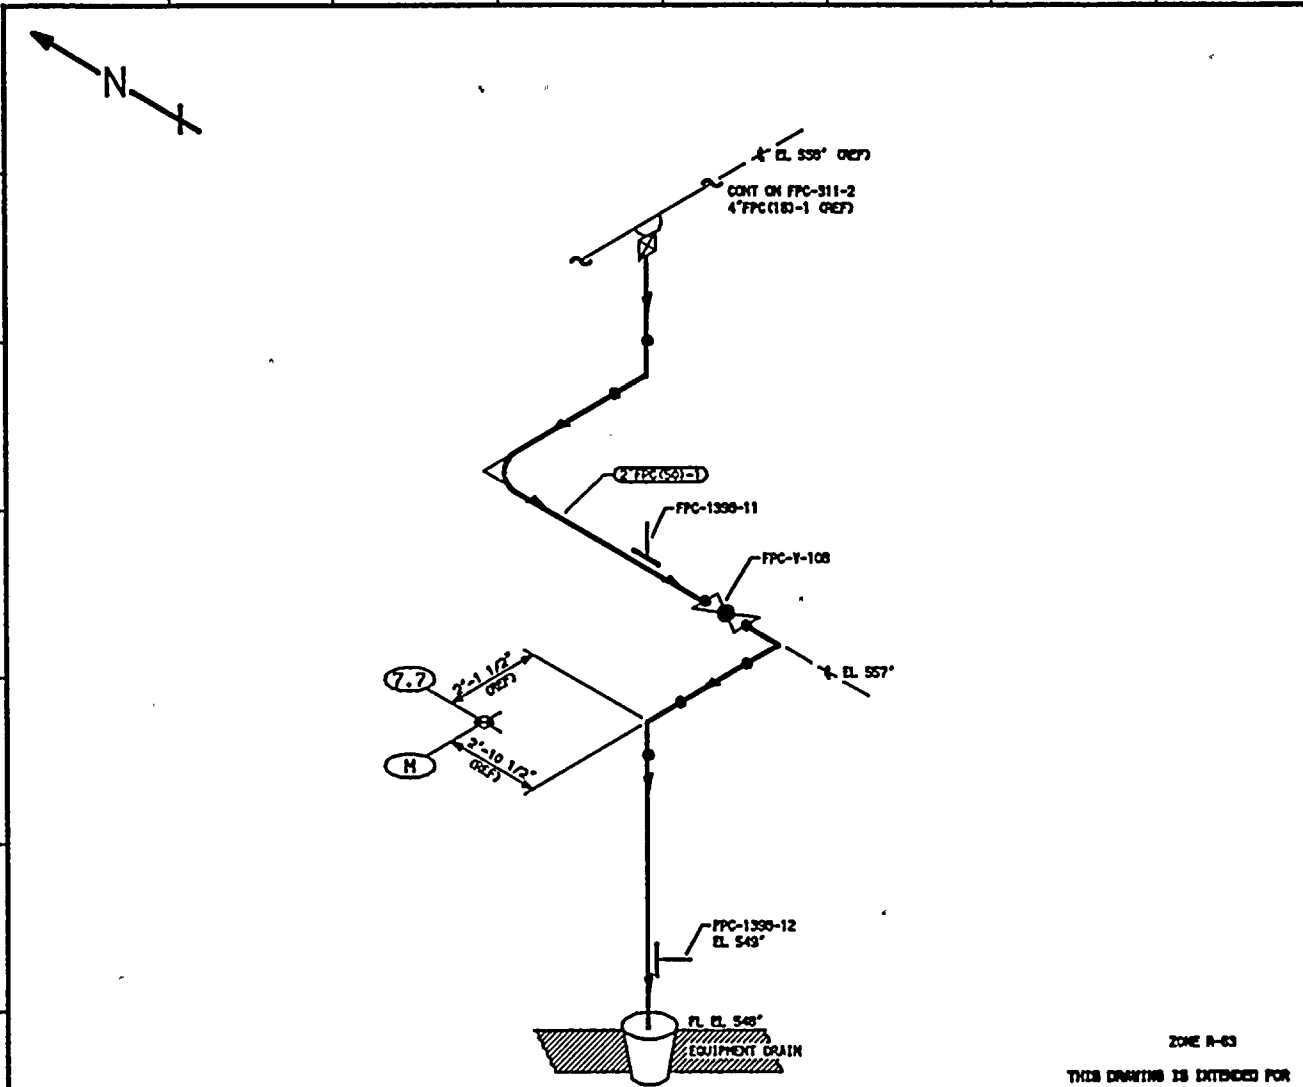

**NOTES:**

1. THIS DRAWING IDENTIFIES PIPING AND COMPONENTS SUBJECT ONLY TO A VISUAL EXAM FOR (1) EVIDENCE OF LEAKAGE DURING SYSTEM PRESSURE OR OPERABILITY TESTS, (2) PRESSURE DECAY TESTS OF BURIED PIPING, AND (3) LOSS OF SUPPORT CAPABILITY OR INADEQUATE RESTRAINT FOR SUPPORTS AND HANGERS ON PIPING EXCEEDING 4" NOM. TESTS SHALL BE CONDUCTED PER ASME SECTION II, ARTICLES 1WA-5000 AND 1WD-2000.

**REFERENCES:**  
 1ST - 226-1  
 DOVEZ & CRAIL ISOMETRIC  
 FPC-1336-1 REV 4

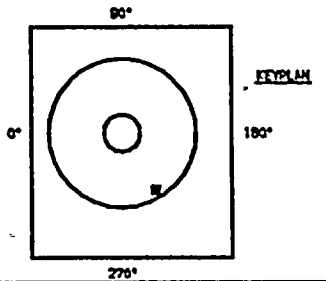

QUALITY CLASS, 2      ASME CODE CLASS, 3  
 ENGR: K-MoANDREX | DRAWN: K-MoA | DATE: 10-30-85

**WASHINGTON PUBLIC POWER  
 SUPPLY SYSTEM**  
 RICHMOND, WASHINGTON 98122

ZONE R-03  
 THIS DRAWING IS EXTENDED FOR  
 USE IN PRESERVICE AND INSERVICE  
 INSPECTIONS PROGRAMS ONLY.


PIPING SYSTEM	NOM DIA (IN)	SCH	NOM WALL THK	MATERIAL SPECIFICATION	NATL TYPE	CAL BLOCK NO
2" FPC(CS)-1	2	80	0.218	SA 106 GR B	CS	NA

WPP-2  
 WELD & COMPONENT  
 IDENTIFICATION DIAGRAM

TITLE:  
 DRYER SEPARATOR POOL TO EQUIPMENT DRAIN

DWG NO: FPC-311-3      REV 0

NO	DATE	REVISION	BY	CHKD	APVD
0	10-16-87	ISSUED FOR USE	K-MoA	DPR	TPH

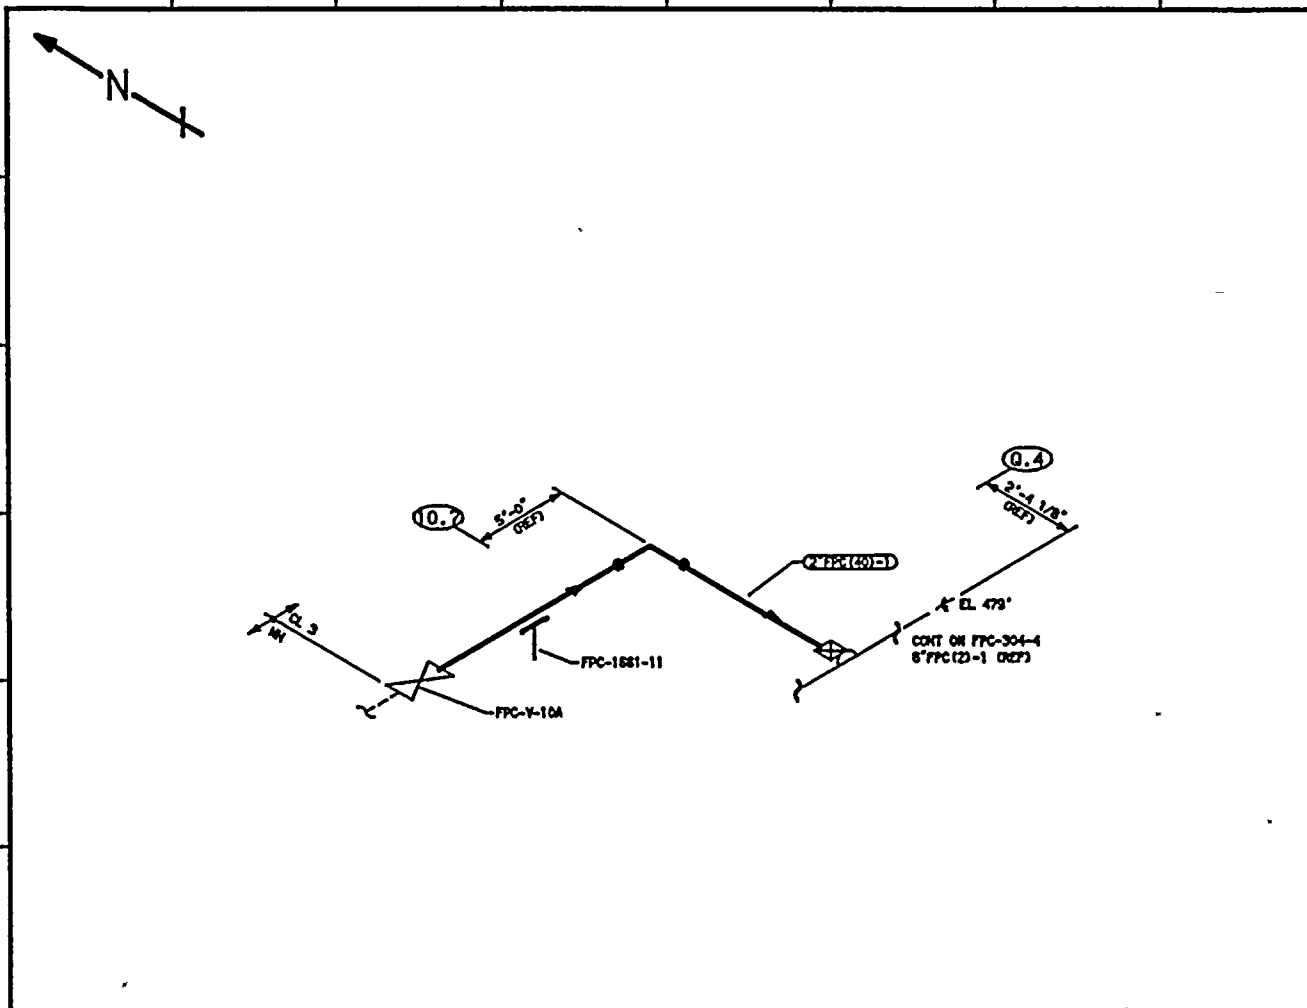


**NOTES:**

1. THIS DRAWING IDENTIFIES PIPING AND COMPONENTS SUBJECT ONLY TO A VISUAL EXAM FOR (1) EVIDENCE OF LEAKAGE DURING SYSTEM PRESSURE OR OPERABILITY TESTS, (2) PRESSURE DECAY TESTS OF BURIED PIPING, AND (3) LOSS OF SUPPORT CAPABILITY OR INADEQUATE RESTRAINT FOR SUPPORTS AND HANGERS ON PIPING EXCEEDING 4" NOM. TESTS SHALL BE CONDUCTED PER ASME SECTION XI, ARTICLES 1WA-5000 AND 1W-2000.

**REFERENCES:**

ISI - 228-2  
 BOYD & CRAIG ISOMETRIC  
 FPC-1681-1 REV 1

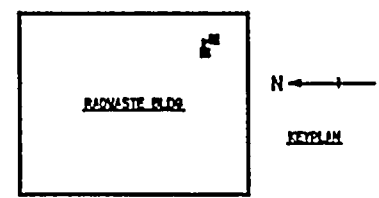

ZONE W-24

THIS DRAWING IS INTENDED FOR  
 USE IN PRE-SERVICE AND IN-SERVICE  
 INSPECTIONS PROGRAMS ONLY.

PIPING SYSTEM	NOM DIA (1/2)	SCH	NOM WALL THK	MATERIAL SPECIFICATION	MATL TYPE	CAL BLOCK NO
2" FPC(40)-1	2	80	0.218	SA 106 GR B	CS	NA

QUALITY CLASS: 2 | ASME CODE CLASS: 3  
 ENGR: K-MoANDREW | DRAWN: K-MoA | DATE: 11-13-85

**WASHINGTON PUBLIC POWER  
 SUPPLY SYSTEM**  
 RICHLAND, WASHINGTON 99354

**WPP-2  
 WELD & COMPONENT  
 IDENTIFICATION DIAGRAM**


**TITLE:  
 CHEMICAL CLEANING TO FPC-DH-1A**

NO	DATE	REVISION	BY	CHKD	APVD
0	10-16-87	ISSUED FOR USE	K-MoA	DPR	TTH

DWG NO: FPC-312 | REV 0






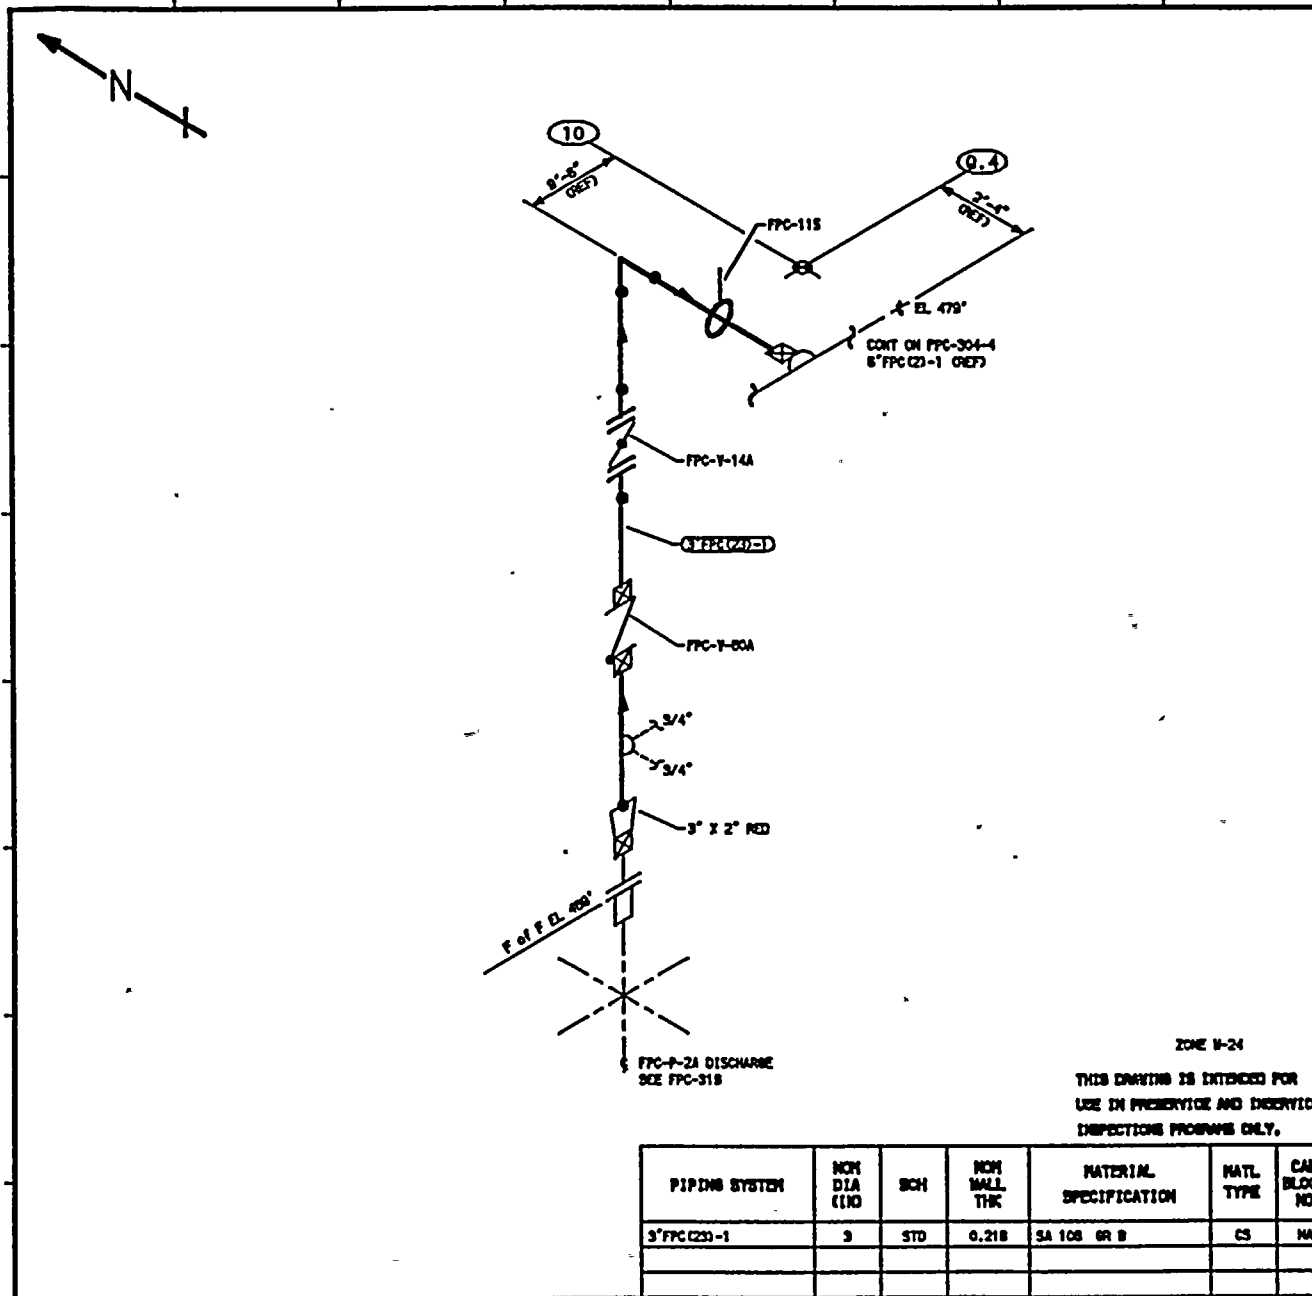

- NOTES:**
1. THIS DRAWING IDENTIFIES PIPING AND COMPONENTS SUBJECT ONLY TO A VISUAL EXAM FOR (1) EVIDENCE OF LEAKAGE DURING SYSTEM PRESSURE OR OPERABILITY TESTS, (2) PRESSURE DECAY TESTS OF BURIED PIPING, AND (3) LOSS OF SUPPORT CAPABILITY OR INADEQUATE RESTRAINT FOR SUPPORTS AND HANGERS ON PIPING EXCEEDING 4" NOM. TESTS SHALL BE CONDUCTED PER ASME SECTION XI, ARTICLES 11A-5000 AND 11A-2000.
  2. FOR BRANCH PIPING 4" NOM. OR LESS (CONNECTION SHOWN IN DASHED LINES) EXTEND VISUAL LEAKAGE EXAM THROUGH THE OUTERMOST NORMALLY CLOSED NUCLEAR CLASS VALVE, OR UNTIL TRANSITION TO INSTRUMENT TUBING, UNLESS OTHERWISE NOTED.

**REFERENCES:**  
 ISI - 228-2  
 BOYCE & CRAIG ISOMETRIC  
 FPC-603-1.3 REV 4

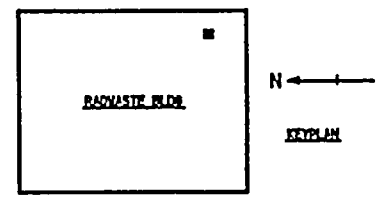

QUALITY CLASS: 2	ASME CODE CLASS: 2
ENGR: K-MoANDREI	DATE: 10-31-83

WASHINGTON PUBLIC POWER  
**SUPPLY SYSTEM**  
 ROCKLAND, WASHINGTON BUREAU

WP-2  
 WELD & COMPONENT  
 IDENTIFICATION DIAGRAM

**TITLE:**  
 HOLDING PUMP FPC-P-2A DISCHARGE

PIPING SYSTEM	NOM DIA (IN)	SCH	NOM WALL THK	MATERIAL SPECIFICATION	MATL TYPE	CAL BLOCK NO
3" FPC (23)-1	3	STD	0.218	SA 108 GR B	CS	NA

NO	DATE	REVISION	BY	CHKD	APVD
0	10-16-87	ISSUED FOR USE	K-MoA	DPR	TTH

DWG NO: FPC-313 REV 0

## 9.5 HPCS High Pressure Core Spray

## Boundary Diagram - ISI-220-1

## Exemptions Applied:

## IWB-1220

(a)	No	
(b)(1)	Yes	All piping 1 NPS and smaller
(b)(2)	Yes	All components 1 NPS and smaller
(c)	No	

## IWC-1221

(a)	Yes	All piping 4 NPS and smaller
(b)	NA <sup>1</sup>	
(c)	Yes	All components 4 NPS and smaller
(d)	NA <sup>1</sup>	
(e)	NA <sup>1</sup>	
(f)	Yes	6" HPCS(4)-1-1, 12" HPCS(3)-1-1

## IWC-1222

NA

IWD-1220.1

NA No Class 3 piping within HPCS system

IWD-1220.2

NA No Class 3 piping within HPCS system

## Code Case N-491

-1230


Yes 6" HPCS(4)-1-1, 12" HPCS(3)-1-1

1

WNP-2 is a BWR



9.5.2 Boundary Diagrams

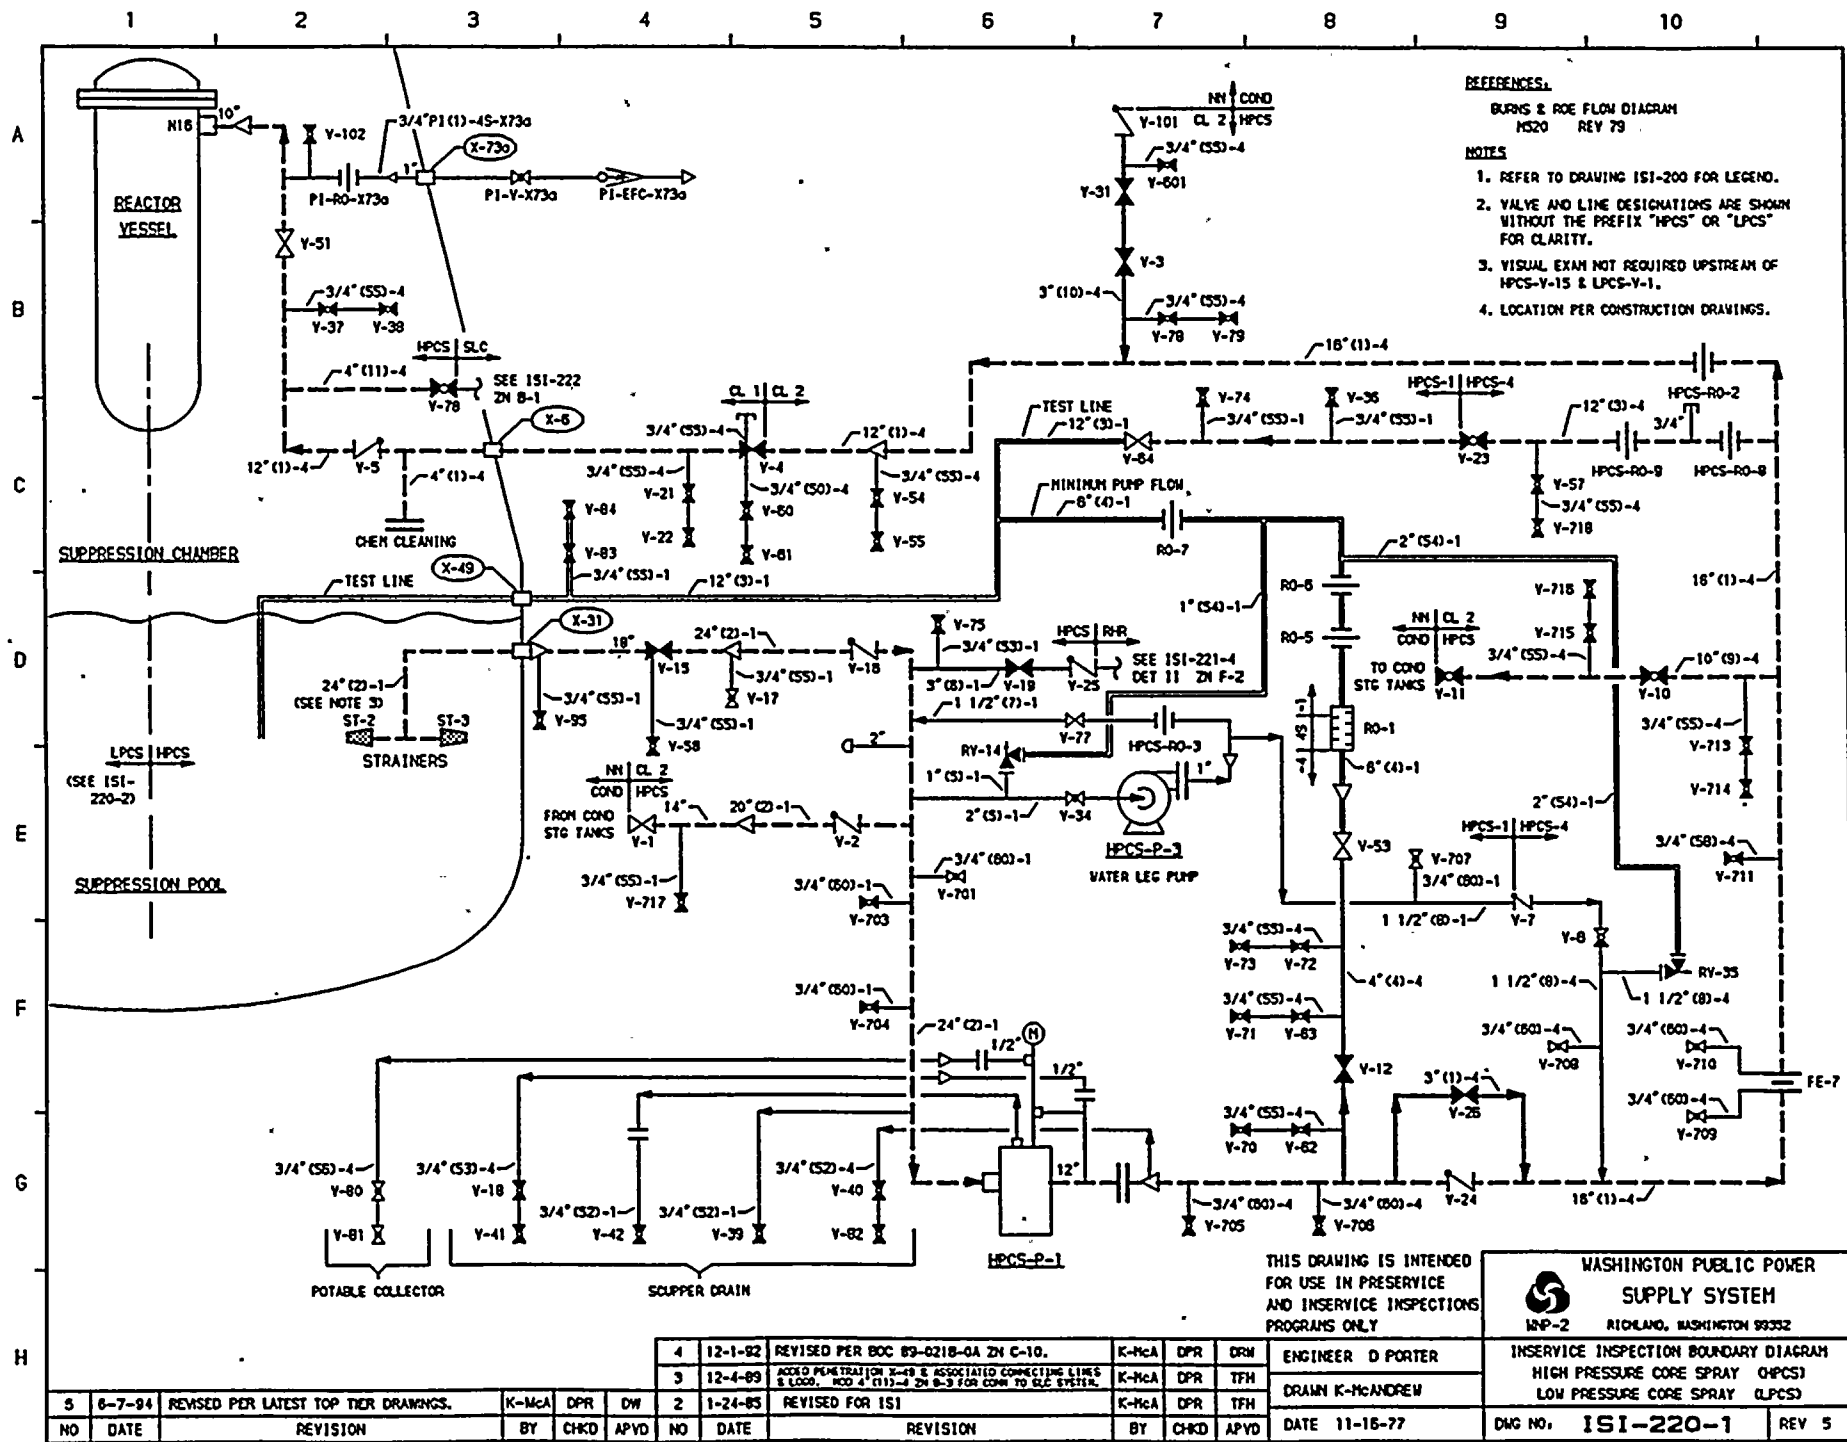

**REFERENCES.**  
 BURNS & ROE FLOW DIAGRAM  
 HSD0 REV 79

**NOTES**

1. REFER TO DRAWING ISI-200 FOR LEGEND.
2. VALVE AND LINE DESIGNATIONS ARE SHOWN WITHOUT THE PREFIX "HPCS" OR "LPCS" FOR CLARITY.
3. VISUAL EXAM NOT REQUIRED UPSTREAM OF HPCS-V-15 & LPCS-V-1.
4. LOCATION PER CONSTRUCTION DRAWINGS.

THIS DRAWING IS INTENDED FOR USE IN PRESERVICE AND INSERVICE INSPECTIONS PROGRAMS ONLY

WASHINGTON PUBLIC POWER  
 SUPPLY SYSTEM  
 12P-2 RICHMOND, WASHINGTON 99352

4	12-1-92	REVISED PER BOC 89-0218-0A ZN C-10.	K-MCA	DPR	DRW
3	12-4-89	ADDED PENETRATION 2-49 & ASSOCIATED CONNECTING LINES & LOGS. MOD 4 (11)-4 ZN 8-3 FOR COND TO SLC SYSTEM.	K-MCA	DPR	TFH
2	1-24-85	REVISED FOR ISI	K-MCA	DPR	TFH
NO	DATE	REVISION	BY	CHKD	APVD

ENGINEER	D PORTER
DRAWN	K-McANDREW
DATE	11-16-77

INSERVICE INSPECTION BOUNDARY DIAGRAM	HIGH PRESSURE CORE SPRAY (HPCS)	LOW PRESSURE CORE SPRAY (LPCS)
DWG NO:	ISI-220-1	REV 5

9.5.3 . Examination Schedule

WNP-2  
Interval 2  
HPCS - High Pressure Core Spray

Table 9.1.4  
Washington Public Power Supply System  
ISI Program Plan and Schedule  
(Grouped by Drawing No. and Walkdown Order)

Revision 0

Pg	Identification No.	Description	Category	Item No.	Method	Per.	Out.	Reqmt.	Code	Out. Freq.	Rel. Req.	Remarks
Diagram No. HPCS-101												
	HPCS-PB-101(L)	LK PRES BNDRY	B-P	B15.50	VT-2	1	10	0	CE	1		
	HPCS-PB-101(H)	HYDRO PRES BNDR	B-P	B15.51	VT-2	3	19	E	CE	10		
	HPCS-V-4-BDY(L)	LK PRES BNDRY	B-P	B15.70	VT-2	1	10	0	CE	1		
	HPCS-V-4-BDY(H)	HYDRO PRES BNDR	B-P	B15.71	VT-2	3	19	E	CE	10		
01	HPCS-V-4-BDY	VALVE BODY	B-M-2	B12.50	VT-3			U	C	0		ANCHOR/DARLING, GATE,CONTAINMENT ISOLATION
	HPCS-V-4-BLT	VALVE BOLTING	B-G-2	B7.70	VT-1	2	16	81	CE	10		
	12HPCS(1)-1	VALVE TO PIPE	B-J	B9.11	SUR VOL			<9 <9	C C	0 0		
	HPCS-42	SPRING	F-A	F1.10B	VT-3			31	C	0		
	12HPCS(1)-2	PIPE TO ELL	B-J	B9.11	SUR VOL			<9 <9	C C	0 0		
	12HPCS(1)-3	ELL TO PEN	B-J	B9.11	SUR VOL			>9 >9	C C	0 0		FITTING TO FITTING FITTING TO FITTING
	12HPCS(1)-4	PEN TO PIPE	B-J	B9.11	SUR VOL			<9 <9	C C	0 0		
	12HPCS(1)-5	PIPE TO ELL	B-J	B9.11	SUR VOL			>9 >9	C C	0 0		
	12HPCS(1)-5LDO	ELL SEAM	B-J	B9.12	SUR VOL			L L	C C	0 0		
	12HPCS(1)-5LDI	ELL SEAM	B-J	B9.12	SUR VOL			L L	C C	0 0		
	12HPCS(1)-6LUO	ELL SEAM	B-J	B9.12	SUR	1	10	L	CE	10		



WNP-2  
Interval 2  
HPCS - High Pressure Core Spray

Table 9.1.4  
Washington Public Power Supply System  
ISI Program Plan and Schedule  
(Grouped by Drawing No. and Walkdown Order)

Revision 0

Pg	Identification No.	Description	Category	Item No.	Method	Per.	Out.	Reqt.	Code	Out. Freq.	Rel. Req.	Remarks
Diagram No. HPCS-101												
01	12HPCS(1)-6LUO	ELL SEAM	B-J	B9.12	VOL	1	10	L	CE	10		
	12HPCS(1)-6LUI	ELL SEAM	B-J	B9.12	SUR	1	10	L	CE	10		
					VOL	1	10	L	CE	10		
	12HPCS(1)-6	ELL TO PIPE	B-J	B9.11	SUR	1	10	>91	CE	10		
					VOL	1	10	>91	CE	10		
	HPCS-907N	STRUT	F-A	F1.10A	VT-3			31	C	0		
	HPCS-911N	RIGID STRUT	F-A	F1.10A	VT-3	1	10	31	CE	10		
	HPCS-908N	STRUT	F-A	F1.10A	VT-3			31	C	0		
	12HPCS(1)-7	PIPE TO ELL	B-J	B9.11	SUR	1	10	>91	CE	10		
					VOL	1	10	>91	CE	10		
	12HPCS(1)-8	ELL TO PIPE	B-J	B9.11	SUR			>9	C	0		
					VOL			>9	C	0		
	12HPCS(1)-9	PIPE TO ELL	B-J	B9.11	SUR			>9	C	0		
					VOL			>9	C	0		
	12HPCS(1)-10	ELL TO PIPE	B-J	B9.11	SUR			>9	C	0		
					VOL			>9	C	0		
	HPCS-906N	SPRING	F-A	F1.10C	VT-3			31	C	0		
	HPCS-904N	SPRING	F-A	F1.10C	VT-3			31	C	0		
	12HPCS(1)-11	PIPE TO ELL	B-J	B9.11	SUR			>9	C	0		
					VOL			>9	C	0		

WNP-2  
Interval 2  
HPCS - High Pressure Core Spray

Table 9.1.4  
Washington Public Power Supply System  
ISI Program Plan and Schedule  
(Grouped by Drawing No. and Walkdown Order)

Revision 0

Pg	Identification No.	Description	Category	Item No.	Method	Per.	Out.	Reqt.	Code	Out. Freq.	Rel. Req.	Remarks
Diagram No. HPCS-101												
01	12HPCS(1)-12	ELL TO PIPE	B-J	B9.11	SUR VOL			>9 >9	C C	0 0		
	12HPCS(1)-13	PIPE TO ELL	B-J	B9.11	SUR VOL			>9 >9	C C	0 0		
	12HPCS(1)-14	ELL TO PIPE	B-J	B9.11	SUR VOL			>9 >9	C C	0 0		
	HPCS-66(W)	4 WELDED LUGS	B-K-1	B10.10	SUR	1	12	81	CE	10		3/4"Wx1 1/8"Hx3"L.
	HPCS-66	SPRING	F-A	F1.10B	VT-3	1	12	31	CE	10		
	HPCS-64(W)	4 WELDED LUGS	B-K-1	B10.10	SUR	2	14	81	CE	10		3/4"W x 2"H x 3"L.
	HPCS-64	HANGER	F-A	F1.10A	VT-3			31	C	0		
	12HPCS(1)-14/4HPCS(1)-4	WOL TO PIPE	B-J	B9.31	SUR VOL			>9 >9	C C	0 0		
	4HPCS(1)-1BD	FLANGE BOLTING	B-G-2	B7.50	VT-1	2	16	81	CE	10		
	4HPCS(1)-1	FLANGE TO PIPE	B-J	B9.11	SUR VOL			<9 <9	C C	0 0		
	4HPCS(1)-2	PIPE TO WOL	B-J	B9.11	SUR VOL	3 3		<9 <9	C C	0 0		
	12HPCS(1)-15	PIPE TO VLV	B-J	B9.11	SUR VOL			>9 >9	C C	0 0		
02	HPCS-V-5-BDY	VALVE BODY	B-M-2	B12.50	VT-3			U	C	0		VELAN, CHECK CONTAINMENT ISOLATION
	HPCS-V-5-BDY(L)	LK PRES BODY	B-P	B15.70	VT-2	1	10	0	CE	1		
	HPCS-V-5-BDY(H)	HYDRO PRES BNDR	B-P	B15.71	VT-2	3	19	E	CE	10		

WNP-2  
Interval 2  
HPCS - High Pressure Core Spray

Table 9.1.4  
Washington Public Power Supply System  
ISI Program Plan and Schedule  
(Grouped by Drawing No. and Walkdown Order)

Revision 0

Pg	Identification No.	Description	Category	Item No.	Method	Per.	Out.	Reqmt.	Code	Out. Freq.	Rel. Req.	Remarks
Diagram No. HPCS-101												
02	HPCS-V-5-BLT	VALVE BOLTING	B-G-2	87.70	VT-1	2	16	81	CE	10		
	12HPCS(1)-16	VLV TO PIPE	B-J	89.11	SUR	1	12	>91	CE	10		
					VOL	1	12	>91	CE	10		
	4HPCS(11)-3	VALVE TO PIPE	B-J	89.11	SUR			<9	C	0		
					VOL			<9	C	0		
	4HPCS(11)-4	PIPE TO WOL	B-J	89.11	SUR			<9	C	0		
					VOL			<9	C	0		
	12HPCS(1)-16/4HPCS(11)-4	PIPE TO WOL	B-J	89.31	SUR			>9	C	0		
					VOL			>9	C	0		
	12HPCS(1)-17	PIPE TO VLV	B-J	89.11	SUR	1	12	>91	CE	10		
					VOL	1	12	>91	CE	10		
	HPCS-V-51-BDY	VALVE BODY	B-M-2	812.50	VT-3			U	C	0		VELAN, GATE, SYSTEM ISOLATION
	HPCS-V-51-BDY(L)	LK PRES BNDRY	B-P	815.70	VT-2	1	10	0	CE	1		
	HPCS-V-51-BDY(H)	HYDRO PRES BNDR	B-P	815.71	VT-2	3	19	E	CE	10		
	HPCS-V-51-BLT	VALVE BOLTING	B-G-2	87.70	VT-1	2	14	81	CE	10		
	12HPCS(1)-18	VLV TO PIPE	B-J	89.11	SUR	1	12	>91	CE	10		
					VOL	1	12	>91	CE	10		
	12HPCS(1)-19	PIPE TO ELL	B-J	89.11	SUR	3	17	>91	CE	10		
					VOL	3	17	>91	CE	10		
	10HPCS(1)-1	ELL TO PIPE	B-J	89.11	SUR	3	17	>91	CE	10		
					VOL	3	17	>91	CE	10		
	10HPCS(1)-2	PIPE TO SE EXT	B-J	89.11	SUR			<9	C	0		SEE RPV-109, NOZZLE N16

WNP-2  
 Interval 2  
 HPCS - High Pressure Core Spray

Table 9.1.4  
 Washington Public Power Supply System  
 ISI Program Plan and Schedule  
 (Grouped by Drawing No. and Walkdown Order)

Revision 0

Pg	Identification No.	Description	Category	Item No.	Method	Per.	Out.	Reqmt.	Code	Out. Freq.	Rel. Req.	Remarks
Diagram No. HPCS-101												
02	10HPCS(1)-2	PIPE TO SE EXT	B-J	B9.11	VOL			<9	C	0		SEE RPV-109, NOZZLE N16
	10HPCS(1)-3	SE EXT TO SE	B-F	B5.130	SUR	3	17	81	CE	10		SEE RPV-105, NOZZLE N16
					VOL	3	17	8A	CGE	10		SEE RPV-105, NOZZLE N16
	10HPCS(1)-4	SE TO NOZZLE	B-F	B5.10	SUR	3	17	81	CE	10		SEE RPV-105, NOZZLE N16
					VOL	1	12	80	CGE	3		SEE RPV-105, NOZZLE N16

WNP-2  
Interval 2  
HPCS - High Pressure Core Spray

Table 9.1.4  
Washington Public Power Supply System  
ISI Program Plan and Schedule  
(Grouped by Drawing No. and Walkdown Order)

Revision 0

Pg	Identification No.	Description	Category	Item No.	Method	Per.	Out.	Reqt.	Code	Out. Freq.	Rel. Req.	Remarks
Diagram No. HPCS-201												
	HPCS-PB-201(L)	LK PRES BNDRY	C-H	C7.30	VT-2	1	13	P	CE	3		
	HPCS-PB-201(H)	HYDRO PRES BNDR	C-H	C7.40	VT-2	3	19	E	CE	10		
	HPCS-PB-PUMP(L)	LK PRES BNDRY	C-H	C7.50	VT-2	1	13	P	CE	3		
	HPCS-PB-PUMP(H)	HYDRO PRES BNDR	C-H	C7.60	VT-2	3	19	E	CE	10		
01	24HPCS(2)-1	PEN TO RED	C-F-2	C5.51	SUR VOL			2 2	C C	0 0		
	18HPCS(2)-1	RED TO VALVE	C-F-2	C5.51	SUR VOL			2 2	C C	0 0		
	18HPCS(2)-2	VALVE TO RED	C-F-2	C5.51	SUR VOL			2 2	C C	0 0		
	24HPCS(2)-2	RED TO VALVE	C-F-2	C5.51	SUR VOL			2 2	C C	0 0		
	24HPCS(2)-3	VALVE TO PIPE	C-F-2	C5.51	SUR VOL			2 2	C C	0 0		
	HPCS-900N	STRUT	F-A	F1.20A	VT-3			41	C	0		
	24HPCS(2)-4	PIPE TO ELBOW	C-F-2	C5.51	SUR VOL			2 2	C C	0 0		
	24HPCS(2)-5	ELBOW TO PIPE	C-F-2	C5.51	SUR VOL	3 3	19 19	21 21	CE CE	10 10		
	24HPCS(2)-6	PIPE TO PIPE	C-F-2	C5.51	SUR VOL			2 2	C C	0 0		

WNP-2  
Interval 2  
HPCS - High Pressure Core Spray

Table 9.1.4  
Washington Public Power Supply System  
ISI Program Plan and Schedule  
(Grouped by Drawing No. and Walkdown Order)

Revision 0

Pg	Identification No.	Description	Category	Item No.	Method	Per.	Out.	Requmt.	Code	Out. Freq.	Rel. Req.	Remarks
Diagram No. HPCS-201												
01	HPCS-901N	BOX	F-A	F1.20A	VT-3		41		C	0		
	24HPCS(2)-7	PIPE TO ELBOW	C-F-2	C5.51	SUR		2		C	0		
					VOL		2		C	0		
	24HPCS(2)-8	PIPE TO ELBOW	C-F-2	C5.51	SUR		2		C	0		
					VOL		2		C	0		
	HPCS-52	ANCHOR	F-A	F1.20A	VT-3		41		C	0		
	24HPCS(2)-8/2CAP	BRANCH CONN	NA	NA	SUR		2					
	24HPCS(2)-9	PIPE TO ELBOW	C-F-2	C5.51	SUR		2		C	0		
					VOL		2		C	0		
02	24HPCS(2)-10	PIPE TO ELBOW	C-F-2	C5.51	SUR		2		C	0		
					VOL		2		C	0		
	24HPCS(2)-11	ELBOW TO PIPE	C-F-2	C5.51	SUR		2		C	0		
					VOL		2		C	0		
	HPCS-46	SPRING	F-A	F1.20C	VT-3		41		C	0		
	24HPCS(2)-12	PIPE TO TEE	C-F-2	C5.51	SUR		2		C	0		
					VOL		2		C	0		
	20HPCS(2)-3	TEE TO PIPE	C-F-2	C5.51	SUR		2		C	0		
					VOL		2		C	0		
	HPCS-45	SPRING	F-A	F1.20C	VT-3		41		C	0		
	20HPCS(2)-2	PIPE TO VALVE	C-F-2	C5.51	SUR		2		C	0		

WNP-2  
Interval 2.  
HPCS - High Pressure Core Spray

Table 9.1.4  
Washington Public Power Supply System  
ISI Program Plan and Schedule  
(Grouped by Drawing No. and Walkdown Order)

Revision 0

Pg	Identification No.	Description	Category	Item No.	Method	Per.	Out.	Requmt.	Code	Out. Freq.	Rel. Req.	Remarks
Diagram No. HPCS-201												
02	20HPCS(2)-2	PIPE TO VALVE	C-F-2	C5.51	VOL			2	C	0		
	20HPCS(2)-1	VALVE TO RED	C-F-2	C5.51	SUR VOL			2 2	C C	0 0		
	14HPCS(2)-1	RED TO VALVE	C-F-2	C5.51	SUR VOL			2 2	C C	0 0		
	24HPCS(2)-13	TEE TO PIPE	C-F-2	C5.51	SUR VOL			2 2	C C	0 0		
	HPCS-47	PSA-3 SNUBBER	F-A	F1.200	VT-3	2	16	41	CE	10		
	HPCS-48	STRUT	F-A	F1.20A	VT-3			41	C	0		
	HPCS-49	STRUT	F-A	F1.20A	VT-3			41	C	0		
	24HPCS(2)-14	PIPE TO FLANGE	C-F-2	C5.51	SUR VOL			2 2	C C	0 0		
	24HPCS(2)-15	FLANGE TO PIPE	C-F-2	C5.51	SUR VOL			2 2	C C	0 0		
	24HPCS(2)-16	PIPE TO FLANGE	C-F-2	C5.51	SUR VOL			2 2	C C	0 0		
	24HPCS(2)-17	FLANGE TO PIPE	C-F-2	C5.51	SUR VOL	3 3	19 19	21 21	CE CE	10 10		
	24HPCS(2)-18	PIPE TO ELBOW	C-F-2	C5.51	SUR VOL			2 2	C C	0 0		
	24HPCS(2)-19	ELBOW TO PIPE	C-F-2	C5.51	SUR			2	C	0		

WNP-2  
Interval 2  
HPCS - High Pressure Core Spray

Table 9.1.4  
Washington Public Power Supply System  
ISI Program Plan and Schedule  
(Grouped by Drawing No. and Walkdown Order)

Revision 0

Pg	Identification No.	Description	Category	Item No.	Method	Per.	Out.	Reqmt.	Code	Out. Freq.	Rel. Req.	Remarks
Diagram No. HPCS-201												
02	24HPCS(2)-19	ELBOW TO PIPE	C-F-2	C5.51	VOL		2		C	0		
	24HPCS(2)-20	PIPE TO NOZZLE	C-F-2	C5.51	SUR		2		C	0		
					VOL		2		C	0		
	HPCS-P-1(CS)	PUMP BASE	F-A	F1.40A	VT-3	1	10	61	CE	10		



WNP-2  
Interval 2  
HPCS - High Pressure Core Spray

Table 9.1.4  
Washington Public Power Supply System  
ISI Program Plan and Schedule  
(Grouped by Drawing No. and Walkdown Order)

Revision 0

Pg	Identification No.	Description	Category	Item No.	Method	Per.	Out.	Requmt.	Code	Out. Freq.	Rel. Req.	Remarks
Diagram No. HPCS-202												
	HPCS-PB-202(L)	LK PRES BNDRY	C-H	C7.30	VT-2	1	21	P	CE	3		
	HPCS-PB-202(H)	HYDRO PRES BNDR	C-H	C7.40	VT-2	3	19	E	CE	10		
01	12HPCS(1)-1A	FLANGE TO RED	C-F-2	C5.51	SUR VOL			2 2	C C	0 0		
	16HPCS(1)-1	RED TO ELL	C-F-2	C5.51	SUR VOL			2 2	C C	0 0		
	HPCS-1	SPRING	F-A	F1.20C	VT-3			41	C	0		
	16HPCS(1)-2	ELL TO PIPE	C-F-2	C5.51	SUR VOL			2 2	C C	0 0		
	16HPCS(1)-2/4(4)-4	BRANCH CONN	NA	NA	SUR					0		
	16HPCS(1)-2/3(1)-4	BRANCH CONN	NA	NA	SUR			Z				
	16HPCS(1)-3	PIPE TO VLV	C-F-2	C5.51	SUR VOL			2 2	C C	0 0		
	16HPCS(1)-4	VLV TO ELL	C-F-2	C5.51	SUR VOL			2 2	C C	0 0		
	16HPCS(1)-4/3(1)-4	BRANCH CONN	NA	NA	SUR			Z				
	16HPCS(1)-5	ELL TO PIPE	C-F-2	C5.51	SUR VOL			2 2	C C	0 0		
	16HPCS(1)-6	PIPE TO ELL	C-F-2	C5.51	SUR VOL			2 2	C C	0 0		

WNP-2  
Interval 2  
HPCS - High Pressure Core Spray

Table 9.1.4  
Washington Public Power Supply System  
ISI Program Plan and Schedule  
(Grouped by Drawing No. and Walkdown Order)

Revision 0

Pg	Identification No.	Description	Category	Item No.	Method	Per.	Out.	Requint.	Code	Out. Freq.	Rel. Req.	Remarks
Diagram No. HPCS-202												
01	16HPCS(1)-7	ELL TO PIPE	C-F-2	C5.51	SUR VOL	2	15	21	CE CE	10 10		
	HPCS-23	SPRING	F-A	F1.20C	VT-3	2	15	41	CE	10		
	HPCS-21	RIGID	F-A	F1.20A	VT-3	2	15	41	CE	10		
	16HPCS(1)-8	PIPE TO ELL	C-F-2	C5.51	SUR VOL			2 2	C C	0 0		
02	16HPCS(1)-9	ELL TO PIPE	C-F-2	C5.51	SUR VOL			2 2	C C	0 0		
	16HPCS(1)-10	PIPE TO ELL	C-F-2	C5.51	SUR VOL			2 2	C C	0 0		
	16HPCS(1)-11	ELL TO PIPE	C-F-2	C5.51	SUR VOL			2 2	C C	0 0		
	HPCS-20	RIGID	F-A	F1.20A	VT-3			41	C	0		
	16HPCS(1)-12	PIPE TO FLANGE	C-F-2	C5.51	SUR VOL			2 2	C C	0 0		
	16HPCS(1)-13	FLANGE TO PIPE	C-F-2	C5.51	SUR VOL			2 2	C C	0 0		
	16HPCS(1)-14	PIPE TO ELL	C-F-2	C5.51	SUR VOL			2 2	C C	0 0		
	16HPCS(1)-15	ELL TO ELL	C-F-2	C5.51	SUR VOL			2 2	C C	0 0		

WNP-2  
Interval 2  
HPCS - High Pressure Core Spray

Table 9.1.4  
Washington Public Power Supply System  
ISI Program Plan and Schedule  
(Grouped by Drawing No. and Walkdown Order)

Revision 0

Pg	Identification No.	Description	Category	Item No.	Method	Per.	Out.	Reqmt.	Code	Out. Freq.	Rel. Req.	Remarks
Diagram No. HPCS-202												
02	16HPCS(1)-16	ELL TO PIPE	C-F-2	C5.51	SUR VOL			2 2	C C	0 0		
	16HPCS(1)-17	PIPE TO TEE	C-F-2	C5.51	SUR VOL			2 2	C C	0 0		
	HPCS-44	SPRING	F-A	F1.20C	VT-3	1	10	41	CE	10		
	16HPCS(1)-18	TEE TO TEE	C-F-2	C5.51	SUR VOL			2 2	C C	0 0		
	12HPCS(3)-1A	TEE TO RO	C-F-2	C5.51	SUR VOL			2 2	C C	0 0		
	12HPCS(3)-1B	RO TO PIPE	C-F-2	C5.51	SUR VOL			2 2	C C	0 0		
	12HPCS(3)-1C	PIPE TO RO	C-F-2	C5.51	SUR VOL			2 2	C C	0 0		
	12HPCS(3)-3A	RO TO PIPE	C-F-2	C5.51	SUR VOL			2 2	C C	0 0		
	HPCS-13	ANCHOR	F-A	F1.20A	VT-3	1	10	41	CE	10		
	12HPCS(3)-4	PIPE TO VALVE	C-F-2	C5.51	SUR VOL			2 2	C C	0 0		
	12HPCS(3)-5	VALVE TO PIPE	C-F-2	C5.51	SUR VOL			2 2	C C	0 0		
	12HPCS(3)-6	PIPE TO VALVE	C-F-2	C5.51	SUR VOL			2 2	C C	0 0		

WNP-2  
Interval 2  
HPCS - High Pressure Core Spray

Table 9.1.4  
Washington Public Power Supply System  
ISI Program Plan and Schedule  
(Grouped by Drawing No. and Walkdown Order)

Revision 0

Pg	Identification No.	Description	Category	Item No.	Method	Per.	Out.	Reqmt.	Code	Out. Freq.	Rel. Req.	Remarks
Diagram No. HPCS-202												
02	16HPCS(1)-19	TEE TO PIPE	C-F-2	C5.51	SUR VOL			2 2	C C	0 0		
	HPCS-15	ANCHOR	F-A	F1.20A	VT-3	1	10	41	CE	0		
	16HPCS(1)-20	PIPE TO PIPE	C-F-2	C5.51	SUR VOL			2 2	C C	0 0		
	16HPCS(1)-21	PIPE TO ELL	C-F-2	C5.51	SUR VOL			2 2	C C	0 0		
	16HPCS(1)-22	ELL TO PIPE	C-F-2	C5.51	SUR VOL			2 2	C C	0 0		
	HPCS-903N	STRUT	F-A	F1.20A	VT-3			41	C	0		
	HPCS-24	STRUT	F-A	F1.20A	VT-3			41	C	0		
03	10HPCS(9)-5	PIPE TO VLV	C-F-2	C5.51	SUR VOL			2 2	C C	0 0		
	HPCS-17	STRUT	F-A	F1.20A	VT-3			41	C	0		
	10HPCS(9)-4	VLV TO PIPE	C-F-2	C5.51	SUR VOL			2 2	C C	0 0		
	10HPCS(9)-3	ELL TO VLV	C-F-2	C5.51	SUR VOL			2 2	C C	0 0		
	10HPCS(9)-2	PIPE TO ELL	C-F-2	C5.51	SUR VOL			2 2	C C	0 0		

WNP-2  
Interval 2  
HPCS - High Pressure Core Spray

Table 9.1.4  
Washington Public Power Supply System  
ISI Program Plan and Schedule  
(Grouped by Drawing No. and Walkdown Order)

Revision 0

Pg	Identification No.	Description	Category	Item No.	Method	Per.	Out.	Reqmt.	Code	Out. Freq.	Rel. Req.	Remarks
Diagram No. HPCS-202												
03	HPCS-16	STRUT	F-A	F1.20A	VT-3			41	C	0		
	HPCS-18	STRUT	F-A	F1.20A	VT-3			41	C	0		
	10HPCS(9)-1	TEE TO PIPE	C-F-2	C5.51	SUR	1	11	21	CE	10		
					VOL	1	11	21	CE	10		
04	16HPCS(1)-23	PIPE TO ELL	C-F-2	C5.51	SUR			2	C	0		
					VOL			2	C	0		
	16HPCS(1)-24	ELL TO PIPE	C-F-2	C5.51	SUR			2	C	0		
					VOL			2	C	0		
	HPCS-25	SPRING	F-A	F1.20C	VT-3			41	C	0		
	16HPCS(1)-25	PIPE TO ELL	C-F-2	C5.51	SUR	2		2	C	0		
					VOL	2		2	C	0		
	16HPCS(1)-26	ELL TO PIPE	C-F-2	C5.51	SUR	2		2	C	0		
					VOL	2		2	C	0		
	HPCS-26	STRUT	F-A	F1.20A	VT-3	2	15	41	CE	10		
	16HPCS(1)-27	PIPE TO ELL	C-F-2	C5.51	SUR	2	15	21	CE	10		
					VOL	2	15	21	CE	10		
	16HPCS(1)-28	ELL TO PIPE	C-F-2	C5.51	SUR			2	C	0		
					VOL			2	C	0		
	16HPCS(1)-29	PIPE TO ELL	C-F-2	C5.51	SUR			2	C	0		
					VOL			2	C	0		
	16HPCS(1)-30	ELL TO PIPE	C-F-2	C5.51	SUR			2	C	0		

WNP-2  
Interval 2  
HPCS - High Pressure Core Spray

Table 9.1.4  
Washington Public Power Supply System  
ISI Program Plan and Schedule  
(Grouped by Drawing No. and Walkdown Order)

Revision 0

Pg	Identification No.	Description	Category	Item No.	Method	Per.	Out.	Reqmt.	Code	Out. Freq.	Rel. Req.	Remarks
Diagram No. HPCS-202												
04	16HPCS(1)-30	ELL TO PIPE	C-F-2	C5.51	VOL		2		C		0	
	HPCS-27	STRUT	F-A	F1.20A	VT-3		41		C		0	
	HPCS-28	BOX	F-A	F1.20A	VT-3		41		C		0	
	HPCS-917N	STRUT	F-A	F1.20A	VT-3		41		C		0	
	HPCS-915N	STRUT	F-A	F1.20A	VT-3		41		C		0	
	16HPCS(1)-31	PIPE TO ELL	C-F-2	C5.51	SUR VOL		2 2		C C		0 0	
	HPCS-909N	STRUT	F-A	F1.20A	VT-3		41		C		0	
	16HPCS(1)-32	ELL TO PIPE	C-F-2	C5.51	SUR VOL		2 2		C C		0 0	
	16HPCS(1)-33	PIPE TO PIPE	C-F-2	C5.51	SUR VOL		2 2		C C		0 0	
	16HPCS(1)-34	PIPE TO ELL	C-F-2	C5.51	SUR VOL		2 2		C C		0 0	
	16HPCS(1)-35	ELL TO PIPE	C-F-2	C5.51	SUR VOL		2 2		C C		0 0	
	16HPCS(1)-36	PIPE TO ELL	C-F-2	C5.51	SUR VOL		2 2		C C		0 0	
05	16HPCS(1)-37	ELL TO PIPE	C-F-2	C5.51	SUR VOL		2 2		C C		0 0	

WNP-2  
Interval 2  
HPCS - High Pressure Core Spray

Table 9.1.4  
Washington Public Power Supply System  
ISI Program Plan and Schedule  
(Grouped by Drawing No. and Walkdown Order)

Revision 0

Pg	Identification No.	Description	Category	Item No.	Method	Per.	Out.	Reqt.	Code	Out. Freq.	Rel. Req.	Remarks
Diagram No. HPCS-202												
05	HPCS-31	STRUT	F-A	F1.20A	VT-3			41	C	0		
	HPCS-32	SPRING	F-A	F1.20C	VT-3			41	C	0		
	HPCS-33	BOX/STRUT	F-A	F1.20A	VT-3			41	C	0		
	16HPCS(1)-38	PIPE TO PIPE	C-F-2	C5.51	SUR VOL			2 2	C C	0 0		
	HPCS-34	SPRING	F-A	F1.20C	VT-3			41	C	0		
	HPCS-916N	BOX	F-A	F1.20A	VT-3			41	C	0		
	16HPCS(1)-39	PIPE TO ELL	C-F-2	C5.51	SUR VOL			2 2	C C	0 0		
	16HPCS(1)-40	ELL TO PIPE	C-F-2	C5.51	SUR VOL			2 2	C C	0 0		
	HPCS-35	SPRING	F-A	F1.20C	VT-3			41	C	0		
	16HPCS(1)-41	PIPE TO ELL	C-F-2	C5.51	SUR VOL			2 2	C C	0 0		
	16HPCS(1)-42	ELL TO PIPE	C-F-2	C5.51	SUR VOL	3 3	17 17	21 21	CE CE	10 10		
	HPCS-37	ANCHOR	F-A	F1.20A	VT-3			41	C	0		
	HPCS-38	SPRING	F-A	F1.20C	VT-3			41	C	0		
	16HPCS(1)-43	PIPE TO ELL	C-F-2	C5.51	SUR VOL			2 2	C C	0 0		

WNP-2  
Interval 2  
HPCS - High Pressure Core Spray

Table 9.1.4  
Washington Public Power Supply System  
ISI Program Plan and Schedule  
(Grouped by Drawing No. and Walkdown Order)

Revision 0

Pg	Identification No.	Description	Category	Item No.	Method	Per.	Out.	Reqmt.	Code	Out. Freq.	Rel. Req.	Remarks
Diagram No. HPCS-202												
06	HPCS-40	STRUT	F-A	F1,20A	VT-3			41	C	0		
	16HPCS(1)-44	ELL TO PIPE	C-F-2	C5.51	SUR			2	C	0		
					VOL			2	C	0		
	16HPCS(1)-45	PIPE TO ELL	C-F-2	C5.51	SUR			2	C	0		
					VOL			2	C	0		
	16HPCS(1)-46	ELL TO PIPE	C-F-2	C5.51	SUR			2	C	0		
					VOL			2	C	0		
	16HPCS(1)-47	PIPE TO ELL	C-F-2	C5.51	SUR			2	C	0		
					VOL			2	C	0		
	16HPCS(1)-48	ELL TO FLANGE	C-F-2	C5.51	SUR			2	C	0		
					VOL			2	C	0		
	16HPCS(1)-49	FLANGE TO PIPE	C-F-2	C5.51	SUR			2	C	0		
					VOL			2	C	0		
	16HPCS(1)-49/3(10)-4	BRANCH CONN	NA	NA	SUR			2				
	HPCS-925N	PSA-3 SHUBBER	F-A	F1.200	VT-3			4	C	0		
	HPCS-905N	PSA-10 SHUBBER	F-A	F1.200	VT-3			4	C	0		
	HPCS-924N	PSA-3 SHUBBER	F-A	F1.200	VT-3			4	C	0		
	16HPCS(1)-50	PIPE TO RED	C-F-2	C5.51	SUR	3	19	21	CE	10		
					VOL	3	19	21	CE	10		
	12HPCS(1)-51	RED TO VALVE	C-F-2	C5.51	SUR			2	C	0		



WNP-2  
Interval 2  
HPCS - High Pressure Core Spray

Table 9.1.4  
Washington Public Power Supply System  
ISI Program Plan and Schedule  
(Grouped by Drawing No. and Walkdown Order)

Revision 0

Pg	Identification No.	Description	Category	Item No.	Method	Per.	Out.	Reqmt.	Code	Out. Freq.	Rel. Req.	Remarks
Diagram No. HPCS-202												
06	12HPCS(1)-51	RED TO VALVE	C-F-2	CS.51	VOL		2		C	0		

WNP-2  
 Interval 2  
 HPCS - High Pressure Core Spray

Table 9.1.4  
 Washington Public Power Supply System  
 ISI Program Plan and Schedule  
 (Grouped by Drawing No. and Walkdown Order)


Revision 0

Pg	Identification No.	Description	Category	Item No.	Method	Per.	Out.	Reqmt.	Code	Out. Freq.	Rel. Req.	Remarks
Diagram No. HPCS-205												
01	HPCS-7	ANCHOR	NA	NA	NA							
02	HPCS-921N	STRUT	NA	NA	NA							
	HPCS-12	STRUT	NA	NA	NA							
	HPCS-922N	STRUT	NA	NA	NA							


9.5.4 Weld and Component Diagrams





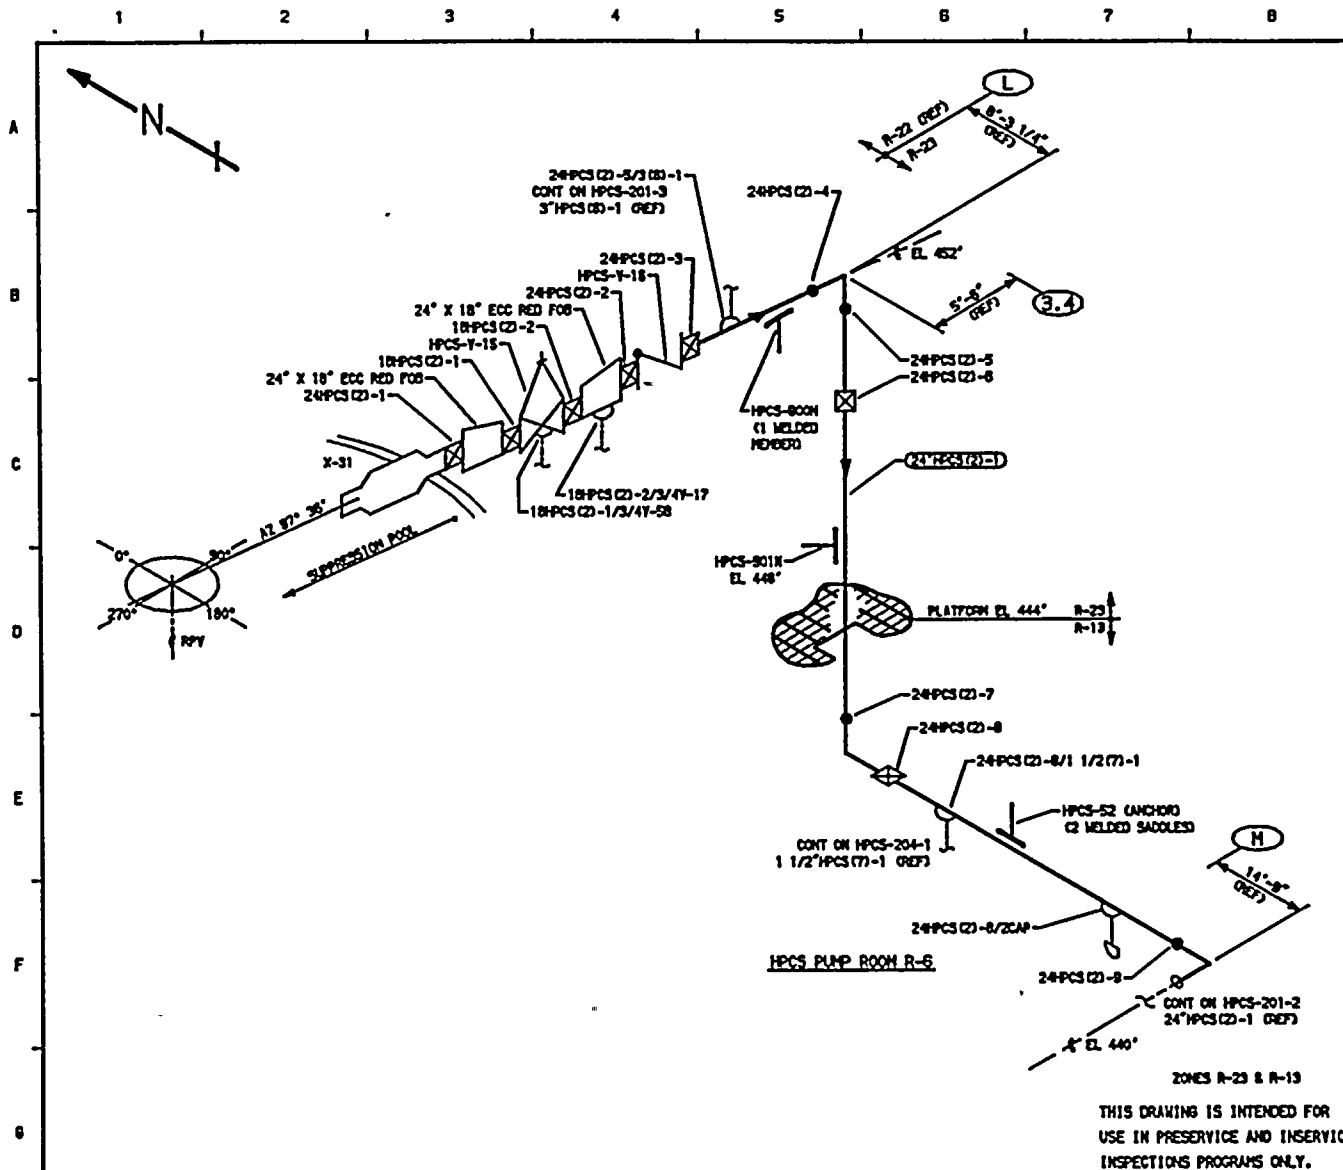

REFERENCES:  
 ISI - 220-1  
 BOYCE & ORAIL ISOMETRIC  
 HPCS-829-1.4 REV 9

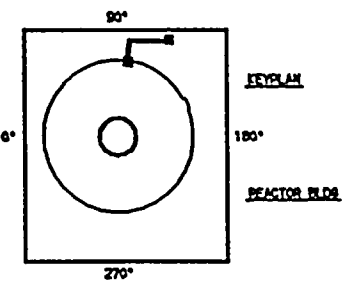

QUALITY CLASS, 1	ASME CODE CLASS, 2
ENGR: SA KUGLER	DRAWN: K-HCA DATE: 8-4-78


WASHINGTON PUBLIC POWER  
 SUPPLY SYSTEM  
 RICHLAND, WASHINGTON 99352

THIS DRAWING IS INTENDED FOR  
 USE IN PRESERVICE AND INSERVICE  
 INSPECTIONS PROGRAMS ONLY.


NO	DATE	REVISION	BY	CHKD	APVD	PIPING SYSTEM	NOM DIA (IN)	SCH	NOM WALL THK	MATERIAL SPECIFICATION	MATL TYPE	CAL BLOCK NO
3	12-4-83	ADDED UT-50, UT-20, LOGO & DWS LINE CONT IN F-6.	K-HCA	DPR	TFH	24\"/>						

WPP-2 WELD & COMPONENT IDENTIFICATION DIAGRAM	
TITLE: HPCS PUMP SUPPRESSION POOL SUCTION LINE	
DWG NO: HPCS-201-1	REV 3



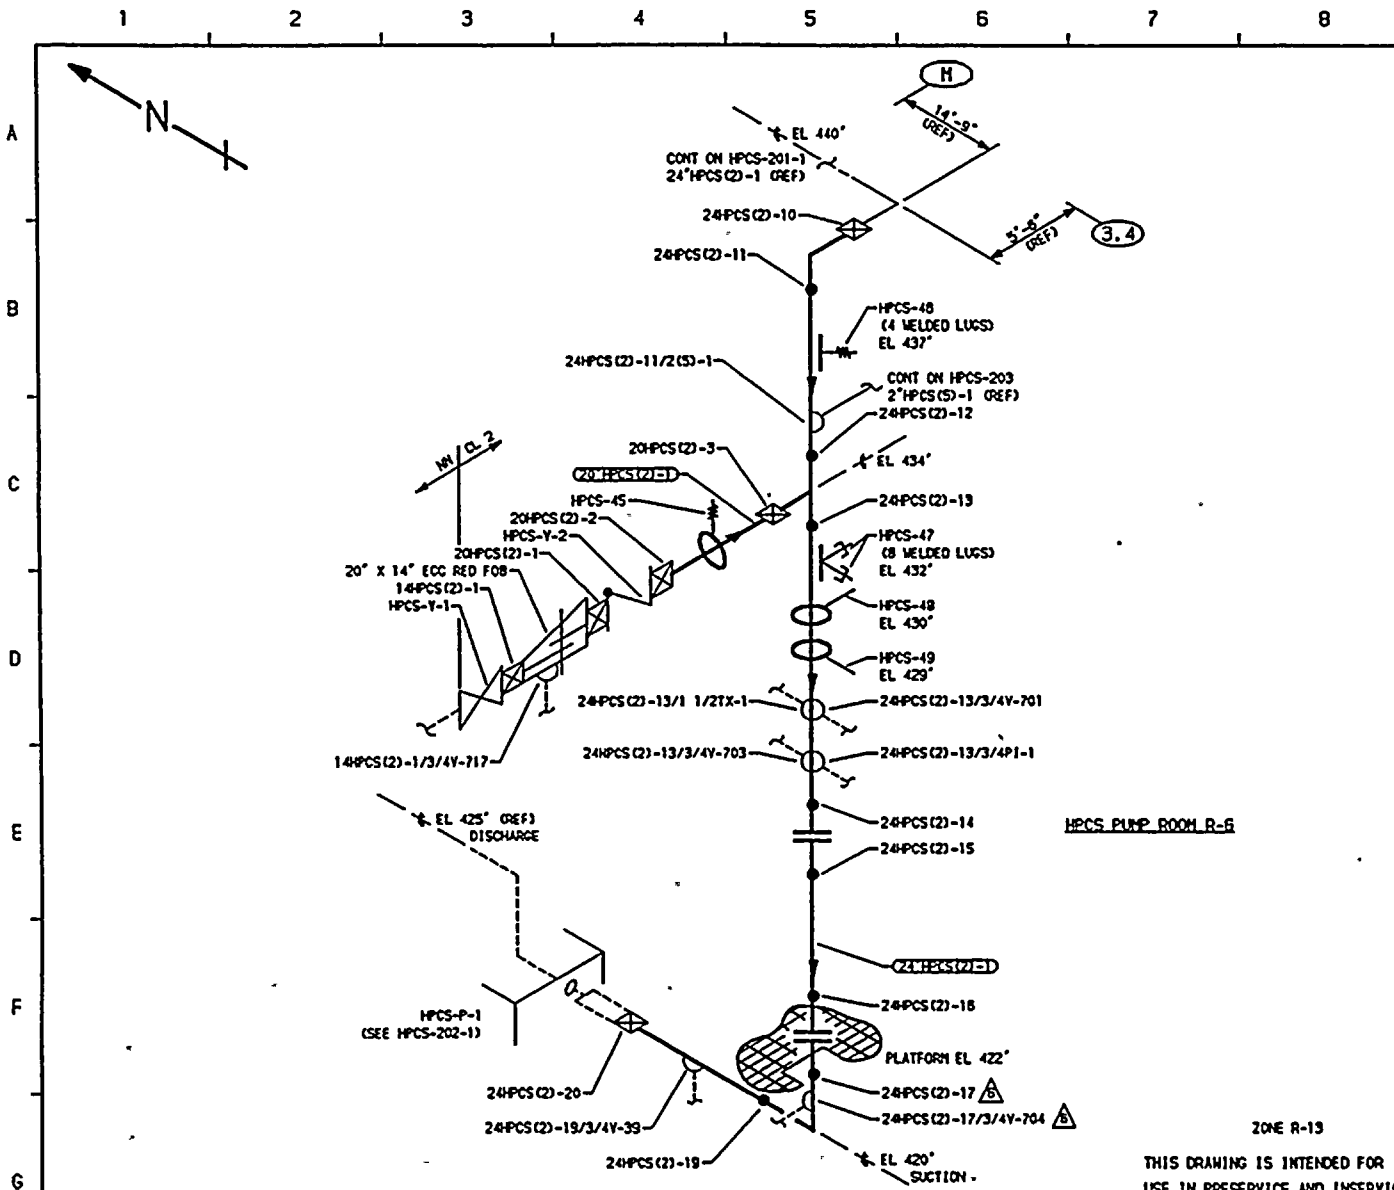

REFERENCES:  
 151 - 220-1  
 BOYEE & CRAIL ISOMETRIC  
 HPCS-629-5.7 REV 12

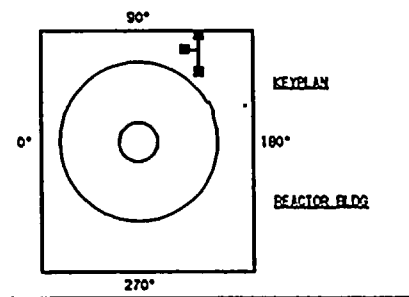

QUALITY CLASS, 1 ASME CODE CLASS, 2  
 ENGR, GA KUHLER DRAIN, K-McA DATE, 8-9-78



WASHINGTON PUBLIC POWER  
 SUPPLY SYSTEM  
 RICHLAND, WASHINGTON 99352

ZONE R-13  
 THIS DRAWING IS INTENDED FOR  
 USE IN PRESERVICE AND INSERVICE  
 INSPECTIONS PROGRAMS ONLY.


WPP-2  
 WELD & COMPONENT  
 IDENTIFICATION DIAGRAM  
 TITLE:  
 HPCS PUMP SUPPRESSION POOL SUCTION LINE

DWG NO. HPCS-201-2 REV 6


NO	DATE	REVISION	BY	CHKD	APVD	PIPING SYSTEM	NOM DIA (IN)	SCH	NOM WALL THK	MATERIAL SPECIFICATION	MATL TYPE	CAL BLOCK NO
6	9-22-94	CORRECTION BETWEEN ELBOW AND FLANGE IN F-5.	K-McA	DPR	DW							
5	6-7-94	CORRECTED CONTINUATION & LINE REFERENCE IN C-8. REMOVED HPCS-ST-1 FOR BCC 83-0052-04 IN E-8.	K-McA	DPR	DW	24" HPCS (2)-1	24	STD	0.375	SA 106 GR B	CS	UT-50
4	9-18-93	ADDED 2" CONN FOR P-3 SUCTION IN C-5 & 3/4" CONN IN D-3	K-McA	DPR	DRW	20" HPCS (2)-1	20	STD	0.375	SA 106 GR B	CS	UT-45
3	12-4-89	ADDED UT-50, UT-45, UT-38 AND LOGO. MOD KEYPLAN.	K-McA	DPR	TFH	14" HPCS (2)-1	14	STD	0.375	SA 106 GR B	CS	UT-38
2	4-24-85	REVISED FOR 151	K-McA	DPR	TFH							
NO	DATE	REVISION	BY	CHKD	APVD							



1 2 3 4 5 6 7 8 9 10

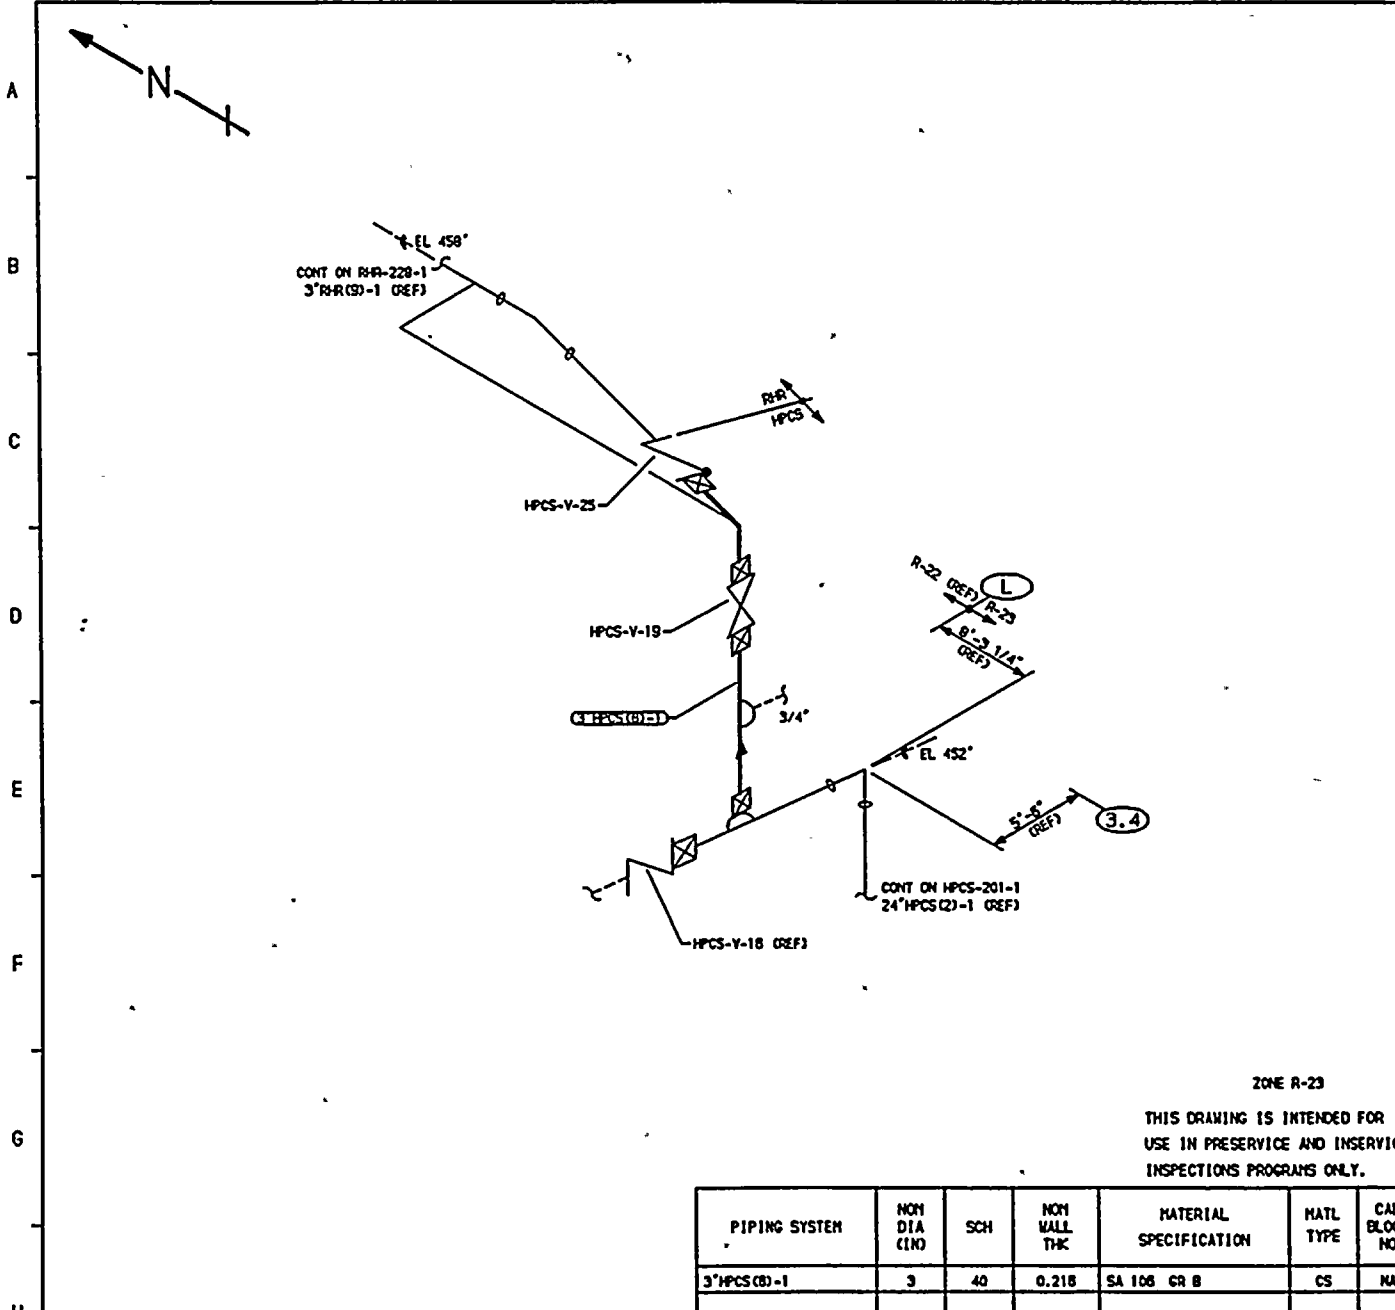

REFERENCES:  
 ISI - 220-1  
 BOYCE & CRAIL ISOMETRIC  
 HPCS-829-1.4 REV 9

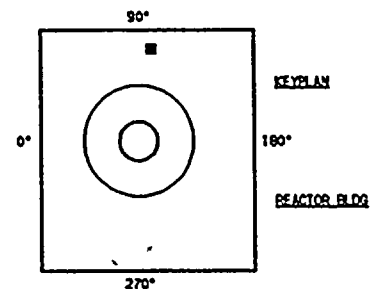

QUALITY CLASS, 1 ASME CODE CLASS, 2  
 ENGR, K-McANDREW DRAWN, K-McA DATE, 8-3-85


WASHINGTON PUBLIC POWER  
 SUPPLY SYSTEM  
 RICHLAND, WASHINGTON 99352

WPP-2  
 WELD & COMPONENT  
 IDENTIFICATION DIAGRAM  
 TITLE:  
 HPCS PUMP SUPPRESSION POOL SUCTION LINE  
 FLUSHING OUT CONNECTION  
 DWG NO. HPCS-201-3 REV 1


ZONE R-23  
 THIS DRAWING IS INTENDED FOR  
 USE IN PRESERVICE AND INSERVICE  
 INSPECTIONS PROGRAMS ONLY.

PIPING SYSTEM	NON DIA (IN)	SCH	NON WALL THK	MATERIAL SPECIFICATION	MATL TYPE	CAL BLOCK NO.
3"HPCS(2)-1	3	40	0.218	SA 106 GR B	CS	NA

NO	DATE	REVISION	BY	CHKD	APVD
1	11-13-92	ADDED LOGO, EL 458" MOD ISI DWG REF & KEYPLAN	K-McA	DPR	DRV
0	1-23-85	ISSUED FOR USE	K-McA	DPR	TFH

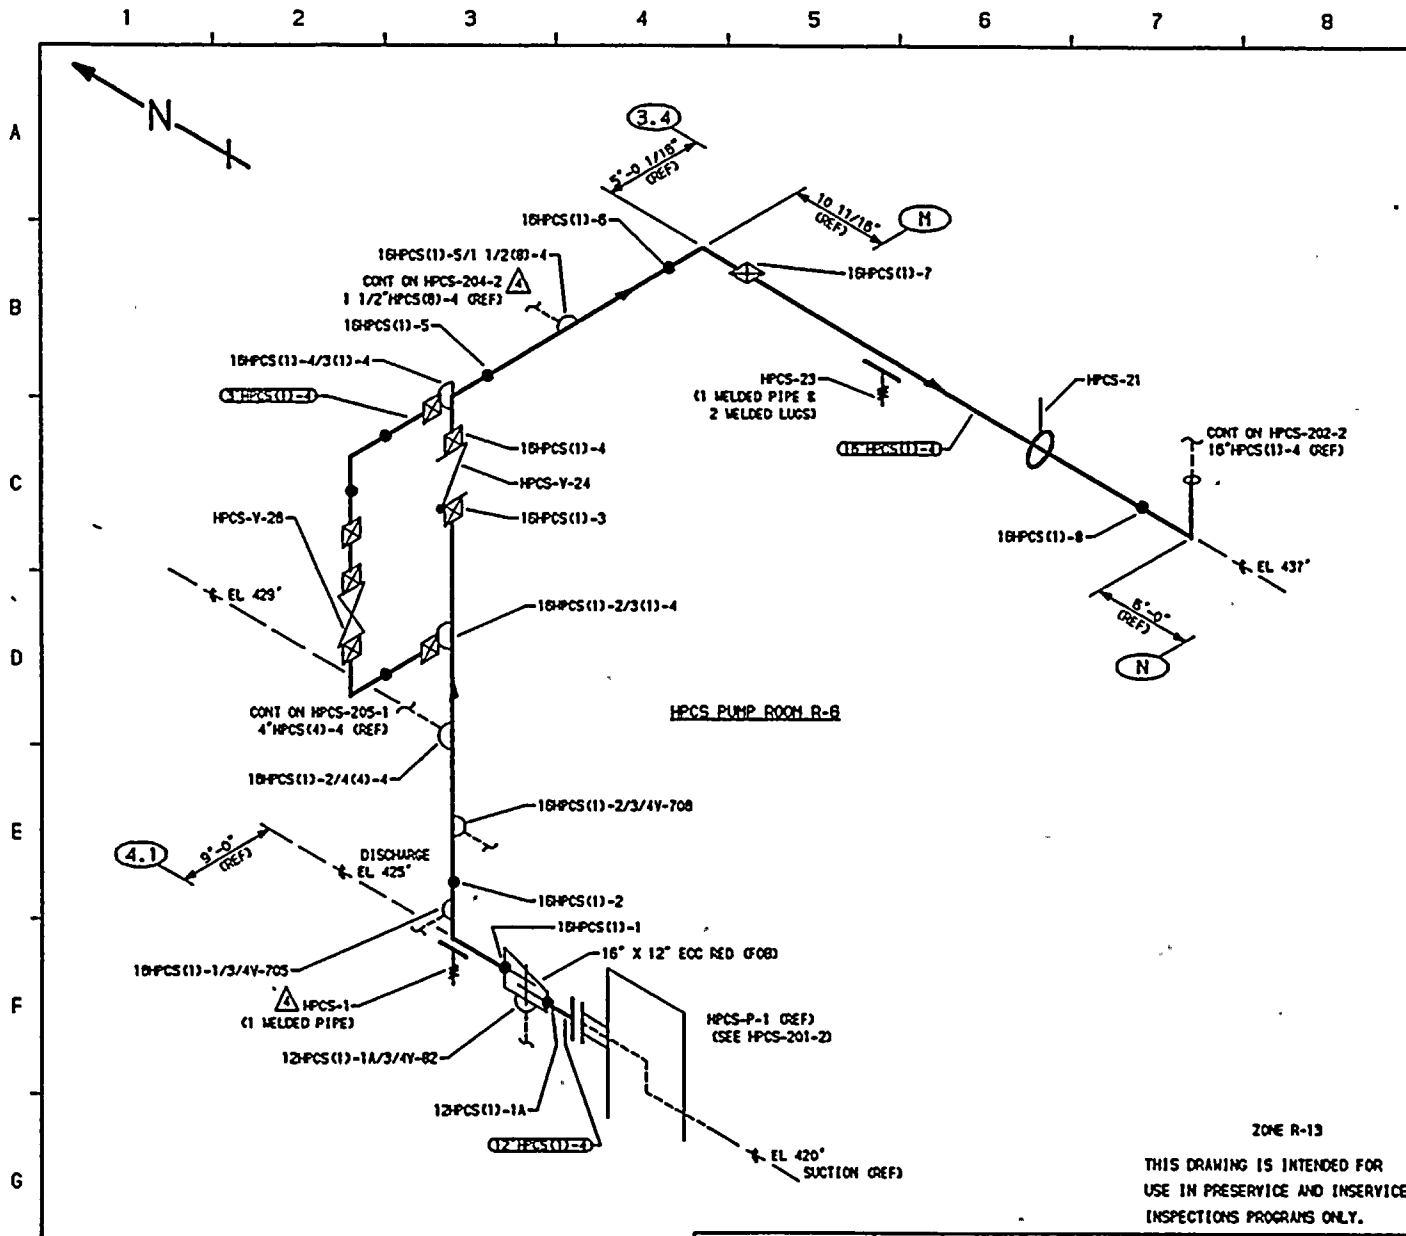

REFERENCES:  
 ISI - 220-2  
 BOYEE & CRAIL ISOMETRICS  
 HPCS-830-1.4 REV 15  
 HPCS-830-7.10 REV 10

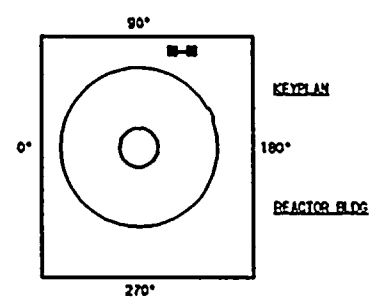


QUALITY CLASS, 1	ASME CODE CLASS, 2
ENGR, GA KUGLER	DRAWN, K-McA DATE, 8-9-78

WASHINGTON PUBLIC POWER  
 SUPPLY SYSTEM  
 RICHMOND, WASHINGTON 99352

MP-2 WELD & COMPONENT IDENTIFICATION DIAGRAM
TITLE: HPCS-PUMP-1 DISCHARGE
DWG NO. HPCS-202-1
REV 4

ZONE R-13  
 THIS DRAWING IS INTENDED FOR  
 USE IN PRESERVICE AND INSERVICE  
 INSPECTIONS PROGRAMS ONLY.

NO	DATE	REVISION	BY	CHKD	APVD	PIPING SYSTEM	NOM DIA (IN)	SCH	NOM WALL THK	MATERIAL SPECIFICATION	MATL TYPE	CAL BLOCK NO
4	6-7-94	CORRECTED HANGER TEXT IN F-2 & AS NOTED.	K-McA	DPR	DW							
3	11-13-92	CORRECTED CONT IN B-2 ADDED LOGO MOD KEYPLAN	K-McA	DPR	DRV							
2	1-23-86	ADD 3\"/>	K-McA	DPR	TFH	18\"/>	18	100	1.031	SA 106 GR B	CS	UT-49
1	5-24-83	NUMBERED WELD, ADDED NO-4, DELETED HPCS-18 & 14 ADDED HPCS-803, RELICATED HPCS-19 (RETRAW)	K-McA	DPR	TFH	12\"/>	12	100	0.844	SA 106 GR B	CS	UT-16
0	12-22-78	ISSUED FOR USE	K-McA	TFH	LFB	3\"/>	3	180	0.438	SA 106 GR B	CS	NA
A	10-3-78	ISSUED FOR INFORMATION ONLY	K-McA	GAK	DMP							
NO	DATE	REVISION	BY	CHKD	APVD							

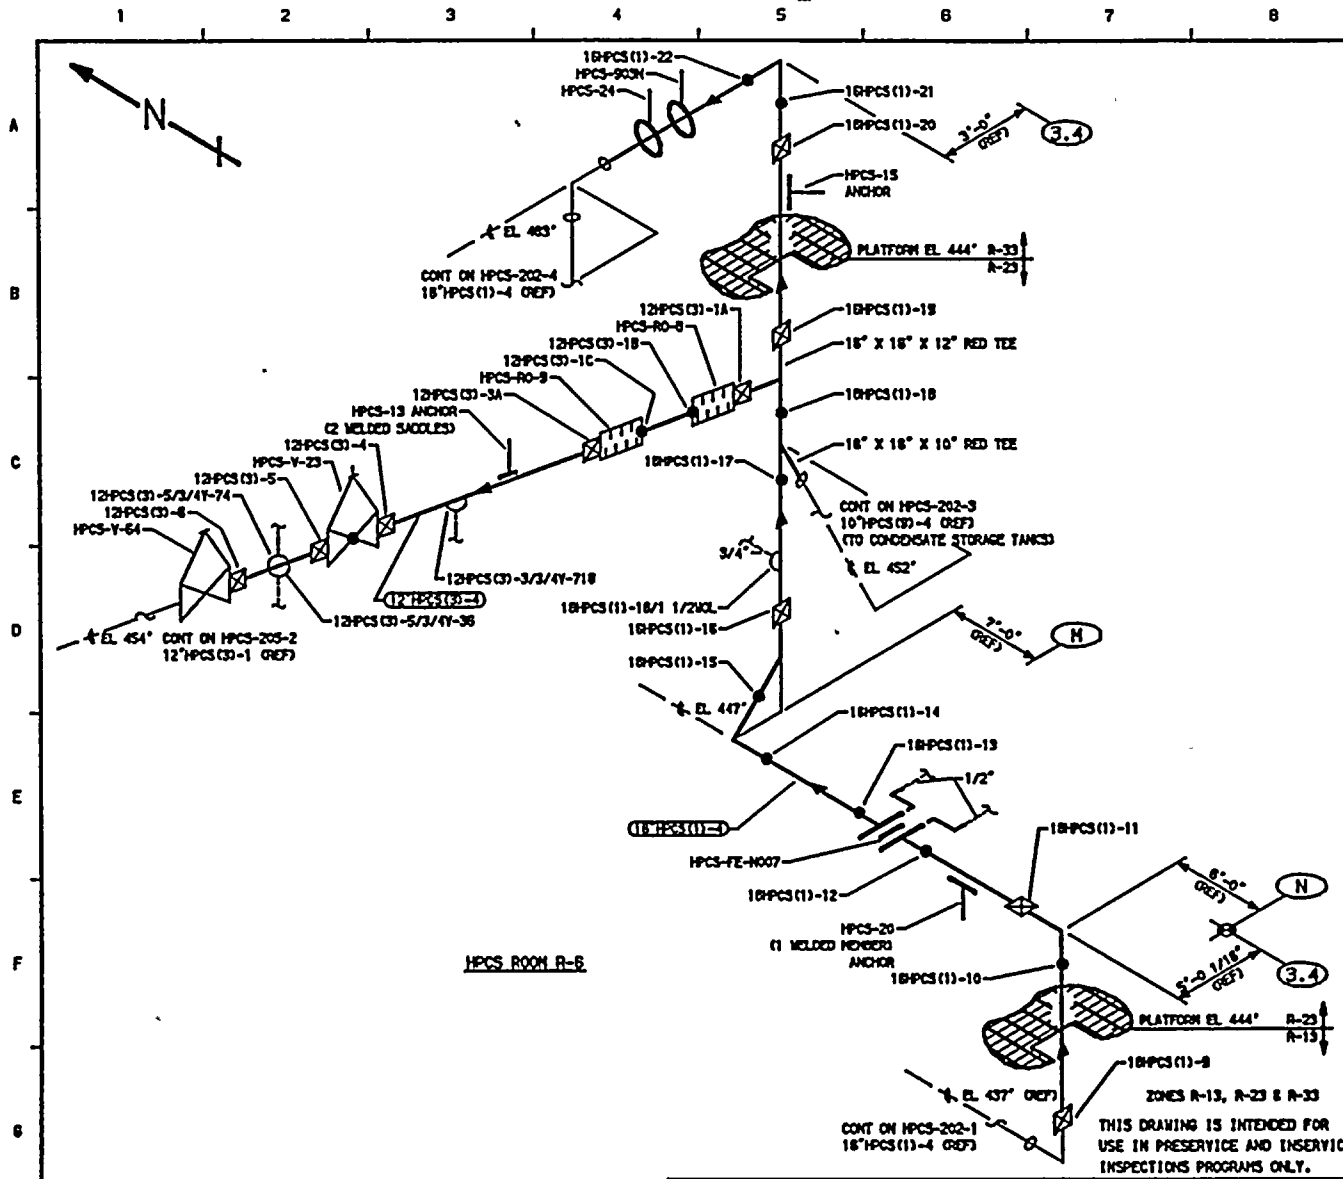


**NOTES**

1. HPCS-RO-8 & HPCS-RO-9 REPLACED HPCS-RO-4 PER DOC 69-0210-0A. SEE SEC XI REPAIR PLAN 2-4731.

**REFERENCES:**

ISI - 220-1  
 BOYCE & GRILL ISOMETRICS  
 HPCS-630-7.10 REV 9  
 HPCS-630-11.12 REV 11  
 HPCS-630-13.18 REV 8  
 HPCS-632-1.3 REV 14

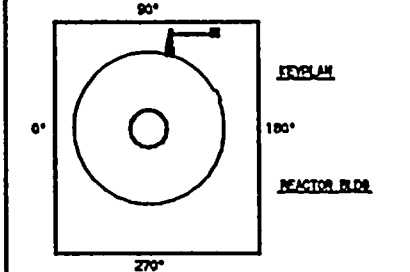

QUALITY CLASS, 1 ASME CODE CLASS, 2  
 ENGR, CA KUGLER DRAWN, K-McA DATE, 9-10-78


WASHINGTON PUBLIC POWER  
 SUPPLY SYSTEM  
 RICHLAND, WASHINGTON 99352

WPP-2  
 WELD & COMPONENT  
 IDENTIFICATION DIAGRAM


TITLE:  
 HPCS-PUMP-1 DISCHARGE

DWG NO: HPCS-202-2 REV 4

NO	DATE	REVISION	BY	CHKD	APVD	PIPING SYSTEM	NOM DIA (IN)	SCH	NOM WALL THK	MATERIAL SPECIFICATION	MATL TYPE	CAL BLOCK NO
4	11-13-82	ADDED NOTE 1. MODIFIED ACCORDINGLY.	K-McA	DPR	DRM							
3	12-4-83	ADDED UT-43, UT-16 AND LOGS. MODIFIED KEYPLAN	K-McA	DPR	TFH							
2	4-24-85	REVISED FOR ISI	K-McA	DPR	TFH	18\"/>						
1	5-24-83	REMOVED WELDS, ADDED RO-4, DELETED HPCS-12 & 14 ADDED HPCS-803M, RELOCATED HPCS-15 (OVERHEAD)	K-McA	DPR	TFH	12\"/>						
0	12-22-78	ISSUED FOR USE	K-McA	TFH	LFB							
A	10-3-78	ISSUED FOR INFORMATION ONLY	K-McA	GAK	DMP							

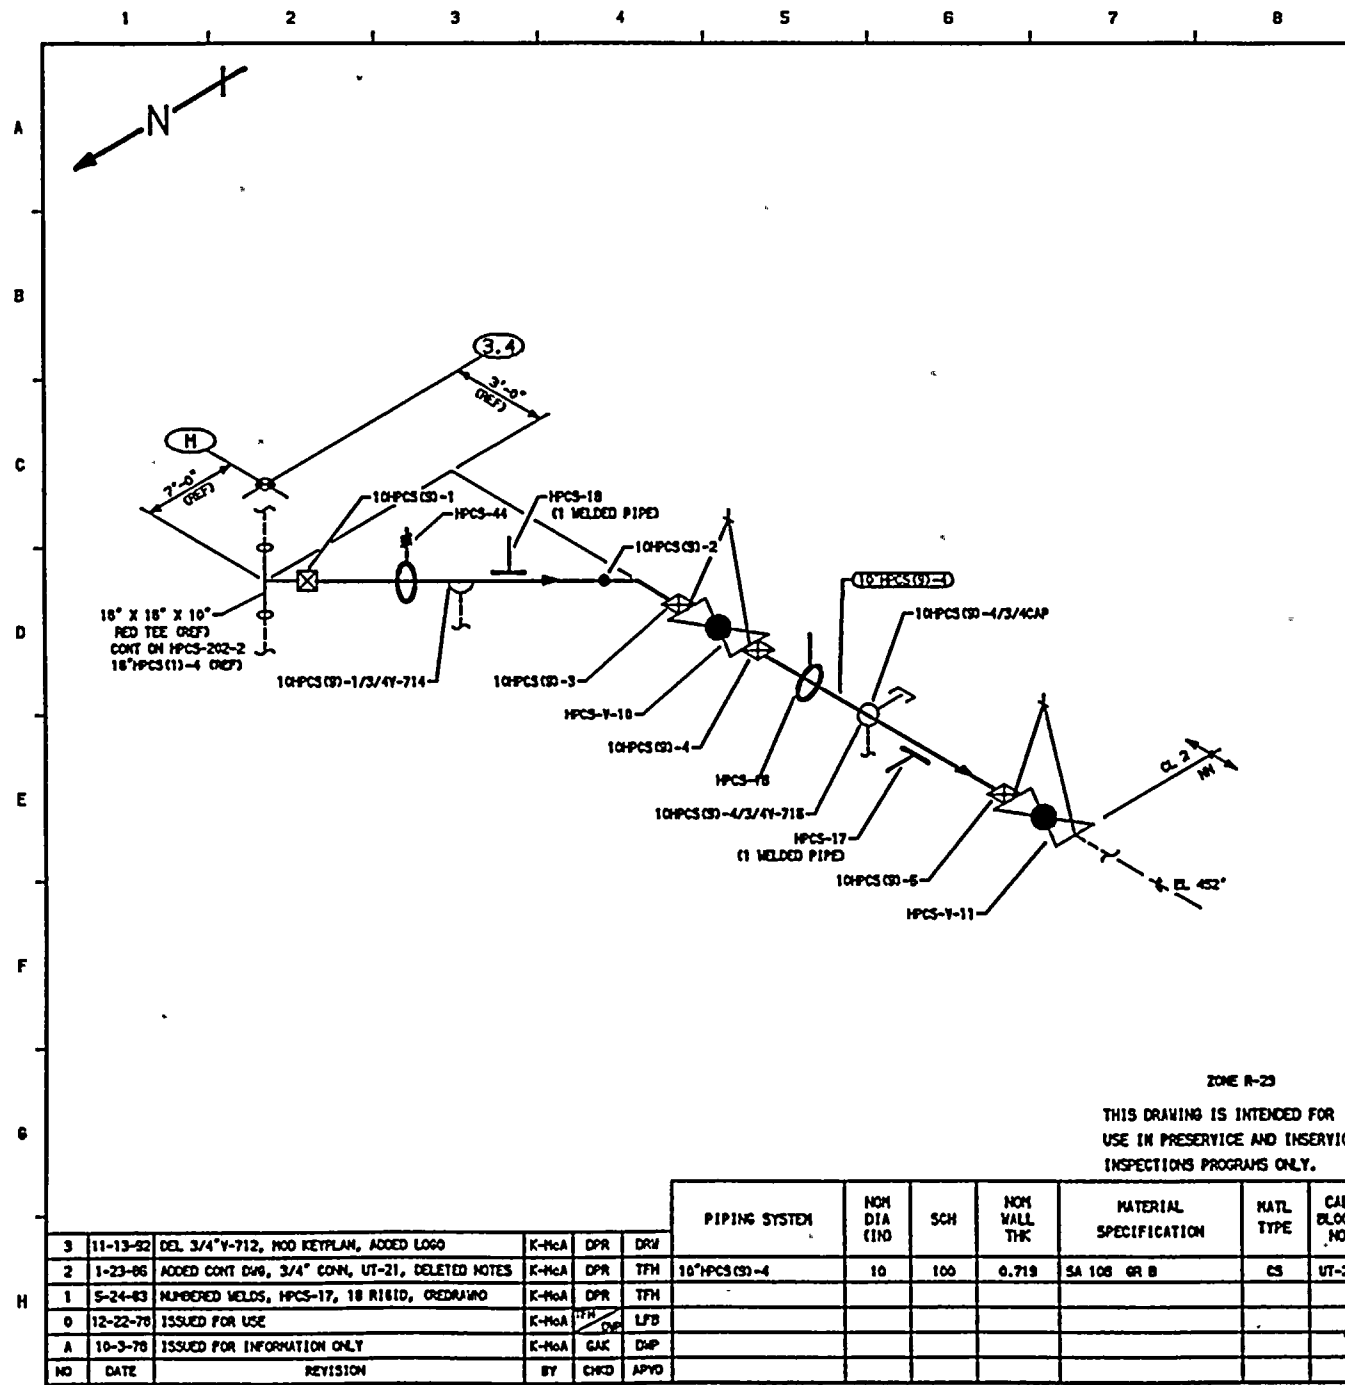

REFERENCE:  
 151 - 220-1  
 BOYCE & GRILL ISOMETRIC  
 HPCS-833-1.2 REV 13

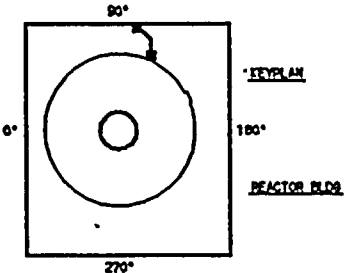

QUALITY CLASS, 1	ASME CODE CLASS, 2
ENGR: GA KUGLER	DRAWN: K-McA DATE: 6-11-78

WASHINGTON PUBLIC POWER  
 SUPPLY SYSTEM  
 RICHLAND, WASHINGTON 99352

ZONE R-23  
 THIS DRAWING IS INTENDED FOR  
 USE IN PRESERVICE AND INSERVICE  
 INSPECTIONS PROGRAMS ONLY.

NO	DATE	REVISION	BY	CHKD	APVD	PIPING SYSTEM	NOM DIA (INO)	SCH	NOM WALL THK	MATERIAL SPECIFICATION	MATL TYPE	CAL BLOCK NO
3	11-13-82	DEL 3/4"Y-712, MOD KEYPLAN, ADDED LOGO	K-McA	DPR	DRM							
2	1-23-86	ADDED CONT DWG, 3/4" CONN, UT-21, DELETED NOTES	K-McA	DPR	TFH	10" HPCS (C)-4	10	100	0.719	SA 108 GR B	CS	UT-21
1	5-24-83	NUMBERED WELDS, HPCS-17, 18 RIGID, REDRAWN	K-McA	DPR	TFH							
0	12-22-78	ISSUED FOR USE	K-McA	TFH	LFB							
A	10-3-78	ISSUED FOR INFORMATION ONLY	K-McA	GAK	DMP							
NO	DATE	REVISION	BY	CHKD	APVD							


WPP-2  
 WELD & COMPONENT  
 IDENTIFICATION DIAGRAM

TITLE:  
 HPCS SUPPLY TO COND STORAGE TANKS


DWG NO. HPCS-202-3

REV 3



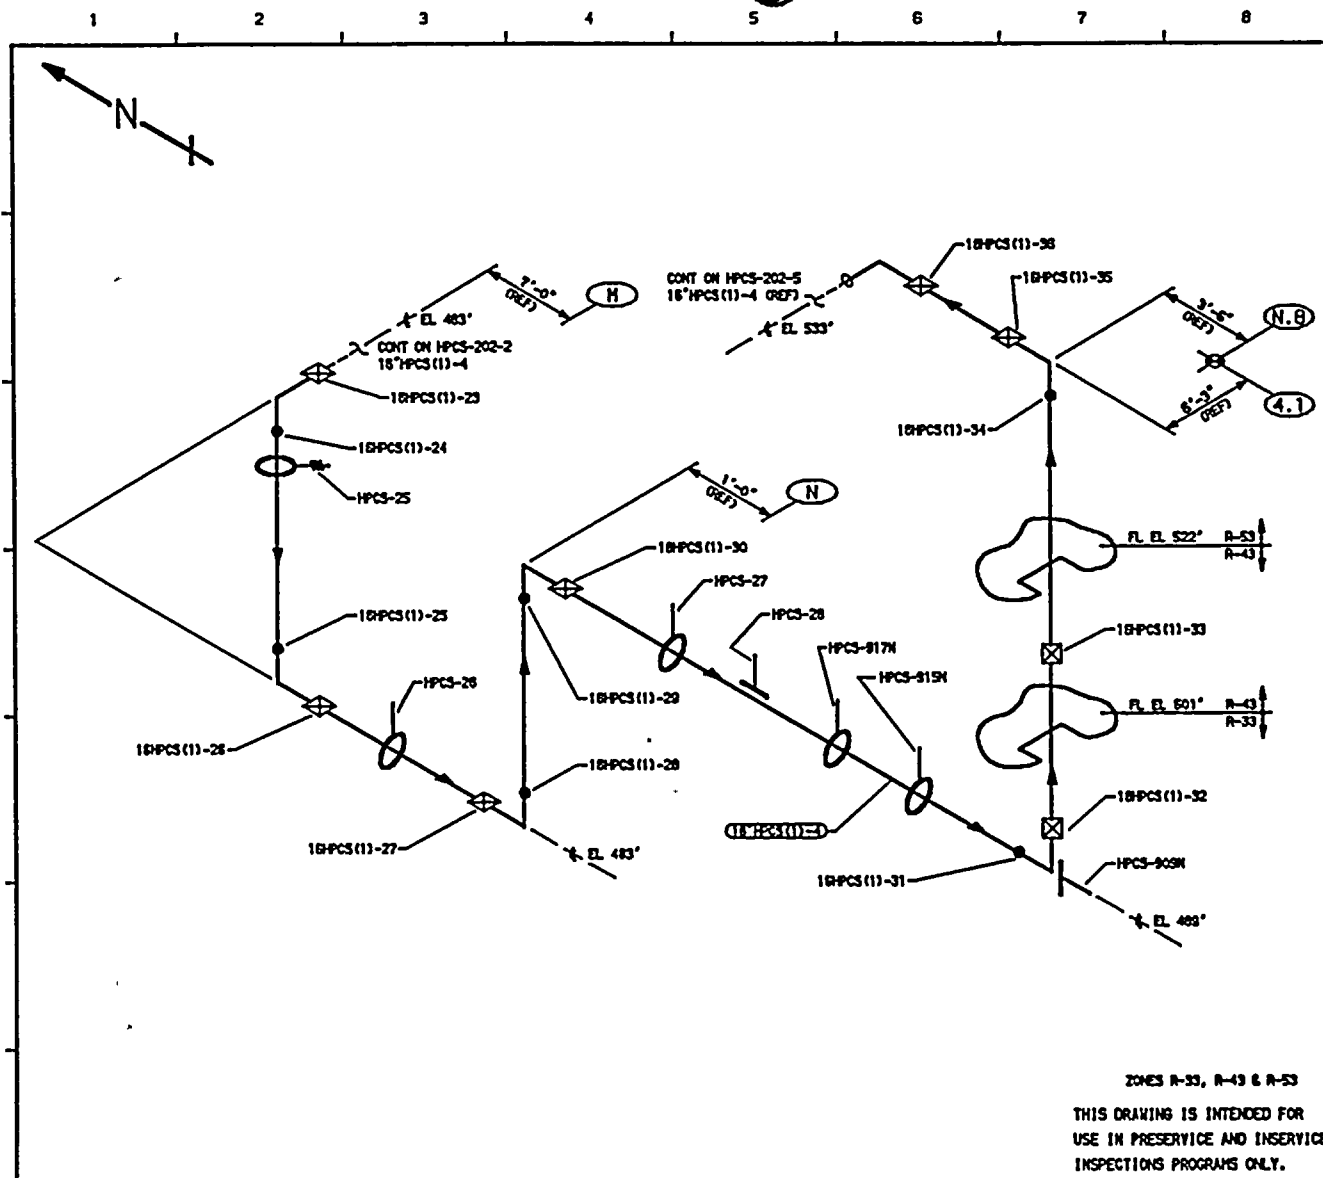


151 - 220-1  
 BOYCE & ORALL ISOMETRIC  
 HPCS-630-15.19 REV B

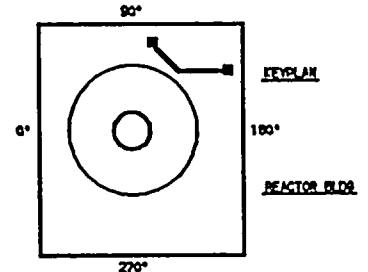


ZONES R-33, R-43 & R-53  
 THIS DRAWING IS INTENDED FOR  
 USE IN PRESERVICE AND INSERVICE  
 INSPECTIONS PROGRAMS ONLY.


NO	DATE	REVISION	BY	CHKD	APVD
3	11-13-92	MODIFIED KEYPLAN ADDED LOGO	K-McA	DPR	DRV
2	1-23-86	WELDS 30 & 36 ARE FIELD WELDS. HPCS-28 IS RIGID. CHANGED CAL BLOCK NO. TO UT-49. DELETED NOTES.	K-McA	DPR	TFH
1	5-24-83	REWORKED WELDS, ADDED HPCS-917N, 915, 905N, DELETED HPCS-29, 30 ADDED UT-15. ADDED NOTE 3. (REWORK)	K-McA	DPR	TFH
0	12-22-78	ISSUED FOR USE	K-McA	TFH	LFB
A	10-3-78	ISSUED FOR INFORMATION ONLY	K-McA	GAK	DMP

PIPING SYSTEM	NOM DIA (IN)	SCH	NOM WALL THK	MATERIAL SPECIFICATION	MATL TYPE	CAL BLOCK NO
18"HPCS(11)-4	18	100	1.031	SA 106 GR B	CS	UT-49

QUALITY CLASS, 1	ASME CODE CLASS, 2
ENGR. GA KUEHLER	DATE, 8-11-78
 WASHINGTON PUBLIC POWER SUPPLY SYSTEM RICHLAND, WASHINGTON 99352	
WPP-2 WELD & COMPONENT IDENTIFICATION DIAGRAM	
TITLE: HPCS-PUMP-1 DISCHARGE	
DWG NO. HPCS-202-4	REV 3

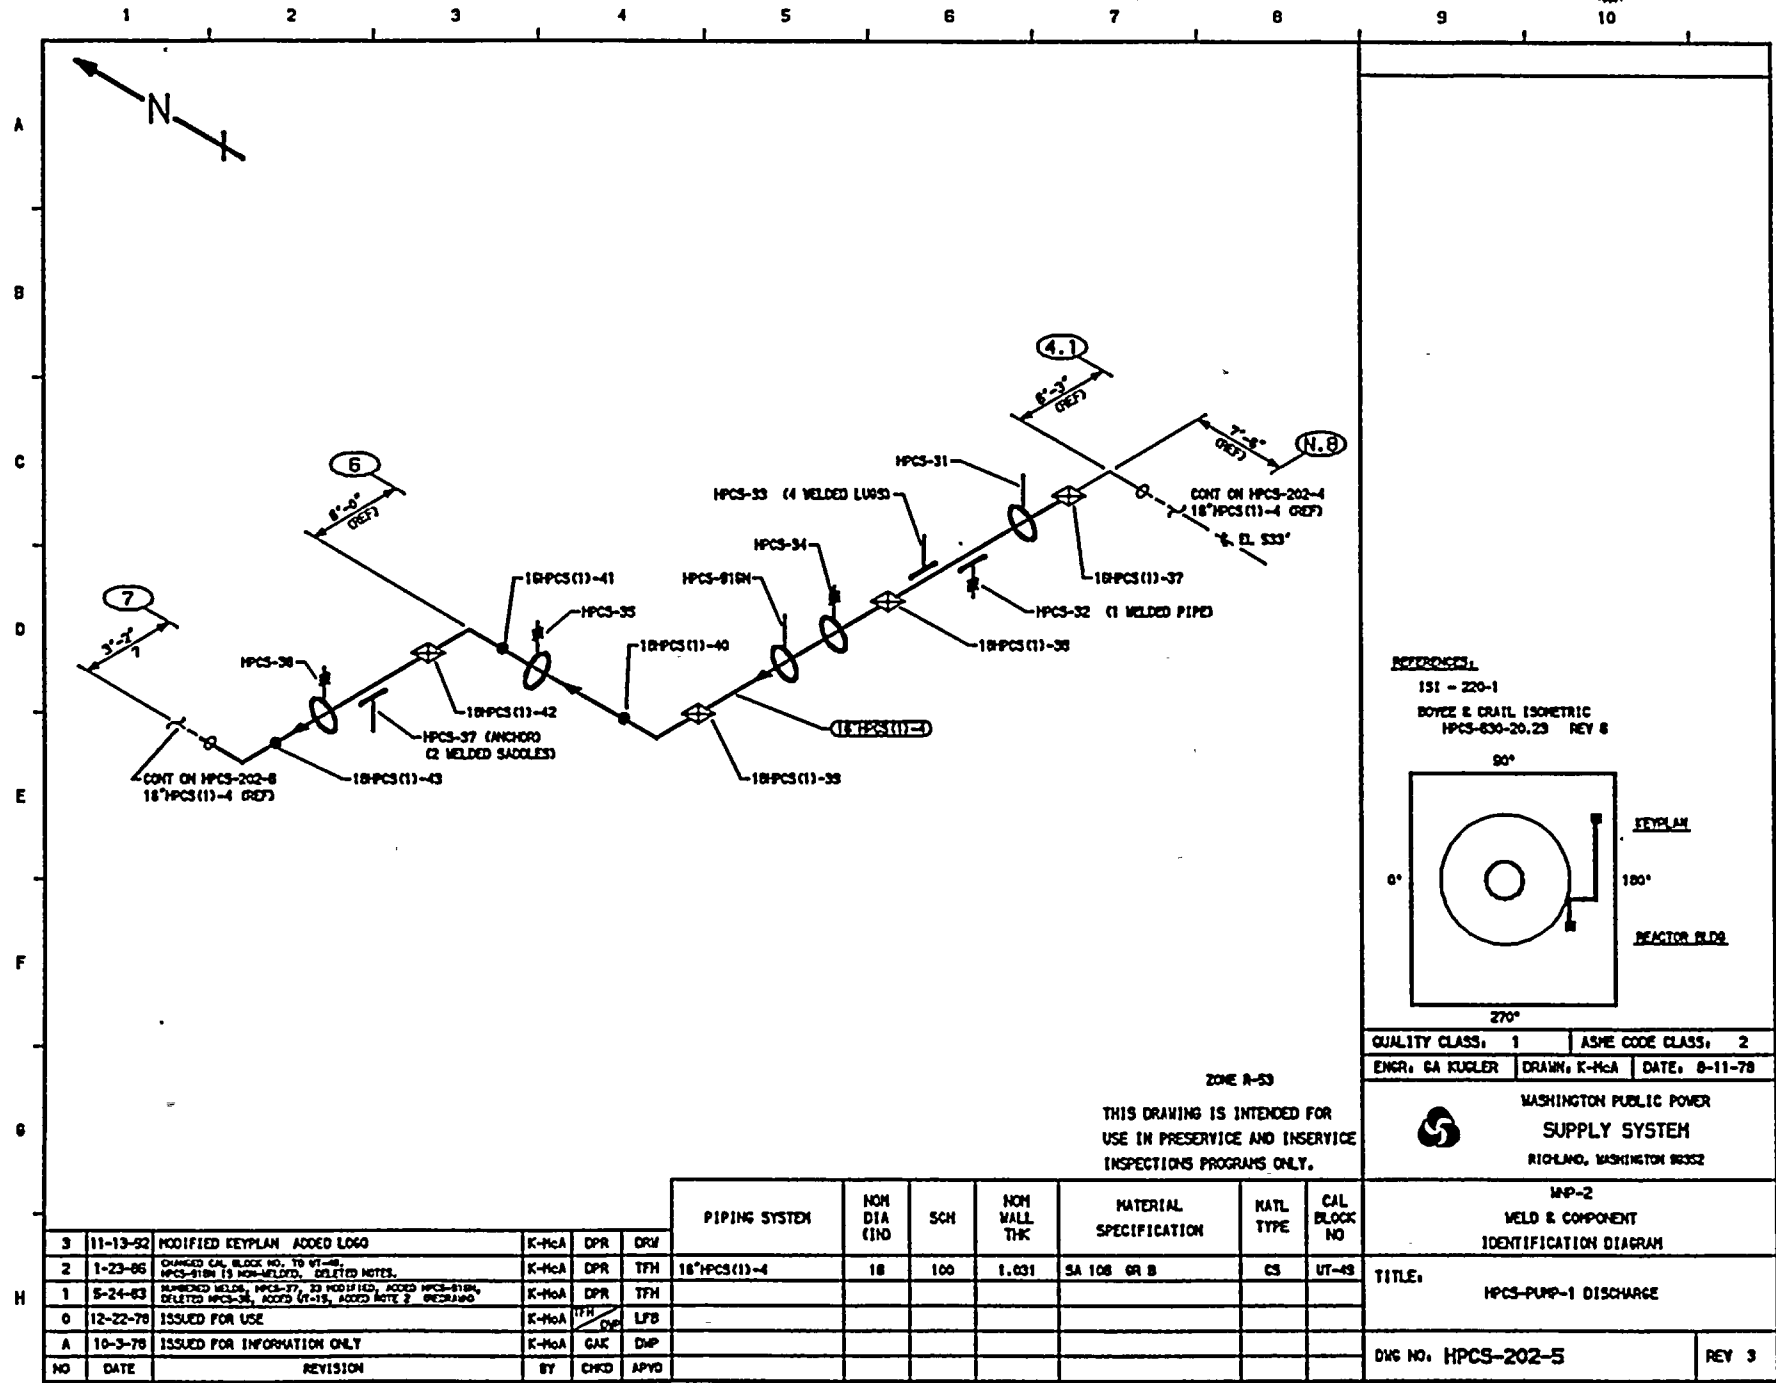


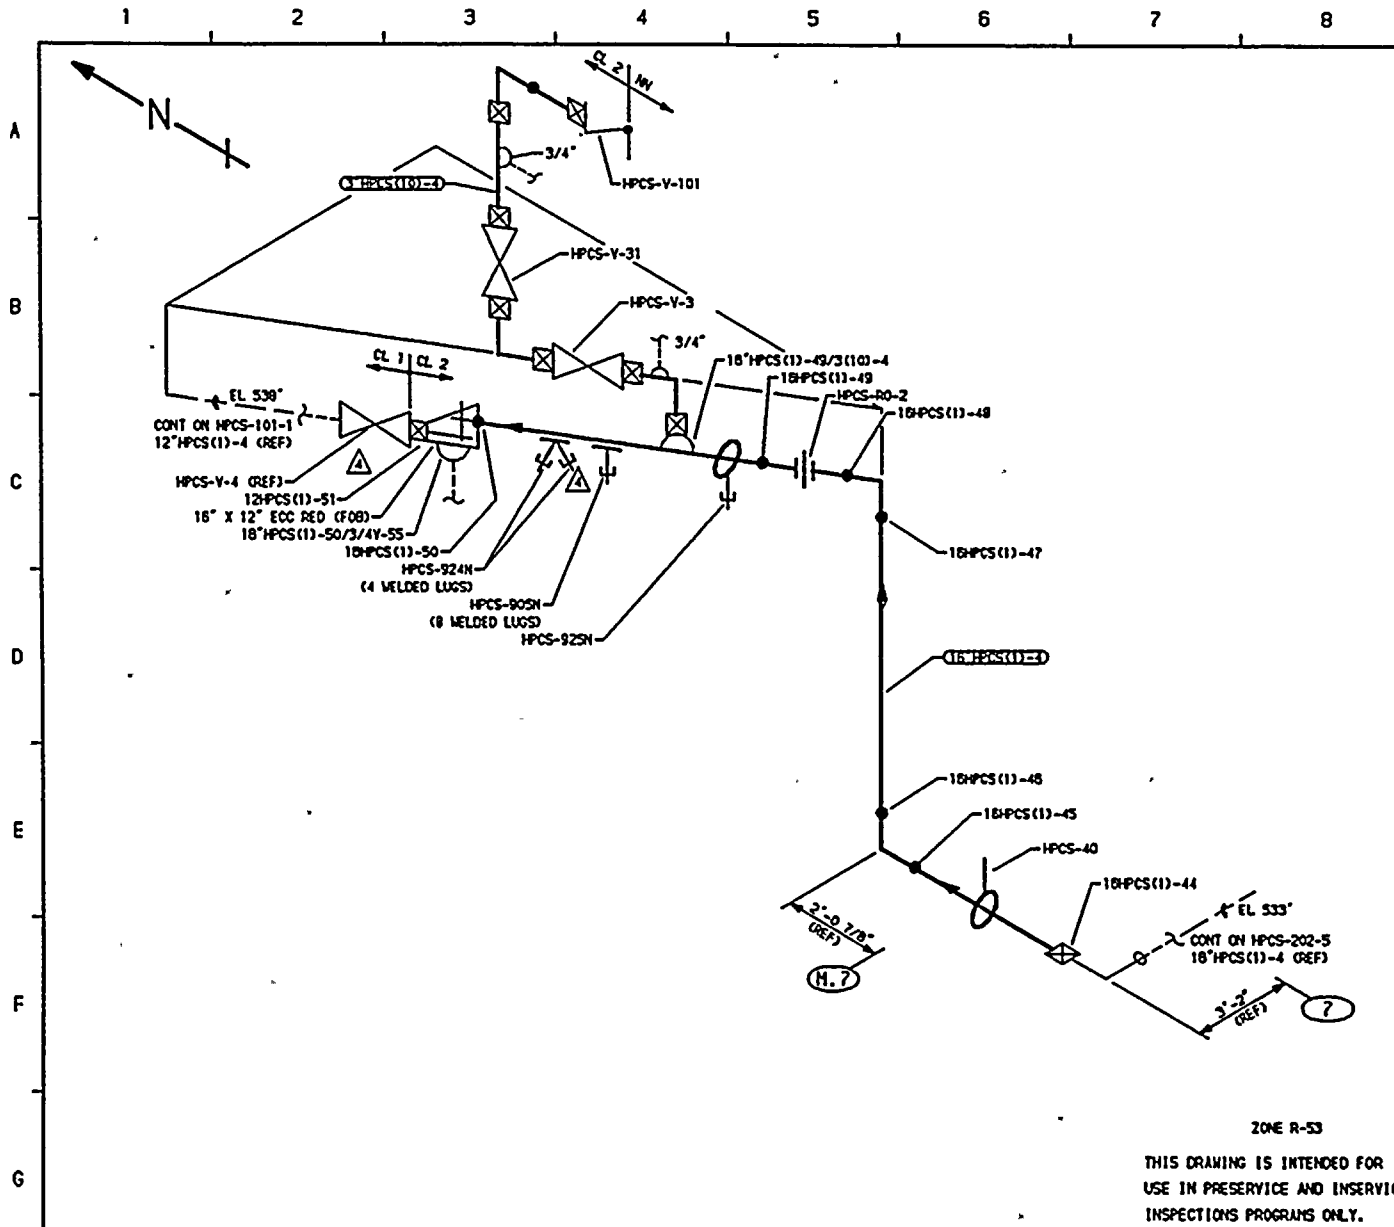
REFERENCES  
 ISI - 220-1  
 BOYCE & GRILL ISOMETRIC  
 HPCS-630-20.23 REV 6

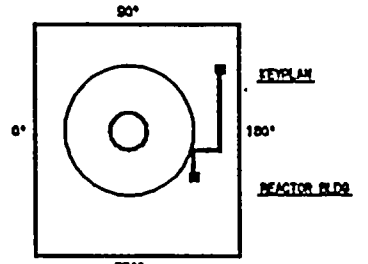

ZONE R-53  
 THIS DRAWING IS INTENDED FOR  
 USE IN PRESERVICE AND INSERVICE  
 INSPECTIONS PROGRAMS ONLY.

NO	DATE	REVISION	BY	CHKD	APVD	PIPING SYSTEM	NOM DIA (IND)	SCH	NOM WALL THK	MATERIAL SPECIFICATION	MATL TYPE	CAL BLOCK NO
3	11-13-92	MODIFIED KEYPLAN ADDED LOGO	K-McA	DPR	DRW							
2	1-23-86	CHANGED CAL BLOCK NO. TO 49-49, HPCS-818M IS NON-WELDED. DELETED NOTES.	K-McA	DPR	TFH	18" HPCS(1)-4	18	100	1.031	SA 106 GR B	CS	UT-49
1	5-24-83	NUMBERED WELDS, HPCS-37, 33 MODIFIED, ADDED HPCS-818M, DELETED HPCS-36, ACCORD (1)-15, ADDED NOTE 2 (REBRAND)	K-McA	DPR	TFH							
0	12-22-78	ISSUED FOR USE	K-McA	TFH	LFB							
A	10-3-78	ISSUED FOR INFORMATION ONLY	K-McA	GAK	DHP							
NO	DATE	REVISION	BY	CHKD	APVD							

QUALITY CLASS: 1	ASME CODE CLASS: 2
ENGR: GA KUGLER	DATE: 8-11-78
 WASHINGTON PUBLIC POWER SUPPLY SYSTEM RICHLAND, WASHINGTON 99352	
WPP-2 WELD & COMPONENT IDENTIFICATION DIAGRAM	
TITLE: HPCS-PUMP-1 DISCHARGE	
DWG NO: HPCS-202-5	REV 3




**NOTES.**

- PORTIONS OF THIS DRAWING IDENTIFY PIPING AND COMPONENTS SUBJECT ONLY TO A VISUAL EXAMINATION FOR EVIDENCE OF LEAKAGE DURING SYSTEM HYDRO OR OPERABILITY TESTS. TESTS ARE TO BE CONDUCTED PER THE REQUIREMENTS OF ASME SECTION XI, PARAGRAPH 11A-5000.

**REFERENCES.**

ISI - 220-1  
 BOYEE & GRILL ISOMETRIC  
 HPCS-830-24.25 REV 8

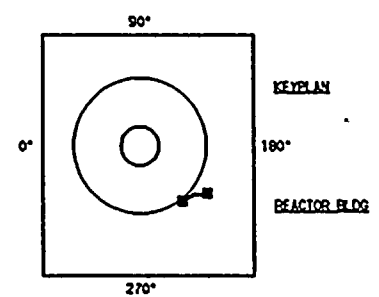

QUALITY CLASS, 1	ASME CODE CLASS, 2
ENGR, GA KUGLER	DATE, 8-11-78


WASHINGTON PUBLIC POWER  
**SUPPLY SYSTEM**  
 RICHLAND, WASHINGTON 99352

MP-2 WELD & COMPONENT IDENTIFICATION DIAGRAM
TITLE: HPCS-PUMP-1 DISCHARGE


NO	DATE	REVISION	BY	CHKD	APVD	PIPING SYSTEM	NOM DIA (IN)	SCH	NOM WALL THK	MATERIAL SPECIFICATION	MATL TYPE	CAL BLOCK NO
4	6-7-84	ADDED 3/4" CONNECTION FOR DCP 84-0183-0A 2H 4-4 MODIFIED WELD 12"HPCS(1)-51 & HANGER HPCS-924N 2H C-3	K-McA	DPR	DW							
3	10-18-87	CHG HPCS-40 TO R1810, ADDED LOGO & NOTE 1, MOD KEYPLAN.	K-McA	DPR	TFH							
2	1-23-86	ADDED 3"HPCS(10)-1, CHG CAL BLK TO UT-49, DEL NOTES.	K-McA	DPR	TFH	18"HPCS(1)-4	18	100	1.031	SA 106 GR B	CS	UT-49
1	5-24-83	REWORKED WELD, ADD HPCS-905N, UT-15, NOTE 3, DELETED HPCS-11, HPCS-38 ON DRAWING	K-McA	DPR	TFH	3"HPCS(10)-1	3	160	0.438	SA 106 GR B	CS	NA
0	12-22-78	ISSUED FOR USE	K-McA	TFH	LFB	12"HPCS(1)-4	12	100	0.844	SA 106 GR B	CS	UT-15
A	10-3-78	ISSUED FOR INFORMATION ONLY	K-McA	GAK	DMP							
NO	DATE	REVISION	BY	CHKD	APVD							

DWG NO. HPCS-202-8 REV 4



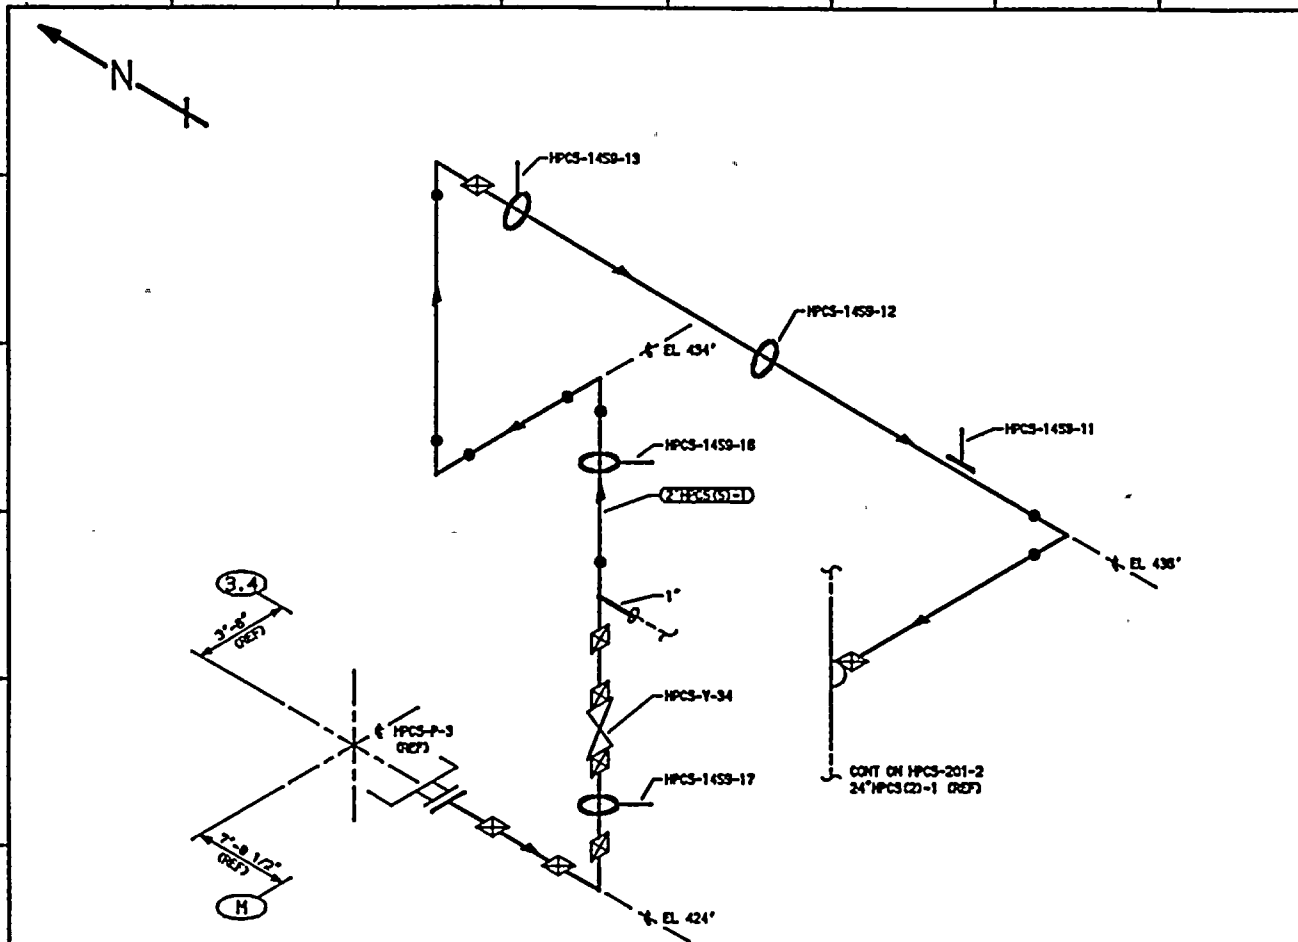

**REFERENCES:**  
 ISI - 220-1  
 BOYCE & GRILL ISOMETRICS  
 HPCS-1459-1 REV B

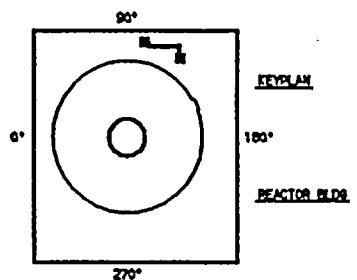


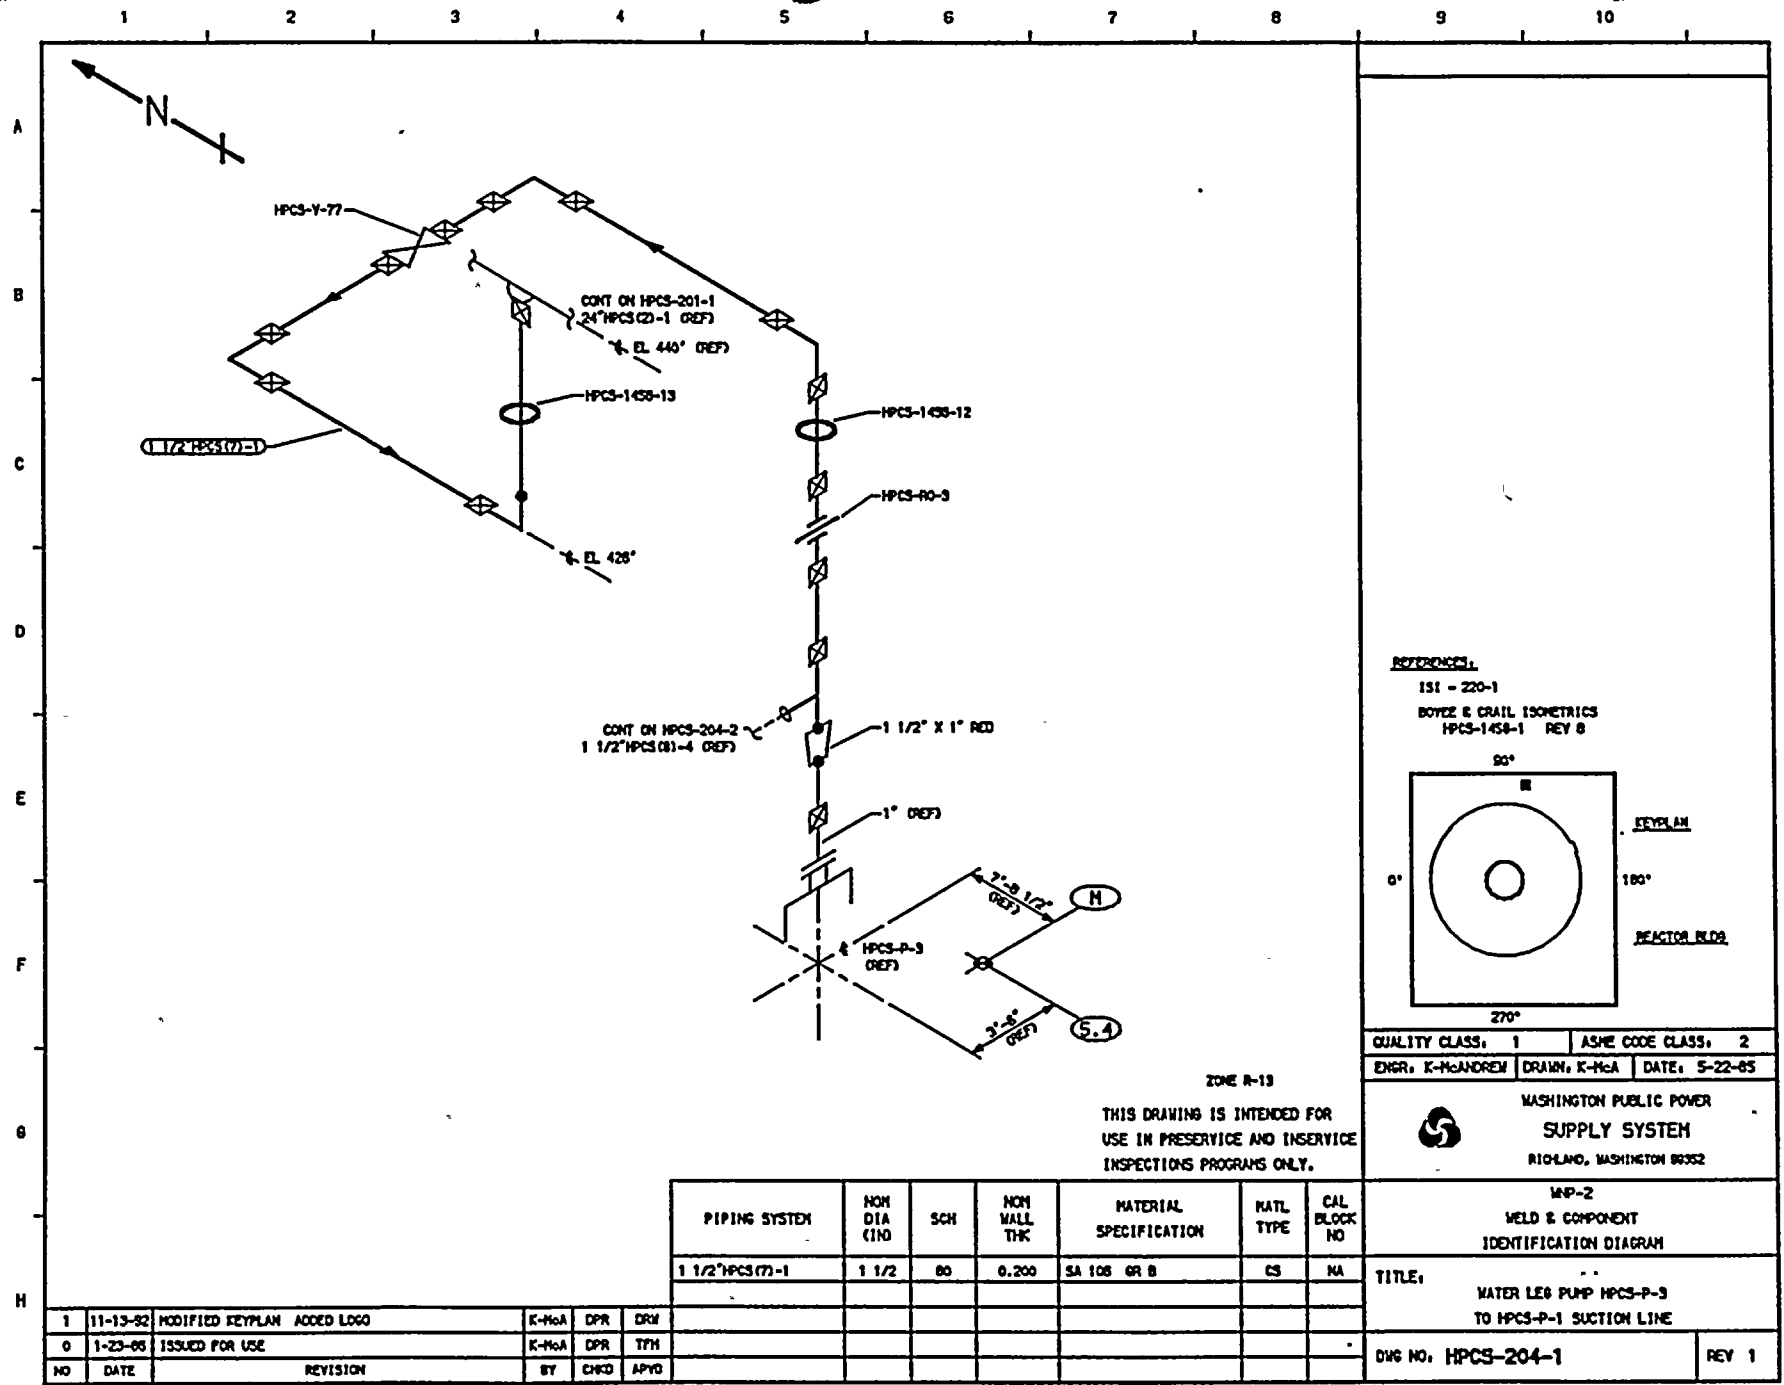
ZONE R-13

THIS DRAWING IS INTENDED FOR  
 USE IN PRESERVICE AND INSERVICE  
 INSPECTIONS PROGRAMS ONLY.

PIPING SYSTEM	NOM DIA (IN)	SCH	NOM WALL THK	MATERIAL SPECIFICATION	MATL TYPE	CAL BLOCK NO
2" HPCS(C)-1	2	80	0.218	SA 106 GR B	CS	NA


NO	DATE	REVISION	BY	CHKD	APVD
1	11-13-82	MODIFIED KEYPLAN ADDED LOGO	K-McA	DPR	DRW
0	1-23-85	ISSUED FOR USE	K-McA	DPR	TTH

QUALITY CLASS: 1	ASME CODE CLASS: 2	
ENGR: K-McANDREW	DRAWN: K-McA	DATE: 5-22-85
 <b>WASHINGTON PUBLIC POWER          SUPPLY SYSTEM</b> RICHLAND, WASHINGTON 99352		
<b>WP-2          WELD &amp; COMPONENT          IDENTIFICATION DIAGRAM</b>		
<b>TITLE:</b> HPCS-P-1 SUCTION TO WATER LESS PUMP HPCS-P-3		
<b>DWG NO: HPCS-203</b>		<b>REV 1</b>



**REFERENCES:**

ISI - 220-1  
 BOYCE & CRAIL ISOMETRICS  
 HPCS-1458-1 REV B

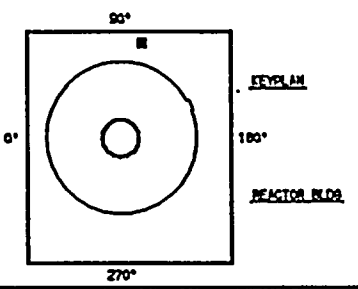

QUALITY CLASS: 1	ASME CODE CLASS: 2
ENGR: K-McANDREW	DATE: 5-22-65




WASHINGTON PUBLIC POWER  
 SUPPLY SYSTEM  
 RICHLAND, WASHINGTON 99352

ZONE R-13  
 THIS DRAWING IS INTENDED FOR  
 USE IN PRESERVICE AND INSERVICE  
 INSPECTIONS PROGRAMS ONLY.


PIPING SYSTEM	NOM DIA (IN)	SCH	NOM WALL THK	MATERIAL SPECIFICATION	MATL TYPE	CAL BLOCK NO
1 1/2" HPCS (7)-1	1 1/2	80	0.200	SA 106 GR B	CS	NA

NO	DATE	REVISION	BY	CHKD	APVD
1	11-13-62	MODIFIED KEYPLAN ADDED LOGO	K-McA	DPR	DRY
0	1-23-65	ISSUED FOR USE	K-McA	DPR	TTH

WMP-2 WELD & COMPONENT IDENTIFICATION DIAGRAM	
TITLE: WATER LEG PUMP HPCS-P-3 TO HPCS-P-1 SUCTION LINE	
DWG NO: HPCS-204-1	REV 1

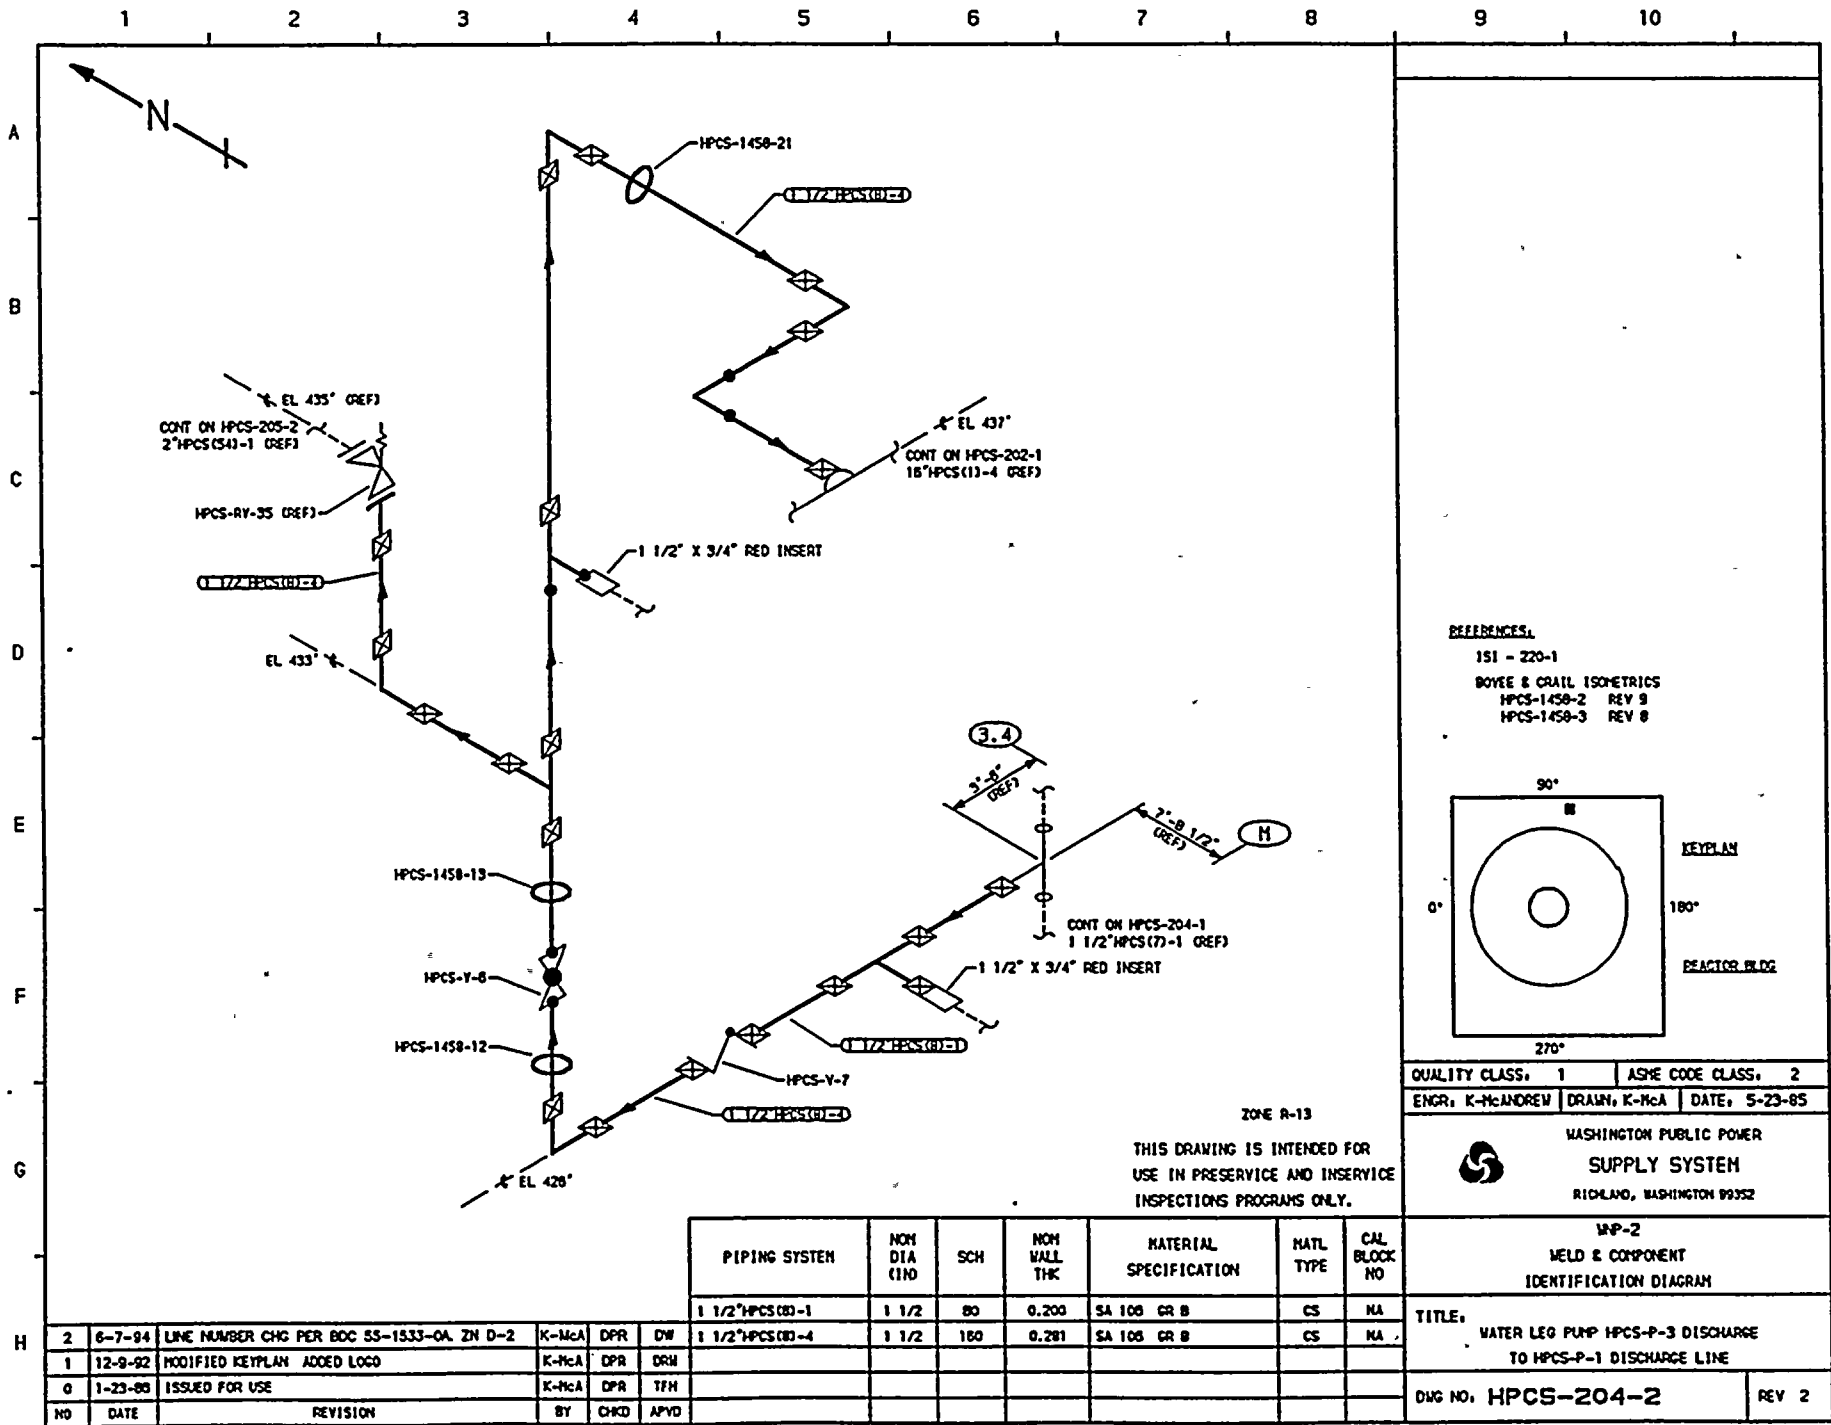

REFERENCES:  
 ISI - 220-1  
 BOYEE & CRAIG ISOMETRICS  
 HPCS-1458-2 REV 9  
 HPCS-1458-3 REV 8

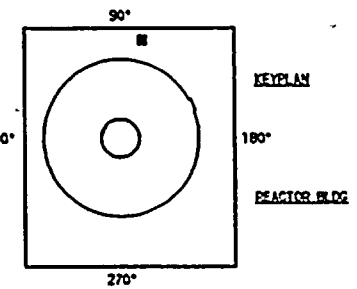

QUALITY CLASS, 1 ASME CODE CLASS, 2  
 ENGR, K-McANDREW DRAIN, K-McA DATE, 5-23-85



WASHINGTON PUBLIC POWER  
**SUPPLY SYSTEM**  
 RICHLAND, WASHINGTON 99352

WP-2  
 WELD & COMPONENT  
 IDENTIFICATION DIAGRAM


TITLE:  
 WATER LEG PUMP HPCS-P-3 DISCHARGE  
 TO HPCS-P-1 DISCHARGE LINE

DWG NO. HPCS-204-2 REV 2

ZONE R-13  
 THIS DRAWING IS INTENDED FOR  
 USE IN PRESERVICE AND INSERVICE  
 INSPECTIONS PROGRAMS ONLY.


PIPING SYSTEM	NOM DIA (IN)	SCH	NOM WALL THK	MATERIAL SPECIFICATION	NATL TYPE	CAL BLOCK NO
1 1/2" HPCS(0)-1	1 1/2	80	0.200	SA 106 GR B	CS	NA
1 1/2" HPCS(0)-4	1 1/2	160	0.281	SA 106 GR B	CS	NA

NO	DATE	REVISION	BY	CHKD	APVD
2	6-7-94	LINE NUMBER CHG PER BOC 55-1533-OA. ZN D-2	K-McA	DPR	DW
1	12-9-92	MODIFIED KEYPLAN ADDED LOCO	K-McA	DPR	DRM
0	1-23-85	ISSUED FOR USE	K-McA	DPR	TJH

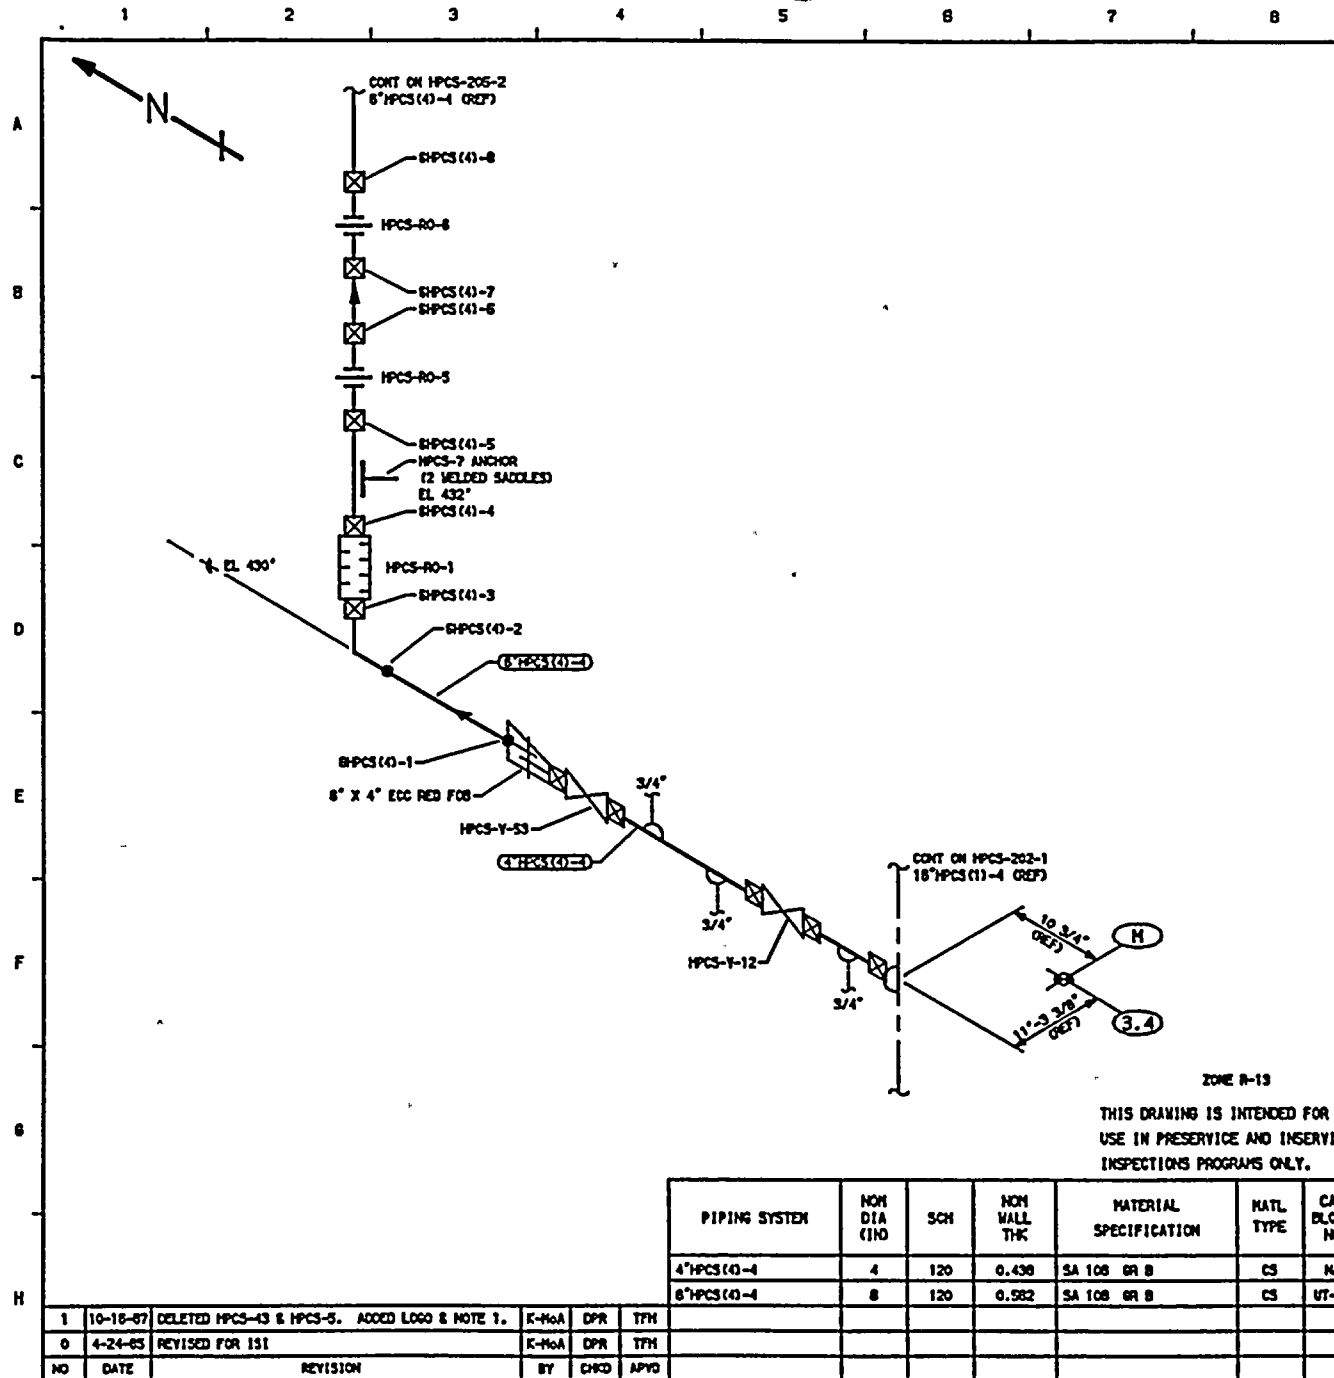

**NOTES:**  
 1. PORTIONS OF THIS DRAWING IDENTIFY PIPING AND COMPONENTS SUBJECT ONLY TO A VISUAL EXAMINATION FOR EVIDENCE OF LEAKAGE DURING SYSTEM HYDRO OR OPERABILITY TESTS. TESTS ARE TO BE CONDUCTED PER THE REQUIREMENTS OF ASME SECTION XI, PARAGRAPH IWA-5000.

**REFERENCES:**  
 ISI - 220-1  
 BOYCE & CRAIL ISOMETRICS  
 HPCS-630-1.4 REV 14  
 HPCS-630-5.8 REV 13  
 HPCS-632-1.3 REV 12

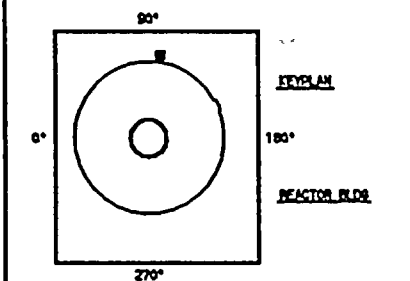

QUALITY CLASS, 1 ASME CODE CLASS, 2  
 ENGR, K-McANDREWM DRAWN, K-McA DATE, 2-27-85

WASHINGTON PUBLIC POWER  
 SUPPLY SYSTEM  
 RICHLAND, WASHINGTON 99352

WP-2  
 WELD & COMPONENT  
 IDENTIFICATION DIAGRAM

TITLE:  
 HPCS-P-1 MINIMUM FLOW  
 TO SUPPRESSION POOL

DWG NO: HPCS-205-1 REV 1

ZONE R-13  
 THIS DRAWING IS INTENDED FOR  
 USE IN PRESERVICE AND INSERVICE  
 INSPECTIONS PROGRAMS ONLY.

PIPING SYSTEM	NOM DIA (IN)	SCH	NOM WALL THK	MATERIAL SPECIFICATION	MATL TYPE	CAL BLOCK NO
4"HPCS (0-4)	4	120	0.438	SA 106 GR B	CS	NA
6"HPCS (0-4)	6	120	0.582	SA 106 GR B	CS	UT-27

NO	DATE	REVISION	BY	CHKD	APPD
1	10-16-87	DELETED HPCS-43 & HPCS-5. ADDED LOGO & NOTE 1.	K-McA	DPR	TTH
0	4-24-85	REVISED FOR ISI	K-McA	DPR	TTH
		REVISION			





## 9.6 LPCS Low Pressure Core Spray

## Boundary Diagram - ISI-220-2

## Exemptions Applied:

## IWB-1220

(a)	No	
(b)(1)	Yes	All piping 1 NPS and smaller
(b)(2)	Yes	All components 1 NPS and smaller
(c)	No	

## IWC-1221

(a)	Yes	All piping 4 NPS and smaller
(b)	NA <sup>1</sup>	
(c)	Yes	All components 4 NPS and smaller
(d)	NA <sup>1</sup>	
(e)	NA <sup>1</sup>	
(f)	Yes	6" LPCS(4)-1-1, 12" LPCS(3)-1-1

## IWC-1222

NA

IWD-1220.1 NA No Class 3 piping within LPCS system

IWD-1220.2 NA No Class 3 piping within LPCS system


## Code Case N-491

-1230 Yes 6" LPCS(4)-1-1, 12" LPCS(3)-1-1

<sup>1</sup> WNP-2 is a BWR

9.6.2 Boundary Diagrams



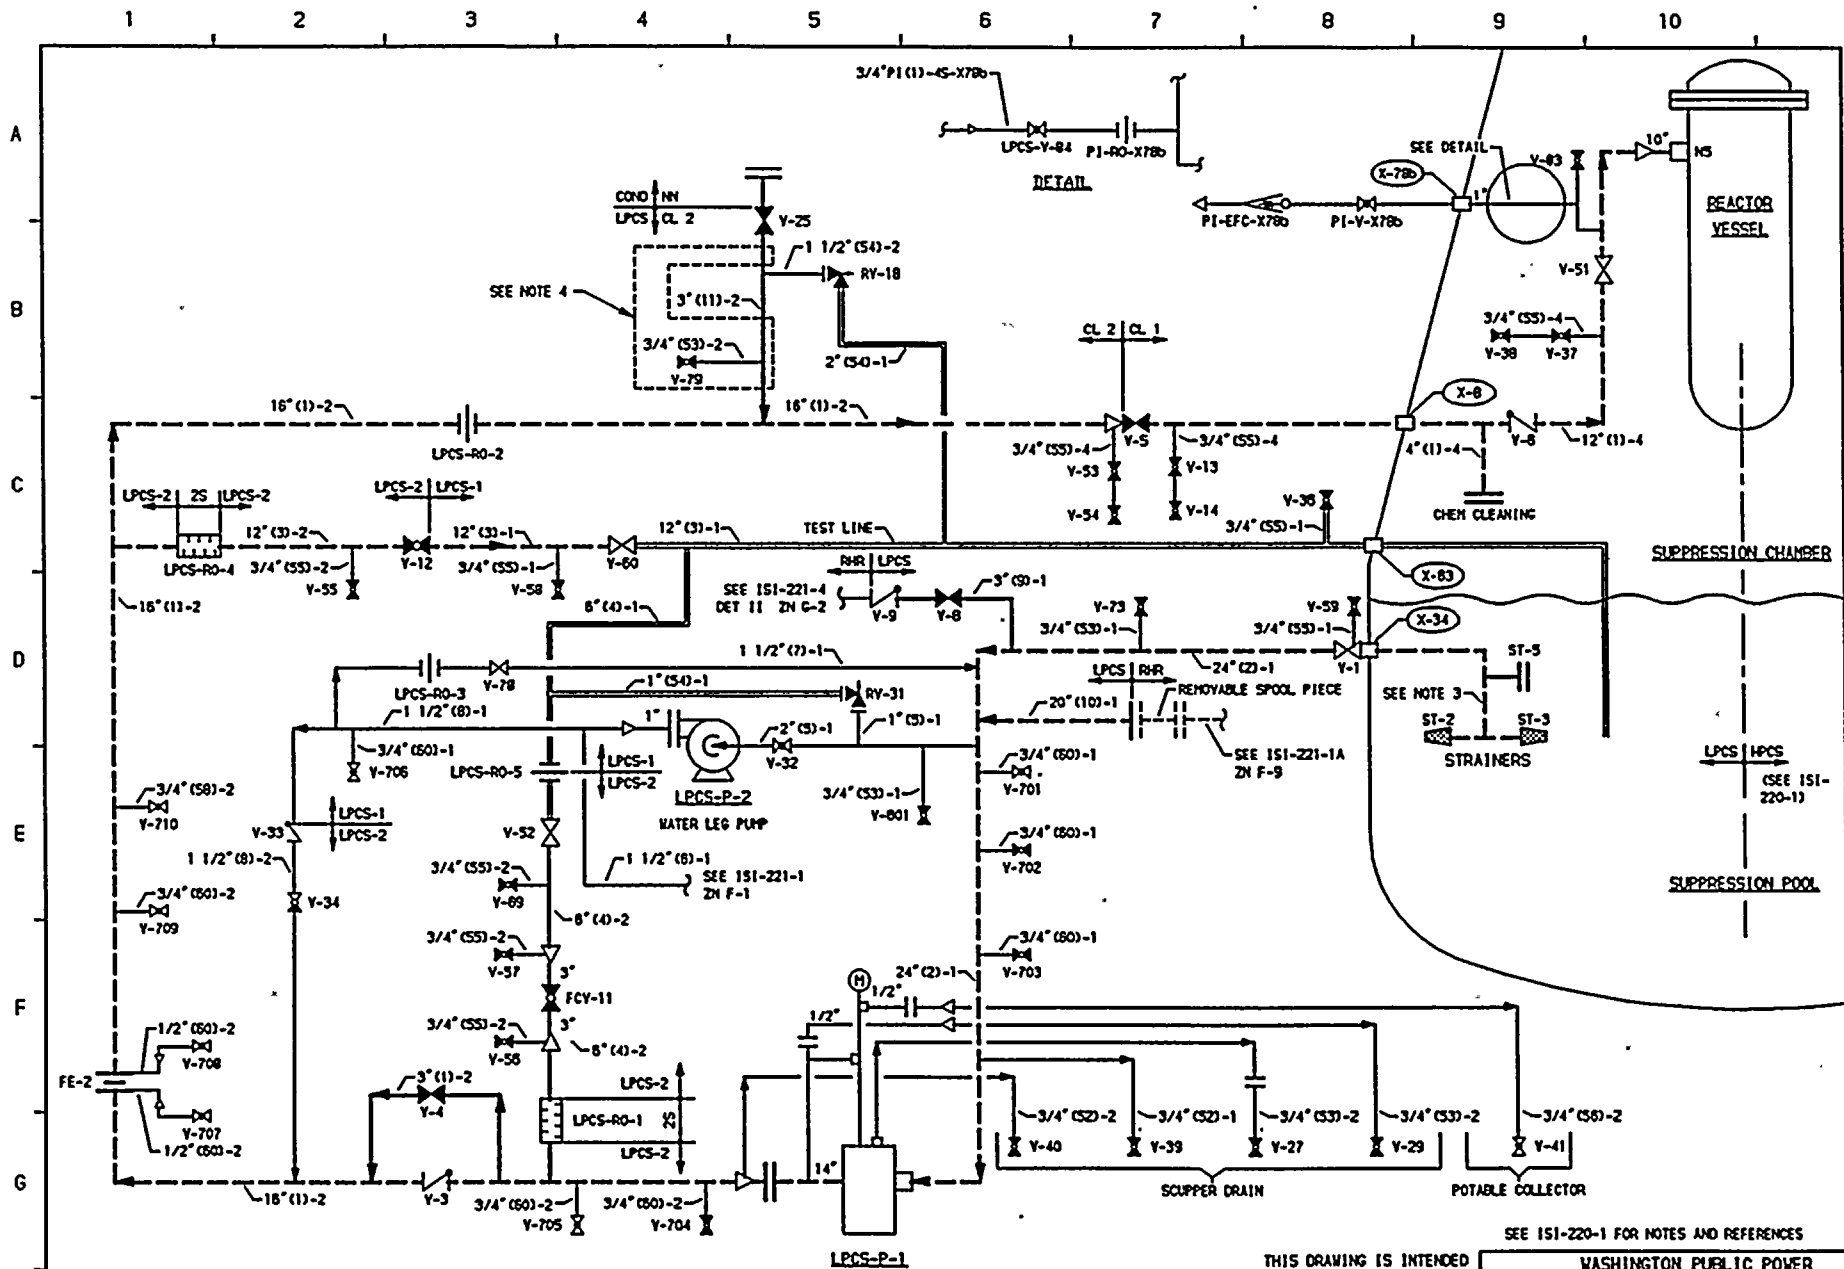

SEE ISI-220-1 FOR NOTES AND REFERENCES

THIS DRAWING IS INTENDED FOR USE IN PRESERVICE AND INSERVICE INSPECTIONS PROGRAMS ONLY



WASHINGTON PUBLIC POWER  
SUPPLY SYSTEM  
INP-2 RICHLAND, WASHINGTON 99352

4	12-1-92	PER BCC-20-1429-04-304 CHANGED FOUR (4) 3/4" SYSTEM DESIGNATIONS, CONNECTED 2-876 & ASSOC. COMPONENTS.	K-MCA	DPR	DRW
3	12-4-89	ADDED PENETRATION 2-83 & ASSOCIATED CONNECTING LINES, CONNECTED V-53 TO V-33 & 2-31 TO 2-31. ADDED LOGS.	K-MCA	DPR	TFH
2	1-24-85	REVISED FOR ISI	K-MCA	DPR	TFH

5	6-7-84	REVISED PER LATEST TOP TIER DRAWINGS.	K-MCA	DPR	DW
NO	DATE	REVISION	BY	CHKD	APVD

ENGINEER	D PORTER
DRAWN	K-McANDREW
DATE	11-16-77

INSERVICE INSPECTION BOUNDARY DIAGRAM
HIGH PRESSURE CORE SPRAY (HPCS)
LOW PRESSURE CORE SPRAY (LPCS)

DWG NO.	ISI-220-2	REV	5
---------	-----------	-----	---

9.6.3 Examination Schedule

WNP-2  
Interval 2  
LPCS - Low Pressure Core Spray

Table 9.1.4  
Washington Public Power Supply System  
ISI Program Plan and Schedule  
(Grouped by Drawing No. and Walkdown Order)

Revision 0

Pg	Identification No.	Description	Category	Item No.	Method	Per.	Out.	Reqmt.	Code	Out. Freq.	Rel. Req.	Remarks
Diagram No. LPCS-101												
	LPCS-PB-101(L)	LK PRES BNDRY	B-P	B15.50	VT-2	1	10	0	CE	3		
	LPCS-PB-101(H)	HYDRO PRES BNDR	B-P	B15.51	VT-2	3	19	E	CE	10		
01	LPCS-V-5-BDY	VALVE BODY	B-M-2	B12.50	VT-3			U	C	0		VELAN, GATE, CONTAINMENT ISOLATION
	LPCS-V-5-BDY(L)	LK PRES BNDRY	B-P	B15.70	VT-2	1	10	0	CE	1		
	LPCS-V-5-BDY(H)	HYDRO PRES BNDR	B-P	B15.71	VT-2	3	19	E	CE	10		
	LPCS-V-5-BLT	VALVE BOLTING	B-G-2	B7.70	VT-1	1	11	81	CE	10		
	12LPCS(1)-1	VLV TO PIPE	B-J	B9.11	SUR	3	17	>91	CE	10		
					VOL	3	17	>91	CE	10		
	LPCS-28	PSA-3 SHUBBER	F-A	F1.10D	VT-3			3	C	0		
	12LPCS(1)-2	PIPE TO ELL	B-J	B9.11	SUR	3	17	>91	CE	10		
					VOL	3	17	>91	CE	10		
	12LPCS(1)-3	ELL TO PIPE	B-J	B9.11	SUR			<9	C	0		
					VOL			<9	C	0		
	LPCS-13(W)	4 WELDED LUGS	B-K-1	B10.10	SUR	3	17	81	CE	10		
	LPCS-13	SPRING	F-A	F1.10C	VT-3	3	17	31	CE	10		
	12LPCS(1)-4	PIPE TO ELL	B-J	B9.11	SUR			<9	C	0		
					VOL			<9	C	0		
	12LPCS(1)-5	ELL TO PIPE	B-J	B9.11	SUR			<9	C	0		
					VOL			<9	C	0		
	12LPCS(1)-6	PIPE TO PEN	B-J	B9.11	SUR			<9	C	0		
					VOL			<9	C	0		

WNP-2  
Interval 2  
LPCS - Low Pressure Core Spray

Table 9.1.4  
Washington Public Power Supply System  
ISI Program Plan and Schedule  
(Grouped by Drawing No. and Walkdown Order)

Revision 0

Pg	Identification No.	Description	Category	Item No.	Method	Per.	Out.	Reqmt.	Code	Out. Freq.	Rel. Req.	Remarks
Diagram No. LPCS-101												
01	12LPCS(1)-7	PEN TO PIPE	B-J	B9.11	SUR VOL			<9 <9	C C	0 0		
	12LPCS(1)-8	PIPE TO ELL	B-J	B9.11	SUR VOL	2 2	14 14	>91 >91	CE CE	10 10		
	12LPCS(1)-9	ELL TO PIPE	B-J	B9.11	SUR VOL			<9 <9	C C	0 0		
	LPCS-904N	STRUT	F-A	F1.10A	VT-3			31	C	0		
	LPCS-908N	STRUT	F-A	F1.10A	VT-3			31	C	0		
	LPCS-907N	STRUT	F-A	F1.10A	VT-3			31	C	0		
	12LPCS(1)-10	PIPE TO PIPE	B-J	B9.11	SUR VOL			<9 <9	C C	0 0		
	12LPCS(1)-11	PIPE TO ELL	B-J	B9.11	SUR VOL			<9 <9	C C	0 0		
	12LPCS(1)-12	ELL TO PIPE	B-J	B9.11	SUR VOL			<9 <9	C C	0 0		
	12LPCS(1)-13	PIPE TO ELL	B-J	B9.11	SUR VOL			<9 <9	C C	0 0		
	12LPCS(1)-14	ELL TO PIPE	B-J	B9.11	SUR VOL			<9 <9	C C	0 0		
	LPCS-906N	SPRING	F-A	F1.10C	VT-3			31	C	0		
	LPCS-64	SPRING	F-A	F1.10C	VT-3			31	C	0		

WNP-2  
Interval 2  
LPCS - Low Pressure Core Spray

Table 9.1.4  
Washington Public Power Supply System  
ISI Program Plan and Schedule  
(Grouped by Drawing No. and Walkdown Order)

Revision 0

Pg	Identification No.	Description	Category	Item No.	Method	Per.	Out.	Requ.	Code	Out. Freq.	Rel. Req.	Remarks
Diagram No. LPCS-101												
01	12LPCS(1)-15	PIPE TO ELL	B-J	B9.11	SUR			<9	C	0		
					VOL			<9	C	0		
	12LPCS(1)-16	ELL TO PIPE	B-J	B9.11	SUR			<9	C	0		
					VOL			<9	C	0		
	12LPCS(1)-17	PIPE TO ELL	B-J	B9.11	SUR			<9	C	0		
					VOL			<9	C	0		
02	12LPCS(1)-18	ELL TO PIPE	B-J	B9.11	SUR	2	14	>91	CE	10		
					VOL	2	14	>91	CE	10		
	LPCS-63	SPRING	F-A	F1.10B	VT-3			31	C	0		
	LPCS-57(W)	4 WELDED LUGS	B-K-1	B10.10	SUR	1	12	81	CE	10		3/4"W x 2"H x 3"L.
	LPCS-57	BOX	F-A	F1.10A	VT-3	1	12	31	CE	10		
	12LPCS(1)-18/4LPCS(1)-4	WOL TO PIPE	B-J	B9.31	SUR			>9	C	0		
					VOL			>9	C	0		
	4LPCS(1)-1BU	FLANGE BOLTING	B-G-2	B7.50	VT-1	2	16	81	CE	10		
	4LPCS(1)-1	FLANGE TO PIPE	B-J	B9.11	SUR			<9	C	0		
					VOL			<9	C	0		
	4LPCS(1)-2	PIPE TO WOL	B-J	B9.11	SUR	2	14	>91	CE	10		
					VOL	2	14	>91	CE	10		
	12LPCS(1)-19	PIPE TO VLV	B-J	B9.11	SUR	2	14	>91	CE	10		
					VOL	2	14	>91	CE	10		

WNP-2  
Interval 2  
LPCS - Low Pressure Core Spray

Table 9.1.4  
Washington Public Power Supply System  
ISI Program Plan and Schedule  
(Grouped by Drawing No. and Walkdown Order)

Revision 0

Pg	Identification No.	Description	Category	Item No.	Method	Per.	Out.	Reqmt.	Code	Out. Freq.	Rel. Req.	Remarks
Diagram No. LPCS-101												
02	LPCS-V-6-BDY	VALVE BODY	B-M-2	B12.50	VT-3			U	C	0		VELAN, CHECK, CONTAINMENT ISOLATION
	LPCS-V-6-BDY(L)	LK PRES BNDRY	B-P	B15.70	VT-2	1	10	0	CE	1		
	LPCS-V-6-BDY(H)	HYDRO PRES BNDR	B-P	B15.71	VT-2	3	19	E	CE	10		
	LPCS-V-6-BLT	VALVE BOLTING	B-G-2	B7.70	VT-1	2	14	81	CE	10		
	12LPCS(1)-20	VLV TO PIPE	B-J	B9.11	SUR	2	14	>91	CE	10		
					VOL	2	14	>91	CE	10		
	12LPCS(1)-21	PIPE TO VLV	B-J	B9.11	SUR	1	10	>91	CE	10		
					VOL	1	10	>91	CE	10		
	LPCS-V-51-BDY	VALVE BODY	B-M-2	B12.50	VT-3			U	C	0		VELAN, GATE, SYSTEM ISOLATION
	LPCS-V-51-BDY(L)	LK PRES BNDRY	B-P	B15.70	VT-2	1	10	0	CE	1		
	LPCS-V-51-BDY(H)	HYDRO PRES BNDR	B-P	B15.71	VT-2	3	19	E	CE	10		
	LPCS-V-51-BLT	VALVE BOLTING	B-G-2	B7.70	VT-1	2	16	81	CE	10		
	12LPCS(1)-22	VLV TO PIPE	B-J	B9.11	SUR	1	10	>91	CE	10		
					VOL	1	10	>91	CE	10		
	12LPCS(1)-23	PIPE TO ELL	B-J	B9.11	SUR	1	10	>91	CE	10		
					VOL	1	10	>91	CE	10		
	10LPCS(1)-1	ELL TO PIPE	B-J	B9.11	SUR	1	11	>91	CE	10		
					VOL	1	11	>91	CE	10		
	10LPCS(1)-2	PIPE TO SE EXT	B-J	B9.11	SUR	1	11	>91	CE	10		SEE RPV-105,NOZ N5
					VOL	1	11	>91	CE	10		SEE RPV-105,NOZ N5
	10LPCS(1)-3	SE EXT TO SE	B-F	B5.130	SUR	1	11	81	CE	10		SEE RPV-105,NOZ N5
					VOL	1	11	8A	CGE	10		SEE RPV-105,NOZ N5
	10LPCS(1)-4	SE TO NOZZLE	B-F	B5.10	SUR	3	17	81	CE	10		SEE RPV-105,NOZ N5
					VOL	1	12	8D	CGE	3		SEE RPV-105,NOZ N5

WNP-2  
Interval 2  
LPCS - Low Pressure Core Spray

Table 9.1.4  
Washington Public Power Supply System  
ISI Program Plan and Schedule  
(Grouped by Drawing No. and Walkdown Order)

Revision 0

Pg	Identification No.	Description	Category	Item No.	Method	Per.	Out.	Reqmt.	Code	Out. Freq.	Rel. Req.	Remarks
Diagram No. LPCS-201												
	LPCS-PB-201(L)	LK PRES BNDRY	C-H	C7.30	VT-2	1	13	P	CE	3		
	LPCS-PB-201(H)	HYDRO PRES BNDR	C-H	C7.40	VT-2	3	19	E	CE	10		
	LPCS-PB-PUMP(L)	LK PRES BNDRY	C-H	C7.50	VT-2	1	13	P	CE	3		
	LPCS-PB-PUMP(H)	HYDRO PRES BNDR	C-H	C7.60	VT-2	3	19	E	CE	10		
01	24LPCS(2)-1	PEN TO VALVE	C-F-2	C5.51	SUR VOL			2 2	C C	0 0		
	24LPCS(2)-2	VALVE TO PIPE	C-F-2	C5.51	SUR VOL			2 2	C C	0 0		
	24LPCS(2)-2/3(9)-1	BRANCH CONN	NA	NA	SUR			2				
	LPCS-900N	BOX	F-A	F1.20A	VT-3			41	C	0		
	24LPCS(2)-3	PIPE TO ELL	C-F-2	C5.51	SUR VOL			2 2	C C	0 0		
	24LPCS(2)-4	ELL TO PIPE	C-F-2	C5.51	SUR VOL			2 2	C C	0 0		
	24LPCS(2)-5	PIPE TO TEE	C-F-2	C5.51	SUR VOL			2 2	C C	0 0		
	20LPCS(10)-1	TEE TO FLANGE	C-F-2	C5.51	SUR VOL			2 2	C C	0 0		
	24LPCS(2)-6	TEE TO ELL	C-F-2	C5.51	SUR VOL			2 2	C C	0 0		
	24LPCS(2)-7	ELL TO PIPE	C-F-2	C5.51	SUR VOL			2 2	C C	0 0		
02	24LPCS(2)-8	PIPE TO ELL	C-F-2	C5.51	SUR	3	17	21	CE	10		

WNP-2  
Interval 2  
LPCS - Low Pressure Core Spray

Table 9.1.4  
Washington Public Power Supply System  
ISI Program Plan and Schedule  
(Grouped by Drawing No. and Walkdown Order)

Revision 0

Pg	Identification No.	Description	Category	Item No.	Method	Per.	Out.	Reqmt.	Code	Out. Freq.	Rel. Req.	Remarks
Diagram No. LPCS-201												
02	24LPCS(2)-8	PIPE TO ELL	C-F-2	C5.51	VOL	3	17	21	CE	10		
	LPCS-3	ANCHOR	F-A	F1.20A	VT-3	3	17	41	CE	10		
	24LPCS(2)-9	ELL TO ELL	C-F-2	C5.51	SUR VOL			2 2	C C	0 0		
	24LPCS(2)-10	ELL TO PIPE	C-F-2	C5.51	SUR VOL			2 2	C C	0 0		
	24LPCS(2)-11	PIPE TO FLANGE	C-F-2	C5.51	SUR VOL			2 2	C C	0 0		
	LPCS-2	RIGID	F-A	F1.20A	VT-3			41	C	0		
	LPCS-902N	SPRING	F-A	F1.20C	VT-3			41	C	0		
	24LPCS(2)-12	FLANGE TO PIPE	C-F-2	C5.51	SUR VOL			2 2	C C	0 0		
	24LPCS(2)-13	PIPE TO FLANGE	C-F-2	C5.51	SUR VOL			2 2	C C	0 0		
	24LPCS(2)-14	FLANGE TO ELL	C-F-2	C5.51	SUR VOL			2 2	C C	0 0		
	24LPCS(2)-15	ELL TO PIPE	C-F-2	C5.51	SUR VOL			2 2	C C	0 0		
	LPCS-P-1(CS)	PUMP BASE	F-A	F1.40A	VT-3	1	10	61	CE	10		
	LPCS-1	RIGID	F-A	F1.20A	VT-3	3	17	41	CE	10		



WNP-2  
 Interval 2  
 LPCS - Low Pressure Core Spray

Table 9.1.4  
 Washington Public Power Supply System  
 ISI Program Plan and Schedule  
 (Grouped by Drawing No. and Walkdown Order)

Revision 0

Pg	Identification No.	Description	Category	Item No.	Method	Per.	Out.	Reqmt.	Code	Out. Freq.	Rel. Req.	Remarks
Diagram No. LPCS-201												
02	24LPCS(2)-16	PIPE TO NOZZLE	C-F-2	C5.51	SUR	3	17	21	CE	10		
					VOL	3	17	21	CE	10		

WNP-2  
Interval 2  
LPCS - Low Pressure Core Spray

Table 9.1.4  
Washington Public Power Supply System  
ISI Program Plan and Schedule  
(Grouped by Drawing No. and Walkdown Order)

Revision 0

Pg	Identification No.	Description	Category	Item No.	Method	Per.	Out.	Reqmt.	Code	Out. Freq.	Rel. Req.	Remarks
Diagram No. LPCS-202												
	LPCS-PB-202(L)	LK PRES BNDRY	C-H	C7.30	VT-2	1	21	P	CE	3		
	LPCS-PB-202(H)	HYDRO PRES BKDR	C-H	C7.40	VT-2	3	19	E	CE	10		
01	14LPCS(1)-1	FLANGE TO RED	C-F-2	C5.51	SUR VOL			2 2	C C	0 0		
	16LPCS(1)-1	RED TO ELL	C-F-2	C5.51	SUR VOL			2 2	C C	0 0		
	LPCS-9	SPRING	F-A	F1.20C	VT-3	2	14	41	CE	10		
	16LPCS(1)-2	ELL TO PIPE	C-F-2	C5.51	SUR VOL			2 2	C C	0 0		
	16LPCS(1)-2/6LPCS(4)-2	BRANCH CONN	C-F-2	C5.81	SUR	2	15	21	CE	10		
	16LPCS(1)-2/3(1)-2	BRANCH CONN	NA	NA	SUR			2				
	16LPCS(1)-3	PIPE TO VALVE	C-F-2	C5.51	SUR VOL			2 2	C C	0 0		
	16LPCS(1)-4	VLV TO PIPE	C-F-2	C5.51	SUR VOL			2 2	C C	0 0		
	16LPCS(1)-4/3(1)-2	BRANCH CONN	NA	NA	SUR			2				
	16LPCS(1)-5	PIPE TO ELL	C-F-2	C5.51	SUR THK VOL	3	18	2 HP 2	C T C	0 0 0		PSI PERFORMED UT THK-10YR
	16LPCS(1)-6	ELL TO PIPE	C-F-2	C5.51	SUR VOL			2 2	C C	0 0		

WNP-2  
Interval 2  
LPCS - Low Pressure Core Spray

Table 9.1.4  
Washington Public Power Supply System  
ISI Program Plan and Schedule  
(Grouped by Drawing No. and Walkdown Order)

Revision 0

Pg	Identification No.	Description	Category	Item No.	Method	Per.	Out.	Reqmt.	Code	Out. Freq.	Rel. Req.	Remarks
Diagram No. LPCS-202												
01	LPCS-38	BOX	F-A	F1.20A	VT-3			41	C	0		
	LPCS-39	BOX	F-A	F1.20A	VT-3			41	C	0		
	16LPCS(1)-7	PIPE TO ELL	C-F-2	C5.51	SUR			2	C	0		
					VOL			2	C	0		
	16LPCS(1)-8	ELL TO PIPE	C-F-2	C5.51	SUR	2	15	21	CE	10		
					VOL	2	15	21	CE	10		
	LPCS-11	SPRING	F-A	F1.20C	VT-3			41	C	0		
02	LPCS-46	BOX	F-A	F1.20A	VT-3			41	C	0		
	LPCS-31	BOX	F-A	F1.20A	VT-3			41	C	0		
03	16LPCS(1)-9	PIPE TO ELL	C-F-2	C5.51	SUR			2	C	0		
					VOL			2	C	0		
	16LPCS(1)-10	ELL TO PIPE	C-F-2	C5.51	SUR			2	C	0		
					VOL			2	C	0		
	16LPCS(1)-10A	PIPE TO PIPE	C-F-2	C5.51	SUR			2	C	0		
					VOL			2	C	0		
	LPCS-12	BOX	F-A	F1.20A	VT-3			41	C	0		
	16LPCS(1)-10B	PIPE TO PIPE	C-F-2	C5.51	SUR			2	C	0		
					VOL			2	C	0		
	16LPCS(1)-11	PIPE TO ELL	C-F-2	C5.51	SUR			2	C	0		
					VOL			2	C	0		

WNP-2  
Interval 2  
LPCS - Low Pressure Core Spray

Table 9.1.4  
Washington Public Power Supply System  
ISI Program Plan and Schedule  
(Grouped by Drawing No. and Walkdown Order)

Revision 0

Pg	Identification No.	Description	Category	Item No.	Method	Per. Out.	Reqmt. Code	Out. Freq.	Rel. Req.	Remarks
Diagram No. LPCS-202										
03	16LPCS(1)-12	ELL TO PIPE	C-F-2	C5.51	SUR VOL	2 2	C C	0 0		
	LPCS-14	ANCHOR	F-A	F1.20A	VT-3	41	C	0		
	16LPCS(1)-13	PIPE TO FLANGE	C-F-2	C5.51	SUR VOL	2 2	C C	0 0		
	16LPCS(1)-14	FLANGE TO PIPE	C-F-2	C5.51	SUR VOL	2 2	C C	0 0		
	16LPCS(1)-15	PIPE TO ELL	C-F-2	C5.51	SUR VOL	2 2	C C	0 0		
	16LPCS(1)-16	ELL TO PIPE	C-F-2	C5.51	SUR VOL	2 2	C C	0 0		
	16LPCS(1)-17	PIPE TO TEE	C-F-2	C5.51	SUR VOL	2 2	C C	0 0		
	12LPCS(3)-1	TEE TO PIPE	C-F-2	C5.51	SUR VOL	2 2	C C	0 0		
	12LPCS(3)-2	PIPE TO RO	C-F-2	C5.51	SUR VOL	2 2	C C	0 0		
	12LPCS(3)-3	RO TO PIPE	C-F-2	C5.51	SUR VOL	2 2	C C	0 0		
	LPCS-17	BOX	F-A	F1.20A	VT-3	41	C	0		
	12LPCS(3)-4	PIPE TO VLV	C-F-2	C5.51	SUR	2	C	0		

WNP-2  
Interval 2  
LPCS - Low Pressure Core Spray

Table 9.1.4  
Washington Public Power Supply System  
ISI Program Plan and Schedule  
(Grouped by Drawing No. and Walkdown Order)

Revision 0

Pg	Identification No.	Description	Category	Item No.	Method	Per.	Out.	Requmt.	Code	Out. Freq.	Rel. Req.	Remarks
Diagram No. LPCS-202												
03	12LPCS(3)-4	PIPE TO VLV	C-F-2	C5.51	VOL			2	C	0		
	12LPCS(3)-5	VLV TO PIPE	C-F-2	C5.51	SUR	2	15	21	CE	10		
					VOL	2	15	21	CE	10		
	12LPCS(3)-6	PIPE TO ELL	C-F-2	C5.51	SUR	2	15	21	CE	10		
					VOL	2	15	21	CE	10		
	12LPCS(3)-7	ELL TO PIPE	C-F-2	C5.51	SUR			2	C	0		
					VOL			2	C	0		
	LPCS-901M	ANCHOR	F-A	F1.20A	VT-3			41	C	0		
	12LPCS(3)-8	PIPE TO VLV	C-F-2	C5.51	SUR			2	C	0		
					VOL			2	C	0		
	16LPCS(1)-18	TEE TO ELL	C-F-2	C5.51	SUR			2	C	0		
					VOL			2	C	0		
04	16LPCS(1)-19	ELL TO PIPE	C-F-2	C5.51	SUR			2	C	0		
					VOL			2	C	0		
	LPCS-18	SPRING	F-A	F1.20C	VT-3			41	C	0		
	16LPCS(1)-20	PIPE TO ELL	C-F-2	C5.51	SUR			2	C	0		
					VOL			2	C	0		
	16LPCS(1)-21	ELL TO ELL	C-F-2	C5.51	SUR			2	C	0		
					VOL			2	C	0		
	16LPCS(1)-22	ELL TO PIPE	C-F-2	C5.51	SUR			2	C	0		
					VOL			2	C	0		

WNP-2  
Interval 2  
LPCS - Low Pressure Core Spray

Table 9.1.4  
Washington Public Power Supply System  
ISI Program Plan and Schedule  
(Grouped by Drawing No. and Walkdown Order)

Revision 0

Pg	Identification No.	Description	Category	Item No.	Method	Per.	Out.	Reqmt.	Code	Out. Freq.	Rel. Req.	Remarks
Diagram No. LPCS-202												
04	LPCS-19	ANCHOR	F-A	F1.20A	VT-3	2	15	41	CE	10		
	16LPCS(1)-23	PIPE TO PIPE	C-F-2	C5.51	SUR VOL			2 2	C C	10 10		
	LPCS-20	STRUT	F-A	F1.20A	VT-3			41	C	0		
	16LPCS(1)-24	PIPE TO PIPE	C-F-2	C5.51	SUR VOL			2 2	C C	0 0		
	LPCS-41	STRUT	F-A	F1.20A	VT-3			41	C	0		
	16LPCS(1)-25	PIPE TO ELL	C-F-2	C5.51	SUR VOL			2 2	C C	0 0		
	16LPCS(1)-26	ELL TO ELL	C-F-2	C5.51	SUR VOL			2 2	C C	0 0		
	16LPCS(1)-27	ELL TO PIPE	C-F-2	C5.51	SUR VOL	2 2	15 15	21 21	CE CE	10 10		
	LPCS-21	BOX	F-A	F1.20A	VT-3			41	C	0		
	LPCS-42	BOX	F-A	F1.20A	VT-3	2	15	41	CE	10		
	LPCS-22	RIGID	F-A	F1.20A	VT-3			41	C	0		
	LPCS-23	SPRING	F-A	F1.20C	VT-3			41	C	0		
	LPCS-24	BOX	F-A	F1.20A	VT-3			41	C	0		
05	16LPCS(1)-28	PIPE TO ELL	C-F-2	C5.51	SUR VOL			2 2	C C	0 0		

WNP-2  
Interval 2  
LPCS - Low Pressure Core Spray

Table 9.1.4  
Washington Public Power Supply System  
ISI Program Plan and Schedule  
(Grouped by Drawing No. and Walkdown Order)

Revision 0

Pg	Identification No.	Description	Category	Item No.	Method	Per.	Out.	Requmt.	Code	Out. Freq.	Rel. Req.	Remarks
Diagram No. LPCS-202												
05	16LPCS(1)-29	ELL TO PIPE	C-F-2	C5.51	SUR		2		C	0		
					VOL		2		C	0		
	LPCS-25	SPRING	F-A	F1.20C	VT-3		41		C	0		
	16LPCS(1)-30	PIPE TO ELL	C-F-2	C5.51	SUR		2		C	0		
					VOL		2		C	0		
	16LPCS(1)-31	ELL TO PIPE	C-F-2	C5.51	SUR		2		C	0		
					VOL		2		C	0		
	LPCS-903N	ANCHOR	F-A	F1.20A	VT-3		41		C	0		
	16LPCS(1)-32	PIPE TO ELL	C-F-2	C5.51	SUR		2		C	0		
					VOL		2		C	0		
	16LPCS(1)-33	ELL TO PIPE	C-F-2	C5.51	SUR		2		C	0		
					VOL		2		C	0		
	16LPCS(1)-34	PIPE TO FLANGE	C-F-2	C5.51	SUR	3	19	21	CE	10		
					VOL	3	19	21	CE	10		
	16LPCS(1)-35	FLANGE TO ELL	C-F-2	C5.51	SUR		2		C	0		
					VOL		2		C	0		
	16LPCS(1)-35/3(11)-2	BRANCH CONN	NA	NA	SUR		2					
	16LPCS(1)-36	ELL TO RED	C-F-2	C5.51	SUR		2		C	0		
					VOL		2		C	0		
	12LPCS(1)-1A	RED TO VALVE	C-F-2	C5.51	SUR		2		C	0		
					VOL		2		C	0		

WNP-2  
Interval 2  
LPCS - Low Pressure Core Spray


Table 9.1.4  
Washington Public Power Supply System  
ISI Program Plan and Schedule  
(Grouped by Drawing No. and Walkdown Order)

Revision 0

Pg	Identification No.	Description	Category	Item No.	Method	Per.	Out.	Reqmt.	Code	Out. Freq.	Rel. Req.	Remarks
Diagram No. LPCS-206												
01	LPCS-32	RIGID	NA	NA	NA			Z		0		
	LPCS-45	RIGID	NA	NA	NA			Z		0		
	LPCS-33	RIGID	NA	NA	NA			Z		0		
	LPCS-35	SPRING	NA	NA	NA			Z		0		
	LPCS-34	RIGID	NA	NA	NA			Z		0		
02	LPCS-36	ANCHOR	NA	NA	NA			Z		0		
	LPCS-911H	SPRING	NA	NA	NA			Z		0		




9.6.4 Weld and Component Diagrams

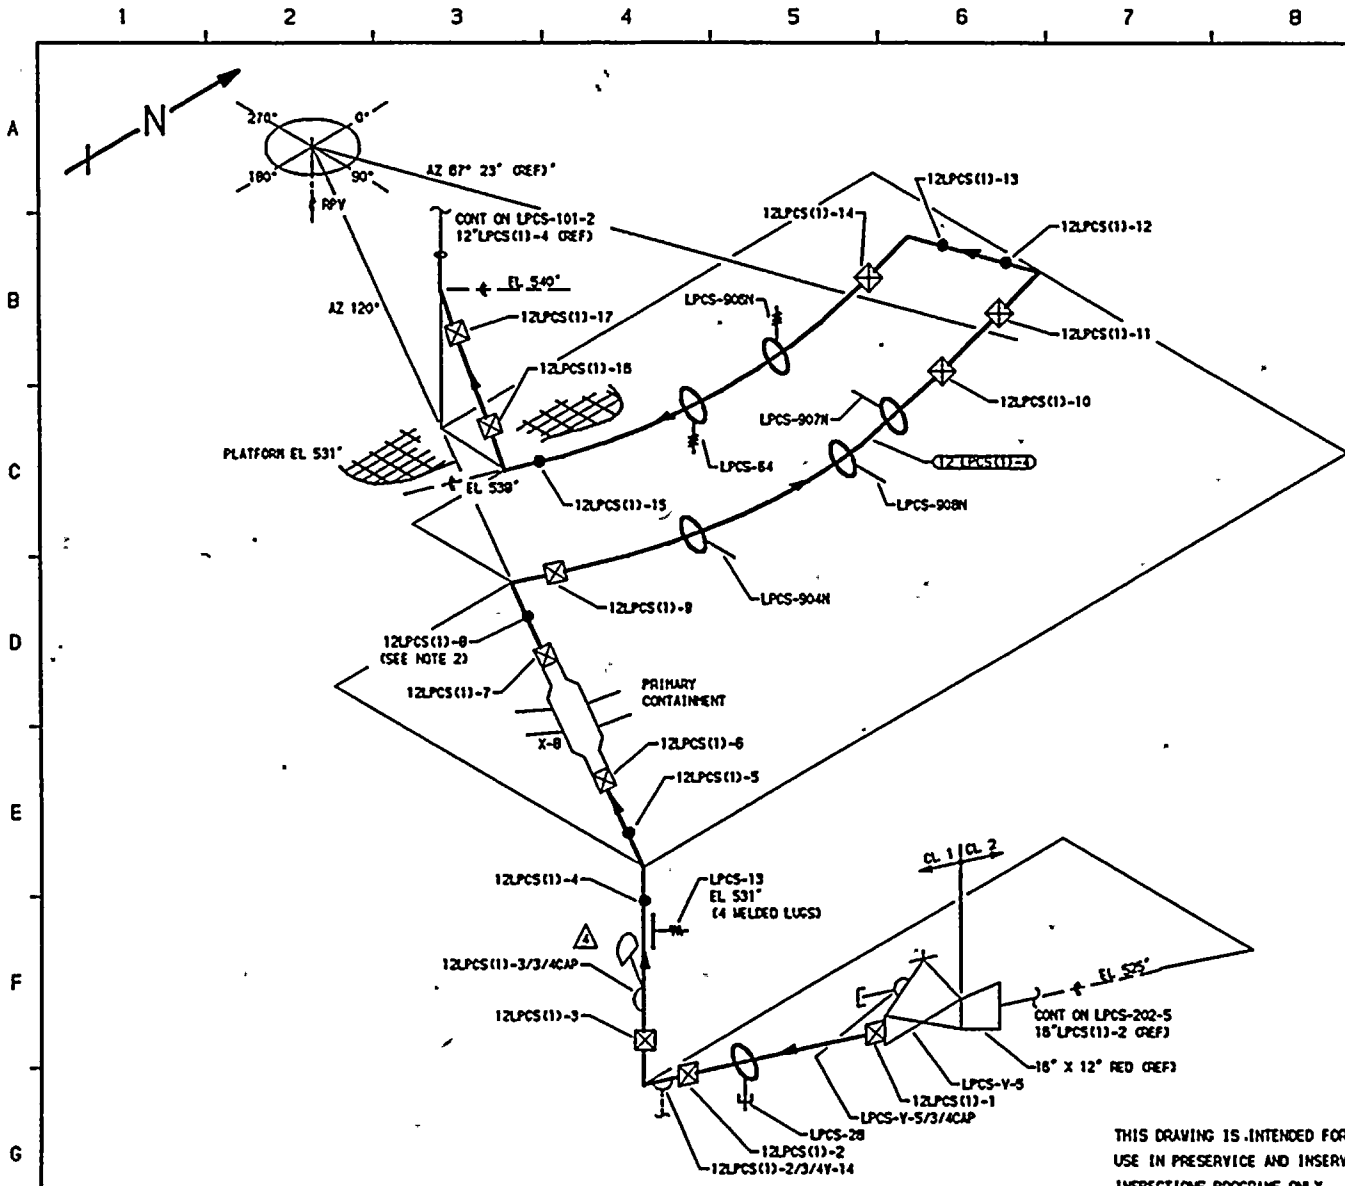

- NOTES:**
1. DELETED.
  2. PIPING SYSTEM 12"LPCS(11)-4 IS CONSTRUCTED OF SEAMLESS SCH 80 PIPE & FITTINGS EXCEPT FOR THE S R ELL ASSOCIATED WITH WELDS 12LPCS(11)-9 & 12LPCS(11)-9 WHICH IS SEAMLESS SCH 100. USE CAL BLOCKS SHOWN BELOW ACCORDINGLY.
  3. ACCESS TO WELDS 12LPCS(11)-5 & 12LPCS(11)-6 REQUIRES USE OF A LADDER.
  4. ACCESS TO WELD 12LPCS(11)-1 REQUIRES REMOVAL OF LPCS-28.
  5. LPCS-908N CHANGED FROM SNUBBER TO STRUT PER BOC-86-0525-5C-022.
  6. LPCS-905N & LPCS-909N WERE DELETED PER BOC-86-0525-5C-022.

- REFERENCES:**
- ISI - 220-2
  - BOVEE & CRAIG ISOMETRICS
  - LPCS-756-19.21 REV 12
  - LPCS-756-22.24 REV 12

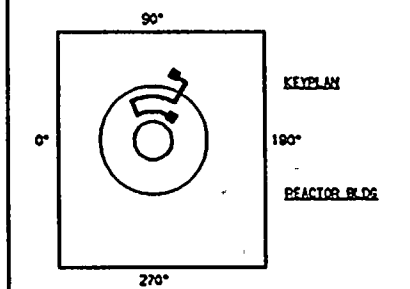

QUALITY CLASS, 1	ASME CODE CLASS, 1
ENGR, GA KUGLER	DATE, 10-28-78

WASHINGTON PUBLIC POWER  
SUPPLY SYSTEM  
RIDLAND, WASHINGTON 99352


MP-2  
WELD & COMPONENT  
IDENTIFICATION DIAGRAM

TITLE:  
LPCS DISCHARGE TO VESSEL

DWG NO. LPCS-101-1      REV 4

THIS DRAWING IS INTENDED FOR  
USE IN PRESERVICE AND INSERVICE  
INSPECTIONS PROGRAMS ONLY.


NO	DATE	REVISION	BY	CHKD	APVD	PIPING SYSTEM	NOM DIA (IND)	SCH	NOM WALL THK	MATERIAL SPECIFICATION	MATL TYPE	CAL BLOCK NO
4	6-7-94	DELETED NOTE 1, CAPPED CONN PER 85-0631-0A.	K-McA	DPR	DW							
3	12-9-92	ADDED ISI DWG REV. DWG LINE CONT. NOTE 3 & NOTE 4. ACQUIRED KEYPLAN & LOGS. DELETED UT-ME. RECORD.	K-McA	DPR	DRM							
2	9-26-83	ADDED SUPPORTS, NOTES 3 & 4, LUGS. DELETED 3/4 LOC.	K-McA	DPR	TFH	12"LPCS(11)-4	12	80	0.688	SA 106 GR B	CS	UT-17
1	7-17-79	ELBOW CHANGED TO SEAMLESS DOWNSTREAM OF 12LPCS(11)-8 PER 85-BURLY: 204 D-4.	K-McA	TFH	LFB	12"LPCS(11)-4	12	100	0.844	SA 106 GR B	CS	UT-18
0	11-27-78	ISSUED FOR USE (REDRAWN)	K-McA	DMP	LFB							
A	11-28-77	ISSUED FOR INFORMATION ONLY	K-McA	DMP	ENR							

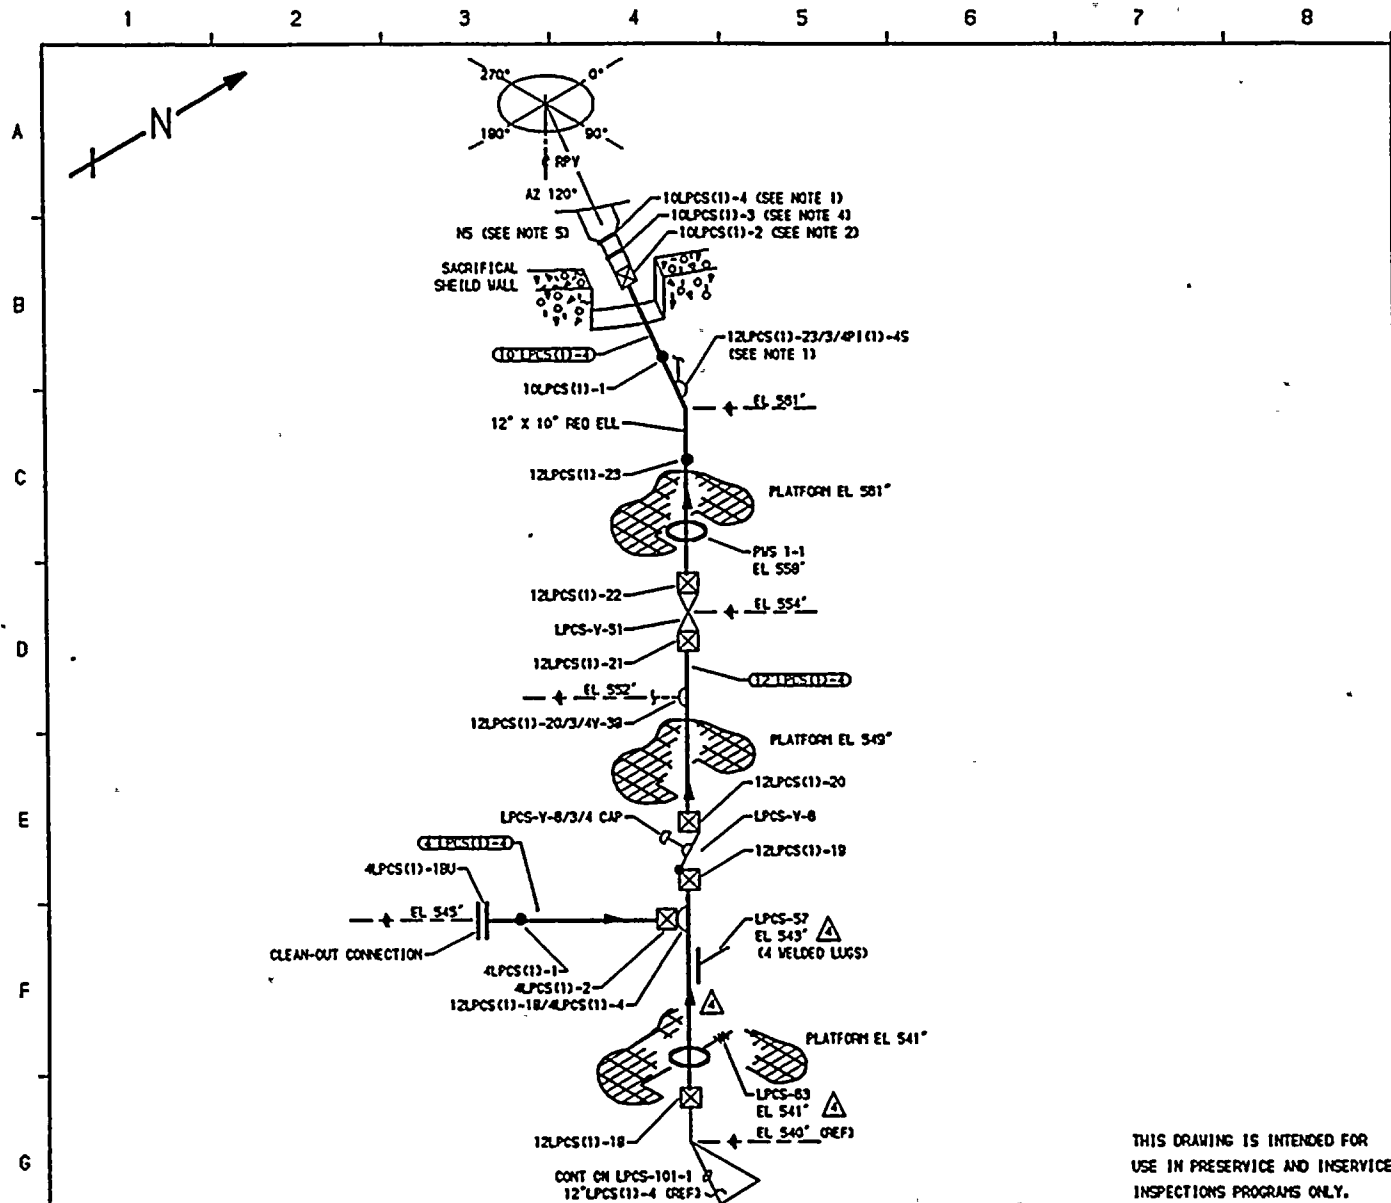

- NOTES.**
1. EXTEND VISUAL LEAKAGE EXAM THROUGH CONTAINMENT PENETRATION(C-780) THROUGH EXCESS FLOW CHECK VALVE TO INSTRUMENT TUBING CONNECTION.
  2. DISTANCE BETWEEN WELDS 10LPCS(1)-2 & 10LPCS(1)-3 IS LESS THAN 8".
  3. DISSIMILAR METAL WELD, CS TO INCO, USE CAL BLOCK UT-102.
  4. DISSIMILAR METAL WELD, INCO TO CS. USE CAL BLOCK UT-106.
  5. FOR NOZZLE ASSEMBLY DETAILS SEE RPV-109.
  6. LPCS-81 WAS DELETED PER EOC-88-0525-5C-022.

**REFERENCES.**

151 - 220-2  
 BOYEE & GRILL ISOMETRICS  
 LPCS-756-22.24 REV 12  
 LPCS-756-25.26 REV 8

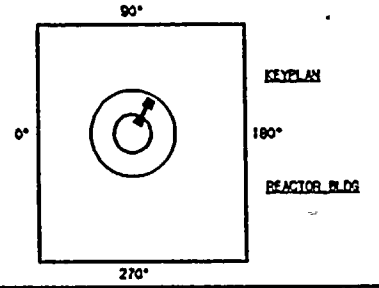

QUALITY CLASS, 1	ASME CODE CLASS, 1
ENGR, GA KUGLER	DRAWN, K-McA DATE, 10-31-77

WASHINGTON PUBLIC POWER  
**SUPPLY SYSTEM**  
 RICHLAND, WASHINGTON 99352


THIS DRAWING IS INTENDED FOR  
 USE IN PRESERVICE AND INSERVICE  
 INSPECTIONS PROGRAMS ONLY.

NO	DATE	REVISION	BY	CHKD	APVD	PIPING SYSTEM	NOM DIA (IN)	SCH	NOM WALL THK	MATERIAL SPECIFICATION	MATL TYPE	CAL BLOCK NO
5	6-7-94	MODIFIED NOTES 1 & 2.	K-McA	DPR	DW							
4	11-13-92	ADDED 15L OME REP, ONE LINE CONT, NOTE 6, ELEV & KEYPLAN, NO. 1118 LOGO, DELETED UT-48, RECDRAW	K-McA	DPR	DRV							
3	9-20-83	ADDED SUPPORTS, LUGS. 3/4LOC CAPPED.	K-McA	DPR	TFH							
2	11-5-80	ADDED NOTE 5 & AS NOTED.	K-McA	TFH	DWP	12"LPCS(1)-4	12	80	0.868	SA 106 GR B	CS	UT-17
1	1-10-79	REVISED REFERENCE TO NOTES 3 & 4.	K-McA	TFH	DWP	4"LPCS(1)-4	4	80	0.337	SA 106 GR B	CS	UT-30
0	11-27-78	ISSUED FOR USE (RECDRAW)	K-McA	DWP	LFB	10"LPCS(1)-4	10	80	0.594	SA 106 GR B	CS	UT-22
A	11-28-77	ISSUED FOR INFORMATION ONLY	K-McA	DWP	GLD							


WP-2  
 WELD & COMPONENT  
 IDENTIFICATION DIAGRAM

**TITLE:**  
 LPCS DISCHARGE TO VESSEL

DWG NO, **LPCS-101-2** REV 5

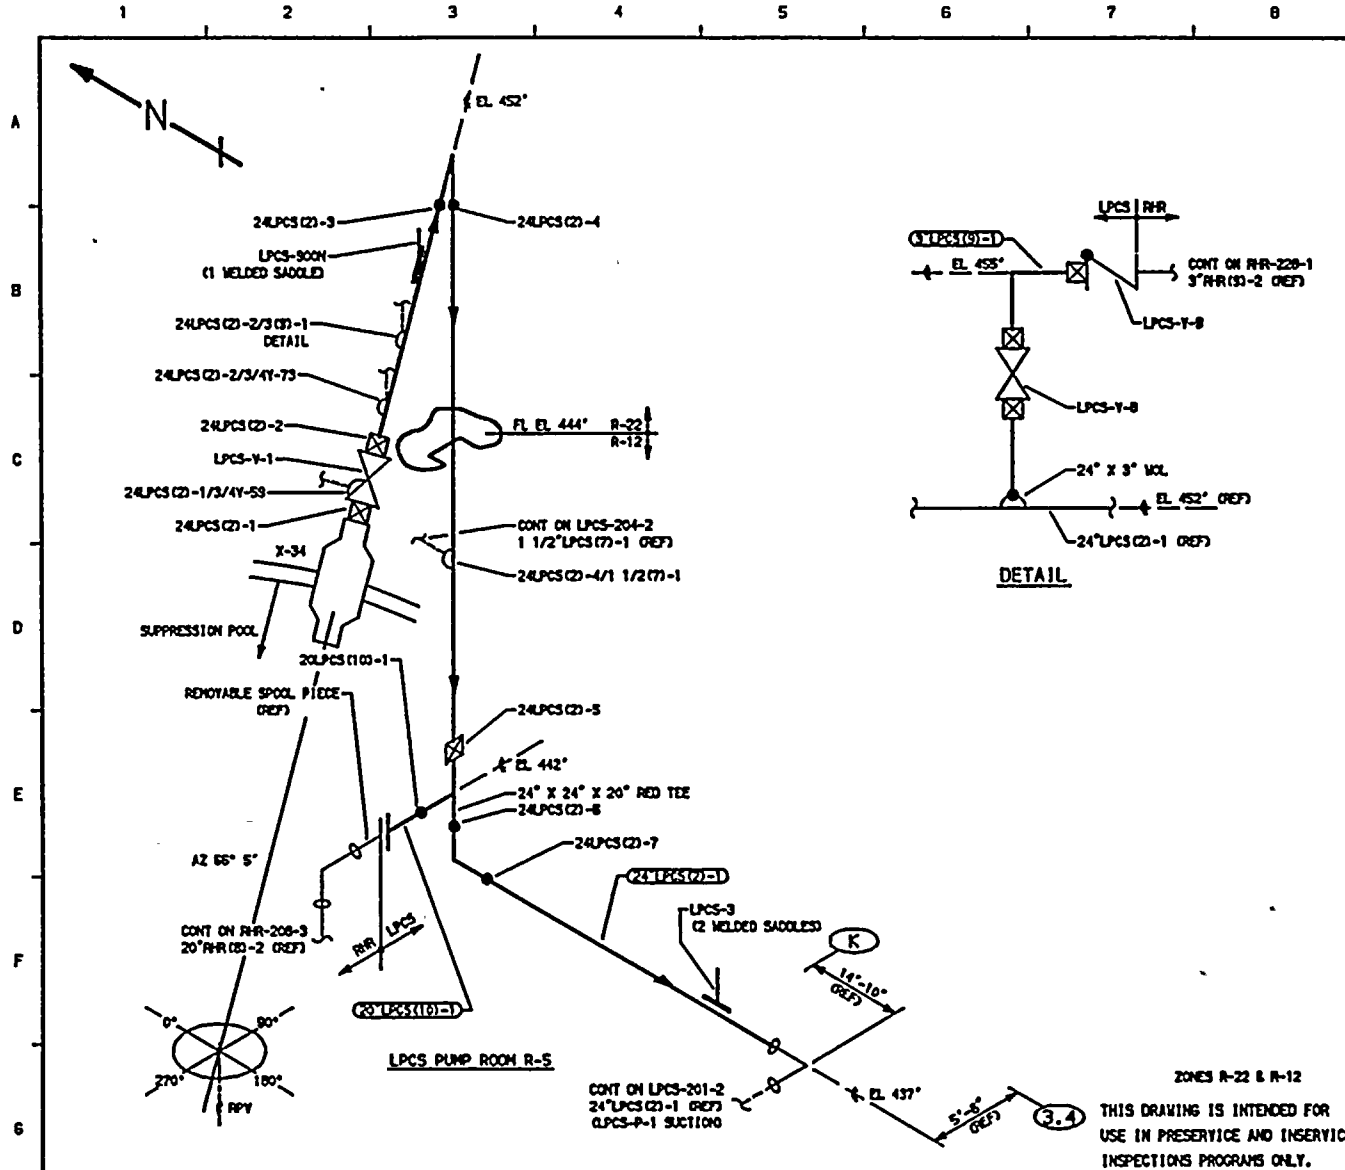

**REFERENCES:**  
 151 - 220-2  
 BOYCE & CRAIG ISOMETRIC  
 LPCS-758-1.2 REV 15

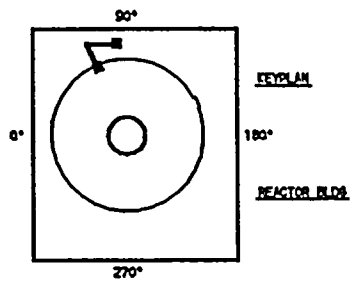

QUALITY CLASS, 1	ASME CODE CLASS, 2
ENGR, GA KUGLER	DATE, 8-18-78

WASHINGTON PUBLIC POWER  
 SUPPLY SYSTEM  
 RICHLAND, WASHINGTON 99352


ZONES R-22 & R-12  
 THIS DRAWING IS INTENDED FOR  
 USE IN PRESERVICE AND INSERVICE  
 INSPECTIONS PROGRAMS ONLY.

NO	DATE	REVISION	BY	CHKD	APVD	PIPING SYSTEM	NOM DIA (IN)	SCH	NOM WALL THK	MATERIAL SPECIFICATION	MATL TYPE	CAL BLOCK NO
3	11-13-82	MODIFIED KEYPLAN ADDED LOGO	K-MCA	DPR	DRW							
2	1-23-86	NUMBERED WELDS, ADDED CONT DWG, CAL BLOCK NUMBERS, 3" LPCS (2)-1, COLETED NOTES, REMAIN	K-MCA	DPR	TFH	24" LPCS (2)-1	24	STD	0.375	SA 106 GR B	CS	UT-50
1	10-13-83	ADDED 3/4 CONN, LPCS-300N, DELETED LPCS-4,5,6,7	K-MCA	DPR	TFH	20" LPCS (10)-1	20	STD	0.375	SA 106 GR B	CS	UT-45
0	12-22-78	ISSUED FOR USE	K-MCA	TFH	LFB	3" LPCS (3)-1	3	40	0.218	SA 106 GR B	CS	NA
A	10-3-78	ISSUED FOR INFORMATION ONLY	K-MCA	GAK	DMP							


WPP-2  
 WELD & COMPONENT  
 IDENTIFICATION DIAGRAM

TITLE:  
 LPCS SUPPRESSION POOL SUCTION

DWG NO, LPCS-201-1      REV 3

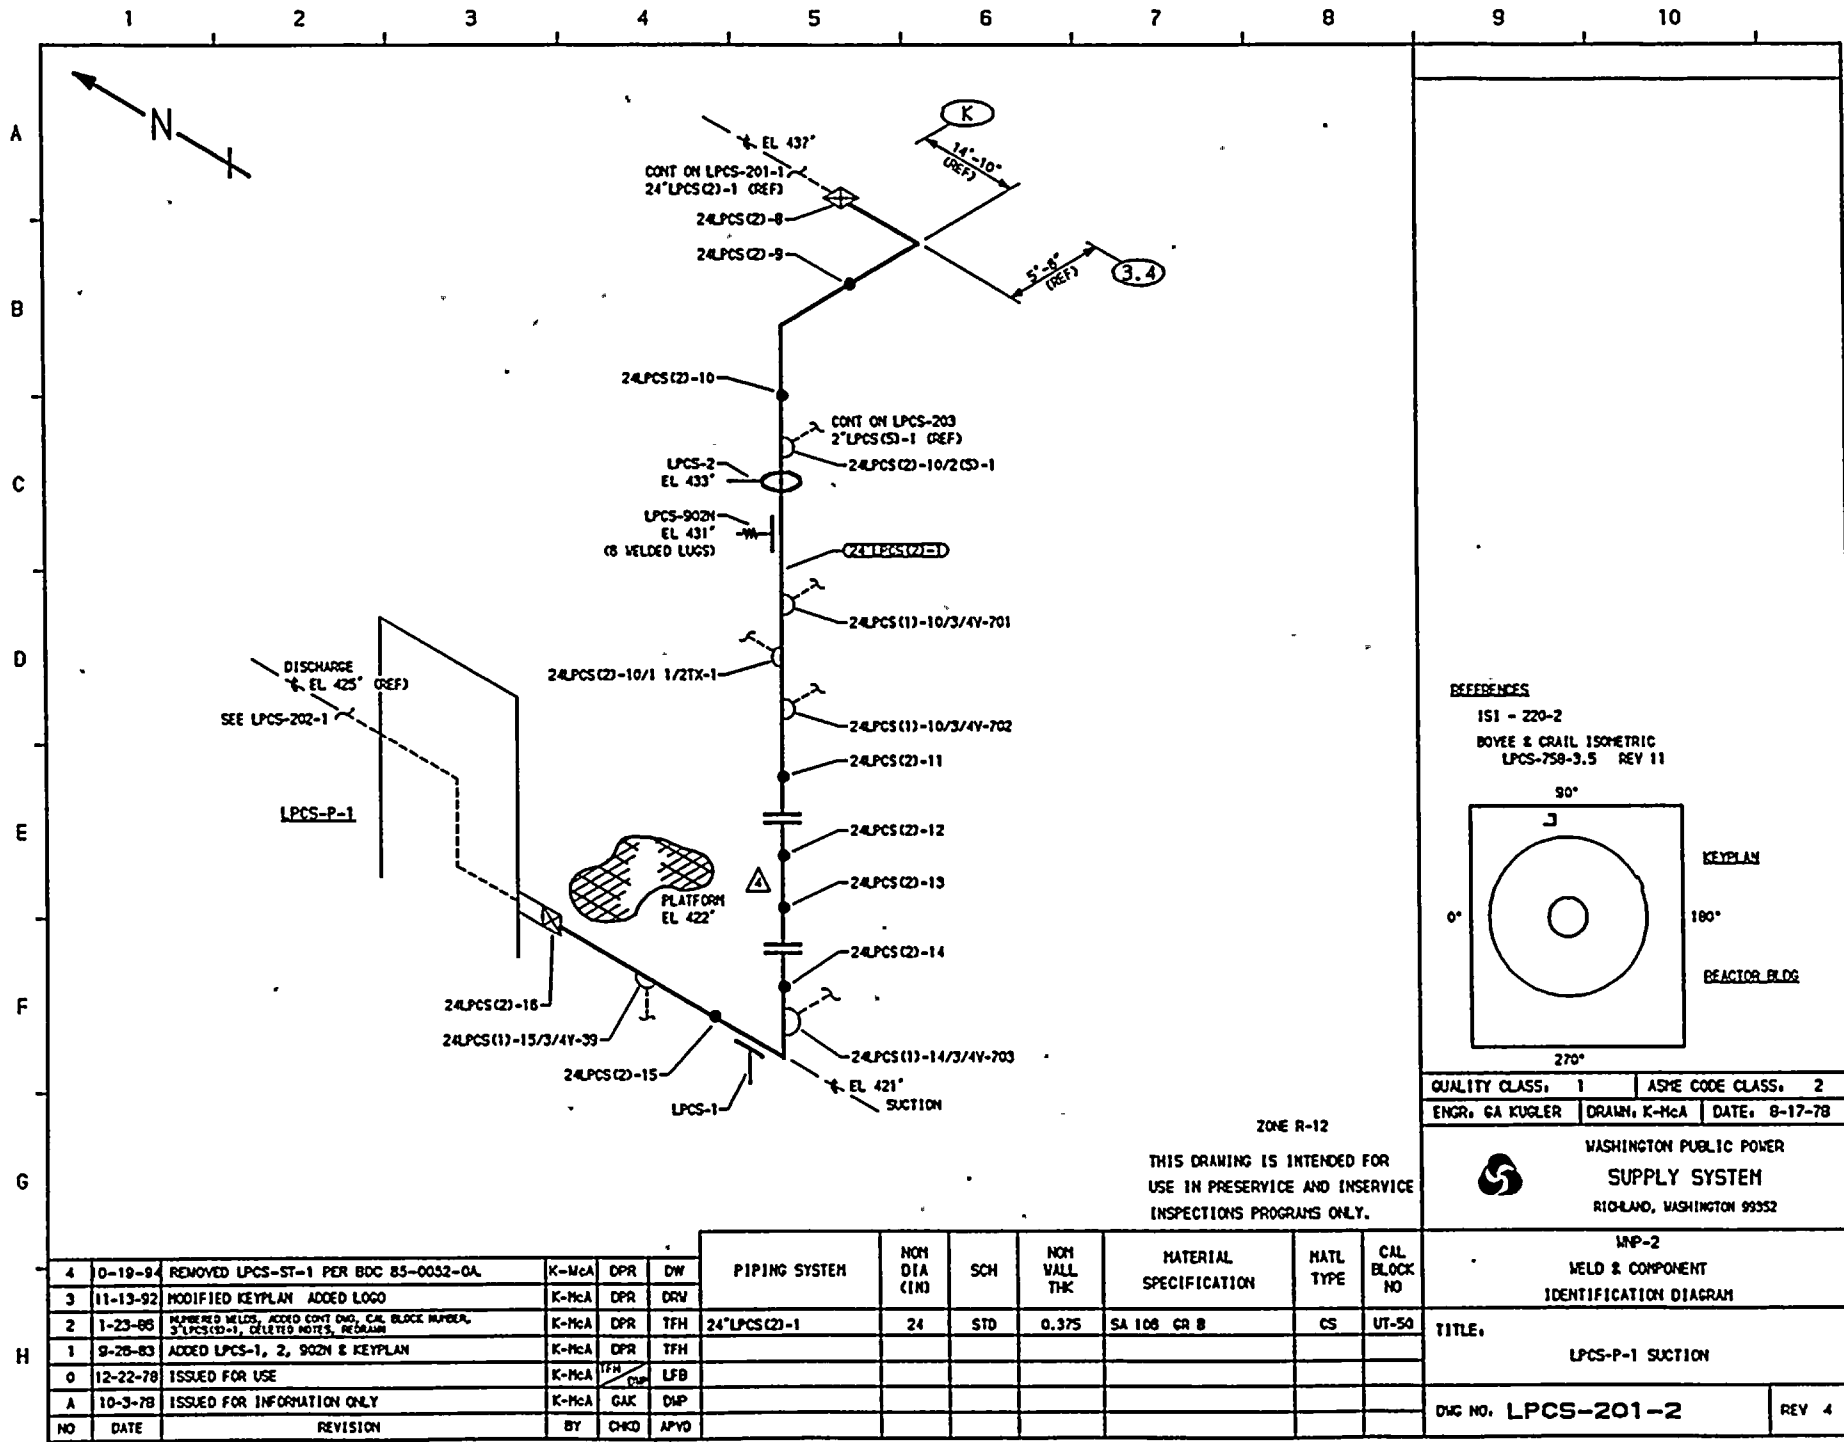

REFERENCES  
 ISI - Z20-2  
 BOYEE & CRAIL ISOMETRIC  
 LPCS-758-3.5 REV 11

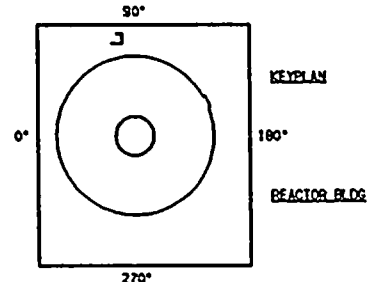

QUALITY CLASS, 1	ASME CODE CLASS, 2
ENGR, GA KUGLER	DATE, 8-17-78

WASHINGTON PUBLIC POWER  
 SUPPLY SYSTEM  
 RICHLAND, WASHINGTON 99352


THIS DRAWING IS INTENDED FOR  
 USE IN PRESERVICE AND INSERVICE  
 INSPECTIONS PROGRAMS ONLY.

ZONE R-12


NO	DATE	REVISION	BY	CHKD	APVD	PIPING SYSTEM	NOM DIA (IN)	SCH	NOM WALL THK	MATERIAL SPECIFICATION	MATL TYPE	CAL BLOCK NO
4	0-19-84	REMOVED LPCS-ST-1 PER BDC 85-0052-0A.	K-McA	DPR	DW							
3	11-13-92	MODIFIED KEYPLAN ADDED LOGO	K-McA	DPR	DRV							
2	1-23-85	NUMBERED WELDS, ADDED CONT DIA, CAL BLOCK NUMBER, 3" LPCS(CS)-1, DELETED NOTES, REDRAWN	K-McA	DPR	TFH	24"LPCS(2)-1	24	STD	0.375	SA 106 GR B	CS	UT-50
1	9-28-83	ADDED LPCS-1, 2, 902N & KEYPLAN	K-McA	DPR	TFH							
0	12-22-78	ISSUED FOR USE	K-McA	DPR	LFB							
A	10-3-78	ISSUED FOR INFORMATION ONLY	K-McA	GAK	DHP							
NO	DATE	REVISION	BY	CHKD	APVD							

INP-2  
 WELD & COMPONENT  
 IDENTIFICATION DIAGRAM  
 TITLE, LPCS-P-1 SUCTION  
 DWG NO. LPCS-201-2 REV 4



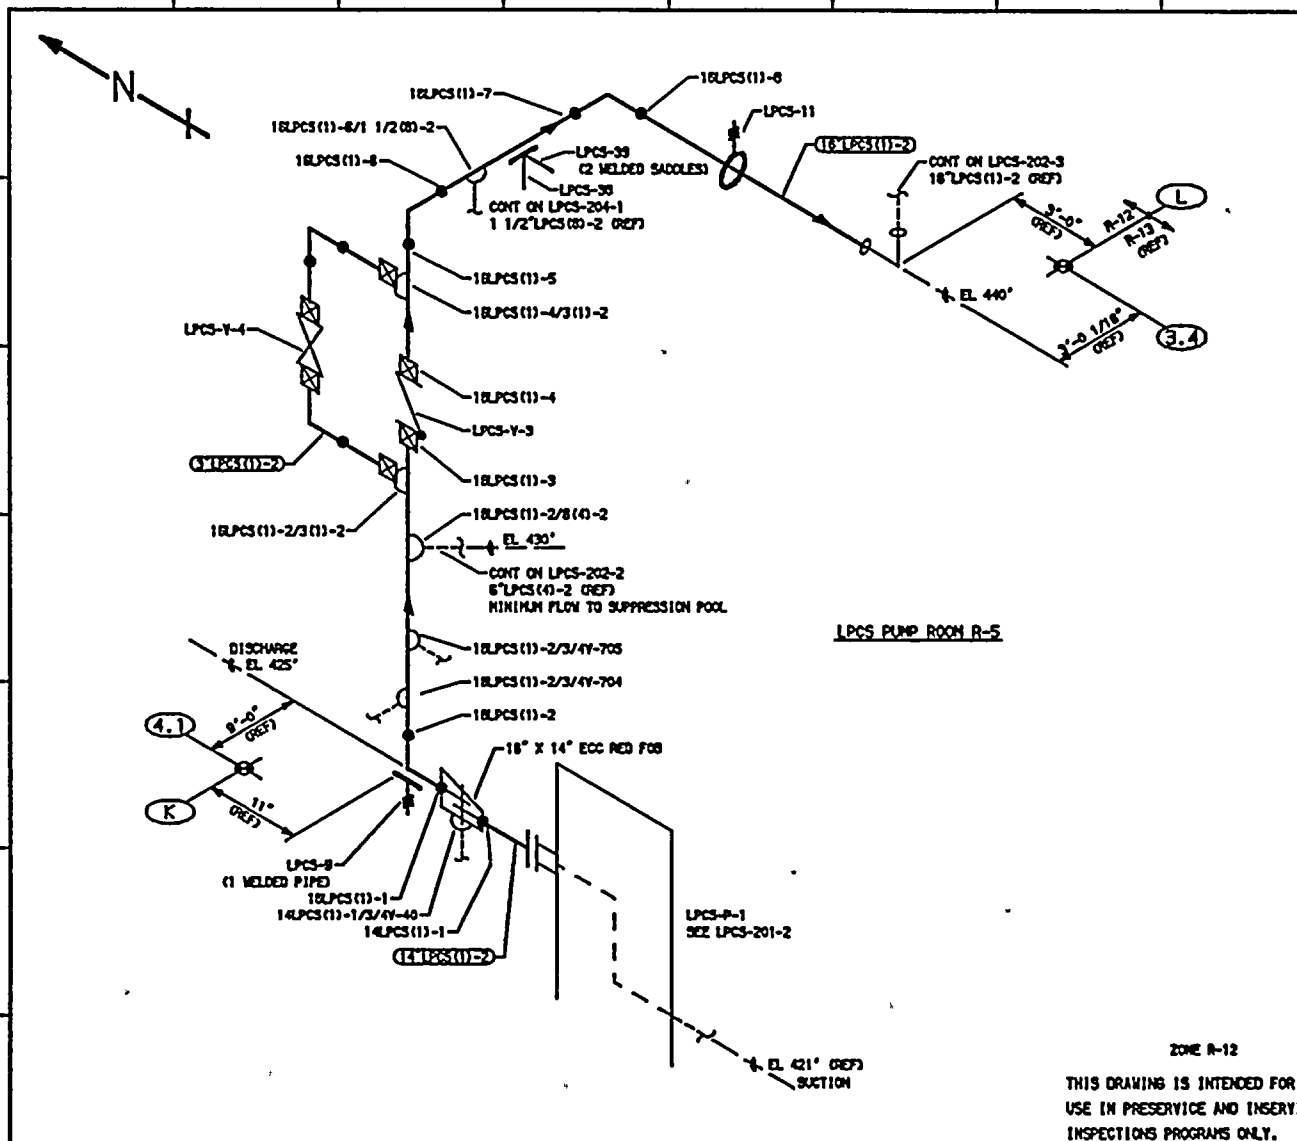

REFERENCES:  
 ISI - 220-2  
 BOYCE & CRAIG ISOMETRIC  
 LPCS-758-1.4 REV 13

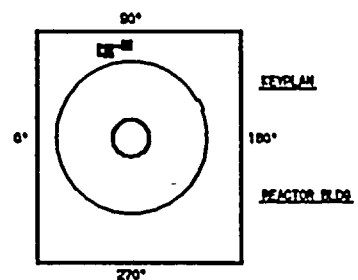

QUALITY CLASS: 1 ASME CODE CLASS: 2  
 ENGR: GA KUGLER DRAWN: K-McA DATE: 8-17-78




WASHINGTON PUBLIC POWER  
 SUPPLY SYSTEM  
 RICHLAND, WASHINGTON 99352

ZONE R-12  
 THIS DRAWING IS INTENDED FOR  
 USE IN PRESERVICE AND INSERVICE  
 INSPECTIONS PROGRAMS ONLY.


NO	DATE	REVISION	BY	CHKD	APVD	PIPING SYSTEM	NOM DIA (IN)	SCH	NOM WALL THK	MATERIAL SPECIFICATION	MATL TYPE	CAL BLOCK NO
3	11-13-82	MODIFIED KEYPLAN ADDED LOGO	K-McA	DPR	DRW							
2	1-23-86	ADDED 3 LPCS(11)-2, CONT DIA, CAL BLOCK NUMBERS, DELETED NOTES, RE-DRAWN.	K-McA	DPR	TFH	18" LPCS(11)-2	18	STD	0.375	SA 106 GR B	CS	UT-39
1	9-26-83	NUMBERED WELDS, ADDED NOTE 3, 14" LPCS(11)-2, DEL LPCS-10	K-McA	DPR	TFH	14" LPCS(11)-1	14	STD	0.375	SA 106 GR B	CS	UT-39
0	12-22-78	ISSUED FOR USE	K-McA	TFH	LFB	3" LPCS(11)-2	3	40	0.218	SA 106 GR B	CS	NA
A	10-3-78	ISSUED FOR INFORMATION ONLY	K-McA	GAK	DHP							

WPP-2  
 WELD & COMPONENT  
 IDENTIFICATION DIAGRAM  
 TITLE:  
 LPCS-P-1 DISCHARGE  
 DWG NO: LPCS-202-1  
 REV 3

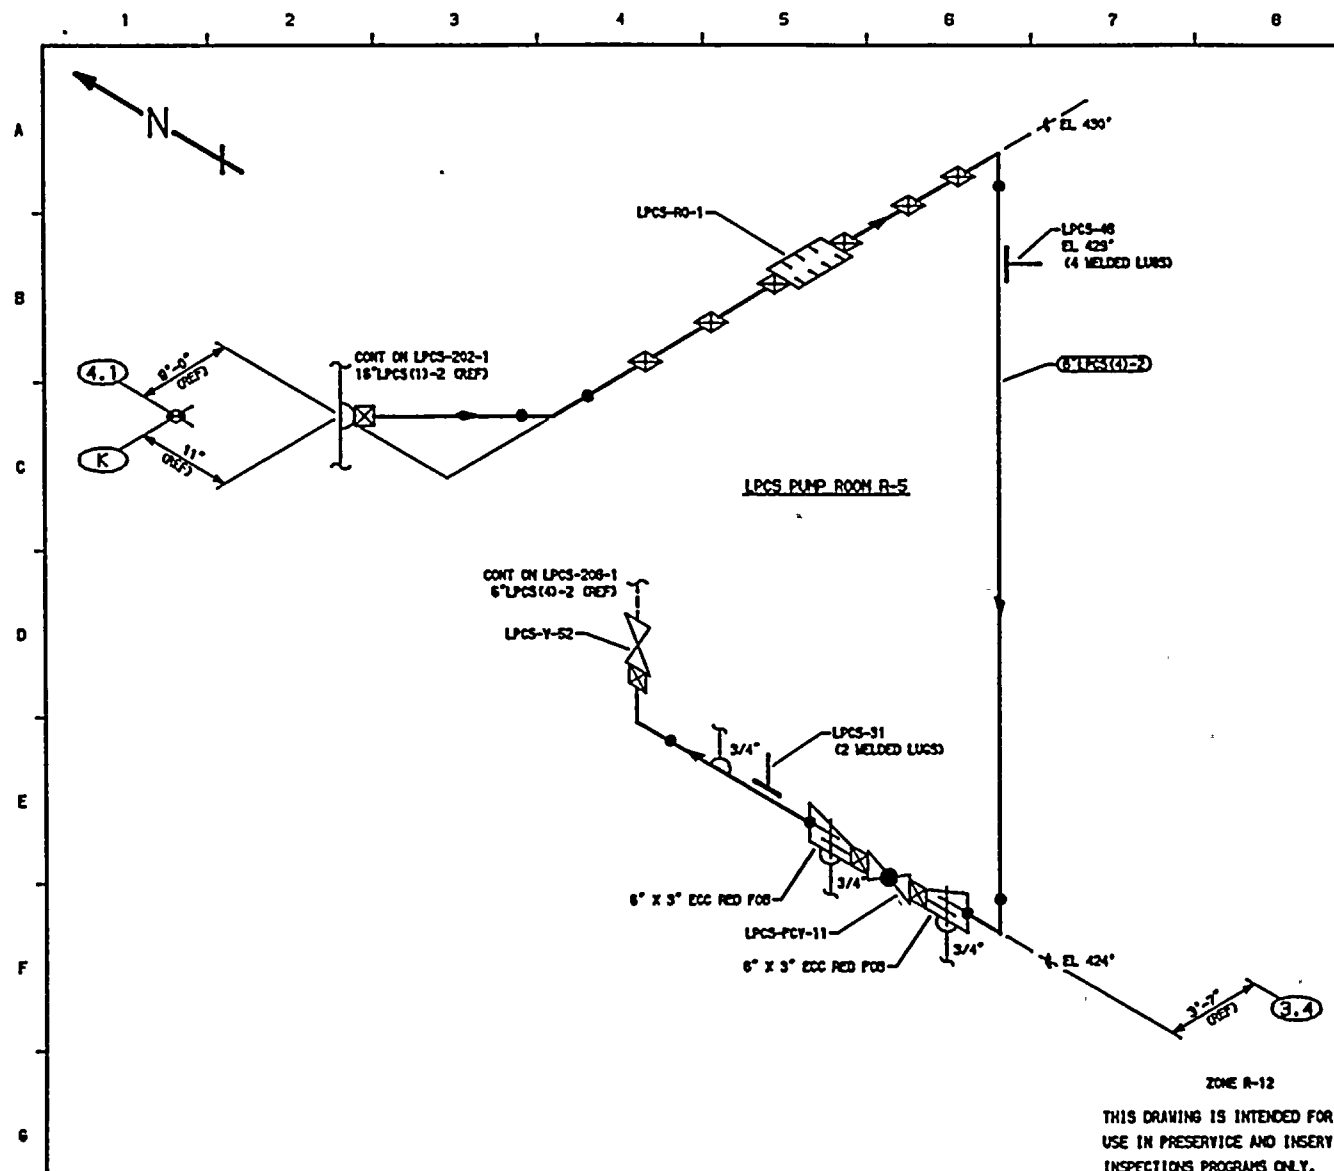

- NOTES:**
1. THIS DRAWING IDENTIFIES PIPING AND COMPONENTS SUBJECT TO A VISUAL EXAM FOR EVIDENCE OF LEAKAGE DURING SYSTEM HYDRO OR OPERABILITY TESTS. TESTS ARE TO BE CONDUCTED PER THE REQUIREMENTS OF ASME SECTION XI, PARAGRAPH IWA-5000.
  2. FOR BRANCH PIPING 4" NOM. OR LESS CONNECTION SHOWN IN DASHED LINES EXTEND VISUAL LEAKAGE EXAM THROUGH THE OUTERMOST NORMALLY CLOSED NUCLEAR CLASS VALVE, OR UNTIL TRANSITION TO INSTRUMENT TUBING, UNLESS OTHERWISE NOTED.

- REFERENCES:**
- ISI - 220-2
  - BOYCE & ORATEL ISOMETRIC LPCS-758-5.7 REV 14

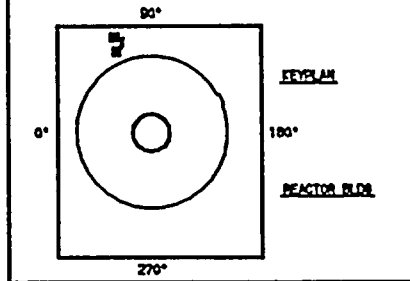

QUALITY CLASS, 1	ASME CODE CLASS, 2
ENGR: GA KUGLER	DATE: 8-17-78

WASHINGTON PUBLIC POWER  
**SUPPLY SYSTEM**  
 RICHLAND, WASHINGTON 99352

WPP-2  
 WELD & COMPONENT  
 IDENTIFICATION DIAGRAM

TITLE:  
 LPCS MINIMUM FLOW LINE TO SUPPRESSION POOL

DWG NO. LPCS-202-2

REV 3


THIS DRAWING IS INTENDED FOR  
 USE IN PRESERVICE AND INSERVICE  
 INSPECTIONS PROGRAMS ONLY.

NO	DATE	REVISION	BY	CHKD	APVD	PIPING SYSTEM	NOM DIA (IND)	SCH	NOM WALL THK	MATERIAL SPECIFICATION	MATL TYPE	CAL BLOCK NO
3	11-13-82	MODIFIED KEYPLAN ADDED LOGO	K-McA	DPR	DRY							
2	1-23-86	ADDED LPCS-R0-1, 3/4" CONN IN E-5, CONT DWG, REDRAWN	K-McA	DPR	TFH	8"LPCS(O-2)	8	STD	0.280	SA 106 GR B	CS	NA
1	9-26-83	ADDED LPCS-31 ADDED KEYPLAN	K-McA	DPR	TFH							
0	12-22-78	ISSUED FOR USE	K-McA	TFH	LFB							
A	10-3-78	ISSUED FOR INFORMATION ONLY	K-McA	GAK	DMP							








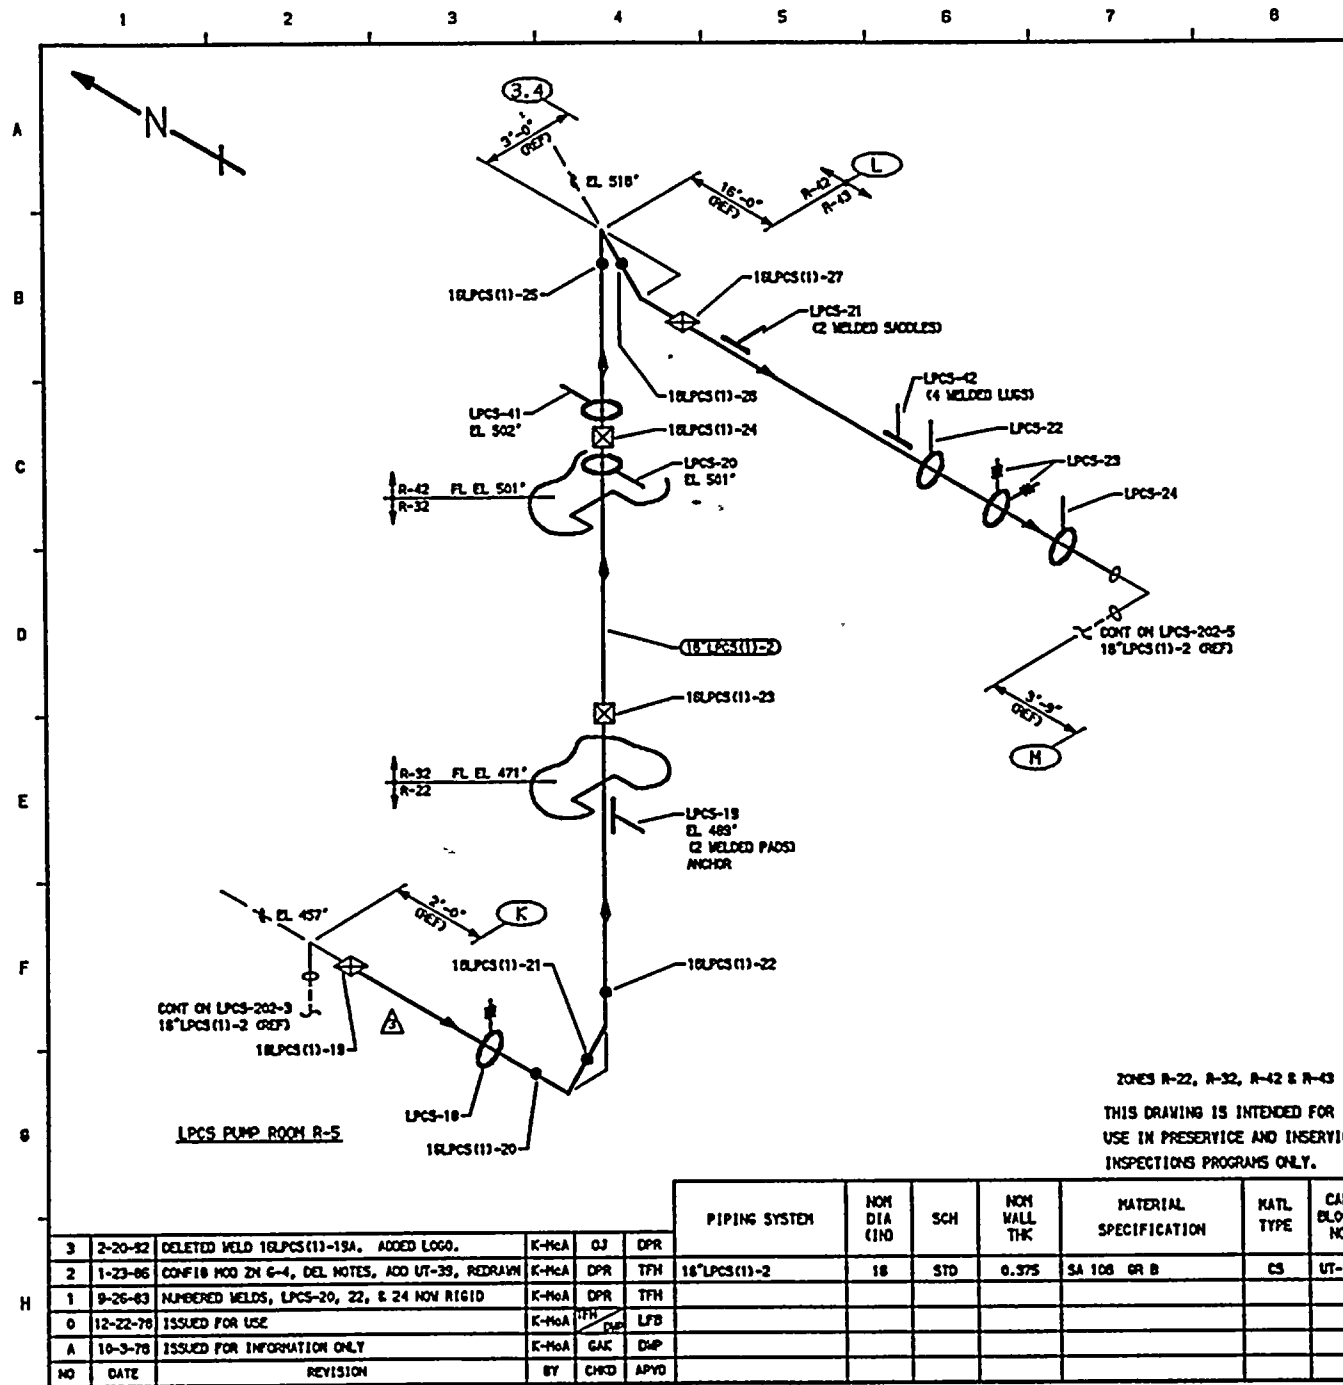

REFERENCES:  
 151 - 220-2  
 BOYCE & CRAIG ISOMETRIC  
 LPCS-756-11.15 REV 7

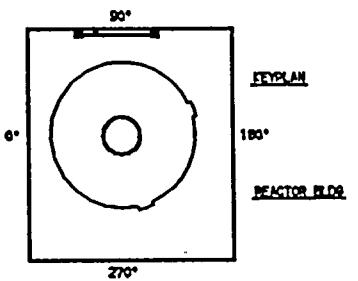


QUALITY CLASS, 1 ASME CODE CLASS, 2  
 ENGR, GA KUGLER DRAWN, K-McA DATE, 8-21-78


WASHINGTON PUBLIC POWER  
 SUPPLY SYSTEM  
 RICHLAND, WASHINGTON 99352

ZONES R-22, R-32, R-42 & R-43  
 THIS DRAWING IS INTENDED FOR  
 USE IN PRESERVICE AND INSERVICE  
 INSPECTIONS PROGRAMS ONLY.


NO	DATE	REVISION	BY	CHKD	APVD	PIPING SYSTEM	NOM DIA (IN)	SCH	NOM WALL THK	MATERIAL SPECIFICATION	NATL TYPE	CAL BLOCK NO
3	2-20-82	DELETED WELD 18LPCS(11)-19A. ADDED LOGO.	K-McA	GJ	DPR	18"LPCS(11)-2	18	STD	0.375	SA 106 GR B	CS	UT-39
2	1-23-86	CONF 18 MOD ZH G-4, DEL NOTES, ADD UT-39, REDRAWN	K-McA	DPR	TFH							
1	9-26-83	NUMBERED WELDS, LPCS-20, 22, & 24 NOW RIGID	K-McA	DPR	TFH							
0	12-22-76	ISSUED FOR USE	K-McA	TFH	LFB							
A	10-3-78	ISSUED FOR INFORMATION ONLY	K-McA	GAK	DWP							

 WMP-2  
 WELD & COMPONENT  
 IDENTIFICATION DIAGRAM  
 TITLE: LPCS-PUMP-1 DISCHARGE  
 DWG NO, LPCS-202-4 REV 3



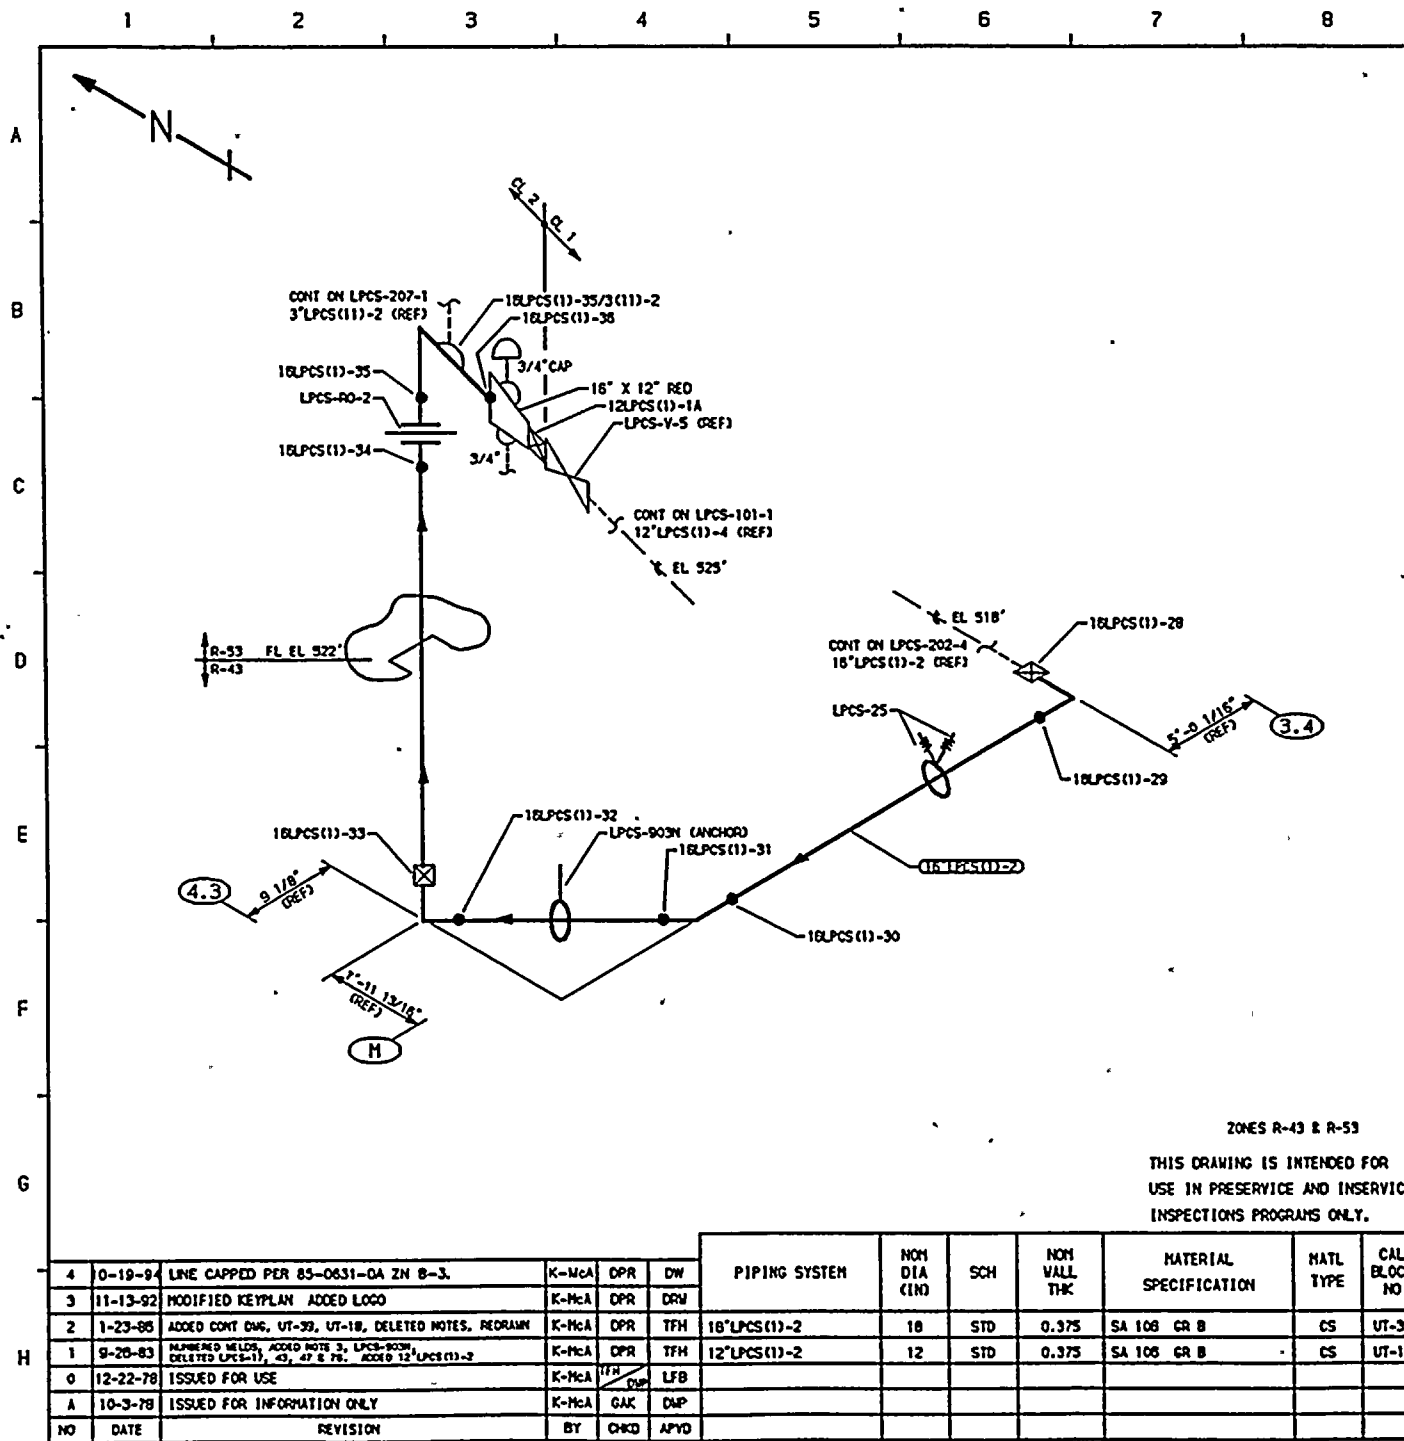

REFERENCES:  
 ISI - 220-2  
 BOYEE & CRAIL ISOMETRICS  
 LPCS-756-11.15 REV 7  
 LPCS-756-18.18 REV 14

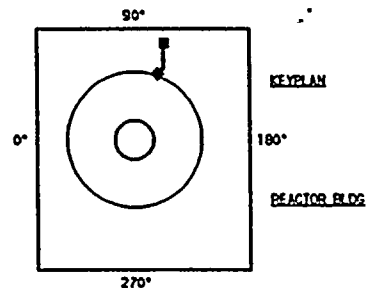

QUALITY CLASS. 1 ASME CODE CLASS. 2  
 ENGR. GA KUGLER DRAWN: K-McA DATE: 8-21-78


WASHINGTON PUBLIC POWER  
 SUPPLY SYSTEM  
 RICHLAND, WASHINGTON 99352


WNP-2  
 WELD & COMPONENT  
 IDENTIFICATION DIAGRAM  
 TITLE:  
 LPCS-PUMP-1 DISCHARGE  
 DWG NO. LPCS-202-5 REV 4

ZONES R-43 & R-53


THIS DRAWING IS INTENDED FOR  
 USE IN PRESERVICE AND INSERVICE  
 INSPECTIONS PROGRAMS ONLY.

NO	DATE	REVISION	BY	CHKD	APVD	PIPING SYSTEM	NOM DIA (IN)	SCH	NOM WALL THK	MATERIAL SPECIFICATION	MATL TYPE	CAL BLOCK NO
4	0-19-84	LINE CAPPED PER 85-0631-0A ZN B-3.	K-McA	DPR	DW							
3	11-13-82	MODIFIED KEYPLAN ADDED LOGO	K-McA	DPR	DRW							
2	1-23-85	ADDED CONT DWG, UT-39, UT-18, DELETED NOTES. REDRAWN	K-McA	DPR	TFH	16" LPCS(1)-2	16	STD	0.375	SA 106 GR B	CS	UT-39
1	9-20-83	ALIGNED WELDS, ADDED NOTE 3, LPCS-903M DELETED LPCS(1)-1, -2, -47 & 48. ADDED 12" LPCS(1)-2	K-McA	DPR	TFH	12" LPCS(1)-2	12	STD	0.375	SA 106 GR B	CS	UT-18
0	12-22-78	ISSUED FOR USE	K-McA	TFH	DPR							
A	10-3-78	ISSUED FOR INFORMATION ONLY	K-McA	GAK	DWP							
NO	DATE	REVISION	BY	CHKD	APVD							

 

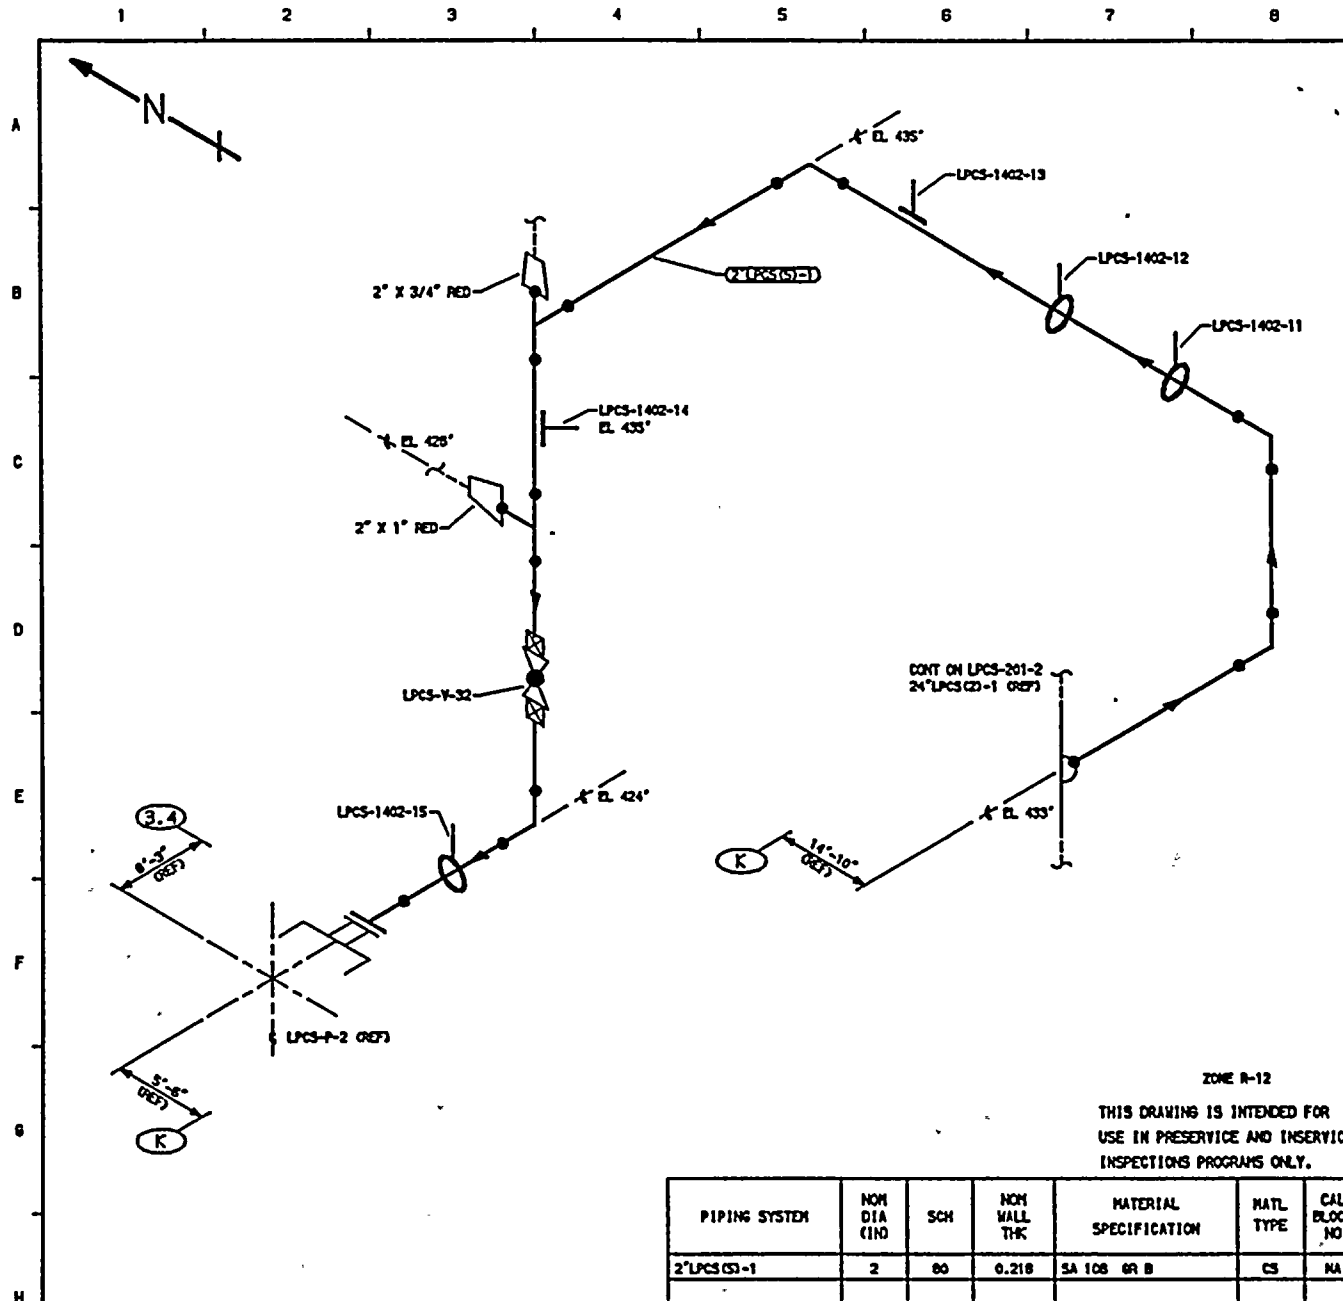

REFERENCES:  
 151 - 220-2  
 BOYCE & CRAIG ISOMETRIC  
 LPCS-1402-1 REV 12

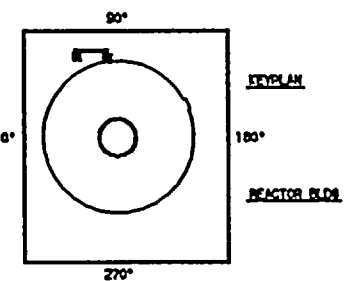

QUALITY CLASS, 1	ASME CODE CLASS, 2
ENGR, K-McANDREW	DRAWN, K-McA DATE, 5-20-65

WASHINGTON PUBLIC POWER  
 SUPPLY SYSTEM  
 RICHLAND, WASHINGTON 99352

WP-2  
 WELD & COMPONENT  
 IDENTIFICATION DIAGRAM


TITLE:  
 WATER LEG PUMP LPCS-P-2 SUCTION  
 FROM LPCS-P-1 SUCTION LINE

DWG NO. LPCS-203 REV 1


ZONE R-12  
 THIS DRAWING IS INTENDED FOR  
 USE IN PRESERVICE AND INSERVICE  
 INSPECTIONS PROGRAMS ONLY.

PIPING SYSTEM	NOM DIA (INO)	SCH	NOM WALL THK	MATERIAL SPECIFICATION	MATL TYPE	CAL BLOCK NO
2" LPCS CS-1	2	80	0.218	SA 106 GR B	CS	NA

NO	DATE	REVISION	BY	CHKD	APVD
1	11-13-62	MODIFIED KEYPLAN ADDED LOGO	K-McA	DPR	DRM
0	1-23-65	ISSUED FOR USE	K-McA	DPR	TFH

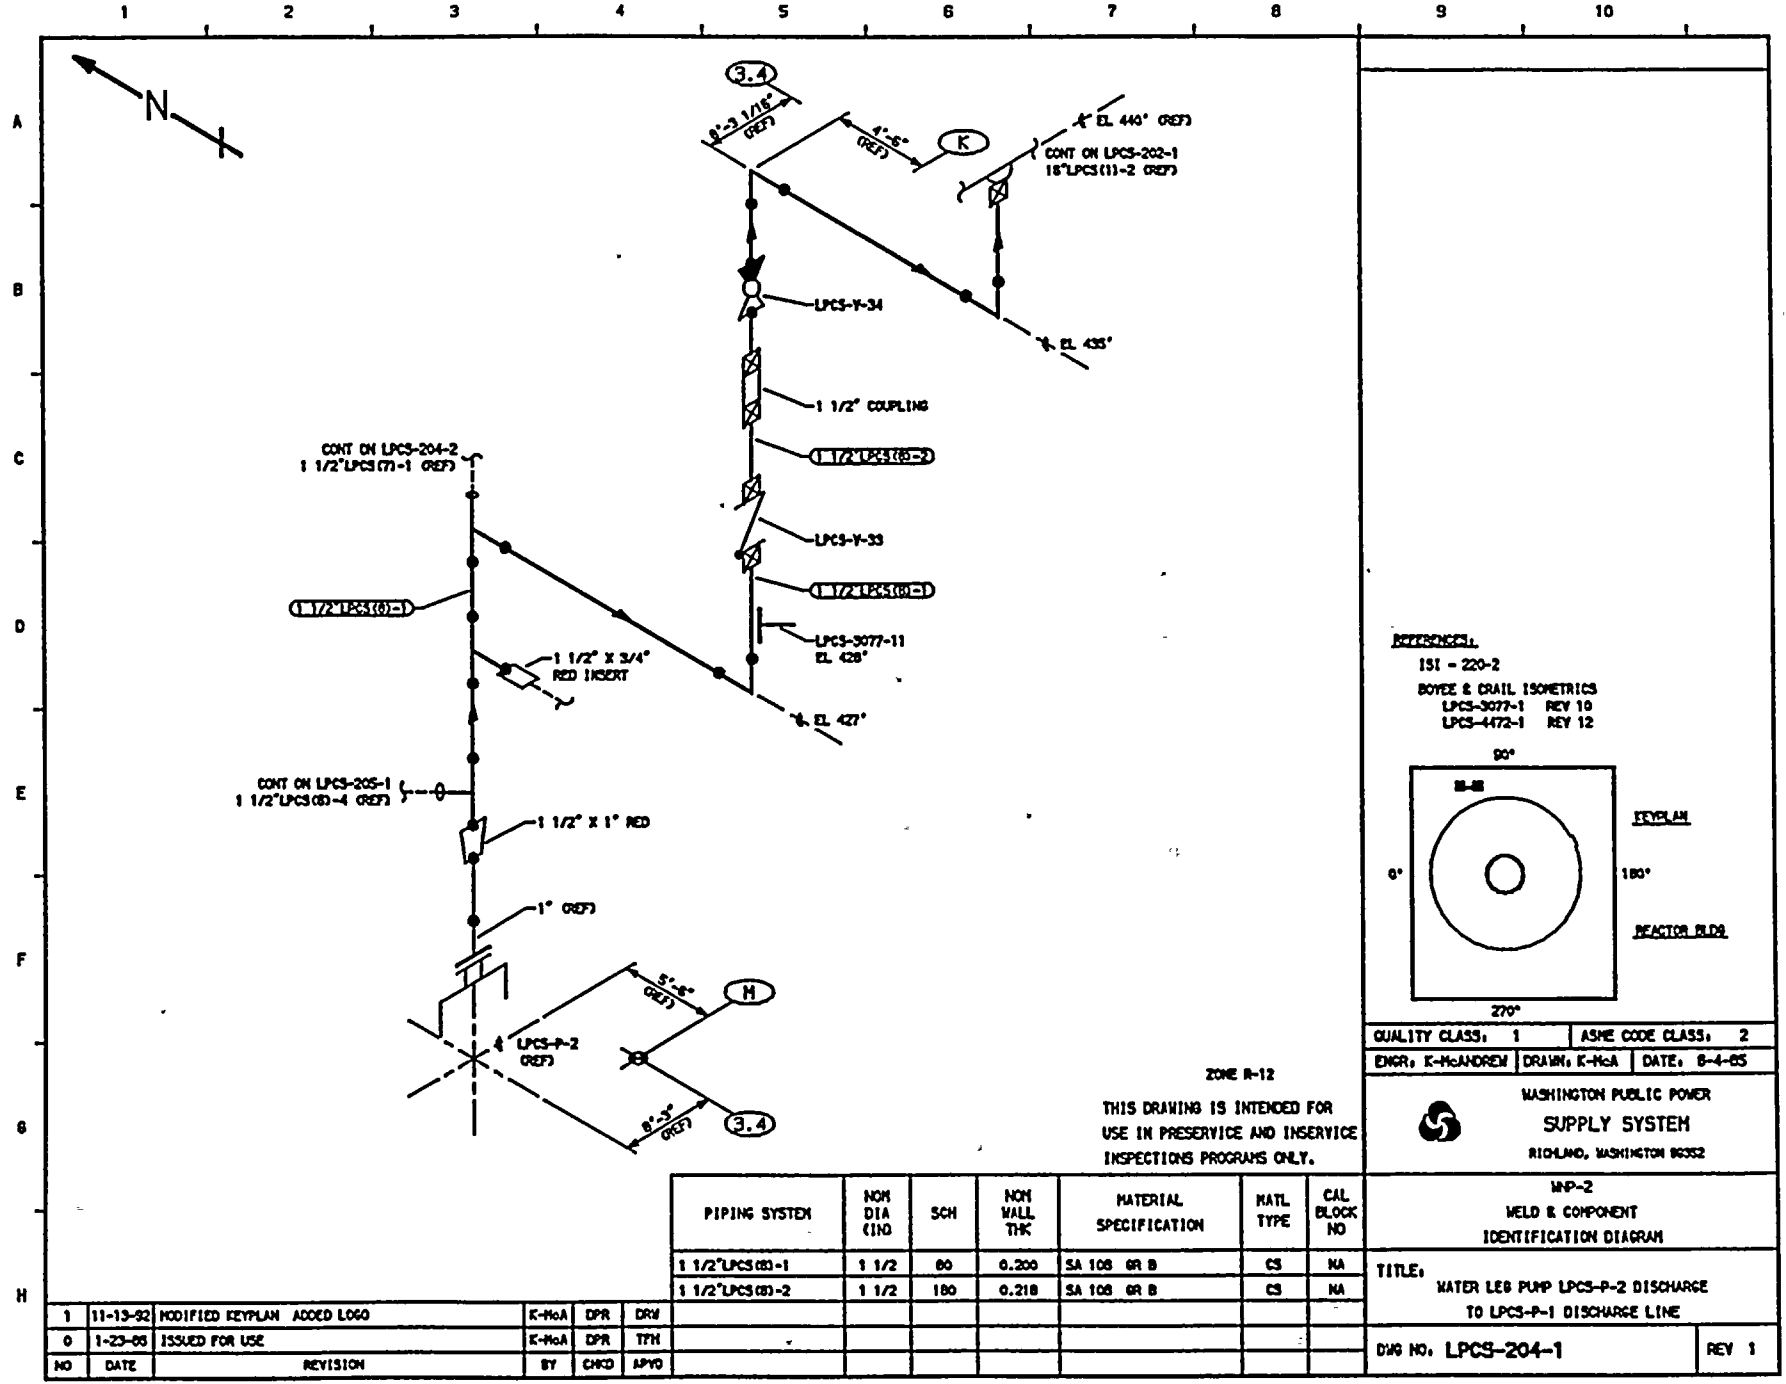

**REFERENCES**  
 ISI - 220-2  
 BOYCE & CRILL ISOMETRICS  
 LPCS-3077-1 REV 10  
 LPCS-4472-1 REV 12

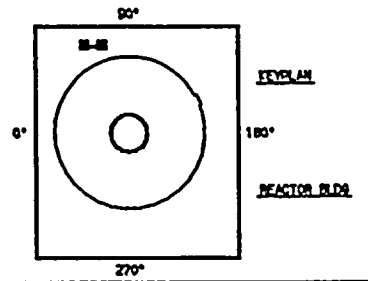

QUALITY CLASS: 1	ASME CODE CLASS: 2
ENGR: K-McANDREW	DATE: 8-4-65

WASHINGTON PUBLIC POWER  
**SUPPLY SYSTEM**  
 RICHLAND, WASHINGTON 99352

**WPP-2  
 WELD & COMPONENT  
 IDENTIFICATION DIAGRAM**

**TITLE:**  
 WATER LEG PUMP LPCS-P-2 DISCHARGE  
 TO LPCS-P-1 DISCHARGE LINE


DWG NO. **LPCS-204-1**      REV 1

ZONE R-12  
 THIS DRAWING IS INTENDED FOR  
 USE IN PRESERVICE AND INSERVICE  
 INSPECTIONS PROGRAMS ONLY.


PIPING SYSTEM	NOM DIA (IN)	SCH	NOM WALL THK	MATERIAL SPECIFICATION	MATL TYPE	CAL BLOCK NO
1 1/2" LPCS (B)-1	1 1/2	80	0.200	SA 106 GR B	CS	NA
1 1/2" LPCS (B)-2	1 1/2	180	0.218	SA 106 GR B	CS	NA

NO	DATE	REVISION	BY	CHKD	APVD
1	11-13-62	MODIFIED KEYPLAN ADDED LOGO	K-McA	DPR	DRW
0	1-23-65	ISSUED FOR USE	K-McA	DPR	TPH



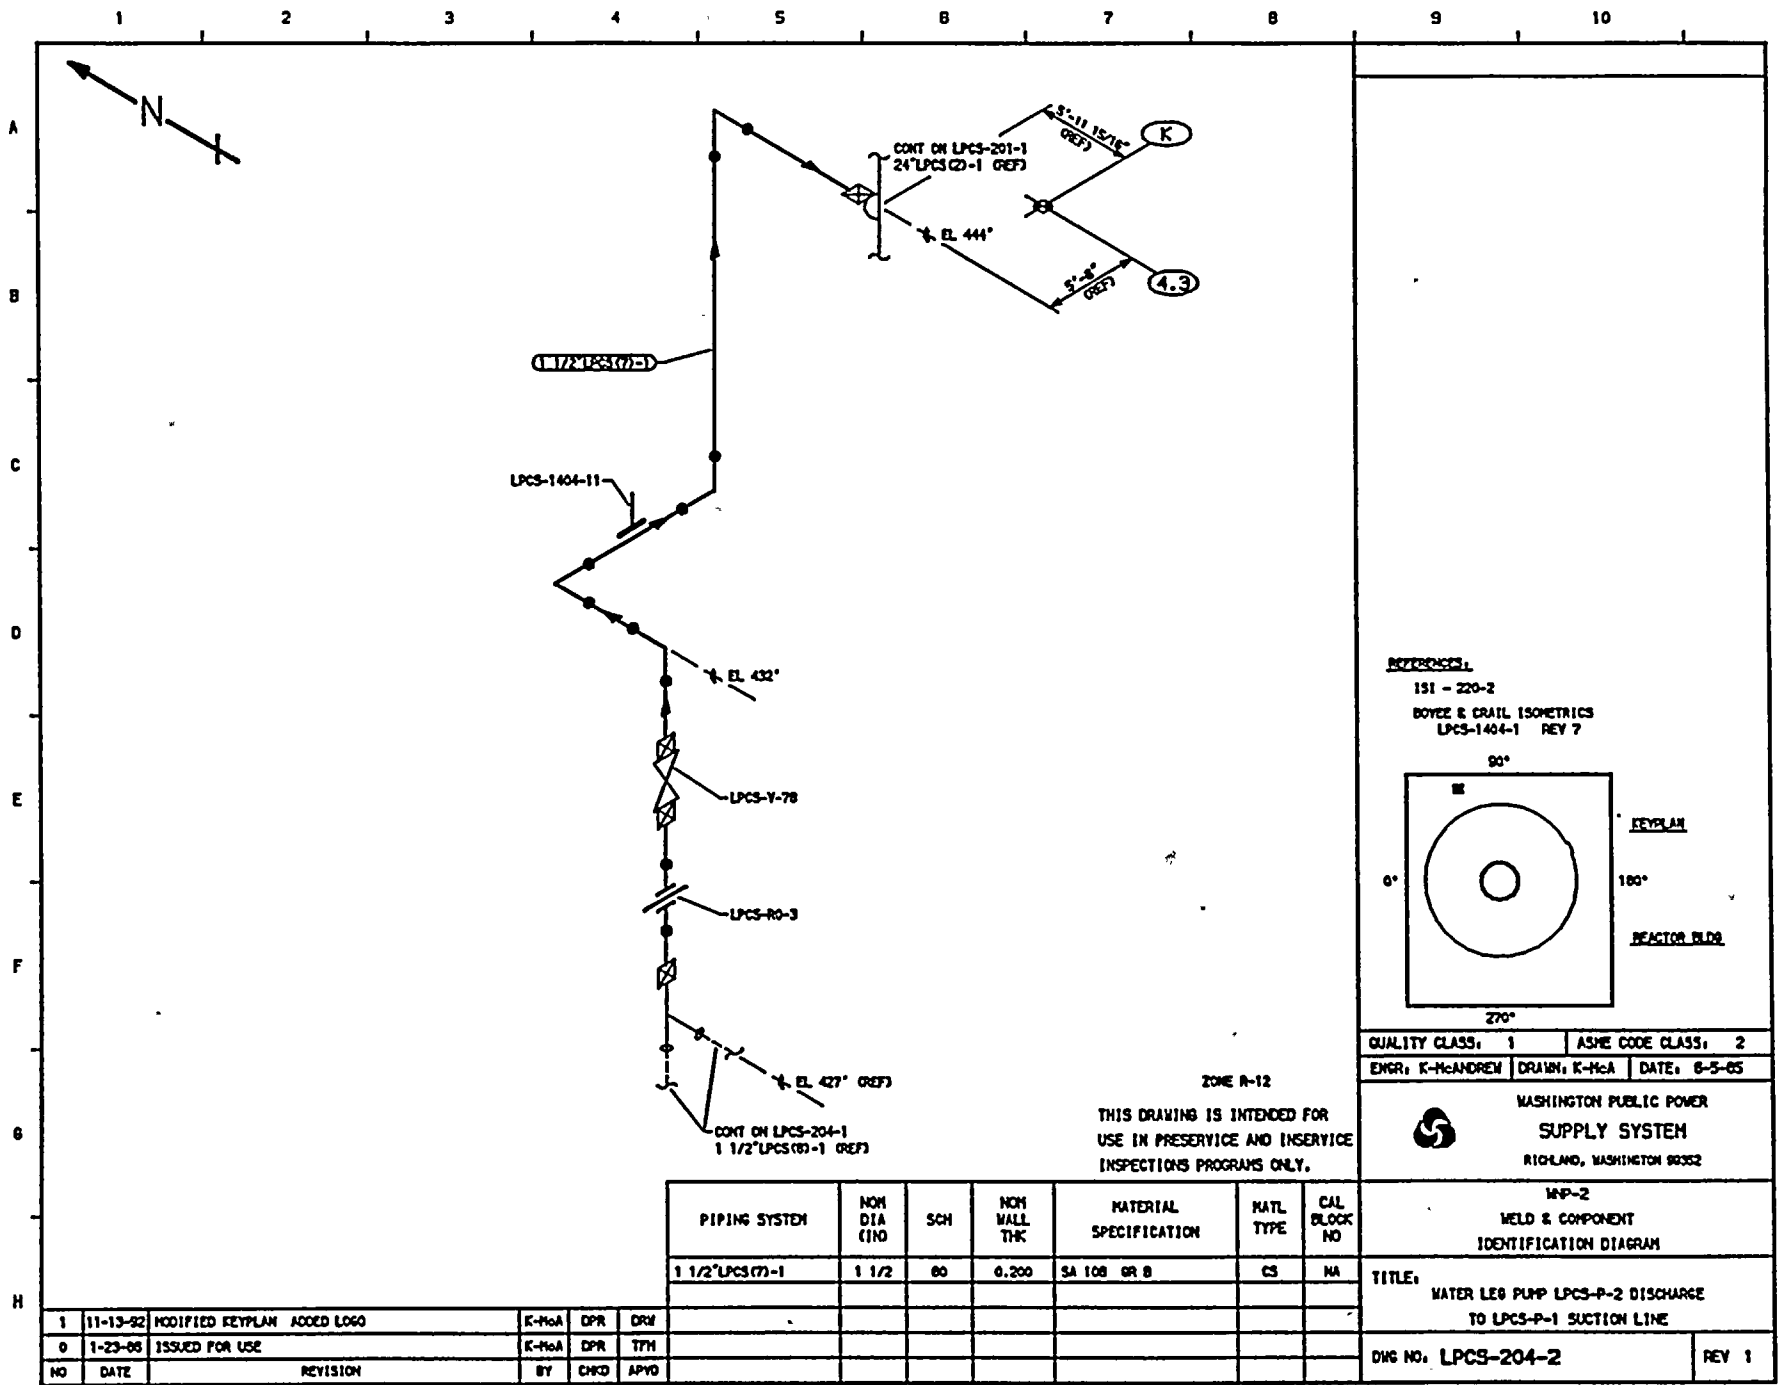

REFERENCES:  
 ISI - 220-2  
 BOYCE & CRAIG ISOMETRICS  
 LPCS-1404-1 REV 7

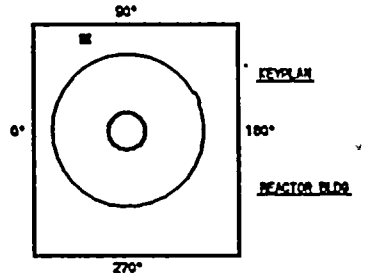

QUALITY CLASS: 1 ASME CODE CLASS: 2  
 ENGR: K-McANDREW DRAIN: K-McA DATE: 6-5-65

WASHINGTON PUBLIC POWER  
 SUPPLY SYSTEM  
 RICHLAND, WASHINGTON 99352

WPP-2  
 WELD & COMPONENT  
 IDENTIFICATION DIAGRAM


TITLE:  
 WATER LEG PUMP LPCS-P-2 DISCHARGE  
 TO LPCS-P-1 SUCTION LINE

DWG NO. LPCS-204-2 REV 1


ZONE R-12  
 THIS DRAWING IS INTENDED FOR  
 USE IN PRESERVICE AND INSERVICE  
 INSPECTIONS PROGRAMS ONLY.

PIPING SYSTEM	NOM DIA (IN)	SCH	NOM WALL THK	MATERIAL SPECIFICATION	MATL TYPE	CAL BLOCK NO
1 1/2" LPCS (7)-1	1 1/2	60	0.200	SA 108 GR B	CS	NA

NO	DATE	REVISION	BY	CHKD	APVD
1	11-13-62	MODIFIED KEYPLAN ADDED LOGO	K-McA	DPR	DRW
0	1-23-65	ISSUED FOR USE	K-McA	DPR	TTH

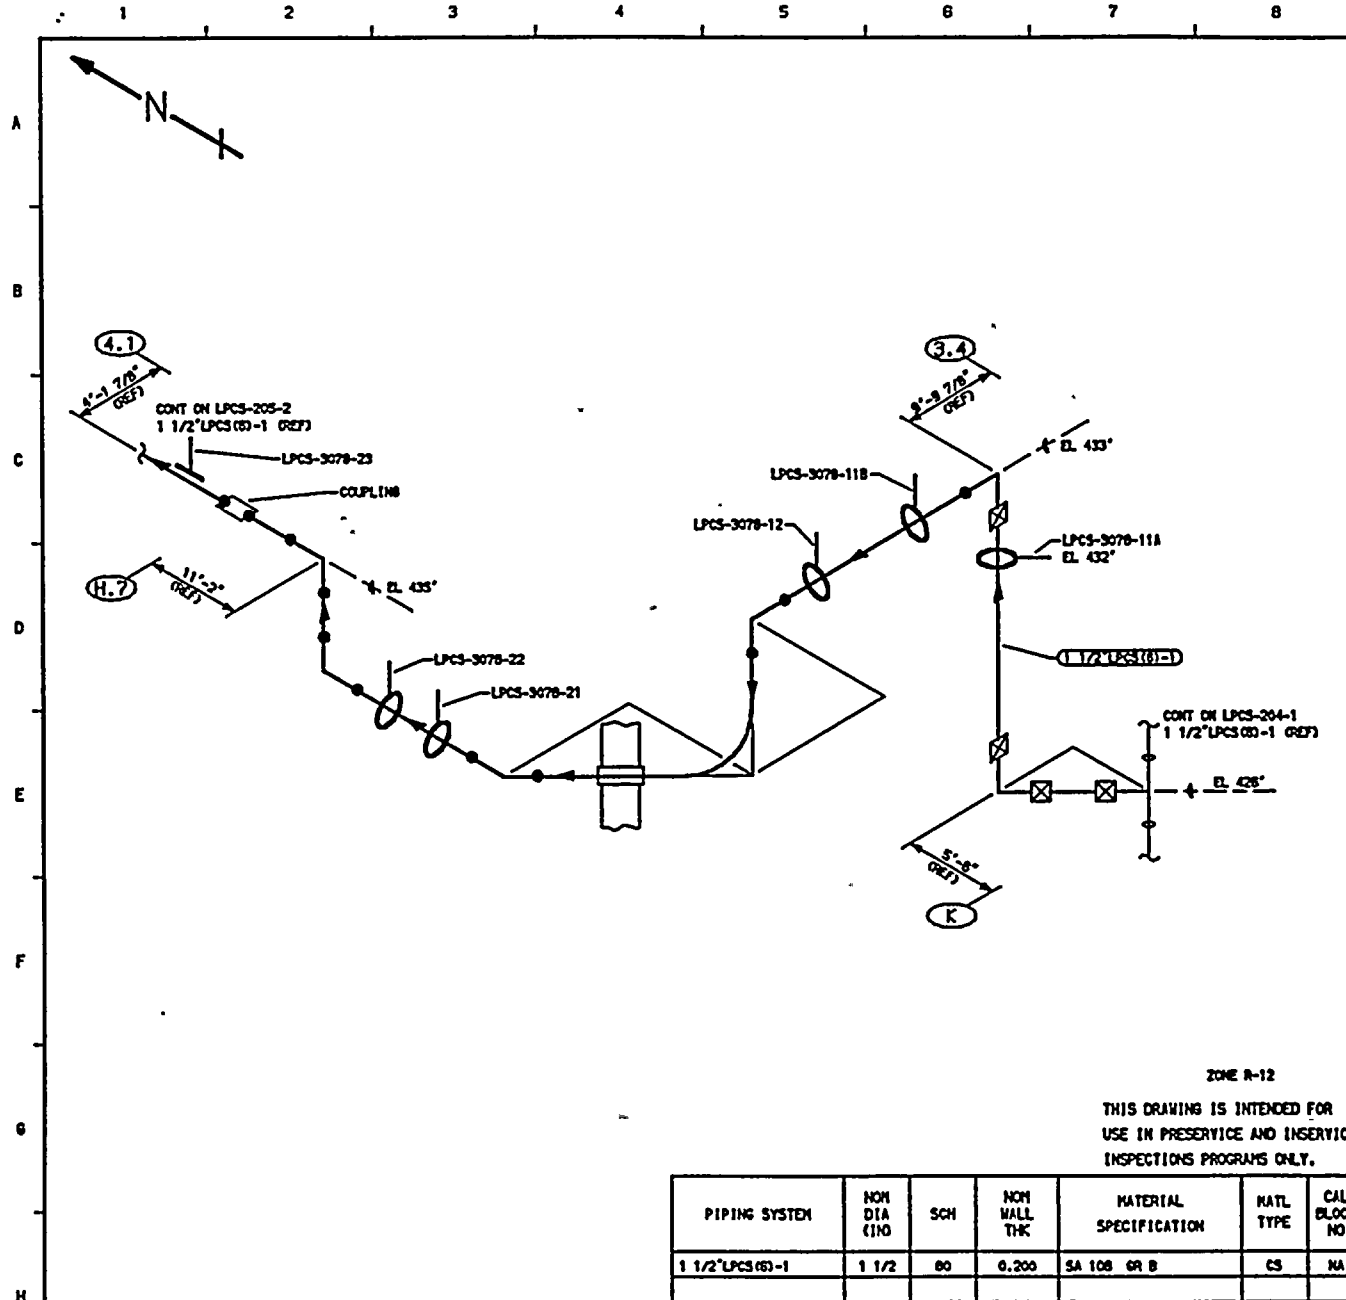

REFERENCES:  
 ISI - 220-2  
 BOYCE & GRILL ISOMETRICS  
 LPCS-3078-1 REV 9  
 LPCS-3078-2 REV 10

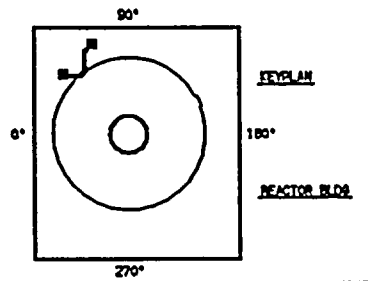

QUALITY CLASS, 1	ASME CODE CLASS, 2
ENGR, K-McANDREW	DRAWN, K-McA DATE, 8-8-05



WASHINGTON PUBLIC POWER  
 SUPPLY SYSTEM  
 RICHLAND, WASHINGTON 99352

ZONE R-12  
 THIS DRAWING IS INTENDED FOR  
 USE IN PRESERVICE AND INSERVICE  
 INSPECTIONS PROGRAMS ONLY.

PIPING SYSTEM	NOM DIA (INO)	SCH	NOM WALL THK	MATERIAL SPECIFICATION	MATL TYPE	CAL BLOCK NO
1 1/2" LPCS (6)-1	1 1/2	60	0.200	SA 106 GR B	CS	NA


NO	DATE	REVISION	BY	CHKD	APVD
1	11-13-02	MODIFIED KEYPLAN ADDED LOGO	K-McA	OPR	DRJ
0	1-23-05	ISSUED FOR USE	K-McA	OPR	TFH


WMP-2  
 WELD & COMPONENT  
 IDENTIFICATION DIAGRAM

TITLE: WATER LEG PUMP LPCS-P-2  
 DISCHARGE TO RHR SYSTEM


DWG NO. LPCS-205-1

REV 1

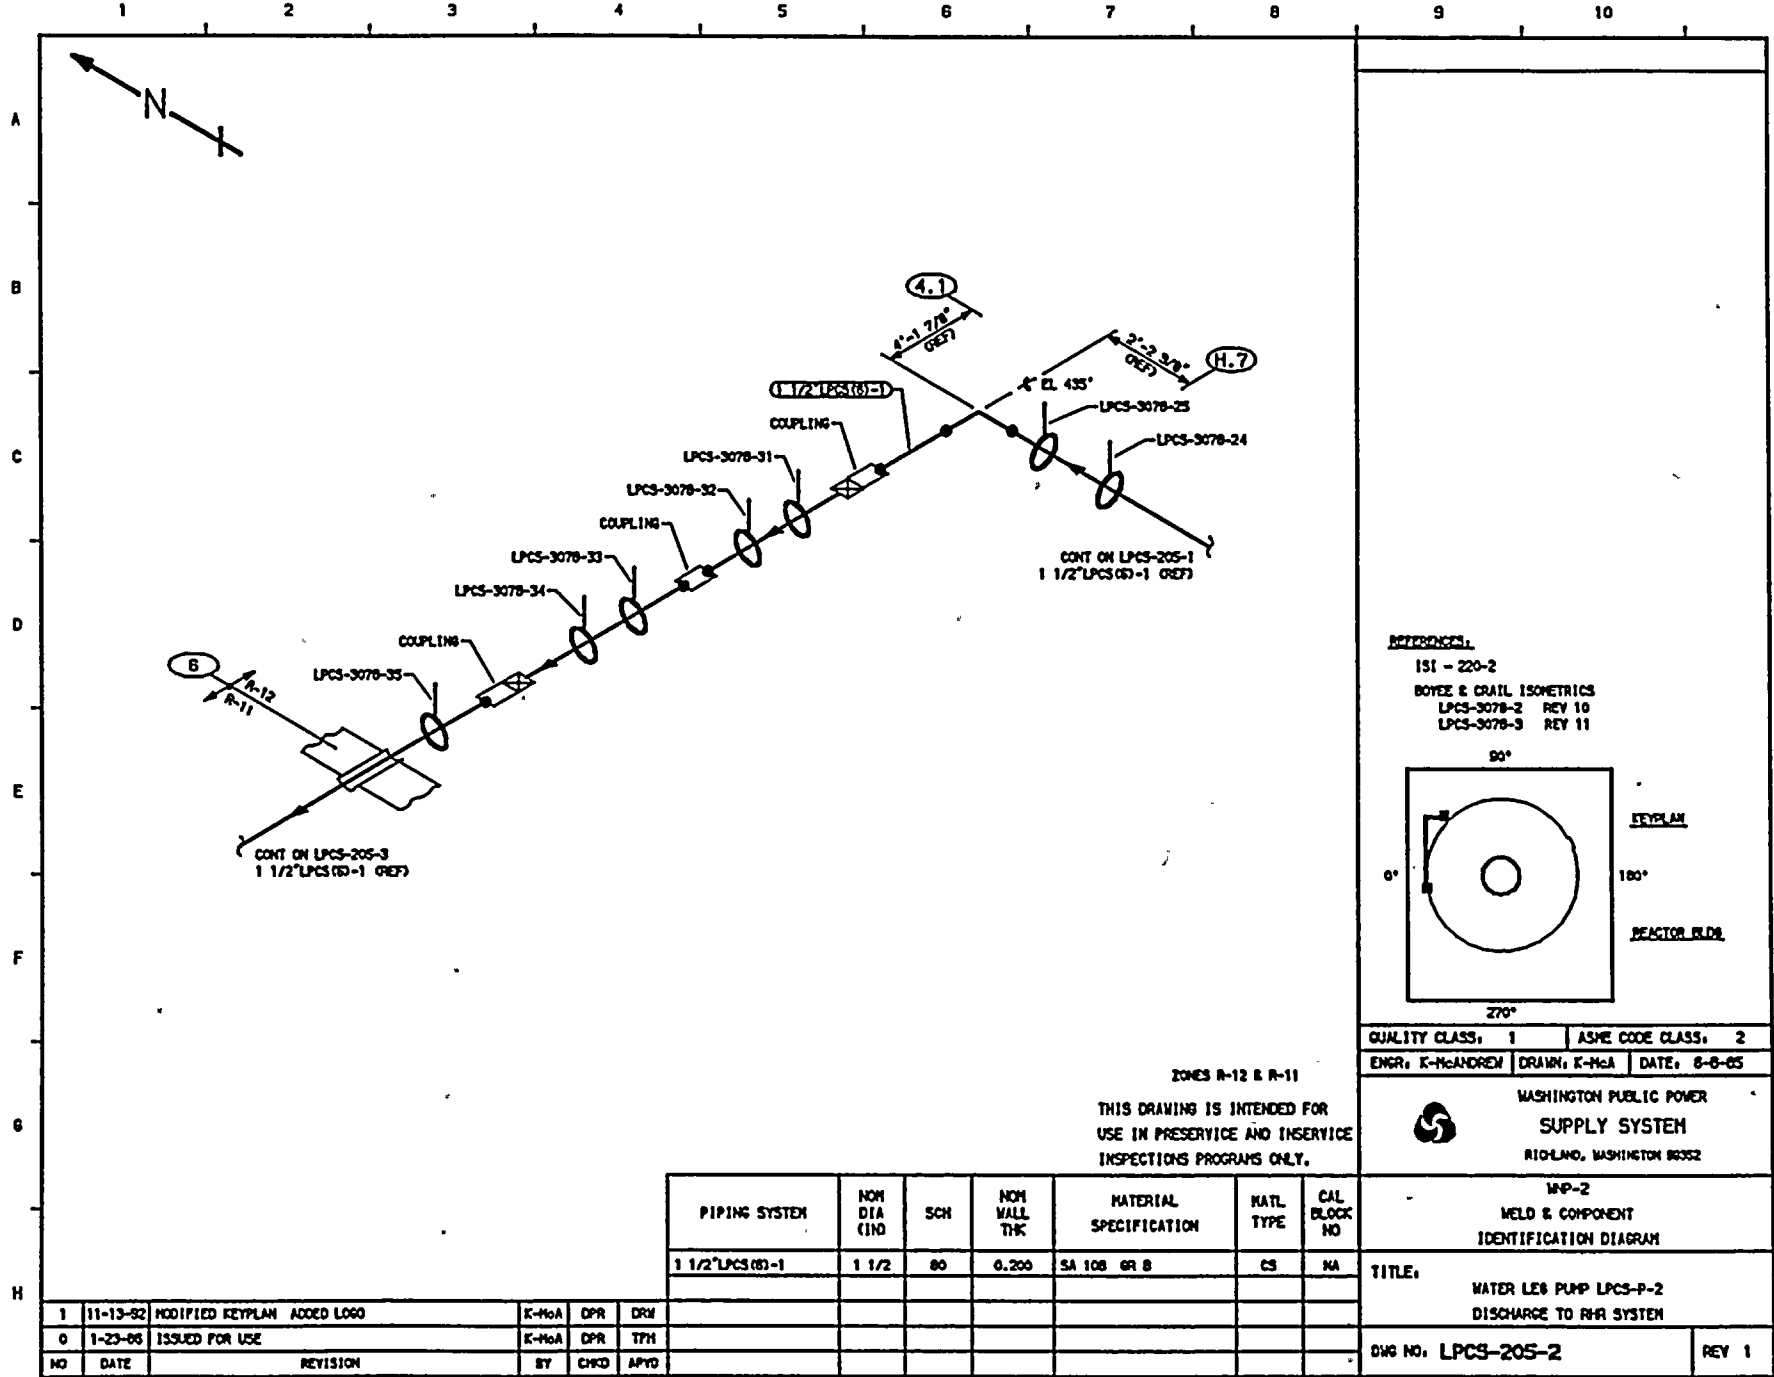

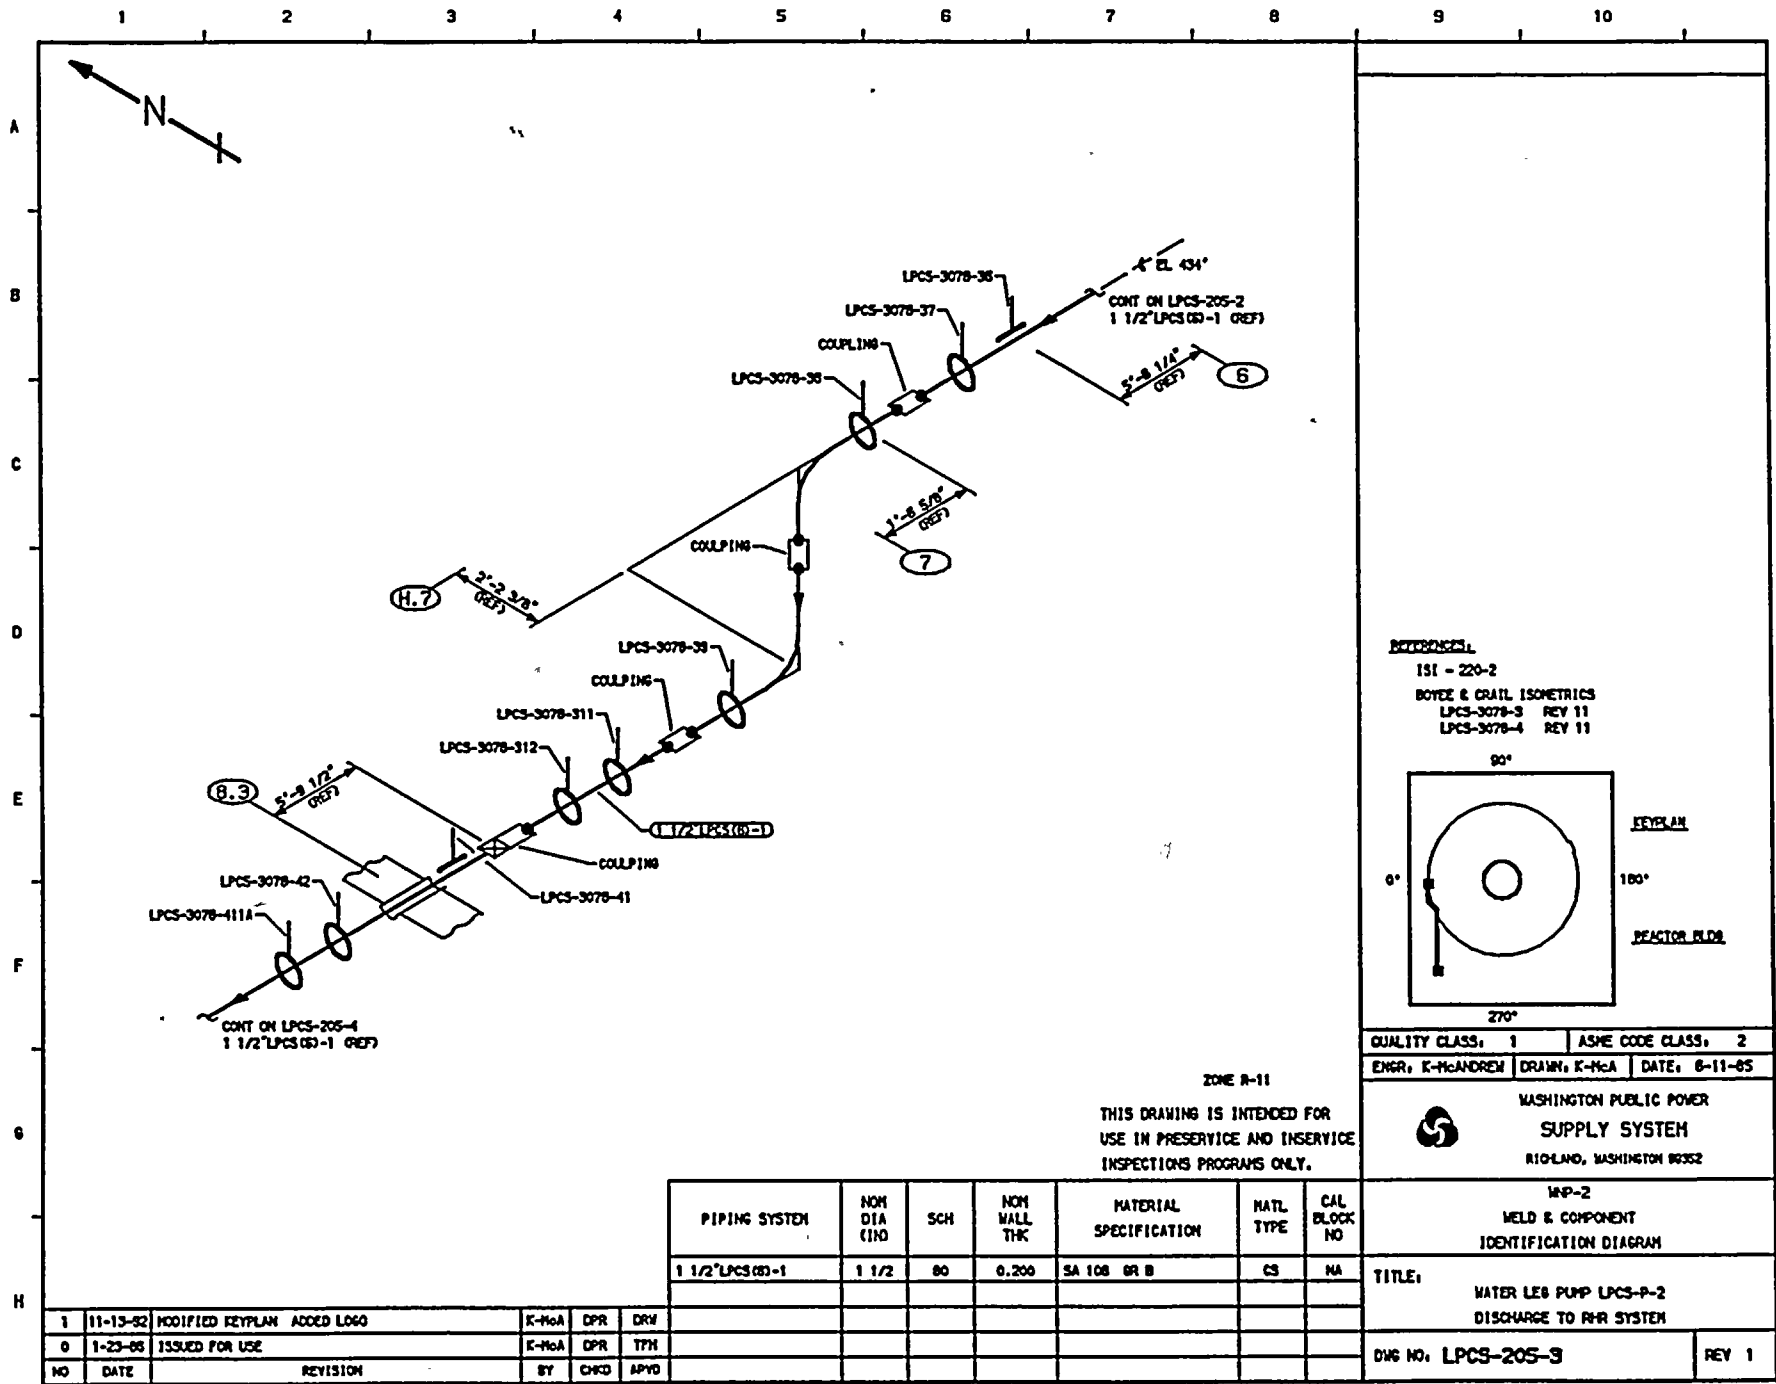

**REFERENCE:**  
 ISI - 220-2  
 BOYCE & ORILL ISOMETRICS  
 LPCS-3078-3 REV 11  
 LPCS-3078-4 REV 11

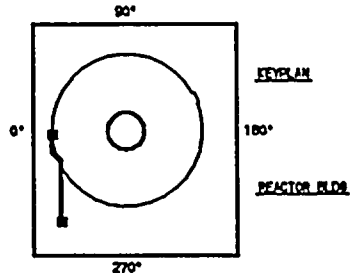

QUALITY CLASS: 1	ASME CODE CLASS: 2
ENGR: E-McANDREW	DATE: 8-11-85

WASHINGTON PUBLIC POWER  
**SUPPLY SYSTEM**  
 RICHLAND, WASHINGTON 99352

WPP-2  
 WELD & COMPONENT  
 IDENTIFICATION DIAGRAM


TITLE: WATER LEG PUMP LPCS-P-2  
 DISCHARGE TO RHR SYSTEM

DWG NO. LPCS-205-3 REV 1


ZONE R-11  
 THIS DRAWING IS INTENDED FOR  
 USE IN PRESERVICE AND INSERVICE  
 INSPECTIONS PROGRAMS ONLY.

PIPING SYSTEM	NOM DIA (IN)	SCH	NOM WALL THK	MATERIAL SPECIFICATION	MATL TYPE	CAL BLOCK NO
1 1/2" LPCS (S)-1	1 1/2	80	0.200	SA 108 GR B	CS	NA

NO	DATE	REVISION	BY	CHKD	APVD
1	11-13-82	MODIFIED KEYPLAN ADDED LOGO	E-McA	DPR	DRW
0	1-23-85	ISSUED FOR USE	E-McA	DPR	TPH

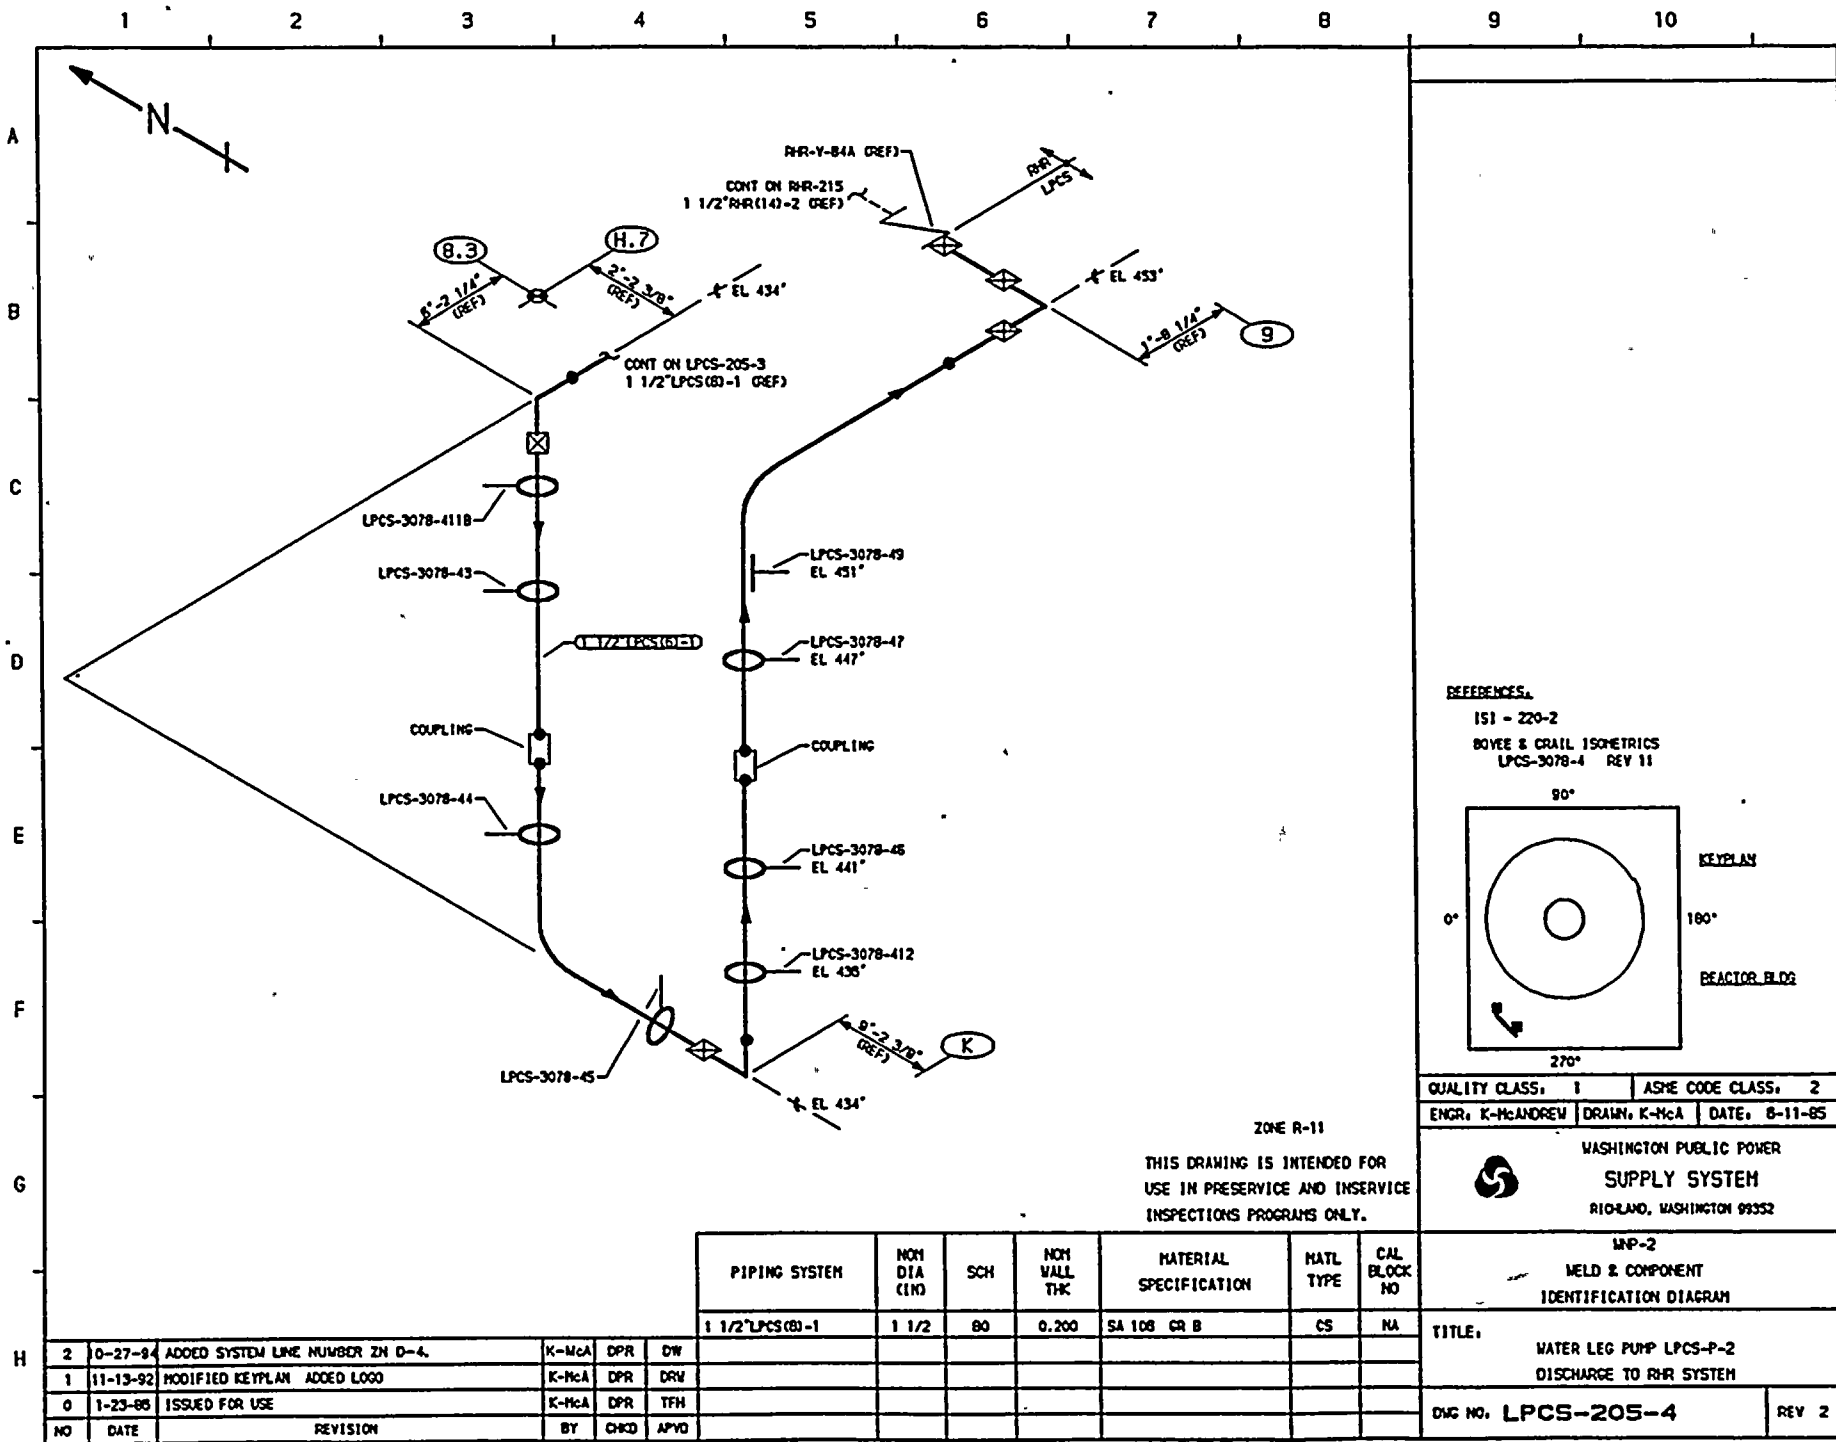

**REFERENCES**  
 151 - 220-2  
 BOVEE & CRAIL ISOMETRICS  
 LPCS-3078-4 REV 11

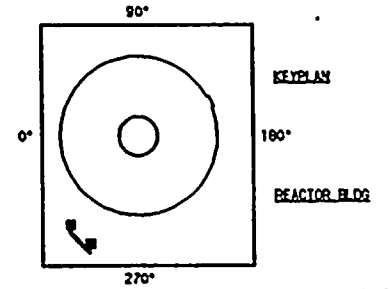

QUALITY CLASS, 1	ASME CODE CLASS, 2
ENGR, K-McANDREW	DATE, 8-11-85

WASHINGTON PUBLIC POWER  
**SUPPLY SYSTEM**  
 RICHLAND, WASHINGTON 99352

MP-2  
 WELD & COMPONENT  
 IDENTIFICATION DIAGRAM


TITLE: WATER LEG PUMP LPCS-P-2  
 DISCHARGE TO RHR SYSTEM

DWG NO. **LPCS-205-4** REV 2

ZONE R-11  
 THIS DRAWING IS INTENDED FOR  
 USE IN PRESERVICE AND INSERVICE  
 INSPECTIONS PROGRAMS ONLY.


PIPING SYSTEM	NON DIA (IN)	SCH	NON WALL THK	MATERIAL SPECIFICATION	MATL TYPE	CAL BLOCK NO
1 1/2" LPCS(B)-1	1 1/2	80	0.200	SA 106 GR B	CS	NA

NO	DATE	REVISION	BY	CHKD	APVD
2	0-27-84	ADDED SYSTEM LINE NUMBER ZH D-4.	K-McA	DPR	DW
1	11-13-92	MODIFIED KEYPLAN ADDED LOGO	K-McA	DPR	DRV
0	1-23-85	ISSUED FOR USE	K-McA	DPR	TFH

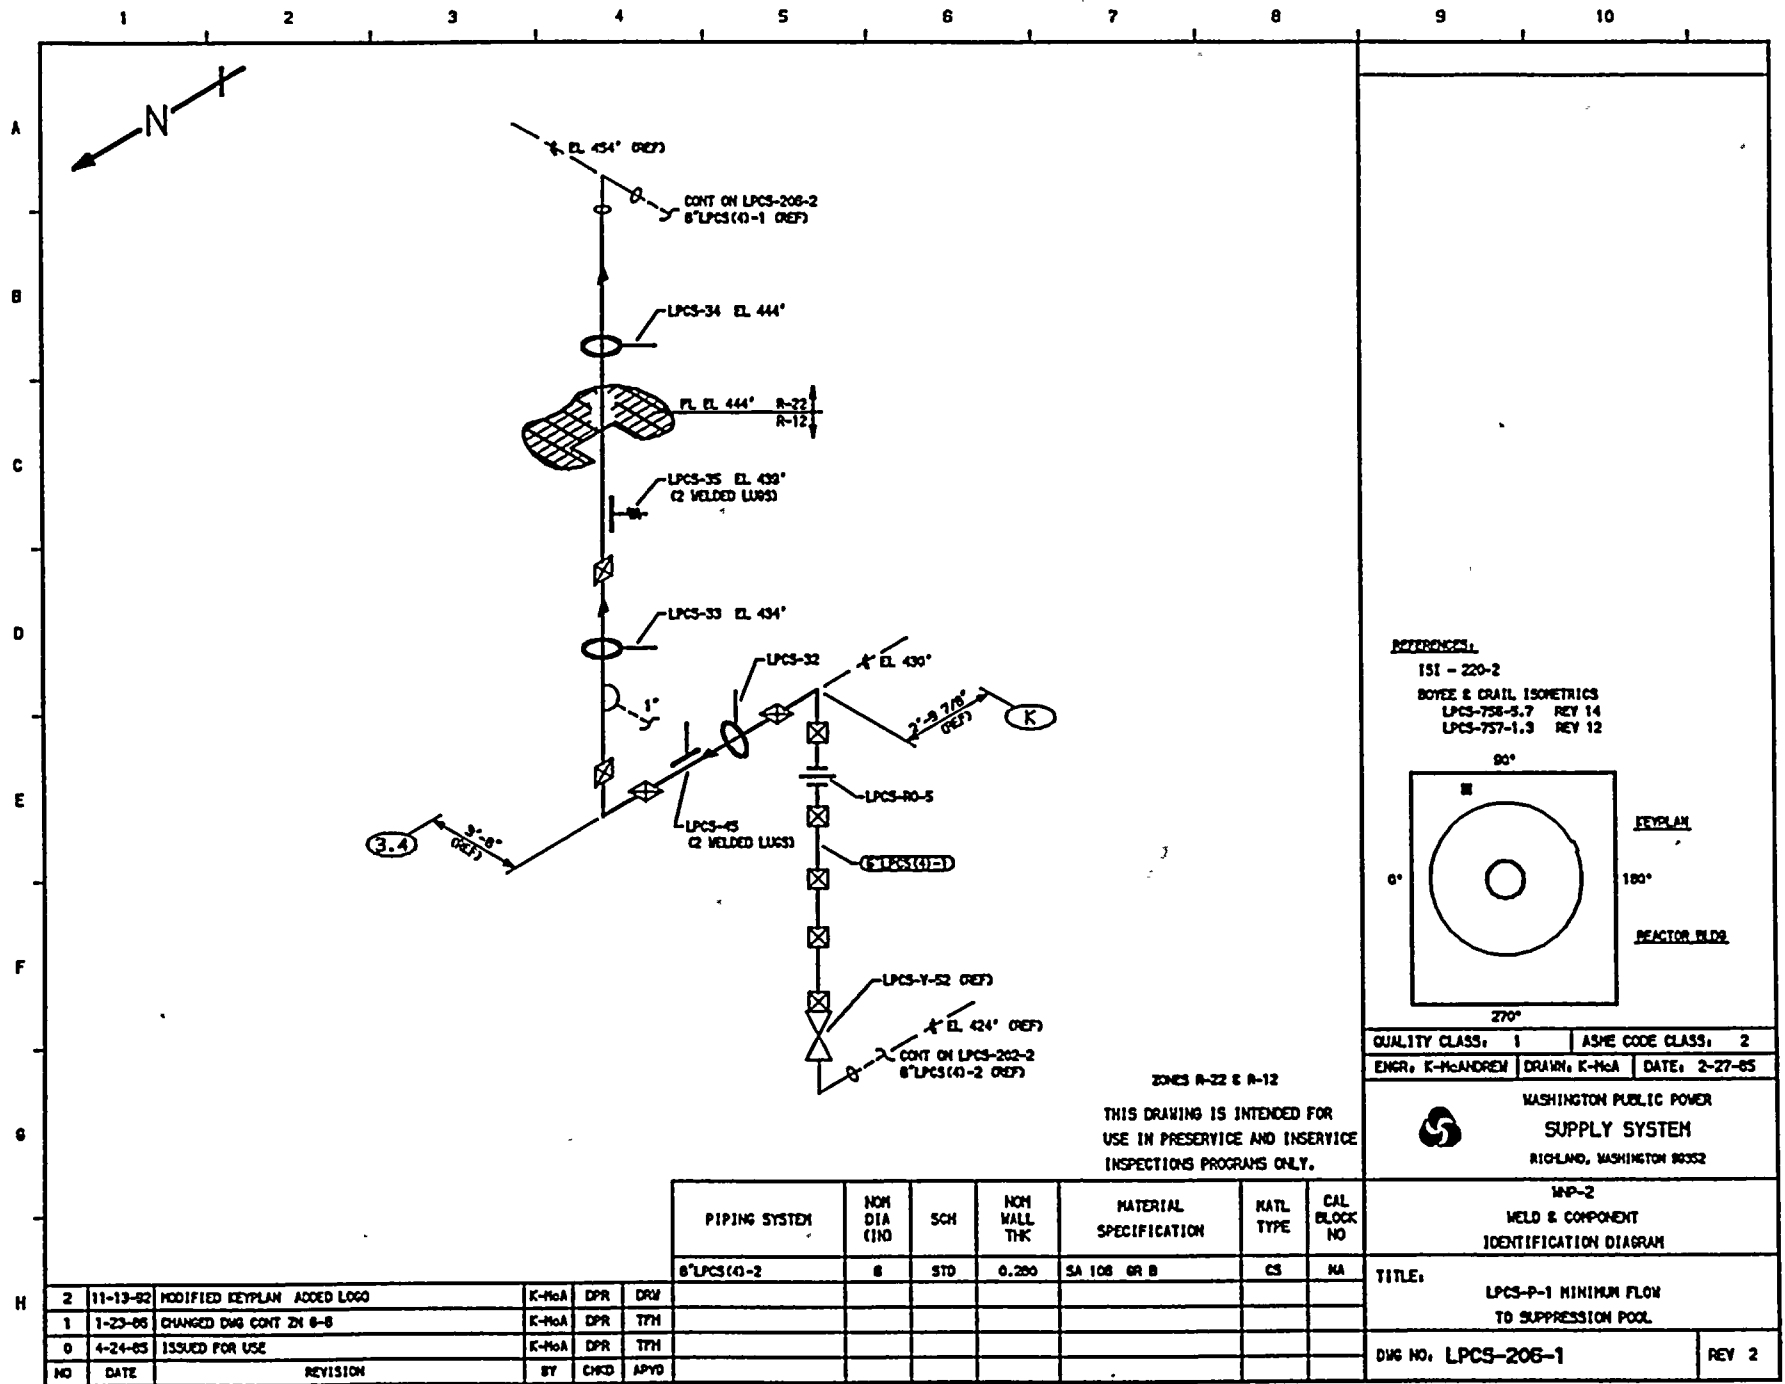

**REFERENCES:**

- ISI - 220-2
- BOYEE & CRAIL ISOMETRICS
- LPCS-758-5.7 REV 14
- LPCS-757-1.3 REV 12

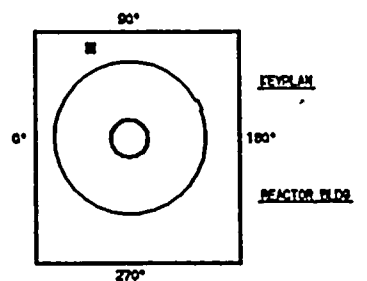

QUALITY CLASS: 1	ASME CODE CLASS: 2
ENGR: K-McAHOREM	DRAWN: K-McA DATE: 2-27-65

WASHINGTON PUBLIC POWER  
SUPPLY SYSTEM  
RICHLAND, WASHINGTON 99352

PIPING SYSTEM	NOM DIA (IN)	SCH	NOM WALL THK	MATERIAL SPECIFICATION	MATL TYPE	CAL BLOCK NO
8" LPCS (0-2)	8	STD	0.200	SA 106 GR B	CS	NA

NO	DATE	REVISION	BY	CHKD	APPD
2	11-13-82	MODIFIED KEYPLAN ADDED LOGO	K-McA	DPR	DRV
1	1-23-65	CHANGED DWG CONT IN 6-8	K-McA	DPR	TTH
0	4-24-65	ISSUED FOR USE	K-McA	DPR	TTH


WPP-2  
WELD & COMPONENT  
IDENTIFICATION DIAGRAM

TITLE: LPCS-P-1 MINIMUM FLOW  
TO SUPPRESSION POOL


DWG NO. LPCS-206-1

REV 2



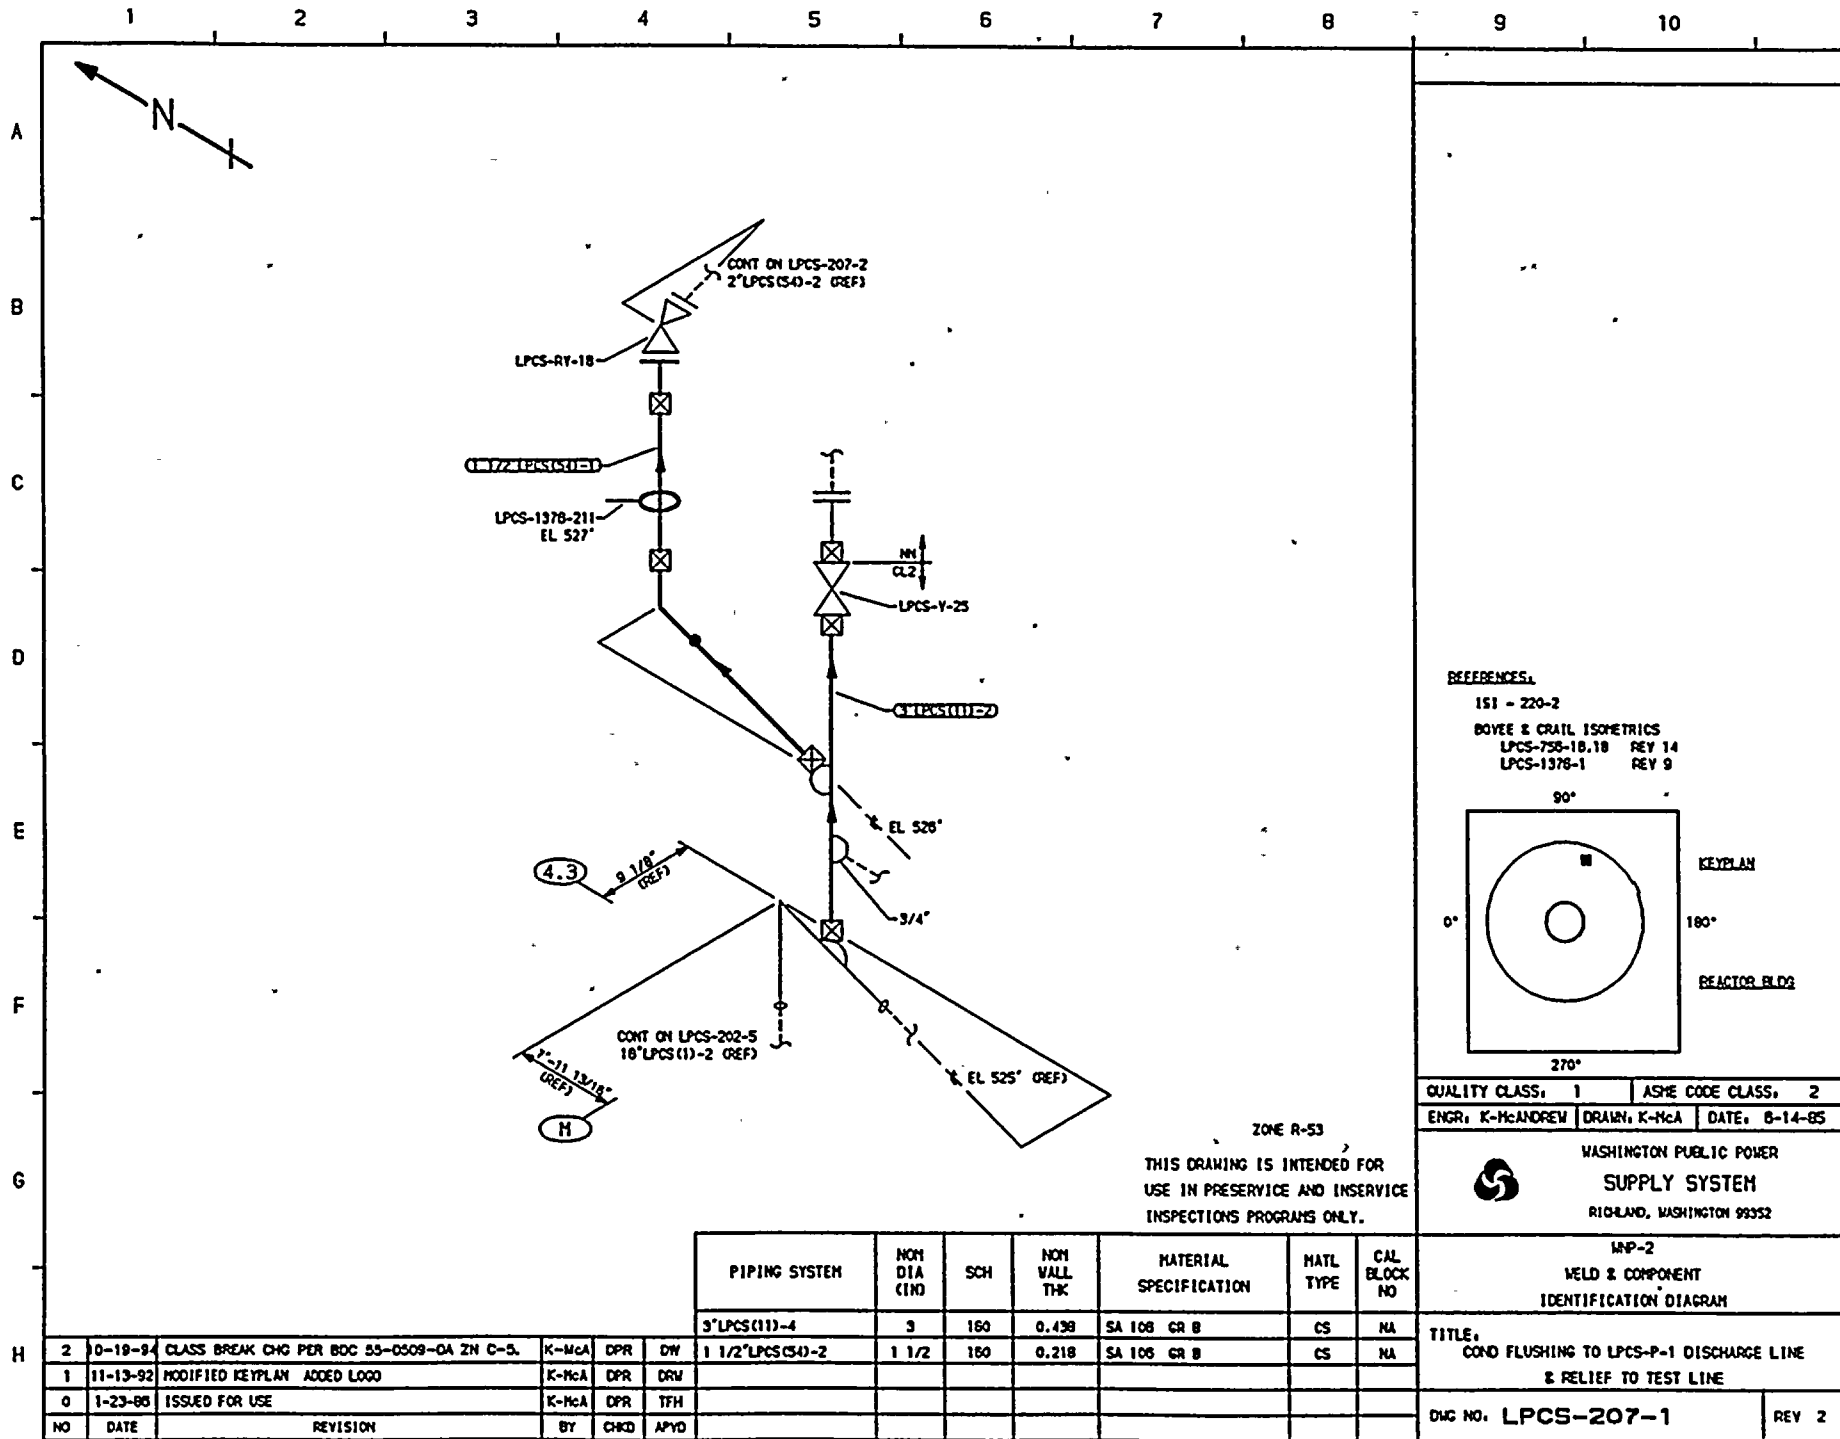

REFERENCES:  
 ISI - 220-2  
 BOYEE & CRAIL ISOMETRICS  
 LPCS-758-18.18 REV 14  
 LPCS-1378-1 REV 9

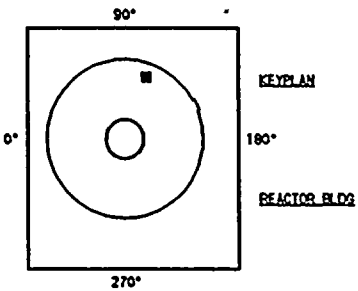

QUALITY CLASS, 1 ASHE CODE CLASS, 2  
 ENGR: K-McANDREW DRAWN: K-McA DATE: 8-14-85

WASHINGTON PUBLIC POWER  
 SUPPLY SYSTEM  
 RICHLAND, WASHINGTON 99352


ZONE R-53  
 THIS DRAWING IS INTENDED FOR  
 USE IN PRESERVICE AND INSERVICE  
 INSPECTIONS PROGRAMS ONLY.

PIPING SYSTEM	NOM DIA (IND)	SCH	NOM WALL THK	MATERIAL SPECIFICATION	MATL TYPE	CAL BLOCK NO
3" LPCS(11)-4	3	160	0.438	SA 106 GR B	CS	NA
1 1/2" LPCS(54)-2	1 1/2	160	0.218	SA 106 GR B	CS	NA


NO	DATE	REVISION	BY	CHKD	APVD
2	10-19-84	CLASS BREAK CHG PER BDC 55-0509-0A ZN C-5.	K-McA	DPR	DW
1	11-13-82	MODIFIED KEYPLAN ADDED LOGO	K-McA	DPR	DRV
0	1-23-85	ISSUED FOR USE	K-McA	DPR	TFH

MAP-2  
 WELD & COMPONENT  
 IDENTIFICATION DIAGRAM  
 TITLE:  
 COND FLUSHING TO LPCS-P-1 DISCHARGE LINE  
 & RELIEF TO TEST LINE  
 Dwg NO. LPCS-207-1 REV 2



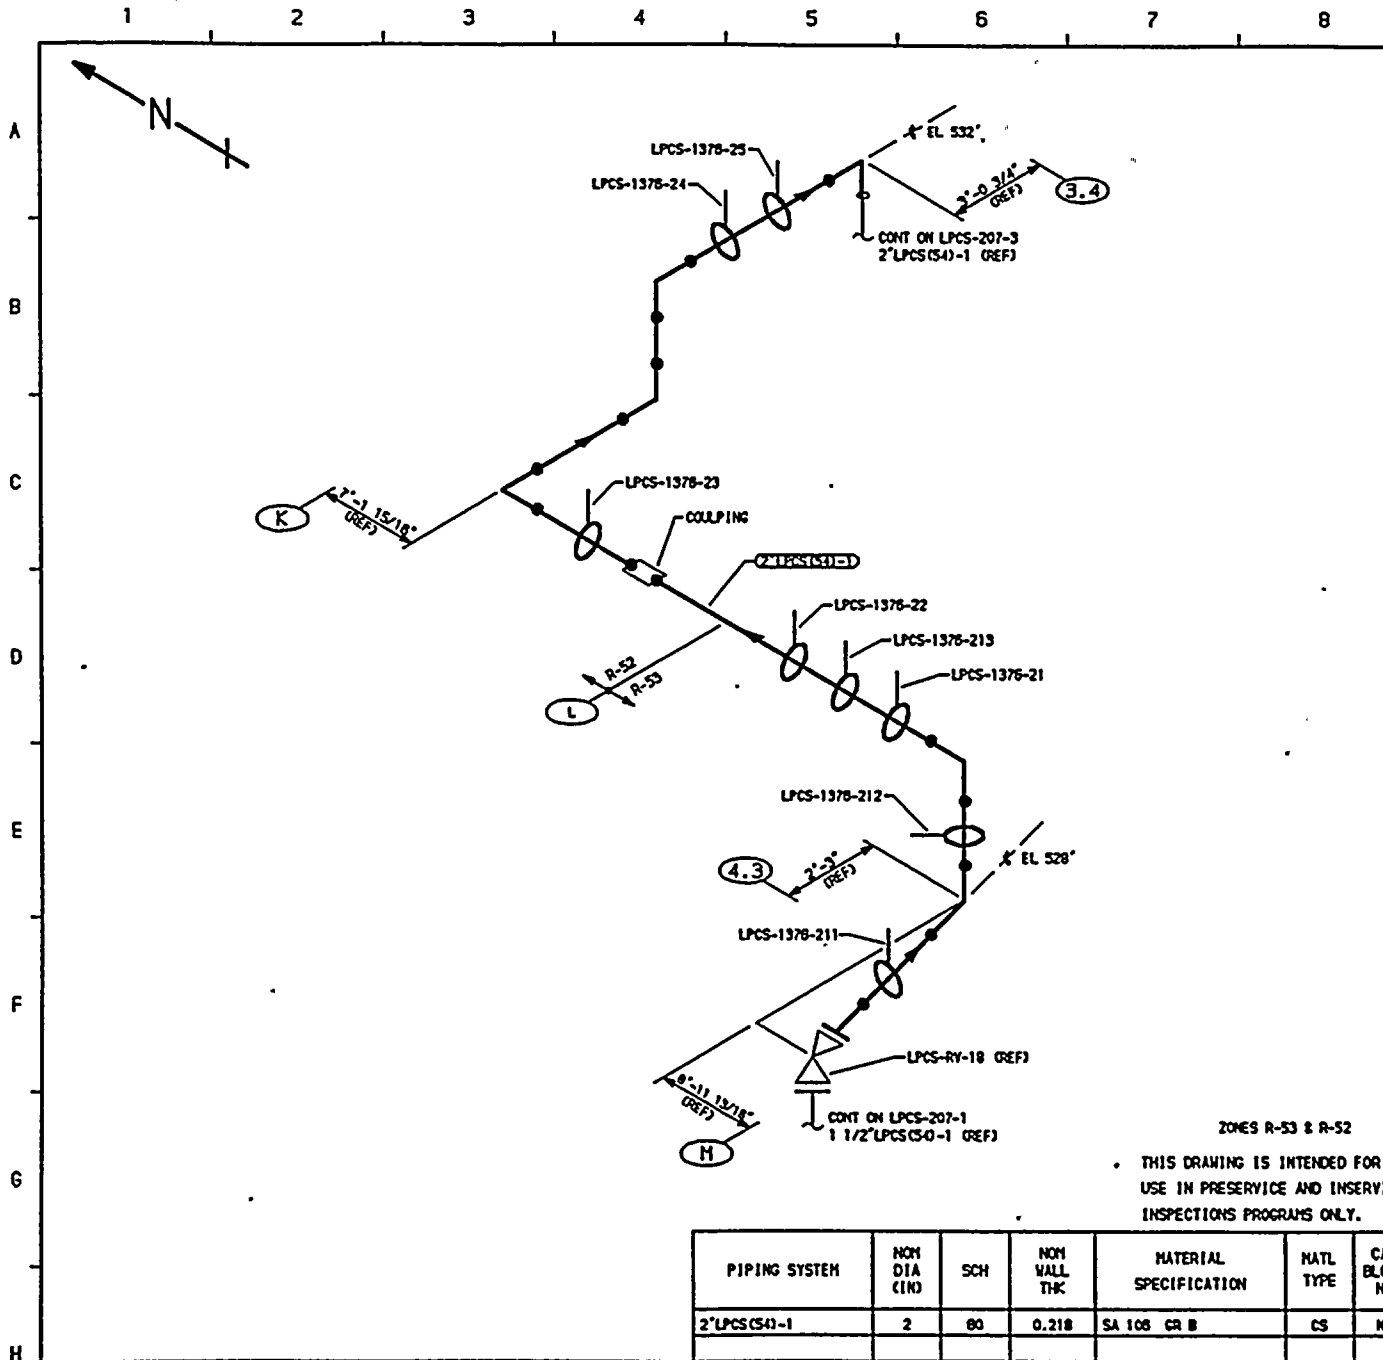

REFERENCES:  
 151 - 220-2  
 BOYEE & CRAIL ISOMETRICS  
 LPCS-1378-2 REV 11

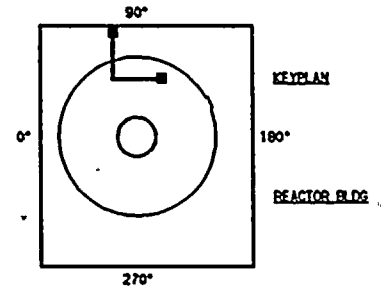

QUALITY CLASS, 1	ASME CODE CLASS, 2
ENGR, K-McANDREW	DATE, 8-18-85



WASHINGTON PUBLIC POWER  
 SUPPLY SYSTEM  
 RICHLAND, WASHINGTON 99352

ZONES R-53 & R-52  
 THIS DRAWING IS INTENDED FOR  
 USE IN PRESERVICE AND INSERVICE  
 INSPECTIONS PROGRAMS ONLY.


PIPING SYSTEM	NOM DIA (IN)	SCH	NOM WALL THK	MATERIAL SPECIFICATION	MATL TYPE	CAL BLOCK NO
2" LPCS(CS4)-1	2	80	0.218	SA 106 GR B	CS	NA

MP-2  
 WELD & COMPONENT  
 IDENTIFICATION DIAGRAM


TITLE:  
 COND FLUSHING TO TEST LINE

DOC NO: LPCS-207-2      REV 1

NO	DATE	REVISION	BY	CHKD	APVD
1	11-13-92	MODIFIED KEYPLAN ADDED LOGO	K-McA	DPR	DRW
0	1-23-85	ISSUED FOR USE	K-McA	DPR	TFH

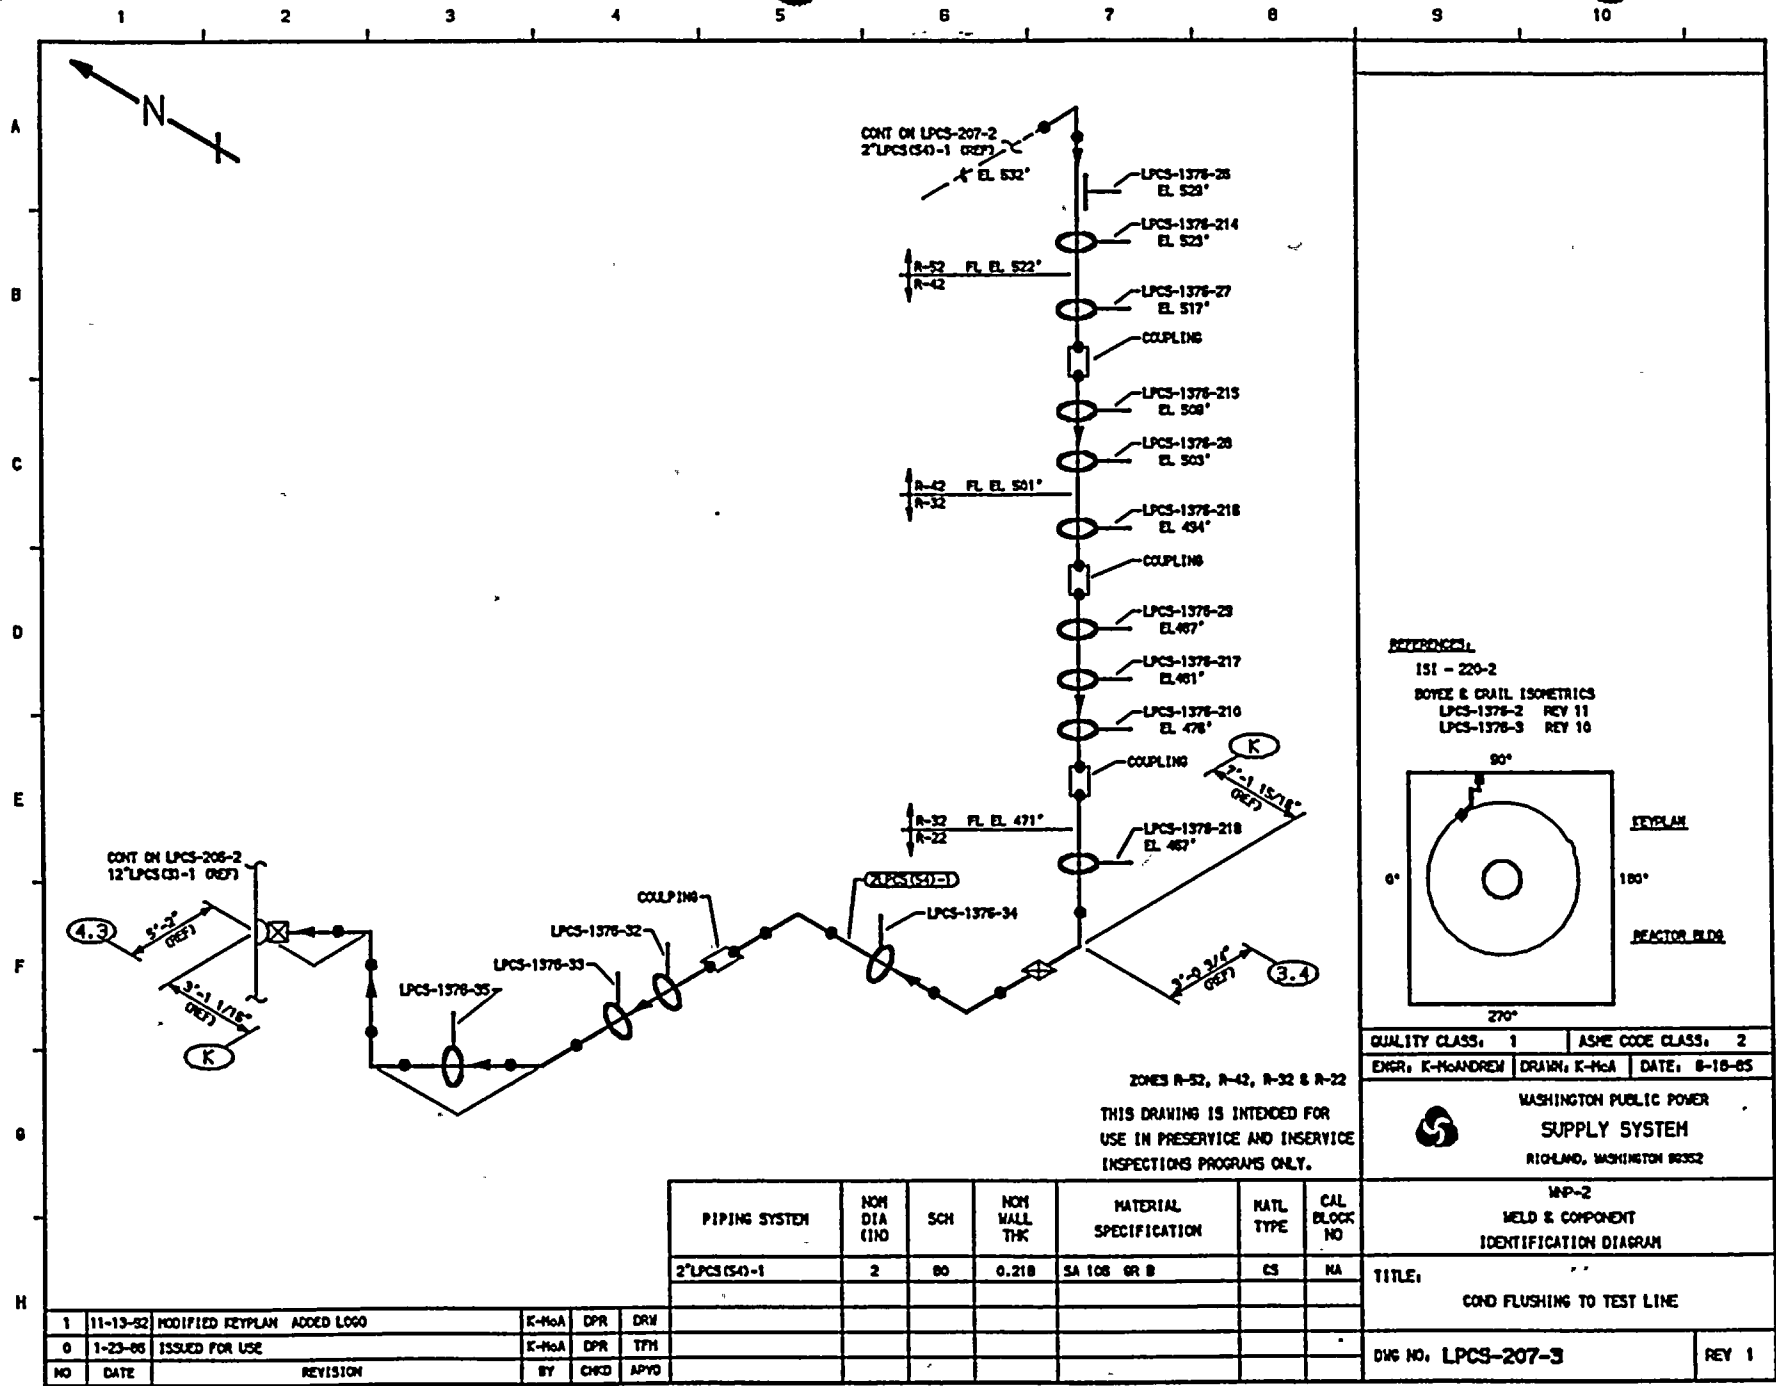

REFERENCES:  
 ISI - 220-2  
 BOYCE & CRILL ISOMETRICS  
 LPCS-1376-2 REV 11  
 LPCS-1376-3 REV 10

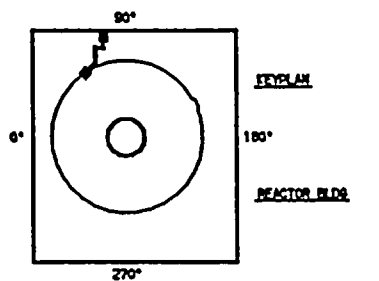

QUALITY CLASS: 1	ASME CODE CLASS: 2
ENGR: K-McANDREW	DRAWN: K-McA DATE: 8-18-85



WASHINGTON PUBLIC POWER  
 SUPPLY SYSTEM  
 RICHLAND, WASHINGTON 99352

PIPING SYSTEM	NOM DIA (IN)	SCH	NOM WALL THK	MATERIAL SPECIFICATION	MATL TYPE	CAL BLOCK NO
2" LPCS (S-1)	2	80	0.210	SA 106 GR B	CS	NA

NO	DATE	REVISION	BY	CHKD	APVD
1	11-13-82	MODIFIED KEYPLAN ADDED LOGO	K-McA	DPR	DRW
0	1-23-85	ISSUED FOR USE	K-McA	DPR	TPH

WMP-2 WELD & COMPONENT IDENTIFICATION DIAGRAM	
TITLE: COND FLUSHING TO TEST LINE	
DWG NO: LPCS-207-3	REV 1