


This drawing and the design it covers are the property of BECKTEL. They are hereby loaned and on the borrower's express agreement that they will not be reproduced, copied, loaned, exhibited, nor used except in the limited way and under the conditions given by the lender to the borrower.

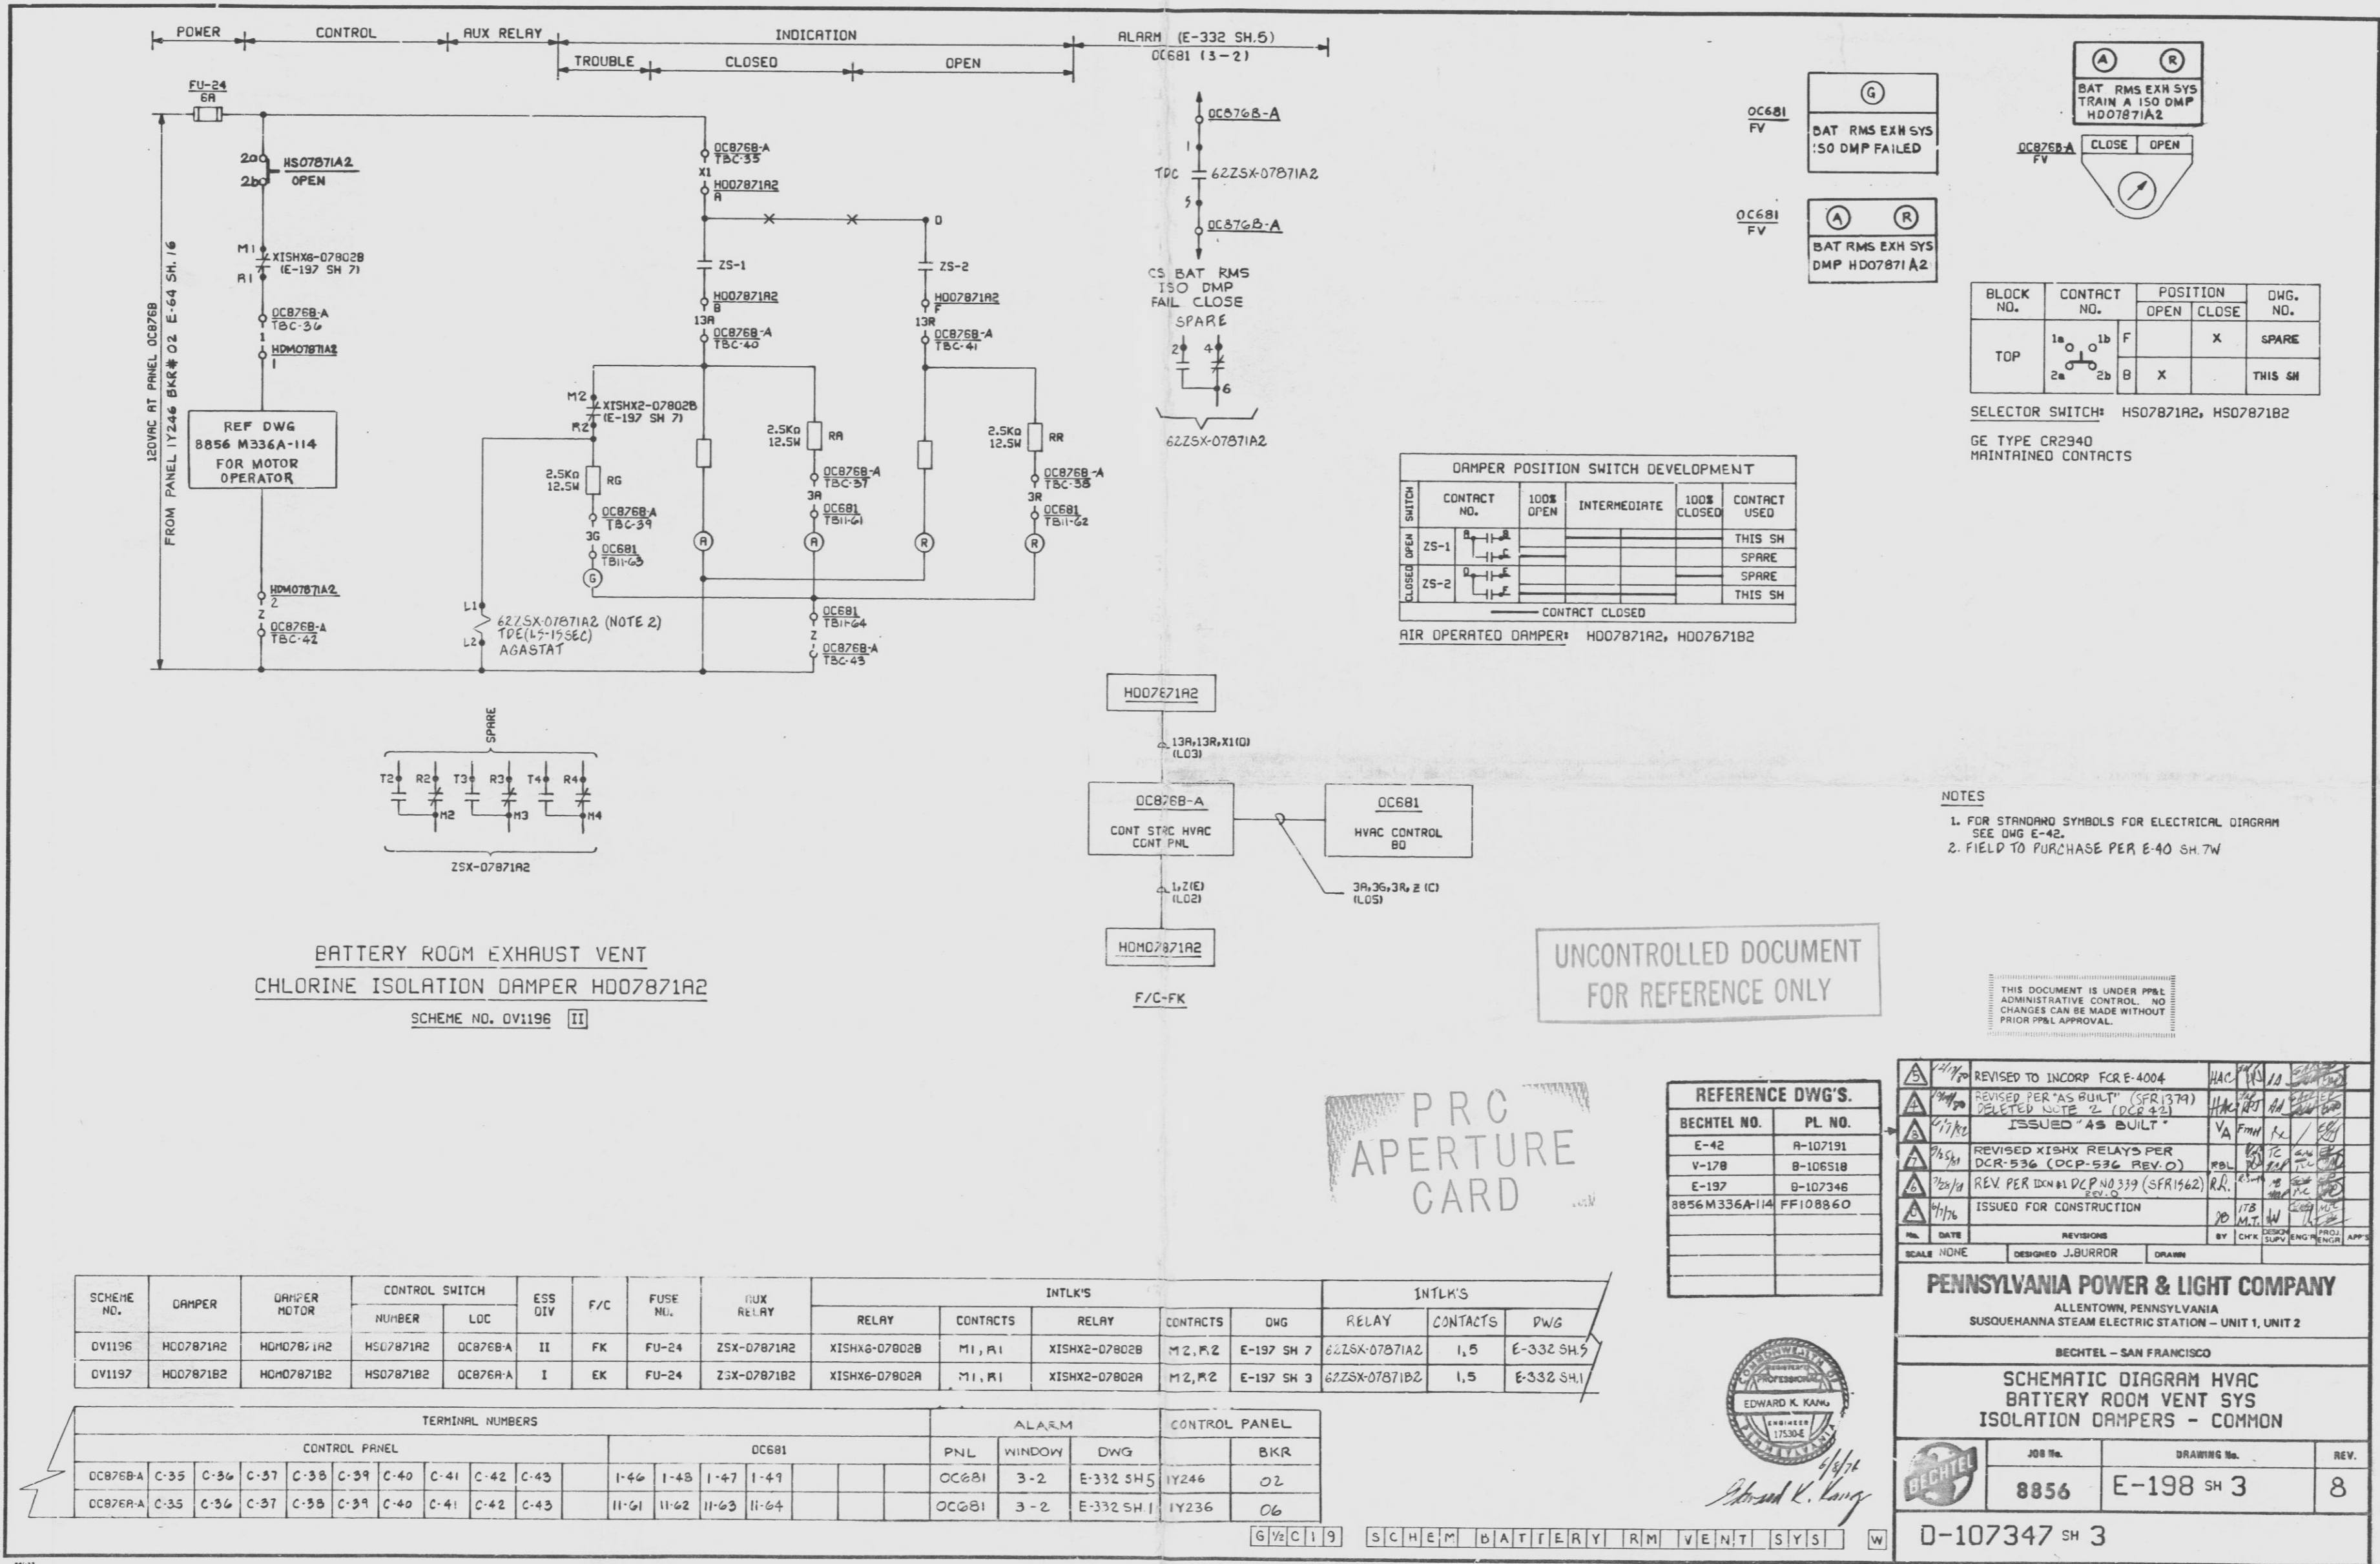

**BATTERY ROOM EXHAUST VENT
CHLORINE ISOLATION DAMPER H007871A2**
SCHEME NO. OV1196 II

UNCONTROLLED DOCUMENT
FOR REFERENCE ONLY

PRC
APERTURE
CARD

SCHEME NO.	DAMPER	DAMPER MOTOR	CONTROL SWITCH		ESS DIV	F/C	FUSE NO.	AUX RELAY	INTLK'S			INTLK'S				
			NUMBER	LOC					RELAY	CONTACTS	DWG	RELAY	CONTACTS	DWG		
OV1196	H007871A2	H007871A2	H507871A2	OCB76B-A	II	FK	FU-24	ZSX-07871A2	XISHX2-07802B	M1, R1	XISHX2-07802B	M2, R2	E-197 SH 7	62ZSX-07871A2	1, 5	E-332 SH 5
OV1197	H007871B2	H007871B2	H507871B2	OCB76B-A	I	EK	FU-24	ZSX-07871B2	XISHX2-07802B	M1, R1	XISHX2-07802B	M2, R2	E-197 SH 3	62ZSX-07871B2	1, 5	E-332 SH 1

CONTROL PANEL										ALARM				CONTROL PANEL				
TERMINAL NUMBERS										PNL	WINDOW	DWG	BKR					
OCB76B-A	C-35	C-36	C-37	C-38	C-39	C-40	C-41	C-42	C-43	I-46	I-48	I-47	I-49	OC681	3-2	E-332 SH 5	IY246	02
OCB76B-A	C-35	C-36	C-37	C-38	C-39	C-40	C-41	C-42	C-43	II-61	II-62	II-63	II-64	OC681	3-2	E-332 SH 1	IY236	06

BECHTEL NO.	PL. NO.
E-42	A-107191
V-178	B-106518
E-197	B-107346
8856M336A-114	FF108860

REVISION	DATE	BY	CHK	APP
REVISED TO INCORP FOR E-4004	11/1/79	JAC		
REVISED PER "AS BUILT" (SFR 1379)	11/1/79	JAC		
DELETED NOTE 2 (DCR 43)	11/1/79	JAC		
ISSUED "AS BUILT"	11/1/79	VA		
REVISED XISHX RELAYS PER DCR-536 (DCP-536 REV. 0)	7/23/81	RR		
REV PER DONALDCPND319 (SFR1462)	7/23/81	RR		
ISSUED FOR CONSTRUCTION	4/1/76	JAC		

PENNSYLVANIA POWER & LIGHT COMPANY
ALLENTOWN, PENNSYLVANIA
SUSQUEHANNA STEAM ELECTRIC STATION - UNIT 1, UNIT 2

BECHTEL - SAN FRANCISCO

**SCHEMATIC DIAGRAM HVAC
BATTERY ROOM VENT SYS
ISOLATION DAMPERS - COMMON**

JOB No.	DRAWING No.	REV.
8856	E-198 SH 3	8

D-107347 SH 3



Docmt # 50-387
Control # 8304050245-164
Date 3-27-83
REGULATORY DOCKET FILE