


This drawing and the design it covers are the property of BECHTEL. They are hereby loaned and on the borrower's express agreement that they will not be reproduced, copied, loaned, exhibited, nor used except in the limited way and for the purposes intended by the lender to the borrower.

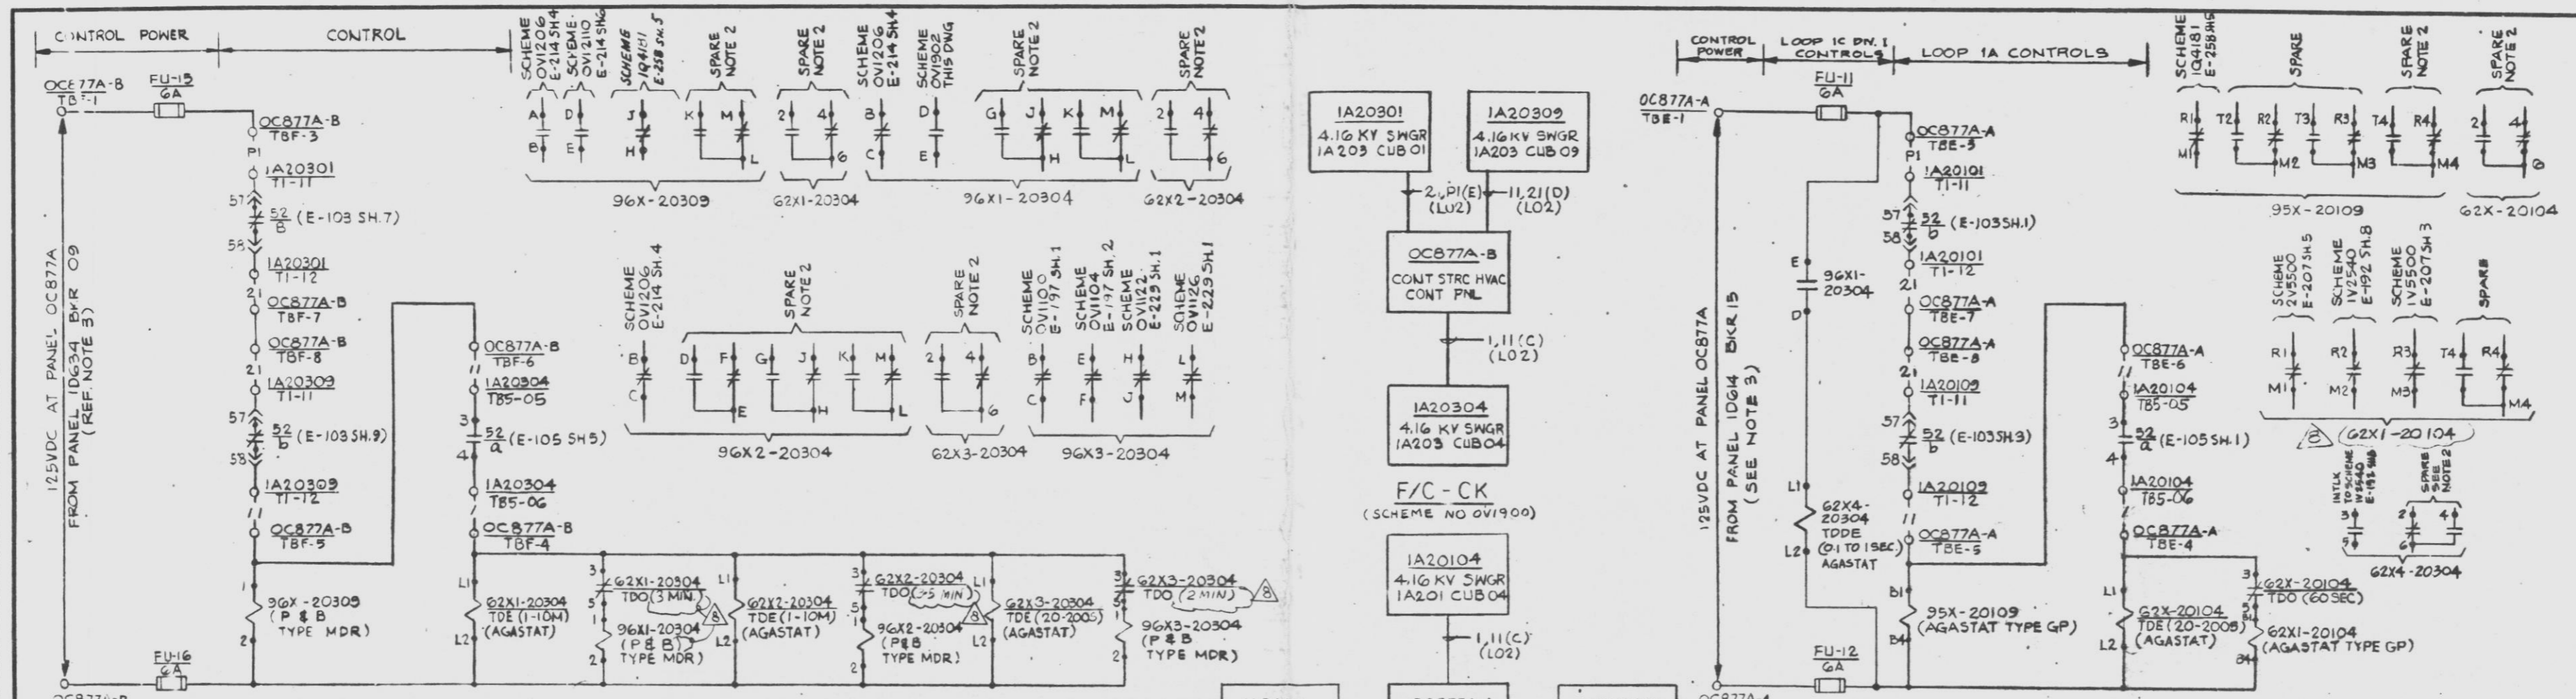

HVAC LOOP IC
SCHEME NO. OV1900 [C]
(SEE TABLE A)

HVAC LOOP 1A/1C
SCHEME NO. OV1902 [I]
(SEE TABLE B)

TABLE A

SCHEME NO.	DESCRIPTION	ESS CHAN	F/C	FUSE		ISOLATION RELAYS				TIME DELAY RELAYS				INTLK'S	
				NUMBER	LOC	CONTACT	SCHEME	CONTACT	SCHEME	CONTACT	SCHEME	CONTACT	SCHEME	CONTACT	SCHEME
OV1900	HVAC L.O.O.P. IC	C	CK	FU-15, 16	OC877A-B	96X-20309	96X1-20304	96X2-20304	96X3-20304	62X1-20304	62X2-20304	62X3-20304	52b/57.58	IA20301	E-103 SH.7
OV1901	HVAC L.O.O.P. ID	D	DK	FU-15, 16	OC877B-B	96X-20409	96X1-20404	96X2-20404	96X3-20404	62X1-20404	62X2-20404	62X3-20404	52b/57.58	IA20401	E-103 SH.10

INTLK'S		SCHEMES INTLK'D														
CONTACTS	LOC	DWG	CONTACTS	LOC	DWG	RELAY	CONTACT	SCHEME	CONTACT	SCHEME	RELAY	CONTACT	SCHEME	CONTACT	SCHEME	RELAY
52b/57.58	IA20309	E-103 SH.7	52a/3.4	IA20304	E-105 SH.9	96X-20309	A,B	OV1206	D,E	OV1210	96X1-20304	B,C	OV1206	D,E	OV1902	96X2-20304
52b/57.58	IA20409	E-103 SH.10	52a/3.4	IA20404	E-105 SH.7	96X-20409	A,B	OV1207	D,E	OV1211	96X1-20404	B,C	OV1207	D,E	OV1903	96X2-20404

SCHEMES INTLK'D												TERMINAL NUMBERS							
CONTACT	SCHEME	CONTACT	SCHEME	CONTACT	SCHEME	CONTACT	SCHEME	RELAY	CONTACT	SCHEME	DWG	F1	F2	F3	F4	F5	F6	F7	F8
B,C	OV1100	E,F	OV1104	H,J	OV1122	L,M	OV1126	96X-20309	H,J	SPARE	151205								
B,C	OV1101	E,F	OV1105	H,J	OV1125	L,M	OV1127	96X-20409	H,J	SPARE	151205								

TABLE B

SCHEME NO.	DESCRIPTION	ESS DIV	F/C	FUSE		AUX. RELAY	TIME DELAY RELAY	INTLK'S				SCHEMES INTLK'D											
				NUMBER	LOC			CONTACT	LOC	DWG	CONTACT	LOC	DWG	CONTACT	LOC	DWG	RELAY	CONTACT	SCHEME	CONTACT	SCHEME	CONTACT	
OV1902	HVAC L.O.O.P. IA	I	EK	FU-11, 12	OC877A-A	95X-20109	62X1-20104	62X-20104	52b/57.58	IA20101	E-103 SH.1	52a/3.4	IA20102	E-103 SH.1	95X-20109	RI, MI	1Q4181	E-258 SH.5	T2, R2, M2	SPARE	T3, R3, M3	SPARE	T4, R4, M4
OV1903	HVAC L.O.O.P. IB	II	FK	FU-11, 12	OC877B-A	95X-20209	62X1-20204	62X-20204	52b/57.58	IA20201	E-103 SH.4	52a/3.4	IA20202	E-103 SH.4	95X-20209	RI, MI	1S1204	E-258 SH.2					
OV1904	HVAC L.O.O.P. IZA	I	EK	FU-13, 14	OC877A-A	295X-20109	262X1-20104	262X-20104	52b/57.58	IA20101	E-103 SH.3	52a/3.4	IA20102	E-103 SH.3	295X-20109	RI, MI	2S1204	E-258 SH.11					
OV1905	HVAC L.O.O.P. IZB	II	FK	FU-13, 14	OC877B-A	295X-20209	262X1-20204	262X-20204	52b/57.58	IA20201	E-103 SH.3	52a/3.4	IA20202	E-103 SH.3	295X-20209	RI, MI	2Q4181	E-258 SH.14					

SCHEMES INTLK'D												TERMINAL NUMBERS								DESCRIPTION																	
SCHEME	RELAY	CONTACT	SCHEME	DWG	CONTACT	SCHEME	DWG	CONTACT	SCHEME	DWG	CONTACT	SCHEME	DWG	CONTACT	SCHEME	DWG	CONTACT	SCHEME	DWG	CONTACT	SCHEME	DWG	CONTACT	SCHEME	DWG	CONTACT	SCHEME	DWG	CONTACT	SCHEME	DWG	CONTACT	SCHEME	DWG	CONTACT	SCHEME	DWG
SPARE	62X1-20104	RI, MI	2V5500	E-207 SH.5	R2, M2	1V2540	E-192 SH.8	R3, M3	1V5501	E-207 SH.3	R4, M4	SPARE		OC877A-A	E1	E2	E3	E4	E5	E6	E7	E8	HVAC LOOP IC	62X1-20304	9.3	B-192 SH.8											
	62X1-20204	RI, MI	2V5501	E-207 SH.5	R2, M2	1V2541	E-192 SH.8	R3, M3	1V5502	E-207 SH.3	R4, M4	SPARE		OC877B-A	E1	E2	E3	E4	E5	E6	E7	E8	HVAC LOOP ID	62X1-20404	9.3	E-192 SH.8											
	262X1-20104	RI, MI	2V2540	E-192 SH.31	R2, M2	SPARE		R3, M3	SPARE		R4, M4	SPARE		OC877A-A	E9	E10	E11	E12	E13	E14	E15	E16															
	262X1-20204	RI, MI	2V2541	E-192 SH.31	R2, M2	SPARE		R3, M3	SPARE		R4, M4	SPARE		OC877B-A	E9	E10	E11	E12	E13	E14	E15	E16															

REFERENCE DWG'S.

BECHTEL NO.	PL. NO.
E-42	A-107191
V-186	B-106926
E-103	D-107392
E-109	D-107392
E-64	D-107219

- NOTES:**
- FOR STANDARD SYMBOLS FOR ELECTRICAL DIAGRAM SEE DWG. E-42.
 - SPARE CONTACTS FOR THESE RELAYS ARE NOT WIRE TO TERMINAL BLOCKS.
 - FOR CHAN C (1C) 125VDC (1D634 BKR 9) POWER SUPPLY TO OC877A REF. DWG. E-64 SH.12.
FOR CHAN D (1D) 125VDC (1D644 BKR 9) POWER SUPPLY TO OC877B REF. DWG. E-64 SH.12.
FOR DIV I (1A) 125VDC (1D614 BKR 15) POWER SUPPLY TO OC877A REF. DWG. E-64 SH.11.
FOR DIV II (1B) 125VDC (1D624 BKR 17) POWER SUPPLY TO OC877B REF. DWG. E-64 SH.11.
FOR DIV I (2A) 125VDC (2D614 BKR 15) POWER SUPPLY TO OC877A REF. DWG. E-64 SH.21.
FOR DIV II (2B) 125VDC (2D624 BKR 17) POWER SUPPLY TO OC877B REF. DWG. E-64 SH.21.

PRO APERTURE CARD

THIS DOCUMENT IS UNDER PPL ADMINISTRATIVE CONTROL. NO CHANGES CAN BE MADE WITHOUT PRIOR PPL APPROVAL.

NO.	DATE	REVISIONS	BY	CHK	APP
1	6/1/75	ISSUED 'AS-BUILT'	JG	YS	AV
2	10/1/75	REVISED TO INCORP. IDCN #1 (DCP # 022 REV. 0)	JG	YS	AV
3	11/1/75	REV. DELAY NOT (MAY) 2 IN CORP. (SEE 1A)	JG	YS	AV
4	12/1/75	ADDED TERMINAL NOS & REVISED 'AS-BUILT'	JG	YS	AV
5	1/1/76	RE-ISSUED 'AS-BUILT' INCORP. IDCN #2 (DCP # 744 REV. 0)	JG	YS	AV
6	2/1/76	ISSUED FOR CONSTRUCTION	JG	YS	AV

PENNSYLVANIA POWER & LIGHT COMPANY
ALLENTOWN, PENNSYLVANIA
SUSQUEHANNA STEAM ELECTRIC STATION - UNIT 1, UNIT 2

BECHTEL - SAN FRANCISCO

SCHEMATIC DIAGRAM HVAC CONTROL STRC CHILLED WATER SYSTEM L.O.O.P. RESET - COMMON

JOB No.	DRAWING No.	REV.
8956	E-214 SH.9	8

D-107363 SH.9

24X

I certify that the microfilm image contained on this microform was made in the normal and regular course of business. This is a true, full, correct and complete reproduction and replacement for and/or in lieu of original documents generated by the Bechtel group of companies.

Signed: _____ Date: 1/31/83 Camera Type: 350 I

Docket # 50-387
Control # 8301650245-41
Date 3-29-83 of Documents
REGULATORY DOCKET FILE

D