



This drawing and the design it covers are the property of BECHTEL. They are hereby loaned and on the borrower's express agreement that they will not be reproduced, copied, loaned, exhibited, nor used except in the limited way and private use permitted by any written consent given by the lender to the borrower.


774 SIP Amendment No. 1102-1000

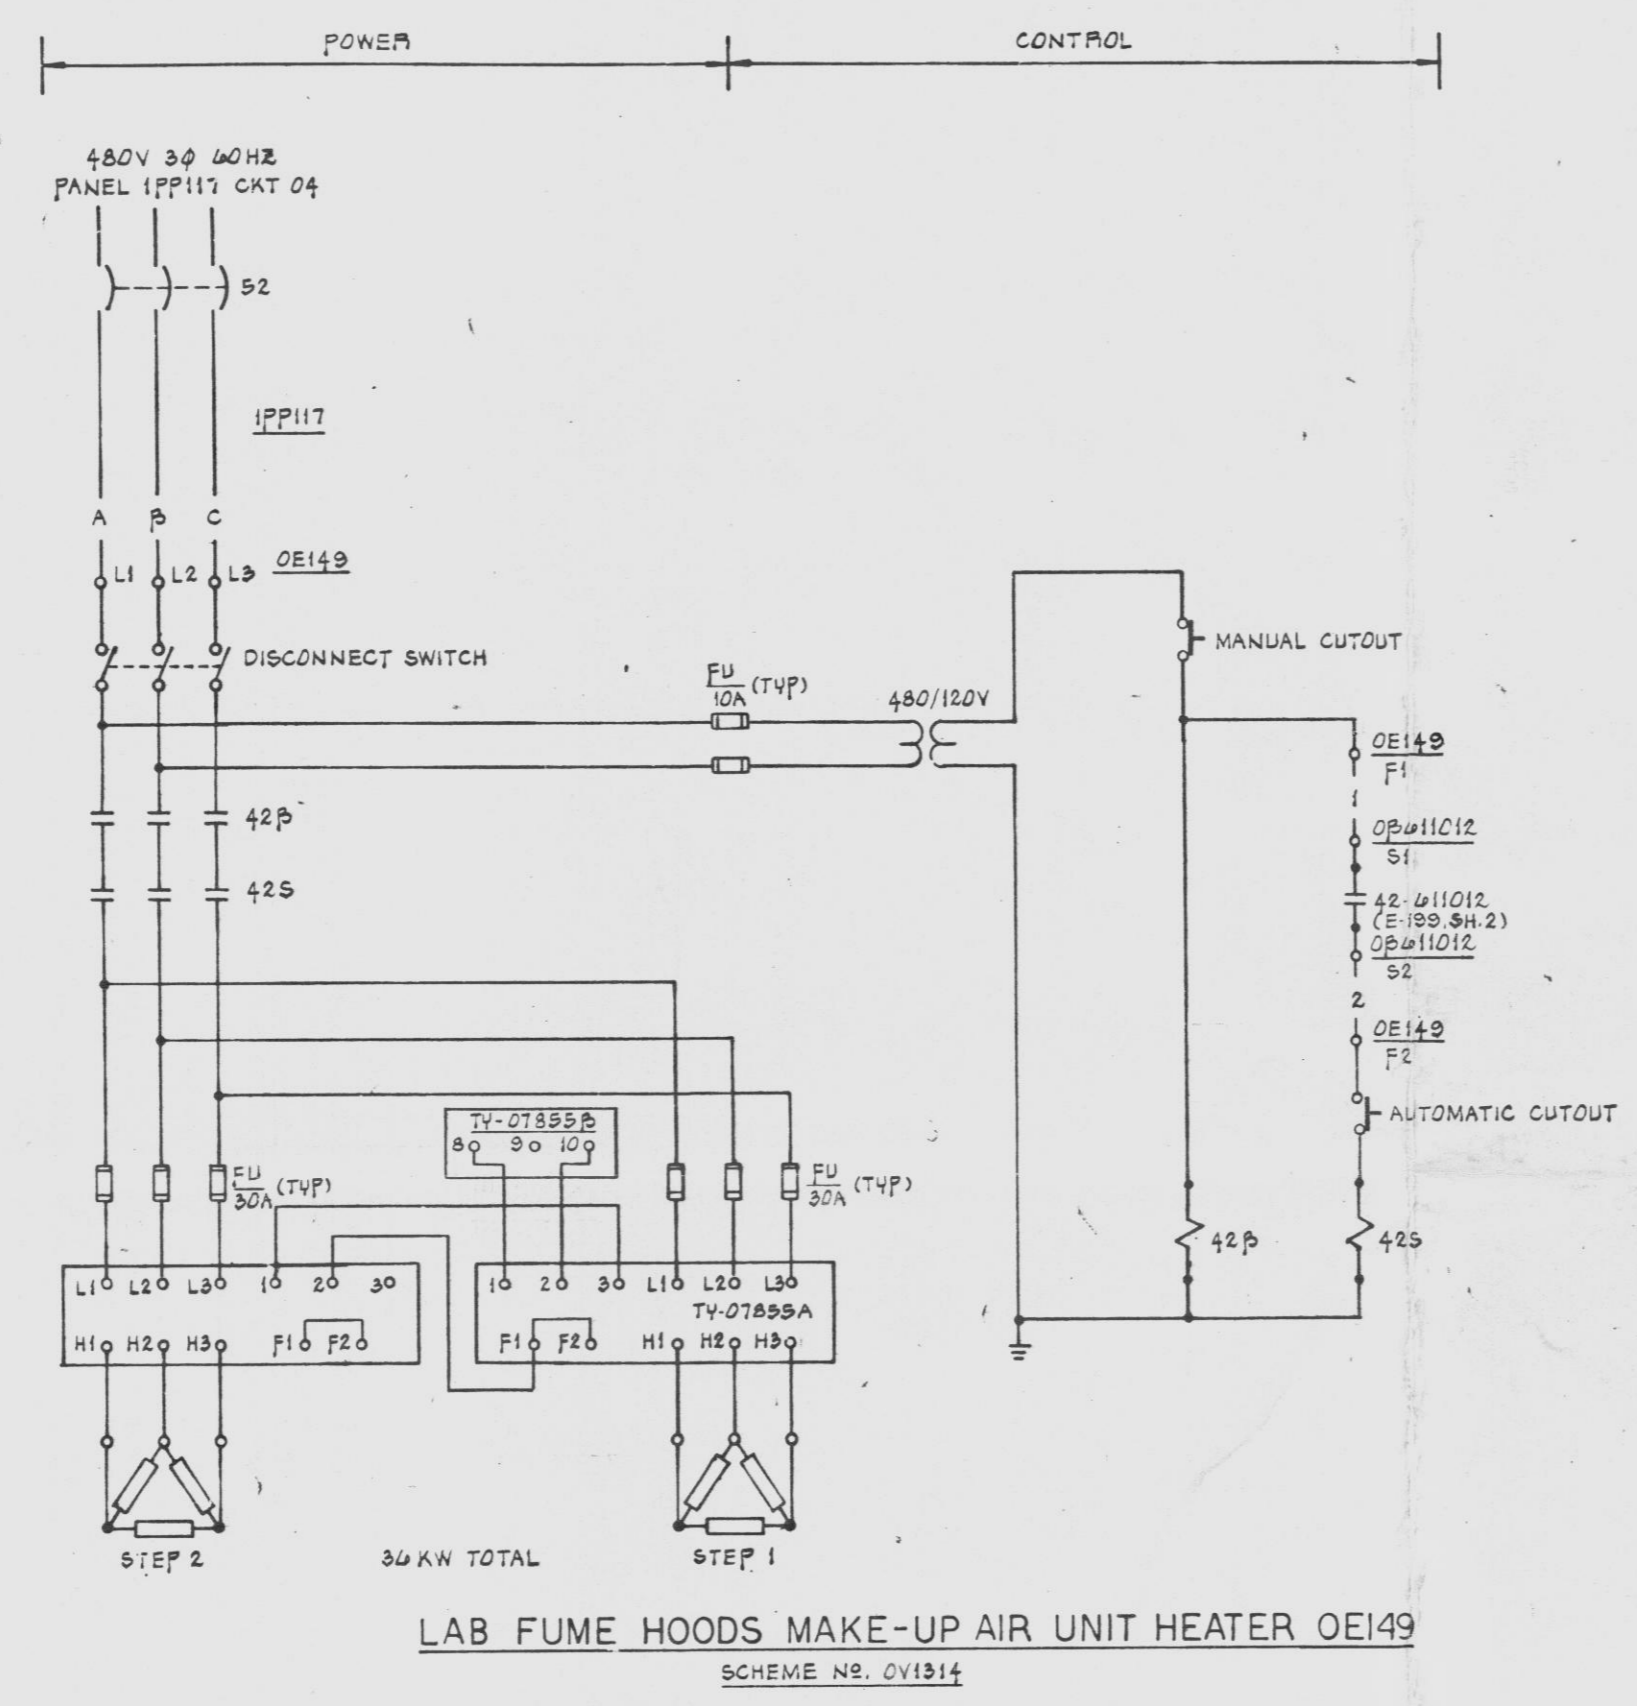

LAB FUME HOODS MAKE-UP AIR UNIT HEATER OEI49  
SCHEME NO. OV1314

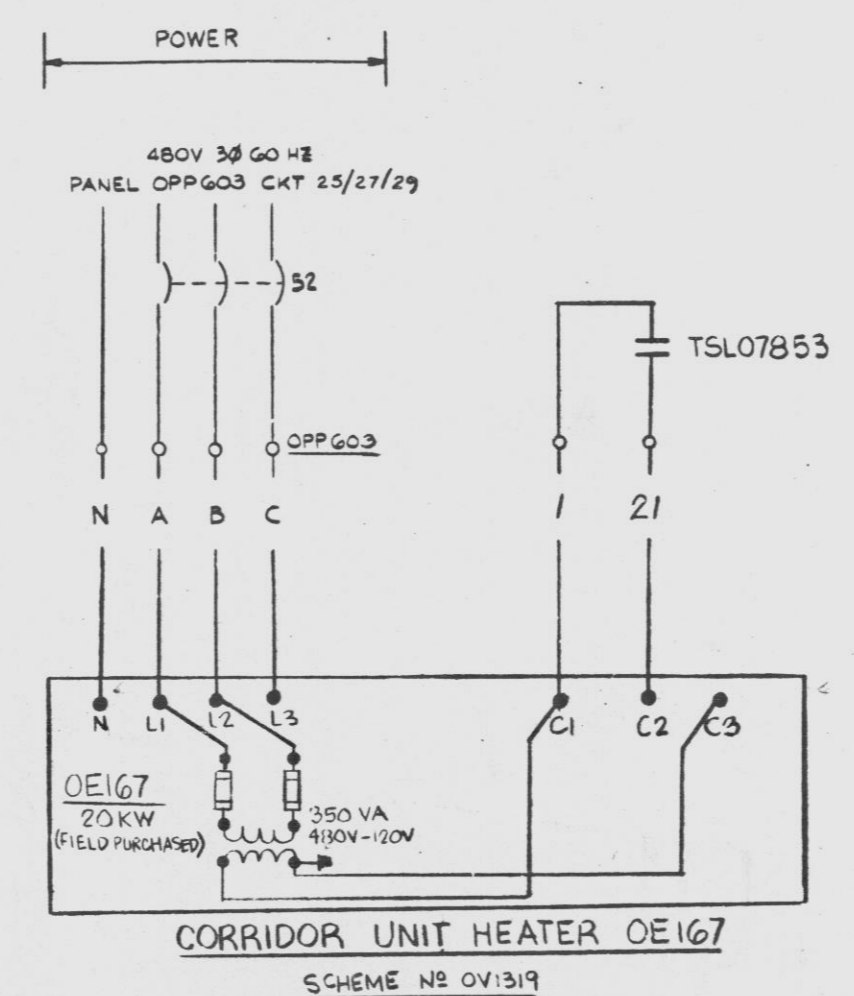

CORRIDOR UNIT HEATER OEI67  
SCHEME NO. OV1319

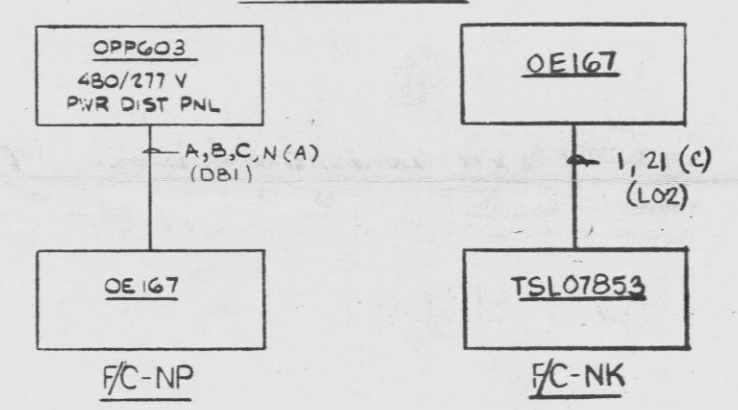

- NOTES:
- FOR STANDARD SYMBOLS FOR ELECTRICAL DIAGRAM SEE DWG E-42.
  - REF. V/P 8856 M-309-53-1 FOR VENDOR DWG OF HEATERS UNIT.

P.R.C.  
APERTURE  
CARD

THIS DOCUMENT IS UNDER PPL ADMINISTRATIVE CONTROL. NO CHANGES CAN BE MADE WITHOUT PRIOR PPL APPROVAL.

REFERENCE DWG'S.	
BECHTEL NO.	PL. NO.
E-42	A-107101
M-309-53	FF108500
E-199	D-107348
V-178	B-104518

NO.	DATE	REVISIONS	BY	CHKD	ENGR	APP.
3/14/82		FCR 2832 WAS INCORPORATED IN REV 4 AS MODIFIED BY VCR 2982 - REVISED PUL 04/82				
7/14/82		REVISED TO INCL. FCR E-2982				
8/6/82		REVISED PWR PNL SCHEME OV1319				
8/23/82		ADDED SCHEME OV1319				
9/16/82		ISSUED "AS BUILT"				
10/1/82		ISSUED FOR CONSTRUCTION				

SCALE: C=1  
DESIGNED: A. SANCHEZ  
DRAWN: M. PORTOS

**PENNSYLVANIA POWER & LIGHT COMPANY**  
ALLENTOWN, PENNSYLVANIA  
SUSQUEHANNA STEAM ELECTRIC STATION - UNIT 1, UNIT 2

BECHTEL - SAN FRANCISCO

SCHEMATIC DIAGRAM HVAC  
CONTROL STRUCTURE HEATING SYS  
CONTROL ROOM HEATERS-COMMON

JOB No.	DRAWING No.	REV.
8856	E-242 SH7	G

UNCONTROLLED DOCUMENT  
FOR REFERENCE ONLY

G 1/2 C 2 2 SCHEMATIC CONTROL STRUCTURE HEATING SYSTEMS

24X

I certify that the microfilm image contained on this microform was made in the normal and regular course of business. This is a true, full, correct and complete reproduction and replacement for and/or in lieu of original documents generated by the Bechtel group of companies.

Signal: JACINTO  
Camera Operator: [Signature]  
Camera Type: [Signature]  
NO. 1

Docket # 50397  
Control # 8804050245-1106  
Date: 3-29-83

D