


This drawing and the design it covers are the property of BECHTEL. They are merely loaned and on the borrower's express agreement that they will not be reproduced, copied, loaned, exhibited, or used except in the limited way and private use permitted by any written consent given by the lender to the borrower.

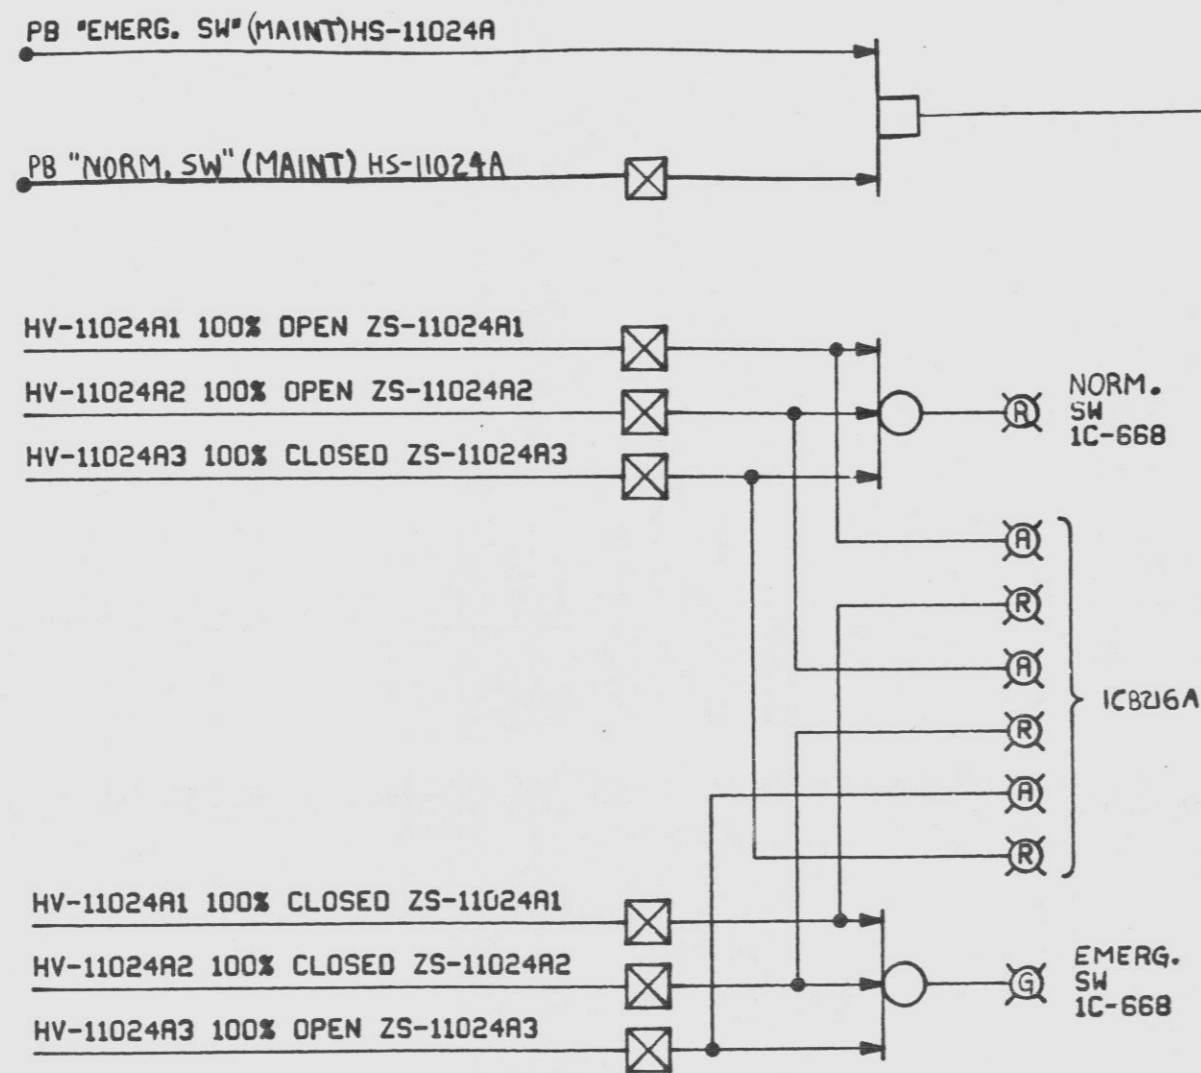

HS-11024B	SV-11024B	HV-11024B1	HV-11024B2	HV-11024B3	ZS-11024B1	ZS-11024B2	ZS-11024B3	IC8216B	E-148, SH 1
HS-11024A	SV-11024A	HV-11024A1	HV-11024A2	HV-11024A3	ZS-11024A1	ZS-11024A2	ZS-11024A3	IC8216A	E-148, SH 1
HAND SWITCH	SOLENOID VALVE	1	2	3	1	2	3	LAMP PANEL	ELECT SCHEME
		HAND VALVE			POSITION SWITCH				

ENERGIZE
SV-11024A
OPEN
HV-11024A1
HV-11024A2
CLOSE
HV-11024A3

DE-ENERGIZE
SV-11024A
CLOSE
HV-11024A1
HV-11024A2
OPEN
HV-11024A3

Ⓡ Ⓢ

NORM SW EMERG SW

HS-11024A
IC-668

MAINTAINED CONTACTS
ALTERNATE ACTION

Ⓡ Ⓢ

HV-11024A1

Ⓡ Ⓢ

HV-11024A2

Ⓡ Ⓢ

HV-11024A3

(LAMPS ONLY)
PANEL IC8216A

UNCONTROLLED DOCUMENT
FOR REFERENCE ONLY

NOTE: ALL EQUIPMENT POWER FROM SAC.

THIS DOCUMENT IS UNDER PPS&L ADMINISTRATIVE CONTROL. NO CHANGES CAN BE MADE WITHOUT PRIOR PPS&L APPROVAL.

REFERENCE DWGS.

BECHTEL NO.	PL NO.
M-110	E-106215
E-148 SH 1 (REV 11)	D-107297 SH 1

7/12	"AS-BUILT"	CL	LOV		
7/12	CORRECTED "NORM. EMERG. SW"				
7/12	REVISED AS NOTED				
7/12	REVISED AS NOTED				
7-28	REDRAWN				
75					
NO.	DATE	REVISIONS	BY	CHKD	DESIGN
SCALE	DESIGNED	LOV	DRAWN	SCALE	APP'D
PENNSYLVANIA POWER & LIGHT COMPANY					
ALLENTOWN, PENNSYLVANIA					
SUSQUEHANNA STEAM ELECTRIC STATION - UNIT 1, UNIT 2					
BECHTEL - SAN FRANCISCO					
LOGIC DIAGRAM					
SERVICE WATER SYSTEM					
RBCCH HX TRANS. VALVES					
JOB No.	DRAWING No.	REV.			
8856	J-110 SH 2	7			
B-103400 SH 2					

GIJSD

LGC OGRM SERVICE WATER

W

11 x 22

16X

I certify that the microfilmed image contained on this microform was made in the normal and regular course of business. This is a true, full, correct and complete reproduction and replacement for and/or in lieu of original documents generated by the Bechtel group of companies.

Signed: DANNY Date: 7-27-82 Camera Type: MRG 1
Camera Operator



Doc # 50-387
Control # 88465245-149
Date 3-27-82 of Document
REGULATORY DOCKET FILE