


This drawing and the design it covers are the property of BECHTEL. They are merely loaned and on the borrower's express agreement that they will not be reproduced, copied, loaned, exhibited, or used except in the limited way and private use permitted by the lender to the borrower.

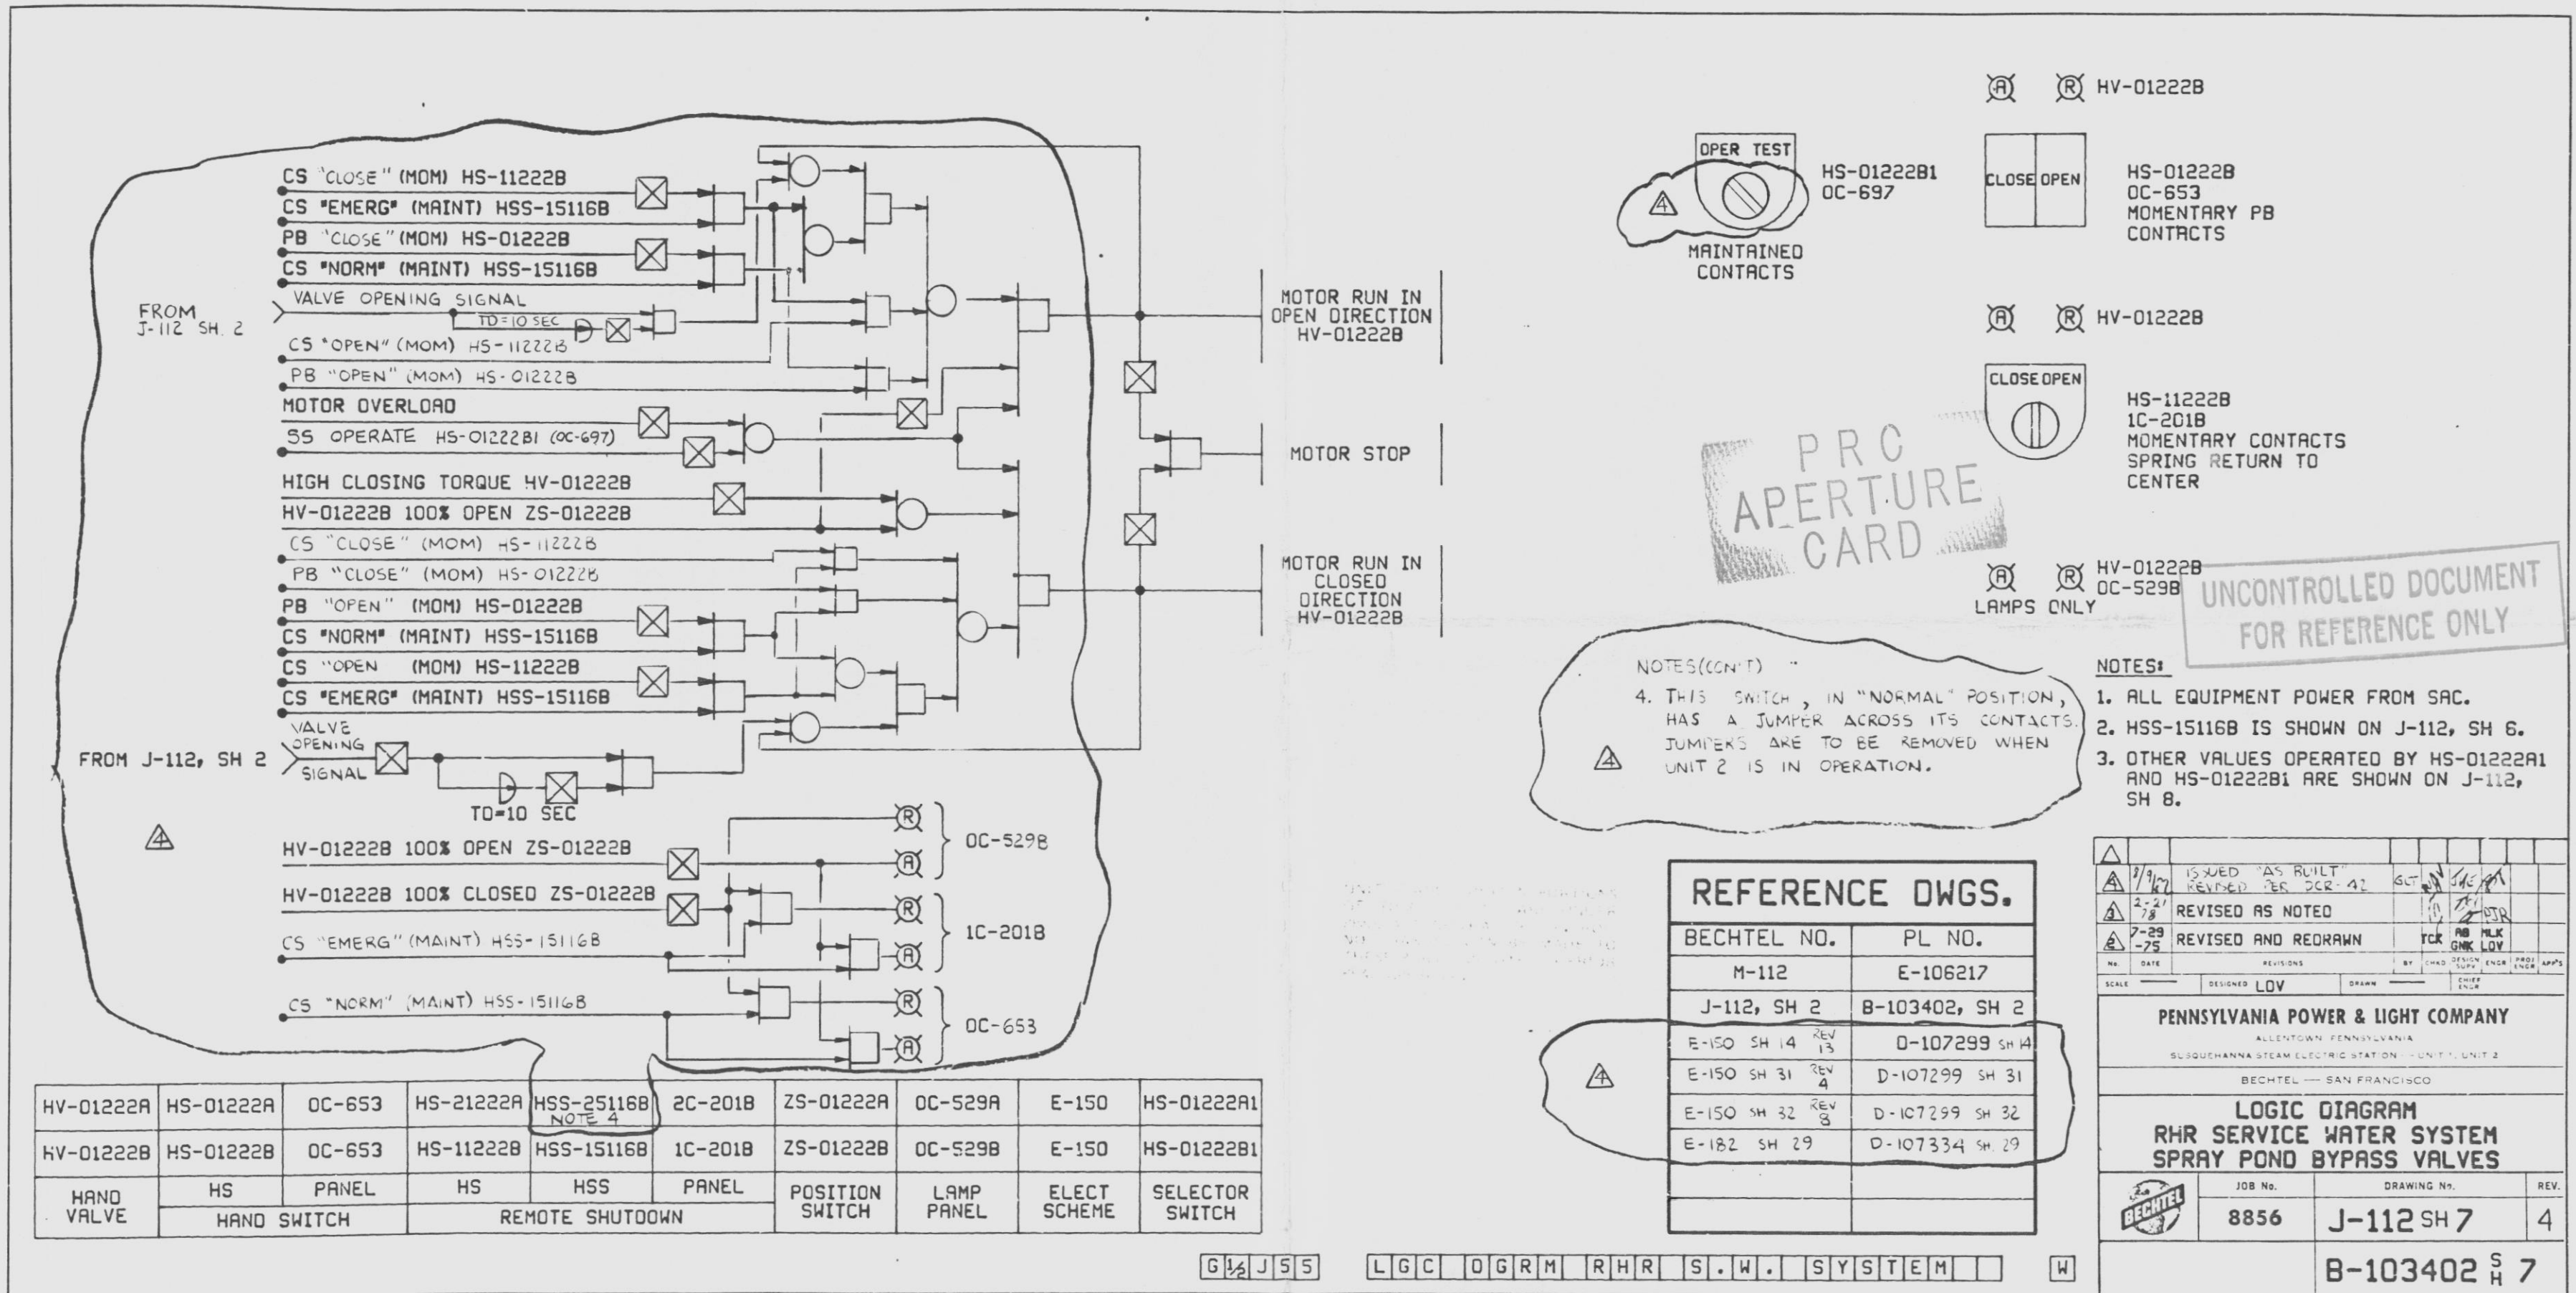

HV-01222A	HS-01222A	OC-653	HS-21222A	HSS-25116B	2C-201B	ZS-01222A	OC-529A	E-150	HS-01222A1
HV-01222B	HS-01222B	OC-653	HS-11222B	HSS-15116B	1C-201B	ZS-01222B	OC-529B	E-150	HS-01222B1
HAND VALVE	HS PANEL		HS PANEL	HSS PANEL	POSITION SWITCH		LAMP PANEL	ELECT SCHEME	SELECTOR SWITCH
	HAND SWITCH		REMOTE SHUTDOWN						

REFERENCE DWGS.

BECHTEL NO.	PL NO.
M-112	E-106217
J-112, SH 2	B-103402, SH 2
E-150 SH 14	D-107299 SH 14
E-150 SH 31	D-107299 SH 31
E-150 SH 32	D-107299 SH 32
E-182 SH 29	D-107334 SH 29


1/9/77	ISSUED "AS BUILT"	REVISED PER DCR 42	GT	
2-21	REVISED AS NOTED			
7-29-78	REVISED AND REDRAWN		TCK	MRK
			CHK	LDV
SCALE: DESIGNED: LOV DRAWN: TCK				
PENNSYLVANIA POWER & LIGHT COMPANY				
ALLENTOWN, PENNSYLVANIA				
SUSQUEHANNA STEAM ELECTRIC STATION - UNIT 1, UNIT 2				
BECHTEL - SAN FRANCISCO				
LOGIC DIAGRAM				
RHR SERVICE WATER SYSTEM				
SPRAY POND BYPASS VALVES				
JOB No.	DRAWING No.	REV.		
8856	J-112 SH 7	4		
B-103402 SH 7				

16X

I certify that the microfilmed image contained on this microform was made in the normal and regular course of business. This is a true, full, correct and complete reproduction and replacement for and/or in lieu of original documents generated by the Bechtel group of companies.

Signed: NINOUS Date: 8-19-82 Camera Type: MRG-11

Camera Operator

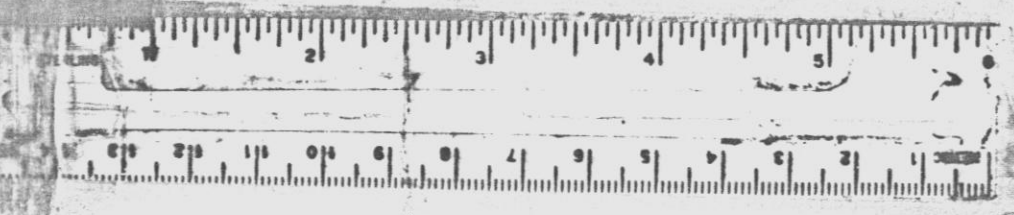

Doc# 58-387
 Cont# 8304050245-162
 Date 3-29-83 of Document
 REGULATORY DOCKET FILE

D