



This drawing and the design it covers are the property of BECHTEL. They are merely loaned and on the borrower's express agreement that they will not be reproduced, copied, loaned, exhibited, or used except in the limited way and private use permitted by any written consent given by the lender to the borrower.

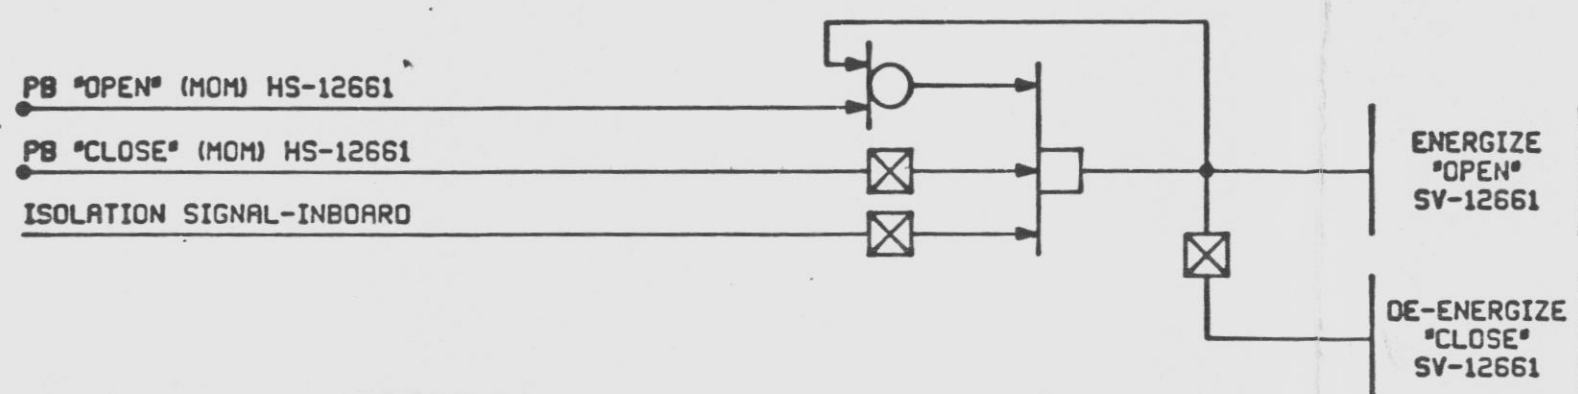

VALVE 100% CLOSED ZS-12661
VALVE 100% OPEN ZS-12661

SV-12671	HS-12671	1C601	ZS-12671		INBOARD DIV. I
SV-12661	HS-12661	1C601	ZS-12661		INBOARD DIV. I
SOLENOID VALVE	HAND SWITCH	HS PANEL	POSITION SWITCH		ISOLATION SIGNAL

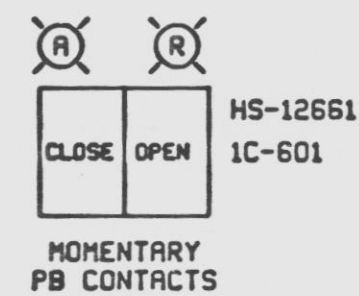

PRO
APERTURE
CARD

UNCONTROLLED DOCUMENT
FOR REFERENCE ONLY

REFERENCE DWGS.	
BECHTEL NO.	PL NO.
M-126	E-106231
E-172 SH1 REV 7	D-107321

THIS DOCUMENT IS UNDER PP&L
ADMINISTRATIVE CONTROL. NO
CHANGES CAN BE MADE WITHOUT
PRIOR PP&L APPROVAL.

AS BUILT	REVISED PER DCR-42	FB	1	2	3	4	5	6	7	8	9	10	11	12
2-24	REVISED AS NOTED													
2-1	REVISED AS NOTED													
4-15	ISSUED FOR CONSTR.													
DATE	REVISIONS	BY	CHKD	REL'D	CHKD	REL'D	CHKD	REL'D	CHKD	REL'D	CHKD	REL'D	CHKD	REL'D
SCALE	DESIGNED	LDV	BRAND	DATE	DATE	DATE	DATE	DATE	DATE	DATE	DATE	DATE	DATE	DATE
PENNSYLVANIA POWER & LIGHT COMPANY														
ALLENTOWN, PENNSYLVANIA														
SUSQUEHANNA STEAM ELECTRIC STATION - UNIT 1, UNIT 2														
BECHTEL - SAN FRANCISCO														
LOGIC DIAGRAM														
CONTAINMENT INSTRUMENT GAS														
CONTAIN. ISOLATION SOLENOID VALVES														
JOB No.	DRAWING No.	REV.												
8856	J-126SH 2	3												
B-103416 S H 2														

61Q25


LGC OGRM CONTAIN INST GAS W

11 x 22

16X

I certify that the microfilmed image contained on this microform were made in the normal and regular course of business. This is a true, full, correct and complete reproduction and replacement for and/or in lieu of original documents generated by the Bechtel group of companies.

Signed **DANNY** Date **7-29-82** Camera Type **MRG I**
Camera Operator

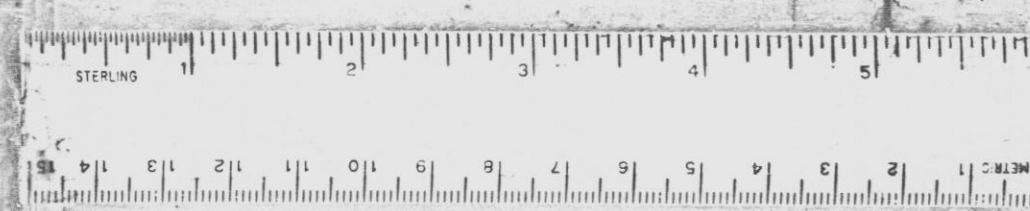

Doc # 50-387
Cont # 8301050240-166
Date 3-29-83
REGULATORY DOCKET FILE

D