

- NOTES:**
1. ALL INSTRUMENT AND EQUIPMENT NUMBERS TO BE PREFIXED WITH "2TML-" EXCEPT WHERE A DIFFERENT PREFIX IS SHOWN.
 2. # - REPRESENTS EQUIPMENT SUPPLIED BY GE-LSTG. GE-LSTG DESIGNATIONS SHOWN IN PARENTHESIS.
 3. COMMON ANNUNCIATOR WINDOW FOR TURBINE GENERATOR MOTOR SUCTION OIL PUMP P3 TROUBLE.
 4. LOGIC FOR 2TML-PS127 IS SHOWN ON LSK-1-4.

SI
APERTURE
CARD


NOTE: THIS DRAWING WAS CREATED USING COMPUTER AIDED DRAWING. DO NOT MAKE MANUAL CHANGES.

NUCLEAR NON SAFETY RELATED

SETPOINTS SHOWN ON LOGIC DIAGRAMS ARE FOR LOGIC CLARIFICATION ONLY AND MAY BE ONLY APPROXIMATIONS OF THE ACTUAL PROCESS SETPOINT. REFER TO SETPOINT DATA SHEETS FOR ACTUAL PROCESS SETPOINTS.

APP		DATE	BY	DESCRIPTION	REV
AKJ	AKJ	12/26/89		LOGIC DIAGRAM - TURBINE GENERATOR LUBE OIL MOTOR SUCTION OIL PUMP	1
DES	AKJ				
APP	SCALE	DWG NO	NONE		
REV			LSK-16-2.1		

REV	DATE	BY	HF	DESCRIPTION	CK	APP.	REV	DATE	BY	HF	DESCRIPTION	CK	APP.	REV	DATE	BY	HF	DESCRIPTION	CK	APP.
10	11/18/91	JP					10	11/18/91	JP					11	06-26-89	TE		REDRAWN AS-BUILT	JSM	EMD

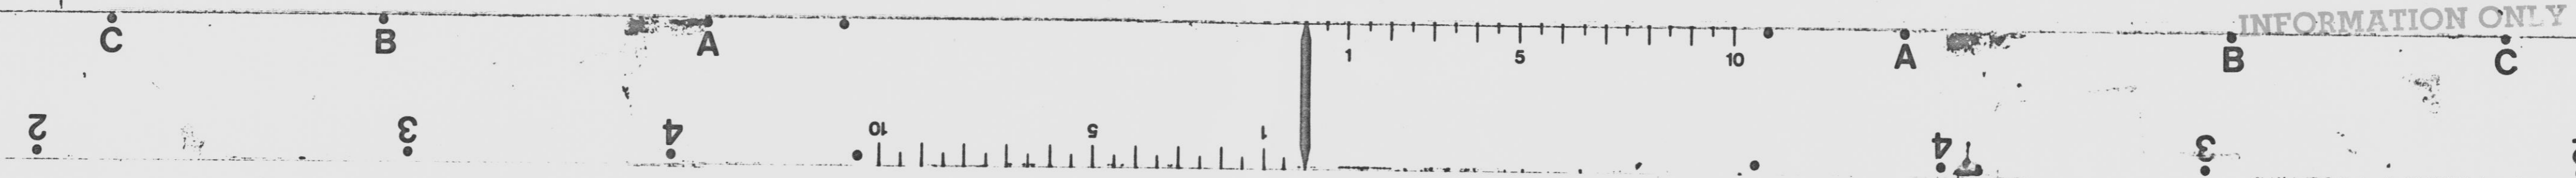

9305030009 07-126-91 D 9305030009