


This drawing and the design it covers are the property of BECHTEL. They are hereby loaned and on the borrower's express agreement that they will not be reproduced, copied, loaned, exhibited, nor used except in the limited way and under the conditions permitted by any written consent given by the lender to the borrower.

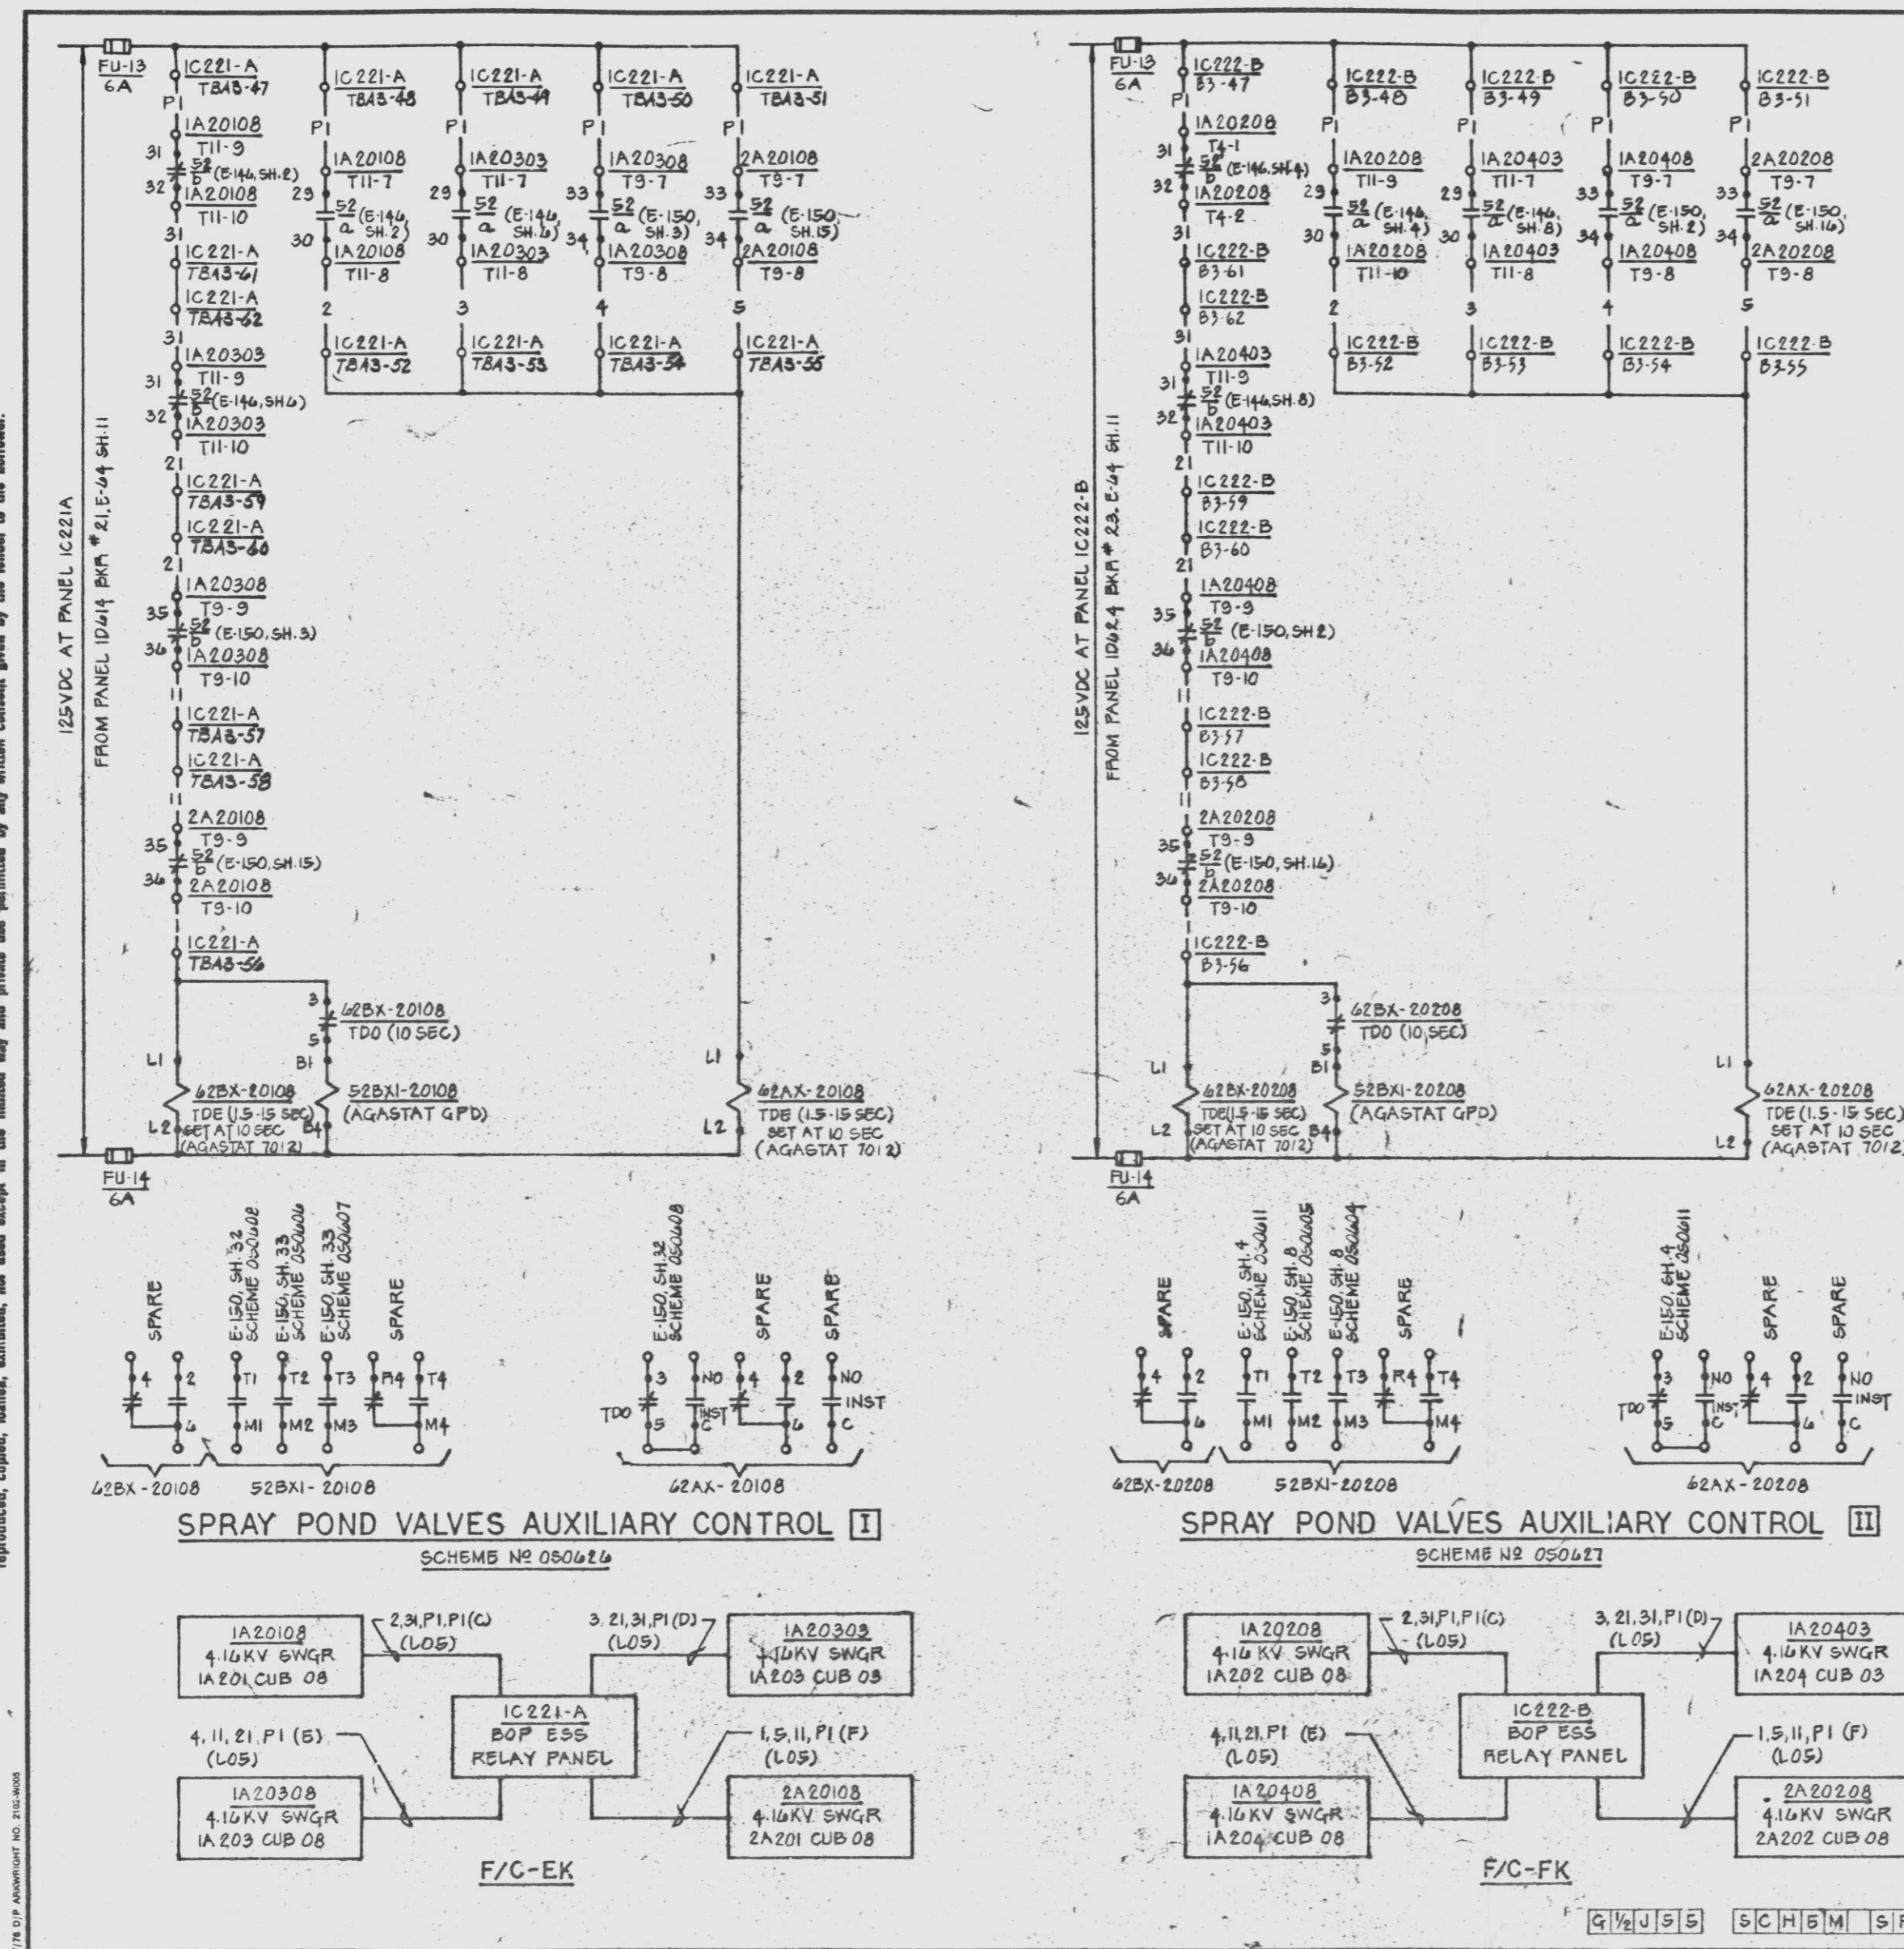

NOTES:
1. FOR STANDARD SYMBOLS FOR ELECTRICAL DIAGRAMS, SEE DWG 8856-E-42.

POOR ORIGINAL

Docket # 50-387
Control # 8203090234 - 119
Date 3/1/83 of Document:
REGULATORY DOCKET FILE

PRC
APERTURE
CARD

BECHTEL NO.	PL. NO.
E-42	A-107191
E-146	D-107295
J-111	B-103401
J-112	B-103402
E-44	D-107213

NO.	DATE	REVISIONS	BY	CHK	DESIGN	ENG	APP
1	6/7/82	ISSUED "AS BUILT"					
2	4/1/83	ADDED TERM. NOS. ON PANEL 16221-A (DOR 42)					
3	4/1/83	INCORP. DCN #1, SFR 798					
4	4/1/83	CHANGED FUSE RATINGS AS SHOWN					
5	4/1/83	ISSUED FOR CONSTRUCTION					

PENNSYLVANIA POWER & LIGHT COMPANY		
ALLENTOWN, PENNSYLVANIA		
SUSQUEHANNA STEAM ELECTRIC STATION - UNIT 1, UNIT 2		
BECHTEL - SAN FRANCISCO		
SCHEMATIC DIAGRAM		
SPRAY POND VALVES AUXILIARY CONTROL		
COMMON		
JOB No.	DRAWING No.	REV.
8856	E-150 SH31	4
D-107299 SH31		

24X

I certify that the microfilmed image contained on this microform was made in the normal and regular course of business. This is a true, full, correct and complete reproduction and replacement for and/or in lieu of original documents generated by the Bechtel group of companies.

Sign: RHEY Date: 10/10/82 Camera Type: MRG-1

D