


This drawing and the design it covers are the property of BECHTEL. They are hereby loaned and on the borrower's express agreement that they will not be reproduced, copied, loaned, exhibited, nor used except in the limited way and private use permitted by any written consent given by the lender to the borrower.

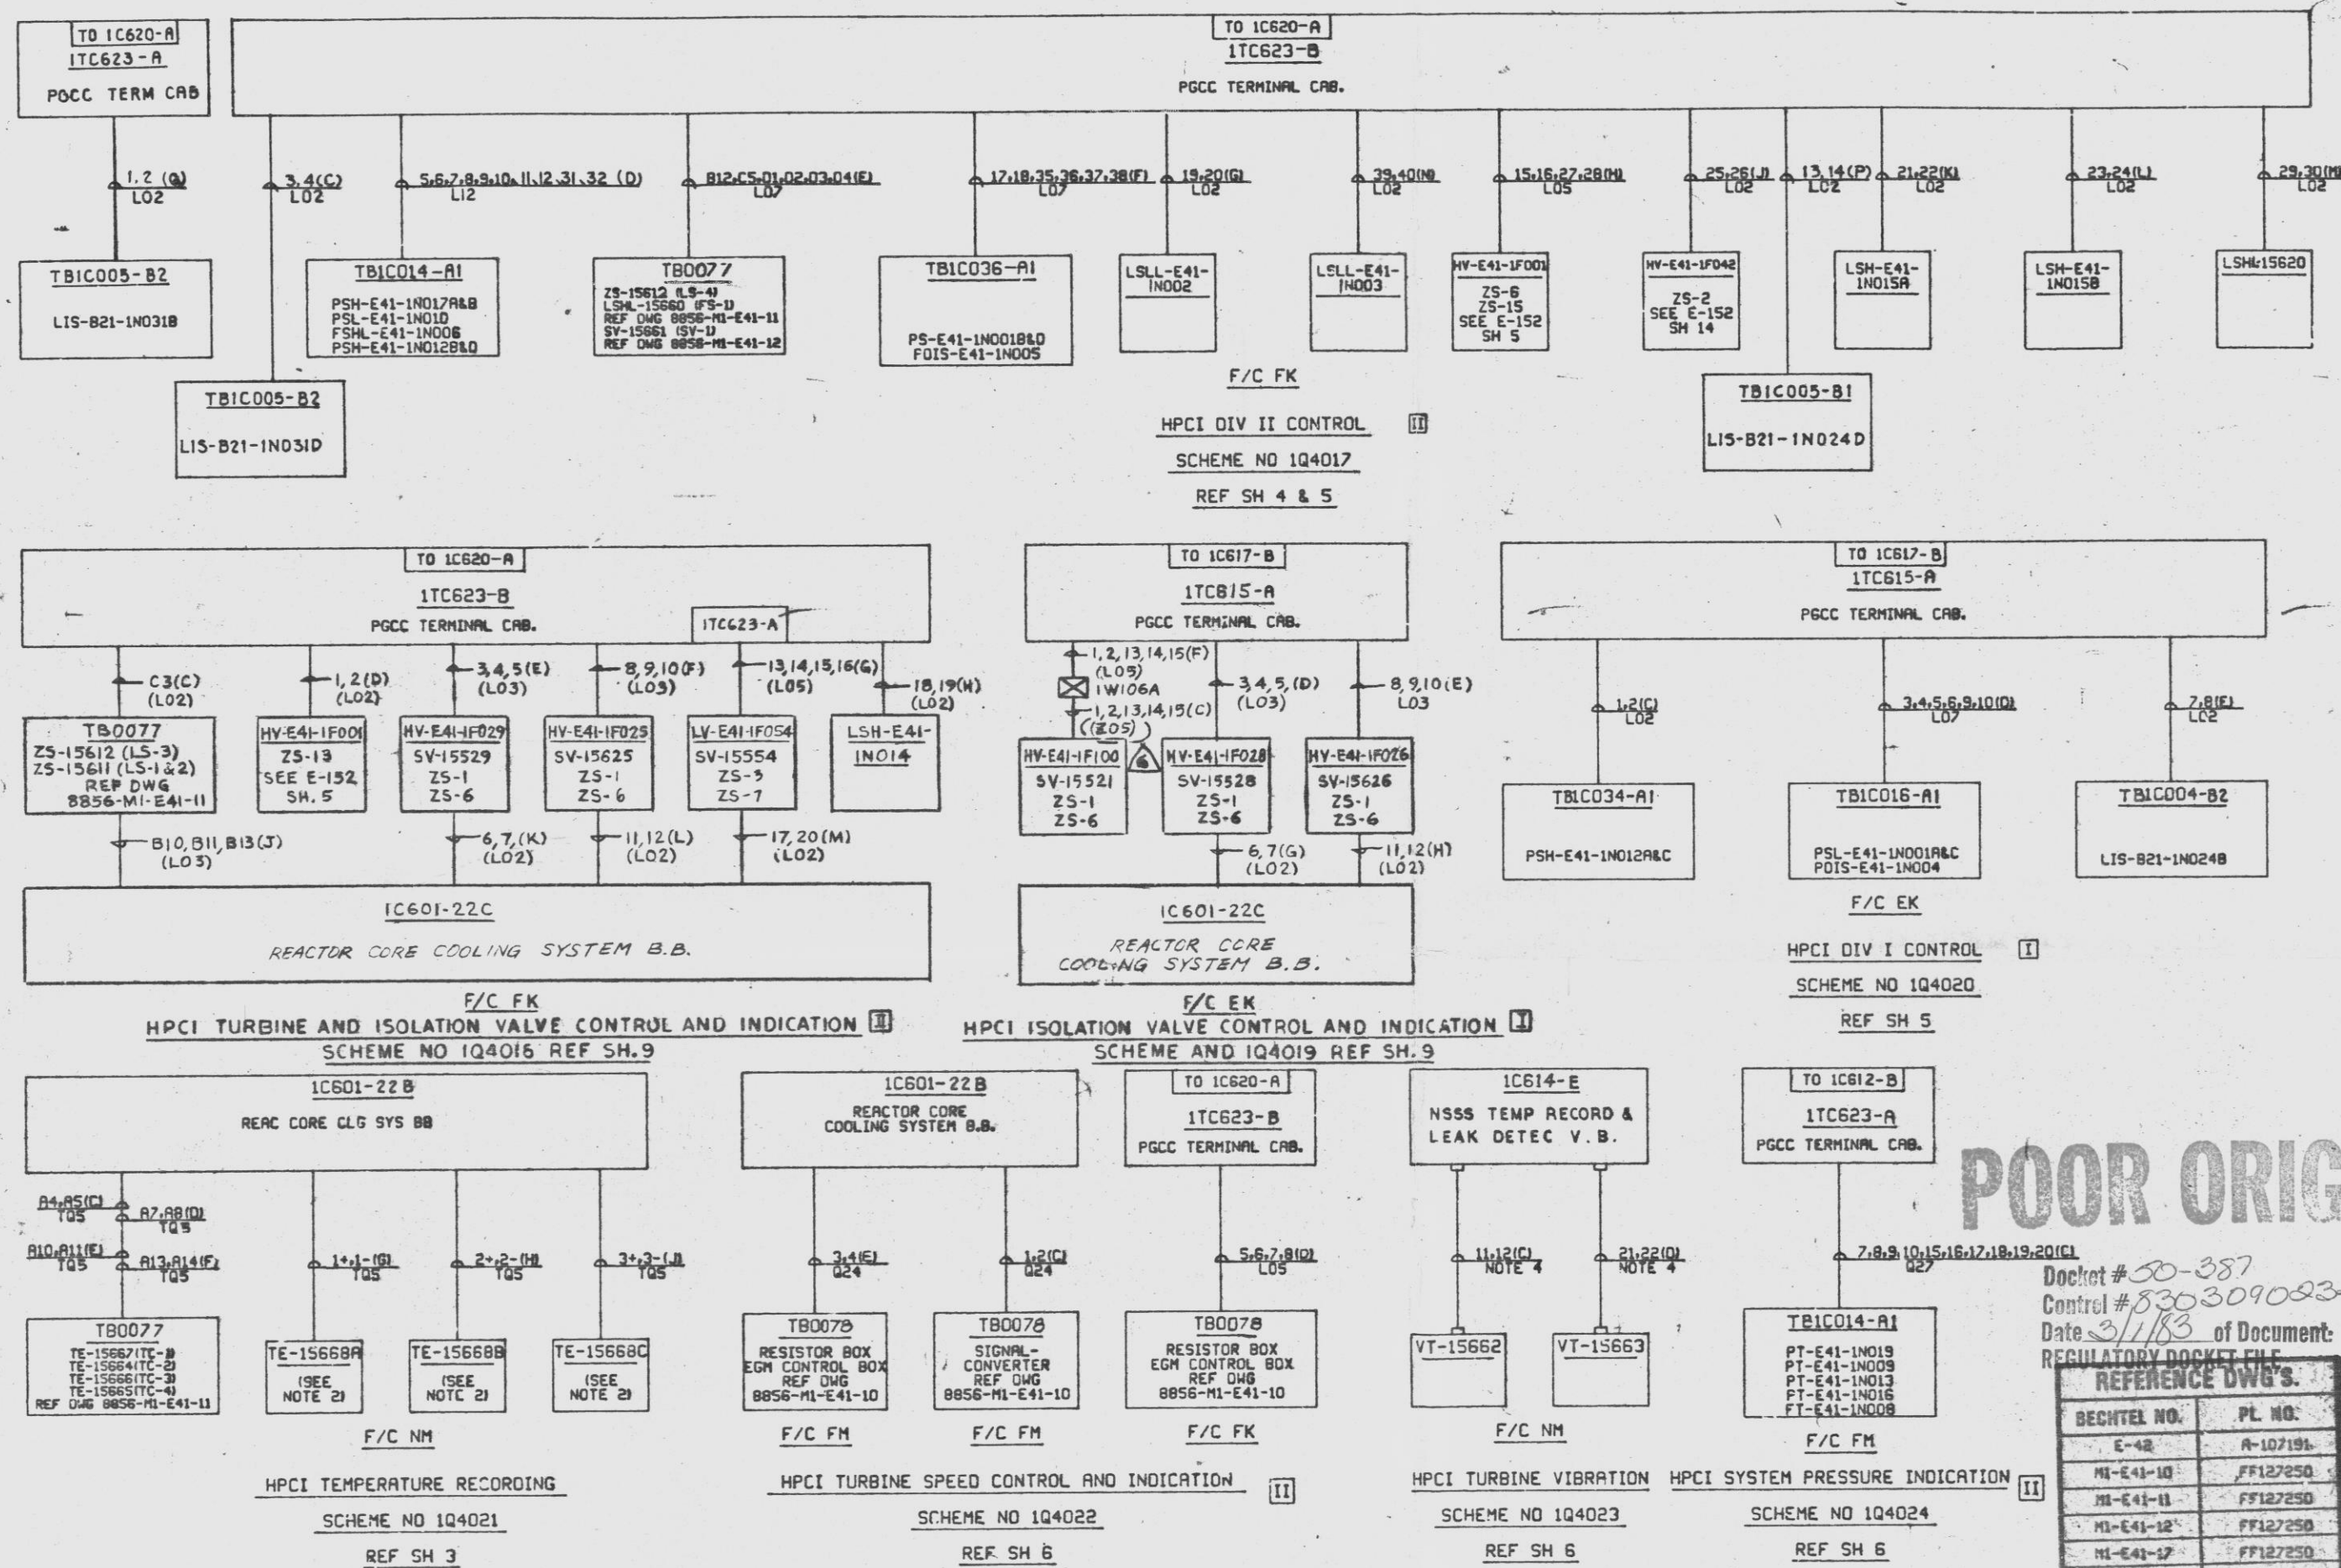

VALVE LIMIT SWITCH DEVELOPMENT				
CONTACT	100% OPEN	INTERMEDIATE	100% CLOSED	CONTACT USED
LSH-E41-1N015A				SPARE
LSH-E41-1N015B				SPARE
LSH-E41-1N015C				THIS SH
LSH-E41-1N015D				SPARE
LSH-E41-1N015E				SPARE
LSH-E41-1N015F				THIS SH
LSH-E41-1N015G				SPARE
LSH-E41-1N015H				SPARE

LV-E41-1F054

VALVE LIMIT SWITCH DEVELOPMENT				
CONTACT	100% OPEN	INTERMEDIATE	100% CLOSED	CONTACT USED
ZS-1 A-H-B				THIS SH
ZS-2 C-H-D				SPARE
ZS-3 E-H-F				SPARE
ZS-4 G-H-H				E 325/12
ZS-5 A-H-B				SPARE
ZS-6 C-H-D				THIS SH
ZS-7 E-H-F				SPARE
ZS-8 G-H-H				SPARE

NOTES:

- FOR STANDARD SYMBOLS FOR ELECTRICAL DIAGRAMS SEE 8856-E-42.
- T/C LOCATED ON HPCI TURBINE PUMPS UP204R AND UP204B. REF DWG 8856-MI-E41-44.
- NUMBERS IN PARENTHESIS ARE G.E. DEVICE NUMBERS.
- SUPPLIED BY TERRY STEAM TURBINE CO. CABLE ASSEMBLY CEC #49637-720B. REF DWG 8856-MI-E41-17.
- DESIGN BASED ON GE/ARPD ELEMENTARY 791E20 W/V/P 8856-MI-E41-03.

THIS DOCUMENT IS UNDER PPL ADMINISTRATIVE CONTROL. NO CHANGES CAN BE MADE WITHOUT PRIOR PPL APPROVAL.

POOR ORIGINAL


Docet # 50-387
Control # 8303090834
Date 3/1/83 of Document:

REFERENCE DWG'S	
BECHTEL NO.	PL. NO.
E-42	A-107191
MI-E41-10	FF127250
MI-E41-11	FF127250
MI-E41-12	FF127250
MI-E41-17	FF127250
MI-E41-44 & 69	FF127250

1/21/81	REV TO INC. SFCR 210158 & DGN #1	SKL	PL	ML	SEC
4/3/81	REVISED LSL TAG NOS AND PGCC TERM CAB SECTION	14	SK	ML	SEC
7/1/81	ISSUED "AS BUILT" INCORP. FCN-E-3361	CIN	ML	SEC	
7/1/81	REVISED FOR PRC-B-DWNT	SKL	PL	ML	SEC
4/1/81	ISSUED FOR CONSTRUCTION (REDRAWN)	SKL	PL	ML	SEC
4/1/81	ISSUED FOR INFORMATION	AV	SK	ML	SEC
DATE	REVISIONS	BY	CHK	RECH	ENGR
SCALE	NONE	DESIGNED	R. VRLUSE	DRAWN	
PENNSYLVANIA POWER & LIGHT COMPANY					
ALLENTOWN, PENNSYLVANIA					
SUSQUEHANNA STEAM ELECTRIC STATION - UNIT 1, UNIT 2					
BECHTEL - SAN FRANCISCO					
BLOCK DIAGRAM HPCI SYSTEM CONTROL AND INDICATION - UNIT 1					
NO. 8856	DRAWING NO. E-152 SH 1	REV. 6			
D-107301 SH 1					

PRC APERTURE CARD

UNCONTROLLED DOCUMENT FOR REFERENCE ONLY

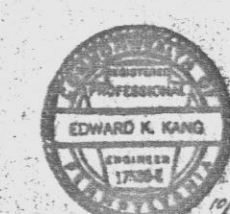

61180 BLK 0110 HPCI SYS CONTINUING

24X

I certify that the microfilm image contained on this microform was made in the normal and regular course of business. This is a true, full, correct and complete reproduction and replacement for and/or in lieu of original documents generated by the Bechtel group of companies.

Signal JACINTO Date 6/1/83 Camera Type MRG I

D