


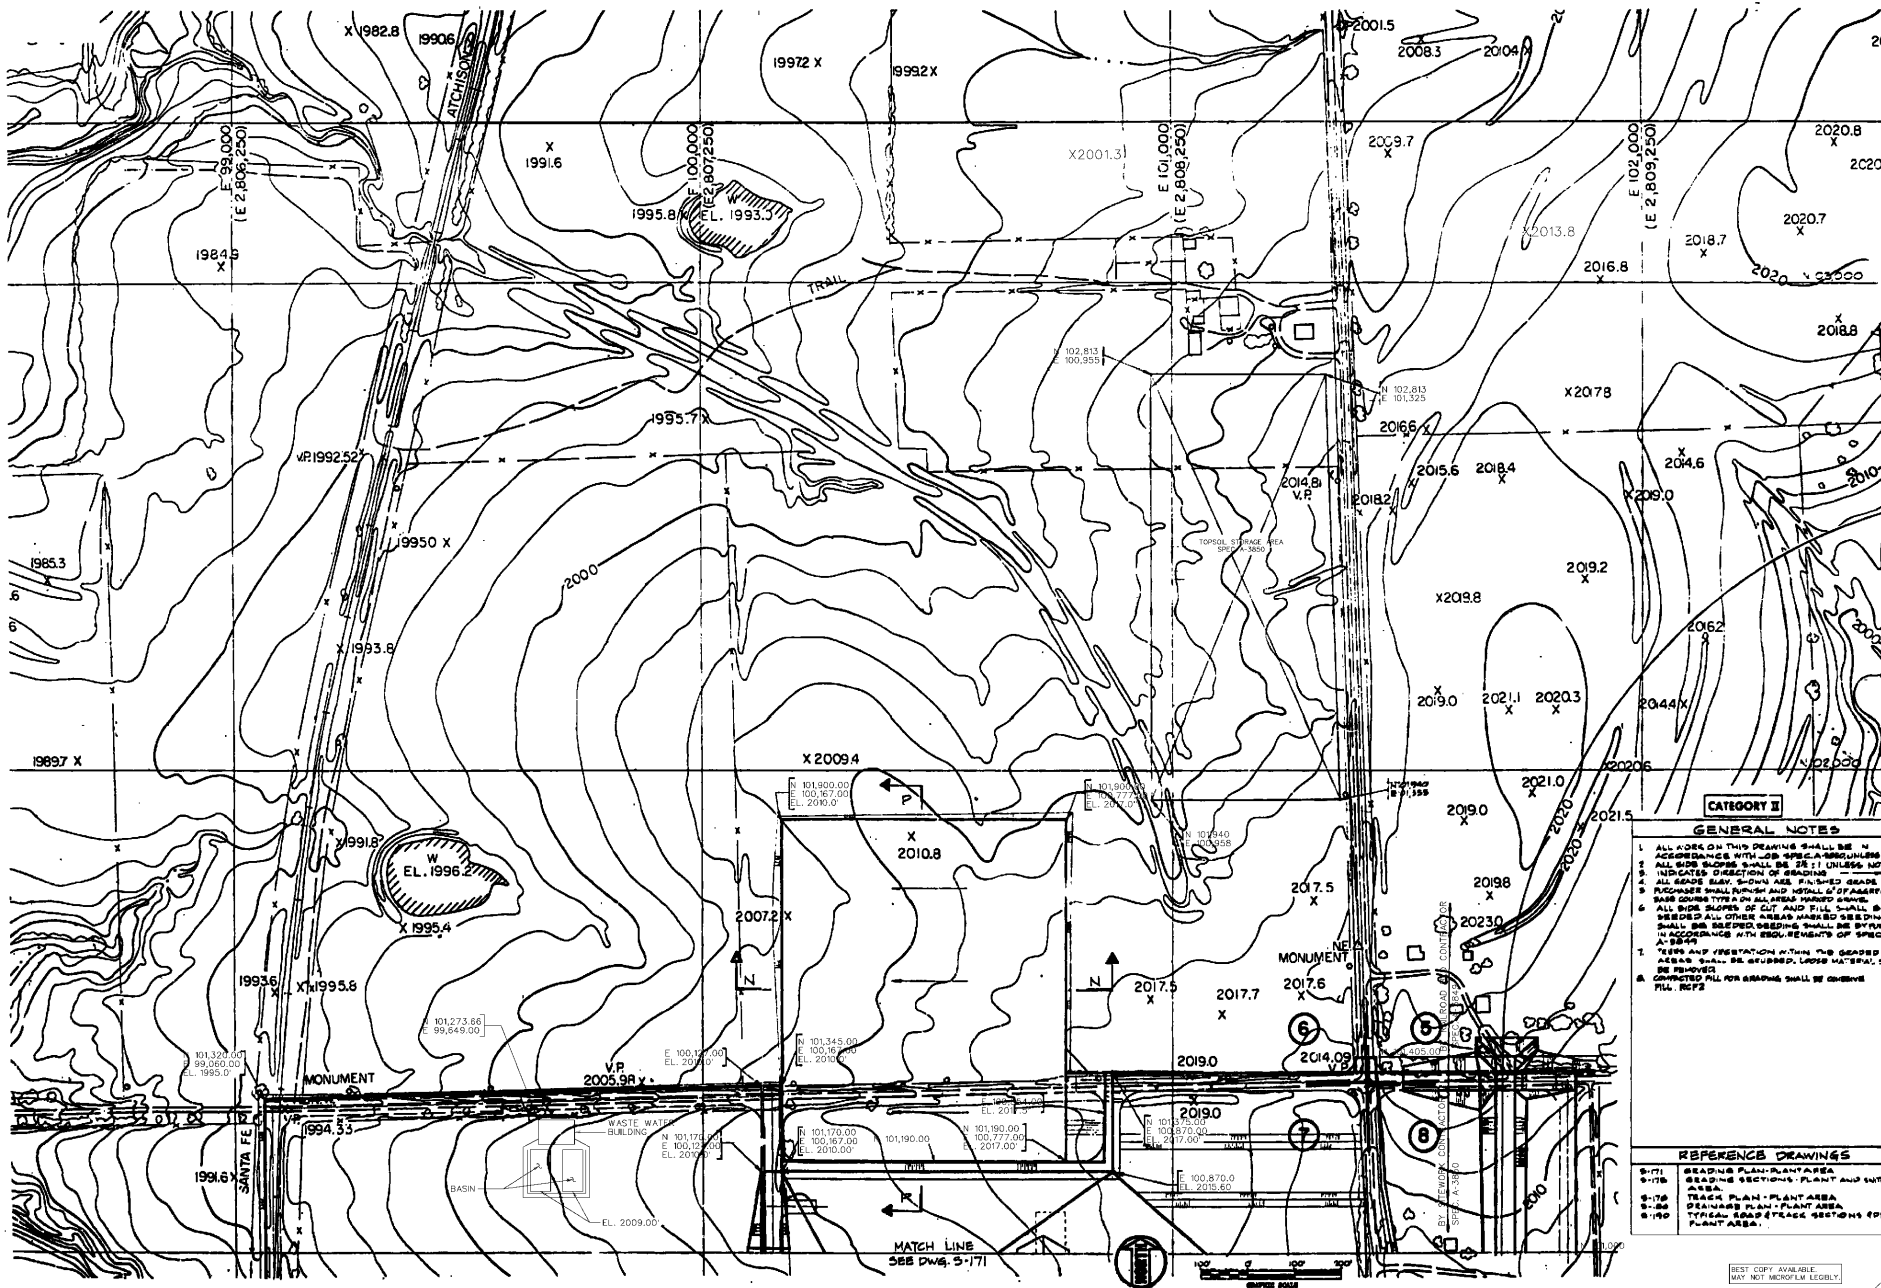

GENERAL NOTES

1. ALL AREAS ON THIS DRAWING SHALL BE IN ACCORDANCE WITH THE SPECIFICATIONS NOTED.
2. ALL AREAS SHOWN SHALL BE 2:1 UNLESS NOTED OTHERWISE.
3. ALL GRADE SHALL BE FINISHED GRADE UNLESS INDICATED OTHERWISE.
4. ALL GRADE SHALL BE FINISHED GRADE UNLESS INDICATED OTHERWISE.
5. ALL AREAS SHOWN SHALL BE FINISHED GRADE UNLESS INDICATED OTHERWISE.
6. ALL AREAS SHOWN SHALL BE FINISHED GRADE UNLESS INDICATED OTHERWISE.
7. ALL AREAS SHOWN SHALL BE FINISHED GRADE UNLESS INDICATED OTHERWISE.
8. ALL AREAS SHOWN SHALL BE FINISHED GRADE UNLESS INDICATED OTHERWISE.
9. ALL AREAS SHOWN SHALL BE FINISHED GRADE UNLESS INDICATED OTHERWISE.
10. ALL AREAS SHOWN SHALL BE FINISHED GRADE UNLESS INDICATED OTHERWISE.





REFERENCE DRAWINGS

- S-171 GRADING PLAN - PLANT AREA
- S-172 GRADING PLAN - PLANT AREA
- S-173 GRADING PLAN - PLANT AREA
- S-174 GRADING PLAN - PLANT AREA
- S-175 GRADING PLAN - PLANT AREA
- S-176 GRADING PLAN - PLANT AREA
- S-177 GRADING PLAN - PLANT AREA
- S-178 GRADING PLAN - PLANT AREA
- S-179 GRADING PLAN - PLANT AREA
- S-180 GRADING PLAN - PLANT AREA

BEST COPY AVAILABLE
MAY NOT BE REPRODUCED LEGALLY

USAR FIG. 2.4-3-2

DESIGNED BY	DATE	NO. OF SHEETS	SHEET NO.
WOLF CREEK	05/17/02	0413	07
ELECTRONIC APPROVAL			
GRADING PLAN SWITCHYARD AREA			
SCALE		SHEET NO.	
1" = 100'-0"		S-0172	

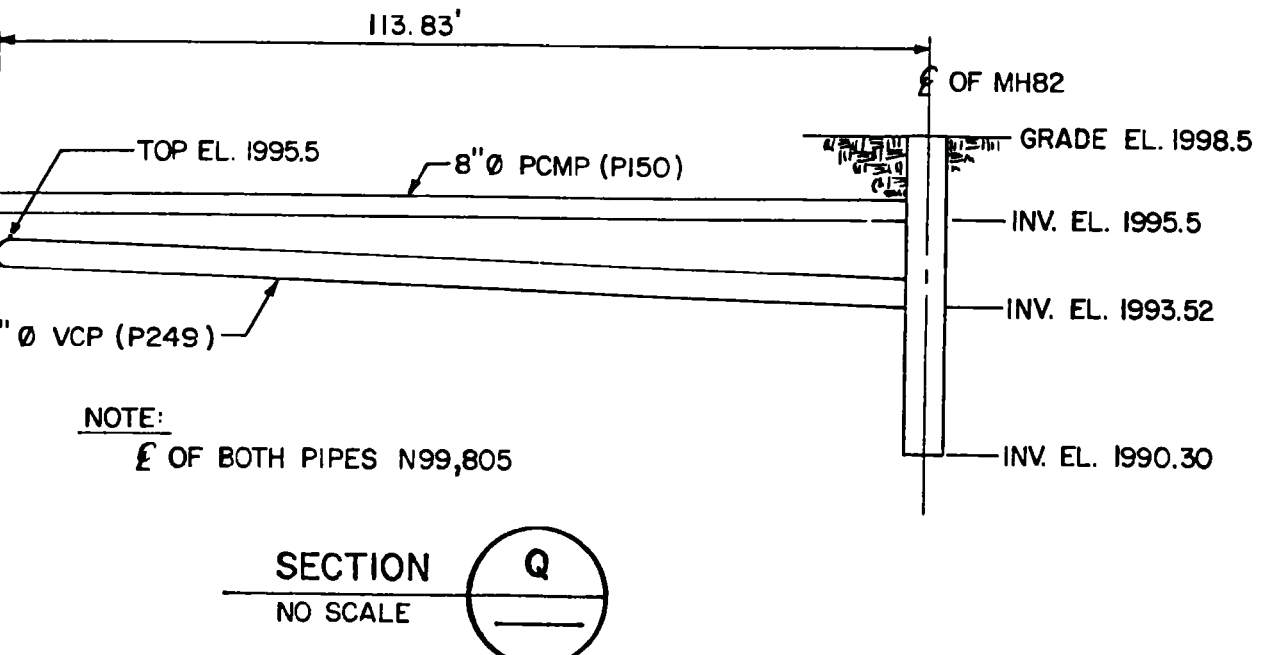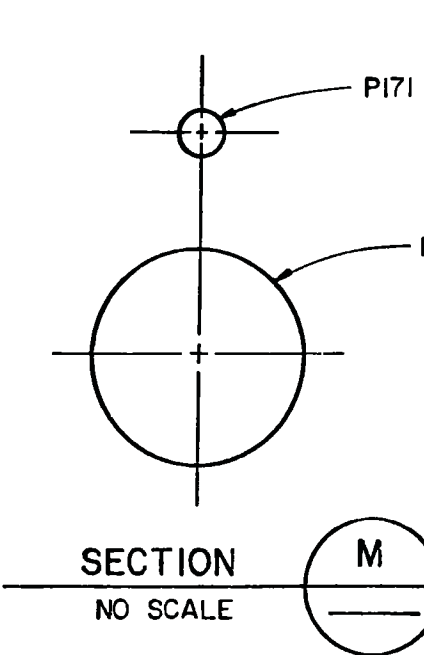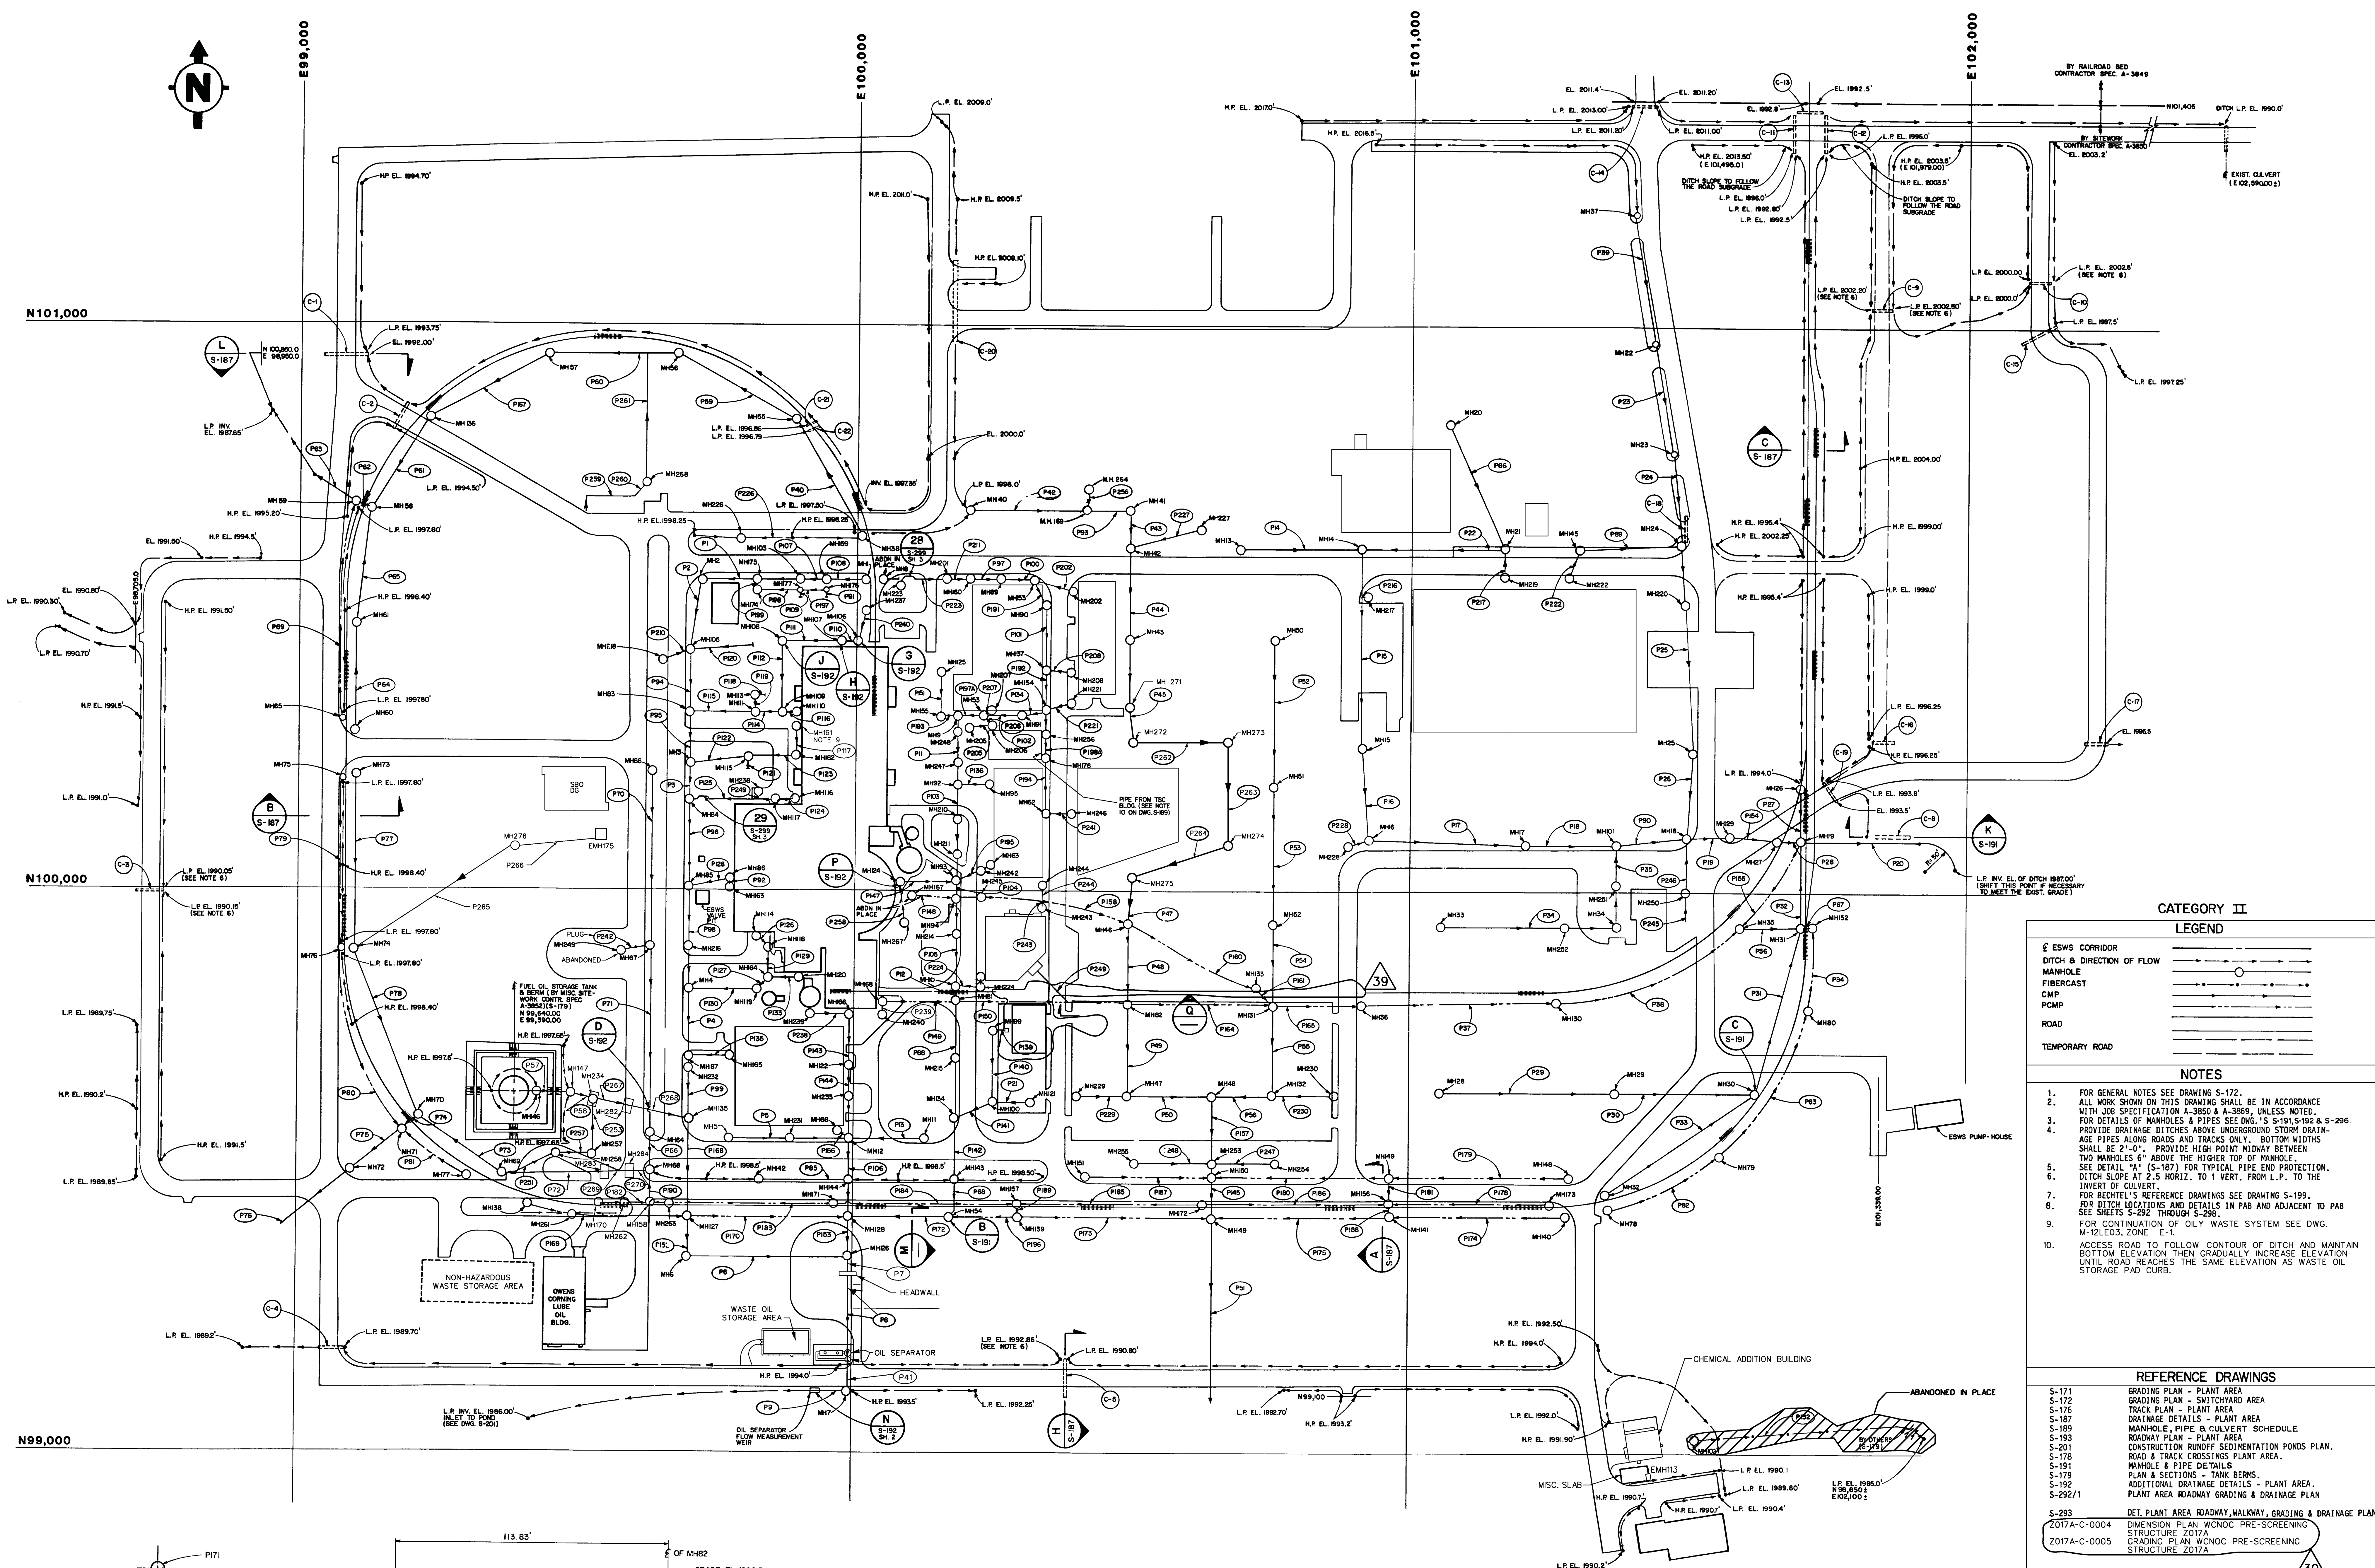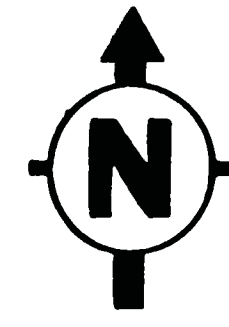

CATEGORY II	
LEGEND	
ESWS CORRIDOR	---
DITCH & DIRECTION OF FLOW	--->---
MANHOLE	○
FIBERCAST	---○---
CMP	---
PCMP	---
ROAD	---
TEMPORARY ROAD	---

- NOTES**
- FOR GENERAL NOTES SEE DRAWING S-172.
 - ALL WORK SHOWN ON THIS DRAWING SHALL BE IN ACCORDANCE WITH JOB SPECIFICATION A-3850 & A-3859, UNLESS NOTED.
 - FOR DETAILS OF MANHOLES & PIPES SEE DWG. S-189 & S-296.
 - PROVIDE DRAINAGE DITCHES ABOVE UNDERGROUND STORM DRAINAGE PIPES ALONG ROADS AND TRACKS ONLY. BOTTOM WIDTHS SHALL BE 2'-0". PROVIDE HIGH POINT MIDWAY BETWEEN TWO MANHOLES 6" ABOVE THE HIGHER TOP OF MANHOLE.
 - SEE DETAIL "A" (S-187) FOR TYPICAL PIPE END PROTECTION. DITCH SLOPE AT 2.5 HORIZ. TO 1 VERT. FROM L.P. TO THE INVERT OF CULVERT.
 - FOR DITCH LOCATIONS AND DETAILS IN PAB AND ADJACENT TO PAB SEE SHEETS S-292 THROUGH S-298.
 - FOR CONTINUATION OF OIL WASTE SYSTEM SEE DWG. M-12/EO3, ZONE C-1.
 - ACCESS ROAD TO FOLLOW CONTOUR OF DITCH AND MAINTAIN BOTTOM ELEVATION THEN GRADUALLY INCREASE ELEVATION UNTIL ROAD REACHES THE SAME ELEVATION AS WASTE OIL STORAGE PAD CURB.

REFERENCE DRAWINGS	
S-171	GRADING PLAN - PLANT AREA
S-172	GRADING PLAN - SWITCHYARD AREA
S-176	TRACK PLAN - PLANT AREA
S-187	DRAINAGE DETAILS - PLANT AREA
S-189	MANHOLE, PIPE & CULVERT SCHEDULE
S-193	ROADWAY PLAN - PLANT AREA
S-201	CONSTRUCTION RUNOFF SEDIMENTATION POND PLAN
S-178	ROAD & TRACK CROSSINGS PLANT AREA
S-191	MANHOLE & PIPE DETAILS
S-179	PLAN & SECTIONS - TANK BERM.
S-192	ADDITIONAL DRAINAGE DETAILS - PLANT AREA
S-292/1	PLANT AREA ROADWAY GRADING & DRAINAGE PLAN
S-293	DET. PLANT AREA ROADWAY, WALKWAY, GRADING & DRAINAGE PLAN
2017A-C-0004	DIMENSION PLAN, WCNOC PRE-SCREENING STRUCTURE 2017A
2017A-C-0005	GRADING PLAN, WCNOC PRE-SCREENING STRUCTURE 2017A

REFERENCE DRAWINGS	
S-294	WAREHOUSE AREA ROADWAY, GRADING & DRAINAGE PLAN
S-295	PLANT AREA ROADWAY & SIDEWALK
S-296	MANHOLE & PIPE DETAILS
S-297	PLANT AREA ROADWAY, GRADING & DRAINAGE
S-298	PARTIAL GRADING PLANS
S-299/1	DRAINAGE DETAILS & SECTION
S-299/2	SELF HEATING SYSTEM & SIDEWALK DETAILS
HE-C0006	WEARINGS RANGE PLANS
S-192	ADDITIONAL DRAINAGE DETAILS
S-0573	SBO DIESEL GENERATOR GRADING & DRAINAGE PLAN

USAR FIG. 2.4-3-03

REVISION	DATE	BY	THIS DWS SUPERSEDES	REV.
1	10/1/00	WOLF CREEK	AS-BUILT INFORMATION	

WOLF CREEK
NUCLEAR OPERATING CORPORATION

ELECTRONIC APPROVAL

DRAINAGE PLAN
PLANT AREA

SCALE: 1"=100'

DRAWING NUMBER: S-0186

SHEET: 39

BEST COPY AVAILABLE.
MAY NOT REPRODUCE LEGIBLY.


MANHOLE SCHEDULE							
NO.	INV. EL.	TOP EL.	LOCATION		DIA.	TYPE	REMARKS
			NORTH COORD.	EAST COORD.			
1	1994.00	1999.20	100,553.00	100,021.50	4'-0"	A	
2	1992.70	1998.00	100,554.00	99,725.00	4'-0"	A	
3	1991.61	1998.00	100,230.90	99,696.00	5'-0"	A	
4	1998.88	1998.00	99,815.00	99,696.00	4'-0"	C	
5	1994.25	1998.00	99,559.00	99,780.00	3'-0"	A	
6	1989.48	1996.88	99,345.00	99,696.00	6'-0"	A	
7	1987.18	1998.00	99,094.00	99,995.50	4'-0"		SEE S-0200 SHT. 2
8	1993.75	1997.20	100,552.00	100,051.50	4'-0"	A	ABANDON - PLUGGED
9	1991.94	1999.50	100,311.00	100,185.00	5'-0"	A	CLOSED TOP
10	1998.98	1999.70	99,831.00	100,185.00	5'-0"	A	15'-0" O.C. TRACK NO. 2, DROP MANHOLE - CLOSED TOP
11	1993.50	1998.00	99,559.00	100,132.00	3'-0"	A	
12	1993.10	1998.00	99,559.00	99,994.75	5'-0"	A	
13	1995.50	2001.60	100,585.86	100,705.98	4'-0"	A	CLOSED TOP
14	1995.00	2005.18	100,596.00	100,912.00	5'-0"	A	DROP MANHOLE TYPE II
15	1993.05	2004.25	100,246.00	100,912.00	5'-0"	A	
16	1992.10	2000.70	100,085.00	100,921.00	5'-0"	A	CLOSED TOP
17	1991.05	1997.00	100,076.00	101,207.00	5'-0"	A	
18	1989.90	1997.50	100,085.00	101,493.00	4'-0"	C	
19	1988.05	1996.00	100,085.00	101,695.00	4'-0"	C	SLAB TOP
20	2005.00	2009.00	100,821.10	101,062.50	4'-0"	A	
21	2001.30	2005.10	100,596.00	101,160.00	4'-0"	A	
22	2005.00	2009.70	100,968.10	101,432.00	4'-0"	A	
23	2000.40	2004.63	100,777.90	101,465.50	4'-0"	A	
24	1999.40	2004.10	100,607.00	101,485.00	5'-0"	A	
25	1991.20	2003.20	100,246.00	101,502.00	5'-0"	B	DROP MANHOLE TYPE II
26	1991.50	1994.00	100,194.06	101,679.28	1'-6"	D	TRACK NO. 2
27	1989.10	1997.00	100,085.00	101,650.27	6'-0"	A	TRACK NO. 2
28	1994.50	1998.00	99,639.50	101,054.00	2'-6"	D	
29	1992.78	1998.00	99,639.50	101,300.00	4'-0"	A	
30	1998.95	1997.50	99,639.50	101,614.34	5'-0"	A	TRACK NO. 1 SEE DETAIL 'C' ON DWG. S-0191 SEE NOTE 8.
31	1998.10	1997.50	99,935.50	101,695.00	4'-0"	C	TRACK NO. 1 SEE NOTE 8.
32	1994.75	1997.50	99,459.57	101,341.79	3'-0"	A	TRACK NO. 1
33	1994.50	1998.00	99,935.50	101,054.00	4'-0"	A	
34	1992.57	1998.00	99,935.50	101,372.00	4'-0"	A	
35	1991.00	1998.00	99,935.50	101,575.12	4'-0"	A	TRACK NO. 2
36	1993.90	1998.00	99,085.00	100,912.00	4'-0"	A	TRACK NO. 2 11'-0" O.C.
37	2007.00	2011.10	101,204.20	101,396.20	3'-0"	A	
38	1994.60	1997.50	100,631.00	100,086.54	3'-0"	A	TRACK NO. 5
40	1994.10	1998.00	100,673.00	100,285.00	3'-0"	D	
41	1993.00	1998.00	100,673.00	100,487.00	5'-0"	A	
42	1992.70	1999.42	100,685.00	100,496.00	5'-0"	A	CLOSED TOP
43	1992.30	1997.41	100,444.56	100,497.23	5'-0"	A	
46	1998.75	1997.00	99,947.30	100,497.25	5'-0"	A	TRACK NO. 4 9'-0" O.C. DROP MANHOLE
47	1989.75	1997.00	99,639.50	100,497.25	4'-0"	C	
48	1989.15	1997.00	99,639.50	100,645.50	4'-0"	C	
49	1988.33	1997.89	99,424.00	100,645.50	4'-0"	C	TRACK NO. 1 11'-0" O.C. CLOSED TOP
50	1994.50	1998.28	100,441.23	100,760.05	3'-0"	A	
51	1993.00	1998.06	100,185.48	100,759.75	4'-0"	A	
52	1992.50	1997.00	99,935.50	100,759.75	4'-0"	A	
53	1992.04	1998.50	100,309.55	100,242.51	5'-0"	A	CLOSED TOP
54	1989.50	1997.89	99,424.00	100,182.52	5'-0"	A	TRACK NO. 1 11'-0" O.C. DROP MANHOLE - CLOSED TOP
55	1992.60	1998.50	100,833.32	99,889.07	4'-0"	A	TRACK NO. 5
56	1991.50	1996.30	100,958.21	99,676.48	5'-0"	A	TRACK NO. 5
57	1998.40	1996.30	100,951.71	99,437.06	5'-0"	A	TRACK NO. 1
58	1988.40	1999.75	100,668.83	99,125.63	6'-0"	A	TRACK NO. 1
59	1988.25	1997.00	100,677.52	99,101.12	4'-0"	C	TRACK NO. 1, DROP MANHOLE TYPE II
60	1992.15	1999.75	100,274.87	99,100.00	3'-0"	A	TRACK NO. 1
61	1998.70	1999.75	100,474.87	99,100.00	4'-0"	A	TRACK NO. 1
62	1993.75	1998.00	100,136.00	100,345.00	4'-0"	A	PROVIDE OPENING FOR SUB-BASE DRAIN
63	1994.00	1998.00	100,078.00	100,242.50	3'-0"	A	
64	1992.20	1997.75	99,577.50	99,631.00	4'-0"	A	
65	1993.00	1998.67	100,296.87	99,074.00	3'-0"	A	HEAVY DUTY CLOSED TOP, FLUSH WITH TOP OF ROAD
66	1995.50	1997.75	100,218.50	99,631.00	3'-0"	D	
67	1993.00	1997.75	99,894.00	99,631.00	4'-0"	A	
68	1991.82	1997.75	99,502.50	99,631.00	4'-0"	B	
69	1998.64	1999.75	99,484.54	99,373.11	4'-0"	A	TRACK NO. 1
70	1989.34	1999.75	99,595.13	99,216.21	5'-0"	A	TRACK NO. 1
71	1988.05	1999.75	99,577.61	99,197.00	5'-0"	A	TRACK NO. 1
72	1988.46	1997.00	99,493.00	99,090.00	4'-0"	C	
73	1992.40	1999.75	100,211.87	99,100.00	4'-0"	A	TRACK NO. 1
74	1998.60	1999.75	99,891.97	99,100.00	4'-0"	A	TRACK NO. 1
75	1993.75	1998.67	100,201.87	99,074.00	3'-0"	A	HEAVY DUTY CLOSED TOP, FLUSH WITH TOP OF ROAD
76	1991.89	1998.67	99,901.87	99,074.00	4'-0"	B	HEAVY DUTY CLOSED TOP, FLUSH WITH TOP OF ROAD
77	1992.75	1999.75	99,491.56	99,301.93	3'-0"	A	TRACK NO. 1
78	1994.40	1997.50	99,434.13	101,347.15	3'-0"	A	CLOSED TOP, TRACK NO. 1
79	1993.40	1997.50	99,528.61	101,545.98	4'-0"	A	CLOSED TOP, TRACK NO. 1

MANHOLE SCHEDULE (CONT.)							
NO.	INV. EL.	TOP EL.	LOCATION		DIA.	TYPE	REMARKS
			NORTH COORD.	EAST COORD.			
80	1992.32	1997.50	99,776.49	101,705.85	4'-0"	B	CLOSED TOP, TRACK NO: 1 SEE NOTE 8.
81	1990.91	1999.00	99,805.00	100,185.00	5'-0"	A	11'-0" O.C. TRACK NO: 2, DROP MANHOLE - CLOSED TOP
82	1990.30	1998.50	99,805.00	100,497.25	4'-0"	C	11'-0" O.C. TRACK NO: 2 DROP MANHOLE
83	1991.00	1998.00	100,319.75	99,696.00	5'-0"	A	
84	1991.48	1998.00	100,163.52	99,696.00	5'-0"	A	
85	1991.38	1998.00	100,002.75	99,696.00	5'-0"	A	D-44 DROP MANHOLE TYPE II
86	1993.00	1999.12	100,019.75	99,769.04	3'-0"	A	D-107
87	1990.59	1998.50	99,711.00	99,696.00	5'-0"	A	CLOSED TOP
88	1994.25	1999.45	99,572.54	99,975.33	3'-0"	A	D-113
89	1991.38	1998.33	100,002.75	100,266.00	4'-0"	A	
90	1992.95	1998.00	100,513.00	100,345.00	4'-0"	A	
91	1992.25	1998.00	100,311.00	100,304.00	4'-0"	A	
92	1991.61	1998.33	100,185.00	100,185.00	5'-0"	A	
93	1991.28	1998.00	100,019.00	100,185.00	5'-0"	A	9'-0" O.C. TRACK NO: 4
94	1991.25	1998.00	99,991.00	100,185.00	5'-0"	A	9'-0" O.C. TRACK NO: 4, DROP MANHOLE TYPE I
95	1993.75	1998.00	100,191.50	100,242.50	3'-0"	A	
98							
99	1994.50	1998.00	99,750.50	100,254.00	4'-0"	A	
100	1993.00	1997.40	99,619.50	100,254.00	4'-0"	A	
101	1998.40	1997.50	100,076.00	101,372.00	6'-0"	A	
102	1989.00	1992.25	99,026.75	101,509.77	3'-0"	A	CLOSED TOP, SEE SECT. C-C ON DRAWING S-0179
103	1993.30	1998.67	100,554.00	99,899.50	4'-0"	A	OD-122
105	1992.38	1998.00	100,412.04	99,696.00	5'-0"	A	
106	1993.33	1999.30	100,442.70	100,018.00	4'-0"	A	D-101 SEE DETAIL 'G' ON DRAWING S-0192
107	1993.15	1999.48	100,442.70	99,948.00	4'-0"	A	D-102 SEE DETAIL 'H' ON DRAWING S-0192
108	1992.73	1999.00	100,440.37	99,869.00	5'-0"	A	SEE DETAIL 'J' ON DRAWING S-0192
109	1992.28	1999.17	100,319.75	99,871.00	5'-0"	A	
110	1993.50	1999.46	100,319.75	99,896.87	3'-0"	A	D-103
111	1992.08	1998.36	100,319.75	99,811.38	5'-0"	A	
113	1992.90	1999.03	100,358.33	99,811.38	3'-0"	A	OD-120
114	1994.25	1999.30	99,911.27	99,819.75	3'-0"	A	D-109
115	1992.60	1997.96	100,240.25	99,795.00	4'-0"	A	OD-121
116	1993.39	1999.46	100,163.52	99,900.50	4'-0"	A	D-105
117	1993.09	1999.46	100,163.52	99,872.50	4'-0"	A	D-106
118	1993.50	1999.44	99,901.00	99,845.09	3'-0"	A	D-110
119	1993.05	1999.43	99,815.00	99,826.50	4'-0"	A	CLOSED TOP
120	1994.40	1999.10	99,849.54	99,923.74	3'-0"	A	D-111
121	1995.00	1997.40	99,619.50	100,318.00	3'-0"	A	
122	1993.44	1999.01	99,685.00	99,987.79	4'-0"	A	D-114
124	1991.50	1999.50	100,014.85	100,084.75	3'-0"	A	D-116 CLOSED TOP
125	1993.25	1998.00	100,385.00	100,167.00	4'-0"	B	
126	1988.58	1996.88	99,345.00	99,995.50	4'-0"	C	NO DROP
127	1989.72	1997.89	99,424.00	99,696.00	5'-0"	A	11'-0" O.C. TRACK NO: 1 CLOSED TOP
128	1988.95	1997.89	99,424.00	99,995.50	4'-0"	C	11'-0" O.C. TRACK NO: 1 WITH SLAB TOP - CLOSED TOP
129	1989.60	1997.50	100,085.00	101,553.00	6'-0"	A	
130	1992.25	1998.50	99,805.32	101,261.32	4'-0"	B	TRACK NO: 2
131	1991.50	1998.50	99,805.00	100,759.75	5'-0"	A	TRACK NO: 2 11'-0" O.C. DROP MANHOLE
132	1998.30	1997.00	99,639.50	100,759.75	4'-0"	C	
133	1994.00	1998.00	99,826.98	100,717.97	4'-0"	B	TRACK NO: 4 & TRACK NO: 2 15'-0" O.C.
134	1998.22	1998.00	99,588.00	100,185.00	5'-0"	A	
135	1998.23	1998.00	99,588.00	99,696.00	6'-0"	A	
136	1989.30	1996.50	100,833.69	99,229.37	5'-0"	B	TRACK NO: 1
137	1992.57	1998.00	100,385.00	100,345.00	4'-0"	A	
138	1994.25	1997.89	99,443.39	99,411.26	3'-0"	A	TRACK NO: 1 CLOSED TOP
139	1994.00	1997.89	99,424.00	100,385.00	3'-0"	A	TRACK NO: 1 11'-0" O.C. CLOSED TOP
140	1995.00	1997.89	99,424.00	101,273.09	3'-0"	A	TRACK NO: 1 CLOSED TOP
141	1993.10	1997.89	99,424.00	100,960.00	4'-0"	B	TRACK NO: 1 11'-0" O.C. CLOSED TOP
142	1994.25	1997.33	99,484.00	99,842.00	3'-0"	A	
143	1989.83	1997.33	99,484.00	100,185.00	5'-0"	A	DROP MANHOLE
144	1998.30	1997.33	99,484.00	99,995.50	5'-0"	D	DROP MANHOLE
145	2001.00	2005.41	100,596.00	101,300.00	3'-0"	A	
146	1993.00	1997.00	99,640.00	99,432.00	3'-0"	A	SEE DETAIL 'B' ON DRAWING S-0179
147	1990.90	1997.55	99,640.00	99,482.00	4'-0"	A	SEE DETAIL 'A' ON DRAWING S-0179
148	1995.00	1998.44	99,484.00	101,289.00	3'-0"	A	CLOSED TOP
149	1994.00	1998.44	99,484.00	100,960.00	4'-0"	B	CLOSED TOP
150	1988.56	1998.44	99,484.00	100,645.50	4'-0"	C	CLOSED TOP
151	1995.00	1998.44	99,484.00	100,416.00	3'-0"	A	CLOSED TOP
152	1991.50	1998.00	99,935.50	101,719.00	4'-0"	B	CLOSED TOP TRACK NO: 1 SEE NOTE 8.
153	1993.05	1999.60	100,550.00	100,341.00	4'-0"	B	HEAVY DUTY CLOSED TOP FLUSH WITH TOP OF ROAD
154	1992.36	1998.00	100,315.00	100,341.00	5'-0"	A	HEAVY DUTY CLOSED TOP FLUSH WITH TOP OF ROAD
155	1992.45	1998.00	100,311.00	100,167.00	4'-0"	B	
156	1993.71	1998.58	99,442.00	100,960.00	3'-0"	A	
157	1994.12	1997.56	99,442.00	100,300.00	3'-0"	A	
158	1992.00	1999.00	99,442.00	99,631.00	3'-0"	A	DROP MANHOLE


PIPE SCHEDULE						
NO.	SIZE & TYPE	GAGE	FROM MANHOLE	TO MANHOLE	INVERT EL. H. P.	REMARKS
P1	18" DIA. CMP	16	103	2	1993.33	1992.70
P2	24" DIA. CMP	14	2	105	1992.70	1992.38
P3	42" DIA. CMP	12	3	84	1991.61	1991.48
P4	48" DIA. CMP	10	4	87	1990.88	1990.59
P5	12" DIA. CMP	16	5	12	1994.25	1993.10
P6	48" DIA. CMP	10	6	126	1989.48	1988.58
P7	54" DIA. CMP	8	126	HEADWALL	1988.58	1988.50
P8	54" DIA. RCP	8	HEADWALL	OIL SEP.	1988.50	1987.65
P9	54" DIA. CMP	8	7	TO OUTLET	1987.18	END COORD. N 99, 094.00 E 99, 908.00
P10	18" DIA. CMP	16	8	160		ABDN. 124" OF PIPE FROM M.H. NO. 8, DET. 28 S-0299-3
P11	38" DIA. CMP	14	9	92	1991.94	1991.61
P12	42" DIA. CMP	12	10	81	1990.98	1990.91
P13	21" DIA. CMP	16	11	12	1993.50	1993.10
P14	38" DIA. CMP	14	13	14	1995.50	1995.00
P15	36" DIA. CMP	12	14	15	1995.00	1993.05
P16	36" DIA. CMP	12	15	16	1993.05	1992.10
P17	42" DIA. CMP	12	16	17	1992.10	1991.05
P18	48" DIA. CMP	10	17	101	1991.05	1990.40
P19	54" DIA. CMP	8	18	129	1989.90	1989.60
P20	54" DIA. CMP	8	19	TO OUTLET	1988.85	END COORD. N 100, 005.00 E 101, 902.50
P21	15" DIA. CMP	16	121	100	1995.00	1994.60
P22	24" DIA. CMP	14	21	14	2001.30	1999.95
P23	38" DIA. CMP	14	22	23	2005.00	2000.40
P24	36" DIA. CMP	12	23	24	2000.40	1999.60
P25	42" DIA. CMP	12	24	25	1999.40	1996.70
P26	42" DIA. CMP	12	25	18	1991.20	1989.90
P27	18" DIA. CMP	16	26	19	1991.50	1988.85
P28	54" DIA. CMP	8	27	19	1989.10	1988.85
P29	38" DIA. CMP	14	28	29	1994.50	1993.28
P30	36" DIA. CMP	12	29	30	1992.78	1991.45
P31	42" DIA. CMP	12	30	31	1990.95	1990.10
P32	42" DIA. CMP	12	31	19	1990.10	1988.85
P33	15" DIA. CMP	16	32	30	1994.75	1993.20
P34	24" DIA. CMP	14	33	34	1994.50	1992.82
P35	36" DIA. CMP	12	34	101	1992.57	1990.40
P36	12" DIA. CMP	16	35	31	1991.00	1990.10
P37	8" DIA. PCMP	16	36	130	1993.90	1992.25
P38	10" DIA. PCMP	16	130	35	1992.25	1991.00
P39	21" DIA. CMP	16	37	22	2007.00	2005.00
P40	18" DIA. CMP	16	38	55	1995.00	1992.60
P41	54" DIA. RCP	8	OIL SEP.	7	1987.50	1987.18
P42	36" DIA. CMP	12	40	169	1994.10	1993.28
P43	36" DIA. CMP	12	41	42	1993.00	1992.70
P44	36" DIA. CMP	12	42	43	1992.70	1992.30
P45	42" DIA. CMP	12	43	272	1992.30	1991.69
P47	42" DIA. CMP	12	45	46	1990.85	1990.75
P48	48" DIA. CMP	10	46	82	1990.75	1990.30
P49	48" DIA. CMP	10	82	47	1990.30	1989.75
P50	48" DIA. CMP	10	47	48	1989.75	1989.15
P51	54" DIA. CMP	8	49	TO OUTLET	1988.33	SEE DET. 37 N99, 087.00 END COORD. E100, 645.50
P52	21" DIA. CMP	16	50	51	1994.50	1993.50
P53	38" DIA. CMP	14	51	52	1993.00	1992.57
P54	36" DIA. CMP	12	52	131	1992.50	1991.50
P55	42" DIA. CMP	12	131	132	1991.50	1990.30
P56	42" DIA. CMP	12	132	48	1990.30	1989.60
P57	18" DIA. CMP	16	146	147	1993.00	1991.03
P58	18" DIA. CMP	16	147	234	1990.90	1990.72
P59	38" DIA. CMP	14	55	56	1992.60	1991.50
P60	36" DIA. CMP	12	56	57	1991.50	1990.40
P61	42" DIA. CMP	12	136	58	1989.30	1988.40
P62	48" DIA. CMP	10	58	59	1988.40	1988.25
P63	48" DIA. CMP	10	59	TO OUTLET	1988.25	END COORD. N 100, 733.00 E 99, 027.00
P64	21" DIA. CMP	16	60	61	1992.65	1991.45
P65	38" DIA. CMP	14	61	58	1990.70	1989.50
P66	21" DIA. CMP	16	64	68	1992.20	1991.02
P67	12" DIA. CMP	16	152	31	1991.50	1991.25
P68	48" DIA. CMP	10	143	54	1989.83	1989.50
P69	8" DIA. PCMP	16	65	59	1993.00	1991.00
P70	15" DIA. CMP	16	66	67	1995.50	1993.00
P71	21" DIA. CMP	16	67	64	1993.00	1992.20
P72	21" DIA. CMP	16	283	69	1991.39	1990.89
P73	24" DIA. CMP	14	69	70	1990.64	1989.94
P74	36" DIA. CMP	12	70	71	1989.34	1989.10
P75	48" DIA. CMP	10	71	72	1988.85	1988.45
P76	48" DIA. CMP	10	72	TO OUTLET	1988.45	END COORD. N 99, 400.00 E 98, 976.00
P77	24" DIA. CMP	14	73	74	1992.40	1991.10
P78	36" DIA. CMP	12	74	70	1990.60	1989.34
P79	8" DIA. PCMP	16	75	76	1993.75	1991.89

PIPE SCHEDULE (CONT.)						
NO.	SIZE & TYPE	GAGE	FROM MANHOLE	TO MANHOLE	INVERT EL. H. P.	REMARKS
P80	10" DIA. PCMP	16	76	71	1991.89	1988.85
P81	8" DIA. PCMP	16	77	71	1992.75	1991.75
P82	8" DIA. PCMP	16	78	79	1994.40	1993.40
P83	10" DIA. PCMP	16	79	80	1993.40	1992.32
P84	12" DIA. PCMP	16	80	152	1992.32	1991.70
P85	15" DIA. CMP	16	142	144	1994.25	1993.77
P86	21" DIA. CMP	16	20	21	2005.00	2001.30
P87	30" DIA. CMP	14	144	128	1990.30	1990.00
P88	48" DIA. CMP	10	81	134	1990.91	1990.22
P89	18" DIA. CMP	16	145	24	2001.00	2000.50
P90	48" DIA. CMP	10	101	18	1990.40	1989.90
P91	8" DIA. CMP	16	176	176	1993.95	1993.90
P92	12" DIA. CMP	16	163	86	1993.70	1993.00
P93	36" DIA. CMP	12	169	41	1993.28	1993.00
P94	38" DIA. CMP	14	105	83	1992.38	1991.00
P95	42" DIA. CMP	12	83	3	1991.80	1991.61
P96	48" DIA. CMP	10	84	85	1991.48	1991.38
P97	18" DIA. CMP	16	160	89	1993.54	1993.43
P98	48" DIA. CMP	10	85	4	1991.38	1990.88
P99	48" DIA. CMP	10	87	135	1990.59	1990.23
P100	21" DIA. CMP	16	89	153	1993.43	1993.05
P101	24" DIA. CMP	14	90	137	1992.95	1992.57
P102	24" DIA. CMP	14	91	53	1992.25	1992.04
P103	36" DIA. CMP	12	92	93	1991.61	1991.28
P104	42" DIA. CMP	12	93	94	1991.20	1991.25
P105	42" DIA. CMP	12	94	10	1991.25	1990.98
P106	38" DIA. CMP	14	12	144	1993.10	1992.90
P107	18" DIA. CMP	16	159	103	1993.53	1993.33
P108	12" DIA. CMP	16	1	159	1994.00	1993.50
P109	8" DIA. CMP	16	SPARE MAIN XFMR V. S.	177	1993.85	1993.64
P110	21" DIA. CMP	16	106	107	1993.33	1993.15
P111	24" DIA. CMP	14	107	108	1993.15	1992.73
P112	38" DIA. CMP	14	108	109	1992.73	1992.28
P114	38" DIA. CMP	14	109	111	1992.28	1992.08
P115	36" DIA. CMP	14	111	83	1992.08	1991.00
P116	12" DIA. CMP	16	110	109	1993.50	1992.45
P117	18" DIA. CMP	16	161	162	1993.75	1993.56
P118	8" DIA. CMP	16	STA. SERVICE XFMR V. S.	113	1993.00	1992.90
P119	12" DIA. CMP	16	113	111	1992.90	1992.08
P120	8" DIA. CMP	16	XFMR V. S.	105	1993.25	1992.75
P121	8" DIA. CMP	16	E. S.F. XFMR SUMP	115	1992.75	1992.60
P122	24" DIA. CMP	14	115	3	1992.60	1992.00
P123	21" DIA. CMP	16	162	115	1993.56	1992.60
P124	15" DIA. CMP	16	116	117	1993.39	1993.09
P125	24" DIA. CMP	14	117	84	1993.09	1991.48
P126	12" DIA. CMP	16	114	118	1994.25	1993.50
P127	24" DIA. CMP	14	164	119	1993.15	1993.05
P128	15" DIA. CMP	16	86	85	1993.00	1992.50
P129	21" DIA. CMP	16	118	164	1993.50	1993.15
P130	24" DIA. CMP	14	119	4	1993.05	1991.60
P132	6" FIBRECAST	N/A	102	TO OUTLET	1989.33	1988.28
P133	18" DIA. CMP	16	120	164	1996.60	1993.15
P134	24" DIA. CMP	14	154	91	1992.36	1992.25
P135	15" DIA. CMP	16	165	87	1994.00	1992.70
P136	18" DIA. CMP	16	95	92	1993.75	1993.50
P139	15" DIA. CMP	16	99	99	1995.00	1994.60
P140	21" DIA. CMP	16	99	100	1994.50	1993.90
P141	24" DIA. CMP	14	100	134	1993.80	1991.50
P142	48" DIA. CMP	10	134	143	1990.22	1989.85
P143	15" DIA. CMP	16	166	122	1994.00	1993.44
P144	21" DIA. CMP	16	122	12	1993.44	1993.10
P145	54" DIA. CMP	8	150	49	1988.56	1988.33
P147	24" DIA. CMP	14	124	93	1991.50	1991.28
P148	8" DIA. PCMP	16	167	94	1996.25	1995.75
P149	8" DIA. PCMP	16	168	81	1996.25	1995.50
P150	8" DIA. PCMP	16	81	82	1996.25	1995.50
P151	15" DIA. CMP	16	125	155	1993.25	1992.45
P152	48" DIA. CMP	10	127	6	1989.72	1989.48
P153	48" DIA. CMP	10	128	126	1988.95	1988.58
P154	54" DIA. CMP	8	129	27	1989.60	1989.10
P155	8" DIA. PCMP	16	19	35	1994.13	1993.50
P157	54" DIA. CMP	8	48	150	1989.15	1988.33
P158	8" DIA. PCMP	16	94	46	1995.50	1993.65


PIPE SCHEDULE (CONT.)							
NO.	SIZE & TYPE	GAGE	FROM MANHOLE	TO MANHOLE	INVERT EL.		REMARKS
					H, P.	L, P.	
P160	8" DIA. PCMP	16	46	133	1994.50	1994.00	
P161	12" DIA. CMP	16	133	131	1994.00	1993.25	
P164	8" DIA. PCMP	16	82	131	1994.50	1993.25	
P165	8" DIA. PCMP	16	131	36	1995.40	1993.25	
P166	12" DIA. CMP	16	88	12	1994.25	1993.10	
P167	42" DIA. CMP	12	57	136	1990.40	1989.30	
P168	48" DIA. CMP	10	135	127	1990.23	1989.72	
P169	8" DIA. PCMP	16	138	127	1995.00	1993.60	
P170	8" DIA. PCMP	16	127	128	1995.00	1991.60	
P171	8" DIA. PCMP	16	54	128	1995.50	1995.00	SEE SECT. " M-M" DWG. S-0186
P172	48" DIA. CMP	10	54	128	1989.50	1988.95	
P173	8" DIA. PCMP	16	139	49	1994.00	1991.00	
P174	8" DIA. PCMP	16	140	141	1995.00	1993.40	
P175	12" DIA. PCMP	16	141	49	1993.10	1991.50	
P178	8" DIA. PCMP	16	173	156	1995.20	1993.71	
P179	8" DIA. PCMP	16	148	149	1995.00	1994.00	
P180	8" DIA. PCMP	16	149	150	1995.00	1994.00	
P181	12" DIA. CMP	16	149	156	1994.00	1993.71	
P182	8" DIA. PCMP	16	170	158	1995.20	1995.00	
P183	8" DIA. PCMP	16	171	158	1995.20	1994.20	
P184	8" DIA. PCMP	16	171	157	1995.20	1994.12	
P185	8" DIA. PCMP	16	172	157	1995.20	1994.12	
P186	8" DIA. PCMP	16	172	156	1995.20	1993.71	
P187	8" DIA. PCMP	16	151	150	1995.00	1994.30	
P188	12" DIA. CMP	16	156	141	1993.71	1993.40	
P189	12" DIA. CMP	16	157	139	1994.12	1994.00	
P190	12" DIA. CMP	16	158	68	1992.00	1991.82	
P191	24" DIA. CMP	14	153	90	1993.05	1992.95	
P192	24" DIA. CMP	14	137	154	1992.57	1992.36	
P193	18" DIA. CMP	16	155	9	1992.45	1992.35	
P194	18" DIA. CMP	16	62	178	1993.90	1993.80	
P195	15" DIA. CMP	16	63	93	1994.00	1993.50	
P196	12" DIA. CMP	16	139	54	1994.00	1994.50	
P197	8" DIA. CMP	16	176	177	1993.90	1993.64	
P197A	30" DIA. CMP	14	53	9	1992.84	1991.94	
P198	10" DIA. CMP	16	177	174	1993.64	1993.19	
P198A	18" DIA. CMP	16	178	154	1993.60	1993.35	
P199	10" DIA. CMP	16	174	175	1993.19	1993.04	
P202	15" DIA. CMP	16	202	153	1993.50	1993.05	
P205	15" DIA. CMP	16	205	206	1995.50	1995.25	
P206	15" DIA. CMP	16	206	53	1995.25	1995.00	
P207	15" DIA. CMP	16	207	53	1995.00	1994.75	
P208	15" DIA. CMP	16	208	137	1995.50	1995.00	
P210	12" DIA. CMP	16	218	105	1995.60	1993.06	
P211	18" DIA. CMP	16	201	160	1993.60	1993.50	
P216	18" DIA. CMP	16	217	P-15	2002.25	2002.00	DROP CONN. SEE DET. NO. 1 DWG. S-0296
P217	15" DIA. CMP	16	219	21	2002.25	2001.50	
P221	15" DIA. CMP	16	221	154	1995.50	1995.00	
P222	18" DIA. CMP	16	222	145	2001.75	2001.00	
P223	18" DIA. CMP	16	223	201	1994.70	1993.60	SEE DET. NO. 28 DWG. S-0299-3
P224	18" DIA. CMP	16	224	10	1991.20	1990.90	
P226	18" DIA. CMP	16	226	38	1995.50	1994.60	
P227	24" DIA. CMP	16	227	42	1993.80	1992.70	
P228	15" DIA. CMP	16	228	16	1992.05	1992.10	
P229	15" DIA. CMP	16	229	47	1993.00	1989.75	
P230	15" DIA. CMP	16	230	132	1993.00	1990.30	
P235							

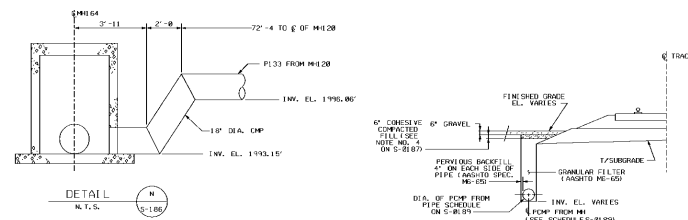


TYPICAL SUBGRADE DRAINAGE
N.T.S.
(S-8109 & S-8191)

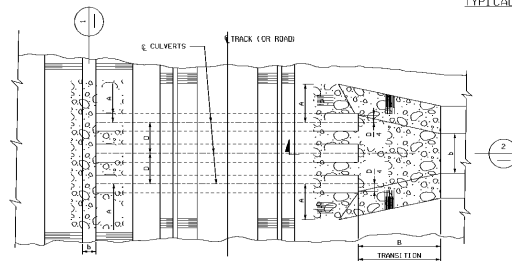


TYPICAL PLAN OF CULVERT END PROTECTION
N.T.S.

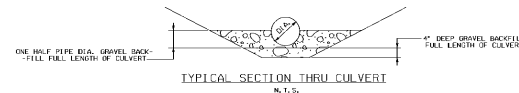

TYPICAL SECTION THRU CULVERT
N.T.S.

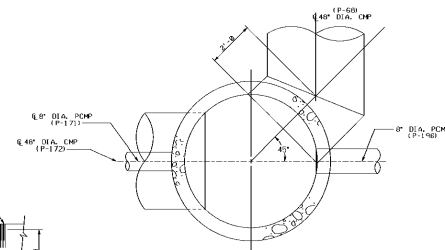


DETAIL
N.T.S.

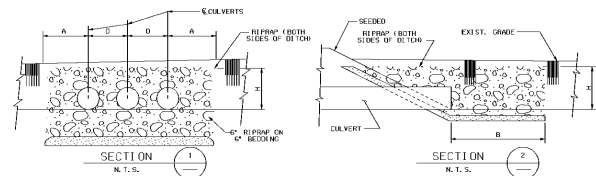


SECTION
N.T.S.

TYPICAL SECTION WITH DITCH PERPENDICULAR TO CULVERT

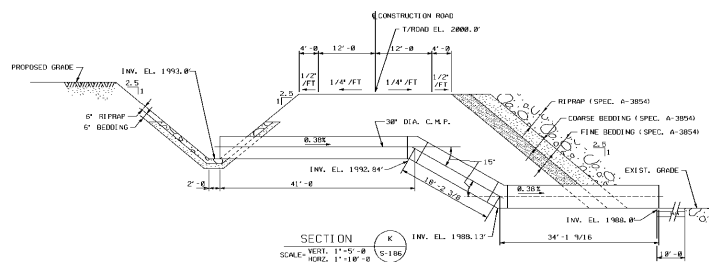

SECTION
N.T.S.

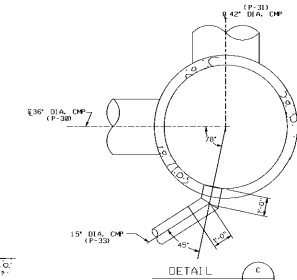

DETAIL
N.T.S.


LEGEND	
M.H. - MANHOLE	
CHP - CULVERT	
V.S. - VAULT	

GENERAL NOTES	
1. FOR GENERAL NOTES SEE DRAWING S-172.	
2. ALL WORK SHOWN ON THIS DRAWING SHALL BE IN ACCORDANCE WITH JOB SPECIFICATION A-3850 UNLESS NOTED.	

REFERENCE DRAWINGS	
S-8172	GRADING PLAN - SWITCHYARD AREA
S-8186	GRADING PLAN - PLANT AREA
S-8197	GRADING DETAILS - PLANT AREA
S-8198	MANHOLE, PIPE & CULVERT SCHEDULE
S-8199	INTERFERENCE LOCATIONS - DITCH, DRAINAGE, TRANSFORMER VAULT, DRAINAGE, & DILLY WASTE


USAR FIG. 2.4-3-05

REVISION	INCORPORATED	CHANGE
ISSUED	NO DEC.	NOV. 1964
DESIGNED BY	REV.	NOV. 1964
REVISIONS	REVISED FOR PIR. 2003-0545	REV.
WOLF CREEK		
NUCLEAR OPERATING CORPORATION		
ELECTRONIC APPROVAL		
WOLF CREEK GENERATING STATION		
MANHOLE AND PIPE DETAILS		
SCALE	AS SHOWN	SCALE
AS SHOWN	S-0191	26

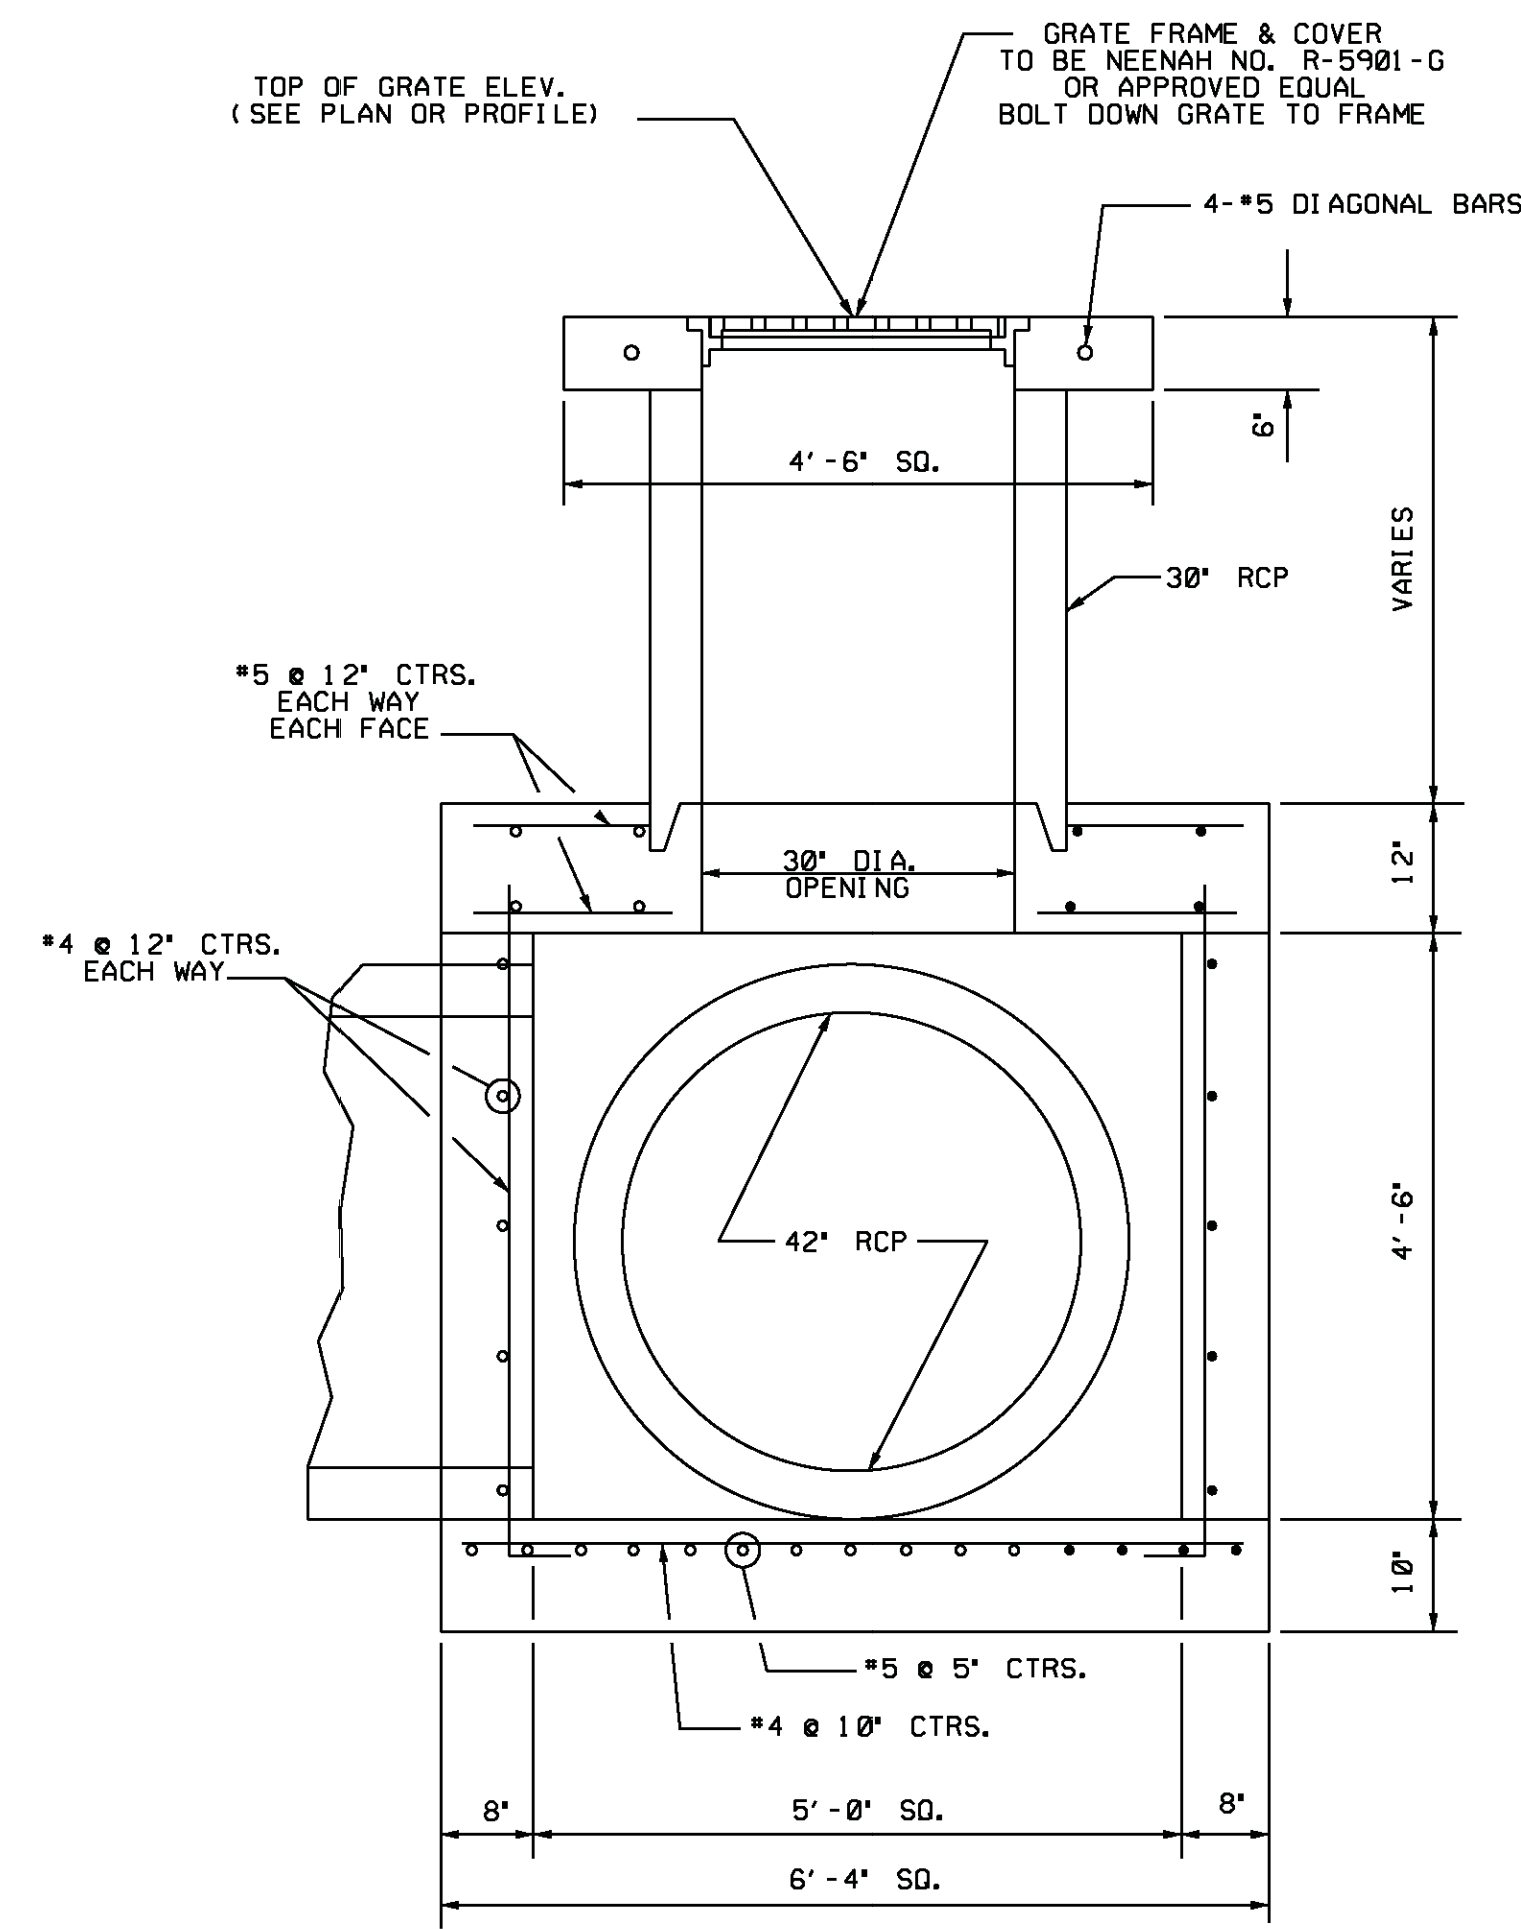


SECTION A-A


DETAIL 3
REINFORCED CONCRETE BOX
N.T.S.

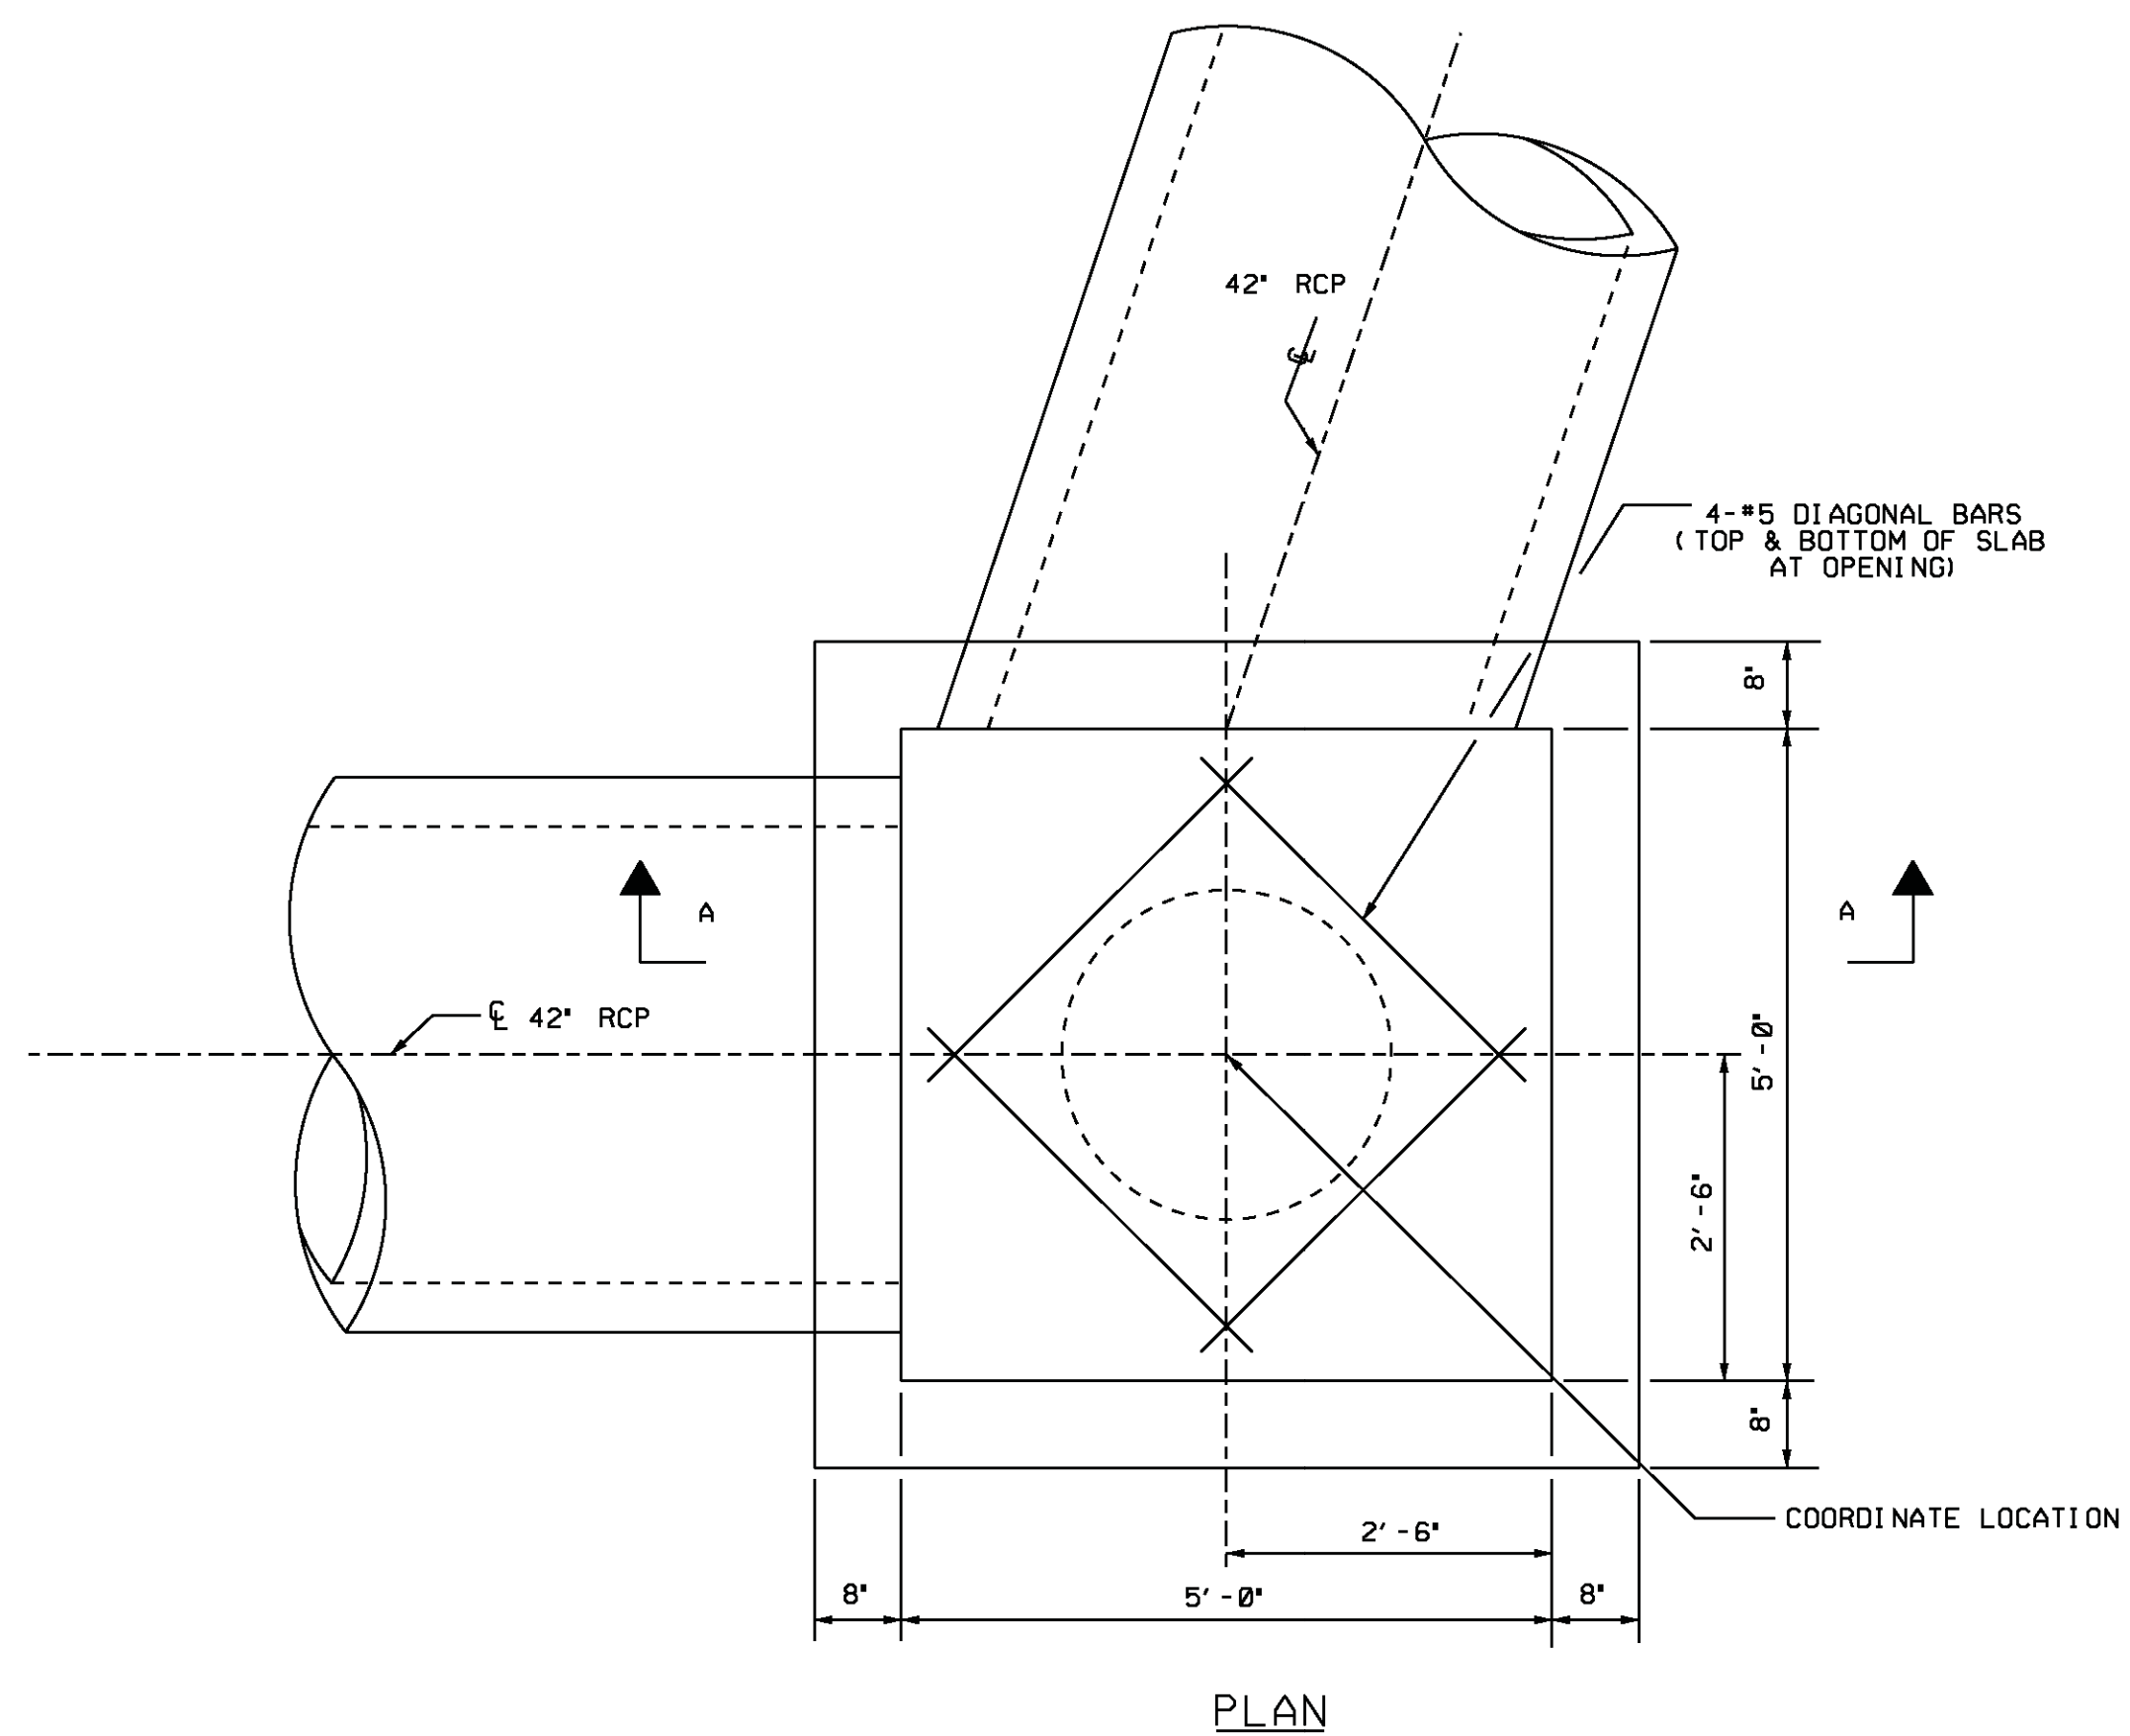


PLAN

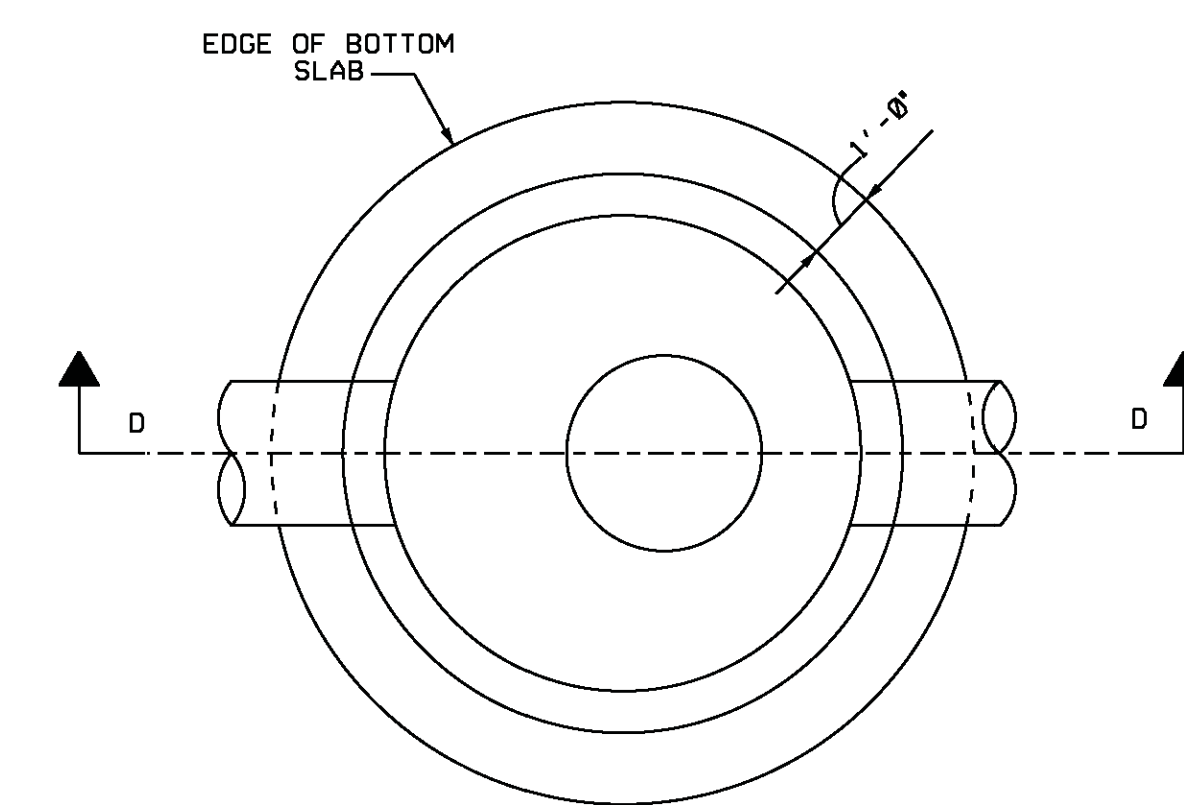


PLAN
N.T.S.

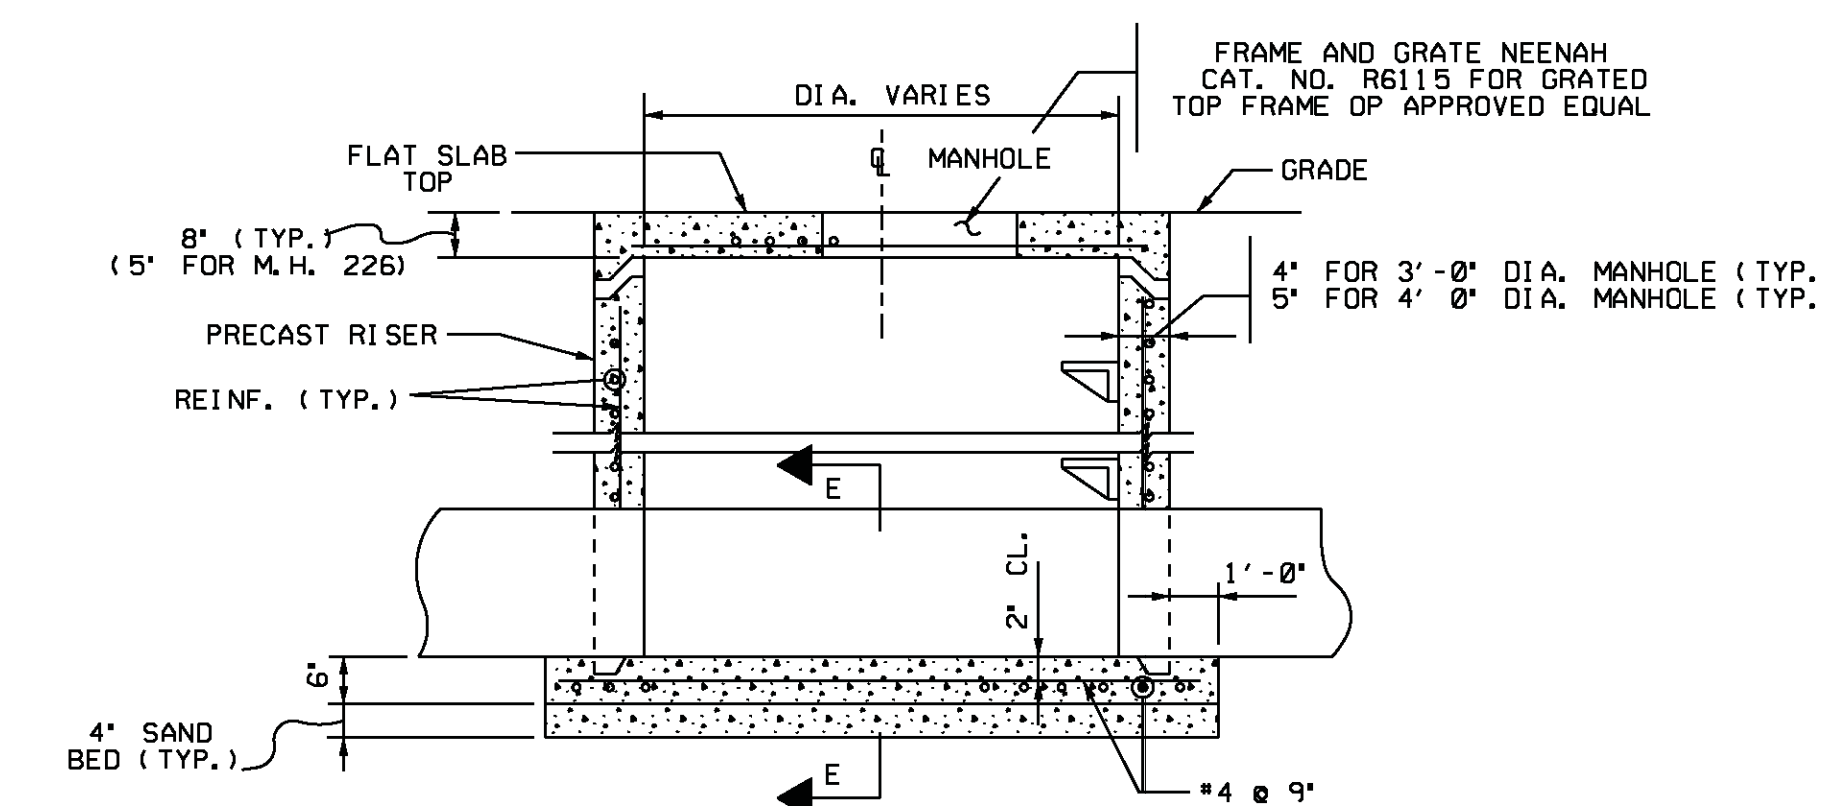


SECTION D
MANHOLE TYPE "A"
N.T.S.

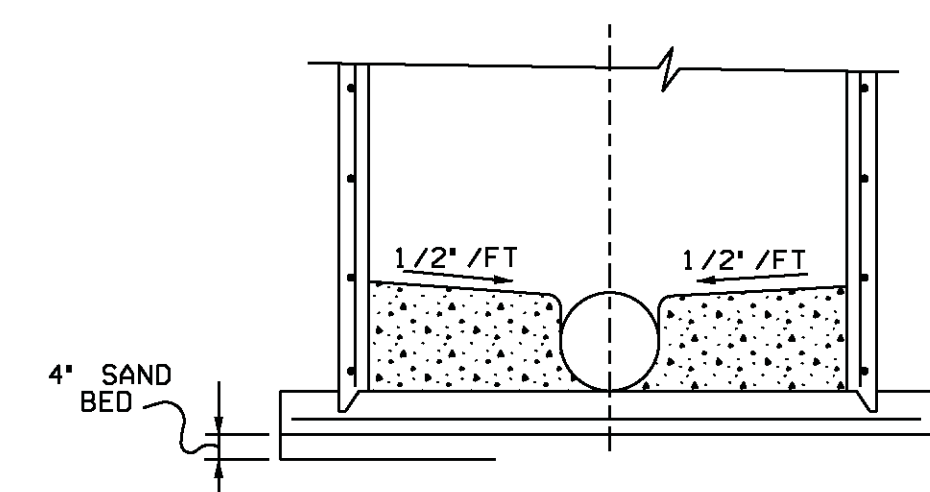


SECTION E
N.T.S.

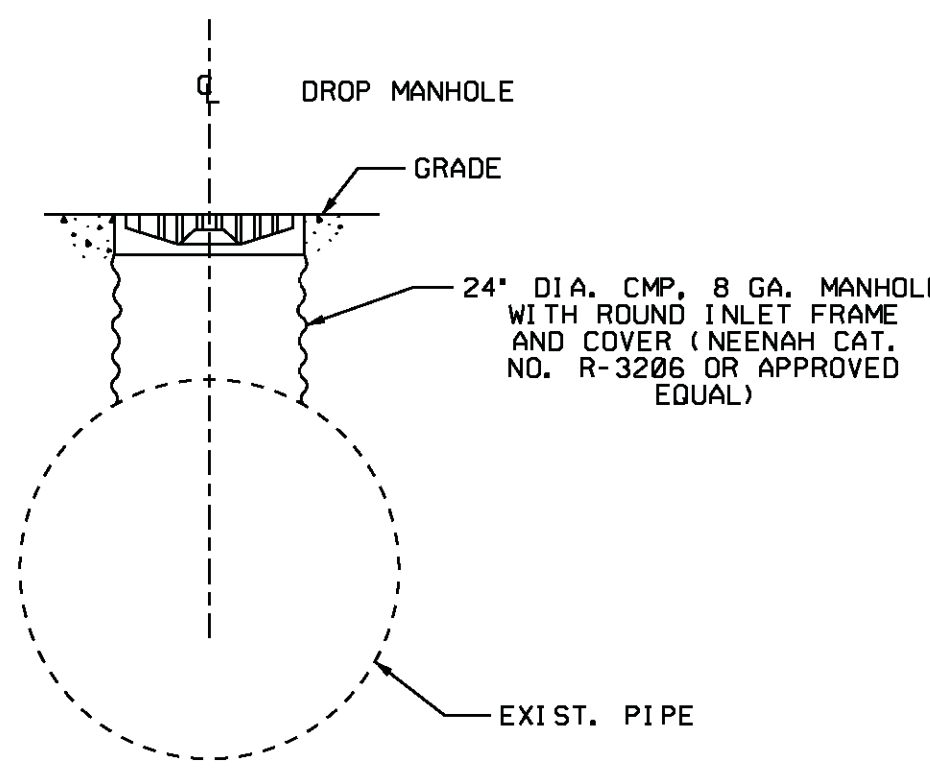

CMP DROP MANHOLE TYPE "F"
N.T.S.

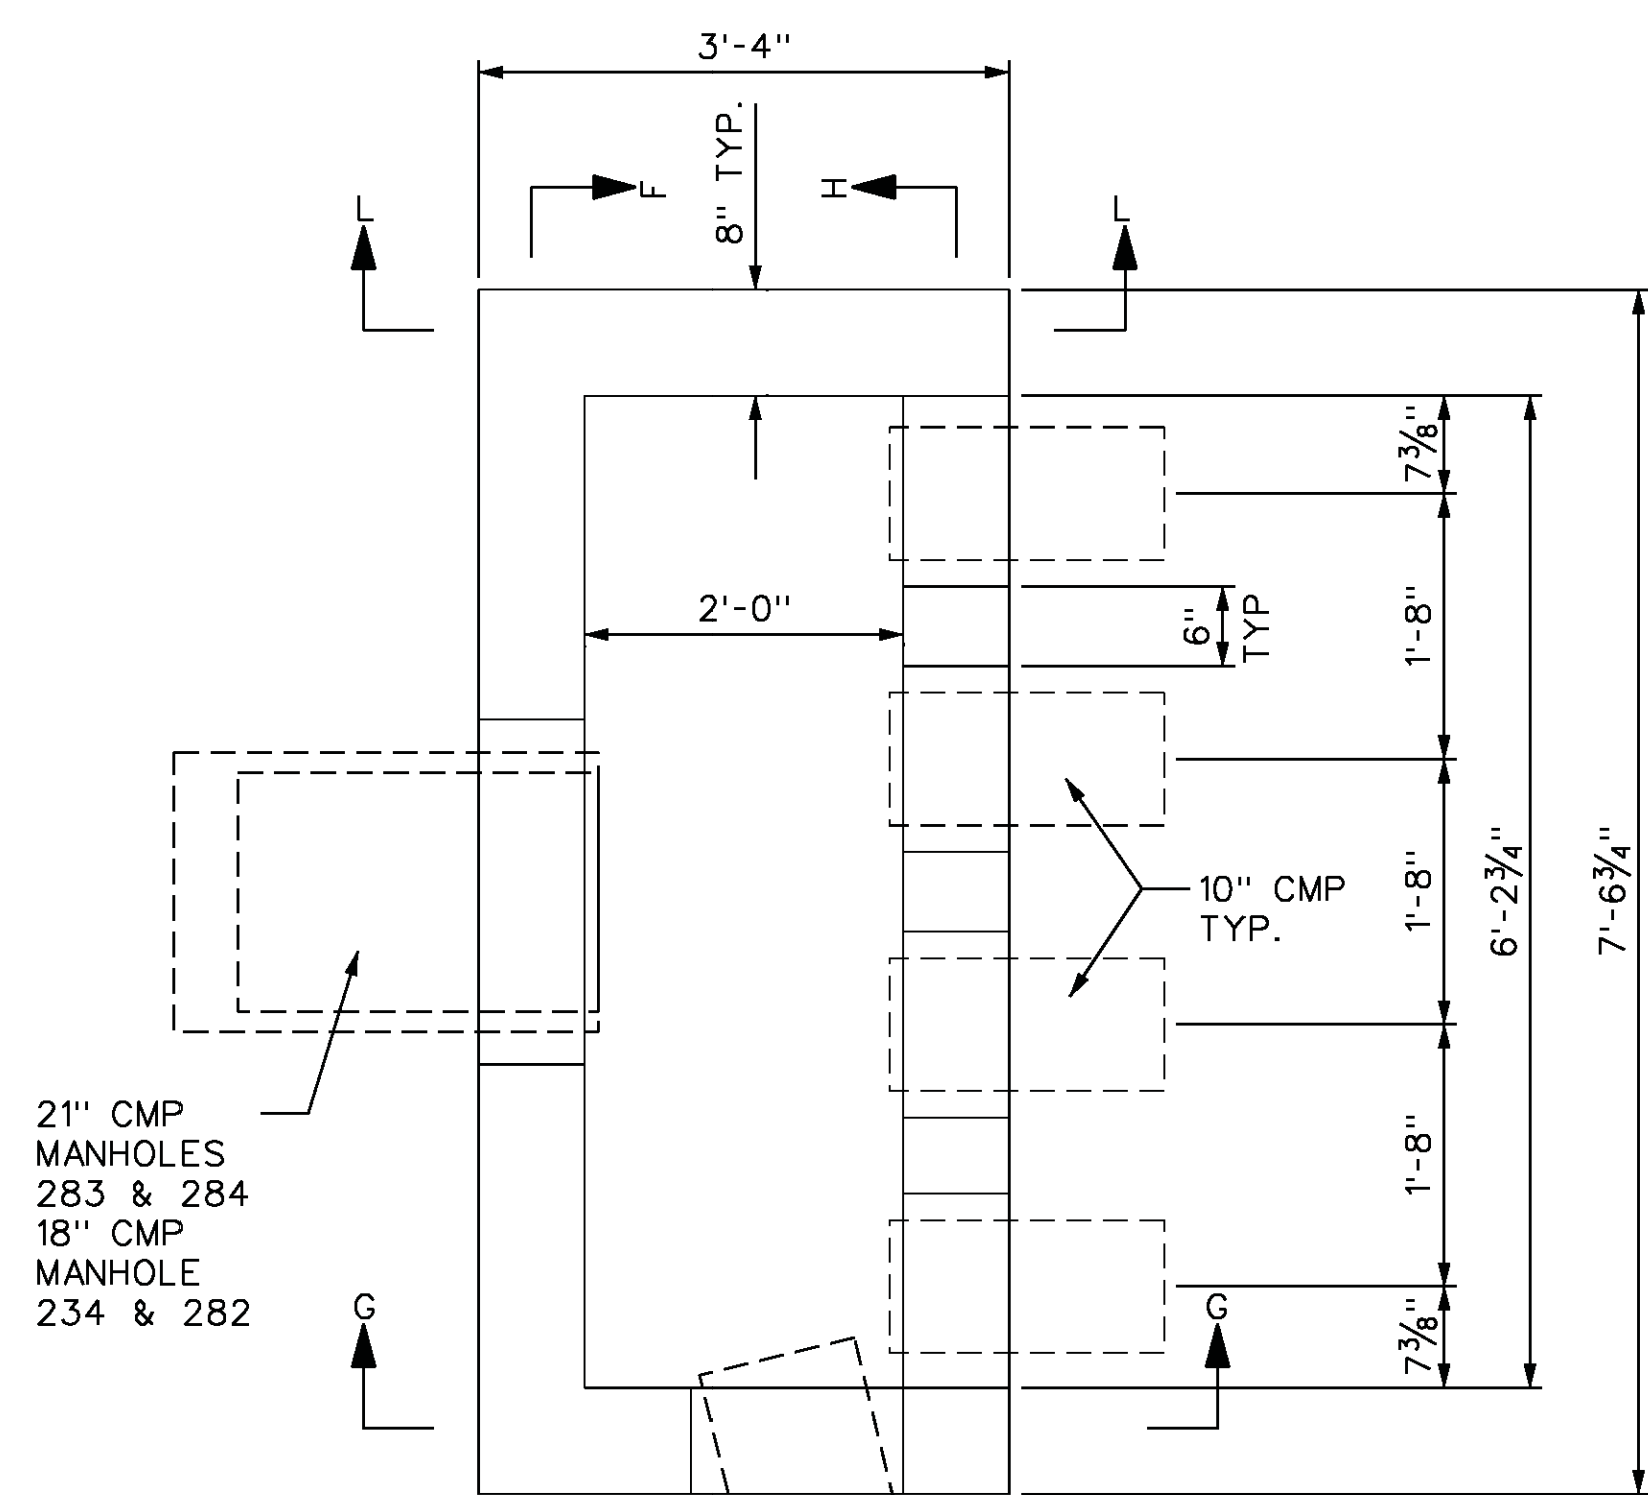


SECURITY SITE
DRAINAGE MANHOLE PLAN
MANHOLES 234, 282, 283, AND 284

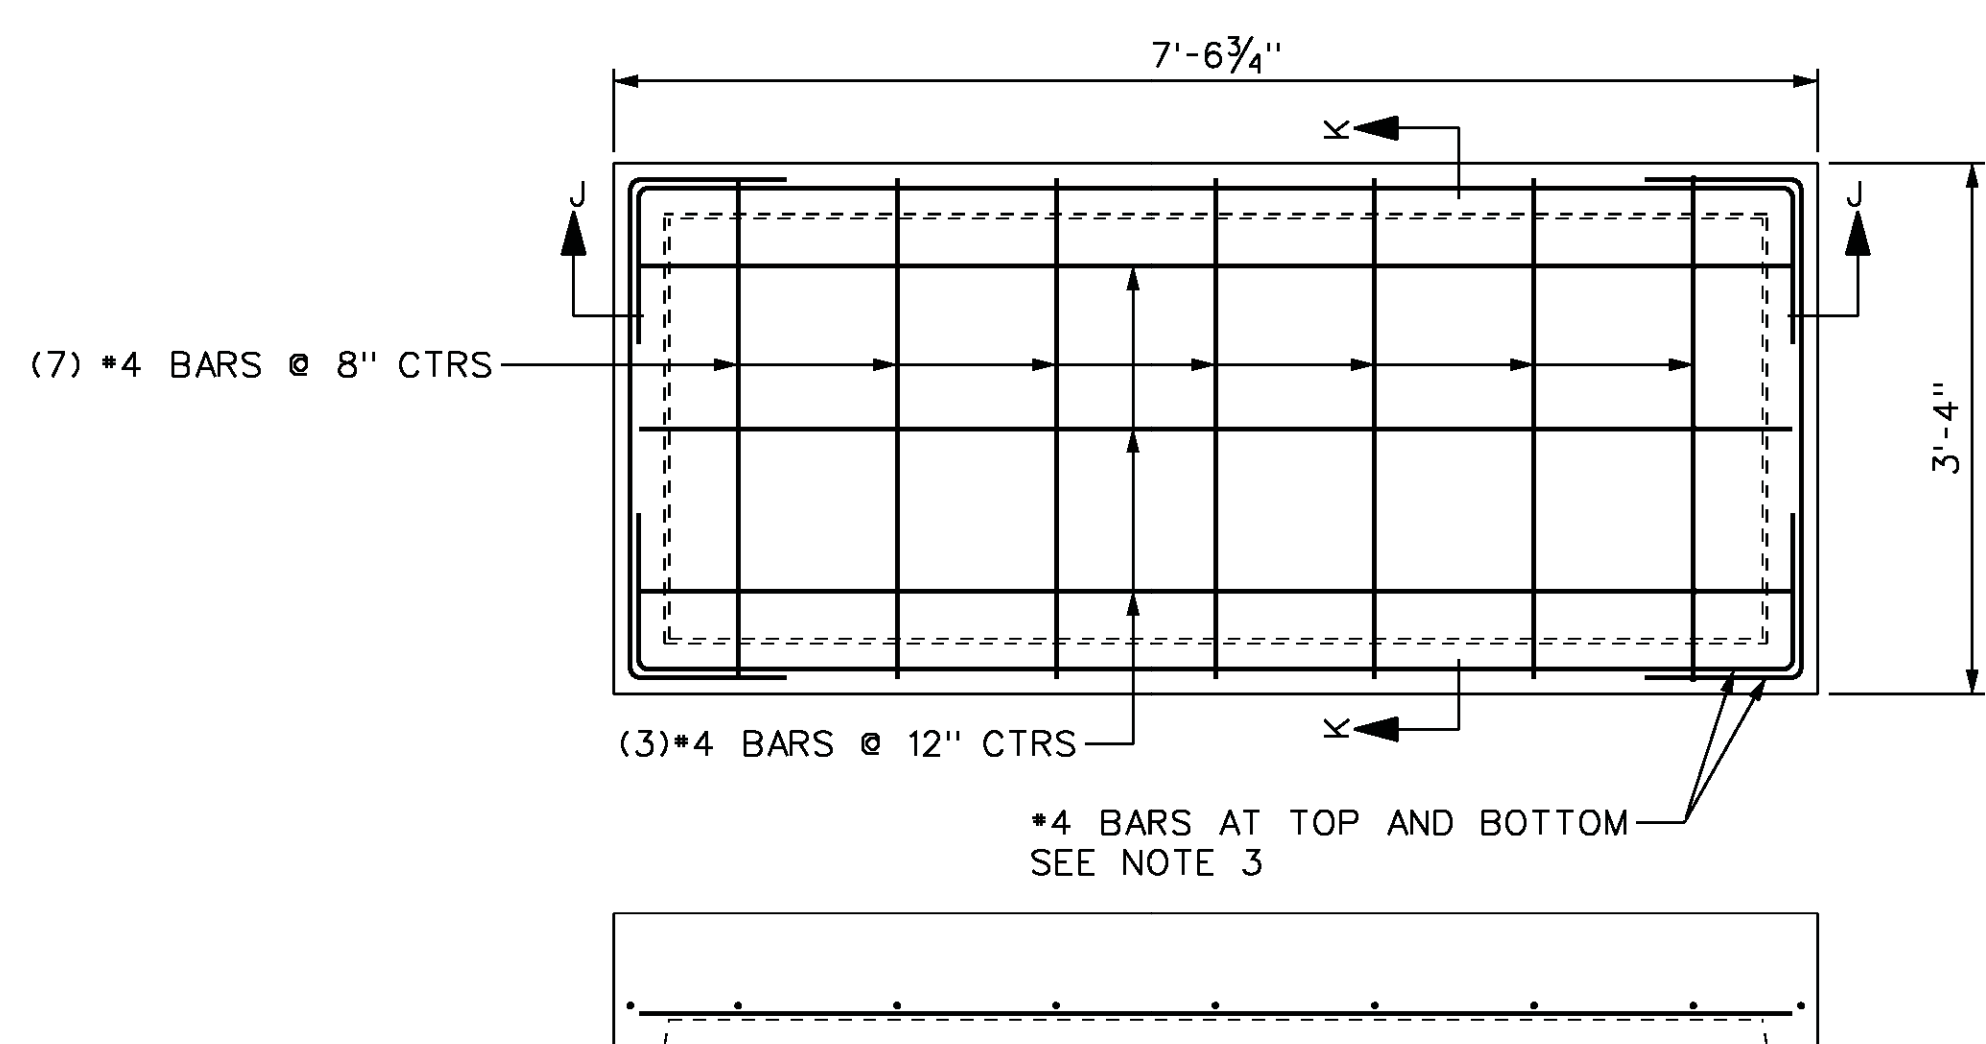

SECTION J-J


SECTION K-K
MANHOLE VAULT
LID REINFORCEMENT PLAN

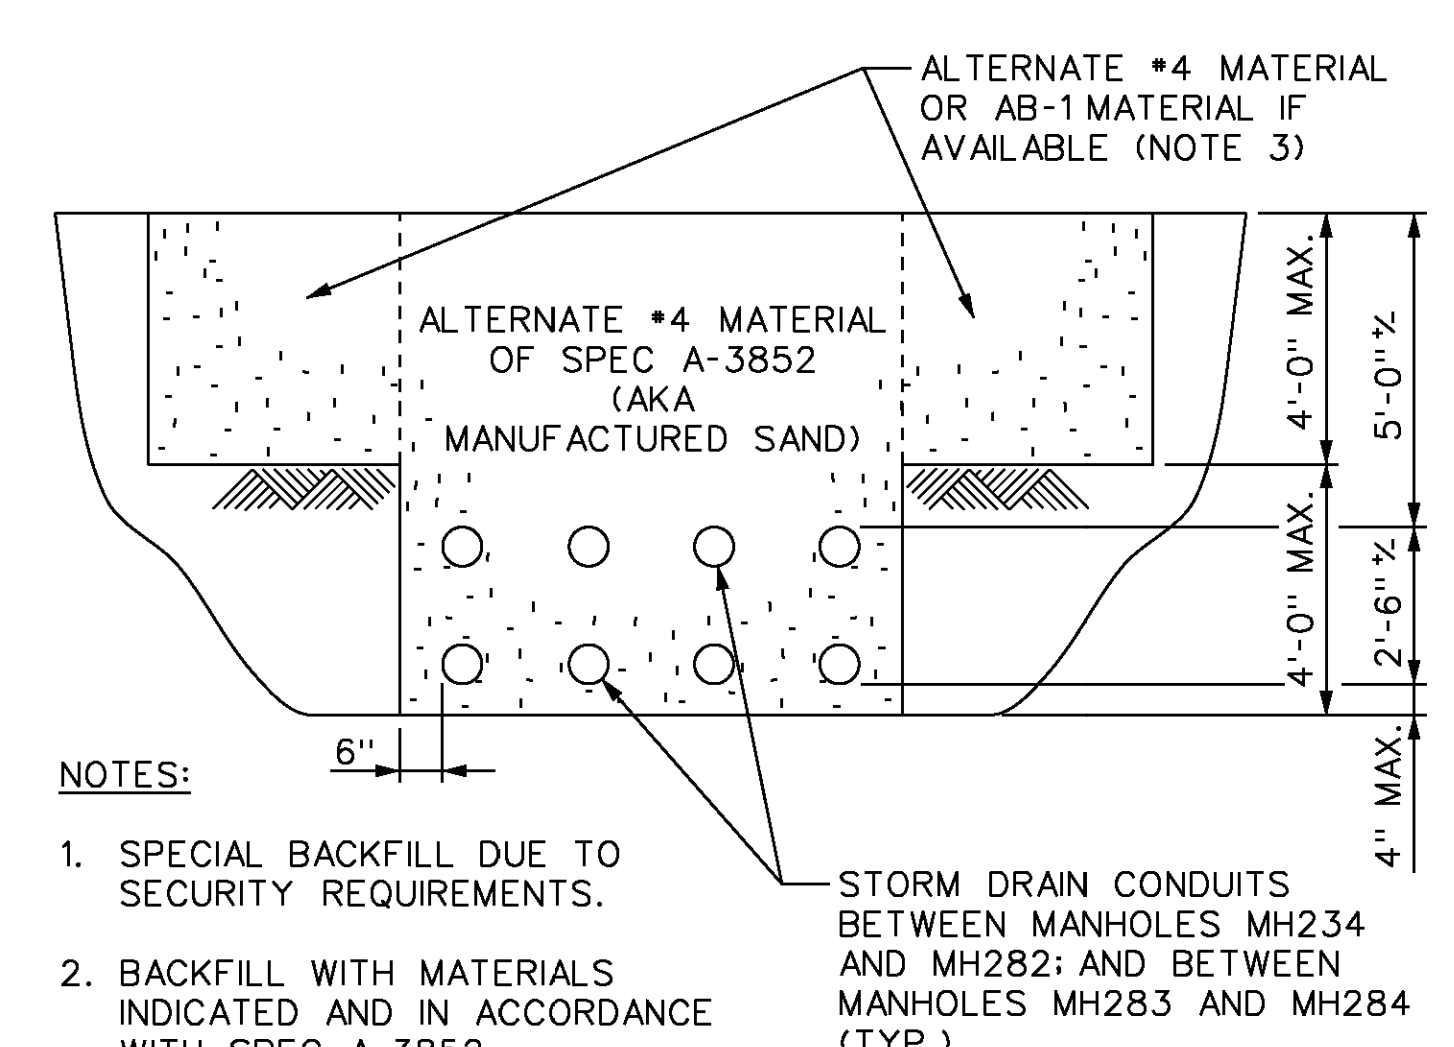


NOTES:

1. SPECIAL BACKFILL DUE TO SECURITY REQUIREMENTS.
2. BACKFILL WITH MATERIALS INDICATED AND IN ACCORDANCE WITH SPEC. A-3852.
3. CLEAN MATERIAL EXCAVATED FROM THE LOCATIONS MAY BE USED IN THESE AREAS ALSO.

BACKFILL FOR STORM DRAIN CONDUITS
MANHOLES 234, 282, 283, AND 284

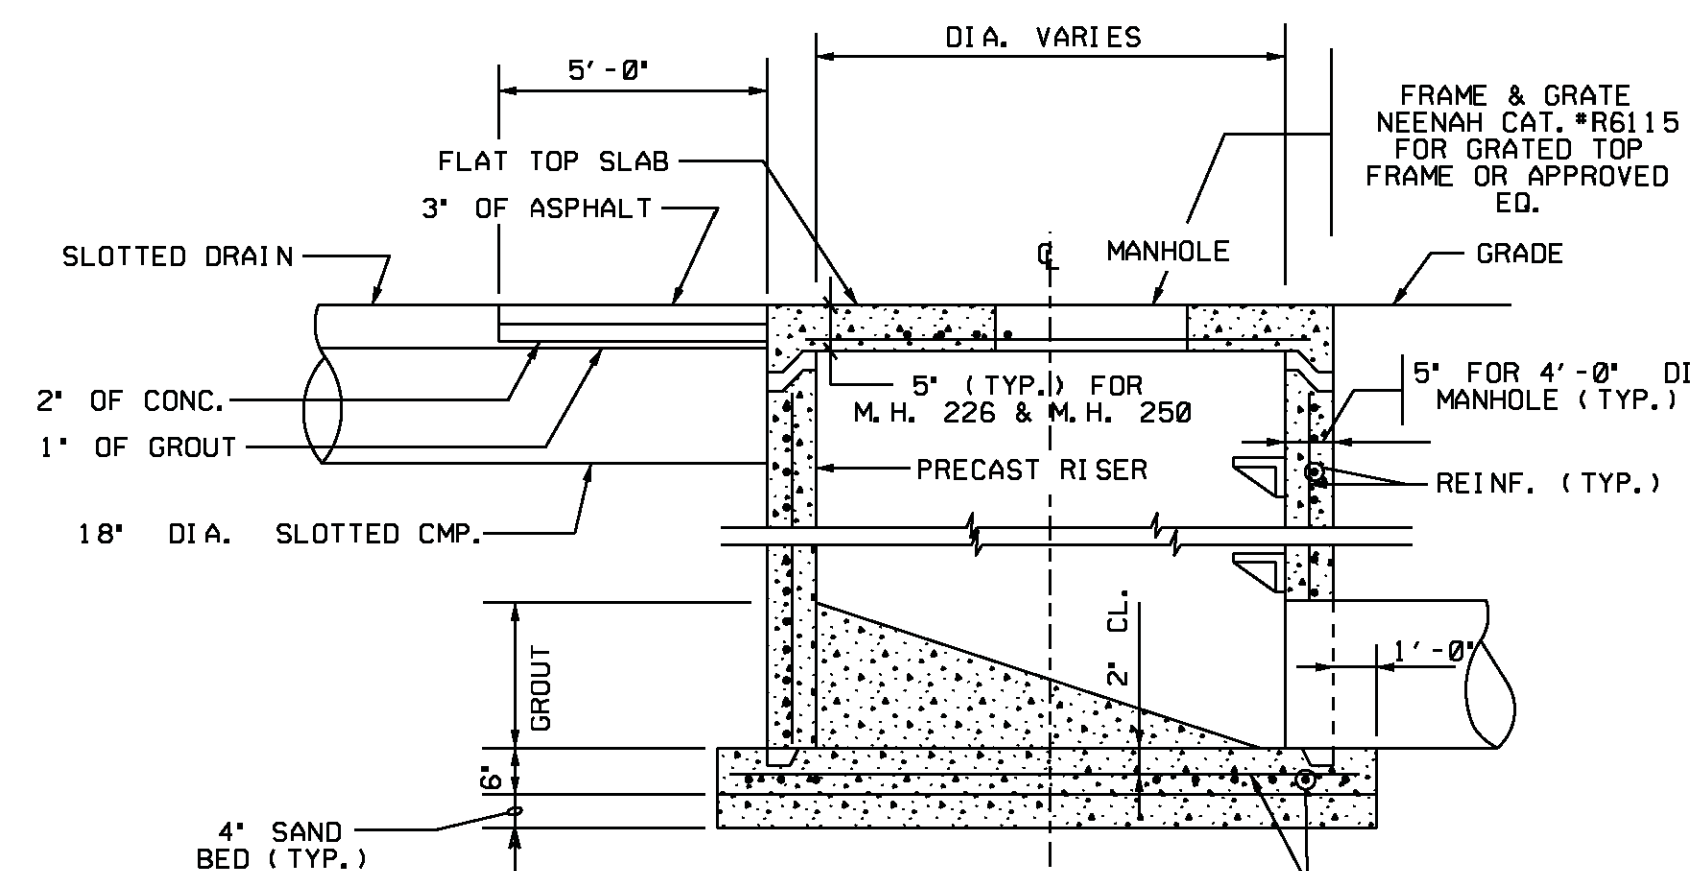


MANHOLE 250
N.T.S.

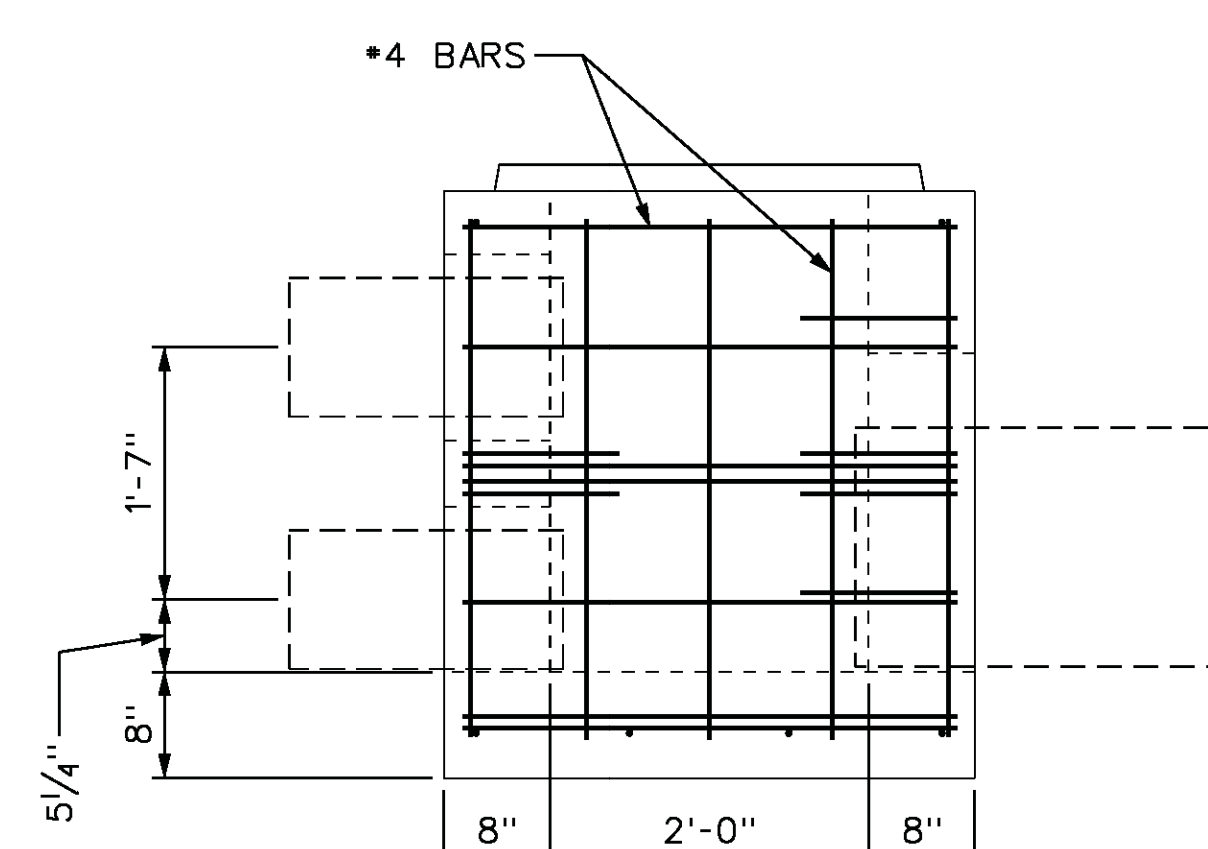


SECTION L-L


- GENERAL NOTES
1. ALL REBAR SHALL BE #4 BARS
 2. 5" CLEARANCE TYP.
 3. ALL REBAR SHALL BE FIELD BEND
 4. ALL REBAR SHALL BE GRADE 60
 5. ALL CONCRETE SHALL BE 4000 PSI, 28 DAY COMPRESSIVE STRENGTH

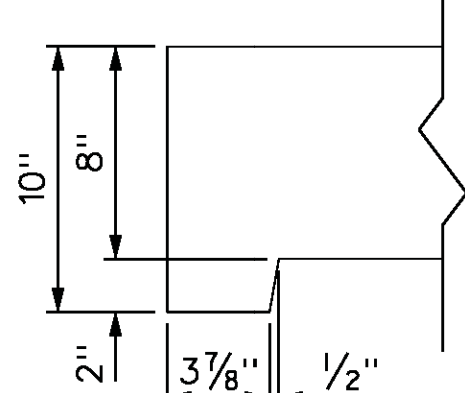


DETAIL 4
KEY WAY DETAIL

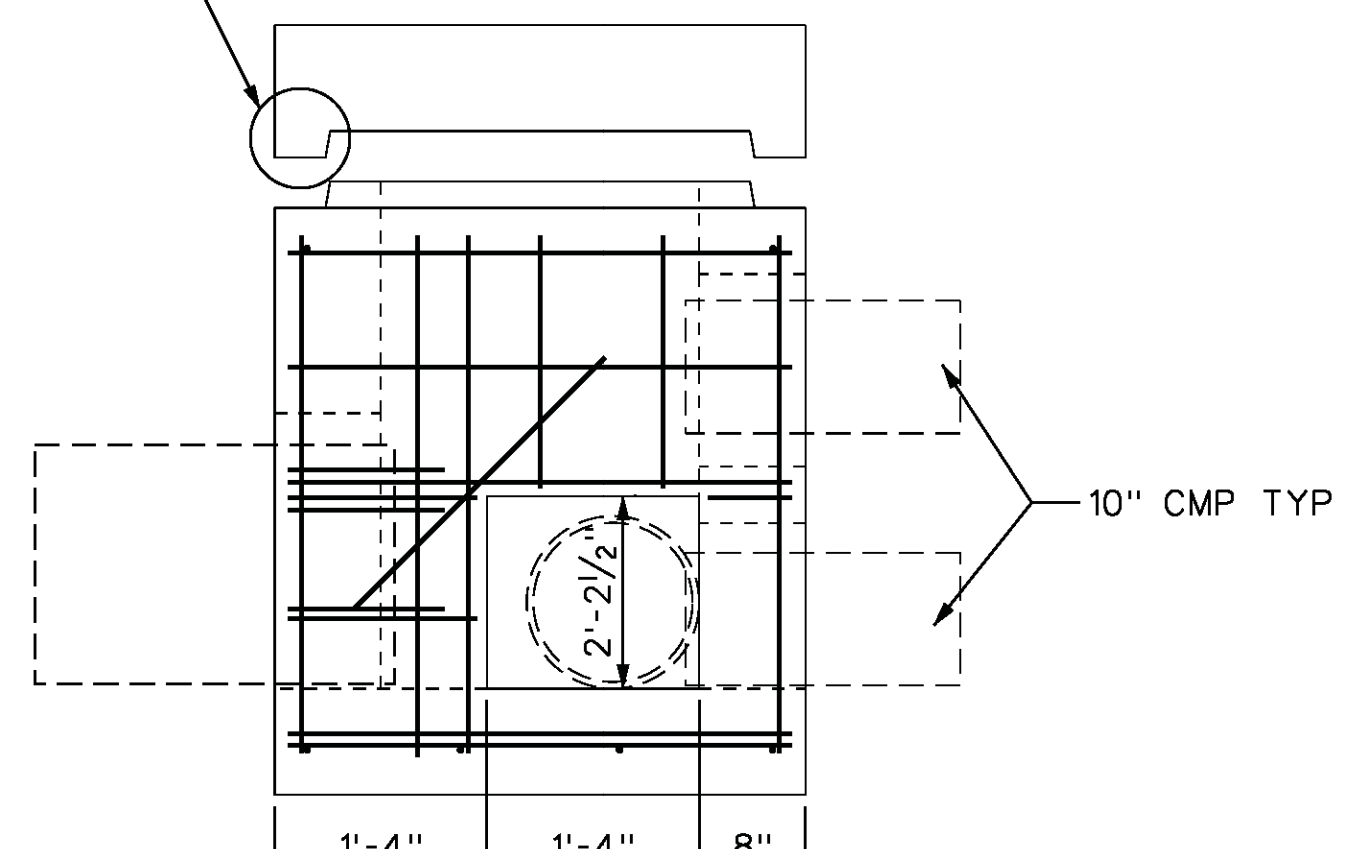

SECTION G-G
MANHOLE 234 ONLY

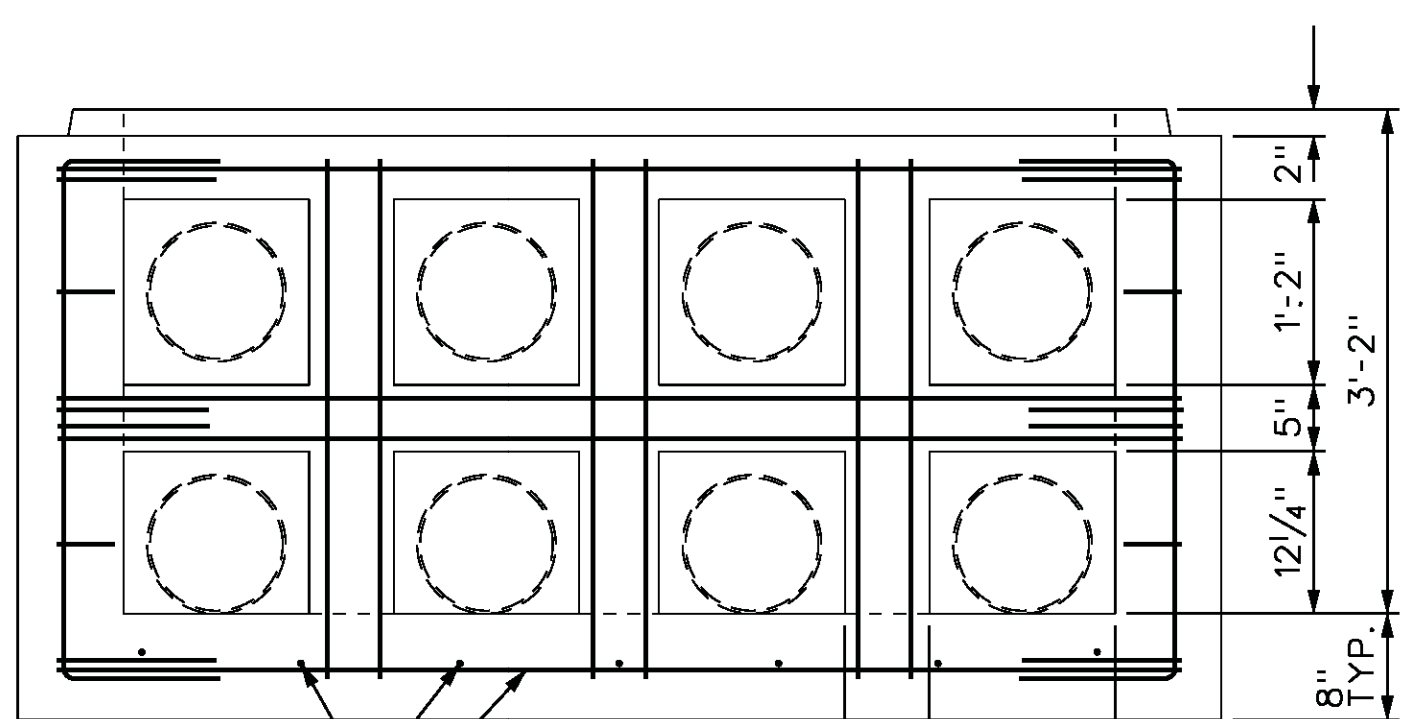


SECTION F-F

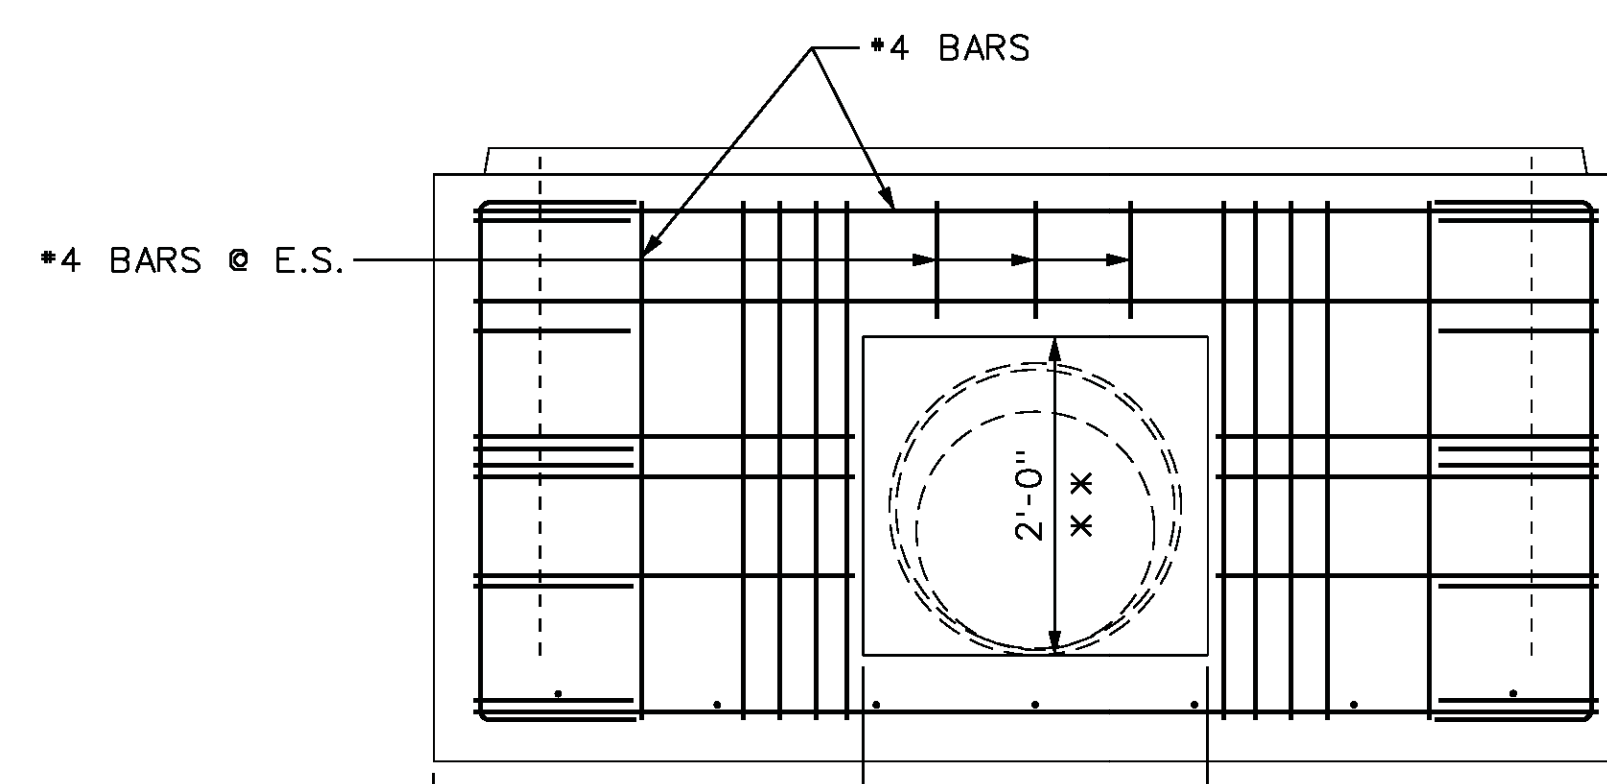


SECTION H-H


* * HOLE MAY BE OFFSET FROM MIDDLE.

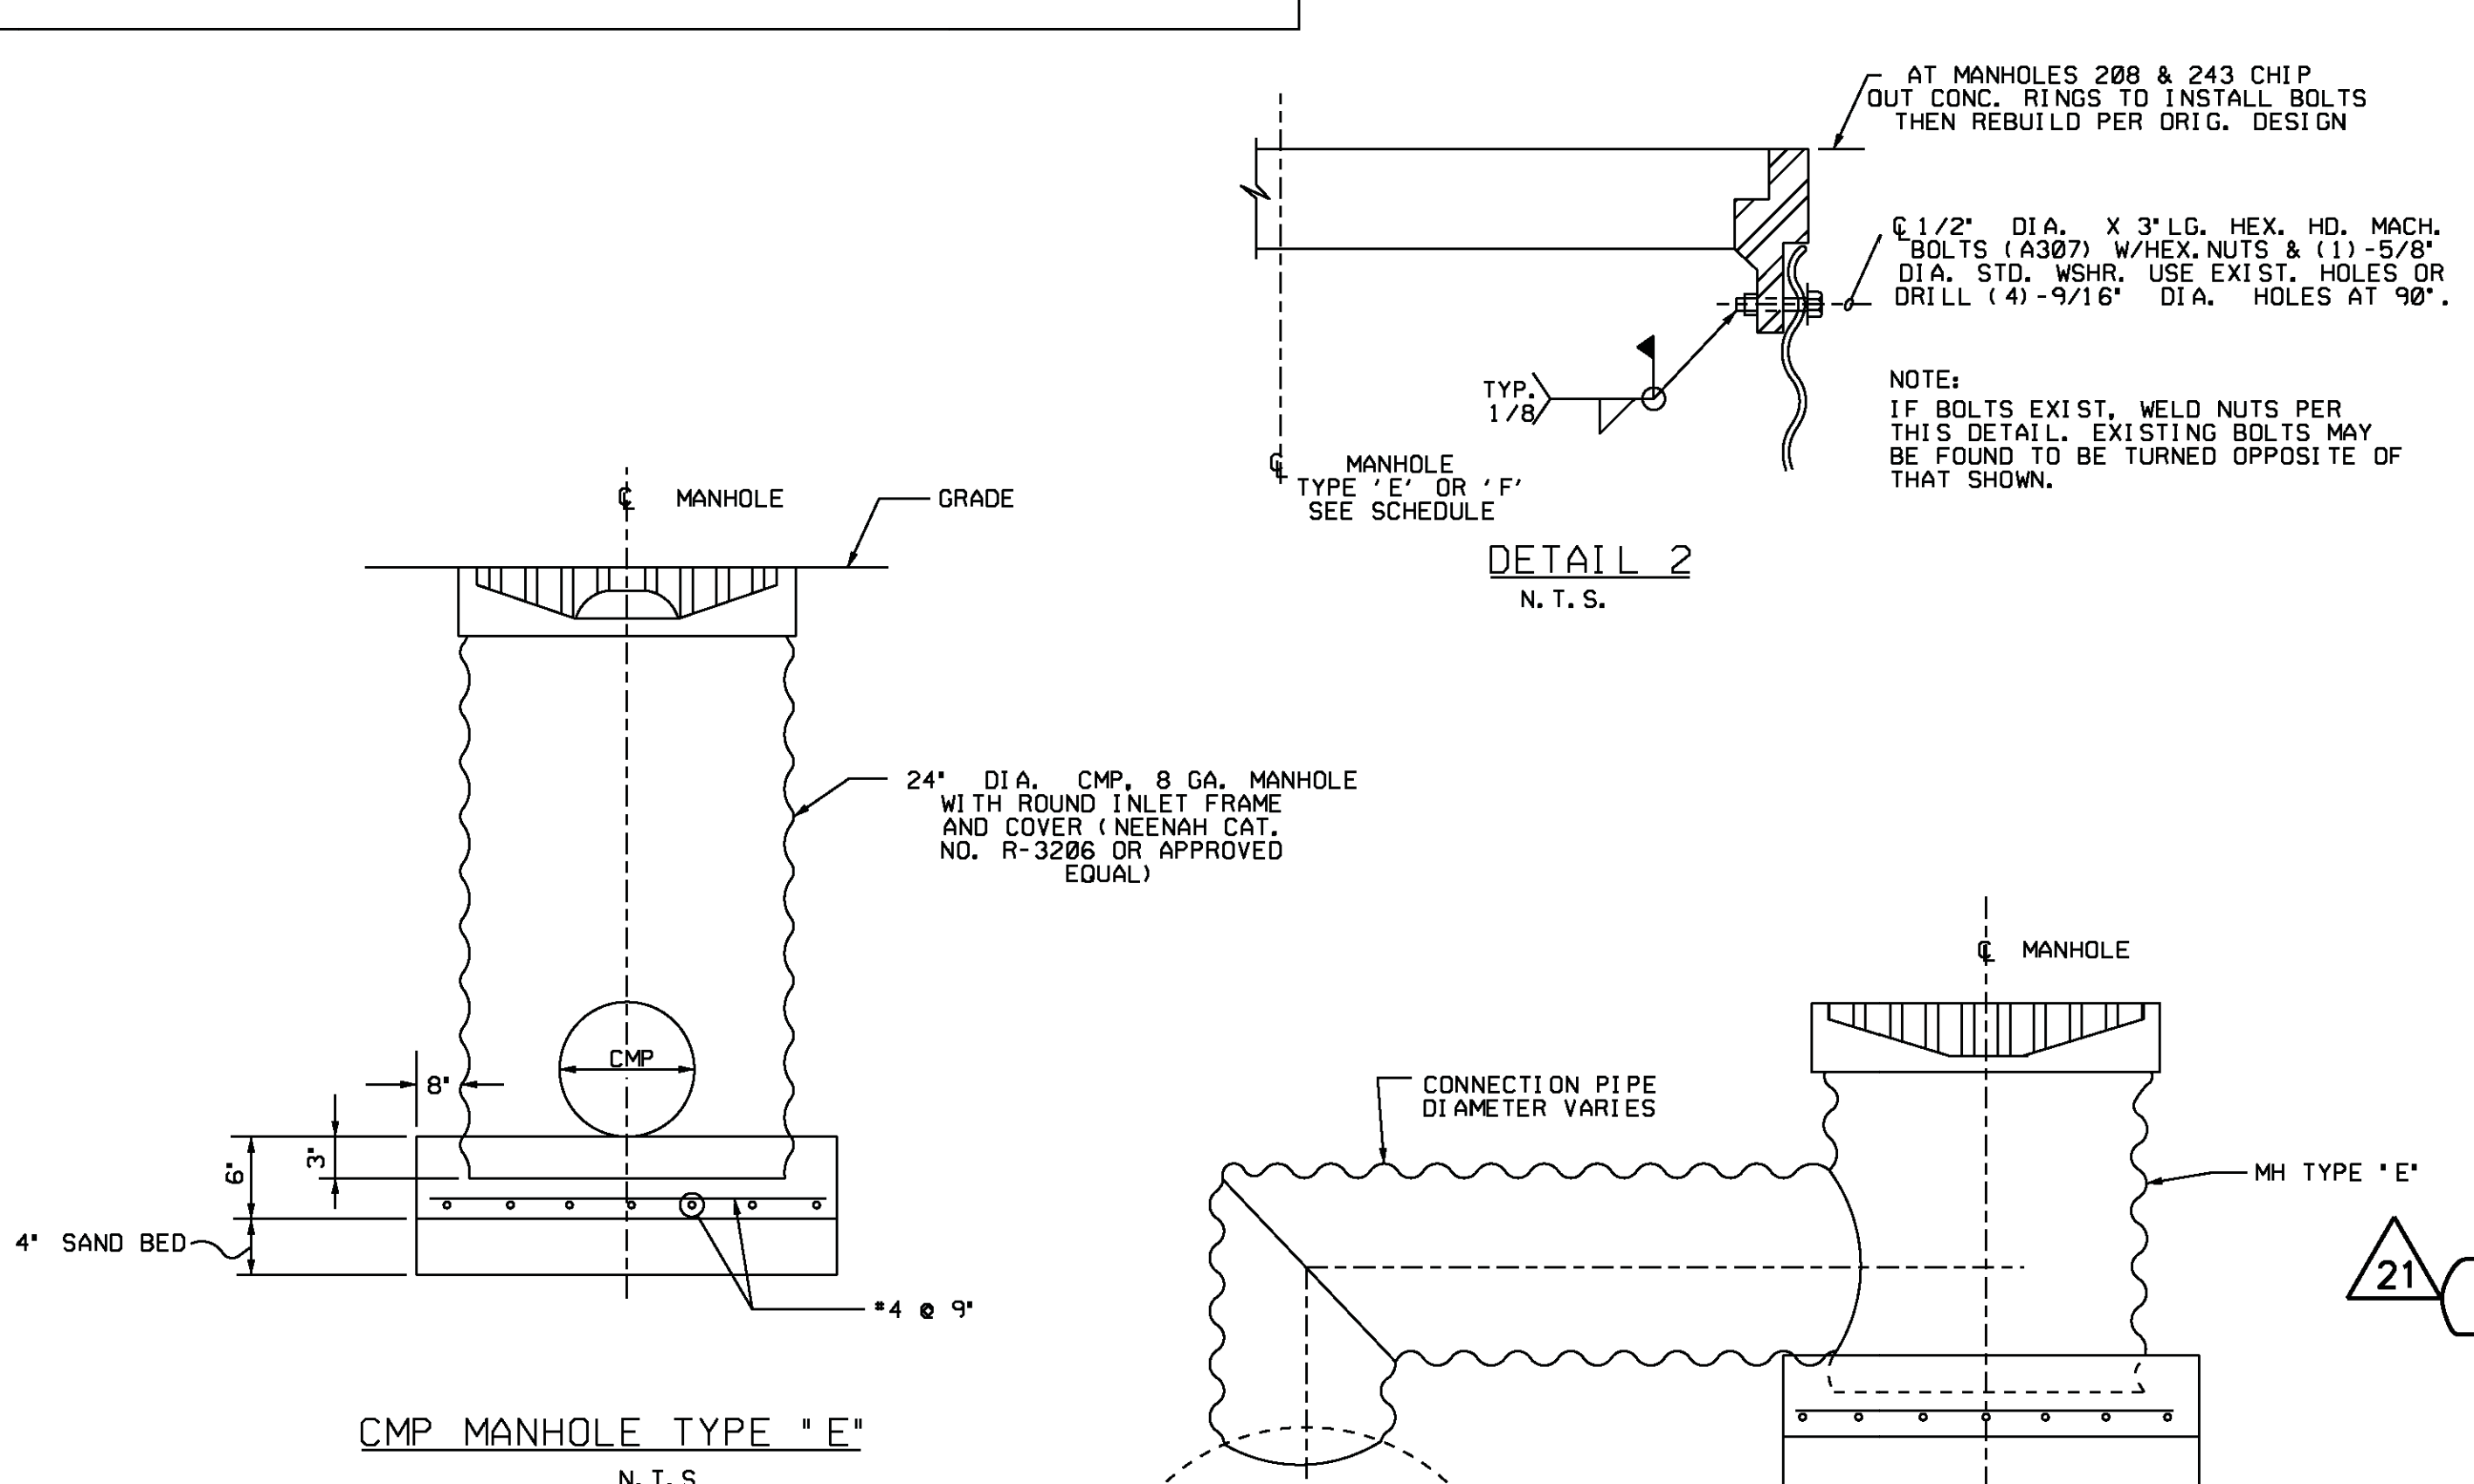

CMP MANHOLE TYPE "E"
N.T.S.

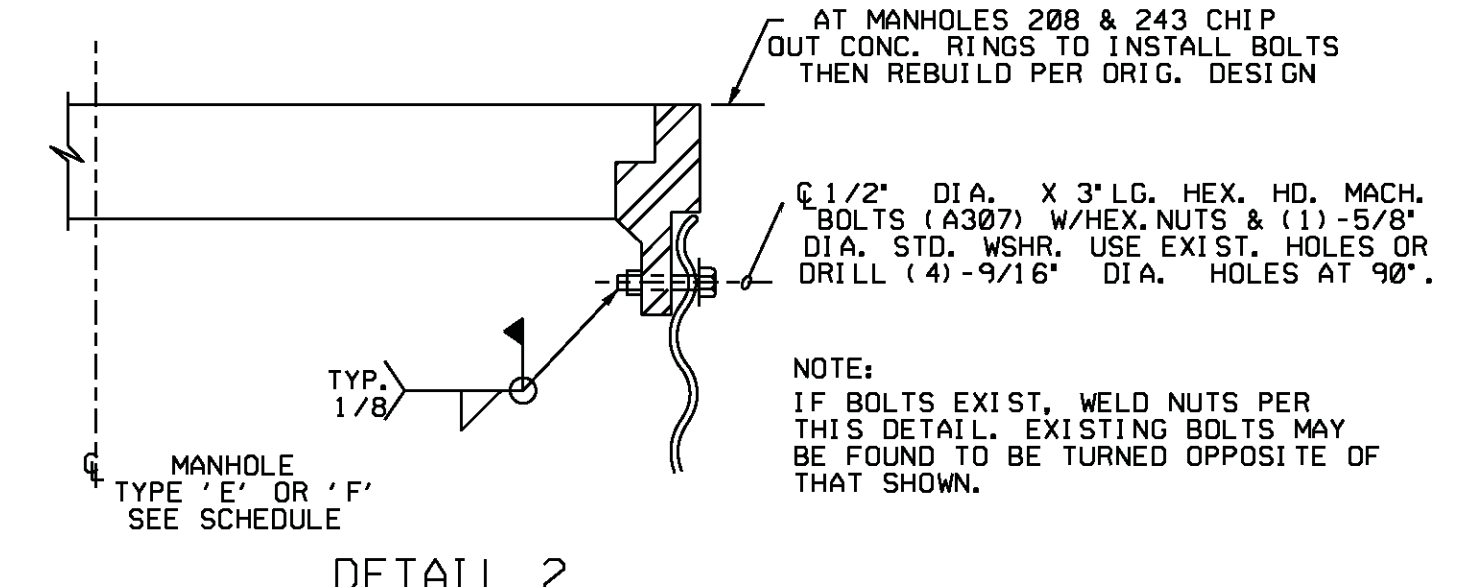

DETAIL 2
N.T.S.

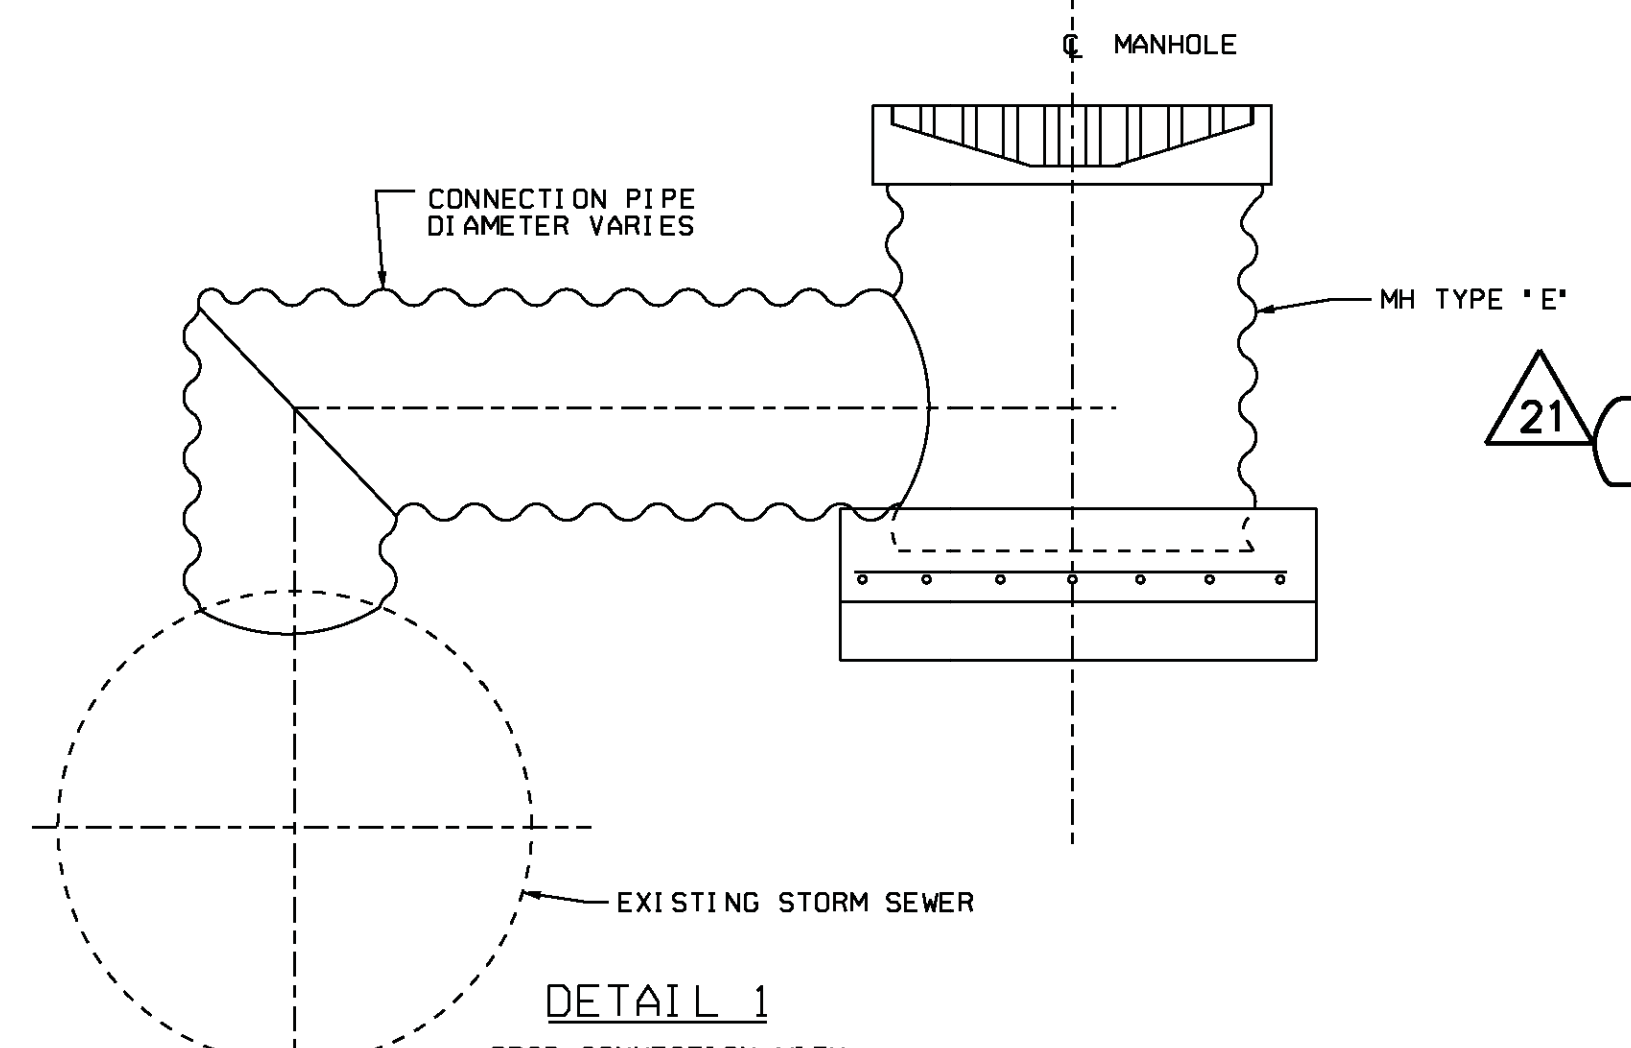

DETAIL 1
DROP CONNECTION WITH
MANHOLE TYPE "E"
SCALE: NONE

NOTES	
1.	FOR GENERAL NOTES & LEGEND SEE DRAWING S-292
2.	USE THIS DRAWING IN CONJUNCTION WITH DRAWING S-0296 SHEET 2.

REFERENCE DRAWINGS	
S-0292	PLANT AREA ROADWAY, GRADING & DRAINAGE PLAN SHEET 1
S-0293	PLANT AREA ROADWAY, GRADING & DRAINAGE PLAN SHEET 2
S-0294	WAREHOUSE AREA ROADWAY, GRADING & DRAINAGE PLAN SH. 3
S-0297	PLANT AREA ROADWAY, GRADING & DRAINAGE PLAN SH. 4
S-0298	PLANT AREA ROADWAY, GRADING & DRAINAGE PLAN SH. 5
S-0299	DRAINAGE DETAILS & SECTIONS SH. 1 & 3
S-0186	DRAINAGE PLAN PLANT AREA
S-0189	MANHOLE, PIPE & CULVERT SCHEDULE
S-0191	MANHOLE & PIPE DETAILS
S-0296	MANHOLE & PIPE DETAILS SHEET 2.

Z017A-C-0004	DIMENSION PLAN WCNOC PRE-SCREENING STRUCTURE Z017A.
Z017A-C-0005	GRADING PLAN WCNOC PRE-SCREENING STRUCTURE Z017A.

USAR FIG. 2.4-3-06A

REVISED	INCORPORATED	CHANGE
CHG. DOC.	CHG. DOC.	013233
ISSUED		PKG. NO.
THIS DNG. SUPERSEDED BY		REV.
REVISION NOTES AS-BUILT INFORMATION		REV.
WOLF CREEK		ELECTRONIC
NUCLEAR OPERATING CORPORATION		APPROVAL
MANHOLE AND		
PIPE DETAILS		
SCALE	DRAWING NUMBER	SHEET
NONE	S-0296	1 21

34X44 E SIZE



DESIGN DOCUMENT
CHANGE NOTICE

INITIATING DOC.
NCR/EER/FCR (CWR) PER
NO. 4244-88-2

PMR NO. 02841
REV. 0

ASSIGNED DISCIPLINE:

FACILITIES ENGINEERING

DDCN NO.

DOCUMENT NUMBER

REV.

SEQ. NO.

S-0297

K

01

OTHER DOCUMENTS AFFECTED BY THIS CHANGE:

S-0291

PAGE 1 OF 2

OTHER DDCN'S REQUIRED TO IMPLEMENT CHANGE:

DDCN S-0292-R-01

REASON FOR CHANGE:

AS BUILT INFORMATION

DESCRIPTION OF CHANGE: SEE CLOUDED "AREA OF CHANGE" ON PAGE
2 OF THIS DDCN.

REVIEWED WITHOUT COMMENTS

FSE

W. Gary Malt
7-11-89
DATE

ESE

Delbert G. Riebe
7-11-89
DATE

FSE

John J. Handberg
7-11-89
DATE

OTHER

Louis Schubert
7-11-89
DATE

RELEASE AS DDCN FOR REVISION

ASSIGNED ENG:

CHECKED BY:

APPROVED BY:

DOCUMENT CONTROL RELEASE:

DC 31

DATE:

DATE:

DATE:

DATE:

7-11-89

7-11-89

7-11-89

8-18-89

MICROFILMED



DESIGN DOCUMENT
CHANGE NOTICE
CONTINUATION SHEET

INITIATING DOC.
NCR/EER/FCR/CWRYPER
NO. 4244-88-2

PMR NO. 02841
REV. 0

ASSIGNED DISCIPLINE:

FACILITIES ENGINEERING

DDCN NO.

DOCUMENT NUMBER

REV.

SEQ. NO.

S-0297

K

01

PAGE 2 OF 2

