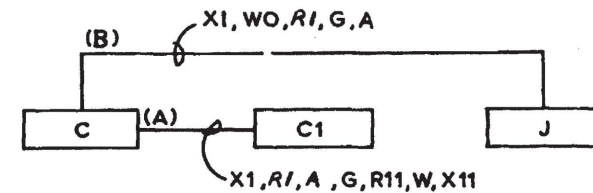


DESCRIPTION

NOTES:

1. FOR GENERAL NOTES SEE DWG. INDEX E-45B.
2. FOR REFERENCE VENDOR DRAWINGS SEE GE WIRING
DIAGRAM 134B541BE SH. 28 (BECHTEL DRAWING
7749-M-38-134) AND GE SCHEMATIC DIAGRAM
509E481EX SH. 1 (BECHTEL DRAWING 7749-M-38-178).
3. RELAY (K1008) ENERGIZES IN MANUAL MODE.

CONTROL TRANS
TR
X-805
X-806

DAVIS-BESSE NUCLEAR POWER STATION

**THE TOLEDO EDISON COMPANY
THE CLEVELAND ELECTRIC ILLUMINATING COMPANY**


ELEMENTARY WIRING DIAGRAM
AFPT & MEPT CONTROL AUXILIARIES
MEPT CONTROL

I CERTIFY THAT THE IMAGE CONTAINED ON THIS FRAME WAS MADE IN THE NORMAL AND REGULAR COURSE OF BUSINESS, ON THE DATE STATED BELOW AND THAT IT IS AN ACCURATE REPRODUCTION OF THE RECORD(S) SUBMITTED TO NUCLEAR RECORDS MANAGEMENT.


DATE 1-26-87 OPERATOR

OPERATOR

REPRODUCTION OF THE RECORD(S)
AGEMENT.
R Lisa M. McCloskey BX

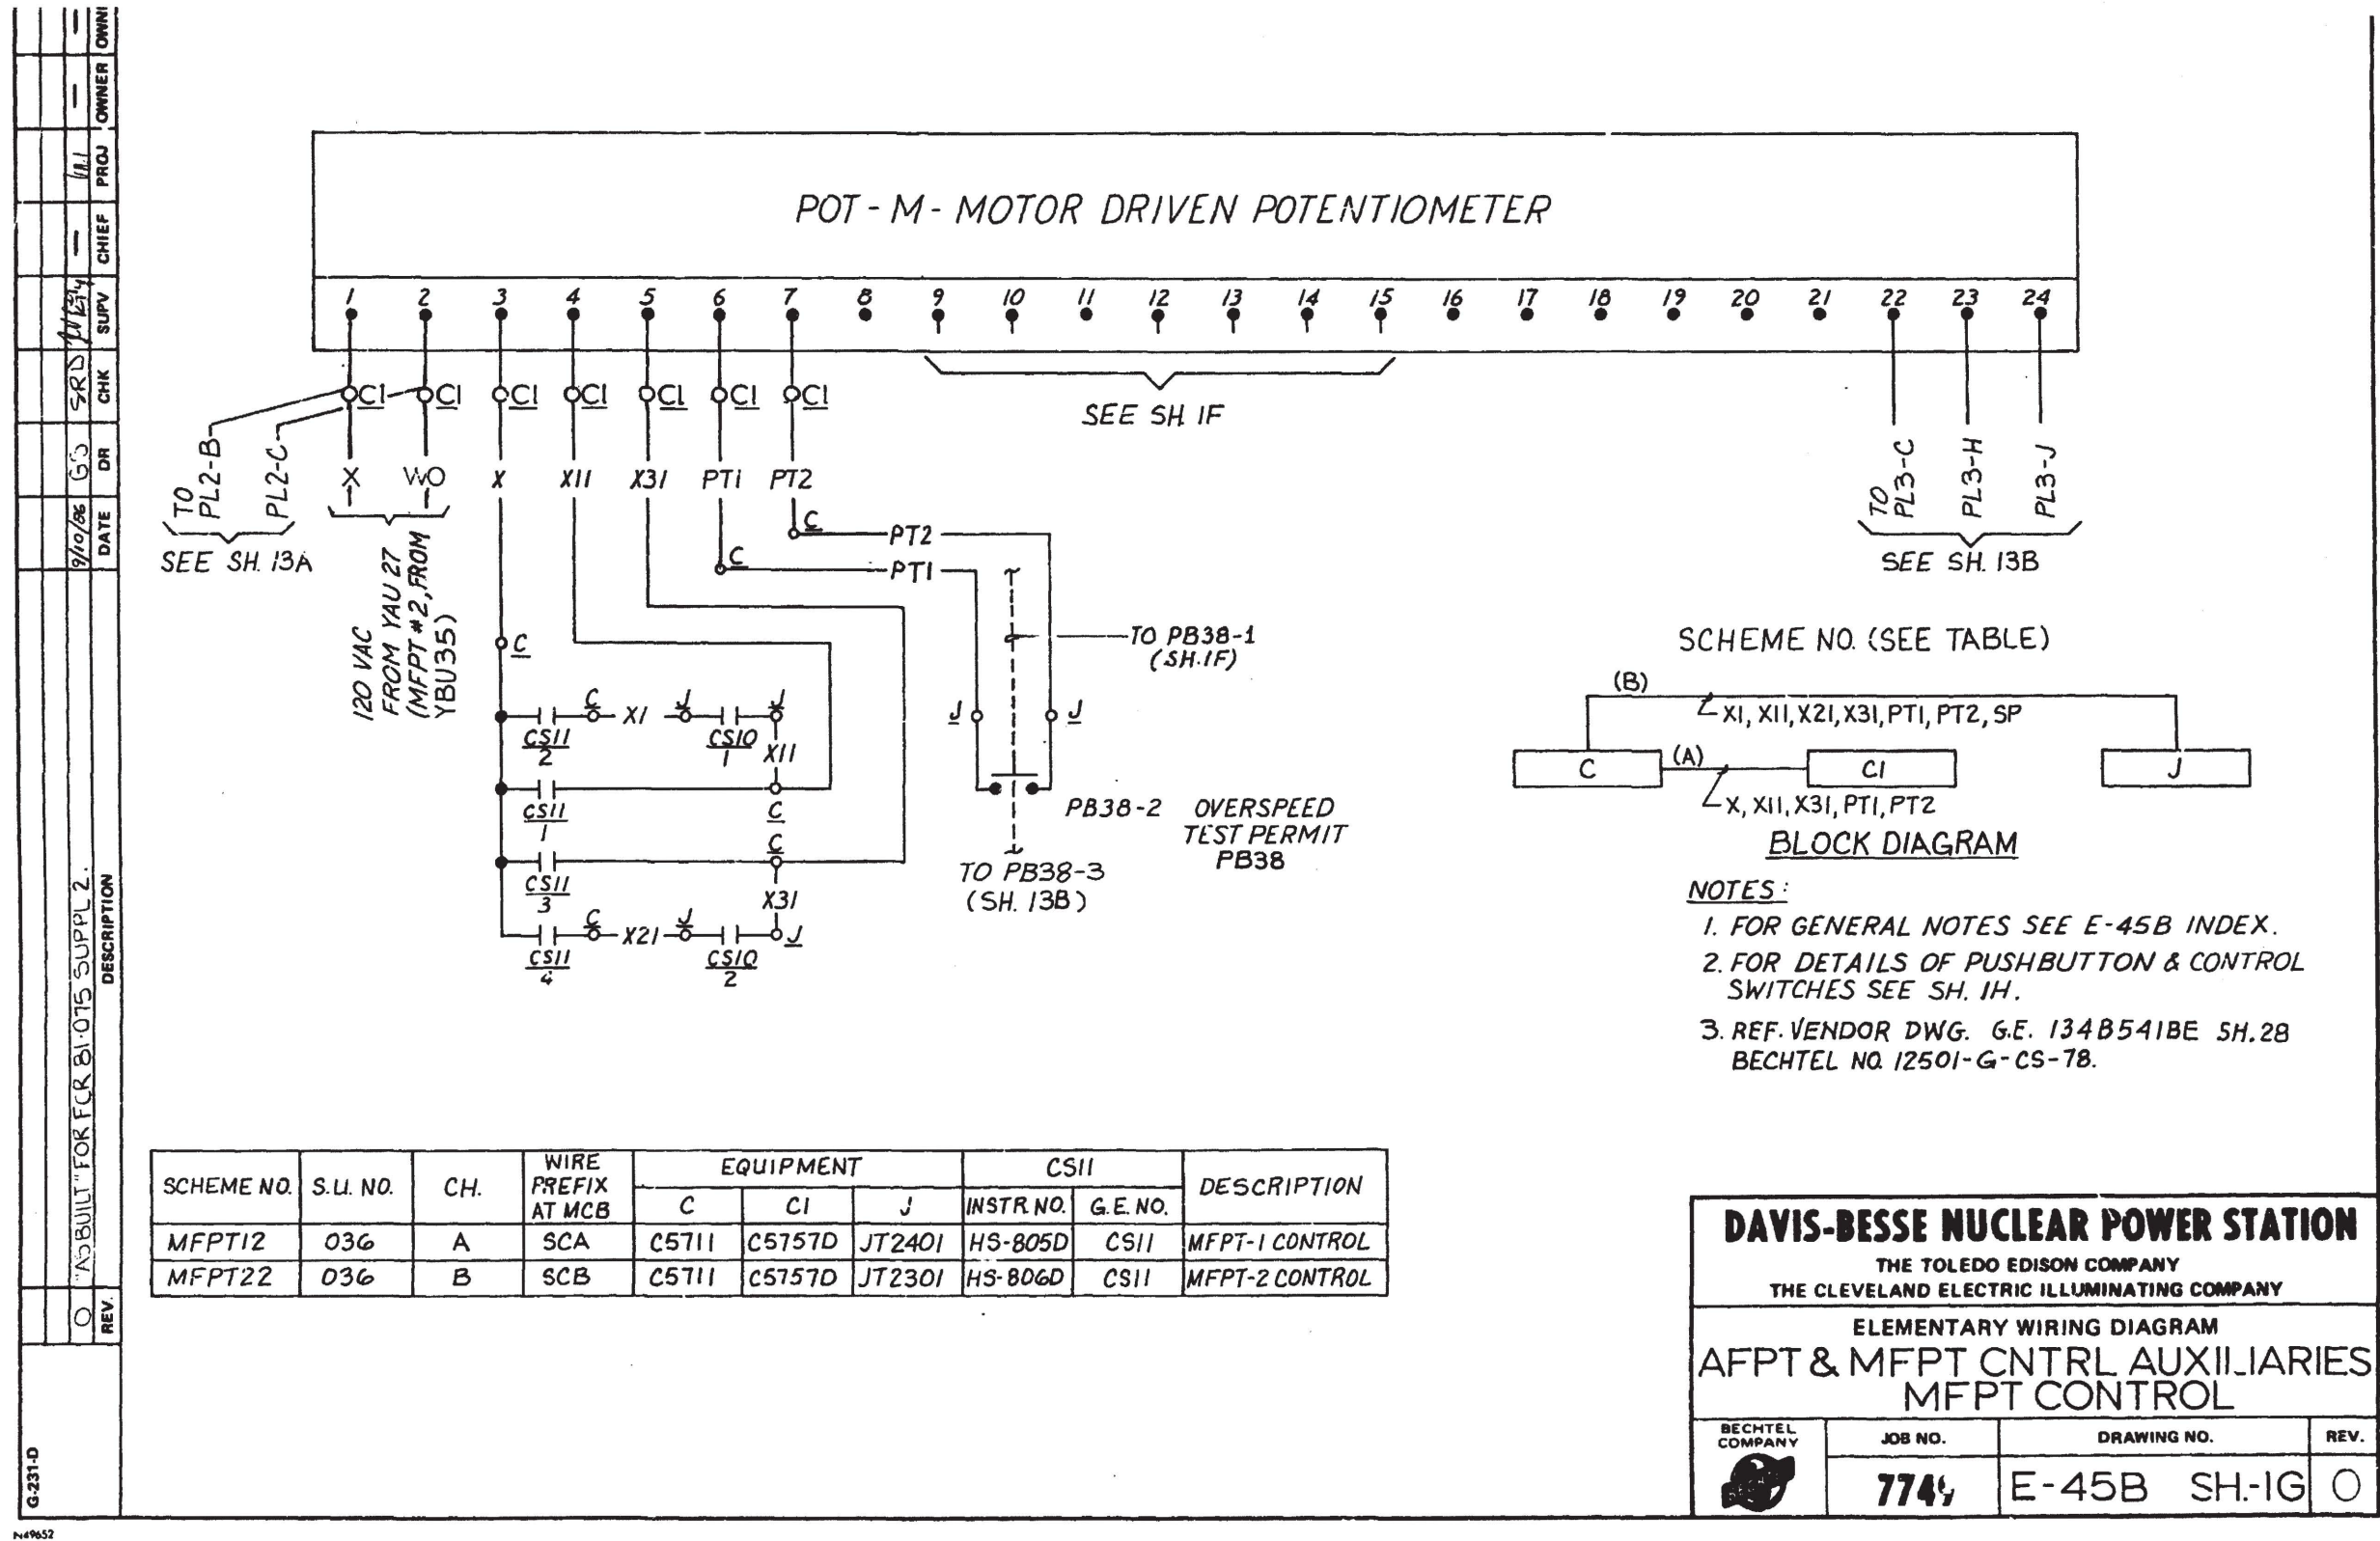

I certify that the image contained on this frame was made in the normal and regular course of business, on the date stated below and that it is an accurate reproduction of the document(s) submitted to Micrographics.
DATE 9/12/86 OPERATOR B. J. Butler

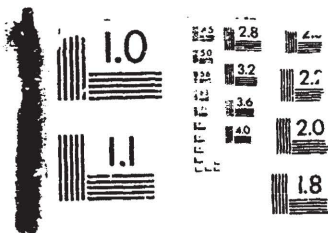

1	INC. DCN E-45B-200 PER ECR 04-0339-00 (CR 02-09678)	DATE	DR	CHK	SUPV	CHIEF	PROJ	OWNER
2	INC. DCN E-45B-183, FOR SEC/RFA 89-0023	9/15/88	JDA	SBW	TRG	---	---	---
3	Q. "ASBUILT" FOR ECR 81-075 SUPPL. 2.	9/10/88	GFB	---	---	---	---	---
REV.	DESCRIPTION							
G-231-D								


TRANSFER SW. CSII
(LOCATED ON CONTROL PANEL C5711)

HS-805D (HS-806D)

CONTACTS (HANDLE END)		CONTACT	POSITION	
ODD	EVEN		INCREASE	DECREASE
1	2	1	X	
3	4	2		X
		3		
		4	X	

X DENOTES CONTACT CLOSED.
SPRING RETURN TO 12 O'CLOCK
POSITION.

CSII (CSIQ)

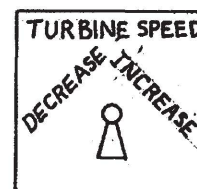

GE CO. TYPE SBM, CAM-OPERATED,
3 POSITION, SPRING RETURN
WITH PISTOL GRIP HANDLE.

ICS
(MAN)

CSIO (TURBINE MOUNTED)

CONTACTS (HANDLE END)		CONTACT	POSITION	
ODD	EVEN		INCREASE	DECREASE
1	2	1	X	
		2		X
		3		
		4	X	

X DENOTES CONTACT CLOSED.
SPRING RETURN TO 12 O'CLOCK
POSITION.

HIS/A PB. HIS-805C1 (HIS-806C1)
HIS/B PB. HIS-805C2 (HIS-806C2)
(LOC. AT PANEL C5711)

CONTACTS	FREE	DEPRESSED
5-06	X	
6-07		X
14-015	X	
15-016		X


MOMENTARY CONTACT
STACO SWITCH-LIGHTED
DISPLAY PUSHBUTTON, SERIES 40

OVERSPEED TEST
PERMIT PUSHBUTTON (BY GE, TURBINE MOUNTED)

PB38

BLOCK	CONTACTS	NORMAL	TEST
1	0-1-0	X	
	0-1-0		X
2	0-1-0	X	
	0-1-0		X
3	0-1-0	X	
	0-1-0		X
4	0-1-0	X	
	0-1-0		X

MOMENTARY CONTACT PUSHBUTTON
GE TYPE CR2940 FORM UA200C
WITH TANDEM BLOCK (U207).
X DENOTES CONTACT CLOSED.

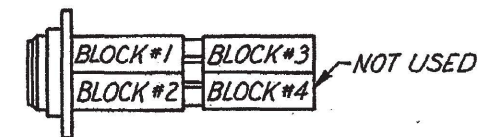

PB38 BLOCK ARRANGMENT

NOTE:

1. FOR GENERAL NOTES SEE E-45B INDEX

CONTACTS		POSITION	
1	2	3	4
1-01	2-02	3-03	4-04
X			X
	X		
		X	
			X

MOMENTARY CONTACT PUSHBUTTON
GE TYPE CR2940 FORM US203A



CS/R - HS 799 (HS 800)
LOC. AT PANEL C5711

CONTACTS	NORMAL	RESET AUTO
1-01	X	
2-02		X
3-03	X	
4-04		X
5-05	X	
6-06		X

MOMENTARY CONTACT PUSHBUTTON
GE TYPE CR2940 FORM WA203E

DAVIS-BESSE NUCLEAR POWER STATION

THE TOLEDO EDISON COMPANY
THE CLEVELAND ELECTRIC ILLUMINATING COMPANY


ELEMENTARY WIRING DIAGRAM
AFPT & MFPT CNTRL AUXILIARIES
MFPT CONTROL



JOB NO.
7749


DRAWING NO.
E-45B SH-IH

REV.
2

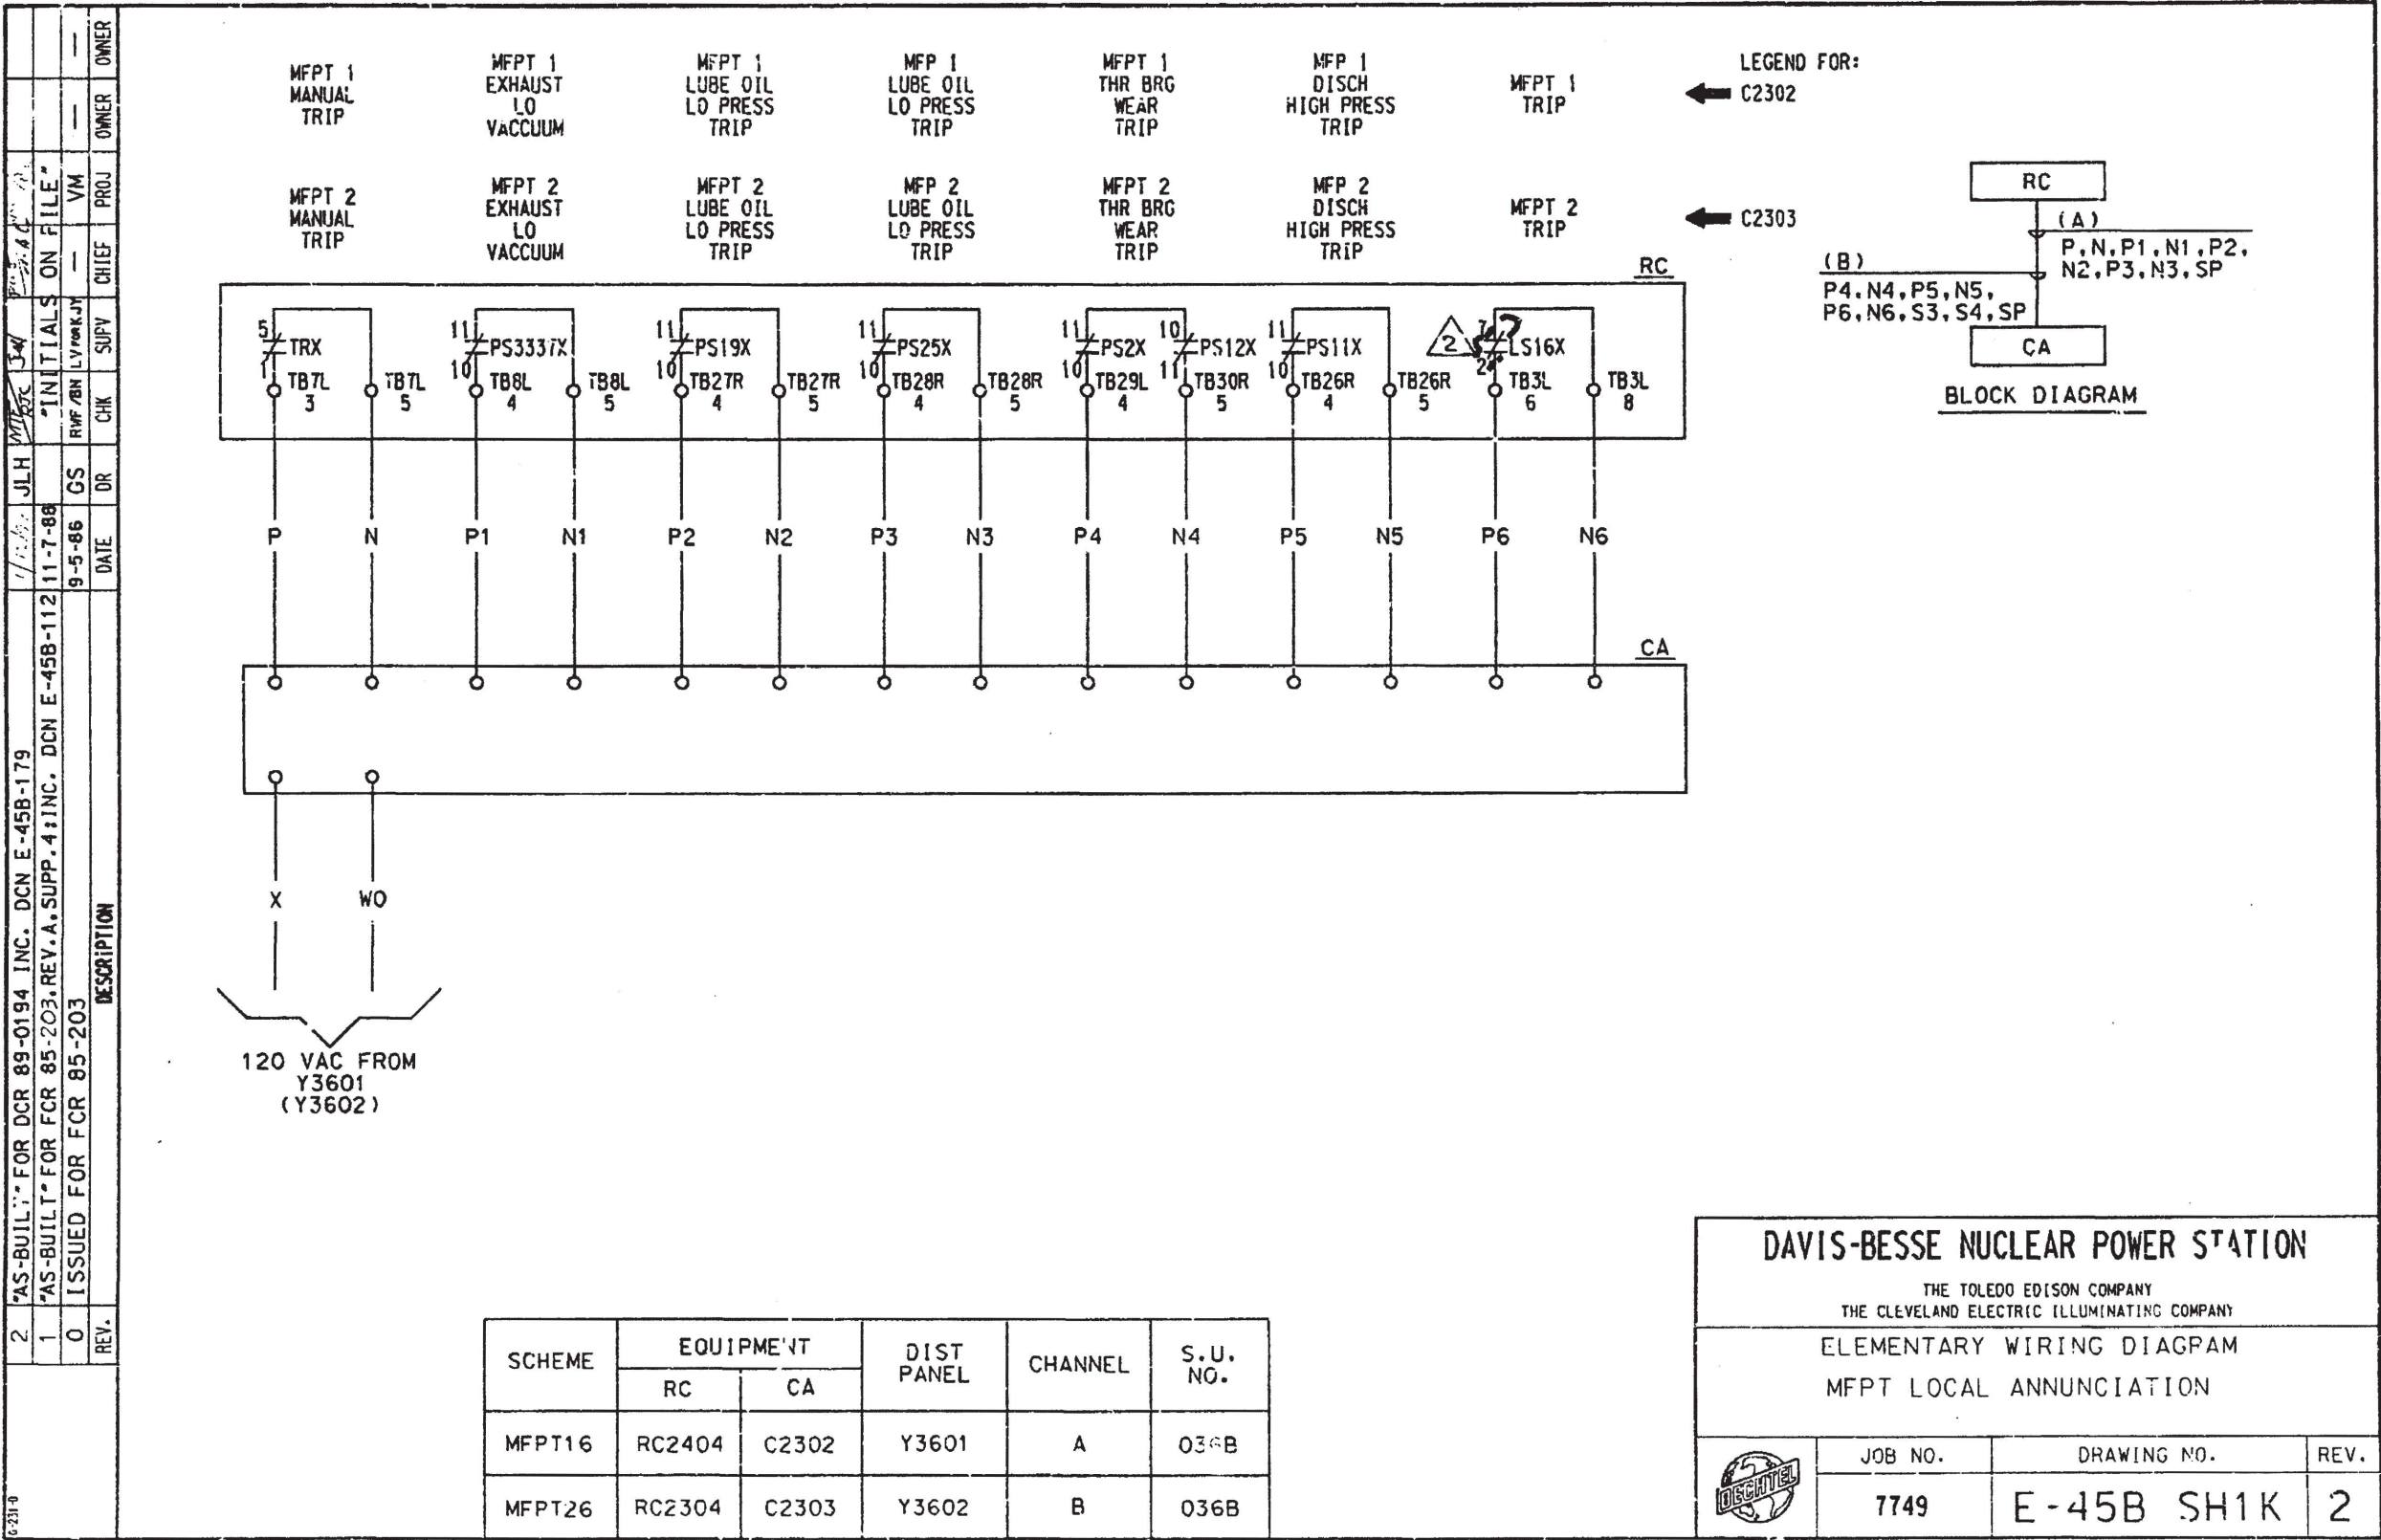

I CERTIFY THAT THE IMAGE CONTAINED ON THIS FRAME WAS MADE IN THE NORMAL AND REGULAR COURSE OF BUSINESS. ON THE DATE STATED BELOW AND THAT IT IS AN ACCURATE REPRODUCTION OF THE RECORD(S) SUBMITTED TO NUCLEAR RECORDS MANAGEMENT.


2000-08-16X

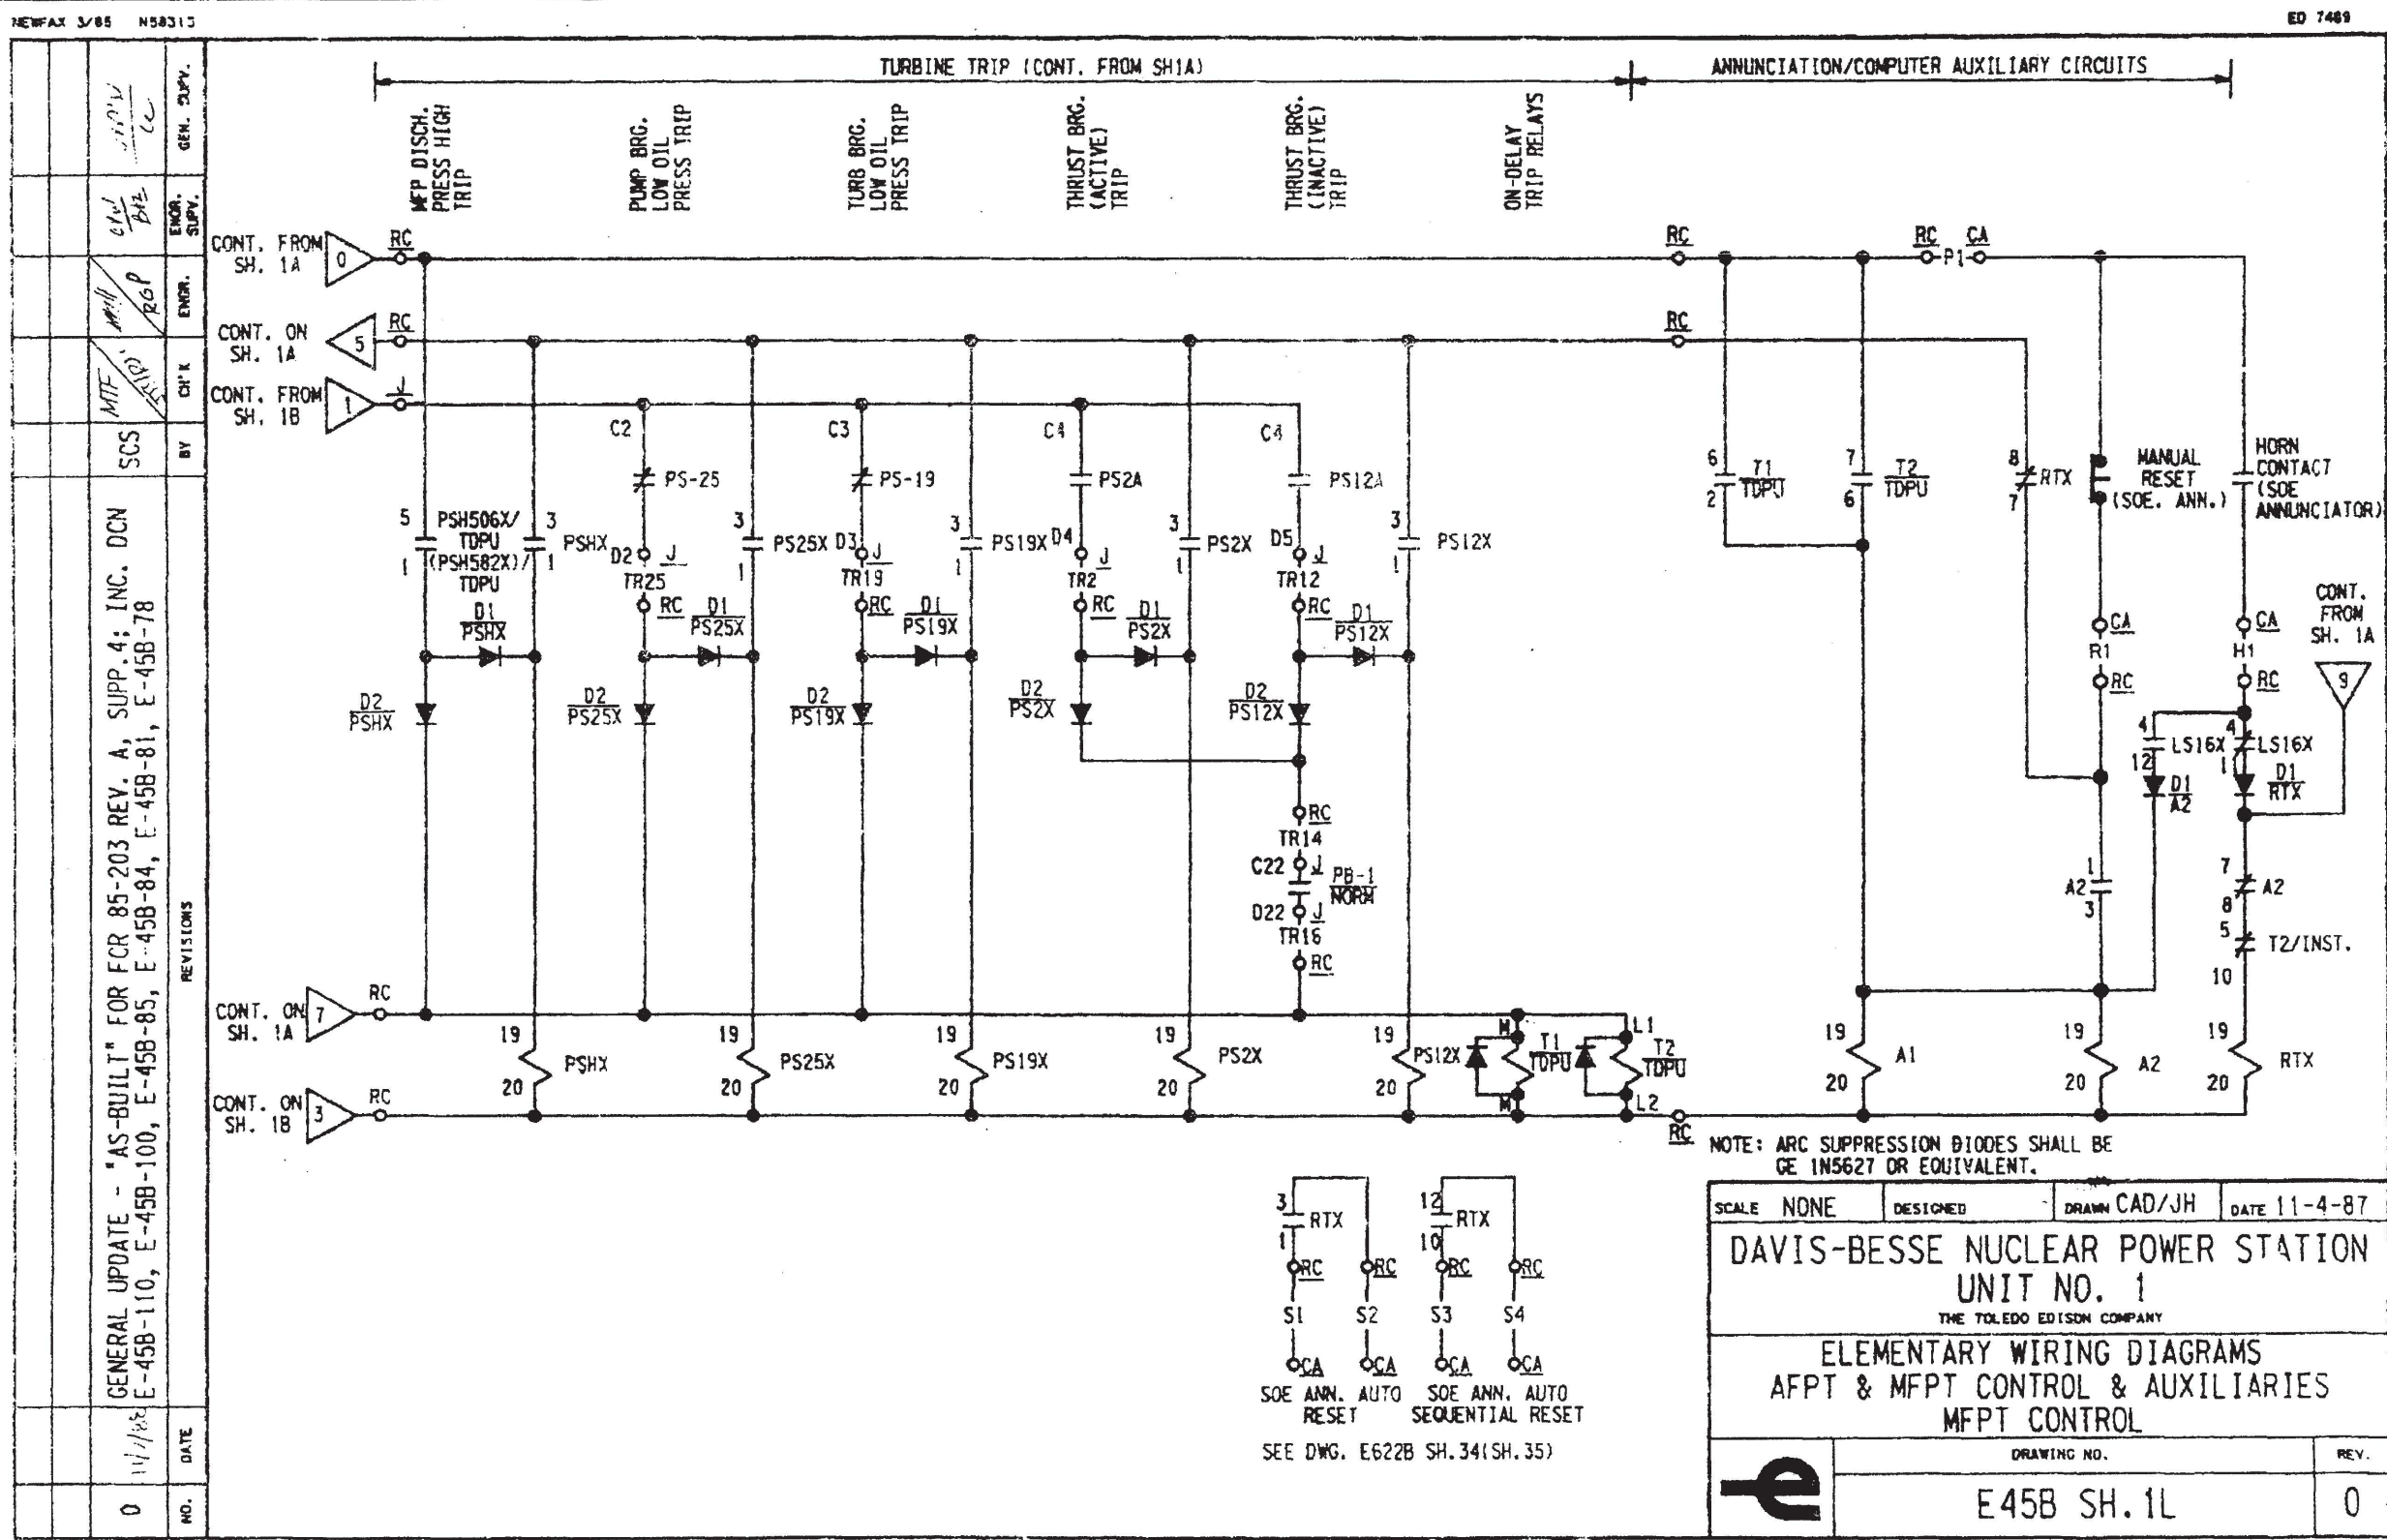


I CERTIFY THAT THE IMAGE CONTAINED ON THIS FRAME WAS MADE IN THE NORMAL AND REGULAR COURSE OF BUSINESS, ON THE DATE STATED BELOW AND THAT IT IS AN ACCURATE REPRODUCTION OF THE RECORD(S) SUBMITTED TO NUCLEAR RECORDS MANAGEMENT.

DATE 11-11-88 OPERATOR H. Weibel

16X

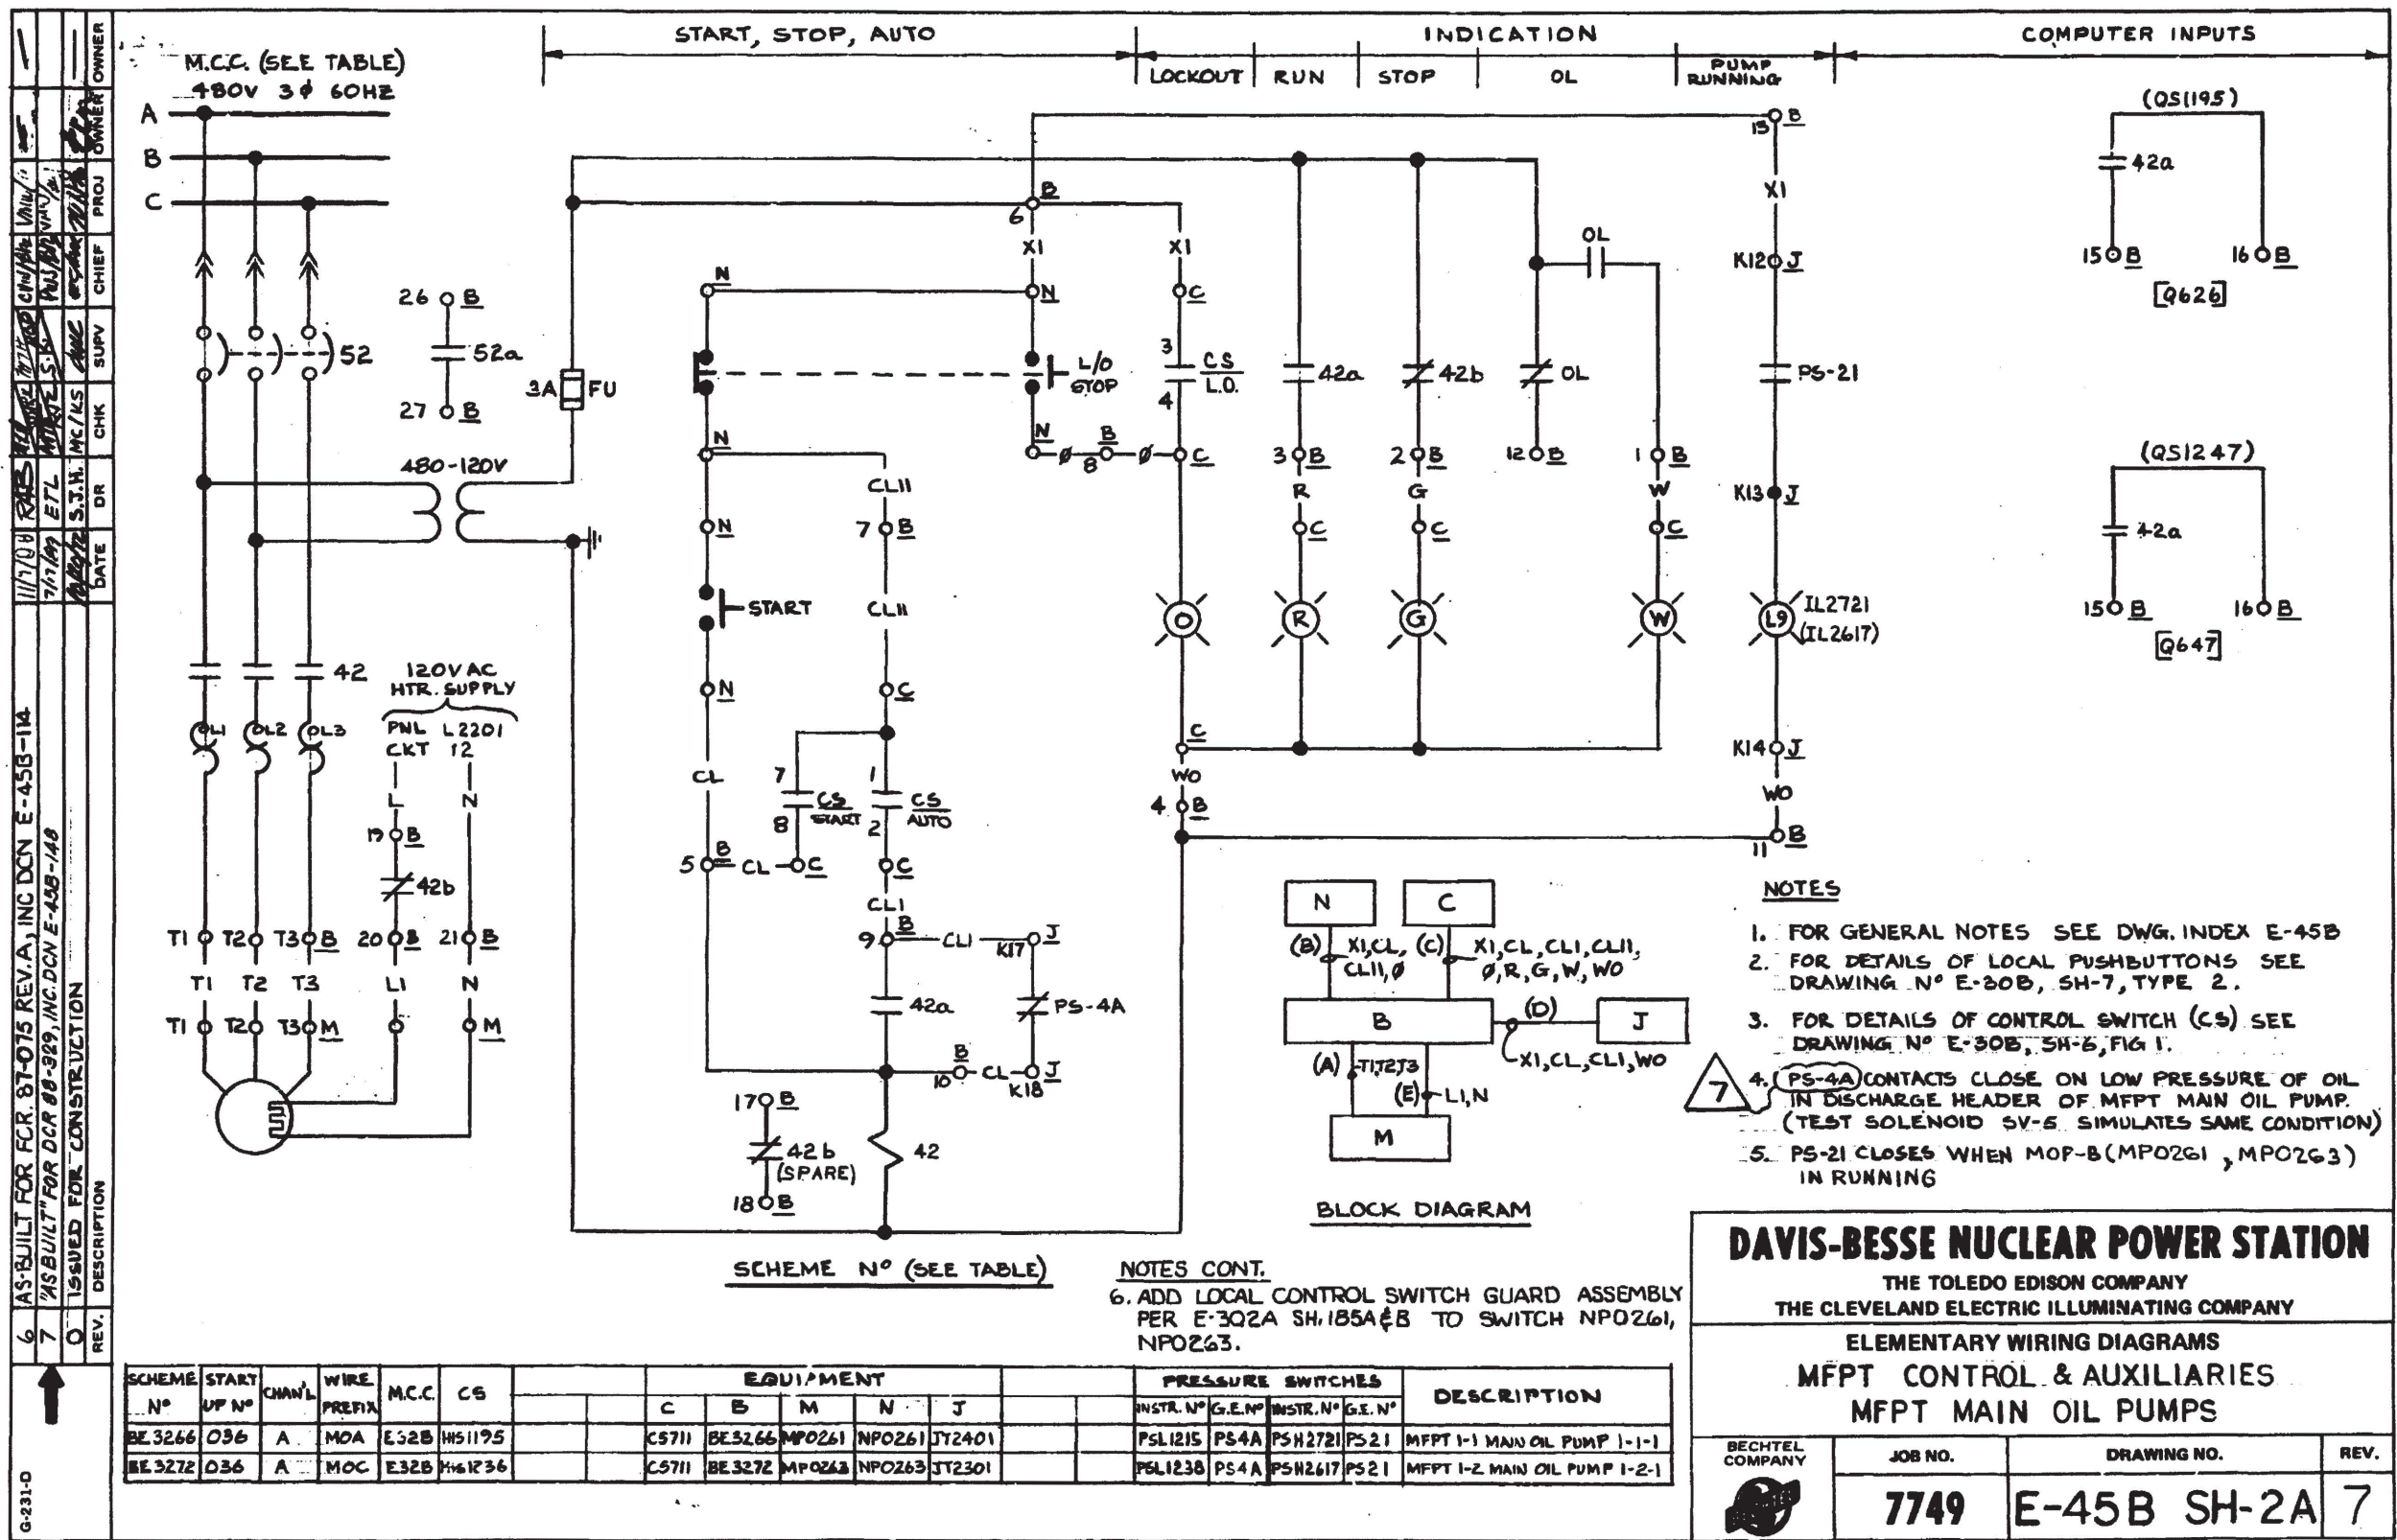

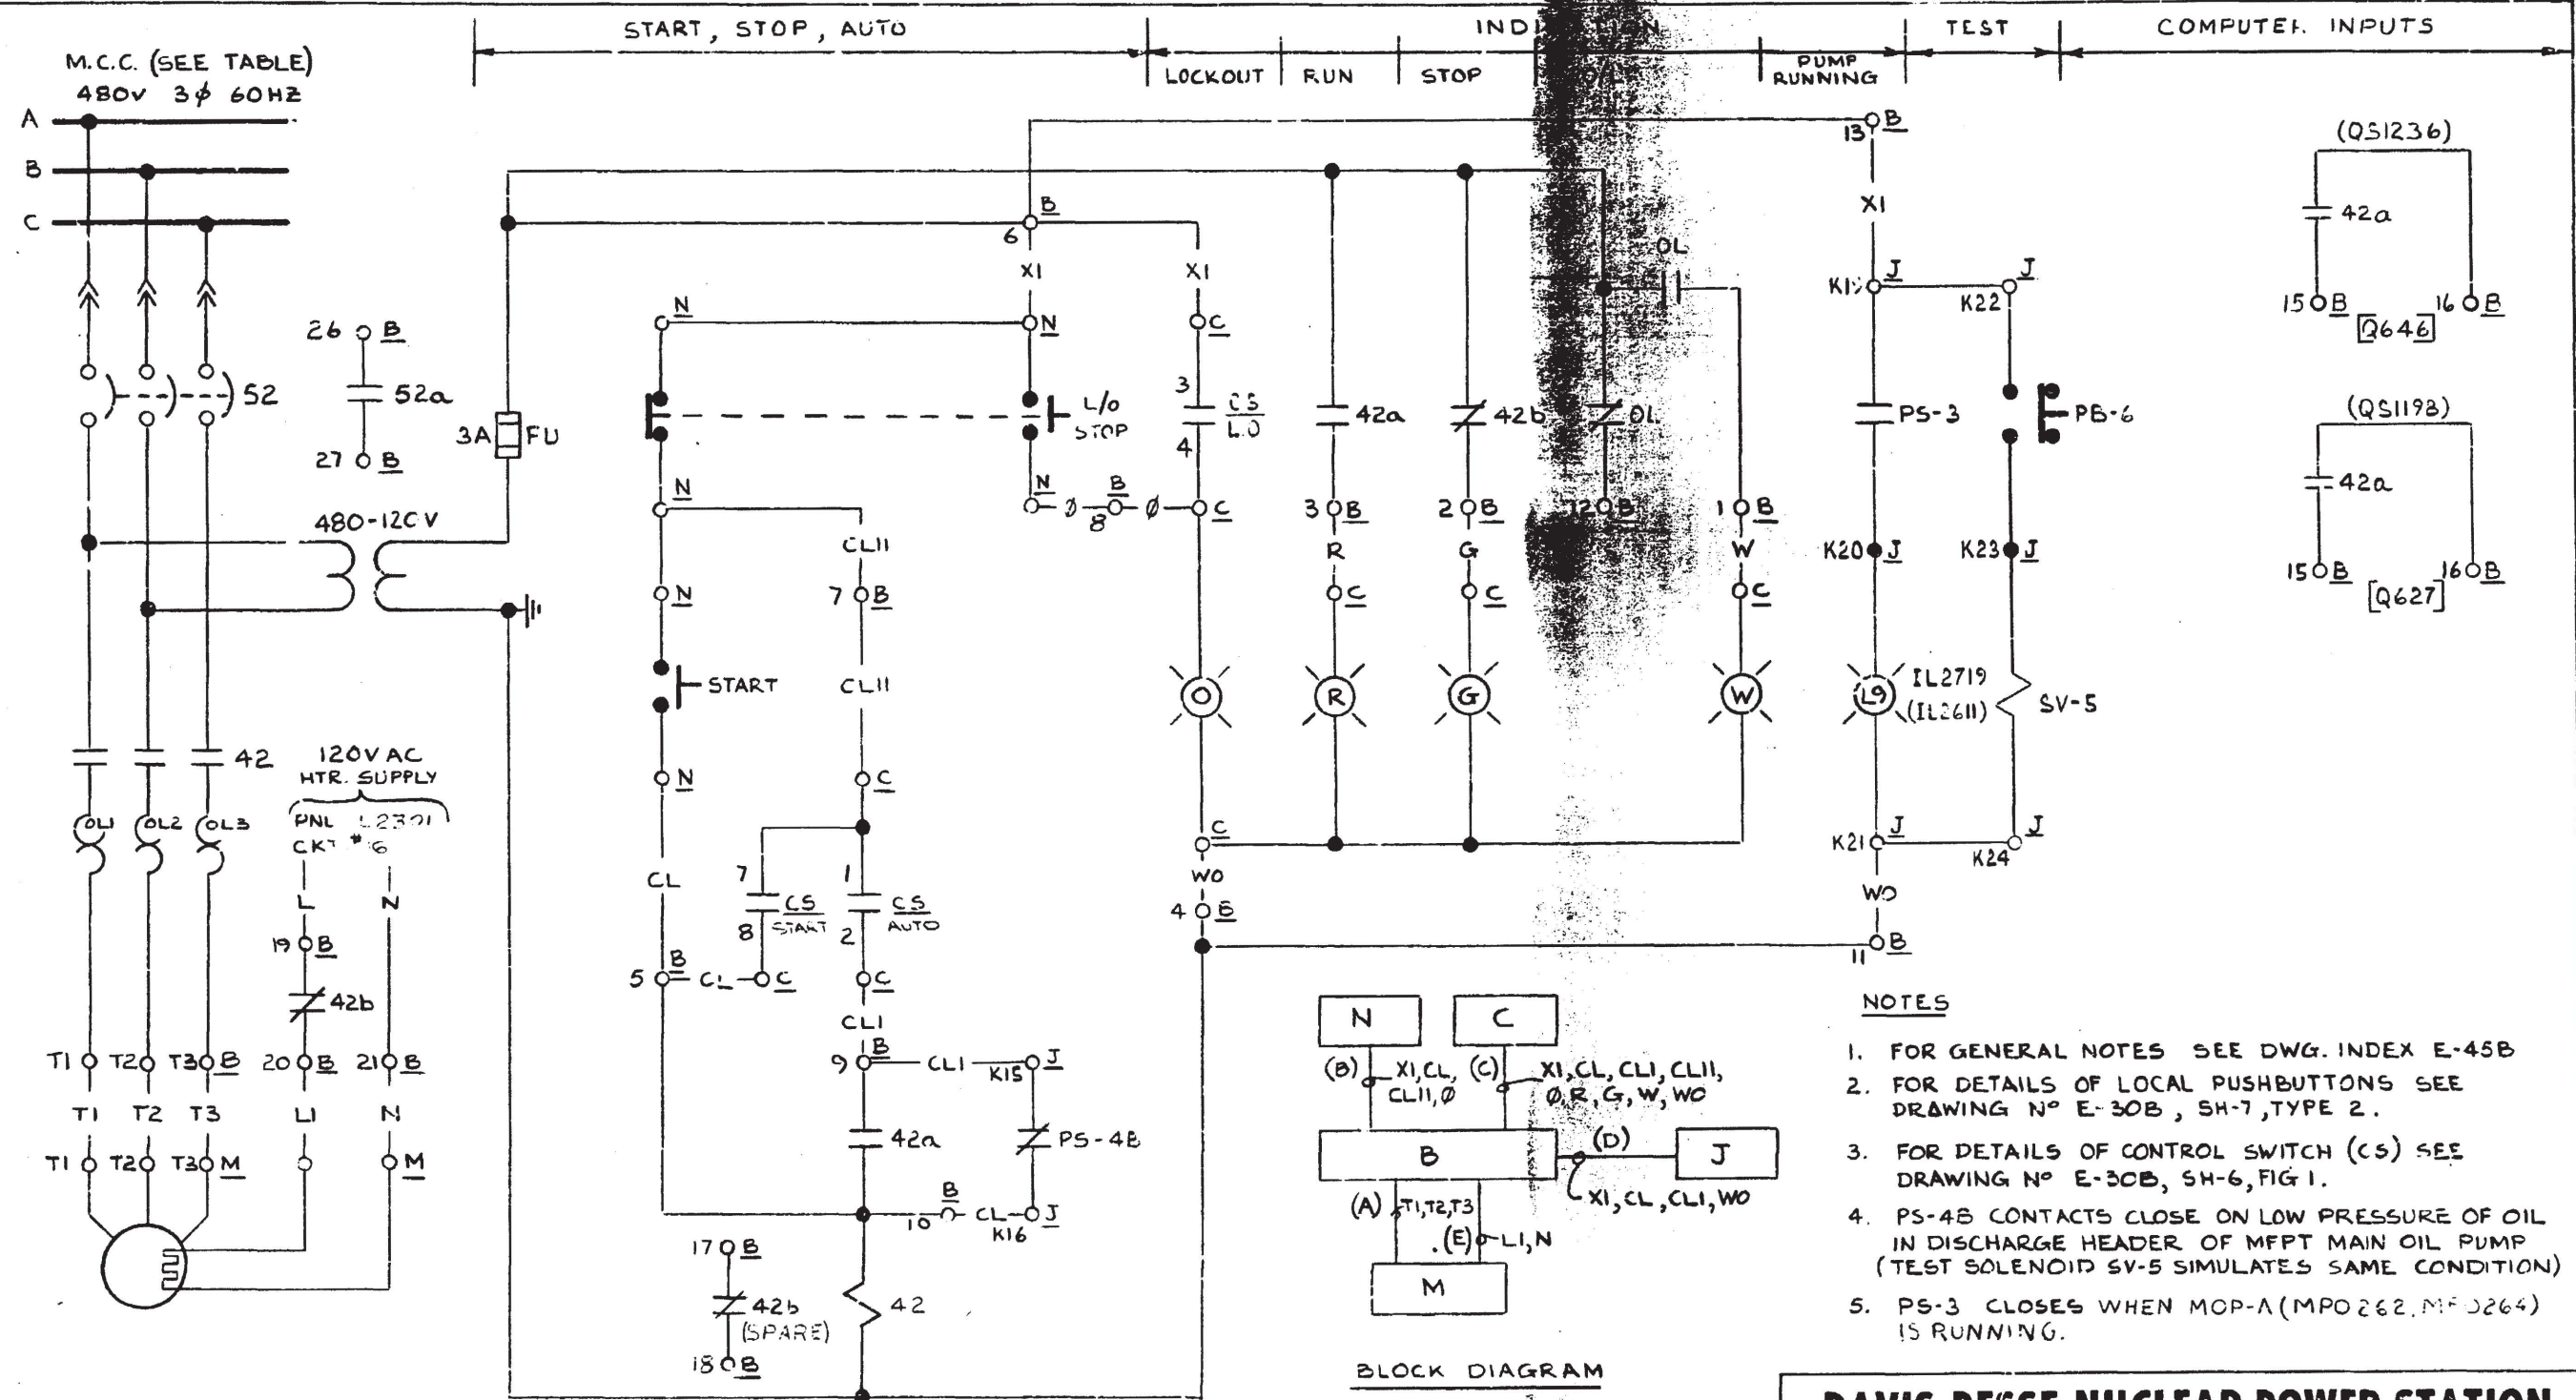

SCHEME NO (SEE TABLE)

NOTES CONT.

6. ADD LOCAL CONTROL SWITCH BOARD ASSEMBLY
PER E-302A SH.135A & B TO SWITCH NPO262, NPO264

SCHEME Nº	START UP Nº	CHAN'L	WIRE PREFIX	M.C.C	C.S	EQUIPMENT					TEST FB		TEST SOLENOID		PRESSURE SWITCHES				DESCRIPTION	
						C	B	M	N	J	INSTR. Nº	G.E. Nº	INSTR. Nº	G.E. Nº	INSTR. Nº	G.E. Nº	INSTR. Nº	G.E. Nº		
BF3266	036	B	MCB	F32B	HIS1198	C5711	BF3266	MP0262	NP0262	JT2401	HIS1199	PE1	SV1129	SV5	FSH270	PS3	PS4	PS5	PS4E	MFFT 1-1 MAIN OIL PUMP 1-1
BF3272	036	B	MOD	F32B	HIS1247	C5711	BF3272	MP0264	NP0264	JT2301	HIS1237	PE1	SV1237	SV5	FSH237	PS3	PS4	PS5	PS4E	MFFT 1-2 MAIN OIL PUMP 1-2

DAVIS-BESSE NUCLEAR POWER STATION

THE TOLEDO EDISON COMPANY
THE CLEVELAND ELECTRIC ILLUMINATING COMPANY

ELEMENTARY WIRING DIAGRAMS
MFPT CONTROL & AUXILIARIES
MFPT MAIN OIL PUMPS

BECHTEL
COMPANY


NO RQ

DRAWING NO.

REV.

7749

E-45B SH-2B 10

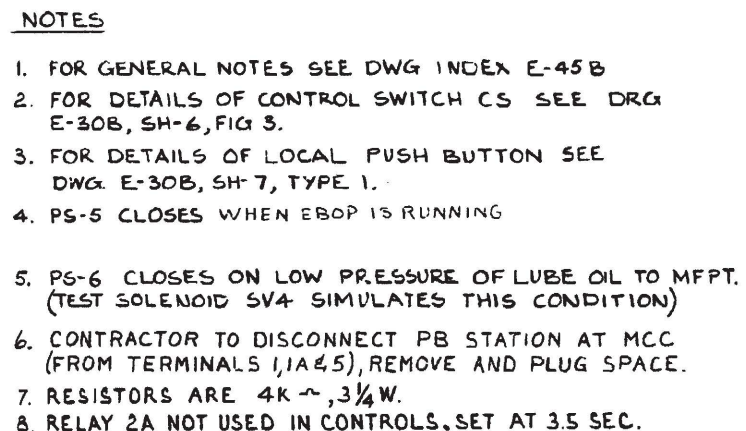

SCHEME N°	START UP N°	CHANNEL	WIRE PREFIX	MCC	CS	EQUIPMENT					PRESSURE SWITCHES				TEST SV		DESCRIPTION
						C	D	M	N	J	INSTR N°	GEN N°	INSTR N°	GEN N°	INSTR N°	GEN N°	
D115	036	A	EA	D1	HIS1209	CS711	D:15	MP0281	NP0281	JT2401	PSL12 2	PS 6	PSH2723	PS 5	SV1210	SV 4	MFPT 1 EBOP
D215	036	B	EB	D2	HIS1188	CS711	D215	MP0282	NP0282	JT2301	PSL1233	PS 6	PSH2607	PS 5	SV1231	SV 4	MFPT 2 EBOP

THE TOLEDO EDISON COMPANY
THE CLEVELAND ELECTRIC ILLUMINATING COMPANY

ELEMENTARY WIRING DIAGRAMS
MFPT CONTROL & AUXILIARIES
MFPT EBOP


BECHTEL COMPANY	JOB NO.	DRAWING NO.	REV.
	7749	E-45B SH-3	7


I CERTIFY THAT THE IMAGE CONTAINED 'ON THIS FRAME WAS MADE' IN THE NORMAL AND REGULAR COURSE OF BUSINESS, ON THE DATE STATED BELOW AND THAT IT IS AN ACCURATE REPRODUCTION OF THE RECORD(S) SUBMITTED TO NUCLEAR RECORDS MANAGEMENT.

DATE 10-8-92 OPERATOR DAVE H. OGDEN

DATE 10-8-92

OPERATOR

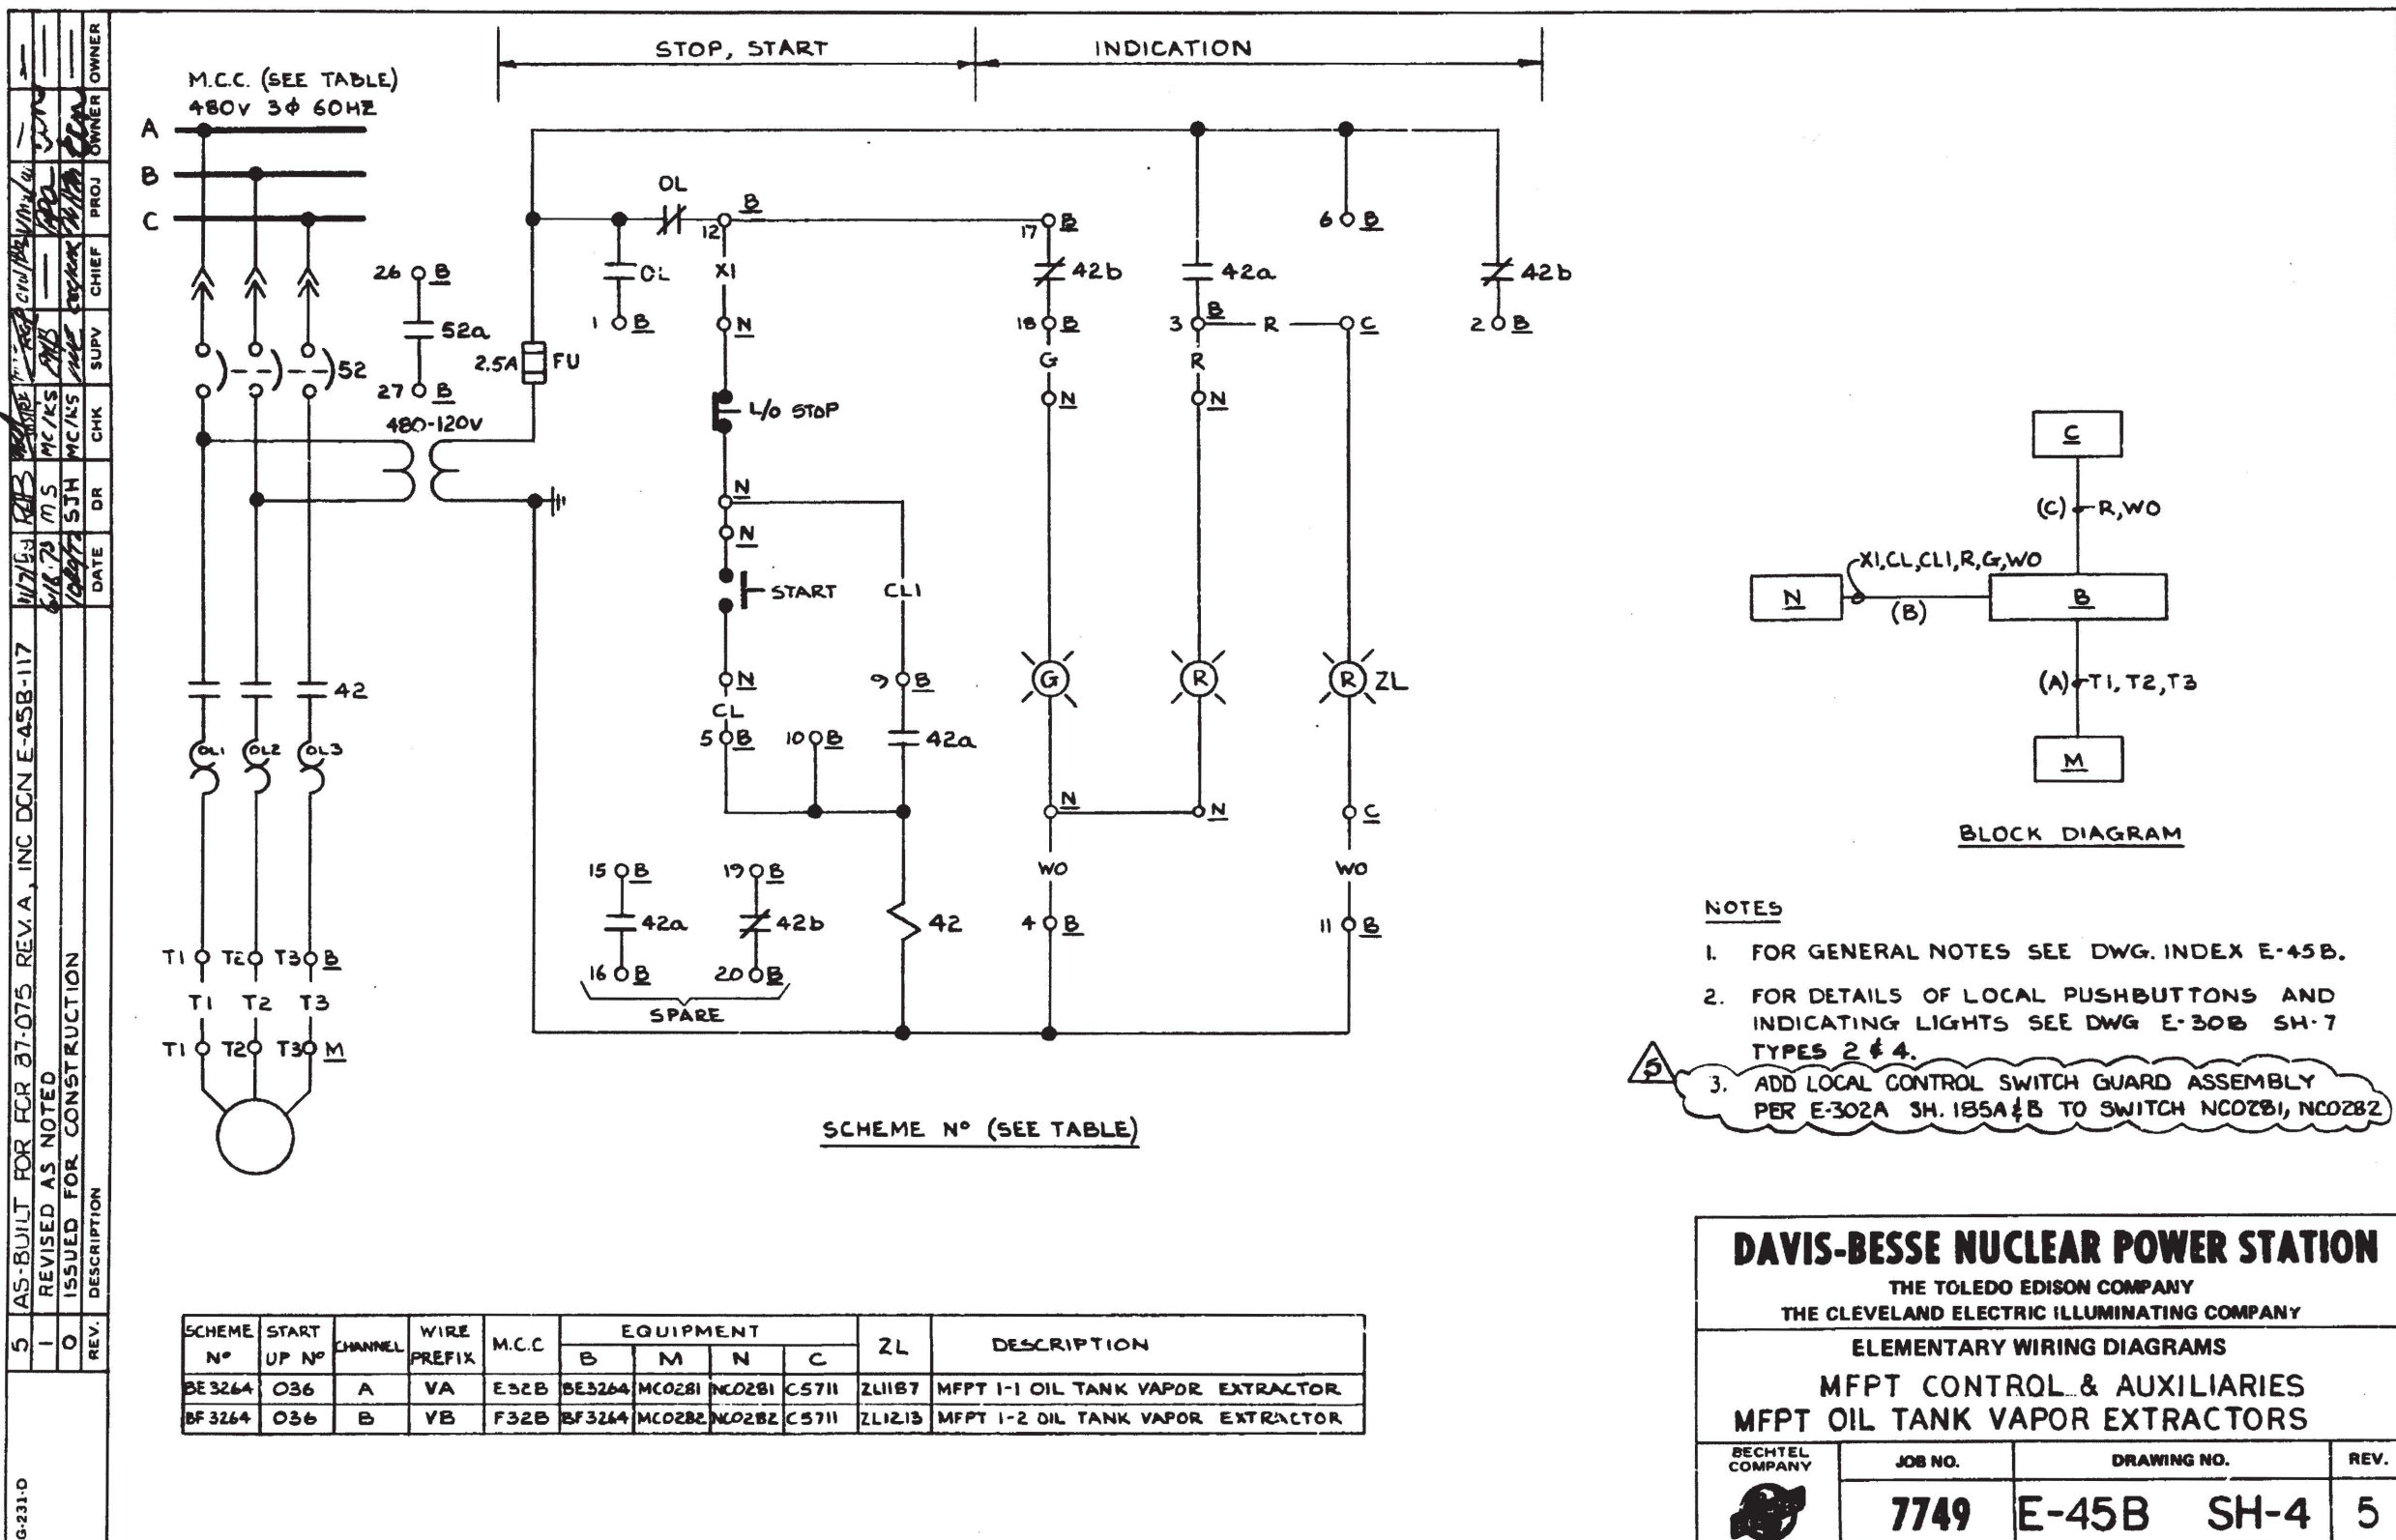

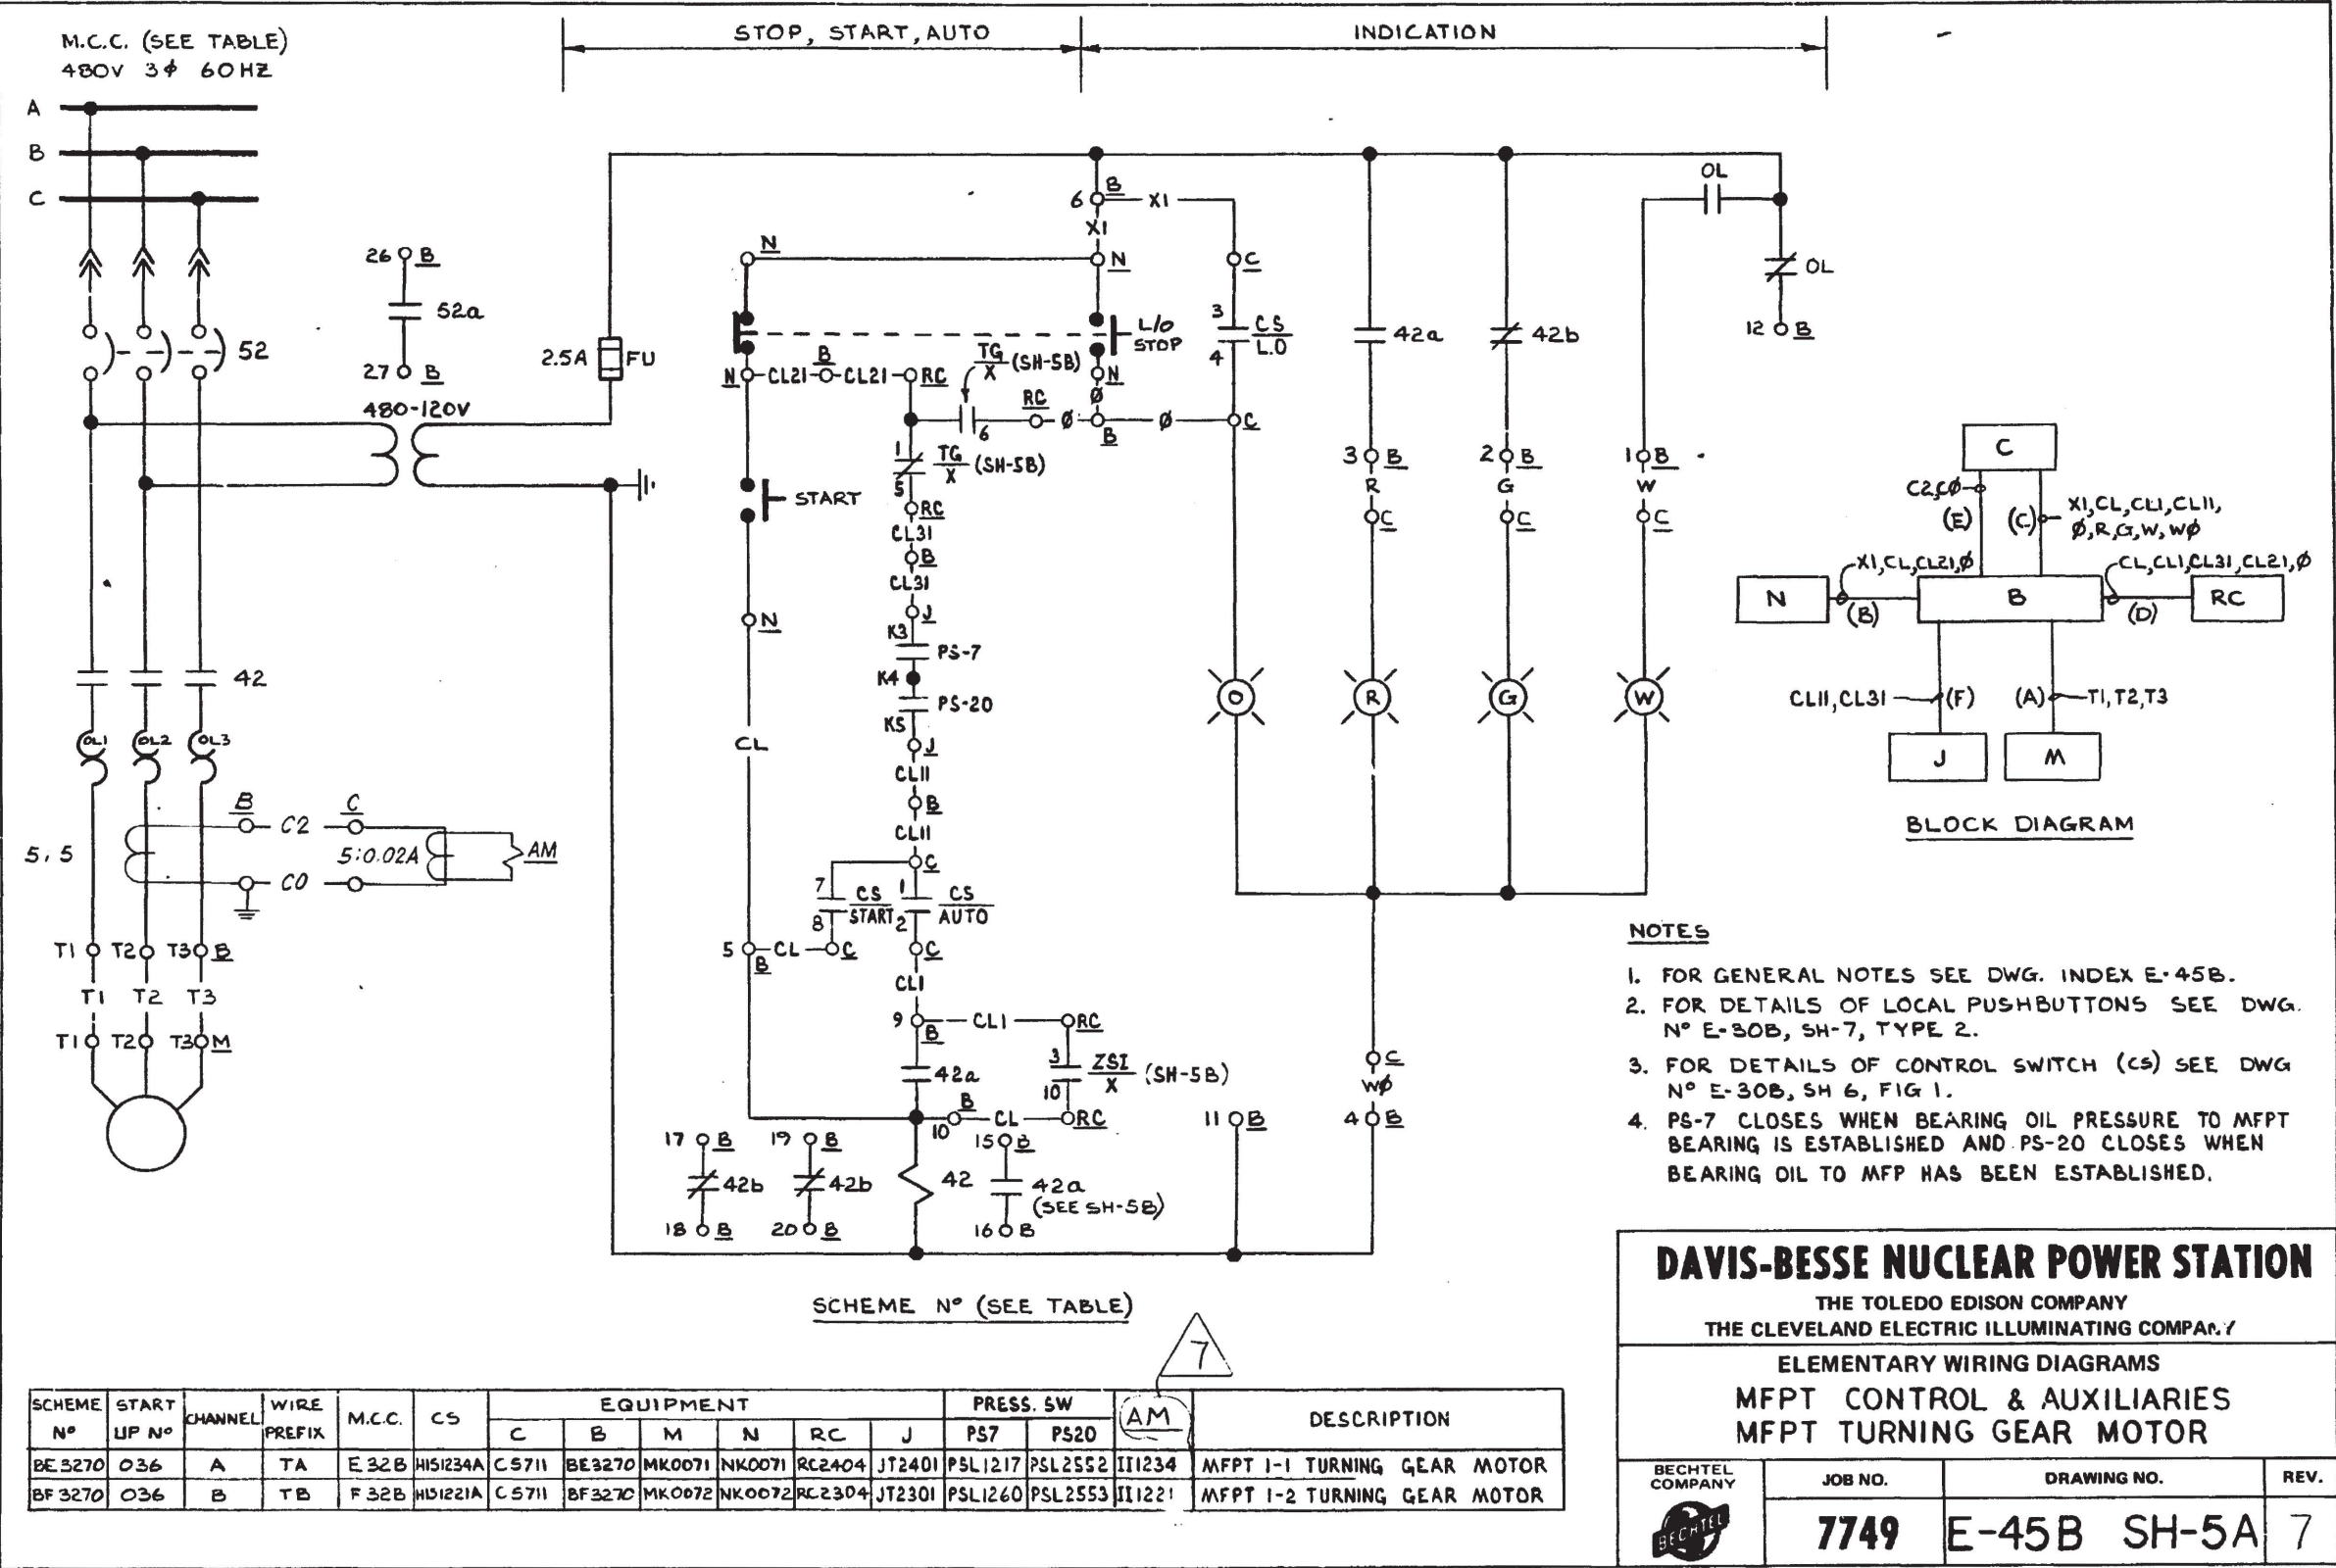


I CERTIFY THAT THE IMAGE CONTAINED ON THIS FRAME WAS MADE IN THE NORMAL AND REGULAR COURSE OF BUSINESS, ON THE DATE STATED BELOW AND THAT IT IS AN ACCURATE REPRODUCTION OF THE RECORD(S) SUBMITTED TO NUCLEAR RECORDS MANAGEMENT.



DATE 9-1-79 OPERATOR SSR

16X

DATE: 11-16-88 OPERATOR: Dorothy Wiedle

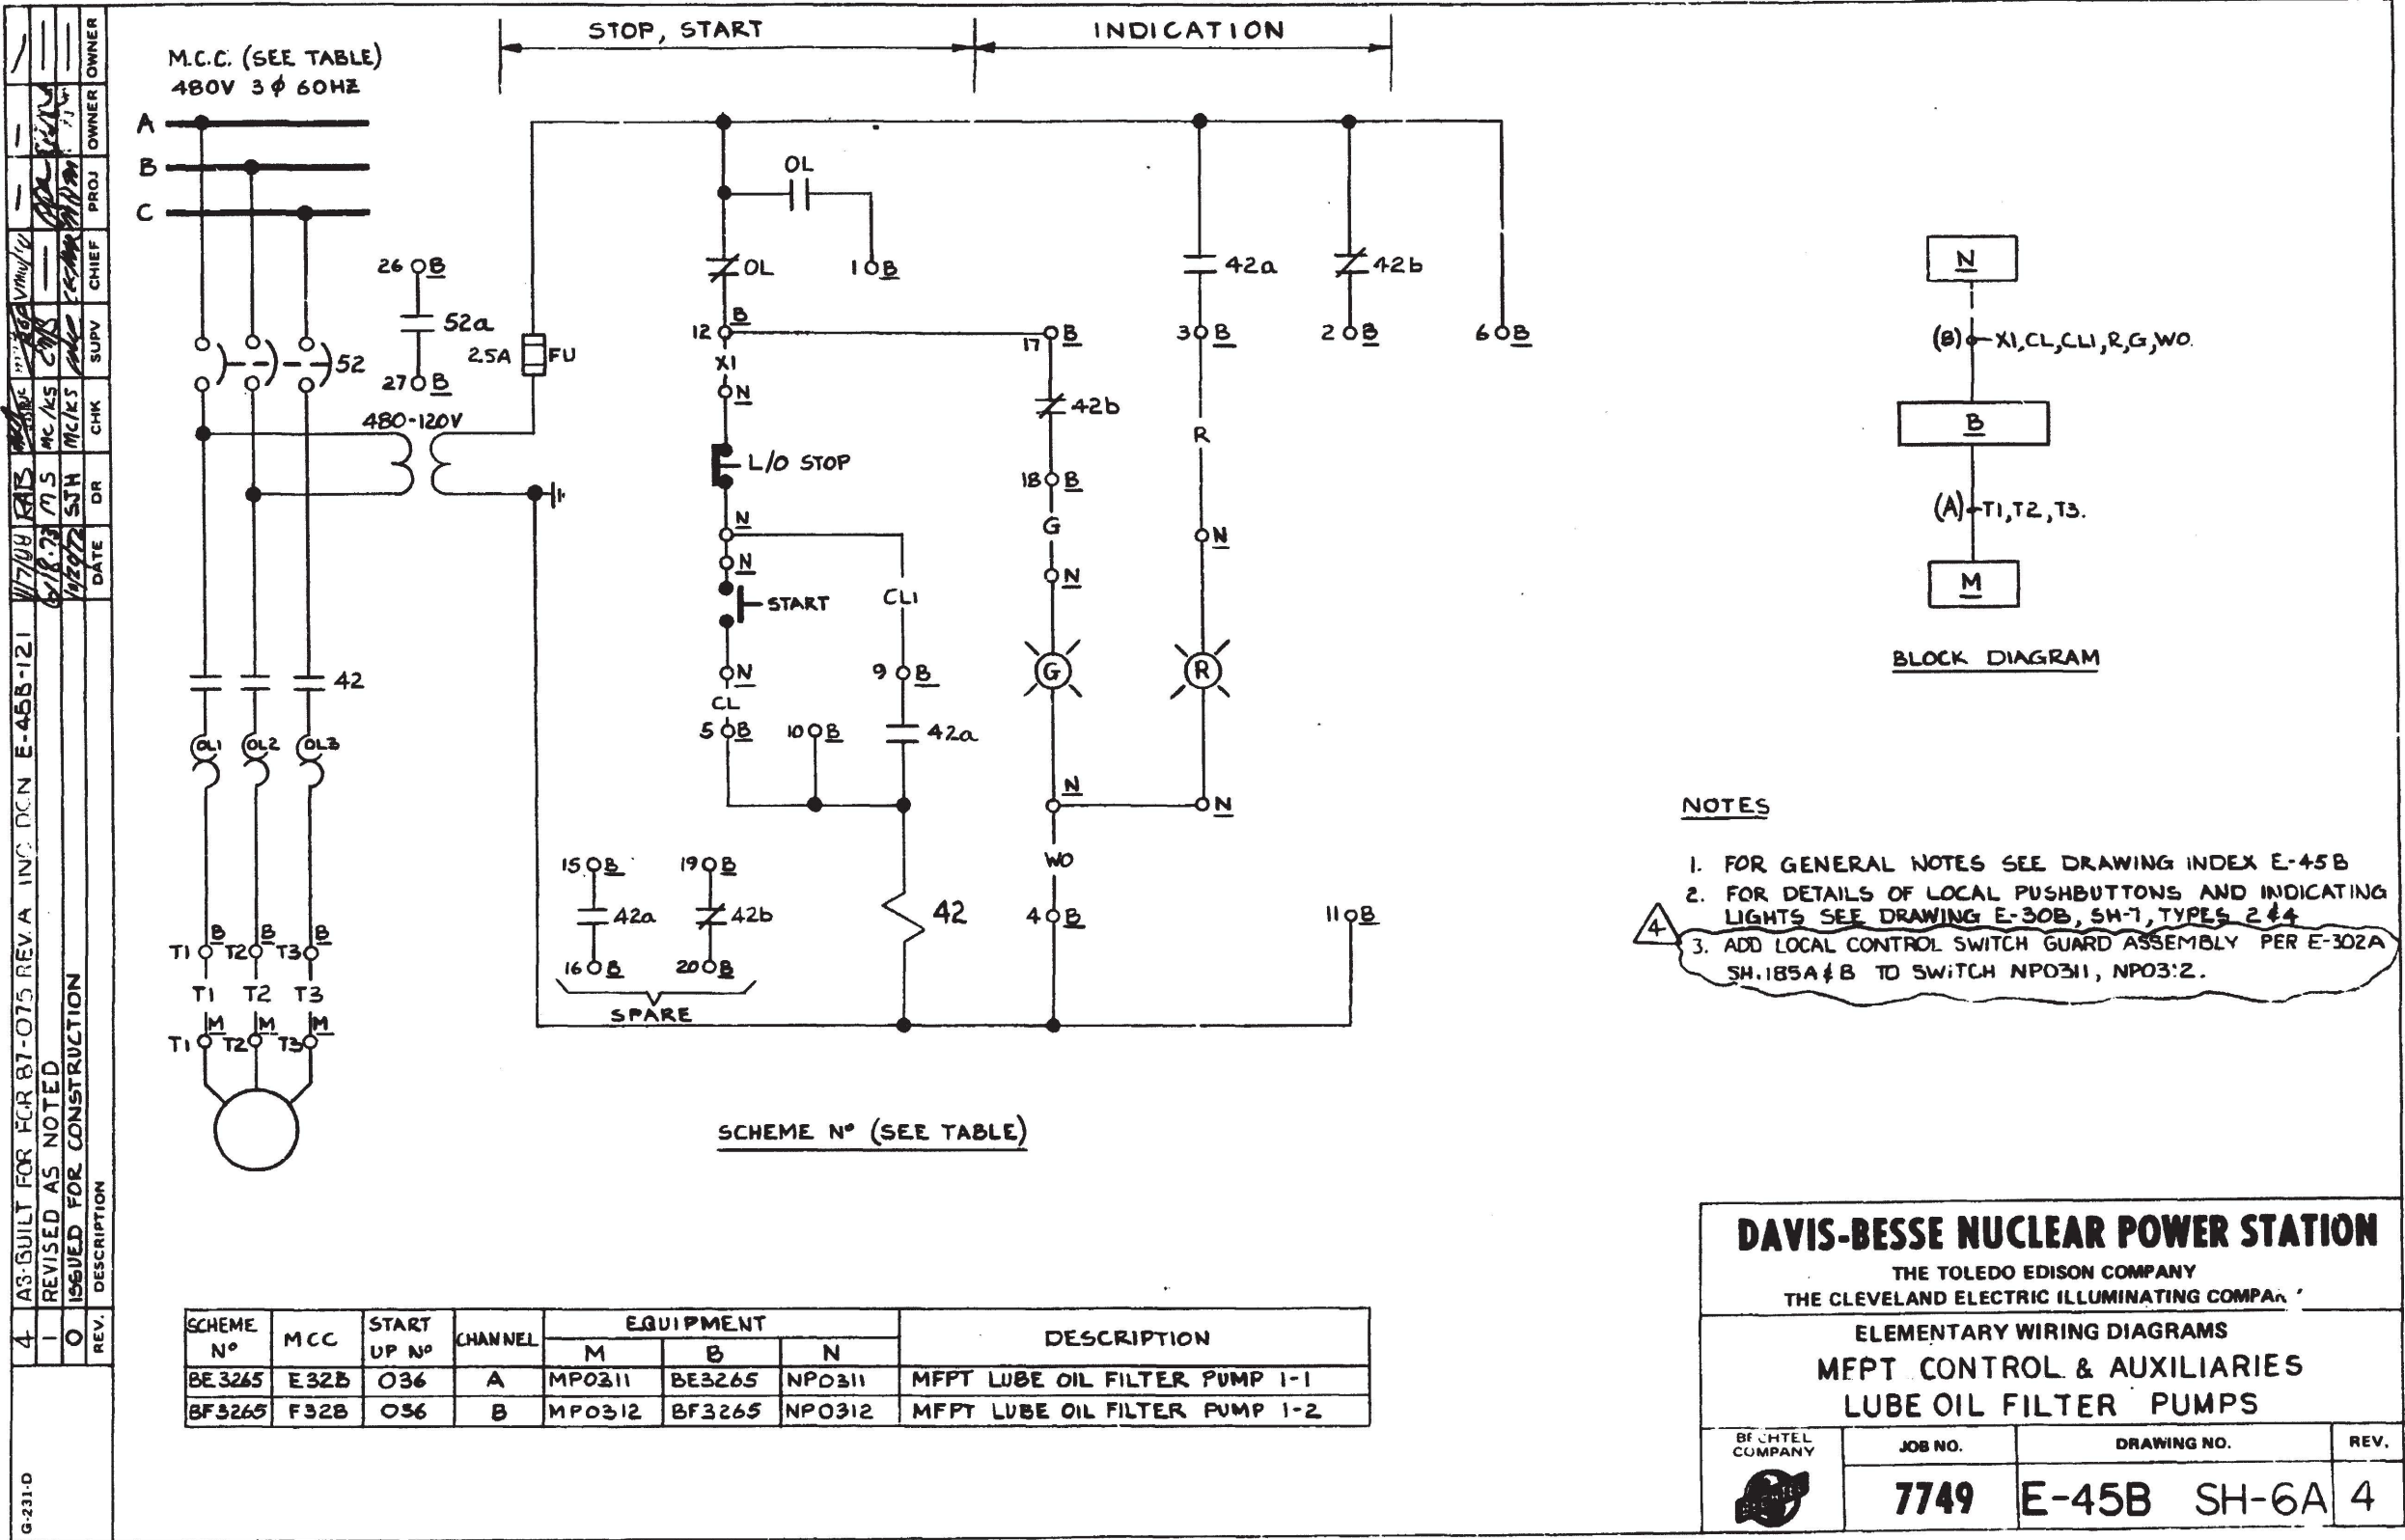

REV.	DESCRIPTION	DATE	DR	CHK	SUPV	CHIEF	PROJ.	OWNER
6	AS-BUILT FOR FCR 87075 REV.A INC. DCN E-45B-120	11/11/88						
5	INC. DCN E-45B-4, FCR 77-217, "AS-BUILT"	2/21/78	JLN	RM	SMS			
0	ISSUED FOR CONSTRUCTION	6/18/73	77.5	MC/RS	CHS			

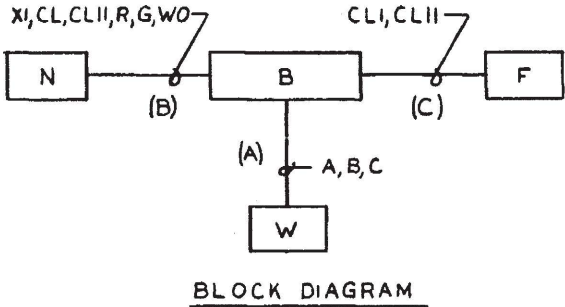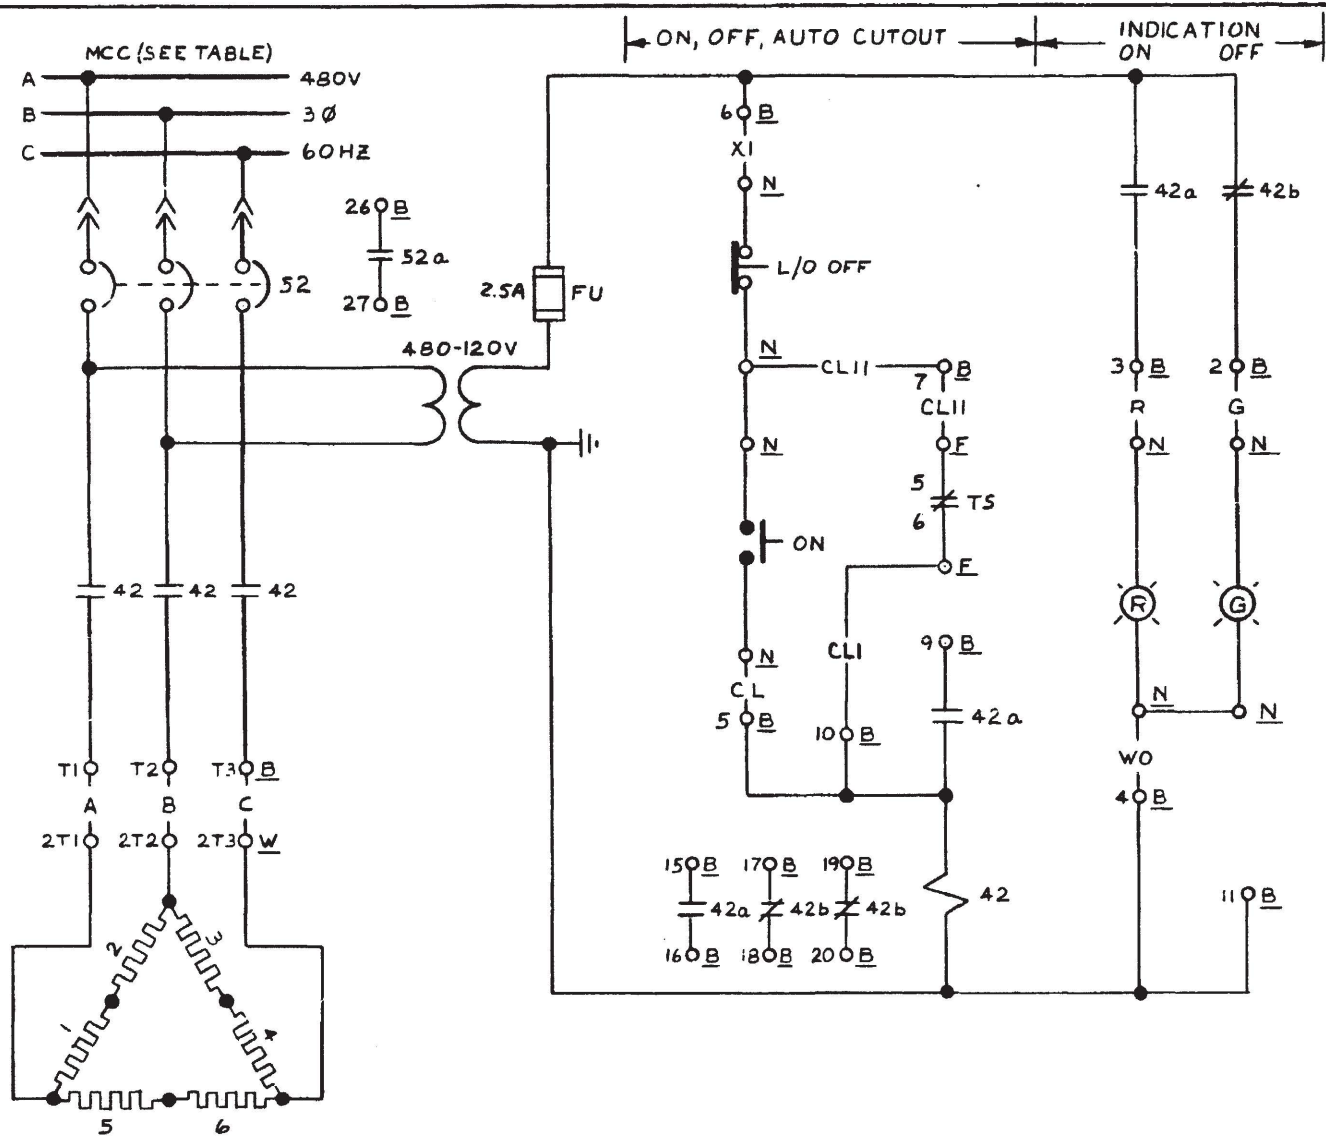

NOTES

- 1. FOR GENERAL NOTES SEE DWG. INDEX E-45B
- 2. FOR DETAILS OF LOCAL PB&INDICATING LIGHTS SEE E-30B SH.7, TYPE 2 & 4.
- 3. TS-2884 (TS2886) THERMOSTAT CUT OUT SWITCH OPENS ON HIGH TEMPERATURE.
- 4. REFERENCE DWG. FP-M-98-12 (COMMERCIAL FILTERS DWG. B 9344-0225)
- 5. ADD LOCAL CONTROL SWITCH GUARD ASSEMBLY PER E-302A SH. 1B5A & B TO SWITCH NFO371, NFO372

LEGEND

SCHEME No	MCC	START UP No	CHANNEL	EQUIPMENT				DESCRIPTION
				B	W	N	F	
BE3273	E32B	36	A	BE3273	WF0371	NFO371	FTS2884	MFPT LUBE OIL FILTER HTR 1-1
BF3137	F31A	36	B	BF3137	WF0372	NFO372	FTS2886	MFPT LUBE OIL FILTER HTR 1-2

DAVIS-BESSE NUCLEAR POWER STATION

THE TOLEDO EDISON COMPANY
THE CLEVELAND ELECTRIC ILLUMINATING COMPANY


ELEMENTARY WIRING DIAGRAMS
MFPT CONTROL & AUXILIARIES
LUBE OIL FILTER HEATERS




JOB NO.	DRAWING NO.	REV.
7749	E-45B SH-6B	6

I CERTIFY THAT THE IMAGE CONTAINED ON THIS FRAME WAS MADE IN THE NORMAL AND REGULAR COURSE OF BUSINESS. ON THE DATE STATED BELOW AND THAT IT IS AN ACCURATE REPRODUCTION OF THE RECORD(S) SUBMITTED TO NUCLEAR RECORDS MANAGEMENT
DATE 11-11-88 OPERATOR K. Weibel

16X

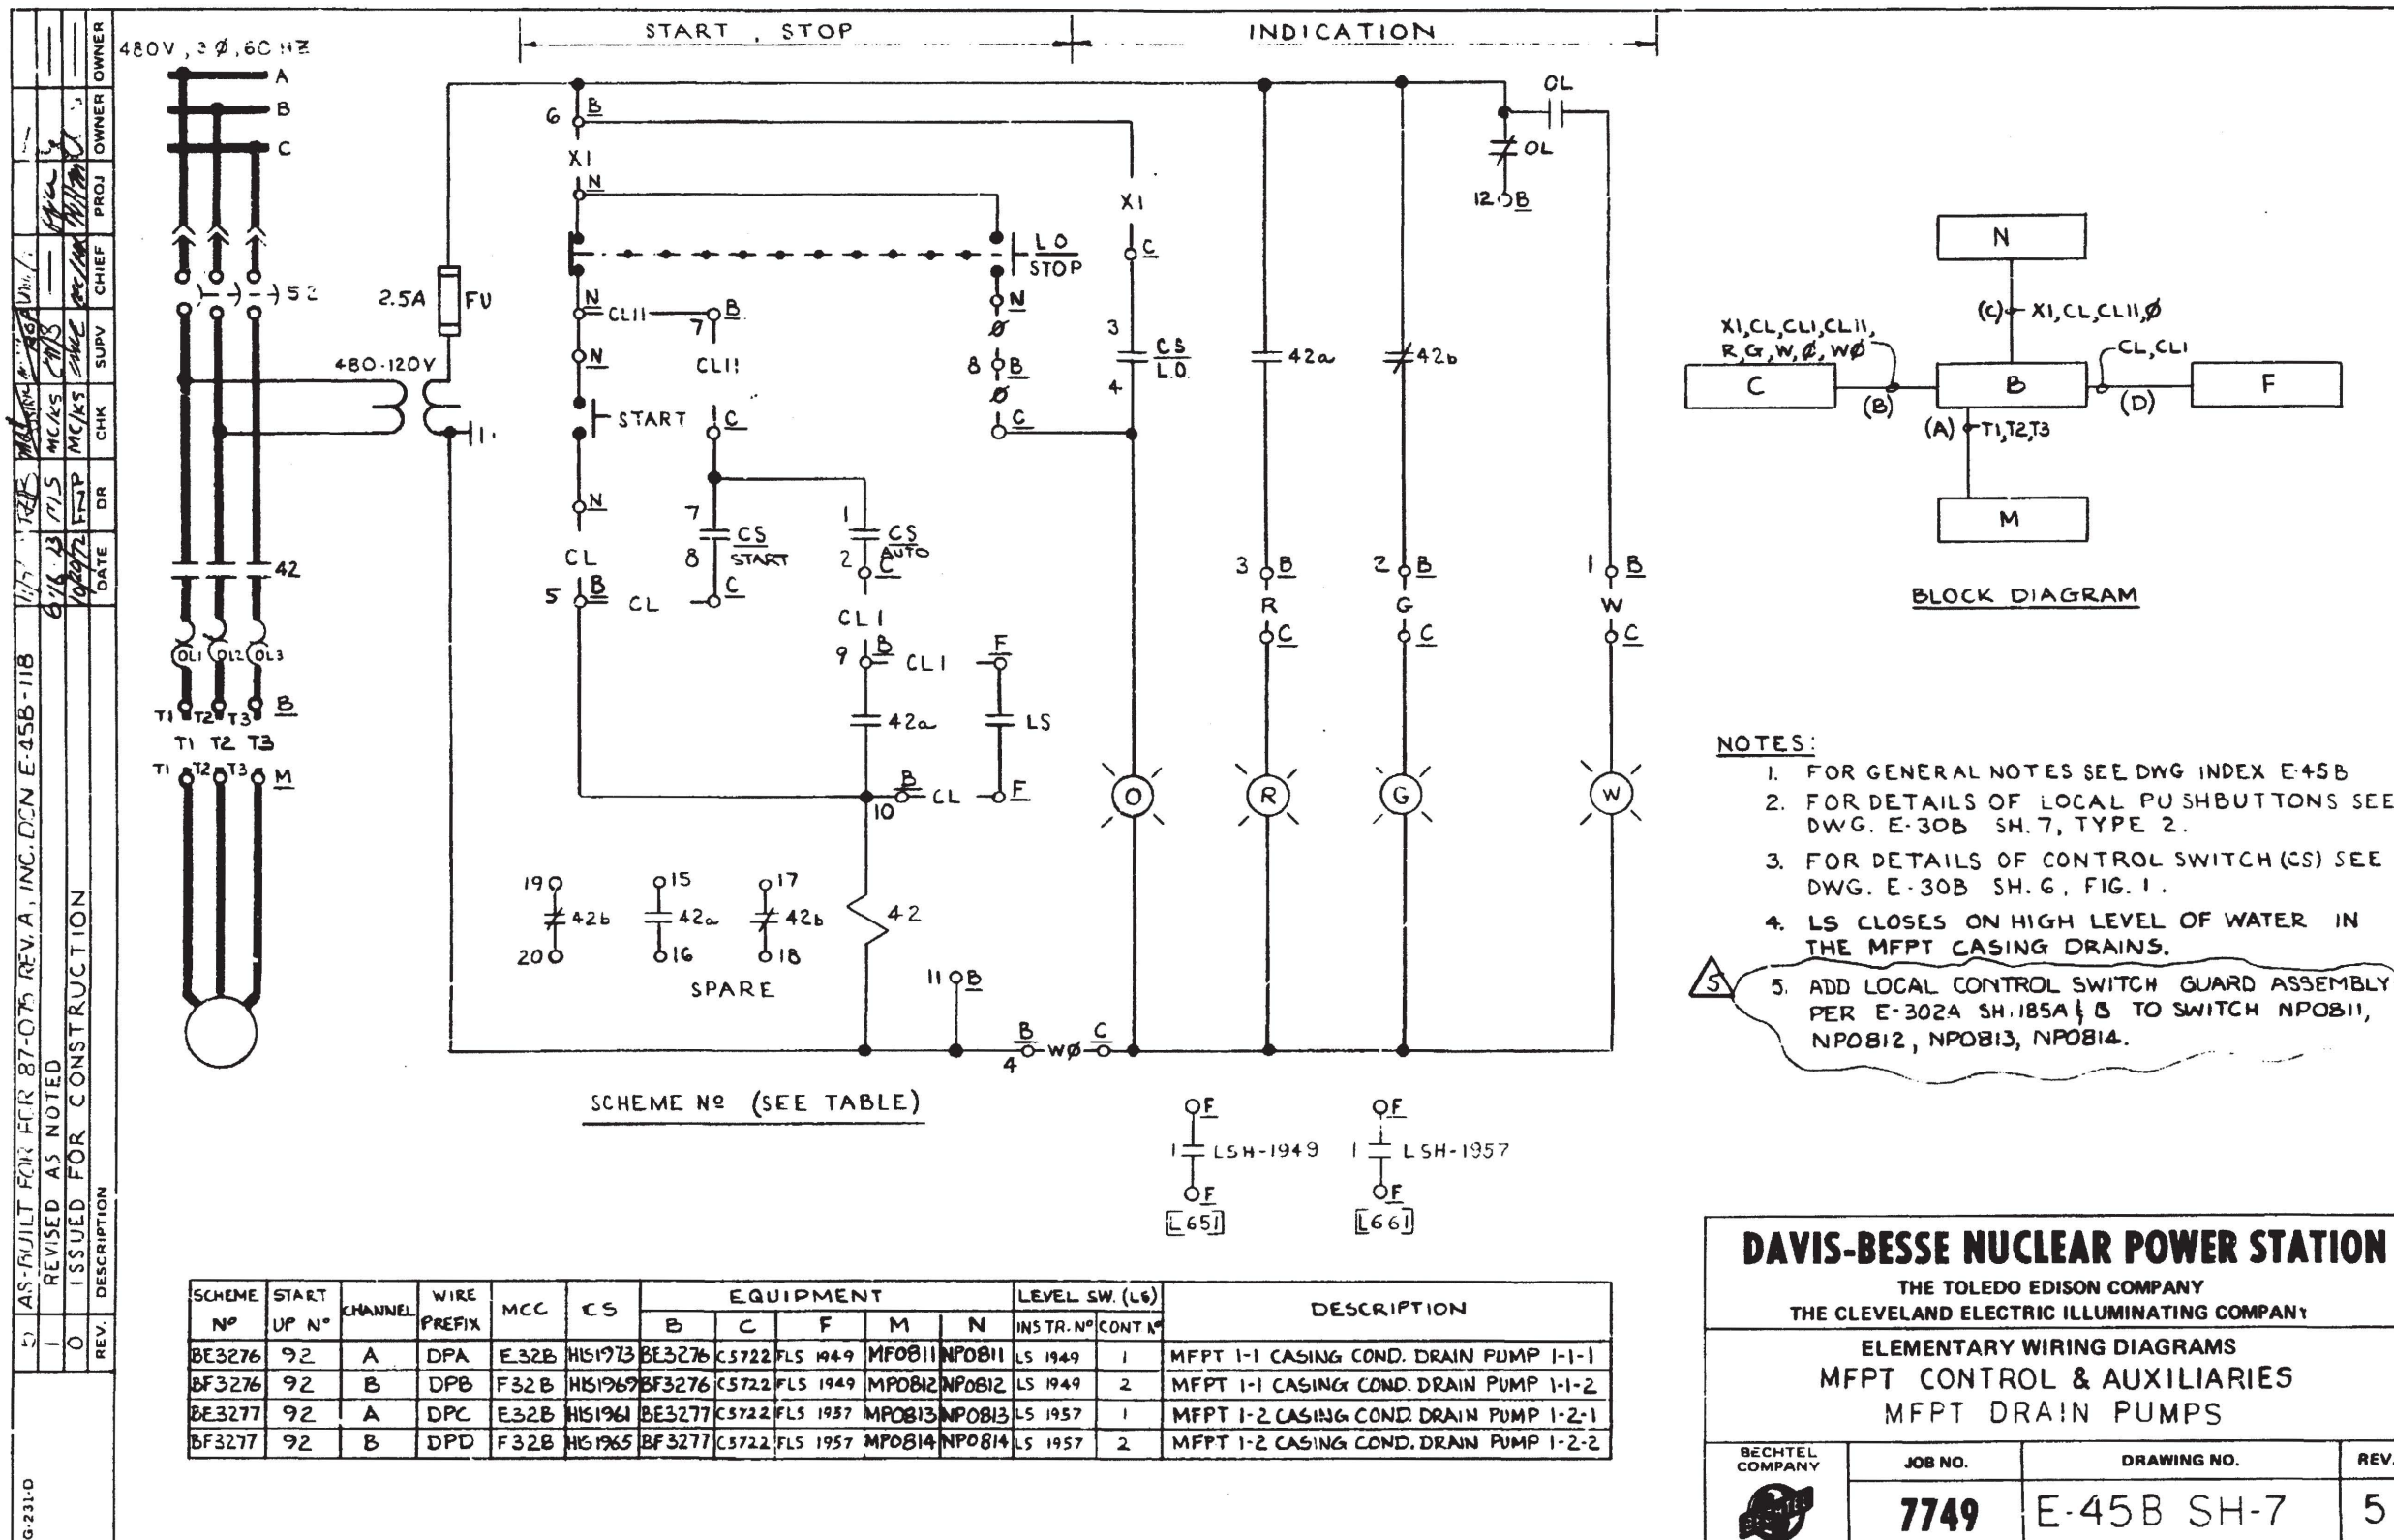

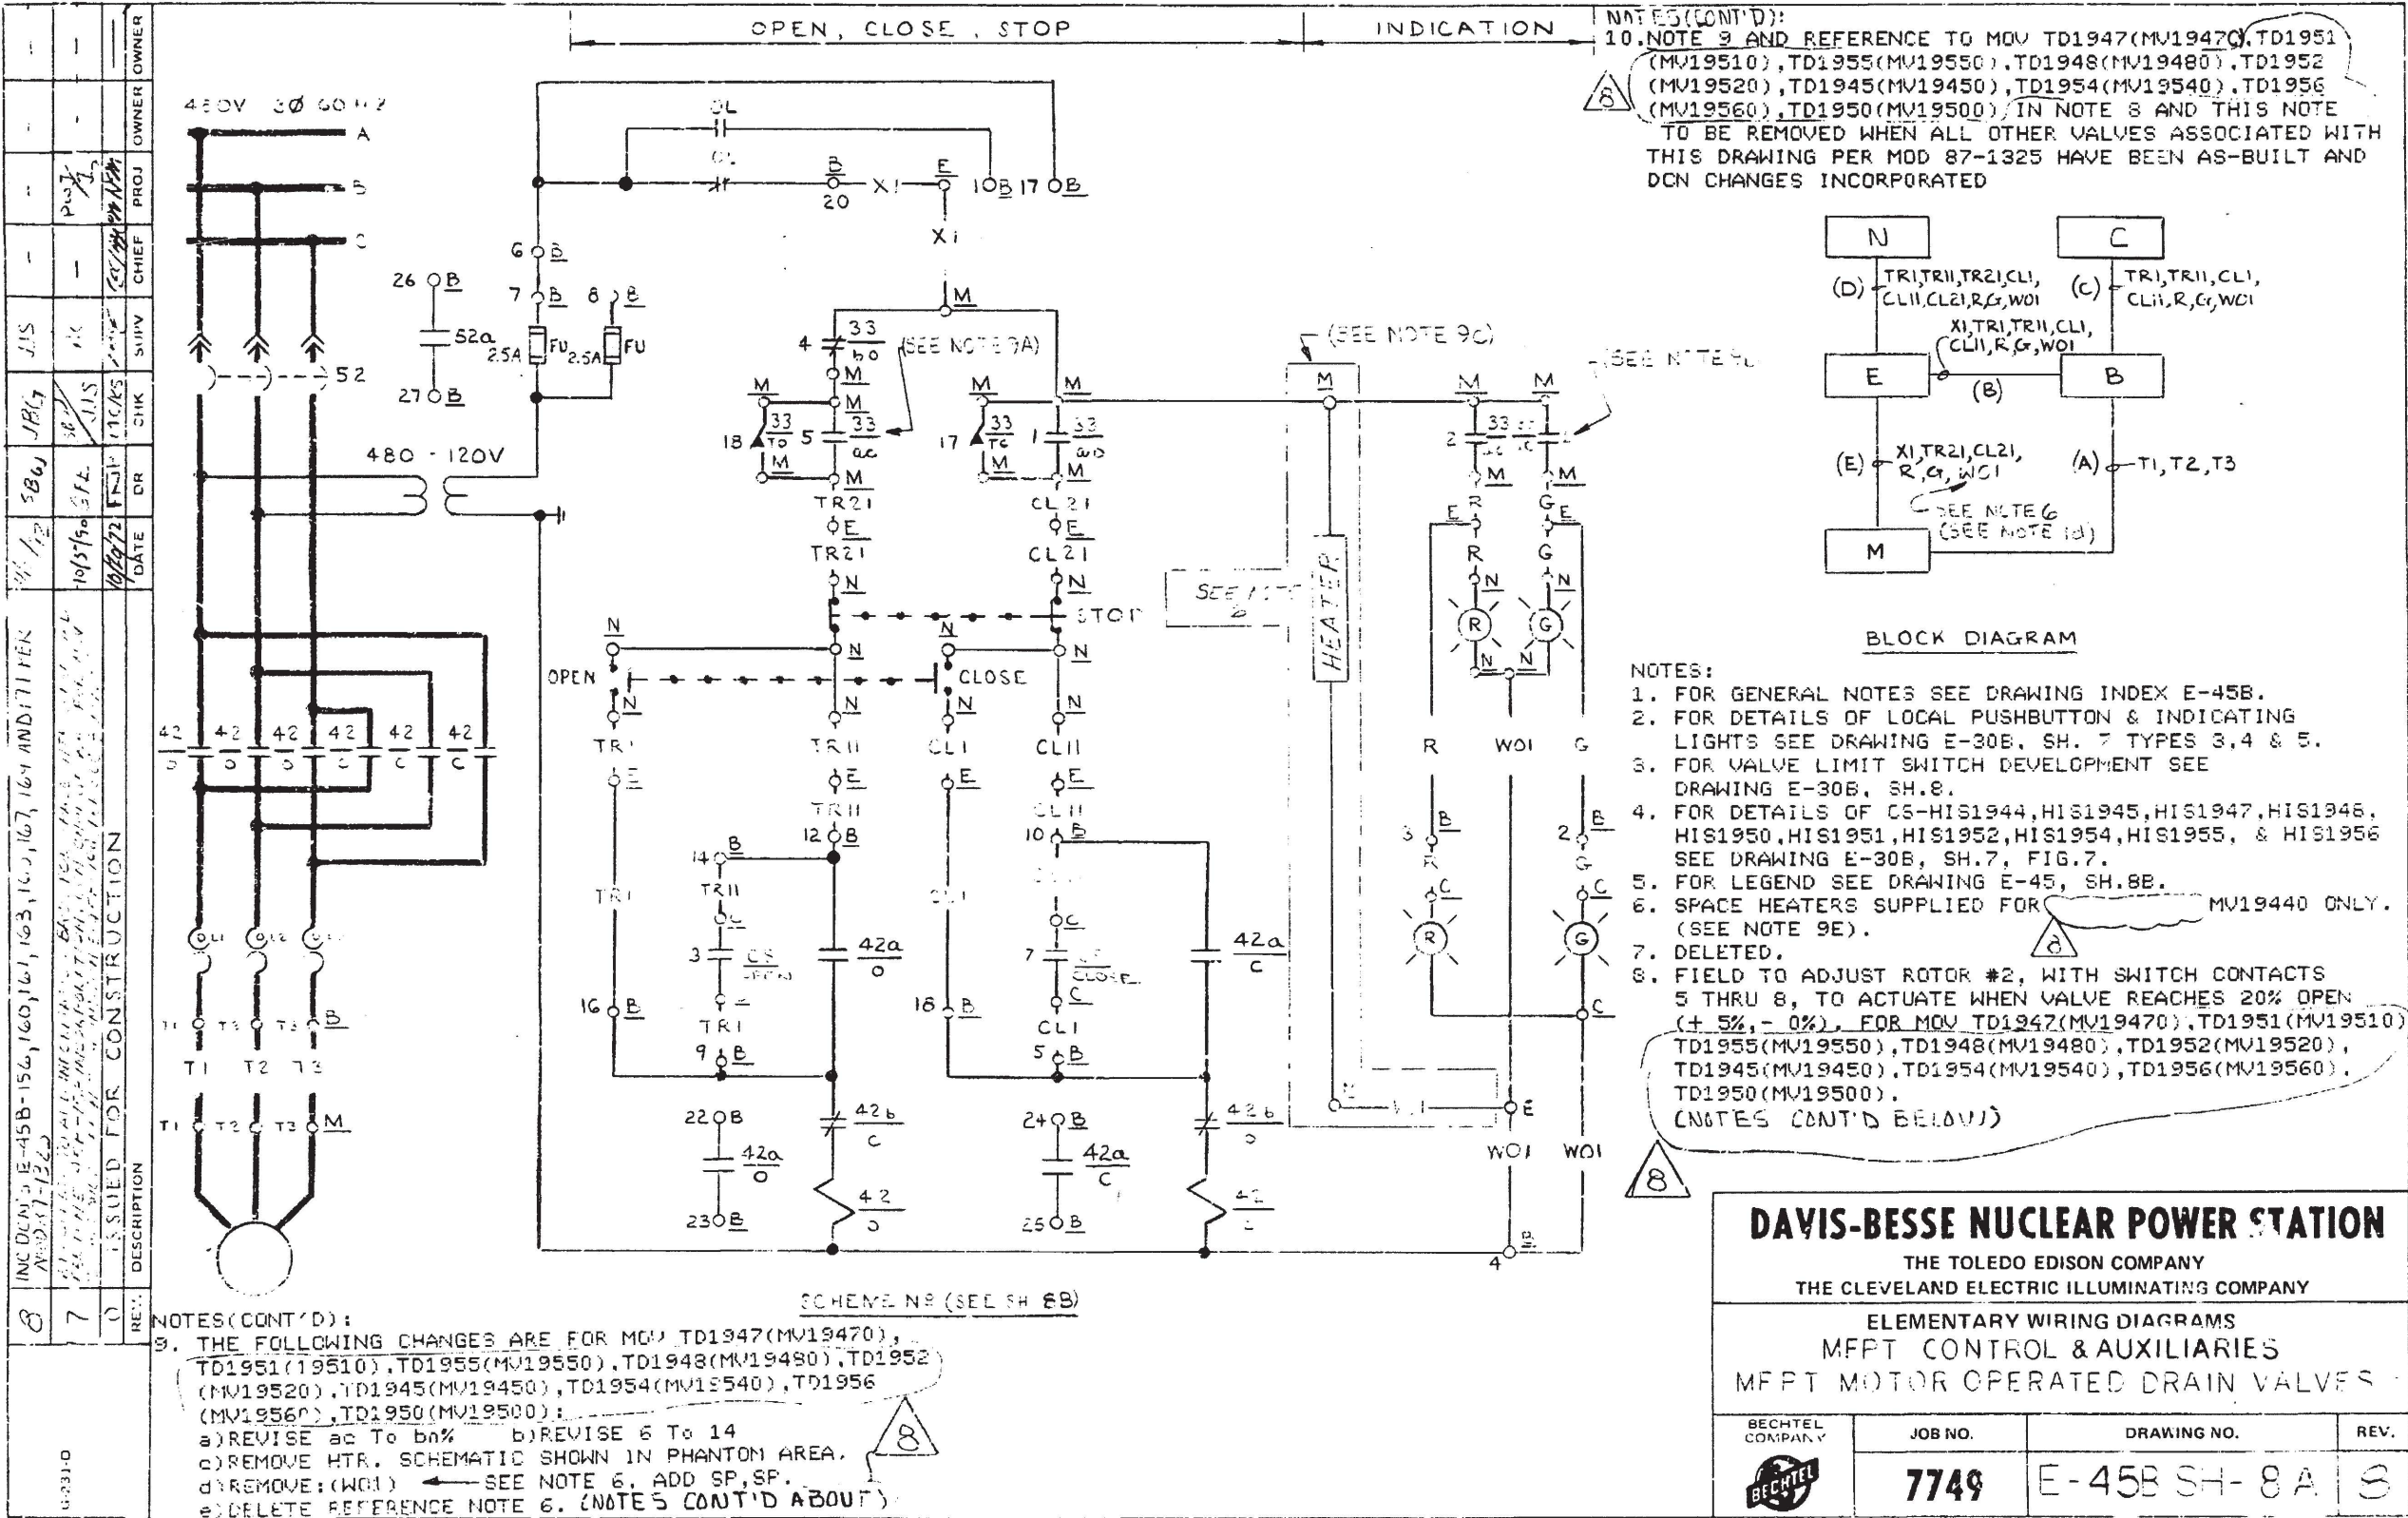

I CERTIFY THAT THE IMAGE CONTAINED ON THIS FRAME WAS MADE IN THE NORMAL AND REGULAR COURSE OF BUSINESS, ON THE DATE STATED BELOW AND THAT IT IS AN ACCURATE REPRODUCTION OF THE RECORD(S) SUBMITTED TO NUCLEAR RECORDS MANAGEMENT.

16X

REV.	DESCRIPTION	DATE	DR	CHK	SUPV	CHIEF	PROJ	OWNER	OWNER
6	MCDCN'S E-45B-157 16.9 16.6 16.3 170 173 AND 173 (CHANGE) AND E-45B-162 PER MSD 3-1-73	7/6/73	SBW	JBG	JL				
5	MCDCN'S E-45B-157 16.9 16.6 16.3 170 173 AND 173 (CHANGE) AND E-45B-162 PER MSD 3-1-73	10/5/73	CFB	JBG	JL				
C	ISSUED FOR CONSTRUCTION	10/23/73	FNP	MLK	MS				
REV.	DESCRIPTION	DATE	DR	CHK	SUPV	CHIEF	PROJ	OWNER	OWNER

SCHEME N°	START UP N°	CHANNEL	WIRE PREFIX	MCC	CS	EQUIPMENT					DESCRIPTION
						B	C	E	M	N	
BE3280	092	A	FBAS	E32B	HIS1951	BE3280	C5722	EV1950	MV19510	NV19510	MFPT 1-1 HP STOP VALVE ABOVE SEAT DRAIN.
BF3280	092	B	FDAS	F32B	HIS1947	BF3280	C5722	EV19470	MV19470	NV19470	MFPT 1-2 HP STOP VALVE ABOVE SEAT DRAIN.
BE3283	092	A	FAAS	E32B	HIS1955	BE3283	C5722	EV19550	MV19550	NV19550	MFPT 1-1 LP STOP VALVE ABOVE SEAT DRAIN.
BF3283	092	B	FCAS	F32B	HIS1948	BF3283	C5722	EV19480	MV19480	NV19480	MFPT 1-2 LP STOP VALVE ABOVE SEAT DRAIN.
BE3281	092	A	FBBS	E32B	HIS1952	BE3281	C5722	EV19520	MV19520	NV19520	MFPT 1-1 HP STOP VALVE BELOW SEAT DRAIN.
BF3281	092	B	FDBS	F32B	HIS1945	BF3281	C5722	EV19450	MV19450	NV19450	MFPT 1-2 HP STOP VALVE BELOW SEAT DRAIN.
BE3284	092	A	FABS	E32B	HIS1954	BE3284	C5722	EV19540	MV19540	NV19540	MFPT 1-1 LP STOP VALVE BELOW SEAT DRAIN.
BF3284	092	B	FCBS	F32B	HIS1956	BF3284	C5722	EV19560	MV19560	NV19560	MFPT 1-2 LP STOP VALVE BELOW SEAT DRAIN.
BE3274	092	A	FID	E32B	HIS1950	BE3274	C5722	EV19500	MV19500	NV19500	MFPT 1-1 1 st STAGE DRAIN.
BF3274	092	B	F2D	F32B	HIS1944	BF3274	C5722	EV19440	MV19440	NV19440	MFPT 1-2 1 st STAGE DRAIN.

SEE NOTE 6 -

PER. TO NOTE C & TH. NOTE TO BE REMOVED WHEN ALL OTHER VALUES ABOVE WITH THIS DAY 13 PER. AND ST-NOTE HAVE BEEN AS-BUILT AND DEN CHANGES INDICATED.

FOR SCHEME, BLOCK DIAGRAM AND NOTES SEE
DRAWING E-45 SH-8A.

DAVIS-BESSE NUCLEAR POWER STATION

THE TOLEDO EDISON COMPANY
THE CLEVELAND ELECTRIC ILLUMINATING COMPANY

ELEMENTARY WIRING DIAGRAMS
MEPT CONTROL & AUXILIARIES
MEPT MOTOR OPERATED DRAIN VALVES

BECHTEL COMPANY	JOB NO.	DRAWING NO.	REV.
	7749	E-45B SH- 8B	6

I CERTIFY THAT THE IMAGE CONTAINED ON THIS FRAME WAS MADE IN THE NORMAL AND REGULAR COURSE OF BUSINESS, ON THE DATE STATED BELOW AND THAT IT IS AN ACCURATE REPRODUCTION OF THE RECORD(S) SUBMITTED TO NUCLEAR RECORDS MANAGEMENT.



DATE 11-9-92

OPERATOR

2014年12月15日

16X

REV.	DESCRIPTION	DATE	DR	CHK	SUPV	CHIEF	PROJ	OWNER
2	ADDED FUSE RATING 1 REVISED AS NOTED	5-12-76	R.W.S	LEW	S.M.C			
1	REVISED CHANNEL & RC NO.	3-15-75	R.W.S	LEW	S.M.C			
0	ISSUED FOR CONSTRUCTION	6-12-75	S.J.H	ME/LS				

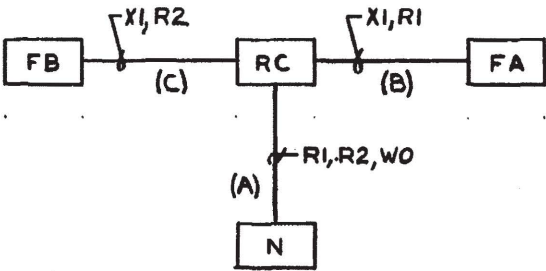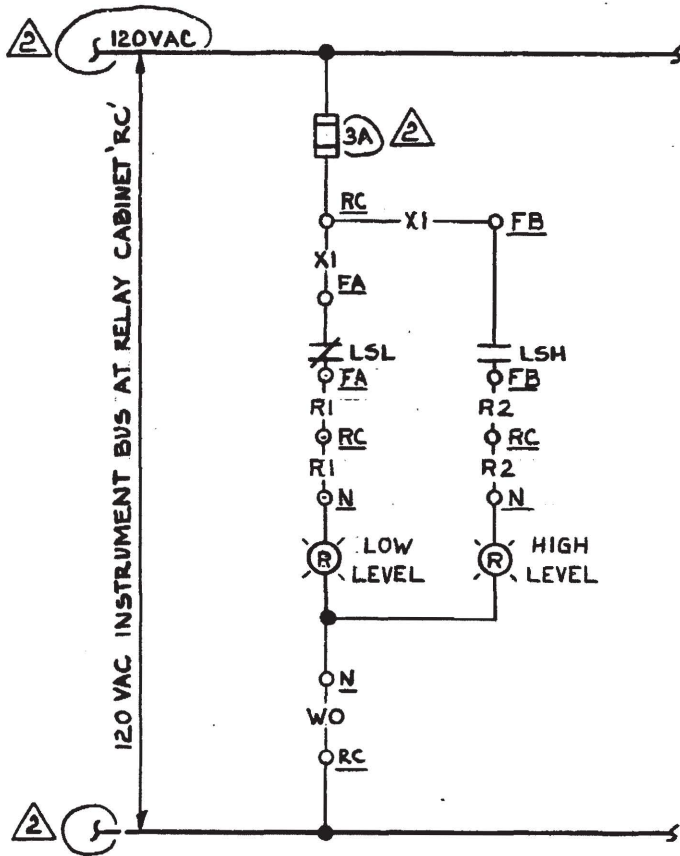

BLOCK DIAGRAM

NOTES

1. FOR GENERAL NOTES SEE DWG INDEX E-45B
2. FOR DETAILS OF INDICATING LIGHTS SEE DRAWING E-30B, SH-7, TYPE 4 EXCEPT WITH TWO RED LENS, & LEGEND AS SHOWN.

SCHEME	SU No	CHANNEL	EQUIPMENT				DESCRIPTION
			RC	N	FA	FB	
I1183	36	A	RC2404	NIL1183	FLSL1183	FLSH1183	MFPT USED LUBE OIL TK. 1-1

DAVIS-BESSE NUCLEAR POWER STATION

THE TOLEDO EDISON COMPANY
THE CLEVELAND ELECTRIC ILLUMINATING COMPANY

ELEMENTARY WIRING DIAGRAMS

MFPT CONTROL & AUXILIARIES

MFPT USED LUBE OIL TK 1-1



JOB NO.

DRAWING NO.

REV.

7749

E-45B SH-9

2

I CERTIFY THAT THE IMAGE CONTAINED ON THIS FRAME WAS MADE IN THE NORMAL AND REGULAR COURSE OF BUSINESS, ON THE DATE STATED BELOW AND THAT IT IS AN ACCURATE REPRODUCTION OF THE RECORD(S) SUBMITTED TO NUCLEAR RECORDS MANAGEMENT

DATE 4-9-88 OPERATOR S. Sutton

16X

NEWFAX 3/85 N58313

ED 7489

DWG. SH. NO.	DESCRIPTION	DESIGNATION	TYPE	RELAY CONTACTS/SHOWN WITH DEUTSCH SOCKET PIN NO. AND TB. TERM. NO. IN ().								
		STANDARD WIRING										
E45B SH.1B	MFPT TRIP AUX. RELAY	PS15X	DEUTSCH RELAY 4AP43AF 125VDC	SPARE	MFP DISCH CHECK VLV CLOSE	PART OF P654	SPARE 8	ICS INPUT		PART OF F043		FUNCTION
		RS2DC			E44B, SH.2	E45B, SH.14		E729, SH.12		E44B, SH.8		REF. DWG.
E45B SH.5B	MFPT TURN GEAR L/O RELAY	TG/X	DEUTSCH RELAY 4APX1603 120VAC	L/O INDICATION	L/O TURN GEAR MOTOR	SEAL-IN	INTERLOCK TURN GEAR SOLENOID	SPARE		SPARE		FUNCTION
		RS5AC		E45B, SH.5A	E45B, SH.5A	E45B, SH.5B	E45B, SH.5B					REF. DWG.
E45B SH.5B	MFPT LOW SPEED RELAY	ZSI/X	DEUTSCH RELAY 4APX1603 120VAC	SPARE	S656 QS-2742C	ENERGIZE TURN. GEAR SOLENOID	SPARE	AUTO START TURN. GEAR MOTOR		ENERGIZE TURN. GEAR SOLENOID		FUNCTION
		RS2AC				E45B, SH.5B		E45B, SH.5A		E45B, SH.5B		REF. DWG.

NOTES:

1. FOR STANDARD WIRING DETAILS REFER TO DWG.E-737A.

SCALE NONE	DESIGNED ARRAS	DRAWN JOR	DATE 7-29-87
DAVIS-BESSE NUCLEAR POWER STATION UNIT NO. 1 THE TOLEDO EDISON COMPANY			
ELEMENTARY WIRING DIAGRAMS #1 MFPT & AFPT CONTROL & AUXILIARIES AUXILIARY RELAYS			
	DRAWING NO.		REV.
	E-45B SH.10		8

DB 08-06-90

DFN-0: /ELEC/E45BSH10.DGN





I CERTIFY THAT THE IMAGE CONTAINED ON THIS FRAME WAS MADE IN THE NORMAL AND REGULAR COURSE OF BUSINESS, ON THE DATE STATED BELOW AND THAT IT IS AN ACCURATE REPRODUCTION OF THE RECORD(S) SUBMITTED TO NUCLEAR RECORDS MANAGEMENT.

DATE 11-19-90 OPERATOR

16X

NEW FAX 3/85 N58313

ED 7489

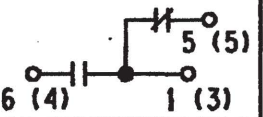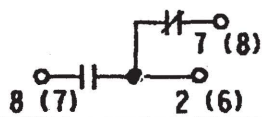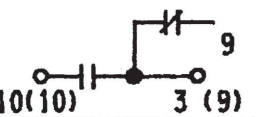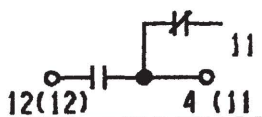DWG. SH. NO.	DESCRIPTION	DESIGNATION	TYPE	RELAY CONTACTS/SHOWN WITH DEUTSCH SOCKET PIN NO. AND TB. TERM. NO. IN ().								
		STANDARD WIRING										
E45B SH. 1B	MFPT TRIP AUX. RELAY	PS15X	DEUTSCH RELAY 4AP43AF 125VDC	SPARE	MFP DISCH CHECK VLV CLOSE	PART OF P664	SPARE	ICS INPUT	—	PART OF F050	—	FUNCTION
		RS2DC		—	E44B, SH. 2	E45B, SH. 15	—	E729, SH. 12	—	E44B, SH. 8	—	REF. DWG.
E45B SH. 5B	MFPT TURN GEAR L/O RELAY	TG/X	DEUTSCH RELAY 4APX1603 120VAC	L/O INDICATION	L/O TURN GEAR MOTOR	SEAL-IN	INTERLOCK TURN GEAR SOLENOID	SPARE	—	SPARE	—	FUNCTION
		RS5AC		E45B, SH. 5A	E45B, SH. 5A	E45B, SH. 5B	E45B, SH. 5B	—	—	—	—	REF. DWG.
E45B SH. 5B	MFPT LOW SPEED RELAY	ZS1/X	DEUTSCH RELAY 4APX1603 120VAC	SPARE	S666 QS-2752C	ENERGIZE TURN. GEAR SOLENOID	SPARE	AUTO START TURN. GEAR MOTOR	—	ENERGIZE TURN. GEAR SOLENOID	—	FUNCTION
		RS2AC		—	—	E45B, SH. 5B	—	E45B, SH. 5A	—	E45B, SH. 5B	—	REF. DWG.

NOTES:

1. FOR STANDARD WIRING DETAILS REFER TO DWG E737A.

SCALE NONE	DESIGNED ARRAS	DRAWN JOR	DATE 7-29-87
DAVIS-BESSE NUCLEAR POWER STATION UNIT NO. 1 THE TOLEDO EDISON COMPANY			
ELEMENTARY WIRING DIAGRAMS #2 MFPT & AFPT CONTROL & AUXILIARIES AUXILIARY RELAYS			
	DRAWING NO.		REV.
	E-45B SH.10A		0

DB 10-14-88

DFN-D1/EL/E45BSH10.DGN

I CERTIFY THAT THE IMAGE CONTAINED ON THIS FRAME WAS MADE IN THE NORMAL AND REGULAR COURSE OF BUSINESS. ON THE DATE STATED BELOW AND THAT IT IS AN ACCURATE REPRODUCTION OF THE RECORD(S) SUBMITTED TO NUCLEAR RECORDS MANAGEMENT.

DATE 11-11-88 OPERATOR K. Weibel

16X

SCALE NONE	DESIGNED ARRAS	DRAWN JOR	DATE 7-29-87
DAVIS-BESSE NUCLEAR POWER STATION UNIT NO. 1 THE TOLEDO EDISON COMPANY			
ELEMENTARY WIRING DIAGRAMS #1 MFPT & AFPT CONTROL & AUXILIARIES AUXILIARY RELAYS			
	DRAWING NO.		REV.
	E-45B SH.10B		0

1. FOR GENERAL NOTES SEE DWG.E45B SH.10.

DB 10-14-88

DFN-DI/EL/E45BSH10.DGN

NEW FAX 3/85 N56313

ED 7489

DWG. SH. NO.	DESCRIPTION	DESIGNATION	TYPE	RELAY CONTACTS/SHOWN WITH DEUTSCH SOCKET PIN NO. AND TB. TERM. NO. IN ().								
		STANDARD WIRING										
E45B SH.1A	MANUAL TURBINE TRIP AUX. RELAY	TRX	DEUTSCH RELAY 4AP43AF 125VDC	SPARE	SOE ANN.	SPARE	TEST CONNECTION		Q642	SEAL-IN		FUNCTION
		RS10DC			E45B, SH. 1K				E45B, SH. 15	E45B, SH. 1A		REF. DWG.

DWG. SH. NO.	DESCRIPTION	DESIGNATION	TYPE	RELAY CONTACTS/SHOWN WITH DEUTSCH SOCKET PIN NO. AND TB. TERM. NO. IN ().								
		STANDARD WIRING										
E45B SH.1A	MFPT VACUUM TRIP RELAY	VRX	DEUTSCH RELAY 4AP43AF 125VDC	SEAL-IN	TURBINE TRIP PERMISSIVE	INDICATION	SPARE	SPARE			ALARM PERMISSIVE	FUNCTION
		RS25DC		E45B, SH. 1A	E45B, SH. 1A	E45B, SH. 1A					E45B, SH. 1A	REF. DWG.

DWG. SH. NO.	DESCRIPTION	DESIGNATION	TYPE	RELAY CONTACTS/SHOWN WITH DEUTSCH SOCKET PIN NO. AND TB. TERM. NO. IN ().								
		STANDARD WIRING										
E45B SH.1B	MFPT EMER. GOV. TRIP AUX. RELAY	LS16X	DEUTSCH RELAY 4AP43AF 125VDC	SPARE	PART OF Q634		SOE ANN.	TEST CONNECTION		LS-16 SOE SEAL-IN	LS-16 AUTO RESET INHIBIT	FUNCTION
		RS26DC			E45B, SH. 15		E45B, SH. 1K			E45B, SH. 1L	E45B, SH. 1L	REF. DWG.

NOTES:
1. FOR GENERAL NOTES SEE DWG.E45B SH.10A.

SCALE NONE DESIGNED ARRAS DRAWN JOR DATE 7-29-87

DAVIS-BESSE NUCLEAR POWER STATION
UNIT NO. 1
THE TOLEDO EDISON COMPANY

ELEMENTARY WIRING DIAGRAMS
#2 MFPT & AFPT CONTROL & AUXILIARIES
AUXILIARY RELAYS

 DRAWING NO. E-45B SH.10C REV. 0

DB 10-14-88 DFN=D:/EL/E45BSH10.DGN




I CERTIFY THAT THE IMAGE CONTAINED ON THIS FRAME WAS MADE IN THE NORMAL AND REGULAR COURSE OF BUSINESS. ON THE DATE STATED BELOW AND THAT IT IS AN ACCURATE REPRODUCTION OF THE RECORD(S) SUBMITTED TO NUCLEAR RECORDS MANAGEMENT

DATE 11-11-88 OPERATOR H. Weibel

16X

NEW FAX 3/85 N58313

ED 7489

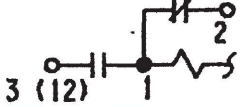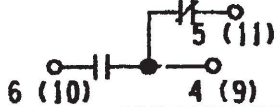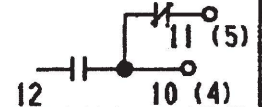DWG. SH. NO.	DESCRIPTION	DESIGNATION	TYPE	RELAY CONTACTS/SHOWN WITH ARMEL SOCKET PIN NO. AND TB. TERM. NO. IN ().								
		STANDARD WIRING										
E 45B SH. 1A	LOW VACUUM TRIP AUX. RELAY	PS3337X	DEUTSCH RELAY 4AP43AF 125VDC	SEAL-IN	—	SPARE	TEST CONNECTION	SPARE	SPARE	—	SOE ANN.	FUNCTION
		RS30DC		E 45B, SH. 1A	—	—	—	—	—	—	E 45B, SH. 1K	REF. DWG.
E 45B SH. 1L	PUMP HIGH DISCH. PRESS. AUX. RELAY	PSHX	DEUTSCH RELAY 4AP43AF 125VDC	SEAL-IN	—	SPARE	TEST CONNECTION	SPARE	PART OF 0628	—	SOE ANN.	FUNCTION
		RS30DC		E 45B, SH. 1L	—	—	—	—	—	E 45B, SH. 14	—	E 45B, SH. 1K
E 45B SH. 1L	TURB. BRG LOW OIL PRESS. TRIP AUX. RELAY	PS19X	DEUTSCH RELAY 4AP43AF 125VDC	SEAL-IN	—	SPARE	TEST CONNECTION	SPARE	PART OF P657	—	SOE ANN.	FUNCTION
		RS30DC		E 45B, SH. 1L	—	—	—	—	—	E 45B, SH. 14	—	E 45B, SH. 1K
E 45B SH. 1L	PUMP BRG LOW OIL PRESS. TRIP AUX. RELAY	PS25X	DEUTSCH RELAY 4AP43AF 125VDC	SEAL-IN	—	SPARE	TEST CONNECTION	SPARE	PART OF P639	—	SOE ANN.	FUNCTION
		RS30DC		E 45B, SH. 1L	—	—	—	—	—	E 45B, SH. 14	—	E 45B, SH. 1K
E 45B SH. 1L	THRUST BRG TRIP (ACTIVE) AUX. RELAY	PS2X	DEUTSCH RELAY 4AP43AF 125VDC	SEAL-IN	—	SPARE	TEST CONNECTION	SPARE	PART OF P658	—	SOE ANN.	FUNCTION
		RS30DC		E 45B, SH. 1L	—	—	—	—	—	E 45B, SH. 14	—	E 45B, SH. 1K
E 45B SH. 1L	THRUST BRG TRIP (INACTIVE) AUX. RELAY	PS12X	DEUTSCH RELAY 4AP43AF 125VDC	SEAL-IN	—	SPARE	TEST CONNECTION	SPARE	PART OF P658	—	SOE ANN.	FUNCTION
		RS30DC		E 45B, SH. 1L	—	—	—	—	—	E 45B, SH. 14	—	E 45B, SH. 1K

NOTES:

1. FOR GENERAL NOTES SEE DWG. E45B SH. 10.

SCALE NONE

DESIGNED ARRAS

DRAWN JOR

DATE 7-29-87

DAVIS-BESSE NUCLEAR POWER STATION
UNIT NO. 1
THE TOLEDO EDISON COMPANY

ELEMENTARY WIRING DIAGRAMS
#1 MFPT & AFPT CONTROL & AUXILIARIES
AUXILIARY RELAYS



DRAWING NO.
E-45B SH. 10D

REV.
0

DB 10-14-88

DFN=D1/EL/E45BSH10.DGN

I CERTIFY THAT THE IMAGE CONTAINED ON THIS FRAME WAS MADE IN THE NORMAL AND REGULAR COURSE OF BUSINESS. ON THE DATE STATED BELOW AND THAT IT IS AN ACCURATE REPRODUCTION OF THE RECORD(S) SUBMITTED TO NUCLEAR RECORDS MANAGEMENT.

DATE 11-11-88 OPERATOR A. Weibel

16X

DFN=D: /EL /E45BSH10.DGN

1. FOR GENERAL NOTES SEE DWG.E45B SH.10A.

SCALE NONE	DESIGNED ARRAS	DRAWN JOR	DATE 7-29-87
DAVIS-BESSE NUCLEAR POWER STATION UNIT NO. 1 THE TOLEDO EDISON COMPANY			
ELEMENTARY WIRING DIAGRAMS #2 MFPT & AFPT CONTROL & AUXILIARIES AUXILIARY RELAYS			
	DRAWING NO.		REV.
	E-45B SH.10E		0

I CERTIFY THAT THE IMAGE CONTAINED ON THIS FRAME WAS MADE IN THE NORMAL AND REGULAR COURSE OF BUSINESS. ON THE DATE STATED BELOW AND THAT IT IS AN ACCURATE REPRODUCTION OF THE RECORD(S) SUBMITTED TO NUCLEAR RECORDS MANAGEMENT.

DATE 11-11-88 OPERATOR A. Weibel

16X

DFN-D1/EL/E45BSH10.DGN

1. FOR GENERAL NOTES SEE DWG.E45B SH.10.

OPERATOR

WEIBEL

DEFN=D1/EL/E45BSH10.DGN

1. FOR GENERAL NOTES SEE DWG.E45B SH.10A.

SCALE NONE	DESIGNED ARRAS	DRAWN JOR	DATE 7-30-87
DAVIS-BESSE NUCLEAR POWER STATION UNIT NO. 1 THE TOLEDO EDISON COMPANY			
ELEMENTARY WIRING DIAGRAMS #2 MFPT & AFPT CONTROL & AUXILIARIES AUXILIARY RELAYS			
	DRAWING NO.		REV.
	E-45B SH.10G		0

I CERTIFY THAT THE IMAGE CONTAINED ON THIS FRAME WAS MADE IN THE NORMAL AND REGULAR COURSE OF BUSINESS, ON THE DATE STATED BELOW AND THAT IT IS AN ACCURATE REPRODUCTION OF THE RECORD(S) SUBMITTED TO NUCLEAR RECORDS MANAGEMENT.

DATE 11-11-88

OPERATOR

GEMENT
Kweibel

16X

DFN=D: \EL \E45BSH10.DGN

1. FOR GENERAL NOTES SEE DWG.E45B SH.10.


SCALE NONE	DESIGNED ARRAS	DRAWN JDR	DATE 7-30-87
DAVIS-BESSE NUCLEAR POWER STATION UNIT NO. 1 THE TOLEDO EDISON COMPANY			
ELEMENTARY WIRING DIAGRAMS #1 MFPT & AFPT CONTROL & AUXILIARIES AUXILIARY RELAYS			
	DRAWING NO.		REV.
	E-45B SH.10H		0

I CERTIFY THAT THE IMAGE CONTAINED ON THIS FRAME WAS MADE IN THE NORMAL AND REGULAR COURSE OF BUSINESS, ON THE DATE STATED BELOW AND THAT IT IS AN ACCURATE REPRODUCTION OF THE RECORD(S) SUBMITTED TO NUCLEAR RECORDS MANAGEMENT.

DEN-D1/EL/E45BSH10.DGN

SCALE NONE	DESIGNED ARRAS	DRAWN JOR	DATE 7-30-87
DAVIS-BESSE NUCLEAR POWER STATION UNIT NO. 1 THE TOLEDO EDISON COMPANY			
ELEMENTARY WIRING DIAGRAMS #2 MFPT & AFPT CONTROL & AUXILIARIES AUXILIARY RELAYS			
	DRAWING NO.		REV.
	E-45B SH.10J		0

I CERTIFY THAT THE IMAGE CONTAINED ON THIS FRAME WAS MADE IN THE NORMAL AND REGULAR COURSE OF BUSINESS, ON THE DATE STATED BELOW AND THAT IT IS AN ACCURATE REPRODUCTION OF THE RECORD(S) SUBMITTED TO NUCLEAR RECORDS MANAGEMENT.

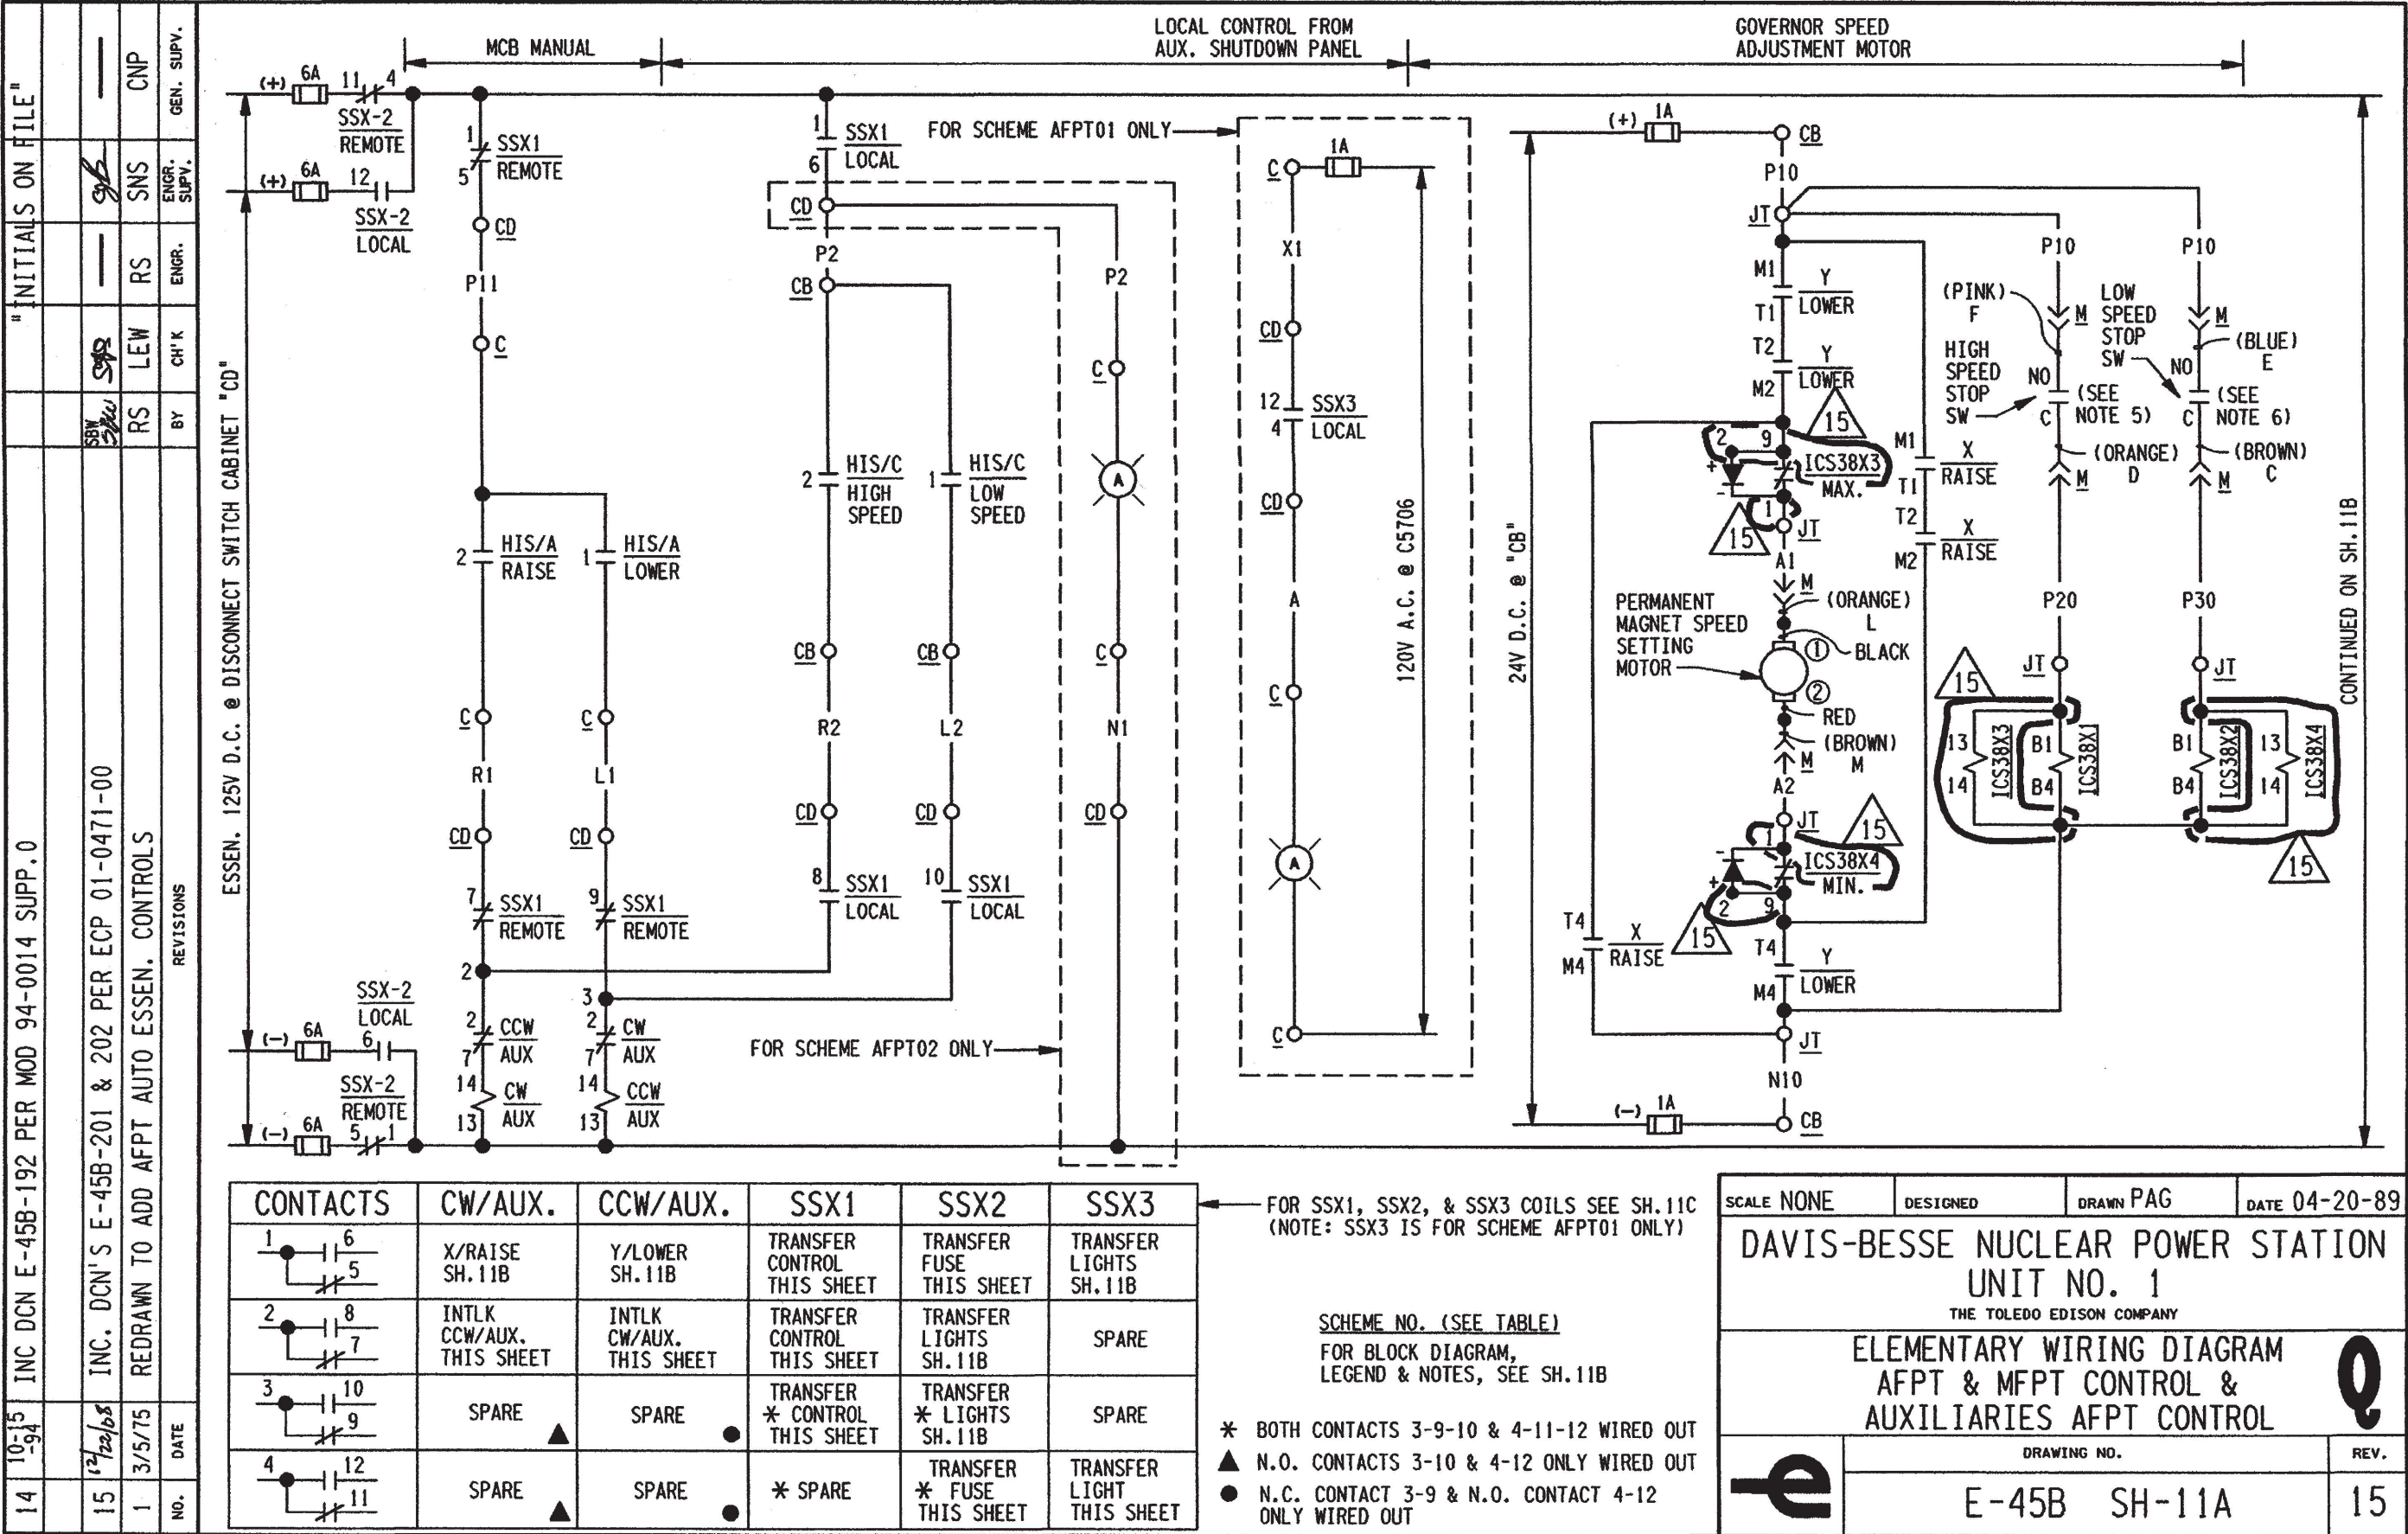

CONTACTS	CW/AUX.	CCW/AUX.	SSX1	SSX2	SSX3
	X/RAISE SH. 11B	Y/LOWER SH. 11B	TRANSFER CONTROL THIS SHEET	TRANSFER FUSE THIS SHEET	TRANSFER LIGHTS SH. 11B
	INTLK CCW/AUX. THIS SHEET	INTLK CW/AUX. THIS SHEET	TRANSFER CONTROL THIS SHEET	TRANSFER LIGHTS SH. 11B	SPARE
	SPARE	SPARE	TRANSFER * CONTROL THIS SHEET	TRANSFER * LIGHTS SH. 11B	SPARE
	SPARE	SPARE	* SPARE	TRANSFER * FUSE THIS SHEET	TRANSFER LIGHT THIS SHEET

FOR SSX1, SSX2, & SSX3 COILS SEE SH. 11C
(NOTE: SSX3 IS FOR SCHEME AFPT01 ONLY)


SCHEME NO. (SEE TABLE)
FOR BLOCK DIAGRAM,
LEGEND & NOTES, SEE SH. 11B

* BOTH CONTACTS 3-9-10 & 4-11-12 WIRED OUT
▲ N.O. CONTACTS 3-10 & 4-12 ONLY WIRED OUT
● N.C. CONTACT 3-9 & N.O. CONTACT 4-12 ONLY WIRED OUT

SCALE NONE	DESIGNED	DRAWN PAG	DATE 04-20-89
DAVIS-BESSE NUCLEAR POWER STATION UNIT NO. 1 THE TOLEDO EDISON COMPANY			
ELEMENTARY WIRING DIAGRAM AFPT & MFPT CONTROL & AUXILIARIES AFPT CONTROL			
DRAWING NO. E-45B SH-11A			REV. 15

NOTES:

1. FOR GENERAL NOTES, SEE DWG. INDEX E-45B
2. FOR HIS/A SWITCH DEVELOPMENT SEE E-30B, SH. II, FIG. 5
FOR HIS/C SWITCH DEVELOPMENT SEE E-30B, SH. II, FIG. 5A
3. DELETED
5. TAG NUMBER FOR HIGH SPEED STOP LIMIT SWITCH
IS ZS-ICS38Q FOR CHANNEL 1 & ZS-ICS38S FOR
CHANNEL 2.
6. TAG NUMBER FOR LOW SPEED STOP LIMIT SWITCH
IS ZS-ICS38R FOR CHANNEL 1 & ZS-ICS38T FOR
CHANNEL 2.

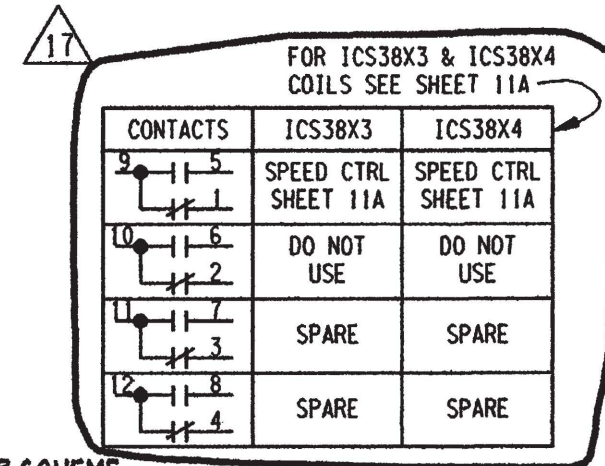
[illegible]

DAVIS-BESSE NUCLEAR POWER STATION

THE TOLEDO EDISON COMPANY
THE CLEVELAND ELECTRIC ILLUMINATING COMPANY.

ELEMENTARY WIRING DIAGRAM
AFPT & MFPT CONTROL & AUXILIARIES
AFPT CONTROL

BECHTEL COMPANY	JOB NO.	DRAWING NO.	REV.
	7749	E-45B SH-IIB	17

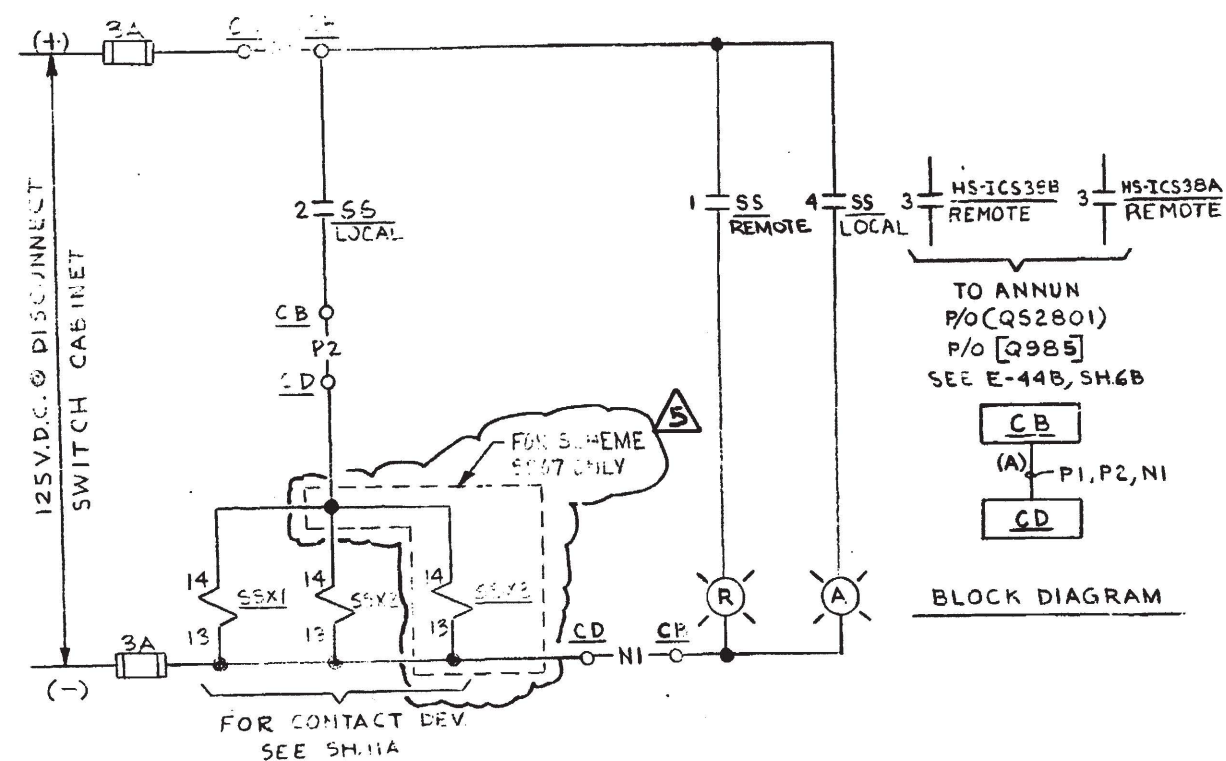

SCHEME NO.	START UP NO.	CHANNEL	SS	EQUIPMENT		DESCRIPTION
				CD	CB	
SD07	50	1	HS-1CS38B	CDE12A-1	C3630	AFPT 1 GOV. CTRL. SEL. CRKT.
SD08	50	2	HS-1CS38A	CDF12A-1	C3630	AFPT 2 GOV. CTRL. SEL. CRKT.

NOTES:

1. FOR GEN. NOTES SEE DWG INDEX E-45B
2. DELETED
3. FOR SS SWITCH DEVELOPMENT
SEE E-30B SHII, FIG. 4A

DAVIS-BESSE NUCLEAR POWER STATION THE TOLEDO EDISON COMPANY THE CLEVELAND ELECTRIC ILLUMINATING COMPANY			
ELEMENTARY WIRING DIAGRAM AFPT & MFPT CONTROL & AUXILIARIES AFPT CONTROL			
 BECHTEL COMPANY	JOB NO.	DRAWING NO.	REV.
	7749	E-45B SH-IIC	5


I CERTIFY THAT THE IMAGE CONTAINED ON THIS FRAME WAS MADE IN THE NORMAL AND REGULAR COURSE OF BUSINESS ON THE DATE STATED BELOW AND THAT IT IS AN ACCURATE REPRODUCTION OF THE RECORD(S) SUBMITTED TO NUCLEAR RECORDS MANAGEMENT.

OPERATOR

3-15-89 OPERATOR 8 Lane System 16 X

NEWFAK 3/85 N58313

ED 7489

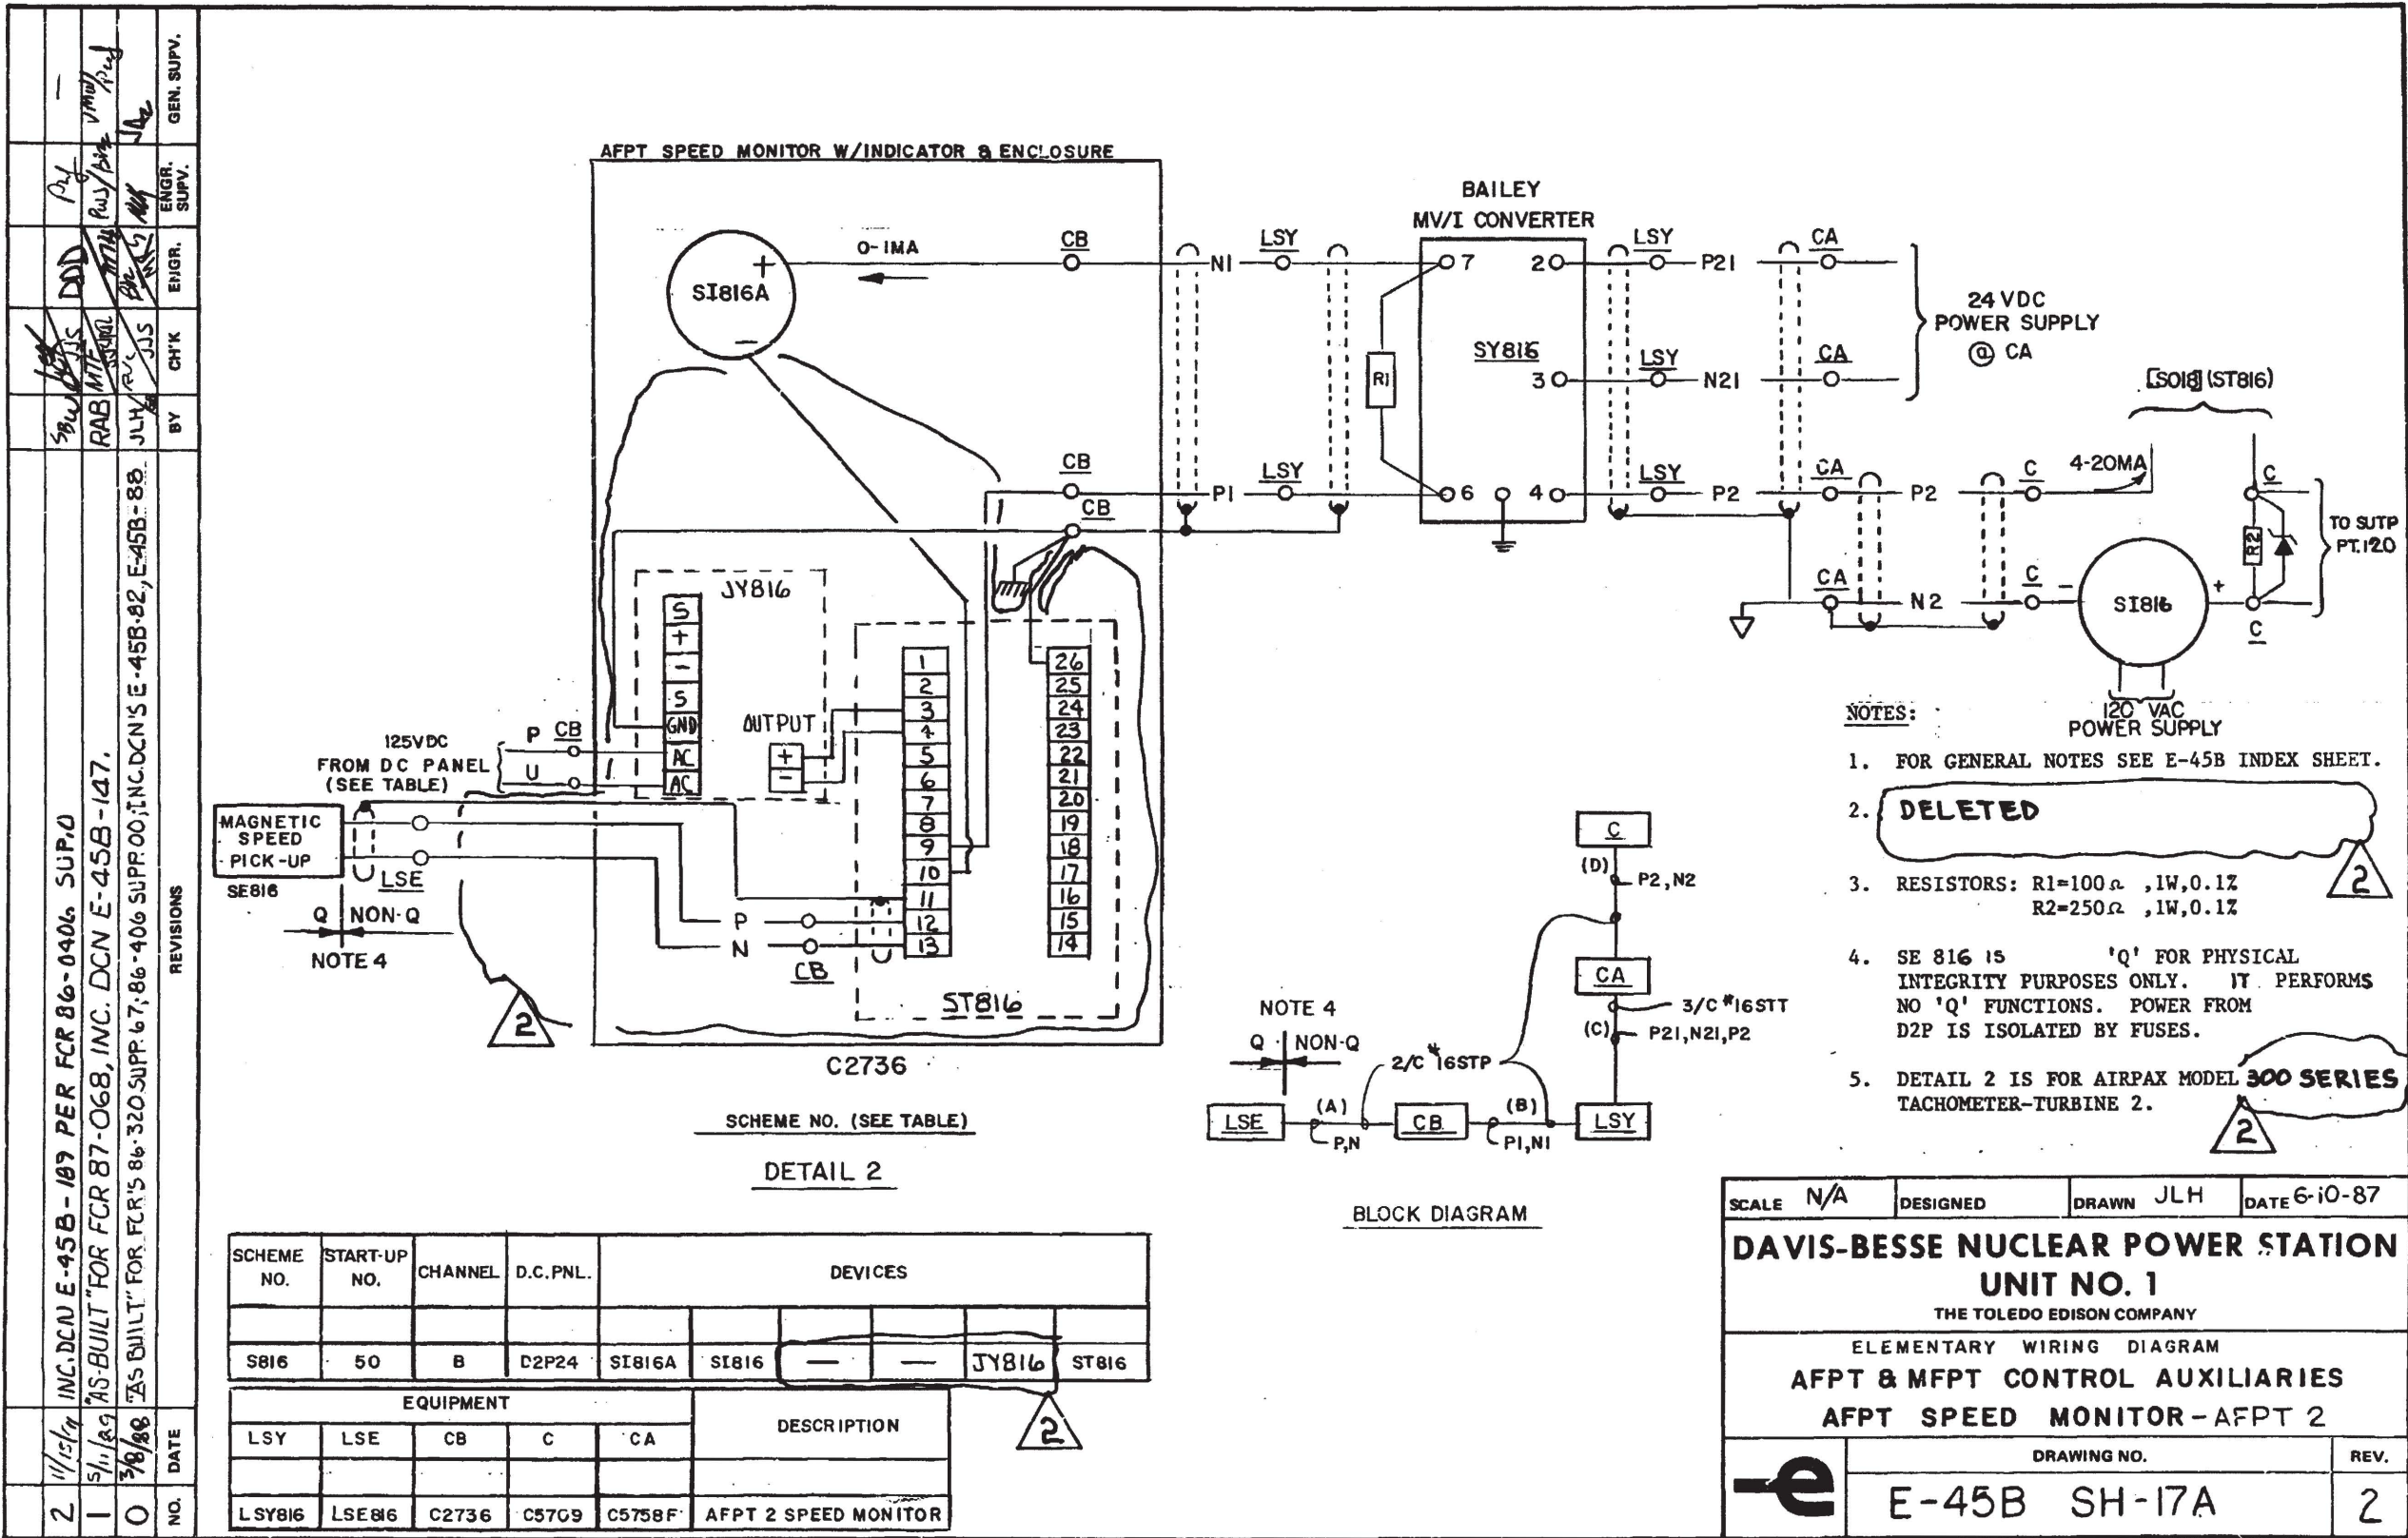

I CERTIFY THAT THE IMAGE CONTAINED ON THIS FRAME WAS MADE IN THE NORMAL AND REGULAR COURSE OF BUSINESS, ON THE DATE STATED BELOW AND THAT IT IS AN ACCURATE REPRODUCTION OF THE RECORD(S) SUBMITTED TO NUCLEAR RECORDS MANAGEMENT.

DATE 11-20-91 OPERATOR [Signature]

16X

INDEX			
SHEET NO.	LATEST REV.	DESCRIPTION	Q
1A	14	MAIN STM LINES ISOLATION VALVES (SOV)	Q
1B	17	MAIN STM LINES ISOLATION VALVES (SOV)	Q
1C	6	VOID	
1D	11	MAIN STM LINES ISOLATION VALVES (SOV)	Q
1E	9	MAIN STM LINES ISOLATION VALVES (SOV)	Q
1F	3	MAIN STM LINES ISOLATION VALVES (SOV)	Q
2	2	DELETED	
2A	1	DELETED	
2B	1	DELETED	
3	5	MAIN STM LINES WARM UP DRAIN VALVES (SOV)	Q
4A	25	AUX FEED PMPS TURBS MN STM IN ISO VLVS (MOV'S)	Q
4B	24	AUX FEED PMPS TURBS MN STM IN ISO VLVS (MOV'S)	Q
4C	3	DELETED	
5A	9	STEAM & CONDENSATE (MOV)	
5B	7	STEAM & CONDENSATE (MOV)	
6A	6	STEAM & CONDENSATE (COMBINED MOV'S)	
6B	7	STEAM & CONDENSATE (COMBINED MOV'S)	
6C	6	STEAM & CONDENSATE (COMBINED MOV'S)	
7A	8	MS EXTR TO MSR 2ND STAGE VALVES (MOV'S)	
7B	6	MS EXTR TO MSR 2ND STAGE VALVES (MOV'S)	
7C	3	MS EXTR TO MSR 2ND STAGE VALVES (MOV'S)	
8	4	DEMIN WATER TRANS PUMP DISCHARGE VALVE (MOV)	
9A	5	HEATER DRAIN PUMP MOTORS	
9B	6	HEATER DRAIN PUMP MOTORS	
10A	8	CONDENSATE PUMP MOTORS	
10B	9	CONDENSATE PUMP MOTORS	
11	6	CONDENSATE PUMPS RECIRC VALVE (SOV)	
12	7	HP EXTR DRAIN VALVES (SOV'S)	
13	6	LP EXTR DRAIN VALVES (SOV'S)	
14	6	FW HTR SU DRAIN VALVES (SOV'S)	
15	9	TURB STM SEAL DIVR VLV HP COND (SOV)	
16	5	CONDENSATE FLASH TANK VLV TO HTR 1-2 & 2-2 (SOV)	
94	5-6-12	REVISED SH. 4A (REV.25), REVISED SH.21, (REV.6), REVISED SH.46A (REV.21), & REVISED SH.54B (REV.19)	
93	07/07/11	REVISED SH. 4B (REV.24), SH. 27 (REV.12) & SH.46A (REV.20)	
95	6/2/14	INC. DUN 08-0573-005-002 REV.00 & REVISED SH. 56 & 67 (REV.1) & SH.66A (REV.4)	
REV	DATE	DESCRIPTION	

GENERAL NOTES:

- FOR EXPLANATION OF EQUIPMENT & WIRING NUMBERS SEE 7749-11A, ELECTRICAL NUMBERING SYSTEM.
- FOR MOTOR INFORMATION SEE 7749-E-12B, ELECT. MOTOR LIST.
- FOR CONTROL PANEL, MCC, DESCRIPTIONS SEE E-13B ELECT. EQUIPMENT LIST.
- WIRE NUMBER PREFIX MUST BE ADDED TO FORM COMPLETE WIRE NUMBER FOR THOSE WIRES AT MAIN CONTROL BOARD.
- AUX CONTROL RELAY IN SOLENOID OPERATED VALVE CONTROL CIRCUITS TO BE COUCH TYPE 4AP.
- NUMBER IN BRACKETS [] REPRESENTS COMPUTER INPUT NUMBER. NUMBERS IN PARENTHESIS () REPRESENTS COMPUTER INPUT SOURCE NUMBER.

REFERENCE DRAWINGS:

- E-5 SH.1 THRU 5 - 480V MCC (NON-ESSENTIAL) ONE LINE DIAGRAM
- E-6 SH.1,2 - 480V MCC (ESSENTIAL) ONE LINE DIAGRAM
- E-10A - STANDARD NOTES AND SYMBOLS
- E-11A - ELECTRICAL NUMBERING SYSTEM
- E-12B - MOTOR LIST
- E-14B - SOLENOID VALVE LIST
- E-30B - GENERAL GUIDES - ELEMENTARY DIAGRAM

FOR CONTINUATION OF INDEX SEE SH.2.

THIS DRAWING WAS REDRAWN ON CAD AND SUPERSEDES REVISION 64.

SCALE NONE	DESIGNED	DRAWN JLH	DATE 12-20-89
DAVIS-BESSE NUCLEAR POWER STATION UNIT NO. 1 THE TOLEDO EDISON COMPANY			
ELEMENTARY WIRING DIAGRAMS			
DRAWING INDEX			
	DRAWING NO.		REV.
	E-46B SH.1		95

INDEX							
SHEET NO.	LATEST REV.	DESCRIPTION	Q	SHEET NO.	LATEST REV.	DESCRIPTION	Q
17A	7	CNDS DEMIN HOLD-UP TANK OUTLET VLV'S		43	3	CNDS DEMIN WST DRUMMING OUT VLV	
17B	3	CNDS DEMIN HOLD-UP TANK OUTLET VLV'S		44A	6	CNDS POL DEMIN WST XFER PMP'S	
17C	1	CNDS DEMIN BKWASH STRNR AUX RELAY		44B	2	CNDS POL DEMIN WST XFER PMP'S	
17D	4	CNDS DEMIN HOLD-UP TANK'S OUT VLV'S		45A	3	STEAM & CONDENSATE (COMBINED MOV'S)	
18	9	STEAM SOLENOID OPERATED VALVES		45B	3	STEAM & CONDENSATE (COMBINED MOV'S)	
19A	4	FW HTR SOLENOID OPERATED VLV'S		45C	3	STEAM & CONDENSATE (COMBINED MOV'S)	
19B	2	FW HTR SOLENOID OPERATED VLV'S		46A	21	SG AFP 1 ISO VLV	Q
19C	1	FW HTR SOLENOID OPERATED VLV'S		46B	17	SG AFP 1 ISO VLV	Q
20	7	DEAR HTR LP TURB EXT (SOV'S)		47	1	HTR DRAIN & COND PMPS COMPUTER CKTS	
21	6	MISC MOTOR OPERATED VALVES		48	3	CNDS DEMIN PRIMING VALVES	
22	5	DEAR HTRS LP EXT DRN (SOV'S)		49	4	VOID	
23A	6	SG ATM STM VENT & SAMPLE VLV'S	Q	50	5	VOID	
23B	9	SG ATM STM VENT & SAMPLE VLV'S	Q	51	6	VOID	
24	5	MN STM LINES BEFORE STOP VLV'S WU VLV'S (SOV'S)		52	6	DELETED	Q
25	4	MISC CHEMICAL PUMPS & MIXERS		53	3	CNDS VACCUM PMP DISCHARGE RADIATION MNTR AUX RELAYS	
26	7	BACKWASH RECEIVING SUMP PUMPS		54A	14	AUX FD PMP TURB MN STM IN ISO VLV	Q
27	12	MECH HOGGER 1-1 VAC PUMP 1-1		54B	19	AUX FD PMP TURB MN STM IN ISO VLV	Q
28	6	MECH HOGGER COOLER CIRC PUMP 1-1		55A	2	MSR 2ND STAGE STEAM SUPPLY MOV	
29	10	STM HOGGER AUX STM INLET VALVE		55B	1	MSR 2ND STAGE STEAM SUPPLY MOV	
30	10	FW HTR SOLENOID OPERATED VALVES		56	195	MSR AUX RELAYS	
31	7	SUMP PUMPS		57	0	MSR AUX RELAYS	
32A	5	MAIN STM LINES ISO VALVES WU VALVES (SOV'S)	Q	58	1	DELETED	
32B	6	MAIN STM LINES ISO VALVES WU VALVES (SOV'S)	Q	59	3	MSR DRAIN VALVES	
33	15	STEAM GENERATOR DRAIN VLV	Q	60	3	MSR DRAIN VALVES	
33A	4	STEAM GENERATOR DRAIN VLV	Q	61	3	MSR DRAIN VALVES	
33B	0	STEAM GENERATOR DRAIN VLV		62	3	MSR DRAIN VALVES	
33C	3	STEAM GENERATOR DRAIN VLV		63	3	MSR DRAIN VALVES	
34	4	TURB BYPASS DESUPERHTNG VLV					
35	4	COND PIT FLOOD PMP 1-1 & 1-2					
36	2	CNDS PMPS RUNOUT VLV					
37	8	TURB BYPASS VLV & MN STM ATM VENT VLV					
38	4	CNDS POLISHING DEMIN HOLD UP PMP					
39A	2	CNDS POLISHING DEMIN MISC AGITATOR					
39B	6	CNDS POLISHING DEMIN MISC PMPS					
40	2	CNDS POLISHING DEMIN DUST EVACUATOR					
41A	5	VOID					
41B	5	FW HTR MOV'S					
42	1	LP COND MU & CNDS STRG IN VLV'S					

FOR GENERAL NOTES AND REFERENCE DRAWINGS
SEE DRAWING E-46B DRAWING INDEX SH.1.


FOR CONTINUATION OF INDEX SEE SH.3.

THIS DRAWING WAS REDRAWN ON CAD AND SUPERSEDES REVISION 64.

SCALE NONE	DESIGNED	DRAWN JLH	DATE 12-22-89
DAVIS-BESSE NUCLEAR POWER STATION UNIT NO. 1 THE TOLEDO EDISON COMPANY			
ELEMENTARY WIRING DIAGRAMS STEAM & COND. DRAWING INDEX			
	DRAWING NO.		REV.
	E-46B SH.2		95


NO.	DATE	REVISIONS	BY	CHK	ENGR.	ENGR. SUPV.	GEN. SUPV.
14	8-24-96	INC. DCN E-46B-576 & 578 FOR MOD 93-0051-00	KNF	DVK	—	—	—
13	3/21/91	INC. DCN E-46B-361 PER DCR 89-0210					
12	9/18/89	"AS-BUILT" FOR FCR 87-063, INC. DCN E-46B-175 & 176; MOD 87-1107 SUPP.2, INC. DCN E-46B-232 & 233, SUPP.4, GEN. UPDATE, INC. DCN E-46B-300 "REDRAWN"					

SEE SF-0038
SH.9 (10)

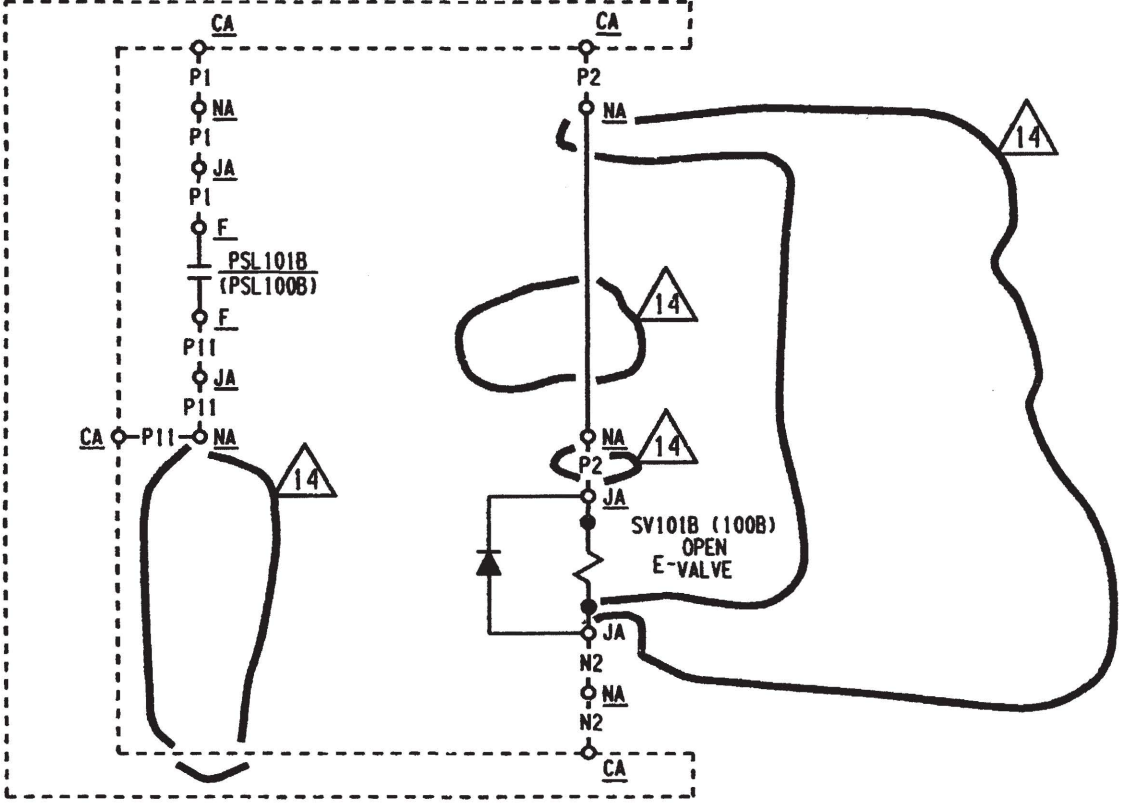

SCHEME NO. (SEE TABLE)

SCHEME NO.	SU. NO.	CHANNEL	EQUIPMENT							DESCRIPTION
			JA	JB	NA	CA			F	
FV101B	83	1	JT6801		NSV101	C5762A			FPSL101B	MN. STM. LINE 1 VISO. VALVE
FV100B	83	2	JT6703		NSV100	C5792			FPSL100B	MN. STM. LINE 2 VISO. VALVE

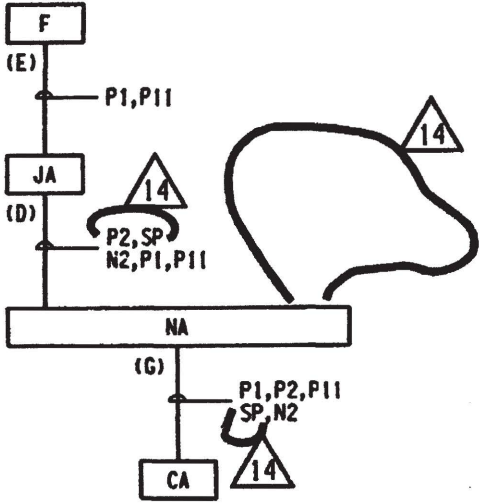

BLOCK DIAGRAM
(SEE NOTE 6)

NOTES:

1. FOR GENERAL NOTES, SEE E-46B INDEX SHEET.
2. DELETED
3. DELETED
4. DELETED
5. FOR CONTROL POWER, SFRCS LOGIC AND CONTROL SWITCH (CS) OPERATION SEE SF-0038 SH.9(10).
6. CABLES TO BE ROUTED DIFFERENTLY FROM SCHEMES FV101A(FV101B) ON SH. 1D.
7. PSL CONTACT OPENS ON LOW AIR PRESSURE TO PILOT SOLENOID (SOLENOID DE-ENERGIZED).

THIS DRAWING WAS REDRAWN ON CAD AND SUPERCEDES REVISION 11

SCALE NONE	DESIGNED	DRAWN JOR	DATE 05-31-89
DAVIS-BESSE NUCLEAR POWER STATION UNIT NO. 1 THE TOLEDO EDISON COMPANY			
ELEMENTARY WIRING DIAGRAM STEAM AND CONDENSATE MN STM LINE ISO VALVES			Q
DRAWING NO. E-46B SH.1A			REV. 14

DB 07-17-96 DFN= DBNPS/SCHEME/E46BS1A .DCN

I CERTIFY THAT THE IMAGE CONTAINED ON THIS FRAME WAS MADE IN THE NORMAL AND REGULAR COURSE OF BUSINESS, ON THE DATE STATED BELOW AND THAT IT IS AN ACCURATE REPRODUCTION OF THE RECORD(S) SUBMITTED TO NUCLEAR RECORDS MANAGEMENT.

DATE 8-30-96 OPERATOR Darcy Wiedle

16X





MM STM LINES (2)
NU 150 VLV
HV-101-1 (100-1)
DWG E46B SH-32A


JT6802
 A ZS-101E
 B bc

JT6802
 [2683]

OJT6802
 A / ZS-101C
 B / 6c
 OJT6802
 SPARE
 SFAS CABINET
 C5763C INPUT
 DWG. E760

JT6704
 1/2S-100E
 bc
 JT6704
 [2686]

○ JT6704
 1/2 ZS-100C
 8 bc
 ○ JT6704
 SPARE
 SFAS CABINET
 C5756C INPUT
 DWG. E 760

JT6802
 C ZS1010
 D AC
 JT6802
 TO SUTP
 PT 26

T6704
TS-100C
bc
T6704
WARE

CABINET
C INPUT
E760

ICS CABINET
C5761B INPUT
E729A SH. 8




JT6802
Z5101B
CLOSES WHEN VL
JT6802
CABINET
51B INPUT
9A SH 8

JT6704
 ZS100B
 CLOSE S
 JT6704

ICS CABINET
 C5761B INPUT
 E729A SH.8



1. FOR GENERAL NOTES SEE DWG. EA6B, INDEX SH.
2. DELETED
3. FOR TERMINAL BOX (JA & JB) INTERNAL WIRING
SEE ROCKWELL MFG., CO., DWG. PD-423882
(F.P. 7749-M-304-7)
4. FOR INDICATING LIGHTS SEE E-308, SH. 17, FIG. 4A & B.
5. PSL CONTACT CLOSURES, ON LOW AIR PRESSURE TO
PILOT SOLENOID (SOLENOID DE-ENERGIZED),
6. DELETED
7. IN LINE TERMINATION LOCATED IN JB5777 (CH. 1).
8. IN LINE TERMINATION LOCATED IN JB5776 (CH. 2).

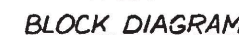


**ELEMENTARY WIRING DIAGRAM
STEAM AND CONDENSATE
MN STM LINE ISO VALVES**

BECHTEL COMPANY 	JOB NO.	DRAWING NO.	REV.
	7749	E 46 B SH1B	17

DATE 8.30.96 OPERATOR Dorothy Wick

16X

SCHEME NO.	SU. NO.	CHANNEL	EQUIPMENT						DESCRIPTION
			JA	NA		CA	F		
FV101A	83	1	JT6801	NSV101		C5762A	FP5L101A		MN. STM. LINE 1 ISO. VALVE
FV100A	83	2	JT6703	NSV100		C5792	FP5L100A		MN. STM. LINE 2 ISO. VALVE

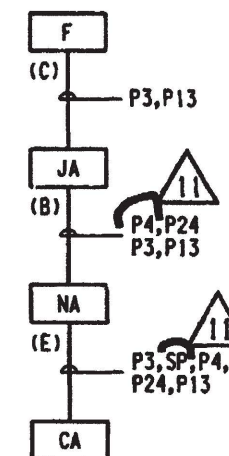

BLOCK DIAGRAM
(SEE NOTE 5)

NOTES:

1. FOR GENERAL NOTES, SEE E-46B INDEX SHEET.
2. DELETED
3. DELETED
4. FOR CONTROL POWER, SFRCS LOGIC AND CONTROL SWITCH (CS) OPERATION SEE SF-003B SH.9(10).
5. CABLES TO BE ROUTED DIFFERENTLY FROM SCHEMES FV101B(FV100B) ON SH.1A.
6. PSL CONTACT OPENS ON LOW AIR PRESSURE TO PILOT SOLENOID (SOLENOID DE-ENERGIZED).

THIS DRAWING WAS REDRAWN ON CAD AND SUPERCEDES REVISION 9

SCALE NONE	DESIGNED	DRAWN JOR	DATE 05-31-89
DAVIS-BESSE NUCLEAR POWER STATION UNIT NO. 1 THE TOLEDO EDISON COMPANY			
ELEMENTARY WIRING DIAGRAM STEAM AND CONDENSATE MN STM LINE ISO VALVES			Q
	DRAWING NO.		REV.
	E-46B SH. 1D		11

I CERTIFY THAT THE IMAGE CONTAINED ON THIS FRAME WAS MADE IN THE NORMAL AND REGULAR COURSE OF BUSINESS, ON THE DATE STATED BELOW AND THAT IT IS AN ACCURATE REPRODUCTION OF THE RECORD(S) SUBMITTED TO NUCLEAR RECORDS MANAGEMENT.

DATE 0-22-76 OPERATOR


⁵16X

DB 07-17-96 DFN= D:\EL \ \E46BS1D .DGN

NEI-AX 3/85 N50313


ED 7409

NO.	DATE	REVISIONS	BY	CHK	ENGR.	ENGR. SUPV.	GEN. SUPV.
9	8-26-89	INC. DCN E-46B-583 & 585 FOR MOD 93-0051-00	KNF	DVK	WLS		
8	9-18-89	"AS-BUILT" FOR: FCR 87-063, INC. DCN E-46B-189 & 190, SUPP. 0, INC. DCN E-46B-284 & 282; MOD 87-1107 SUPP. 2, INC DCN E-46B-236 & 237, SUPP. 4 GEN. UPDATE, INC. DCN E-46B-303 "REDRAWN"					

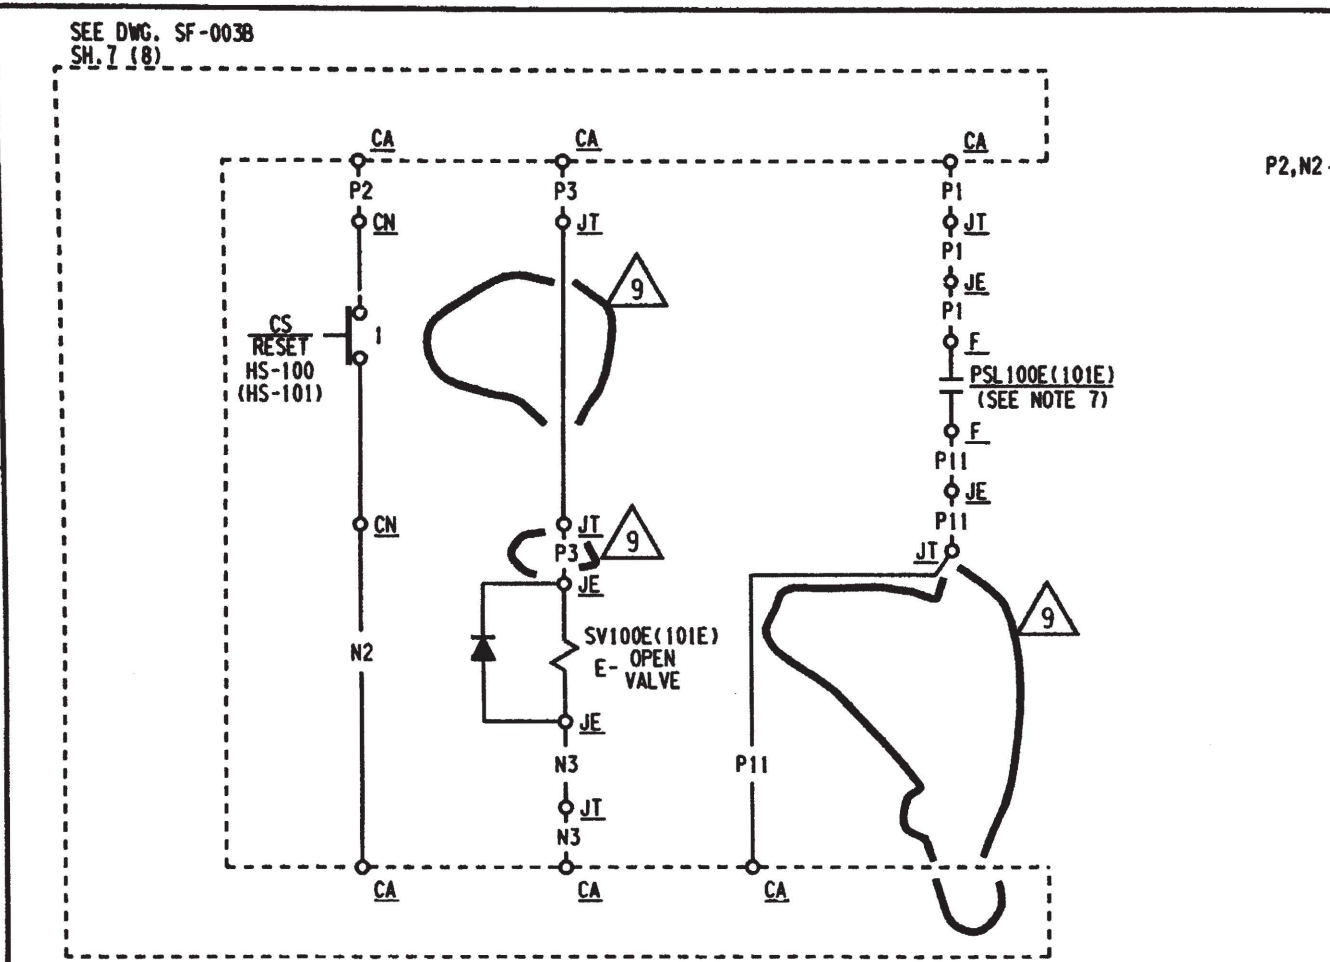

SCHEME NO. (SEE TABLE)

SCHEME NO.	SU. NO.	CHANNEL	EQUIPMENT						DESCRIPTION
			CN	CA	JT	JE		F	
FV100E	83	1	C5762N	C5762A	JT6717	JT6707		FPSL100E	MN. STM. LINE 2 ISO. VALVE
FV101E	83	2	C5792N	C5792	JT6811	JT6807		FPSL101E	MN. STM. LINE 1 ISO. VALVE

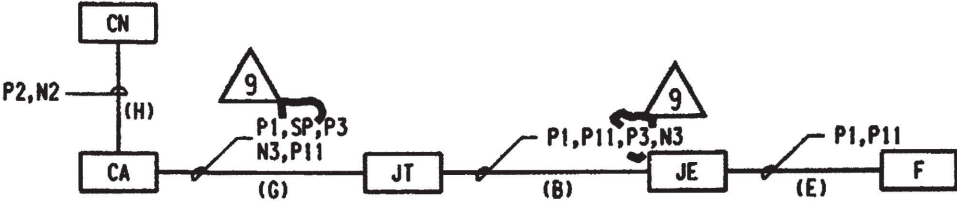

BLOCK DIAGRAM (SEE NOTE 5)

NOTES:

1. FOR GENERAL NOTES, SEE E-46B INDEX SHEET.
2. DELETED
3. FOR CONTROL POWER, SFRCS LOGIC AND CONTROL SWITCH (CS) OPERATION SEE DWG. SF-0038 SH. 7(8).
4. DELETED
5. CABLES IN SCHEMES FV100E(FV101E) ARE TO BE ROUTED DIFFERENTLY FROM THOSE IN SCHEMES FV100D(FV101D).
6. DELETED
7. PSL CONTACT OPENS ON LOW AIR PRESSURE TO PILOT SOLENOID (SOLENOID DE-ENERGIZED).
8. DELETED
9. DELETED
10. JT6717(6811) IS PHYSICALLY LOCATED INSIDE NSV100E (101E).

THIS DRAWING WAS REDRAWN ON CAD AND SUPERCEDES REVISION 7

SCALE NONE	DESIGNED	DRAWN JCR	DATE 05-31-89
DAVIS-BESSE NUCLEAR POWER STATION UNIT NO. 1 THE TOLEDO EDISON COMPANY			
ELEMENTARY WIRING DIAGRAM STEAM AND CONDENSATE MN STM LINE ISO VALVES			
	DRAWING NO.		REV.
	E-46B SH.1E		9

DB 07-18-96 DFN= DBNPS/SCHEME /E46BS1E .DGN


I CERTIFY THAT THE IMAGE CONTAINED ON THIS FRAME WAS MADE IN THE NORMAL AND REGULAR COURSE OF BUSINESS, ON THE DATE STATED BELOW AND THAT IT IS AN ACCURATE REPRODUCTION OF THE RECORD(S) SUBMITTED TO NUCLEAR RECORDS MANAGEMENT.

DATE 8-30-96 OPERATOR Dorey Wied

16X

NEW FAX 3/85 N58313

ED 7489


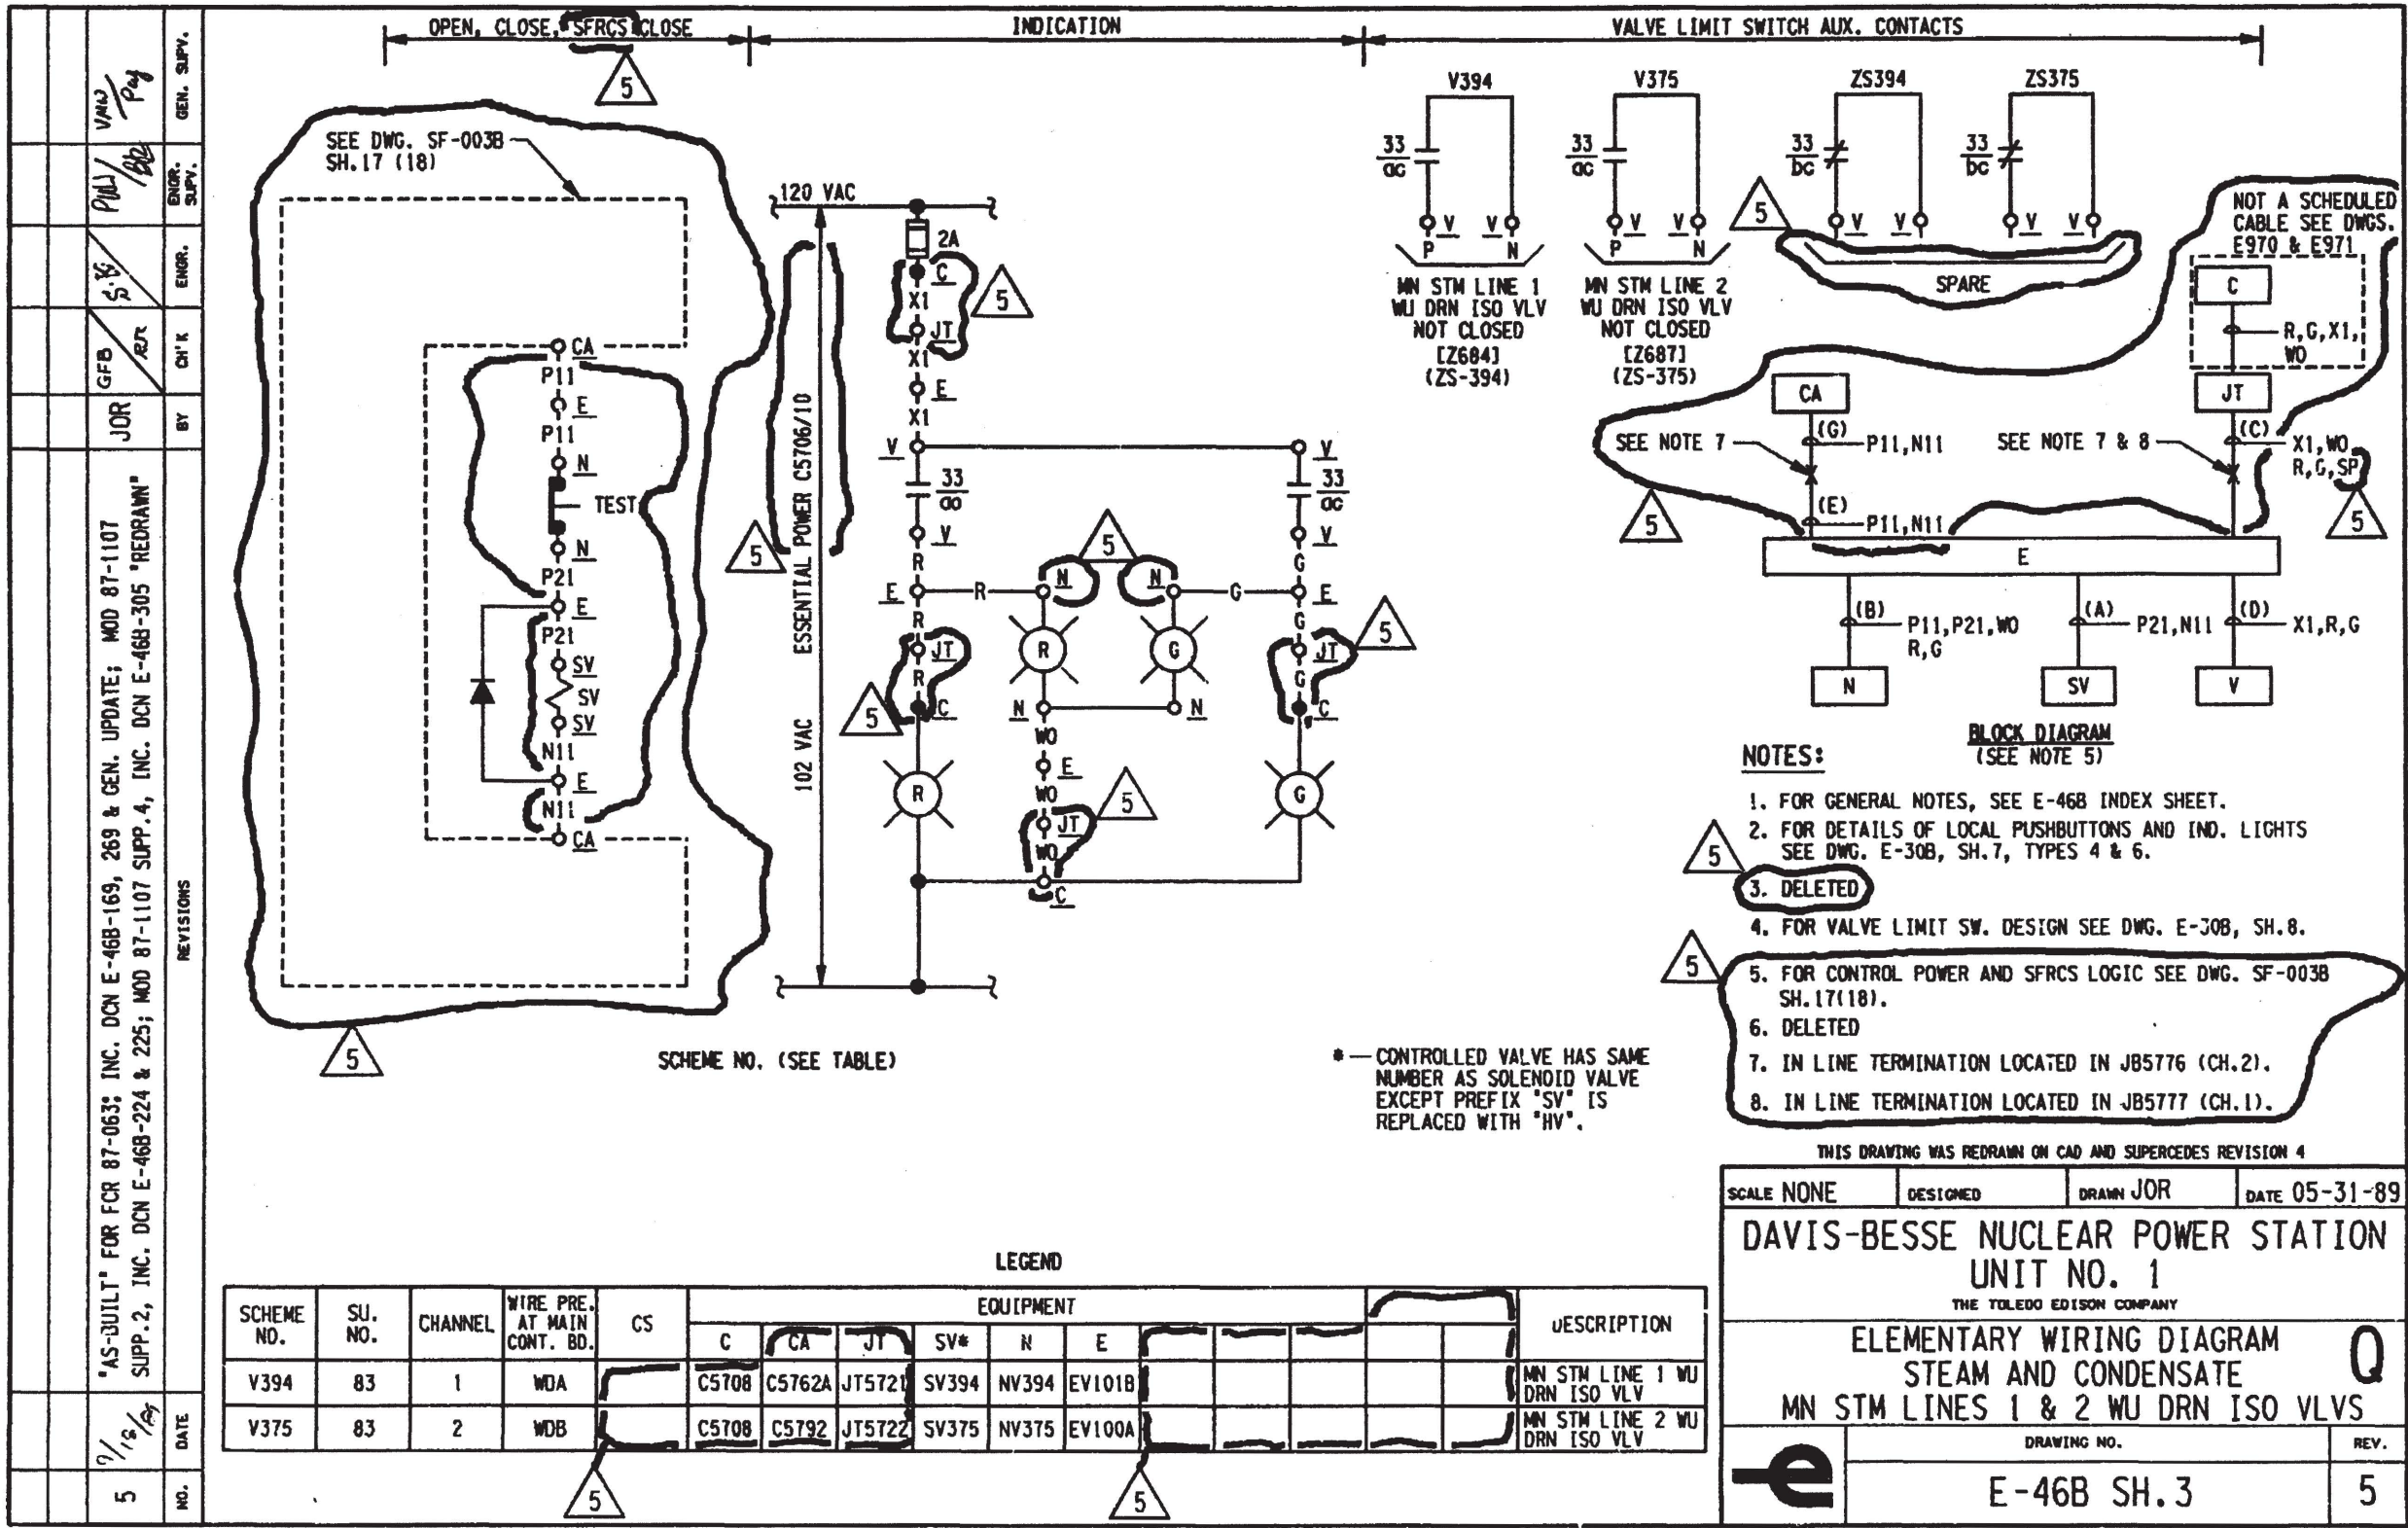


I CERTIFY THAT THE IMAGE CONTAINED ON THIS FRAME WAS MADE IN THE NORMAL AND REGULAR COURSE OF BUSINESS. ON THE DATE STATED BELOW AND THAT IT IS AN ACCURATE REPRODUCTION OF THE RECORD(S) SUBMITTED TO NUCLEAR RECORD MANAGEMENT.

DATE 9-19-87 OPERATOR [Signature]

16X

22	8/26/96	INC DCN E-46B-592 FOR DDR 95-2640 & E-46B-593 FOR MOD 93-0035-00		"INITIALS ON FILE"	
25	5.6.12	INC. DUN 11-0787-001-003 REV.00	SAC <i>sm</i>	—	—
24	04-16-10	INC. DUN 09-0588-001-003 REV.00		"INITIALS ON FILE"	
23	10-11-03	INC DCN E-46B-615 PER ECR 03-0026-00 REV.01 (CR 03-05956)		"INITIALS ON FILE"	
NO.	DATE	REVISIONS			
		BY	CH'K	ENGR.	ENGR. SUPV.
					GEN. SUPV.

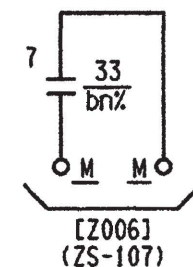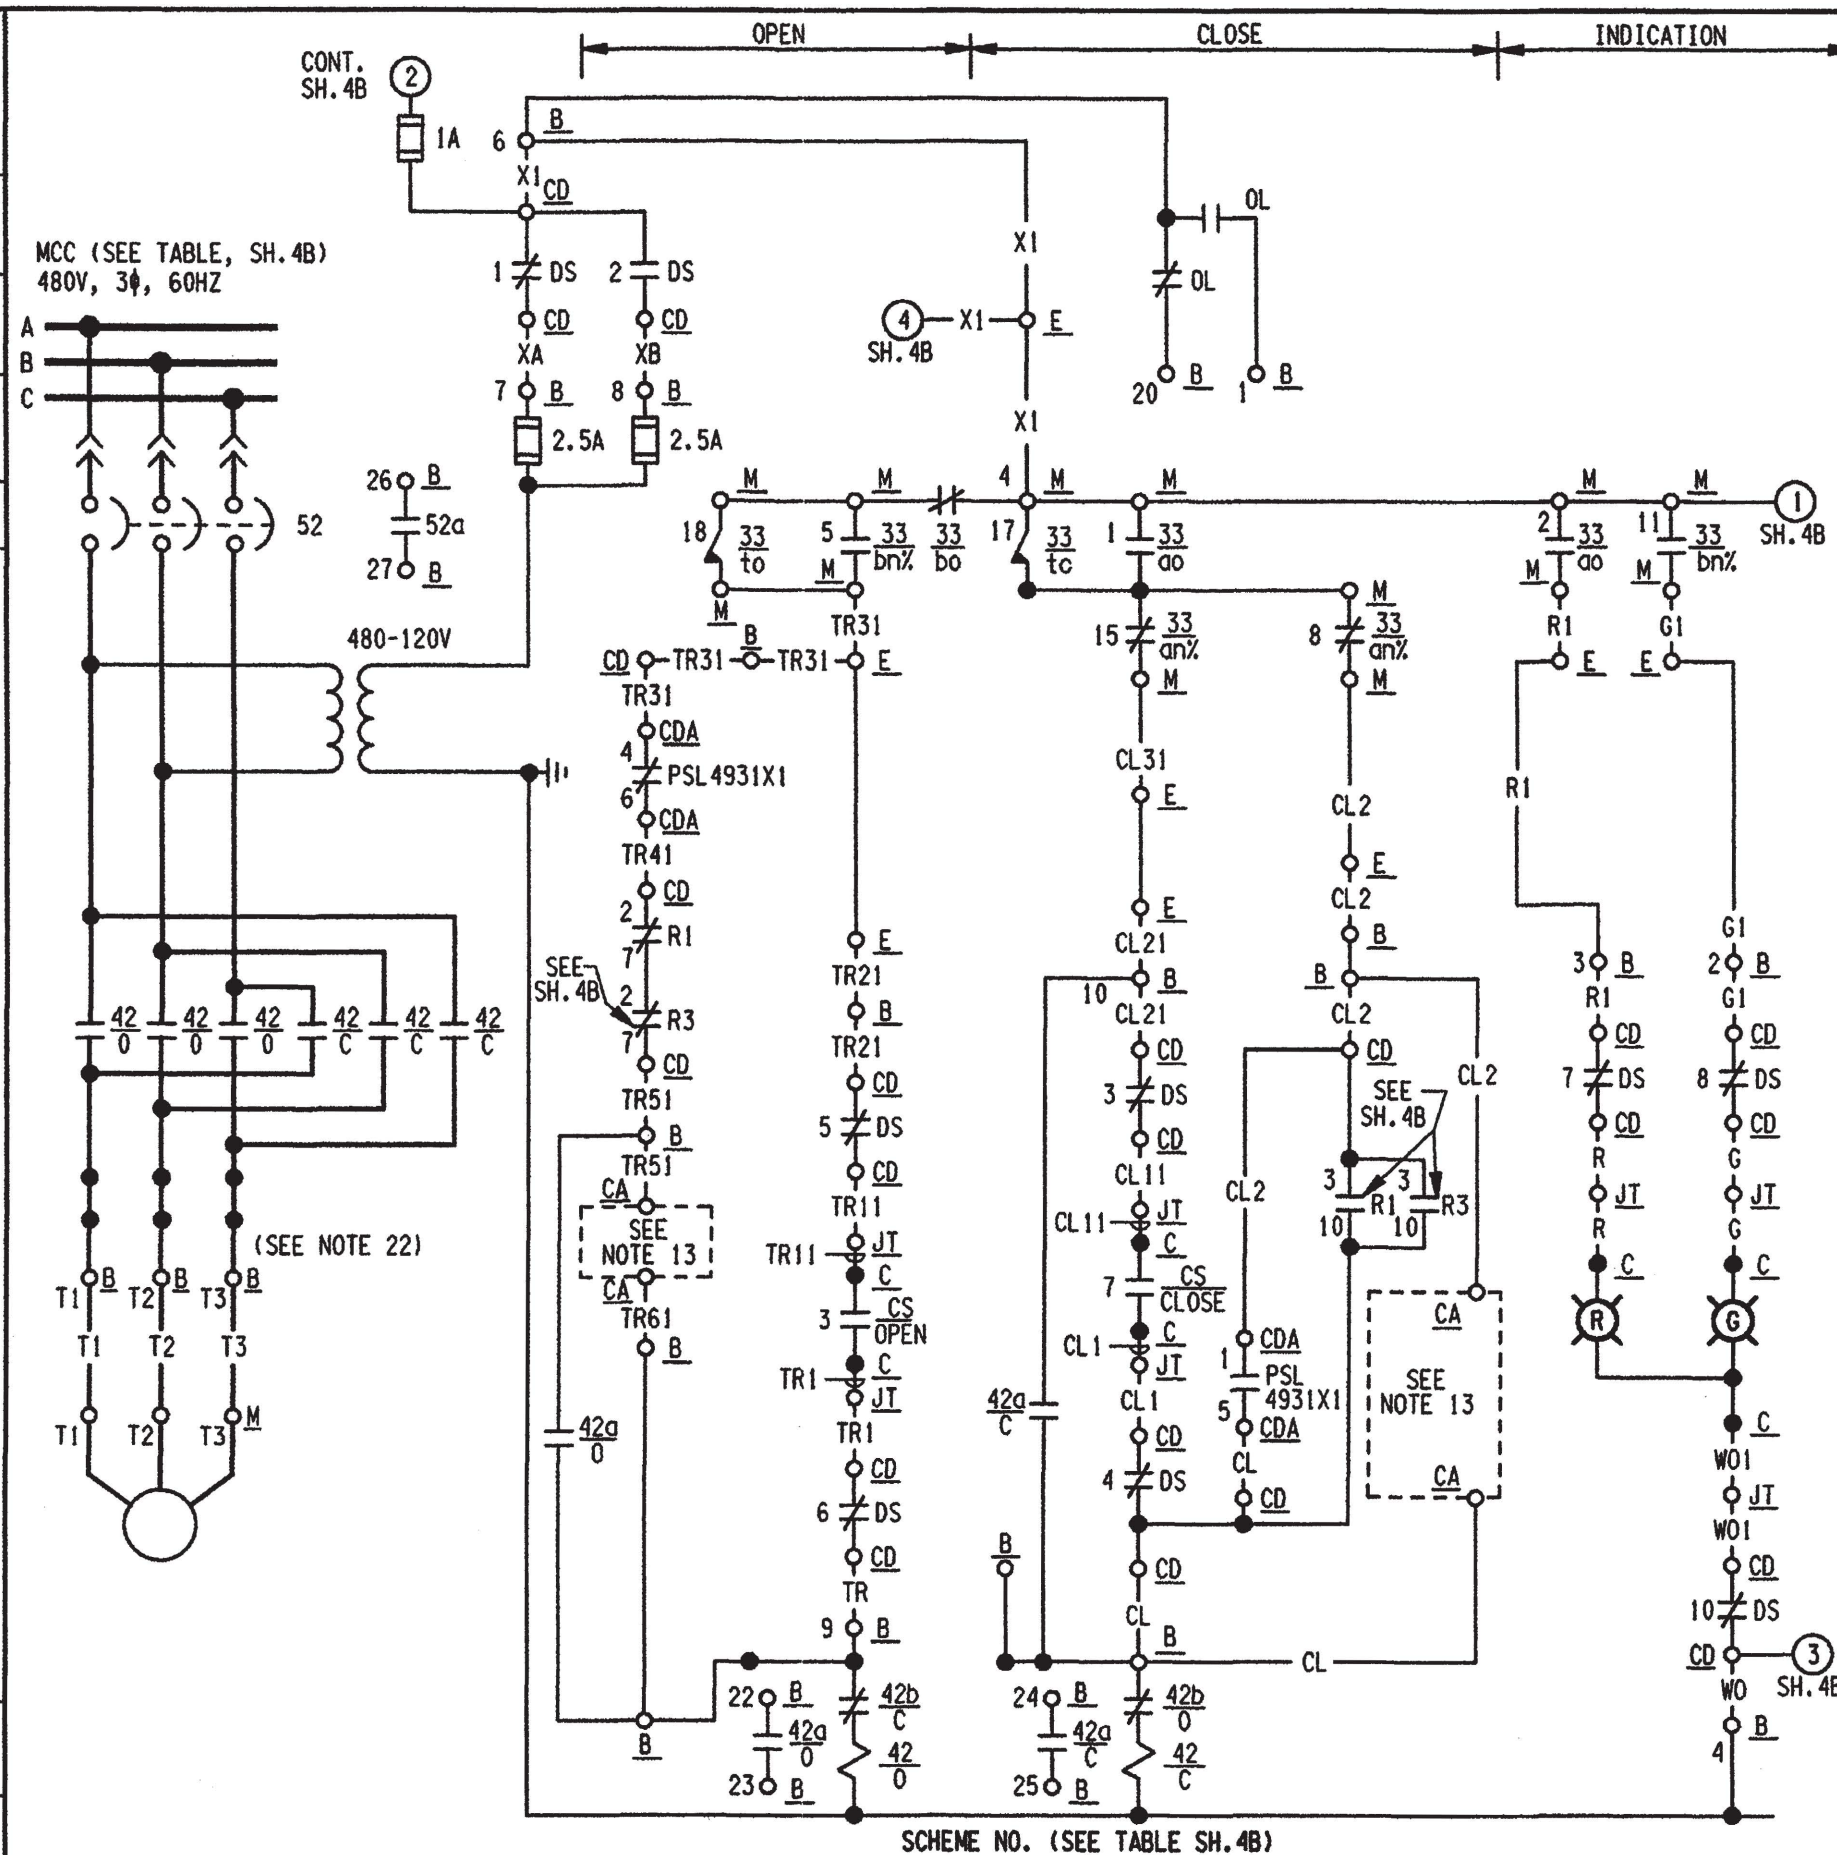


1. FOR LEGEND & BLOCK DIAG. SEE DWG. E-46B, SH.4B.
2. FOR GENERAL NOTES, SEE E-46B INDEX SHEET.
3. FIELD TO ADJUST ROTOR 4 SUCH THAT CONTACT 15 WILL PROVIDE SPECIFIED TARGET THRUST ON SEATING.
4. FOR C.S. DETAILS SEE DWG. E-30B SH.7, FIG.7.
5. FOR VLV LIMIT SWITCH DEV. SEE DWG. E-30B SH.8E, FIG.H (ALSO SEE NOTES 3, 6, AND 10 THIS SHEET).
6. FIELD TO ADJUST ROTOR 3 SUCH THAT CONTACT 11 CLOSES WHEN VALVE IS CLOSED, (I.E. AFTER HARD SEAT CONTACT)
8. DELETED
9. PSL4931A CONTACT CLOSES ON LOW PRESSURE AT AFP SUCTION.
10. FIELD TO ADJUST ROTOR #2 WITH SWITCH CONTACTS 5 THRU 8 TO ACTUATE WHEN VALVE REACHES 20% OPEN $\begin{matrix} +5\% \\ -0\% \end{matrix}$
13. FOR SFRCS BLOCK SWITCH AND SCHEMATIC SEE DWG. SF-003B SH.14.

(NOTES CONT'D ON SH. 4B)

THIS DRAWING WAS REDRAWN ON CAD AND SUPERCEDES REVISION 16

SCALE NONE	DESIGNED	DRAWN JOR	DATE 05-31-89
DAVIS-BESSE NUCLEAR POWER STATION UNIT NO. 1 THE TOLEDO EDISON COMPANY			
ELEMENTARY WIRING DIAGRAM STEAM AND CONDENSATE AUX FD PMPS TURBS MN STM IN ISO VLVS			Q
	DRAWING NO.		REV.
	E-46B SH. 4A		25

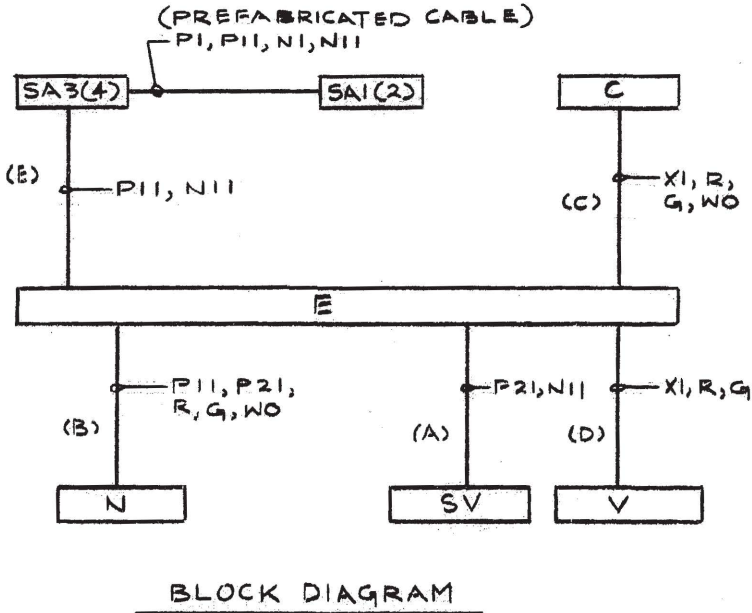
[illegible]

DAVIS-BESSE NUCLEAR POWER STATION

THE TOLEDO EDISON COMPANY
THE CLEVELAND ELECTRIC ILLUMINATING COMPANY

ELEMENTARY WIRING DIAGRAMS
STEAM & CONDENSATE
SG ATM STM VENT & SAMPLE VLV'S

BECHTEL COMPANY	JOB NO.	DRAWING NO.	REV.
	7749	E-46B SH.23B	9

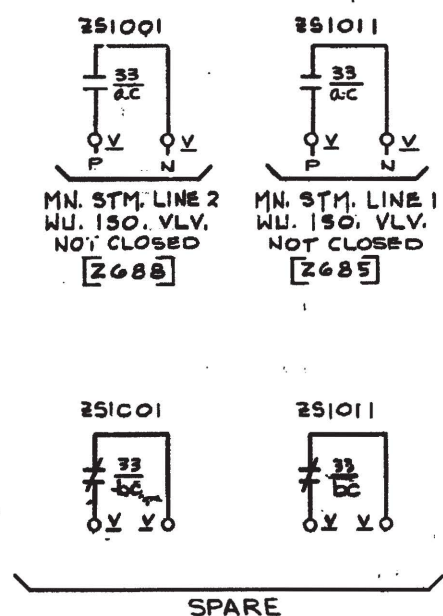

1. FOR LEGEND & BLOCK DIAG. SEE DWG. E-46B, SH.32B.
2. FOR GENERAL NOTES SEE DWG. E-46B INDEX SH.
3. FOR DETAILS OF LOCAL PUSHBUTTON AND IND. LIGHTS SEE DWG. E-30B, SH.7, TYPES 4 & 6.
4. DELETED
5. FOR VALVE LIMIT SW. DESIG. SEE DWG. E-30B, SH.8.
6. FOR CONTROL POWER AND SPRCS LOGIC DWG. SF-003 SH. 11 (12).
7. DELETED
8. IN LINE TERMINATION LOCATED IN JB 5777 (CH.1)

DAVIS-BESSE NUCLEAR POWER STATION THE TOLEDO EDISON COMPANY THE CLEVELAND ELECTRIC ILLUMINATING COMPANY			
ELEMENTARY WIRING DIAGRAMS STEAM & CONDENSATE MN. STM. LINES WU. ISO. VLV'S.			
 BECHTEL COMPANY	JOB NO. 7749	DRAWING NO. E-46B SH.32A	REV. 5

DATE 9-19-89 OPERATOR

OPERATOR

1950

16X

BLOCK DIAGRAM

NOT A SCHEDULED
CABLE SEE DWG.
E970 & E971.

NOTES:
1. FOR NOTES SEE SHEET 32A

DAVIS-BESSE NUCLEAR POWER STATION

THE TOLEDO EDISON COMPANY
THE CLEVELAND ELECTRIC ILLUMINATING COMPANY

**ELEMENTARY WIRING DIAGRAMS:
STEAM & CONDENSATE
MN. STM. LINES WU, ISO. VLV'S.**

**BECHTEL
COMPANY**

JOB NO.

DRAWING NO.

REV.

7749

E-46 B SH.32 B

16


I CERTIFY THAT THE IMAGE CONTAINED ON THIS FRAME WAS MADE IN THE NORMAL AND REGULAR COURSE OF BUSINESS, ON THE DATE STATED BELOW AND THAT IT IS AN ACCURATE REPRODUCTION OF THE RECORD(S) SUBMITTED TO NUCLEAR RECORDS MANAGEMENT.

DATE **9-19-89**


OPERATOR

Stacy Smith

16X

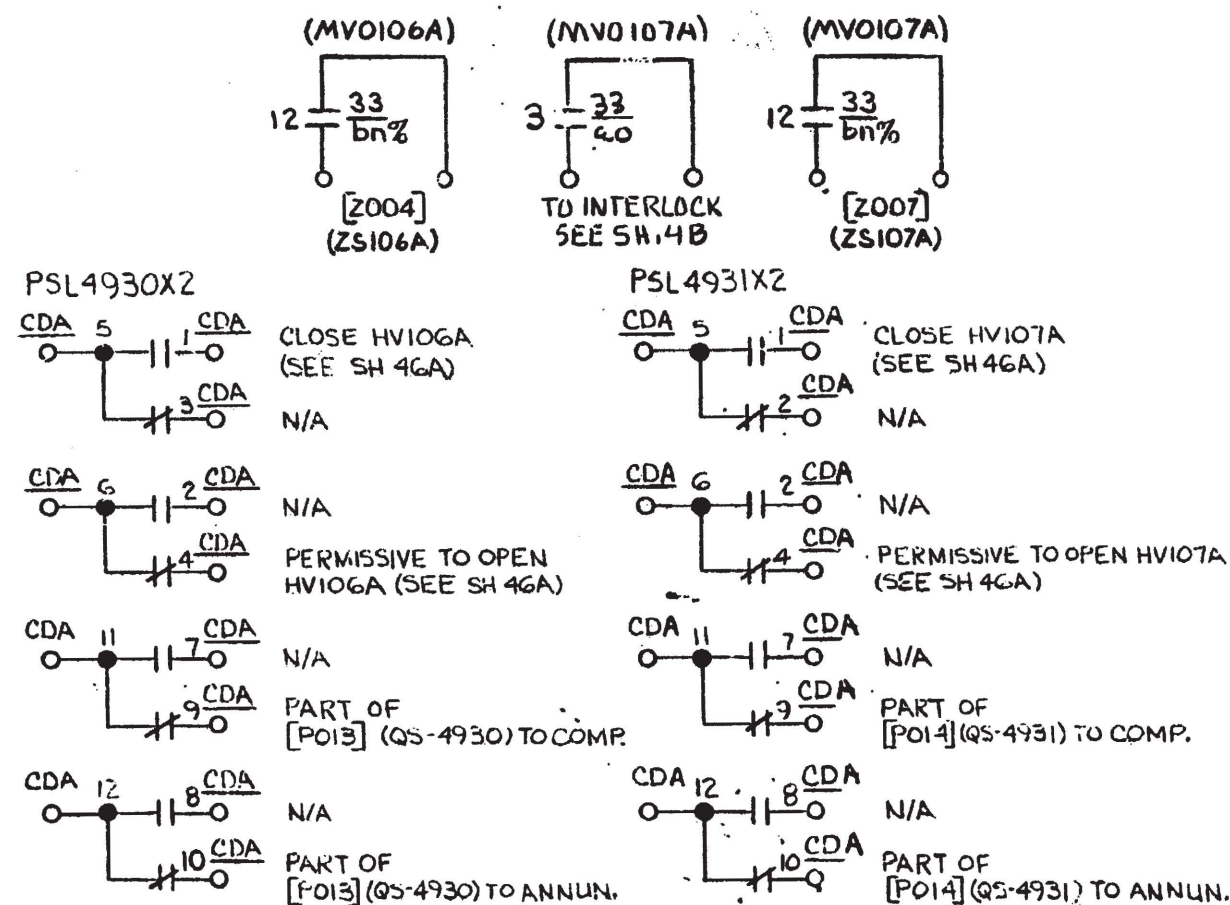

SCHEME NO	MCC	SU NO	CH	WIRE PREFIX	CS	EQUIPMENT NUMBERS														DESCRIPTION
						C	CD	CDA	B	M	E		CA	FI	JT					
BE1271	E12B	50A	1	STM	HIS106E	C5706	CDE12B	CDE11C	BE1271	MNO106A	EVO106A		C5762A	PSL47430E	JT5721			SG2 TO AFPT 1 ISO VLV		
BF1188	F11B	50A	2	STN	HIS107E	C5709	CDF11B	CDF11A-2	BF1188	MNO107A	EVO107A		C5792	PSL47431B	JT5722			SG1 TO AFPT 2 ISO VLV		

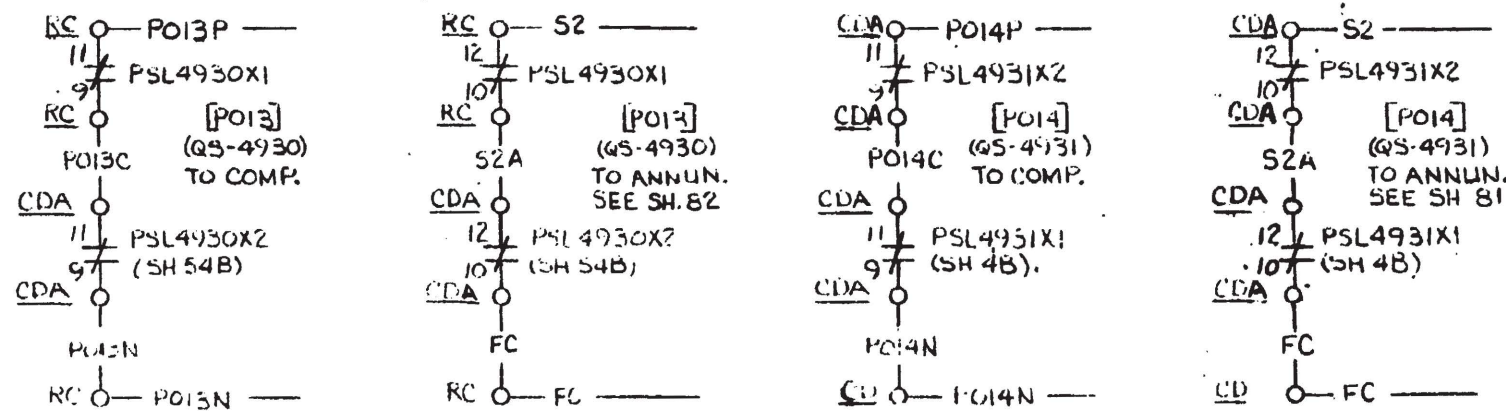

DAVIS-BESSE NUCLEAR POWER STATION THE TOLEDO EDISON COMPANY THE CLEVELAND ELECTRIC ILLUMINATING COMPANY			
ELEMENTARY WIRING DIAGRAM STEAM AND CONDENSATE SG AFPT ISO VLV			
 BECHTEL COMPANY	JOB NO.	DRAWING NO.	REV.
	7749	E46B SH46B	17

INDEX			
SHEET NO.	LATEST REV.	DESCRIPTION	
1A	74 13	CIRCULATING WATER PUMP	
1B	15	CIRCULATING WATER PUMP	
1C	8	CIRCULATING WATER PUMP	
2A	6	CIRCULATING WATER PUMP DISCH. VLV'S	
2B	8	CIRCULATING WATER PUMP DISCH. VLV'S	
2C	10	CIRCULATING WATER PUMP DISCH. VLV'S	
3A	7	COOLING TOWER MAKE-UP PUMP	
3B	9	COOLING TOWER MAKE-UP PUMP	
4	9	COOLING TOWER MAKE-UP PUMP STRAINERS	
5	6	COOLING TOWER MAKE-UP PUMP BACK WASH VALVES	
6A	11	SERVICE WATER PUMP 1	Q
6B	13	SERVICE WATER PUMP 1 (AC 107)	Q
6C	5	SERVICE WATER PUMP 2	Q
6D	5	SERVICE WATER PUMP 2 (AD 107)	Q
7	15	SERVICE WATER PUMP STRAINERS 1-2	Q
7A	2	SERVICE WATER PUMP STRAINER 1-1	Q
7B	1	SERVICE WATER PUMP STRAINER 1-3	Q
8	13	SERVICE WATER PUMP STRAINERS 1-2 & 1-3 DRAIN VLV	Q
8A	1	SERVICE WATER PUMP STRAINER 1-1 DRAIN VLV	Q
9A	14	SW ISO VLV'S TO CLNG WTR (MOV'S) 1395	Q
9B	9	SW ISO VLV'S TO CLNG WTR (MOV'S) 1399	Q
10	1	DELETED	
11A	14	SERVICE WATER PUMP 3 CH.1	Q
11B	16	SERVICE WATER PUMP 3 (AC 109)	Q
11C	11	SERVICE WATER PUMP 3 XFER BRKR	Q
11D	6	SERVICE WATER PUMP 3 XFER BRKR	Q
11E	5	SERVICE WATER PUMP 3 CH.2	Q
11F	4	SERVICE WATER PUMP 3 (AD 109)	Q
12	6	CTMT AIR CLR'S 1-2 IN ISO VLV (MOV)	Q
12A	74 1	CTMT AIR CLR'S 1-1 IN ISO VLV (MOV)	Q
13	8	CTMT AIR CLR'S 1-1 & 1-2 OUTLET VLV'S (SOV'S)	Q
14A	8	CTMT AIR CLR'S 1-3 IN ISO VLV (MOV)	Q
14B	6	CTMT AIR CLR'S 1-3 IN ISO VLV (MOV)	Q
14C	7	CTMT AIR CLR'S 1-3 IN ISO VLV (MOV)	Q
15	12	ECCS RM CLR'S OUT VLV'S (MOV'S) DWG. VOID	Q
16	1	DELETED	

GENERAL NOTES:

- 1. FOR EXPLANATION OF EQUIPMENT, WIRING AND SCHEME NUMBERS SEE E-11A, ELECTRICAL NUMBERING SYSTEMS.
- 2. FOR MOTOR INFORMATION SEE E-12B, ELECTRICAL MOTOR LIST.
- 3. FOR CONTROL PANEL, JUNCTION BOX & TERMINAL BOX DESCRIPTION SEE E-13B, ELECTRICAL EQUIPMENT LIST.
- 4. WIRE NUMBER PREFIX MUST BE ADDED TO FORM COMPLETE WIRE NUMBER FOR THOSE WIRES AT MAIN CONTROL BOARD.
- 5. AUX. CONTROL RELAY IN SOLENOID OPERATED VALVE CONTROL CIRCUIT TO BE COUCH RELAY TYPE 4AP44-AF.
- 6. NUMBERS IN BRACKETS [] REPRESENTS COMPUTER INPUT NUMBER. NUMBER IN PARENTHESIS () REPRESENTS COMPUTER INPUT SOURCE NUMBER.

BLOCK DIAGRAM DESIGNATIONS:

- A - 4.16 KV SYSTEM SWITCHGEAR
- B - 480V SYSTEM MOTOR CONTROL CENTER
- C - MAIN CONTROL BOARD
- CA - LOCAL CONTROL CABINET
- E - LOCAL DISTRIBUTION TERMINAL BOX
- H - 13.8 KV SYSTEM SWITCHGEAR
- M - MOTOR
- N - LOCAL CONTROL STATION
- P - PENETRATION TERMINAL BOX
- RC - AUXILIARY RELAY CABINET

REFERENCE DRAWINGS:

- E-5 SH.1 THRU 5 - 480V MCC (NON-ESSENTIAL) ONE LINE DIAGRAM
- E-6 SH.1 & 2 - 480V MCC (ESSENTIAL) ONE LINE DIAGRAM
- E-10A - STANDARD NOTES AND SYMBOLS
- E-14B - SOLENOID VALVE LIST
- E-30B - GENERAL GUIDES - ELEMENTARY DIAGRAM

THIS DRAWING WAS REDRAWN ON CADD AND SUPERSEDES REVISION 64.

SCALE NONE	DESIGNED	DRAWN EAL	DATE 04-13-04
DAVIS-BESSE NUCLEAR POWER STATION UNIT NO. 1 THE TOLEDO EDISON COMPANY			
ELEMENTARY WIRING DIAGRAMS LAKE WATER SYSTEM DRAWING INDEX			
DRAWING NO. E-48B SH.1			REV. 74


FOR CONTINUATION OF INDEX SEE SH.2.

74	05/12/16	REVISED SH.1A (REV.13), SH.12A (REV.1) & SH.34 (REV.7)	SAP <i>AP</i>	<i>GBW</i>	—	SML	—
73	02/08/14	REVISED SH.13 (REV. 8), SH.33A (REV.7), SH. 33C, 34 & 37A (REV. 6), & SH. 37D (REV. 3).			INITIALS ON	FILE	
72	08/15/13	REVISED SH.7 (REV.15), SH.7B (REV.1), SH.11C (REV.11), SH.37D (REV.2), SH.50 (REV.6) & SH.51 (REV.5) & GEN. UPDATE ADD SH.7B TO INDEX & CORRECT SH.7A (IND. SH.1) REMOVE 1-3, NOW ON NEW SH.7B BOTH PER REVIEW OF ASSOC. DWG. & FILENET			INITIALS ON	FILE	
71	8/14/12	REVISED SH.7 (REV.14), SH.7A (REV.2), SH.31A (REV.13), SH.33A (REV.6), SH.33B (REV.4) & SH.50 (REV.5)			INITIALS ON	FILE	
70	7/14/09	REVISED SH.7A & 8A (REV.1), SH.36 (REV.7) & SH.50 & 51 (REV.4)			INITIALS ON	FILE	
69	02/29/08	REVISED SH. 11C (REV.10), & SH. 19 (REV.6)			INITIALS ON	FILE	
68	05/22/06	REVISED SH. 38 (REV.7)			INITIALS ON	FILE	
67	02/20/06	REVISED SH'S. 13 (REV.7), 30 (REV.11), 33A (REV.5)& 33B (REV.3)			INITIALS ON	FILE	
66	09/15/05	REVISED SH'S. 1A & 31A (REV.12), SH.1B (REV.15), SH.1C (REV.8), SH.2C & 30 (REV.10), SH.9A (REV.14), SH.9B (REV.9) & SH.13 (REV.6)			INITIALS ON	FILE	
65	10/5/04	REVISED SH'S. 7, 8, 9A & 28 (REV.13); SH'S. 12, 14B, 36 (REV.6); SH'S. 9B & 14A (REV.8); SH'S. 14C, 18 & 46B (REV.7); SH. 35 (REV.4); SH'S. 50 & 51 (REV.3), AND GEN. UPDATE ADDED SH'S. 7A, 8A, 12A (REV.0) TO INDEX PER DWG. SPLIT FOR DCN UPDATE AND REVISED DWG. TITLE FOR SH'S. 7, 8, 9A, 9B, 12 & 28.			INITIALS ON	FILE	
REV	DATE	DESCRIPTION	BY	CH'K	ENGR.	ENGR. SUPV.	GEN. SUPV.

FOR GENERAL NOTES AND REFERENCE DRAWINGS
SEE DRAWING E-48B DRAWING INDEX SH.1.

THIS DRAWING WAS REDRAWN ON CADD AND SUPERSEDES REVISION 64.


SCALE NONE	DESIGNED	DRAWN EAL	DATE 04-13-04
DAVIS-BESSE NUCLEAR POWER STATION UNIT NO. 1 THE TOLEDO EDISON COMPANY			
ELEMENTARY WIRING DIAGRAMS LAKE WATER SYSTEM DRAWING INDEX			
DRAWING NO. E-48B SH.3			REV. 74

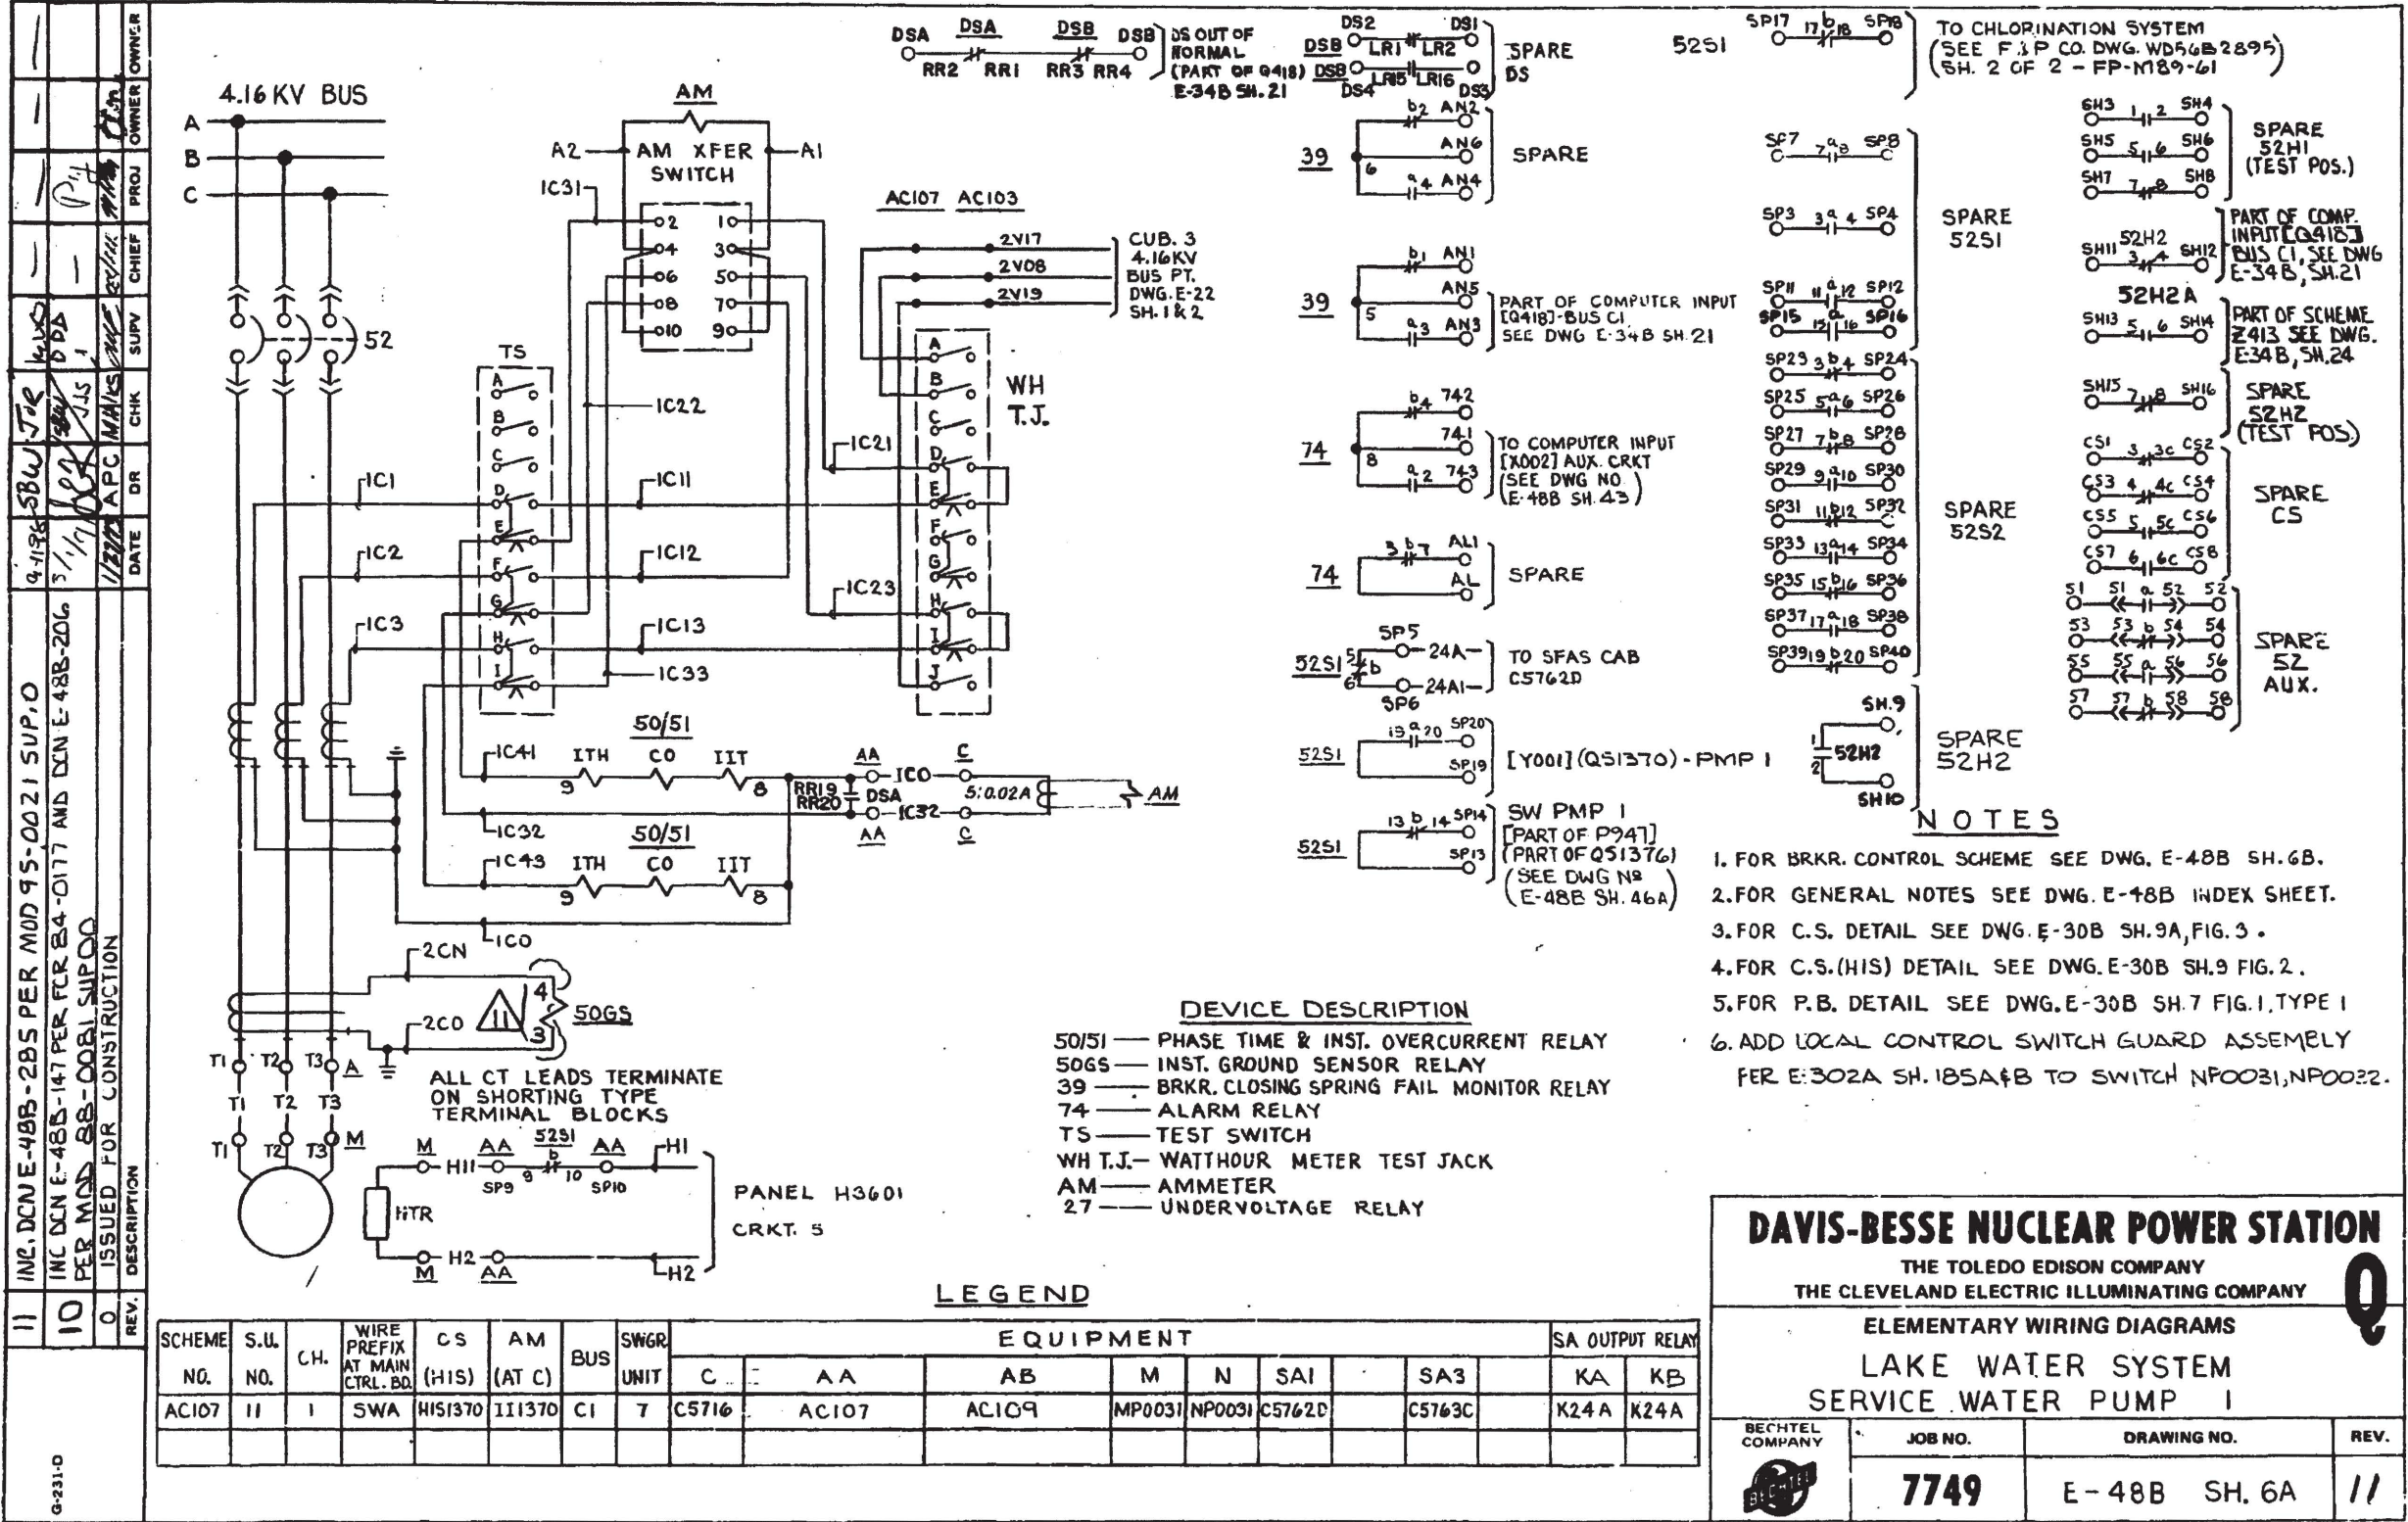

I CERTIFY THAT THE IMAGE CONTAINED ON THIS FRAME WAS MADE IN THE NORMAL AND REGULAR COURSE OF BUSINESS, ON THE DATE STATED BELOW AND THAT IT IS AN ACCURATE REPRODUCTION OF THE RECORD(S) SUBMITTED TO NUCLEAR RECORDS MANAGEMENT, DAVIS-BESSE N.P.S.

DATE: 10/10/00 OPERATOR: Dorothy Wiedle



16X

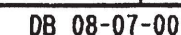


OR King's College 16X



SCHEME NO.	MCC	S.U. NO.	CHANNEL NO.	EQUIPMENT								DESCRIPTION
				B	M	CA	E	FA	FB	FC	RC	
BF1274	F12C	11	2	BF1274	MF0152	C3018	EV13800	FPSH2918	FPDIS1380A	FPSH2918A	RC3014	SW STRAINER 1-2
												15

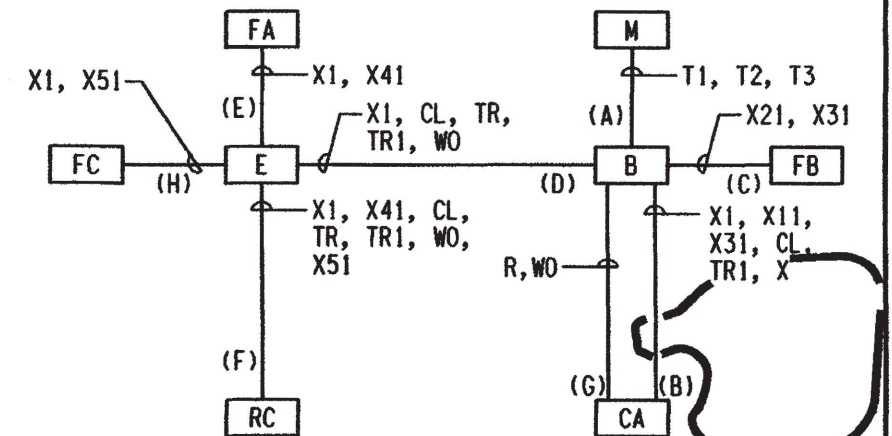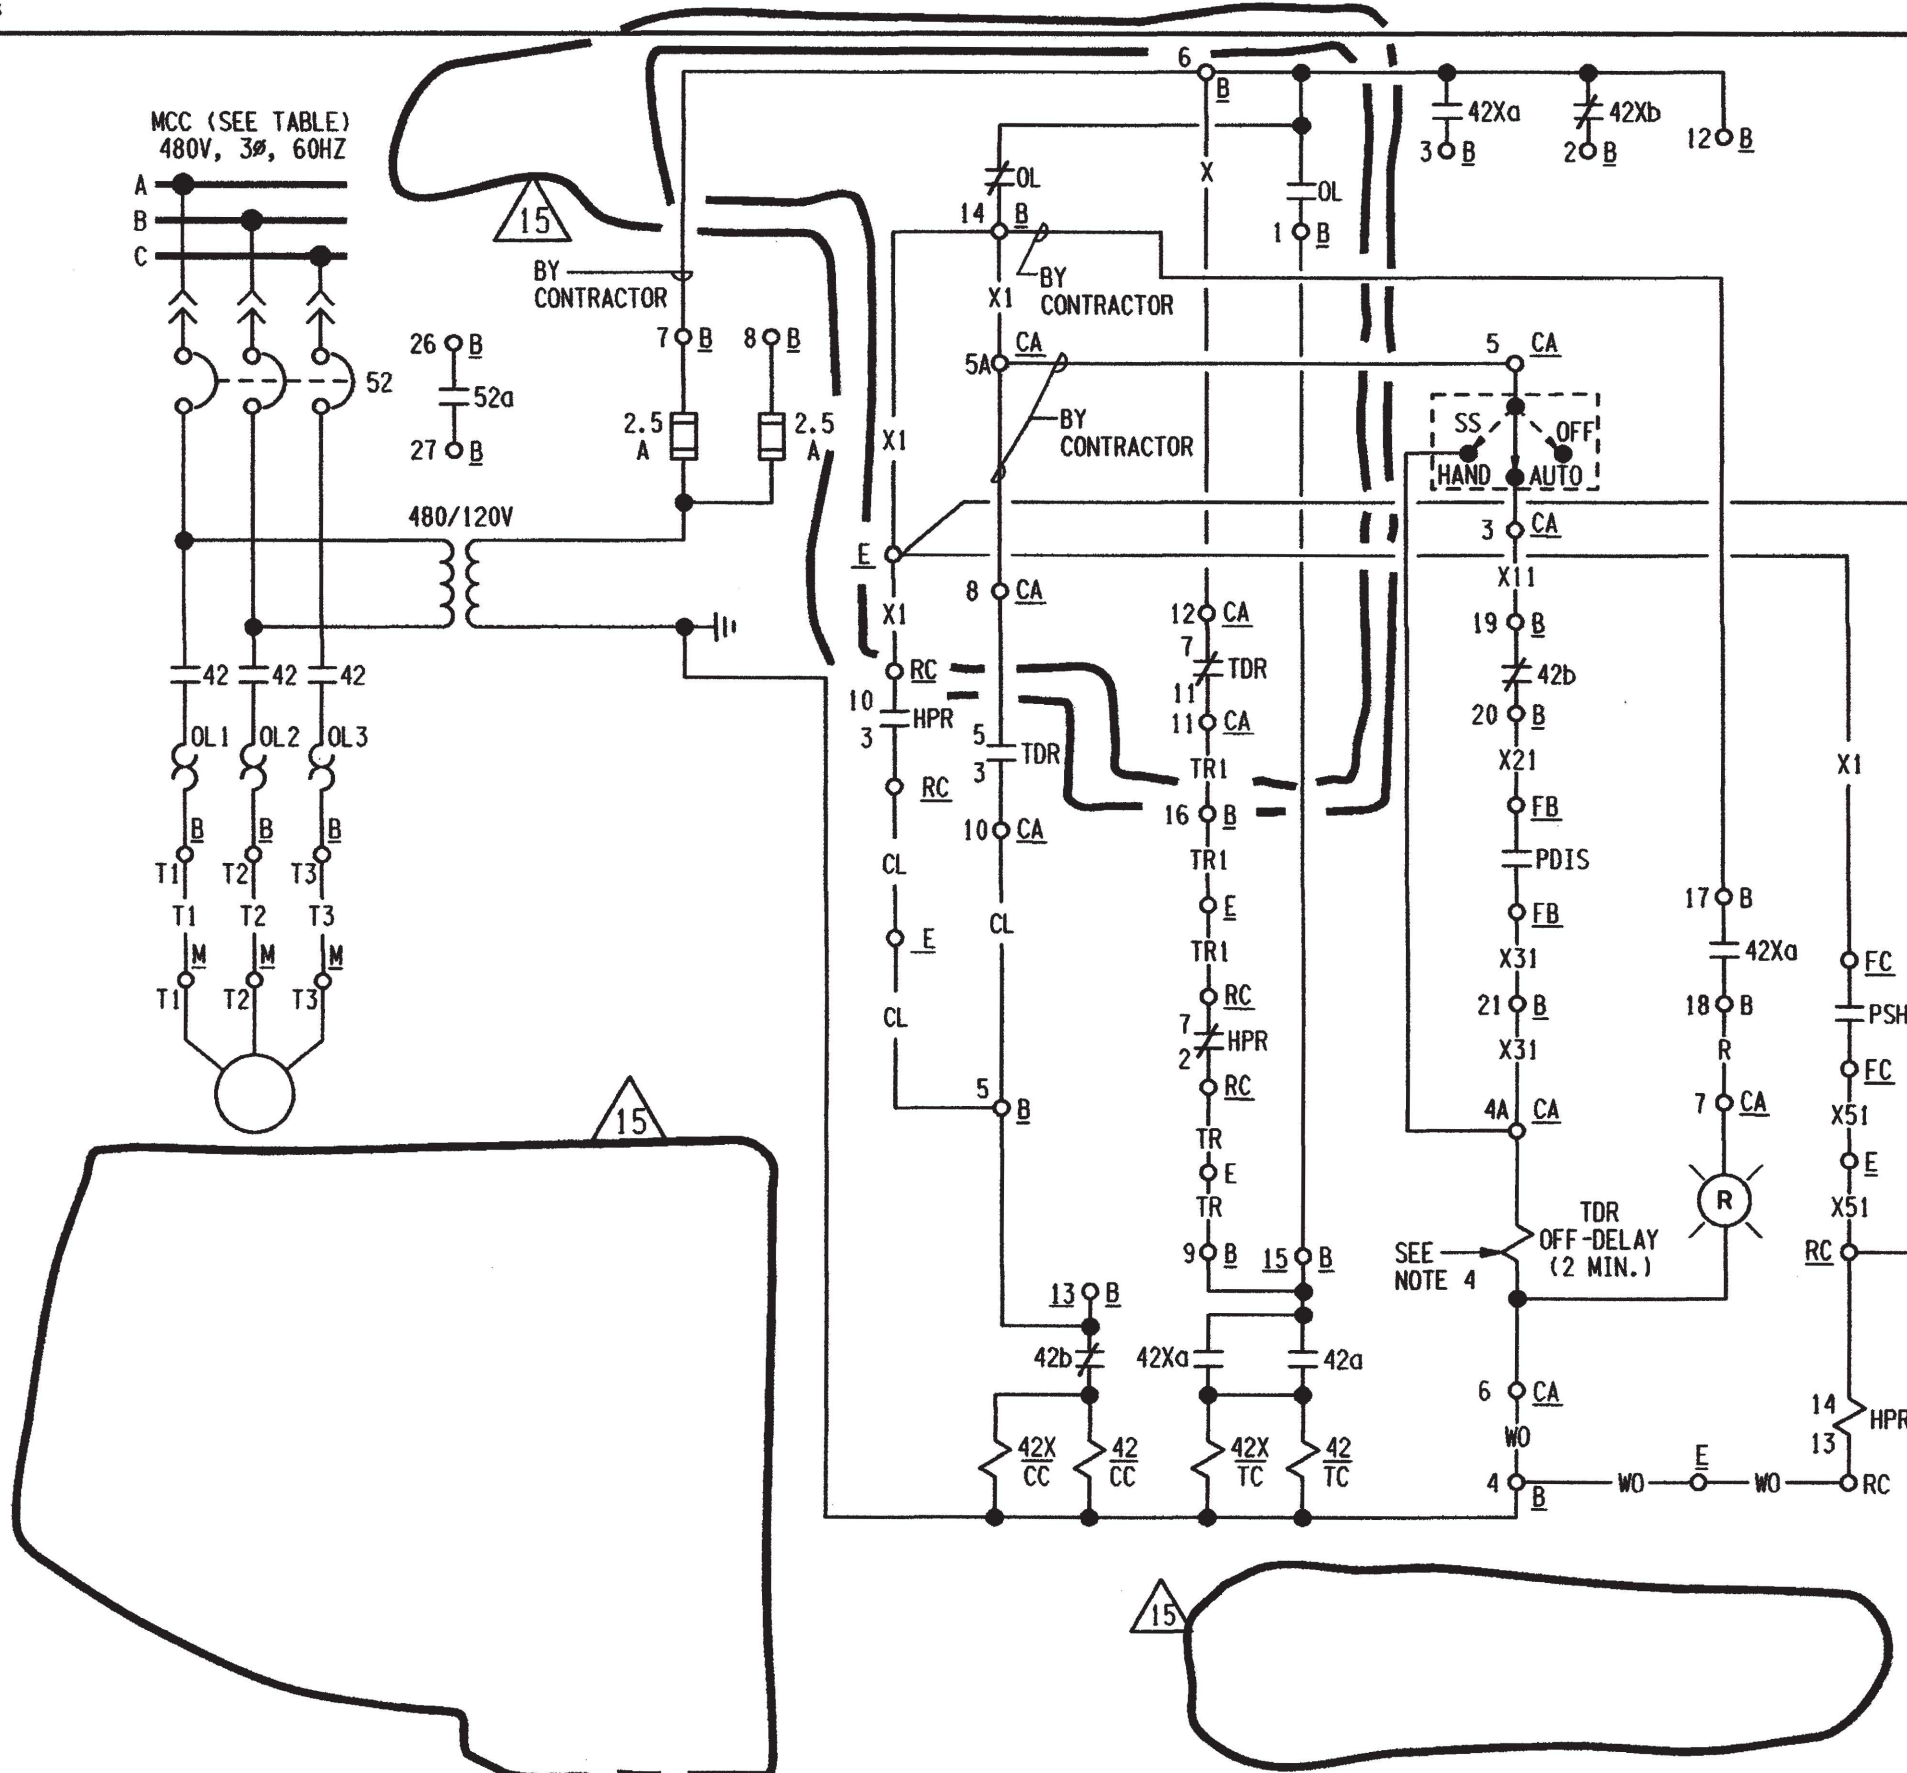

BLOCK DIAGRAM

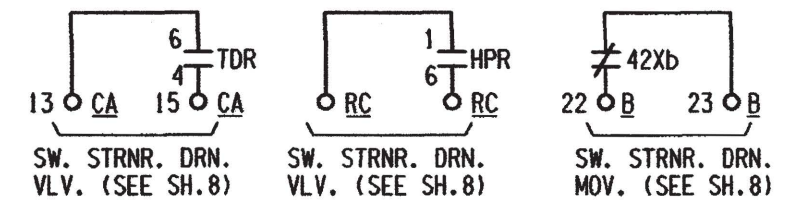


NOTES

1. FOR GENERAL NOTES SEE DWG. E-48B INDEX SHEET.
2. TDR CHANGES CONTACT POSITION ON HIGH DIFF. PRESS. ACROSS STRAINER ON "AUTO", RESETS AT NORMAL DIFF. PRESS.; PSH CONTACT OPENS ON DECREASING PRESS. AT STRAINER. PSHA CLOSSES ON INCREASING PRESS. ON STRAINER.
3. DELETED
4. DELETED
5. RELAY 42X IS A POTTER & BRUMFIELD MDR RELAY AND HAS 8 PDT CONTACTS. FOR SPARE CONTACTS SEE DWG'S. E-8-78 & E-8Q-165.
6. FOR SCHEME NO. BE1274 SERVICE WATER STRAINER 1-1 SEE DWG. E-48B SH.7A.
7. FOR SCHEME NO. BEF124 SERVICE WATER STRAINER 1-3 SEE DWG. E-48B SH.7B.


THIS DRAWING WAS REDRAWN ON CADD AND SUPERSEDES REVISION 12

SCALE NONE	DESIGNED	DRAWN EAL	DATE 04-15-04
DAVIS-BESSE NUCLEAR POWER STATION UNIT NO. 1 THE TOLEDO EDISON COMPANY			
ELEMENTARY WIRING DIAGRAM LAKE WATER SYSTEM SERVICE WATER PUMP STRAINERS 1-2			
	DRAWING NO.		REV.
	E-48B SH. 7		15


2	8/14/12	INC. DUN 10-0192-001-001 REV.00	SBW	SC	—	82	—
	7-15-04	GEN. UPDATE FOR ECR 03-0507-00 REV.1 PER DCN E-48B-440, ECR 03-0335-00 REV.4 PER DCN E-48B-438 AND ECR 03-0507-00 REV.2 PER DCN E-48B-478 (CR 03- 10201CA1) AND ADD NOTE 6 REF. IN D65 VOLTAGE MONITOR RELAY BOX FOR CLARITY.		INITIALS ON FILE			
0							
NO.	DATE	REVISONS	BY	CH'K	ENGR.	ENGR. SUPV.	GEN. SUPV.

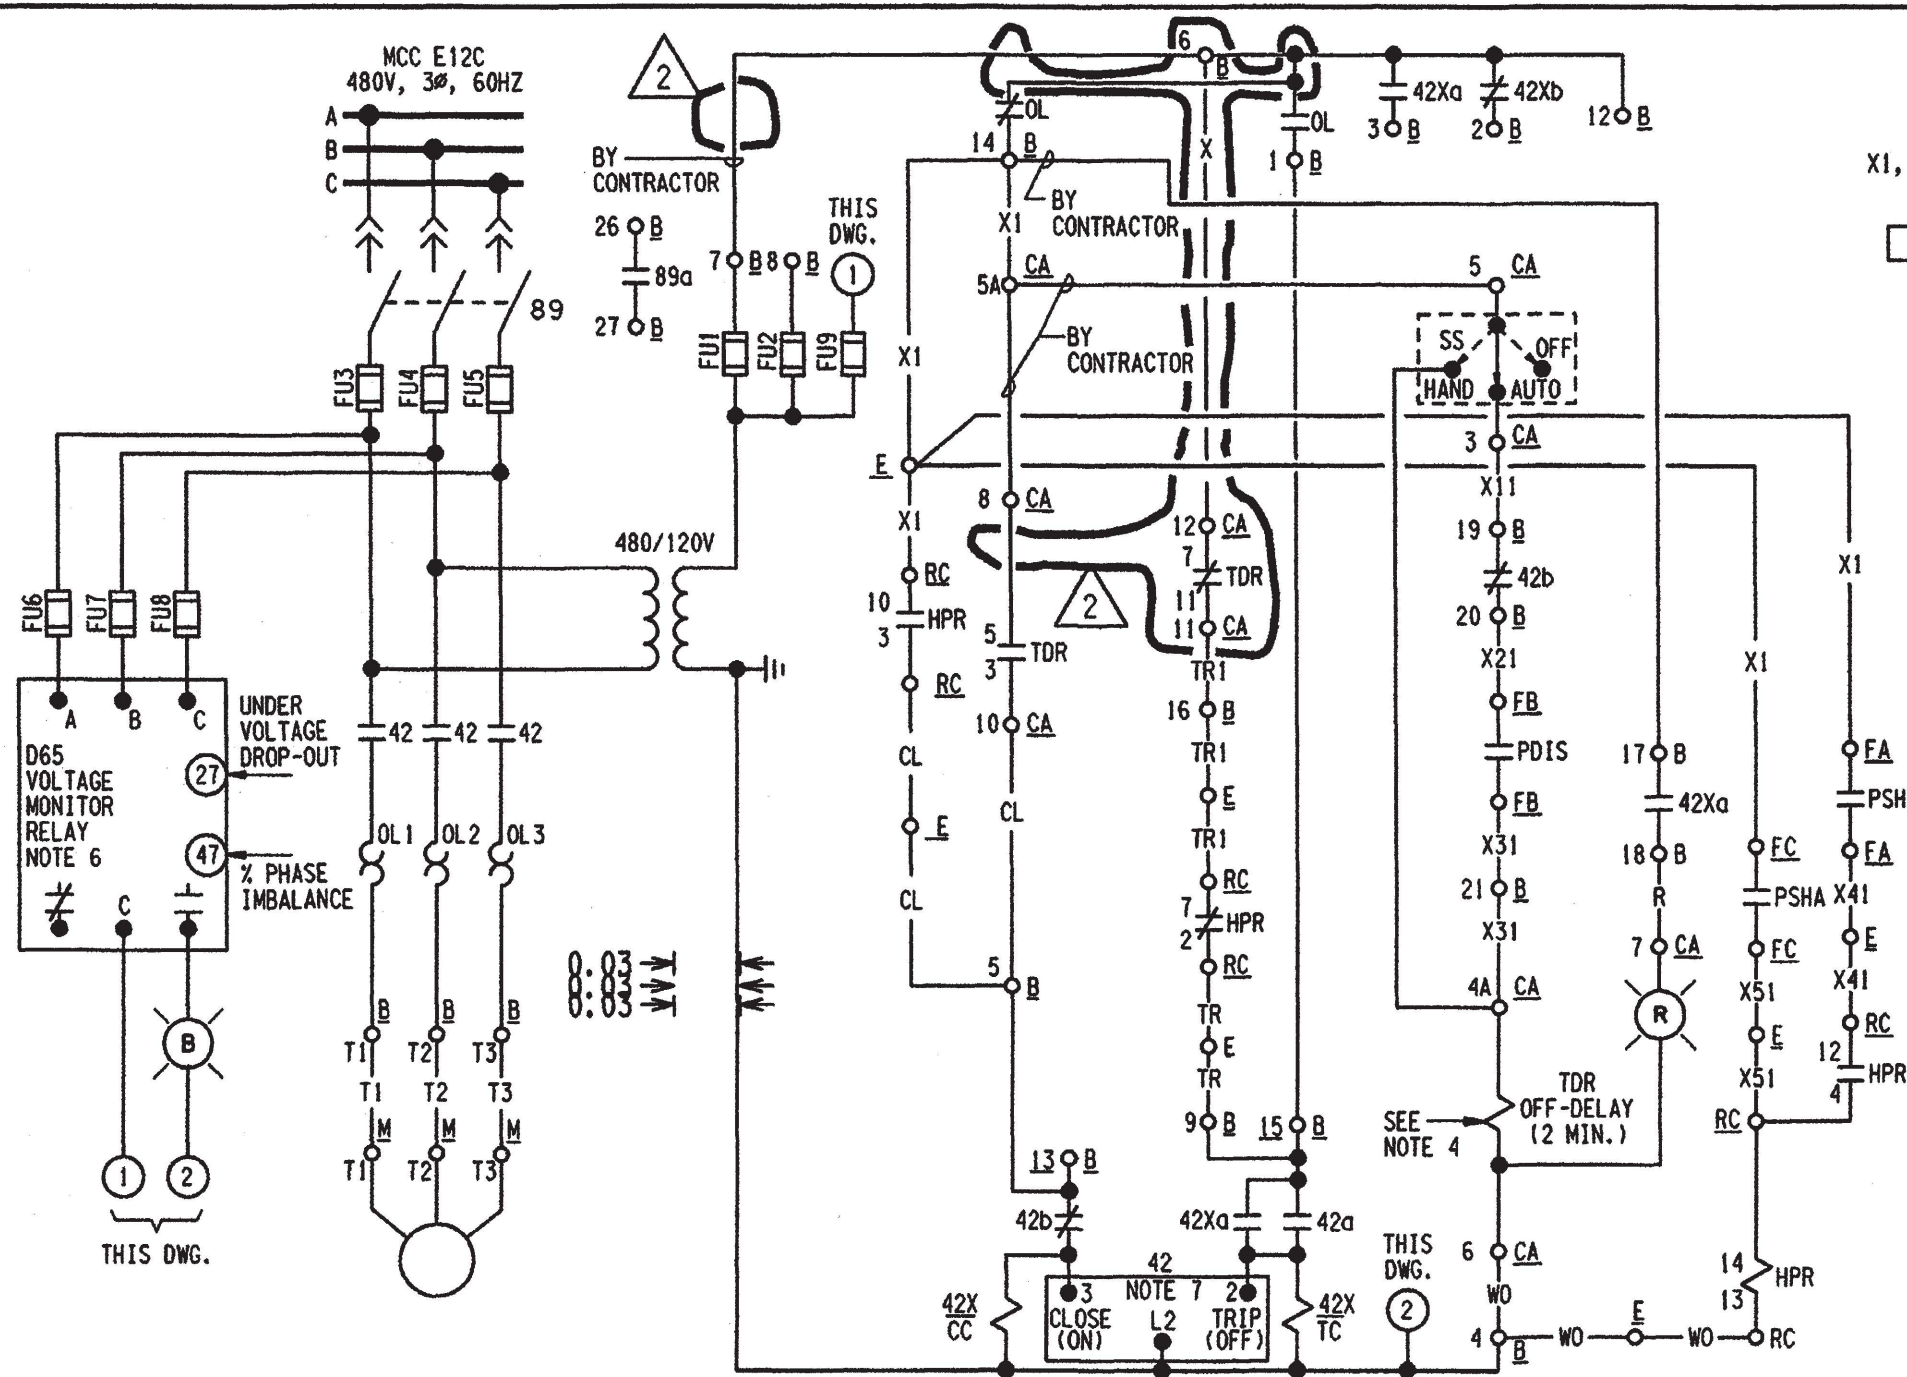

SCHEME NO. BE1274

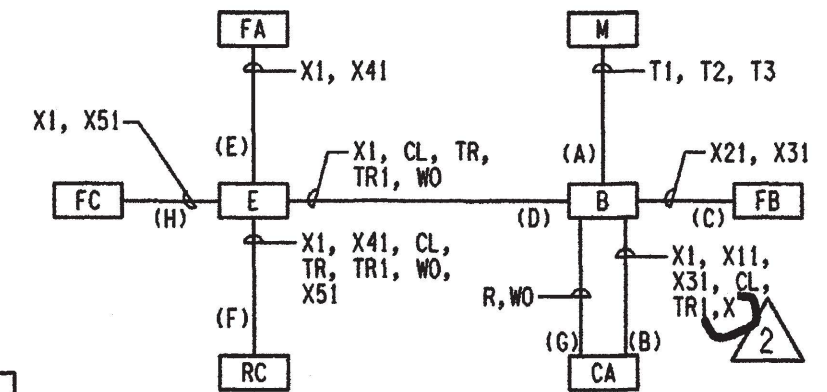

BLOCK DIAGRAM

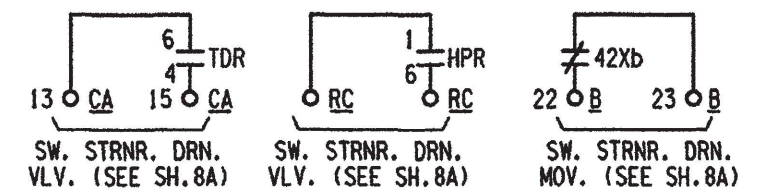



NOTES

1. FOR GENERAL NOTES SEE DWG. E-48B INDEX SHEET.
2. TDR CHANGES CONTACT POSITION ON HIGH DIFF. PRESS. ACROSS STRAINER ON "AUTO", RESETS AT NORMAL DIFF. PRESS.; PSH CONTACT OPENS ON DECREASING PRESS. AT STRAINER. PSHA CLOSING ON INCREASING PRESS. ON STRAINER.
3. DELETED
4. DELETED
5. RELAY 42X IS A CUTLER-HAMMER D26.
6. CONTACTS ARE SHOWN IN SHELF (DE-ENERGIZED) STATE. SEE RELAY SETTING MANUAL FOR SET POINTS. (ECR 03-0507-00)
7. REFERENCE E-008Q-00181 FOR STARTER INTERNALS.
8. 42 DEVICES CONTAIN CONTACTS THAT MAY CHATTER DURING A SEISMIC EVENT (SEE ECP 08-0709 FOR DETAILS).

SCHEME NO.	MCC	S.U. NO.	CHANNEL NO.	EQUIPMENT								DESCRIPTION
				B	M	CA	E	FA	FB	FC	RC	
BE1274	E12C	11	1	BE1274	MF0151	C3017	EV13790	FPSH2917	FPDIS1379A	FPSH2917A	RC3013	SW STRAINER 1-1

SCALE NONE	DESIGNED	DRAWN EAL	DATE 04-28-04
DAVIS-BESSE NUCLEAR POWER STATION UNIT NO. 1			
ELEMENTARY WIRING DIAGRAM LAKE WATER SYSTEM SERVICE WATER PUMP STRAINER 1-1			
	DRAWING NO.		REV.
	E-48B SH.7A		2

1	8/15/2017	INC. DUN 10-0192-003-006 REV.00
---	-----------	---------------------------------

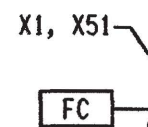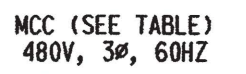

SW. STRNR. DRN. VLV. (SEE SH.8)



SW. STRNR. DRN. VLV. (SEE SH.8)

SW. STRNR. DRN. MOV. (SEE SH.8)

1. FOR GENERAL NOTES SEE DWG. E-48B INDEX SHEET.
2. TDR CHANGES CONTACT POSITION ON HIGH DIFF. PRESS. ACROSS STRAINER ON "AUTO", RESETS AT NORMAL DIFF. PRESS.; PSH CONTACT OPENS ON DECREASING PRESS. AT STRAINER. PSHA CLOSSES ON INCREASING PRESS. ON STRAINER.
3. DELETED
4. DELETED
5. RELAY 42X IS A POTTER & BRUMFIELD MDR RELAY AND HAS 8 PDT CONTACTS. FOR SPARE CONTACTS SEE DWG'S. E-8-78 & E-80-165.
6. FOR SCHEME NO. BE1274 SERVICE WATER STRAINER 1-1 SEE DWG. E-48B SH.7A.
7. FOR SCHEME NO. BF1274 SERVICE WATER STRAINER 1-2 SEE DWG. E-48B SH.7.
8. TDR RELAY ORIGINALLY AGASTAT MODEL 7022F. ANY FUTURE REPLACEMENT IS TO BE MODEL E-7024F. REF. NCR INFO. NOTICE 87-66 AND ECP 10-0192.

[illegible]

SCALE NONE	DESIGNED	DRAWN SAS	DATE 05-03-1
DAVIS-BESSE NUCLEAR POWER STATION UNIT NO. 1			
ELEMENTARY WIRING DIAGRAM LAKE WATER SYSTEM SERVICE WATER PUMP STRAINER 1-3			
	DRAWING NO.		REV.
	E-48B SH.7B		1

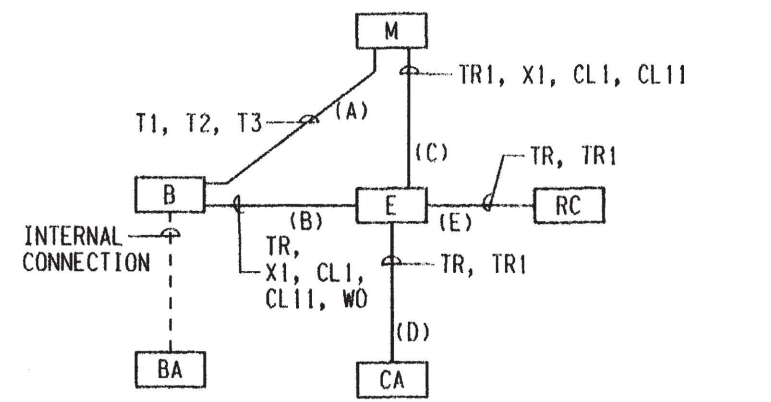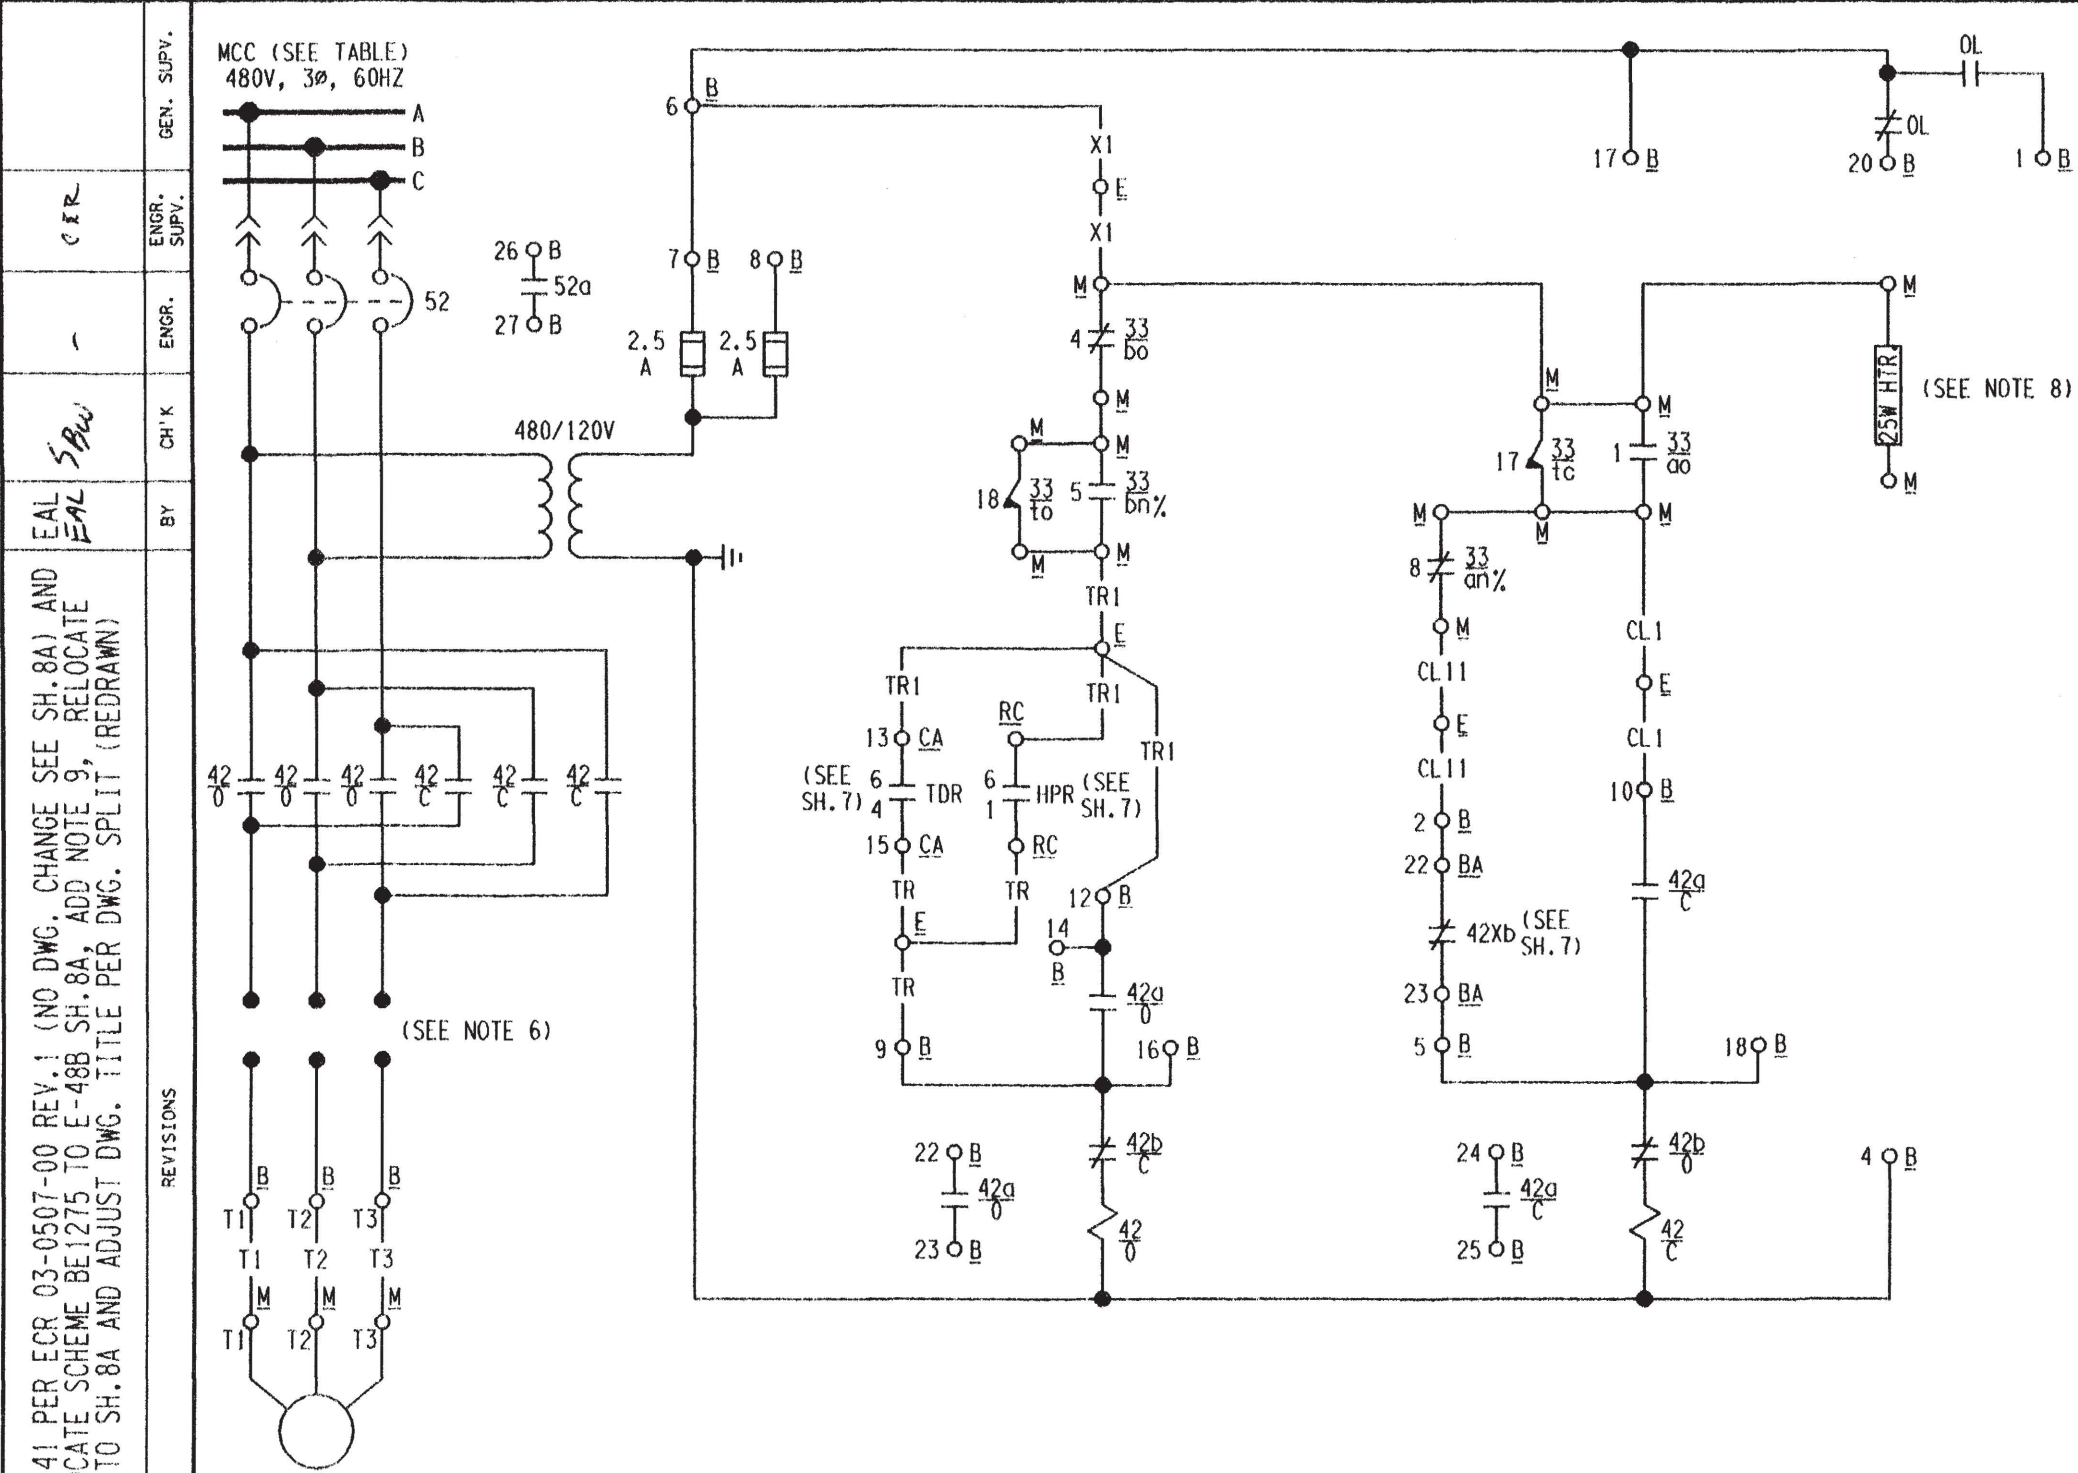

NOTES

1. FOR GENERAL NOTES SEE DWG. E-48B INDEX SH.
2. FOR VALVE LIMIT SW. CONTACT DEVELOPMENT SEE DWG. E-30B SH.8 FIG.A (SEE NOTE 7 THIS SHEET).
3. FOR INTERNAL WIRING OF LOCAL PANEL CA SEE R.P. ADAMS DWG. 35405 (M234-11-1).
4. TDR CONTACT CLOSING ON HIGH DIFF. PRESS. ON "AUTOMATIC" & HPR CONTACT CLOSING ON HIGH PRESS. AT SERVICE WATER STRAINER.
5. CONTRACTOR SHALL ADD JUMPER BETWEEN TERMINALS 6 & 7 OF STARTER.
6. OVERLOAD HEATERS REPLACED BY SHORTING BARS.
7. FIELD TO ADJUST ROTOR #2 WITH SWITCH CONTACTS 5 THRU 8 TO ACTUATE WHEN VALVE REACHES 20% OPEN +5%, -0%.
8. THE 25W HEATER HAS BEEN REMOVED FROM MOTOR MV13800.
9. FOR SCHEME NO. BE1275 SERVICE WATER STRAINERS DRAIN SEE DWG. E-48B SH.8A.

THIS DRAWING WAS REDRAWN ON CADD AND SUPERSEDES REVISION 12

SCHEME NO.	MCC	S.U. NO.	CHANNEL	EQUIPMENT						DESCRIPTION
				CA	B	E	M	BA	RC	
BF1275	F12C	11	2	C3018	BF1275	EV13800	MV13800	BF1274	RC3014	SERVICE WATER STRNR 1-2 DRAIN VLV
BEF125	EF12C	11	3	C3019	BEF125	EV13810	MV13810	BEF124	RC3015	SERVICE WATER STRNR 1-3 DRAIN VLV

SCALE NONE	DESIGNED	DRAWN EAL	DATE 04-16-04
DAVIS-BESSE NUCLEAR POWER STATION UNIT NO. 1 THE TOLEDO EDISON COMPANY			
ELEMENTARY WIRING DIAGRAM LAKE WATER SYSTEM			
SERVICE WATER STRAINERS 1-2 & 1-3 DRAIN VLV			
DRAWING NO. E-48B SH.8			REV. 13

DB 06-19-09 DFN= F:/SCHEME/E48BS8A.DGN

