


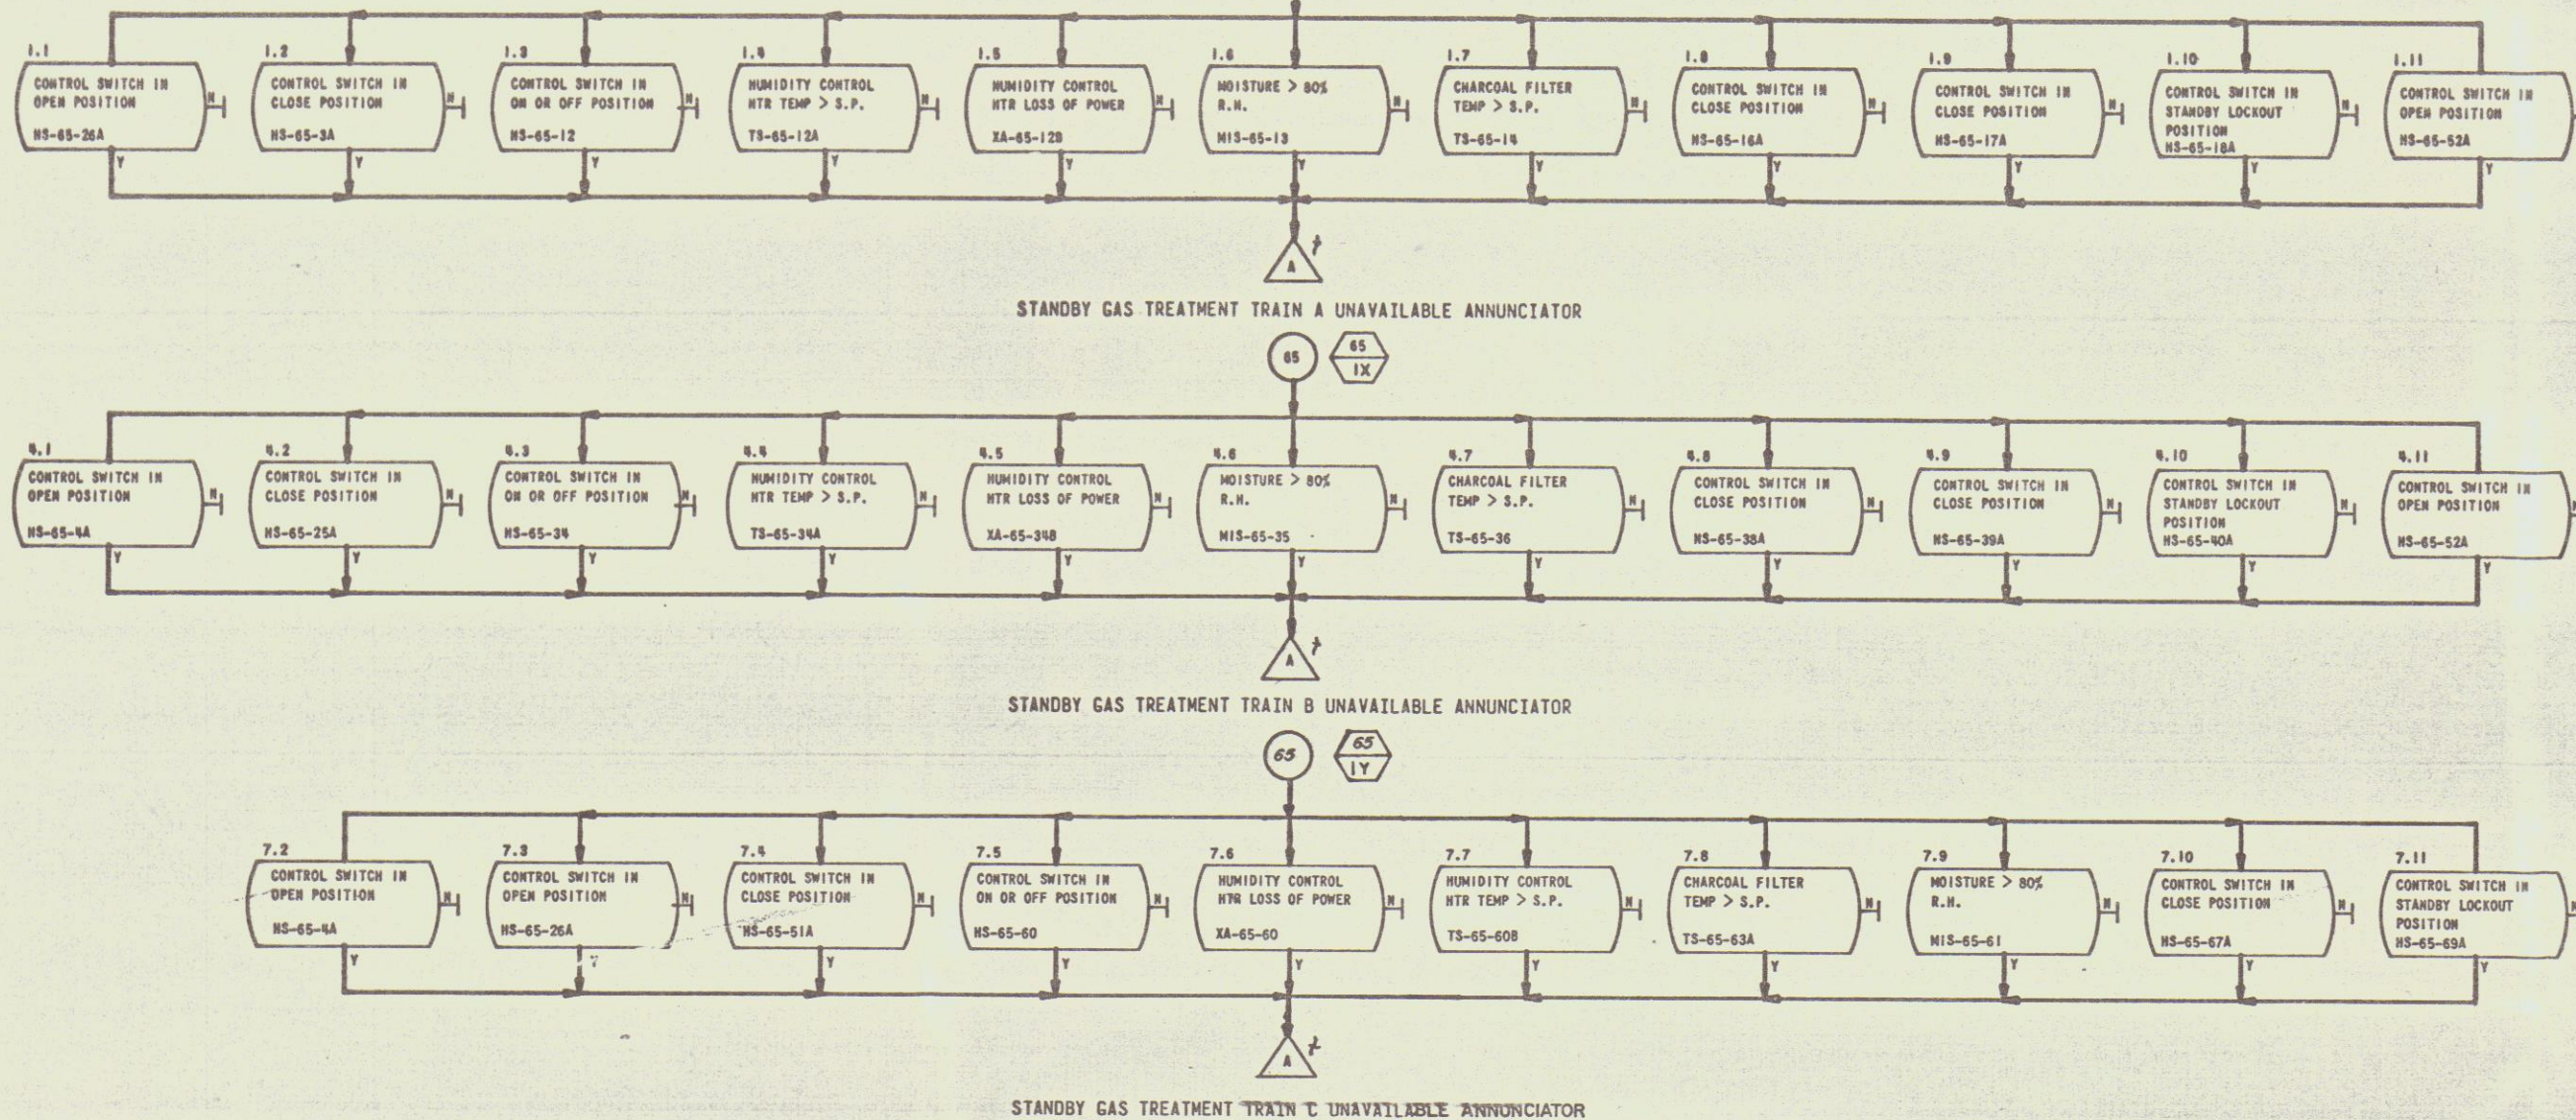

NOTES:
1. REFER TO 47W611-65-2 FOR NOTES CONCERNING STANDBY GAS TMT.

RETURN TO REACTOR DOCKET
FILE

Docket # 50-296
Control # 781940015
Date 6/25/78 of Document
REGULATORY DOCKET FILE

MAY 15 1978

COMPARISON DWGS:
47W611-65-1
47W611-65-2

RD ISSUED FOR L2004

INSPECTED AND APPROVED FOR ISSUE

PRINT
SIZE

REV NO	ECN NO	DATE	DESIGN	CHKD	SUPV	ENGR	INSP	SUBM	REC'D	APP'D
DESIGN	S.J. WADDELL						INSP			
CHKD	J.R. BOWITT						ENGINEER			
SUPV										
SCALE EXCEPT AS NOTED										
POWERHOUSE UNITS 1-3										
MECHANICAL LOGIC DIAGRAM STANDBY GAS TREATMENT SYS										
BROWNS FERRY NUCLEAR PLANT TENNESSEE VALLEY AUTHORITY DIVISION OF ENGINEERING DESIGN										
SUBMITTED			RECOMMENDED			APPROVED				
KNOXVILLE 67 M 47W611-65-3 RD										
RECORD DRAWING AS CONSTRUCTED										