

From: Joyce, Ryan M.
To: [Hall, Randy](#)
Cc: [Burns, Pamela Diane](#)
Subject: [External_Sender] Hatch alternative for plant service water leak
Date: Friday, May 18, 2018 7:23:23 AM
Attachments: [Scanned from a Xerox Multifunction Device.pdf](#)
[H11142 PSW Leak Location.pdf](#)
[BM11021 Sheet 9 Mark Up - Intake Structure Sump Pump Capacity.pdf](#)

Randy – please see answers below. Thanks.

1. Provide a drawing showing the location of the leak with respect to the elbow. **Attached (H11142 mark up)**
2. Provide a thickness map showing the wall thickness in the vicinity of the leaking location. **Attached (scanned document)**
3. Provide the minimum wall thickness calculated as part of the licensee evaluation in accordance with Code Case N-513-4 **$T_{min} = 0.130"$**
4. Section 5 of the licensee's May 17, 2018 letter states "For a leaking flaw, the allowable leakage rate will be determined by dividing the critical leakage rate by a safety factor of four (4)." Provide the allowable leakage rate for the degraded elbow described in the proposed alternative and discuss how the critical leakage rate was determined. **There is approximately 4000 gpm of margin in the PSW system but the two sump pumps for the area can only remove 80 gpm total (Reference BM11021 Sheet 9 – Attached). This makes the critical leakage rate 80 gpm and an allowable leakage rate of 20 gpm when the safety factor of four (4) is applied.**
5. Section 5 of the Code Case provides provisions for augmented examinations. Discuss how the proposed alternative satisfies Section 5 of the code case. **Section 5 of the Code Case requires 5 sample locations within 30 days and repeat the process within 15 days if an additional flaw is located. This requirement will be specifically addressed in Compensatory Action Number 3 of the PDO.**
6. Verify that the implementation of the proposed alternative will comply with Code Case N-513-4 in its entirety, in addition to the licensee's proposed allowable leakage rate. **SNC confirms that the proposed alternative will comply with Code Case N-513-4 in its entirety.**
7. Section 6 of the proposed alternative states, in part, "The repair will be implemented no later than the end of the next Hatch Unit 1 refueling outage or before exceeding the temporary acceptance criteria of Code Case N-513-4, whichever comes first." Section 5 of the proposed alternative states that the licensee will determine an allowable leakage rate. Verify that the allowable leakage rate will not be exceeded prior to system shutdown to perform a repair. **The current leakage rate is 3 gpm which, based on $Q=C_f \cdot A_o \cdot \sqrt{2 \cdot (P_2 - P_1) / \rho}$ from Crane Technical Paper 410, equates to a hole in the pipe of approximately 1/8". Using the same equation, the hole in the pipe would have to increase to approximately 5/16" to reach the allowable leakage rate of 20 gpm. SNC is in the process of determining the flaw growth rate to reach 5/16". If the flaw growth rate from 1/8" to 5/16" is greater than 20 months, then it will be acceptable to make the repair during the next refueling outage.**


Thanks,

Ryan

(205) 992-6468 (work)

WO SNC 245584
 Date: 05/14/18
 1P41 30 IN ELBOW
 INTAKE
 Sheet 1 of 1

UT THICKNESS MEASUREMENTS
 PSW 30" ELBOW DOWNSTREAM
 OF 1P41-F305A

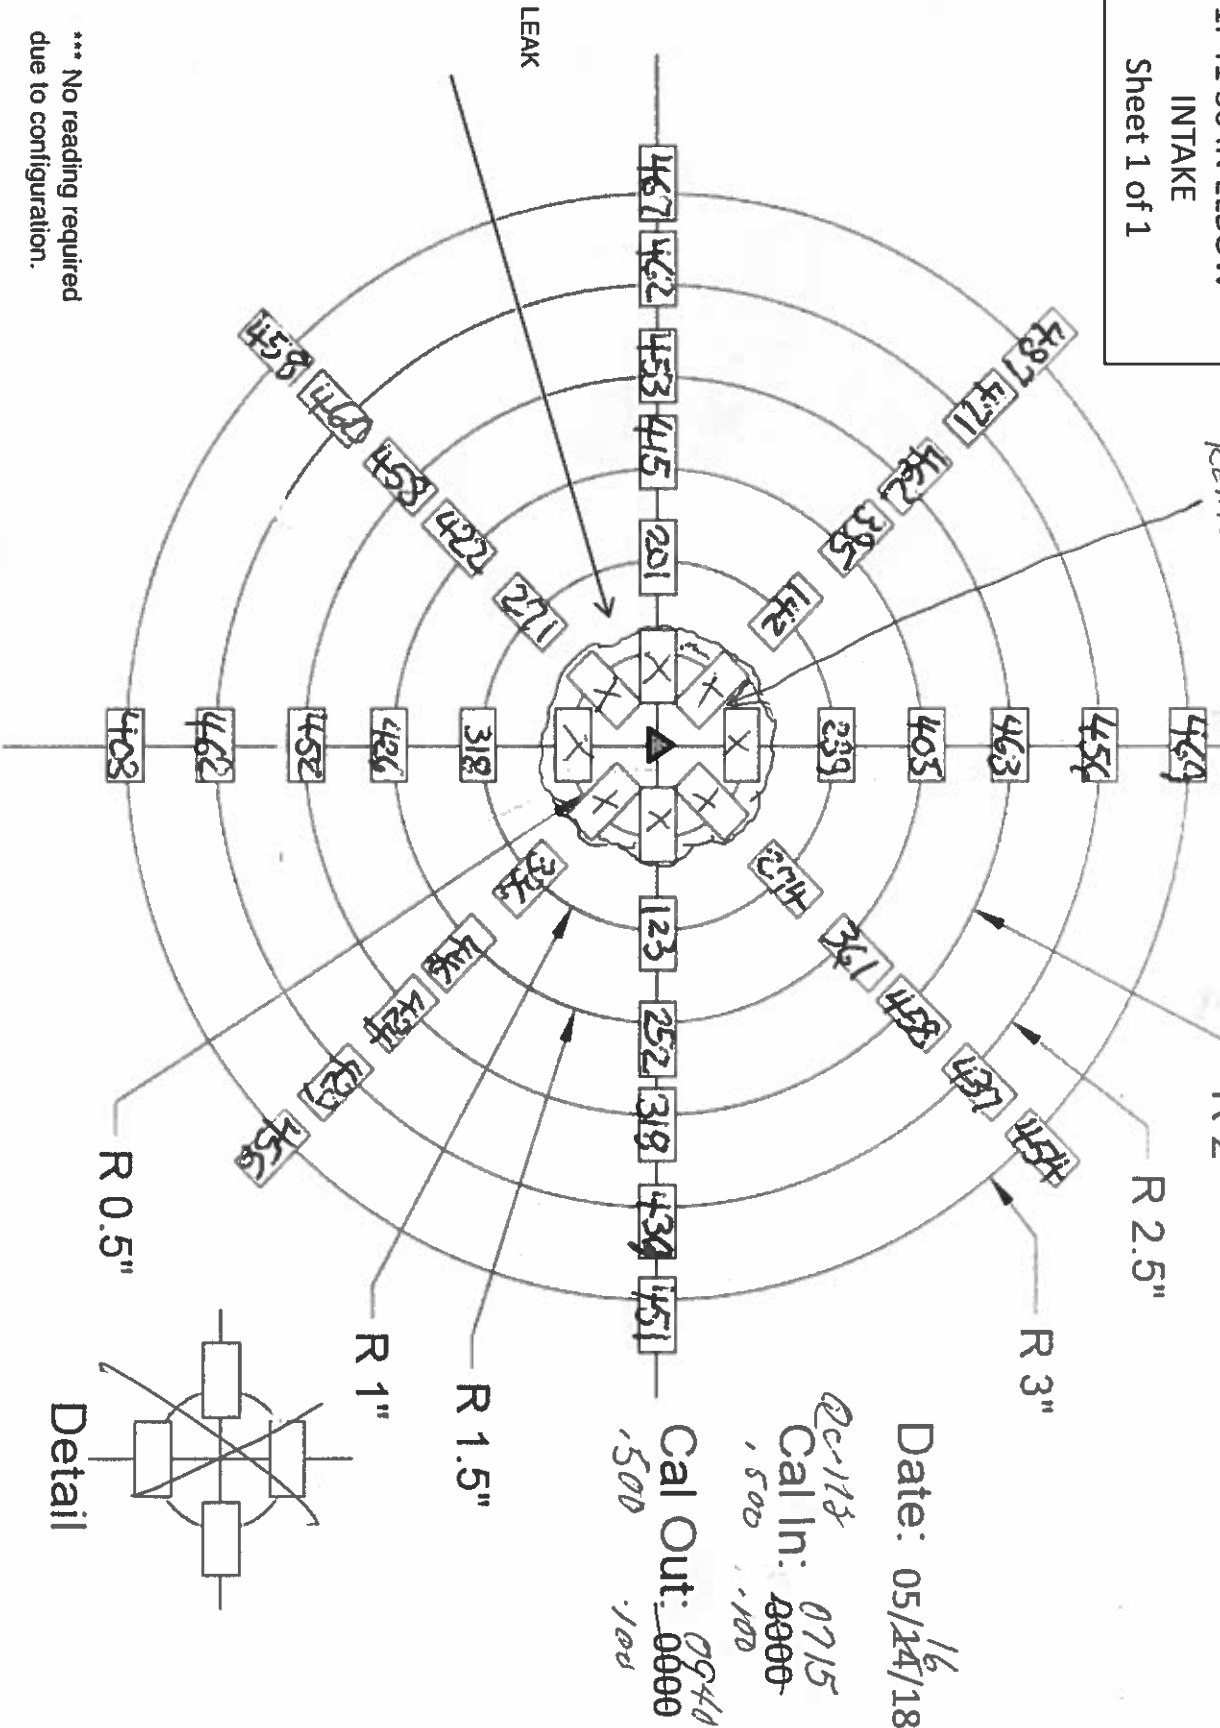

REQUISITION	REVISION		MK.	TOTAL REQUIRED	QUALITY ASSURANCE	DESCRIPTION	CATALOG OR DWG NO	REMARKS	DRAWING NUMBER							
	NO	CHANGE														
37566-SS			SP-1	2	N	1½" Vertical duplex, heavy duty sump pump, 50 GPM capacity @ 40ft. TDH flanged discharge complete with 2H.P. 208 volt., 3 phase, 60 cycle A-C motor furnished with flexible coupling on a common 52" sq base plate with manhole cover, control plate, float, float control assembly, float switch and high level alarm switch and alternator. Pump materials of construction: casing-cast iron, impeller-cast iron, shaft-stainless steel, column-black pipe, bearings-carba lube. Sump depth is 12'-0".	Crane Deming Fig. 4511 Size 1½S (SX-15925)	Control Bldg. Sump Z45C001 A&B	H-11090							
48443-SS			SP-2	12	N	1½" vertical sump pump 40 GPM capacity @ 40 ft. TDH, screwed discharge, pump to be complete with 1 HP 200 volt, 3 phase, 60 cycle A.C. motor furnished with flexible coupling, control float assembly, float switch and high level alarm switch. Pumps to be mounted on floor of 2'-0" deep sump.	Crane-Deming Fig. 4508 Type B Unit #6J (SX-11842)	Cond. Backwash Sump G11C050 River Intake Structure Sump X45C001A&B S.W.Valve Box Sump X45C002 A+B Radwaste Valve Box Sump X45C003 Circ. Water Intake Structure Sump W21C001A-D	H-11071 H-11342 H-11342 H-11342							
48469-SS			SP-3	2	N	1½" Automatic Heavy Duty Submersible Sump Pump, with 1 H.P. Motor Suitable for Operation on 208 Volts.	Fairbanks Morse Inc. Model No. CD-1058	Control Bldg Elevator Sump Pump Z45-C005 River Discharge Metering Box Y21-C001	H-11342 H-11342							
48450-SS			SA-1	4	N	High Water alarm switches for operating remote alarm, for 120 volt 5 Amp 60 cycle service.	Square "D" Fig. 9018 BSW-9 (SX-11857)	T. B. Sump (2)G11-M100A Control Bld. Sump (2)Z45-M001A	H-11090 H-11090							
48693-SS			HCP	1	N	Horizontal centrifugal pump, 1750 rpm, 400 gpm @ 83 ft. TDH, 15 HP motor, 550 VAC. 3 phase, 60 Hz.	Ingersall-Rand No. 4x3x10HC	Circ. Water Disc. in Chlorination Sys. MPL No. W33-0001	H-11039							
<div>FOR REFERENCE ONLY</div> <div>REV. 9 DATE 6/16/86</div> <div>THIS IS A CAT. IV DRAWING</div> <div>AND IS NOT MAINTAINED.</div> <div>SEE A-43102: LETTER LOG</div> <div>SS-GP-9-4-741 HATCH</div>																
REVISIONS	Rev. 0. Issued for approval and construction SSV 4-20-72					Listed SSV	App	SOUTHERN SERVICES INC., FOR GEORGIA POWER COMPANY BILL OF MATERIAL FOR PLANT HATCH UNIT NO. 1 Date 4-20-72								
	REV 8: CHANGED MPL NOS. PER ABN 85-654 PSC 4-10-86					Typed pr	App									
						Checked JHK	App									
						Passed	App									
Applies to Drawings MISC. EQUIPMENT FOR PIPING INSTALLATION							Total Number of Sheets For									
							DRAWING NO.									
							LOCATION	SHEET 9								
							10-502	BM- 11021								