

CHART B

VALVE NO	A	B	C	D	E	F
310	ZC-310-IS	ZC-310-2S	SOV-310			IA-857
FCV-110B	ZC-FCV-110B-IS	ZC-FCV-110B-2S	SOV-110B			IA-856
FCV-111B	ZC-FCV-111B-IS	ZC-FCV-111B-2S	SOV-111B			IA-849
LCV-112A	ZC-LCV-112A-IS	ZC-LCV-112A-2S	SOV-112A			IA-848
LCV-112B	ZC-LCV-112B-IS	ZC-LCV-112B-2S	SOV-112B			IA-852
PCV-113B	ZC-PCV-113B-IS	ZC-PCV-113B-2S	SOV-113B			IA-802
TCV-149	ZC-TCV-149-IS	ZC-TCV-149-2S	SOV-149			IA-847

REFERENCE DRAWINGS:

FP9321-2293	RCS - REACTOR COOLANT SYSTEM
9321-F-2720	ACS - AUXILIARY COOLANT SYSTEM
9321-F-2745	SS - SAMPLING SYSTEM
9321-F-2725	GA - GAS ANALYZER SYSTEM
9321-F-2502	ISIS - SAFETY INJECTION SYSTEM
9321-F-2719	WDS - WASTE DISPOSAL SYSTEM (SHT. 1)
9321-F-2730	WDS - WASTE DISPOSAL SYSTEM (SHT. 2)
2081B8	CVCS - CHEMICAL & VOLUME CONTROL SYSTEM (SHT. 2)
235309	CVCS - CHEMICAL & VOLUME CONTROL SYSTEM (SHT. 4)
9321-F-2737	CVCS - CHEMICAL & VOLUME CONTROL SYSTEM (SHT. 3)
9321-F-2724	PW - PRIMARY MAKE-UP WATER
9321-F-2728	(DH) - NUCLEAR EQUIPMENT DRAINS
9321-C-2016	----- FLOW DIAGRAM SYMBOLS
9321-F-2746	IVSWS - ISOLATION VALVE SEAL WATER SYSTEM

- NOTES:
- VALVES FAILS WITH FLOW TO VOLUME CONTROL TANK.
  - SPECIAL VALVE - FUNCTIONS AS BOTH ISOLATION RELIEF VALVE.
  - SPECIAL SPRING LOADED CHECK VALVE.
  - ELECTROMAGNETIC - LOCATE METER IN VERTICAL PIPE RUN.
  - 1/2" HOLE OR 0.18" WIDE X 0.09" DEEP GROOVE IN DISC.
  - ADDITIONAL VENTS & DRAINS MAY BE REQUIRED BY THE PIPE LAYOUT.
  - GLOBE VALVES ARE NORMALLY INSTALLED WITH FLOW UNDER THE SEAT. EXCEPTIONS ARE VALVES NO. 230, 232, 233, 235, 236, 238, 240A, 250A, 250B, 250C & 250D.
  - STEAM TRAP AND STRAINER SUPPLIED BY UE & C.
  - ITEM NO'S IN PARENTHESES ARE PRECEDED BY IPP. L. DRAIN, CHARGING PUMPS LEAKAGE COLLECTIVE SYSTEM.
  - M... INDICATES CONTROL VALVE HAS ADDITIONAL ASSOCIATED CONTROL EQUIPMENT IS REPRESENTED ON CONTROL VALVE HOOD-UP DETAIL DWG. 9321-F-7056.
  - THE QUALITY GROUP A, B, C AND SEISMIC BOUNDARIES EXTEND TO THE FIRST SEISMIC SUPPORT/RESTRAINT BEYOND THE BOUNDARIES SHOWN.
- INSERVICE INSPECTION NOTES:
- CONTAINMENT PENETRATIONS, ASME CLASS MC APPLIES.
  - FOR NON-CODE PIPING PENETRATING CONTAINMENT & NDT CLASSIFIED QUALITY GROUP "A", "B" OR "C" QUALITY GROUP "MC" DESIGNATION SHALL BE APPLIED.

CHART A

FI/FE/FXE	A	B	C	D	E	F	G	H	O
116	239C	240C	5026	5027	5028	5029	5030	5031	
115	239D	240D	5032	5033	5034	5035	5036	5037	
143	239B	240B	5038	5039	5040	5041	5042	5043	
144	239A	240A	5044	5045	5046	5047	5048	5049	
168	4916	4917				5070	5071	5072	
158	4918	4919				5073	5074	5075	
145B	4914	4913				5076	5077	5078	
144B	4912	4911				5079	5080	5081	




THIS DWG. TO BE REVISED ONLY IN AUTOCAD

DATE	BY	CHKD	APP.	REVISION
06/13/16	W. J. KING			1

TITLE: FLOW DIAGRAM  
CHEMICAL & VOLUME CONTROL SYSTEM -  
LFSAR FIGURE NO. 9.2-1 (SHT. 1)


STATION: INDIAN POINT

NO. 9321-F-2736-130

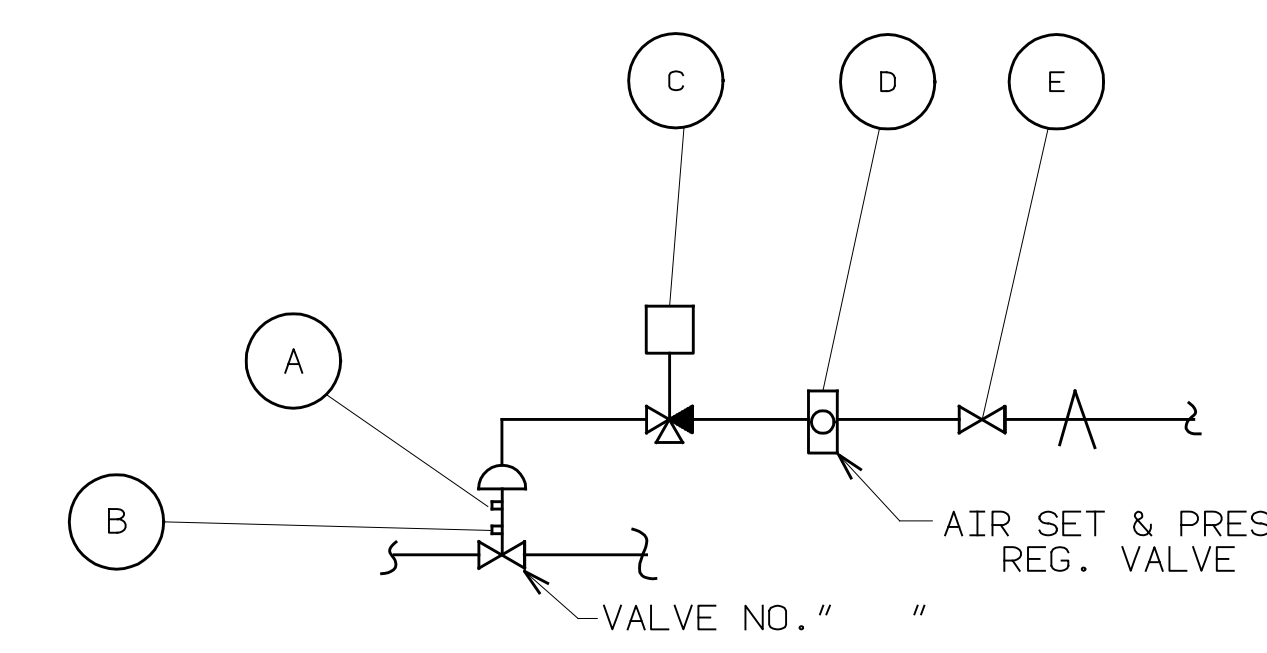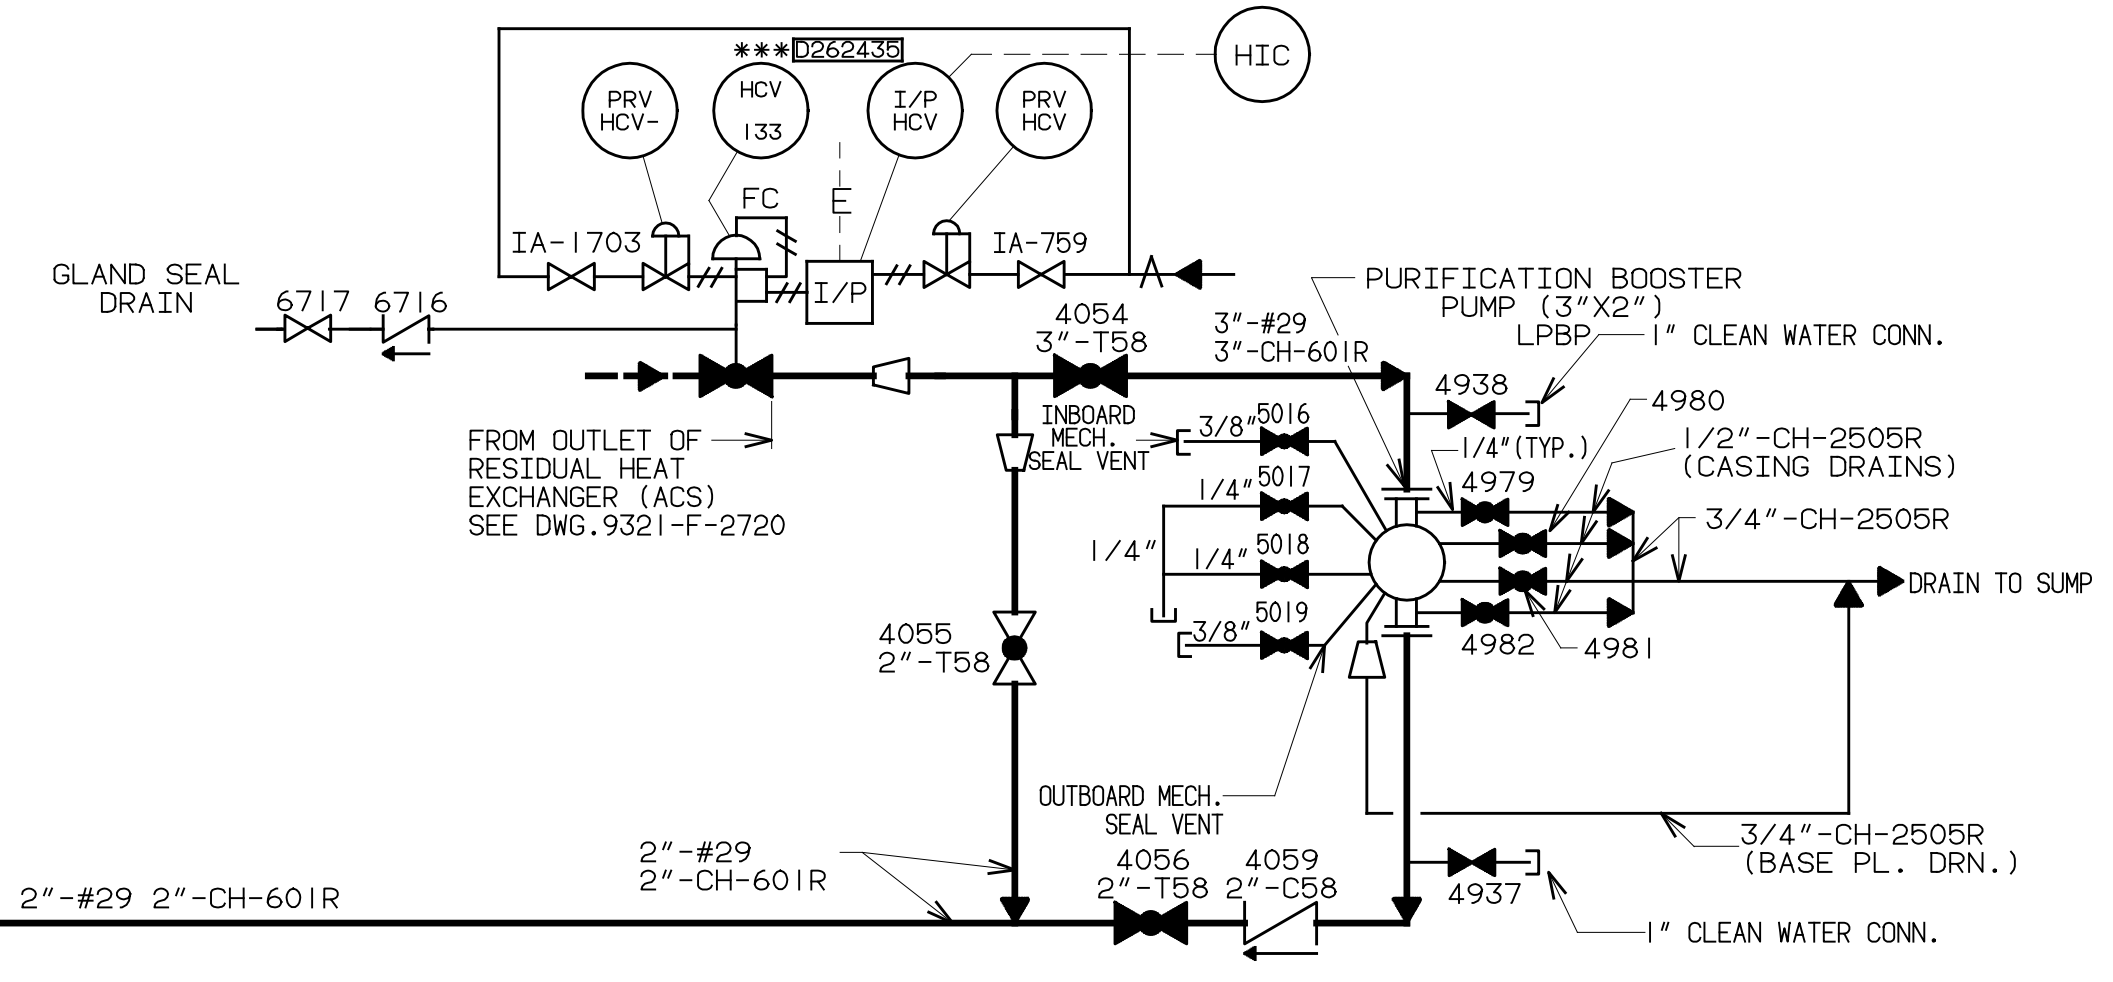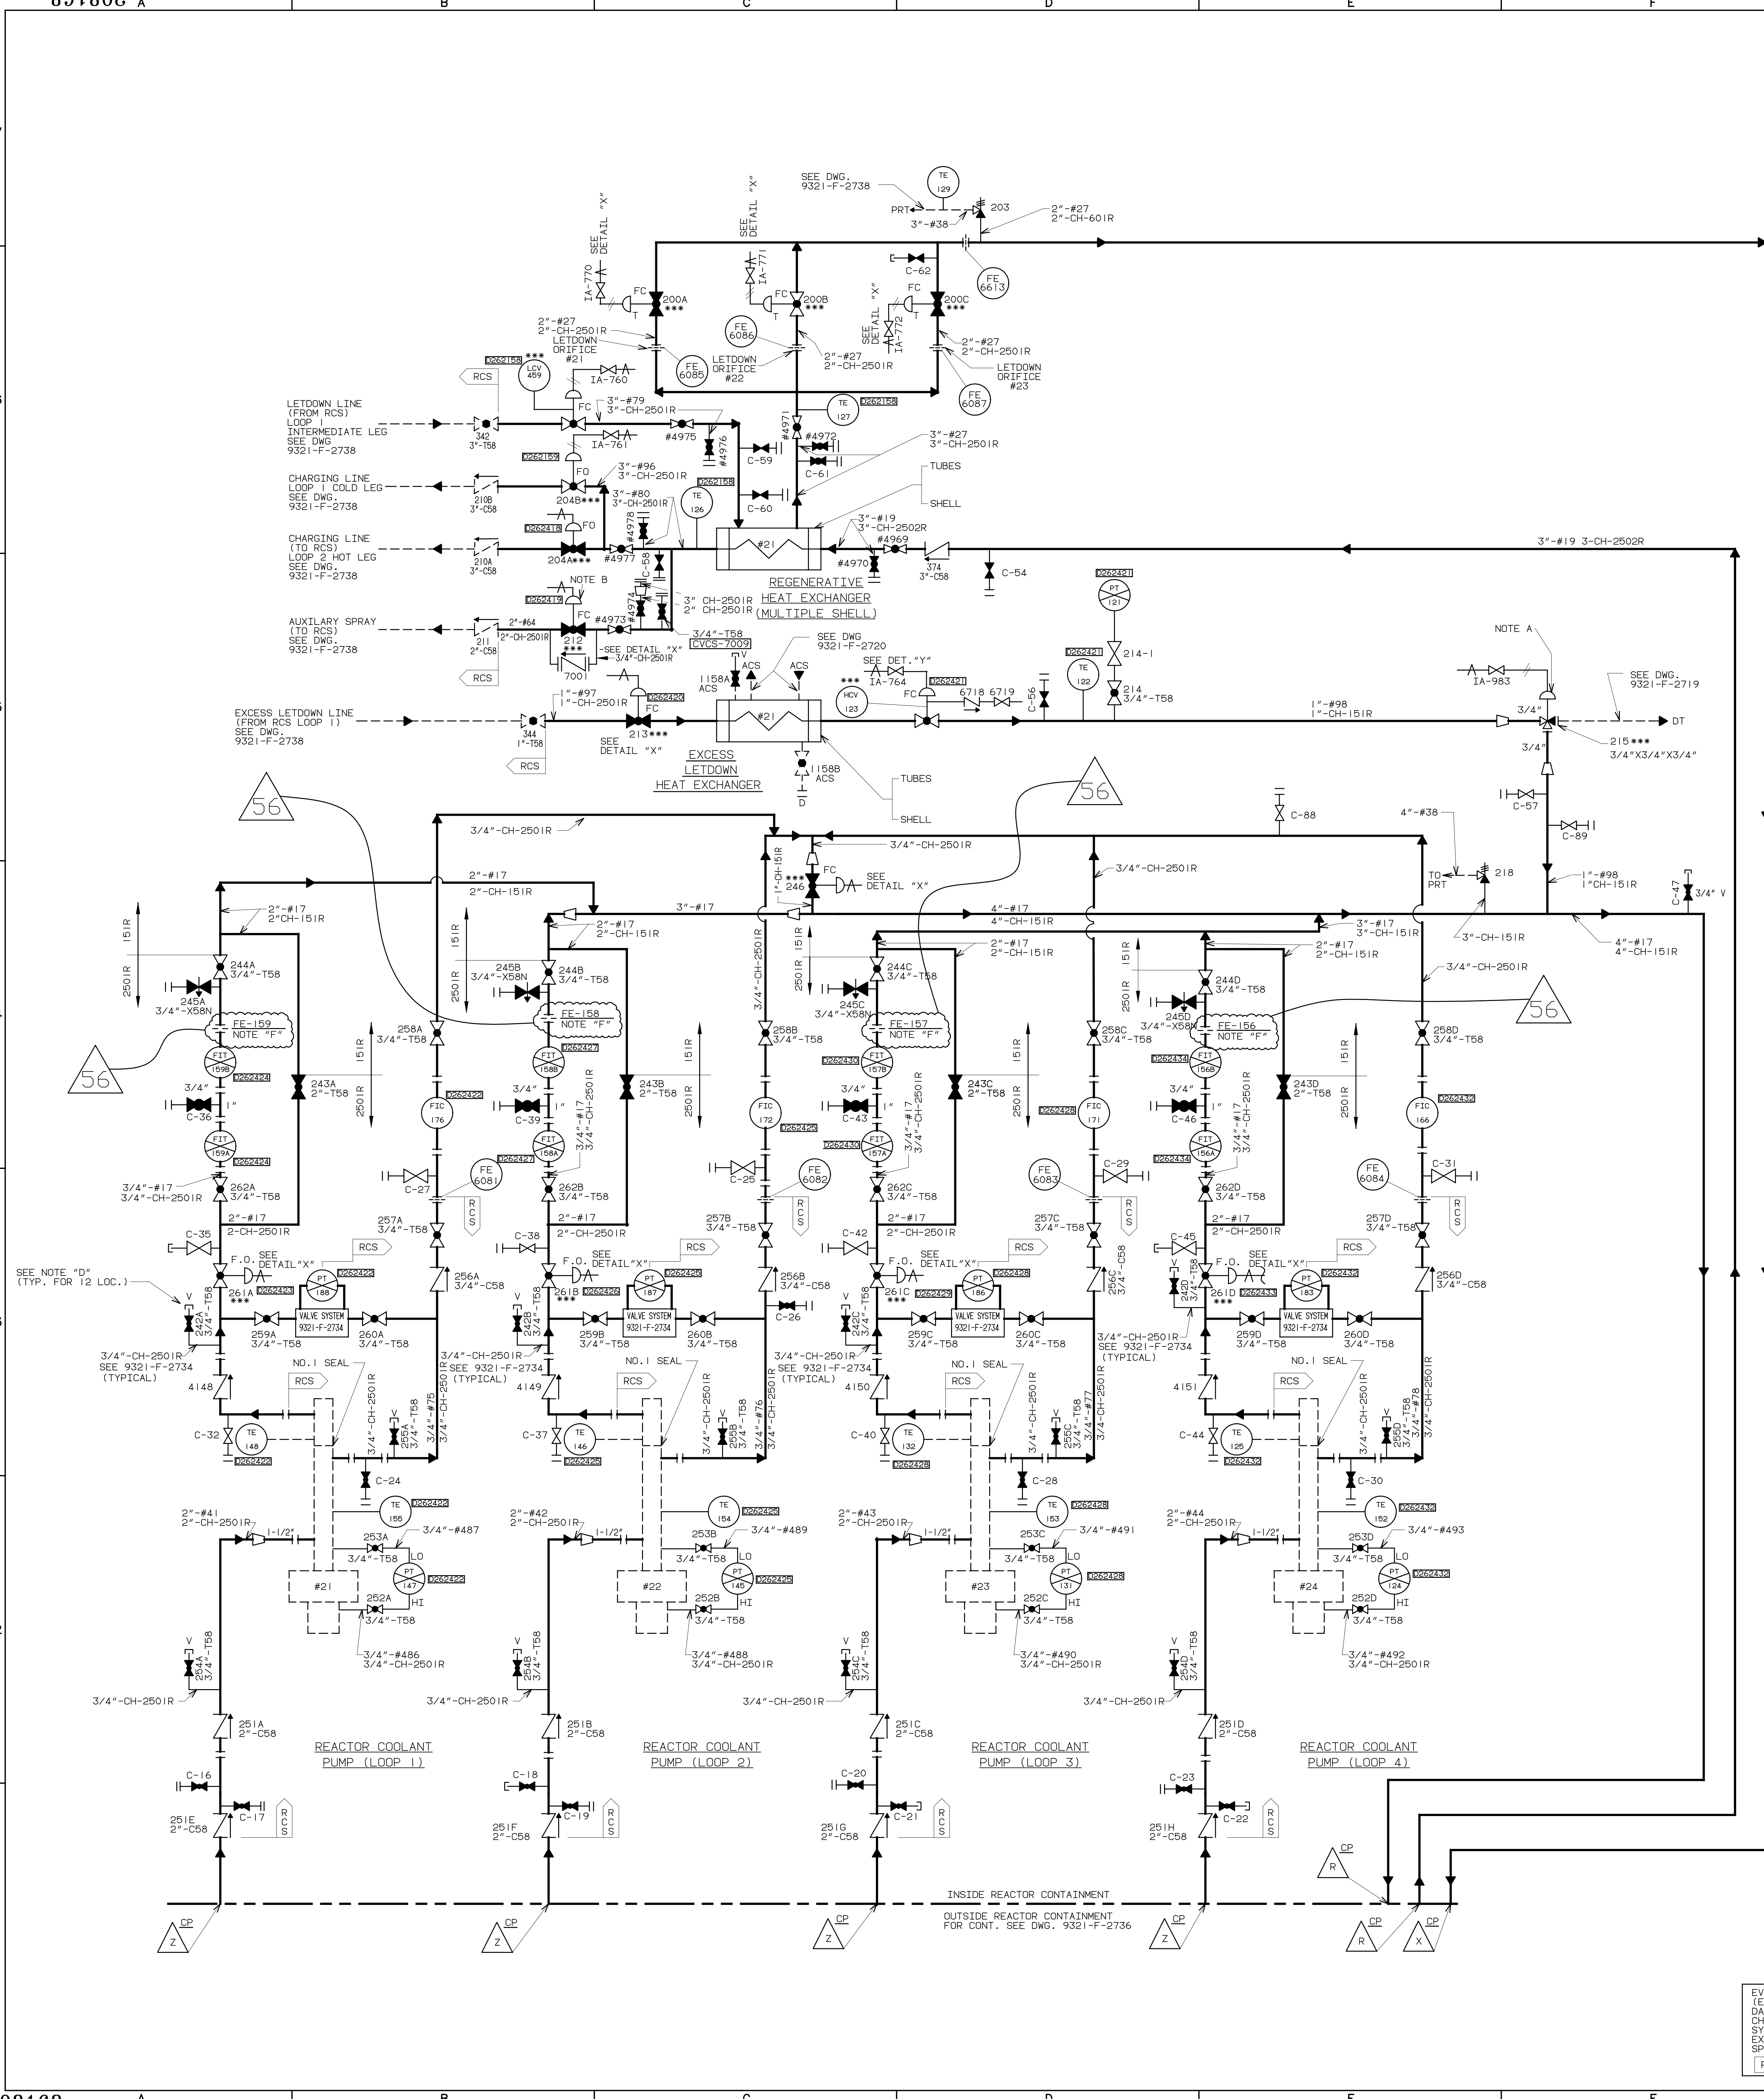

VALVE NO.	A	B	C	D	E
246	ZC-246-1	ZC-246-2	SOV-246	PRV-246	IA-773
261A	ZC-261A-1S	ZC-261A-2S	SOV-261A	PRV-261A	IA-766
261B	ZC-261B-1S	ZC-261B-2S	SOV-261B	PRV-261B	IA-767
261C	ZC-261C-1S	ZC-261C-2S	SOV-261C	PRV-261C	IA-768
261D	ZC-261D-1S	ZC-261D-2S	SOV-261D	PRV-261D	IA-769
212	ZC-212-1S	ZC-212-2S	SOV-212	PRV-212	IA-1312
213	ZC-213-1S	ZC-213-2S	SOV-213	PRV-213	IA-765
200A	ZC-200A-1	ZC-200A-2	SOV-200A	PRV-200A	IA-770
200B	ZC-200B-1	ZC-200B-2	SOV-200B	PRV-200B	IA-771
200C	ZC-200C-1	ZC-200C-2	SOV-200C	PRV-200C	IA-772
215	ZC-215-1	ZC-215-2	SOV-215	PRV-215	IA-983
204A	ZC-204A-1	ZC-204A-2	SOV-204A	PRV-204A	IA-762
204B	ZC-204B-1	ZC-204B-2	SOV-204B	PRV-204B	IA-761
LCV-459	ZC-LCV-459-1	ZC-LCV-459-2	SOV-459	PRV-LCV-459	IA-760

DETAIL "X"

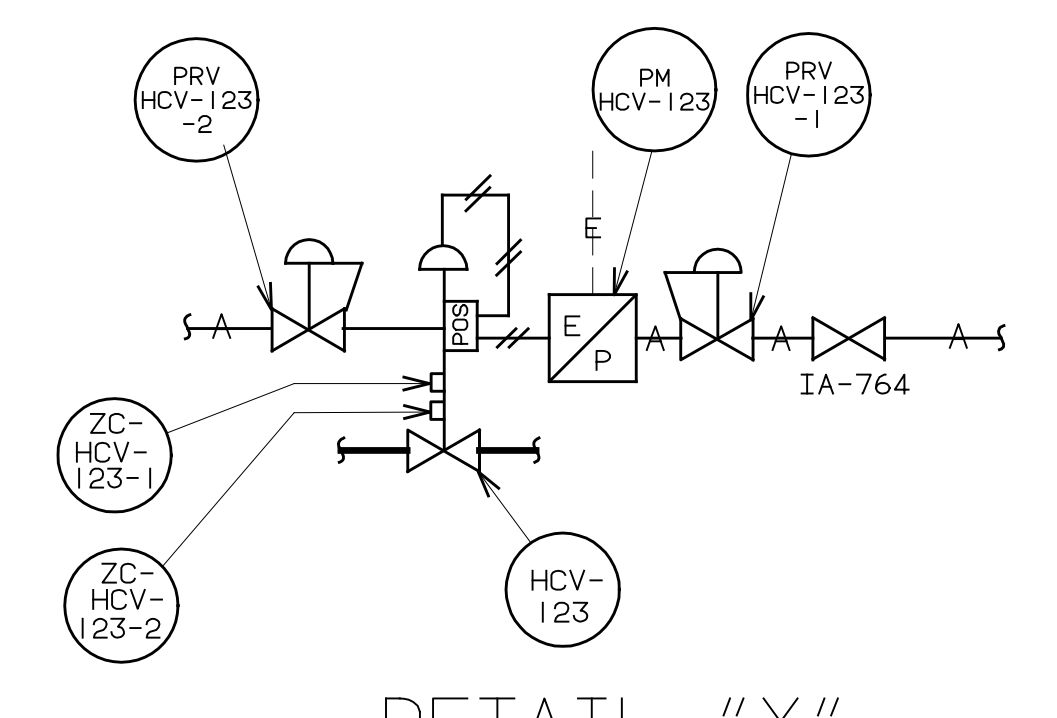

DETAIL "Y"

- NOTES
- A. VALVE FAILS WITH FLOW TO VOLUME CONTROL TANK & RELIEF VALVE
  - B. SPECIAL VALVE FUNCTIONS AS BOTH ISOLATION & RELIEF VALVE
  - C. \*\*\* INDICATES CONTROL VALVE HAS ADDITIONAL ASSOCIATED CONTROL EQUIPMENT & IS REPRESENTED ON CONTROL VALVE HOOK-UP DETAIL DRAWING 9321-F-7056.
  - D. FOR CONTINUATION SEE DWG. 9321-F-2734 (TYP. FOR 12 LOC.)
  - E. THE QUALITY GROUP A, B, C AND SEISMIC BOUNDARIES EXTEND TO THE FIRST SEISMIC SUPPORT/RESTRAINT BEYOND THE BOUNDARIES SHOWN.
  - F. FE-156, FE-157, FE-158, AND FE-159 ARE FLOW RESTRICTION ORIFICES INSTALLED PER EC 56002.

- INSERVICE INSPECTION NOTES:
- 1. CP-CONTAINMENT PENETRATIONS, ASME CLASS MC APPLIES.
  - 2. FOR NON-CODE PIPING PENETRATING CONTAINMENT & NOT CLASSIFIED QUALITY GROUP "A", "B" OR "C" QUALITY GROUP "MC" DESIGNATION SHALL BE APPLIED.

WORK THIS DRAWING WITH DWG. 9321-F-2734 AND DWG. 9321-F-2736


EVERYTHING ON THIS DRAWING (EXCLUDING THOSE PORTIONS WITH DASHED LINES) IS PART OF THE CHEMICAL AND VOLUME CONTROL SYSTEM (CVCS) LISTED IN EXHIBIT A, CI-240-1 EXCEPT AS SPECIFICALLY INDICATED HEREIN

RCS REACTOR COOLANT SYSTEM

REF. DWG:

9321-C-2016	FLOW DIAGRAM SYMBOLS
9321-F-2538	CONTAINMENT BLDG PRIMARY COOLANT PRESSURIZER PIPING PLAN (SOUTH HALF)
9321-F-2734	PIPING AT REACTOR COOLANT PUMPS

9321-F-2737

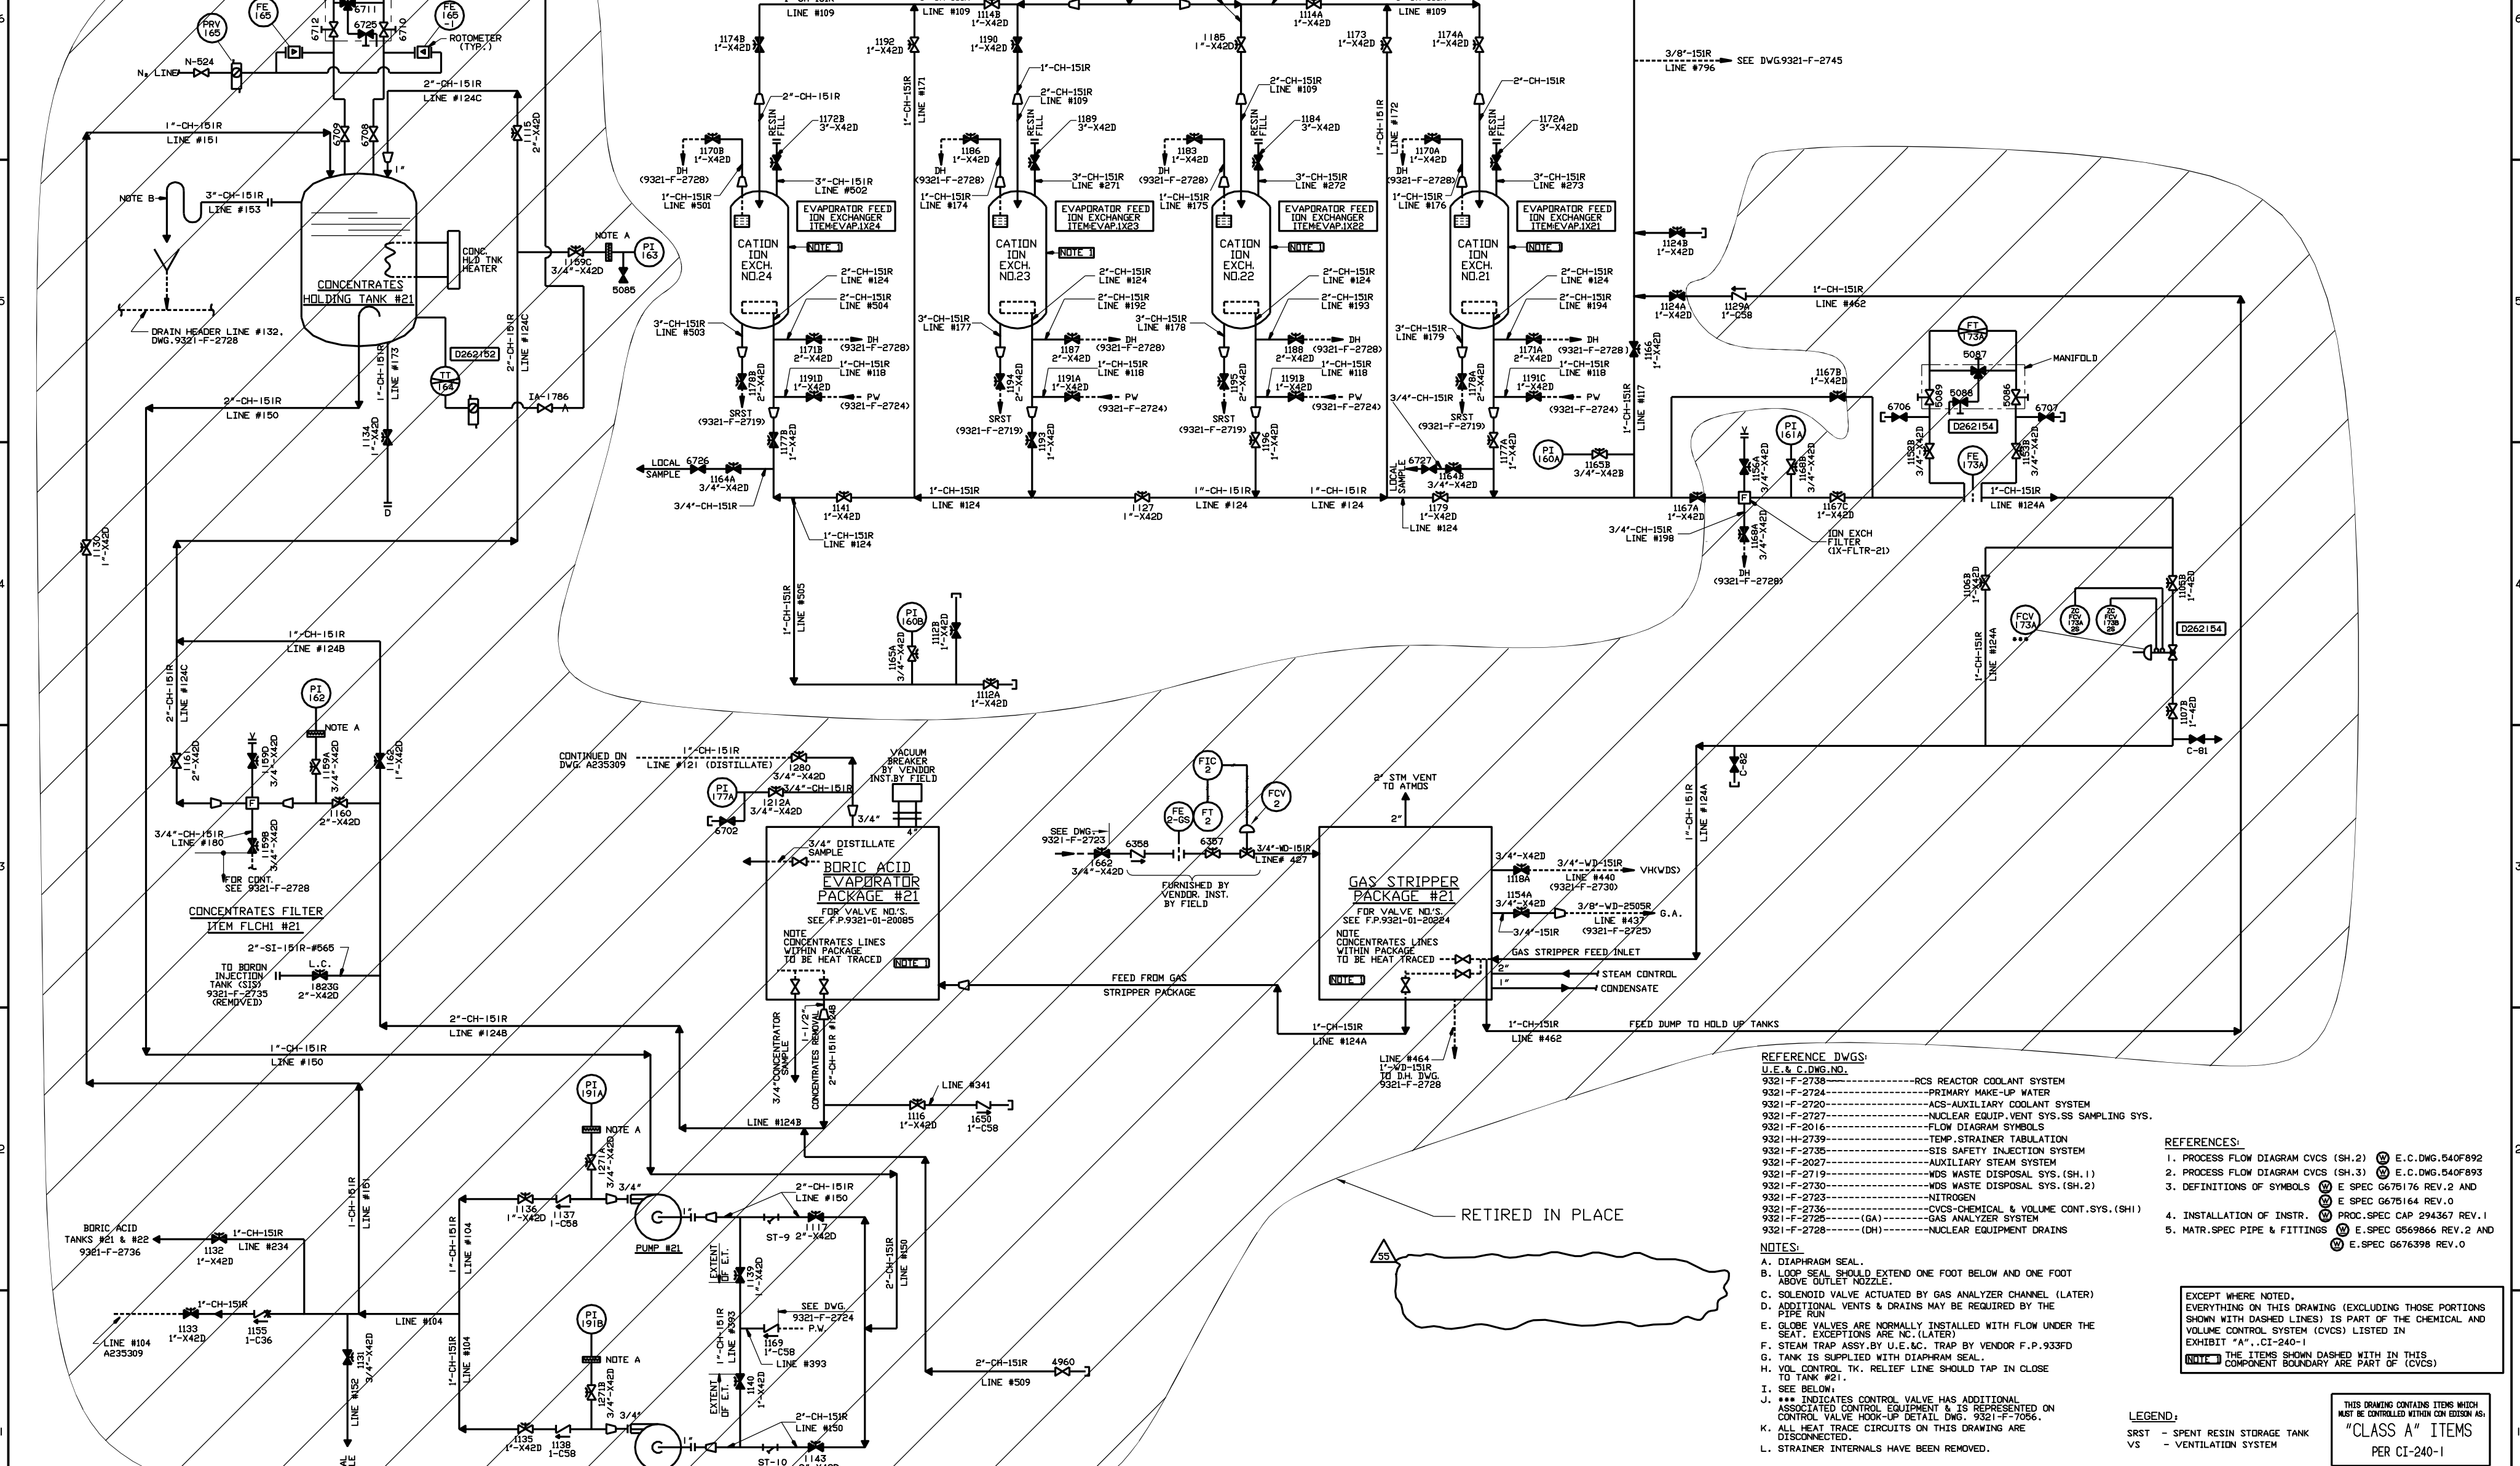

- REFERENCE DWGS:**  
 U.E. & C. DWG. NO.  
 9321-F-2738-----RCS REACTOR COOLANT SYSTEM  
 9321-F-2724-----PRIMARY MAKE-UP WATER  
 9321-F-2720-----ACS-AUXILIARY COOLANT SYSTEM  
 9321-F-2727-----NUCLEAR EQUIP. VENT. SYS. SS SAMPLING SYS.  
 9321-F-2016-----FLOW DIAGRAM SYMBOLS  
 9321-H-2739-----TEMP. STRAINER TABULATION  
 9321-F-2735-----SIS SAFETY INJECTION SYSTEM  
 9321-F-2027-----AUXILIARY STEAM SYSTEM  
 9321-F-2719-----WDS WASTE DISPOSAL SYS. (SH. 1)  
 9321-F-2730-----WDS WASTE DISPOSAL SYS. (SH. 2)  
 9321-F-2723-----NITROGEN  
 9321-F-2736-----CVCS-CHEMICAL & VOLUME CONT. SYS. (SH. 1)  
 9321-F-2726-----GAS ANALYZER SYSTEM  
 9321-F-2728-----NUCLEAR EQUIPMENT DRAINS
- REFERENCES:**  
 1. PROCESS FLOW DIAGRAM CVCS (SH. 2) E.C. DWG. 540F892  
 2. PROCESS FLOW DIAGRAM CVCS (SH. 3) E.C. DWG. 540F893  
 3. DEFINITIONS OF SYMBOLS E SPEC G675176 REV. 2 AND E SPEC G675164 REV. 0  
 4. INSTALLATION OF INSTR. PROC. SPEC CAP 294367 REV. 1  
 5. MATR. SPEC PIPE & FITTINGS E. SPEC C569866 REV. 2 AND E. SPEC G676398 REV. 0
- NOTES:**  
 A. DIAPHRAGM SEAL.  
 B. LOOP SEAL SHOULD EXTEND ONE FOOT BELOW AND ONE FOOT ABOVE OUTLET NOZZLE.  
 C. SOLENOID VALVE ACTUATED BY GAS ANALYZER CHANNEL (LATER)  
 D. ADDITIONAL VENTS & DRAINS MAY BE REQUIRED BY THE PIPE RUN  
 E. GLOBE VALVES ARE NORMALLY INSTALLED WITH FLOW UNDER THE SEAT. EXCEPTIONS ARE N.C. (LATER)  
 F. FLEAM TRAP ASSY. BY U.E. & C. TRAP BY VENDOR F.P. 933FD  
 G. TANK IS SUPPLIED WITH DIAPHRAGM SEAL.  
 H. VOL. CONTROL TK. RELIEF LINE SHOULD TAP IN CLOSE TO TANK #21.  
 I. SEE BELOW.  
 J. \*\*\* INDICATES CONTROL VALVE HAS ADDITIONAL ASSOCIATED CONTROL EQUIPMENT & IS REPRESENTED ON CONTROL VALVE HOOK-UP DETAIL DWG. 9321-F-7056.  
 K. ALL HEAT TRACE CIRCUITS ON THIS DRAWING ARE DISCONNECTED.  
 L. STRAINER INTERNALS HAVE BEEN REMOVED.

EXCEPT WHERE NOTED, EVERYTHING ON THIS DRAWING (EXCLUDING THOSE PORTIONS SHOWN WITH DASHED LINES) IS PART OF THE CHEMICAL AND VOLUME CONTROL SYSTEM (CVCS) LISTED IN EXHIBIT "A", CI-240-1

NOTE: THE ITEMS SHOWN DASHED WITH IN THIS COMPONENT BOUNDARY ARE PART OF (CVCS)

**LEGEND:**  
 SRST - SPENT RESIN STORAGE TANK  
 VS - VENTILATION SYSTEM

THIS DRAWING CONTAINS ITEMS WHICH MUST BE CONTROLLED WITHIN CDN EDISON AS "CLASS A" ITEMS PER CI-240-1

COMPUTER GENERATED DRAWING NOT TO BE HAND REVISED WORK THIS DRAWING WITH DWG. A235309

55 INCORPORATED EC0000003112	11/07/07 CLG	APPROVAL	DATE	DESIGN	DATE	SCALE	REV'D	DWG. NO.
								9321-F-2737-55


STATION INDIAN POINT

UFSAR FIGURE No. 9.2-1 (SHT. 3)

SCALE NONE

CON Edison

609327

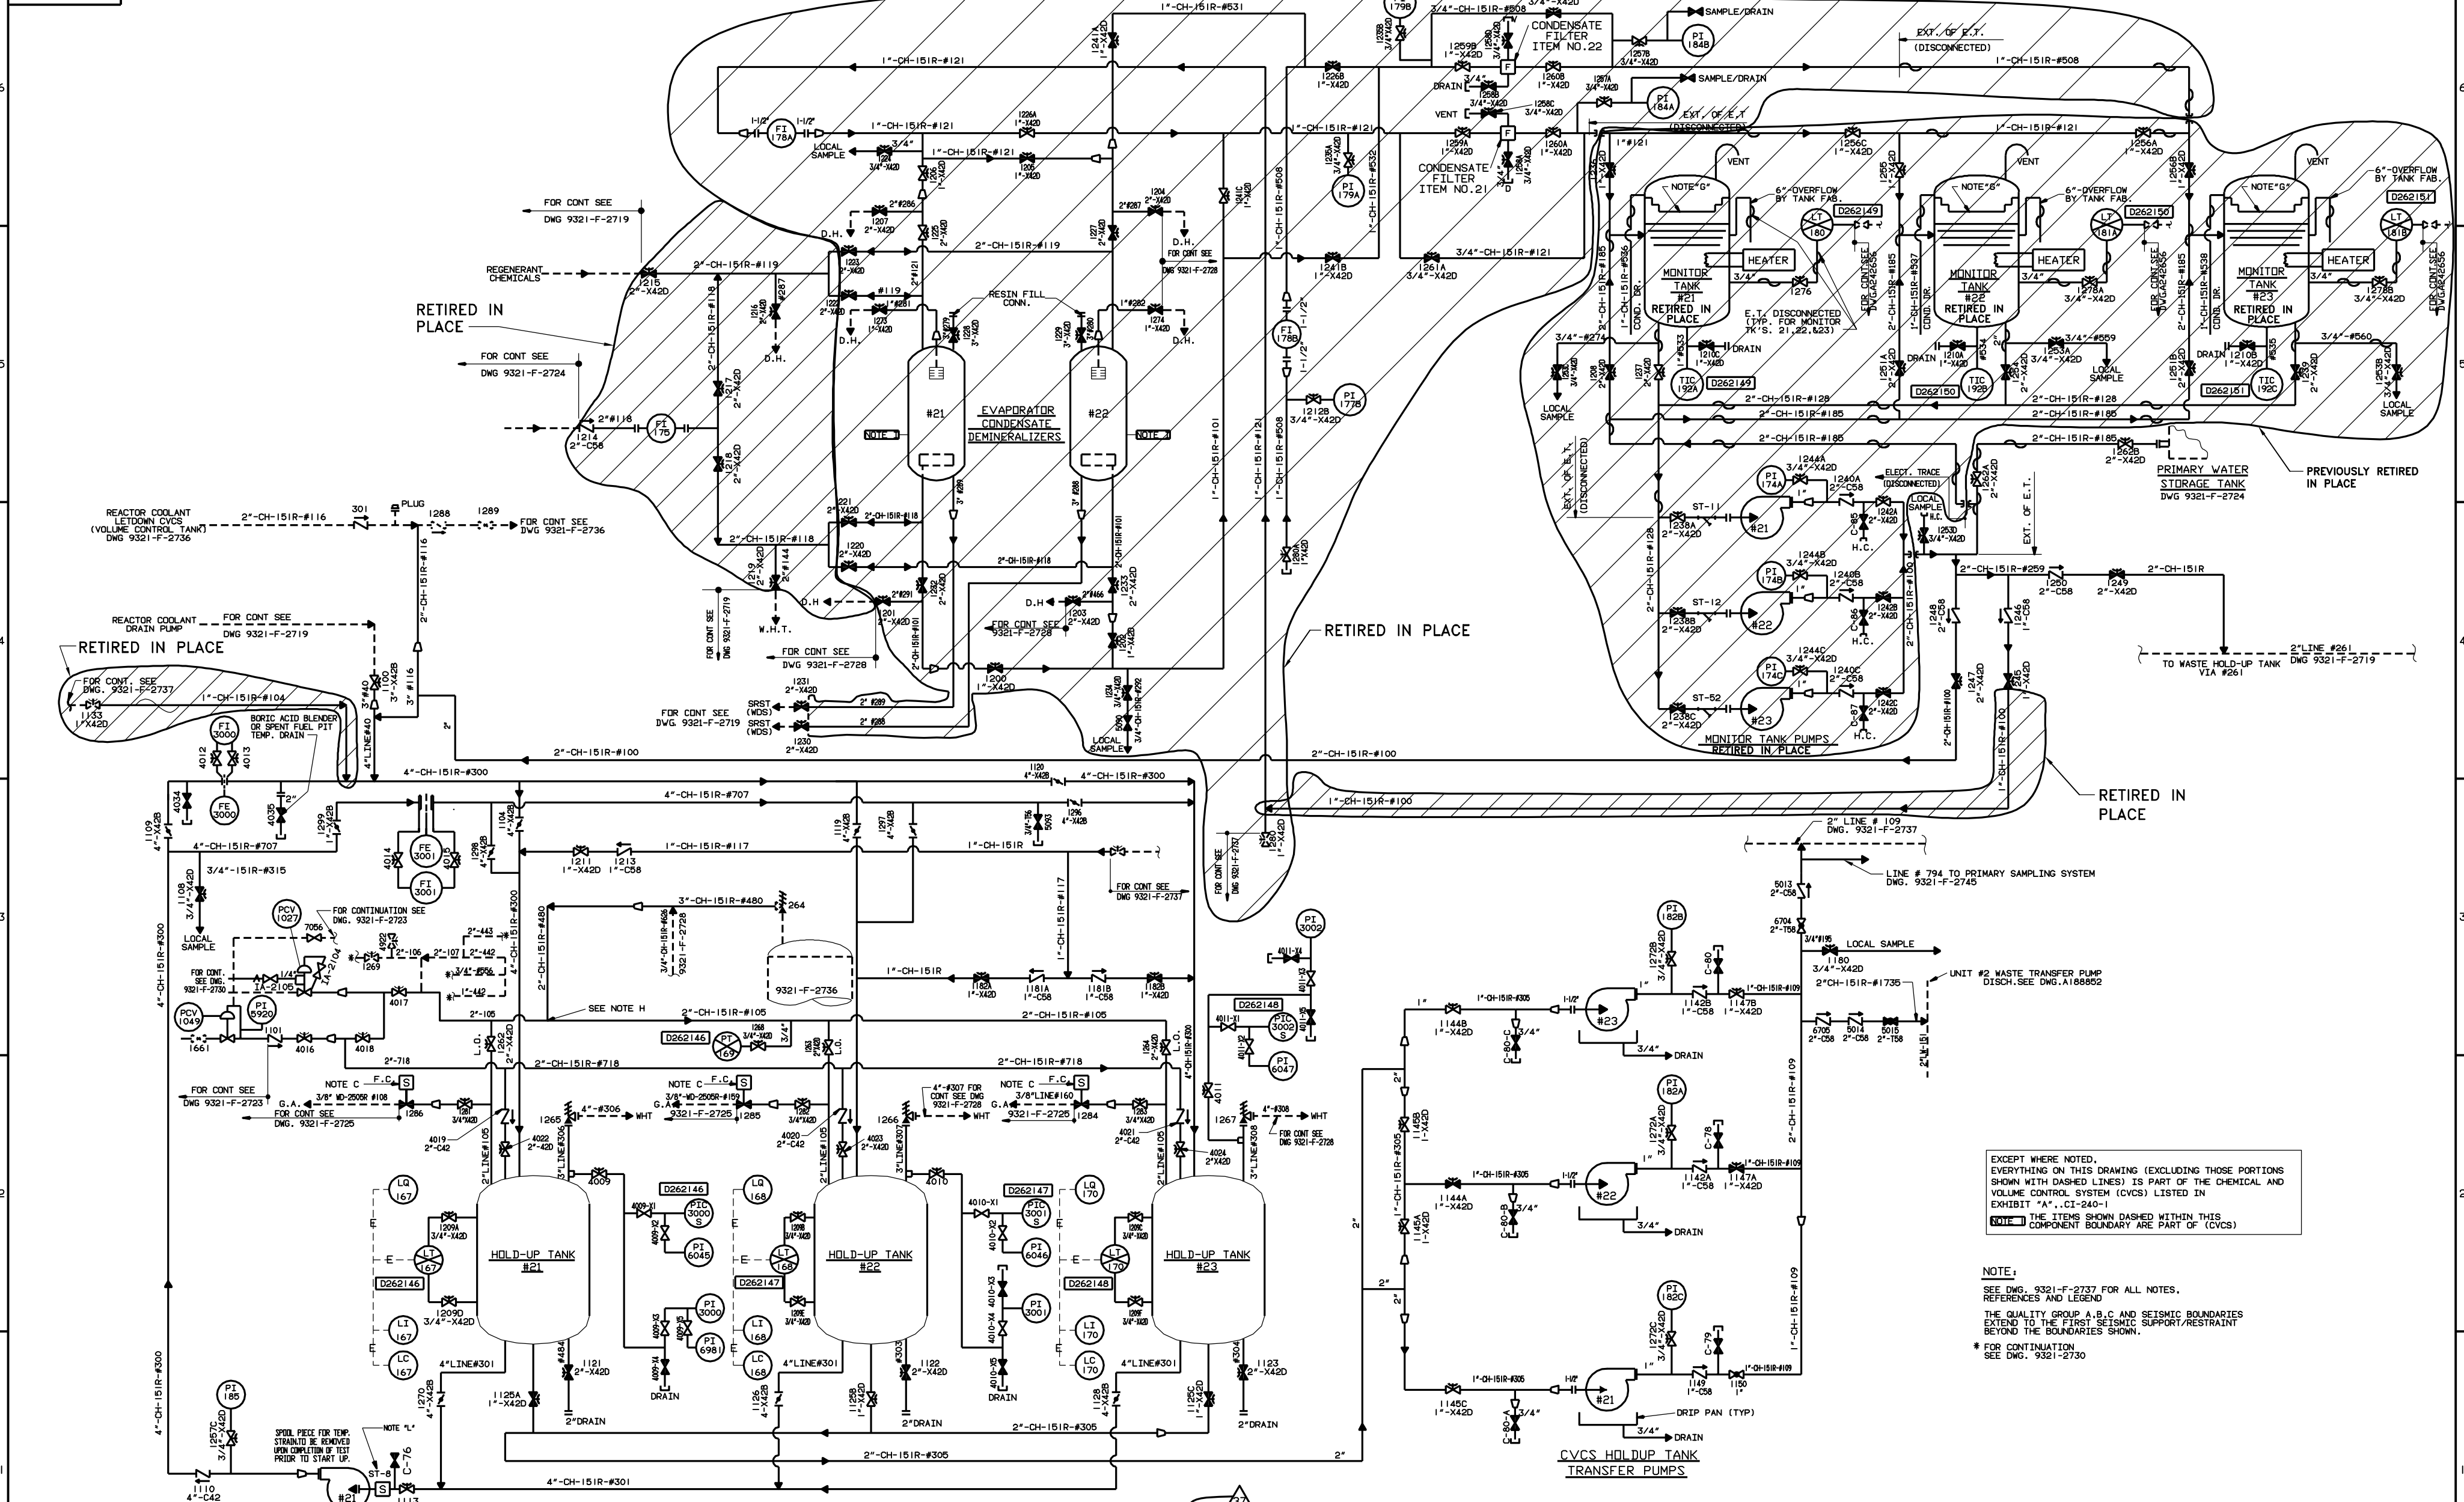



EXCEPT WHERE NOTED, EVERYTHING ON THIS DRAWING (EXCLUDING THOSE PORTIONS SHOWN WITH DASHED LINES) IS PART OF THE CHEMICAL AND VOLUME CONTROL SYSTEM (CVCS) LISTED IN EXHIBIT "A", CI-240-1. THE ITEMS SHOWN DASHED WITHIN THIS NOTE COMPONENT BOUNDARY ARE PART OF (CVCS)

NOTE:  
 SEE DWG. 9321-F-2737 FOR ALL NOTES, REFERENCES AND LEGEND.  
 THE QUALITY GROUP A, B, C AND SEISMIC BOUNDARIES EXTEND TO THE FIRST SEISMIC SUPPORT/RESTRAINT BEYOND THE BOUNDARIES SHOWN.  
 \* FOR CONTINUATION SEE DWG. 9321-F-2730

WORK THIS DRAWING WITH 9321-F-2737

37	INCORPORATED EC 16545	8/05/09	WVR	APPROVAL SIGNATURES ON FILE
REV	DESCRIPTION	DATE	BY	CHK
1				
2				
3				
4				
5				
6				
7				
8				
9				
10				

THIS REVISION IS NON-CLASS PER Q-240-1. UPDATED DWG. TO SHOW RETIRED BORON RECOVERY EQUIPMENT PER CR 89806527. RELEASED AS CONSTRUCTED. D.B./G.B. 03/12/01	23 / 88 D.P. W.J. KING 2/23/88	TITLE: FLOW DIAGRAM CHEMICAL & VOLUME CONTROL SYSTEM UFSAR FIGURE No. 9.2-1 (SHT. 4) SCALE: NONE RECD:	STATION INDIAN POINT Entergy INDIAN POINT
S. BHALLA 03/12/01 ENG	APPROVALS DATE REVIEW	APPROVALS DATE REVIEW	DWG. NO. A235309-37 MY

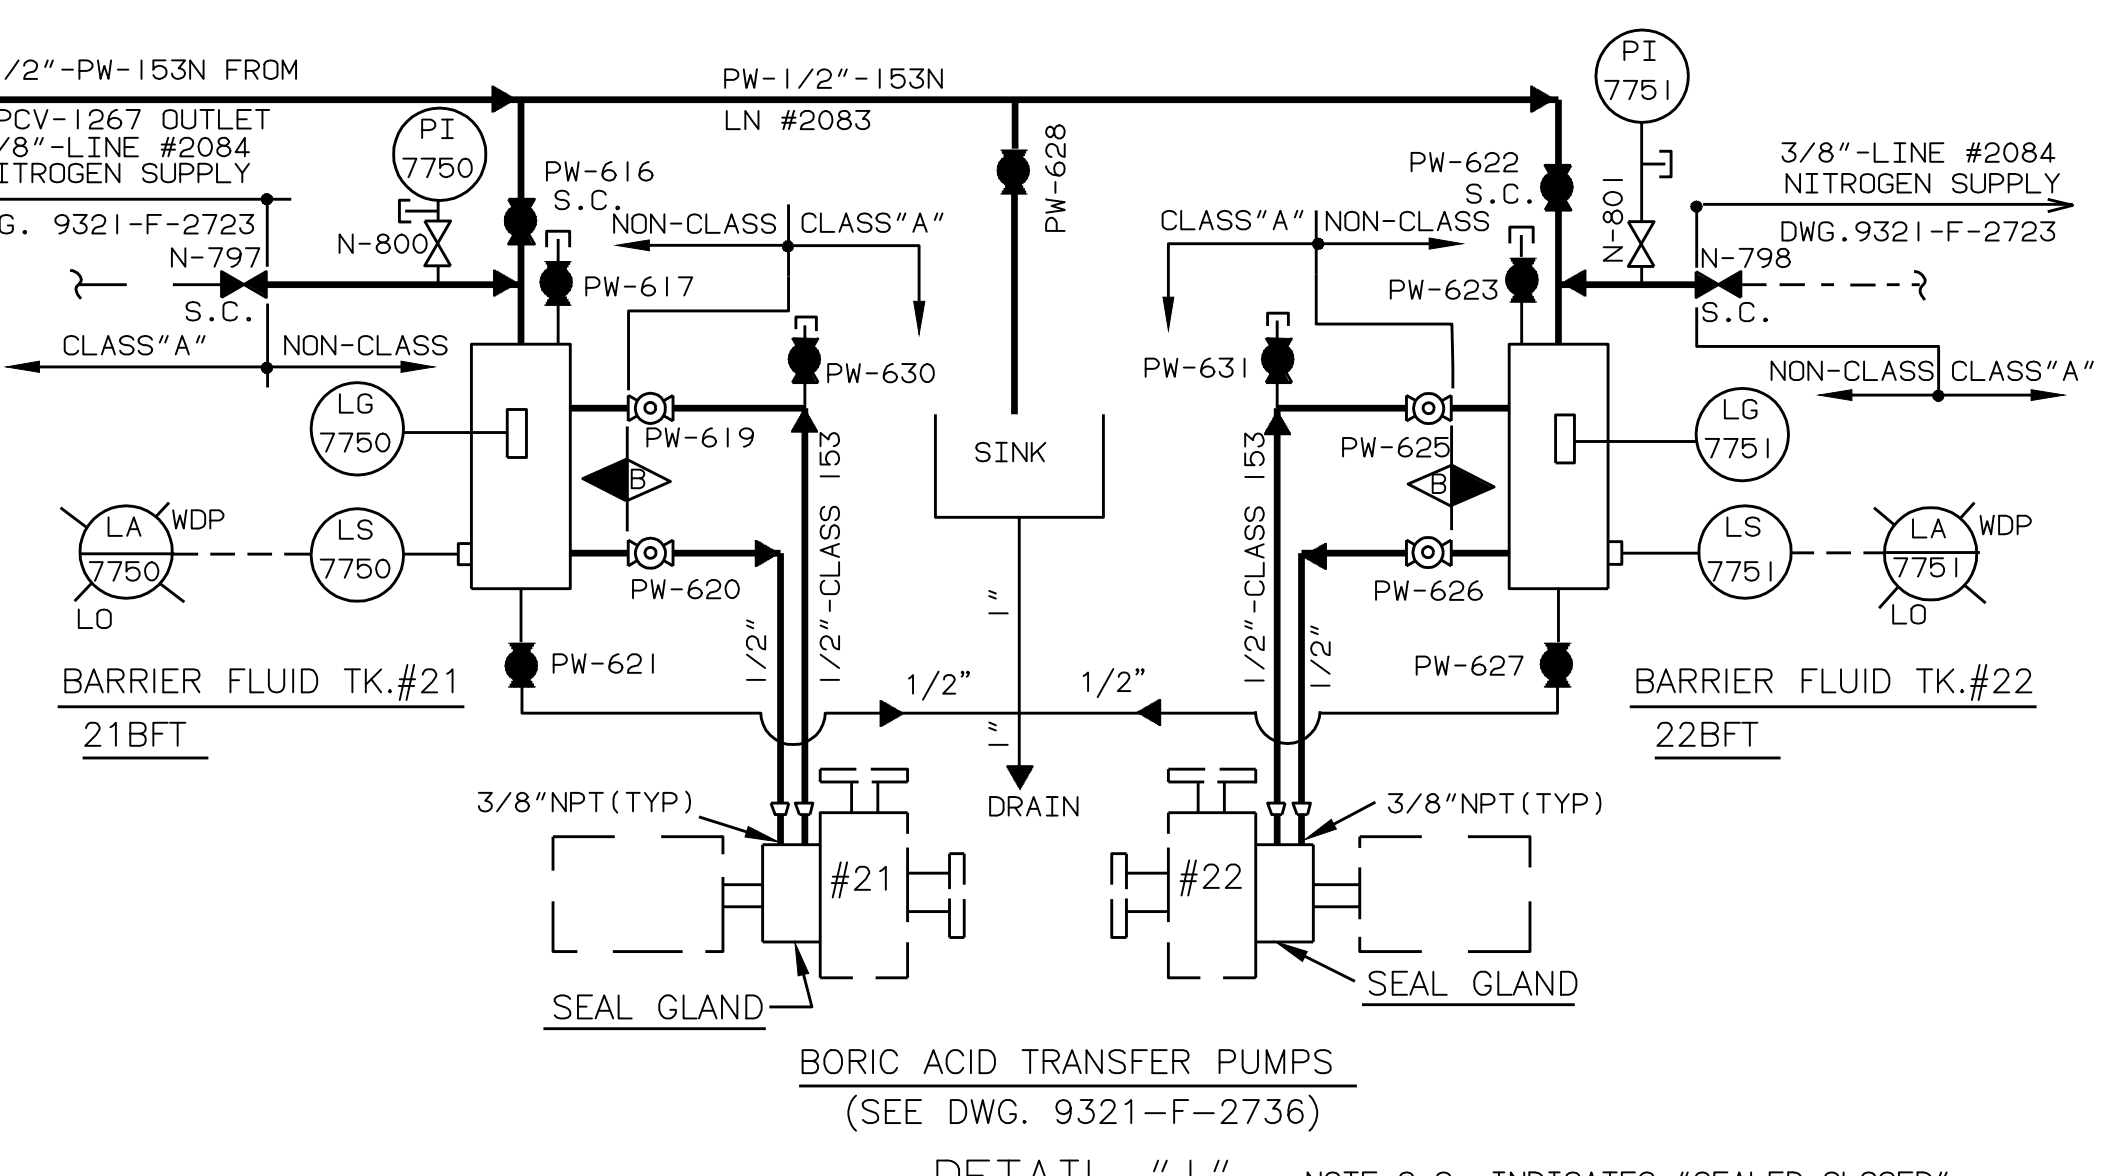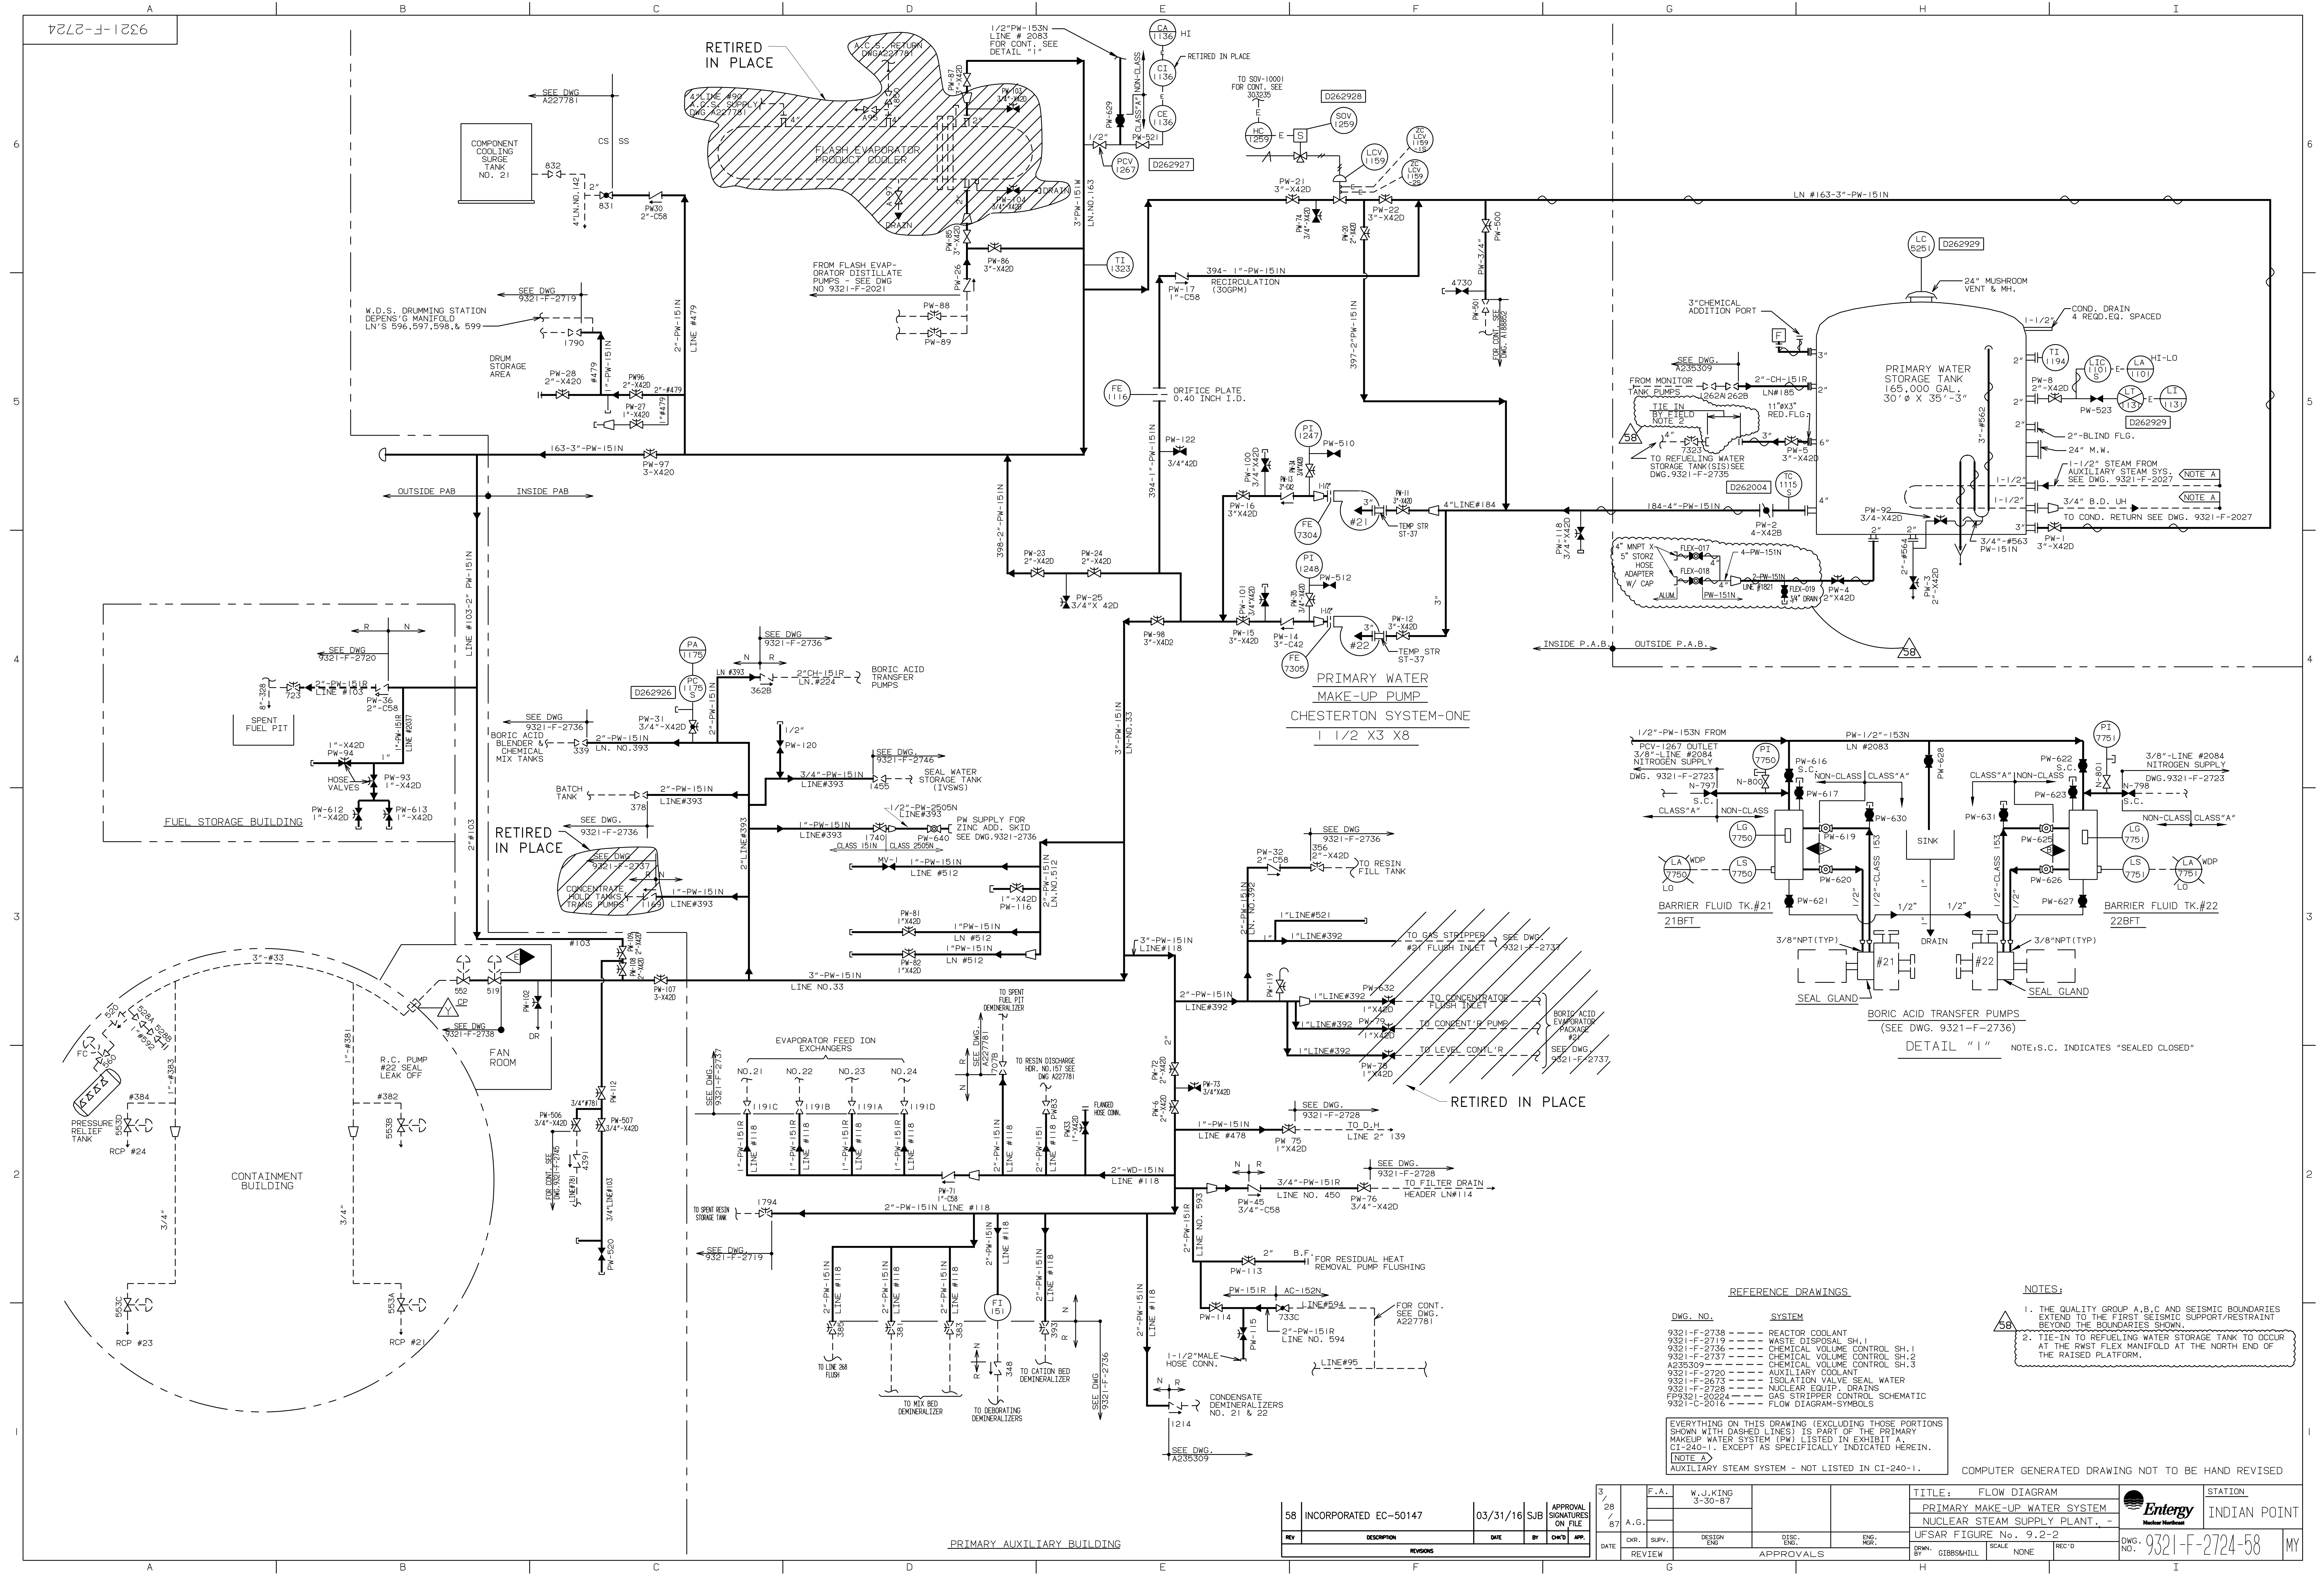

**REFERENCE DRAWINGS.**

DWG. NO.	SYSTEM
9321-F-2738	REACTOR COOLANT
9321-F-2719	WASTE DISPOSAL SH.1
9321-F-2736	CHEMICAL VOLUME CONTROL SH.1
9321-F-2737	CHEMICAL VOLUME CONTROL SH.2
A235309	CHEMICAL VOLUME CONTROL SH.3
9321-F-2720	AUXILIARY COOLANT
9321-F-2673	ISOLATION VALVE SEAL WATER
9321-F-2728	NUCLEAR EQUIP. DRAINS
F9321-20624	GAS STRIPPER CONTROL SCHEMATIC
9321-C-2016	FLOW DIAGRAM-SYMBOLS

**NOTES:**

1. THE QUALITY GROUP A, B, C AND SEISMIC BOUNDARIES EXTEND TO THE FIRST SEISMIC SUPPORT RESTRAINT BEYOND THE BOUNDARIES SHOWN.
2. TIE-IN TO REFUELING WATER STORAGE TANK TO OCCUR AT THE FIRST FLEX MANIFOLD AT THE NORTH END OF THE RAISED PLATFORM.


EVERYTHING ON THIS DRAWING (EXCLUDING THOSE PORTIONS SHOWN WITH DASHED LINES) IS PART OF THE PRIMARY MAKEUP WATER SYSTEM (PW) LISTED IN EXHIBIT A, CI-240-1, EXCEPT AS SPECIFICALLY INDICATED HEREIN.

NOTE A: AUXILIARY WATER SYSTEM - NOT LISTED IN CI-240-1.

COMPUTER GENERATED DRAWING NOT TO BE HAND REVISED

58	INCORPORATED EC-50147	03/31/16	SJB	APPROVAL SIGNATURES ON FILE	DATE	CHK.	REV.	SESSION	DATE	SCALE	REC'D	BY	61886SHILL	SCALE	NONE	REC'D	BY	61886SHILL																											
<table border="1"> <tr> <td colspan="12"> <b>TITLE:</b> FLOW DIAGRAM                  PRIMARY MAKE-UP WATER SYSTEM                  NUCLEAR STEAM SUPPLY PLANT, -                  LFSAR FIGURE NO. 9.2-2             </td> <td colspan="2"> <b>STATION:</b>                  INDIAN POINT             </td> </tr> <tr> <td colspan="12"> <b>DWG. NO.:</b> 9321-F-2724-58             </td> <td colspan="2"> <b>MY</b> </td> </tr> </table>																		<b>TITLE:</b> FLOW DIAGRAM PRIMARY MAKE-UP WATER SYSTEM NUCLEAR STEAM SUPPLY PLANT, - LFSAR FIGURE NO. 9.2-2												<b>STATION:</b> INDIAN POINT		<b>DWG. NO.:</b> 9321-F-2724-58												<b>MY</b>	
<b>TITLE:</b> FLOW DIAGRAM PRIMARY MAKE-UP WATER SYSTEM NUCLEAR STEAM SUPPLY PLANT, - LFSAR FIGURE NO. 9.2-2												<b>STATION:</b> INDIAN POINT																																	
<b>DWG. NO.:</b> 9321-F-2724-58												<b>MY</b>																																	

PRIMARY AUXILIARY BUILDING

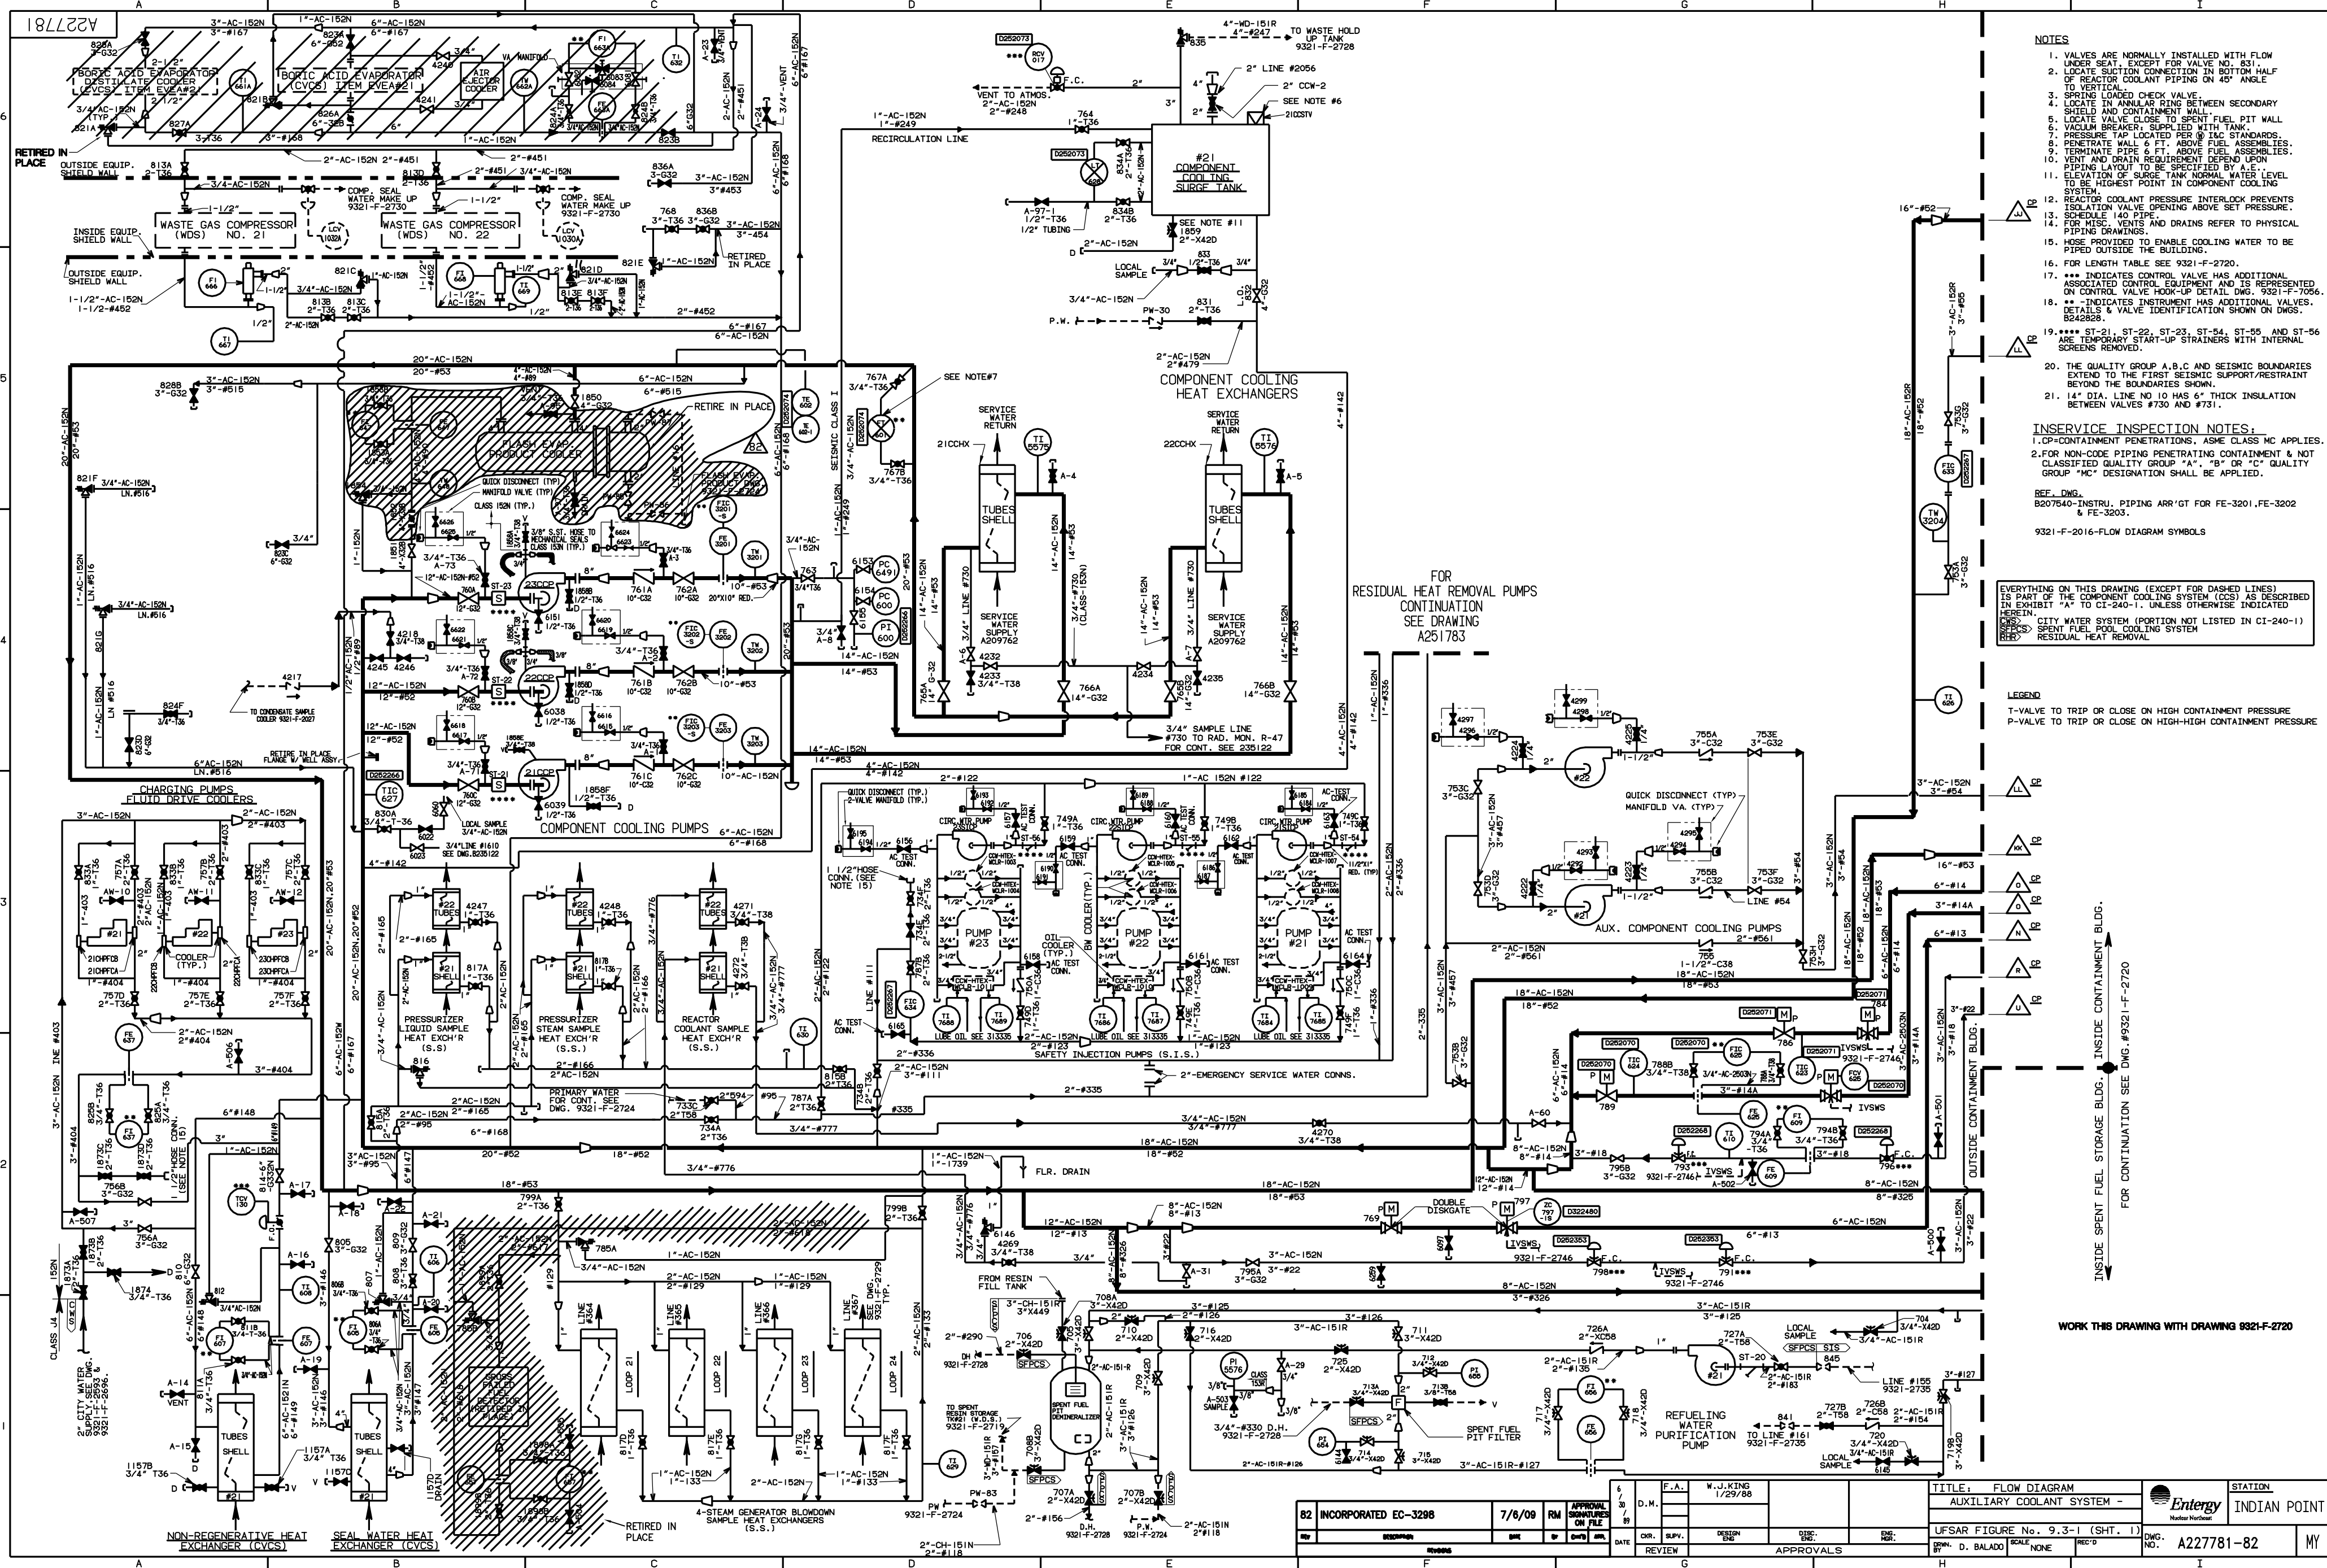

- NOTES**
1. VALVES ARE NORMALLY INSTALLED WITH FLOW UNDER SEAT, EXCEPT FOR VALVE # 831.
  2. LOCATE SUCTION CONNECTION IN BOTTOM HALF OF REACTOR COOLANT PIPING ON 45° ANGLE TO VERTICAL.
  3. SPRING LOADED CHECK VALVE.
  4. LOCATE IN ANNULAR RING BETWEEN SECONDARY SHIELD AND CONTAINMENT WALL.
  5. VACUUM BREAKER, SUPPLIED WITH TANK.
  6. PRESSURE TAP LOCATED PER 8" IAC STANDARDS.
  7. PENETRATE WALL 6 FT. ABOVE FUEL ASSEMBLIES.
  8. TERMINATE PIPE 6 FT. ABOVE FUEL ASSEMBLIES.
  9. VENT AND DRAIN REQUIREMENT DEPEND UPON PIPING LAYOUT TO BE SPECIFIED BY A.E.
  10. ELEVATION OF SURGE TANK NORMAL WATER LEVEL TO BE HIGHEST POINT IN COMPONENT COOLING SYSTEM.
  11. ISOLATION COOLANT PRESSURE INTERLOCK PREVENTS ASSOCIATED CONTROL EQUIPMENT AND IS REPRESENTED ON CONTROL VALVE HOOD-UP DETAIL DWG. 9321-F-7056.
  12. SCHEDULE 140 PIPE.
  13. FOR MISC. VENTS AND DRAINS REFER TO PHYSICAL PIPING DRAWINGS.
  14. HOSE PROVIDED TO ENABLE COOLING WATER TO BE PIPED OUTSIDE THE BUILDING.
  15. FOR LENGTH TABLE SEE 9321-F-2720.
  16. \*\*\* INDICATES CONTROL VALVE HAS ADDITIONAL ASSOCIATED CONTROL EQUIPMENT AND IS REPRESENTED ON CONTROL VALVE HOOD-UP DETAIL DWG. 9321-F-7056.
  17. \*\* INDICATES INSTRUMENT HAS ADDITIONAL VALVES. DETAILS & VALVE IDENTIFICATION SHOWN ON DWGS. B242828.
  18. ST-21, ST-22, ST-23, ST-54, ST-55 AND ST-56 ARE TEMPORARY START-UP STRAINERS WITH INTERNAL SCREENS REMOVED.
  19. THE QUALITY GROUP A, B, C AND SEISMIC BOUNDARIES EXTEND TO THE FIRST SEISMIC SUPPORT/RESTRAINT BEYOND THE BOUNDARIES SHOWN.
  20. 1 1/2" DIA. LINE NO 10 HAS 6" THICK INSULATION BETWEEN VALVES #730 AND #731.

**INSERVICE INSPECTION NOTES:**  
 1. CP-CONTAINMENT PENETRATIONS, ASME CLASS MC APPLIES.  
 2. FOR NON-CODE PIPING PENETRATING CONTAINMENT & NOT CLASSIFIED QUALITY GROUP "A", "B" OR "C" QUALITY GROUP "MC" DESIGNATION SHALL BE APPLIED.

REF. DWG. B207540-INSTRU. PIPING ARR'GT FOR FE-3201, FE-3202 & FE-3203.  
 9321-F-2016-FLOW DIAGRAM SYMBOLS


EVERYTHING ON THIS DRAWING (EXCEPT FOR DASHED LINES) IS PART OF THE COMPONENT COOLING SYSTEM (CCS) AS DESCRIBED IN EXHIBIT "A" TO CI-240-1, UNLESS OTHERWISE INDICATED HEREIN.  
 (S.S.) SPENT FUEL POOL COOLING SYSTEM  
 (RHR) RESIDUAL HEAT REMOVAL

**LEGEND**  
 T-VALVE TO TRIP OR CLOSE ON HIGH CONTAINMENT PRESSURE  
 P-VALVE TO TRIP OR CLOSE ON HIGH-HIGH CONTAINMENT PRESSURE

FOR CONTINUATION SEE DWG. #9321-F-2720  
 INSIDE SPENT FUEL STORAGE BLDG.  
 INSIDE CONTAINMENT BLDG.  
 OUTSIDE CONTAINMENT BLDG.

WORK THIS DRAWING WITH DRAWING 9321-F-2720

82 INCORPORATED EC-3298		7/6/09	RM	APPROVAL SIGNATURE ON FILE	D.H.	F.A.	W.J. KING	1/29/88	STATION	INDIAN POINT
UFSAR FIGURE No. 9.3-1 (SHT. 1)		DWG. NO. A227781-82		REV. DATE		DESIGN		APPROVALS		MY

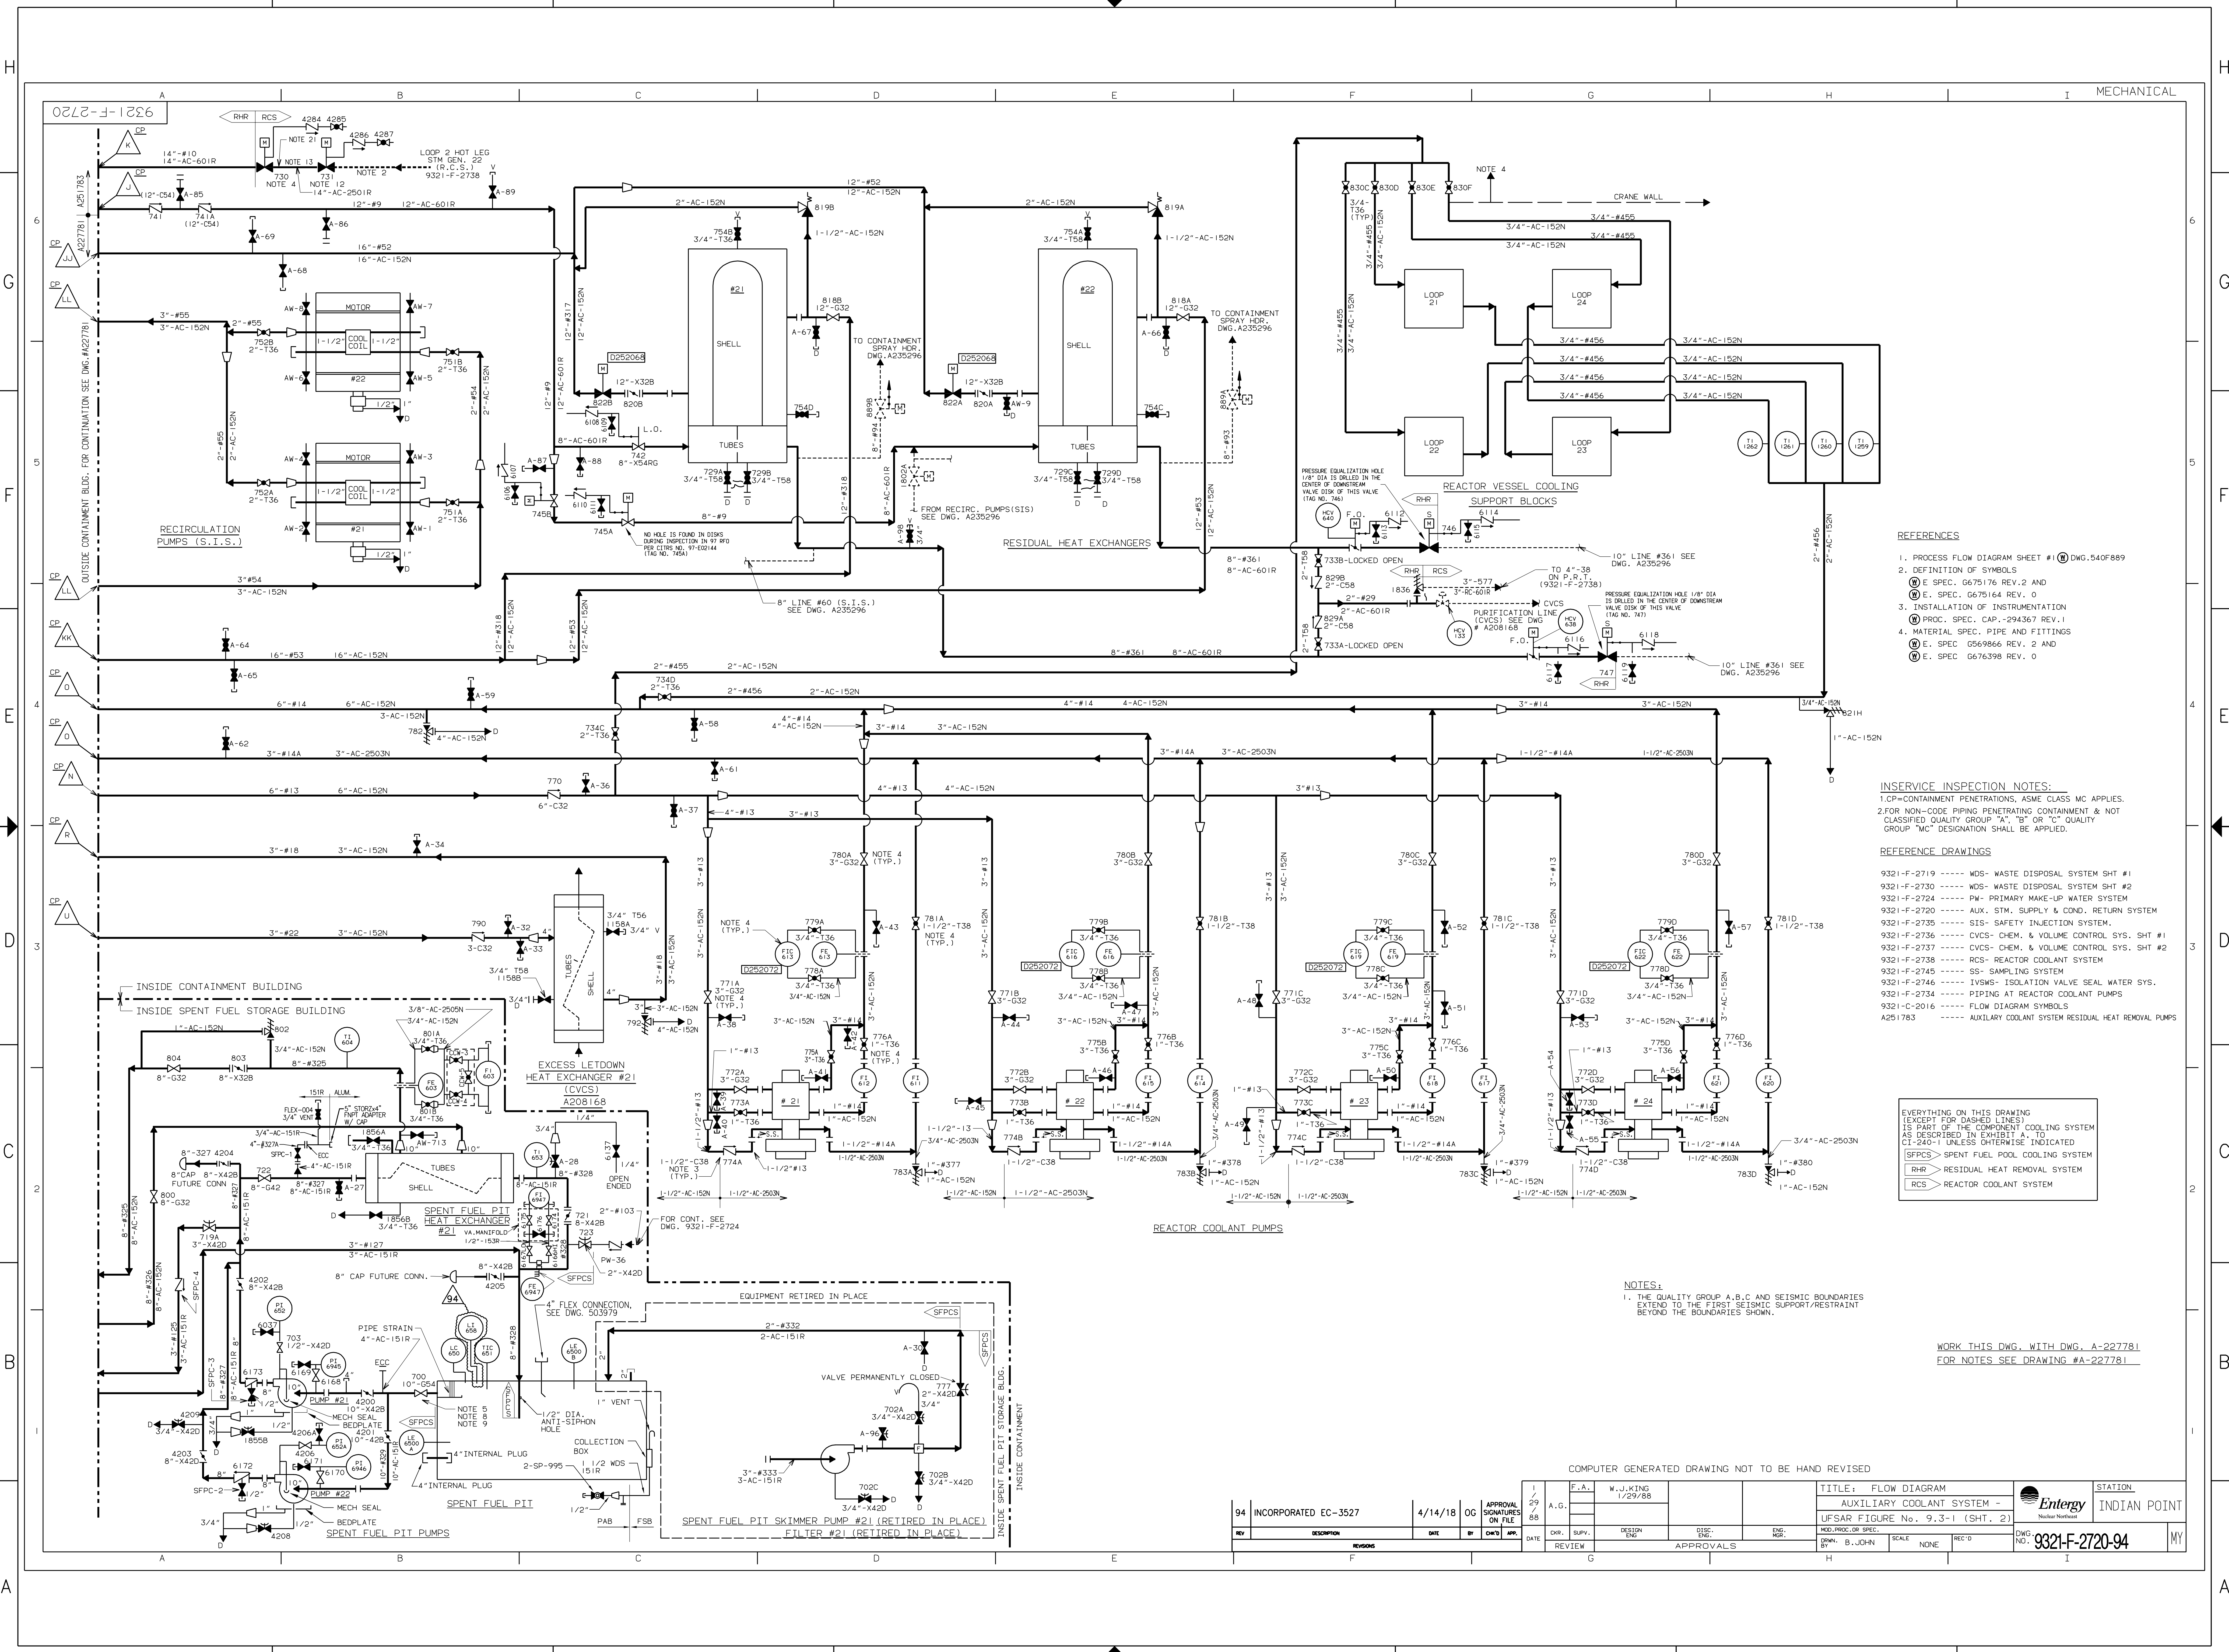

- REFERENCES**
1. PROCESS FLOW DIAGRAM SHEET #1 (DWG. 540F889)
  2. DEFINITION OF SYMBOLS
  3. E. SPEC. 6675176 REV. 2 AND 6675164 REV. 0
  4. INSTALLATION OF INSTRUMENTATION
  5. PROC. SPEC. CAP.-294367 REV. 1
  6. MATERIAL SPEC. PIPE AND FITTINGS
  7. E. SPEC 0569866 REV. 2 AND 6675398 REV. 0

- INSERVICE PENETRATION NOTES:**
1. CP=CONTAINMENT PENETRATIONS, ASME CLASS MC APPLIES.
  2. FOR NON-CODE PIPING PENETRATING CONTAINMENT & NOT CLASSIFIED QUALITY GROUP "A," "B" OR "C" QUALITY GROUP "MC" DESIGNATION SHALL BE APPLIED.

- REFERENCE DRAWINGS**
- 9321-F-2719 ---- WDS- WASTE DISPOSAL SYSTEM SHT #1
  - 9321-F-2730 ---- WDS- WASTE DISPOSAL SYSTEM SHT #2
  - 9321-F-2724 ---- PW- PRIMARY MAKE-UP WATER SYSTEM
  - 9321-F-2735 ---- AUX. STM. SUPPLY & COND. RETURN SYSTEM
  - 9321-F-2735 ---- SIS- SAFETY INJECTION SYSTEM
  - 9321-F-2736 ---- CVCS- CHEM. & VOLUME CONTROL SYS. SHT #1
  - 9321-F-2737 ---- CVCS- CHEM. & VOLUME CONTROL SYS. SHT #2
  - 9321-F-2738 ---- RCS- REACTOR COOLANT SYSTEM
  - 9321-F-2745 ---- SS- SAMPLING SYSTEM
  - 9321-F-2746 ---- ISVWS- ISOLATION VALVE SEAL WATER SYS.
  - 9321-F-2754 ---- PIPING AT REACTOR COOLANT PUMPS
  - 9321-C-2016 ---- FLOW DIAGRAM SYMBOLS
  - A251783 ---- AUXILIARY COOLANT SYSTEM RESIDUAL HEAT REMOVAL PUMPS

EVERYTHING ON THIS DRAWING (EXCEPT FOR DASHED LINES) IS PART OF THE COMPONENT COOLING SYSTEM AS DESCRIBED IN EXHIBIT A TO CI-240-1 UNLESS OTHERWISE INDICATED

- SFPCS- SPENT FUEL POOL COOLING SYSTEM
- RHR- RESIDUAL HEAT REMOVAL SYSTEM
- RCS- REACTOR COOLANT SYSTEM

**NOTES:**


1. THE QUALITY GROUP A,B,C AND SEISMIC BOUNDARIES EXTEND TO THE FIRST SEISMIC SUPPORT/RESTRAINT BEYOND THE BOUNDARIES SHOWN.

WORK THIS DWG. WITH DWG. A-227781 FOR NOTES SEE DRAWING #A-227781

COMPUTER GENERATED DRAWING NOT TO BE HAND REVISED

94	INCORPORATED EC-3527	4/14/18	OG	APPROVAL SIGNATURES ON FILE	1 / 29 / 88	E.A. G.	W.J.KING 1/29/88	TITLE: FLOW DIAGRAM AUXILIARY COOLANT SYSTEM - UFSAR FIGURE No. 9.3-1 (SHT. 2)	STATION: INDIAN POINT
REV	DESCRIPTION	DATE	BY	CHK'D	APP.	DESIGN	DESIGN	SCALE	REC'D

DWG. NO. 9321-F-2720-94

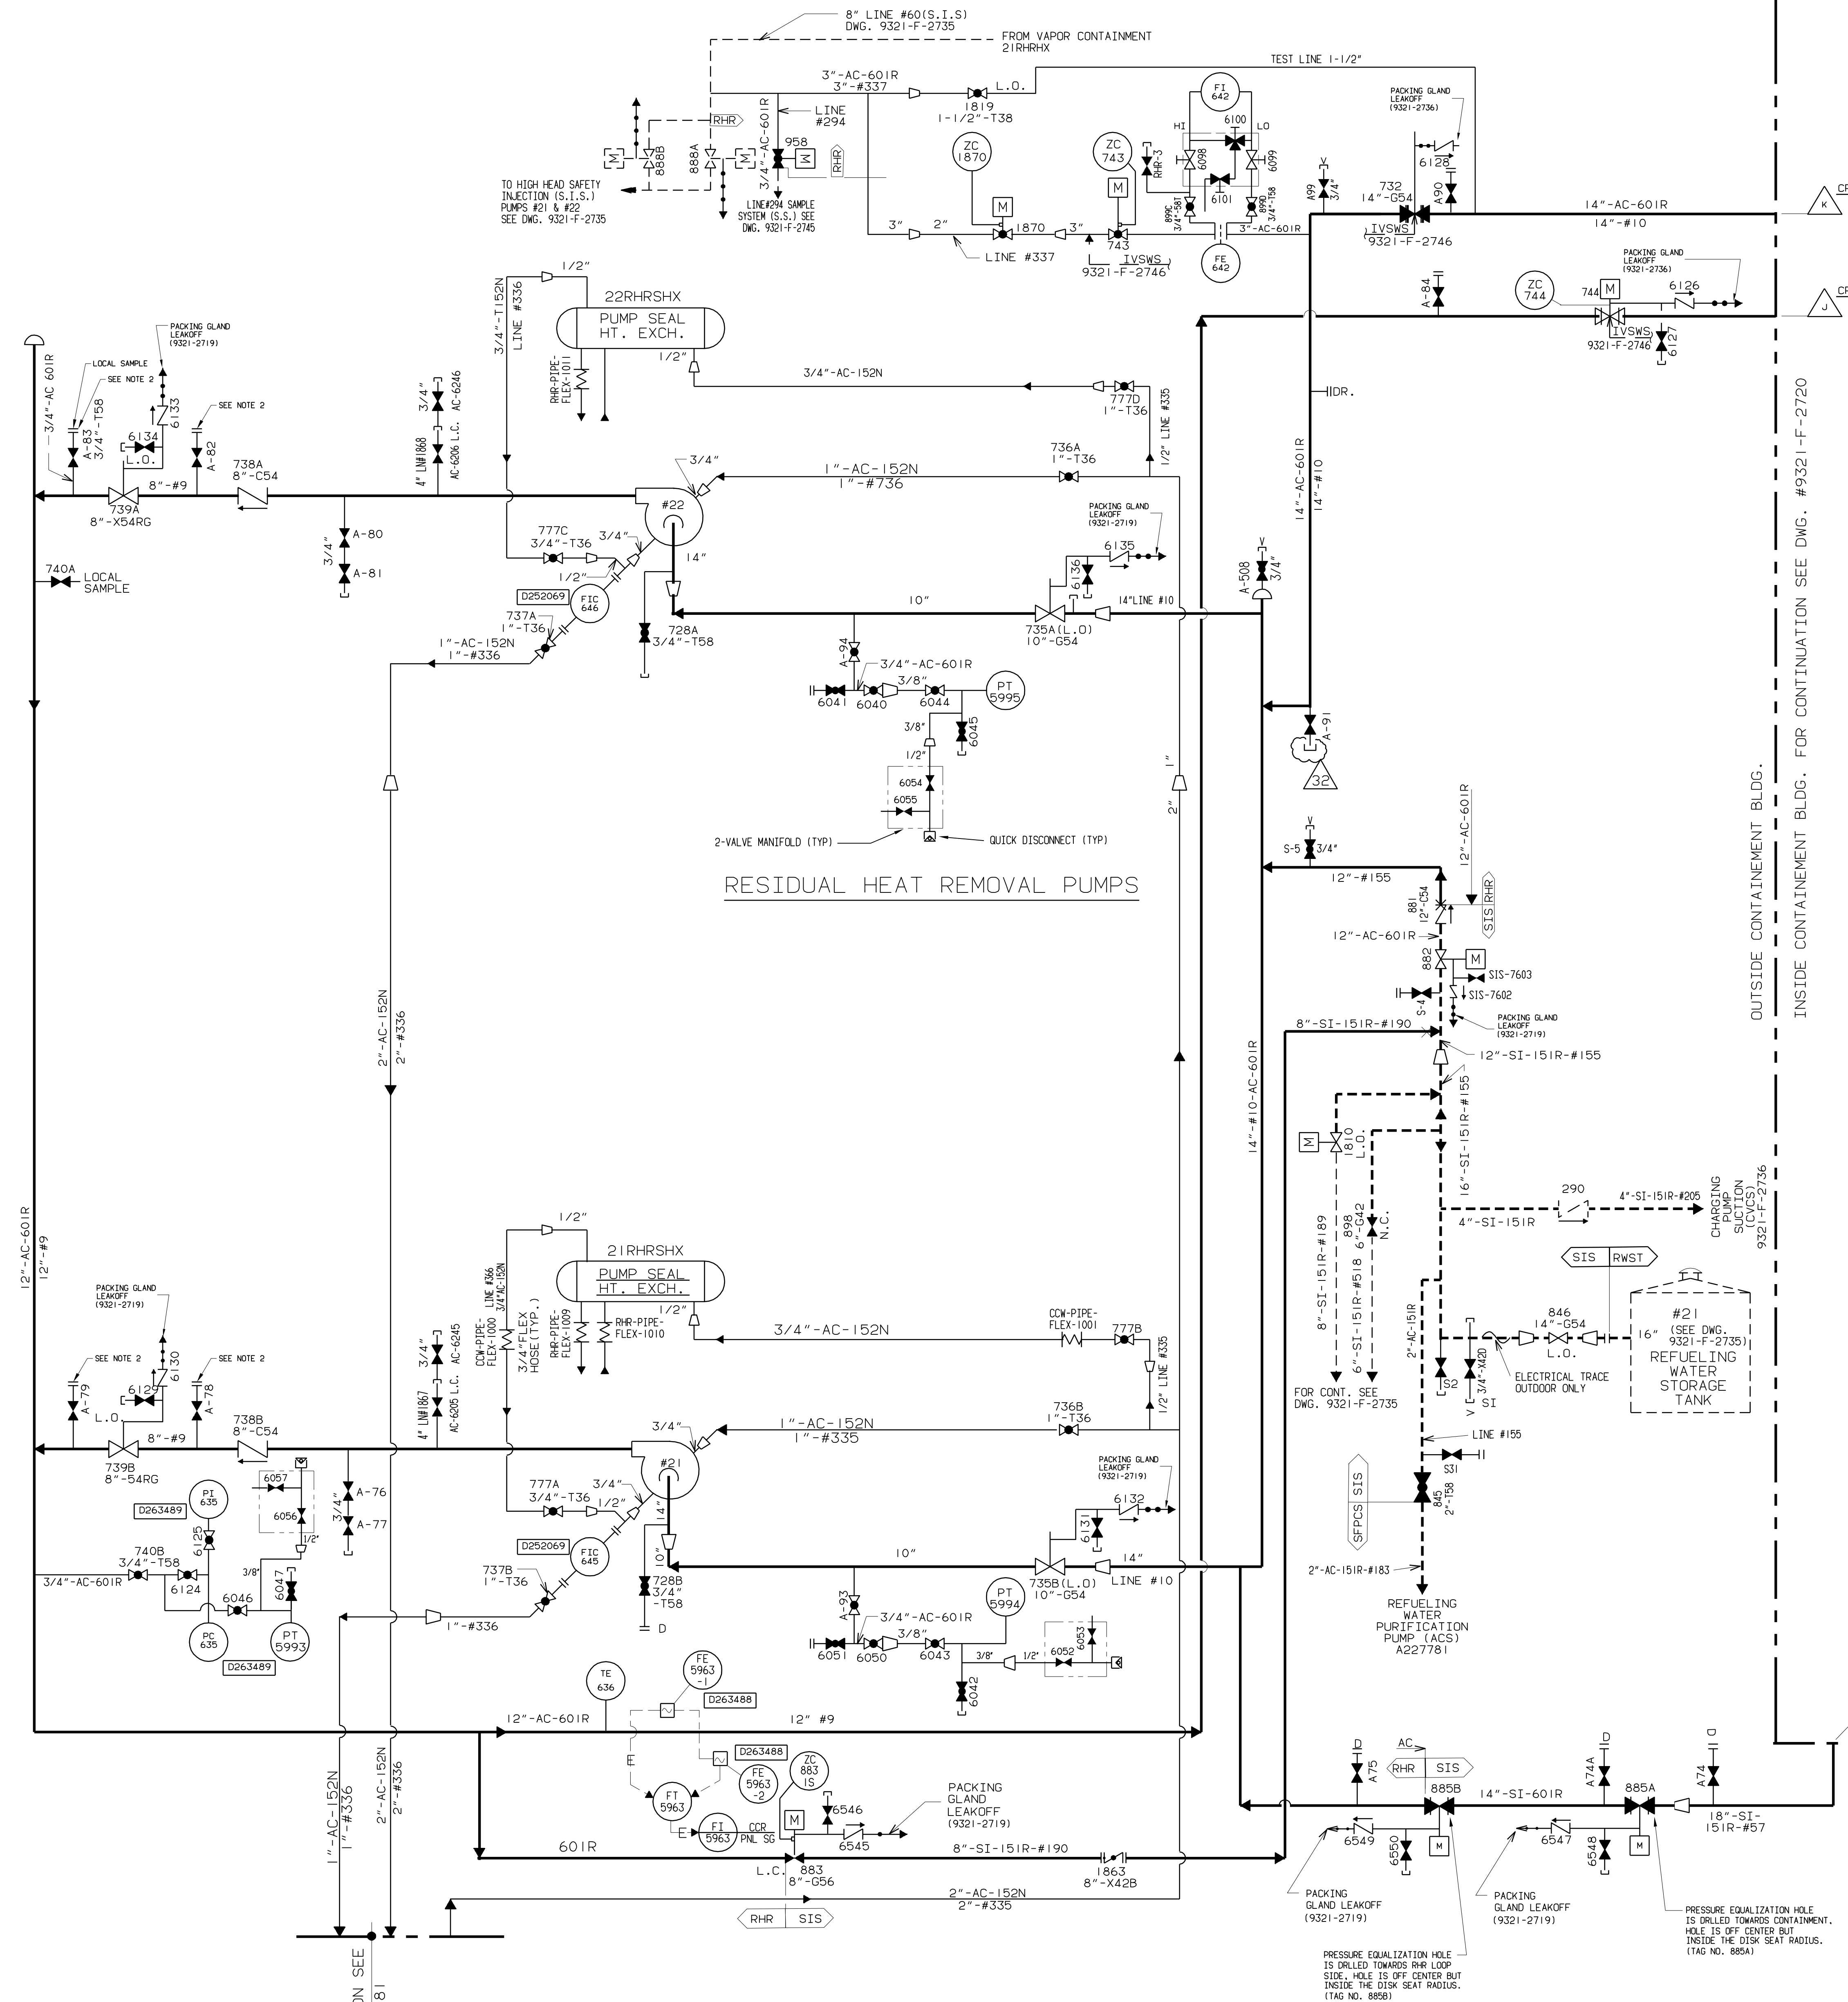

RESIDUAL HEAT REMOVAL PUMPS

INSIDE CONTAINMENT BLDG. FOR CONTINUATION SEE DWG. #9321-F-2720

OUTSIDE CONTAINMENT BLDG.

- NOTES:
1. THE QUALITY GROUP A,B,C AND SEISMIC BOUNDARIES EXTEND TO THE FIRST SEISMIC SUPPORT/RESTRAINT BEYOND THE BOUNDARIES SHOWN.
  2. FLANGES HAVE A 1500W RATING (ONLY WHERE NOTED).
- INSERVICE INSPECTION NOTES:
1. CP=CONTAINMENT PENETRATIONS, ASME CLASS MC APPLIES.
  2. FOR NON-CODE PIPING PENETRATING CONTAINMENT & NOT CLASSIFIED QUALITY GROUP "A", "B" OR "C" QUALITY GROUP "MC" DESIGNATION SHALL BE APPLIED.

FOR NOTES AND REF. DWGS. SEE DWG. A227781


THIS DWG. TO BE REVISED ONLY IN AUTOCAD.

32	INCORPORATED EC-58811	4/6/16	VMR	APPROVAL SIGNATURES ON FILE
REV	DESCRIPTION	DATE	BY	CHKD
1		04/10/03	M.RADWANSKY	
2				


THIS REVISION IS CLASS A PER THE QAPD. UPDATED DWG TO SHOW THE WORK DONE ON MOD. PROC # FTX-91-07049-M, DMT-07049 SH. 61, & DMD251783-AN REV. 00 RELEASED AS CONSTRUCTED P.N. 07049-S1

6/26/92	G.B.	F.A.	W.J. KING	6-26-92
DATE	DR.	SUPV.	DESIGN	ENG.

TITLE:	FLOW DIAGRAM	STATION	INDIAN POINT
	AUXILIARY COOLANT SYSTEM		
	RESIDUAL HEAT REMOVAL PUMPS -		
	UFSAR FIGURE No. 9.3-1 (SHT. 3)		
DWG. NO.	A251783-32	SCALE	NONE

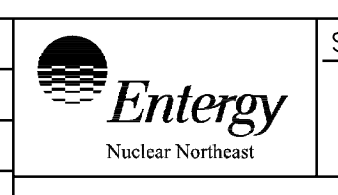



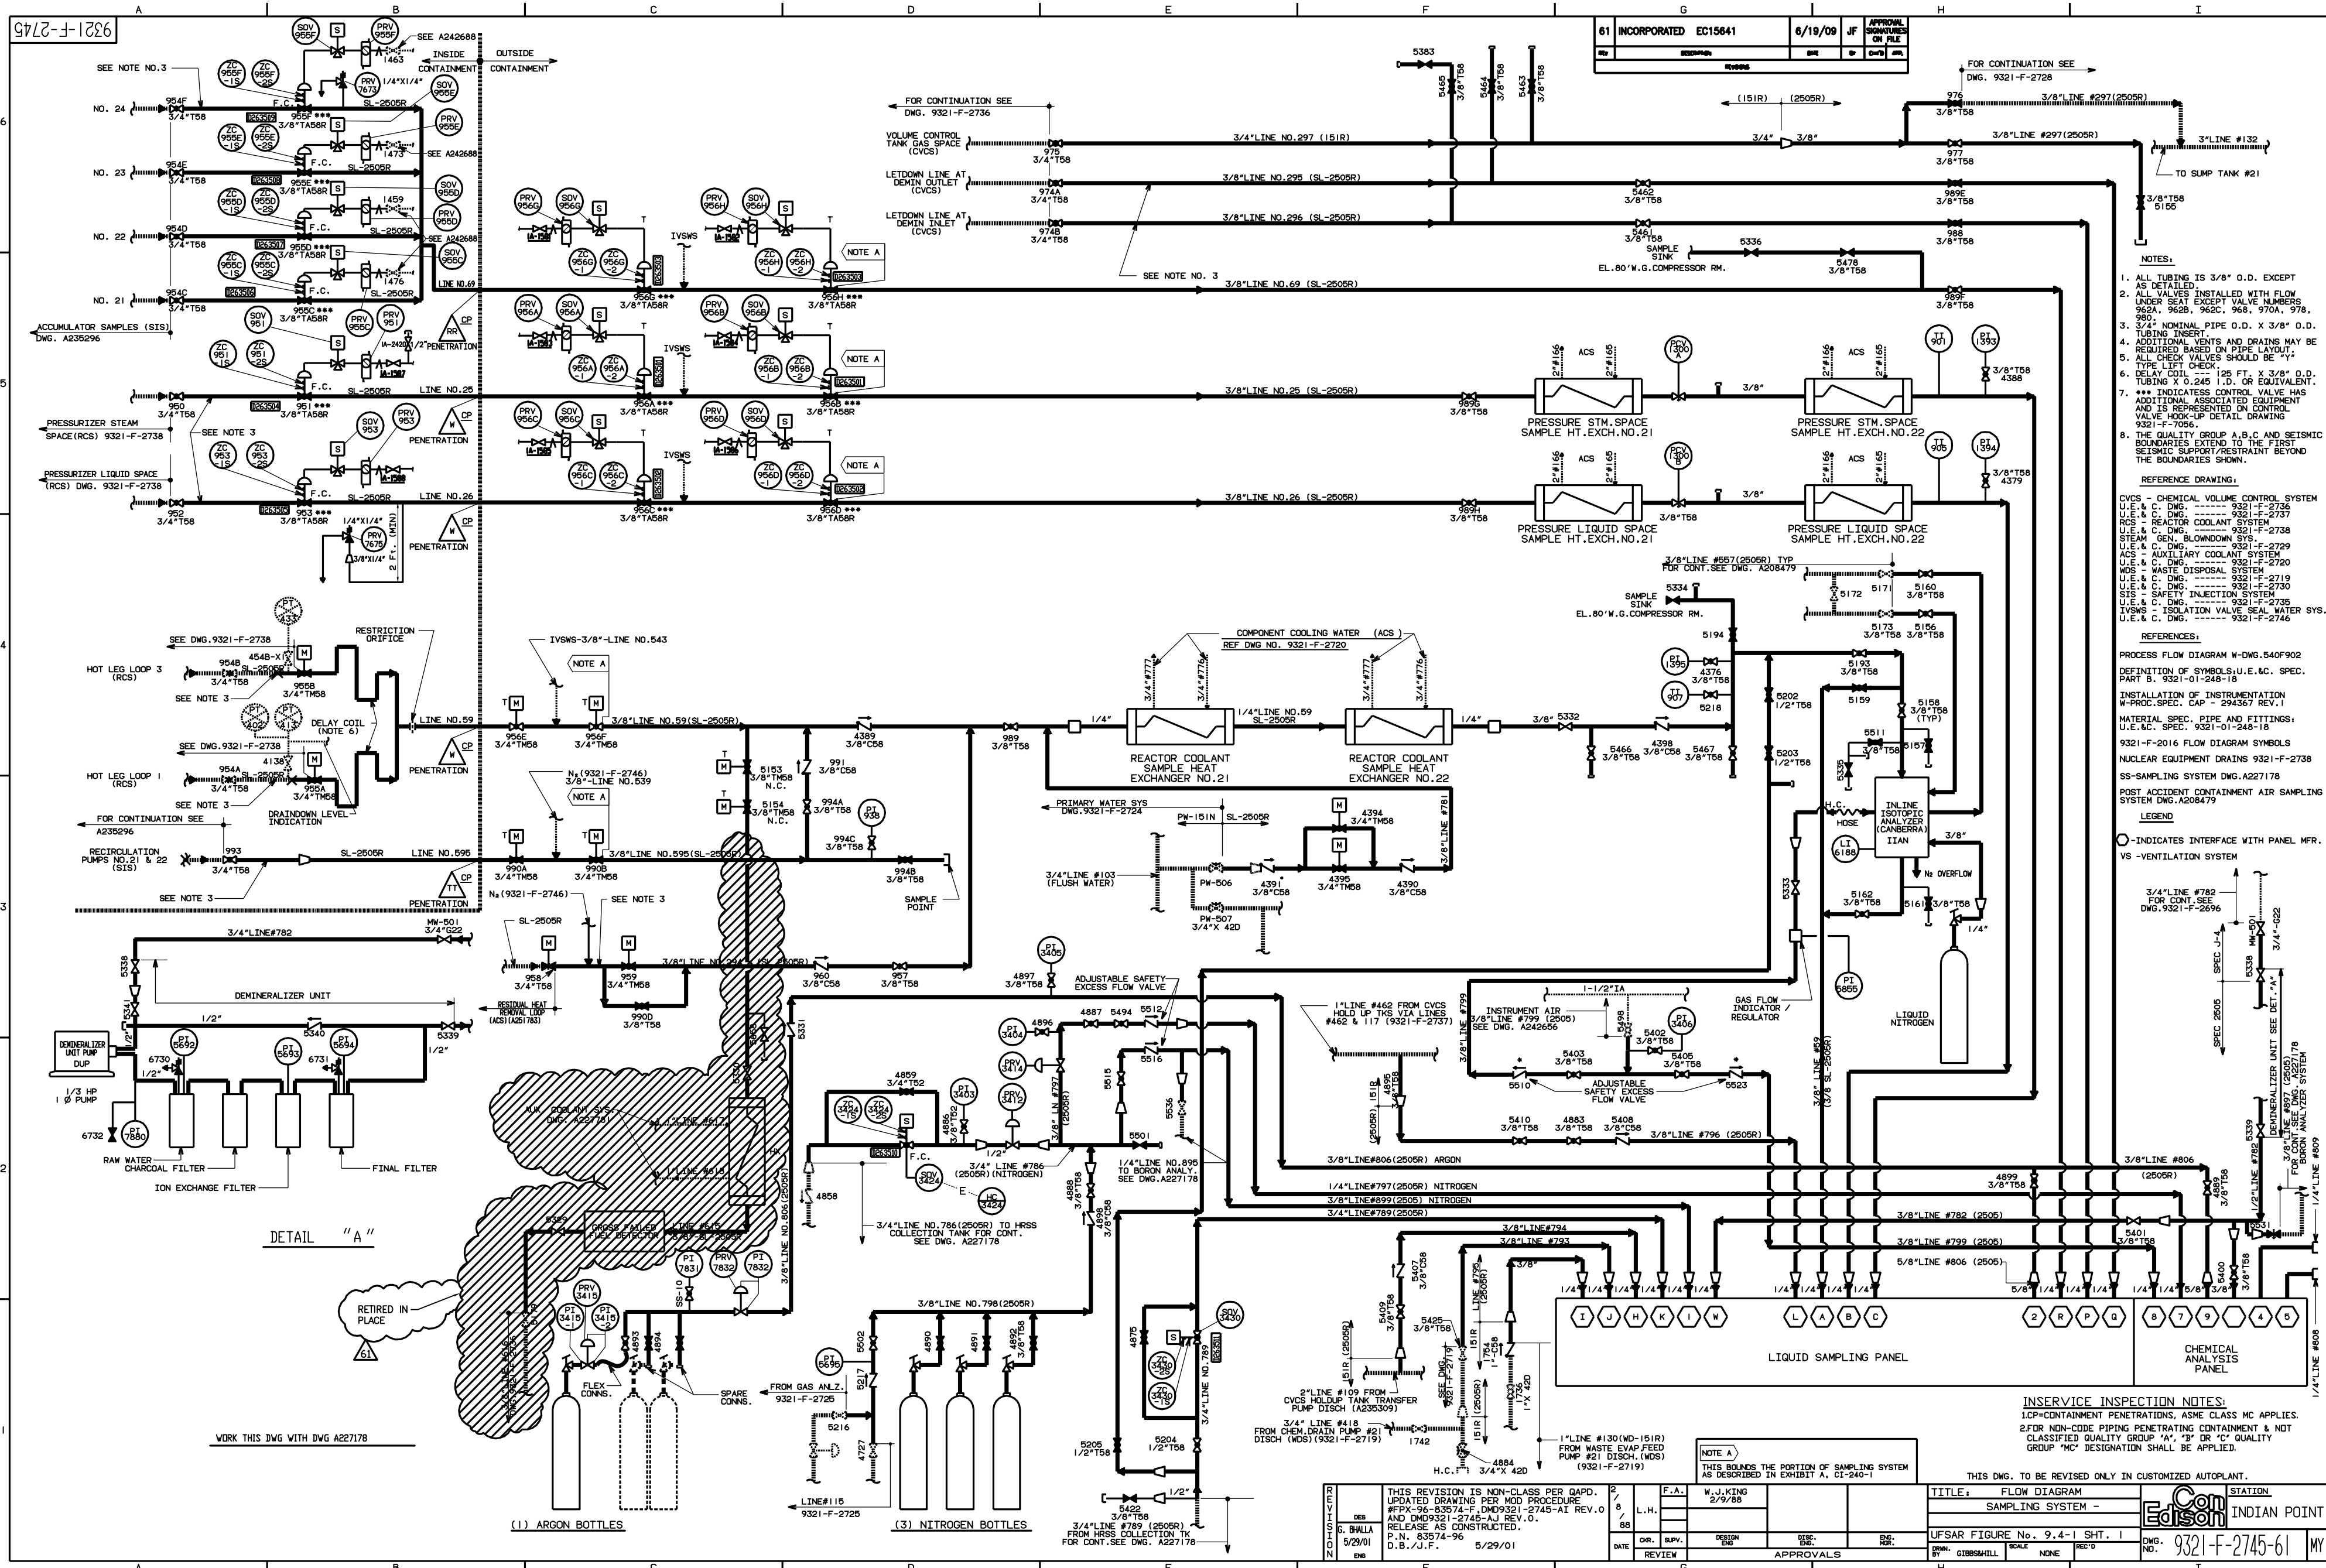

61 INCORPORATED EC15641  
 6/18/09 JF  
 APPROVAL SIGNATURES ON FILE

- NOTES:
1. ALL TUBING IS 3/8" O.D. EXCEPT AS DETAILED.
  2. ALL VALVES INSTALLED WITH FLOW UNDER SEAT EXCEPT VALVE NUMBERS 962A, 962B, 962C, 968, 970A, 978, 980.
  3. 3/4" NOMINAL PIPE O.D. X 3/8" O.D. TUBING INSERT.
  4. ADDITIONAL VENTS AND DRAINS MAY BE REQUIRED BASED ON PIPE LAYOUT.
  5. ALL CHECK VALVES SHOULD BE TYPE "LIFT CHECK".
  6. \*\*\* TADICNESS CONTROL VALVE HAS ADDITIONAL ASSOCIATED EQUIPMENT AND IS REPRESENTED ON CONTROL VALVE HOOD-UP DETAIL DRAWING 9321-F-7056.
  7. THE QUALITY GROUP A, B, C AND SEISMIC BOUNDARIES EXTEND TO THE FIRST SEISMIC SUPPORT/RESTRAINT BEYOND THE BOUNDARIES SHOWN.

REFERENCE DRAWING:

CVCS - CHEMICAL VOLUME CONTROL SYSTEM  
 U.E. & C. DWG. ----- 9321-F-2736  
 RCS - REACTOR COOLANT SYSTEM  
 U.E. & C. DWG. ----- 9321-F-2738  
 STEAM GEN. BLOWDOWN SYS.  
 U.E. & C. DWG. ----- 9321-F-2729  
 ACS - AUXILIARY COOLANT SYSTEM  
 U.E. & C. DWG. ----- 9321-F-2720  
 WDS - WASTE DISPOSAL SYSTEM  
 U.E. & C. DWG. ----- 9321-F-2719  
 U.E. & C. DWG. ----- 9321-F-2730  
 SIS - SAFETY INJECTION SYSTEM  
 U.E. & C. DWG. ----- 9321-F-2735  
 IVSWS - ISOLATION VALVE SEAL WATER SYS.  
 U.E. & C. DWG. ----- 9321-F-2746

REFERENCES:

PROCESS FLOW DIAGRAM W-540F902  
 DEFINITION OF SYMBOLS, U.E. & C. SPEC. PART B. 9321-01-248-18  
 INSTALLATION OF INSTRUMENTATION W-PROC. SPEC. CAP - 294367 REV. 1  
 MATERIAL SPEC. PIPE AND FITTINGS, U.E. & C. SPEC. 9321-01-248-18  
 9321-F-2016 FLOW DIAGRAM SYMBOLS  
 NUCLEAR EQUIPMENT DRAINS 9321-F-2738  
 SS-SAMPLING SYSTEM DWG. A227178  
 POST ACCIDENT CONTAINMENT AIR SAMPLING SYSTEM DWG. A208479

LEGEND

○ - INDICATES INTERFACE WITH PANEL MFR.  
 VS - VENTILATION SYSTEM

INSERVICE INSPECTION NOTES:  
 1. CP-CONTAINMENT PENETRATIONS, ASME CLASS MC APPLIES.  
 2. FOR NON-CODE PIPING PENETRATING CONTAINMENT & NOT CLASSIFIED QUALITY GROUP 'A', 'B' OR 'C' QUALITY GROUP 'MC' DESIGNATION SHALL BE APPLIED.

THIS REVISION IS NON-CLASS PER GARD. UPDATED DRAWING PER MOD PROCEDURE W/FPX-96-83574-F, DMD9321-2745-A1 REV. 0 AND DMD9321-2745-A1 REV. 0. RELEASE AS CONSTRUCTED. P.N. 83574-96 D.B./J.F.F. 5/29/01	W. J. KING 2/3/88	TITLE: FLOW DIAGRAM SAMPLING SYSTEM	INDIAN POINT
UFSAR FIGURE No. 9.4-1 SHT. 1 SCALE NONE REC'D	DATE DR. L.H. CH. B.P.V. REVIEW	APPROVALS	DWG. NO. 9321-F-2745-61 MY

WORK THIS DWG WITH DWG A227178


DETAIL "A"

RETIRED IN PLACE

(1) ARGON BOTTLES

(3) NITROGEN BOTTLES

A227178

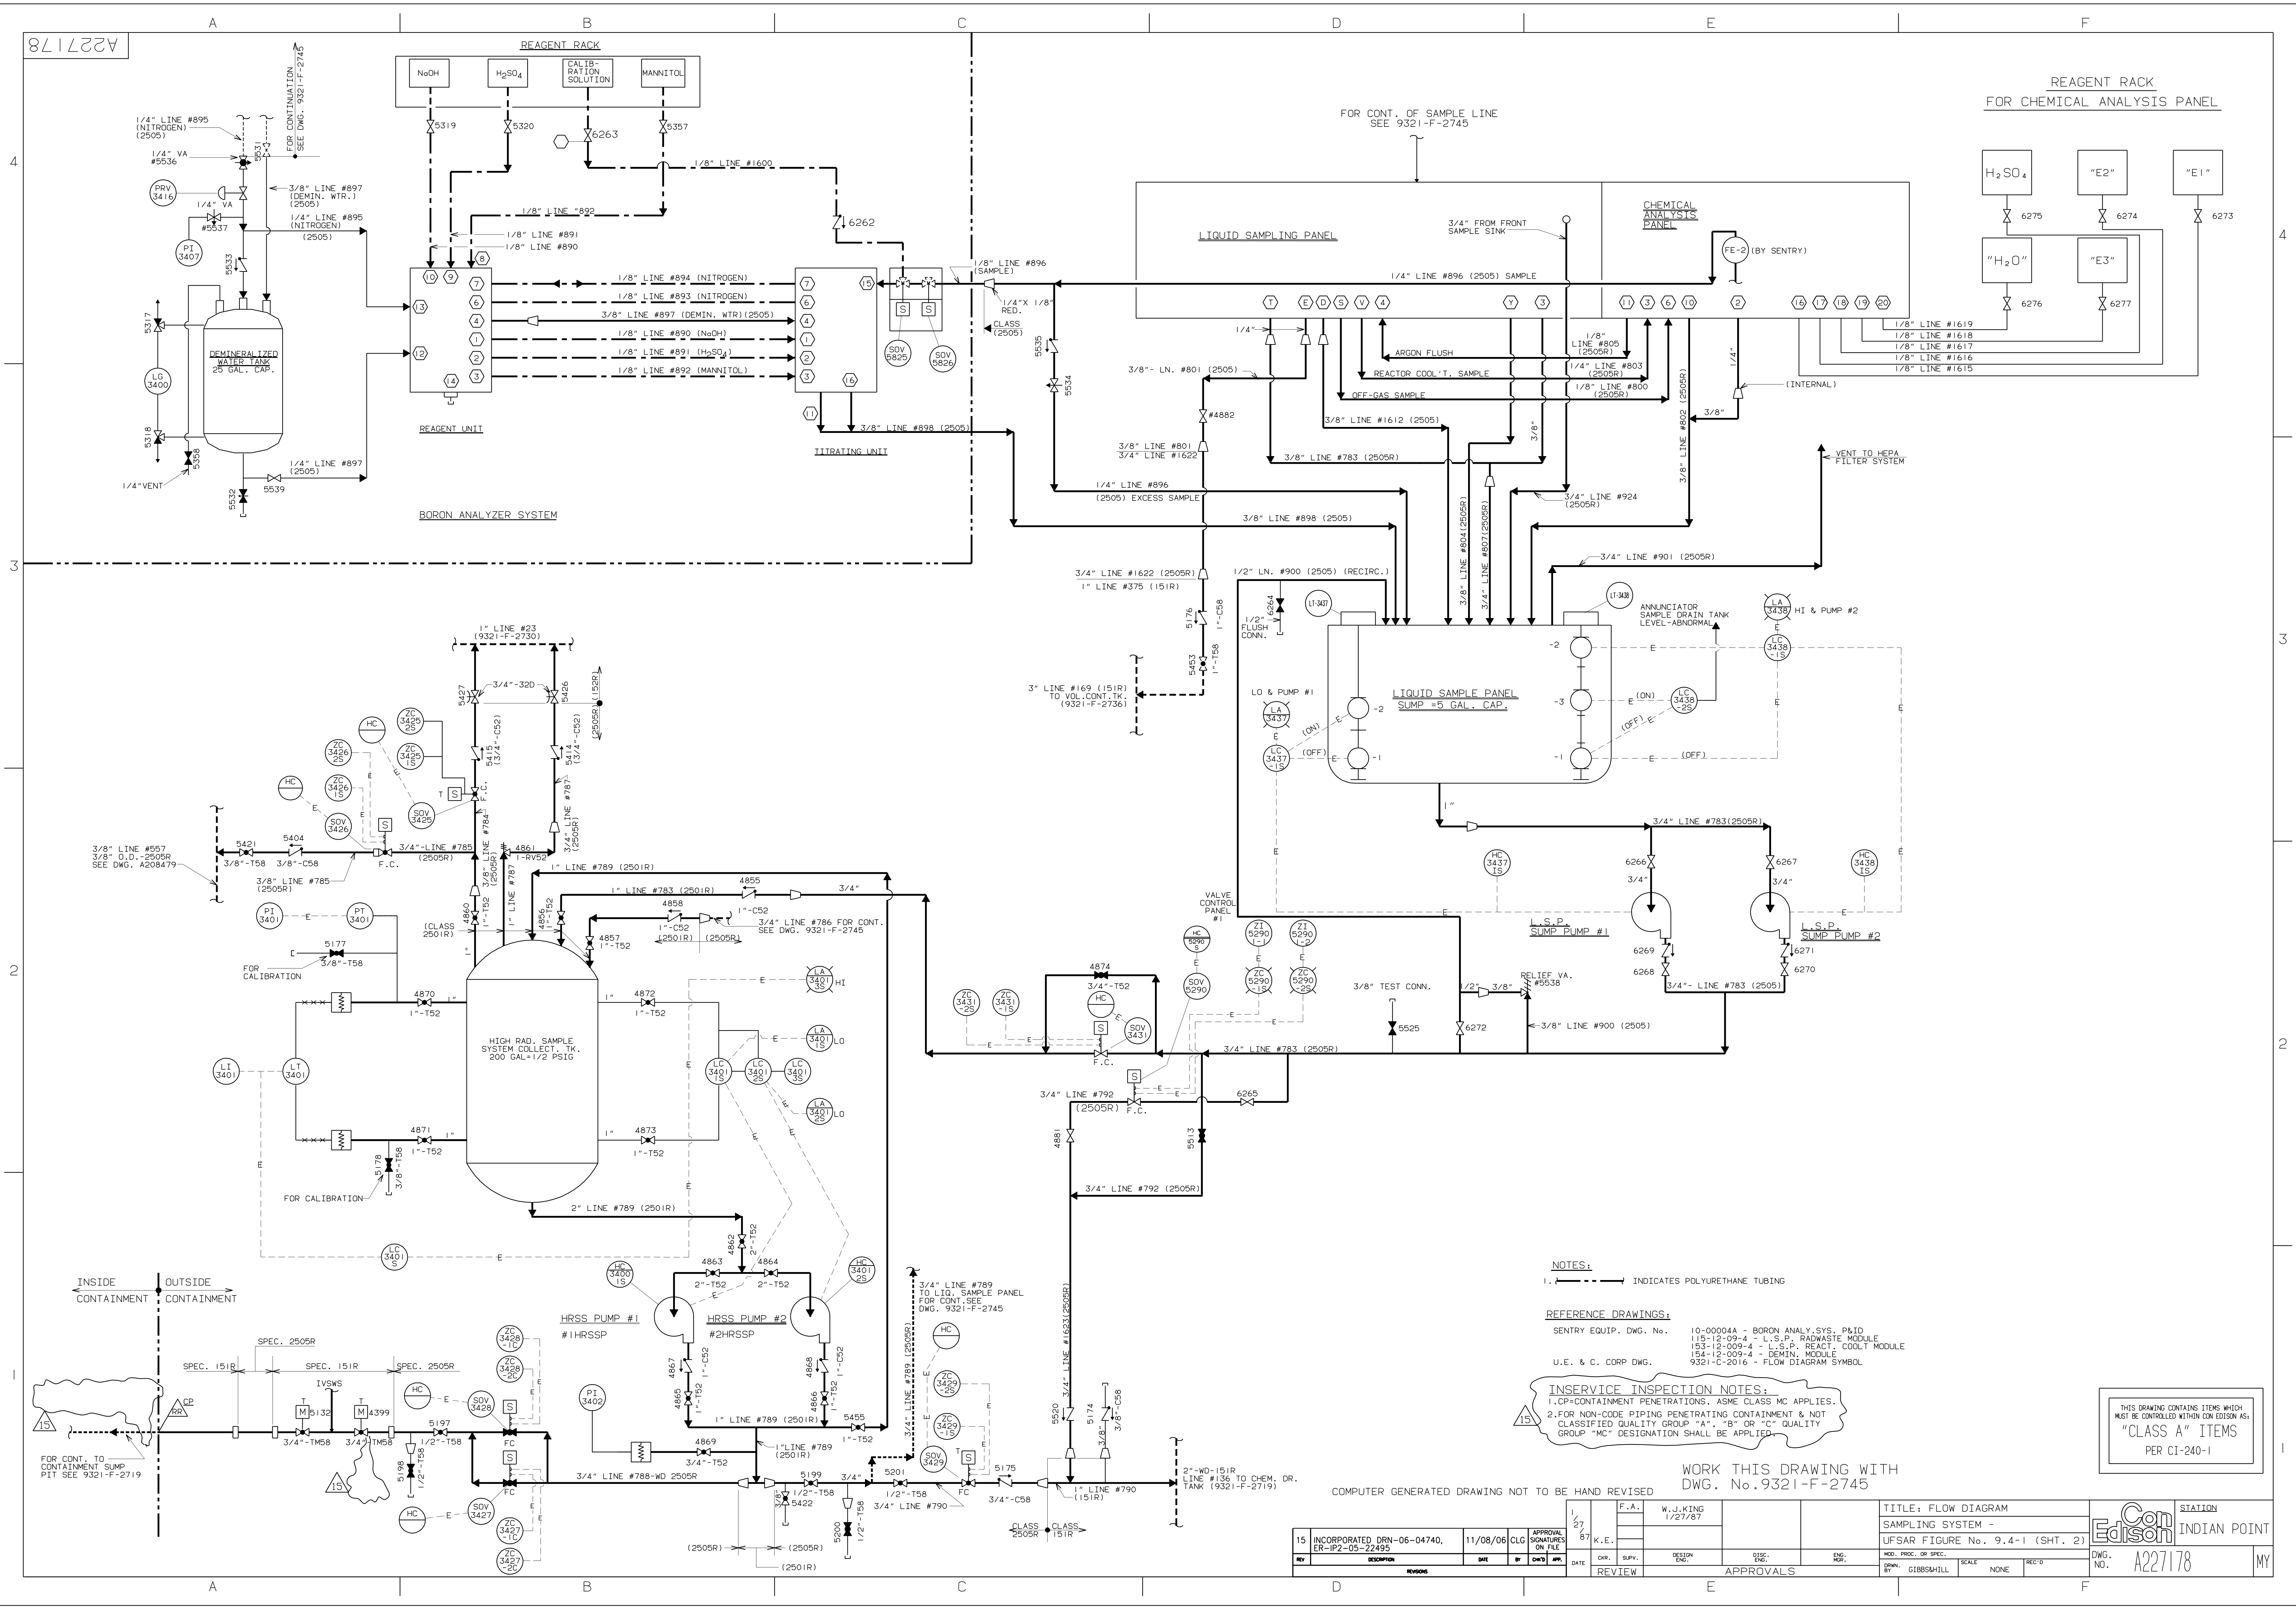

**NOTES:**  
 1. --- INDICATES POLYURETHANE TUBING

**REFERENCE DRAWINGS:**  
 SENTRY EQUIP. DWG. No. 10-00004A - BORON ANALY. SYS. P&ID  
 115-12-09-4 - L.S.P. RADWASTE MODULE  
 153-12-009-4 - L.S.P. REACT. COOL. MODULE  
 154-12-009-4 - DEMIN. MODULE  
 9321-C-2016 - FLOW DIAGRAM SYMBOL


**INSERVICE INSPECTION NOTES:**  
 1. CP-CONTAINMENT PENETRATIONS, ASME CLASS MC APPLIES.  
 2. FOR NON-CODE PIPING PENETRATING CONTAINMENT & NOT CLASSIFIED QUALITY GROUP "A", "B" OR "C" QUALITY GROUP "MC" DESIGNATION SHALL BE APPLIED.

WORK THIS DRAWING WITH  
 DWG. No. 9321-F-2745

COMPUTER GENERATED DRAWING NOT TO BE HAND REVISED

15 INCORPORATED DRN-06-04740, ER-IP2-05-22495	11/08/06	CLG	APPROVAL SIGNATURES ON FILE	DATE	DR.	SRV.	REGION	SCALE	REC'D	DES.	NO.	A227178	MY
---	----------	-----	-----------------------------	------	-----	------	--------	-------	-------	------	-----	---------	----

TITLE: FLOW DIAGRAM SAMPLING SYSTEM - UFSAR FIGURE No. 9.4-1 (SHT. 2)		STATION INDIAN POINT	
DWG. NO. A227178		SCALE NONE	

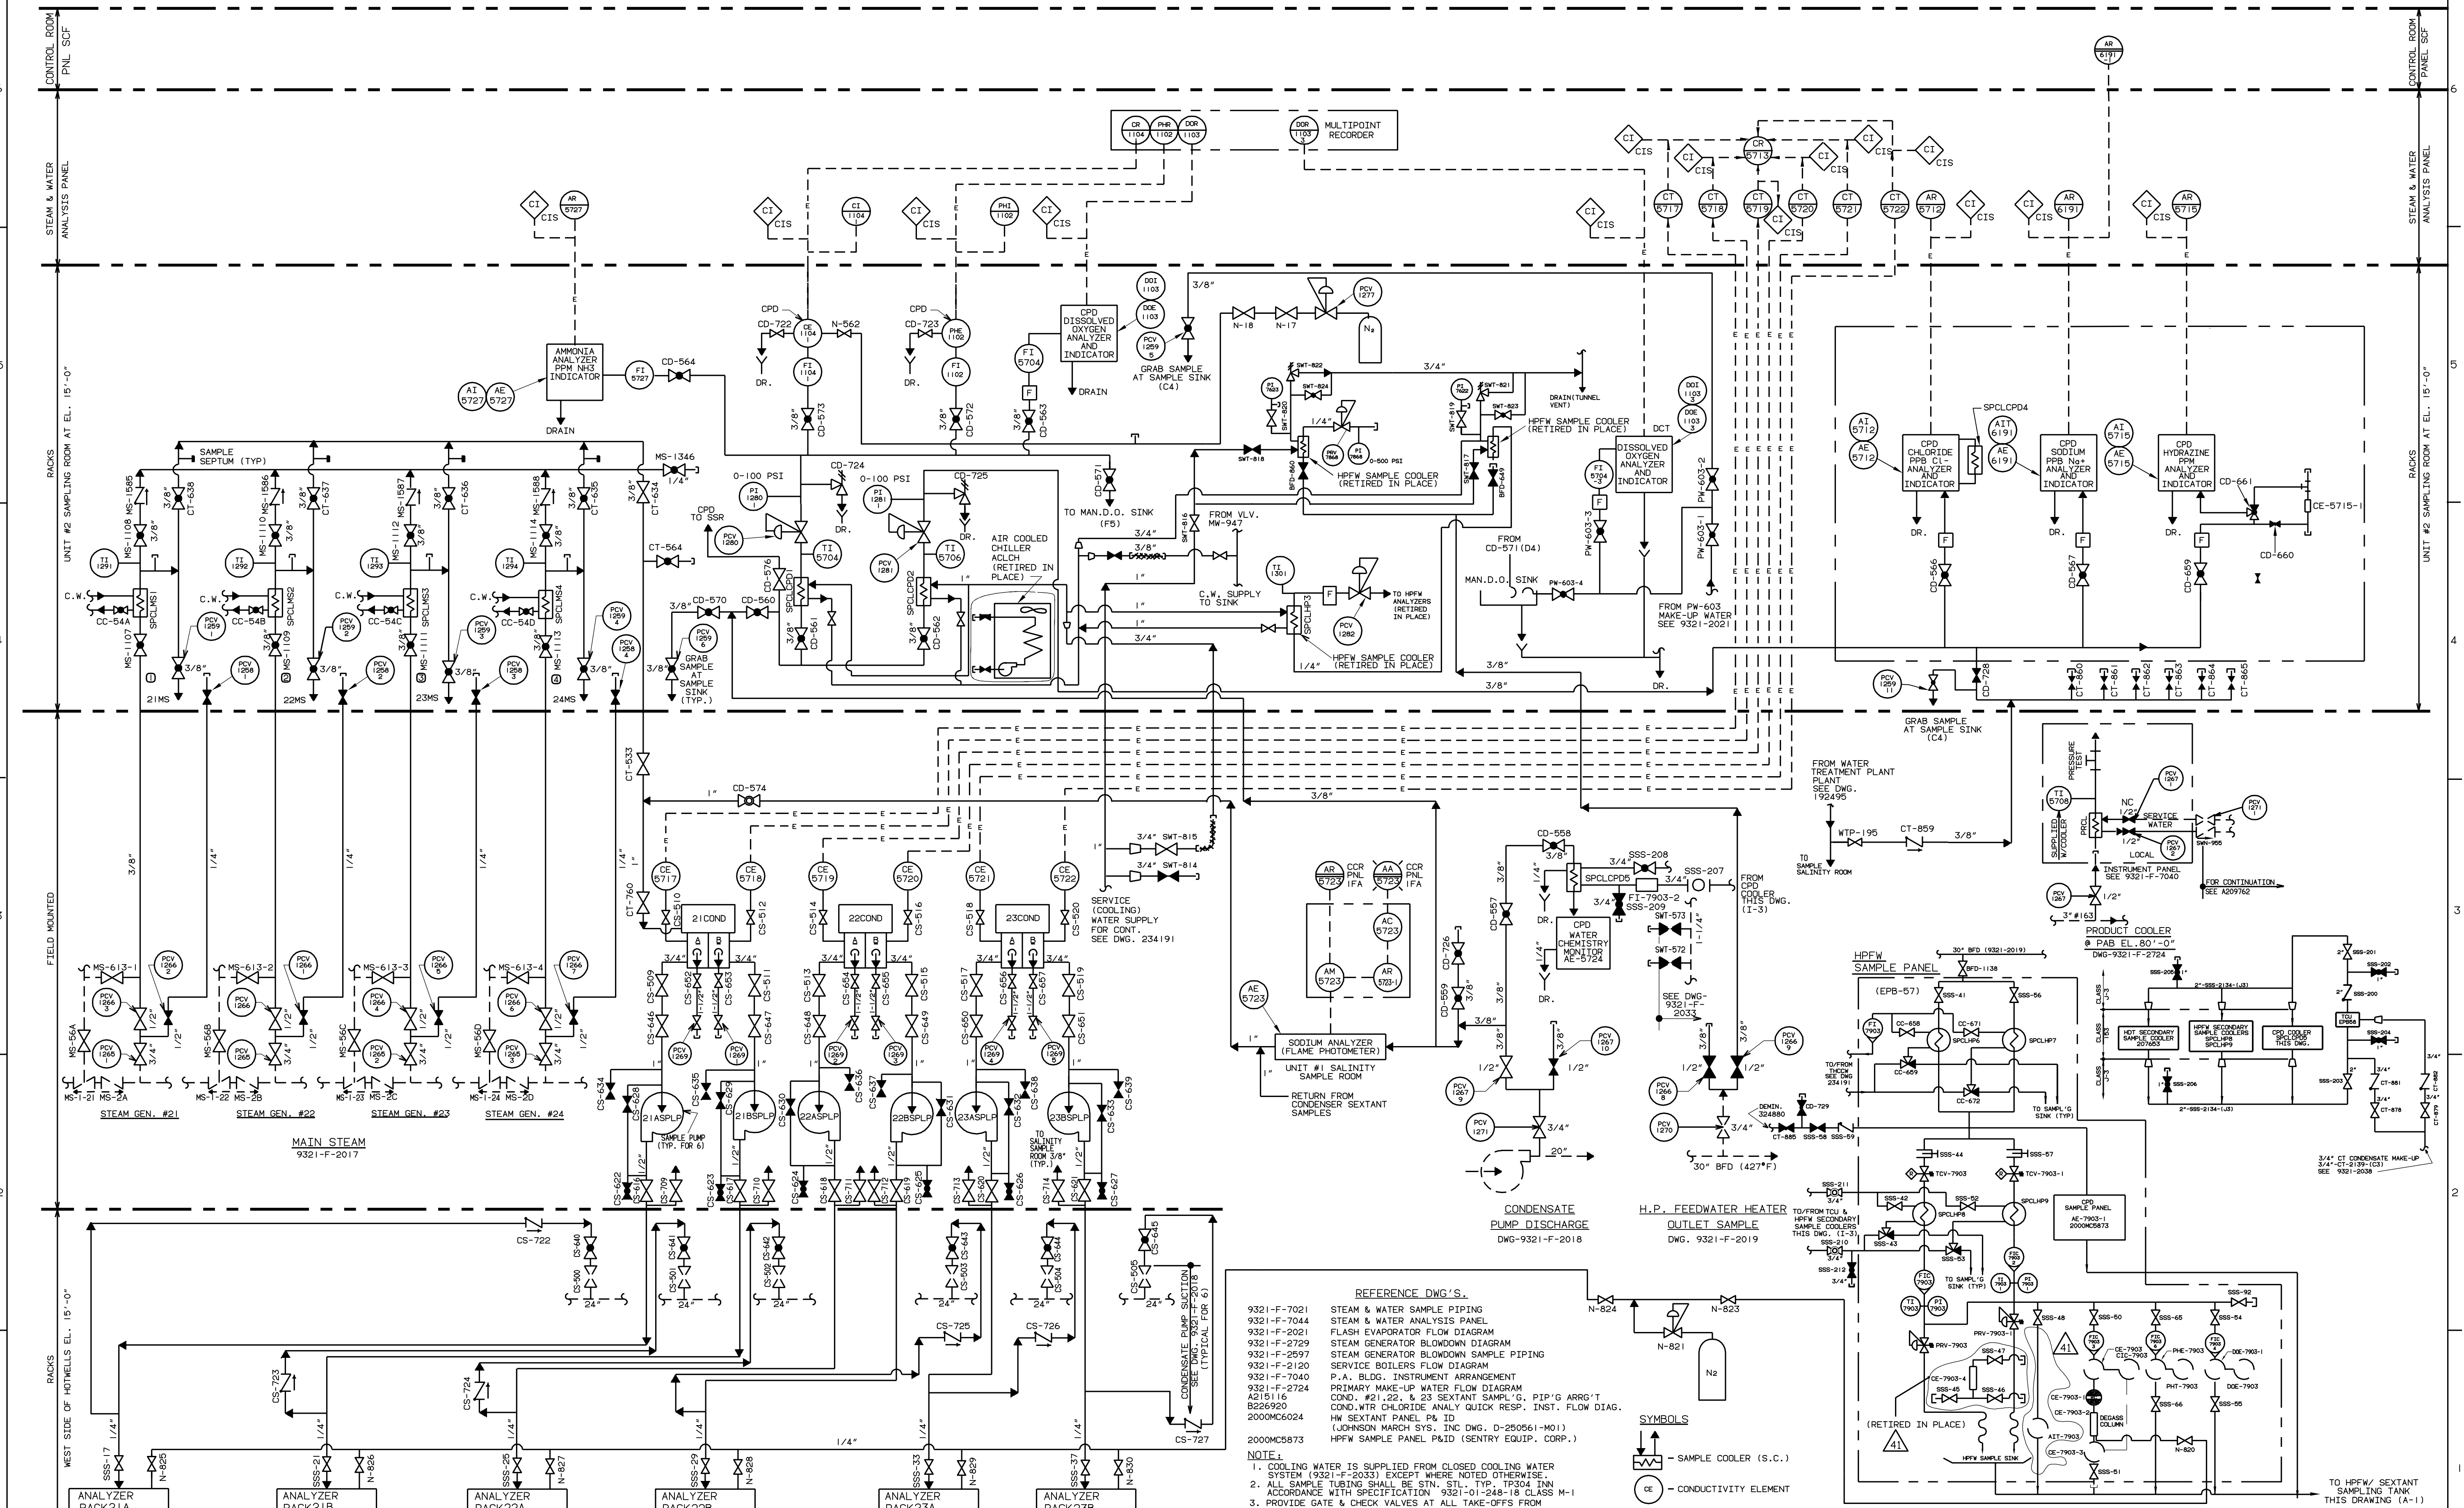

**REFERENCE DWG'S.**

- 9321-F-7021 STEAM & WATER SAMPLE PIPING
- 9321-F-7044 STEAM & WATER ANALYSIS PANEL
- 9321-F-2021 FLASH EVAPORATOR FLOW DIAGRAM
- 9321-F-2729 STEAM GENERATOR BLOWDOWN SAMPLE PIPING
- 9321-F-2597 SERVICE BOILERS FLOW DIAGRAM
- 9321-F-7040 P.A. BLDG. INSTRUMENT ARRANGEMENT
- 9321-F-2724 PRIMARY MAKE-UP WATER FLOW DIAGRAM
- A215116 COND. #21, 22, & 23 SEXTANT SAMPL'G. PIP'G ARR'G'T
- B262920 COND. WTR CHLORIDE ANALY. QUICK RESP. INST. FLOW DIAG.
- 2000MC6024 HW SEXTANT PANEL P&ID (JOHNSON MARCH SYS. INC DWG. D-250561-M01)
- 2000MC6873 H.PFW SAMPLE PANEL P&ID (SENTRY EQUIP. CORP.)

**NOTE:**

- COOLING WATER IS SUPPLIED FROM CLOSED COOLING WATER SYSTEM (9321-F-2033) EXCEPT WHERE NOTED OTHERWISE.
- ALL SAMPLE TUBING SHALL BE STN. STL. TYP. TP304 INN ACCORDANCE WITH SPECIFICATION 9321-01-248-18 CLASS M-1
- PROVIDE GATE & CHECK VALVES AT ALL TAKE-OFFS FROM CITY WATER LINES

**SYMBOLS**

- (S.C.) - SAMPLE COOLER
- (CE) - CONDUCTIVITY ELEMENT
- (BULKHEAD) - SEE DWG. 9321-F-7044

**COMPUTER GENERATED DRAWING NOT TO BE HAND REVISED**

**TITLE: STEAM & WATER ANALYSIS SYSTEM SAMPLING DIAGRAM**


**STATION: INDIAN POINT**

**UFSAR FIGURE No. 9.4-2**

**SCALE: NONE**


**DWG. NO. 9321-F-7020-41**

41	INCORPORATED EC-64123	1/3/17	AI	APPROVAL SIGNATURES ON FILE	INDIAN POINT
REV	DESCRIPTION	DATE	BY	CHKD	APP'D

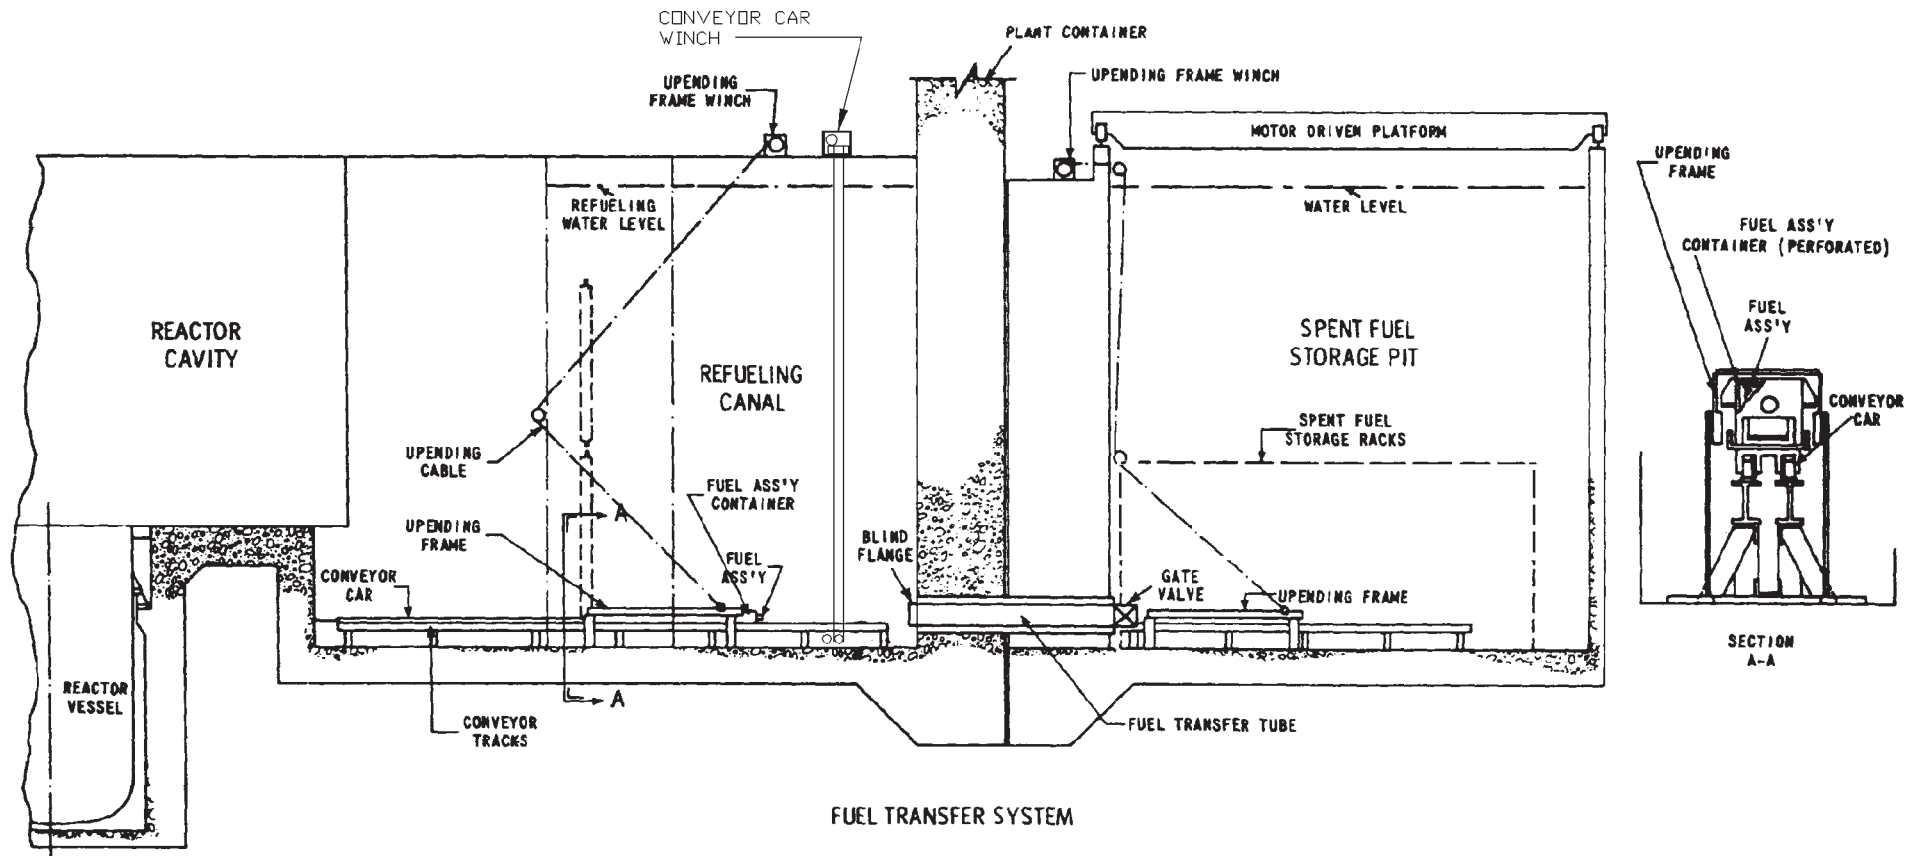

FUEL TRANSFER SYSTEM

INDIAN POINT UNIT No. 2	
UFSAR FIGURE 9.5-1	
FUEL TRANSFER SYSTEM	
MIC. No. 1999MC3886	REV. No. 17B

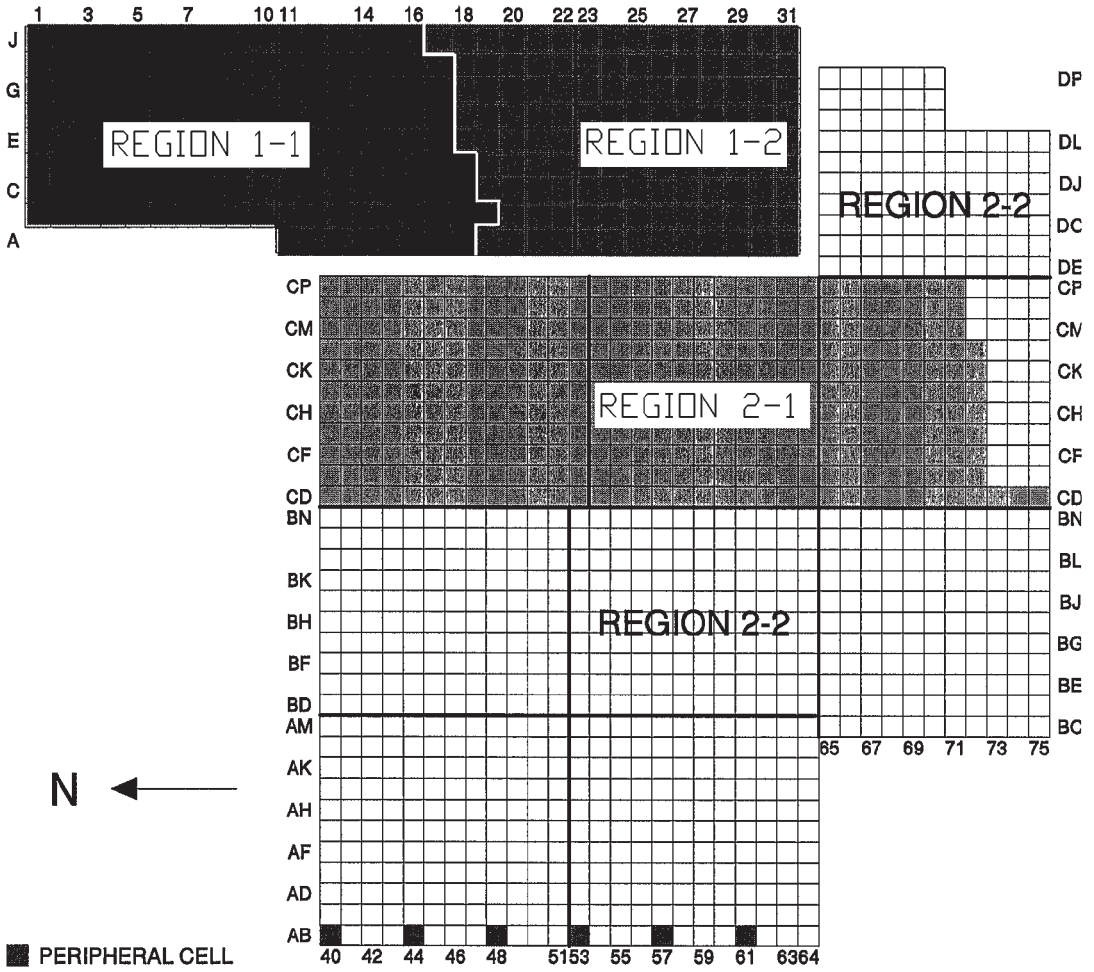


INDIAN POINT UNIT No. 2

UFSAR FIGURE 9.5-2

SPENT FUEL STORAGE RACK LAYOUT

MIC. No. 1999MC3887 | REV. No. 17B

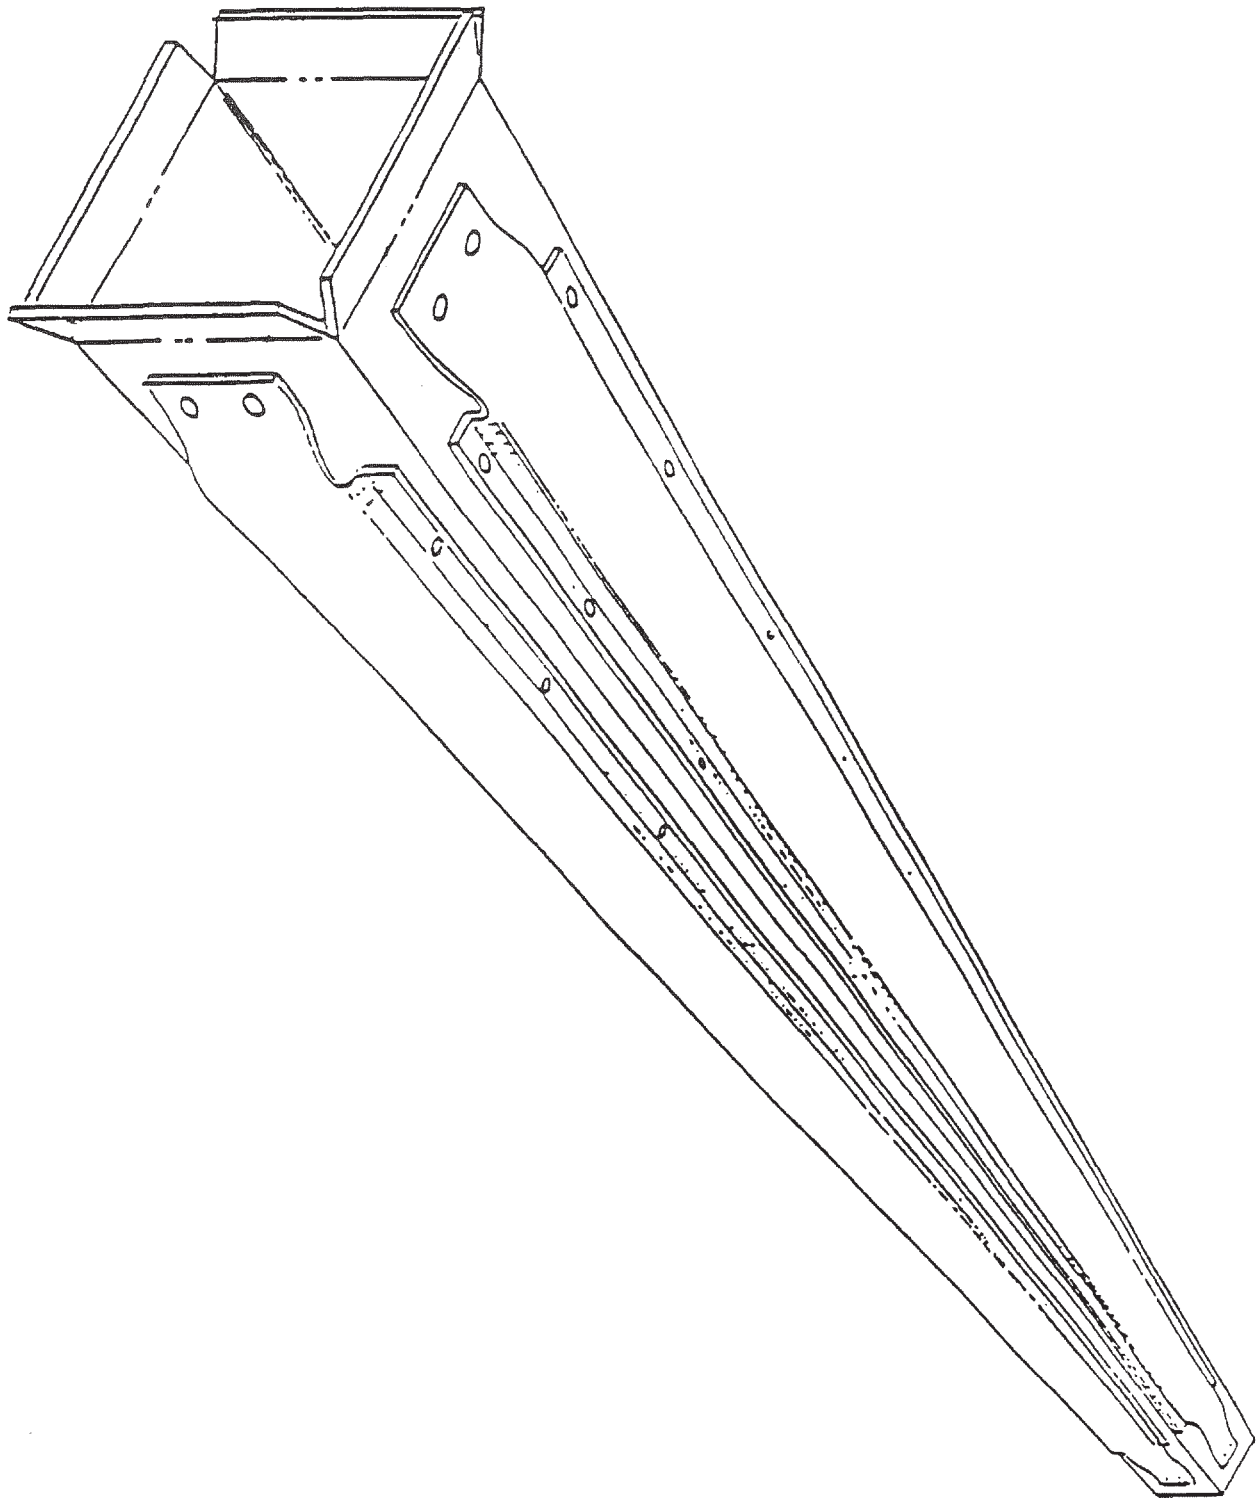


INDIAN POINT UNIT No. 2

UFSAR FIGURE 9.5-3

SPENT FUEL STORAGE CELL  
REGION I

MIC. No. 1999MC3888

REV. No. 17A

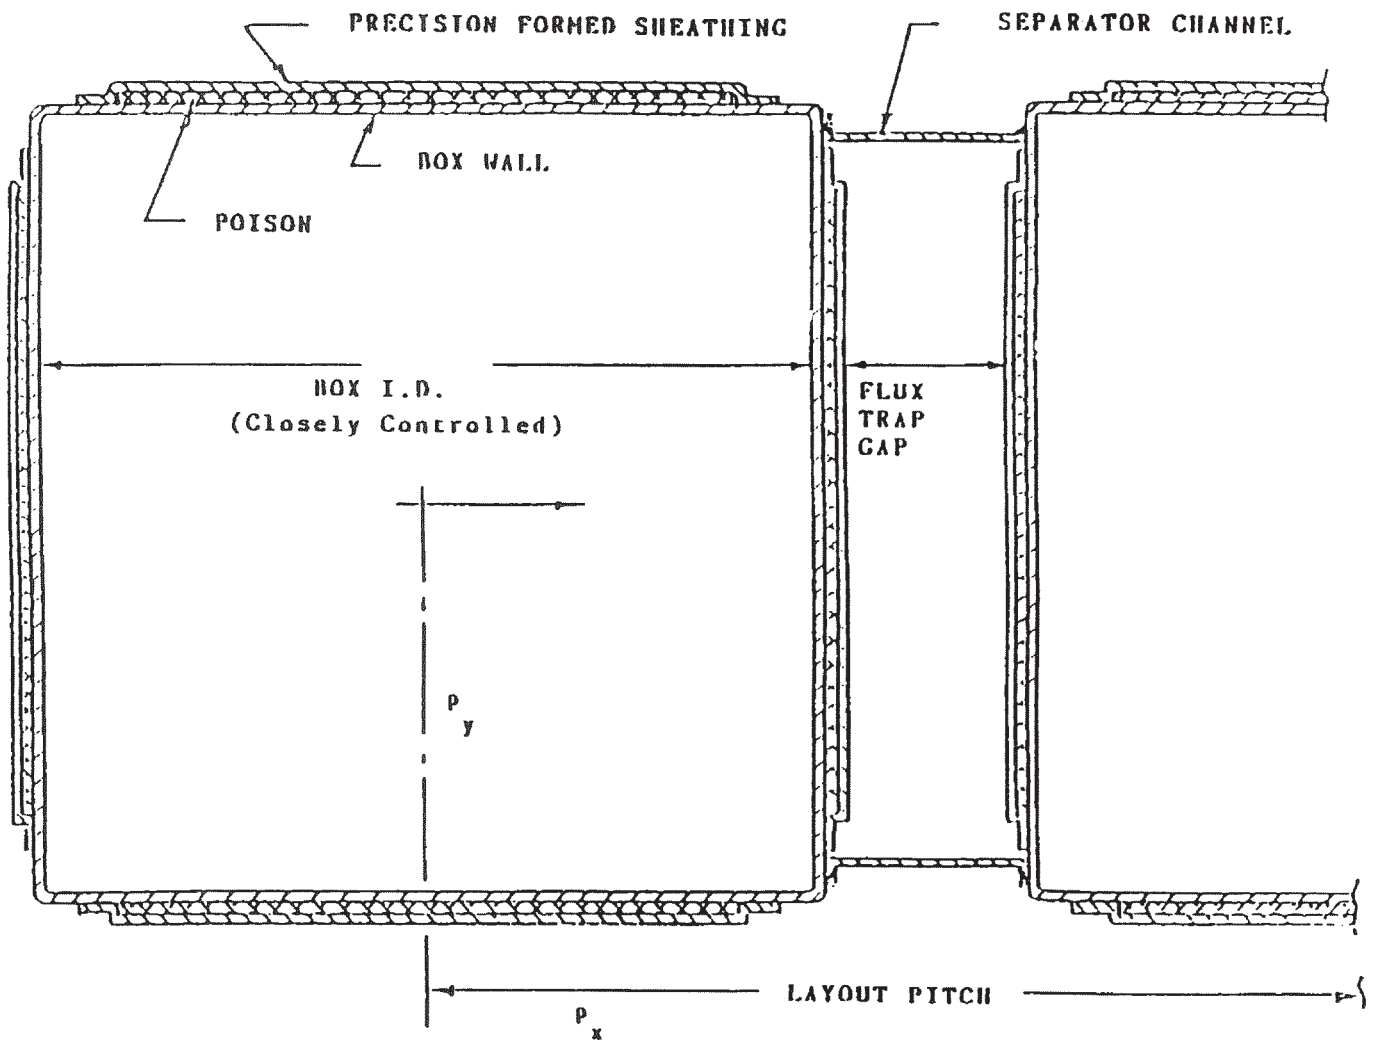


INDIAN POINT UNIT No. 2

UFSAR FIGURE 9.5-4

REGION I CELL  
CROSS SECTION

MIC. No. 1999MC3889

REV. No. 17A

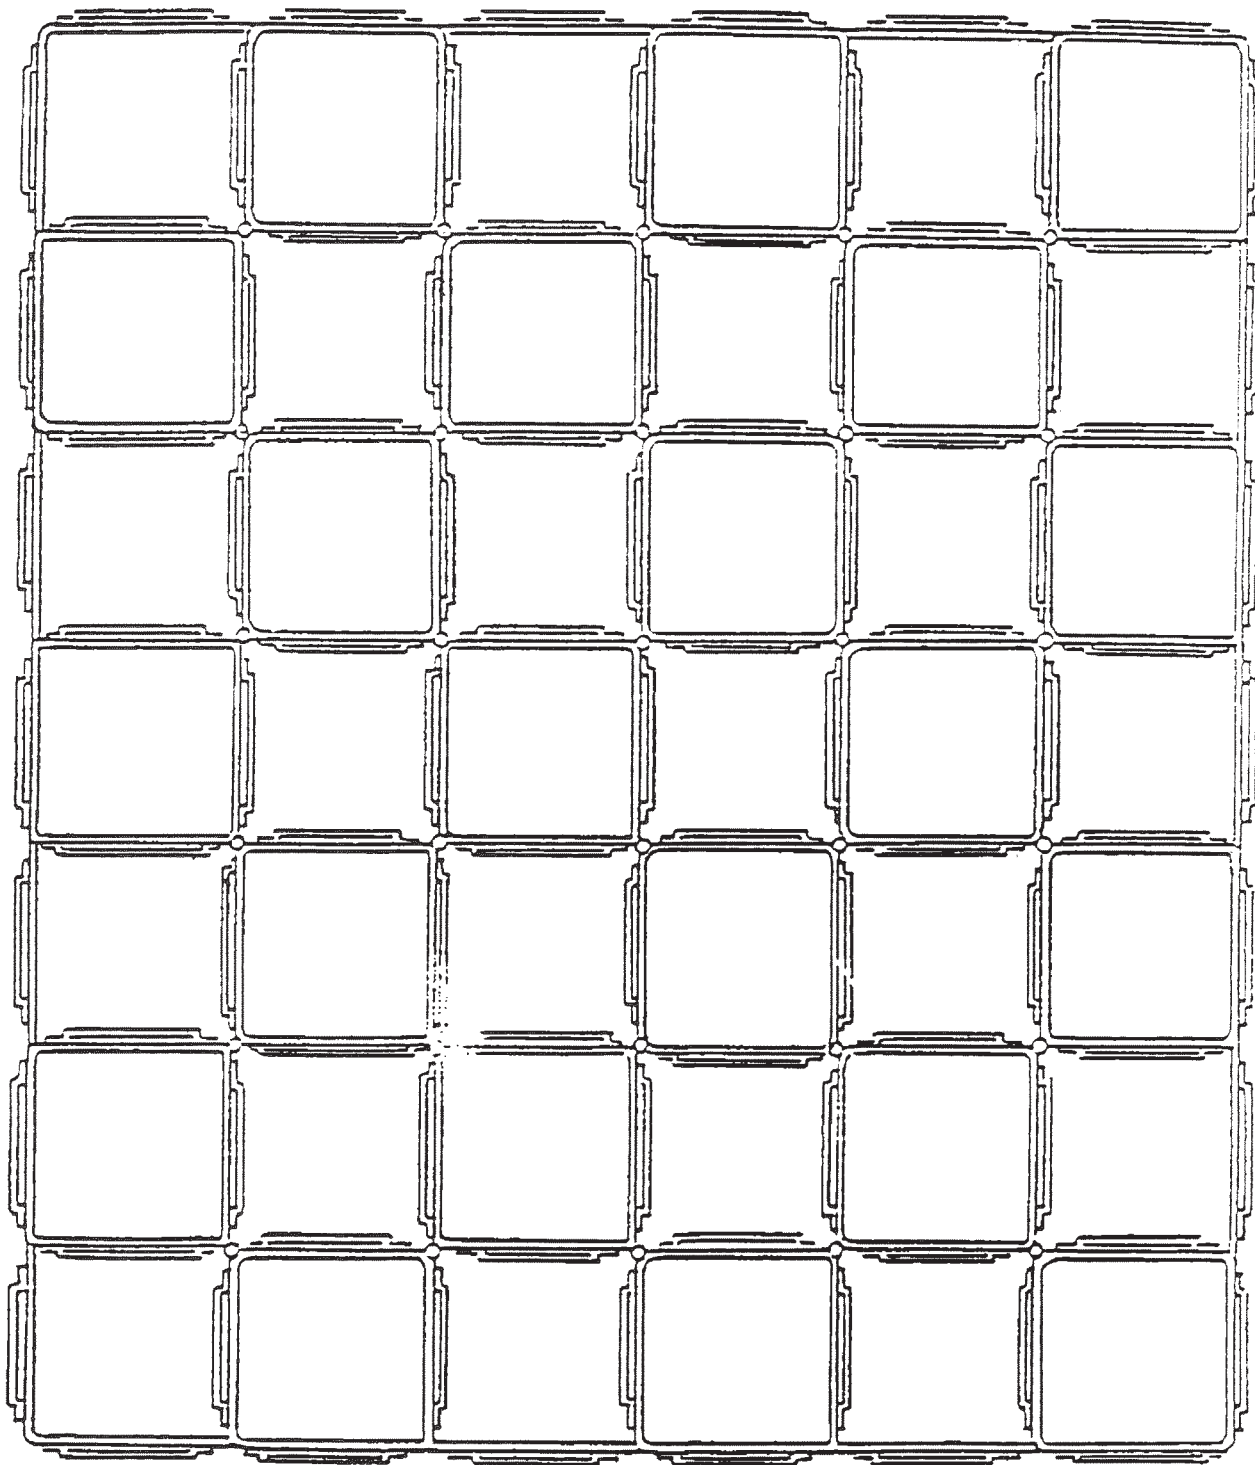

INDIAN POINT UNIT No. 2

UFSAR FIGURE 9.5-5

REGION II  
CROSS SECTION


MIC. No. 1999MC3890

REV. No. 17A



9321-F-2722

MATCH LINE, DWG. A209762

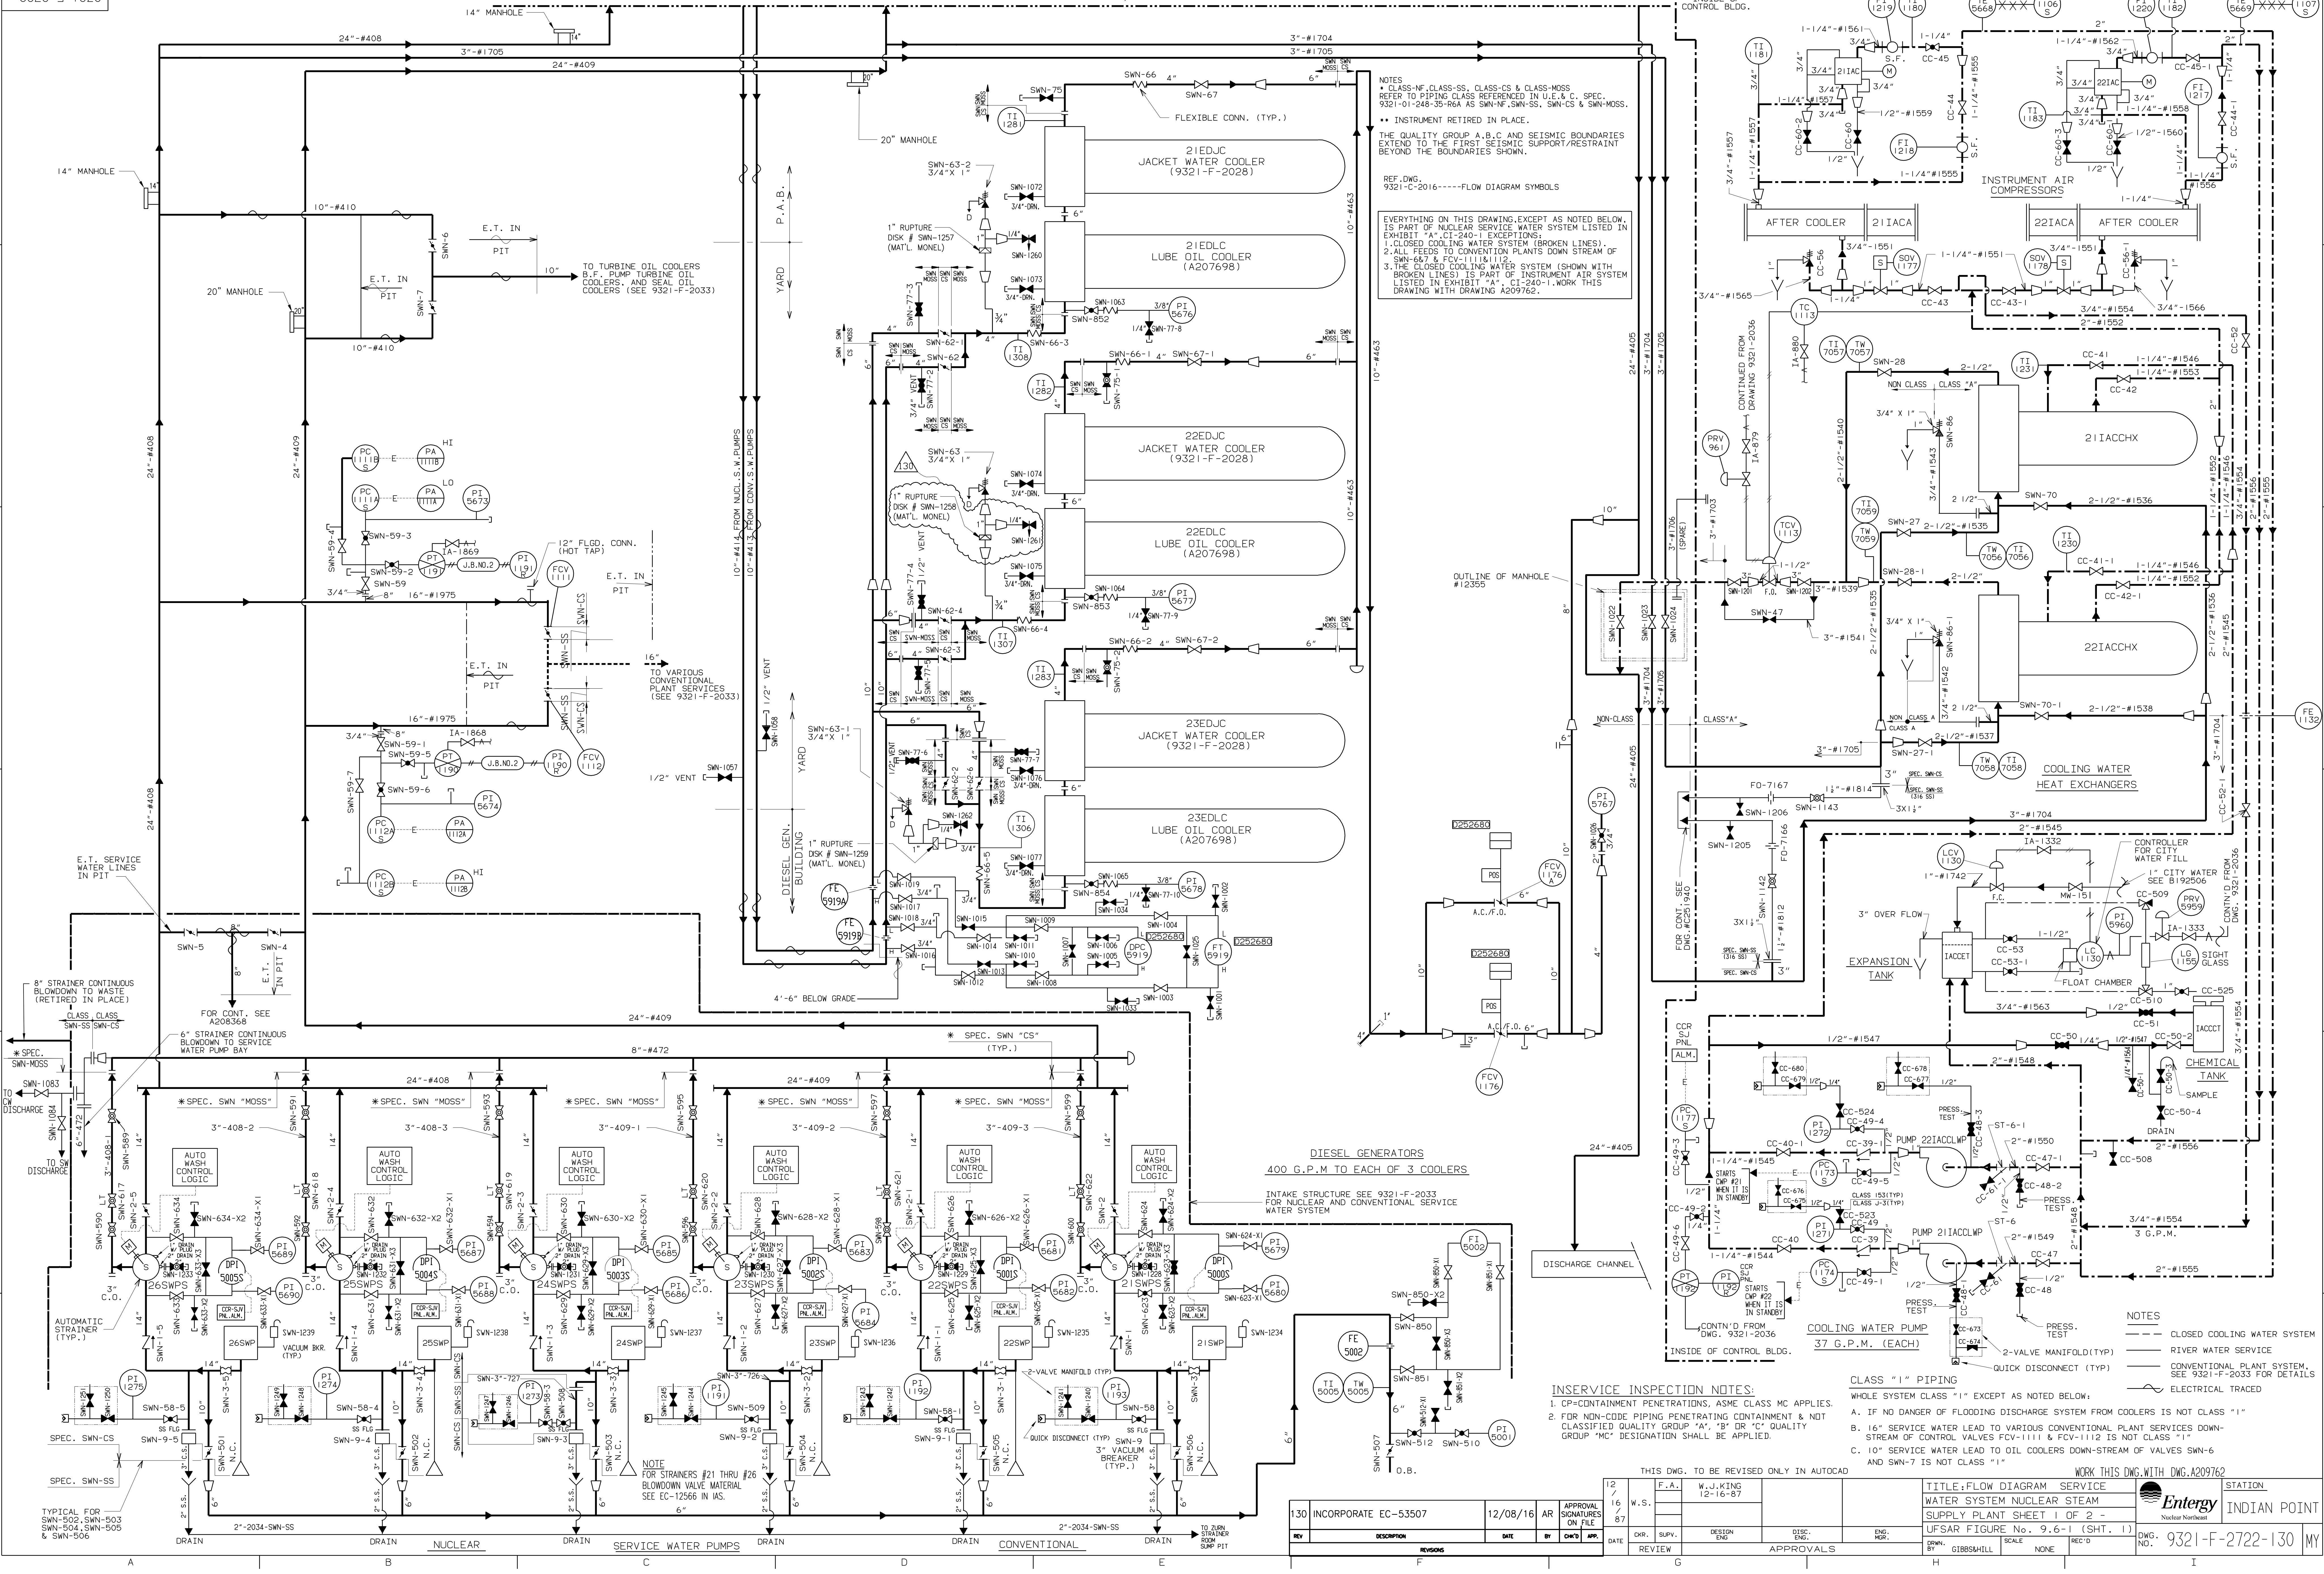

NOTES



- CLASS-NF, CLASS-SS, CLASS-CS & CLASS-MOSS REFER TO PIPING CLASS REFERENCED IN U.E. & C. SPEC. 9321-01-248-35-R6A AS SWN-NF, SWN-SS, SWN-CS & SWN-MOSS.
- INSTRUMENT RETIRED IN PLACE.
- THE QUALITY GROUP A, B, C AND SEISMIC BOUNDARIES EXTEND TO THE FIRST SEISMIC SUPPORT/RESTRAINT BEYOND THE BOUNDARIES SHOWN.

REF. DWG. 9321-C-2016-444-FLOW DIAGRAM SYMBOLS

EVERYTHING ON THIS DRAWING, EXCEPT AS NOTED BELOW, IS PART OF NUCLEAR SERVICE WATER SYSTEM LISTED IN EXHIBIT "A", CI-240-1 EXCEPTIONS.

- CLOSED COOLING WATER SYSTEM (BROKEN LINES).
- ALL FEEDS TO CONVENTIONAL PLANTS DOWN STREAM OF SWN-687 & FCV-1111 & 1112.
- THE CLOSED COOLING WATER SYSTEM (SHOWN WITH BROKEN LINES) IS PART OF INSTRUMENT AIR SYSTEM LISTED IN EXHIBIT "A", CI-240-1. WORK THIS DRAWING WITH DRAWING A209762.

OUTLINE OF MAN-HOLE #12355

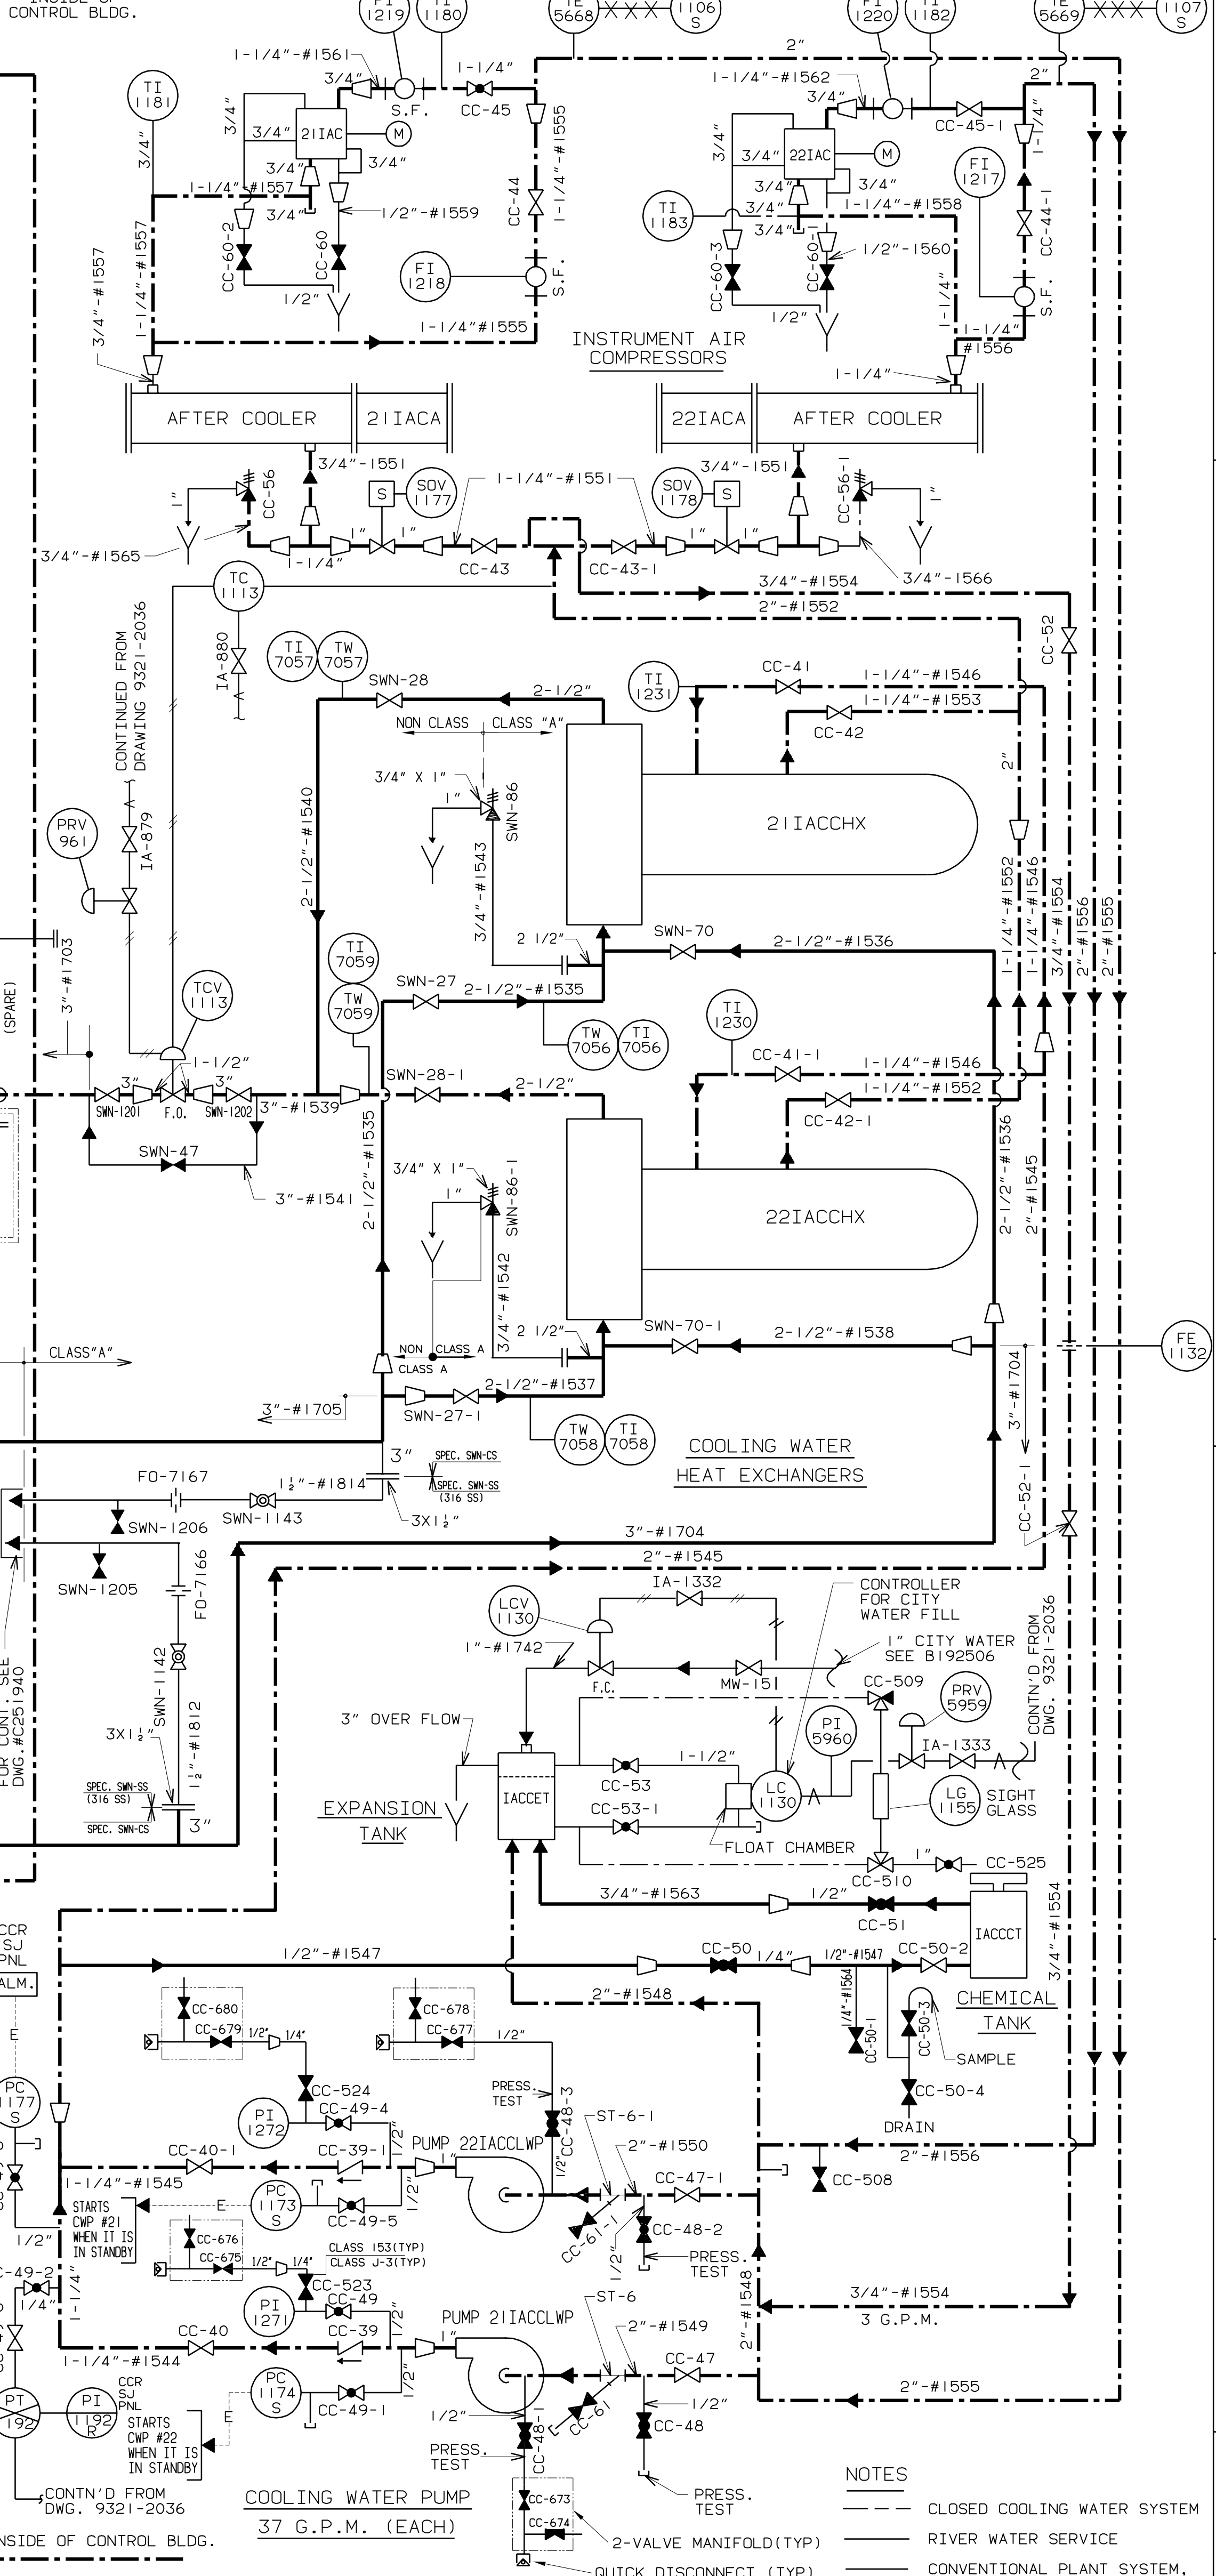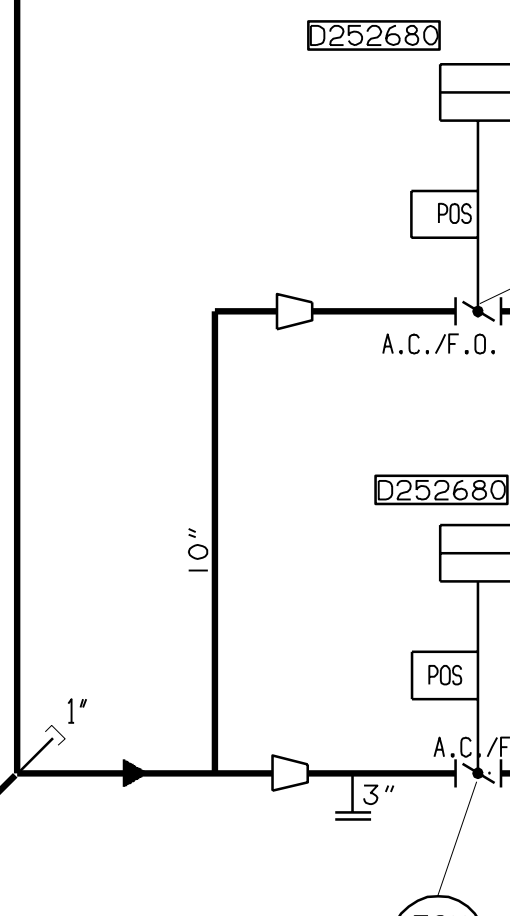

INSERVICE INSPECTION NOTES:


- CP-CONTAINMENT PENETRATIONS, ASME CLASS MC APPLIES.
- FOR NON-CODE PIPING PENETRATING CONTAINMENT & NOT CLASSIFIED QUALITY GROUP "A", "B" OR "C" QUALITY GROUP "MC" DESIGNATION SHALL BE APPLIED.

CLASS "1" PIPING


WHOLE SYSTEM CLASS "1" EXCEPT AS NOTED BELOW:

- IF NO DANGER OF FLOODING DISCHARGE SYSTEM FROM COOLERS IS NOT CLASS "1"
- 16" SERVICE WATER LEAD TO VARIOUS CONVENTIONAL PLANT SERVICES DOWN-STREAM OF CONTROL VALVES FCV-1111 & FCV-1112 IS NOT CLASS "1"
- 10" SERVICE WATER LEAD TO OIL COOLERS DOWN-STREAM OF VALVES SWN-6 AND SWN-7 IS NOT CLASS "1"

THIS DWG. TO BE REVISED ONLY IN AUTOCAD		DATE: 12/16/87		DESIGNER: W.J. KING		DATE: 12-16-87		TITLE: FLOW DIAGRAM SERVICE WATER SYSTEM NUCLEAR STEAM SUPPLY PLANT SHEET 1 OF 2		STATION: INDIAN POINT	
REV: 1.30 INCORPORATE EC-53507		DATE: 12/08/16		APPROVAL: AR		DATE: 12/08/16		LFSAR FIGURE NO. 9.6-1 (SHT. 1)		DWG. NO.: 9321-F-2722-130	
DESIGNER: W.J. KING		DATE: 12-16-87		CHECKED: [ ]		DATE: [ ]		SCALE: NONE		REVISIONS:	
SUPERVISOR: [ ]		DESIGN ENGINEER: [ ]		USE ENGINEER: [ ]		DATE: [ ]		DRAWN BY: GIBBSHILL		REVISIONS:	

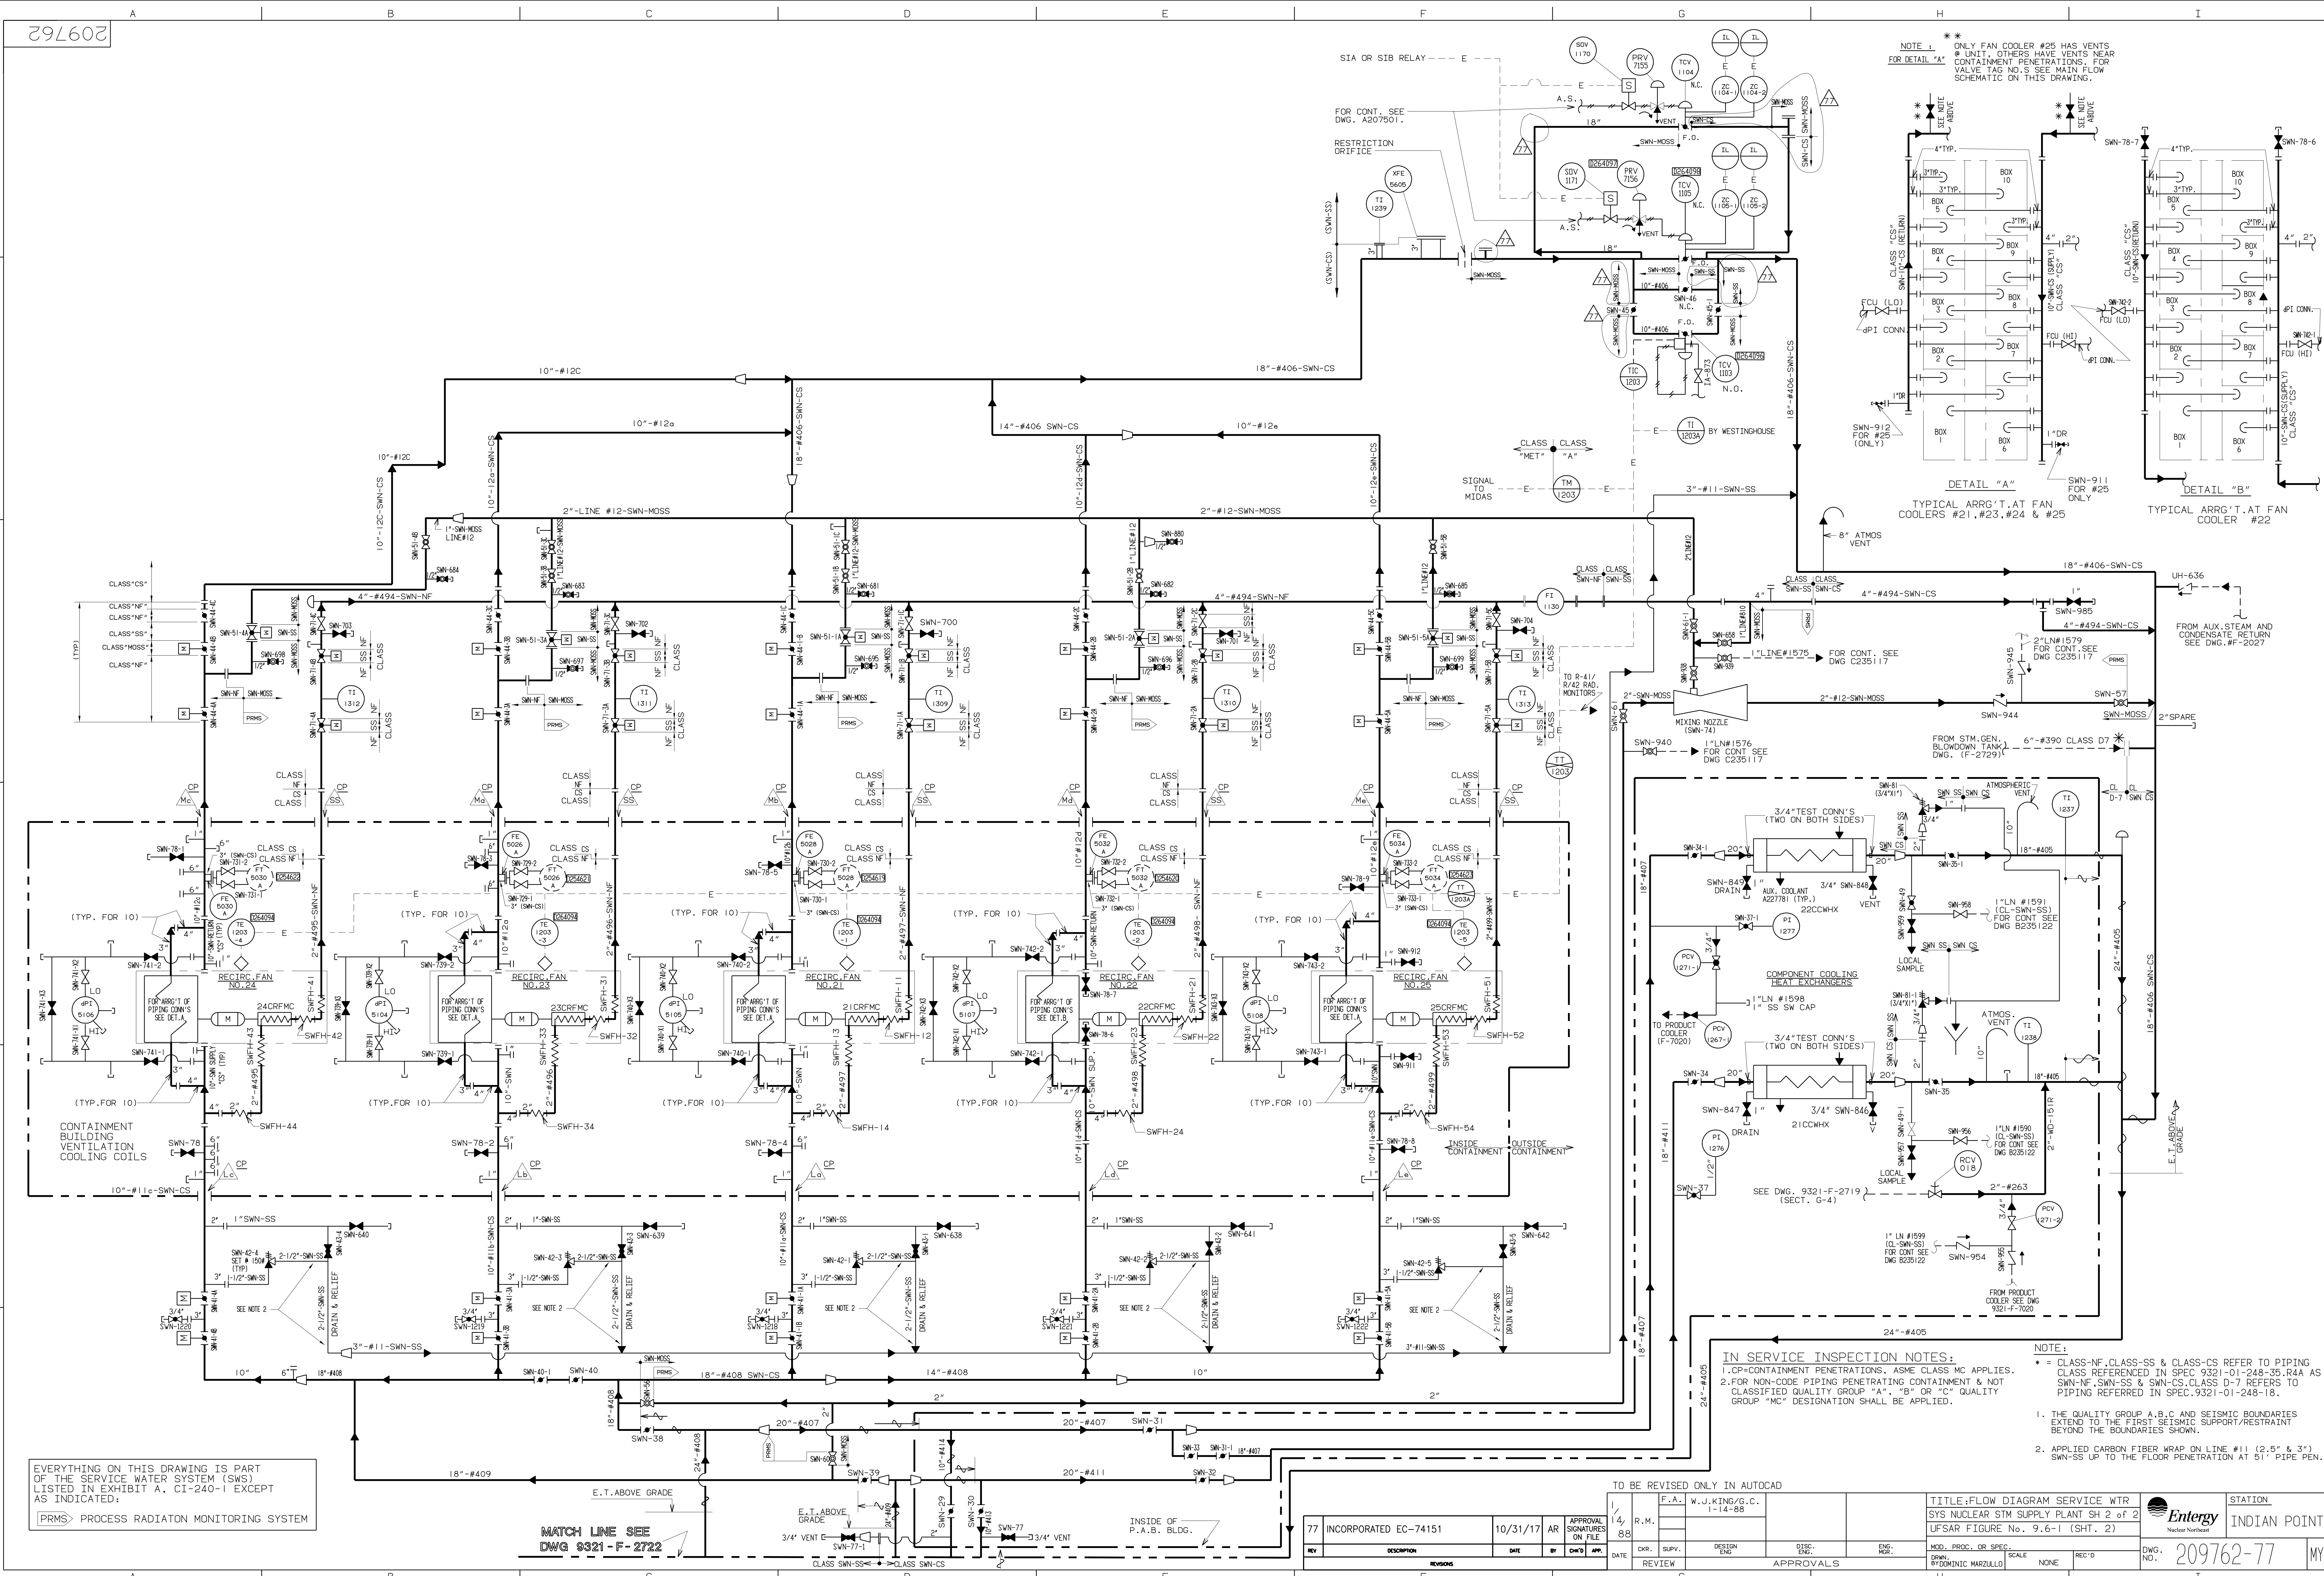

NOTE: \*\* ONLY FAN COOLER #25 HAS VENTS  
 @ UNIT. OTHERS HAVE VENTS NEAR  
 CONTAINMENT PENETRATIONS. FOR  
 VALVE TAG NO.'S SEE MAIN FLOW  
 SCHEMATIC ON THIS DRAWING.

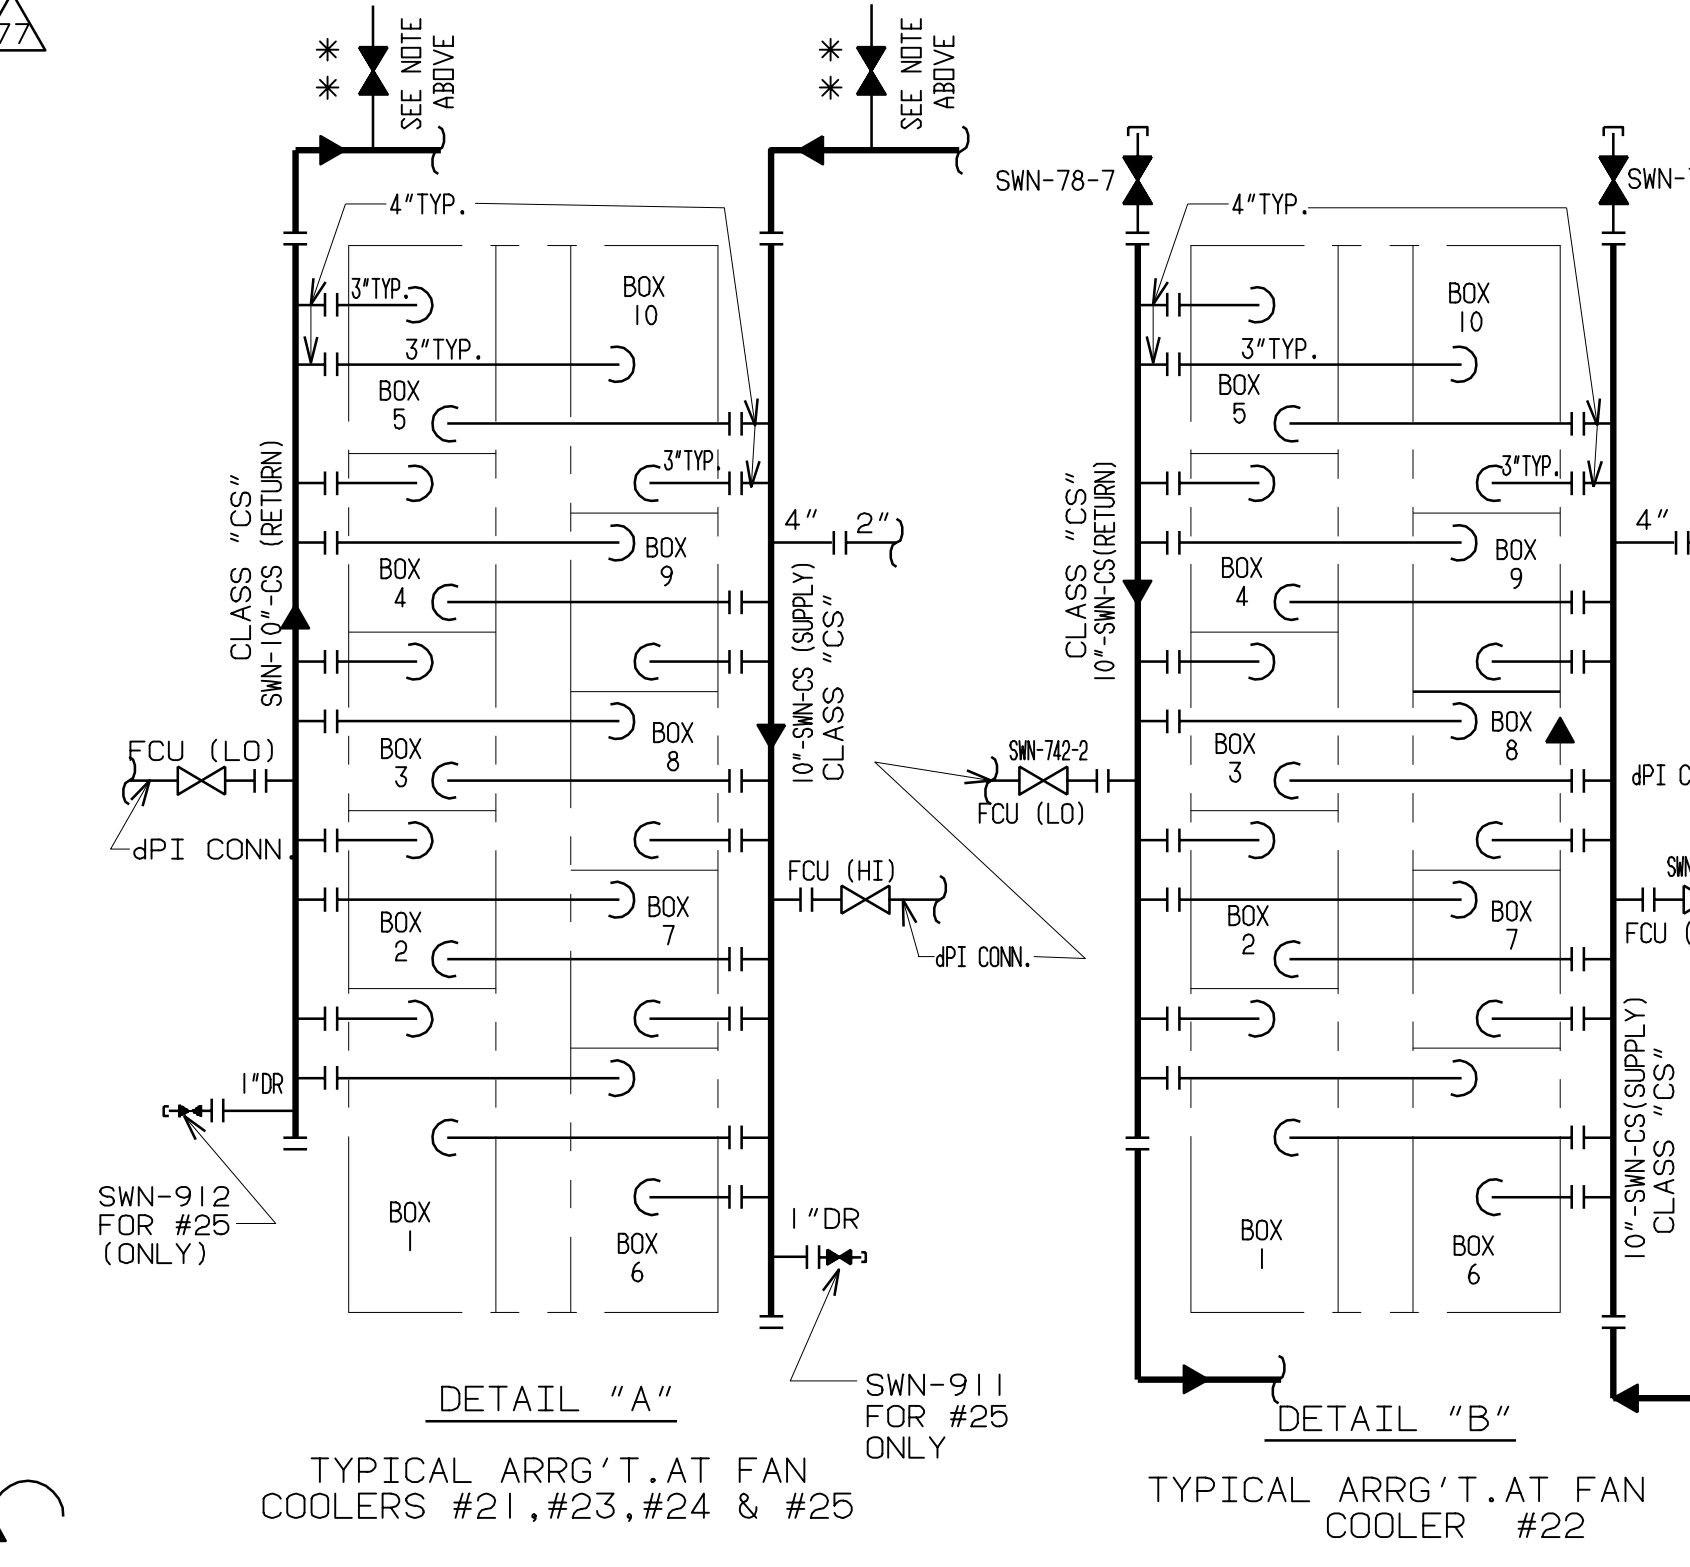

EVERYTHING ON THIS DRAWING IS PART  
 OF THE SERVICE WATER SYSTEM (SWS)  
 LISTED IN EXHIBIT A, CI-240-1 EXCEPT  
 AS INDICATED:  
 [PRMS] PROCESS RADIATION MONITORING SYSTEM

MATCH LINE SEE  
 DWG 9321-F-2722


IN SERVICE INSPECTION NOTES:  
 1. CP=CONTAINMENT PENETRATIONS. ASME CLASS MC APPLIES.  
 2. FOR NON-CODE PIPING PENETRATING CONTAINMENT & NOT  
 CLASSIFIED QUALITY GROUP "A", "B" OR "C" QUALITY  
 PIPING REFERRED IN SPEC. 9321-01-248-18.  
 PIPING REFERRED IN SPEC. 9321-01-248-18.  
 1. THE QUALITY GROUP A, B, C AND SEISMIC BOUNDARIES  
 EXTEND TO THE FIRST SEISMIC SUPPORT/RESTRAINT  
 BEYOND THE BOUNDARIES SHOWN.  
 2. APPLIED CARBON FIBER WRAP ON LINE #11 (2.5" & 3")  
 SWN-SS UP TO THE FLOOR PENETRATION AT 51" PIPE PEN.

TO BE REVISED ONLY IN AUTOCAD				APPROVALS				TITLE: FLOW DIAGRAM SERVICE WTR		STATION			
REV	DESCRIPTION	DATE	BY	CHKD	APP	DR.	DESIGN	DISC.	ENG. MGR.	SCALE	REC'D	DWG. NO.	MY
77	INCORPORATED EC-74151	10/31/17	AR			F.A.	W.J. KING, G.C.			1-14-88		209762-77	

B 192505-21  
 CITY WATER  
 UNIT #1  
 INDIAN POINT  
 FLOW DIAG.  
 SYSTEM SHT #1

REV	DESCRIPTION	DATE	BY	CHK'D	APP.
21	INCORPORATED EC-23341	8/17/10	JS		

REV	DESCRIPTION	DATE	BY	CHK'D	APP.
17	M. RADVANSKY 05/02/03				

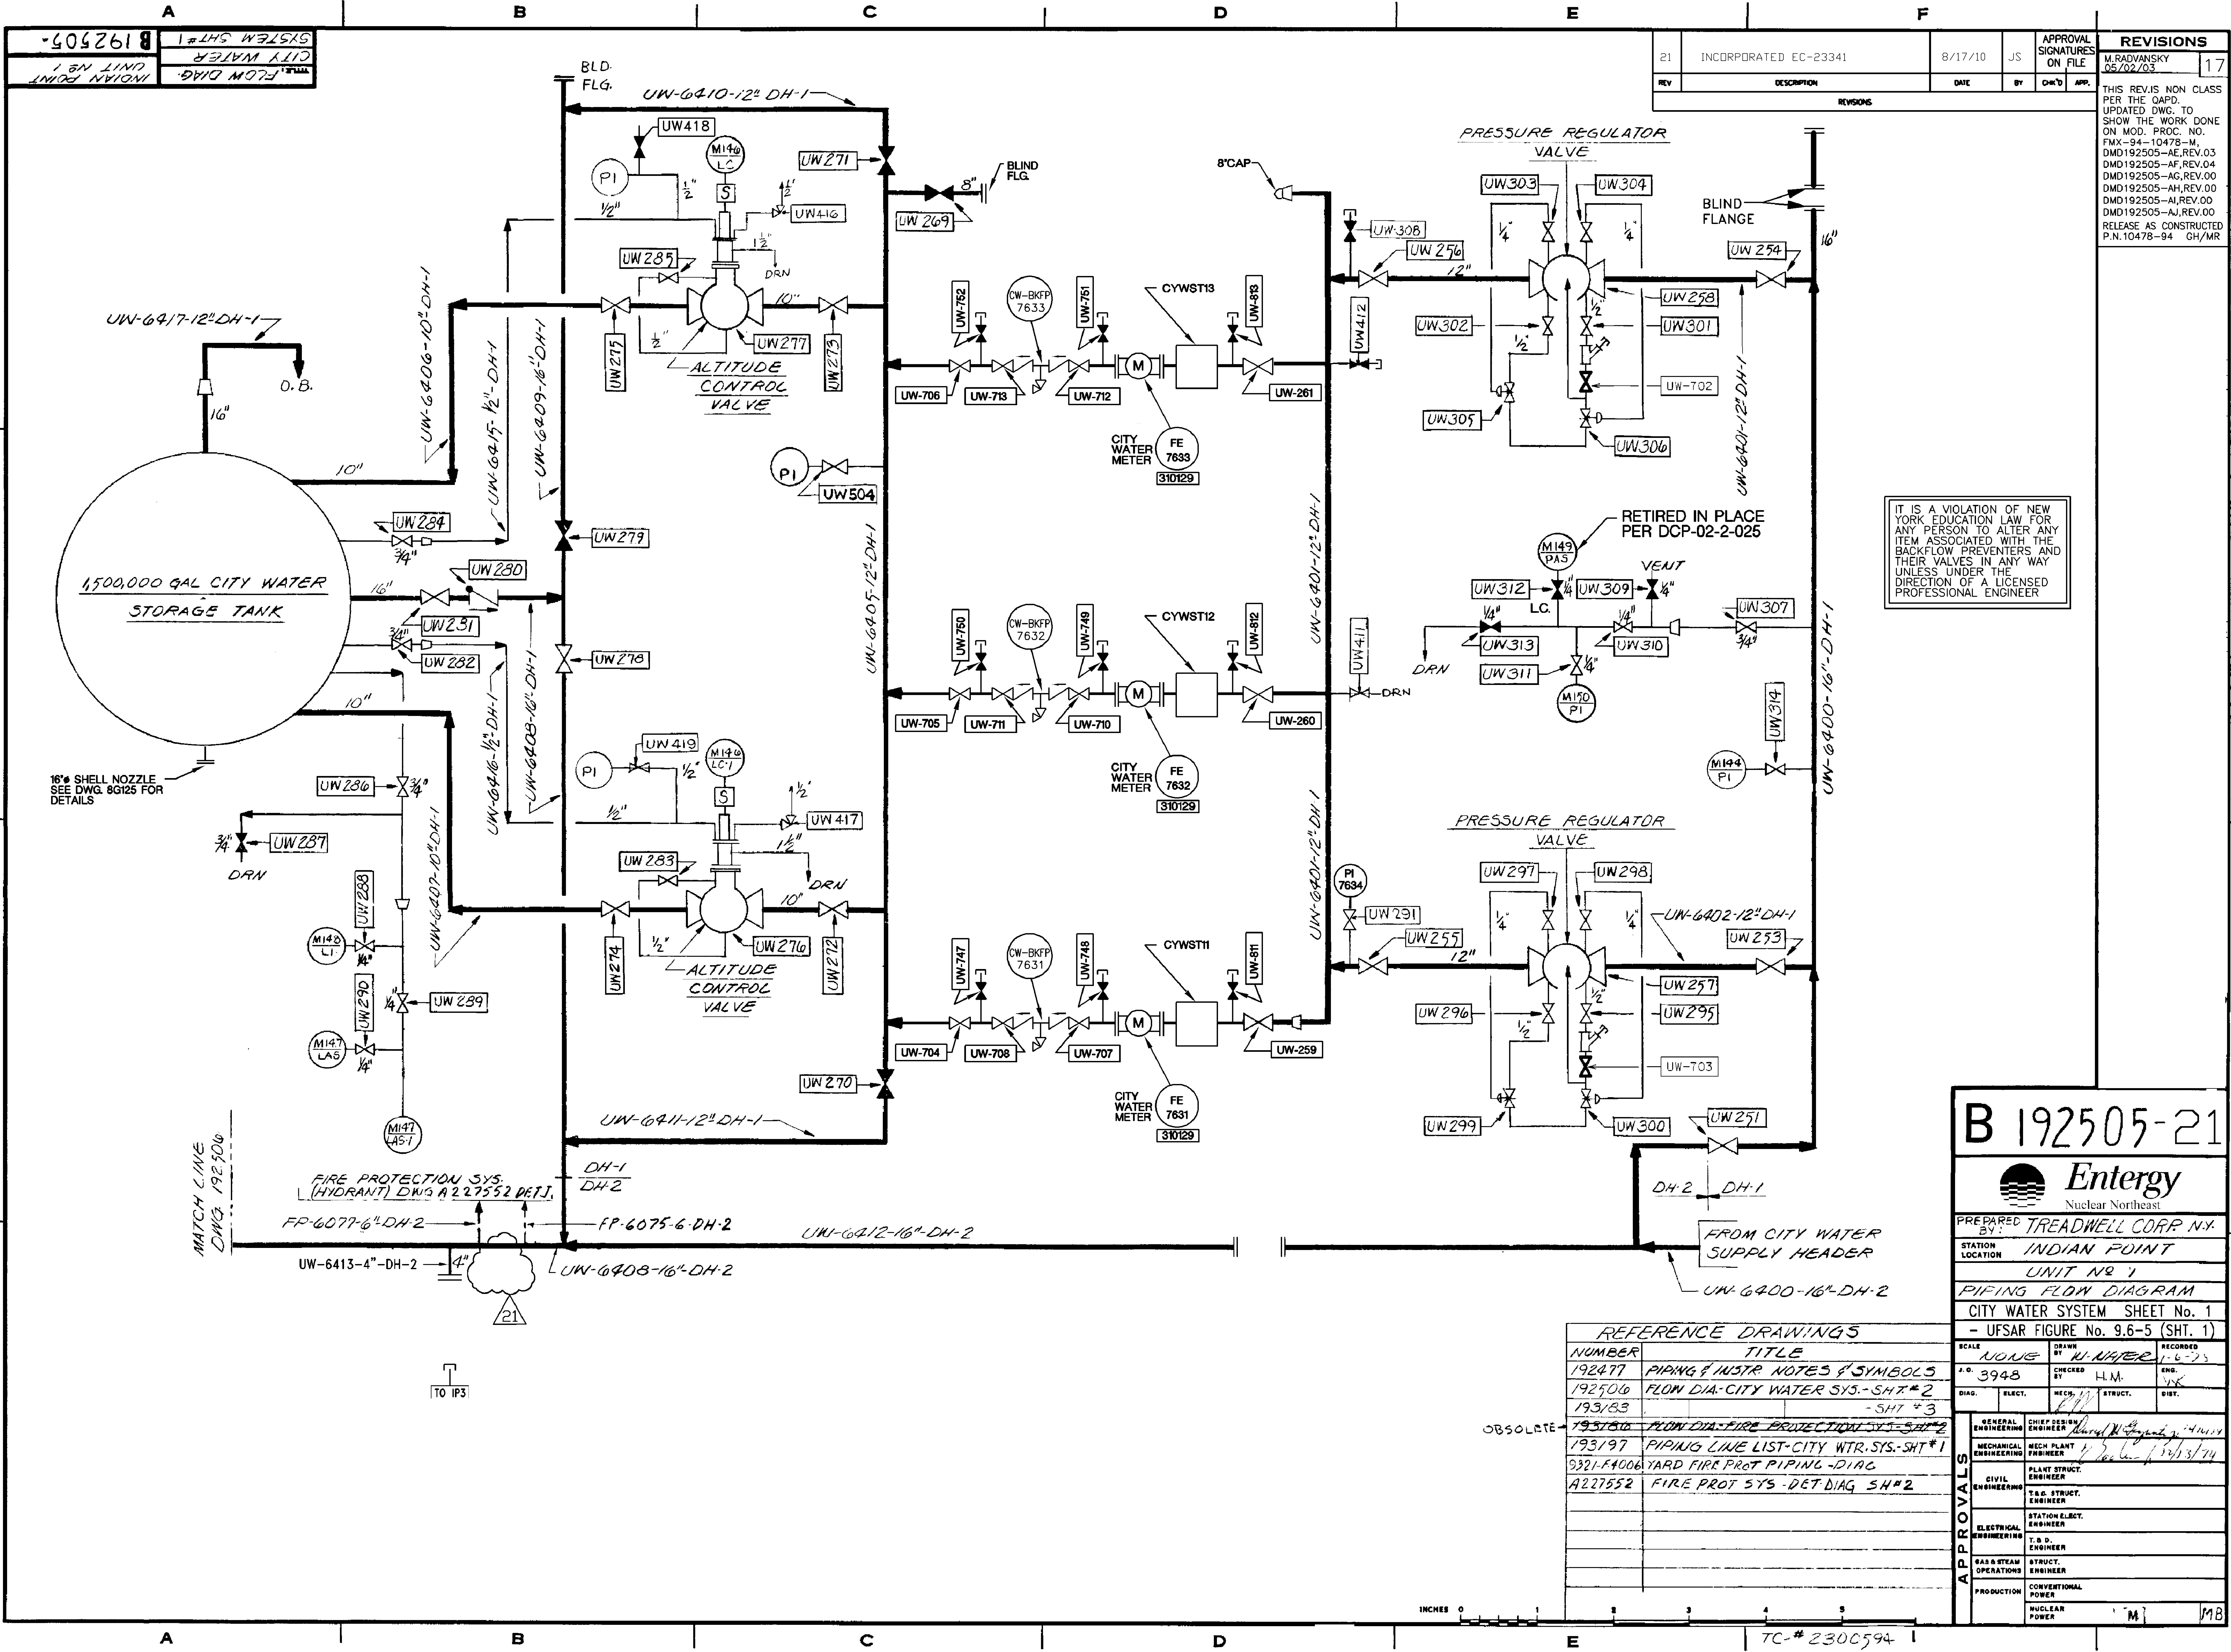

IT IS A VIOLATION OF NEW YORK EDUCATION LAW FOR ANY PERSON TO ALTER ANY ITEM ASSOCIATED WITH THE BACKFLOW PREVENTERS AND THEIR VALVES IN ANY WAY UNLESS UNDER THE DIRECTION OF A LICENSED PROFESSIONAL ENGINEER

B 192505-21



PREPARED BY: TREADWELL CORP. NY.  
 STATION: INDIAN POINT  
 LOCATION: UNIT #1  
 PIPING FLOW DIAGRAM  
 CITY WATER SYSTEM SHEET No. 1  
 - UFSAR FIGURE No. 9.6-5 (SHT. 1)

NUMBER	TITLE
192477	PIPING & INSTR. NOTES & SYMBOLS
192506	FLOW DIA.-CITY WATER SYS.-SHT #2
193/83	-SHT #3
<del>193781</del>	<del>FLOW DIA.-FIRE PROTECTION SYS.-SHT #1</del>
193197	PIPING LINE LIST-CITY WTR.SYS.-SHT #1
9321-F4006	YARD FIRE PROT PIPING-DIAG
A22752	FIRE PROT SYS-DET DIAG SH #2


SCALE	DRAWN BY	RECORDED
NONE	W. WALTER	1-6-73
#. 3948	CHK'D BY H.M.	ENG. 4/8

APPROVALS	GENERAL ENGINEERING	MECHANICAL ENGINEERING	CIVIL ENGINEERING	ELECTRICAL ENGINEERING	GAS & STEAM OPERATIONS	PRODUCTION
CHIEF DESIGN ENGINEER	MECH. PLANT ENGINEER	PLANT STRUCT. ENGINEER	T.S. STRUCT. ENGINEER	STATION ELCT. ENGINEER	T.S.D. ENGINEER	STRUCT. ENGINEER
						CONVENTIONAL POWER
						NUCLEAR POWER


TC-# 2300594



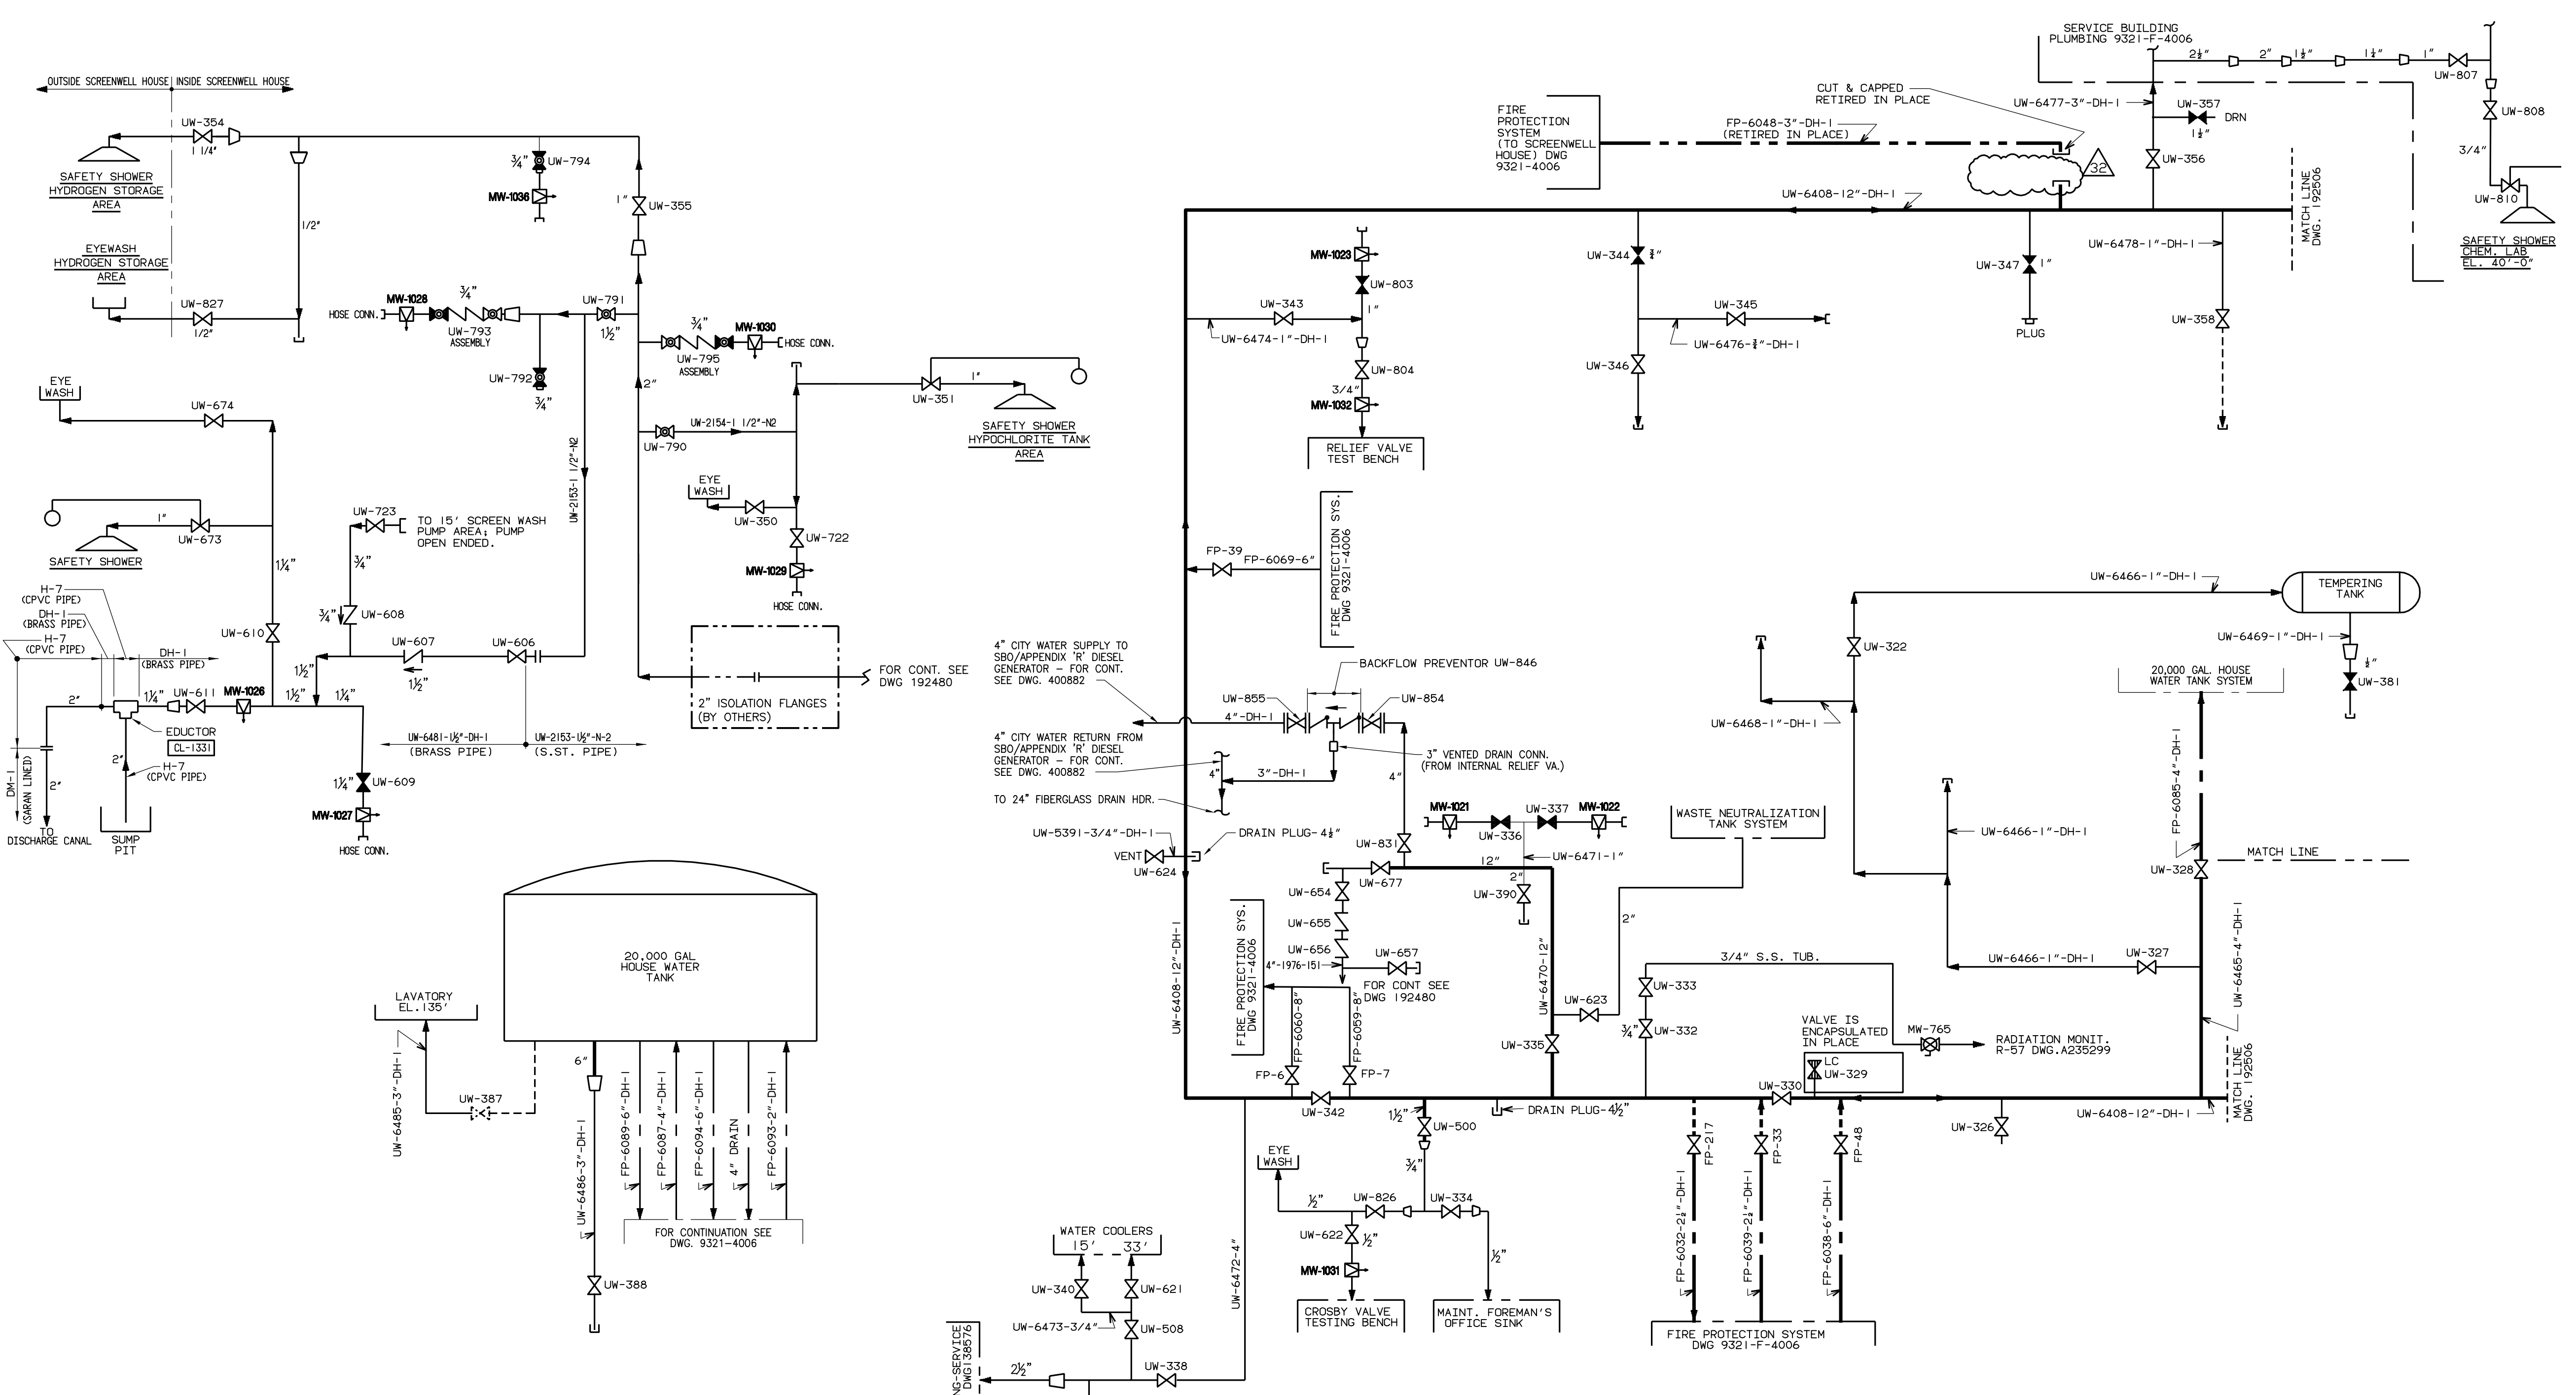

REFERENCE DRAWINGS	
NUMBER	TITLE
192477	PIPING & INSTR. NOTES & SYMBOLS
192505	FLOW DIA-CITY WATER SYS. -SHT#1
192480	PIPING LINE LIST CITY WATER SYS. -SHT#2
192482	RIVER WTR SERVICE SYS DIAG. -SHT#1
192483	MAIN CONDENSATE CIRC. WATER DIAG.
192484	MAIN CONDENSATE CIRC. WATER DIAG. -SHT#2
192486	CONDENSATE RETURN SYS. DIAG. -SHT#1
192489	CONDENSATE AIR REMOVAL DIAG.
193159	PIPING LINE LIST CITY WATER SYS. -SHT#3
9321-F-4006	YARD FIRE PROT PIPING-DIAG.
A227551	FIRE PROT. SYS.-DET.-DIAG. SH.1
A227552	SH.2
A227553	SH.3
A227554	SH.4
A231568	SCREEN WELL HOUSE #1 EL. 1360"

**DWG NO. 193183-32**  
**Entergy** MECHANICAL  
 DWG TYPE: A  
 LOCATION: INDIAN POINT  
 TITLE: UNIT No. 1 PIPING FLOW DIAG.  
 CITY WATER SYSTEM SHEET No. 3  
 UFSAR Fl. No. 9.6-5 (SHT. 3)  
 APPROVALS:  
 ENGINEERING MANAGER:  
 PROJECT ENGINEER:  
 DESIGNER:  
 DRAWN BY: M. HEREDIA  
 SCALE: DISCIPLINE CODE: MB

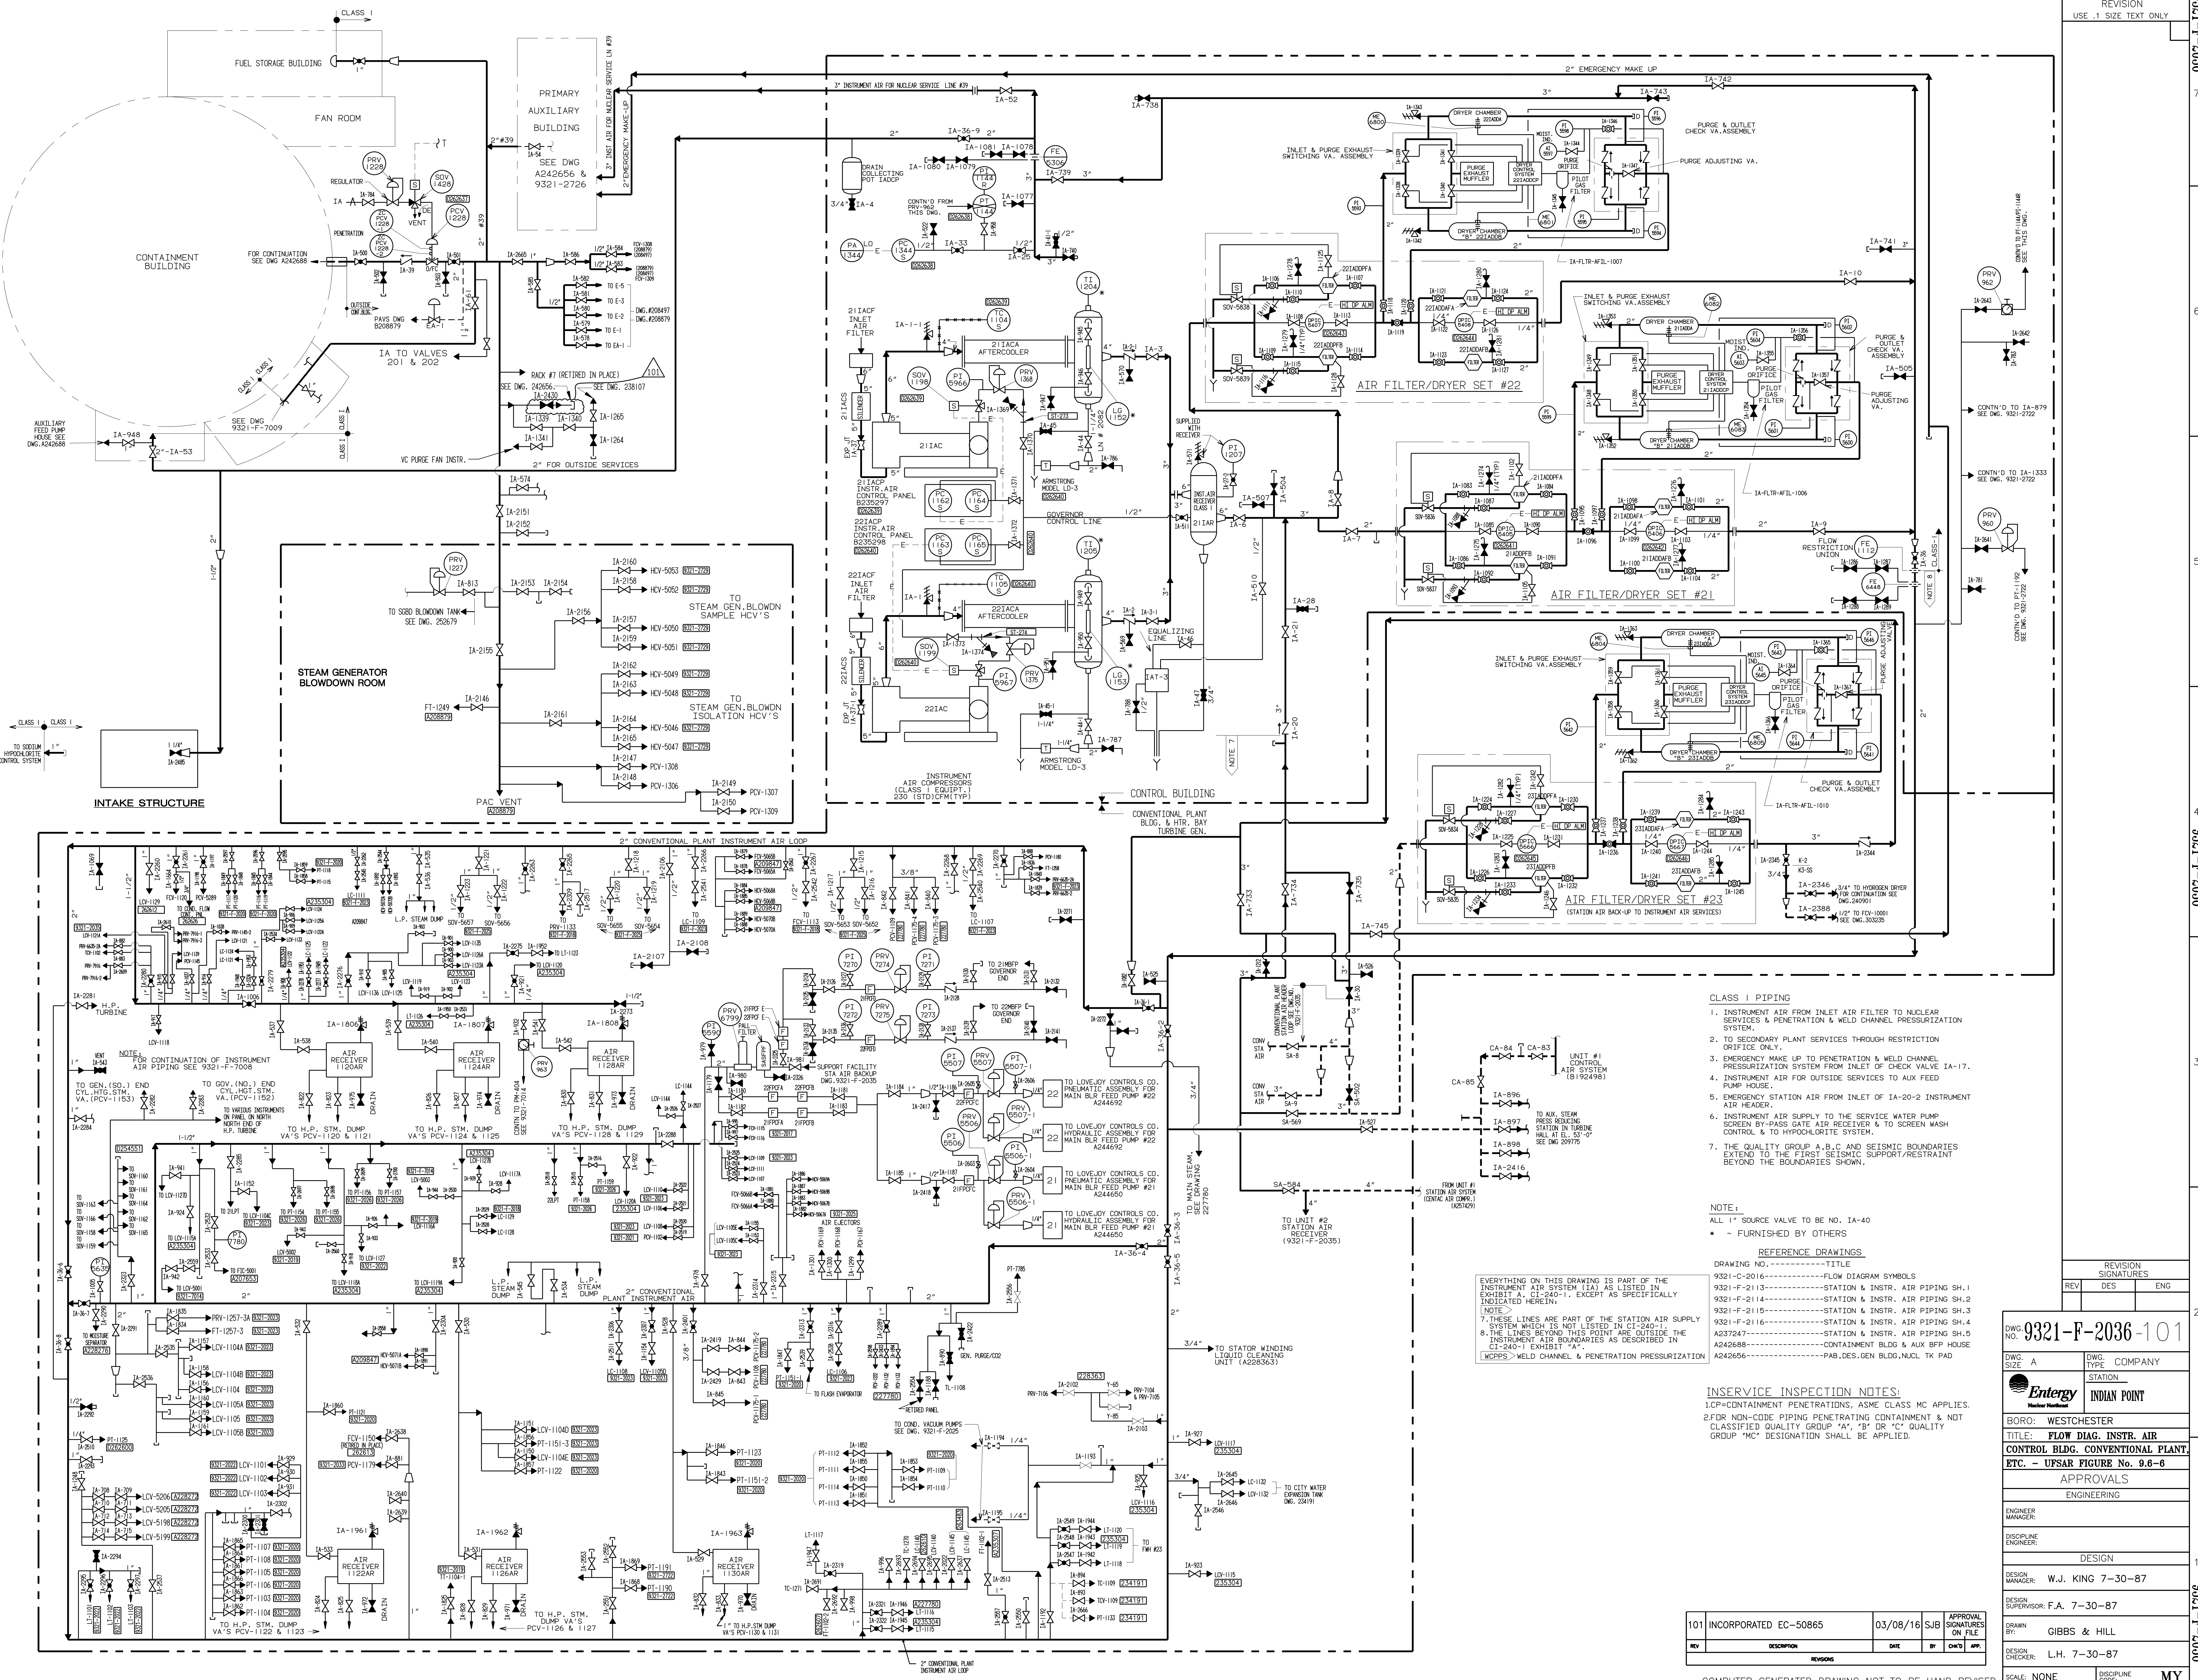

- CLASS I PIPING**
1. INSTRUMENT AIR FROM INLET AIR FILTER TO NUCLEAR SERVICES & PENETRATION & WELD CHANNEL PRESSURIZATION SYSTEM.
  2. TO SECONDARY PLANT SERVICES THROUGH RESTRICTION ORIFICE ONLY.
  3. EMERGENCY MAKE UP TO PENETRATION & WELD CHANNEL PRESSURIZATION SYSTEM FROM INLET OF CHECK VALVE IA-17.
  4. INSTRUMENT AIR FOR OUTSIDE SERVICES TO AUX FEED PUMP HOUSE.
  5. EMERGENCY STATION AIR FROM INLET OF IA-20-2 INSTRUMENT AIR HEADER.
  6. INSTRUMENT AIR SUPPLY TO THE SERVICE WATER PUMP SCREEN BY-PASS GATE AIR RECEIVER & TO SCREEN WASH CONTROL & TO HYDROCLORITE SYSTEM.
  7. THE QUALITY GROUP A,B,C AND SEISMIC BOUNDARIES EXTEND TO THE FIRST SEISMIC SUPPORT/RESTRAINT BEYOND THE BOUNDARIES SHOWN.

**NOTE:**  
ALL 1" SOURCE VALVE TO BE NO. IA-40  
- FURNISHED BY OTHERS

**REFERENCE DRAWINGS**  
DRAWING NO. .... TITLE  
9321-C-2016.....FLOW DIAGRAM SYMBOLS  
9321-F-2113.....STATION & INSTR. AIR PIPING SH.1  
9321-F-2114.....STATION & INSTR. AIR PIPING SH.2  
9321-F-2115.....STATION & INSTR. AIR PIPING SH.3  
9321-F-2116.....STATION & INSTR. AIR PIPING SH.4  
A237247.....STATION & INSTR. AIR PIPING SH.5  
A242688.....CONTAINMENT BLDG. & AUX BFP HOUSE  
A242656.....PAB,DES GEN BLDG,NUCL TK PAD

EVERYTHING ON THIS DRAWING IS PART OF THE INSTRUMENT AIR SYSTEM (IA) AS LISTED IN EXHIBIT A, CI-240-1, EXCEPT AS SPECIFICALLY INDICATED HEREIN.  
NOTE:  
7. THESE LINES ARE PART OF THE STATION AIR SUPPLY SYSTEM WHICH IS NOT LISTED IN CI-240-1.  
8. THE LINES BEYOND THIS POINT ARE OUTSIDE THE INSTRUMENT AIR BOUNDARIES AS DESCRIBED IN CI-240-1 EXHIBIT "A".  
ICRPS- WELD CHANNEL & PENETRATION PRESSURIZATION

**INSERVICE INSPECTION NOTES:**  
1.CP=CONTAINMENT PENETRATIONS, ASME CLASS MC APPLIES.  
2.FOR NON-CODE PIPING PENETRATING CONTAINMENT & NOT CLASSIFIED QUALITY GROUP "A", "B" OR "C" QUALITY GROUP "MC" DESIGNATION SHALL BE APPLIED.

REV	DES	ENG

DWG NO. **9321-F-2036-101**

DWG SIZE: A DWG TYPE: COMPANY: STATION: INDIAN POINT

BORO: WESTCHESTER  
TITLE: FLOW DIAG. INSTR. AIR CONTROL BLDG. CONVENTIONAL PLANT, ETC. - UFSAR FIGURE No. 9.6-6

APPROVALS  
ENGINEERING  
ENGINEER  
DESIGN

DESIGN MANAGER: W.J. KING 7-30-87  
DESIGN SUPERVISOR: F.A. 7-30-87

DESIGN BY: GIBBS & HILL  
DESIGN CHECKER: L.H. 7-30-87


SCALE: NONE DISCIPLINE CODE: MY

REV	DESCRIPTION	DATE	BY	CHKD	APP
101	INCORPORATED EC-50865	03/08/16	SJB	APPROVAL SIGNATURES ON FILE	


COMPUTER GENERATED DRAWING NOT TO BE HAND REWISED

9321-F-2036

46	INCORPORATED EC3300	4/30/09	JF	APPROVAL SIGNATURES ON FILE
REV	DESCRIPTION	DATE	BY	CHK

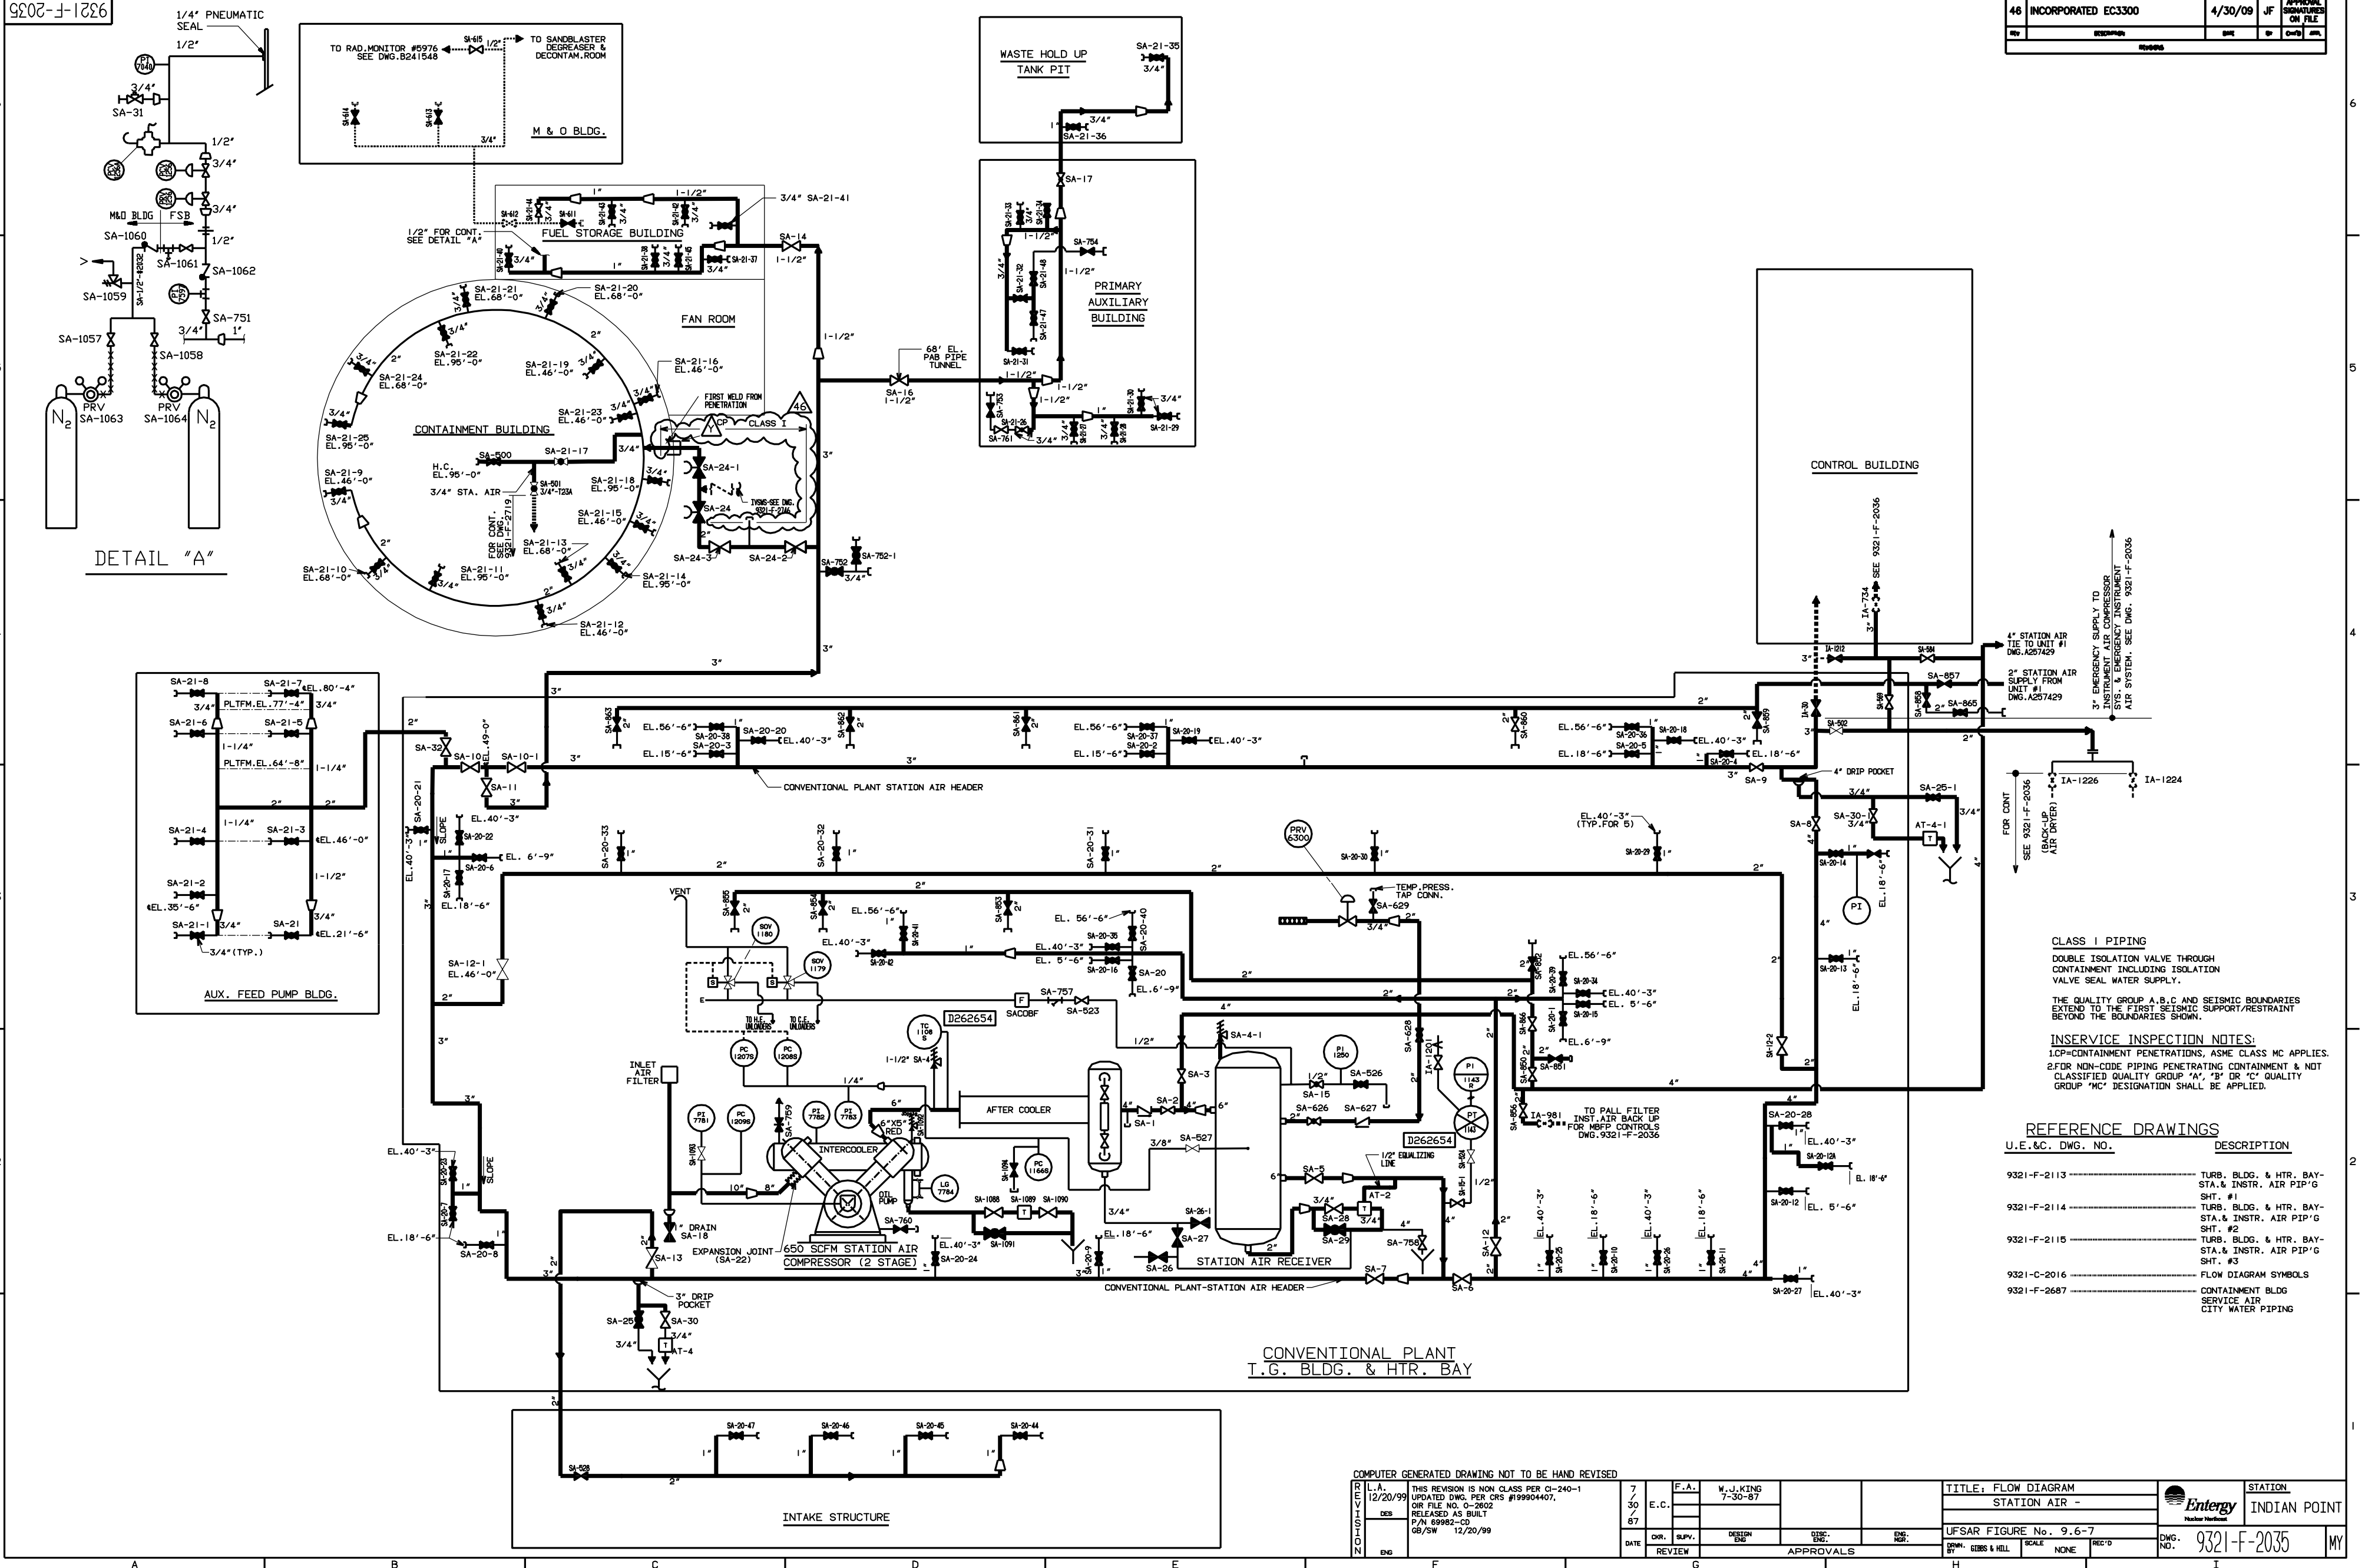

DETAIL "A"

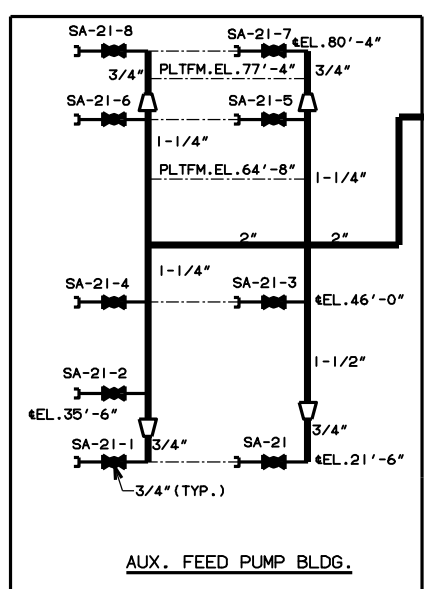

**CLASS I PIPING**  
 DOUBLE ISOLATION VALVE THROUGH CONTAINMENT INCLUDING ISOLATION VALVE SEAL WATER SUPPLY.

THE QUALITY GROUP A, B, C AND SEISMIC BOUNDARIES EXTEND TO THE FIRST SEISMIC SUPPORT/RESTRAINT BEYOND THE BOUNDARIES SHOWN.

**INSERVICE INSPECTION NOTES:**  
 1CP-CONTAINMENT PENETRATIONS, ASME CLASS MC APPLIES.  
 2FOR NON-CODE PIPING PENETRATING CONTAINMENT & NOT CLASSIFIED QUALITY GROUP "A", "B" OR "C" QUALITY GROUP "MC" DESIGNATION SHALL BE APPLIED.

**REFERENCE DRAWINGS**

U.E.&C. DWG. NO.	DESCRIPTION
9321-F-2113	TURB. BLDG. & HTR. BAY-STA. & INSTR. AIR PIP'G SHIT. #1
9321-F-2114	TURB. BLDG. & HTR. BAY-STA. & INSTR. AIR PIP'G SHIT. #2
9321-F-2115	TURB. BLDG. & HTR. BAY-STA. & INSTR. AIR PIP'G SHIT. #3
9321-C-2016	FLOW DIAGRAM SYMBOLS
9321-F-2687	CONTAINMENT BLDG SERVICE AIR CITY WATER PIPING




CONVENTIONAL PLANT T.G. BLDG. & HTR. BAY

COMPUTER GENERATED DRAWING NOT TO BE HAND REVISED


REV	DATE	DESCRIPTION	BY	CHK
1	12/20/99	THIS REVISION IS NON CLASS PER C-240-1 UPDATED DWG. PER CRS #199904407. OR FILE NO. 0-2862 RELEASED AS BUILT P/N 69962-CD 68/SW 12/20/99		
2	7/30/87			
3				
4				

DESIGN	DATE	APPROVALS

TITLE: FLOW DIAGRAM STATION AIR	STATION INDIAN POINT
UFSAR FIGURE No. 9.6-7	DWG. NO. 9321-F-2036
SCALE NONE	REV'D
BY: GIBBS & HILL	MY

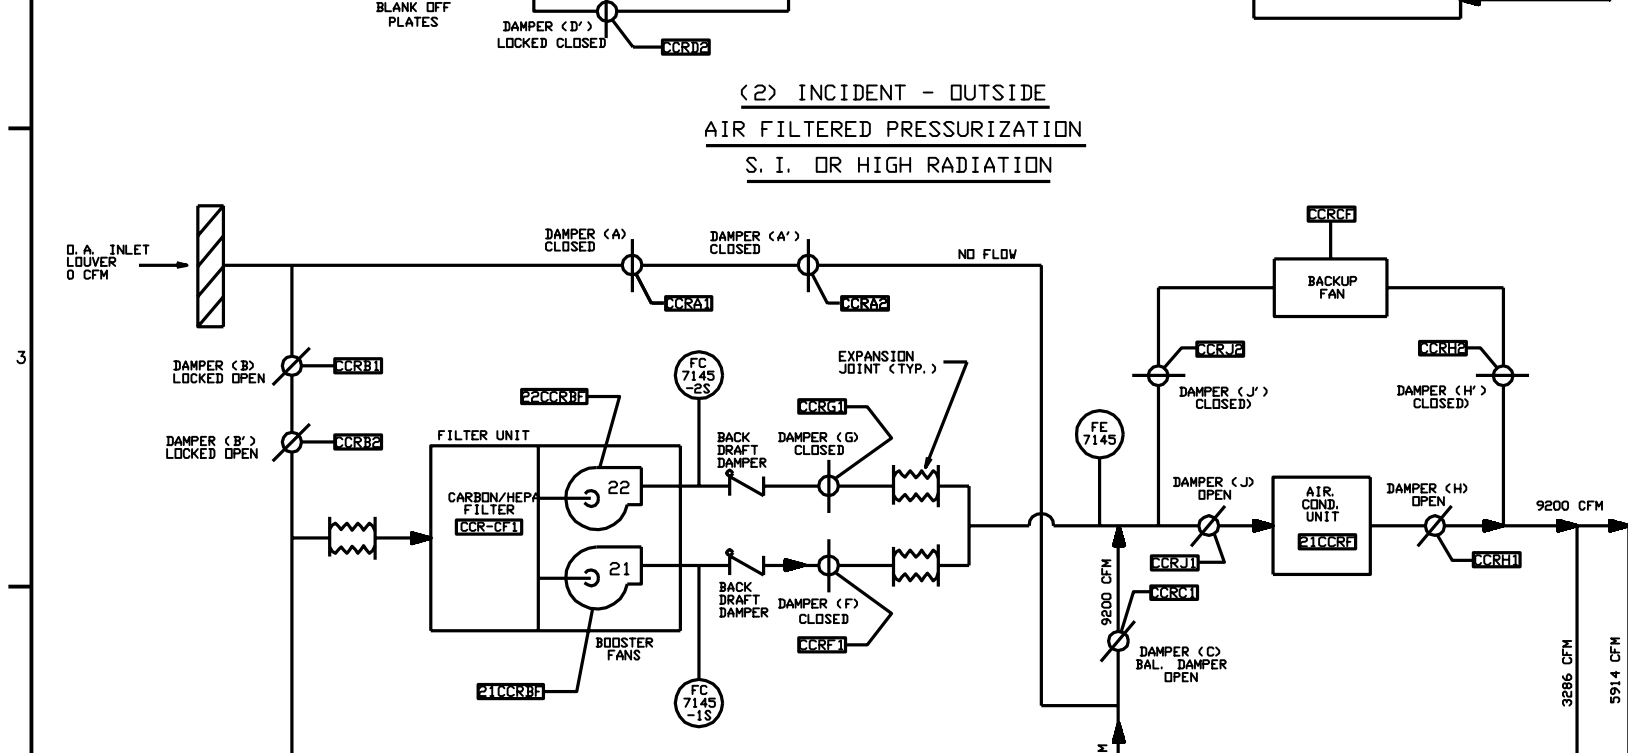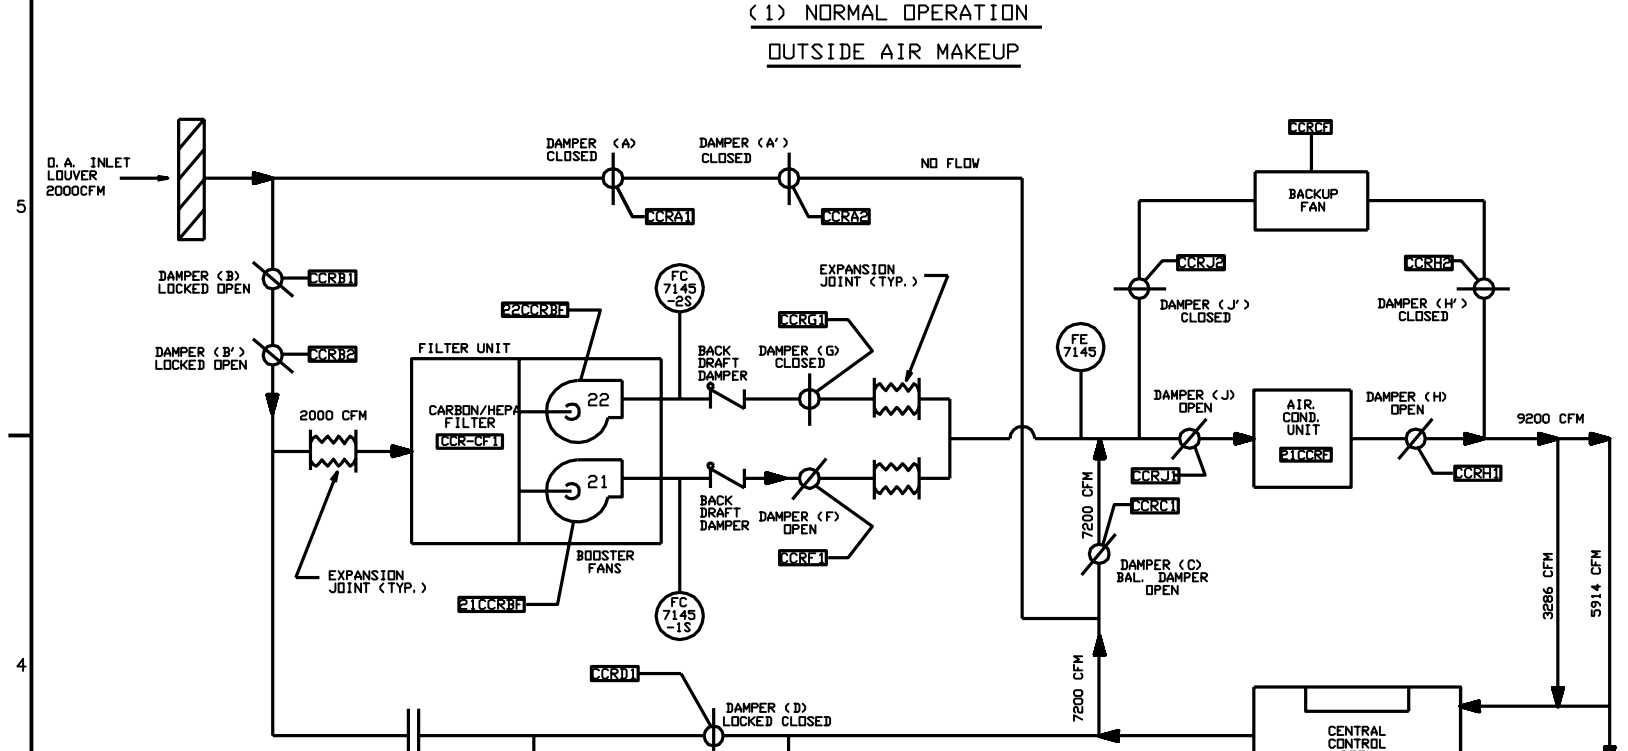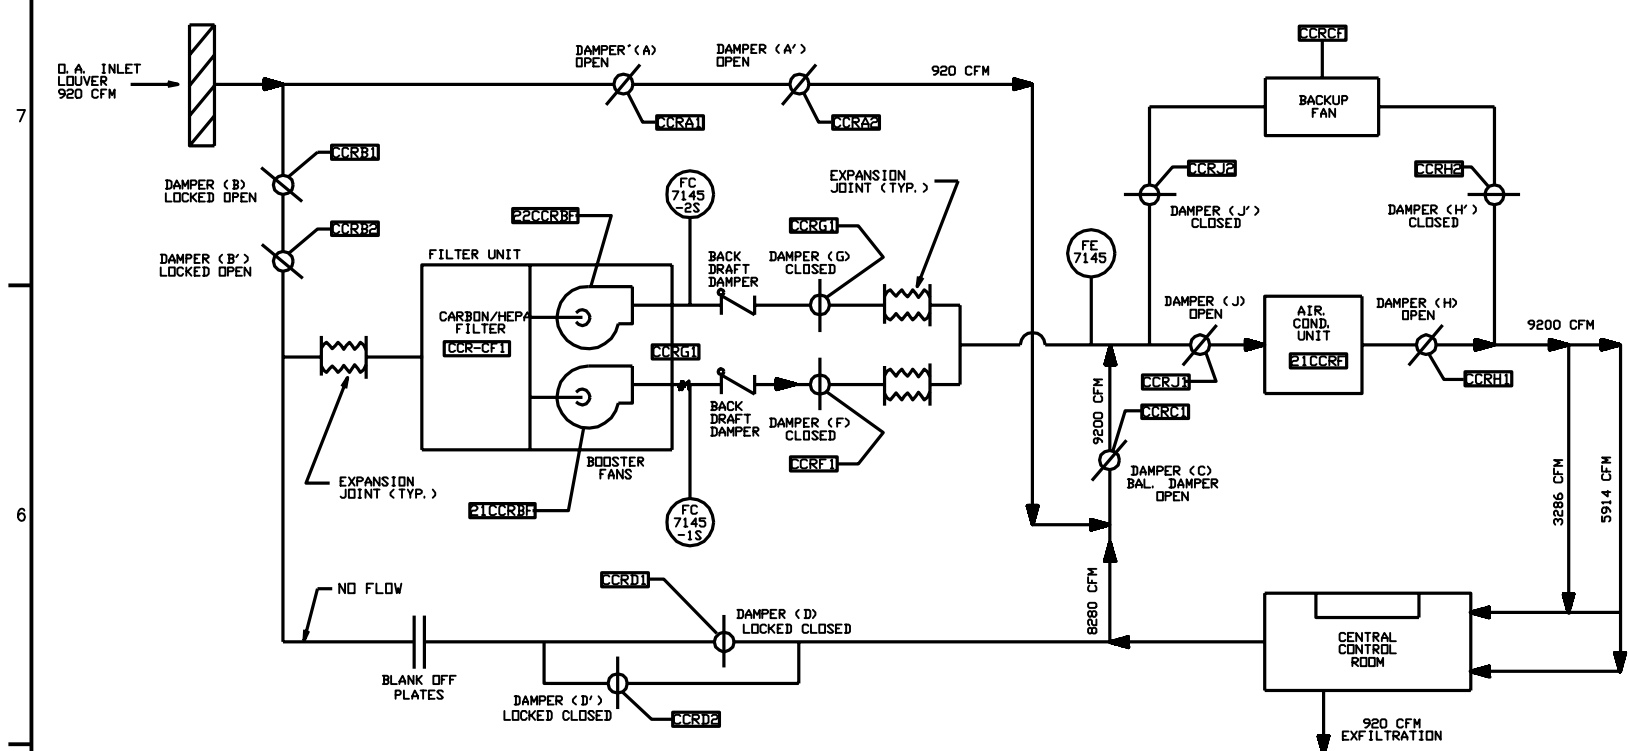

AIR FLOW DIAGRAMS

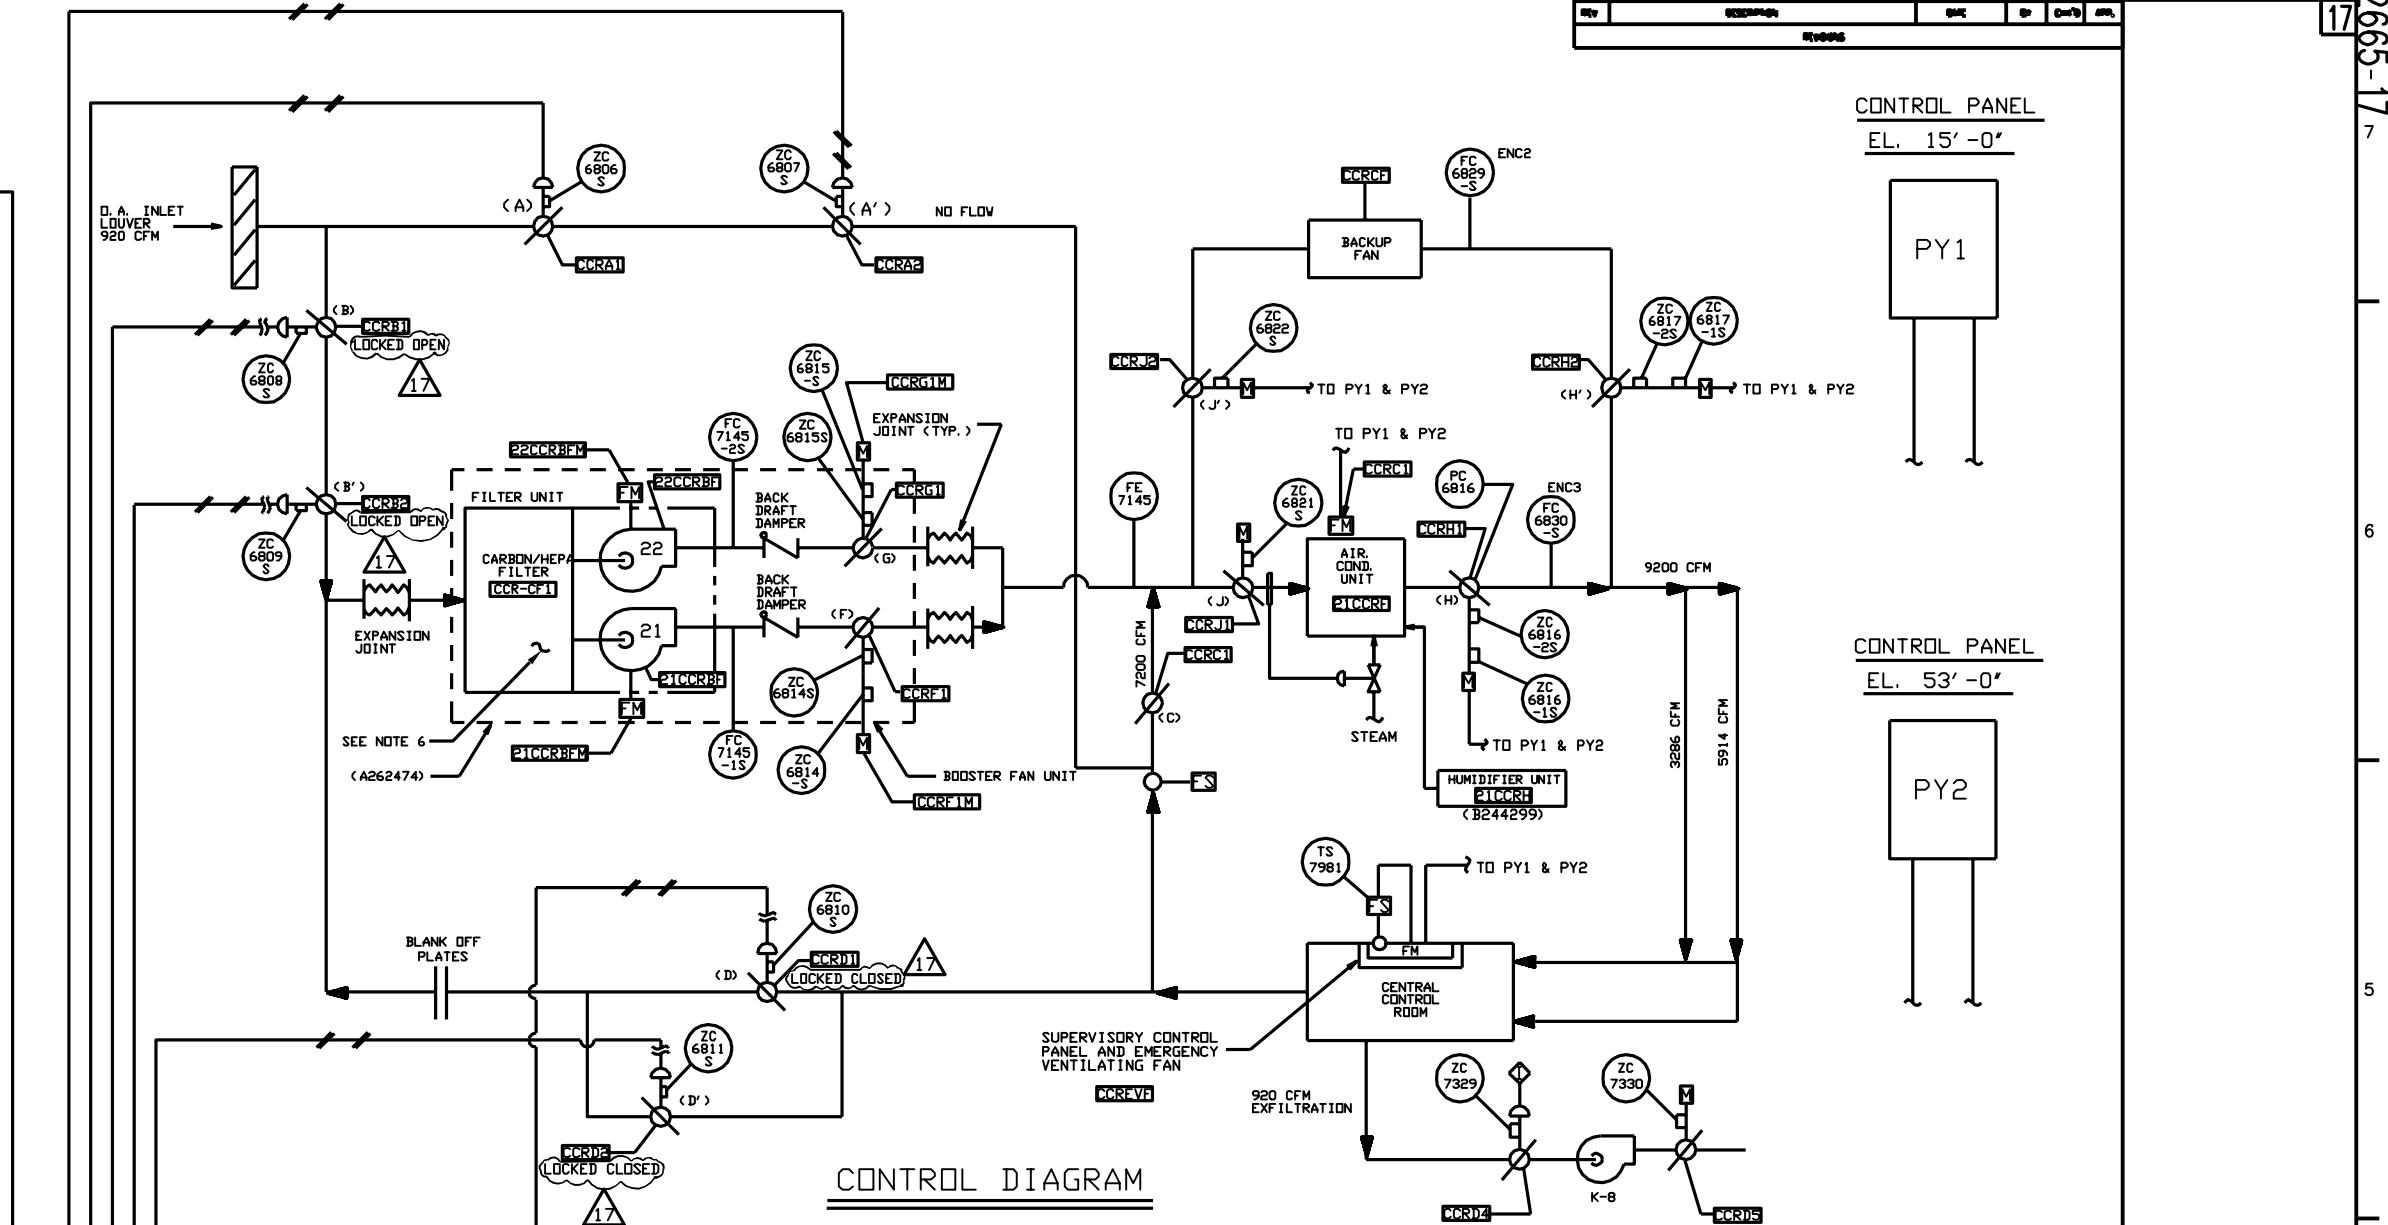

LEGEND


- D. A. - OUTSIDE AIR
- F. S. - FIRE STAT
- F. M. - FAN MOTOR
 - DAMPER MOTOR
 - FLOW SWITCH
 - FLOW MEASUREMENT DEVICE
 - SOLENOID VALVE
 - POSITION CONTROLLER

REFERENCE DRAWINGS

- 9321-F-4017 - CONTROL BUILDING -HVAC- PLANS.
- 9321-F-4050 - CONTROL BUILDING -HVAC- SECTIONS.
- 9321-F-4055 - CONTROL BUILDING - COOLING WATER TO AIR COND. UNIT.
- A226948 - CENTRAL CONTROL RM. HVAC SYSTEM DAMPERS AND REDUNDANCY.
- A225636 - SUPPLY DWG MODIFICATION OF CCR VENTILATION SYSTEM.
- 9321-F-3147 - CONDUIT LAYOUT - CONTROL ROOM AIR CONDITIONING.
- A262474 - CARBON FILTER UNIT (SHEET 1 OF 2)
- B244299 - CCR HUMIDIFIER FLOW DIAGRAM
- 192498 - PIPING FLOW DIAGRAM-CONTROL AIR SYSTEM

NOTES

1. DAMPERS 'J' & 'H' ARE NORMALLY CLOSED. OPEN WHEN A. C. FAN IS OFF. (BACKUP FAN ON)
2. DAMPERS 'J' & 'H' ARE NORMALLY OPEN. CLOSED WHEN A. C. FAN OFF. (BACKUP FAN ON)
3. 'Q' = 'Q' DESIGNATED EQUIPMENT NO.
4. AIRFLOW RATES (CFMs) SHOWN ON THIS FLOW DIAGRAM DRAWING ARE FOR DESIGN CONDITIONS ONLY.
5. DAMPER 'D' & 'D' WILL REMAIN CLOSED ON LOSS OF POWER OR AIR.
6. CCR-CF1 FILTER TAG NUMBERS:
  - HEPA FILTER (CCRHF)
  - CARBON FILTER STACK A (CCRCFA)
  - CARBON FILTER STACK B (CCRCFB)
  - POST FILTER (CCRCFP)

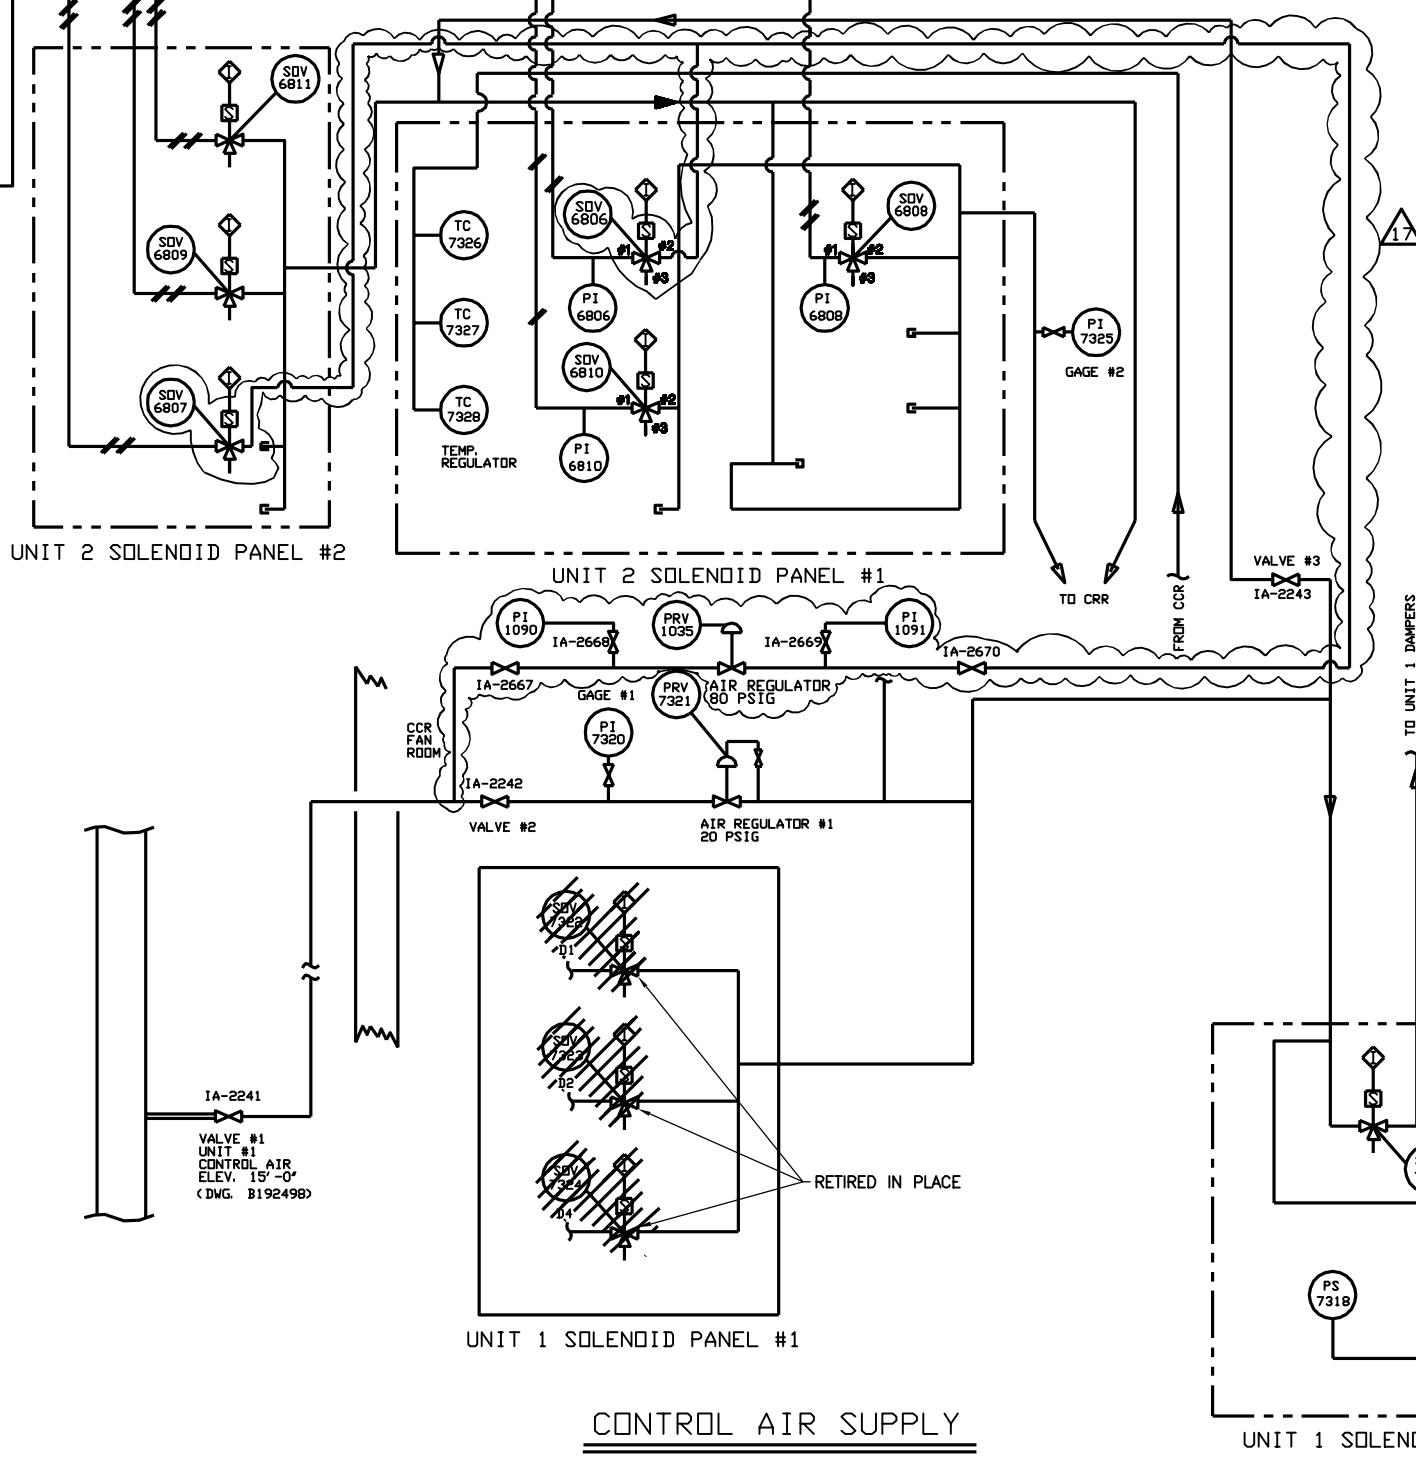

REVISION		SIGNATURES	
REV	DES	ENG	
00			

DWG. NO. **252665-17**

DWG. SIZE: **A** DWG. COMPANY: **ENTERTY**

STATION: **INDIAN POINT**

BORO: **WESTCHESTER**

TITLE: **CONTROL BUILDING (CCR) CONTROL AND AIR FLOW DIAGRAMS**

-UFSAR FIGURE NO. 9.9-1

APPROVALS

ENGINEERING

DESIGN

DESIGN MANAGER: **M. J. CAPUTO** 12/30/93


DESIGN SUPERVISOR: **A. D.**

DESIGN BY:

DESIGN CHECKER: **E. D.**

SCALE: **NDNE** DISCIPLINE CODE: **MY**



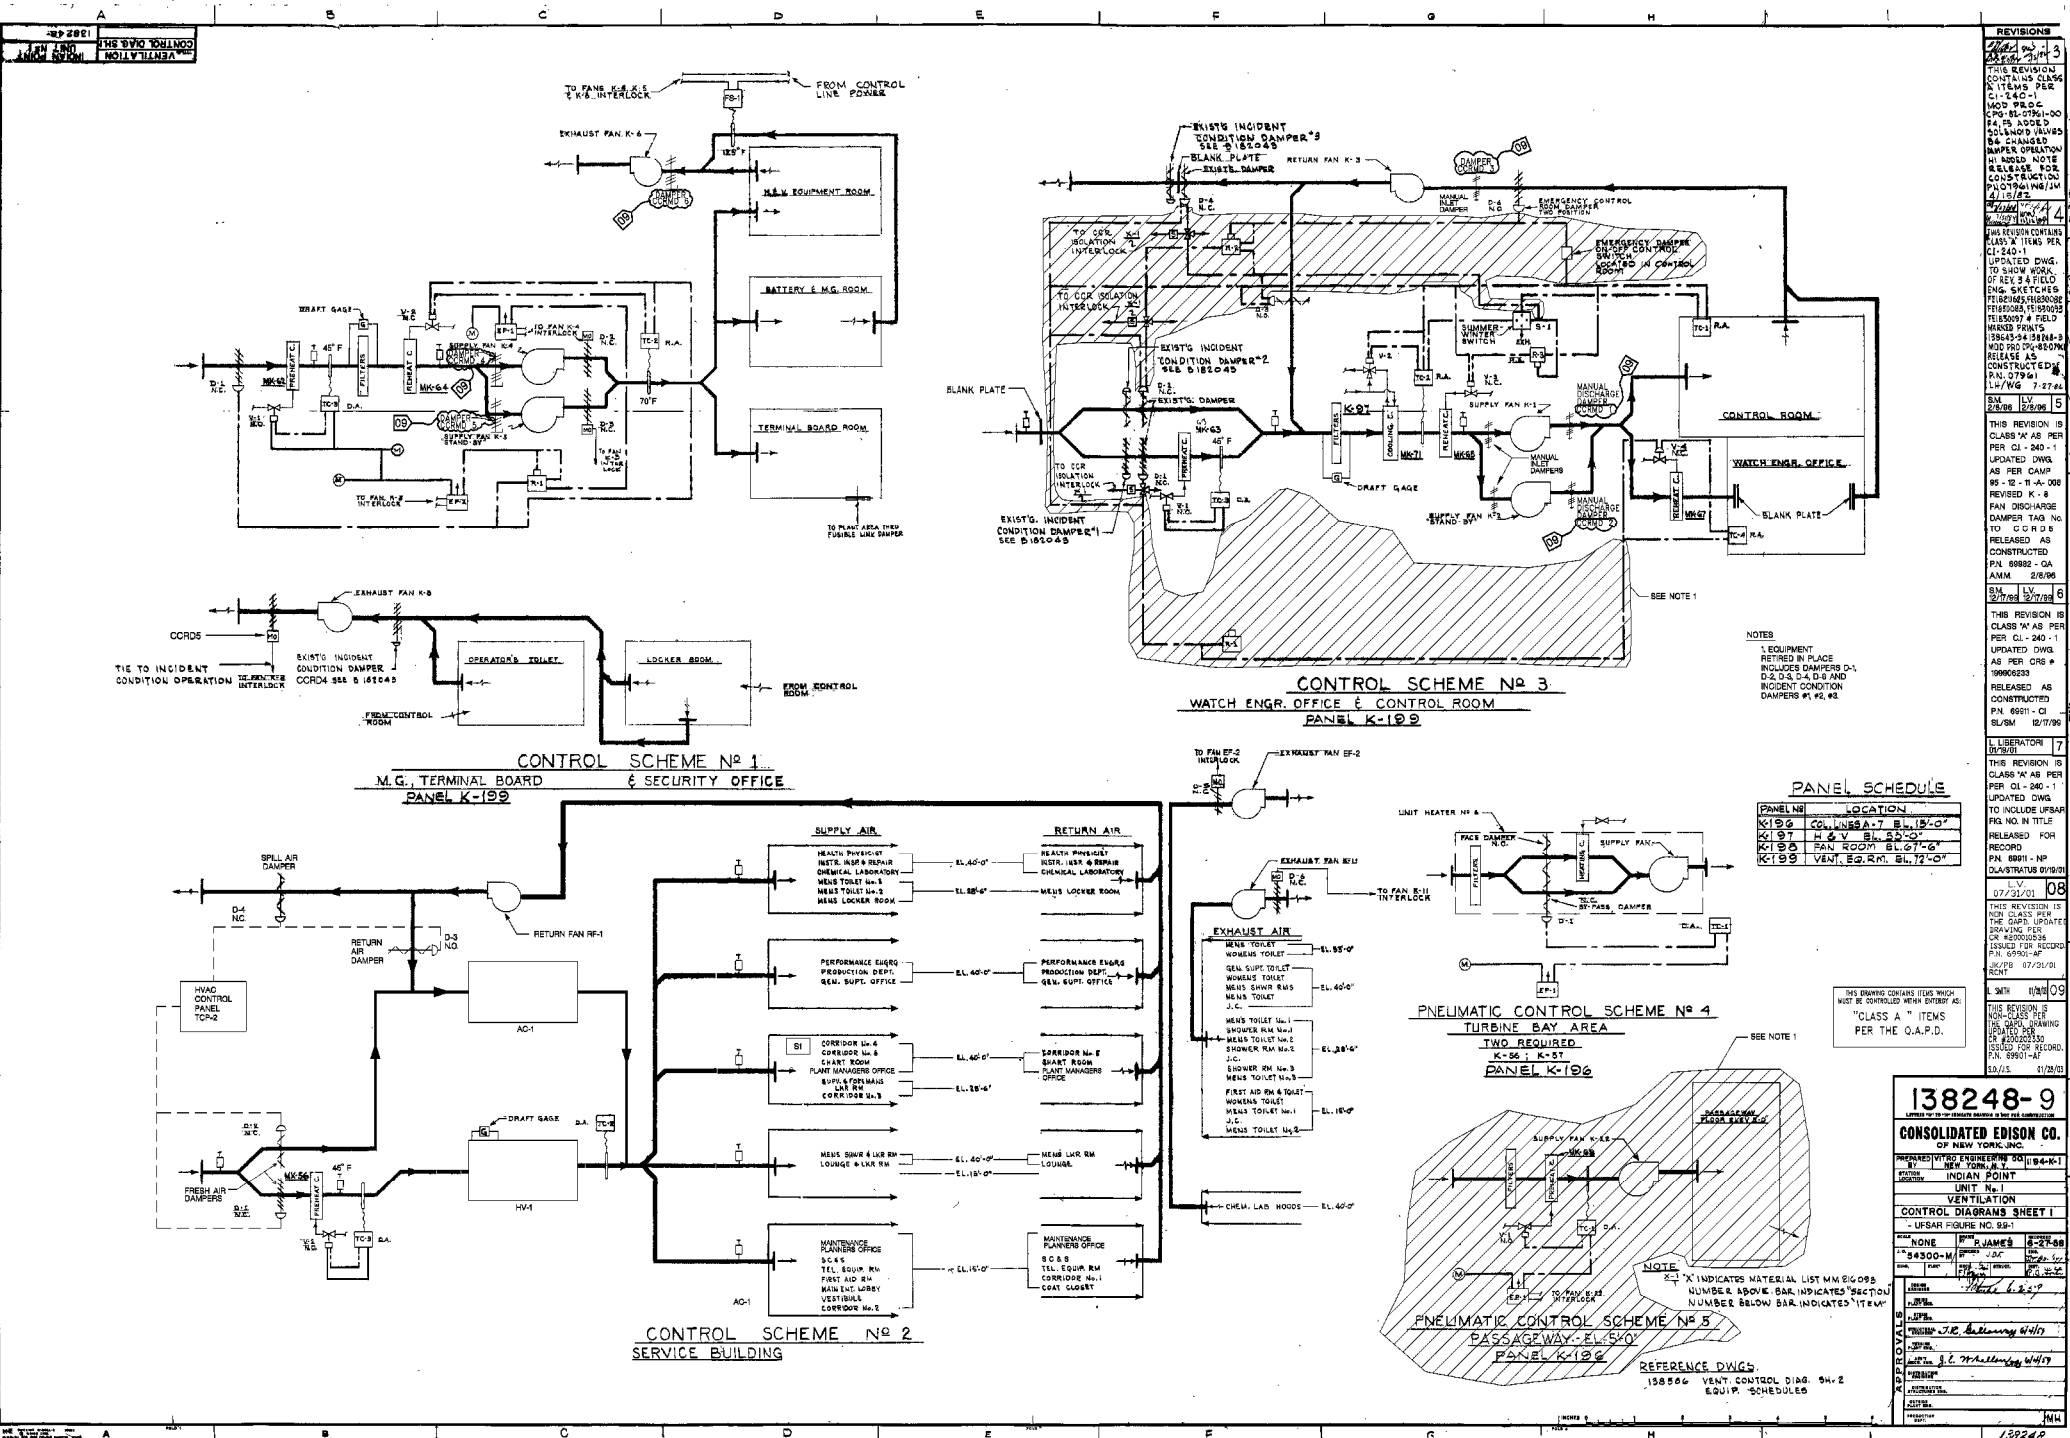

REV 2001  
 THE 1910 CONTROL DIALS  
 VENTILATION

CONTROL SCHEME No 1  
 M.G. TERMINAL BOARD  
 & SECURITY OFFICE  
 PANEL K-190

CONTROL SCHEME No 3  
 WATCH ENGR. OFFICE & CONTROL ROOM  
 PANEL K-199

CONTROL SCHEME No 2  
 SERVICE BUILDING

PNEUMATIC CONTROL SCHEME No 4  
 TURBINE BAY AREA  
 TWO REQUIRED  
 K-56 I, K-57  
 PANEL K-196

PNEUMATIC CONTROL SCHEME No 5  
 PASSAGEWAY - EL. 50'  
 PANEL K-198

PANEL SCHEDULE

PANEL NO.	LOCATION
K199	COLLINGS A-7 EL. 15'-0"
K197	M & V EL. 50'-0"
K198	FAN ROOM EL. 67'-6"
K199	VENT. EQ. RM. EL. 72'-0"

THIS DRAWING CONTAINS ITEMS WHICH MUST BE CONTROLLED WITHIN THE "CLASS A" ITEMS PER THE O.A.P.D.

NO.	DATE	REVISIONS
1	10/21/80	REVISED FOR CONSTRUCTION OF CLASS A ITEMS PER CI-240-1 MOD. P.D.C. CP-80-0761-00 P. 4, 5, 6 AND 7. BLANK PLATE CHANGED. DAMPER OPERATION IN NEED NOTE RELEASE FOR CONSTRUCTION POLYMER/AM 4/18/82
2	12/18/80	REVISED FOR CONSTRUCTION OF CLASS A ITEMS PER CI-240-1 UPDATED DWG. TO SHOW WORK OF KEY 3 & FIELD ENG. SKETCHES TELEPHONE ROOMS FEBRUARY 1980'S FEBRUARY 1980'S WERED PRINTS 1984-94 91888-9 1984-94 91888-9 RELEASE AS CONSTRUCTED P.N. 07941 1/17/81 7-2744 2/20/81 2/20/81
3	12/18/80	REVISED FOR CONSTRUCTION OF CLASS A ITEMS PER CI-240-1 UPDATED DWG. TO SHOW WORK OF KEY 3 & FIELD ENG. SKETCHES TELEPHONE ROOMS FEBRUARY 1980'S FEBRUARY 1980'S WERED PRINTS 1984-94 91888-9 1984-94 91888-9 RELEASE AS CONSTRUCTED P.N. 07941 1/17/81 7-2744 2/20/81 2/20/81
4	12/18/80	REVISED FOR CONSTRUCTION OF CLASS A ITEMS PER CI-240-1 UPDATED DWG. AS PER CAMP 85-12-11-A-000 RELEASED AS CONSTRUCTED P.N. 8982-CA AAM 2/8/86
5	12/18/80	REVISED FOR CONSTRUCTION OF CLASS A ITEMS PER CI-240-1 UPDATED DWG. AS PER CAMP 85-12-11-A-000 RELEASED AS CONSTRUCTED P.N. 8982-CA AAM 2/8/86
**138248-9**

CONSOLIDATED EDISON CO.  
 OF NEW YORK, INC.

PREPARED BY: ENGINEERING DEPT. (104-K-1)  
 UNIT No. 1  
 INDIAN POINT  
 CONTROL DIAGRAMS SHEET I  
 - USBAR FIGURE NO. 99-1

DATE: 8-2-80  
 BY: J.C. JAMES  
 CHECKED: J.C. JAMES  
 APPROVED: J.C. JAMES

REVISIONS:  
 1. REVISED FOR CONSTRUCTION OF CLASS A ITEMS PER CI-240-1  
 2. REVISED FOR CONSTRUCTION OF CLASS A ITEMS PER CI-240-1  
 3. REVISED FOR CONSTRUCTION OF CLASS A ITEMS PER CI-240-1  
